

For Project Location Map
Refer to Sheet No. A.02

INDEX OF SHEETS	
No.	DESCRIPTION
A Sheets	Title Sheets
* A.1	Title Sheet
* A.2	Location Map Sheet
* A.3 - 7	Criteria and Concept
B Sheets	Typical Cross Sections and Details
B.1 - 2	Typical Cross Sections and Details
D Sheets	Mainline Plan and Profile Sheets
* D.1	Plan & Profile Legend & Symbol Information Sheet
* D.2	IA 93
G Sheets	Survey Sheets
G.1 - 3	Reference Ties and Bench Marks
J Sheets	Traffic Control and Staging Sheets
J.1	Traffic Control Plan
V Sheets	Bridge and Culvert Situation Plans
V.1	Bridge and Culvert Situation Plans
W Sheets	Mainline Cross Sections
W.1	Cross Sections Legend & Symbol Information Sheet
W.2 - 4	Mainline Cross Sections
	* Color Plan Sheets



Highway Division

PLANS OF PROPOSED IMPROVEMENT ON THE

**PRIMARY ROAD SYSTEM
FAYETTE COUNTY
BRIDGE REPLACEMENT**

IA 93 - Stream 0.7 mi W of Co Rd V68

SCALES: As Noted

Refer to the Proposal Form for list of applicable specifications.

Value Engineering Saves. Refer to Article 1105.14 of the Specifications.



REVISIONS

FIELD EXAM MARK-UP

TOTAL
20
PROJECT IDENTIFICATION NUMBER
19-33-093-010
PROJECT NUMBER
BRFN-093-2(22)--39-33
R.O.W. PROJECT NUMBER

Field Exam held virtually on 6/14/21

Meeting Attendees:

- Tracy Meise (IDOT)
- Steven Schroder (IDOT)
- Kevin Smith (IDOT)
- Matt Erickson (IDOT)
- Gabriel Zittergruen (IDOT)
- Ron Loecher (IDOT)
- Jenifer Bates (Shive-Hattery)
- Joe Appel (Shive-Hattery)
- Mike Janecek (Shive-Hattery)
- Dan Jensen (Shive-Hattery)

- D3 PLAN - Date: July 16, 2021
- D5 PLAN - Date: November 19, 2021
- D4 PLAN - Date: August 22, 2023

PRELIMINARY PLANS



Subject to change by final design.

- D2 PLAN - Date: June 18, 2021

DESIGN DATA RURAL			
2024	AADT	1,600	V.P.D.
2044	AADT	1,700	V.P.D.
2044	DHV	170	V.P.H.
	TRUCKS	11	%
	Total		
	Design ESALs	--	

INDEX OF SEALS		
SHEET NO.	NAME	TYPE
A.1	Michael J. Janecek	Primary Signature Block
V.1	Phillip M. Harpole	Hydraulic Design

Detour okay as shown. Contractor will install and maintain detour signing as part of contract. District stated structure #11220 is in poor condition. Deck is severely spalled and could use some surface work before detour traffic is placed on the route. Detour route will also have a few sign upgrades, but they'll address that as it gets closer to needing the detour agreement.

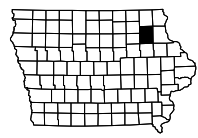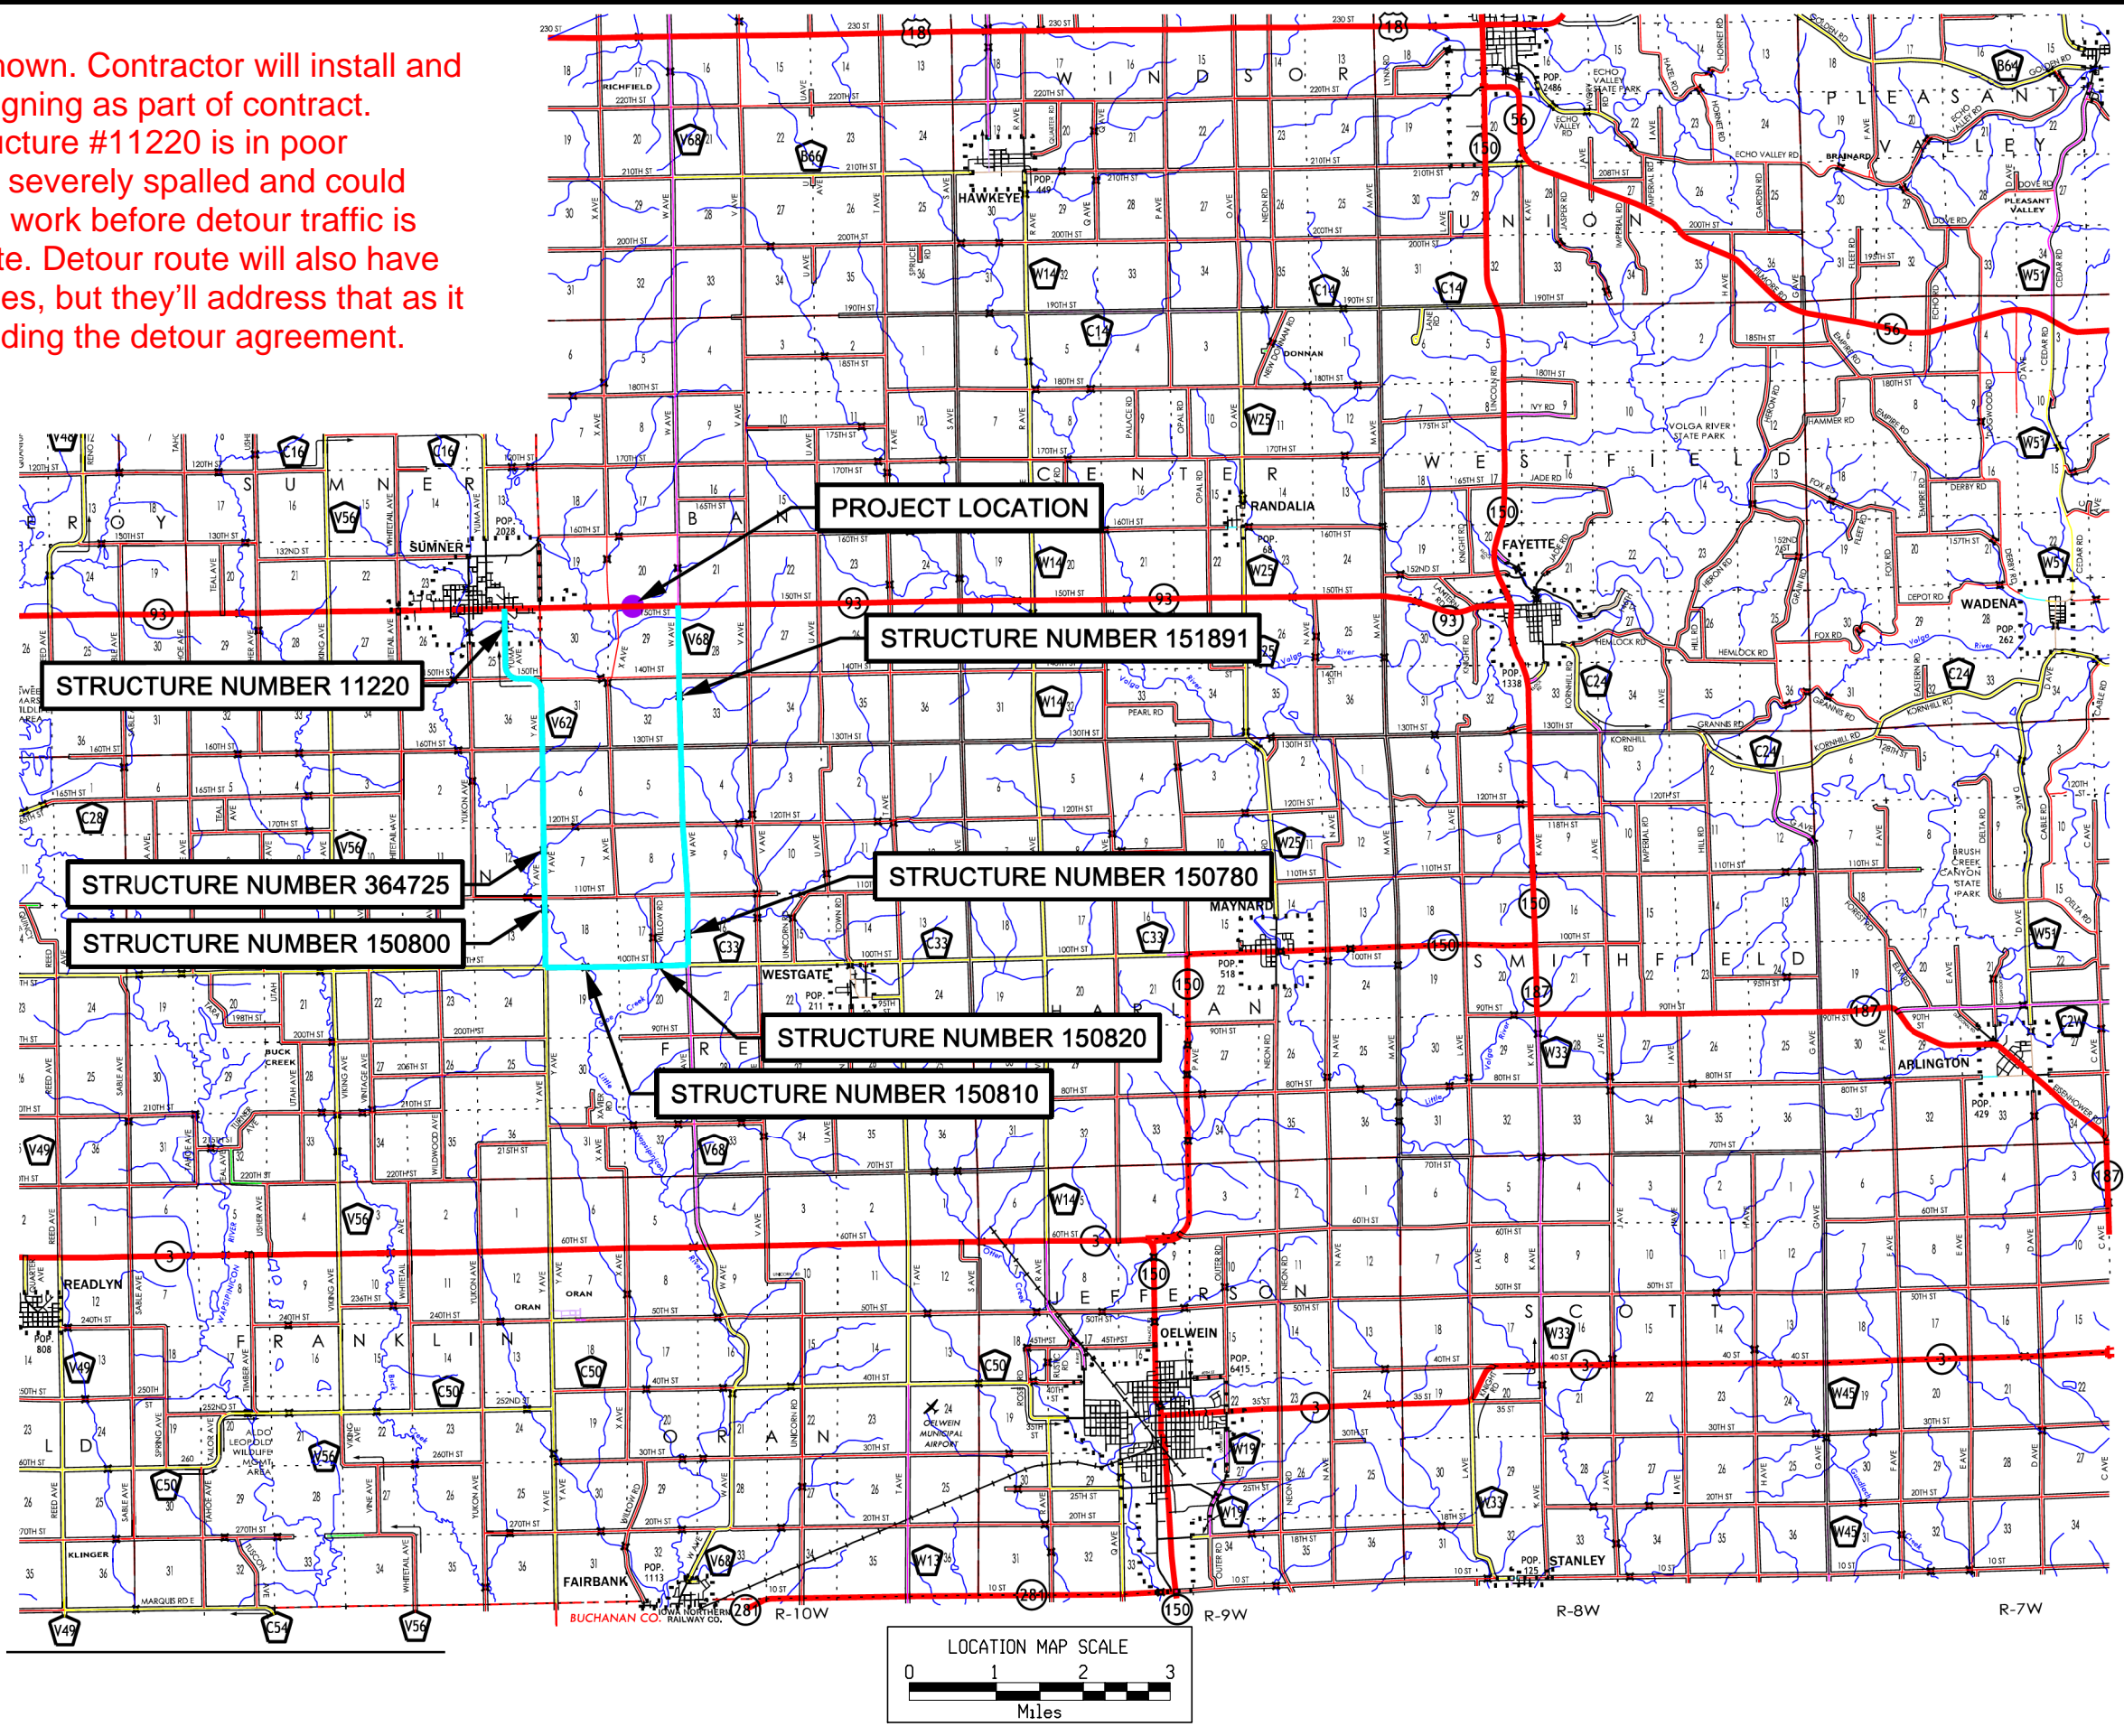

Roadway			
PIN Number	19-33-093-010	Submittal Date	5/22/2020
Project Number	BRFN-093-2(22)--39-33		Approval Date
District	District 2	Assistant District Engineer	Nick Humpal
County	FAYETTE	or	
Route	IA 93	Office Director	
Location	Stream 0.7 mi W of Co Rd V68		
Work Type	Bridge Replacement		
Segment Manager	John Bartholomew		
Designer	Jenifer Bates		

[Design Manual Section 1C-1](#)
[Last Updated: 04-29-19](#)

Rural Two-Lane Highways (Rural Arterials)

Design Element	Preferred	Acceptable	Project Values
Design speed (mph)	60	50	60
Maximum superelevation rate (Refer to Section 2A-2)	6%	8%	6%
Design lane width (ft)	12	12	12
Full depth paved width (ft)	12	12	12
Right turn lane (ft)	12	10	N/A
Climbing Lane (ft)	12	12	N/A
Left turn lane (ft)	12	10	N/A
Pavement cross-slope (on tangent sections)	Through lanes	1.5% minimum, 2% maximum	2%
	Auxiliary and turn lanes	3% maximum	N/A
	Crown break at centerline	4% maximum	N/A
Shoulder cross-slope (on tangent sections)	4%	Shoulder cross-slope cannot be less than the adjacent lane, 6% max for paved or granular shoulders, 8% max for earth shoulders	4%
Curb type (Refer to Section 3C-2)	Design speed = 50 or 55 mph	6-inch sloped	6-inch standard
	Design speed ≥ 60 mph	4-inch sloped	6-inch sloped
Foreslope (For fill areas greater than 40 ft, contact the Soils Design Section for assistance)	Adjacent to shoulder	10:1 for 4' then 6:1	3:1
	Beyond standard ditch depth and design clear zone	3.5:1	3:1
	Curbed roadways	2%	not steeper than 3:1
Backslope (For cut areas greater than 25 feet, contact the Soils Design Section for assistance with backslope benches.)	3:1	2.5:1	3:1
Transverse Slopes	w/ drainage structures	8:1	6:1
	w/o drainage structures	10:1	6:1
Ditches (Refer to Section 3G-1)	Outside ditch (depth x width) (ft)	5 x 10	--
Bridge width—new*	Bridge length ≤ 200 ft	design lane widths + effective shoulder widths	design lane widths + effective shoulder widths
	Bridge length > 200 ft	design lane widths + effective shoulder widths	design lane width + 4' right and left of the design lane widths
Bridge width—existing*	design lane widths + no less than 2 ft left and right		design lane widths + 2 ft. offset left and right
Vertical clearance (ft) (above lanes, shoulders and 25 feet left and right of the center of railroad tracks)	Over primary	16.5	16
	Over non-primary	16.5 at interchange locations, 15 at all other locations	14
	Over railroad	23.3	23.3
	Sign trusses and pedestrian bridges	17.5	17
Structural Capacity	Contact Office of Bridges and Structures		Contact Office of Bridges and Structures
Level of Service	B		B

*FHWA notification via email is required if acceptable criteria is not met on the NHS system (No formal design exception is required)

Design year ADT = 1600						
Design Manual Section 1C-1 Last Updated: 04-29-19						
Effective Shoulder Width and Type for Two-Lane Highways						
Preferred (values shown in feet)			Acceptable (values shown in feet)			Project Values
	Rural Roadways	Urban Roadways		Rural Roadways	Urban Roadways	
Turn lanes with shoulders	6	6	Turn lanes with shoulders	6	0	N/A
Turn lanes with curbs	6	See Section 3C-2	Turn lanes with curbs	6	0	N/A
	Effective Shoulder Width	Paved Width		Effective Shoulder Width	Paved Width	
Climbing Lanes	6	4	Climbing Lanes	4	0	N/A
Two-Lane Highways	Effective Shoulder Width	Paved Width	Two-Lane Highways	Effective Shoulder Width	Paved Width	
Routes where bicycles are to be accommodated	10	10	Design year ADT > 2000 vpd	8	0*	Effective = 8' Paved = 0'
On roadways approaching urban areas (due to increased bike traffic)	10	10				
On all curves with a superelevation rate of 7.0% or greater	10	10				
On roadways with design year ADT > 5000	10	6	Design year ADT between 400 - 2000 vpd	6	0*	
On all other NHS	10	6				
On non-NHS routes with design year ADT > 3000	10	6	Design year ADT < 400 vpd	4	0*	
On non-NHS routes with design year ADT < 3000	8	0*				
*Requires safety edge-Refer to Section 3C-6						
Curbs should be located beyond the outer edge of the effective shoulder width in rural areas						
Refer to Section 3C-2 for curb offsets in urban areas						
Notes:						
Requires safety edge						

Roadway Design Speed (mph) = 60															
Design Manual Section 1C-1 Last Updated: 04-29-19															
Design Criteria for High Speed Roadways															
Design Element	Preferred Criteria						Acceptable Criteria						Project Values		
	Design Speed, mph						Design Speed, mph								
	50	55	60	65	70	75	50	55	60	65	70	75			
Stopping sight distance (ft) (Refer to Section 6D-1)	425	495	570	645	730	820	425	495	570	645	730	820	570		
Minimum horizontal curve radius (ft) (Refer to Sections 2A-2 and 2A-3)	Method 5 superelevation and side friction distribution	$e_{max} = 6\%$	833	1060	1330	1660	2040	2500	833	1060	1330	1660	2040	2500	1330
		$e_{max} = 8\%$	--	--	--	--	--	--	758	960	1200	1480	1810	2210	N/A
Minimum vertical curve length (ft) (Refer to Section 2B-1)	crest vertical curves		150	165	180	195	210	225	150	165	180	195	210	225	180
Minimum rate of vertical curvature (K) (Refer to Section 2B-1)	crest vertical curves	roadways without fixed-source lighting	84	114	151	193	247	312	84	114	151	193	247	312	151
		roadways with fixed-source lighting	96	115	136	157	181	206	96	115	136	157	181	206	136
Minimum gradient (%)	(Refer to Section 2B-1)		0.5						0.3% with a curb, 0.0% without a curb						0.5
Maximum gradient (%) (Refer to Section 2B-1)	(Refer to Section 2B-1)	Urban roadways	4		3				7	6	6	--	--	--	
		Rural roadways	4		3				5	5	4	4	4	4	3
		Interstates	4		3				5	5	4	4	4	4	
Clear zone	See "Preferred Clear Zone" table in Section 8A-2						See "Acceptable Clear Zone" table in Section 8A-2						30'		

FINAL PROJECT CONCEPT STATEMENT

IA 93 Bridge over stream 0.7 mi W of Co Rd V68

TO OFFICE: District 2 **DATE:** September 8, 2020
ATTENTION: E. Jon Ranney **PROJECT:** Fayette County
 BRFN-093-2(22)--39-33
 PIN: 19-33-093-010
FROM: Jenifer Bates
OFFICE: Shive-Hattery
SUBJECT: Project Concept Statement; (Final, D0)

Fayette County
 Proj. # BRFN-093-2(22)--39-33
 PIN: 19-33-093-010
 Maint. No. 3317.1S093
 FHWA No. 24580

Jenifer J. Bates, P.E.
 515-223-8104

September 8, 2020

This project involves the replacement of the IA 93 bridge (Maint. No 3317.1S093) over stream 0.7 mi W of County Road V68.

A concept review was held virtually on July 23, 2020. Those present included Nick Humpal and Randy Taylor from District 2; Steven Schroder, David Claman, Matt Erickson from the Iowa DOT and Jenifer Bates, Joe Appel, Mike Janecek, and Mark Harpole from Shive-Hattery.

One alternative was considered:

- 1) Replace the existing structure with a twin 12' x 11' x 90' reinforced concrete box (RCB) placed at a 15 degree left ahead skew and 15 degree bend) at an estimated cost of \$835,000 (see attached concept for details). Additional right of way does look like it will be required. Traffic will be maintained using a detour.

Alternative 1 is the preferred alternative due to the site topography, low traffic volumes, safety considerations, and availability of a suitable detour route.

The Draft Project Concept Statement was sent out for review and comment with concerns to be resolved by September 4, 2020. Comments received during the review period have been considered and resolved.

This project is recommended for construction in FY 2024. The Bridges and Structures Bureau will coordinate the plan preparation with the assistance of the Design Bureau and Shive-Hattery.

Cc:	C. Purcell	M. J. Kennerly	K. D. Nicholson
	S. J. Megivern	J. S. Nelson	B. Walls
	M. Nop	M. A. Swenson	R. A. Younie
	K. Brink	D. L. Newell	J. W. Laaser-Webb
	W. A. Sorenson	D. E. Sprengeler	E. C. Wright
	M. E. Ross	A. A. Welch	N. M. Miller
	C. C. Poole	B. Bradley	B. E. Azeltine
	B. D. Hofer	T. D. Crouch	S. J. Gent
	S. Anderson	J. Selmer	K. K. Patel
	S. Godbold	D. R. Claman	J. Hauber
	A. Abu-Hawash	M. E. Khoda	K. Olson
	S. Neubauer	T. Abbett	M. Kelly
	B. Dolan	P. Hjelmstad	N. Humpal
	M. K. Solberg	G. Pavelka	R. Loecher
	R. Gelhaus	J. Bartholomew	D. Stokes
	S. Majors		

I. STUDY AREA

A. Project Description

This project involves the replacement of the IA 93 bridge (Maint. No 3317.1S093) over stream 0.7 mi W of Co Rd V68.

The alternative considered was:

1. Replace the existing structure with a twin 12' x 11' x 90' reinforced concrete box (RCB) placed at a 15-degree left ahead skew and 15 degree bend.

Alternative 1 is the preferred alternative due to the site topography, low traffic volumes, safety considerations, and availability of a suitable detour route.

Traffic will be maintained by an off-site detour.

The preliminary project cost is \$835,000. (This does not include costs associated with detour.)

B. Need for Project

This bridge is a 30' x 30' steel beam bridge constructed in 1949. The bridge deck is near the end of its useful life and needs replaced. There are areas of section loss at the ends of the steel girders. This type of superstructure is vulnerable to fatigue cracking in the vicinity of the welded cover plates. Due to the extent of these deficiencies and section loss, the bridge should be replaced.



SH Project #4202370

Shive-Hattery | 4125 Westown Parkway | Suite 100 | West Des Moines, IA 50266 | 515.223.8104 | shive-hattery.com



SH Project #4202370

Shive-Hattery | 4125 Westown Parkway | Suite 100 | West Des Moines, IA 50266 | 515.223.8104 | shive-hattery.com



C. Present Facility

The existing structure is a 30' x 30' steel beam bridge constructed in 1949.

IA 93 in the project area is 24' wide ACC pavement with 6' wide granular shoulders and 3:1 foreslopes, constructed in 1950. ACC resurfacing was accomplished in 1971 and 2004.

D. Traffic Estimates

The 2024 construction year and 2044 design year average daily traffic estimates are 1,600 ADT with 11 % trucks and 1,700 ADT with 11 % trucks, respectively.

E. Sufficiency Ratings

IA 93 is classified as an access route and is a maintenance service level C roadway. The federal bridge sufficiency rating is 81.5.

F. Access Control

Access rights will not be acquired for this project.

G. Crash History

During the five-year study period from January 1, 2015 through December 31,2019, there were 2 crashes including, 2 personal injury crashes.

II. PROJECT CONCEPT

A. Feasible Alternatives

Alternative #1 - Replace with a culvert

The existing 30' x 30' steel beam bridge will be replaced with a twin 12' x 11' x 90' reinforced concrete box (RCB) placed at a 15-degree left ahead skew and 15 degree bend.

The typical cross section over the culvert will consist of a 24' roadway with 8' effective shoulders (8' granular so requires safety edge) and 10:1 for 4' then 6:1/3.5:1 foreslopes.

The roadway will be reconstructed on the existing vertical and horizontal alignment. The flow line of the box will be buried 1' below the existing flow line in the channel. This will allow the bottom of the box to silt in and provide a natural bottom for fish passage. The existing ditches will need to be relocated to meet the inlet and outlet flowlines of the new RCB. Class E revetment will be placed at the ends of the RCB.

Apply erosion control and rural seeding and fertilizing to all disturbed areas.

Right of way does appear to be required for this project.

Traffic will be maintained by an off-site detour.

Bridge Items	<u>Estimated Costs</u>
New Culvert	\$378,200
Bridge Removal	\$10,400
Revetment	\$16,600
Engineer Fabric	\$1,200

Mobilization - 10%	\$40,600
Contingency - 20%	<u>\$89,400</u>
Bridge Costs	\$ 536,400

Roadway Items

Clearing and Grubbing	\$5,000
Embankment in place, contractor furnished	\$50,000
Excavation Class 10	\$2,000
Modified Subbase	\$3,800
Granular Shoulder	\$5,400
PCC Pavement	\$29,500
Flooded Backfill	\$13,200
Excavation Class 20	\$29,000
Removal of Pavement	\$5,100
Erosion Control	\$50,000
Right of Way	\$20,000
Traffic Control - 5%	\$10,700
Mobilization - 5%	\$10,700
M & C - 30%	<u>\$64,200</u>
Roadway costs	\$ 298,600

Project Total **\$835,000**

B. Detour Analysis

IA 93 will be closed and an offsite detour will be utilized. It is anticipated the detour will be in place for approximately 75 days. The detour would follow Co Rd V68 from its junction with IA 93 south to the junction of Co Rd V68 and Co Rd C33, then west on Co Rd C33 to its junction with V62, then north on Co Rd V62 to its junction with IA 93 in the town of Sumner, IA. Out of distance travel is 10 miles. The total distance user cost is anticipated to be \$295,600. The cost for county road maintenance will be \$15,300 as calculated by the Gas Tax Method. Detour signing costs will be \$10,000.

C. Recommendations

It is recommended that the present structure be replaced as described in Alternative No. 1.

D. Construction Sequence

It is anticipated that all work on this project will be awarded to one prime contractor. The Bridges and Structures Bureau will coordinate the plan preparation with assistance from the Design Bureau and Shive-Hattery.

E. ADA Accommodations

There are no bike paths or sidewalks adjacent to IA 93; therefore, no ADA accommodations are planned in conjunction with this project.

F. Special Considerations

This will not be a traffic critical project.

The ABC Rating Score of 30 is less than the first stage filter threshold of 50, therefore no further evaluation is considered.

Fayette County
Proj # BRFN-093-2(22)--39-33
PIN: 19-33-093-010
Page 4

No additional survey is requested at this time.

Right of Way does appear to be required for this project.

Once the Location and Environment Bureau has completed their review, comments will be incorporated into the final concept statement.

F. Program Status

Site data has been developed by Shive-Hattery. This project is listed in the 2020-2024 Iowa Transportation Improvement Program, with \$900,000 programmed for replacement in FY 2024. Costs for this project may be eligible for bridge replacement funds. A schedule of events will be developed following approval of the Project Concept.

Following page has a map of the county showing the location of the project area and the anticipated detour route.

Attachment A - Utilities


Jenifer J. Bates

From: ia@occinc.com
Sent: Wednesday, July 22, 2020 6:35 AM
To: Page, Jason
Subject: Design Information Results for Ticket # 552004883

(P11) BLACK HILLS ENERGY DECORAH
Contact Name : Jan Krueger
Contact Phone : 5633820953
Contact Email : jan.krueger@blackhillscorp.com
Locate Requested: N

(WINIA) WINDSTREAM COMMUNICATIONS
Contact Name : LOCATE DESK
Contact Phone : 8002891901
Contact Email : LOCATE.DESK@WINDSTREAM.COM
Locate Requested: N

LOCATION		DIMENSIONS			
ROAD IDENTIFICATION	STATION TO STATION	(L) Feet	(R) Feet	(X) Inches	(BW) Feet
IA 93	69+00.00 70+65.00	30.84	30.84	20	11.16

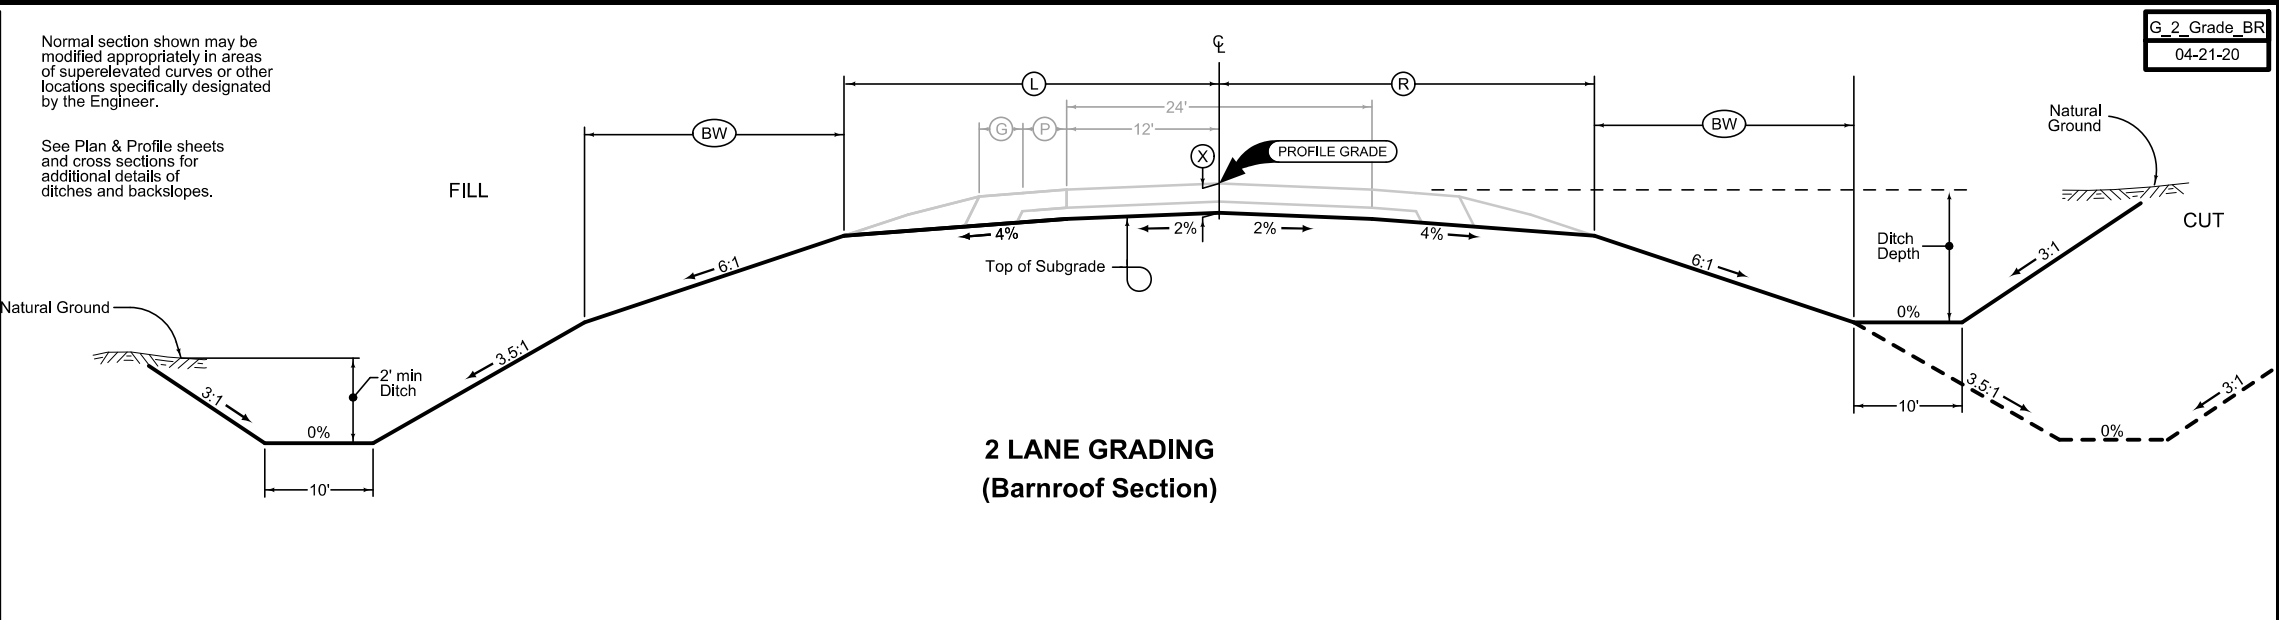


G_2_Grade_BR
04-21-20

District's comment: Rather than fully updating the short section of foreslopes to accommodate the RCB, I'd recommend more closely mimicking the existing conditions. Perhaps the foreslopes can be 4:1 rather than the barn roof currently shown. (This will be reviewed and incorporated into the D3 submittal.)

Granular Shoulder with Safety Edge

2_G_		Ⓞ
04-21-20		
STATION TO STATION		Feet
69+00.00	70+65.00	8

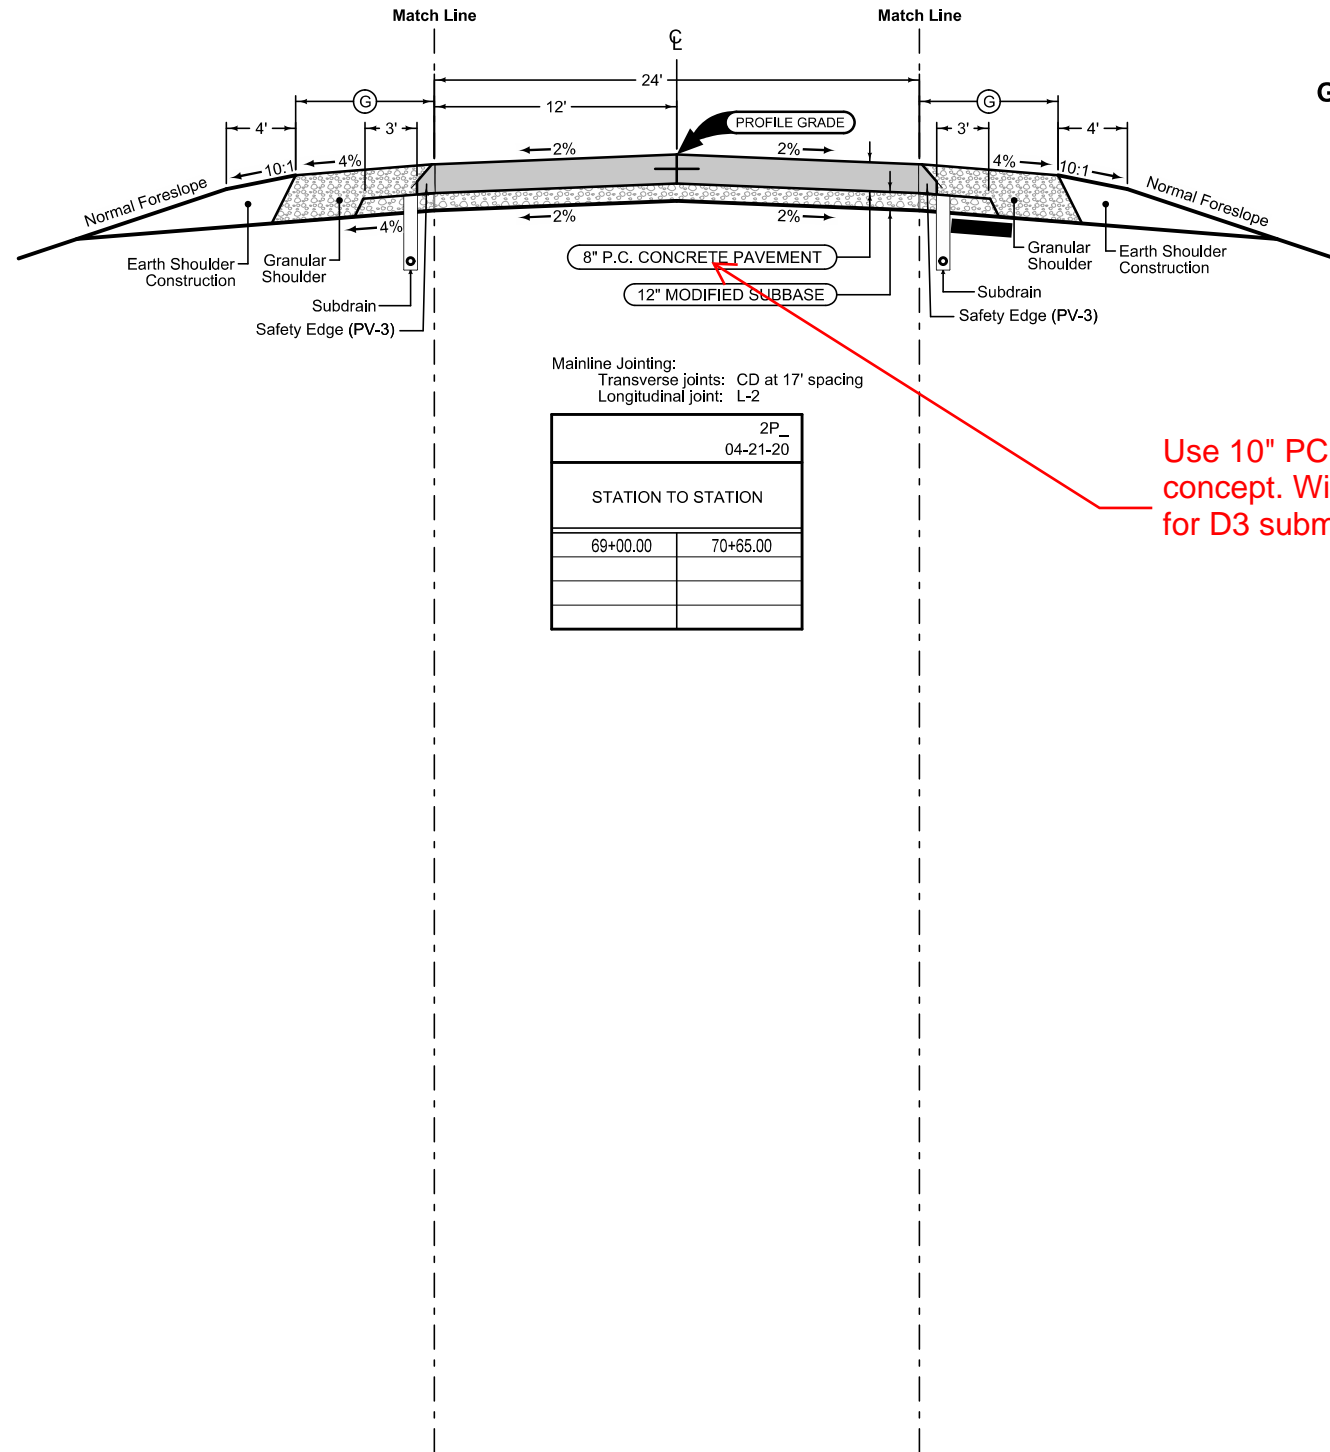

Granular Shoulder with Safety Edge

2_G_		Ⓞ
04-21-20		
STATION TO STATION		Feet
69+00.00	70+65.00	8

Mainline Jointing:
 Transverse joints: CD at 17' spacing
 Longitudinal joint: L-2

2P_	
04-21-20	
STATION TO STATION	
69+00.00	70+65.00

Use 10" PCC as per concept. Will update for D3 submittal.

See Tab 100-24 or 100-25 for pavement quantities.
 See Tab 112-9 for shoulder quantities.

IA 93

SURVEY SYMBOLS

- PI Tangent Point
- SCR Section Corner
- CP Control Point
- WC Wild Card (Misc. Field Shot)
- BM Bench Mark
- BNK Stream Bank
- TW Top of Water
- SBR Size of Bridge
- BL Topo Breakline
- D Centerline Draw or Stream (Down)
- FW Wire Fence
- GR Ground Shot
- ENU Edge Unpaved Entrance & Parking
- PIP Pipe Culvert
- PLG Location of General Photo
- PPA Power Pole Co. 1
- ENT Centerline BL of Entrance
- DU Centerline Draw or Stream (Up)
- SNP Unpaved Shoulder
- EP Edge of Paved Roads (ML or SR)
- C Centerline BL of Road (ML or SR)
- TPD Telephone Pedestal
- ROW Right of Way Mark
- OUT Tile Outlet
- GDL Guard Rail Steel
- BD Bridge Deck
- BRG Bridge
- CON Concrete or A/C Slab
- RIP Rip-Rap
- BLD Building or Foundation
- FWD Wood Fence
- EW Edge of Water
- BLS Bridge Low Steel
- BCL Bridge Centerline
- FO1D Fiber Optic Co. 1 - Quality D
- GL1D Gas Line Co. 1 - Quality D

UTILITY LEGEND

Sub-Surface Utility Mapping Quality Level is in accordance with CI/ASCE 38-02 Standard Guidelines for the Collection and Depiction of Existing Subsurface Utility Data.

Remark Abbreviations
 QLA Quality Level A Highest guideline quality level
 QLD Quality Level D Lowest guideline quality level

- PPA Power Pole Black Hills Energy
Jan Krueger
563-382-0953
jan.krueger@blackhillscorp.com
- FO - Windstream Communications - Quality D
800-289-1901
LOCATE.DESK@WINDSTREAM.COM
- GL Gas Line - Black Hills Energy - Quality D
Jan Krueger
563-382-0953
jan.krueger@blackhillscorp.com

PLAN VIEW COLOR LEGEND OF PLAN AND PROFILE SHEETS

LINEWORK	Design Color No.	
Green	(2)	Existing Topographic Features and Labels
Blue	(1)	Proposed Alignment, Stationing, Tic Marks, and Alignment Annotation
Magenta	(5)	Existing Utilities
SHADING		
Design Color No.		
Yellow	(4)	Highlight for Critical Notes or Features
Red	(3)	Delineates Restricted Areas
Lavender	(9)	Temporary Pavement Shading
Gray, Light	(48)	Proposed Pavement Shading
Gray, Med	(80)	Proposed Granular Shading
Gray, Dark	(112)	Proposed Grade and Pave Shading "In conjunction with a paving project"
Brown, Light	(236)	Grading Shading
Tan	(8)	Proposed Sidewalk Shading
Blue, Light	(230)	Proposed Sidewalk Landing Shading
Pink	(11)	Proposed Sidewalk Ramp Shading

PROFILE VIEW COLOR LEGEND OF PLAN AND PROFILE SHEETS

LINEWORK	Design Color No.	
Green	(2)	Existing Ground Line Profile
Blue	(1)	Proposed Profile and Annotation
Magenta	(5)	Existing Utilities
Blue, Light	(230)	Proposed Ditch Grades, Left
Black	(0)	Proposed Ditch Grades, Median
Rust	(14)	Proposed Ditch Grades, Right

Reference Point

Station Survey Line

- Section Corner
- Ground Line Intercept
- Saw Cut
- Guardrail
- Trench Drain
- HighTension Cable Guardrail
- Sheet Pile

Pavement Removal Clearing & Grubbing Area

RIGHT-OF-WAY LEGEND

- Proposed Right-of-Way
- Existing Right of Way
- Existing and Proposed Right-of-Way
- Easement and Existing Right-of-Way
- Easement (Temporary)
- Easement
- Access Control
- Property Line

PLAN AND PROFILE LEGEND AND SYMBOL INFORMATION SHEET


(COVERS SHEET SERIES D, E, F, & K)

Banks TWP.
T-93N R-10W
SEC. 20

STA. 69+00.00
BEGIN ROADWAY



STA. 70+65.77
END ROADWAY

As per District review: west end of entrance pipe needs one section reset, east end needs one section replaced and aprons need added to both sides.

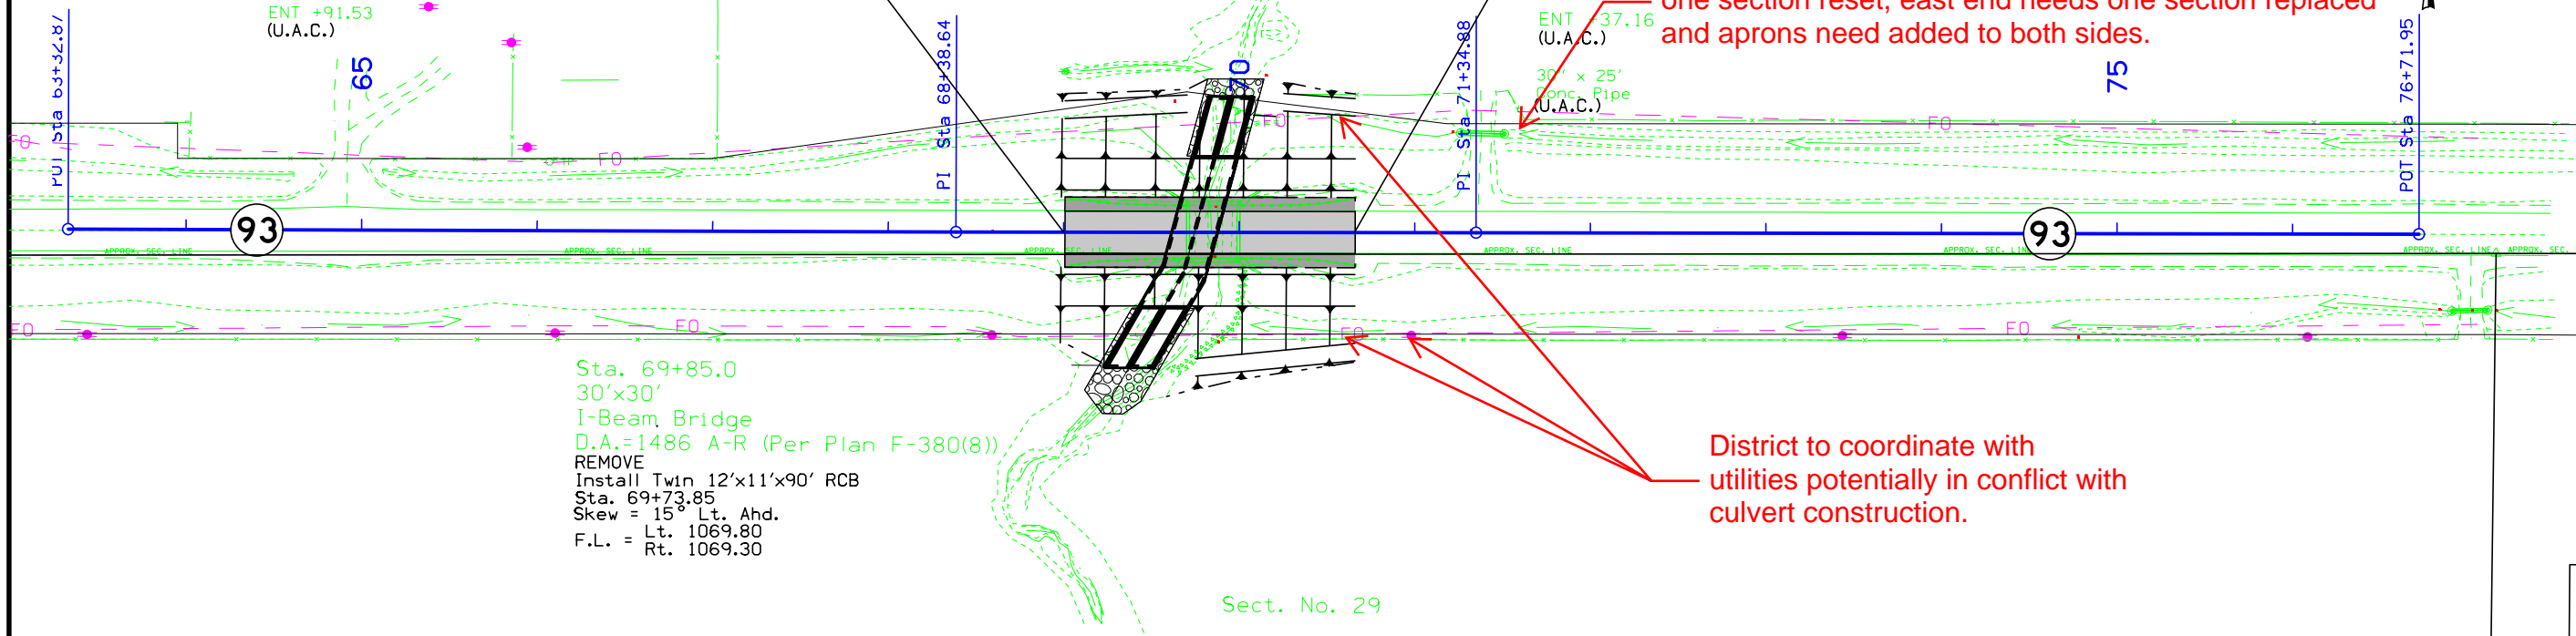

Sta. 69+85.0
30'x30'
I-Beam Bridge
D.A.=1486 A-R (Per Plan F-380(8))
REMOVE
Install Twin 12'x11'x90' RCB
Sta. 69+73.85
Skew = 15° Lt. Ahd.
F.L. = Lt. 1069.80
Rt. 1069.30

Sect. No. 29

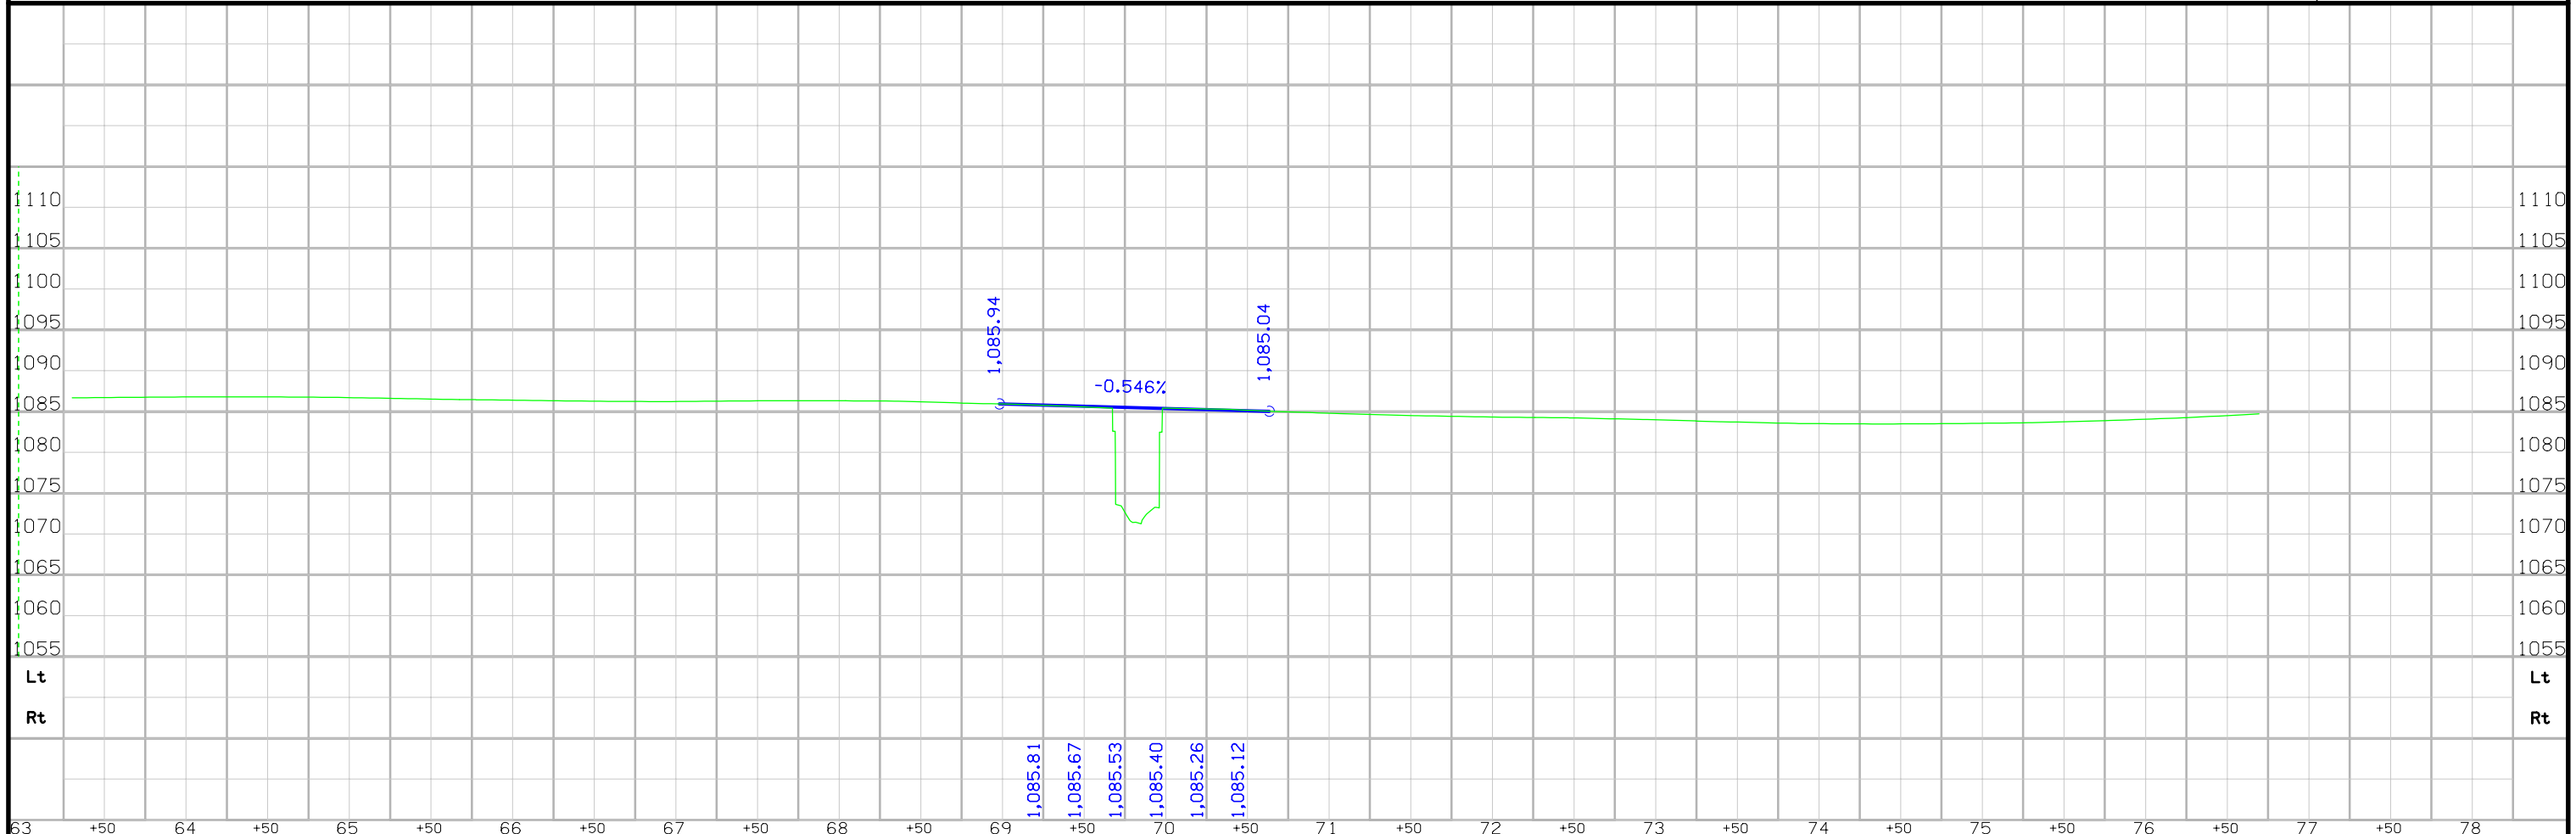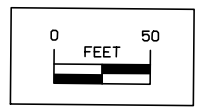

Survey Information

Fayette County
BRFN-093-2(22)--39-33
Stream 0.7 mi W of Co Rd V68
Bridge-Unspecified
PIN 19-33-093-010
Sap-958.0

General Information

Measurement units for this survey are US survey feet. This survey is for proposed Bridge replacement. Project datum and control information is provided by Design Survey Office. This project is a Full Field concept survey. This survey request was for the Iowa Hwy. 93 corridor only.

Vertical Control

Vertical datum for this survey is NAVD88 (Computed using Geoid12b). GRS80 Ellipsoidal Height was computed at project control Pts. 341, 93168, 93175, J 38 RESET, and JOHNSON by conducting two concurrent six-hour static observations. Additional benchmarks were placed throughout the project using a GNSS Base-Rover setup relative to Pt. 93168 and Pt. 93175. Two observations with a minimum of four-hours between were collected and used in a weighted average.

This survey observed 1 NGS Control Monument with published NAVD88 height to compare to local ground control:

NGS 3rd. order mark designated J 38 RESET has a published Elev. Of 1071.8
Survey Elev. = 1071.67

This survey observed 1 local area county Control Monument with published NAVD88 height to compare to local ground control:

Fayette County GPS Control Pt 341 has a published Elev. of 1165.00
Survey Elev. = 1164.89

This survey observed 1 As-Built plan benchmark to compare to local ground control:

BM 6A As-built Plans Project No. F-380(8) Elev. 1077.50
Survey Elev. = 1077.17

Survey elevations obtained on the bridge seats have a close vertical difference relationship with the plan bridge seat elevations as follows:

As-built Plan FA-380(8) Bridges and Culverts Design No. 1048

West abutment bridge seat plan elev. = 1082.89
Survey elev. = 1082.58

East abutment bridge seat plan elev. = 1082.78
Survey elev. = 1082.49

The average vertical difference of the As-built plan benchmark and the As-built plan bridge seat elevations is -0.31 to be applied to as built elevations.

Horizontal Control

The project coordinate system for this survey is Iowa RCS Zone 5 (U.S. Survey Feet). This survey control is relative to IaRTN reference stations. IaRTN Reference Station coordinates are relative to the National Reference Station network datum: NAD83 (2011) for Epoch 2010.00. Coordinates were determined by conducting two concurrent six-hour static observations at project control Pts. 341, 93168, 93175, J 38 RESET, and JOHNSON.

Alignment Information

The horizontal alignment for this survey is a retrace of As-built Plans Project No. F-380(8) Grading and Surfacing. Survey stationing was equated to the plan PI at Sta. 77+16.2 and run back and ahead without equation throughout the survey.

Survey stationing relates to as built plan stationing as follows:

PI Sta. 50+37.5 As-built Plans Project No. F-380(8)
Survey PI Sta. 50+37.94

PI Sta. 77+16.2 As-built Plans Project No. F-380(8)
Survey PI Sta. 77+16.20

POT Sta. 103+85.5 As-built Plans Project No. F-380(8)
Survey POT Sta. 103+85.58

CONTROL POINT VICINITY MAP

This map is a guide to the vicinity of the primary project control points
Primary control is for use with RTK base stations and for RTN validation.
Future surveys will use primary project control to establish temporary
control as needed for construction or other surveying applications.



HORIZ. DATUM: NAD83(2011) EPOCH 2010.00

VERT. DATUM: NAVD88

1a. Regional Coordinate System Zone 5

Coordinate listing from next sheet will be used with 1aRTN for monument
recovery. No other reference ties are given.

HORIZONTAL AND VERTICAL PROJECT CONTROL COORDINATE LISTING

HORIZ. DATUM: NAD83(2011) EPOCH 2010.00

VERT. DATUM: NAVD88

Ia. Regional Coordinate System Zone 5

Point Name	Northing	Easting	Elevation	Code - Description
341	8977390.543	15560825.317	1164.892	BM FD FAYETTE CO GPS CONTROL POINT 341_28 FT NORTH OF 160TH ST AND 33 FT WEST OF V AVE
J38 RESET	8966691.288	15548226.786	1071.670	BM FD NGS THIRD ORDER BENCH MARK J 38 RESET 160 FT EAST OF OLD RR GRADE TOP EAST END OF SOUTH HDWLL 4X6 RCB AND 17 FT SOUTH OF 140TH ST
JOHNSON	8972208.660	15560924.846	1178.429	BM FD NGS SECOND ORDER TRIANGULATION STATION JOHNSON 140 FT NORTH OF IA HWY 93 AND 40 FT EAST OF V AVE
93168	8972086.448	15550427.922	1076.226	BM FD ROW RAIL DRILL HOLE IN BALL 82 FEET EAST OF X AVE AND 58 FEET NORTH OF IA HWY 93
93175	8972110.745	15554220.381	1092.081	BM FD ROW RAIL DRILL HOLE IN BALL 60 FEET NORTH OF IA HWY 93 AND 40 FEET SOUTH OF ROW RAIL

108-23A
08-01-08

TRAFFIC CONTROL PLAN

1) While existing bridge is removed and replaced with a RCB, IA 93 traffic shall be maintained via off-site detour as shown on sheet A.2.

108-25
10-21-14

511 TRAVEL RESTRICTIONS

Route	Direction	County	Location Description	Feature Crossed	Object Type	Maint. Bridge No., Structure ID, or FHWA No.	Type of Restriction	Existing Measurement	Construction Measurement	Construction Measurement as Signed	Projected As Built Measurement	Remarks
IA 93	Both	Fayette	0.7 Miles West of Co. Rd. V68	Stream			None					

111-01
04-17-12

COORDINATED OPERATIONS

Other work in progress during the same period of time will include the construction of the projects listed. Coordinate operations with those of other contractors working within the same area.

Project	Type of Work
None Provided	

1100		1100
1090		1090
1080		1080
1070		1070
1060	CLASS E REVETMENT UNDERLAIN WITH ENGINEERING FABRIC ELEV.= 1070.80	1060
1050		1050

BENCH MARK NO.


STA: 69+00.61
1,085.94

-0.546%

STA: 70+65.87
1,085.04

LONGITUDINAL SECTION ALONG ϕ CULVERT

PROPOSED PROFILE
GRADE IA 93

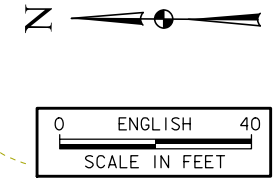

NOTES:

1. EXISTING 28'x30' STEEL BEAM BRIDGE DESIGN NO. 287 TO BE REMOVED.
2. DRAINAGE THROUGH EXISTING CULVERT/CHANNEL MUST BE MAINTAINED THROUGHOUT CONSTRUCTION
3. FLOW LINE OF CULVERT NOMINALLY BURIED 1.0 FOOT.
4. BURIED AND OVERHEAD UTILITIES TO BE RELOCATED TEMPORALLY OR PERMANENTLY AS REQUIRED FOR CONSTRUCTION.

HYDRAULIC DATA

DRAINAGE AREA = 2.43 ACRES
 $Q_{50} = 1,740$ CFS
 HW ELEV. = 1080.10
 STREAM SLOPE = 30.60 FT./MI.

Use Class B
Revetment due to
high flow velocities

UTILITIES LEGEND:

- PPA Power Pole Black Hills Energy
 - FO - Windstream Communications - Quality D
 - GL Gas Line Black Hills Energy - Quality D
- UTILITIES SHOWN ON THIS SHEET ARE FOR INFORMATION ONLY, SEE ROAD DESIGN SHEETS FOR FINAL UTILITY INFORMATION.

LOCATION


IA. 93 OVER STREAM
 T-93N R-10W
 SECTION 20 - 29
 BANKS TOWNSHIP
 FAYETTE COUNTY
 FHWA NO. ?
 BRIDGE MAINT. NO. 3317.IS093
 LATITUDE 42.847486°
 LONGITUDE -92.055557°

TRAFFIC ESTIMATE

2024 AADT	1600	V.P.D.
2044 AADT	1700	V.P.D.
2044 DHV	170	V.P.H.
TRUCKS	11	%
TOTAL DESIGN ESALS		

PRELIMINARY

DESIGN FOR 15° SKEW L.A.
TWIN 12'-0x11'-0x90'-0 CAST IN PLACE CONCRETE CULVERT
 SITUATION PLAN
 STATION 69+73.85 JUNE 2021
 FAYETTE COUNTY
 IOWA DEPARTMENT OF TRANSPORTATION - HIGHWAY DIVISION
 DESIGN SHEET NO. 1 OF 1 FILE NO. 31934 DESIGN NO. 124

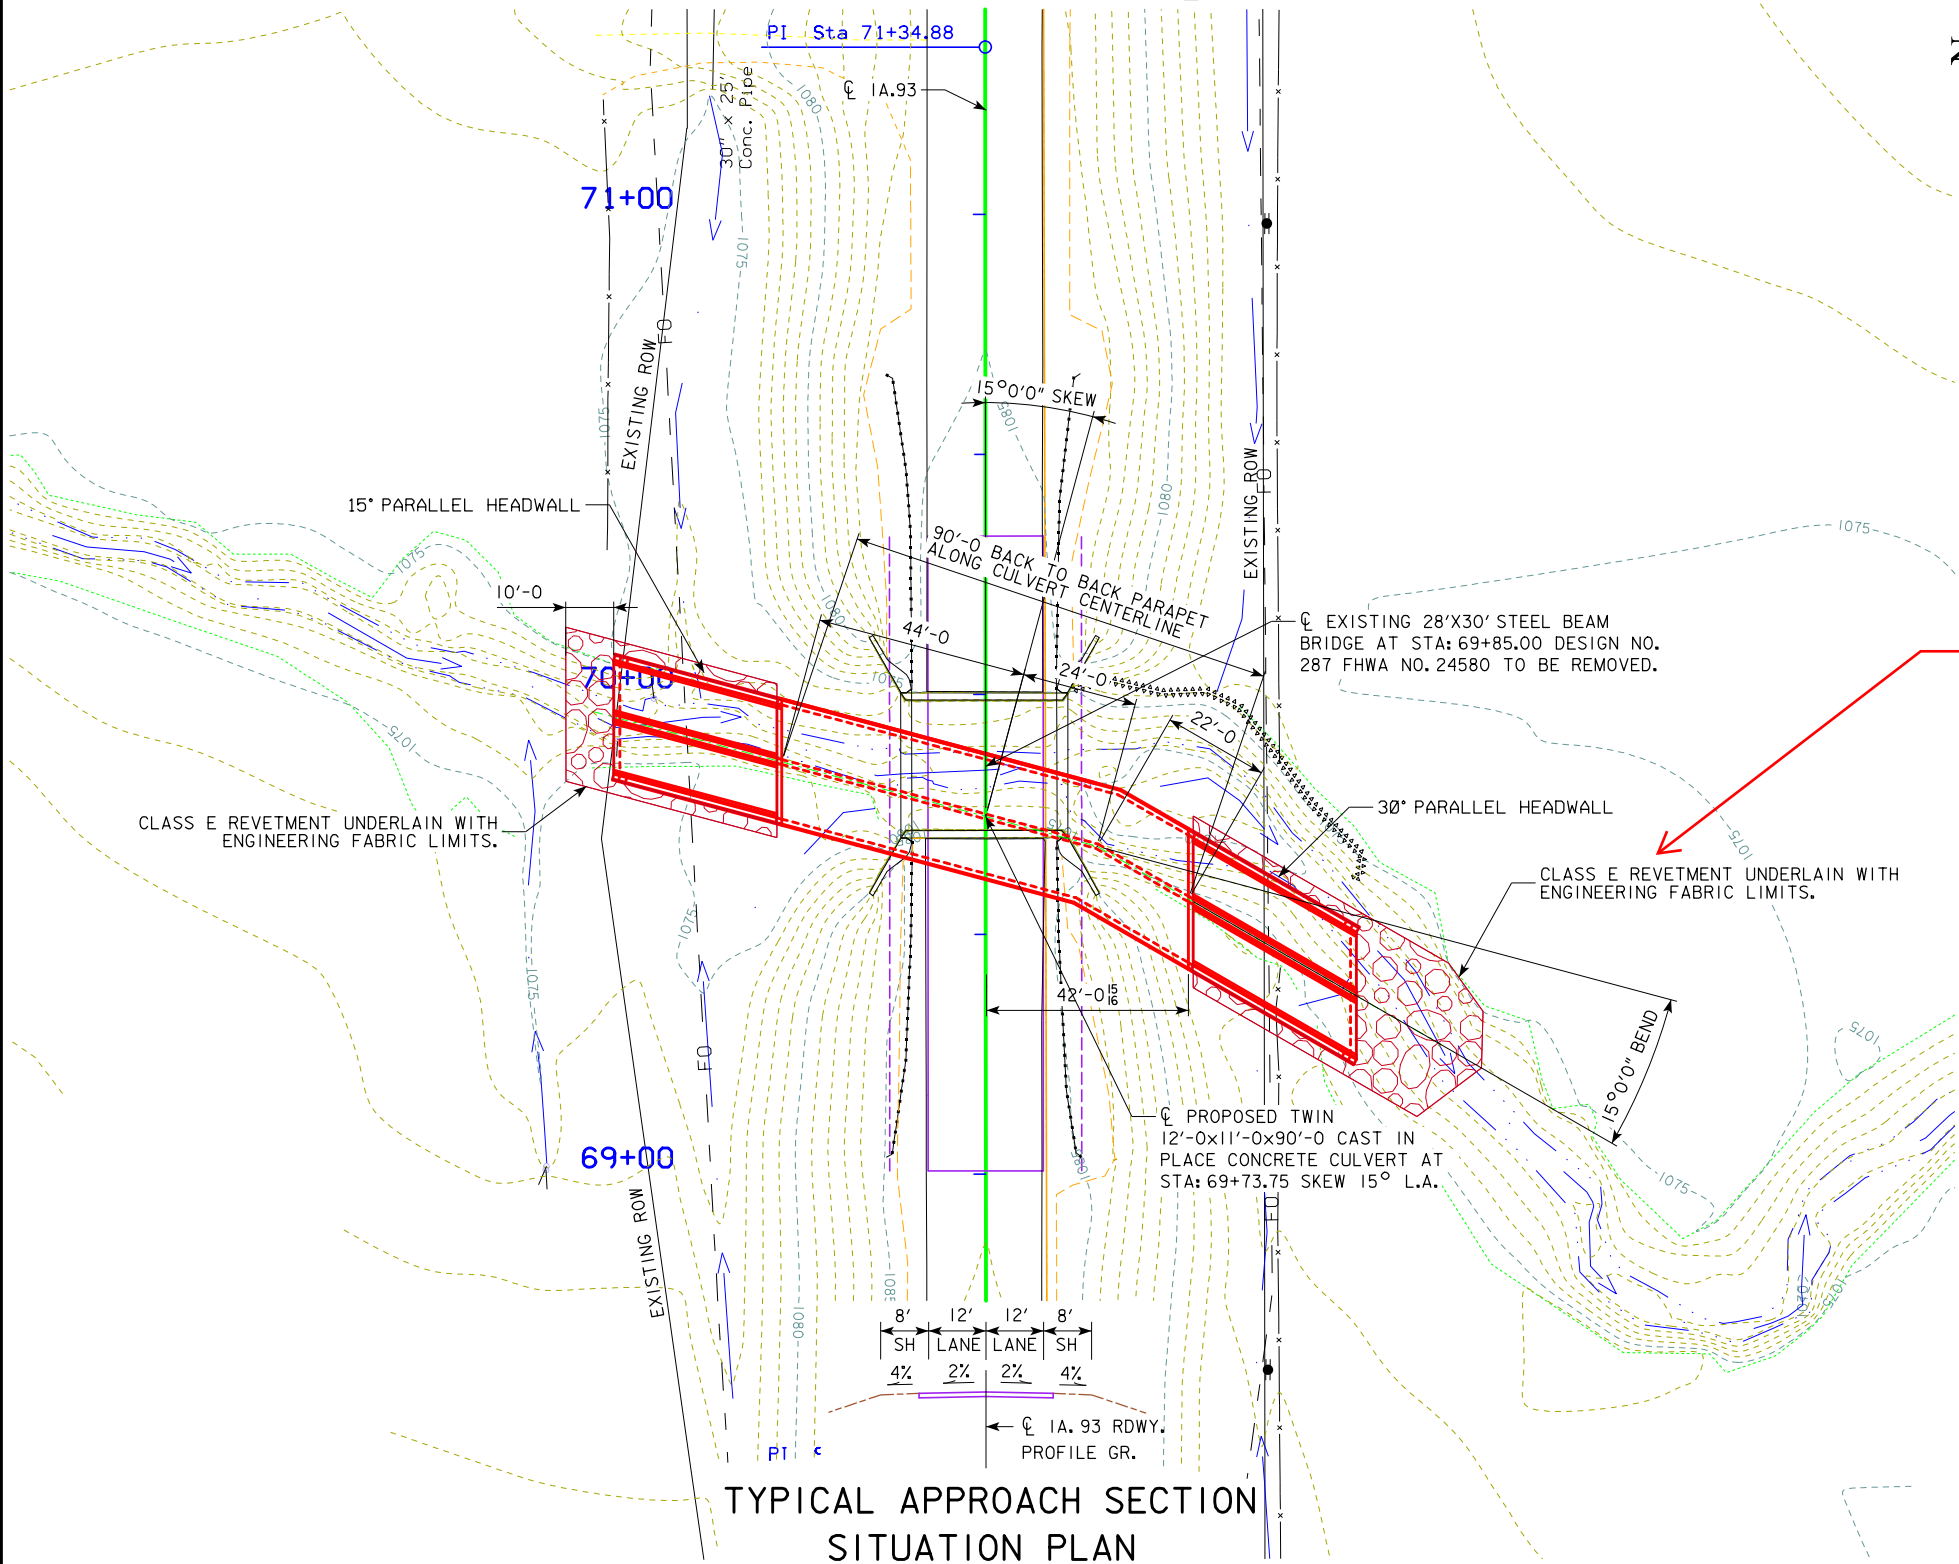

TYPICAL APPROACH SECTION
SITUATION PLAN

LINE STYLE LEGEND OF CROSS SECTION SHEETS (ROAD)

- - - - - - Existing Ground Line
- Proposed Template
- Proposed Topsoil Placement
- - - - - Additional Topsoil Removal
- Subgrade Treatment
- - - - - Granular Shoulder
- Pavement
- - - - - Existing Pipe\RCB
- Proposed Pipe\RCB
- Proposed Dike
- All Elements Associated with Proposed Entrances

LINE STYLE LEGEND OF CROSS SECTION SHEETS (SOILS)

- Topsoil (Class 10)
- Slope Dressing Only
- Class 10 Materials
- Select Loams And Clay-Loams
- Select Sand
- Unsuitable Type A Disposal
- Unsuitable Type B Disposal
- Unsuitable Type C Disposal
- Shale
- Waste
- Broken and Weathered Rock
- Solid Rock
- Boulders

Note: All layer lines and descriptions identify layers above the line.

Note: Vertical or near vertical lines connecting soil layers at edges of cross sections are only for the purpose of calculating template quantities and do not depict soil stratification.


SYMBOL LEGEND OF CROSS SECTION SHEETS

- Existing ROW
|
Existing Right-of-Way Limit
- Proposed ROW
|
Proposed Right-of-Way Limit
- Temporary ROW
|
Temporary Right-of-Way Limit


**CROSS SECTION
LEGEND AND SYMBOL
INFORMATION SHEET**

(COVERS SHEET SERIES W, X, Y, & Z)

IA 93 Preliminary

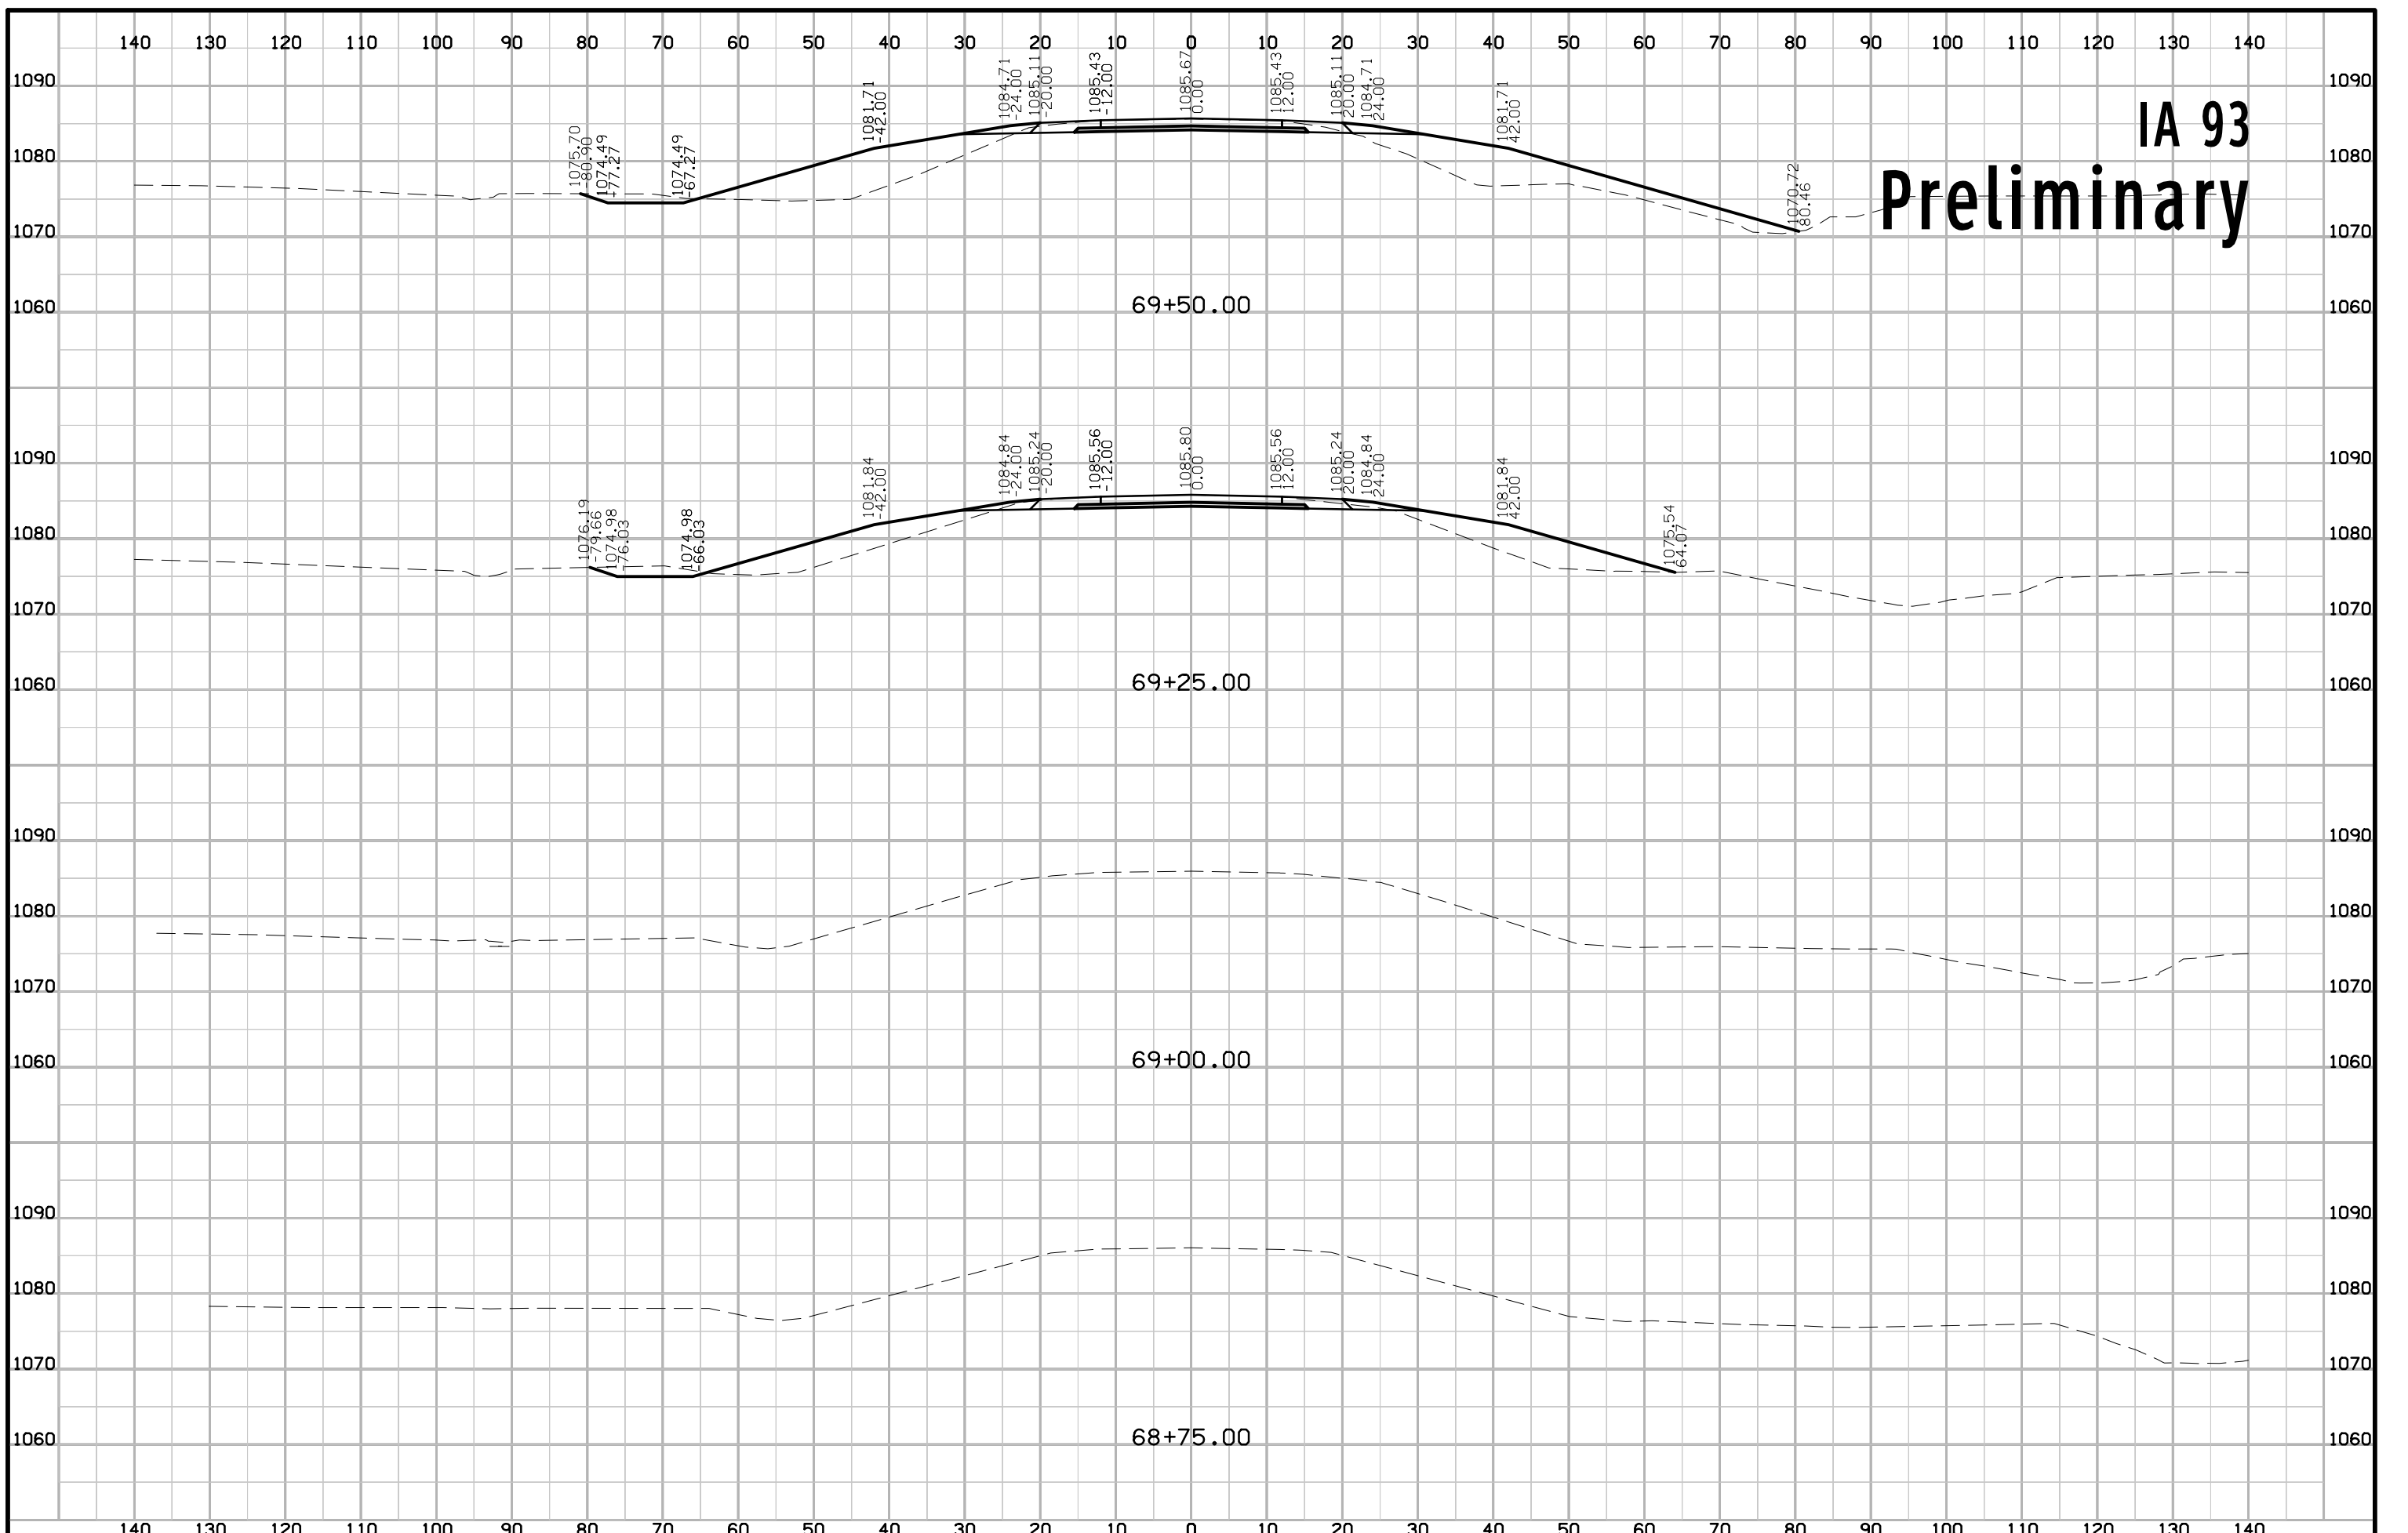

IA 93 Preliminary

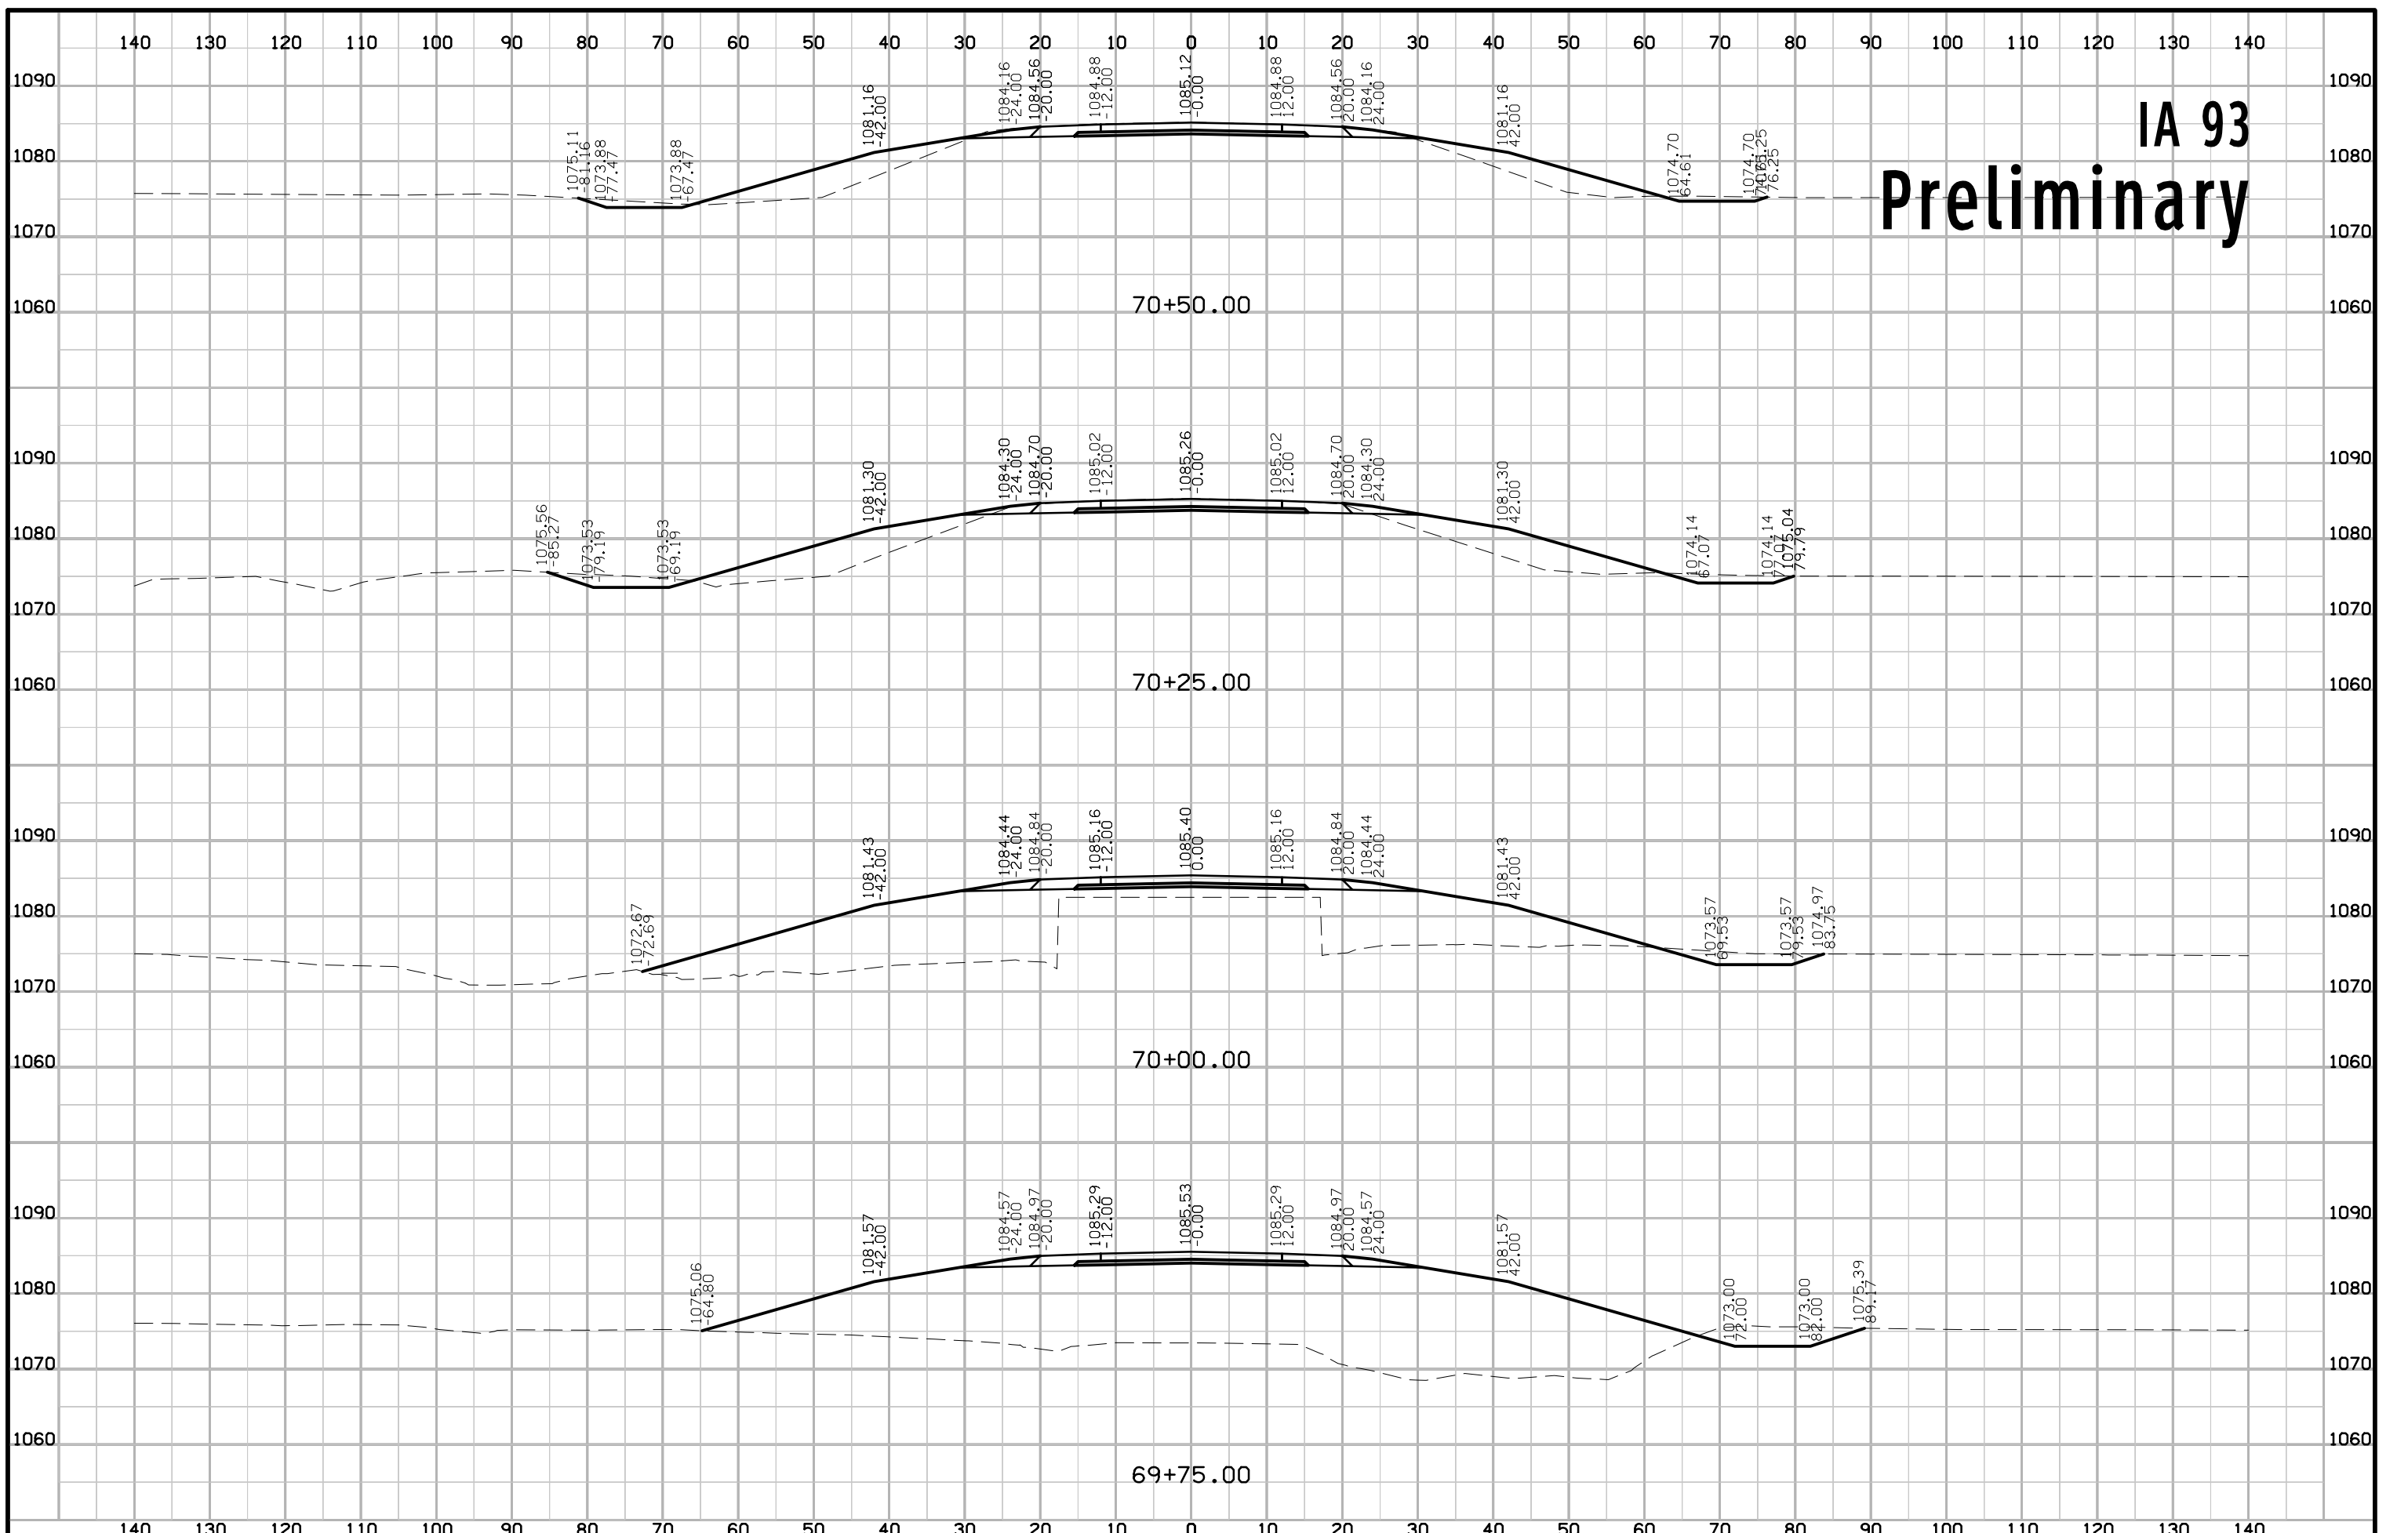

IA 93 Preliminary

