



**IA 92, Near MM 205.5, Station 160+60 (Eastbound)**

The letdown for a 36” concrete pipe at this location has separated/failed which is causing erosion of the foreslope. This erosion has encroached into the outside edge of the existing gravel shoulder. There is also erosion near the outlet of the existing flume beyond the existing fence line. The proposed repair is to replace the half-round letdown with a concrete flume/basin. Plans will be prepared by the Office of Design and the Office of Bridge for this location. Additional ROW via a TE may be required to repair the erosion that has occurred beyond the ROW. Field survey will be obtained by the District. Click [here](#) for pictures of the site. Link to relevant “as-built” plans: Click [here](#). The estimated cost of this repair is \$50,000.

**IA 92, Near MM 212.9, Station 516+50 to Station 518+10 (Eastbound)**

The slide is located on the foreslope and is approximately 160 feet long by 30 feet wide. A previous repair at the eastern limits of the slide was done by DOT Maintenance consisting of benching and rebuilding a portion of the foreslope with broken concrete. The current scarp is near the outside edge of the gravel shoulder. The proposed repair will consist of benching and rebuilding the foreslope with Class 10 embankment to the original design, installing bench drains and guardrail is anticipated. Additional ROW will not be required. Field survey will be obtained from Lidar. Click [here](#) for pictures of the site. Link to relevant “as-built” plans: Click [here](#). The estimated cost of this repair is \$25,000.

**CRASH DATA:**

Crash data was not reviewed for this project.

**RECOMMENDATIONS:**

The recommendation is to repair the slide repairs sites as described above. The total estimated cost of the project is \$ 225,000 with a 40% contingency that includes mobilization traffic control. Traffic will be maintained during construction. A temporary construction easement may be required for one location.



**FUNDS PROGRAMMED:**

This proposed project is not currently in the Five Year Program. It has been identified by the District 5 Office for construction in FY 2017 pending program approval. A schedule of events for plan development will be determined following approval of the Concept.

**PROJECT AGREEMENTS:**

No project agreements will be required for this project.

### LOCATION MAP

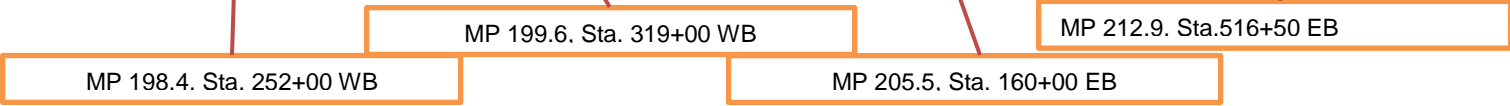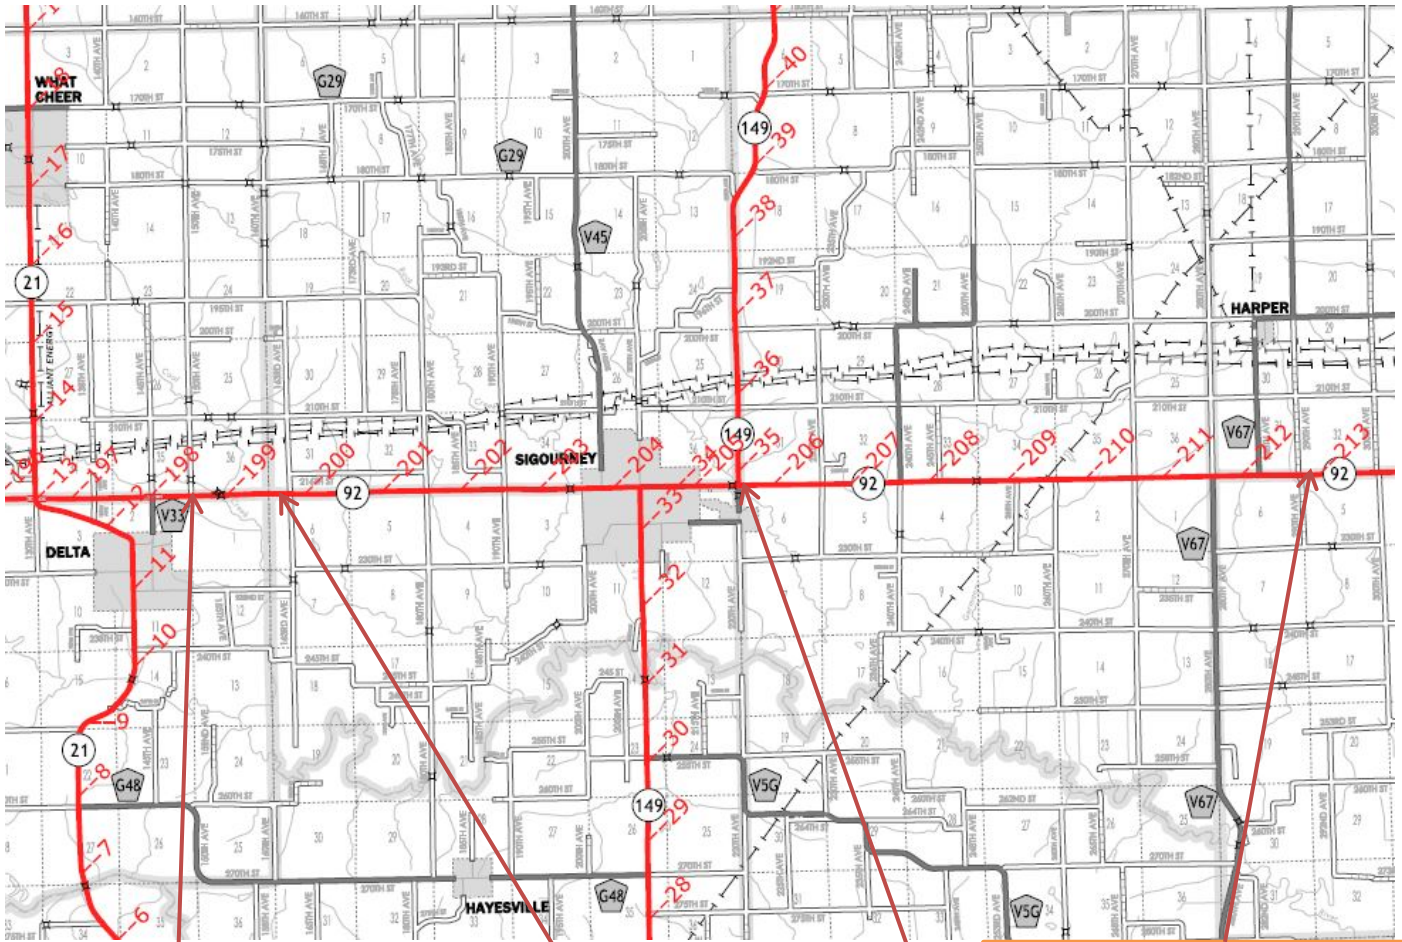

cc:

- |                 |                  |                  |
|-----------------|------------------|------------------|
| J. F. Adam      | J. R. Selmer     | M. J. Kennerly   |
| K. D. Nicholson | D. L. Maifield   | C. B. Brakke     |
| S. J. Megivern  | M. D. Masteller  | B. R. Smith      |
| F. W. Todey     | A. A. Welch      | N. M. Miller     |
| C. C. Poole     | N. L. McDonald   | G. A. Novey      |
| J. S. McClain   | M. A. Swenson    | P. C. Keen       |
| R. A. Younie    | S. P. Anderson   | Z. T. Bitting    |
| D. R. Tebben    | B. D. Hofer      | J. N. Garton     |
| A. Poole        | D. L. Newell     | B. E. Azeltine   |
| G. Mulder       | T. D. Hanson     | S. A. Schram     |
| S. J. Gent      | T. D. Crouch     | J.W. Laaser-Webb |
| W.A. Sorenson   | D. E. Sprengeler | E. C. Wright     |
| M. Van Dyke     | J. R. Webb       | J. Huddle        |
| J. D. Owen      | C. E. Belgarde   | J. R. Phillips   |
| B. M. Clancy    | T. Quam          | FHWA             |
| M. E. Ross      |                  |                  |

FIELD CHECK LEFT DITCH ELEVATION  
AND JACKING MAY BE ADJUSTED IN  
THE FIELD

719.47

APPROX 160+60

APPROX 160+70

730.04

731.1  
731.38


731.8

732.86

716.28

ROW

700.4

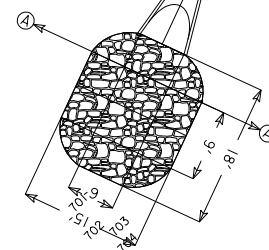

700.36

ROW

TEMP ROW 35' FROM ROW

TEMP ROW FOR JACKING



50' AHEAD AND BACK (100' TOTAL)  
FROM JACKING LOCATION



on 25° skew

719.47 EXTRAPULATED FROM ASBUILTS

719.47 EXTRAPULATED FROM ASBUILTS

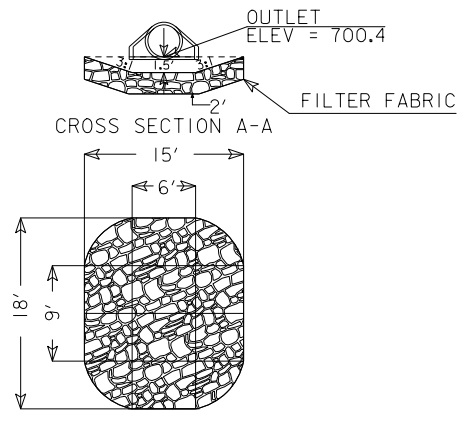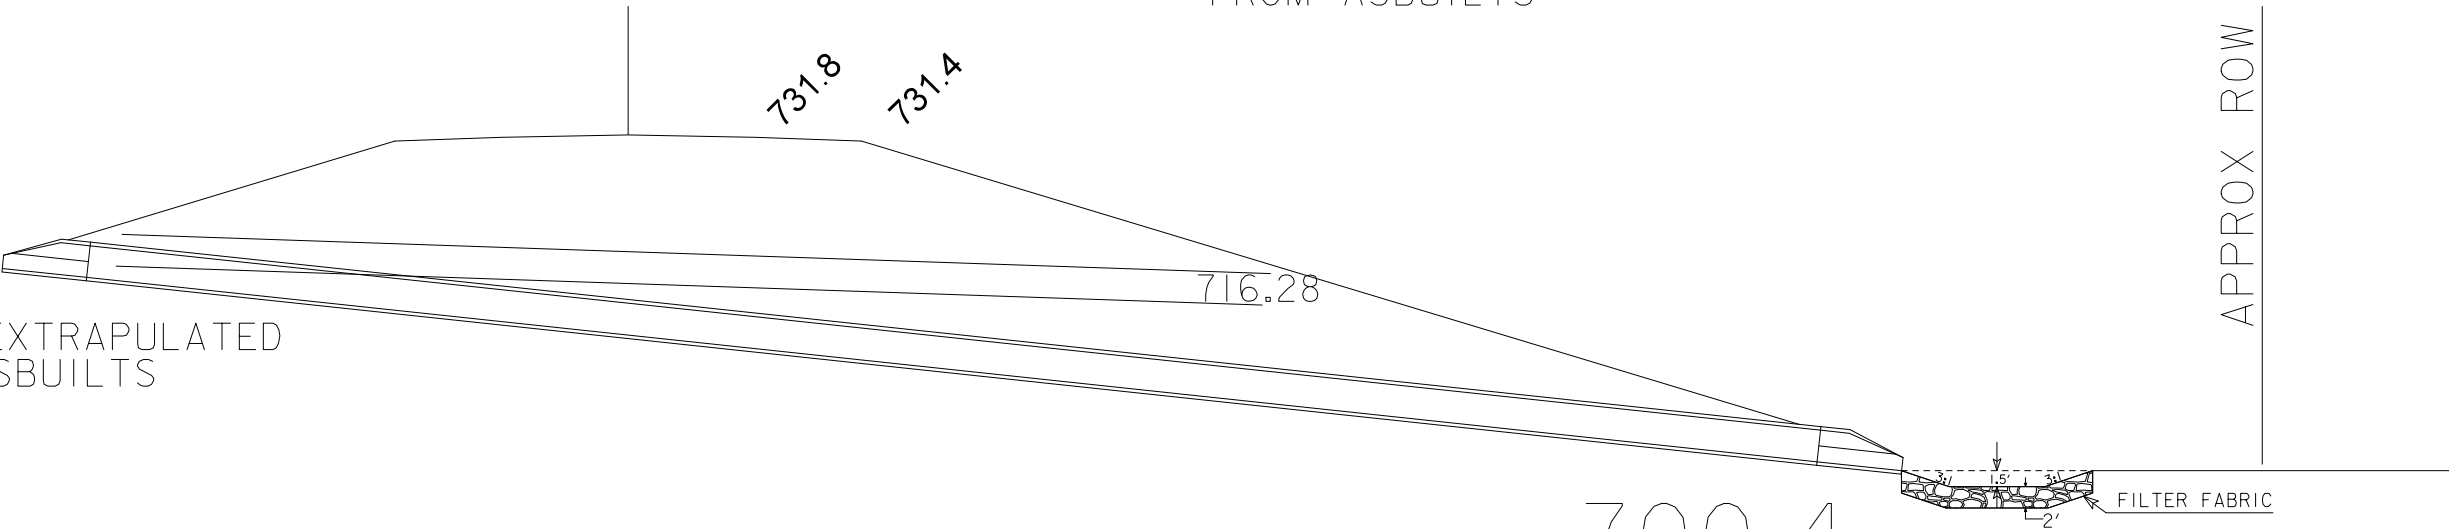

QUANTITIES  
32.4 TONS RIP RAP  
45 SQ YDS ENG FABRIC  
10 CUBIC YDS CLASS 10

STATE	FED. ROAD DIST. NO.	FISCAL YEAR	SHEET NO.	TOTAL SHEETS
IOWA	5		1	28
PROJECT NUMBER				
F-92-8(2)--20-54				
R.O.W. PROJECT NUMBER				
FN-92-8(2)--21-54				

# STATE OF IOWA STATE HIGHWAY COMMISSION

PLANS OF PROPOSED IMPROVEMENT  
ON THE


## PRIMARY ROAD SYSTEM KEOKUK COUNTY

### GRADING-P.C.C. PAVING AND A.C. RESURFACING P.C.C. PAVEMENT WIDENING GRADING (SHOULDERING) LIGHTING


ON IA. NO. 92 FROM THE EAST CORP. LINE OF THE TOWN OF SIGOURNEY EASTERLY  
TO 1/2 MILE WEST OF IA. NO. 159

SCALE: AS NOTED

THE IOWA STATE HIGHWAY COMMISSION STANDARD SPECIFICATIONS  
FOR CONSTRUCTION WORK, SERIES OF 1964 SHALL  
APPLY TO WORK ON THIS PROJECT

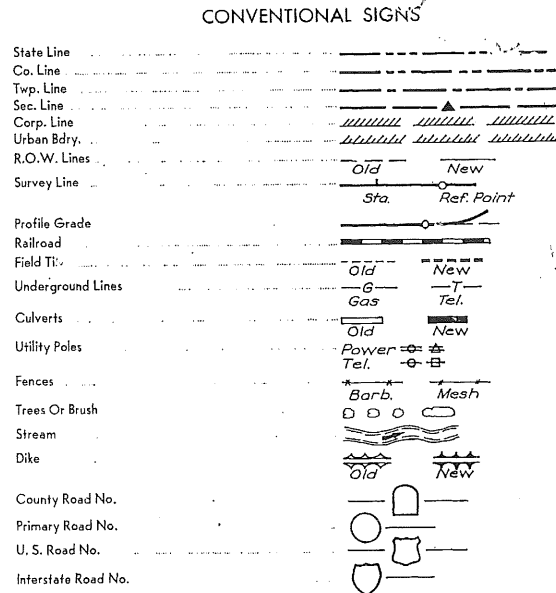

INDEX OF SHEETS	
NO.	DESCRIPTION
1	TITLE SHEET
1A	TABULATION OF REVISIONS
2-4	TYPICAL SECTIONS
5-7	ESTIMATE OF QUANTITIES AND GENERAL INFORMATION
8-19	PLAN AND PROFILE STA. 100+00 TO STA. 448+00
20-24	PLAN AND PROFILE SIDE ROADS
25, 26	REFERENCE INFORMATION AND BENCH MARKS
27, 28	STAKE-OUT OF INTERSECTION OF IA. NO. 92 AND IA. NO. 149
29A, 29B	JOINING DETAIL OF INTERSECTION OF IA. NO. 92 AND IA. NO. 149
30A, 30B	PAINTING DETAIL OF INTERSECTION OF IA. NO. 92 AND IA. NO. 149
31	HIGHWAY LIGHTING LAYOUT INTERSECTION OF IA. NO. 92 AND IA. NO. 149
32, 33	TABULATION AND DETAILS OF DRAINAGE STRUCTURES
34	TABULATION OF SUBGRADE TREATMENT
35-49	SOILS SHEETS
50-58	TABULATION OF QUANTITIES AND ADJUSTMENTS
59-89	STANDARD ROAD PLANS
90-95	STANDARD LIGHTING PLANS
96-280	CROSS SECTIONS

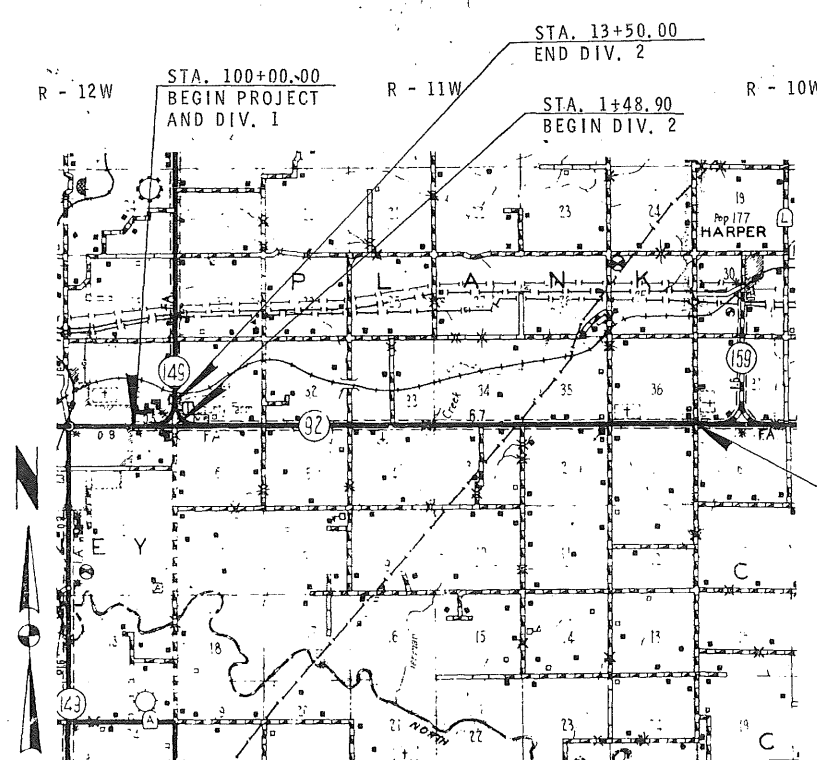

MILEAGE SUMMARY			105-1	STATE CONTROL SECTION NO.
DIV.	LOCATION	LIN. FT.	MILES	
1	IOWA NO. 92			54-0400
	STA. 100+00.00 TO STA. 448+00.00	34,800.00		
	DEDUCT BRIDGE STA. 122+25	132.54		
	DEDUCT BRIDGE STA. 287+60	130.83		
	NET LENGTH OF ROADWAY IN DIV. 1	34,536.63	6.541	
	NET LENGTH OF BRIDGES IN DIV. 1	263.37	0.050	
	TOTAL NET LENGTH OF DIV. 1	34,800.00	6.591	
2	IOWA NO. 149			54-1000
	STA. 1+48.90 TO STA. 13+50.00	1,201.10		
	NET LENGTH OF ROADWAY IN DIV. 2	1,201.10	0.227	
	NET LENGTH OF ROADWAY IN PROJECT	35,737.73	6.768	
	NET LENGTH OF BRIDGES IN PROJECT	263.37	0.050	
	TOTAL NET LENGTH OF PROJECT	36,001.10	6.818	

CONSTRUCTION PLANS SHOWING PROJECT AS BUILT  
ONE COPY PREPARED BY J.M. Debin DATE 4/2/70  
RESIDENT CONST. ENGINEER  
ONE COPY APPROVED & FORWARDED TO AMES  
James W. Edgerton DATE 6-1-70  
DISTRICT CONST. ENGINEER  
TWO COPIES TO BE MADE & RETURNED TO  
Virgil Butler DISTRICT ENGINEER  
Charles Holmes RESIDENT MAINTENANCE ENGINEER

DESIGN DATA RURAL  
196 7 AADT 1913 V.P.D.  
198 7 AADT 2363 V.P.D.  
198 7 DHV 257 V.P.H.  
DIRECTIONAL 53 %  
TRUCKS 10 %  
DESIGN V 60 M.P.H.  
PARTIAL ACCESS CONTROL

STANDARD ROAD PLANS					
NUMBER	DATE	NUMBER	DATE	NUMBER	DATE
RA-3	1-2-63	RF-1	7-1-64	RH-2	1-25-67
RA-12	6-21-66	RF-3	11-18-66	RH-7	4-23-69
RA-4	4-23-64	RF-4	4-2-65	RH-22	6-28-65
RA-1	11-28-66	RF-5	6-4-65	RH-7	9-1-66
RA-2	11-28-66	RF-7	4-2-65	RL-1	3-14-65
RA-17	12-7-64	RF-13	12-2-66	RL-3	11-18-61
RA-1	12-18-66	RF-14	12-1-66	RL-4	4-15-66
RA-2	3-11-66	RF-20	1-8-65	RA-1	1-20-67
RA-7	3-25-66	RF-22	4-3-65	RA-2A	1-27-67
RA-3	3-25-66	RF-23	4-15-66	RA-2B	1-27-67
RA-9	10-21-66	RF-3	3-1-62	RA-2A	1-27-67

STANDARD ROAD PLANS					
NUMBER	DATE	NUMBER	DATE	NUMBER	DATE
RA-11	1-28-67				
RA-12	9-21-65				



100 SHEETS

REVISED: SEE FOLLOWING SHEET 1-A

APPROVED: J.M. Debin 3/26/70  
DEPUTY CHIEF ENGINEER  
IOWA HIGHWAY COMMISSION DATE


DEPARTMENT OF COMMERCE  
BUREAU OF PUBLIC ROADS

APPROVED: \_\_\_\_\_  
DIVISION ENGINEER DATE

I HEREBY CERTIFY THAT THIS PLAN WAS PREPARED UNDER MY SUPERVISION AND THAT THE DESIGN, DETAILS AND CONSTRUCTION OF THE DESIGN WERE MADE BY ME OR BY OTHER FULLY LICENSED PROFESSIONAL ENGINEERS UNDER THE LAWS OF THE STATE OF IOWA.  
DATE March 17 1970 IOWA REG. NO. 4153

KEOKUK COUNTY GRADING-P.C.C. PAVING AND A.C. RESURFACING  
 P.C.C. PAVEMENT WIDENING GRADING (SHOULDERING) LIGHTING  
 LETTING DATE April 25, 1967  
 F-92-8(2)--20-54

2101  
5-28-65

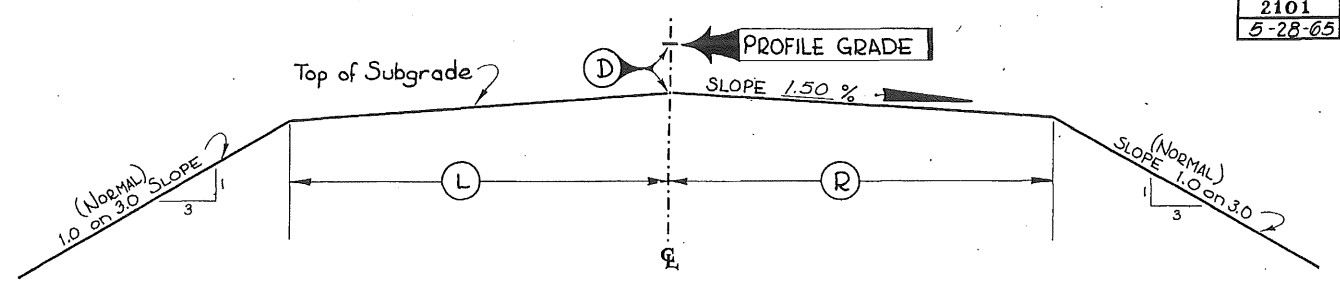

NOTE:  
Normal section shown may be modified appropriately in areas of superelevated curves or other locations specifically designated by the engineer.


**GRADING  
TYPICAL CROSS SECTION**

LOCATION		DIMENSIONS		
Station to Station		L	R	D
*108+00.0	300+00.0	23.5	23.5	9"
311+50.0	374+00.0	23.5	23.5	9"
387+50.0	406+00.0	23.5	23.5	9"
414+00.0	426+00.0	23.5	23.5	9"
442+00.0	448+00.0	23.5	23.5	9"
1+76.9	13+50.0	23.5	23.5	9"

See typical cross section for details of ditches and backslopes

\* Typical varies from 23.5' to 43.5'

2108  
5-28-65

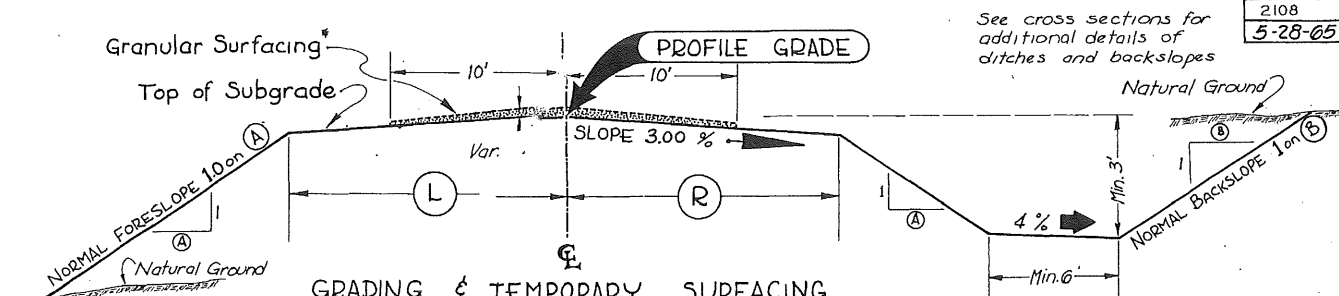


GRADING & TEMPORARY SURFACING  
TYPICAL CROSS SECTION

LOCATION AT STATION	DIMENSIONS		SLOPES	
	L	R	A	B
126+40.4 Rt.	14'	14'	2	2
183+12.9 Lt. & Rt.	14'	14'	2	2
235+91.1 Lt. & Rt.	14'	14'	2	2
262+75 Lt.	14'	14'	2	2
314+80.6 Rt.	14'	14'	2	2
340+56.8 Rt.	14'	14'	2	2
394+37.3 Lt.	14'	14'	2	2
394+42.2 Rt.	14'	14'	2	2
447+21.7 Rt.	14'	14'	2	2
447+23 Lt.	14'	14'	2	2

NOTE:  
Normal section shown may be modified appropriately in areas of superelevated curves or other locations specifically designated by the engineer.

4101

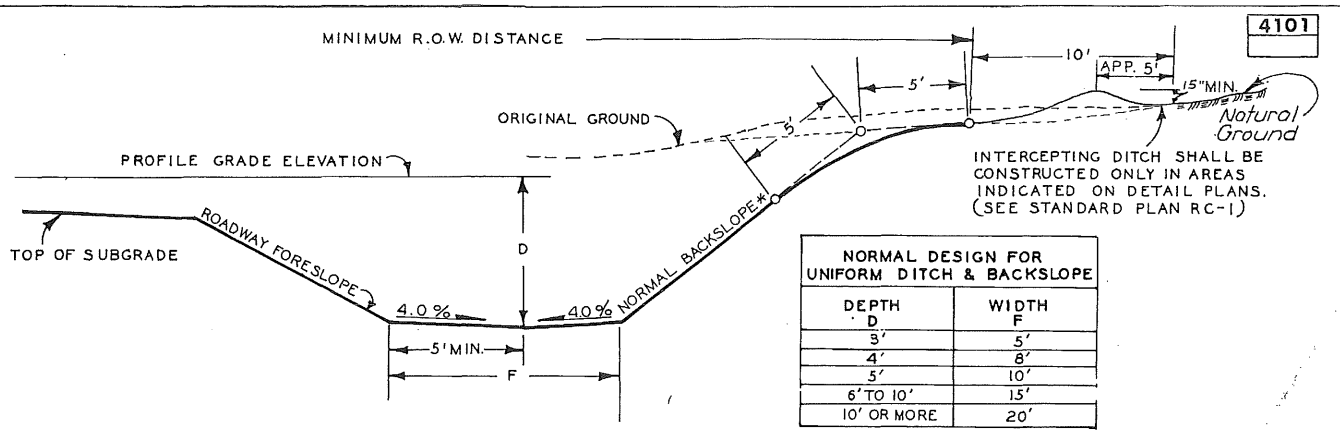


TYPICAL CROSS SECTION OF DITCHES & BACKSLOPES

**NORMAL DESIGN FOR UNIFORM DITCH & BACKSLOPE**

DEPTH D	WIDTH F
3'	5'
4'	8'
5'	10'
6' TO 10'	15'
10' OR MORE	20'


\* BACKSLOPE SHALL BE CONSTRUCTED ON A SLOPE OF 2.50 ON 1.00 EXCEPT WHERE INDICATED OTHERWISE ON DETAIL PROJECT PLANS.

2105  
5-19-66

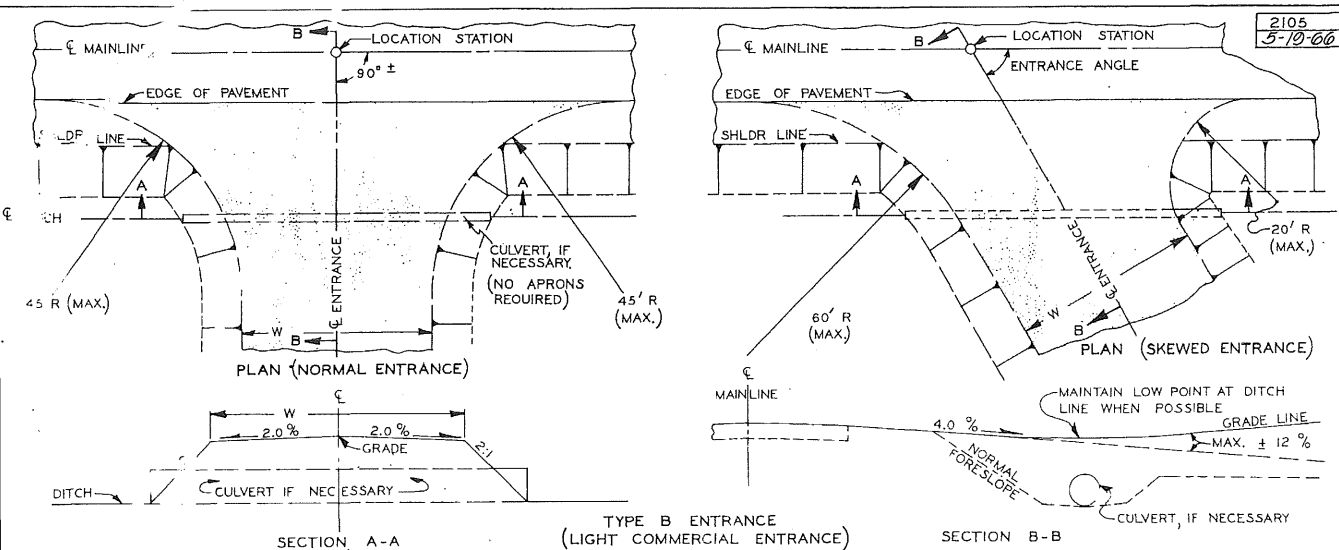

SECTION A-A TYPE B ENTRANCE (LIGHT COMMERCIAL ENTRANCE) SECTION B-B


2405

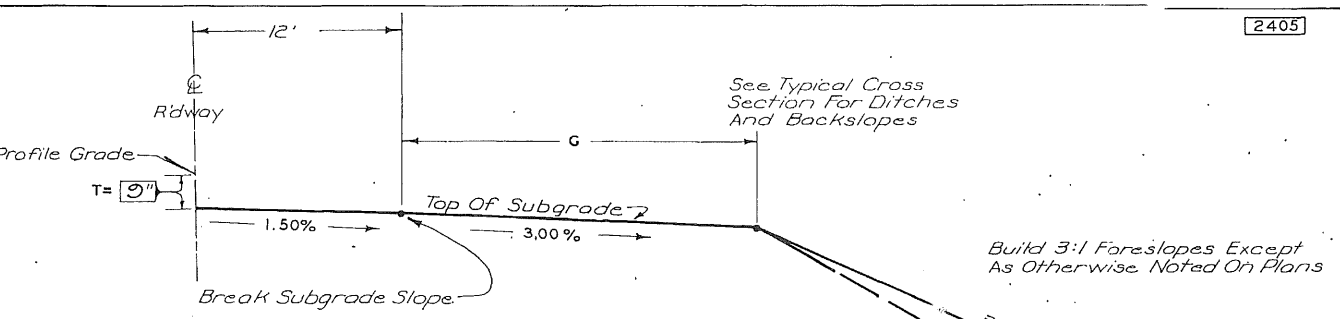

GRADING  
TYPICAL HALF SECTION  
PROPOSED CLIMBING LANE  
(SIMILAR FOR LEFT OR RIGHT LANE)






STA	TO STA.	SIDE	G
160+50	133+75	Rt.	18.2
236+50	254+50	Rt.	18.2
240+00	262+00	Lt.	18.2
311+50	333+00	Rt.	18.2

2106  
5-19-66


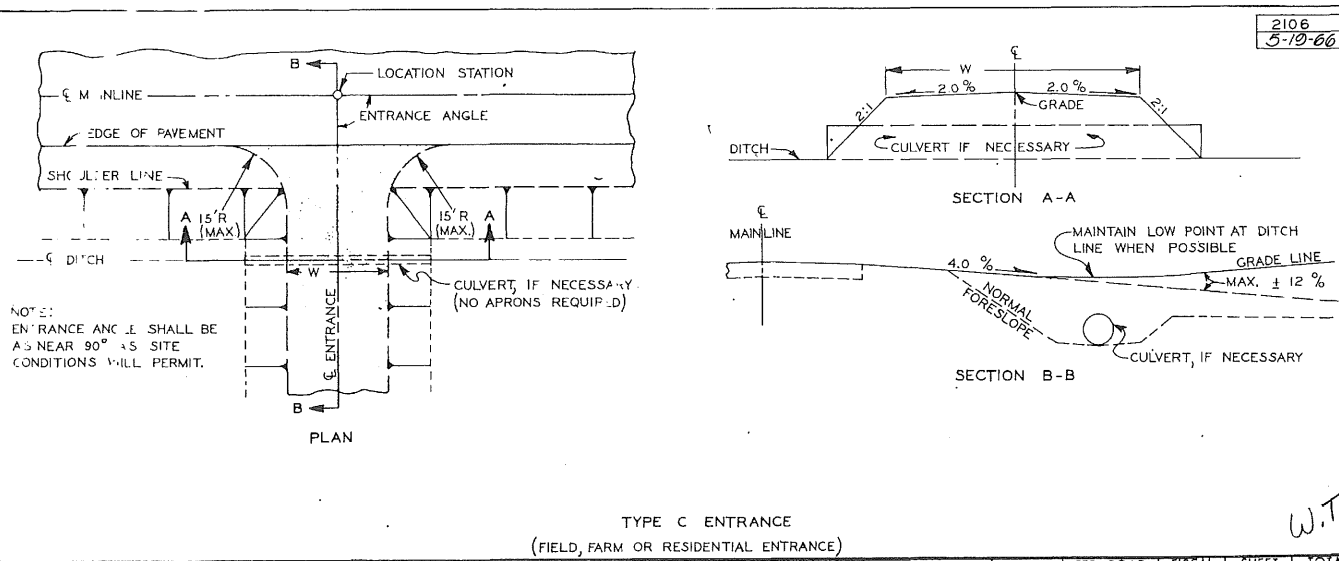


SECTION A-A TYPE C ENTRANCE (FIELD, FARM OR RESIDENTIAL ENTRANCE) SECTION B-B

W.T.

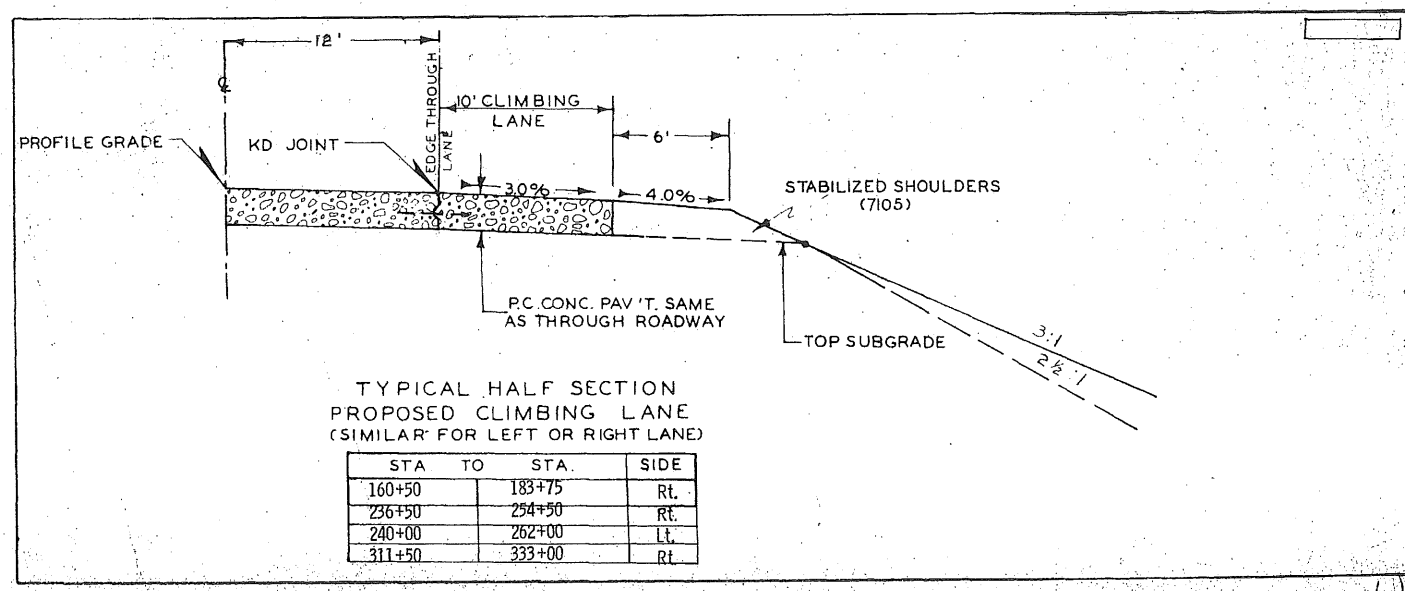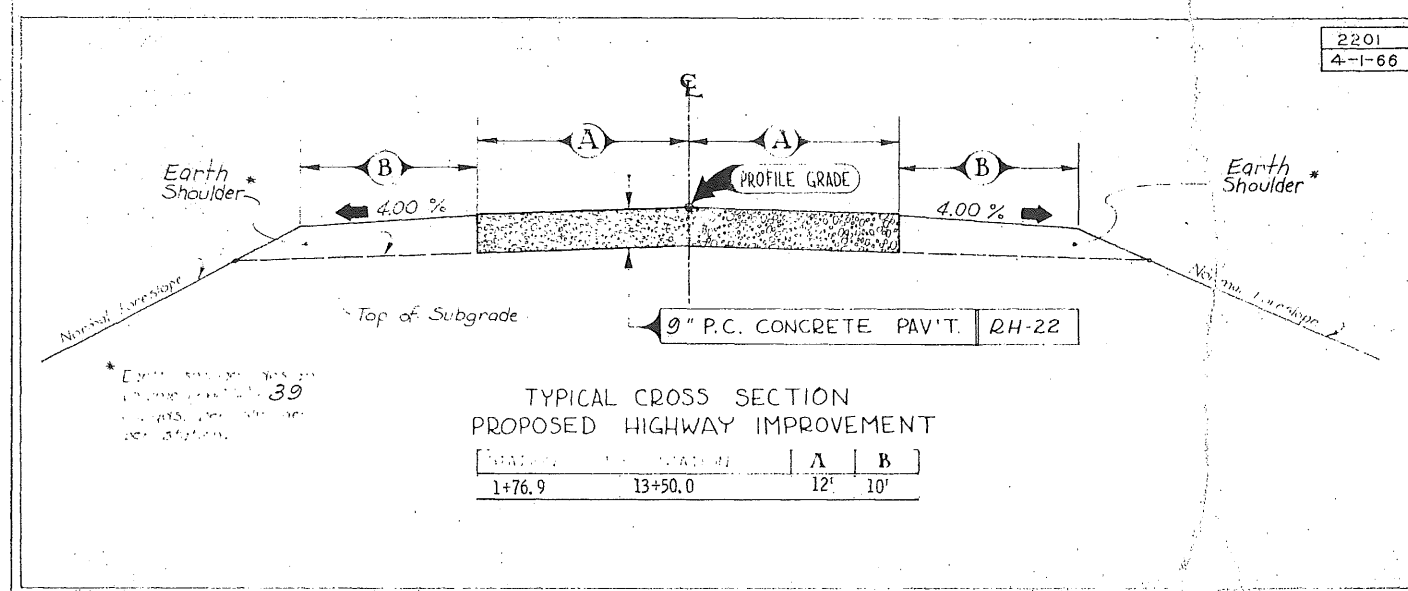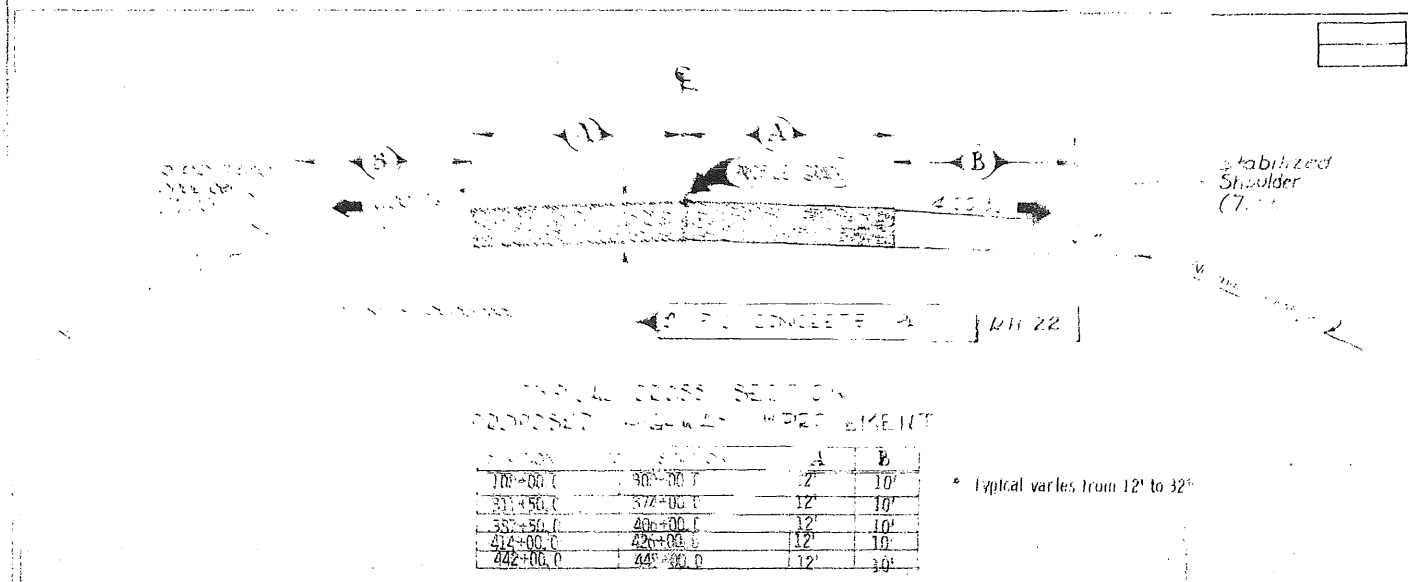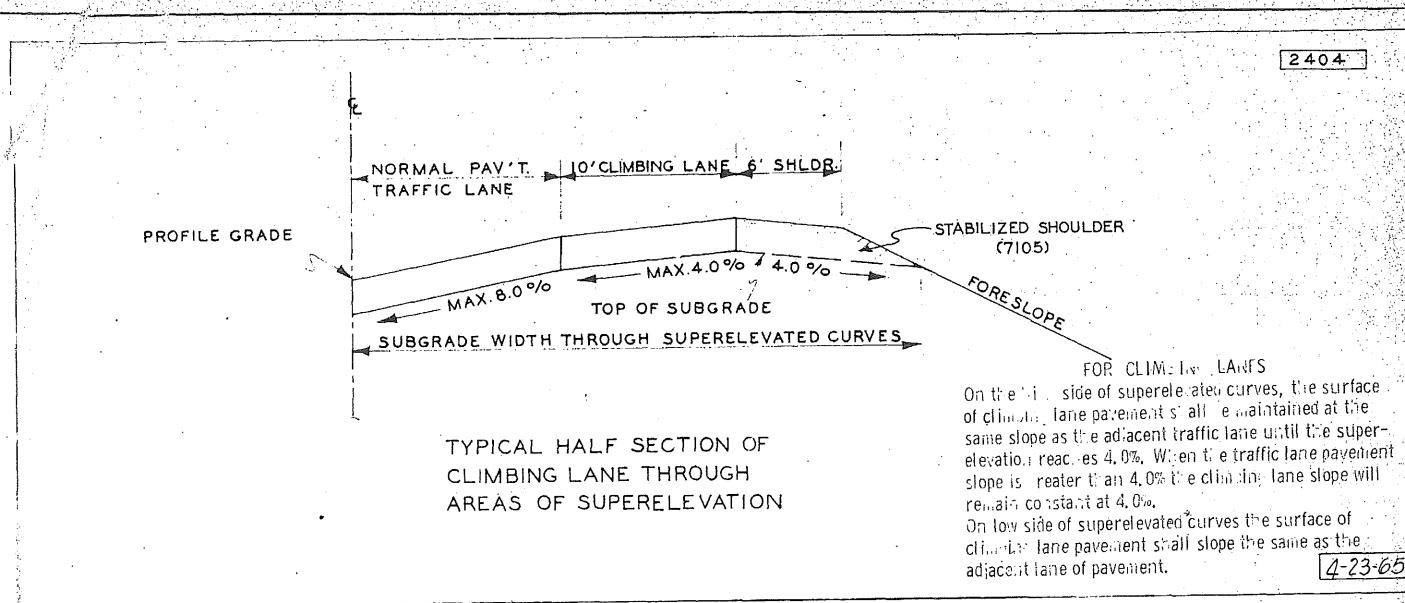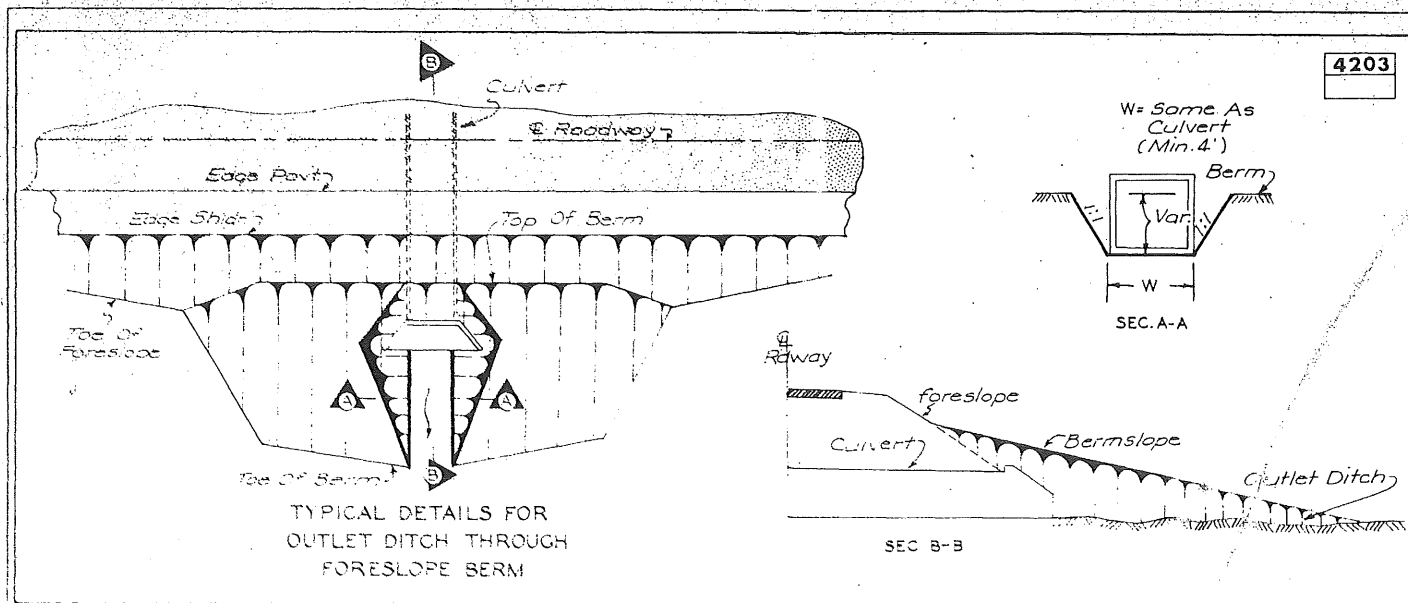


FED. ROAD DIST. NO.	STATE	FEDERAL PROJ. NO.	FISCAL YEAR	SHEET NO.	TOTAL SHEETS
				10	280

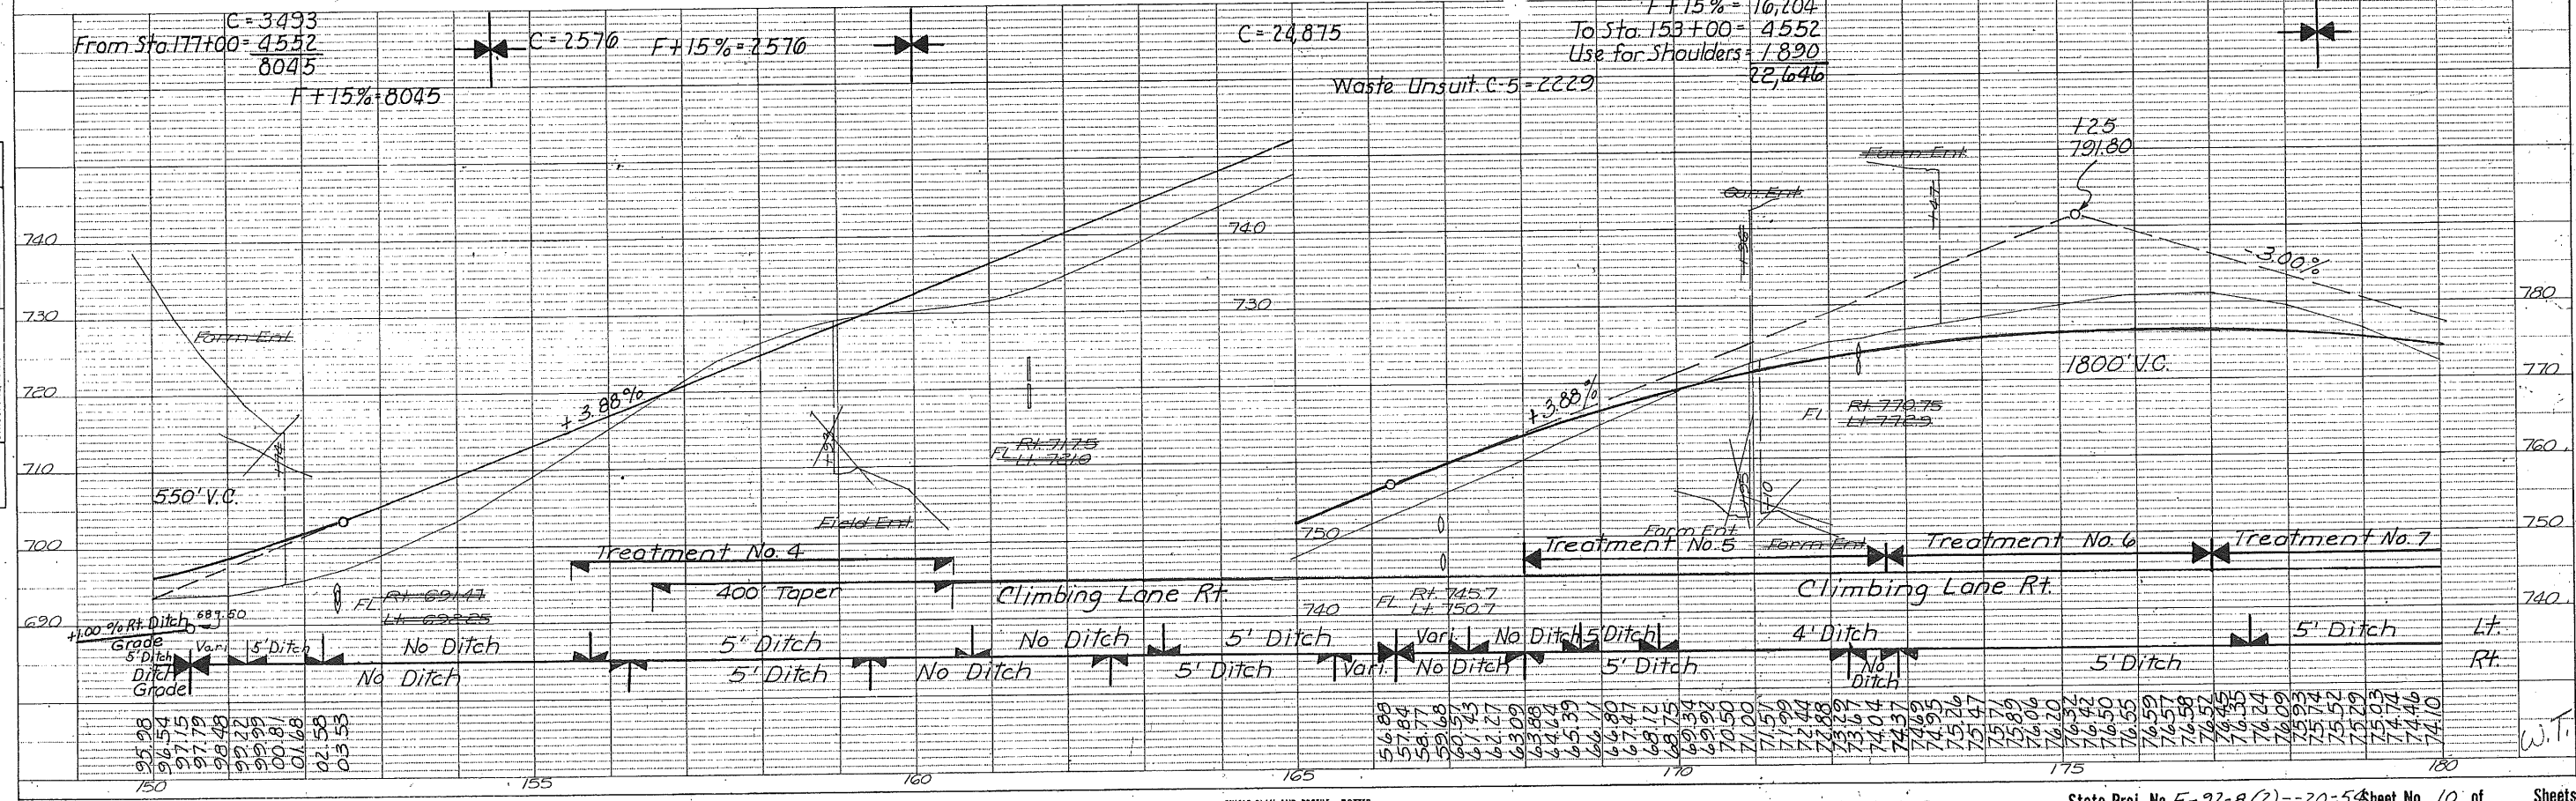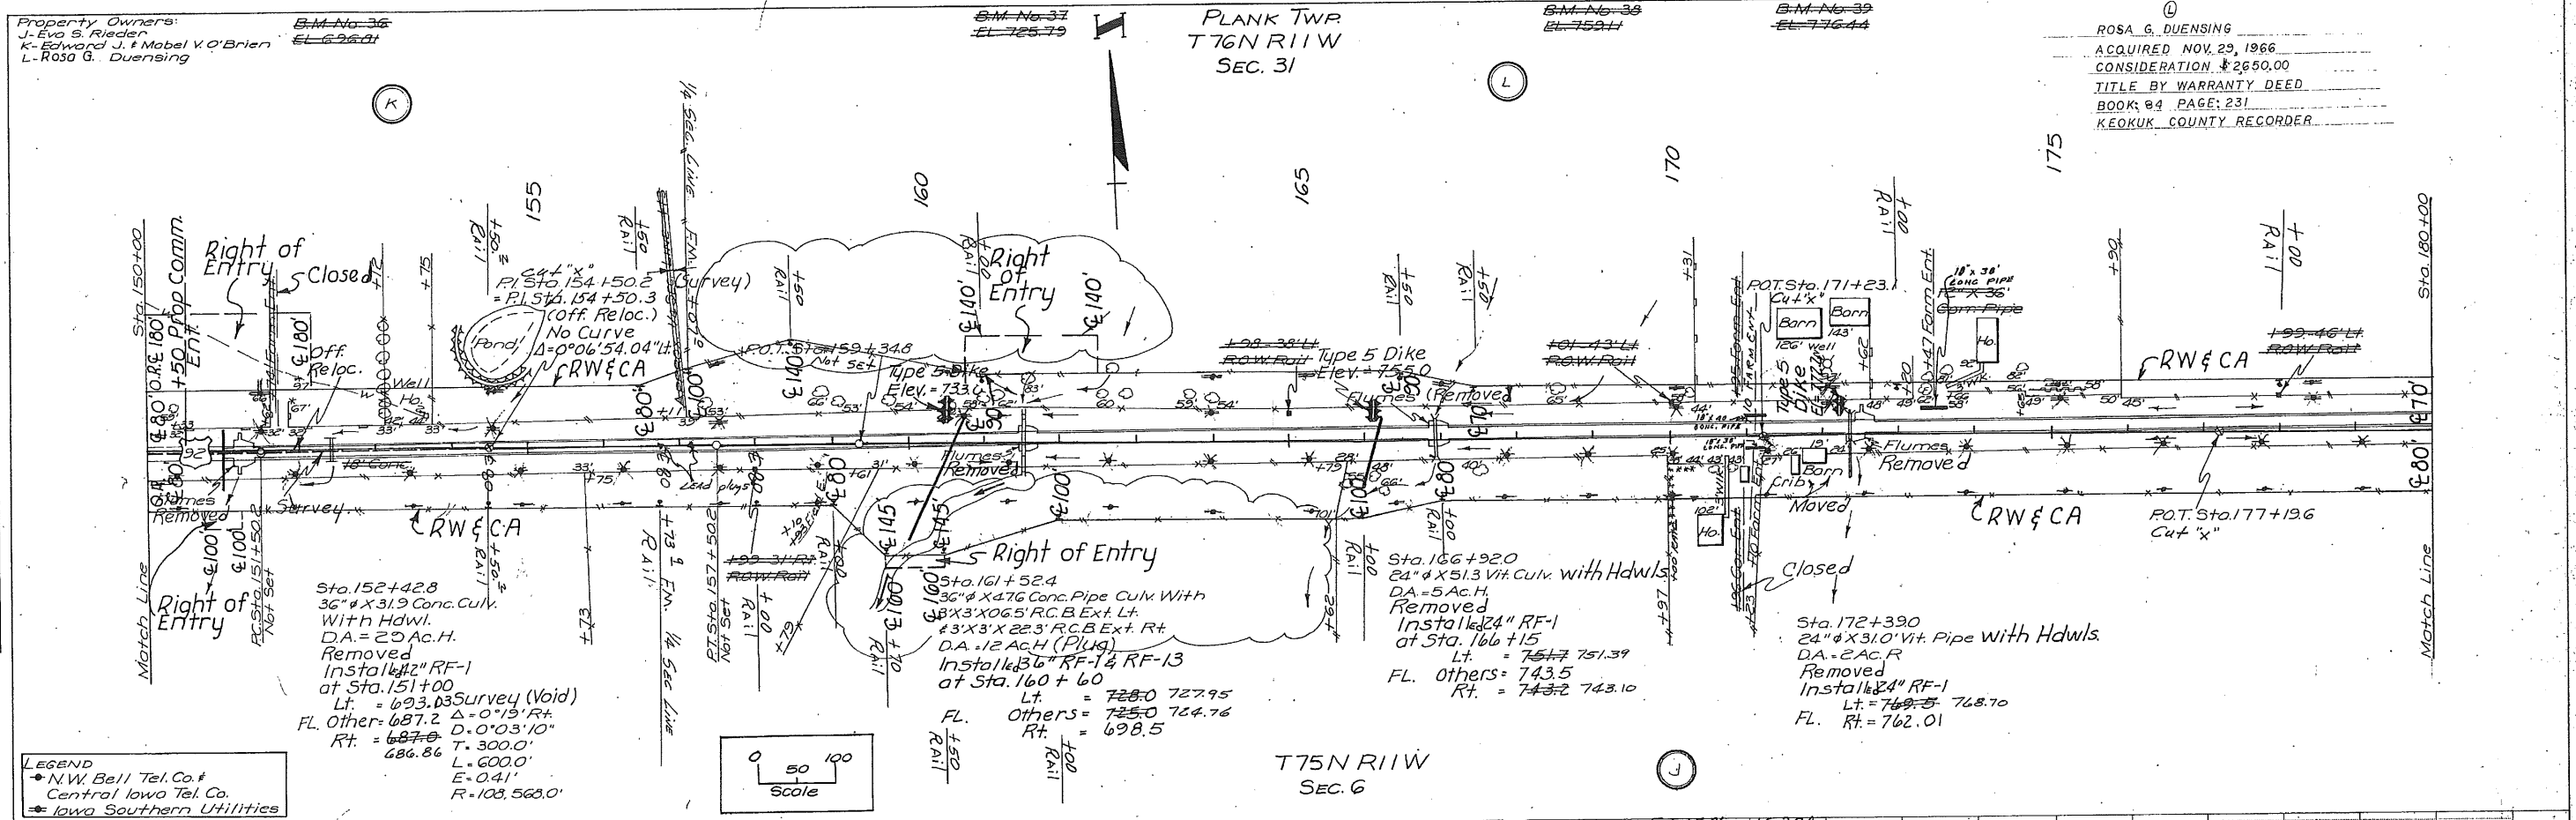


PLAN	DATE
SURVEYED	
ALIGNED	
CHECKED	
RT. OF WAY CHECKED	
NO. 1	

PROFILE	DATE
SURVEYED	
PLOTTED	
CHECKED	
NO. 1	

LEGEND  
 • N.W. Bell Tel. Co.  
 Central Iowa Tel. Co.  
 Iowa Southern Utilities

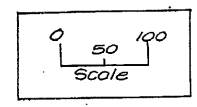



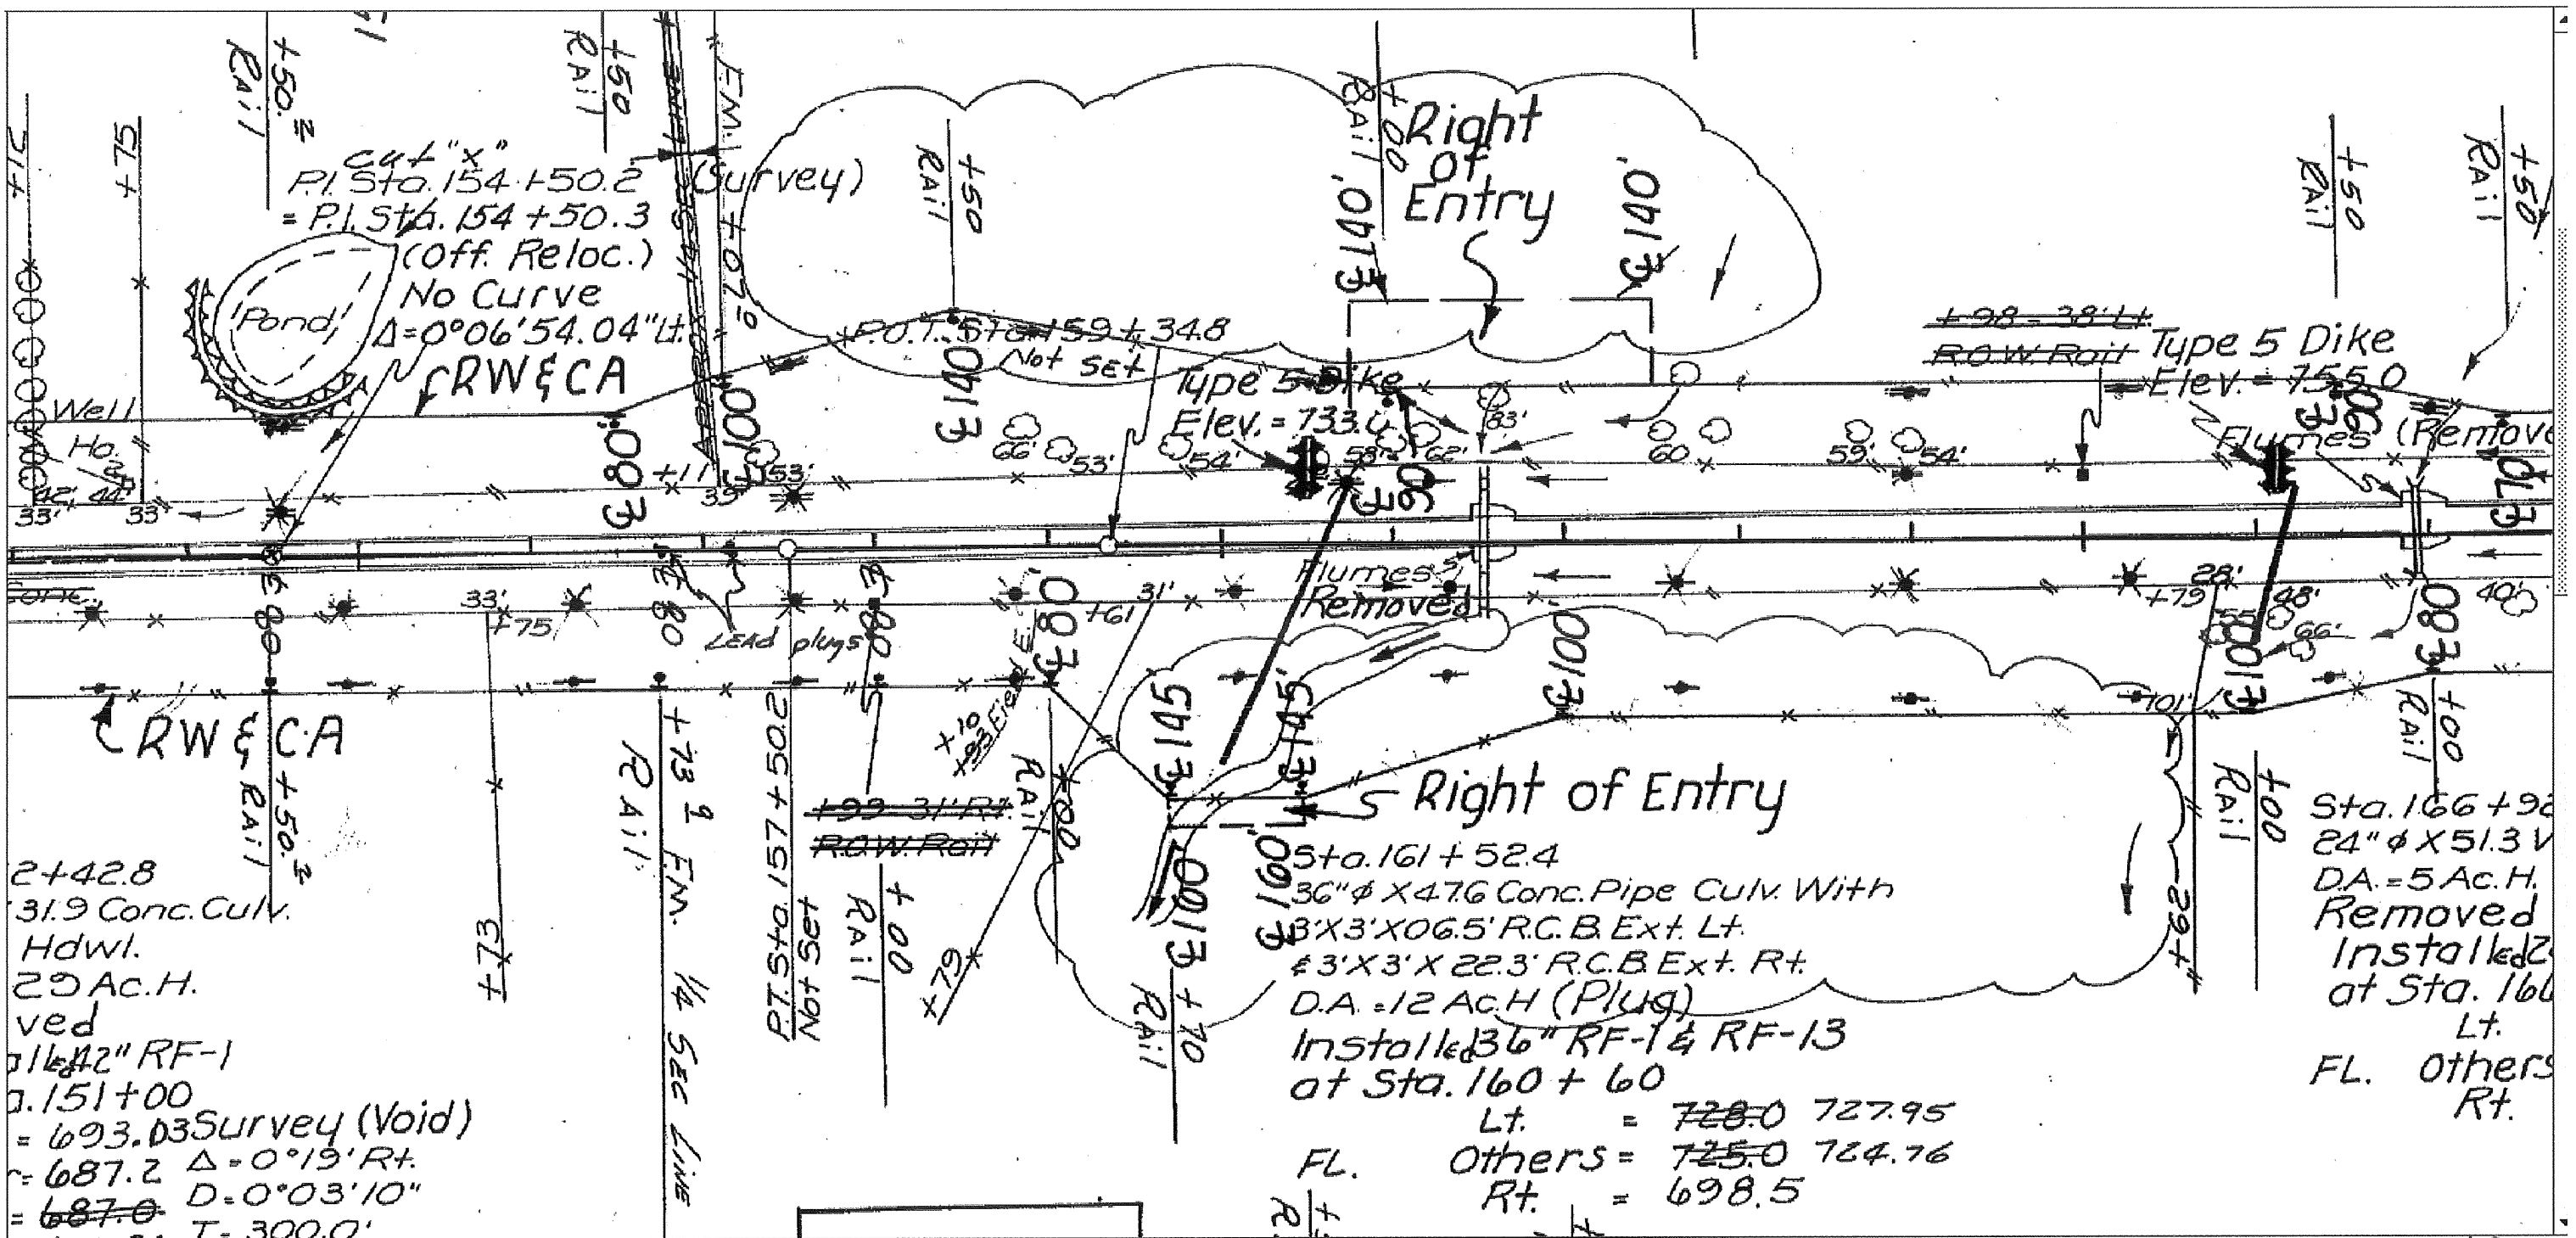

cut "x"  
 P.I. Sta. 154+50.2  
 = P.I. Sta. 154+50.3  
 (Off. Reloc.)  
 No Curve  
 $\Delta = 0^\circ 06' 54.04''$  Lt.  
 RW&CA

Right of Entry

198-38' Lt.  
 ROW RAIL Type 5 Dike  
 Elev. = 755.0

Type 5 Dike  
 Elev. = 733.0

Flumes (Removed)

Flumes Removed

Right of Entry

Sta. 161+52.4  
 36"  $\phi$  X 47.6 Conc. Pipe Culv. With  
 3' X 3' X 06.5' R.C.B. Ext. Lt.  
 3' X 3' X 22.3' R.C.B. Ext. Rt.  
 D.A. = 12 Ac.H. (Plug)  
 Installed 36" RF-1 & RF-13  
 at Sta. 160+60

Sta. 166+92  
 24"  $\phi$  X 51.3 V  
 D.A. = 5 Ac.H.  
 Removed  
 Installed  
 at Sta. 160  
 Lt.  
 FL. Others  
 Rt.

Lt. = ~~728.0~~ 727.95  
 FL. Others = ~~725.0~~ 724.76  
 Rt. = 698.5

2+42.8  
 31.9 Conc. Culv.  
 Hdwl.  
 29 Ac.H.  
 ved  
 1642" RF-1  
 a. 151+00  
 = 693.03 Survey (Void)  
 $\Delta = 0^\circ 19' Rt.$   
 $\Delta = 0^\circ 03' 10''$   
 T = 300.0'

73' 2' F.M. 1/4 SEC LINE  
 RAIL

PT. STA. 157+05  
 Not Set  
 RAIL

RAIL

RAIL

RAIL

Well  
 Ho.  
 33'



Lead plugs

PT. STA. 157+05  
 Not Set  
 RAIL

RAIL

DRAINAGE STRUCTURES BY ROAD CONTRACTOR																				104-3
TYPE	LOCATION	D SIZE	LENGTH L.F.	KIND	SKEW AHEAD		APR. NO.	DIMENSIONS		FLOW LINE ELEV.		CL. 20 EXCAV. CU. YDS.	DIKE		REMARKS					
					LT.	RT.		LT.	RT.	OTHER	OTHER		LOCATION	TOP EL.						
1301	100+06.5	15"	8'	RF-1	-	-	1	30'	-	717.87	717.70	5			L=8' Requires 1 RA-3 Intake					
1301	100+06.5	15"	8'	RF-1	-	-	1	30'	-	717.73	717.88	6			R=8' Requires 1 RA-3 Intake					
1502	121+20 - 66' LT.	24"	45'	CMP	-	-	1	-	-	678.86	674.43	52	20	121+40 RT.	683.0	Requires 1 - Type "A" Diaphragm				
1502	121+48 - 135' LT.	24"	47'	CMP	-	-	1	-	-	678.2	674.68	52	20	121+70 LT.	683.5	Requires 1 - Type "A" Diaphragm				
1502	123+40 - 140' LT.	30"	44'	CMP	-	-	1	-	-	674.33	678.90	14	20	123+20 LT.	683.0±	Requires 1 - Type "A" Diaphragm 10' From Inlet. No Outlet Structure				
1201	143+80	42"	62'	RF-1	-	-	2	33'	45'	686.89	682.50	115		137+50 LT. PARK RT. FIELD EN.		Includes 1 - "D" Section. F=50' Removed Present Structure				
1201	151+00	42"	64'	RF-1	-	-	2	33'	46.5'	693.03	687.86	104		143+50 RT. FIELD EN.		Includes 1 - "D" Section F=36' Removed Present Structure. Rd. Contr. Ditch Outlet				
1503	160+60	36"	94'	RF-1	25°	-	1	42'	139.7'	727.95	698.5	130	5	160+50 LT.	733.0	Requires 1 - 16° RF-13 Elbow & 17 Connected Pipe Joints. Rd. Contr. Fill Inlet Dw. El. 728.0. Plug & Present Structure.				
1201	166+15	24"	88'	RF-1	15°	-	2	35.5'	64'	751.37	743.10	87	5	166+10 LT.	755.0	Includes 1 - "D" Section F=40' Removed Present Structure. Rd. Contr. Ditch Outlet				
1101	172+39	24"	74'	RF-1	-	-	2	31'	57'	768.70	762.01	111	5	172+25 LT.	772.2	Removed Present Structure. Rd. Contr. Ditch Outlet				
1503	183+75	24"	74'	RF-1	-	-	1	64.5'	38'	750.5	761.74	72	5	184+00 RT.	764.5	Plug Present Structure. Requires 1-17° Elbow & 7 Connected Pipe Joints.				
1101	188+03	24"	64'	RF-1	-	-	2	43'	33'	745.16	747.97	73	5	188+30 RT.	751.5	Removed Present Structure. Rd. Contr. Ditch Outlet				
1101	204+12	24"	78'	RF-1	-	-	2	36'	54'	732.22	732.80	41		203+80 LT.	FIELD EN.	Removed Present Structure				
1201	262+00	30"	88'	RF-1	15°	-	2	63.0'	36.5'	708.30	717.25	69	5	262+10 RT.	720.5	Includes 1 - "D" Section F=36' Removed Present Structure				
1101	393+00	24"	46'	RF-1	10°	-	2	30'	28'	776.63	777.30	17	2	393+00 RT.	780.0					
1102	394+03 - 41' LT.	24"	45'	CMP	-	-	2	-	-	774.82	759.63	20				Requires 2-45° Elbows Sta. 394+23-22' LT. El. 773.5 Sta. 398+47 - 22' LT. El. 760.0; One 18° on 24" Tee Q Tee Sta. 394+57, 22' LT. Removed Present Structure				
1502	394+57 - 70' LT.	18"	40'	CMP	-	-	1	-	-	774.67	772.7	6				Connect to Tee at Sta. 394+57, 22' LT.				
1503	402+00 - 60' RT.	36"	42'	RF-1	75°	-	1	E 22'	W 49.2'	751.24	737.1	46		402+00 RT.	FIELD EN.	Requires 1 - 24° RF-13 Elbow & 7 Connected Pipe Joints				
1101	433+62	24"	58'	RF-1	-	-	2	32'	38'	787.90	786.27	61				Removed Present Structure				
1101	442+54	24"	56'	RF-1	-	-	2	32'	36'	785.92	784.62	62	5	443+88 LT.	789.5	Removed Present Structure				
1601	1182+50	24"	40'	UNCL.	-	-	2	19'	21'	784.30	782.60	26				Removed Present Structure				
1503	1184+50	24"	50'	RF-1	-	-	1	25'	41.2'	757.70	748.8	28	5	1185+00 LT.	760.0	Requires 1-25° RF-13 Elbow & 5 Connected Pipe Joints				
1503	1233+80	30"	58'	RF-1	-	-	1	66.7'	29'	718.4	738.0	57				Requires 1-25° RF-13 Elbow & 8 Connected Pipe Joints. Removed Present Structure				
1601	1236+65	24"	42'	UNCL.	-	-	2	19'	23'	742.0	740.7	25	5	235+25 LT.	744.5	Removed Present Structure				
1601	1264+00	36"	54'	UNCL.	-	30°	2	25'	29'	708.17	706.00	84				Removed Present Structure				
1601	1448+00	24"	54'	UNCL.	-	-	2	27'	27'	779.0	778.30	33				Removed Present Structure				

DRAINAGE STRUCTURES BY CULVERT CONTRACTOR																		104-4
DESIGN NO.	LOCATION	SIZE	LENGTH	L.F.	KIND	SKEW AHEAD		APR. NO.	DIMENSION		FLOW LINE		BY ROAD CONTRACTOR		DIKE	TOP ELEV.	REMARKS	
						LT.	RT.		LT.	RT.	OTHER	COMP OF B.F.	LOCATION					
2565	197+80	6' x 6'	93'	93'	RCB	-	-	-	45'	48'	716.73	715.80	708.8	82			Flume Outlet. Rd. Contr. Break in Top and Fill Present Structure. Road Contr. to Ditch Inlet	
2665	210+18.5	30"	50'	50'	RF-1	-	-	2	45.4'	71.1	742.15	733.13	-	210+60 LT.	FARM BN		Extensions = 10' Lt. & 52' Rt	
2765	225+10	10' x 10'	114'	114'	R. C. B.	-	-	-	56'	58'	690.62	687.80	169				Rd. Contr. Shape Inlet and Outlet	
2865	236+21.6	3' x 3'	43'	43'	R. C. B.	46°	-	-	53.9'	103.2'	740.55	729.29	717.0	19			Extension = 24' Lt. & 19' Rt. Rd. Contr. Fill Draw El. 740.5	
2965	318+68.6	30"	82'	82'	RF-1	-	-	2	85.2'	60.4'	750.25	761.50	-				Flume Outlet Extensions = 64' Lt. & 30' Rt	
3065	323+65.2	30"	88'	88'	RF-1	-	-	2	76.8'	60.5'	759.73	765.80	-	327+35 RT.	FARM BN		Rd. Contr. Ditch Outlet Extensions = 76' Lt. & 24' Rt. Rd. Contractor Ditch Outlet	
3165	339+17	4' x 4'	143'	143'	RCB	-	-	-	59'	84'	730.07	720.22	712.0	85			Culv. Contr. Outlet Tile Into RCB Build Drop Inlet	
3265	351+93.9	2' x 2'	49'	49'	RCB	-	-	-	33.5'	61.5'	764.13	753.95	15	5	351+50 LT.	768.5	Culv. Contr. Outlet Tile Into RCB	
3365	368+10	48"	124'	124'	RF-1	15°	-	1	67'	65'	761.89	764.83	753.0	-			Stub Flume Outlet. Rd. Contr. Fill Draw to Elev. 769.0±	
3465	401+00	10' x 8'	63'	63'	RCB	15°	-	-	29'	34'	746.50	745.37	737.0	68			Flume Outlet. Rd. Contr. Ditch Outlet	
2465	2+45.9	30"	20'	20'	RF-1	-	-	1	61.1'	43'	684.0	685.20	678.8	-			Ext. = 27.1' Lt. & 10' Rt.	
		30"	12'	12'	RF-13	-	-	-	-	-	-	-	-	-				

LISTING OF SUBDRAIN WORK															104-6			
INTAKES			SUBDRAIN										BACKFILL	TRENCH DRAIN	Note			
Location Station	Type	No. FL. Elev.	Line No.	Location Station	Type	Size	Corr.	Corr.	Corr.	RF-5	RF-22	Size	Std.	E. Q.	RF-5	Porous	Drain	Lin. Ft.
						Outlet	Perf.	Perf.	Perf.	Perf.	Perf.	Outlet				Cu. Yds.	Cu. Yds.	
			1	109+80±	C	6"	2'					1						
			2	122+40 to 123+75	C	6"	70"						6"	65"				
			3	274+10± to 275+80±	G	6"	34'						4"	150"				
			4	357+70±	C	6"	8'											
			5	376+70±	C	6"	4'											
			6	391+60±	C	6"	16'											
			7	392+50±	C	6"	12'											
			8	408+60±	C	6"	30'											
			9	3+10±	C	8"	22'											
				16+10	C	6"	16'											
				195+90±	C	6"	6'											
				204+50±	C	6"	4'											
				276+14	C	6"	20'											
				277+25	C	6"	20'											
				279+12	C	6"	20'											
				280+12	C	6"	20'											
				281+00	C	6"	20'											
				281+50	C	6"	20'											
				287+92±	C	6"	20'											
				146+85	C	6"	18'											
				147+43	C	6"	12'											
				198+50	C	8"	8'											
				1467+60	C	8"	6'											
				408±	C	8"	18'											

W.T.  
32 280

### CONVENTIONAL SIGNS

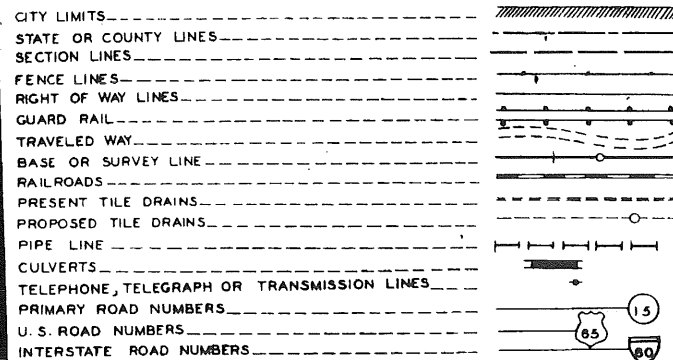

## STATE OF IOWA STATE HIGHWAY COMMISSION

### PLAN & PROFILE OF PROPOSED IMPROVEMENT ON THE PRIMARY ROAD SYSTEM KEOKUK COUNTY

GRADING SHOULDERING - P.C.C. PAVING & P.C.C. PAVT. WIDE. PROJECT NO. F 34 (5)

ON U. S. 92 FROM THE MAHASKA CO. LINE EAST TO S'IGOURNEY

SCALES } PLAN 1 INCH=100 FT.  
          } PROFILE HOR. 1 INCH=100 FT., VERT. 1 INCH=10 FT.

THE IOWA STATE HIGHWAY COMMISSION STANDARD SPECIFICATIONS FOR CONSTRUCTION WORK, SERIES OF 1960, SHALL APPLY TO WORK ON THIS PROJECT

THE 1964 SPECIFICATIONS SHALL APPLY TO ALL WORK ON THIS PROJECT LET ON OR AFTER NOV. 3, 1964


FED. ROAD DIST. NO.	STATE	PROJ. NO.	SHEET NO.	TOTAL SHEETS
5	IOWA	F 34(5)	1A	345

INDEX OF SHEETS  
SEE SHEET NO. 1B

CONSTRUCTION PLAN SHOWING PROJECT AS BUILT  
ONE COPY PREPARED BY J.M. Orbin DATE Feb 1, 1968  
ONE COPY APPROVED & FORWARDED TO AMES  
Jamie v. Edgerton DATE 2-2-68  
DISTRICT ENGINEER *const.*  
TWO COPIES TO BE MADE & RETURNED TO  
Virgil Butler, DISTRICT ENGINEER  
Floyd Sheets, RESIDENT MAINTENANCE ENGINEER

STANDARD ROAD PLANS					
NUMBER	DATE	NUMBER	DATE	NUMBER	DATE
RL-1	8-16-61	RA-7	5-1-63	RC-1	10-1-64
RL-2	3-19-62	RA-16	4-1-63	RC-2	1-5-64
RL-3	11-1-63	RA-1	12-2-63		
RL-4	10-9-63	RA-1	4-9-64	RD-2	
RE-1	2-7-60	EH-2	2-5-61		
RE-3	12-18-61	EH-7	2-5-61		
RE-4	2-7-61	EH-13	11-26-61		
RE-5	12-30-61	PK-2	2-2-61		
RE-7	3-22-63	RL-3	3-1-62		
RE-12	4-18-63	RE-2	1-10-61		
RE-16	4-18-63	RE-1	11-16-60		

MILEAGE SUMMARY			
105-1			
DIV.	LOCATION	LIN. FT.	MILES
1	(RURAL:)		
	STA. 0+00.00 TO STA. 526+95.40	52,695.40	
	BRIDGE STA. 282+45.00	182.83	
	EQUATION: STA. 292+06.17 = STA. 292+06.10 (LENGTHENS LINE)	0.07	
	BRIDGE STA. 518+70.00	127.03	
	NET LENGTH ROADWAY	52,385.61	9.921
	NET LENGTH BRIDGES	309.86	0.059
	NET LENGTH DIV. 1	52,695.47	9.980
2	(SIGOURNEY:)		
	STA. 526+95.40 TO STA. 534+19.85	724.45	0.137
	NET LENGTH DIV. 2	724.45	0.137
	NET LENGTH ROADWAY	53,110.06	10.058
	NET LENGTH BRIDGES	309.86	0.059
	NET LENGTH PROJECT	53,419.92	10.117

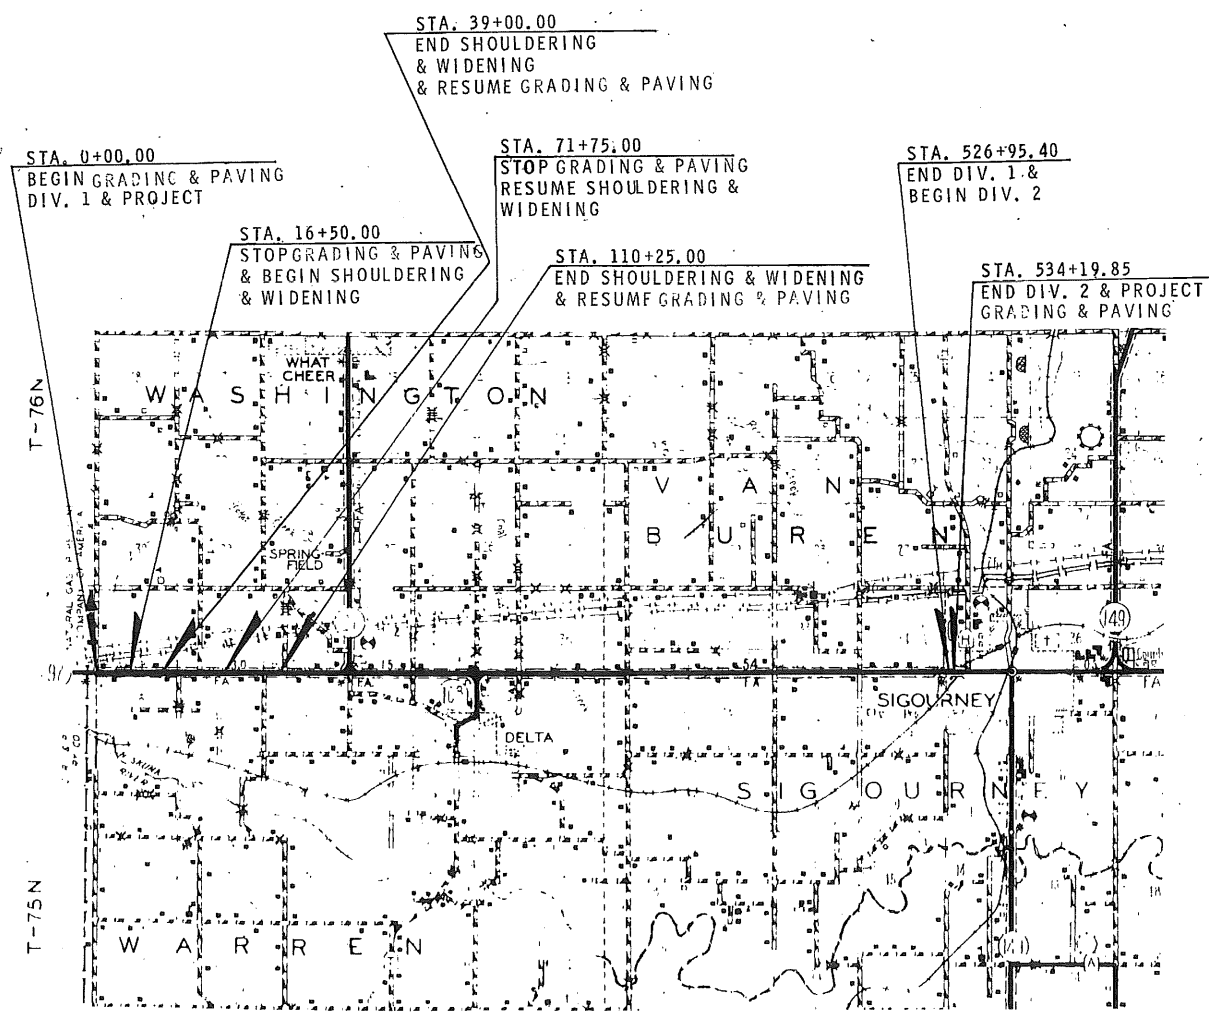

F-34(5) EROSION - Dec 1, 1964

DESIGN DATA		
RURAL		
1963 AADT	2050	V.P.D.
1963 AADT	3500	V.P.D.
1963 DHV	403	V.P.H.
DIRECTIONAL	52	%
TRUCKS	11	%
DESIGN V	60	M.P.H.
PARTIAL ACCESS CONTROL		


# 10 SHEETS

REVISED OCT. 27, 1964 SHEETS NO. 1A, 3C, 67 & 68  
REVISED JULY 7, 1964 SHEETS NO. 3A, 3C, 3D & 39  
REVISED OCT. 29, 1963 SHEETS NO. 3A & 3C

APPROVED: \_\_\_\_\_  
DISTRICT ENGINEER  
IOWA HIGHWAY COMMISSION

DEPARTMENT OF COMMERCE  
BUREAU OF PUBLIC ROADS

APPROVED: \_\_\_\_\_  
DISTRICT ENGINEER

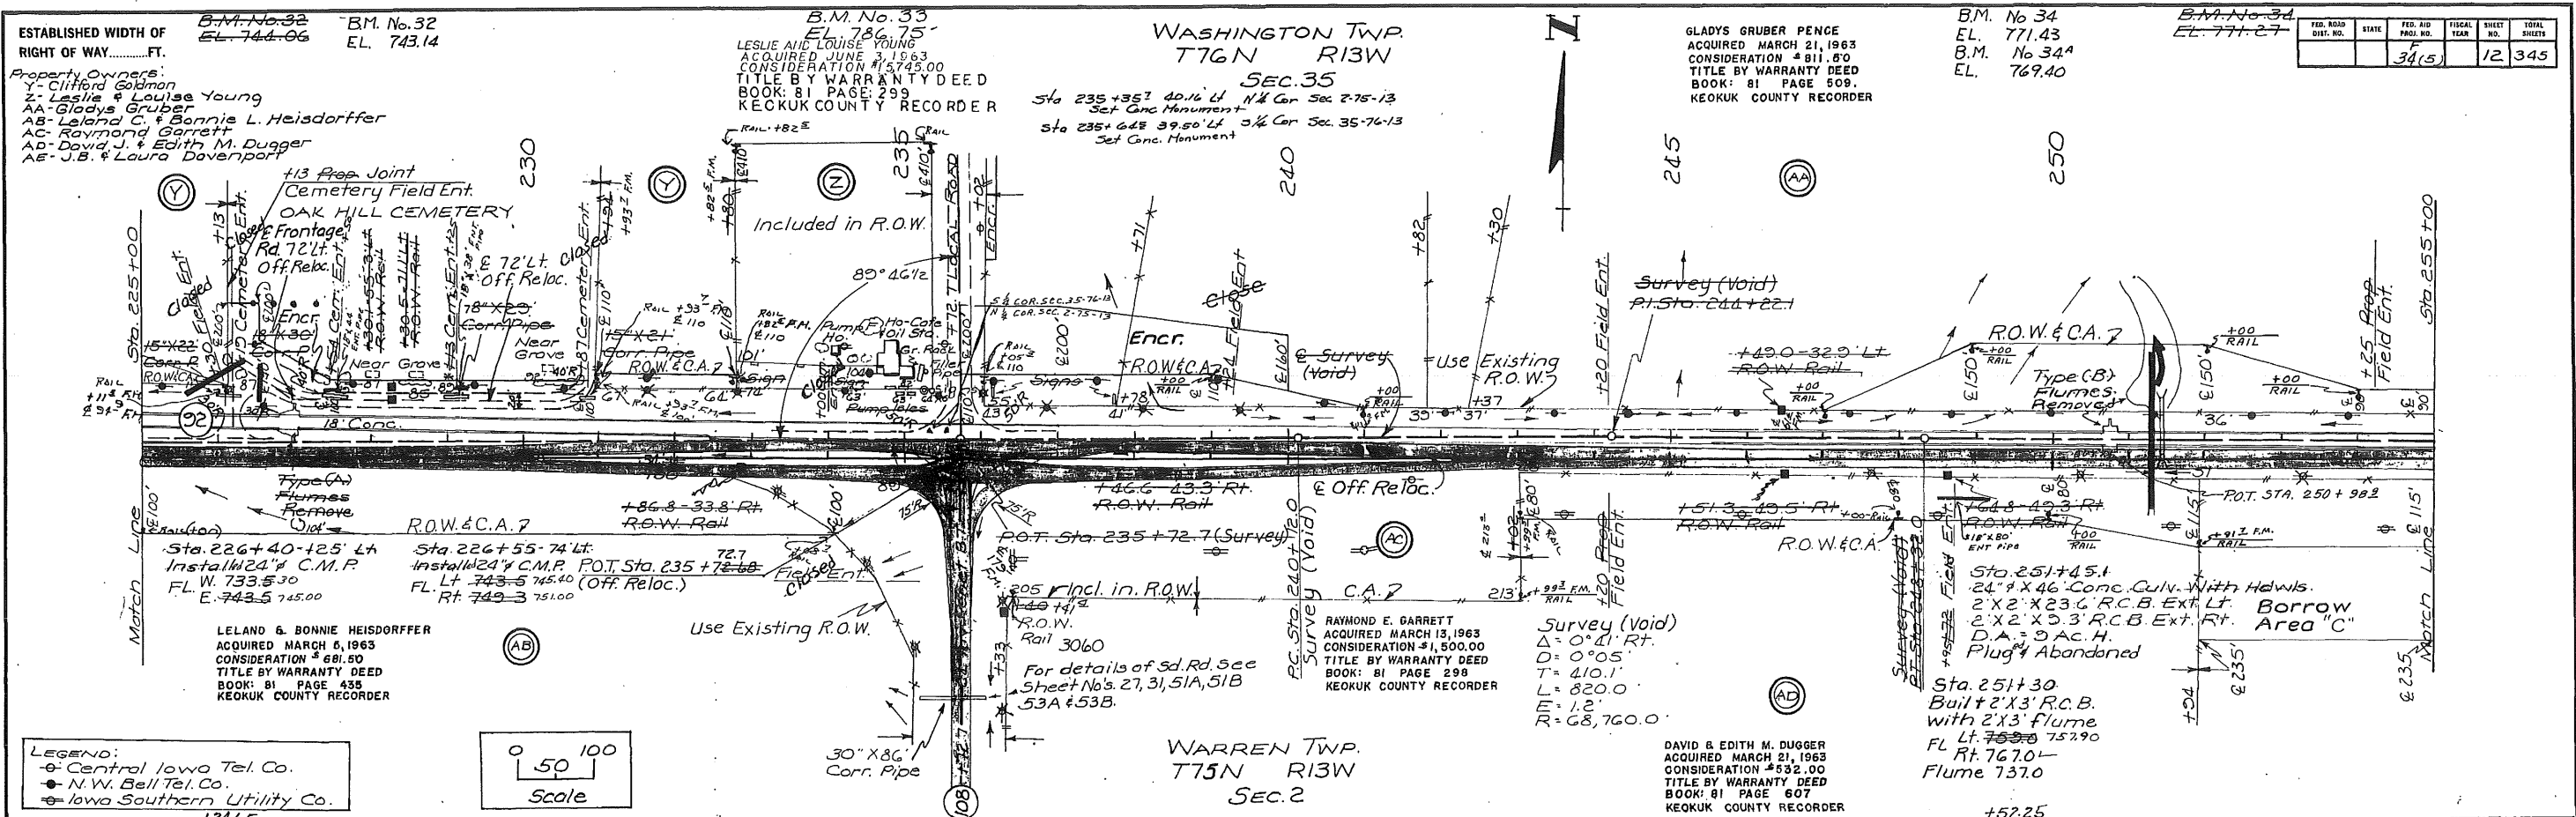



DATE	BY	PLAN	SHOWN	PLANNED	NOTED	NO.

DATE	BY	PROFILE	SHOWN	PLANNED	NOTED	NO.

**LEGEND:**  
 - Central Iowa Tel. Co.  
 - N.W. Bell Tel. Co.  
 - Iowa Southern Utility Co.

**Scale**  
 0 50 100

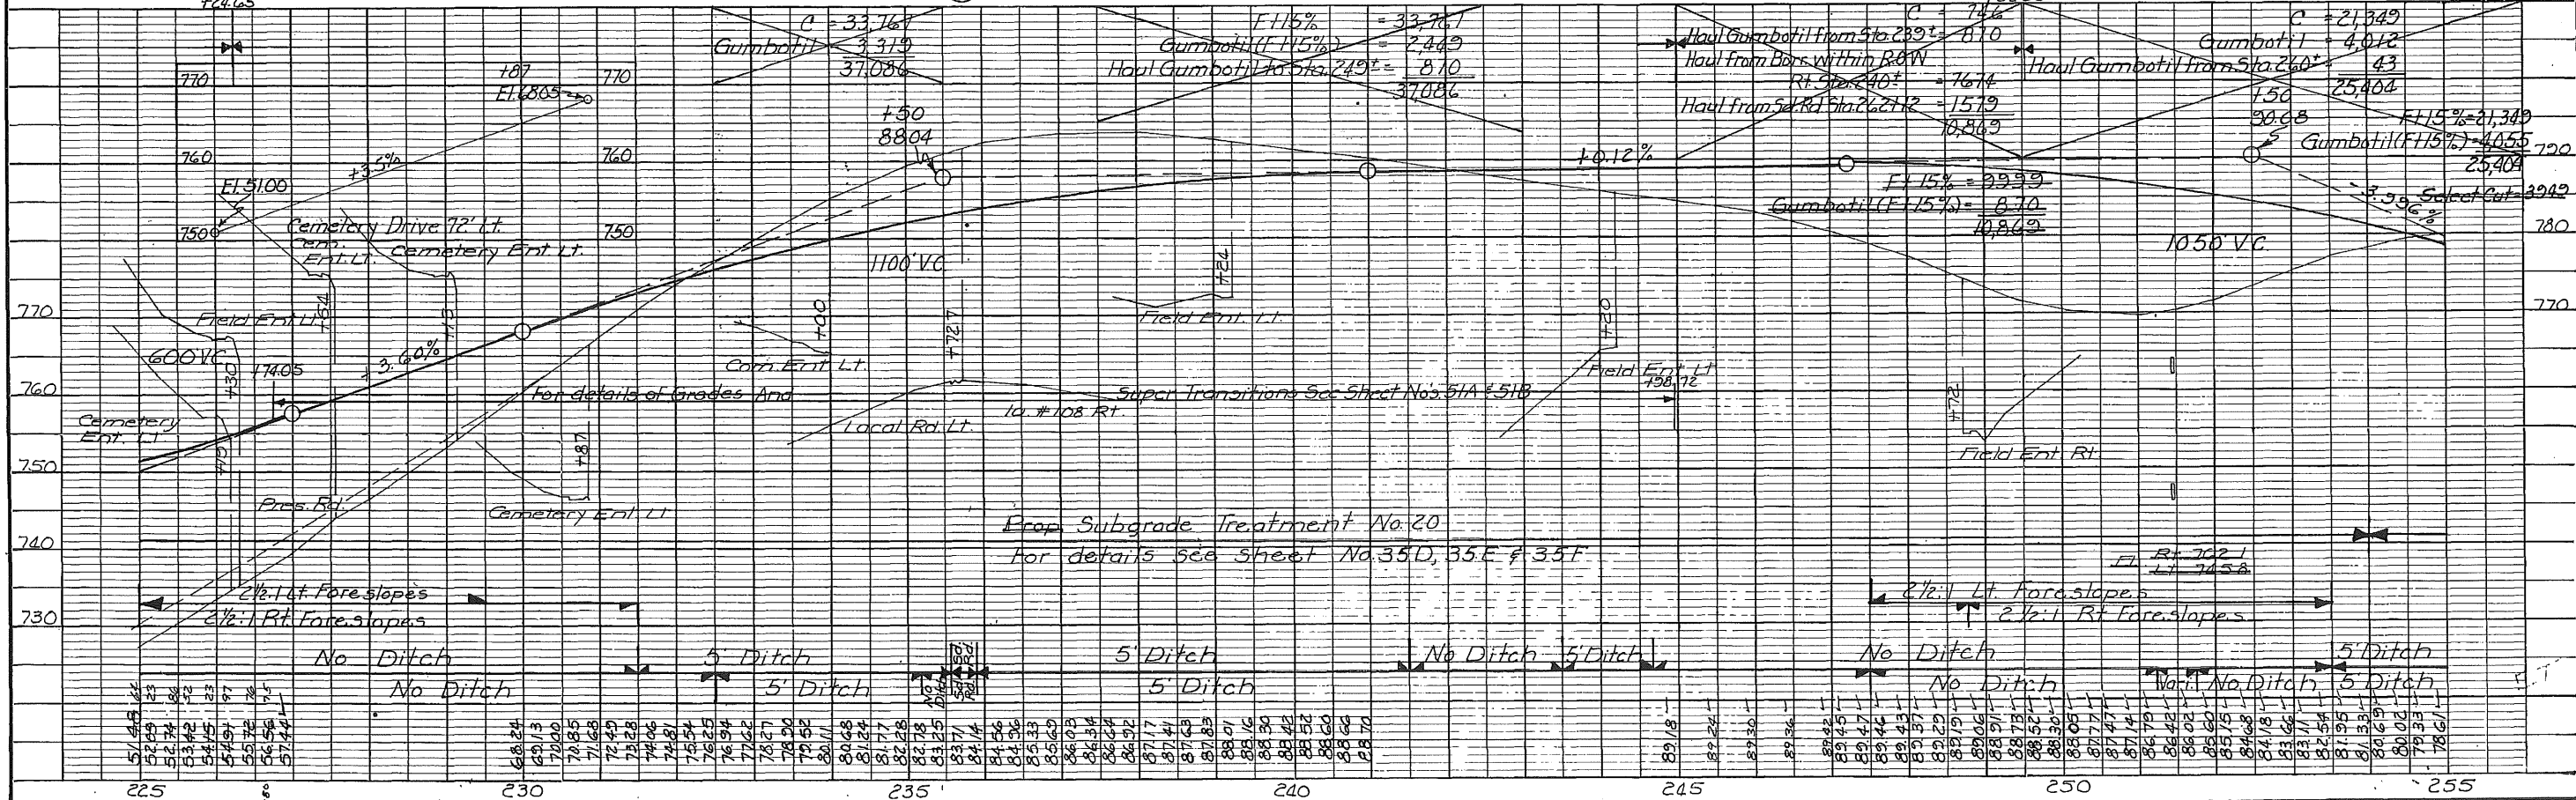

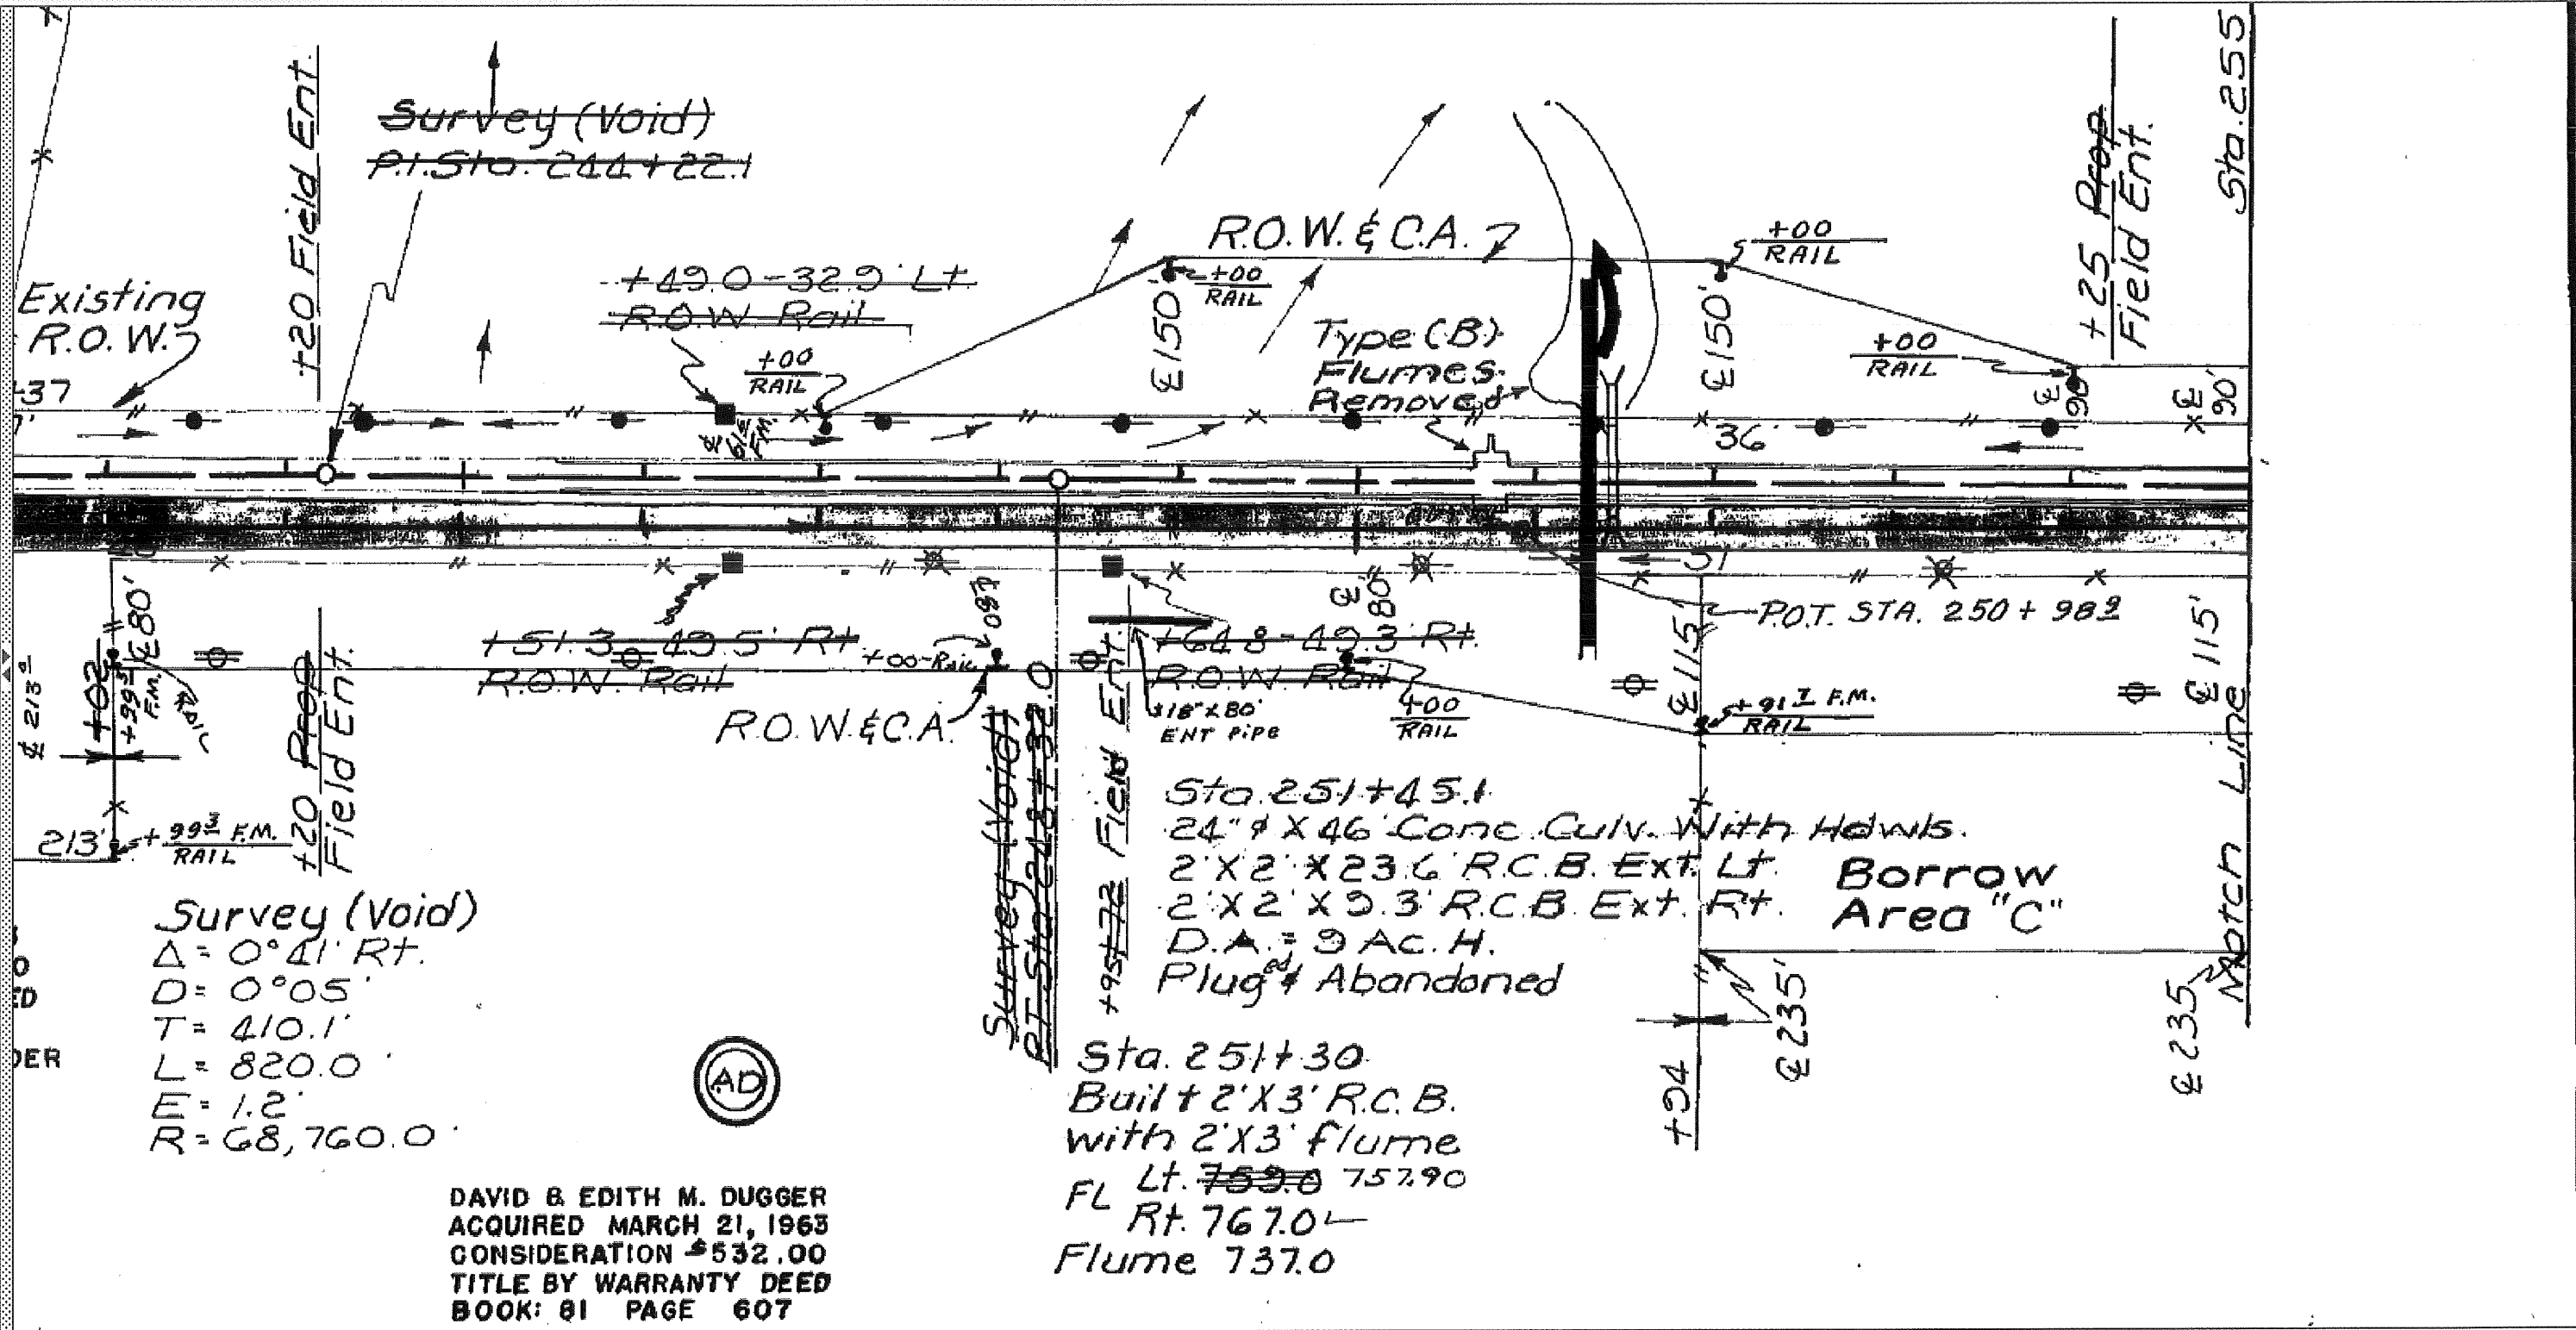

Survey (Void)  
 $\Delta = 0^\circ 41' \text{ Rt.}$   
 $D = 0^\circ 05'$   
 $T = 410.1'$   
 $L = 820.0'$   
 $E = 1.2'$   
 $R = 68,760.0'$



DAVID & EDITH M. DUGGER  
 ACQUIRED MARCH 21, 1963  
 CONSIDERATION \$532.00  
 TITLE BY WARRANTY DEED  
 BOOK: 81 PAGE 607

Sta. 251+45.1  
 24" x 46" Conc. Culv. With Howls.  
 2' x 2' x 23.6' R.C.B. Ext. Lt. Borrow  
 2' x 2' x 9.3' R.C.B. Ext. Rt. Area "C"  
 D.A. = 9 Ac. H.  
 Plug & Abandoned

Sta. 251+30  
 Built 2' x 3' R.C.B.  
 with 2' x 3' flume  
 FL Lt. ~~753.0~~ 757.90  
 Rt. 767.0  
 Flume 737.0



BRIDGES & CULVERTS - KEOKUK CO. F-34(5)

NOVEMBER 12 1963 LETTING


STATE OF IOWA  
 STATE HIGHWAY COMMISSION  
 DESIGN FOR  
**BRIDGES AND CULVERTS**  
**TRAINARY ROAD SYSTEM**  
 PROJECT NO. F-34(5)  
**KEOKUK COUNTY**

DESIGN NO. 762	T - 76N R - 12W & T - 75N R - 12W OVER ROCK CREEK ON IOWA RELOCATED #92	STATION 518+70.00 VAN BUREN & SIGONNE TOWNSHIPS	
125'-0 X 30' CONTINUOUS CONCRETE SLAB BRIDGE 10° SKEW			
ESTIMATE OF QUANTITIES			
ITEM	UNIT	TOTAL	
Concrete	Cu. Yds.	312.9	
Reinforcing Steel	Lbs.	69,969	
16" P10A TYPE I-III or TYPE III-IV	Furnish 18 at 65' Drive 18 at 65'	Lin. Ft. 1,370	or
Piling	Furnish & Drive 18 at 50'	Lin. Ft. 900	
Crossed Piling	11 at 45'; 11 at 50'	Lin. Ft. 1,045	
Class 20 Excavation	Cu. Yds.	120	
Granular Backfill	Tons	80	
4" Tile Subdrains	Lin. Ft.	100	
Class 10 Channel Excavation	Cu. Yds.	650	
Aluminum Handrail (C - C End Posts) or Steel Handrail (C - C End Posts)	Lin. Ft.	250	
Removal of Existing Structure	L. S.	LumpSum	
* Hauling & Storing Structural Steel	L. S.	LumpSum	
* NON-PARTICIPATING			

DESIGN NO. 662	T - 75N R - 13W T - 76N R - 13W OVER CEDAR CREEK ON IOWA NO. 92	STATION 282+45.00 WASHINGTON & WARREN TOWNSHIP	
180'-0 X 30'-0 PRETENSIONED PRESTRESSED CONCRETE BEAM BRIDGE			
ESTIMATE OF QUANTITIES			
ITEM	UNIT	TOTAL	
Concrete	Cu. Yds.	358.1	
Reinforcing Steel	Lbs.	67,381	
Prest. Conc. Beams 55'-0 (B-4)	Only	14	
Prest. Conc. Beams 67'-6 (B-7)	Only	7	
Crossed Piling	26 at 45'	Lin. Ft. 1,170	
16" P10A TYPE I-III or TYPE III-IV	Furnish 32 at 35' Drive 32 at 35'	Lin. Ft. 1,120	
Crossed Piling	26 at 45'	Lin. Ft. 1,170	
4" Tile Subdrain	Lin. Ft.	168	
Class 10 Channel Excavation	Cu. Yd.	1,925	
Class 20 Excavation	Cu. Yd.	145	
Class 21 Excavation	Cu. Yds.	250	
Removal of Existing Structure	L. S.	LumpSum	
Aluminum Handrail (C - C End Posts) or Steel Handrail (C - C End Posts)	Lin. Ft.	341.0	
* Hauling and Storing Structural Steel	L. S.	LumpSum	
Granular Backfill	Tons	145	
* NON-PARTICIPATING ITEM			

IOWA STATE HIGHWAY COMMISSION  
STANDARDS REQUIRED

CHP	C1P	CFP	C2J	P10A
CBH-00	C2P		C4J	
CBH-30	C3P		C5J	
	C4P		C6J	
	C5P		C10J	
	C6P		F2J	
	C10P		F3J	
	C6F		F4J	
	C10F		F5J	
			F6J	

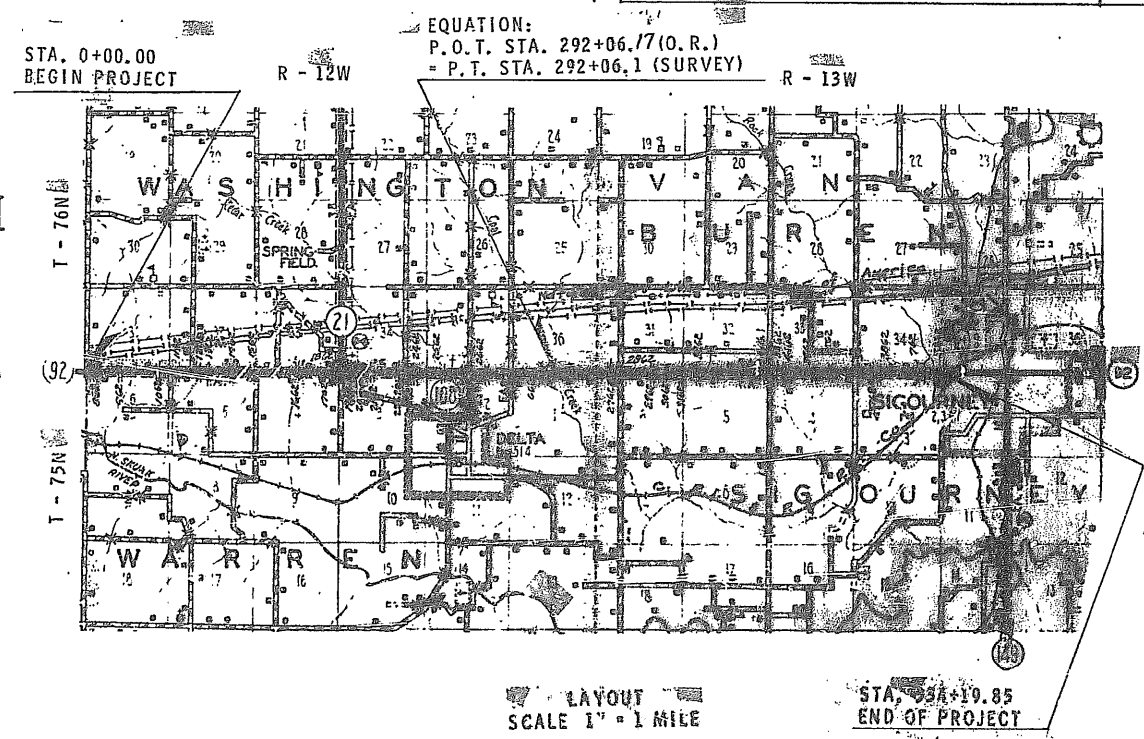

These bridges will require Bridge Sign Assemblies furnished and placed by others as specified in Traffic and Highway Planning Instruction No. 11, Revised October 1, 1961.

**DETAIL PLANS  
REDUCED IN SIZE  
(DO NOT SCALE)**

**SPECIFICATIONS:**

CONSTRUCTION: Standard Specifications of the Iowa State Highway Commission, Series of 1960, plus current Supplemental Specifications and Special Provisions.

DESIGN STRESSES for the following materials are in accordance with A. A. S. H. O. Standard Specifications for Highway Bridges, Series of 1961.

- Concrete in accordance with Section 1.4.11 f'c = 3500 psi.
- Reinforcing Steel in accordance with Section 1.4.12 "Reinforcement" for Intermediate, Hard, or Rail Steel Grade.
- Structural Steel in accordance with INT. 7(62); 1.4.2 "Structural Steel".
- Prestressed Concrete in accordance with Section 1.13.7 f'c = 5000 psi.
- Prestressing Steel in accordance with Section 1.13.7 f'c = 250,000 psi.

Revised 8-31-64 Sheet No 2 of 43 Sheet No 30 of 43  
 Revised 7-9-64:  
 Title Sheet 2 of 2 - Des. No's 4062 & 4162 added. Effected quantities changed accordingly.  
 Revised 7-9-64:  
 Sheet No 43A & Des. No's 4062 & 4162 added to project.

Revised: 2-4-64 Sheet 26 of 43 Design 862 barsize corrected. - Sheet 28 of 43 Design 962 dimension corrected. - Sheet 26 of 43 Design 2362 Junction details added.  
 Design 762 Revised 10-11-63: Listing of 16" P10A Piling corrected.  
 Revised 1-15-64, Design 2462 for grade line change. See Sheet 35 and title sheet 2 of 2



MILEAGE SUMMARY		
LOCATION	LIN. FT.	MILES
BRIDGE AT STA. 282+45.00	122,633	.035
BRIDGE AT STA. 518+70.00	127,051	.024
<b>Total</b>		<b>.059</b>

Excavation quant. changed. Total quantities corrected.

APPROVED:  
*R. M. Teutler* AUG 22 1963  
 DEPUTY CHIEF ENGINEER  
 IOWA HIGHWAY COMMISSION


DEPARTMENT OF COMMERCE  
 BUREAU OF PUBLIC ROADS

Revised 4-17-64 Sheet No 30 of 43 Des. No 1262 Flow Line elevations raised.

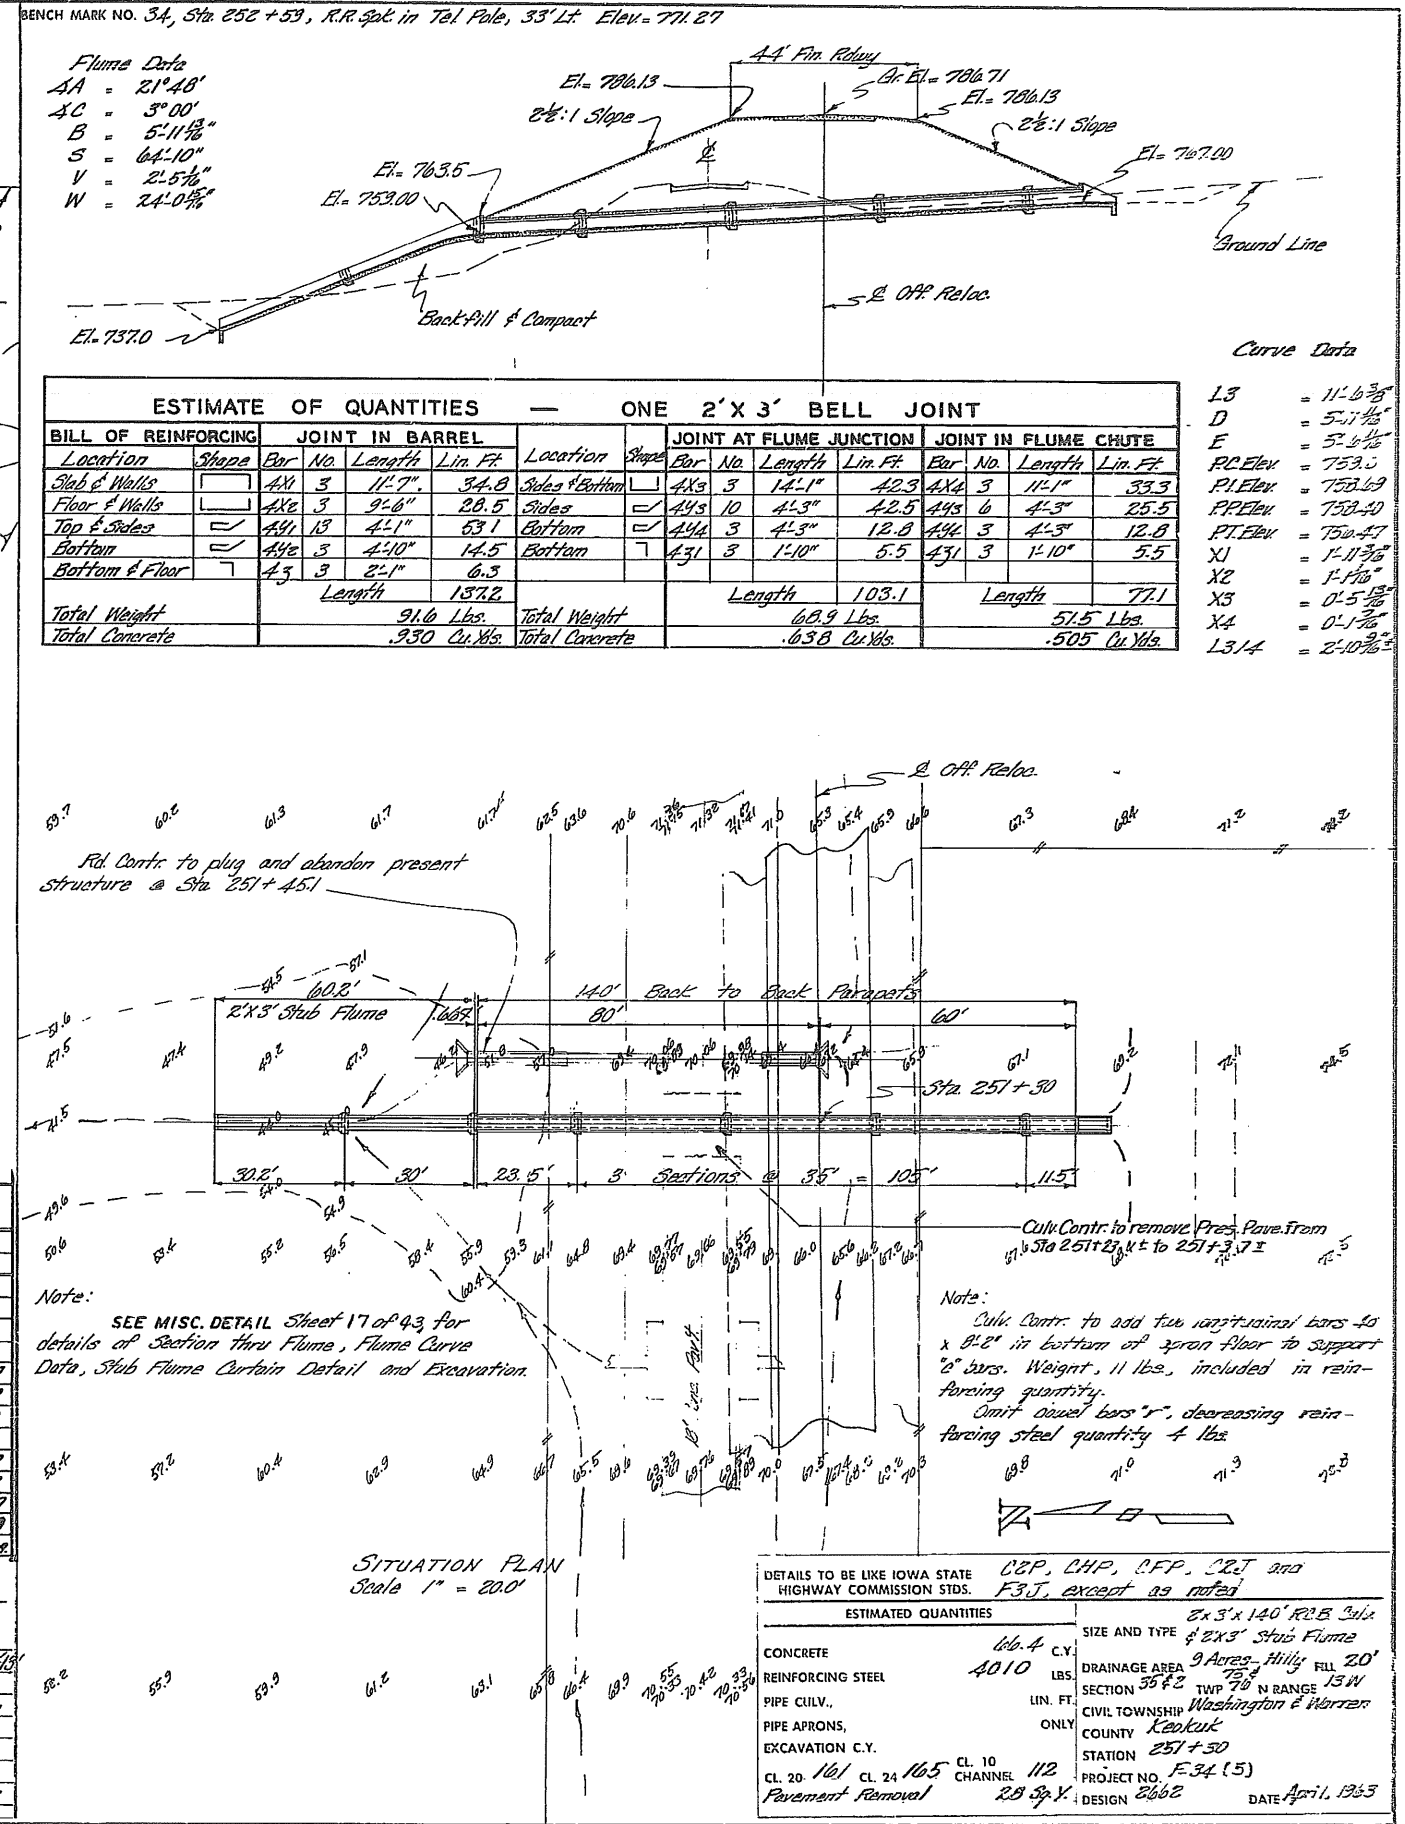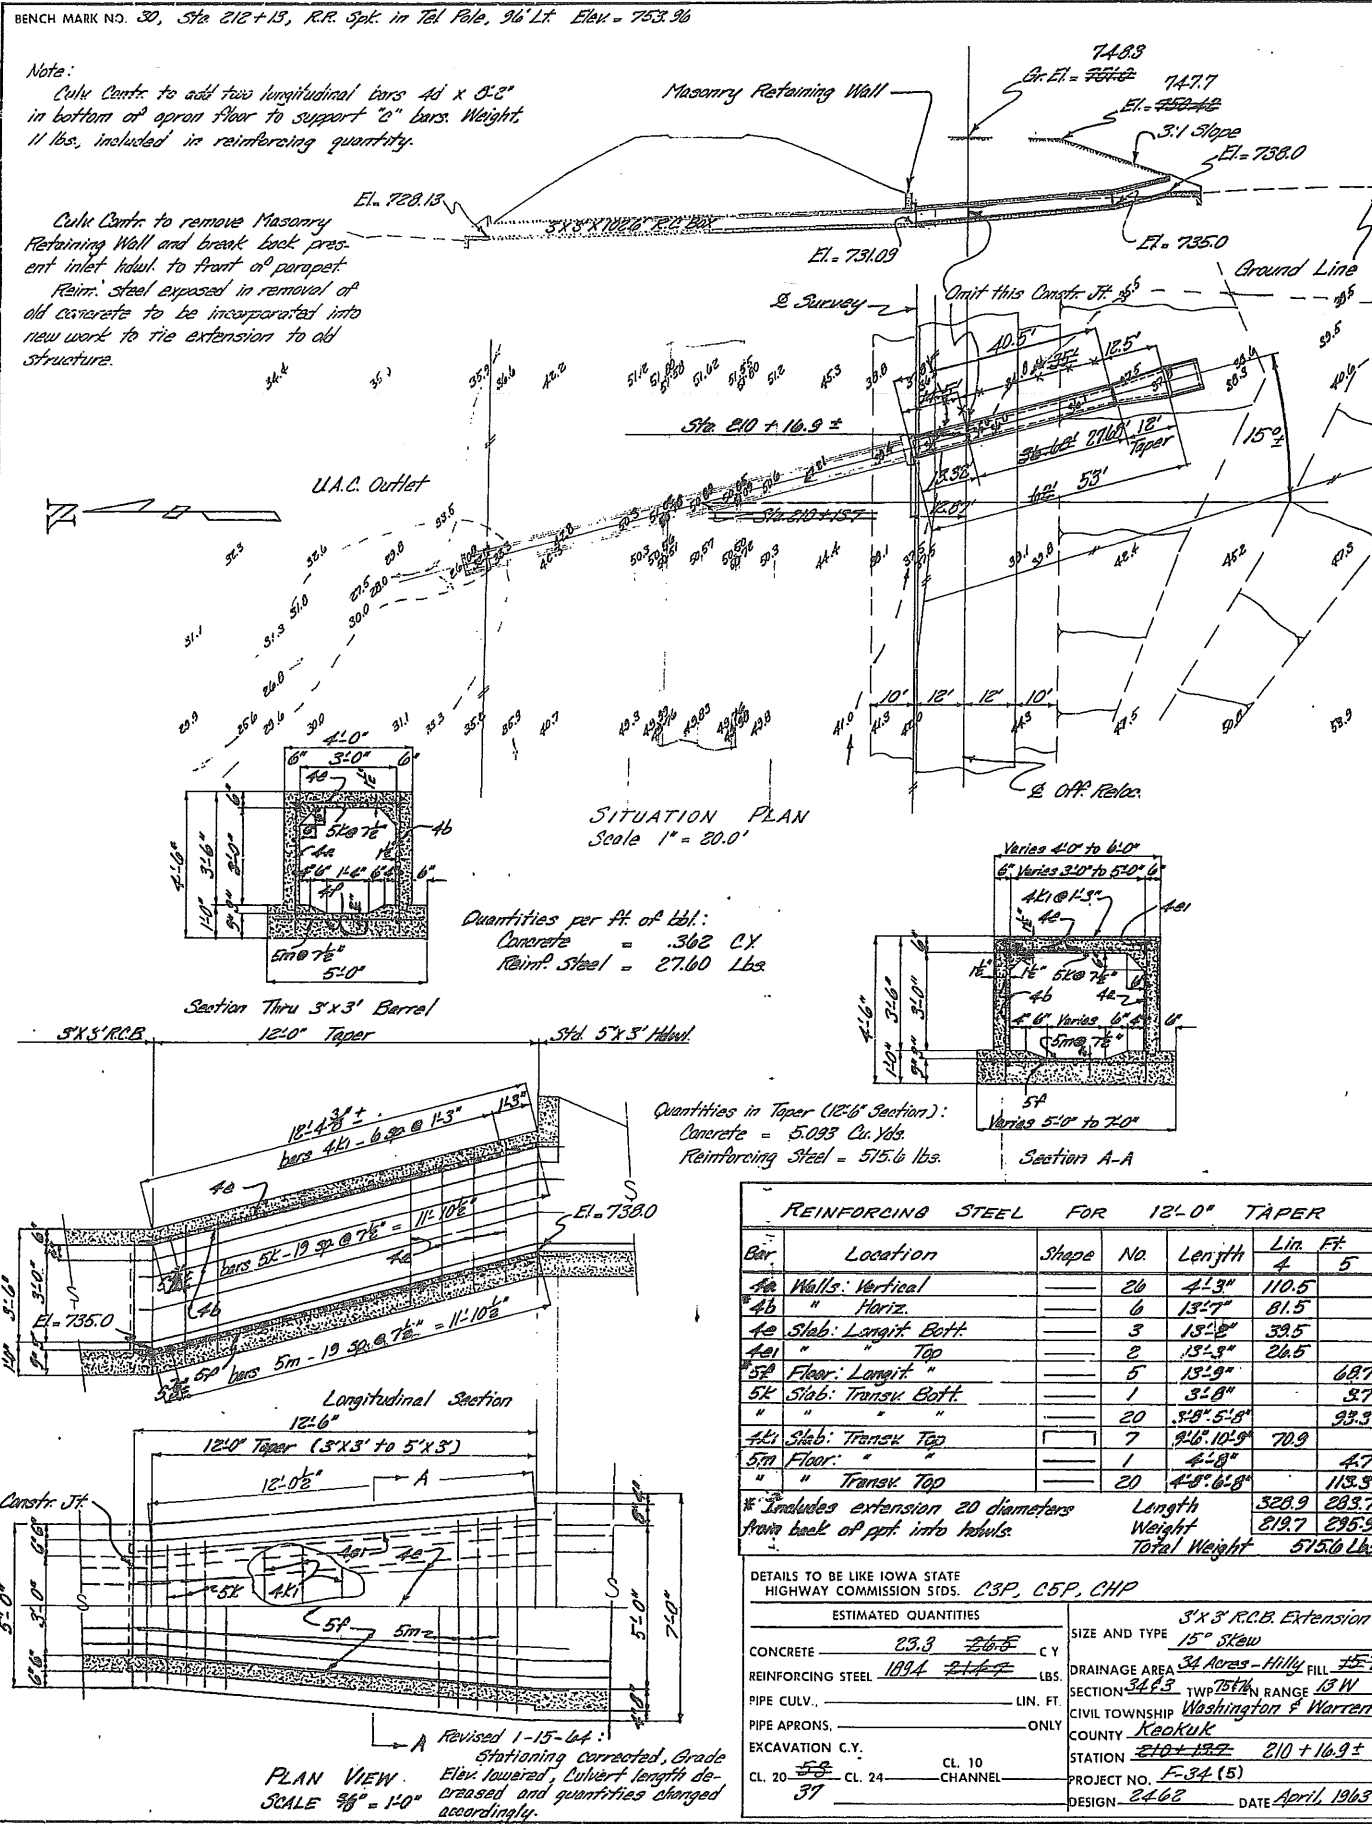



### CONVENTIONAL SIGNS

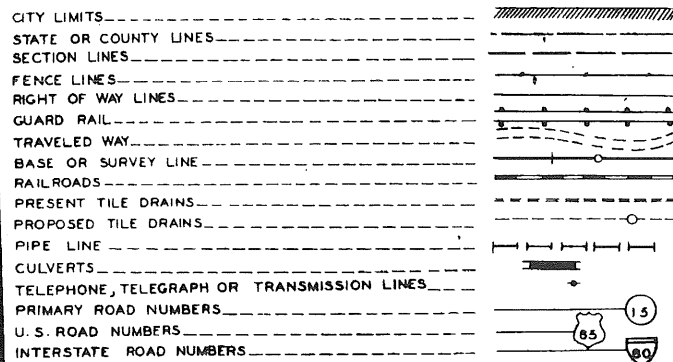

## STATE OF IOWA STATE HIGHWAY COMMISSION

### PLAN & PROFILE OF PROPOSED IMPROVEMENT ON THE PRIMARY ROAD SYSTEM

## KEOKUK COUNTY

GRADING SHOULDERING - P.C.C. PAVING & P.C.C. PAVT. WIDE. PROJECT NO. F 34 (5)

ON U. S. 92 FROM THE MAHASKA CO. LINE EAST TO S'IGOURNEY

SCALES } PLAN 1 INCH=100 FT.  
          } PROFILE HOR. 1 INCH=100 FT., VERT. 1 INCH=10 FT.

THE IOWA STATE HIGHWAY COMMISSION STANDARD SPECIFICATIONS  
FOR CONSTRUCTION WORK, SERIES OF 1960, SHALL  
APPLY TO WORK ON THIS PROJECT

THE 1964 SPECIFICATIONS SHALL APPLY TO ALL WORK ON THIS  
PROJECT LET ON OR AFTER NOV. 3, 1964

FED. ROAD DIST. NO.	STATE	PROJ. NO.	SHEET NO.	TOTAL SHEETS
5	IOWA	F 34(5)	1A	345

### INDEX OF SHEETS

SEE SHEET NO. 1B

CONSTRUCTION PLAN SHOWING PROJECT AS BUILT

ONE COPY PREPARED BY J. M. Orbin DATE Feb 1, 1968

ONE COPY APPROVED & FORWARDED TO AMES

Jamies W. Edgerton, DISTRICT ENGINEER *const.*, DATE 2-2-68


TWO COPIES TO BE MADE & RETURNED TO

Virgil Butler, DISTRICT ENGINEER

Floyd Sheets, RESIDENT MAINTENANCE ENGINEER

STANDARD ROAD PLANS					
NUMBER	DATE	NUMBER	DATE	NUMBER	DATE
RL-1	8-16-62	RA-13	5-1-63	RL-1	1-1-64
RL-2	3-14-62	RA-16	4-1-63	RL-2	1-4-64
RL-3	11-10-62	RA-1	1-10-64	RL-3	
RL-4	1-14-63	RA-2	2-2-64	RL-4	
RF-1	2-7-63	RA-2	2-9-64	RF-1	
RF-3	12-14-63	RA-7	2-9-64	RF-3	
RF-4	2-9-64	RA-15	11-22-64	RF-4	
RF-5	12-14-64	RA-2	2-9-64	RF-5	
RF-7	3-22-65	RA-3	3-1-62	RF-7	
RF-12	4-18-63	RA-2	1-10-64	RF-12	
RF-16	4-18-63	RA-1	11-16-60	RF-16	

MILEAGE SUMMARY			
105-1			
DIV.	LOCATION	LIN. FT.	MILES
1	(RURAL:)		
	STA. 0+00.00 TO STA. 526+95.40	52,695.40	
	BRIDGE STA. 282+45.00	182.83	
	EQUATION: STA. 292+06.17 = STA. 292+06.10 (LENGTHENS LINE)	0.07	
	BRIDGE STA. 518+70.00	127.03	
	NET LENGTH ROADWAY	52,385.61	9.921
	NET LENGTH BRIDGES	309.86	0.059
	NET LENGTH DIV. 1	52,695.47	9.980
2	(SIGOURNEY:)		
	STA. 526+95.40 TO STA. 534+19.85	724.45	0.137
	NET LENGTH DIV. 2	724.45	0.137
	NET LENGTH ROADWAY	53,110.06	10.058
	NET LENGTH BRIDGES	309.86	0.059
	NET LENGTH PROJECT	53,419.92	10.117

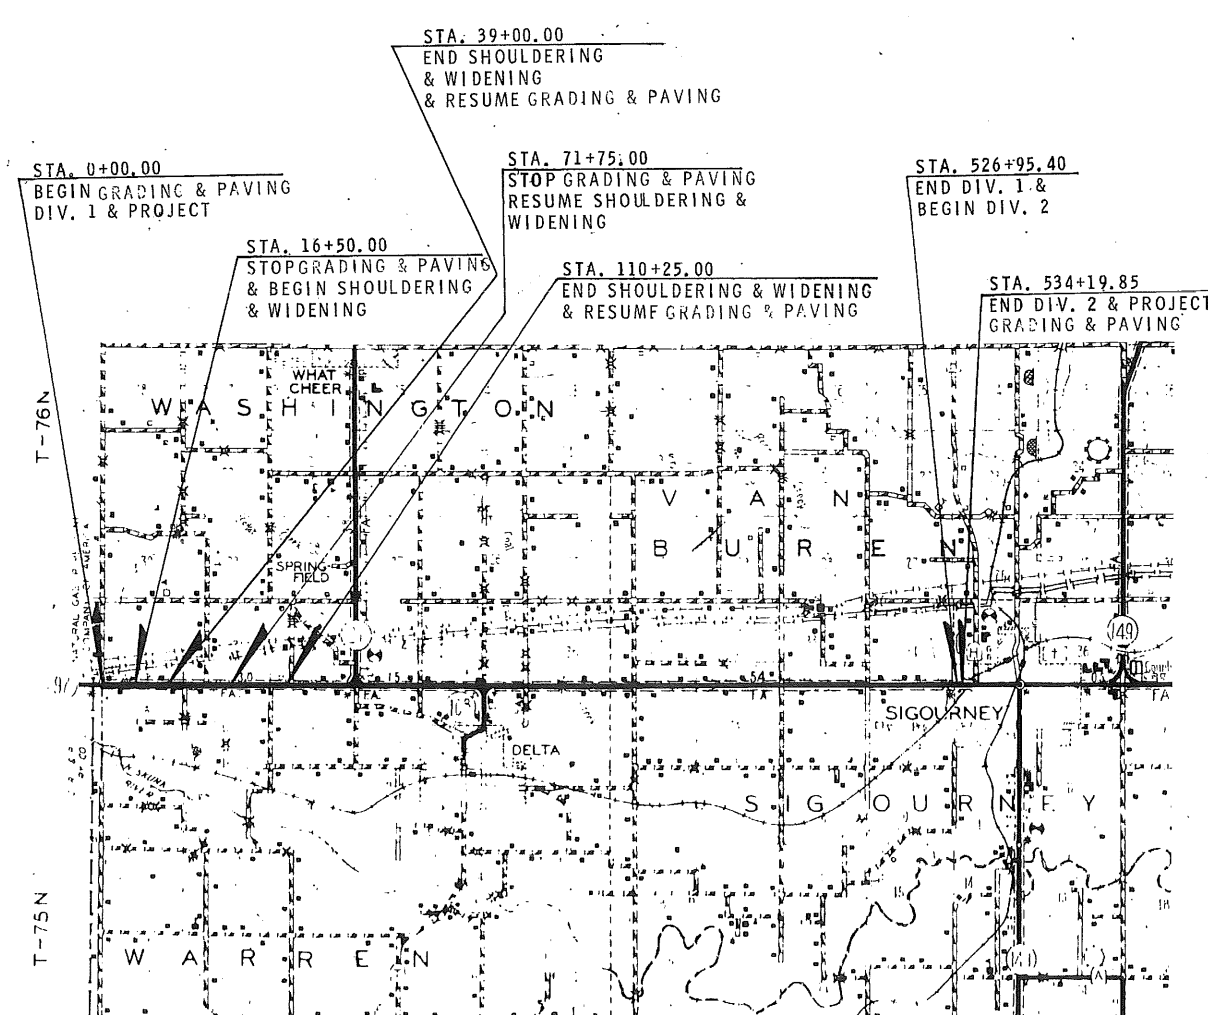

F-34(5) EROSION - Dec 1, 1964

DESIGN DATA		
RURAL		
1963 AADT	2050	V.P.D.
1963 AADT	3500	V.P.D.
1963 DHV	403	V.P.H.
DIRECTIONAL	52	%
TRUCKS	11	%
DESIGN V	60	M.P.H.
PARTIAL ACCESS CONTROL		

# 10 SHEETS

REVISED OCT. 27, 1964 SHEETS NO. 1A, 3C, 67 & 68  
REVISED JULY 7, 1964 SHEETS NO. 3A, 16, 1D & 39  
REVISED OCT. 29, 1963 SHEETS NO. 3A & 3C

APPROVED: [Signature]  
DISTRICT ENGINEER  
IOWA HIGHWAY COMMISSION

DEPARTMENT OF COMMERCE  
BUREAU OF PUBLIC ROADS

APPROVED: \_\_\_\_\_  
DATE: \_\_\_\_\_

Property Owners:  
 AO - Rex V. & Mildred M. McNabb  
 AP - Earl Morrow  
 AQ - John F. & Blanche E. Hauptert  
 AR - Kenneth E. Vogel  
 AS - Fadal Schultheiss

B.M. No. 41 BM No 41<sup>a</sup>  
 EL. 746.92' EL. 768.02

B.M. No. 42  
 EL. 773.87'

VAN BUREN TWP  
 T 76N R 12W  
 SEC. 31

B.M. No. 43 BM No 43  
 EL. 790.24 EL. 792.84

KENNETH E. VOGEL  
 ACQUIRED MARCH 27, 1963  
 CONSIDERATION \$456.00  
 TITLE BY WARRANTY DEED  
 BOOK: 81 PAGE: 408  
 KEOKUK COUNTY RECORDER

FED. ROAD DIST. NO.	STATE	FED. AID PROJ. NO.	FISCAL YEAR	SHEET NO.	TOTAL SHEETS
		34(5)		15	345


REX V. & MILDRED McNABB  
 ACQUIRED MARCH 15, 1963  
 CONSIDERATION \$1,231.00  
 TITLE BY WARRANTY DEED  
 BOOK: 81 PAGE: 352  
 KEOKUK COUNTY RECORDER

EARL MORROW  
 ACQUIRED MARCH 14, 1963  
 CONSIDERATION \$700.00  
 TITLE BY WARRANTY DEED  
 BOOK: 81 PAGE: 355  
 KEOKUK COUNTY RECORDER



JOHN F. & BLANCHE E. HAUPERT,  
 ACQUIRED SEPT. 10, 1963  
 CONSIDERATION \$3,560.00  
 TITLE BY WARRANTY DEED  
 BOOK: 81 PAGE: 396  
 KEOKUK COUNTY RECORDER

DATE	BY	NO.


DATE	BY	NO.

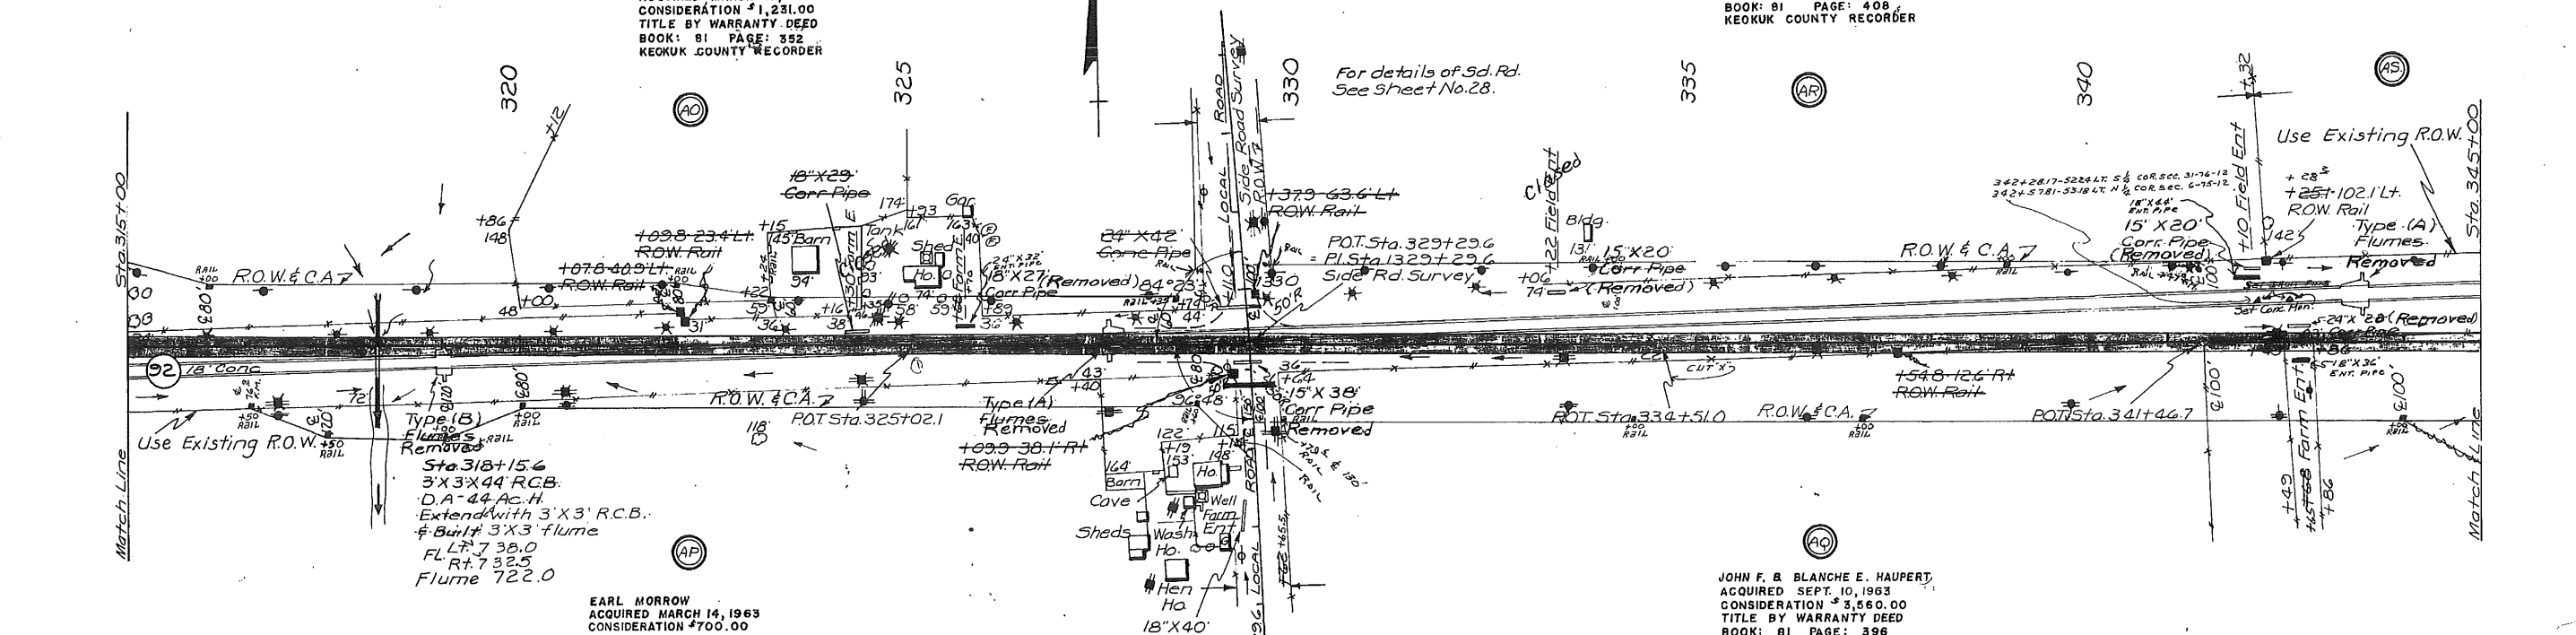

LEGEND:  
 ⊕ Central Ia. Tel. Co.  
 ⊙ N. W. Bell Tel. Co.  
 ⊞ Tama Ia. Poweshiek R.E.A. Co-op

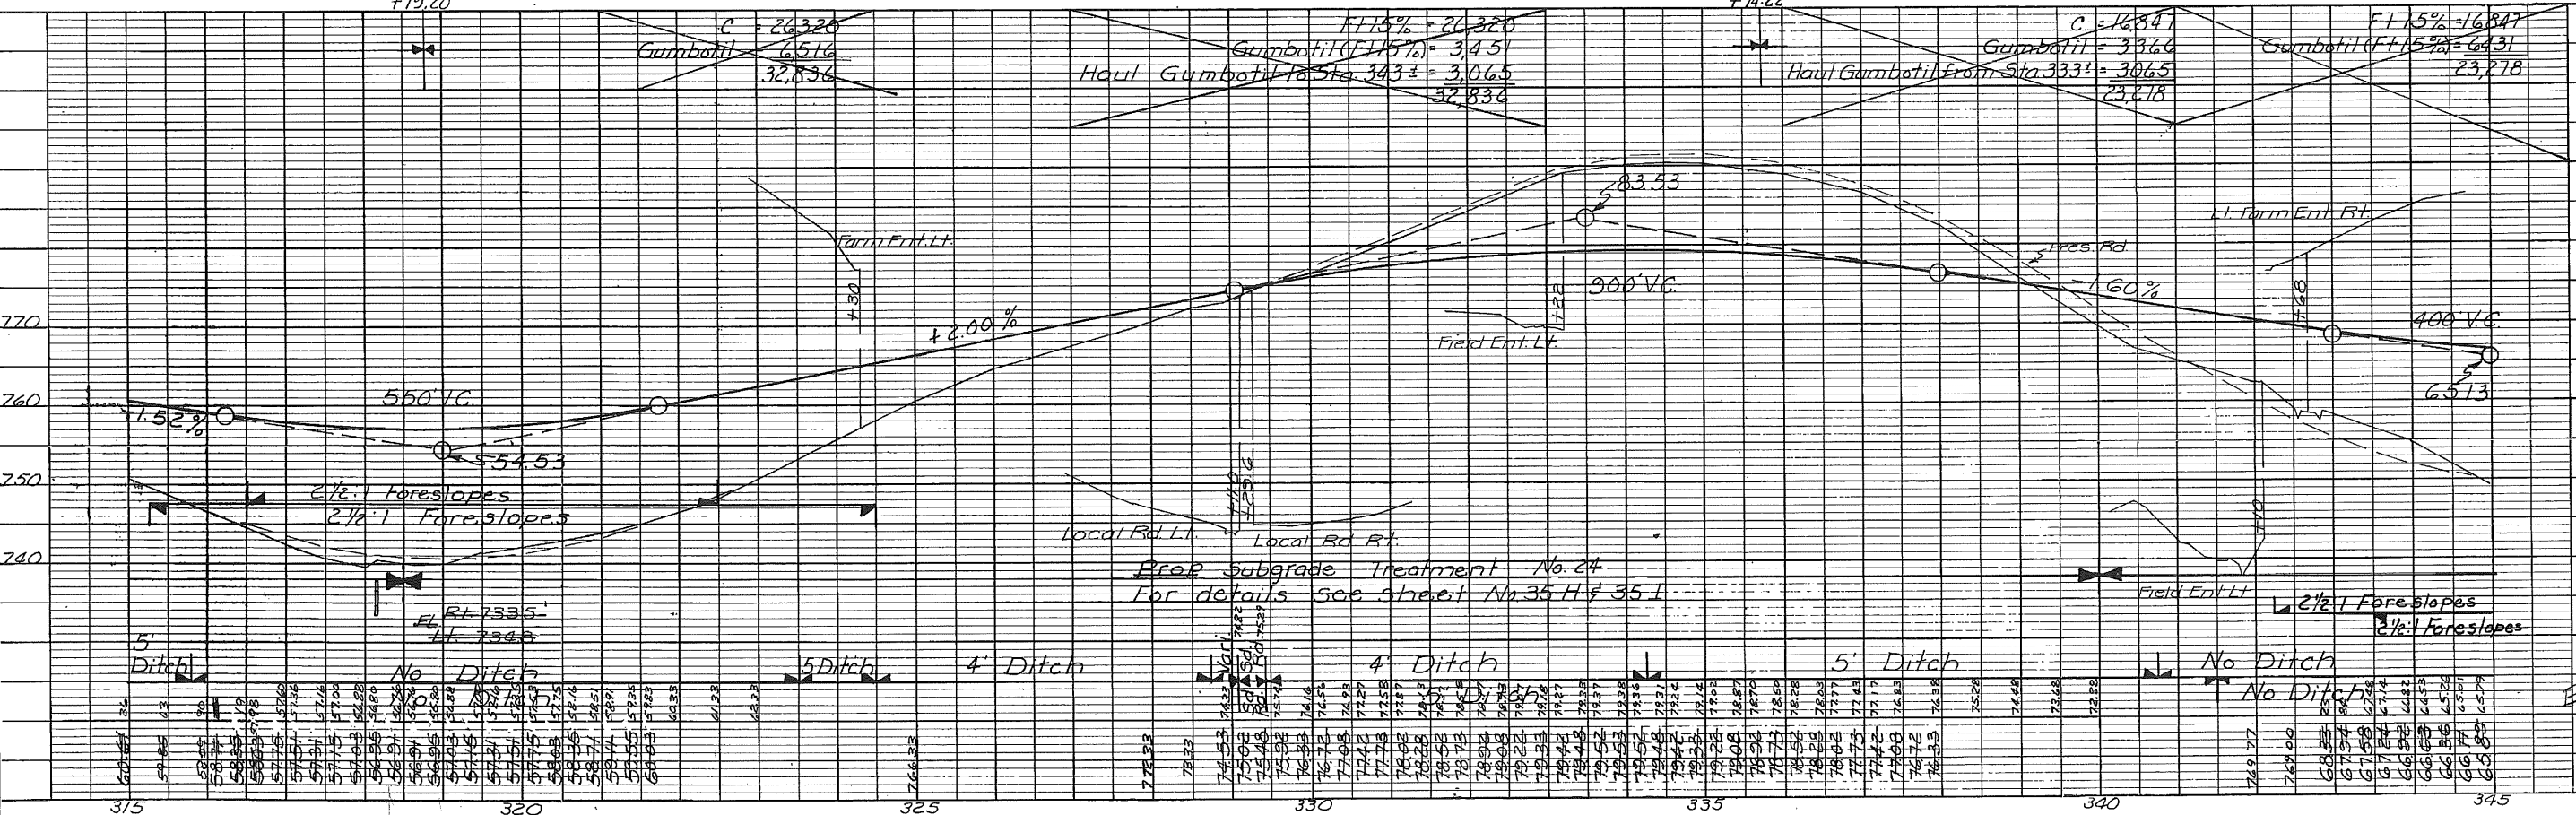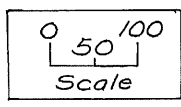

Sta. 315+00  
Match Line

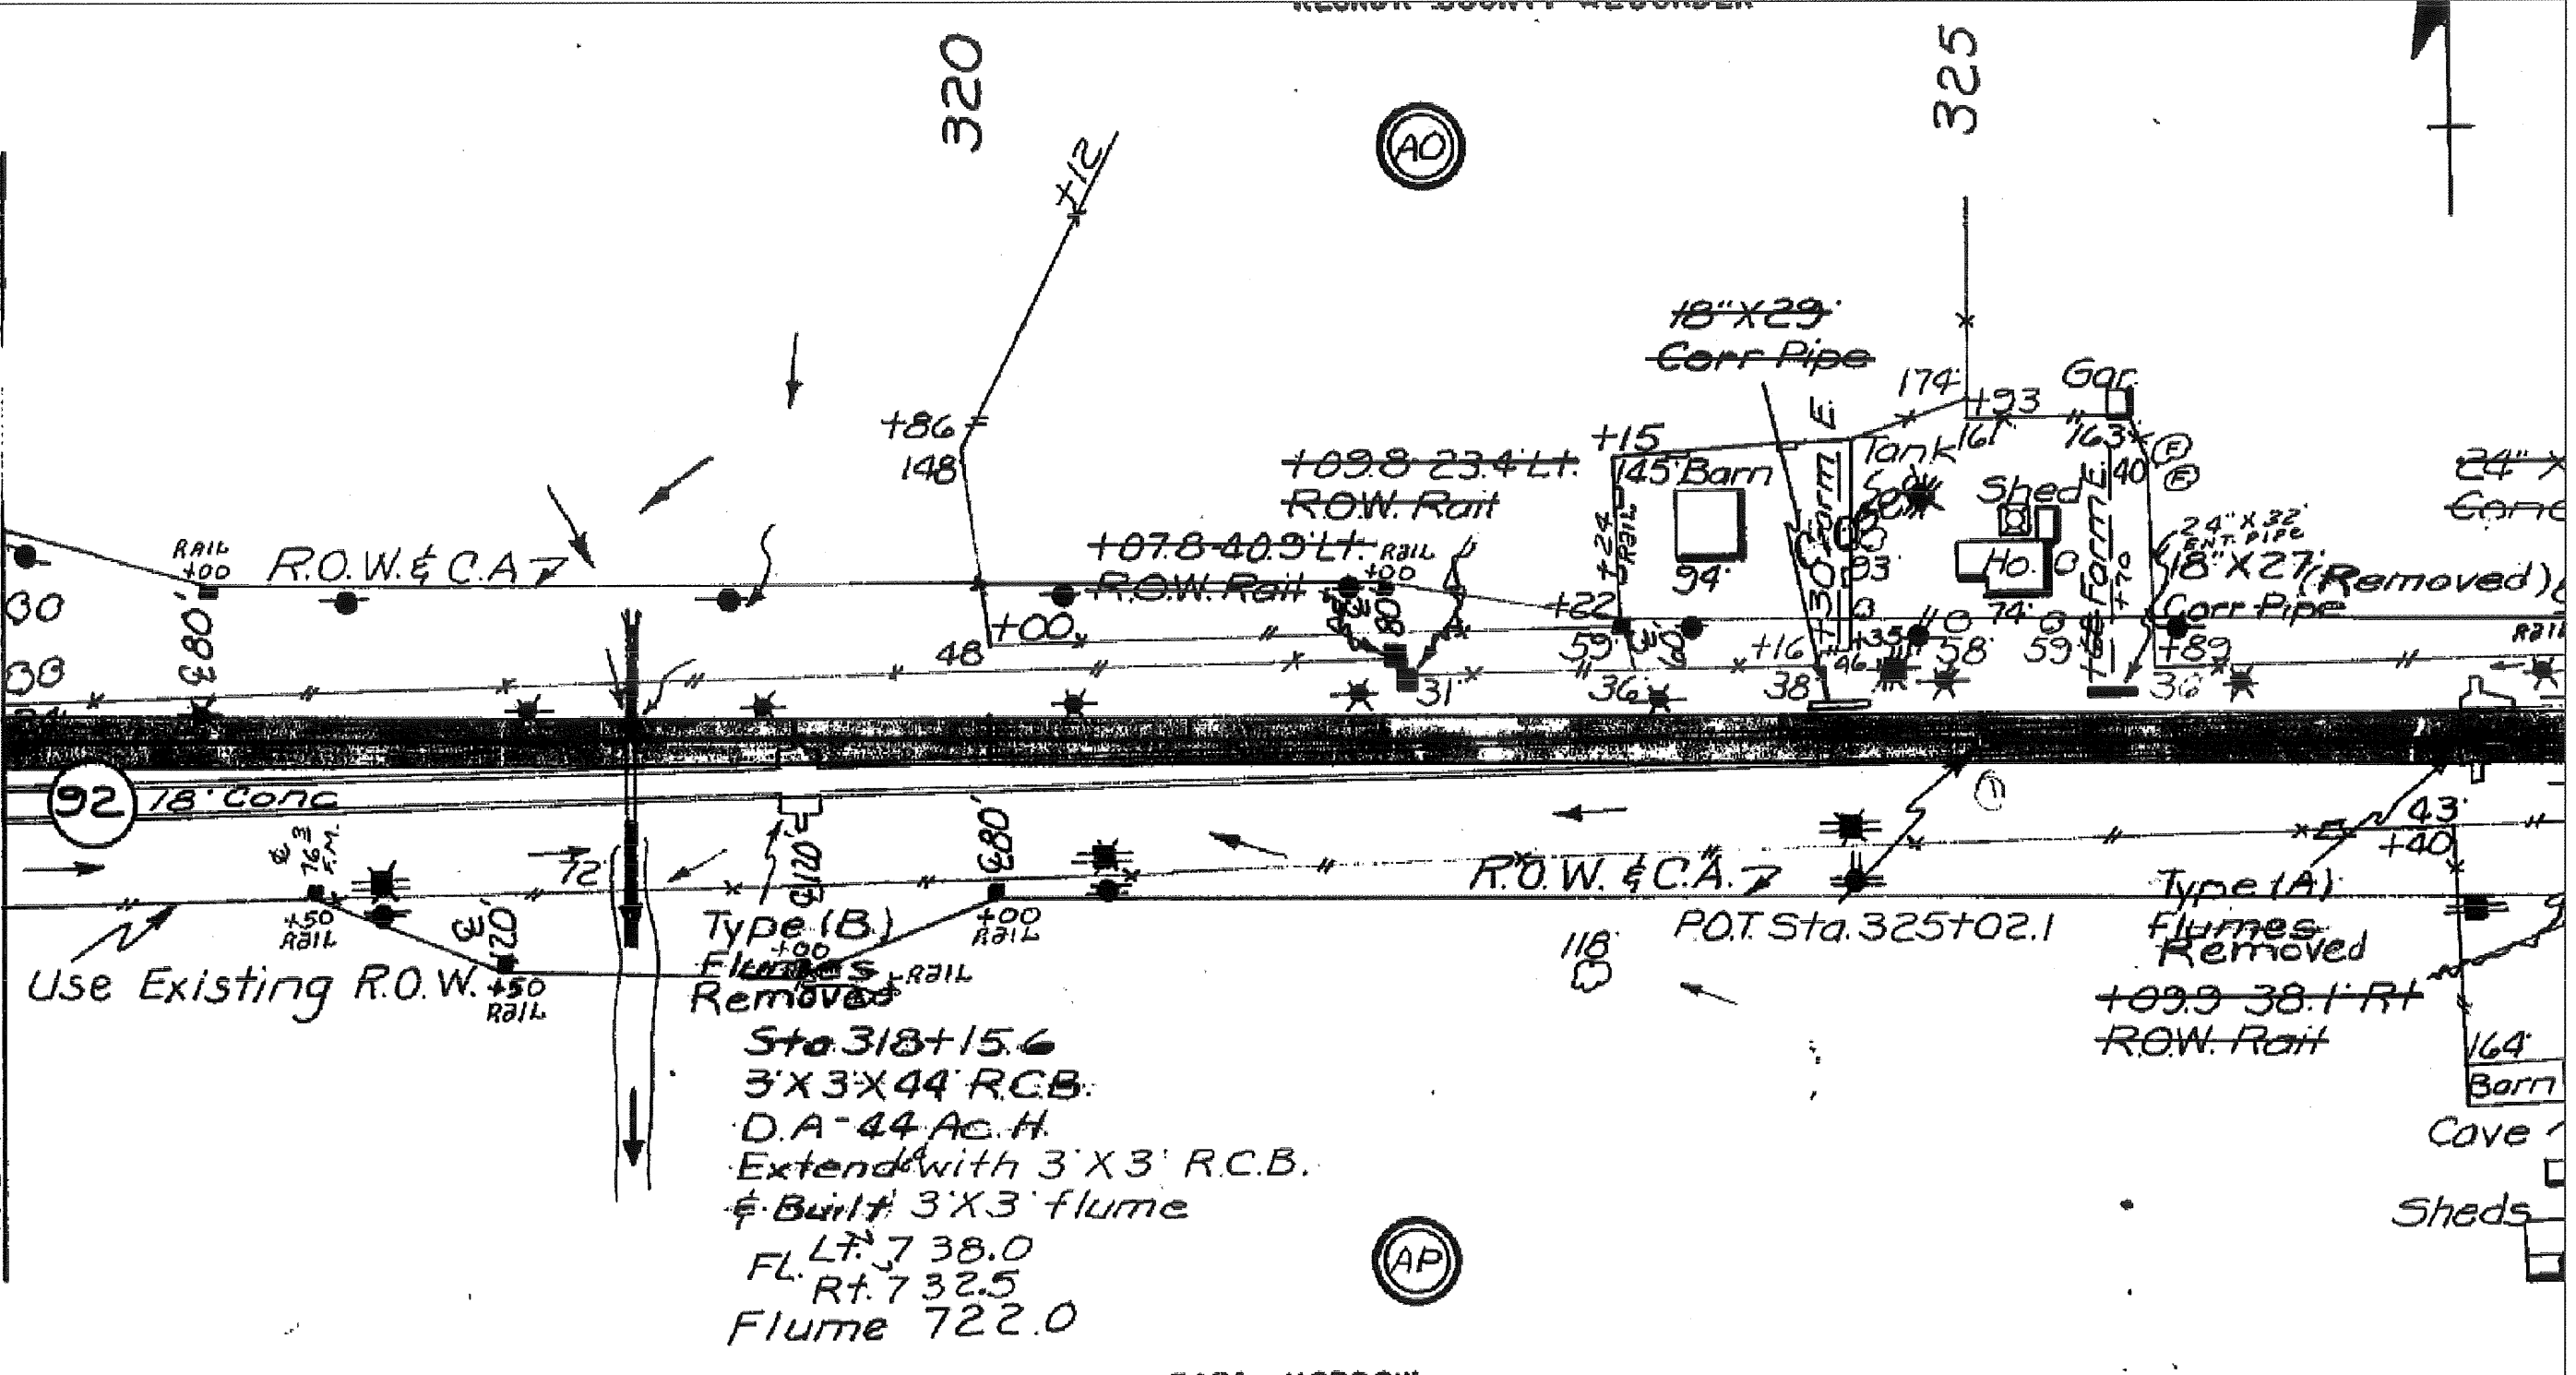

Type (B)  
Flumes  
Removed  
Sta. 318+15.6  
3' X 3' X 44' R.C.B.  
D.A. 44 AC. H.  
Extend with 3' X 3' R.C.B.  
& Built 3' X 3' flume  
FL. Lt. 7 38.0  
FL. Rt. 7 32.5  
Flume 7 22.0

R.O.W. & C.A.  
P.O.T. Sta. 325+02.1

Type (A)  
Flumes  
Removed  
+09.9 38.1 Rt  
R.O.W. Rail

164'  
Barn  
Cove  
Sheds

BRIDGES & CULVERTS - KEOKUK CO. F-34(5)

NOVEMBER 12, 1963 LETTING


STATE OF IOWA  
 STATE HIGHWAY COMMISSION  
 DESIGN FOR  
**BRIDGES AND CULVERTS**  
**TRAINING ROAD SYSTEM**  
 PROJECT NO. F-34(5)  
**KEOKUK COUNTY**

DESIGN NO. 762	T - 76N R - 12W & T - 75N R - 12W OVER ROCK CREEK ON IOWA RELOCATED #92	STATION 518+70.00 VAN BUREN & SIGOURNEY TOWNSHIPS	
125'-0 X 30' CONTINUOUS CONCRETE SLAB BRIDGE 10° SKEW			
ESTIMATE OF QUANTITIES			
ITEM	UNIT	TOTAL	
Concrete	Cu. Yds.	312.9	
Reinforcing Steel	Lbs.	69,969	
16" P10A TYPE I or II or TYPE III or IV	Furnish 18 at 65' Drive 18 at 65'	Lin. Ft. 1,370	or
Piling	Furnish & Drive 18 at 50'	Lin. Ft. 900	
Crescoted Piling	11 at 45'; 11 at 50'	Lin. Ft. 1,045	
Class 20 Excavation	Cu. Yds.	120	
Granular Backfill	Tons	80	
4" Tile Subdrains	Lin. Ft.	100	
Class 10 Channel Excavation	Cu. Yds.	650	
Aluminum Handrail (C - C End Posts) or Steel Handrail (C - C End Posts)	Lin. Ft.	250	
Removal of Existing Structure	L. S.	LumpSum	
* Hauling & Storing Structural Steel	L. S.	LumpSum	
* NON-PARTICIPATING			

DESIGN NO. 662	T - 75N R - 13W T - 76N R - 13W OVER CEDAR CREEK ON IOWA NO. 92	STATION 282+45.00 WASHINGTON & WARREN TOWNSHIP	
180'-0 X 30'-0 PRETENSIONED PRESTRESSED CONCRETE BEAM BRIDGE			
ESTIMATE OF QUANTITIES			
ITEM	UNIT	TOTAL	
Concrete	Cu. Yds.	358.2	
Reinforcing Steel	Lbs.	67,381	
Prest. Conc. Beams 55'-0 (B-4)	Only	14	
Prest. Conc. Beams 67'-6 (B-7)	Only	7	
Crescoted Piling	26 at 45'	Lin. Ft. 1,170	
16" P10A TYPE I or II or TYPE III or IV	Furnish 32 at 35' Drive 32 at 35'	Lin. Ft. 1,120	
Crescoted Piling	26 at 45'	Lin. Ft. 1,170	
4" Tile Subdrain	Lin. Ft.	168	
Class 10 Channel Excavation	Cu. Yd.	1,925	
Class 20 Excavation	Cu. Yd.	145	
Class 21 Excavation	Cu. Yds.	250	
Removal of Existing Structure	L. S.	LumpSum	
Aluminum Handrail (C - C End Posts)	Lin. Ft.	341.0	
Steel Handrail (C - C End Posts)	Lin. Ft.	342.0	
* Hauling and Storing Structural Steel	L. S.	LumpSum	
Granular Backfill	Tons	145	
* NON-PARTICIPATING ITEM			

IOWA STATE HIGHWAY COMMISSION  
STANDARDS REQUIRED

CHP	C1P	CFP	C2J	P10A
CBH-00	C2P		C4J	
CBH-30	C3P		C5J	
	C4P		C6J	
	C5P		C10J	
	C6P		F2J	
	C10P		F3J	
	C6F		F4J	
	C10F		F5J	
			F6J	

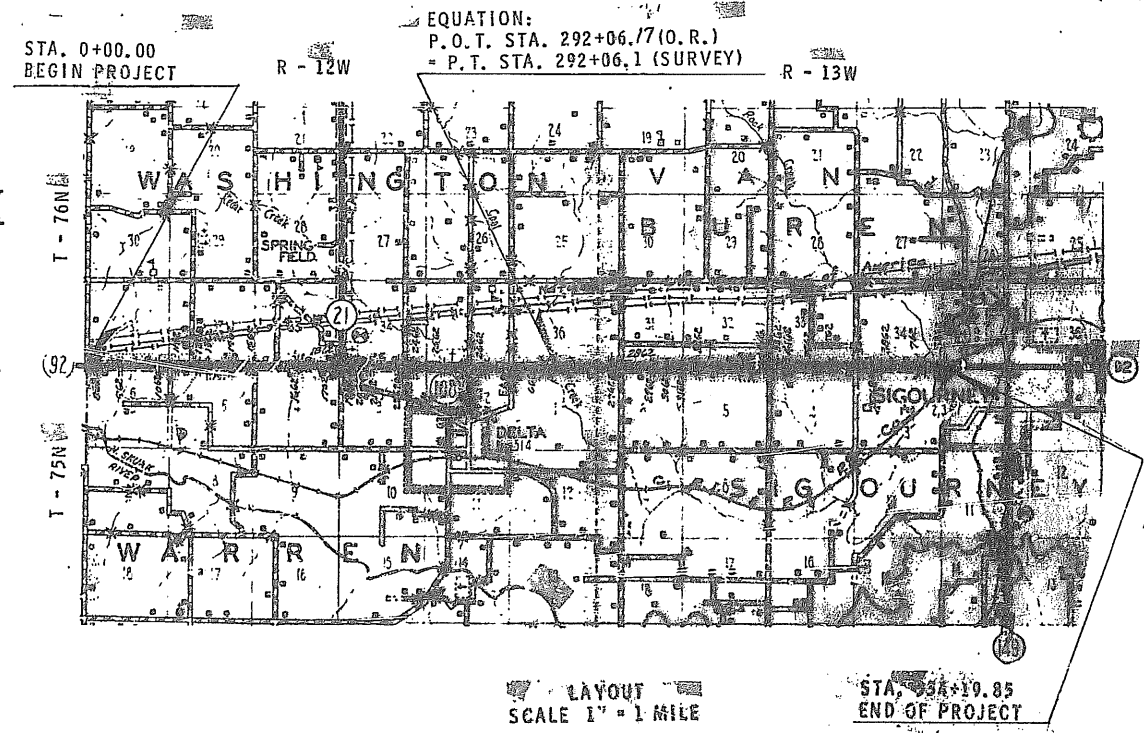

These bridges will require Bridge Sign Assemblies furnished and placed by others as specified in Traffic and Highway Planning Instruction No. 11, Revised October 1, 1961.

**DETAIL PLANS**  
**REDUCED IN SIZE**  
**(DO NOT SCALE)**

MILEAGE SUMMARY		
LOCATION	LIN. FT.	MILES
BRIDGE AT STA. 282+45.00	182,639	.635
BRIDGE AT STA. 518+70.00	127,651	.624
<b>Total</b>		<b>.659</b>

Excavation quant. changed. Total quantities corrected.

**SPECIFICATIONS:**

CONSTRUCTION: Standard Specifications of the Iowa State Highway Commission, Series of 1960, plus current Supplemental Specifications and Special Provisions.

DESIGN STRESSES for the following materials are in accordance with A. A. S. H. O. Standard Specifications for Highway Bridges, Series of 1961.

- Concrete in accordance with Section 1.4.11 f'c = 3500 psi.
- Reinforcing Steel in accordance with Section 1.4.12 "Reinforcement" for Intermediate, Hard, or Rail Steel Grade.
- Structural Steel in accordance with INT. 7(62); 1.4.2 "Structural Steel".
- Prestressed Concrete in accordance with Section 1.13.7 f'c = 5000 psi.
- Prestressing Steel in accordance with Section 1.13.7 f'c = 250,000 psi.

Revised 8-31-64 Sheet No 2 of 43 Sheet No 30 of 43  
 Revised 7-9-64:  
 Title Sheet 2 of 2 - Des. No's 4062 & 4162 added. Effected quantities changed accordingly.  
 Revised 7-9-64:  
 Sheet No 43A & Des. No's 4062 & 4162 added to project.

Revised: 2-4-64 Sheet 26 of 43 Design 962 bar size corrected - Sheet 28 of 43 Design 962 dimension corrected - Sheet 26 of 43 Design 2362 Junction details added.  
 Design 762 Revised 10-11-63: Listing of 16" P10A Piling corrected.  
 Revised 1-15-64, Design 2462 for grade line change. See Sheet 35 and title sheet 2 of 2

APPROVED:  
 R. M. Tetterton  
 DEPUTY CHIEF ENGINEER  
 IOWA HIGHWAY COMMISSION

DEPARTMENT OF COMMERCE  
 BUREAU OF PUBLIC ROADS

Revised 4-17-64 Sheet No 30 of 43 Des. No 1262 Flow Line elevations raised.





BILL OF REINFORCING STEEL - INLET TAPER						
MARK	LOCATION	SHAPE	NO.	LENGTH	LINEAR FT.	
					4	5
4a1	Walls: FFV		22	4'-9"	104.5	
*4b1	Walls: FFH		8	10'-1"	81.7	
4e2	Bottom Slab: Long		2	10'-9"	21.5	
*5f1	Top Floor: Long		5	10'-0"	50.0	
4h2	Bottom Slab: Trans.		25	3'-8"	104.2	
4m2	Top Floor: Trans.		24	4'-8"	112.0	
				LENGTH	423.9	50.0
				WEIGHT	283.2	58.2
				TOTAL WEIGHT	335.4	

\* Extensions from Std 4'x4' Hdwl. Add two longitudinal "d" bars (1/2" x 10'-8") in apron floor to support "e" bars. 14 lbs included in Reinf. Steel Quantity.

Add 20 dia lap on 3'x3' RCB longitudinal inlet bars. 7 lbs included in Reinf. Steel Quantity.




BENCH MARK NO. 10, Sta 314 + 65 Set RR Spike in power pole 99' Rt Elev = 742.14

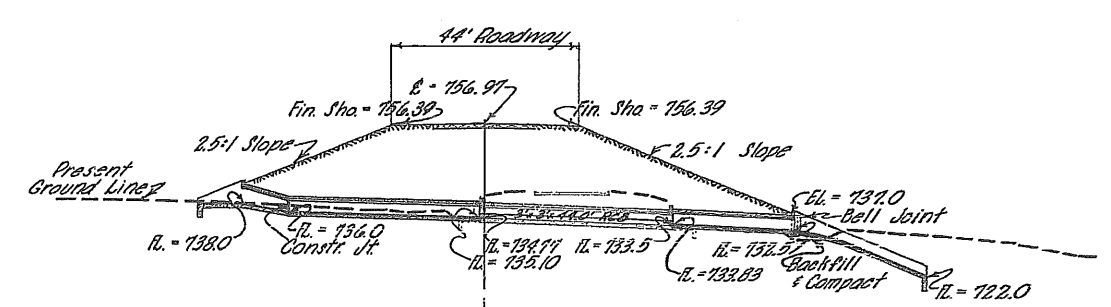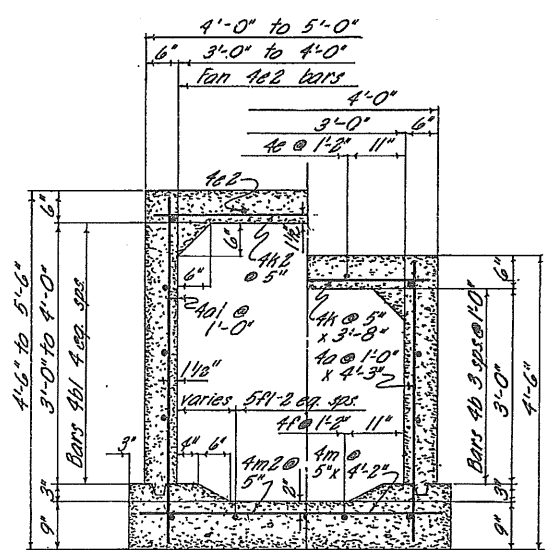

**FLUME DATA**  
 A = 2'-2 1/2", ΔC = 3'-0", B = 5'-11 13/16", S = 33'-10 7/16", V = 2'-5 1/16",  
 W = 12'-6 9/16", L3 = 11'-6 3/8", D = 5'-11 1/16", E = 5'-6 1/16",  
 P.C. El. = 732.5, P.I. El. = 732.19, P.P. El. = 731.90, P.T. El. = 729.97  
 X1 = 1'-11 3/16", X2 = 1'-1 1/16", X3 = 0'-5 13/16", X4 = 0'-1 7/16", X5 = 2'-10 5/8"


Quantities per ft. of bbl.  
 Concrete = 3.44 C.Y.  
 Reinf. Steel = 26.25 lbs.

VAR. HALF CROSS SEC. THRU INLET TAPER SCALE: 3/4" = 1'  
 HALF CROSS SEC. THRU 3' x 3' BBL. SCALE: 3/4" = 1'

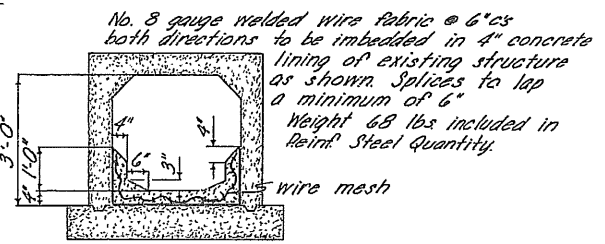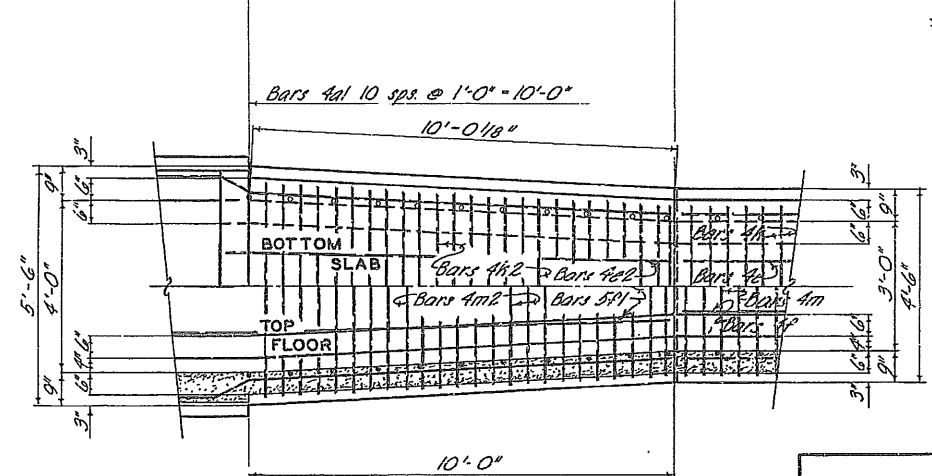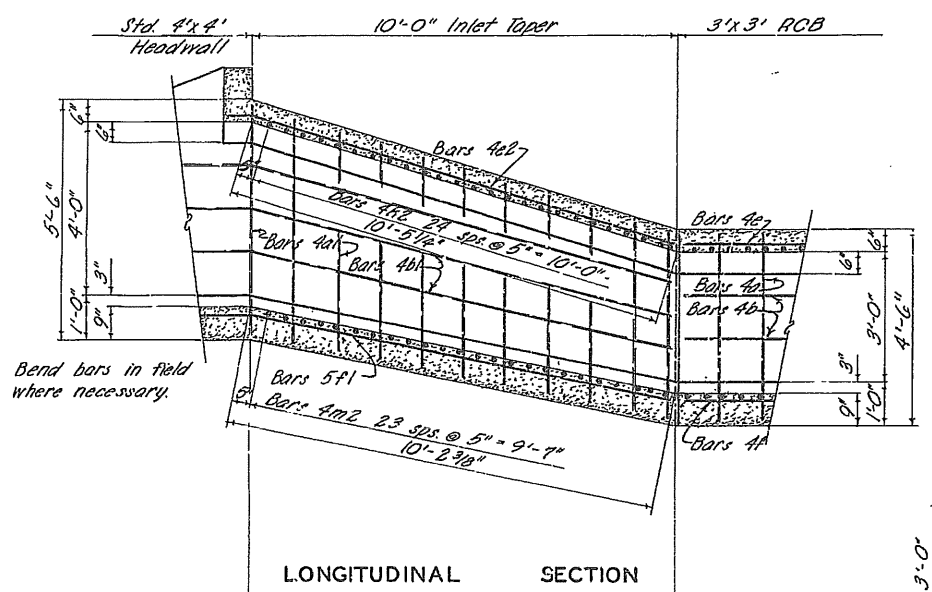

CONCRETE IN PARTS			
LOCATION	ABOVE KEYWAY	BELOW KEYWAY	TOTAL
HEADWALL	1.91	2.59	4.50
INLET TAPER 10'-0"	2.22	1.64	3.86
BARREL - 73.34' + PPT	14.34	10.97	25.31
JCT. BELL JOINT	.31	.38	.69
FLUME	3.10	5.08	8.18
LINER	2.82		2.82
TOTAL	25.30	20.66	45.96

TOTAL QUANTITIES		
CONCRETE	46.0	C.Y.
REINFORCING STEEL	3199	LBS.
CL. 20 EXCAVATION	67	C.Y.
CL. 10 EXCAVATION (CHANNEL)	62	C.Y.

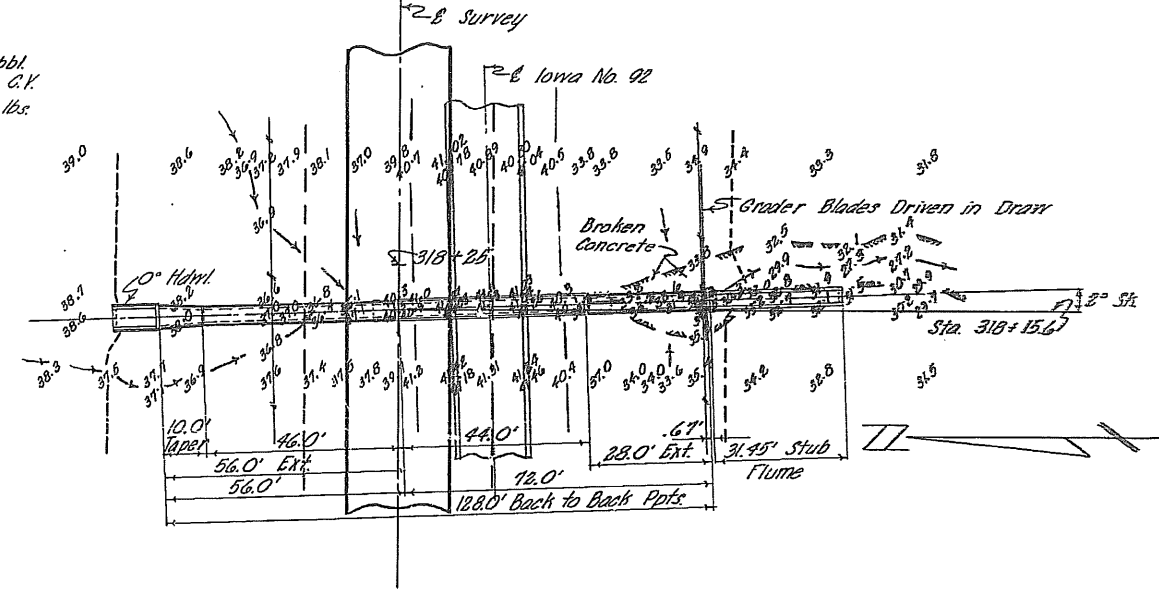

SITUATION PLAN SCALE: 1" = 20'

LOCATION SECTION 31 & 6 - T 76 & 75N - R 12W TOWNSHIP VAN BUREN & SIGOURNEY COUNTY KEOKUK

DRAINAGE AREA = 44 AC. H. FILL = 18'

DESIGN FOR 3' x 3' RCB EXTENSION & STUB FLUME - 2° SK.

STA. 318 + 15.6 PROJECT NO. F-34 (5)

KEOKUK COUNTY

IOWA STATE HIGHWAY COMMISSION

MAY 1963 SCALES AS NOTED

SHEET 1 OF 1

Cult. Contr. to remove portions of broken concrete and grader blades interfering with new construction. Include in price bid for removals.


See Miscellaneous Details Sheet No 17 of 43 for Flume excavation detail, section thru flume, flume curve data, and stub flume curtain detail.

For notes and details not shown, see Iowa State Highway Commission Sta's: CHQ, CSR, CRQ, F31.

Cult. Contr. to break existing hdwls to front of ppt. and extend with 3'x3' RCB. Incorporate exposed reinf. steel into new work.

STATE	FED. ROAD DIST. NO.	FISCAL YEAR	SHEET NO.	TOTAL SHEETS
IOWA	5		1	261
PROJECT NUMBER				
F-92-8(3)--20-54				
R.O.W. PROJECT NUMBER				
FN-92-8(3)--21-54				

KEOKUK COUNTY  
 GRADING-P.C.C. PAVING AND A.C. RESURFACING  
 P.C.C. PAVEMENT WIDENING  
 GRADING (SHOULDERING)  
 LIGHTING

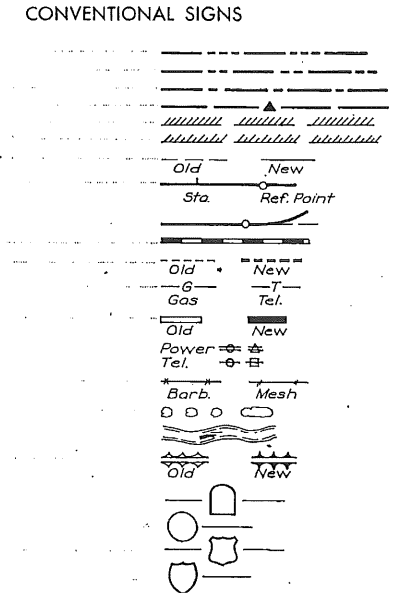

## STATE OF IOWA STATE HIGHWAY COMMISSION

PLANS OF PROPOSED IMPROVEMENT  
ON THE

# PRIMARY ROAD SYSTEM KEOKUK COUNTY

## GRADING-P.C.C. PAVING AND A.C. RESURFACING P.C.C. PAVEMENT WIDENING GRADING (SHOULDERING) LIGHTING

SCALES: AS NOTED

THE IOWA STATE HIGHWAY COMMISSION STANDARD SPECIFICATIONS  
FOR CONSTRUCTION WORK, SERIES OF 1964 SHALL  
APPLY TO WORK ON THIS PROJECT


ON IA. #92 FROM 1/2 MILE WEST IA. NO. 159 TO THE INTERSECTION WITH IA. NO. 77

CONSTRUCTION PLANS SHOWING PROJECT AS BUILT  
 ONE COPY PREPARED BY James W. Edgerton DATE 4/2/70  
 ONE COPY APPROVED & FORWARDED TO AMES DATE 5-25-70  
James W. Edgerton DISTRICT ENGINEER, CONSTRUCTION  
 TWO COPIES TO BE MADE AND RETURNED TO:  
Virgil Butler DISTRICT ENGINEER  
Charles Holmes RESIDENT MAINT. ENGINEER

INDEX OF SHEETS		105-3
NO.	DESCRIPTION	
1	TITLE SHEET	
1A	TABULATION OF REVISIONS	
2, 3	TYPICAL SECTIONS	
4-6	ESTIMATE OF QUANTITIES AND GENERAL INFORMATION	
7-15	PLAN AND PROFILE STA. 448+00 TO STA. 709+86	
16, 17	PLAN AND PROFILE SIDE ROADS	
18, 19	REFERENCE INFORMATION AND BENCH MARKS	
20	STAKE-OUT OF INTERSECTION OF IA. #92 AND IA. #159	
21	JOINTING DETAILS OF INTERSECTION OF IA. #92 AND IA. #159	
22	HIGHWAY LIGHTING LAYOUT INTERSECTION IA. #92 AND IA. #159	
23	TABULATION OF DRAINAGE STRUCTURES, AND TABULATION OF SUBGRADE TREATMENTS	
24	DETAILS OF DRAINAGE STRUCTURES	
25-35	SOILS SHEETS	
36-40	TABULATION OF QUANTITIES AND ADJUSTMENTS	
41-71	STANDARD ROAD PLANS	
72-77	STANDARD LIGHTING PLANS	
78-261	CROSS SECTIONS	

MILEAGE SUMMARY				105-1	STATE CONTROL SECTION NO.
DIV.	LOCATION	LIN. FT.	MILES		
	RURAL KEOKUK COUNTY, STA. 448+00.00 TO STA. 709+86.00 DEDUCT BRIDGE STA. 587+36	26,186.00 174.67			
	NET LENGTH OF ROADWAY	26,011.33	4.926		
	NET LENGTH OF BRIDGE	174.67	0.033		
	TOTAL NET LENGTH OF PROJECT	26,186.00	4.959		54-0400

THIS PROJECT LET AS PROJECT NO.  
FN-92-8(3)--21-54

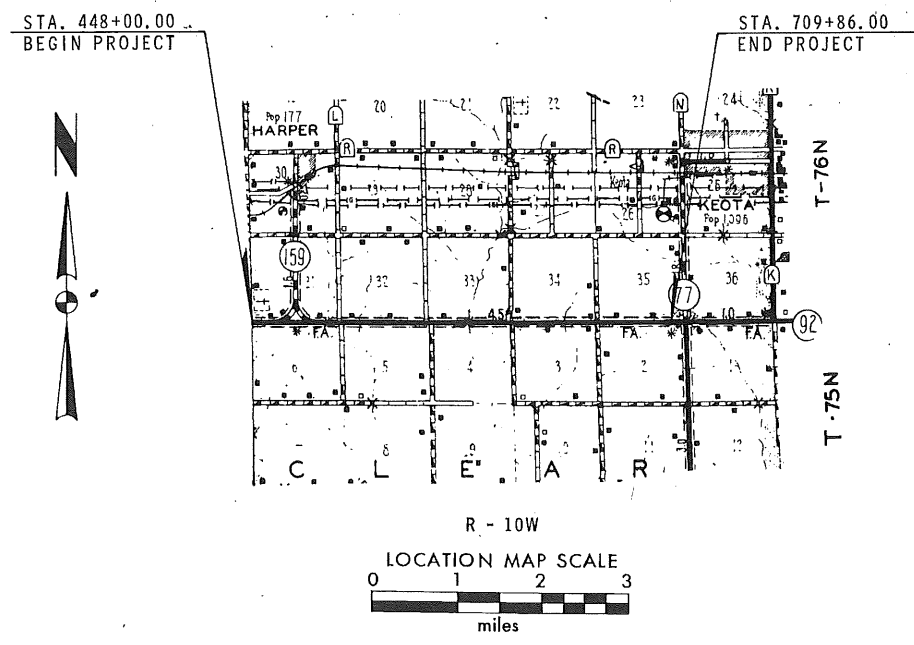

STANDARD ROAD PLANS					
NUMBER	DATE	NUMBER	DATE	NUMBER	DATE
RA-13	11-24-66	RF-2	5-1-64	RM-2	12-23-67
RA-16	4-15-66	RF-3	11-16-60	RM-7	4-22-63
RC-1	11-28-66	RF-4	8-6-63	RM-22	2-9-67
RC-2	11-28-66	RF-5	6-4-63	RM-7	9-1-66
CO-17	12-27-64	RF-7	11-2-63	AL-1	3-14-65
RE-1	12-14-64	RF-13	12-2-64	AL-3	11-16-64
RE-2	8-11-64	RF-14	12-1-64	AL-4	4-13-66
RE-7	3-25-66	RF-20	1-8-65	RM-1	3-27-67
RE-8	3-23-66	RF-22	4-24-65	RA-2A	1-27-67
RE-9	10-23-66	RF-23	7-15-64	RM-2B	10-27-67
RF-1	7-1-64	RF-3	3-1-62	RA-7A	9-24-65

STANDARD ROAD PLANS					
NUMBER	DATE	NUMBER	DATE	NUMBER	DATE
RA-11	1-26-67				
RA-12	9-24-65				

101-4

**DESIGN DATA RURAL**

196.7 AADT 1457 V.P.D.  
 198.7 AADT 1797 V.P.D.  
 198.7 DHV 196 V.P.H.  
 DIRECTIONAL 53 %  
 TRUCKS 10 %  
 DESIGN V 60 M.P.H.  
 PARTIAL ACCESS CONTROL

REVISED: SEE FOLLOWING SHEET 1-A

I HEREBY CERTIFY THAT THIS PLAN WAS PREPARED UNDER MY SUPERVISION AND THAT ENGINEERING DECISIONS WITH REGARD TO THE DESIGN WERE MADE BY ME OR BY OTHER DULY REGISTERED PROFESSIONAL ENGINEERS UNDER THE LAWS OF THE STATE OF IOWA.

J. Williams  
DATE April 17 1967 IOWA REG. NO. 4133

APPROVED

[Signature]  
DEPUTY CHIEF ENGINEER  
IOWA HIGHWAY COMMISSION

DATE

DEPARTMENT OF COMMERCE  
BUREAU OF PUBLIC ROADS






APPROVED









\_\_\_\_\_  
DIVISION ENGINEER

DATE

79 SHEETS






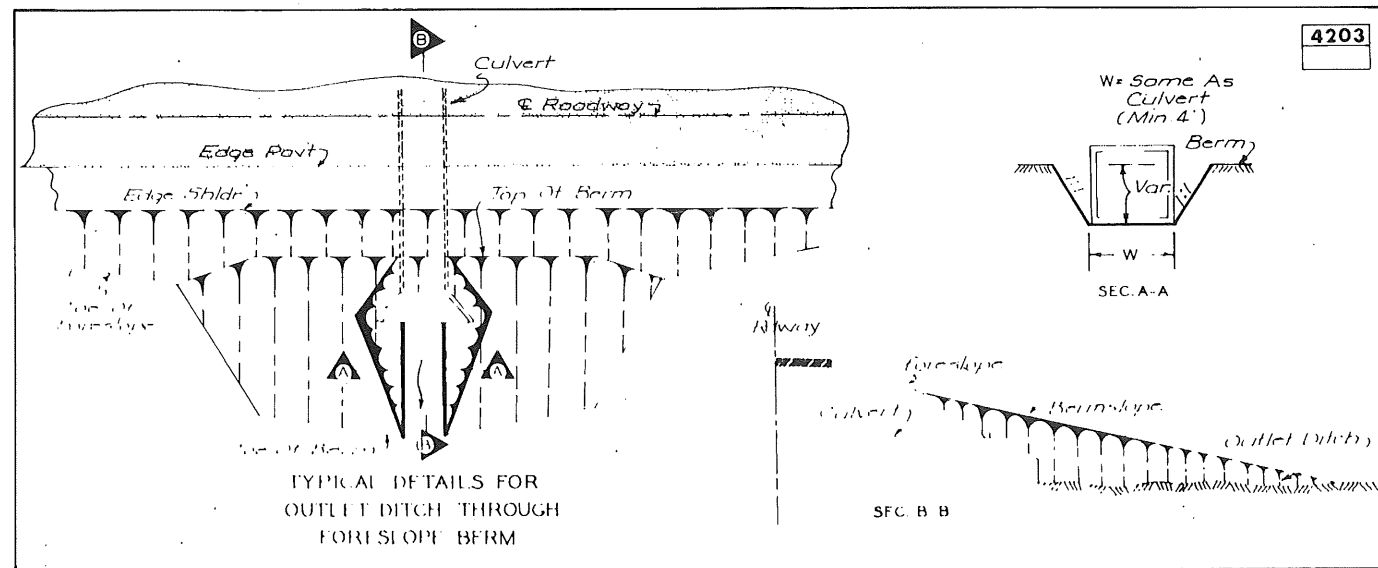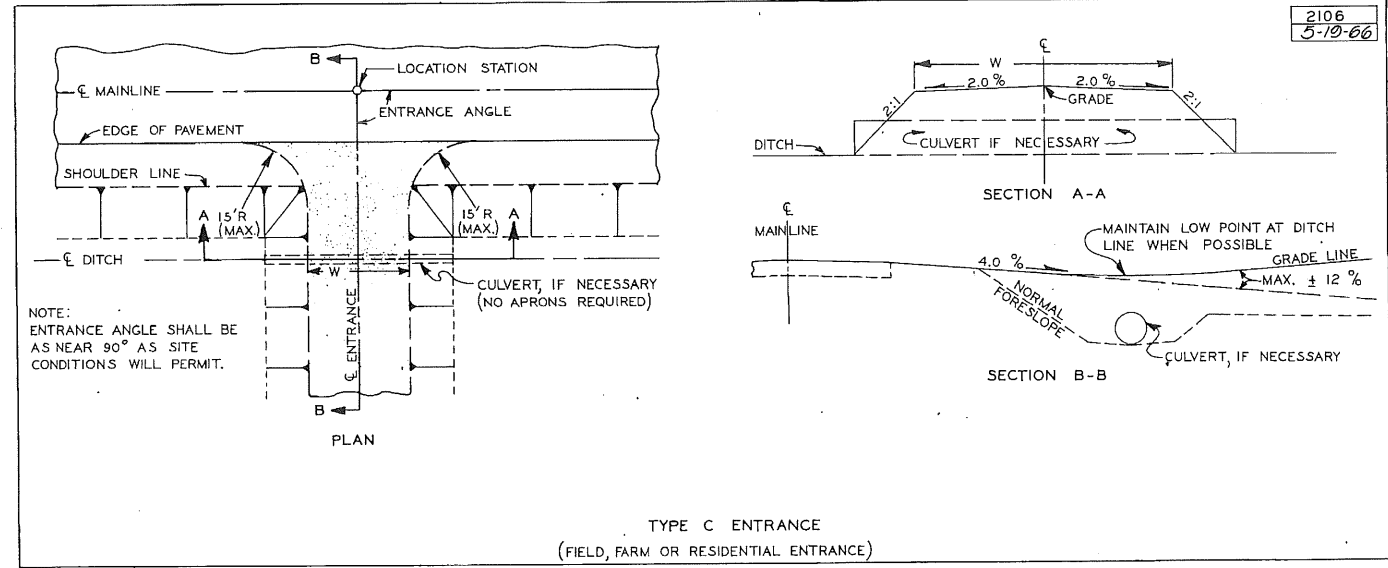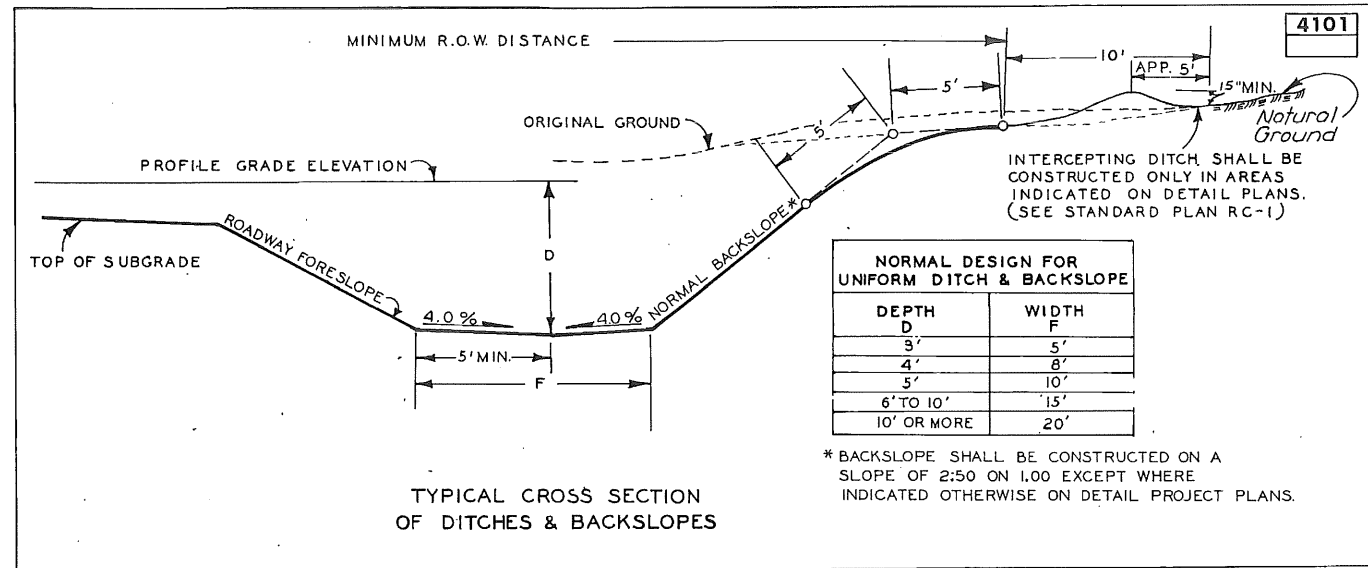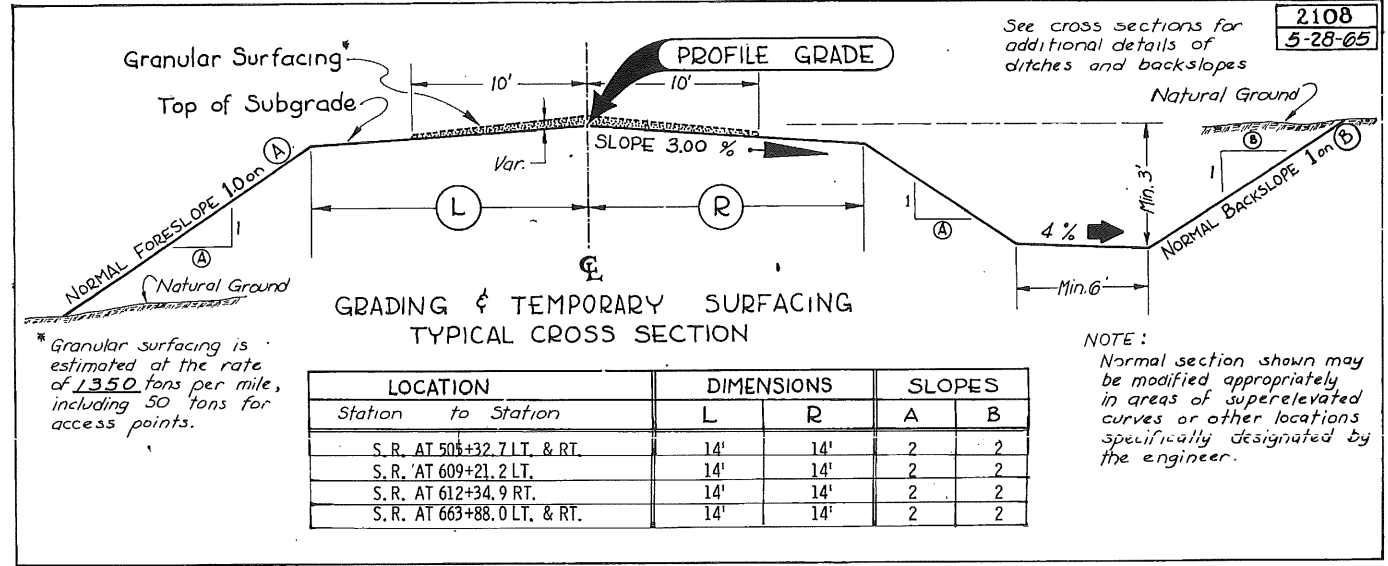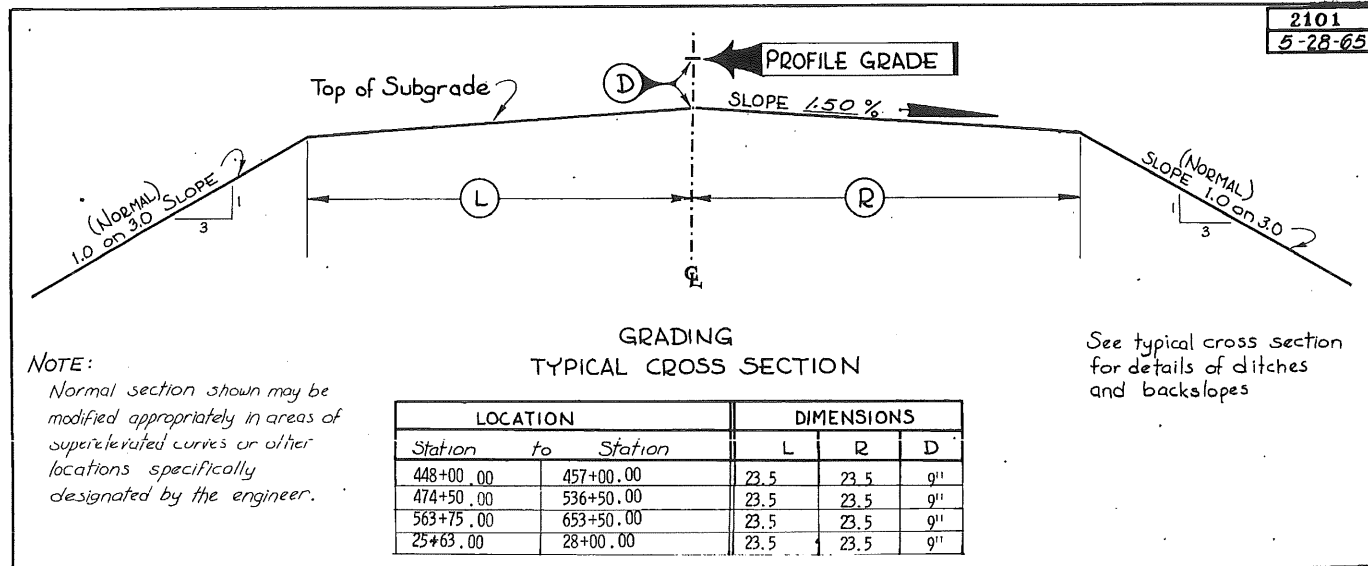


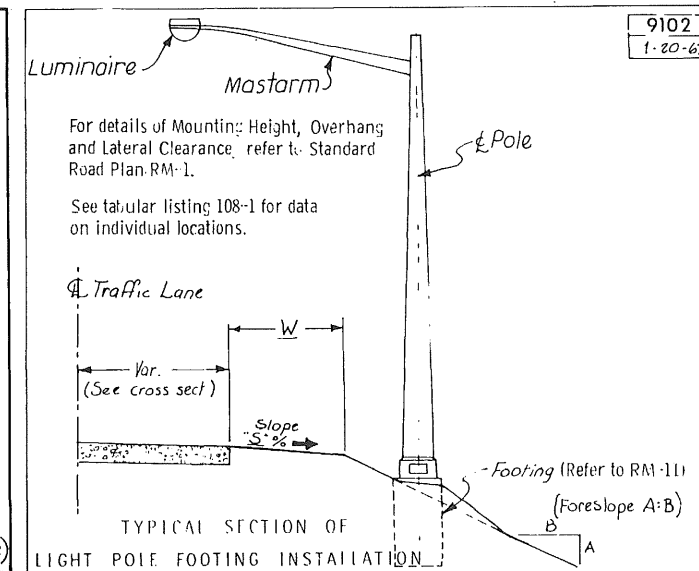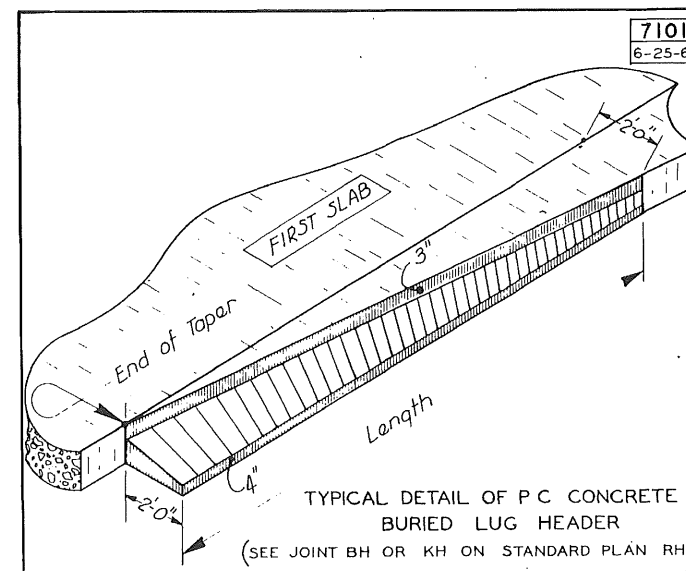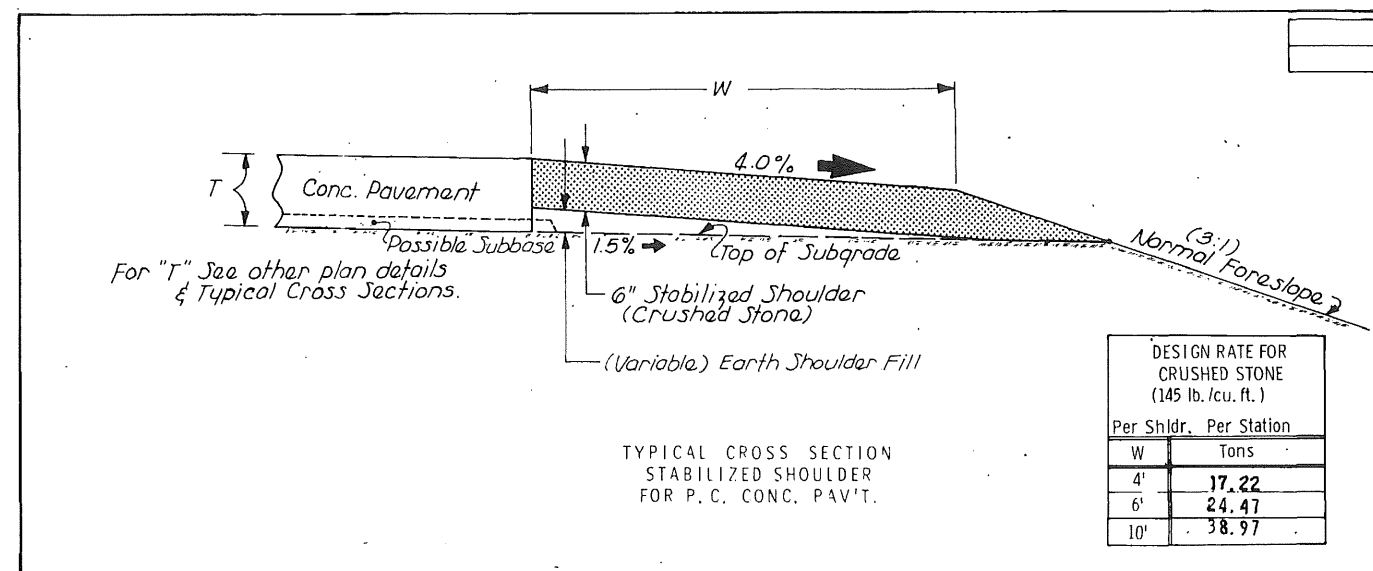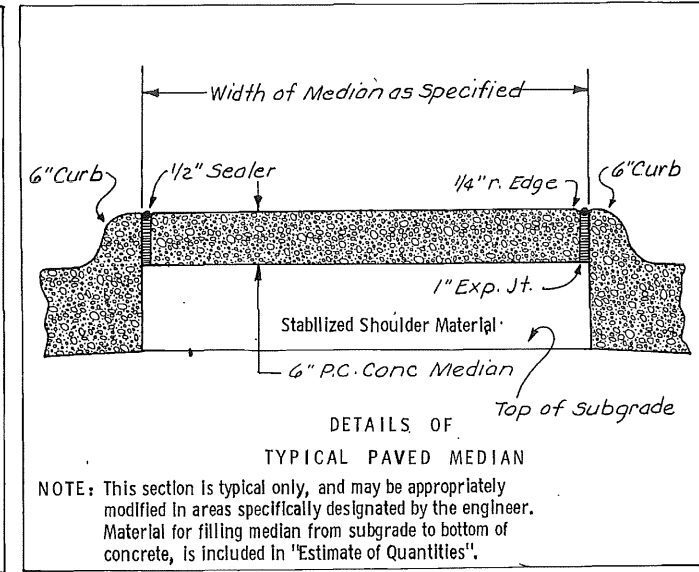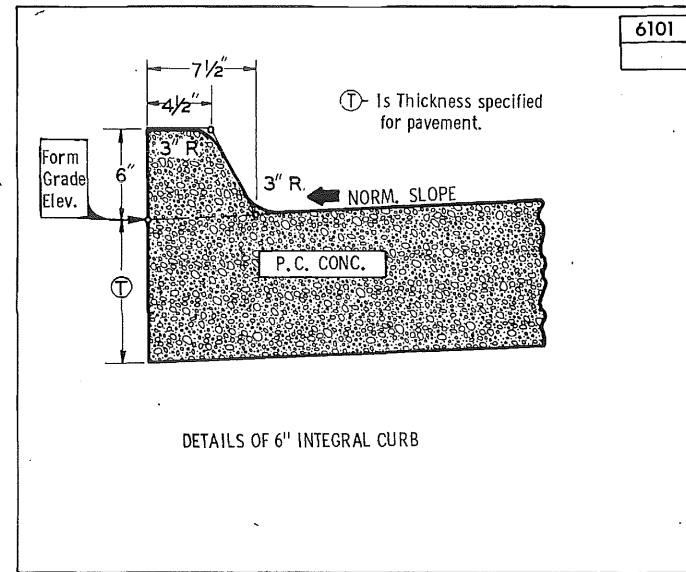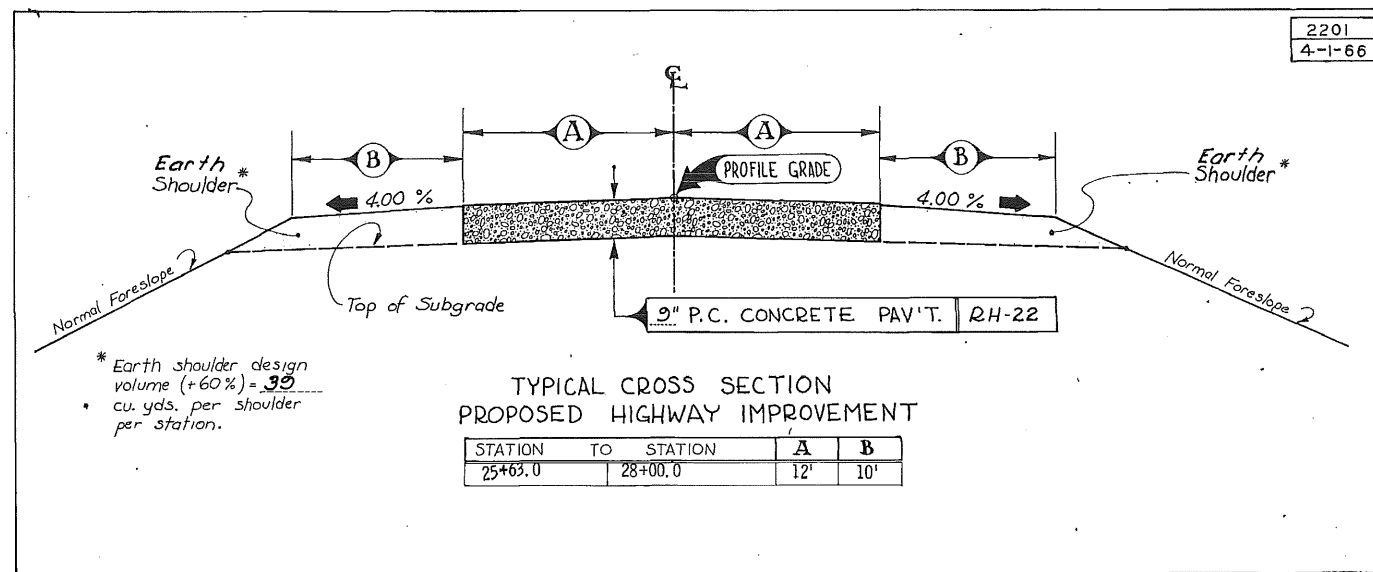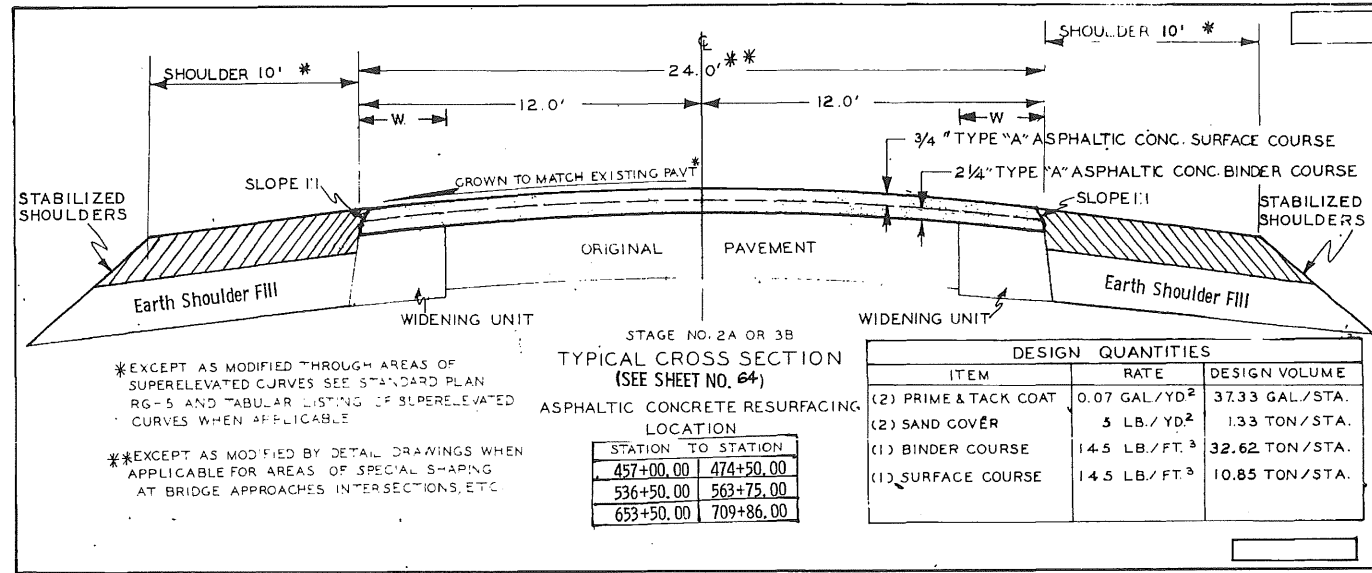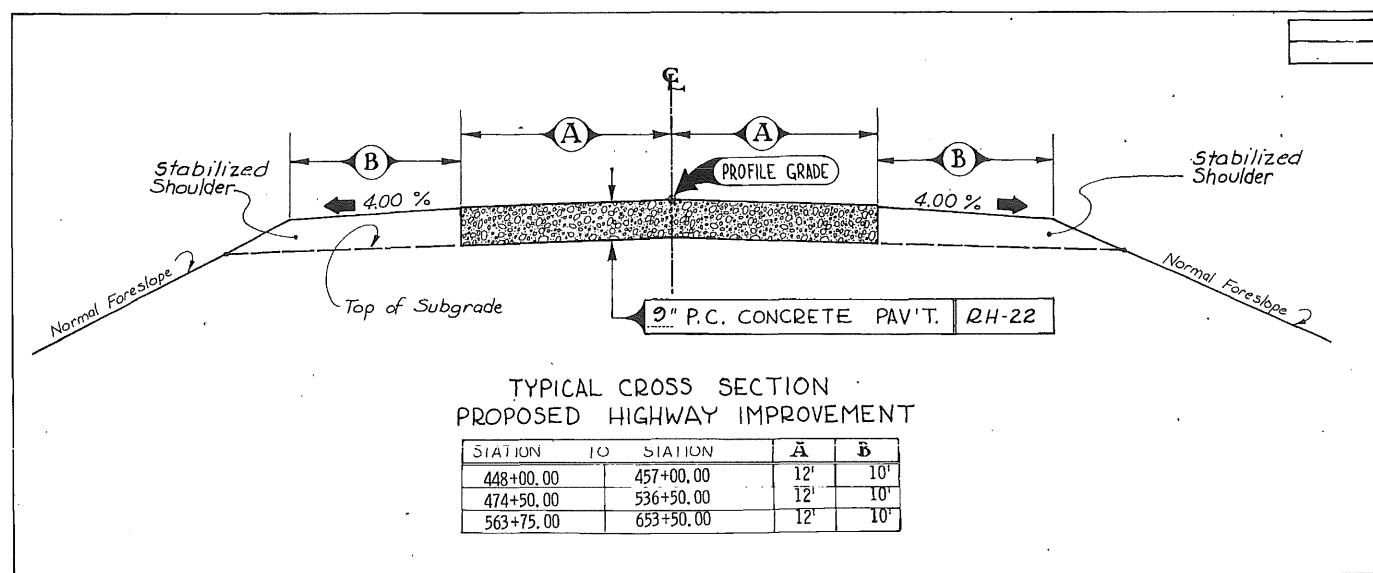

DATE	BY


DATE	BY

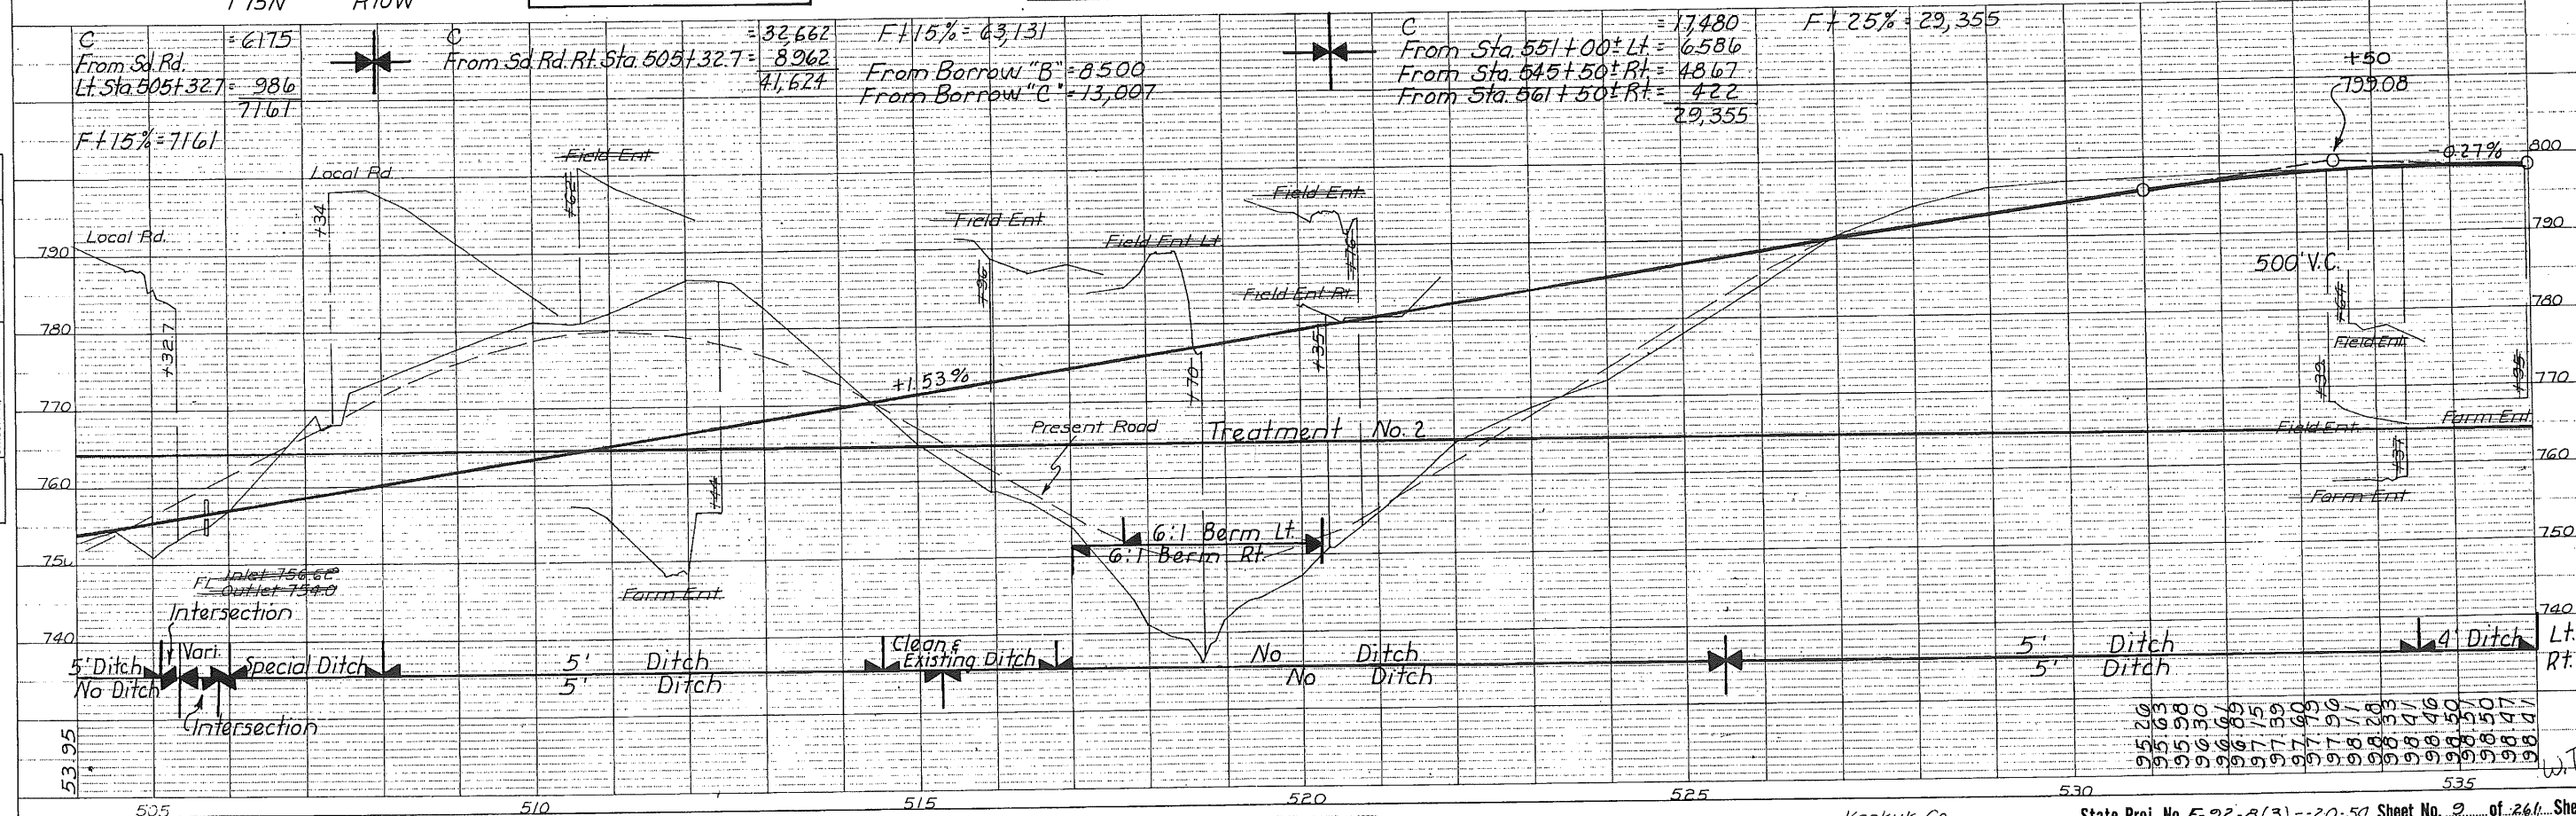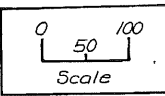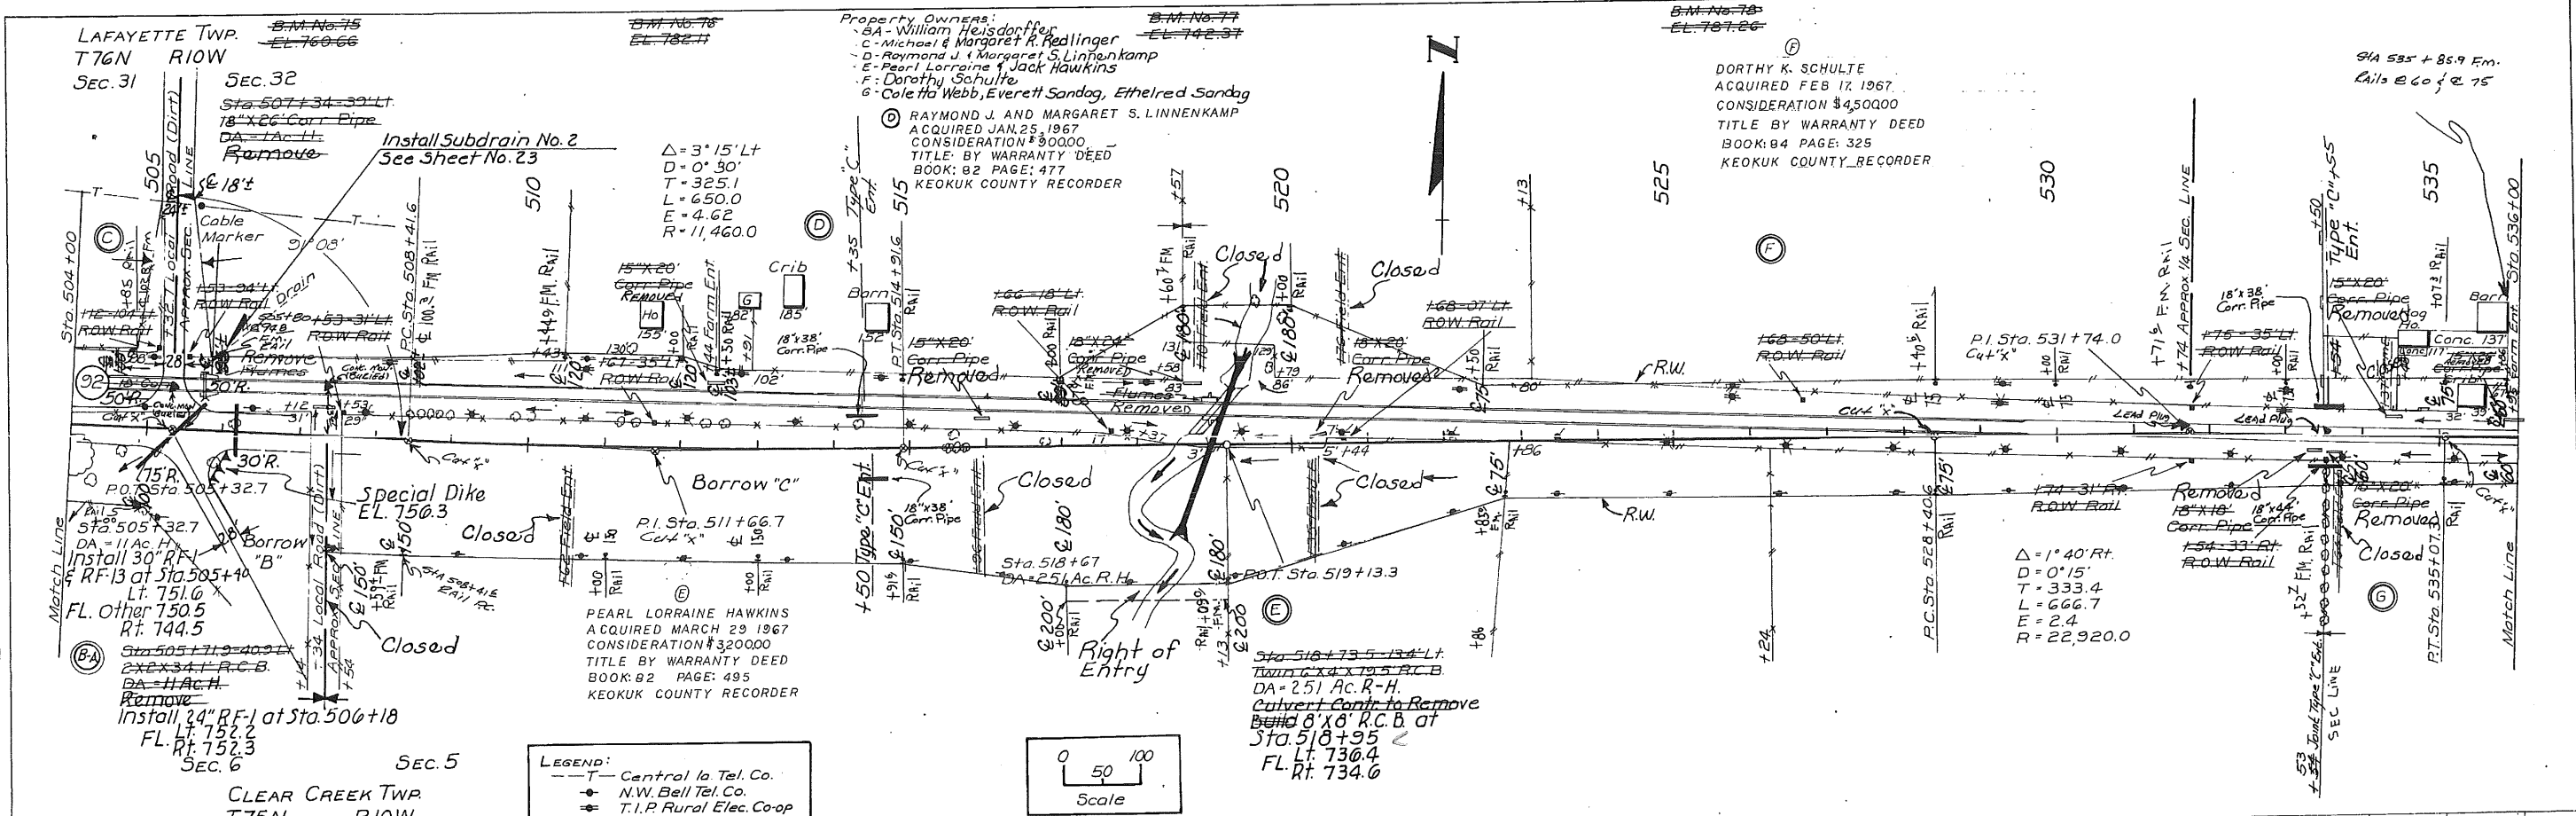

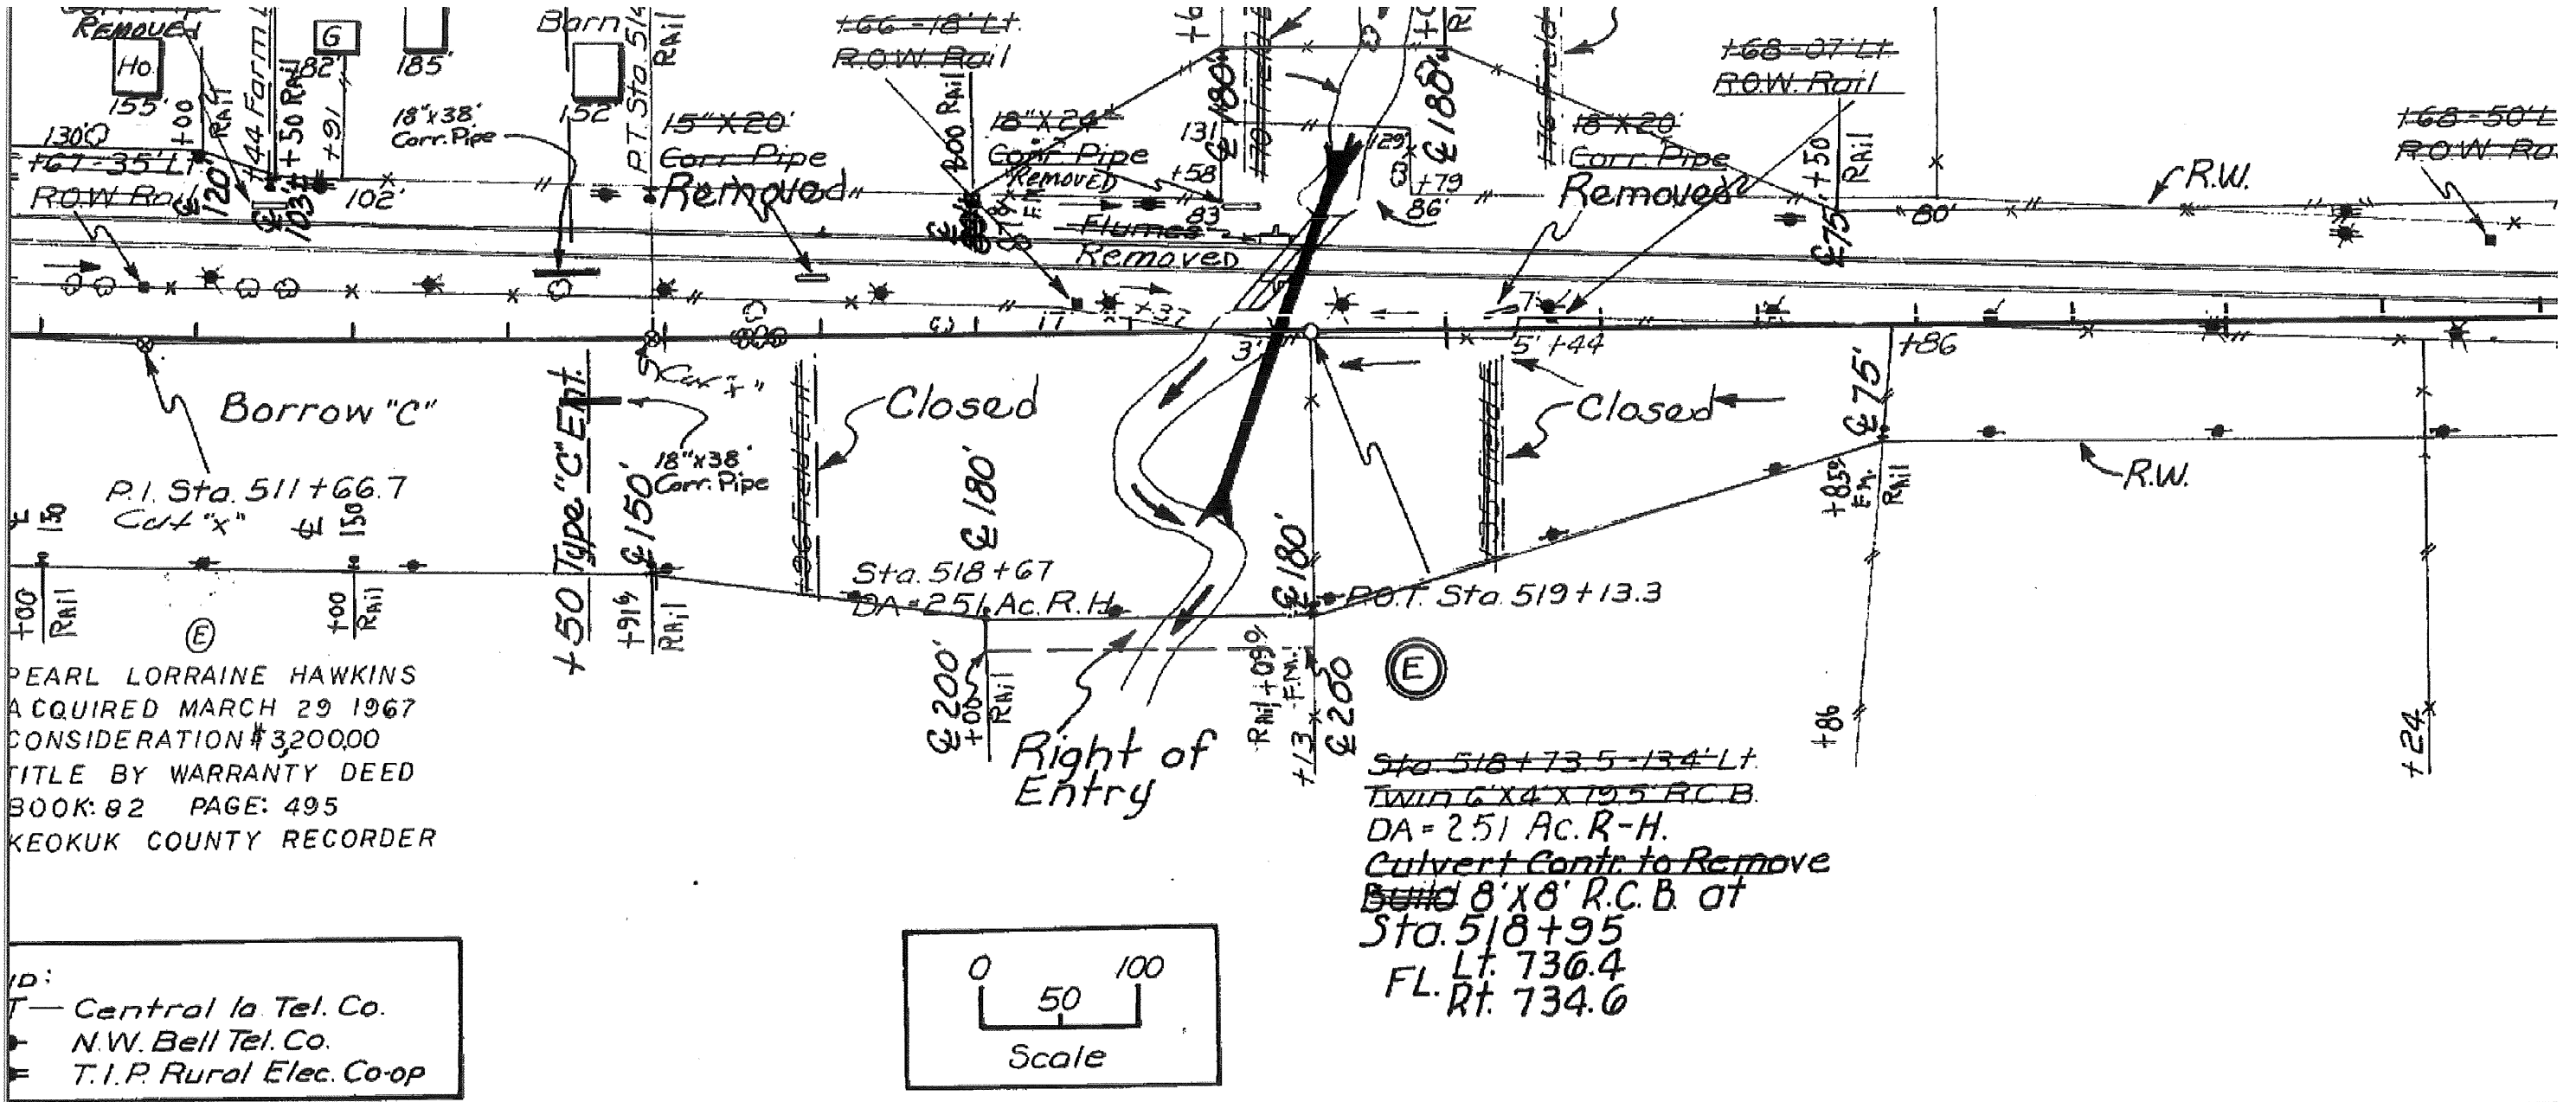

PEARL LORRAINE HAWKINS  
 ACQUIRED MARCH 29 1967  
 CONSIDERATION \$320000  
 TITLE BY WARRANTY DEED  
 BOOK: 82 PAGE: 495  
 KEOKUK COUNTY RECORDER

- id:  
 T— Central Ia. Tel. Co.  
 N.W. Bell Tel. Co.  
 T.I.P. Rural Elec. Co-op

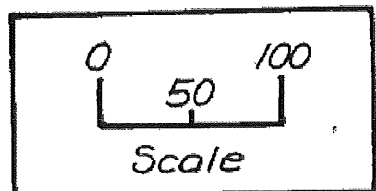

Sta. 518+73.5-134' Lt.  
 TWIN 6' X 4' X 19.5' R.C.B.  
 DA = 2.51 Ac. R-H.  
 Culvert Contr. to Remove  
 Build 8' X 8' R.C.B. at  
 Sta. 518+95  
 FL. Lt. 736.4  
 Rt. 734.0

STATE	FED. ROAD DIST. NO.	FISCAL YEAR	SHEET NO.	TOTAL SHEETS
IOWA	5		1	29
PROJECT NUMBER				
FN-92-B(3)-21-54				
FN-92-B(3)-21-54 (R.O.W.)				

KEOKUK COUNTY


BRIDGE AND CULVERTS

LETTING DATE

May 23-1967

- State Line
- Co. Line
- Top. Line
- Sec. Line
- Corp. Line
- Urban Bdry.
- R.O.W. Lines
- Survey Line
- Profile Grade
- Railroad
- Field Tile
- Underground Lines
- Culverts
- Utility Poles
- Fences
- Trees Or Brush
- Stream
- Dike
- County Road No.
- Primary Road No.
- U. S. Road No.
- Interstate Road No.

CONVENTIONAL SIGNS

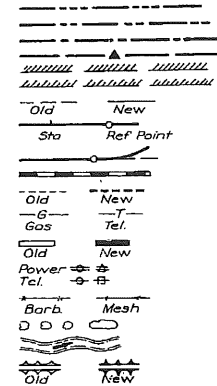

STATE OF IOWA STATE HIGHWAY COMMISSION

PLANS OF PROPOSED IMPROVEMENT ON THE

PRIMARY ROAD SYSTEM KEOKUK COUNTY BRIDGE AND CULVERTS

0.5 MILES W. OF IA. 159 E. TO IA. 77


THE IOWA STATE HIGHWAY COMMISSION STANDARD SPECIFICATIONS FOR CONSTRUCTION WORK, SERIES OF 1964 SHALL APPLY TO WORK ON THIS PROJECT

(PLUS CURRENT SUPPLEMENT SPECIFICATIONS AND SPECIAL PROVISIONS)

DESIGN STRESSES for the following materials are in accordance with A. A. S. H. O. Standard Specifications for Highway Bridges, Series of 1961.

- Concrete in accordance with Section 1.4.11  $f_c = 3500$  psi.
- Reinforcing Steel in accordance with Section 1.4.12
- Reinforcement for Intermediate, Hard, or Rail Steel Grade
- Prestressed Concrete in accordance with Section 1.13.7  $f_c = 5000$  psi.
- Prestressing Steel in accordance with Section 1.13.7  $f_s = 270,000$  psi.

INDEX OF SHEETS		105-3
NO.	DESCRIPTION	
1.	TITLE SHEET	
2	ESTIMATE SHEET	
3	MISCELLANEOUS DETAIL SHEET	
4	MISCELLANEOUS DETAIL SHEET	
5	MISCELLANEOUS DETAIL SHEET	
6	MISCELLANEOUS DETAIL SHEET RF-1	
7	MISCELLANEOUS DETAIL SHEET RF-2	
8	MISCELLANEOUS DETAIL SHEET RF-3	
9	MISCELLANEOUS DETAIL SHEET RF-4	
10	MISCELLANEOUS DETAIL SHEET RF-13	
11	MISCELLANEOUS DETAIL SHEET RF-14	
12-18	BRIDGE DESIGN NO. 365	
19	CULVERT DESIGN NO. 'S 465 - 565 - 665	
20-21	CULVERT DESIGN NO. 765	
22	CULVERT DESIGN NO. 865	
23	CULVERT DESIGN NO. 'S 965 - 1065 - 1265	
24	CULVERT DESIGN NO. 'S 1165 - 1465	
25	CULVERT DESIGN NO. 1365	
26	CULVERT DESIGN NO. 1565	
27	CULVERT DESIGN NO. 'S 1665 - 2265	
28	CULVERT DESIGN NO. 'S 1765 - 1965 - 2065 - 2165	
29	CULVERT DESIGN NO. 1865	

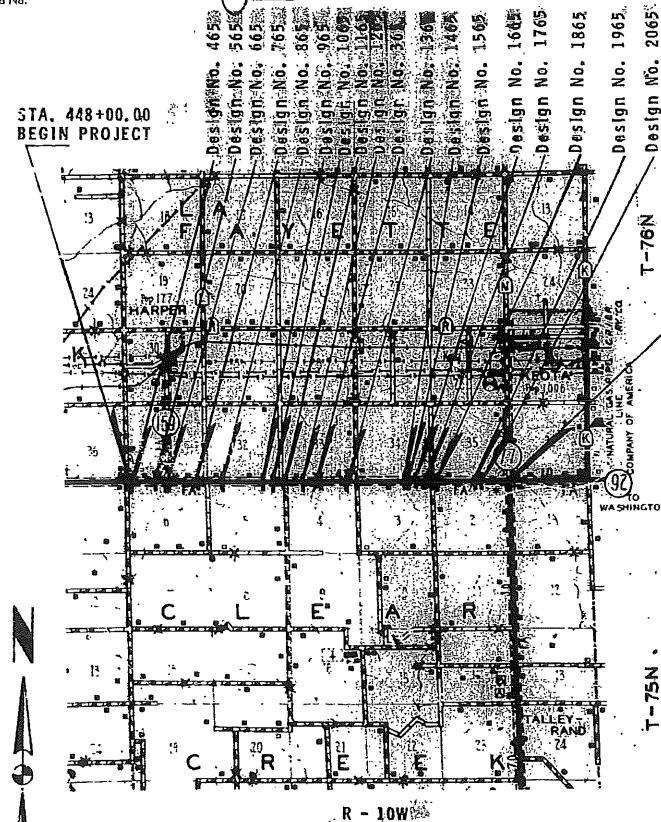

STA. 709+86.00 END PROJECT

NO MILEAGE SUMMARY

IOWA STATE HIGHWAY COMMISSION STANDARDS REQUIRED (Available at the I. S. H. C. Storeroom)

STANDARD	ISSUED	REVISED
C1P	1932	1944
C2P	1932	1944
C3P	1932	1944
C4P	1932	1944
C5P	1932	1944
F4J		1964
C4J	1959	1964
C8J	1959	1964
C6F	1952	1955
C8F	1952	1955
C12F	1952	1955
CFP	1945	
CBH-00	1960	
CBH-15	1960	
CHP2, 5-65	1965	
P10A	1959	

REVISED: \_\_\_\_\_

APPROVED: *[Signature]* 4/17/67  
DEPUTY CHIEF ENGINEER  
IOWA HIGHWAY COMMISSION

I HEREBY CERTIFY THAT THIS PLAN WAS PREPARED UNDER MY SUPERVISION AND THAT ENGINEERING DECISIONS WITH REGARD TO THE DESIGN WERE MADE BY ME OR BY OTHER DULY REGISTERED PROFESSIONAL ENGINEERS UNDER THE LAWS OF THE STATE OF IOWA.

DATE *April 11, 1967* IOWA REG. NO. *2192*

DEPARTMENT OF COMMERCE  
BUREAU OF PUBLIC WORKS

APPROVED: \_\_\_\_\_  
SUPERVISOR

STATE CONTROL SECTION NUMBER 54-0900



STATE	FED. ROAD DIST. NO.	FISCAL YEAR	SHEET NO.	TOTAL SHEETS
IOWA	5		1	29



I HEREBY CERTIFY THAT THIS PLAN WAS PREPARED BY ME OR UNDER MY DIRECT PERSONAL SUPERVISION AND THAT I AM A DULY REGISTERED PROFESSIONAL ENGINEER UNDER THE LAWS OF THE STATE OF IOWA.

*Donald K. Schulze*  
DONALD K. SCHULZE  
DATE 4-13-67 REG. NO. 2793

DESIGN NO. 365 IOWA #92 STA. 587+36  
SECTIONS 33 & 4 OVER CLEAR CREEK  
7-75 & 76 N R-10W LAFAYETTE & CLEAR CREEK TOWNSHIP

THIS BRIDGE WILL REQUIRE BRIDGE SIGN ASSEMBLIES, FURNISHED AND PLACED BY OTHERS, AS SPECIFIED IN SECTION 2 C-5 OF THE I. S. H. C. MANUAL ON "UNIFORM TRAFFIC CONTROL DEVICES", DATED JANUARY 1963.

172'-2 x 30'-0 PRETENSIONED PRESTRESSED CONCRETE BEAM BRIDGE

ESTIMATE OF QUANTITIES

ITEM	UNIT	TOTAL	
Structural Concrete	Cu. Yds.	253.2	
Reinforcing Steel	Lbs.	56,007	
Aluminum Handrail	L.F.	351	
Steel Handrail	L.F.	351	
Granular Backfill	Cu. Yds.	80	
4" Tile Subdrain	L.F.	160	
Class 20 Excavation	Cu. Yds.	58	
12BP53 Steel	Furnish	L.F.	440
Bearing Piling	Drive	L.F.	440
	Encase	L.F.	250
10BP42 Steel	Furnish	L.F.	440
Bearing Piling	Drive	L.F.	440
Preten. Prestressed Conc. Beam (50'-10; B-5)	No.	10	
Preten. Prestressed Conc. Beam (67'-6; B9)	No.	5	
Channel Excavation Class 10	Cu. Yds.	600	
Removal of Existing Structure	L.S.	Lump Sum	

(1) 231.8 c.y. Structural Concrete Class D for Superstructure, and 21.4 c.y. Class "C" for Substructure.

I HEREBY CERTIFY THAT THESE PLANS HAVE BEEN PREPARED BY ME OR UNDER MY DIRECT PERSONAL SUPERVISION AND THAT I AM A DULY REGISTERED PROFESSIONAL ENGINEER UNDER THE LAWS OF THE STATE OF IOWA.

*A. E. Derby*  
A. E. DERBY  
IOWA REGISTRATION NO. 3049 DATE April 13, 1967


DESIGN	LOCATION			DESCRIPTION	ESTIMATE OF QUANTITIES													REMOVALS	
	SECTION	TOWNSHIP	STATION		SIZE AND TYPE	STRUC. CONC. CL. "C" CU. YD.	REINF. STEEL LBS.	EXCAVATION - C. Y.			CONCRETE ROADWAY PIPE CULVERT LIN. FT.		CONCRETE APRONS NO.		CONC. HALF PIPE LIN. FT.	CONNECT-ED PIPE JOINTS NO.	CONCRETE ELBOWS NO.		CORR. METAL PIPE SUBDRAIN LIN. FT.
								CL. 20	CL. 24	CL. 10 CHAN.	30" & 42" & 6"	30" & 42" & 6"	30"	30"					
465	31-6	LA FAYETTE - CLEAR CREEK	449+64	4' x 5' x 110' Reinforced Concrete Box Culvert with Flume	75.3	6,876	167												
565	31-6	LA FAYETTE - CLEAR CREEK	468+61.5	5.0' x 3.0' Reinforced Concrete Box Culvert Ext.	15.4	1,402	15											As Per Plan	
665	31-6	LA FAYETTE - CLEAR CREEK	475+48.2	2' x 2' Reinforced Concrete Box Culvert Ext.	8.2	481	14											As Per Plan	
765	31-6	LA FAYETTE - CLEAR CREEK	500+70	12' x 12' x 75' Reinforced Concrete Box Culvert 25° Sk.	276.1	36,098	320											20 x 24 CONC. SLAB BE.	
865	32-5	LA FAYETTE - CLEAR CREEK	518+95	8' x 8' x 210' Reinforced Concrete Box Culvert 20° Sk.	370.5	65,429	1,747											TWIN 6 x 4 x 79.5" CS SUBDRAIN	
965	32-5	LA FAYETTE - CLEAR CREEK	549+36.9	30" & 42" Concrete Roadway Pipe Culvert Extension			5	11		0	20		2						
1065	32-5	LA FAYETTE - CLEAR CREEK	558+40.5	30" & 42" Concrete Roadway Pipe Culvert Extension			5	18		0	28		2						
1165	33-5	LA FAYETTE - CLEAR CREEK	558+91.1	3' x 2' Reinforced Concrete Box Culvert Extension	11.4	664	13											As Per Plan	
1265	33-4	LA FAYETTE - CLEAR CREEK	572+37.7	2' x 2' R.C.B. Culv. Ext. (Inlet) - 30" & 42" Conc. Roadway Pipe Culv. Ext. + Flume (Outlet)	5.1	283	9	56	28	0	44			30	8	(3)		As Per Plan	
1365	33-4	LA FAYETTE - CLEAR CREEK	604+82	4' x 5' x 136' Reinforced Concrete Box Culvert with Flume 30° Sk.	110.0	10,229	362	49											
1465	34-3	LA FAYETTE - CLEAR CREEK	645+50	4' x 4' x 58' Reinforced Concrete Box Culvert with Flume 30° Sk.	61.2	4,572	97	202											
1565	34-3	LA FAYETTE - CLEAR CREEK	647+77.6	4' x 5' x 114' Reinforced Concrete Box Culvert with Flume 30° Sk.	90.6	8,491	178	230											
1665	34-3	LA FAYETTE - CLEAR CREEK	652+96.4	30" & 42" Concrete Roadway Pipe Culvert Ext.	2.3	125	1	3		20		2						As Per Plan	
1765	34-3	LA FAYETTE - CLEAR CREEK	660+95.8	4' x 3' Reinforced Concrete Box Culvert Ext.	8.0	652	12											As Per Plan	
1865	35-2	LA FAYETTE - CLEAR CREEK	666+67	3' x 2' Reinforced Concrete Box Culvert Ext.	7.7	550	8										4	As Per Plan	
1965	35-2	LA FAYETTE - CLEAR CREEK	694+39	5' x 3' x 48' Reinforced Concrete Box Culvert	30.3	2,923	58											As Per Plan	
2065	35-2	LA FAYETTE - CLEAR CREEK	698+10	5' x 3' x 49' Reinforced Concrete Box Culvert	30.8	2,971	54											As Per Plan	
TOTALS					1,102.9	141,746	3,065	88	509	112		6	30	8	1		4		

- (1) Includes 2 C-2 Connections
- (2) Includes one type C-2 Connection.
- (3) 17" Elbow.

ESTIMATE SHEET




Bench Mark No. 77 Sta. 519+27.7 Found iron pin in North Hdwl of Twin 6' x 4' 72" LT Elev. 742.570

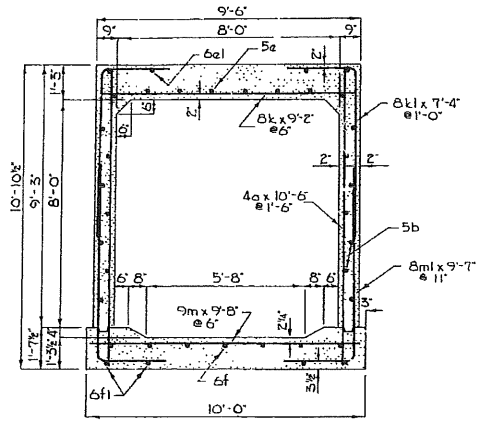


SECTION THRU BARREL

SCALE: 3/8" = 1'


Concrete / ft Bbl.  
Above Kayway .894 cu yds.  
Below Kayway .524 cu yds.  
Total 1.418 cu yds.

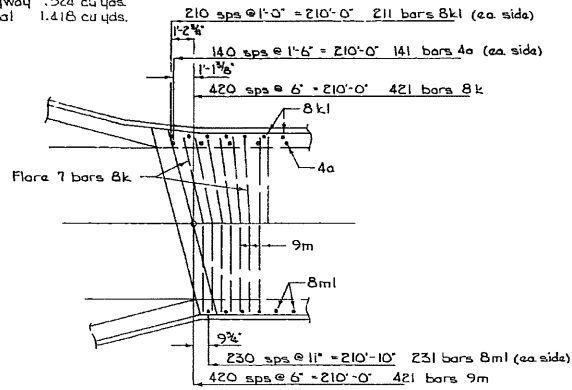

PLAN VIEW

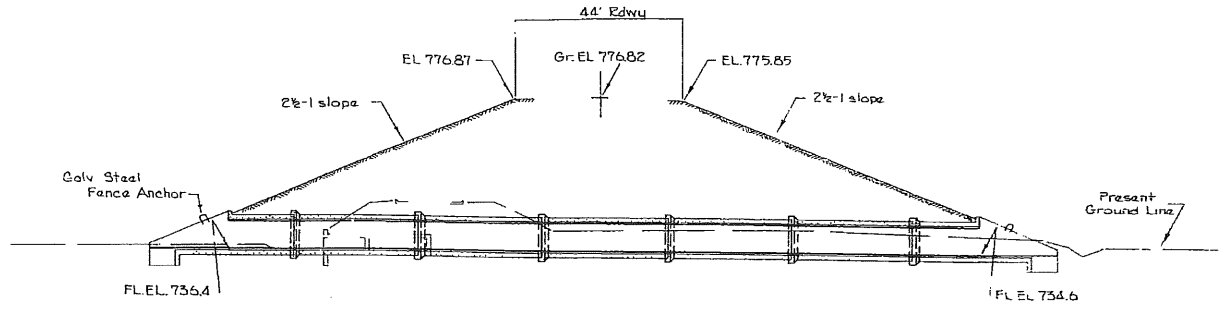

SECTION

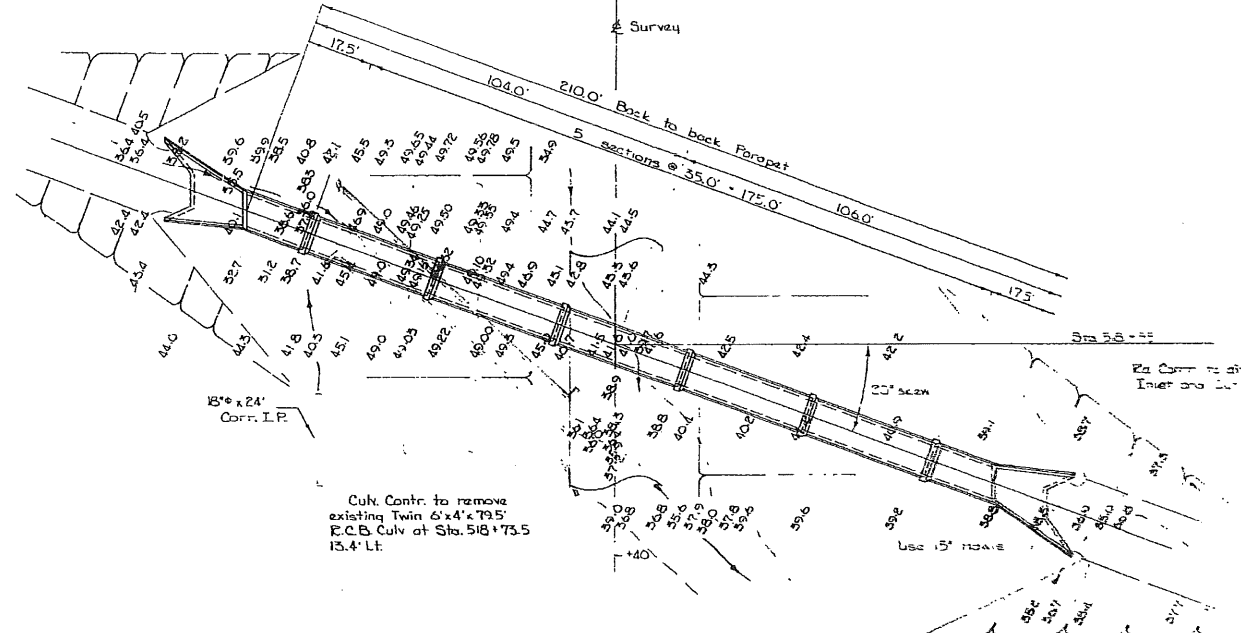

SITUATION PLAN

SCALE: 1" = 20'

Omit 8 bars 5a and shorten 4 bars 4b-4e 1/2" to meet the Std. Hdwl. Reinf. Steel Quantity 98 lbs.

ESTIMATED QUANTITIES		SIZE AND TYPE	
CONCRETE (STRUCTURAL)	572.5	CY	6' x 8' x 210' R.C.B. Culv
REINFORCING STEEL	6542.9	lbs.	DRAINAGE AREA 231 sq. ft. FILL 32'
PIPE CURV.		LN. FT.	SECTION 32-5 TWENTY-FIVE RANGE 10 W
PIPE APRONS		ONLY	CIVIL TOWNSHIP La Fayette & Clear Creek
EXCAVATION C.Y.			COUNTY Keokuk
CL. 20 1747, CL. 24			STATION 515+95
Removal as per plan			PROJECT NO. FN-92-8(3)-21-51
			DESIGN 855 DATE November 1964

REINFORCING STEEL ESTIMATE		8' x 8' x 210' BARREL						
BAR	SHAPE	NO	LENGTH	LINEAR FEET				
				4	5	6	8	9
4a	Walls Vert.	282	10'-6"	2961.0				
5b	Walls Horiz.	32	Listed		554.7			
5b	Walls Horiz.	80	34'-8"		2775.5			
5a	Slab Longit.	12	Listed		216.5			
5a	Slab Longit.	30	34'-8"		1040.0			
6a	Slab Top Longit.	8	Listed		144.3			
6a	Slab Top Longit.	20	34'-8"		695.5			
6f	Floor Longit.	14	Listed		242.7			
6f	Floor Longit.	35	34'-8"		1213.5			
6f	Floor Bott. Longit.	8	Listed		138.7			
6f	Floor Bott. Longit.	20	34'-8"		695.5			
8k	Slab Transv.	421	9'-2"			3859.2		
8k	Slab i Walls	422	7'-4"			3094.7		
9m	Floor Transv.	421	9'-8"				4069.7	
8ml	Floor i Walls	462	9'-7"				4427.5	
LENGTH				2961.0	4584.5	3125.6	11581.4	4069.7
WEIGHT				1977.9	4781.6	4694.7	50588.3	18837.0
TOTAL WEIGHT				55679.5 lbs.				

Variable Bars  
bars 5b 32 bars  
16 each length  
16'-2" 18'-6"  
bars 5a 12 bars  
6 each length  
long 16'-10"  
short 17'-3"  
bars 6a 8 bars  
2 each length  
16'-11" 18'-9"  
17'-4" 19'-2"  
bars 6f 14 bars  
7 each length  
long 18'-5"  
short 16'-3"  
bars 6f 8 bars  
2 each length  
16'-2" 18'-0"  
16'-8" 18'-6"

CONCRETE IN PARTS			REINFORCING STEEL		
	ABOVE KEYWAY	BELOW KEYWAY	TOTAL		
Barrel	187.14	110.04	297.18	55679.5	
Headwalls (2)	18.00	28.80	46.80	5546.0	
Ball Joints (6)	16.60	9.28	25.88	4193.4	
Fence Anchors				10.0	
<b>TOTAL</b>	<b>222.34</b>	<b>148.12</b>	<b>370.46</b>	<b>65428.9</b>	

M.E. ER

FILE NO. 21903

DES. NO. 865

KEOKUK COUNTY

PROJECT NUMBER FN-92-8(3)-21-54

STATE	FED. ROAD DIST. NO.	FISCAL YEAR	SHEET NO.	TOTAL SHEETS
IOWA	5		22	27