

HMA Resurfacing/CIP Recycling
NHSX-003-5(86)--3H-35

FRANKLIN COUNTY

LETTING DATE
10/18/22

INDEX OF SHEETS	
No.	DESCRIPTION
A Sheets	Title Sheets
A.1	Title Sheet
A.2	Location Map Sheet
A.3	Legend Sheet (B&W Plans Only)
A.4	Revison Sheets (if needed)
B Sheets	Typical Cross Sections and Details
B.1	Typical Cross Sections and Details
C Sheets	Quantities and General Information
C.1	Project Description
C.1	Estimated Project Quantities
C.1	Estimate Reference Information
C.1	Estimate Reference Information
C.1	Estimate Reference Information
C.1	Standard Road Plans
C.1	Standard Road Plans
C.1	Index of Tabulations
C.1	Pollution Prevention Plan
C.1	General Notes
C.1	Tabulations (beg. with tab. of incidentals if needed)
D Sheets	Mainline Plan and Profile Sheets
* D.1	Plan & Profile Legend & Symbol Information Sheet
* D.2	"Mainline Name"
J Sheets	Traffic Control and Staging Sheets
* J.1	Traffic Control Plan
* J.2	Staging Notes Stage
* J.3	Traffic Control & Staging Legend & Symbol Info. Sheet
* J.4	Staging and Traffic Control Sheets Stage ??
L Sheets	Geometric, Staking and Jointing Sheets
L.1	Geometric & Staking "Mainline or Side Road Name"
L.2	Edge Profiles "Mainline or Side Road Name"
L.3	Jointing "Mainline or Side Road Name"
* Color Plan Sheets	

FE exam 5/11/22

Attendance:
Mary Kelly
Tracy Meise
Ron Reichter
Jason Ruter


BEGIN CONSTRUCTION
STA 4+75, RP 182.76
Squaw Creek Bridge



PLANS OF PROPOSED IMPROVEMENT ON THE
PRIMARY ROAD SYSTEM
FRANKLIN COUNTY
HMA Resurfacing/CIP Recylcing
Squaw Creek Bridge
to Butler County Line

SCALES: As Noted

Refer to the Proposal Form for list of applicable specifications.
Value Engineering Saves. Refer to Article 1105.14 of the Specifications.

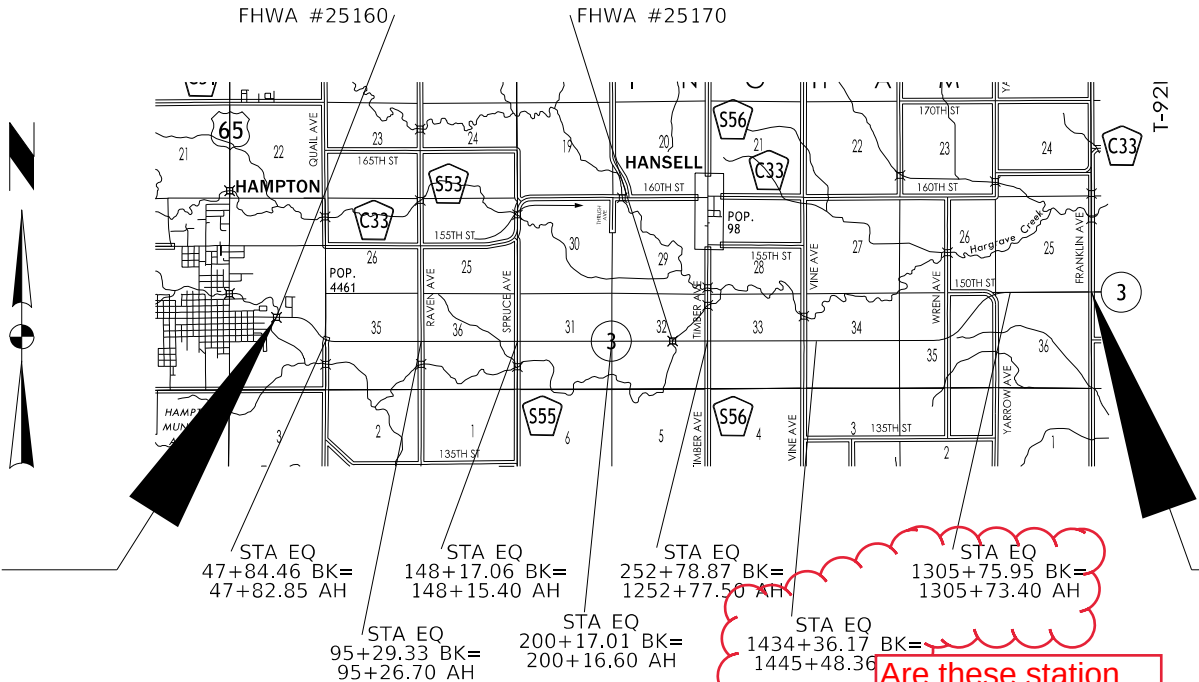

Adjust EOP to go just thru
intersection at County line to joint in
pavement

END CONSTRUCTION
STA 1485+29.34, RP 191.81
Butler County Line

DESIGN DATA RURAL			
2023	AADT	2,300	V.P.D.
2043	AADT	2,400	V.P.D.
20	--	--	V.P.H.
TRUCKS		16	%
Total			
Design ESALs		1,121,280	

INDEX		
SHEET NO.	NAME	TYPE
A.1	Mary Kelly	Primary Signature Block
X	X	X

PRELIMINARY PLANS

Subject to change by final design.



D2 PLAN – Date: 5/1/22



REVISIONS

TOTAL
--
PROJECT IDENTIFICATION NUMBER
21-35-003-010
PROJECT NUMBER
NHSX-003-5(86)--3H-35
R.O.W. PROJECT NUMBER

INDEX OF SHEETS	
No.	DESCRIPTION

MILEAGE SUMMARY		
Location	LF	Miles
STA 4+75.0 to STA 47+84.46 STA EQ 47+84.46 BK= 47+82.85 AH	4,309.46	0.82
STA 47+82.85 to STA 95+29.33 STA EQ 95+29.33 BK= 95+26.7 AH	4,746.48	0.90
STA 95+26.7 to STA 148+17.06 STA EQ 148+17.06 BK= 148+15.4 AH	5,290.36	1.00
STA 148+15.4 to STA 200+17.01 STA EQ 200+17.01 BK= 200+16.6 AH	5,201.61	0.99
STA 200+16.6 to STA 252+78.87 STA EQ 252+78.87 BK= 1252+77.5 AH	5,262.27	0.99
STA 1252+77.5 to STA 1305+75.95 STA EQ 1305+75.95 BK= 1305+73.4 AH	5,298.45	1.00
STA 1305+73.4 to STA 1434+36.17 STA EQ 1434+36.17 BK= 1445+48.36 AH	12,862.77	2.44
STA 1445+48.36 to STA 1485+29.34	3,980.98	0.75
Bridge STA 10+60.0	(80.0)	()
Bridge STA 233+57.0	(60.0)	()
TOTAL	46,952.38	8.89

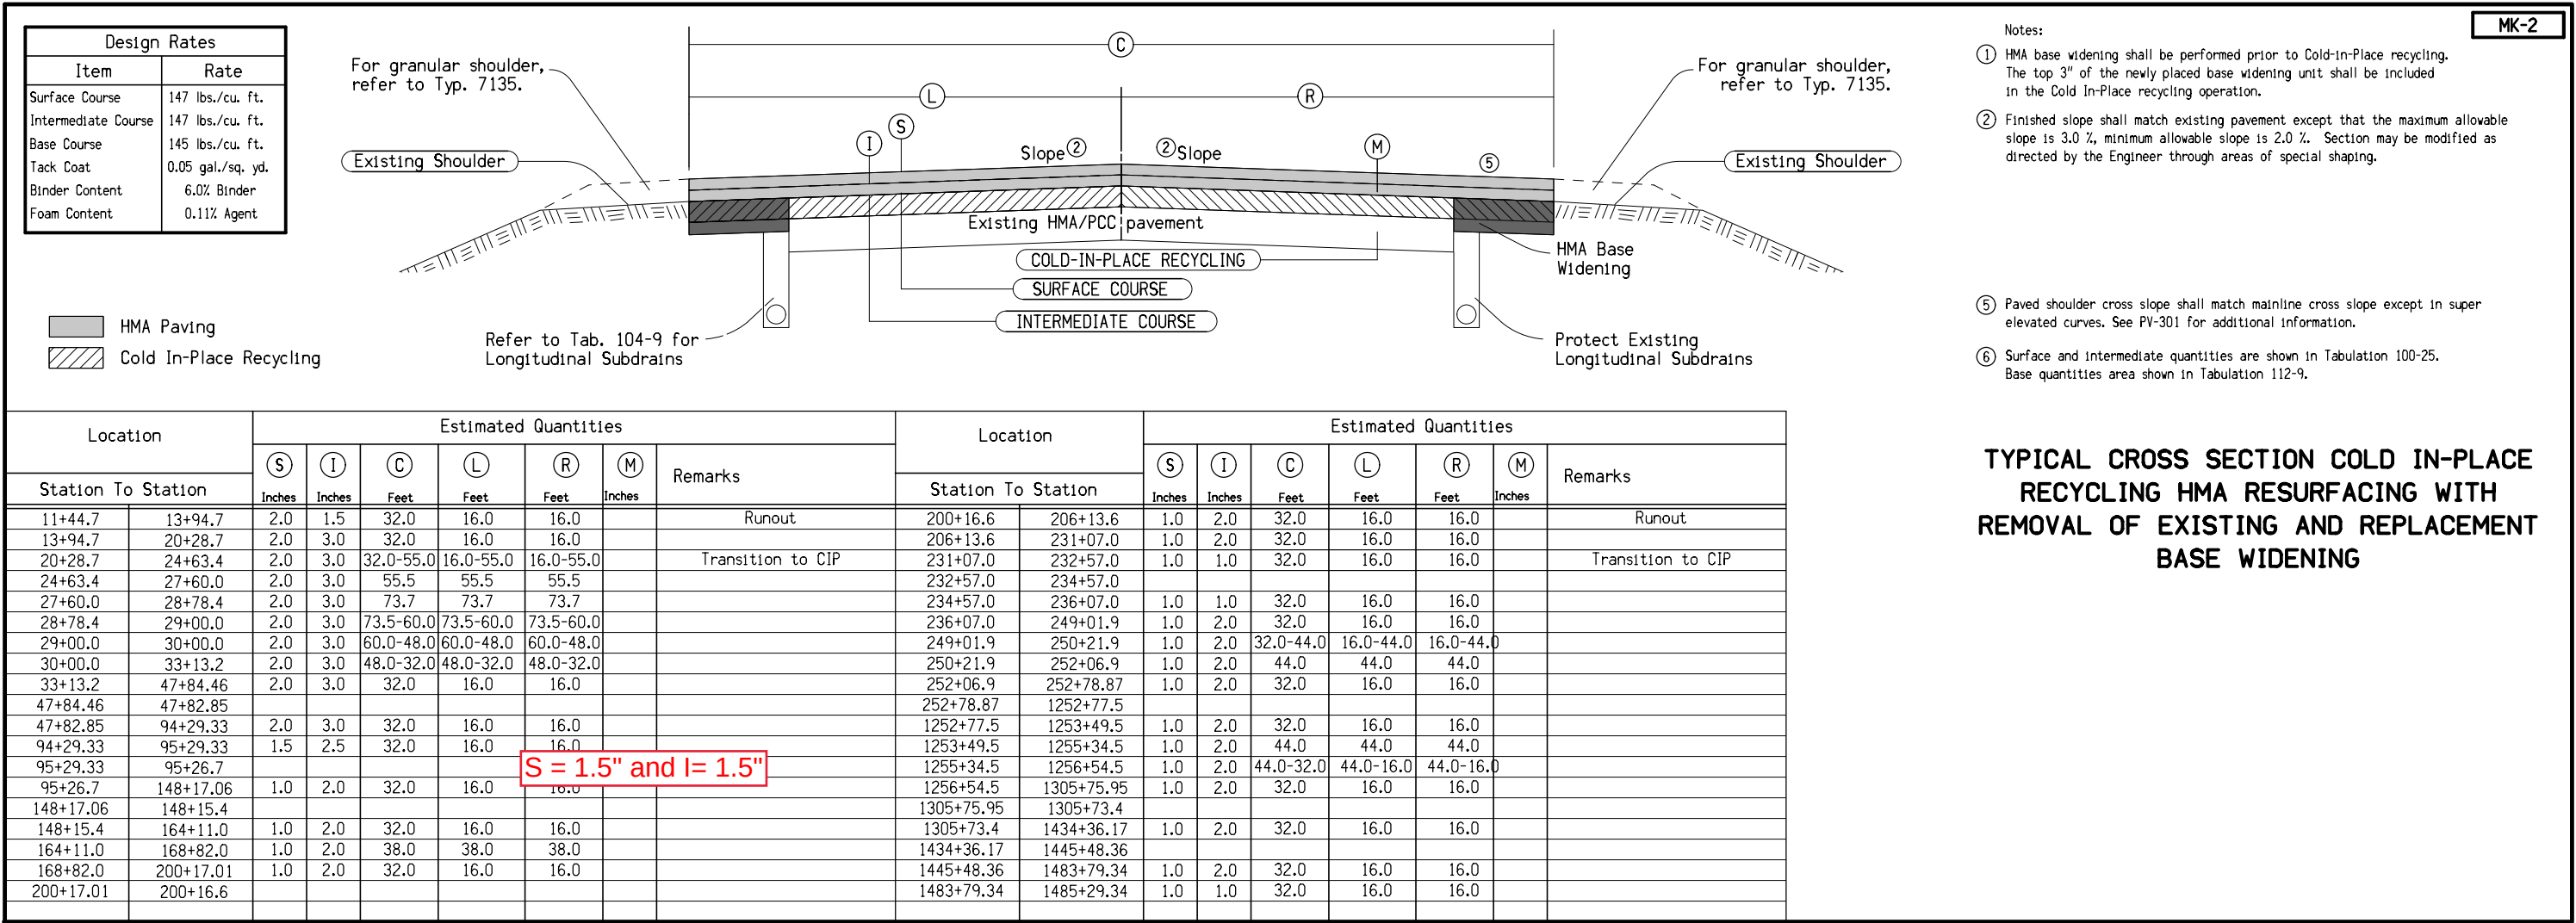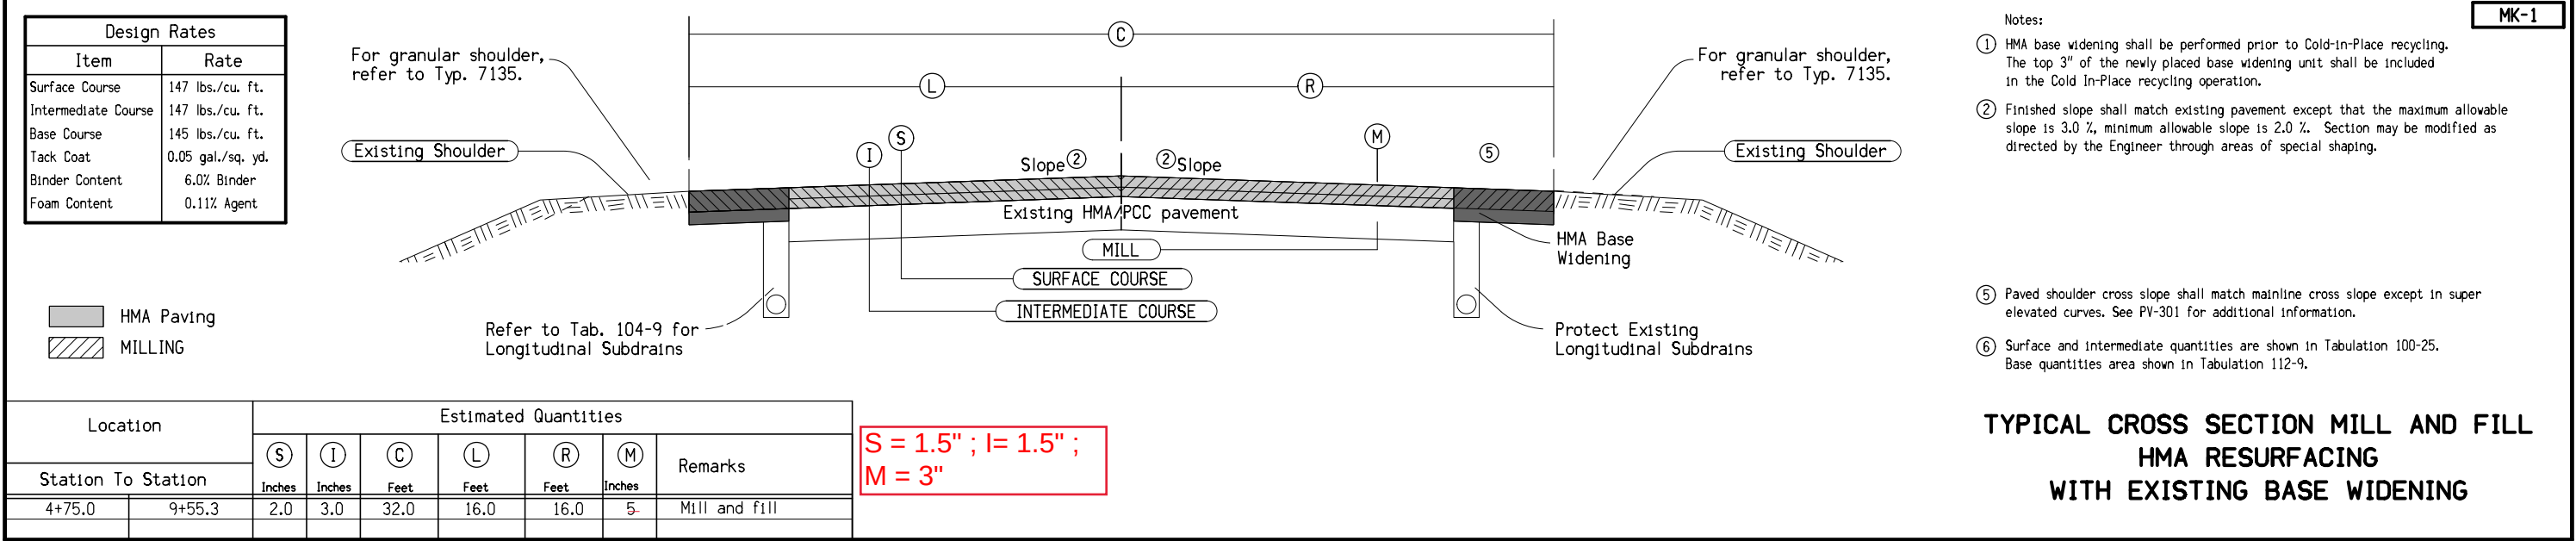

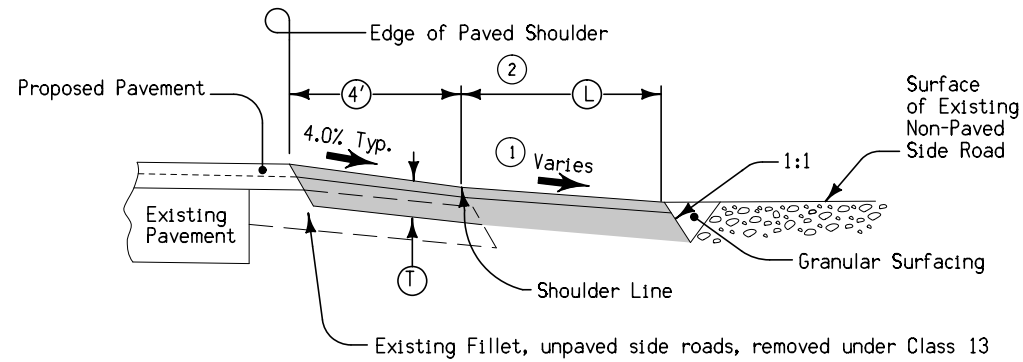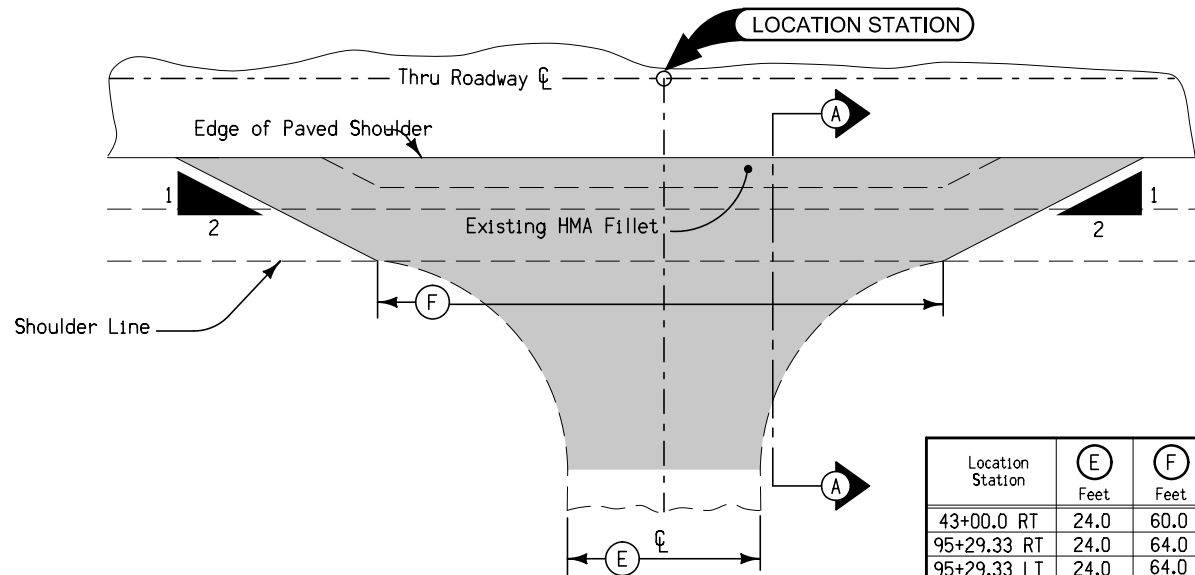


SECTION A-A

Location Station	E Feet	F Feet	Remarks
43+00.0 RT	24.0	60.0	Quail
95+29.33 RT	24.0	64.0	Raven/S53
95+29.33 LT	24.0	64.0	Raven
148+17.06 RT	24.0	64.0	Spruce S55
148+17.06 LT	24.0	64.0	Spruce
1305+75.95 RT	24.0	64.0	Vine
1305+75.95 LT			Vine
1384+97.4 RT			Wren
1384+97.4 LT			Wren
1418+88.8 RT			Yarrow
1485+29.3 RT			Franklin
1485+29.3 LT			Franklin/33

Special shaping of existing surface prior to placement of fillet or fillet extension may be requested by the Engineer and will be incidental to other work on the project.

- ① Match existing slope.
 - ② At skewed sideroads, the L distances are measured along sideroad centerline.
 - ③ See Tab 100-25.
 - ④ Any excavation needed to extend the fillets is considered incidental.
- ① = 2" Surface Course
4" Intermediate Course


FILLET FOR NON-PAVED SIDE ROADS

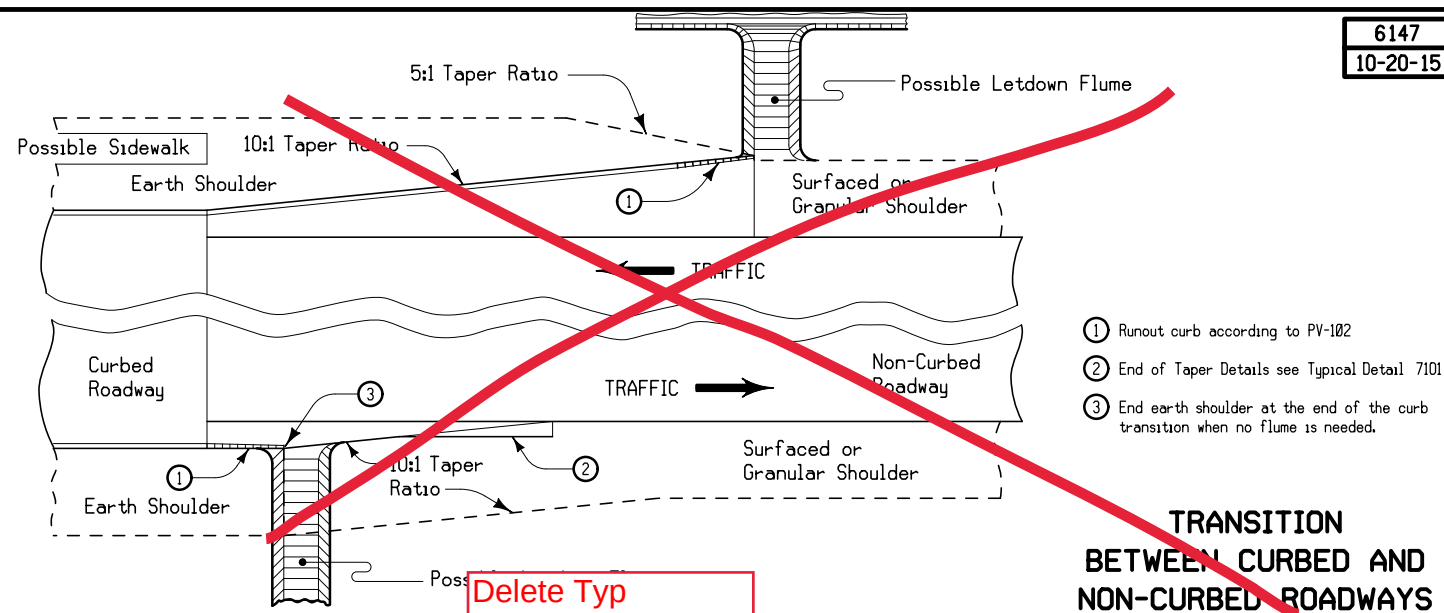

6147
10-20-15

Storm sewer outlet east of curb and gutter in Hampton on south side of road needs cleaned out and new rock splash pad. Do nothing to north side intake.

TRANSITION
BETWEEN CURBED AND
NON-CURBED ROADWAYS

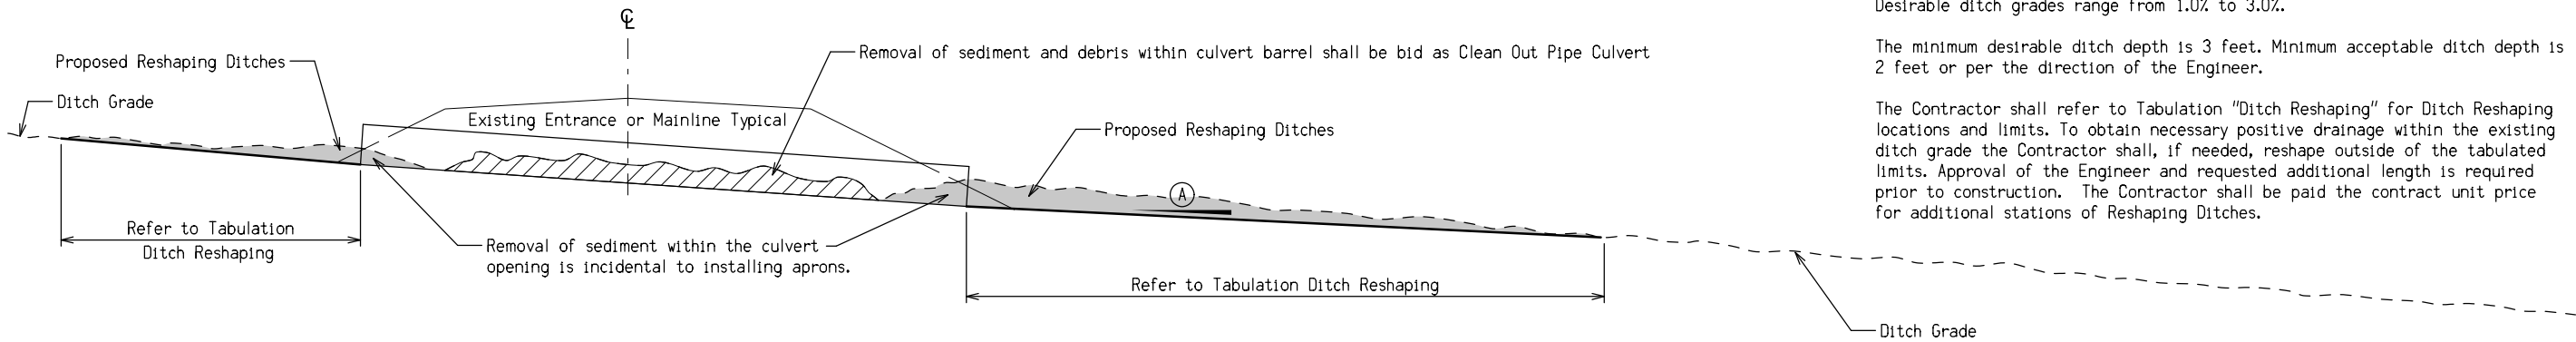


Ⓐ Contractor to reshape ditch from culvert outlet as follows:

Minimum acceptable ditch grades range from 0.2% to 1.0%.
Desirable ditch grades range from 1.0% to 3.0%.

The minimum desirable ditch depth is 3 feet. Minimum acceptable ditch depth is 2 feet or per the direction of the Engineer.

The Contractor shall refer to Tabulation "Ditch Reshaping" for Ditch Reshaping locations and limits. To obtain necessary positive drainage within the existing ditch grade the Contractor shall, if needed, reshape outside of the tabulated limits. Approval of the Engineer and requested additional length is required prior to construction. The Contractor shall be paid the contract unit price for additional stations of Reshaping Ditches.

RESHAPING DITCHES TYPICAL

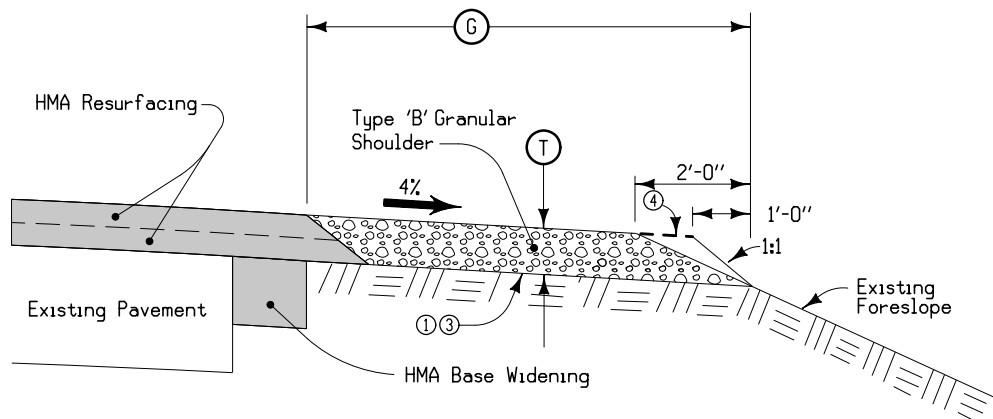

- Notes:
- ① Existing shoulder surface to be shaped to a uniform cross slope prior to placing granular shoulder material. Shape to ensure the thickness of the granular shoulder material is not less than the thickness of the resurfacing.
 - ② Nominal thickness adjusted to account for existing slopes greater than 4%.
 - ③ Placing granular shoulder material in advance of Class 13 Excavation for Widening and Base Widening shall be performed as part of the "Granular Shoulders, Type B" bid item.
 - ④ Place and compact material to the dashed lines; then blade and shape to foreslope that portion above the solid line in the outer 2' and roll with loaded truck tire.


7135
Modified

ROAD	STATION TO STATION		SIDE	①②		STATION TO STATION		SIDE	①②	
				Inches	Feet				Inches	Feet
1A 3	4+90.0	9+15.0	LT	5	4	4+80.0	8+61.0	RT	5	4
			LT	5	6			RT	5	6
	12+39.0	48+00.0	LT	5	4	11+59.0	20+29.0	RT	5	4
			LT	5	6	20+29.0	47+84.46	RT	5-6	4
	47+82.85	95+29.33	LT	5-6	6			RT	6	4
			LT	6	6	47+82.85	95+29.33	RT	6-5	4
	95+26.7	148+17.05	LT	6	4			RT	5	4
			LT	6-5	4	95+26.7	148+17.06	RT	5-6	4
	148+15.4	164+11.0	LT	5	4			RT	6	4
	164+11.0	168+82.0	LT			148+15.4	200+17.01	RT	6	4
	168+82.0	200+17.01	LT	5	4			RT	6	6
			LT	5-6	4	200+16.6	231+52.0	RT	6-5	6
	200+16.6	231+63.0	LT	6	4			RT	5	6
			LT	6-5	4	235+51.0	252+66.87	RT	5	4
	235+62.0	252+78.87		5	4			RT		
			LT			1252+77.5	1305+75.95	RT	5	4
	1252+89.5	1305+75.95	LT	5	4			RT	5	4
				5	4	1305+73.4	1434+36.17	RT		
	1305+73.4	1434+36.17		5	4			RT		

TYPICAL SECTION
FOR TYPE 'B'
GRANULAR SHOULDER
ADJACENT TO HOT MIX ASPHALT
RESURFACING

This typical needs to reflect that the base widening is existing. Remove shading and callout "Ex. Base Widening"

Would it possibly be more accurate to use 7135, unmodified?

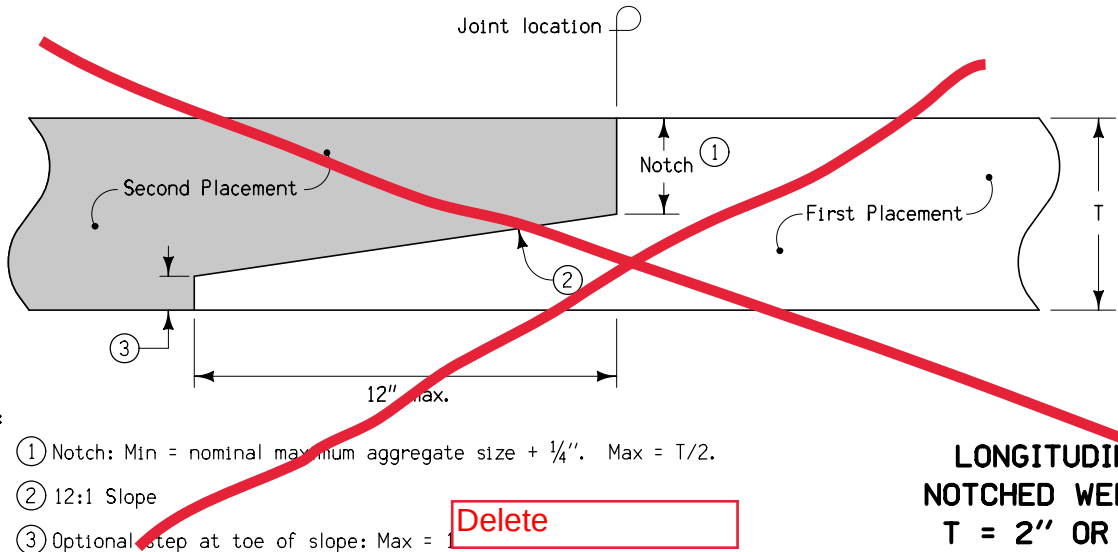

- Notes:
- ① Notch: Min = nominal maximum aggregate size + 1/4". Max = T/2.
 - ② 12:1 Slope
 - ③ Optional step at toe of slope: Max = Delete

LONGITUDINAL HMA
NOTCHED WEDGE JOINT
T = 2" OR GREATER

7315
10-20-09

100-1D
10-18-05

111-25
10-18-11

111-25
10-18-11

		100-1U Modified
UTILITIES		

262-6
10-18-05

105-4
10-18-11

105-4
10-18-11

[illegible]

At the Hansell Corner in the NW quadrant, Verify ROW and clear and grub is possibly.

The diagram shows a red boundary enclosing a rectangular area. A blue horizontal line is drawn across the top of the area. This blue line is divided into two segments by a vertical line. The left segment is labeled "1 ft" and the right segment is labeled "2 ft". Below the blue line, there is a light blue shaded rectangle. This shaded rectangle is positioned such that its left edge aligns with the vertical line that divides the blue line, and its right edge aligns with the right edge of the "2 ft" segment. The shaded rectangle is positioned below the blue line, indicating it is not part of the area defined by the blue line.

102-504-18-17

EXISTING PAVEMENT

No.	Location					Year	Type	Project Number	Surface		Base		Subbase		Removal		Coarse Aggregate			Reinforcement	Remarks
	County	Route	Dir. of Travel	Begin Ref. Loc. Sign	End Ref. Loc. Sign				Type	Depth	Type	Depth	Type	Depth	Type	Depth	Source	Type	Durability Class	Type	
	Franklin	IA 3	B	182.69	183.48	2011		MP-003-2(703)183--76-38	MSS									Hibness	C.LST.		
						1997		STPN-3-5(45)--2J-35	AAC	1.5	AAC	1.5									
						1961		NA	BAC	3											
						1930		NA	PCC	7											
				183.48	184.47	2011		MP-003-2(703)183--76-38	MSS												
						1997		STPN-35(45)--2J-35	AAC	1.5	AAC	1.5						Hibness	C.LST.		
						1961		FN-105	AAC	3								Lillybridge	C.LST.		
						1930		FA-105*<1>	PC7	7								Clarksville-KN	Gravel	2	
				184.47	184.98	2011		MP-003-2(703)183--76-38	MSS												
						1997		STPN-3-5(45)--2J-35	AAC	3	BAC	9.5						Hibness	C.LST.		
				184.98	186.1	2011		MP-003-2(703)183--76-38	MSS												
						1997		STPN-3-5(45)--2J-35	AAC	3	BAC	9.5						Hibness	C.LST.		
				186.1	186.76	2011		MP-003-2(703)183--76-38	MSS												
						1997		STPN-3-5(45)--2J-35	AAC	3	BAC	9.5						Hibness	C.LST.		
				186.76	189.7	2011		MP-003-2(703)183--76-38	MSS												
						1997	S	STPN-3-5(45)--2J-35	AAC	1.5	AAC	1.5						Hibness	C.LST.		
						1961		FN-105	AAC	3								Lillybridge	C.LST.		
						1930		FA-105*<1>	PC7	7								Clarksville-KN	Gravel	2	
				189.7	190.82	2011		MP-003-2(703)183--76-38	MSS												
						1997	S	STPN-3-5(45)--2J-35	AAC	1.5	AAC	2.5						Hibness	C.LST.		
						1976		HHS-3-5(19)	PCC	7								Geneva	Gravel	2	
				190.82	191.81	2011		MP-003-2(703)183--76-38	MSS												
						1997	S	STPN-3-5(45)--2J-35	AAC	1.5	AAC	1.5						Hibness	C.LST.		
						1985		FN-3-5(38)--21-12	AAC	1.5	TBB	1.5						Jensen	Gravel		
						1961		FN-171	AAC	3								Lillybridge	C.LST.		
						1930		FA-171	PC7	7								Clarksville-KN	Gravel	2	

232-3C10-19-21

EROSION CONTROL
(NATIVE GRASS SEEDING)

Area to be seeded is estimated to be less than 1 acre. If the Contractor determines the area exceeds 2 acres, notify the Engineer. Approved quantity in excess of 2 acres will be paid for as extra work according to Article 1109.03,B of the Standard Specifications.

Following the completion of work in a disturbed area and according to the seeding dates in Section 2601 of the Standard Specifications, place seed and mulch on the disturbed area lying 8 feet or more beyond the shoulder as follows:

SEED MIX:
Big bluestem (Andropogon geradii) 6 lbs. PLS/Acre (7.0 kg/ha)
Indiangrass (Sorghastrum nutans) 6 lbs. PLS/Acre (7.0 kg/ha)
Little bluestem (Schizachyrium scoparium) 6 lbs. PLS/Acre (7.0 kg/ha)
Partridge Pea (Chamaecrista fasciculata) 4 lbs. PLS/Acre (4.5 kg/ha)
Sideoats grama (Bouteloua curtipendula) 4 lbs. PLS/Acre (4.5 kg/ha)
Canada wildrye (Elymus canadensis) 2 lbs. PLS/Acre (2.2 kg/ha)
Switchgrass (Panicum virgatum) 1 lbs. PLS/Acre (1.1 kg/ha)
Oats (Avena sativa) 32 lbs./Acre (36.0 kg/ha)

Furnish Big bluestem, Indiangrass, Canada wildrye and Little bluestem that is debarbed or equal to facilitate the application of seed.

Furnish seed certified as Source Identified Class (Yellow Tag) Source G0-Iowa. Oats are excluded from this requirement.

Place seed according to the requirements of Article 4169.02 of the Standard Specifications.

Place mulch according to the requirements of Articles 2601.03,E,2,a and 4169.07,A of the Standard Specifications.

Preparing the seedbed, furnishing and applying seed and mulch

232-3C10-19-21

EROSION CONTROL
(NATIVE GRASS SEEDING)

are incidental to mobilization and will not be paid for separately.

232-3A10-19-21

EROSION CONTROL
(RURAL SEEDING)

Area to be seeded is estimated to be less than 1 acre. If the contractor determines the area exceeds 2 acres, notify the Engineer. Approved quantity in excess of 2 acres will be paid for as extra work according to Article 1109.03,B of the Standard Specifications.

Following the completion of work in a disturbed area and according to the seeding dates in Section 2601 of the Standard Specifications, place seed, fertilizer, and mulch on the disturbed area lying 8 feet adjacent to shoulder and median as follows:

Place seed and fertilize according to the requirements of Article 2601.03,C,3 and Section 4169 of the Standard Specifications.

Place mulch according to the requirements of Articles 2601.03,E,2,a and 4169.07,A of the Standard Specifications.

Preparing the seedbed, furnishing and applying seed, fertilizer, and mulch are all incidental to mobilization and will not be paid for separately.

100-2704-17-18

PROPOSED POSTED SPEED LIMIT

Road Identification	Begin Station	End Station	Proposed Posted Speed Limit			Remarks
			35 or less	40 - 45	over 45	
IA 3	4+75.00	30+00.00	X			
	30+00.00	1485+29.34			x	

232-3B10-19-21

EROSION CONTROL
(URBAN SEEDING)

Area to be seeded is estimated to be less than 1 acre. If the Contractor determines the area exceeds 2 acres, notify the Engineer. Approved quantity in excess of 2 acres will be paid for as extra work according to Article 1109.03,B of the Standard Specifications.

Following the completion of work in a disturbed area and according to the seeding dates in Section 2601 of the Standard Specifications, place seed, fertilizer, and mulch on the disturbed area as follows:

Place seed and fertilize according to the requirements of Article 2601.03,C,4 and Section 4169 of the Standard Specifications.

Place mulch according to the requirements of Articles 2601.03,E,2,a and 4169.07,A of the Standard Specifications.

Preparing the seedbed, furnishing and applying seed, fertilizer, and mulch are incidental to mobilization and will not be paid for separately.

232-1110-19-21

EROSION CONTROL
(STABILIZING CROP SEEDING)

Area to be seeded is estimated to be less than 1 acre. If the contractor determines the area exceeds 2 acres, notify the Engineer. Approved quantity in excess of 2 acres will be paid for as extra work according to Article 1109.03,B of the Standard Specifications.

If outside of permanent seeding dates in Section 2601 of the Standard Specifications, or if required by a storm water permit, place stabilizing crop, fertilizer, and mulch on the disturbed area as follows:

Place seed and fertilize according to the requirements of Article 2601.03,C,1 and Section 4169 of the Standard Specifications.

Place mulch according to the requirements of Articles 2601.03,E,2,a and 4169.07,A of the Standard Specifications.

Preparing the seedbed, furnishing and applying seed, fertilizer, and mulch are incidental to mobilization and will not be paid for separately.

FILE NO.

ENGLISH

DESIGN TEAM

KELLY\MEISE

FRANKLIN COUNTY

PROJECT NUMBER

NHSX-003-5(86)--3H-35

SHEET NUMBER

C.2

5/10/2022 3:14:51 PM tmeise c:\pw_work\pmain\tmeise\d1608081\35003086C.xlsm

EMERALD ASH BORER

Any living, dead, cut or fallen material of the ash (*Fraxinus* spp.) including trees, nursery stock, logs, firewood, stumps, roots, branches, and composted or uncomposted ash chips can be freely moved within the yellow areas of the most recent Federal EAB Quarantine & Authorized Transit.

https://www.aphis.usda.gov/plant_health/plant_pest_info/emerald_ash_b/downloads/eab_quarantine_map.pdf.

Obtain appropriate Compliance Agreements from USDA APHIS PPQ prior to moving any of the above listed ash articles to areas outside the yellow zone on the map.

For questions, concerns, and general assistance, contact:

USDA APHIS PPQ, Iowa office, 515-414-3295

Or

Iowa Department of Agriculture & Land Stewardship


515-725-1470

Entomology@IowaAgriculture.gov

232-10
04-18-17

SILT FENCES FOR DITCH CHECKS

Possible Standard: EC-201

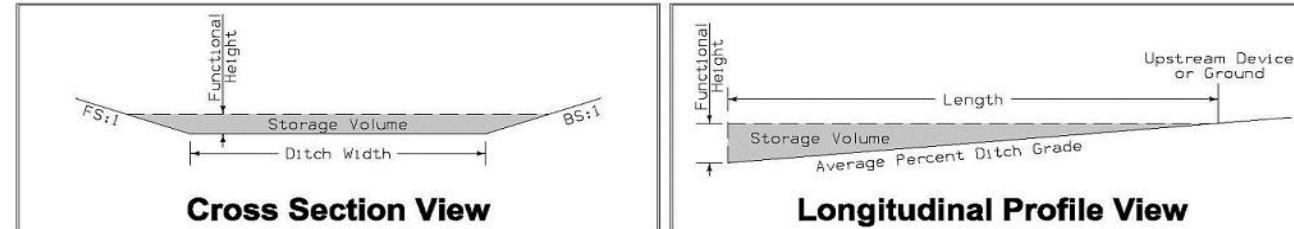

* The functional height used in the volume equation is 85% of effective height. Effective height is 1.58 feet as shown on EC-201.

* Volume equation: $[0.5 \cdot \text{Spacing} \cdot (0.5 \cdot H^2 \cdot FS + DW \cdot H + 0.5 \cdot H^2 \cdot BS)]$

[illegible]

100-18
10-16-18

DITCH RESHAPING

Refer to Typical MK-2

Side	Location		Remarks
	Station	Length (STA)	
RT	23+50.00	1.0	
LT	1372+78.00	1.0	
RT	1422+25.00	1.0	
LT	1422+25.00	1.0	
		4.0	TOTAL

300-1
Modified

TABULATION OF SILT FENCES

Refer to EC-201

Location			Length	Remarks
Begin Station	End Station	Side		
			LF	

00-17
-20-10

SCOUR PROTECTION OR ROCK FLUME FOR BRIDGE END DRAIN

Refer to Standard Road Plan DR-401 and DR-402

[illegible]

104-8A
04-19-22

CLEARING AND GRUBBING

[illegible]

Did not see trees in field. Verify where this information came from?

110-17
4-18-17

LONGITUDINAL SUBDRAIN SHOULDER AND BACKSLOPE

Refer to Soils Sheets

* Not a bid item. Bridge berm quantities assume a trench depth of 24 inches.

Location					Longitudinal Subdrain (DR-303)									Subdrain Outlet		Porous* Backfill	Class "A"* Crushed Stone	Remarks
Line No.	Road or Lane Identification	Station to Station		Side	Depth	Shoulder		Backslope		Bridge Berm (EW-203 or EW-204)			DR-303, DR-305 or DR-306					
						Size	Length	Size	Length	Standard Road Plan and Type		Size	Length	Station	Standard Road Plan and Type			
						IN	IN	FT	IN	FT	IN	FT						
1	NBL	1+00.00	2+00.00	LT	66.0	4.0	160.0						1+00.00	DR-306	24.7			
													2+00.00	DR-306				

FORESLOPE FLATTENING AND DRAINAGE STRUCTURES BY ROAD CONTRACTOR (MAINLINE PIPES)

Refer to Standard Road Plans DR-121, DR-122, and DR-213.

* Not a bid item

Existing Information		New Information		Length of New Const.	Flow Line Elevations		Dimensions				Removal and Reinstallation of Culvert Aprons and Pipes						New Apron No.		Apron Guard* (DR-213)	Type 'C' Connections* (DR-122)		Connected Pipe Joint* (DR-121)	Embank.- In-Place	Class 20	Remarks	
Location	Size and Type of Culvert	Size	Type of Culvert				Total (LF)		Extensions (LF)		Aprons		Culvert Sections													
							LEFT	RIGHT	LEFT	RIGHT	LEFT	RIGHT	Left Side		Right Side											
		IN			LF	LEFT							RIGHT	LEFT	RIGHT	NO.*	FT	NO.*	FT	IN	OUT	NO.	TYPE	NO.		TYPE
23+50	12" x 42" RCP																									
32+86	2'x2', extended 30"x52' RF-1																									
36+47	2'x2', extended 30"x48' RF-1																									See 100-23, 300-1
52+36	36"x 48' RF-1																									See 100-23
63+43	2'x2.3', extended 30"x108' RF-1																									
75+19	2'x2.5', extended 30"x50' RFP																									See 100-23
94+88	2'x2' extended 30"x55' RCP																									
109+50	30"x100' RF-1																1									See 100-23
138+86	48"x92' RCP																									See 100-23
138+96	48"x92' RCP																									
155+59	3'x2.2' extended 42"x44' RF-1																									
169+20	24"x72' RF-1																									See 100-23
182+83	2'x2'extended 30"x50' RCP																									See 300-1
214+74	2'x2'extended 30"x85' RCP																									See 100-23
1305+25	73"x45" extended 48"x85' CAP																									
1337+01	48"x92' RCP												1	1												
1337+10	48"x92' RCP												1	1												
1372+78	66" extended 48"x 110' RCP												1													See 300-1
1385+97	60" extended 48"x 84' RF-1																									
1400+50	36" x 104' RF-1												1	1												MAINTENANCE
1422+25	60" extended 48"x 89' RF-1																									See 100-23
1470+92	2'x2.5' extended 30"x71' RCP													1												See 100-23
1481+50	48"x80' RF-1																	1								See 100-23
1481+84	3'x3.5'extended 42"/48" RCP												1													See 100-23
														9					2							TOTALS

102-16

10-21-14

NOTCHES AND RUNOUTS FOR RESURFACING

①

Bid item. Applies only to Types 'N1' and 'N3' on PR-202. Refer to 100-25 for remaining values.

Refer to PR-201 and PR-202.



Location Station	Type of Notch or Runout	S	I	DI	L	M	Pavement Scarification ①	Remarks
		IN	IN	IN	FT	IN	SY	
4+75.00	Type 'N5'	2.0	3.0		250.0			Begin Project
9+55.30	Type 'N5'	2.0	3.0		250.0			Bridge
11+44.70	Type 'N5'	2.0	3.0		250.0			Bridge
94+29.33		2.0-1.0	3.0-2.0		100.0			Transition between overlay depth
232+57.00	Type 'N5'	1.0	2.0		150.0			Bridge
234+57.00	Type 'N5'	1.0	2.0		150.0			Bridge
1485+29.34	Type 'N5'	1.0	2.0		150.0			End Project

102-6C 04-18-17																				
FULL-DEPTH PATCHES																				
Possible Standards: PR-101, PR-102, PR-103, PR-104, PR-105, and PR-140.																				
Location				Dimension			PCC Patches				HMA Patches	Composite HMA	Subbase Patches	Subbase Patch w/ 'EF' Joint	Patch Subdrain	'CD' Joints	'CT' Joints	'EF' Joints	Anchor Lugs Removal	Remarks
Count	Station	Reference Location Sign	Lane	Length	Width	Patch Thickness	With Dowels	Without Dowels	C R C	Ramp with Dowels										
							PR-103	PR-102	PR-104	PR-105										
							L, R, or B	FT	FT	IN										
	232+75.00 234+75.00		B B															1 1		
	1418+88.80		LT	20.0	20.0															

PERIMETER, SLOPE AND DITCH CHECK SEDIMENT CONTROL DEVICES								100-19 10-19-21
Possible Standards: EC-204								
Location			Perimeter and Slope			Ditch Check		Remarks
Begin Station	End Station	Side	Length of Installation			Length of Installation		
			9 inch Dia	12 inch Dia	20 inch Dia	12 inch Dia	20 inch Dia	
			LF	LF	LF	LF	LF	
109+50.00						50.0	New apron	
1481+50.00						50.0	New apron	
						100.0	TOTAL	

100-23 04-17-18														
ROCK EROSION CONTROL														
Refer to EC-301 and Detail 570-8														
Location				L	W	Rock Erosion Control (REC)					Material Bid Quantities			Remarks
Road Identification	Begin Station	End Station	Side			Type 1	Type 2	Type 3	Type 4	Type 5	Eng. Fabric	Class E Revetment	Erosion Stone	
						Rock Ditch Check	Rock Ditch	Rock Flume	Rock Splash Basin	Rock Slope Protection	SY	TON	TON	
						Lt./Rt.	FT	FT						
IA 3	36+47.00		LT											
	52+36.00													
	75+19.00		RT											
	109+50.00		RT											
	138+96.00		RT											
	169+20.00		RT											
	214+74.00		LT											
	1422+25.00													
	1470+92.00													
1481+50.00														
1481+84.00														
														TOTAL

HMA PAVEMENT

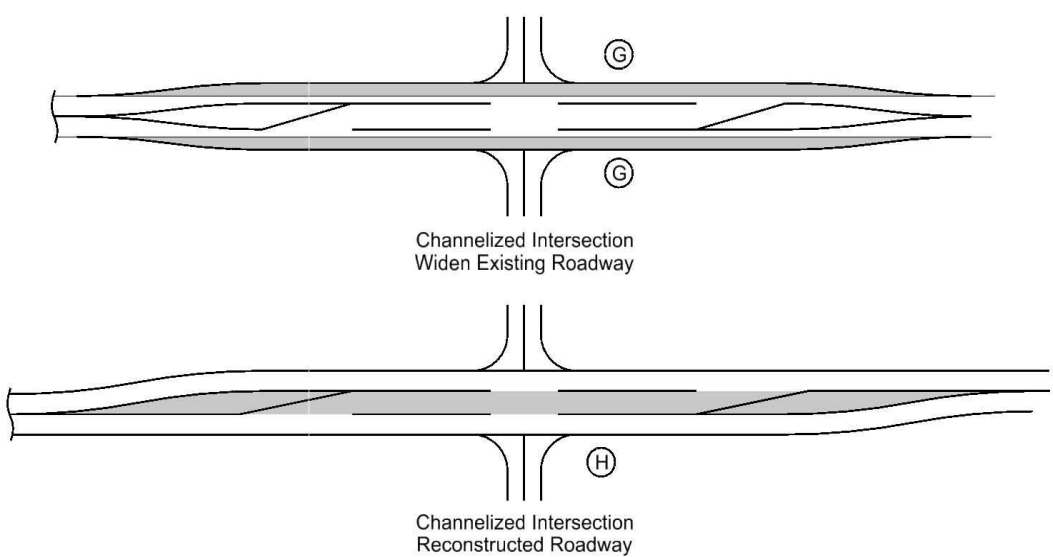
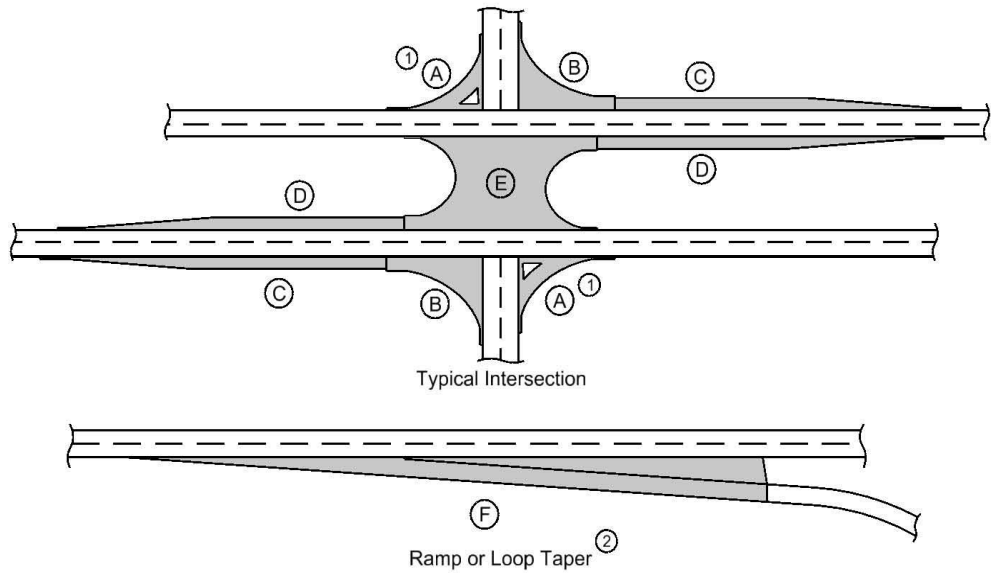


- ① Does not include raised island area or curb.
Refer to tabulation 112-4 for quantities.
- ② Refer to PV-410, PV-411, PV-412, and PV-414.
- ③ Quantity includes Pavement Header.

Calculations assume a surface course unit weight (lbs/cf) of 147, an intermediate course unit weight (lbs/cf) of 147, a base course unit weight (lbs/cf) of 145, and a special backfill unit weight (lbs/cf) of 140.

Location				Mainline			Area ③								Bid Items												Remarks		
Road Identification	Direction of Travel	Station to Station		Width	Length	Area	A ①	B	C	D	E	F ②	G	H	Hot Mix Asphalt Pavement						Binder			Special Backfill	Modified Subbase	Granular Subbase		Pavement Scarification	
															Surface		Intermediate		Cold-In-Place		Surface	Intermediate	Foam Asphalt						
															TONS	SY	TONS	SY	WIDTH	SY	TONS	TONS	TONS						
				FT	FT	SY	SY	SY	SY	SY	SY	SY	SY	SY	TONS	SY	TONS	SY	WIDTH	SY	TONS	TONS	TONS	TONS	CY	SY	SY		
IA 3		4+75.00	9+55.30	32.0	480.3	1707.7									188.3	1707.7	282.4	1707.7			11.3	16.9					1707.7	TM-1	
Bridge		9+55.30	11+44.70		189.4																								
		11+44.70	13+94.70	32.0	250.0	888.9									98.0	888.9	73.5	888.9			5.9	4.4							
		13+94.70	20+28.70	32.0	634.0	2254.2									248.5	2254.2	372.8	2254.2			14.9	22.4							
		20+28.70	24+63.40	32-55	434.7	2101.1									231.6	2101.1	347.5	2101.1			13.9	20.8							
		24+63.40	27+60.00	55.5	296.6	1829.0									201.7	1829.0	302.5	1829.0			12.1	18.1							
		27+60.00	28+78.40	73.5	118.4	966.9									106.6	966.9	159.9	966.9			6.4	9.6							
		28+78.40	29+00.00	73.5-60	21.6	160.2									17.7	160.2	26.5	160.2			1.1	1.6							
		29+00.00	30+00.00	60-48	100.0	600.0									66.2	600.0	99.2	600.0			4.0	6.0							
		30+00.00	33+13.20	48-32	313.2	1392.0									153.5	1392.0	230.2	1392.0			9.2	13.8							
		33+13.20	47+84.46	32.0	1471.3	5231.1									576.7	5231.1	865.1	5231.1			34.6	51.9							
		47+84.46	47+82.85																										
		47+82.85	94+29.33	32.0	4646.5	16520.8									1821.4	16520.8	2732.1	16520.8			109.3	163.9							
		94+29.33	95+29.33	32.0	100.0	355.6									29.4	355.6	49.0	355.6			1.8	2.9							
		95+29.33	95+26.70																										
		95+26.70	148+17.06	32.0	5290.4	18810.2									1036.9	18810.2	2073.8	18810.2			62.2	124.4							
		148+17.06	148+15.40																										
		148+15.40	164+11.00	32.0	1595.6	5673.2									312.7	5673.2	625.5	5673.2			18.8	37.5							
		164+11.00	168+82.00	38.0	471.0	1988.7									109.6	1988.7	219.3	1988.7			6.6	13.2							
		168+82.00	200+17.01	32.0	3135.0	11146.7									614.5	11146.7	1228.9	11146.7			36.9	73.7							
		200+17.01	200+16.60																										
Bridge		200+16.60	206+13.60	32.0	597.0	2122.7									117.0	2122.7	234.0	2122.7			7.0	14.0							
		206+13.60	231+07.00	32.0	2493.4	8865.4									488.7	8865.4	977.4	8865.4			29.3	58.6							
		231+07.00	232+57.00	32.0	150.0	533.3									29.4	533.3	29.4	533.3			1.8	1.8							
		232+57.00	234+57.00		200.0																								
		234+57.00	236+07.00	32.0	150.0	533.3									29.4	533.3	29.4	533.3			1.8	1.8							
		236+07.00	249+01.90	32.0	1294.9	4604.1									253.8	4604.1	507.6	4604.1			15.2	30.5							
		249+01.90	250+21.90	32-44	120.0	506.7									27.9	506.7	55.9	506.7			1.7	3.4							
		250+21.90	252+06.90	44.0	185.0	904.4									49.9	904.4	99.7	904.4			3.0	6.0							
		252+06.90	252+78.87	32.0	72.0	255.9									14.1	255.9	28.2	255.9			0.8	1.7							
		252+78.87	1252+77.50																										
		1252+77.50	1253+49.50	32.0	72.0	256.0									14.1	256.0	28.2	256.0			0.8	1.7							
		1253+49.50	1255+34.50	44.0	185.0	904.4									49.9	904.4	99.7	904.4			3.0	6.0							
		1255+34.50	1256+54.50	44-32	120.0	506.7									27.9	506.7	55.9	506.7			1.7	3.4							
		1256+54.50	1305+75.95	32.0	4921.5	17498.5									964.6	17498.5	1929.2	17498.5			57.9	115.8							
		1305+75.95	1305+73.40																										
		1305+73.40	1434+36.17	32.0	12862.8	45734.3									2521.1	45734.3	5042.2	45734.3			151.3	302.5							
		1434+36.17	1445+48.36																										
		1445+48.36	1483+79.34	32.0	3831.0	13621.3									750.9	13621.3	1501.7	13621.3			45.1	90.1							
		1483+79.34	1485+29.34	32.0	150.0	533.3									29.4	533.3	29.4	533.3			1.8	1.8							
Park Windsor Blvd	LT	12+75.00		30.0	70.0	831.2																							
	LT	19+22.00		30.0	80.0	1016.2																							

HMA PAVEMENT

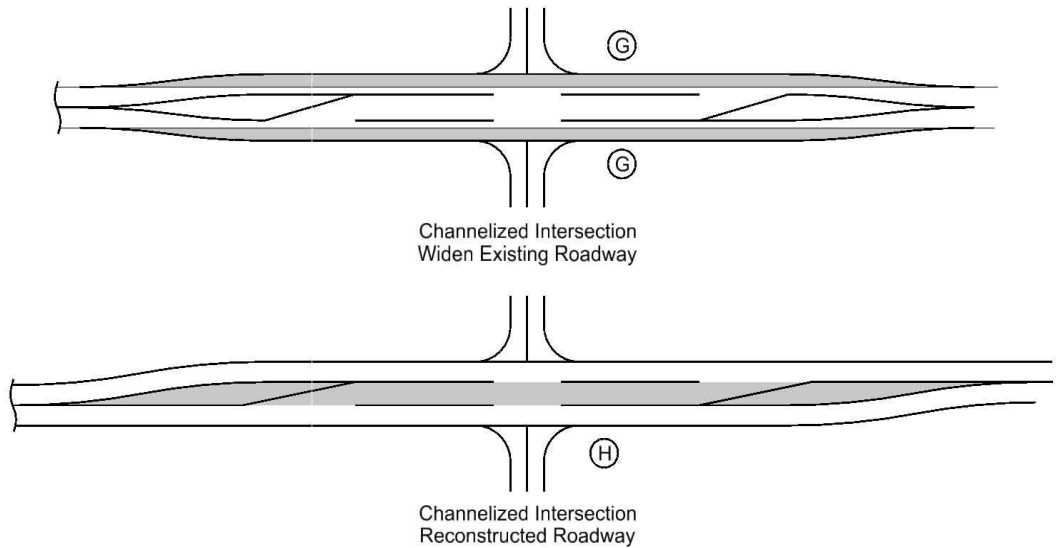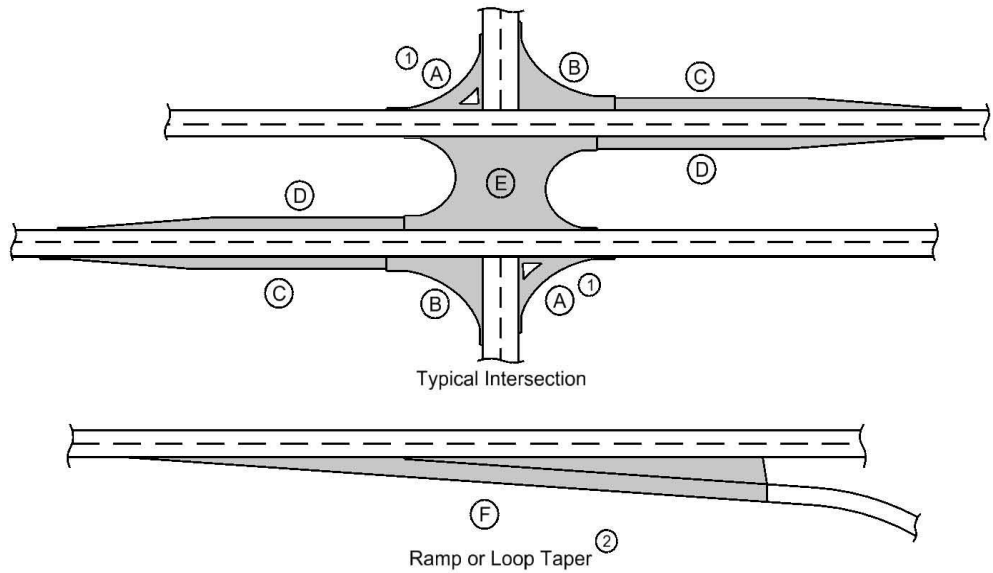

- ① Does not include raised island area or curb. Refer to tabulation 112-4 for quantities.
- ② Refer to PV-410, PV-411, PV-412, and PV-414.
- ③ Quantity includes Pavement Header.

Calculations assume a surface course unit weight (lbs/cf) of 147, an intermediate course unit weight (lbs/cf) of 147, a base course unit weight (lbs/cf) of 145, and a special backfill unit weight (lbs/cf) of 140.

Location				Mainline			Area ③								Bid Items													Remarks
															Hot Mix Asphalt Pavement						Binder			Special Backfill	Modified Subbase	Granular Subbase	Pavement Scarification	
Road Identification	Direction of Travel	Station to Station		Width	Length	Area	A ①	B	C	D	E	F ②	G	H	Surface		Intermediate		Cold-In-Place		Surface	Intermediate	Foam Asphalt					
															TONS	SY	TONS	SY	WIDTH	SY				TONS	TONS	TONS	TONS	
Chruch Dr	RT	26+81.00		30.0	80.0	921.2																						
Hospital Dr	LT	27+08.00		30.0	80.0	891.2																						
Quail	RT	43+00.00		10.0	75.0	476.6																						
Raven/S53	RT	95+29.33		10.0	70.0	440.6																						
Raven	LT	95+29.33		10.0	87.0	476.6																						
Spruce/S55	RT	148+17.06		10.0	80.0	752.6																						
Spruce	LT	148+17.06		10.0	73.0	476.6																						
Timber/S56	RT	252+78.87		30.0	70.0	831.2																						
Timber	LT	252+78.87		30.0	80.0	831.2																						
Vine	RT	1305+75.95		10.0	60.0	476.6																						
Vine	LT	1305+75.95		10.0	86.0	452.6																						
Wren	RT	1384+97.40		10.0	112.0	761.1																						
Wren	LT	1384+97.40		10.0	100.0	440.6																						
Yarrow	RT	1418+88.80		10.0	60.0	566.1																						
Yarrow/150thSt	LT	1418+88.80		30.0	115.0	1026.4																						
Franklin	RT	1485+29.30		10.0	75.0	464.6																						
Franklin/33	LT	1485+29.30		10.0	87.0	512.6																						
															11181.4	169006.7	20336.2	169006.7	0.0	0.0	670.9	1220.2	0.0	0.0	0.0	1707.7	TOTA	
Quail	RT	43+00.00		40.0		891.2																						
Raven/S53	RT	95+29.33		40.0		831.2																						
Raven	LT	95+29.33		40.0		891.2																						
Spruce/S55	RT	148+17.06		40.0		851.2																						
Spruce	LT	148+17.06		40.0		891.2																						
Vine	RT	1305+75.95		40.0		476.6																						
Vine	LT	1305+75.95		40.0		851.2																						
Wren	RT	1384+97.40		40.0		1339.7																						
Wren	LT	1384+97.40		40.0		831.2																						
Yarrow	RT	1418+88.80		40.0		1052.7																						
Franklin	RT	1485+29.30		40.0		891.2																						
Franklin/33	LT	1485+29.30		40.0		851.2																						
															0.0	0.0	0.0	0.0	0.0	0.0	0.0	0.0	0.0	0.0	0.0	0.0	TOTA	

112-9 10-20-20																										
SHOULDERS																										
① Lane(s) to which the shoulder is adjacent. ② See Typ. 7156, 7157, or 7158. ③ Bid Item. ④ Applies only for Paved Shoulders constructed on project with existing granular shoulders. ⑤ Bid Item. Typ. 7156, 7157, or 7158. ⑥ Does not include shrink.																										
Calculations assume a HMA unit weight (lbs/cf) of 0, a Special Backfill unit weight (lbs/cf) of 140, and a Granular Shoulder unit weight (lbs/cf) of 140.																										
Road Identification	① Direction Of Traffic	Location			P Width	P_{SG} Width	G Width	L Length	Class 13 ^④ Excavation	Hot Mix Asphalt		Binder	Paved Shoulder	" Paved Shoulder at Guardrail	Reinforced Paved Shoulder	Quantities				Subbase CY ③	Granular Shoulder		Earth Shoulder Construction Alternates			Remarks
		Station to Station	Side	Special Backfill												STA ^③	HMA CY ⑥	PCC CY ⑥								
				HMA Alternate															PCC Alternate							
				TON ③															TON/STA				TON ③	TON/STA		
FT	FT ②	FT	FT	CY ③	TON	TON/STA	TONS	SY ③	SY ⑤	SY ③	TON ③	TON/STA	TON ③	TON/STA	TON ③	TON/STA	TON ③	TON/STA	STA ③	HMA CY ⑥	PCC CY ⑥					
IA 3 Bridge		4+80.00	8+61.00	RT			6.0	381.0													33.338	8.750	3.8			
		11+59.00	20+29.00	RT			6.0	870.0													76.125	8.750	8.7			
		20+29.00	47+84.46	RT			6.0	2755.5													241.103	8.750	27.6			
STA EQ		47+82.85	95+29.33	RT			6.0	4746.5													415.317	8.750	47.5			
STA EQ		95+26.70	148+17.06	RT			6.0	5290.4													462.907	8.750	52.9			
STA EQ		148+15.40	200+17.01	RT			6.0	5201.6													455.141	8.750	52.0			
STA EQ		200+16.60	231+52.00	RT			6.0	3135.4													274.348	8.750	31.4			
Bridge		235+51.00	252+66.87	RT			6.0	1715.9													150.139	8.750	17.2			
STA EQ		1252+77.50	1305+75.95	RT			6.0	5298.5													463.614	8.750	53.0			
STA EQ		1305+73.40	1434+36.17	RT			6.0	12862.8													1125.492	8.750	128.6			
		4+90.00	9+15.00	LT			6.0	425.0													37.188	8.750	4.3			
Bridge		12+39.00	48+00.00	LT			6.0	3561.0													311.588	8.750	35.6			
STA EQ		47+82.85	95+29.33	LT			6.0	4746.5													415.317	8.750	47.5			
STA EQ		95+26.70	148+17.05	LT			6.0	5290.4													462.906	8.750	52.9			
STA EQ		148+15.40	164+11.00	LT			6.0	1595.6													139.615	8.750	16.0			
PCC shoulder		164+11.00	168+82.00	LT			0.0	471.0													0.000	0.000	4.7			
		168+82.00	200+17.01	LT			6.0	3135.0													274.313	8.750	31.4			
STA EQ		200+16.60	231+63.00	LT			6.0	3146.4													275.310	8.750	31.5			
Bridge		235+62.00	252+78.87	LT			6.0	1716.9													150.226	8.750	17.2			
STA EQ		1252+89.50	1305+75.95	LT			6.0	5286.5													462.564	8.750	52.9			
STA EQ		1305+73.40	1434+36.17	LT			6.0	12862.8													1125.492	8.750	128.6			
																					7352.041	175.000	844.9	0.0	0.0	TOTAL

108-29 04-21-15																													
PAVEMENT MARKING SYMBOLS AND LEGENDS																													
Refer to PM-111																													
Road Identification	Location																			SCHOOL	XING	STOP	AHEAD	ONLY	BIKE	LANE	EXIT	Groove Cuts	Remarks
	Station	Side																											
			STAW	RTAW	LTAW	CSRW	CSLW	CSTW	CRLW	FERW	LLRW	RLRW	RRCW	BLSW	WCSW	WPSB	SCLW	XNGW	STPW	AHDW	ONLW	BIKW	LANW	XITW	EACH				

112-10 10-20-20												
MILLED RUMBLE STRIPS See PV-12 and PV-13												
* Calculated at 18" width for Shoulder.												
Road Identification	Location				L IN	Installation Length		Fog Seal* (Milled Rumble Strip)	Effective Shoulder Width			Remarks
	Station to Station		Shoulder Pavement Type	Rumble Strip Type (Centerline, Rt or Lt Shoulder)		PCC	HMA		PCC Paved	HMA Paved	Granular\ Earth	
						STA	STA					
								GAL	FT	FT	FT	
IA 3	33+13.15	47+84.46	HMA	Right Shoulder			14.71	16.0				
STA EQ	47+82.85	95+29.33	HMA	Right Shoulder			47.46	51.5				
STA EQ	95+26.70	148+17.06	HMA	Right Shoulder			52.90	57.4				
STA EQ	148+15.40	200+17.01	HMA	Right Shoulder			52.02	56.4				
STA EQ	200+16.60	231+40.00	HMA	Right Shoulder			31.23	33.9				
STA EQ	235+25.00	249+01.87	HMA	Right Shoulder			13.77	15.0				
STA EQ	1252+77.50	1305+75.95	HMA	Right Shoulder			52.98	57.4				
STA EQ	1305+73.40	1434+36.17	HMA	Right Shoulder			128.63	139.4				
STA EQ	1445+48.36	1485+29.34	HMA	Right Shoulder			39.81	43.2				
	30+00.00	48+00.00	HMA	Left Shoulder			18.00	19.5				
STA EQ	47+82.85	95+29.33	HMA	Left Shoulder			47.46	51.5				
STA EQ	95+26.70	148+17.06	HMA	Left Shoulder			52.90	57.4				
STA EQ	148+15.40	164+11.00	HMA	Left Shoulder			15.96	17.3				
STA EQ	168+82.00	200+17.01	HMA	Left Shoulder			31.35	34.0				
STA EQ	200+16.60	231+89.00	HMA	Left Shoulder			31.72	34.4				
STA EQ	235+75.00	252+78.87	HMA	Left Shoulder			17.04	18.5				
STA EQ	1252+77.50	1305+75.95	HMA	Left Shoulder			52.98	57.4				
STA EQ	1305+73.40	1434+36.17	HMA	Left Shoulder			128.63	139.4				
STA EQ	1445+48.36	1485+29.34	HMA	Left Shoulder			39.81	43.2				
	30+00.00	48+00.00	HMA	Centerline			18.00	0.0				
STA EQ	47+82.85	95+29.33	HMA	Centerline			47.46	0.0				
STA EQ	95+26.70	148+17.06	HMA	Centerline			52.90	0.0				
STA EQ	148+15.40	164+11.00	HMA	Centerline			15.96	0.0				
STA EQ	168+82.00	200+17.01	HMA	Centerline			31.35	0.0				
STA EQ	200+16.60	231+89.00	HMA	Centerline			31.72	0.0				
STA EQ	235+75.00	252+78.87	HMA	Centerline			17.04	0.0				
STA EQ	1252+77.50	1305+75.95	HMA	Centerline			52.98	0.0				
STA EQ	1305+73.40	1434+36.17	HMA	Centerline			128.63	0.0				
STA EQ	1445+48.36	1485+29.34	HMA	Centerline			39.81	0.0				
				Totals		PCC	HMA	Fog Seal				
				HMA Shoulders			869.38	942.8				
				HMA Centerlines			435.86					


***MNY4 - Factor of 1.00 as value includes number of 4-inch passes to cover median nose area.


****NPY4 - For estimating purposes only. No Passing Zone Lines will be located in the field.**


ELW4: Edge Line Right (White) @ 1.00

CHY8: Channelizing Line (Yellow) @ 2.00


FILE NO.	ENGLISH	DESIGN TEAM	KELLY\MEISE	FRANKLIN COUNTY	PROJECT NUMBER	NHSX-003-5(86)--3H-35	SHEET NUMBER	C.10
----------	---------	-------------	-------------	-----------------	----------------	-----------------------	--------------	------

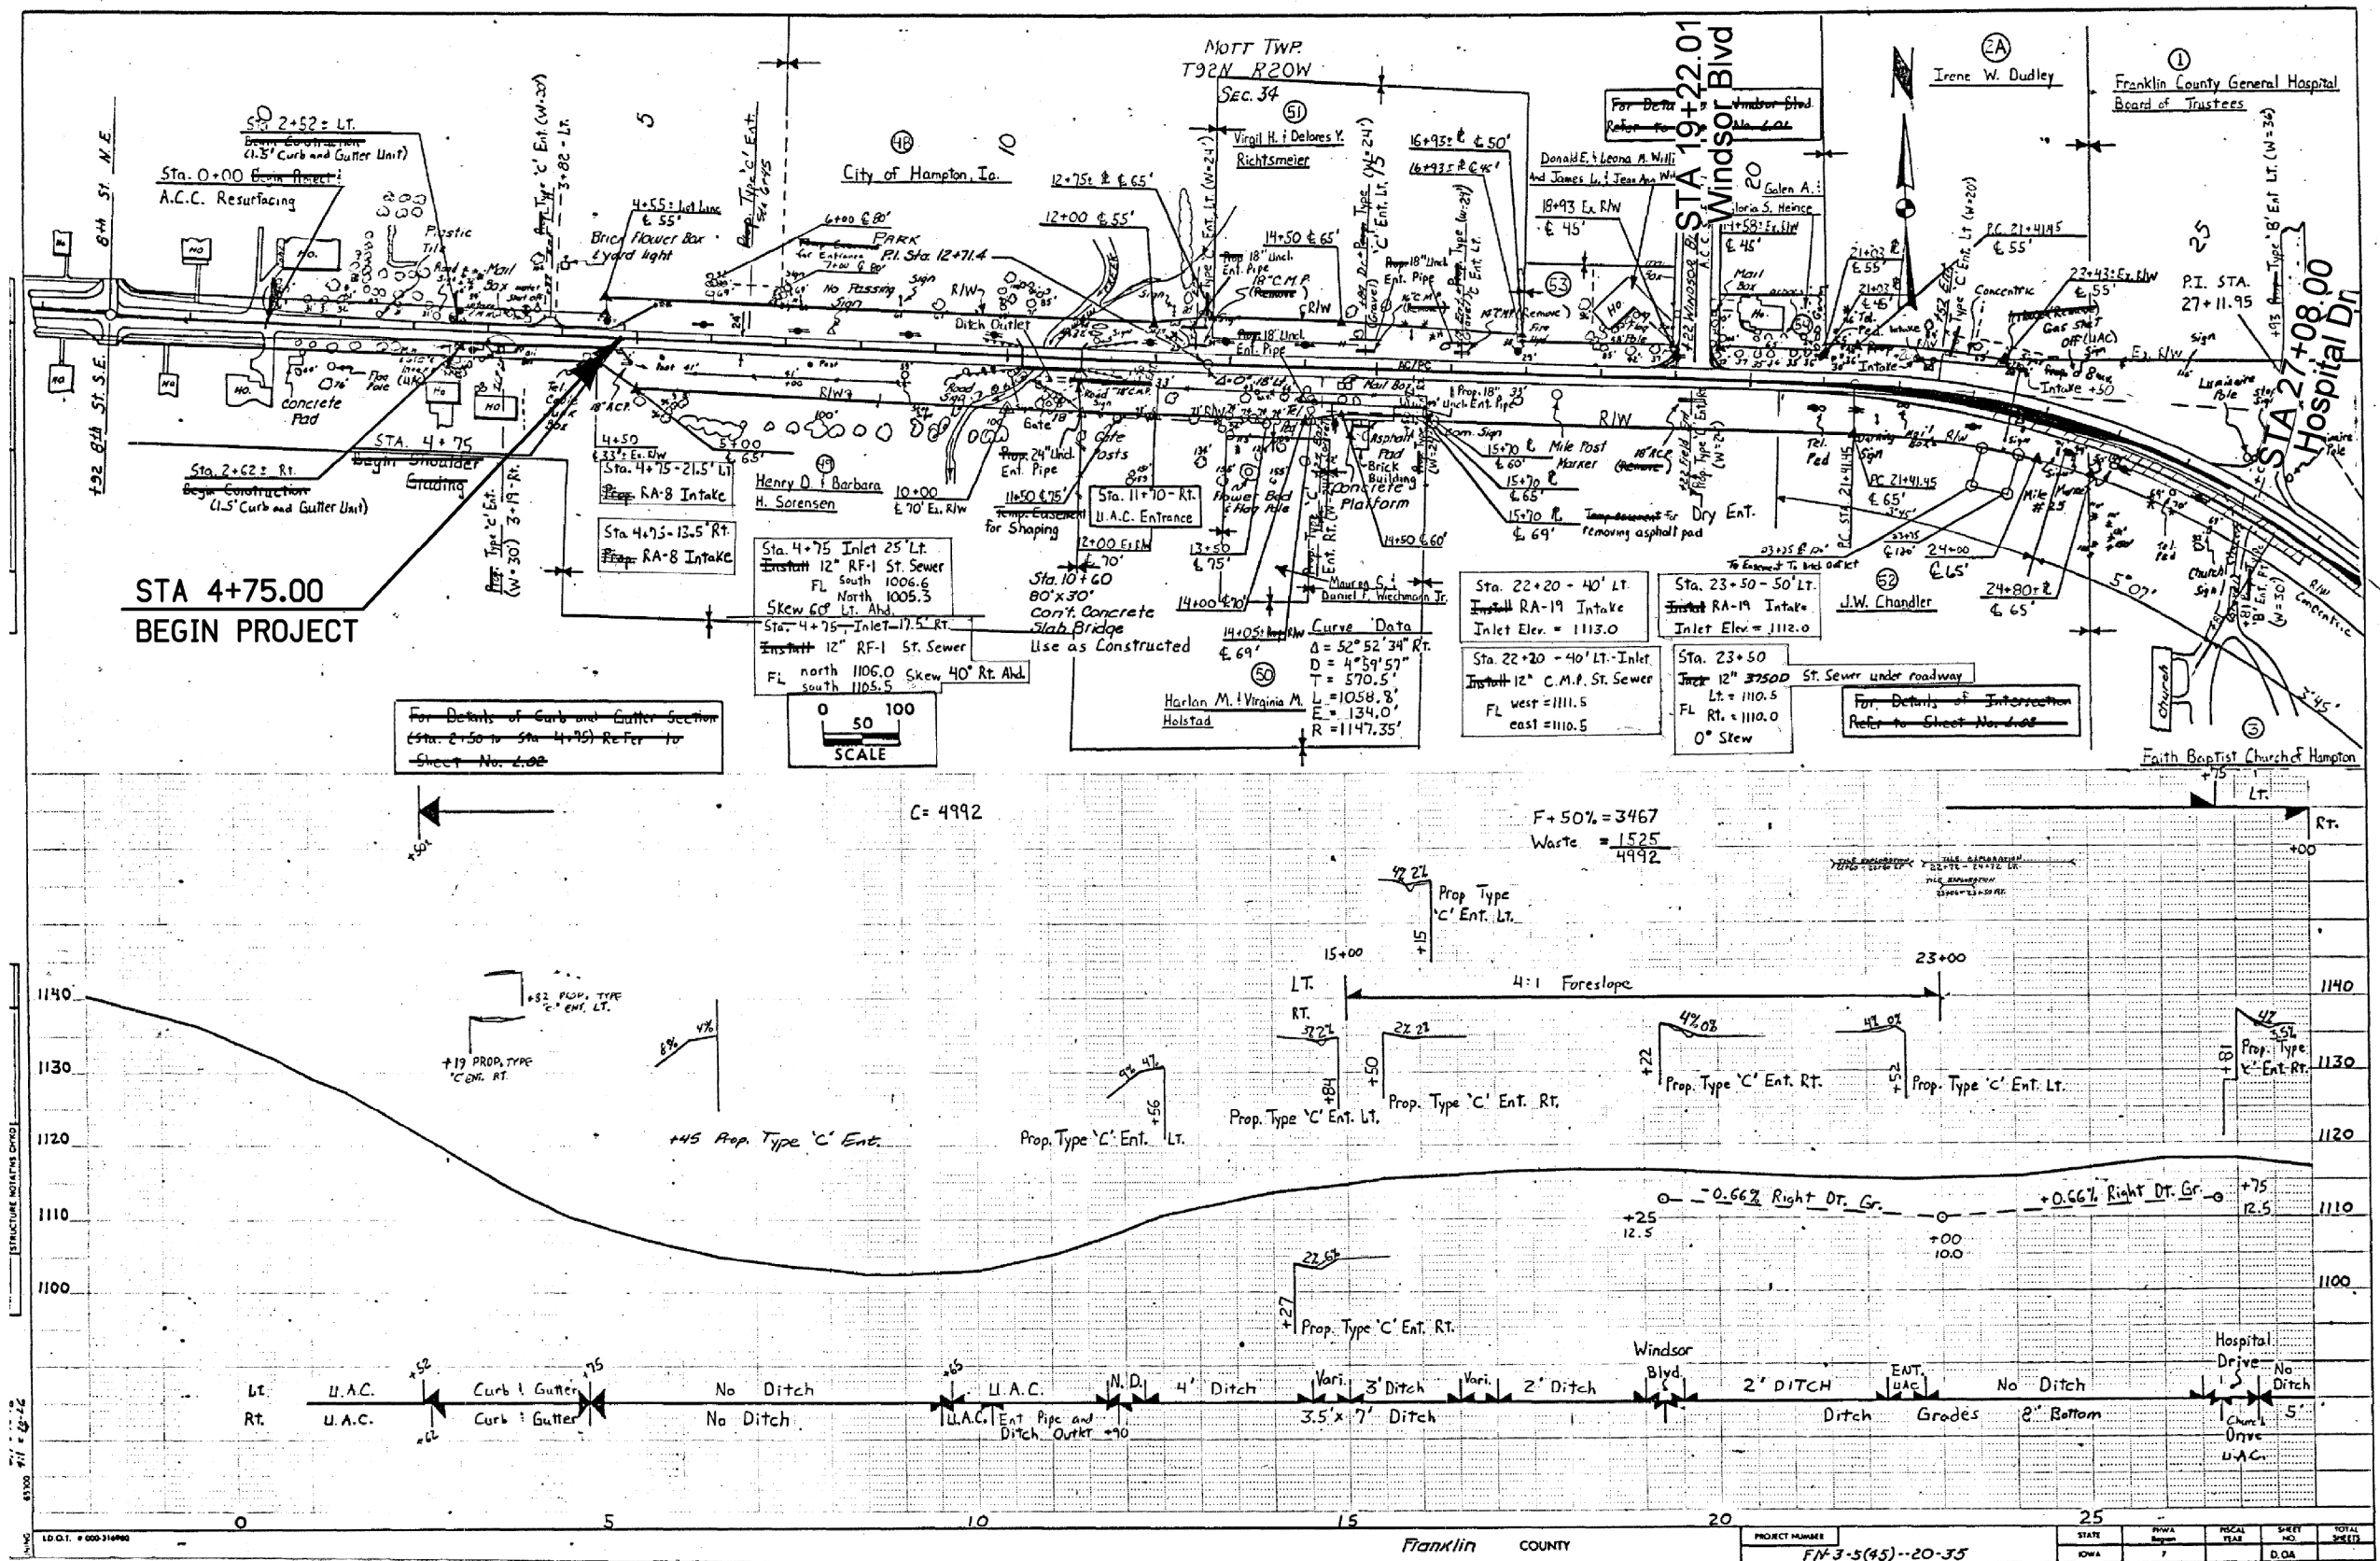


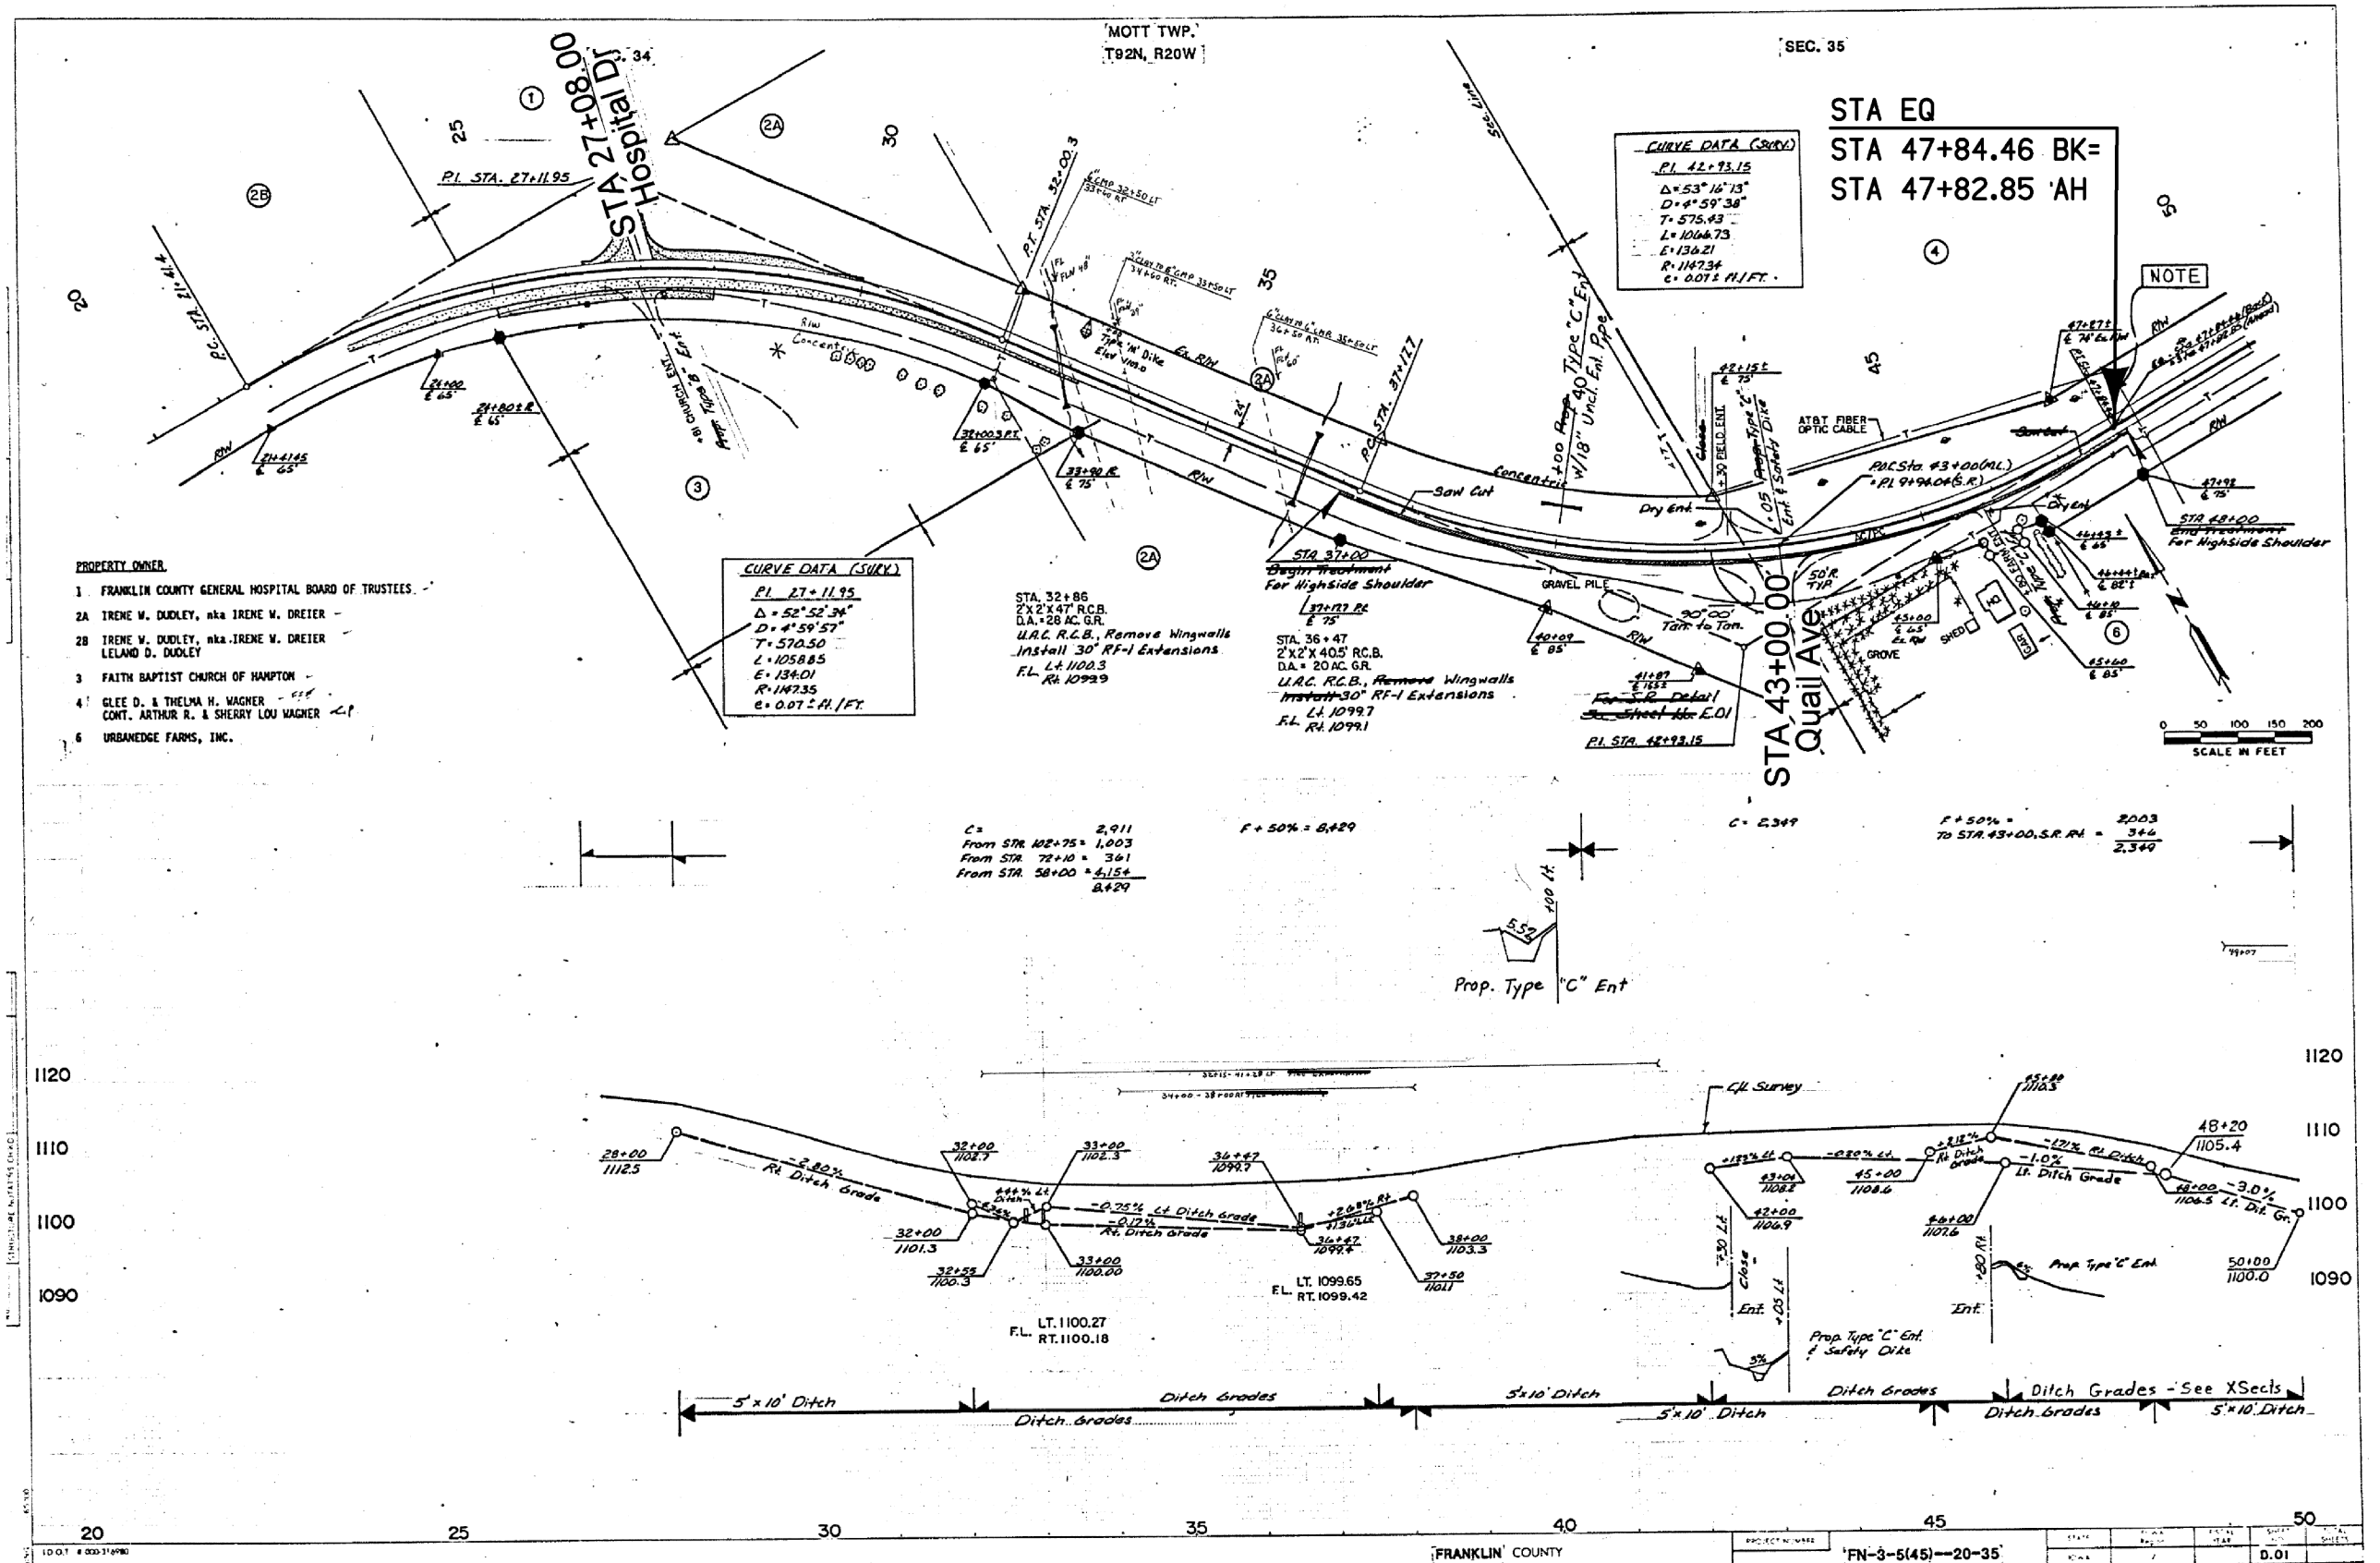

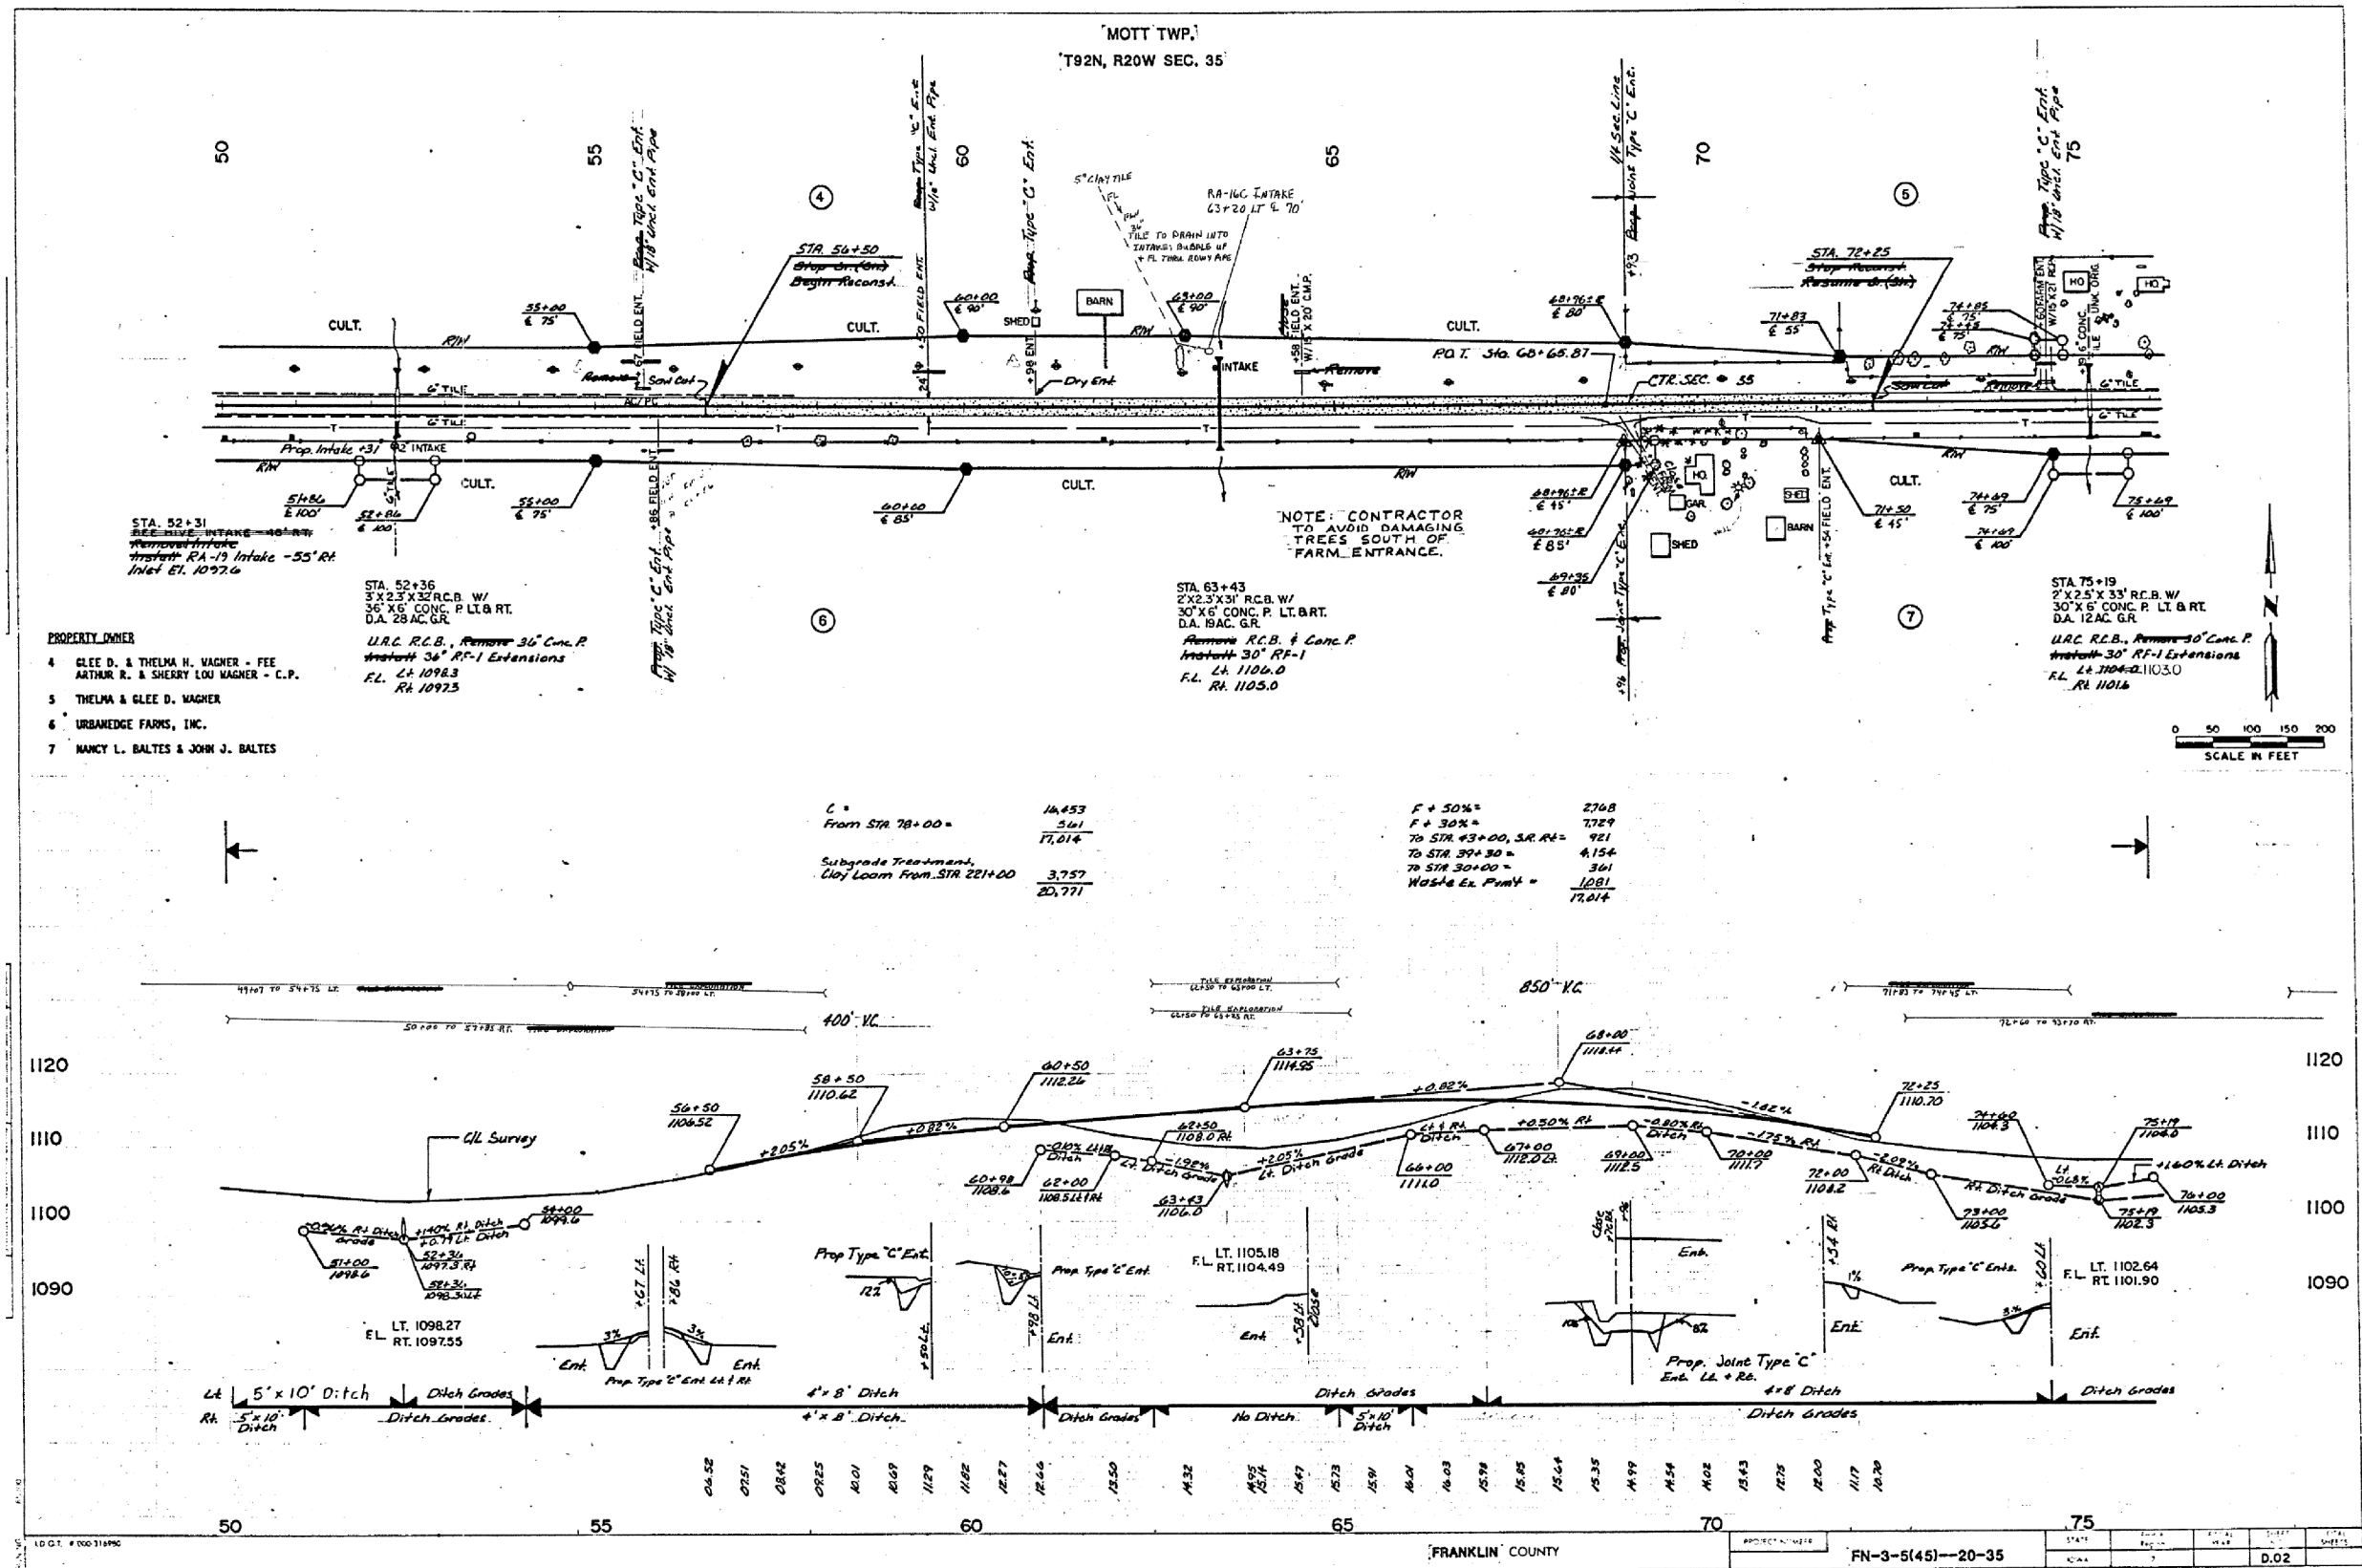



AS-BUILT PLANS, FOR INFORMATION ONLY

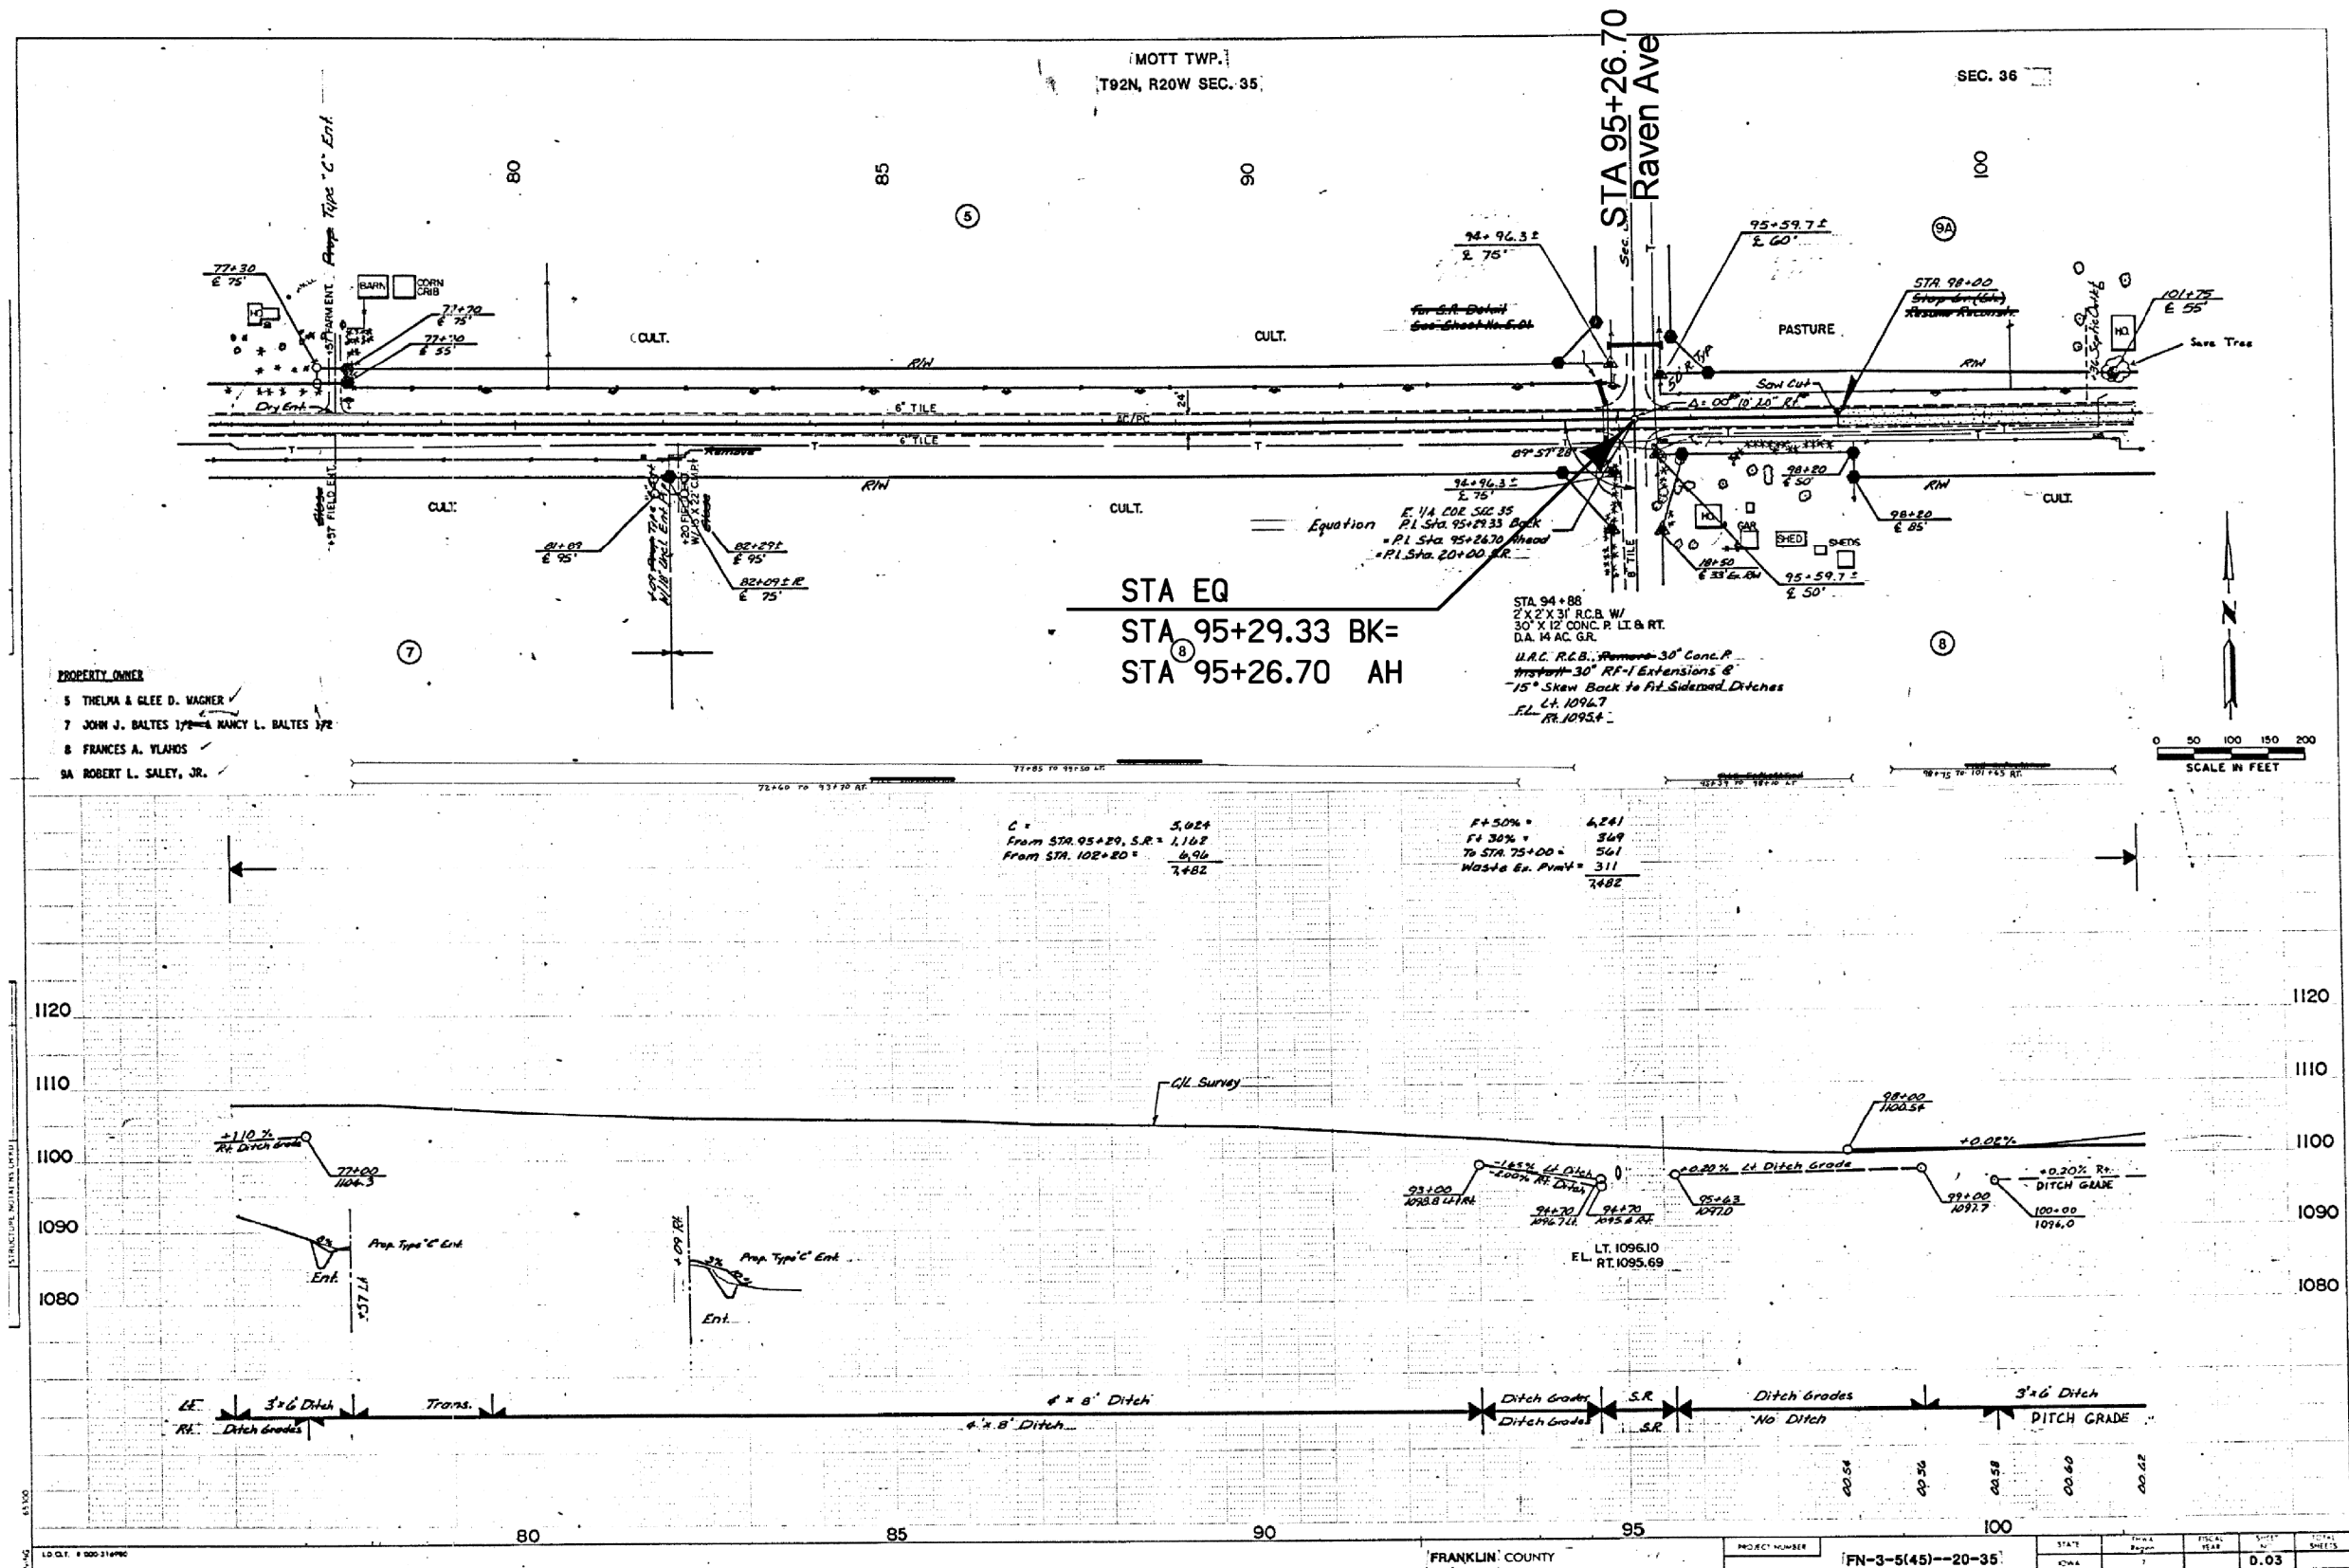

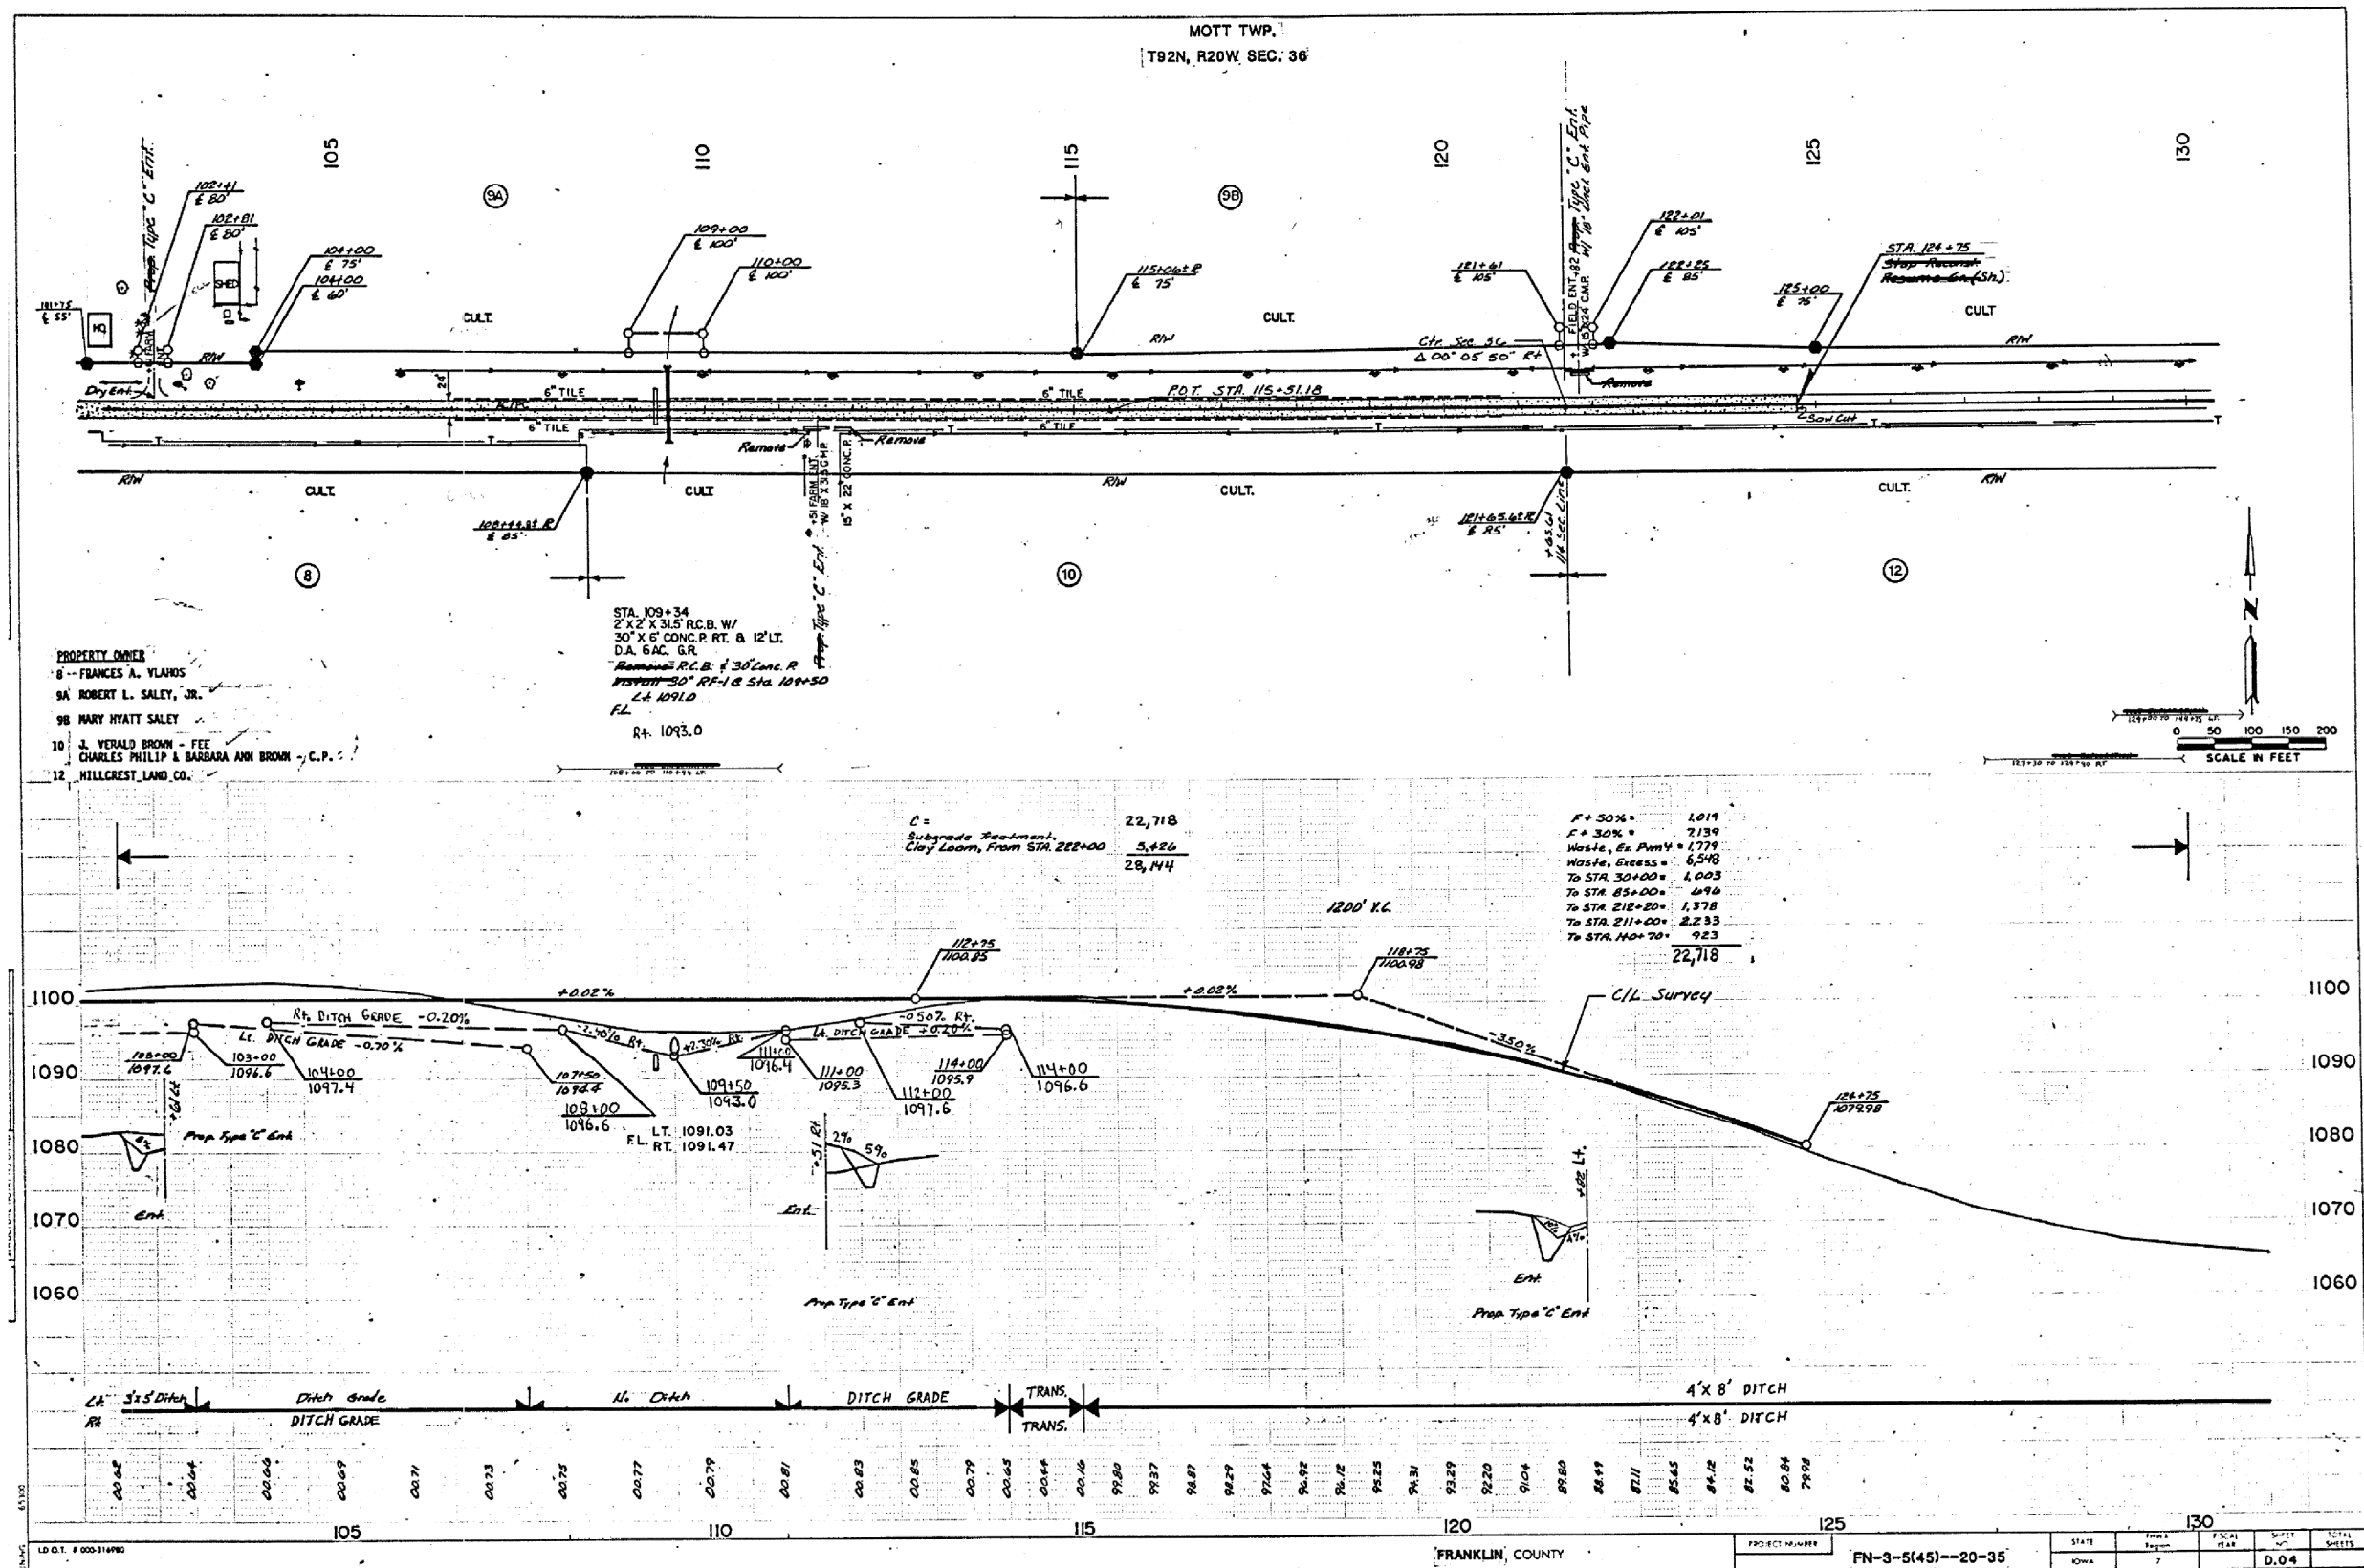



AS-BUILT PLANS, FOR INFORMATION ONLY

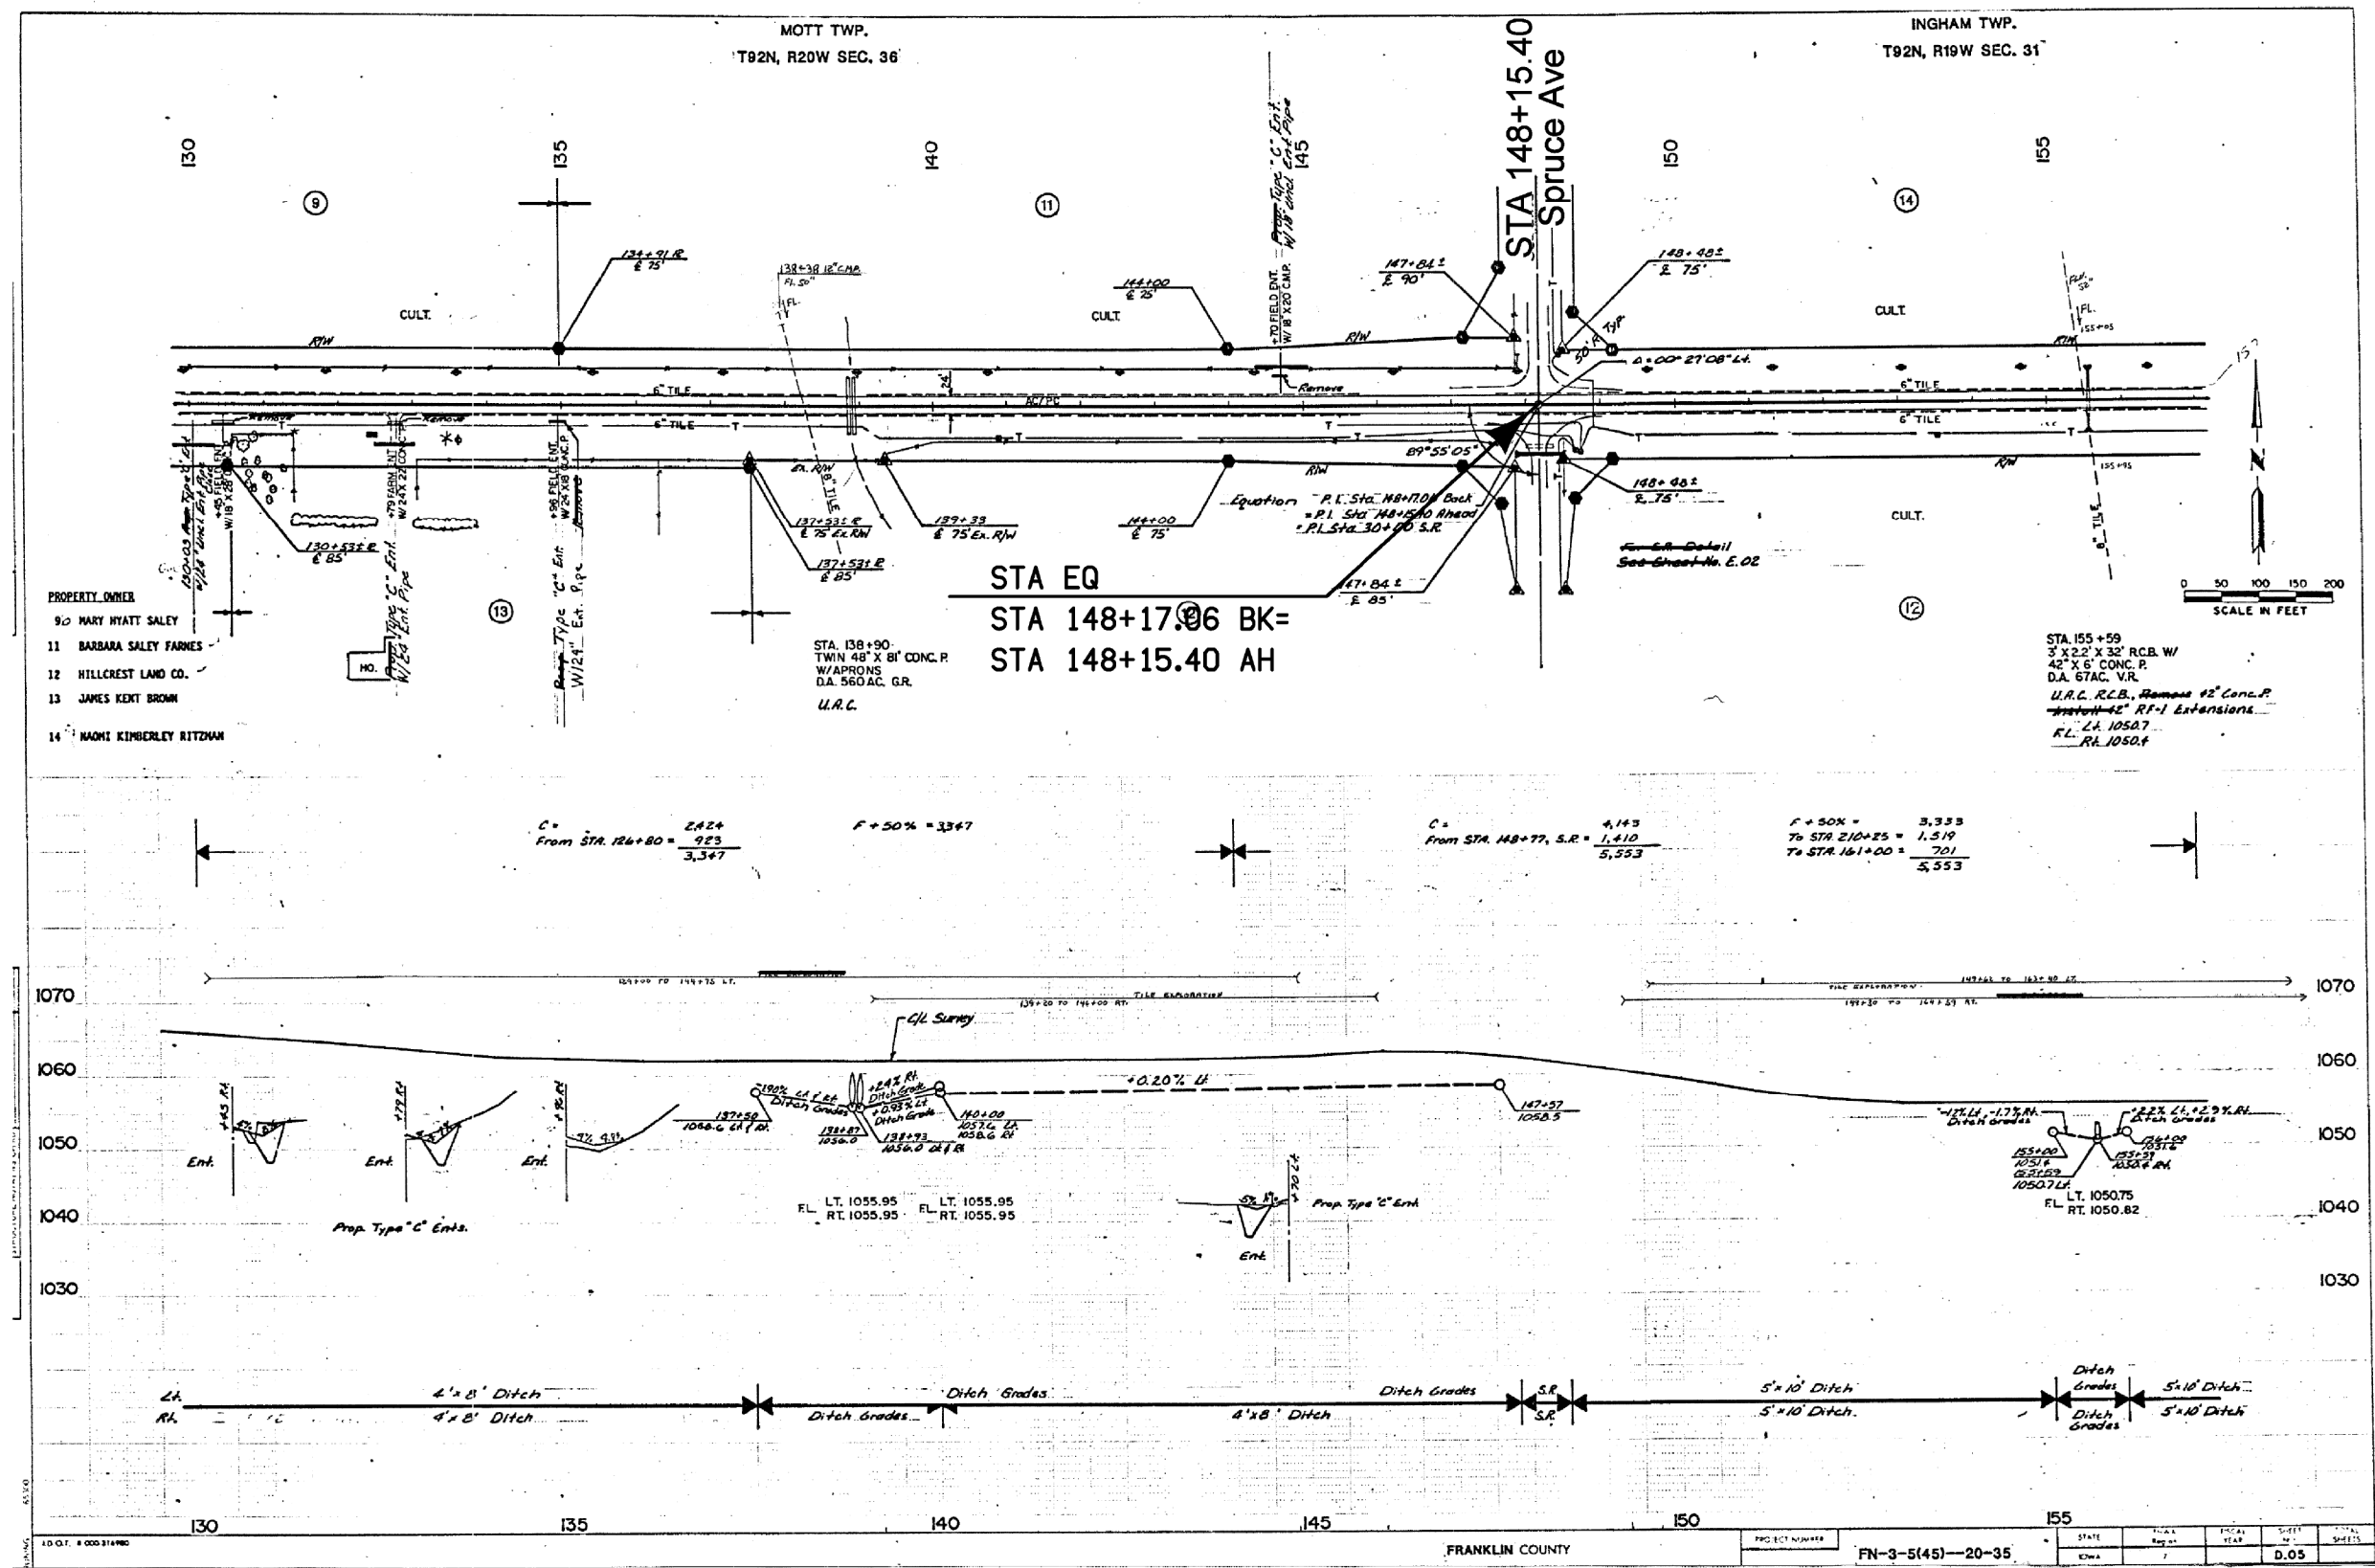

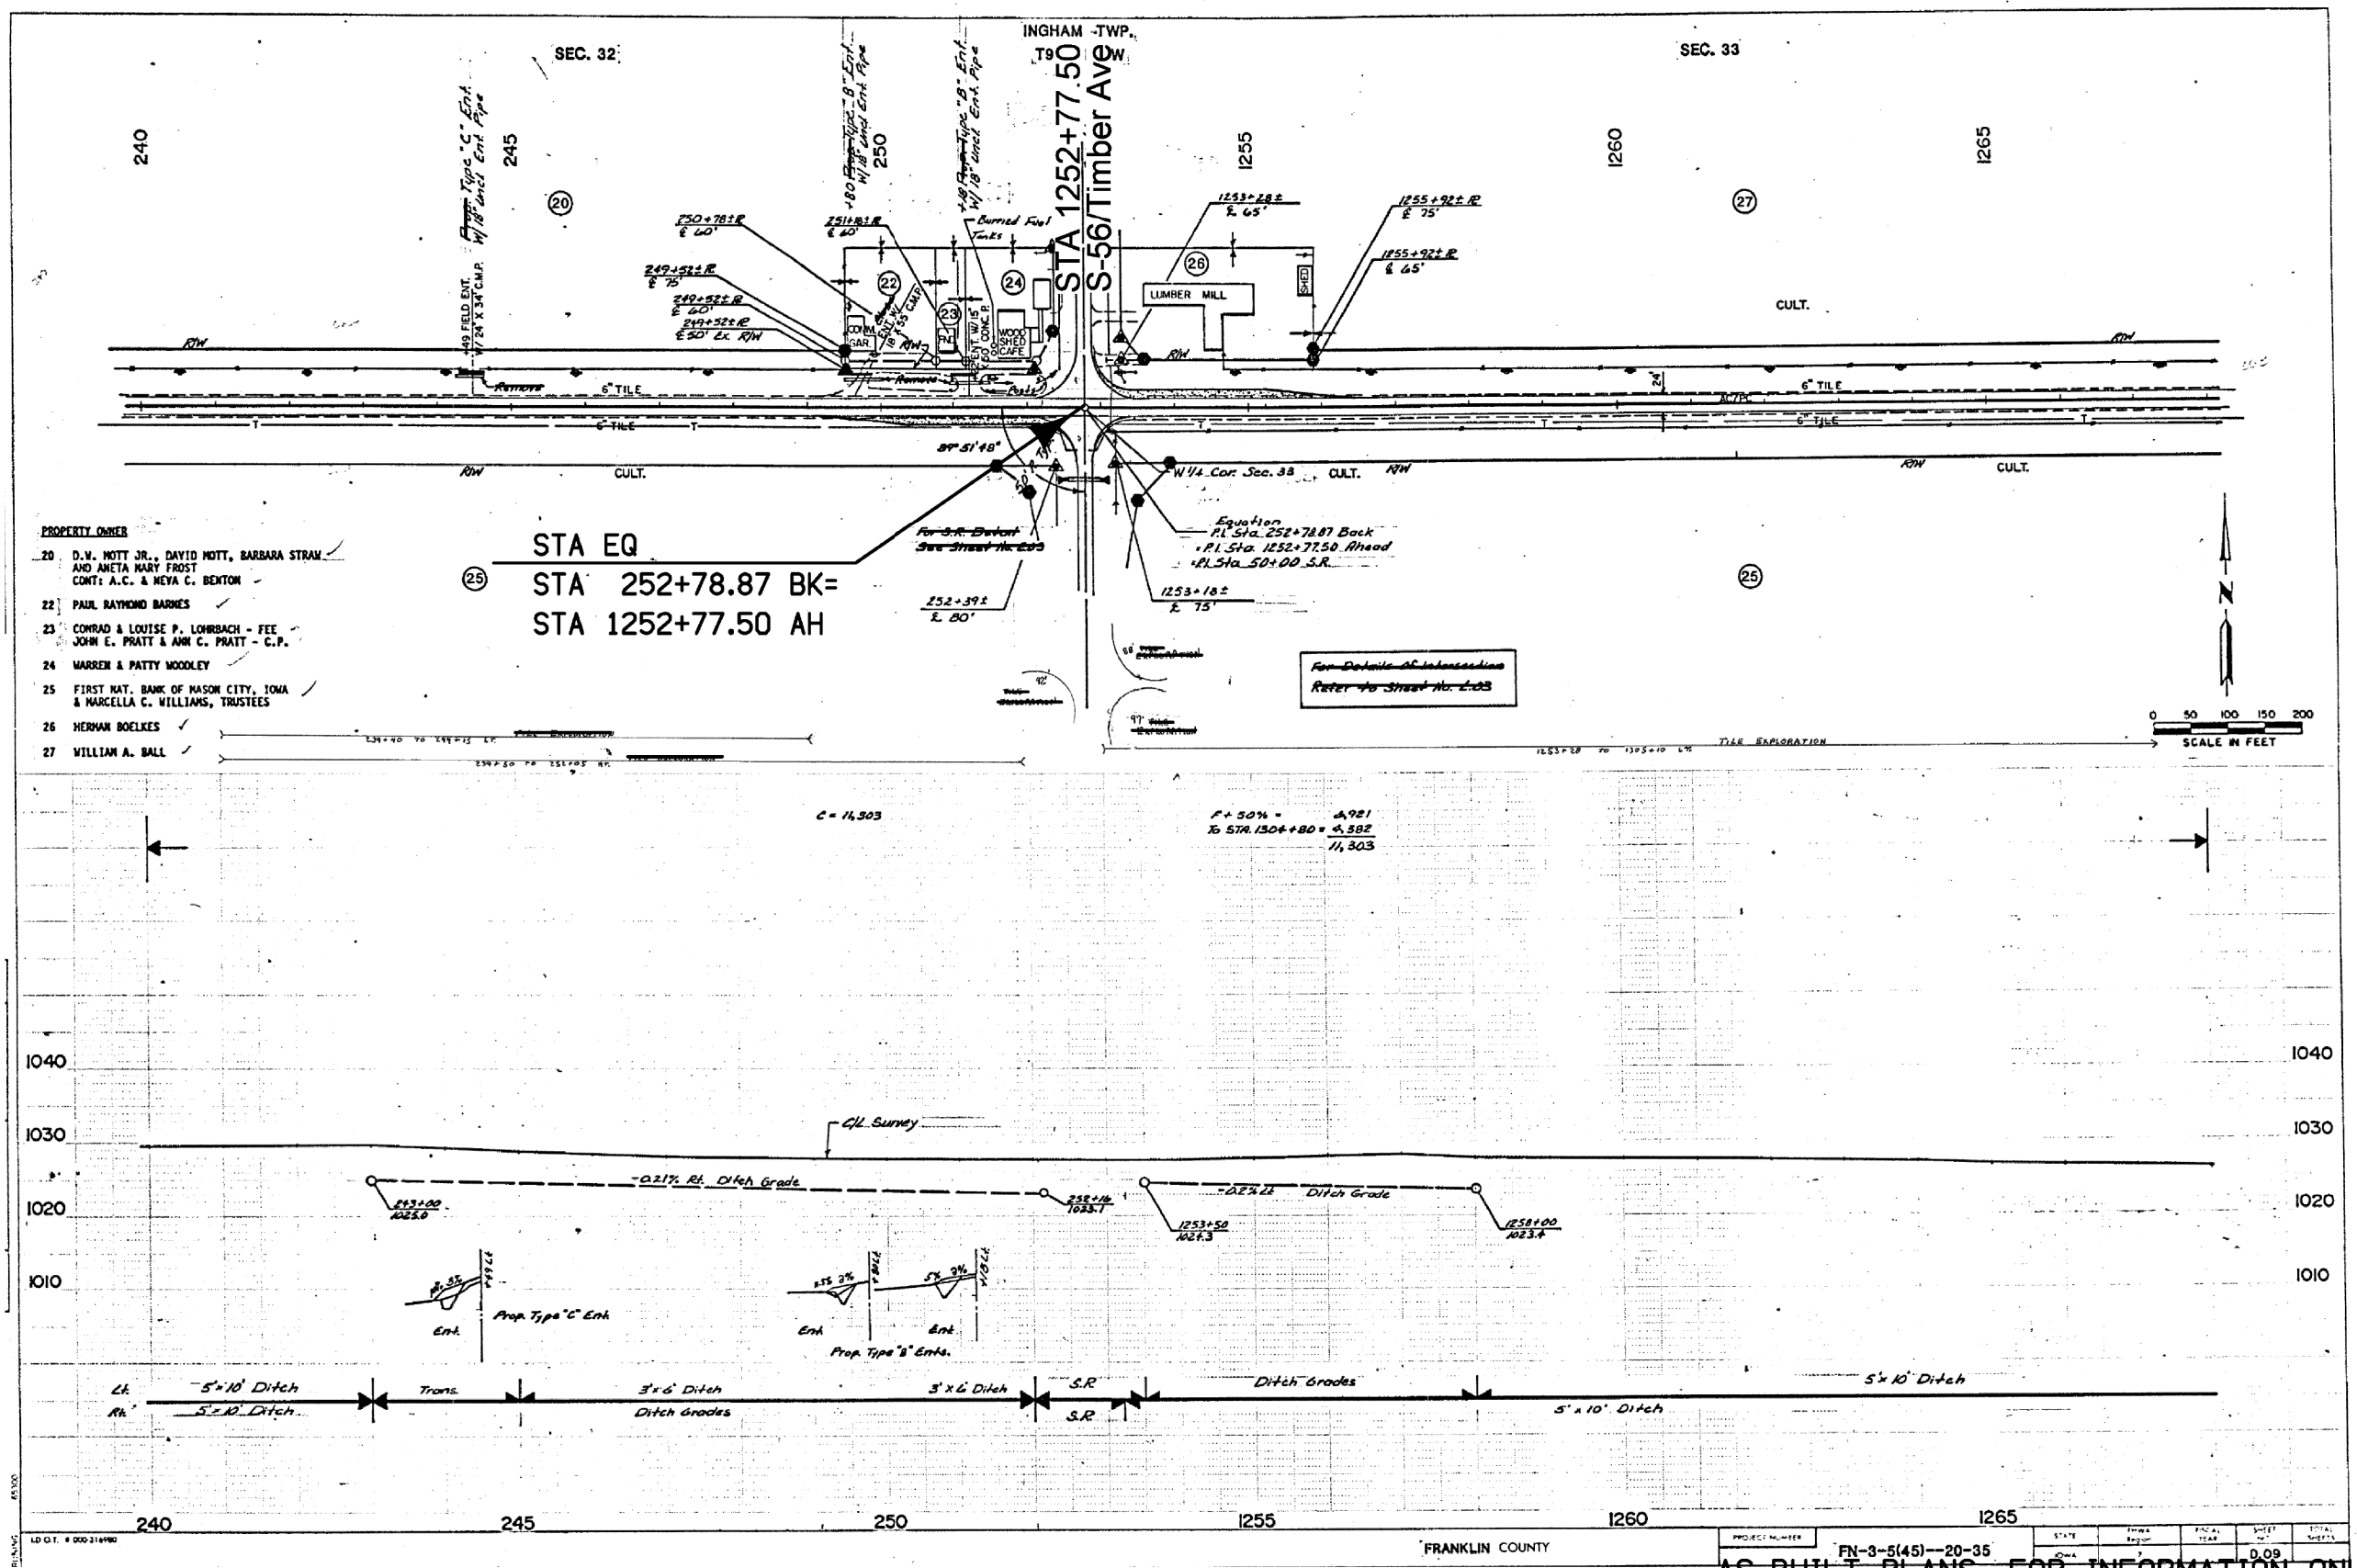


AS-BUILT PLANS, FOR INFORMATION ONLY

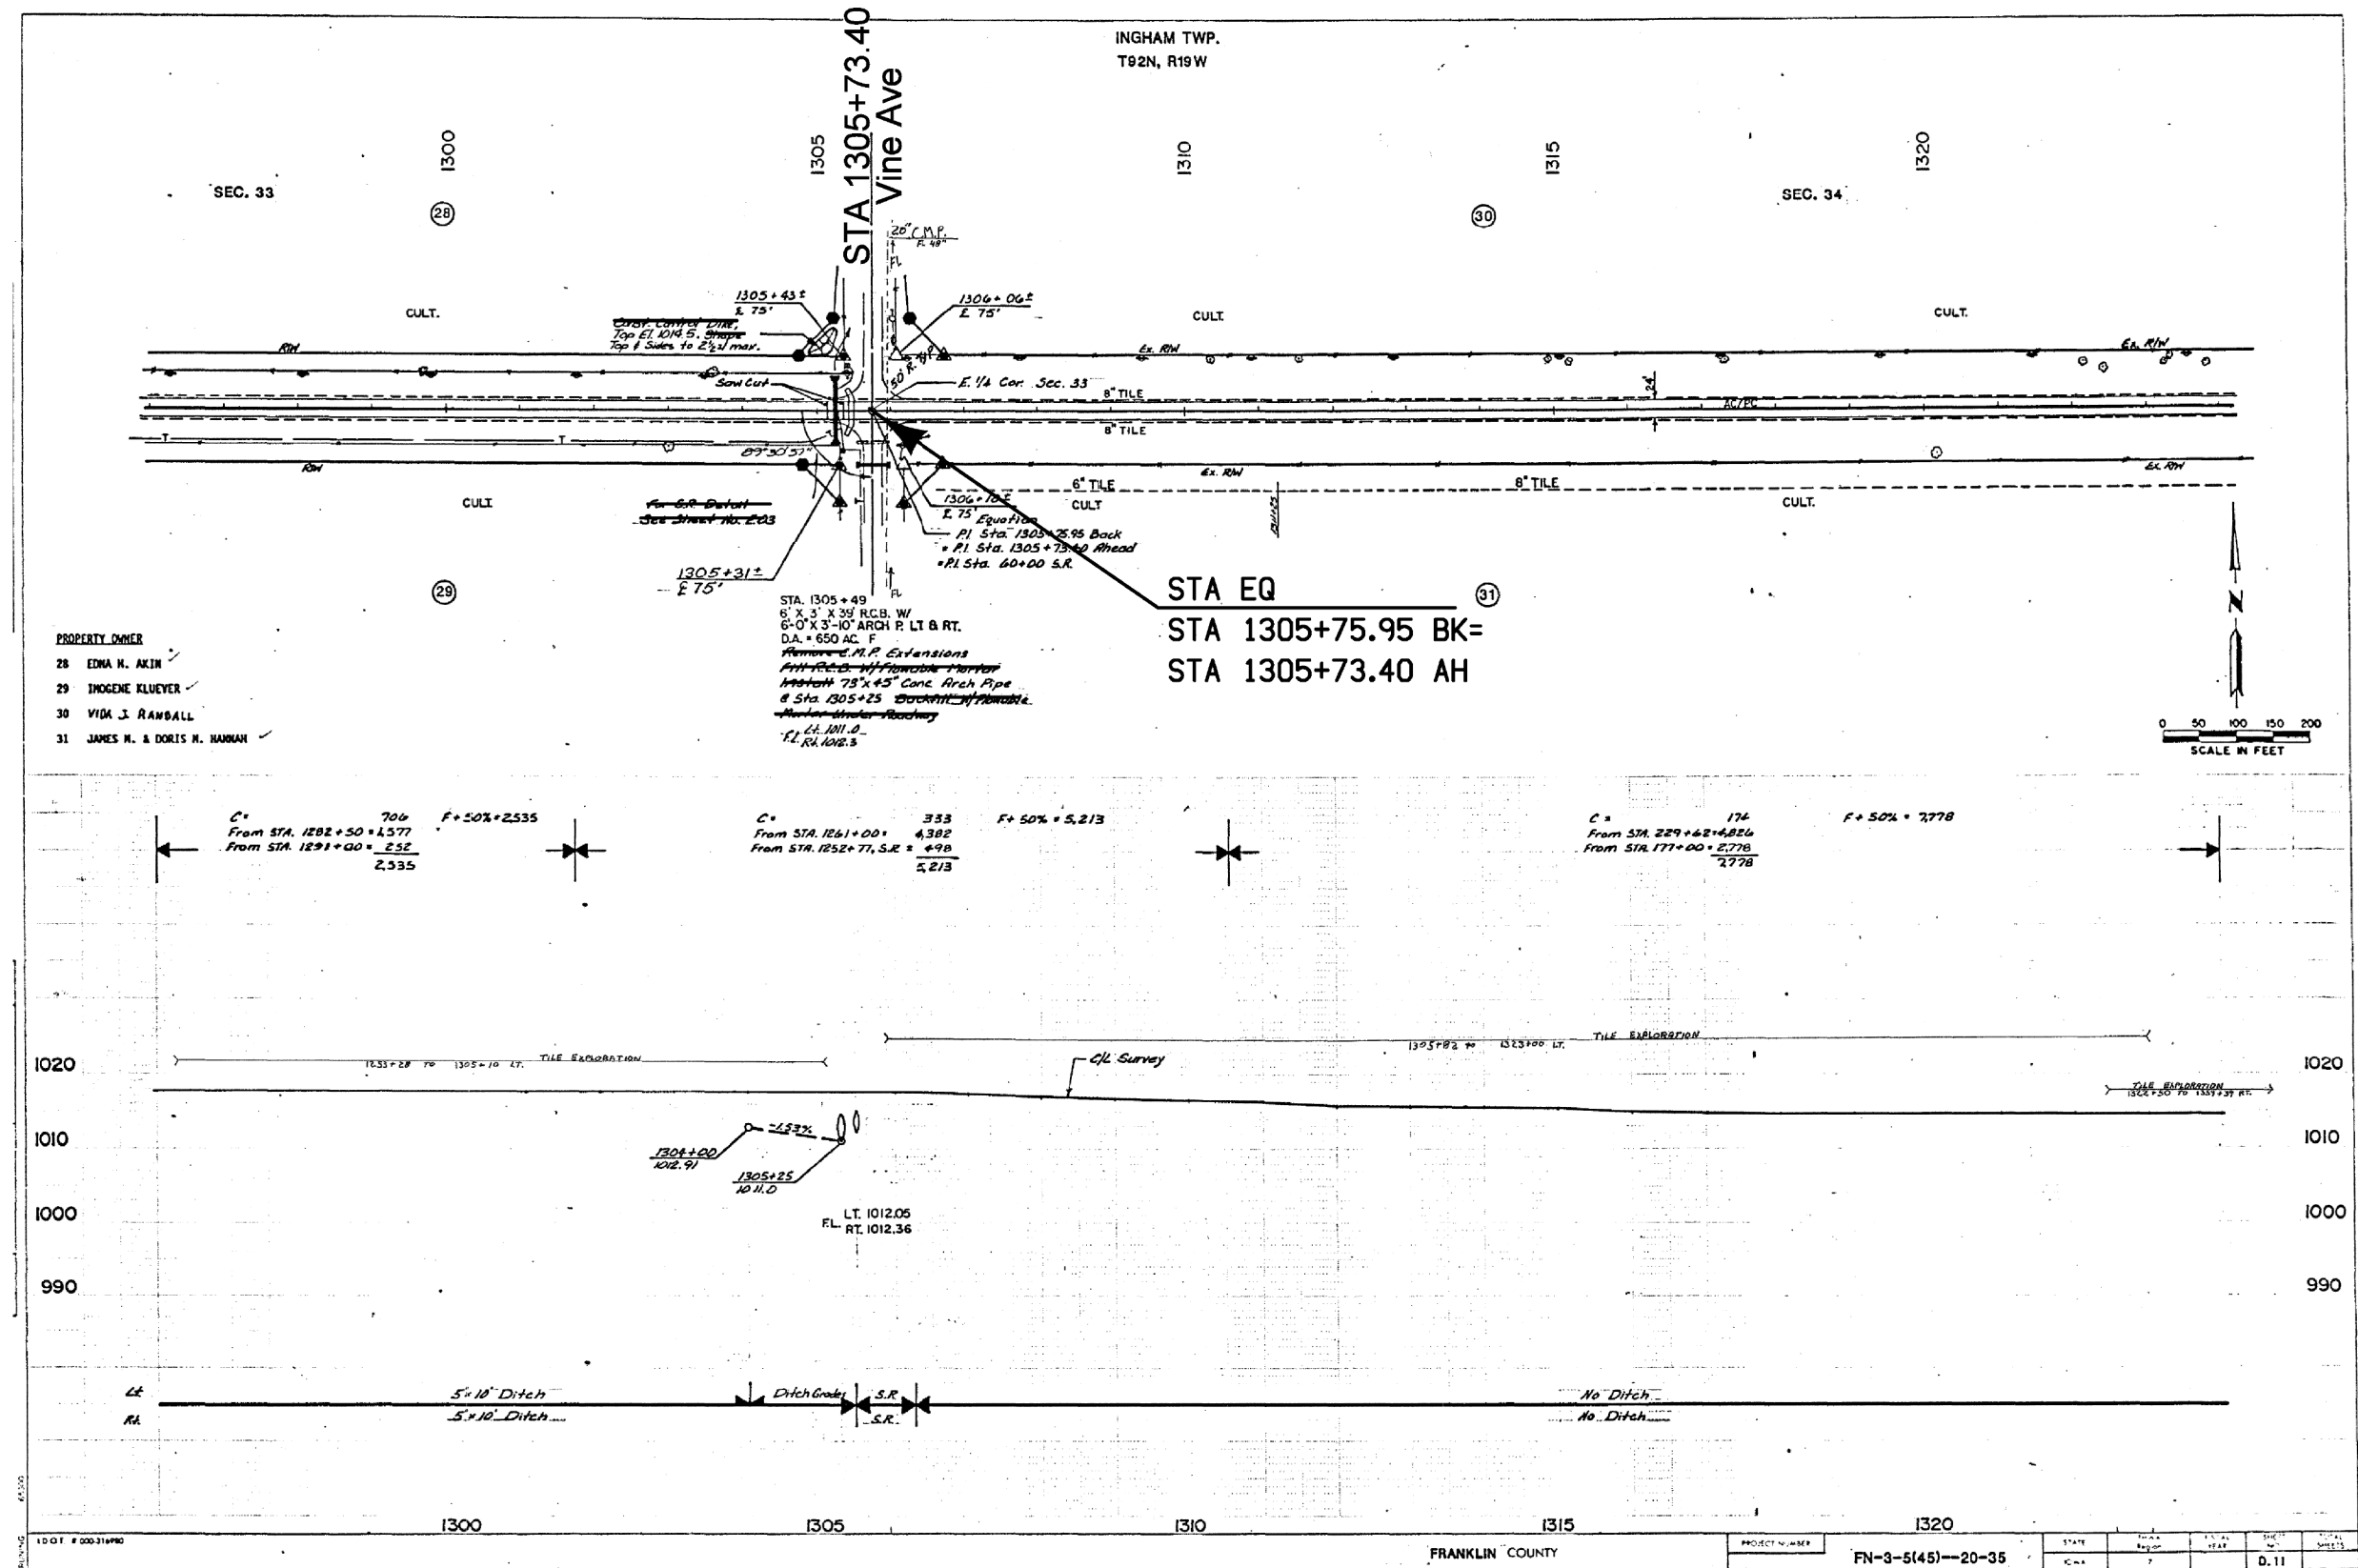

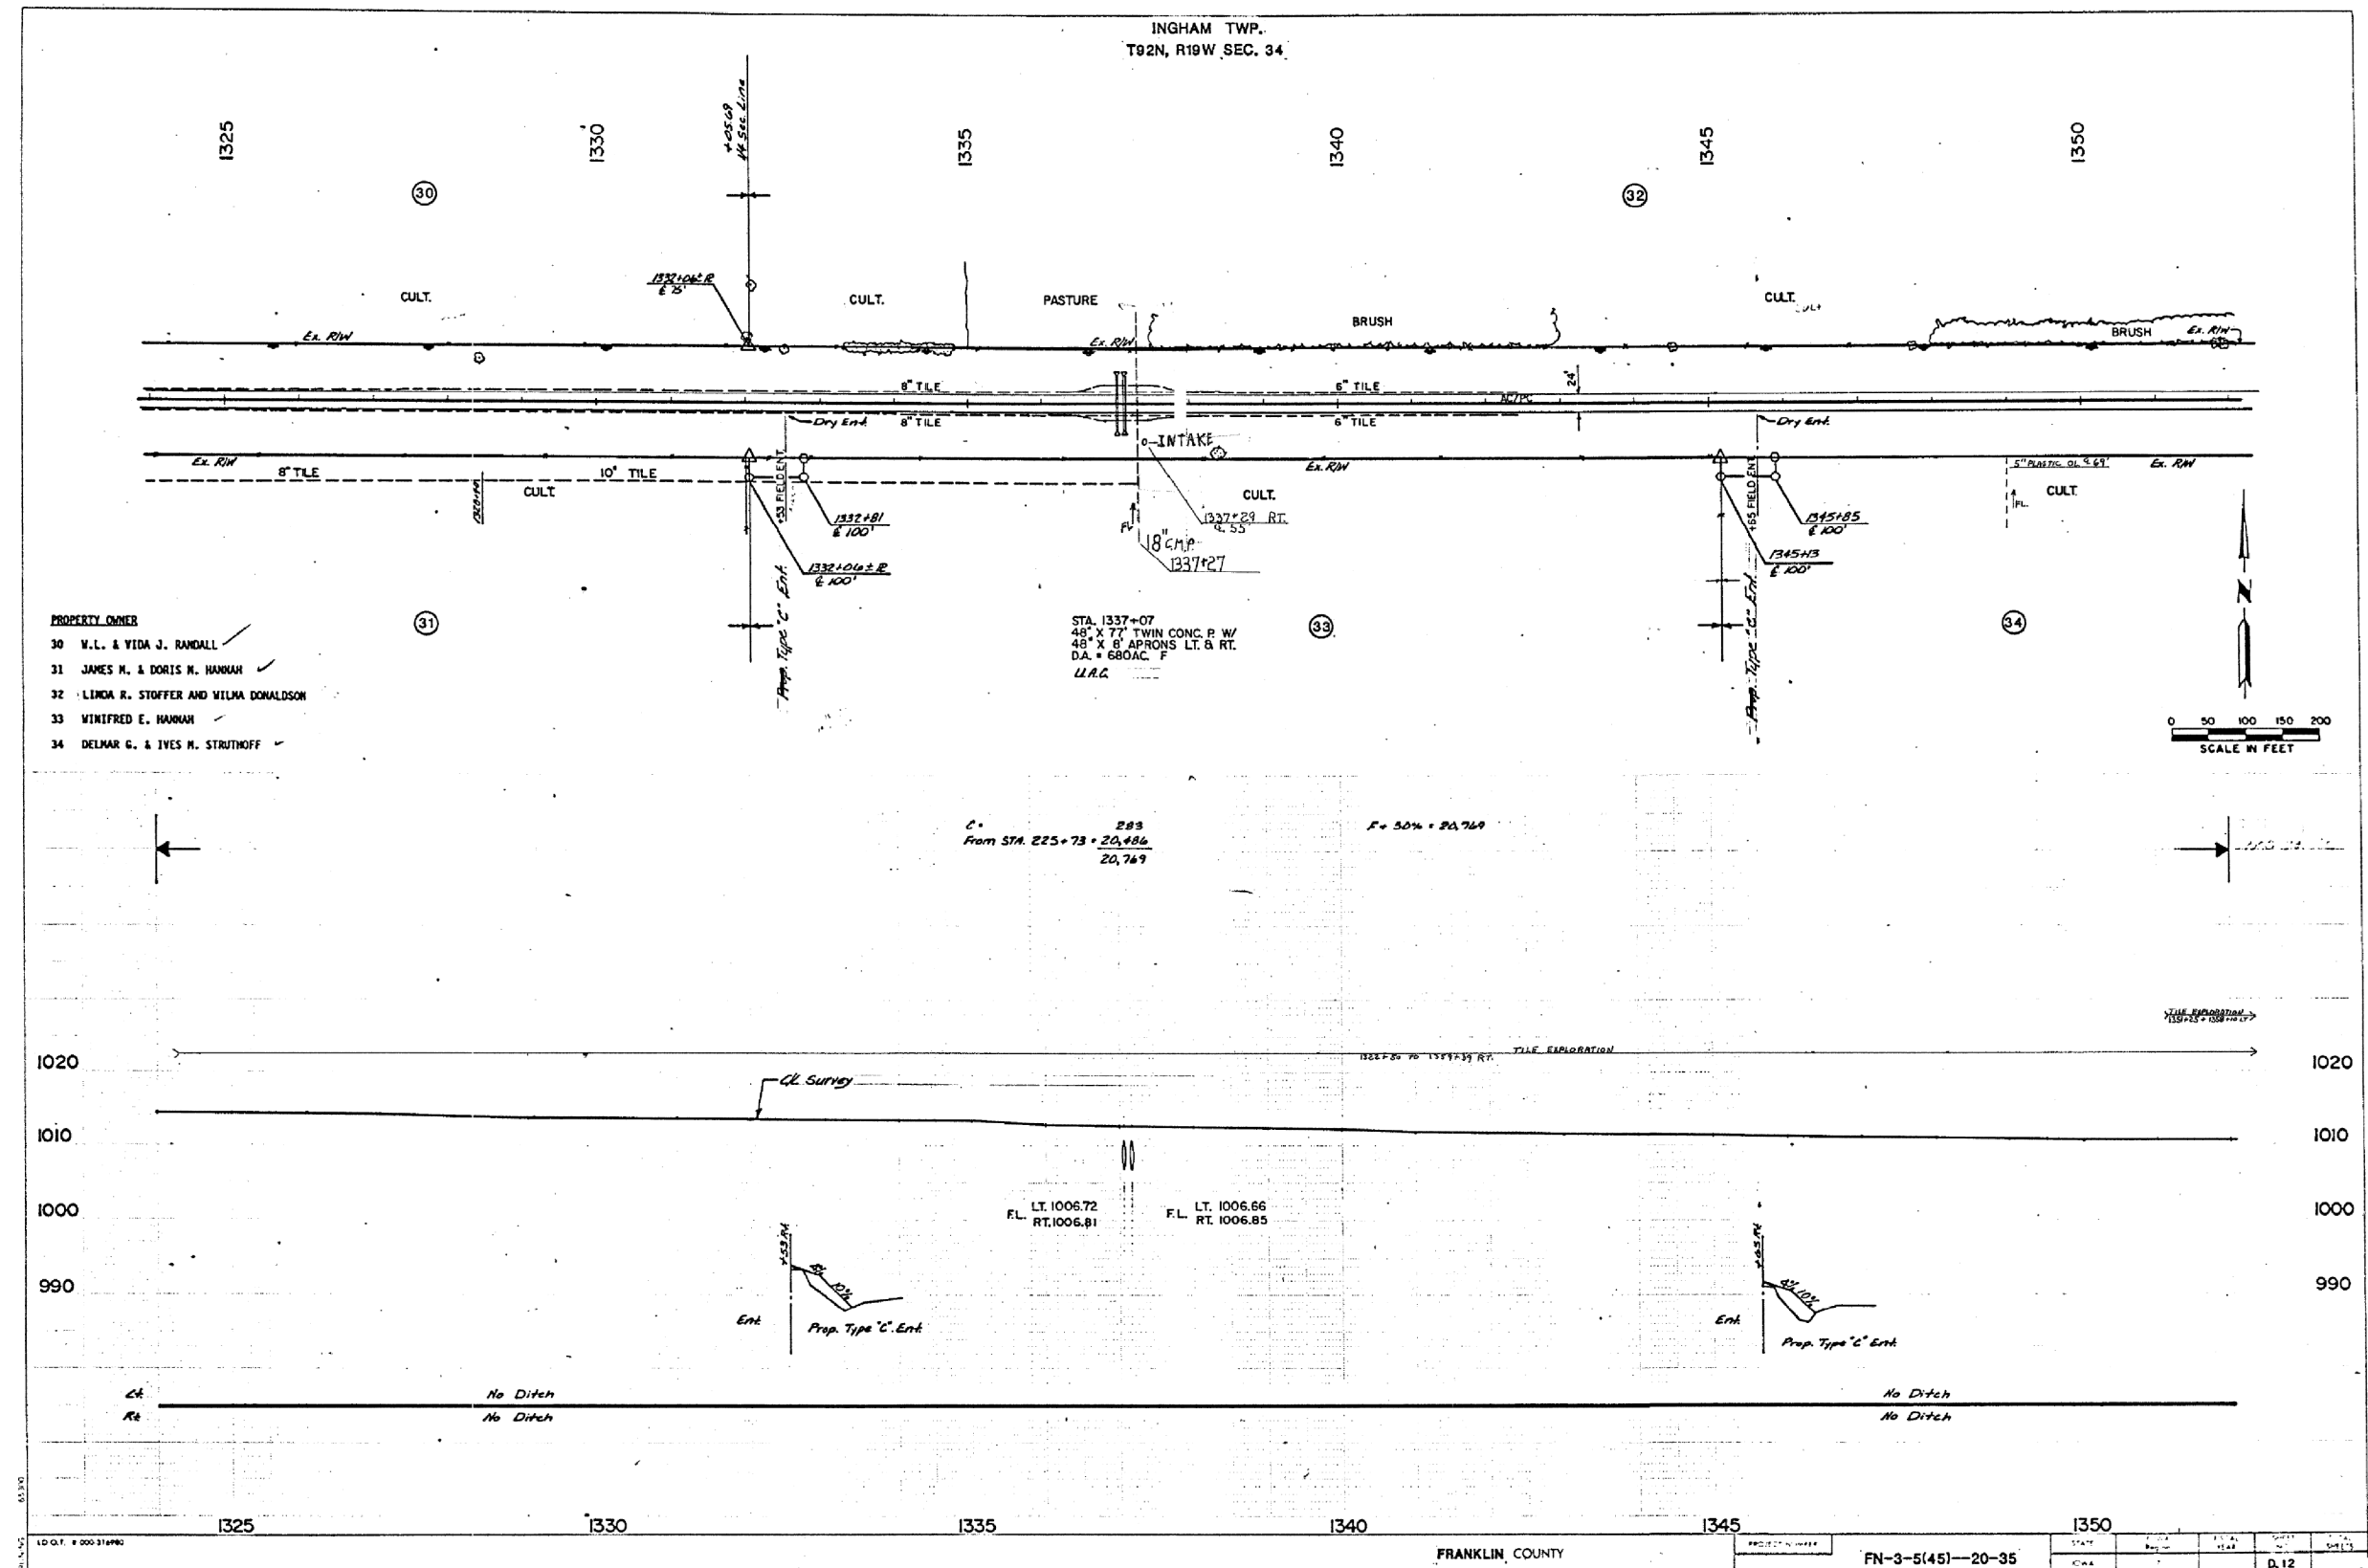

AS-BUILT PLANS, FOR INFORMATION ONLY

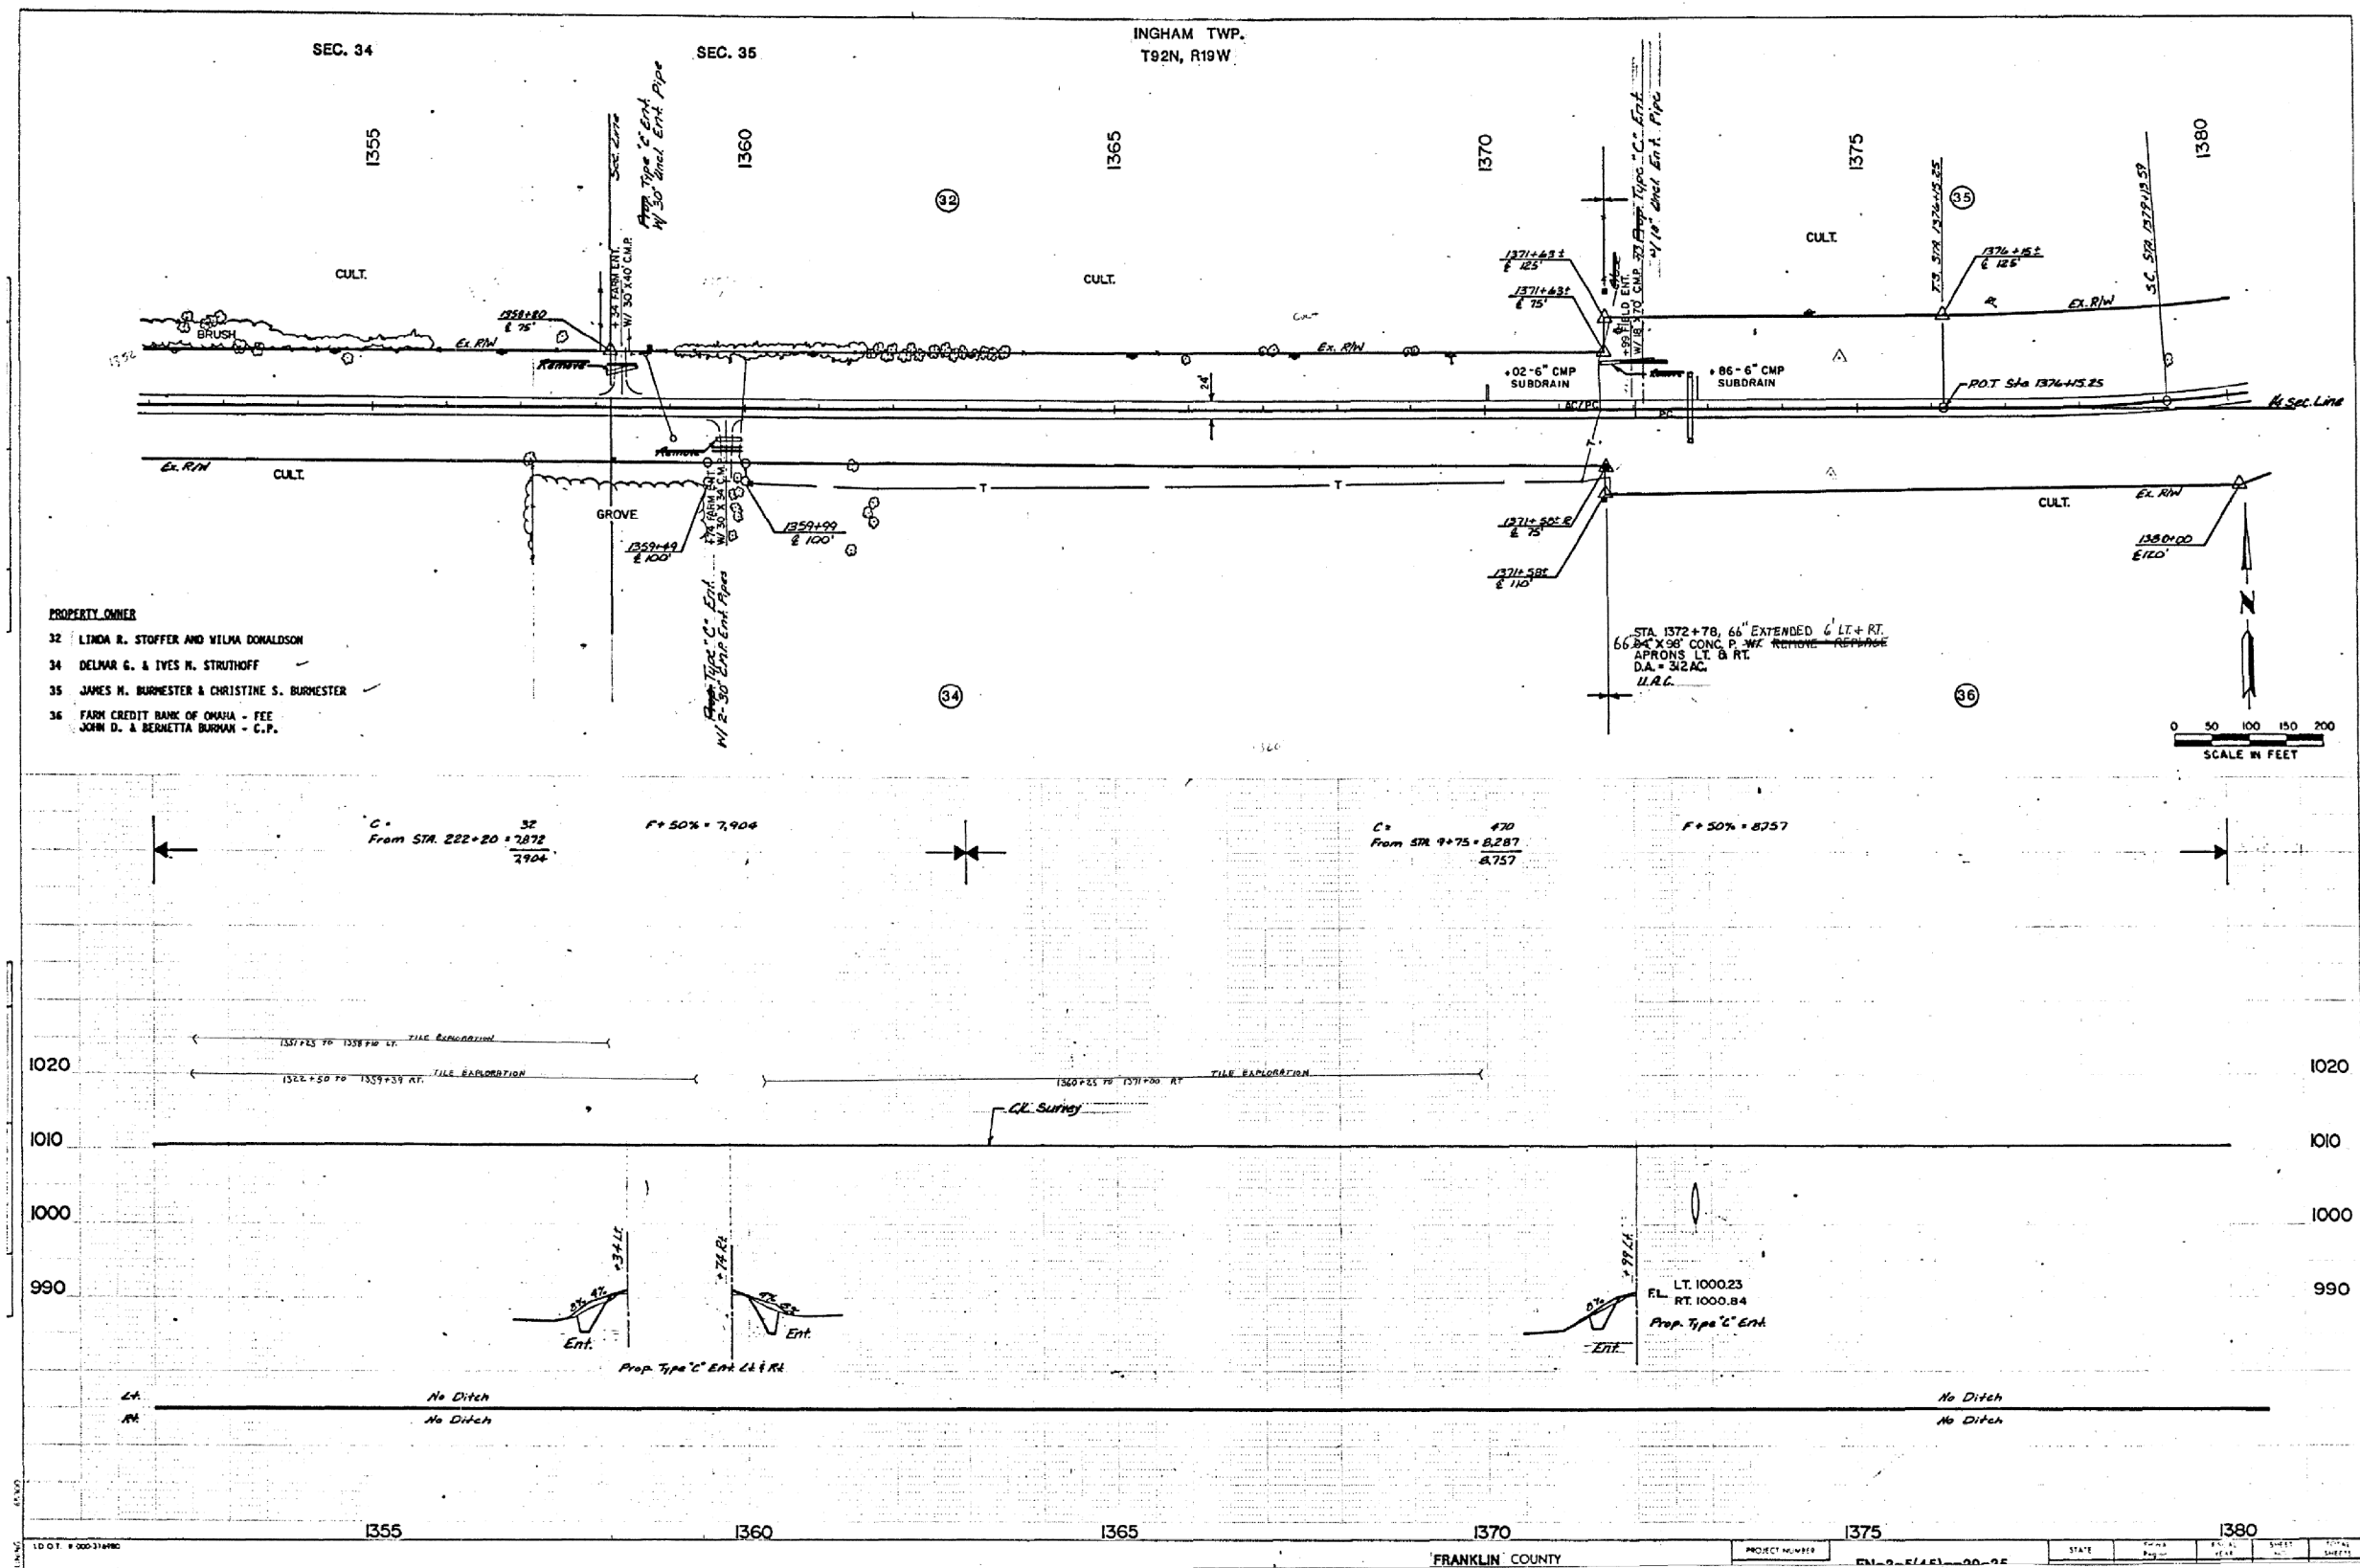

AS-BUILT PLANS, FOR INFORMATION ONLY

108-25
10-21-14

511 TRAVEL RESTRICTIONS

Route	Direction	County	Location Description	Feature Crossed	Object Type	Maint. Bridge No., Structure ID, or FHWA No.	Type of Restriction	Existing Measurement	Construction Measurement	Construction Measurement as Signed	Projected As Built Measurement	Remarks
IA 3	Both	Franklin	No restrictions expected									

108-23A
08-01-08

TRAFFIC CONTROL PLAN

The Contractor shall coordinate traffioc control with other projects in the area.

Through traffic shall be maintained at all times during construction.

111-01
04-17-12

COORDINATED OPERATIONS

Other work in progress during the same period of time will include the construction of the projects listed. Coordinate operations with those of other contractors working within the same area.

Project	Type of Work

108-26A
08-01-08

STAGING NOTES

1) Install subdrains and perform pipe work.

2) Perform patching.

3) Perform milling of HMA and Cold-in-place recycling.

4) Place HMA.

5) Place final pavement markings and rumble strips.

FILE NO.	ENGLISH	DESIGN TEAM	KELLY\MEISE	FRANKLIN COUNTY	PROJECT NUMBER	NHSX-003-5(86)--3H-35	SHEET NUMBER	
----------	---------	-------------	-------------	-----------------	----------------	-----------------------	--------------	--

5/10/2022 3:25:36 PM tmeise c:\pw_work\pwmain\tmeise\d1608081\35003086J.xlsm

For pavement marking line types, see PM-110.


For stop line information, see PM-120.

Estimated at 20 LF. For equalizer pipes place silt fence left and right of discharge point.

Estimated at 20 LF.

Estimated at 30 LF of 20 in. diameter device.
Quantity shown are for estimating purposes only.
Actual quantities shall be governed by conditions at each location where storm water leaves the right of way.

See Standard Road Plans EC-201 and EC-204 for installation details.

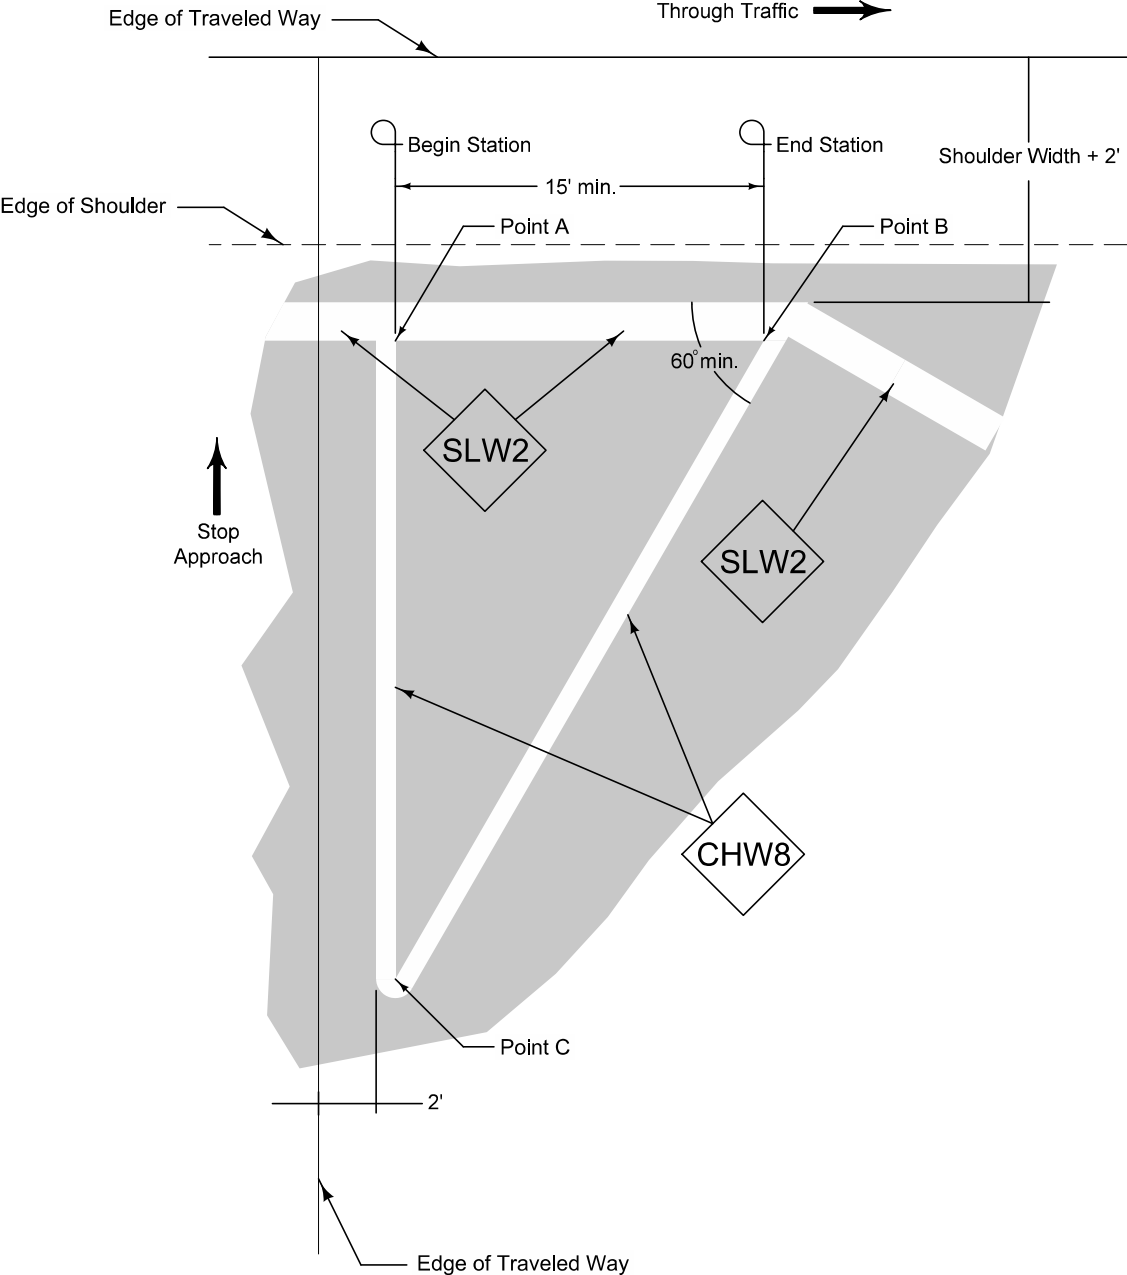



Possible Contract Item:
Silt Fence Ditch Check
Silt Fence
Perimeter and Slope Sediment
Control Device

Possible Tabulations:
100-16
100-17
100-19
100-34


Possible Contract Item:
Pavement Marking Line Items

Possible Tabulations:
101-10
108-22

	REVISION	
	1	04-21-20
	560-5	
ROAD DESIGN DETAIL	SHEET 1 of 1	
REVISIONS: <u>Added SLW2 and YLW2.</u>		
PAINTED ISLANDS		

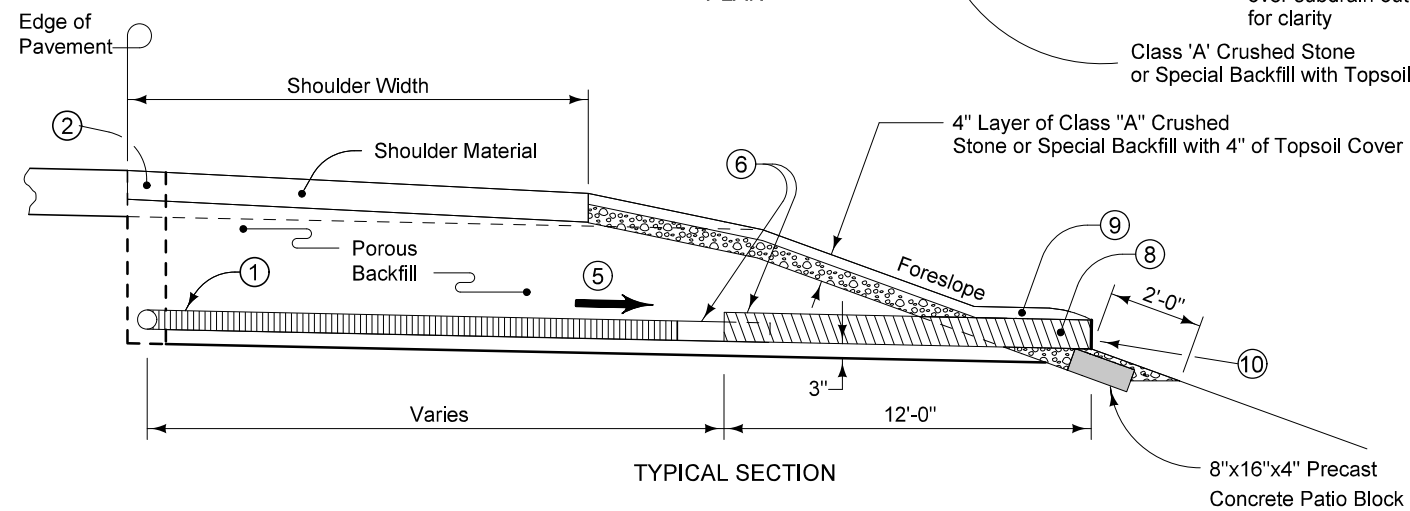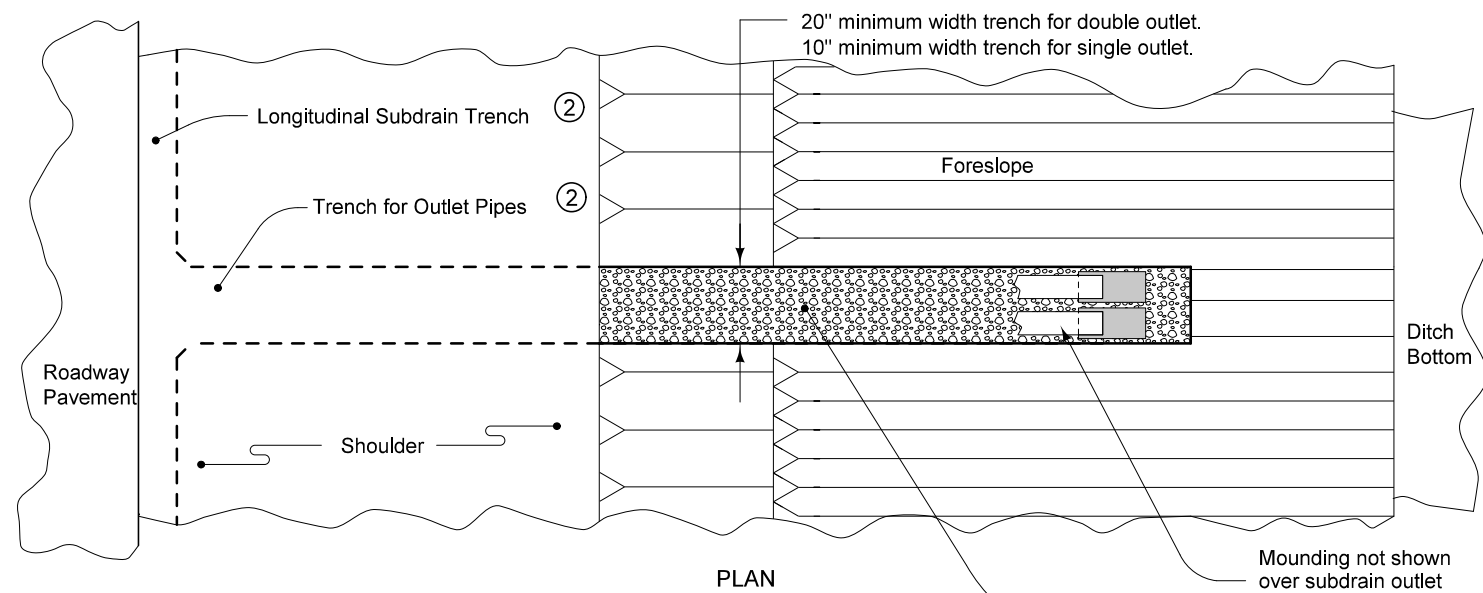

LONGITUDINAL AND TRANSVERSE OUTLETS

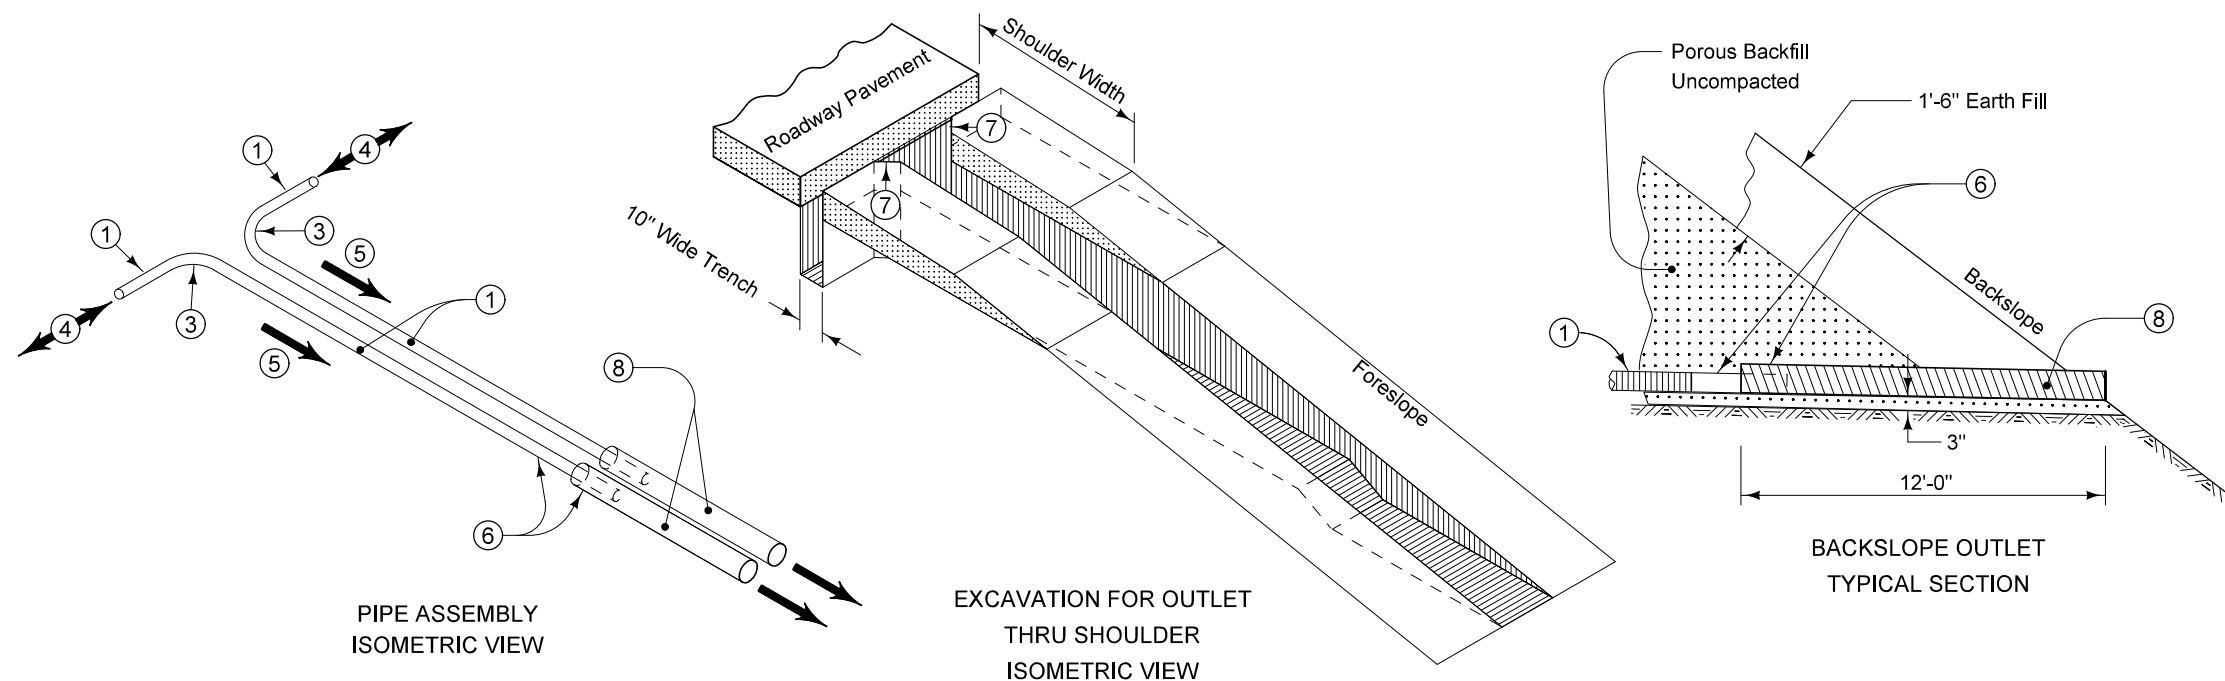

- ① Perforated Subdrain (Polyethylene Corrugated Tubing).
- ② On projects where existing shoulder material is removed, replace the shoulder material according to Article 2502.03, C of the Standard Specifications.
- ③ 'Y' or 'T' connection **will** not be allowed. Place subdrain on 1 foot minimum radius.
- ④ Direction of flow.
- ⑤ 6 inch minimum drop in elevation between longitudinal subdrain and outlet. 12 inch minimum drop for projects using recycled PCC subbase.
- ⑥ Corrugated metal pipe outlet 2 inches larger than subdrain pipe or corrugated double-walled PE or PVC pipe of the same diameter as the subdrain pipe with an appropriate coupler. If metal pipe is used, the pipes should be coupled in one of the following ways: (1) Use an inside fit reducer coupler (insert coupler a minimum of 12 inches into CMP); or (2) Insert 1 inch of the 4 inch subdrain into the 6 inch metal outlet pipe, then fully seal the entire opening with grout.
- ⑦ Bevel the trench to provide a minimum of 3 inches of porous backfill surrounding all portions of subdrain pipe.
- ⑧ Corrugated metal pipe outlet 2 inches larger than existing subdrain pipe, or corrugated double-walled PE or PVC pipe of the same diameter as the existing subdrain pipe.
- ⑨ Place class 4" of Topsoil over pipe outlet
- ⑩ Install rodent guard. See I.M. 443.01.

Possible Contract Item:
Subdrain Outlet, 500-10

Possible Tabulations:
104-5C
104-6

	REVISION	
	New	10-17-17
STANDARD ROAD PLAN	500-10	
REVISIONS:		
APPROVED BY DESIGN METHODS ENGINEER		
OUTLETS FOR LONGITUDINAL, TRANSVERSE AND BACKSLOPE SUBDRAINS		