

ALLAMAKEE CO. HMA PAVEMENT WIDENING WITH HMA RESURFACING
 STP-9-9(71)--2C-03/HSIPX-9-9(88)--3L-03

LETTING DATE
 12-17-2019



Highway Division

PLANS OF PROPOSED IMPROVEMENT ON THE

PRIMARY ROAD SYSTEM

ALLAMAKEE COUNTY

HMA PAVEMENT WIDENING WITH HMA RESURFACING

From 10th Ave NW in Waukon to
 South Rd in Lansing

SCALES: As Noted

Refer to the Proposal Form for list of applicable specifications.

Value Engineering Saves. Refer to Article 1105.14 of the Specifications.



REVISIONS

TOTAL
56

PROJECT IDENTIFICATION NUMBER

15-03-009-020

PROJECT NUMBER

STP-9-9(71)-2C-03/HSIPX-9-9(88)-3L-03

R.O.W. PROJECT NUMBER

| INDEX OF SHEETS | |
|-----------------|---|
| No. | DESCRIPTION |
| A Sheets | Title Sheets |
| A.1 | Title Sheet |
| A.2 | Location Map Sheets |
| B Sheets | Typical Cross Sections and Details |
| B.1 - 3 | Typical Cross Sections and Details |
| C Sheets | Quantities and General Information |
| C.1 | Project Description |
| C.1 - 2 | Estimated Project Quantities |
| C.2 - 3 | Estimate Reference Information |
| C.4 | Standard Road Plans |
| C.4 | Index of Tabulations |
| C.5 - 6 | Pollution Prevention Plan |
| C.1 - 7 | General Notes |
| C.4 - 21 | Tabulations |
| D Sheets | Mainline Plan and Profile Sheets |
| * D.1 - 28 | Plan & Profile Including Erosion |
| J Sheets | Traffic Control and Staging Sheets |
| J.1 | Traffic Control Plan |
| J.2 | Detour Signage |
| | * Color Plan Sheets |



MILEAGE SUMMARY

105-1
09-27-94

| Div. | Location | Lin. Ft. | Miles |
|------|---|------------------|--------------|
| 1 | STA 15+50.0 to STA 109+03.45 STA EQ STA 109+03.45 BACK= STA 109+36.09 AHEAD | 9,353.45 | 1.77 |
| | STA 109+36.09 to STA 171+90.99 STA EQ STA 171+90.99 BACK= STA 171+90.39 AHEAD | 6,254.90 | 1.18 |
| | STA 171+90.39 to STA 253+29.50 STA EQ STA 253+29.50 BACK= STA 253+08.76 AHEAD | 8,139.11 | 1.54 |
| | STA 253+08.76 to STA 308+16.60 STA EQ STA 308+16.60 BACK= STA 308+17.52 AHEAD | 5,507.84 | 1.04 |
| | STA 308+17.52 to STA 326+03.13 STA EQ STA 326+03.13 BACK= STA 326+03.71 AHEAD | 1,785.61 | 0.34 |
| | STA 326+03.71 to STA 371+12.74 STA EQ STA 371+12.74 BACK= STA 371+21.06 AHEAD | 4,509.03 | 0.85 |
| | STA 371+21.06 to STA 470+76.84 STA EQ STA 470+76.84 BACK= STA 471+05.97 AHEAD | 9,955.78 | 1.89 |
| | STA 471+05.97 to STA 752+66.35 STA EQ STA 752+66.35 BACK= STA 752+20.79 AHEAD | 28,160.38 | 5.33 |
| | STA 752+20.79 to STA 802+25.00 | 5,004.21 | 0.95 |
| | TOTAL | 78,670.31 | 14.90 |

DESIGN DATA RURAL

| | | |
|--------------------|---------|--------|
| 2020 AADT | 1,800 | V.P.D. |
| 2040 AADT | 1,900 | V.P.D. |
| 20-- DHV | -- | V.P.H. |
| TRUCKS | 9 | % |
| Total Design ESALs | 499,320 | |

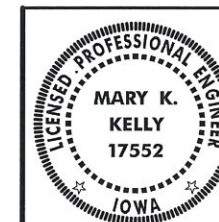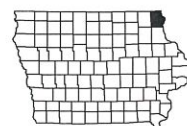

I hereby certify that this plan was prepared under my supervision and that engineering decisions with regard to the design were made by me or by other duly licensed Professional Engineers under the laws of the State of Iowa.

Mary K. Kelly 10/1/19
 Signature Date

MARY K. KELLY

My license renewal date is December 31, 2020

Pages or sheets covered by this seal: A.1-A.2, B.1-B.3, C.1-C.21, D.1-D.28 & J.1-J.2

STA EQ
STA 308+16.6 BK=
STA 308+17.52 AH

STA EQ
STA 326+03.13 BK=
STA 326+03.71 AH

STA EQ
STA 371+12.74BK=
STA 371+21.06 AH

STA 802+25
END PROJECT
(near South Rd)

STA EQ
STA 253+29.5 BK=
STA 253+08.76 AH




STA EQ
STA 171+90.99 BK=
STA 171+90.39 AH

STA EQ
STA 109+03.45 BK=
STA 109+36.09 AH


STA EQ
STA 752+66.35 BK=
STA 752+20.79 AH

STA EQ
STA 470+76.84 BK=
STA 471+05.97 AH

STA 15+50.0
BEGIN PROJECT
(near 10th Ave NW)

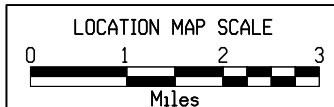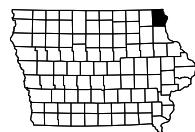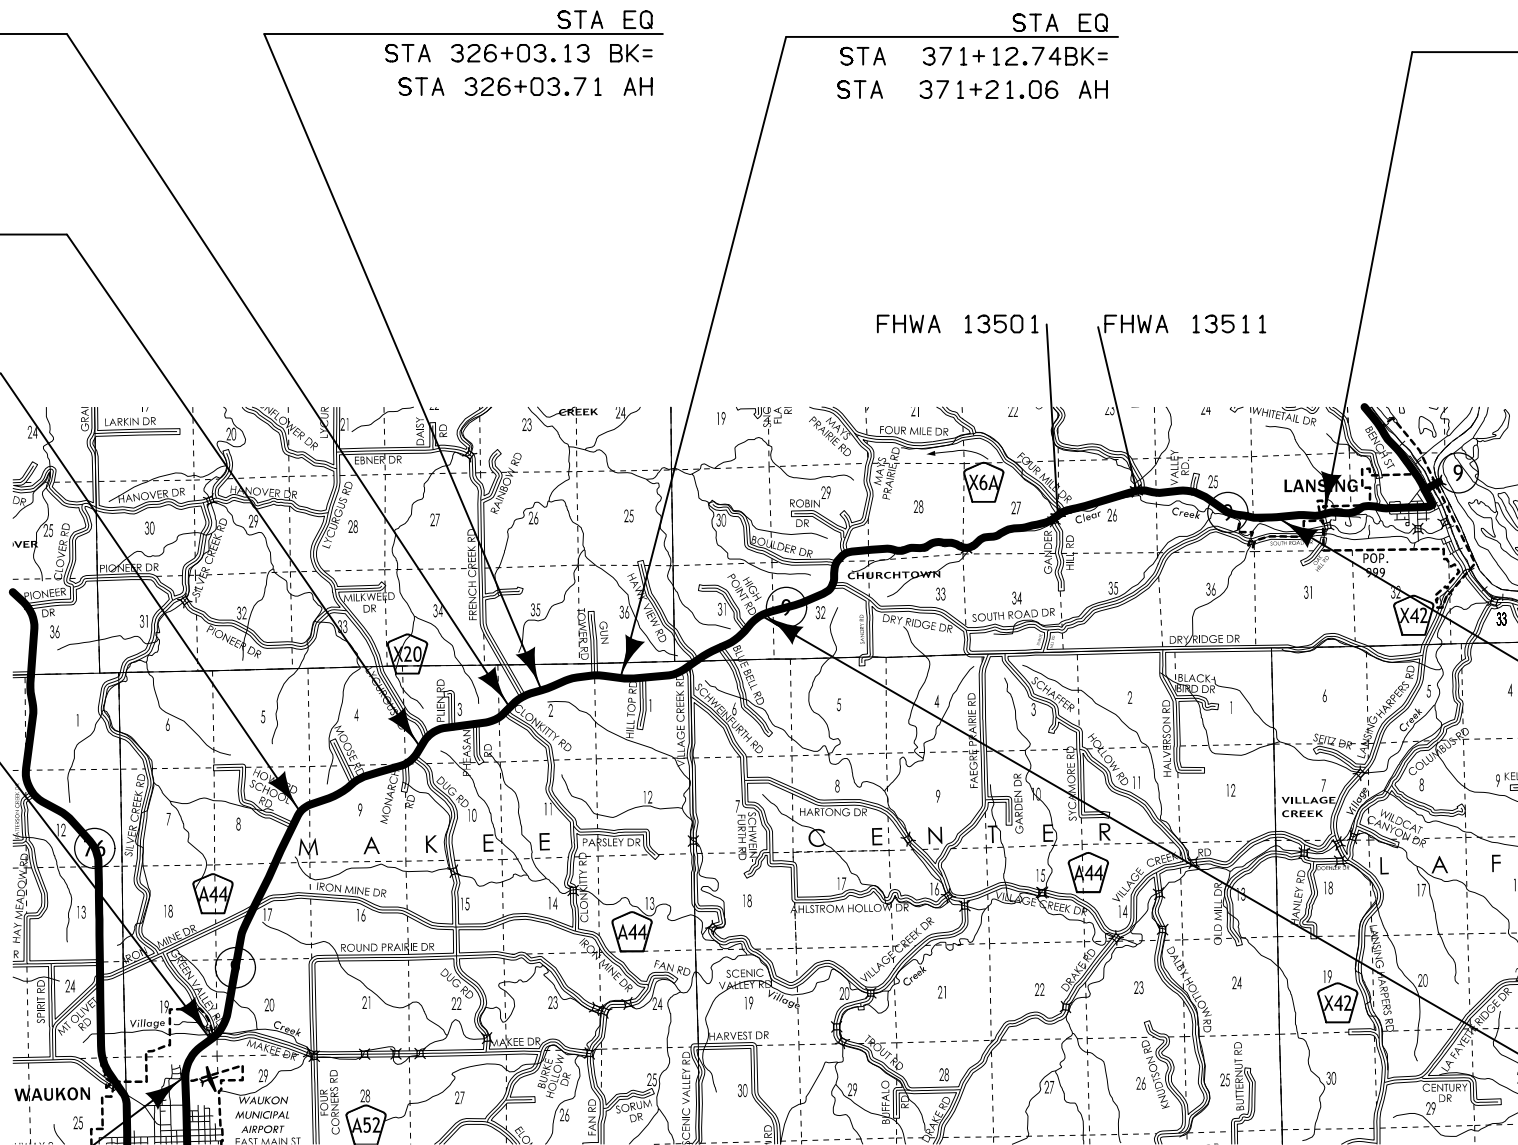

| Design Rates | |
|---------------------|-------------------|
| Item | Rate |
| Surface Course | 147 lbs./cu. ft. |
| Intermediate Course | 147 lbs./cu. ft. |
| Base Course | 145 lbs./cu. ft. |
| Tack Coat | 0.05 gal./sq. yd. |
| Binder Content | 6.0% Binder |
| Foam Content | 0.11% Agent |

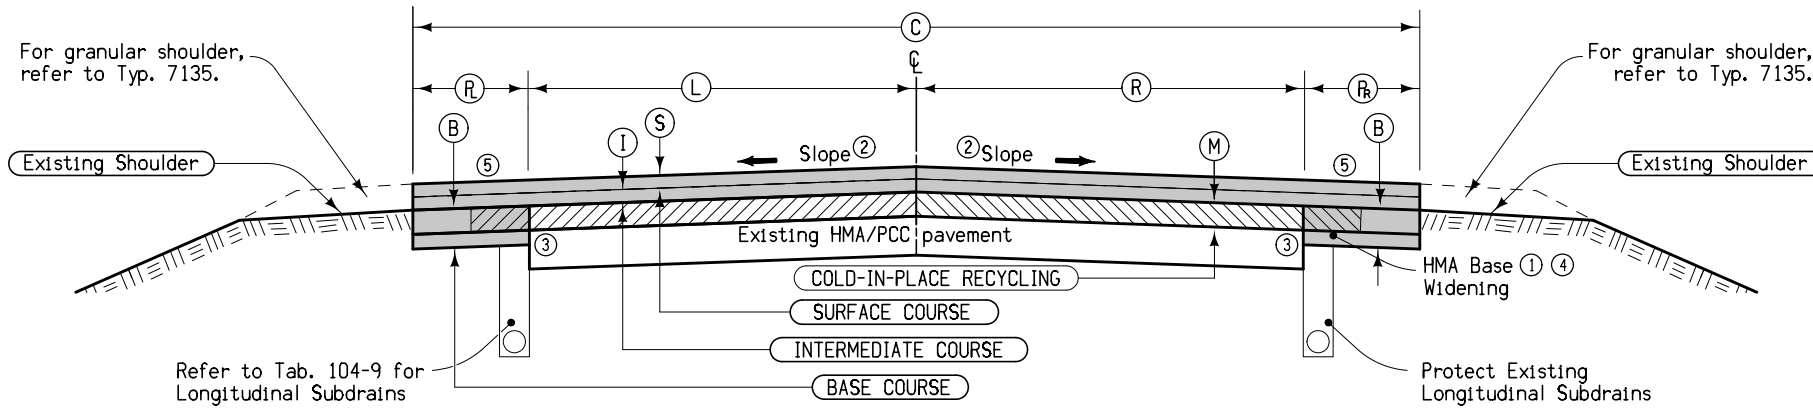


- Notes:
- HMA base widening shall be performed prior to Cold-in-Place recycling. The top 3" of the newly placed base widening unit shall be included in the Cold In-Place recycling operation.
 - Finished slope shall match existing pavement except that the maximum allowable slope is 3.0 %, minimum allowable slope is 2.0 %. Section may be modified as directed by the Engineer through areas of special shaping.
 - Provide a vertical edge similar to what can be achieved with a milling machine. Incidental to Class 13 Excavation.
 - Suspend base widening at paved side roads and at the turn lane. Refer to Typical 2620 and 7149 for additional information.
 - Paved shoulder cross slope shall match mainline cross slope except in super elevated curves. See PV-301 for additional information.
 - Surface and intermediate quantities are shown in Tabulation 100-25. Base quantities area shown in Tabulation 112-9.

MK-1

| Location | | Estimated Quantities | | | | | | | | | Remarks |
|--------------------|----------|----------------------|--------|-----------|-----------|-----------|--------|-------|------|--------|--------------------------|
| Station To Station | | (S) | (I) | (C) | (L) | (R) | (M) | (P) | (R) | (B) | |
| | | Inches | Inches | Feet | Feet | Feet | Inches | Feet | Feet | Inches | |
| | | | | | | | | | | | Begin Project/N-3 notch |
| 16+25.0 | 21+50.0 | 1.5 | 1.5 | 50.0 | 24.0 | 12.0 | 3 | 4.0 | 10.0 | 7 | Replace 10' RT |
| 21+50.0 | 32+00.0 | 1.5 | 1.5 | 44.0 | 24.0 | 12.0 | 3 | 4.0 | 4.0 | 7 | Climb LT |
| 32+00.0 | 38+60.0 | 1.5 | 1.5 | 44.0-32.0 | 24.0-12.0 | 12.0 | 3 | 4.0 | 4.0 | 7 | Climb taper |
| 38+60.0 | 70+20.0 | 1.5 | 1.5 | 32.0 | 12.0 | 12.0 | 3 | 4.0 | 4.0 | 7 | Climb taper |
| 70+20.0 | 75+00.0 | 1.5 | 1.5 | 32.0-44.0 | 12.0 | 12.0-24.0 | 3 | 4.0 | 4.0 | 7 | Climb RT |
| 75+00.0 | 113+00.0 | 1.5 | 1.5 | 44.0 | 12.0 | 24.0 | 3 | 4.0 | 4.0 | 7 | Climb taper |
| 113+00.0 | 119+60.0 | 1.5 | 1.5 | 44.0-32.0 | 12.0 | 24.0-12.0 | 3 | 4.0 | 4.0 | 7 | Climb taper |
| 119+60.0 | 501+00.0 | 1.5 | 1.5 | 32.0 | 12.0 | 12.0 | 3 | 4.0 | 4.0 | 7 | |
| | | | | | | | | | | | See MK-2 |
| 517+60.0 | 518+80.0 | 1.5 | 1.5 | 32.0-44.0 | 12.0-24.0 | 12.0 | 3 | 4.0 | 4.0 | 7 | Climb taper |
| 518+80.0 | 520+00.0 | 1.5 | 1.5 | 44.0 | 24.0 | 12.0 | 3 | 4.0 | 4.0 | 7 | Climb LT |
| 520+00.0 | 554+00.0 | 1.5 | 1.5 | 50.0 | 24.0 | 12.0 | 3 | 4.0 | 10.0 | 7 | Replace and new 10' RT |
| 554+00.0 | 555+00.0 | 1.5 | 1.5 | 44.0 | 24.0 | 12.0 | 3 | 4.0 | 4.0 | 7 | Climb LT |
| 555+00.0 | 560+00.0 | 1.5 | 1.5 | 46.0 | 24.0 | 12.0 | 3 | 6.0 | 4.0 | 7 | Replace 6' LT |
| 560+00.0 | 644+20.0 | 1.5 | 1.5 | 44.0 | 24.0 | 12.0 | 3 | 4.0 | 4.0 | 7 | Climb LT |
| 644+20.0 | 650+80.0 | 1.5 | 1.5 | 44.0-32.0 | 24.0-12.0 | 12.0 | 3 | 4.0 | 4.0 | 7 | Climb taper |
| 650+80.0 | 769+60.0 | 1.5 | 1.5 | 32.0 | 12.0 | 12.0 | 3 | 4.0 | 4.0 | 7 | |
| 769+60.0 | 771+00.0 | 1.5 | 1.5 | 32.0-31.0 | 12.0-15.0 | 12.0 | 3 | 4.0-0 | 4.0 | 7 | Transition to Urban/MK-2 |

TYPICAL CROSS SECTION COLD IN-PLACE RECYCLING HMA RESURFACING WITH BASE WIDENING

| Design Rates | |
|---------------------|-------------------|
| Item | Rate |
| Surface Course | 147 lbs./cu. ft. |
| Intermediate Course | 147 lbs./cu. ft. |
| Tack Coat | 0.05 gal./sq. yd. |
| Binder Content | 6.0% Binder |



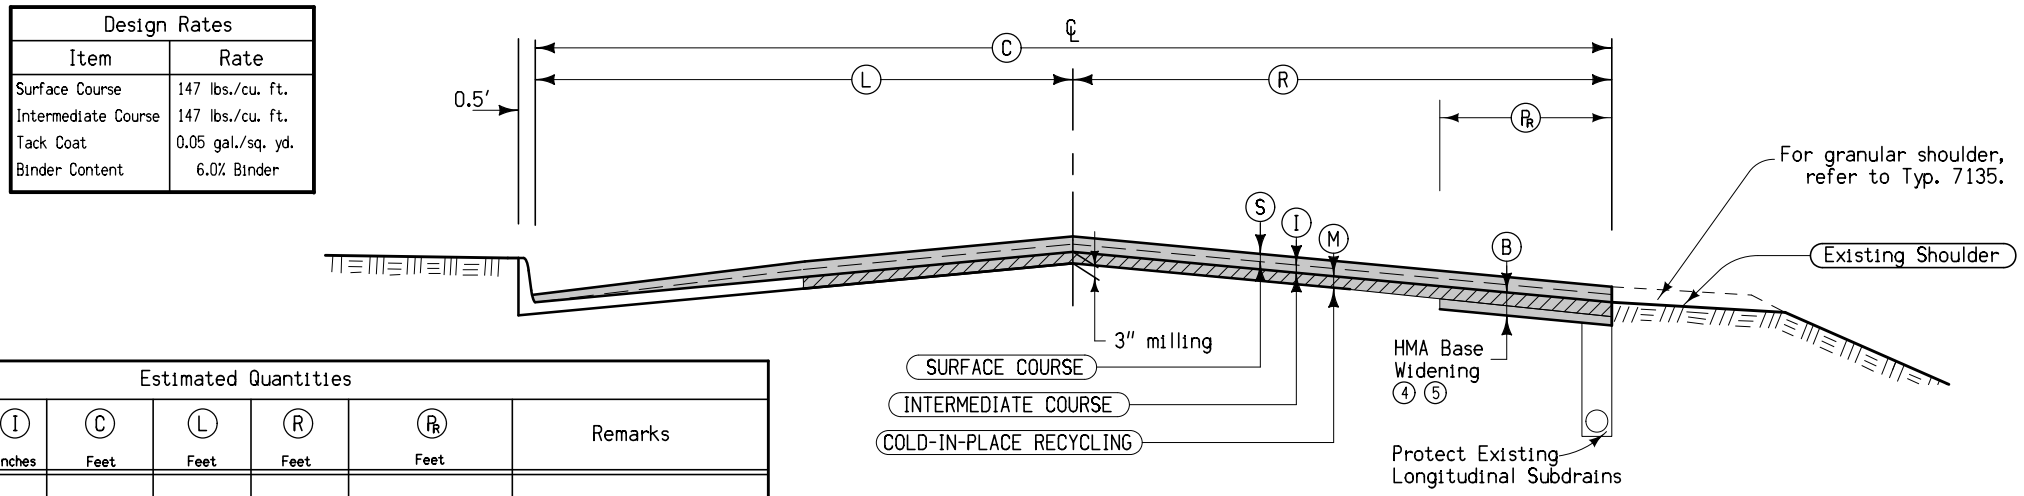


- Notes:
- Section may be modified as directed by the Engineer through areas of special shaping.
 - Pavement scarification shall continue through intersections.
 - Contractor shall use care near intakes, manholes and other structures. Any damage to structures as a result of contractor negligence shall be replaced or repaired by the contractor at no cost to the DOT.
 - Quantities are shown in Tabulation 100-25.
 - Finished slope shall match existing pavement except that the maximum allowable slope is 3.0 %, minimum allowable slope is 2.0 %. Section may be modified as directed by the Engineer through areas of special shaping.

MK-2


| Location | | Estimated Quantities | | | | | | Remarks |
|--------------------|----------|----------------------|--------|-----------|-----------|-----------|-------------|-----------------------|
| Station To Station | | (S) | (I) | (C) | (L) | (R) | (R) | |
| | | Inches | Inches | Feet | Feet | Feet | Feet | |
| | | | | | | | | See MK-1 |
| 501+00.0 | 514+00.0 | 1.5 | 1.5 | 36.0 | 20.0 | 16.0 | 8.0 (on LT) | Curb LT |
| 514+00.0 | 517+60.0 | 1.5 | 1.5 | 36.0-54.0 | 16.0-28.0 | 20.0 | 8.0 | Curb RT |
| | | | | | | | | See MK-1 |
| 771+00.0 | 800+15.0 | 1.5 | 1.5 | 31.0 | 15.0 | 16.0 | 4.0 | Curb LT |
| 800+15.0 | 800+85.0 | 1.5 | 1.5 | 31.0-30.0 | 15.0 | 16.0-15.0 | 4.0-0 | Curb LT |
| | | | | | | | | End project/N-3 notch |

TYPICAL PAVEMENT SCARIFICATION & HMA RESURFACING URBAN SECTION

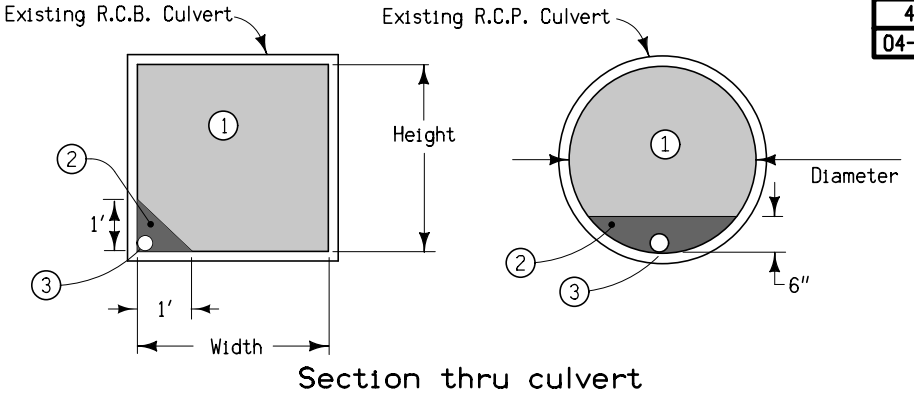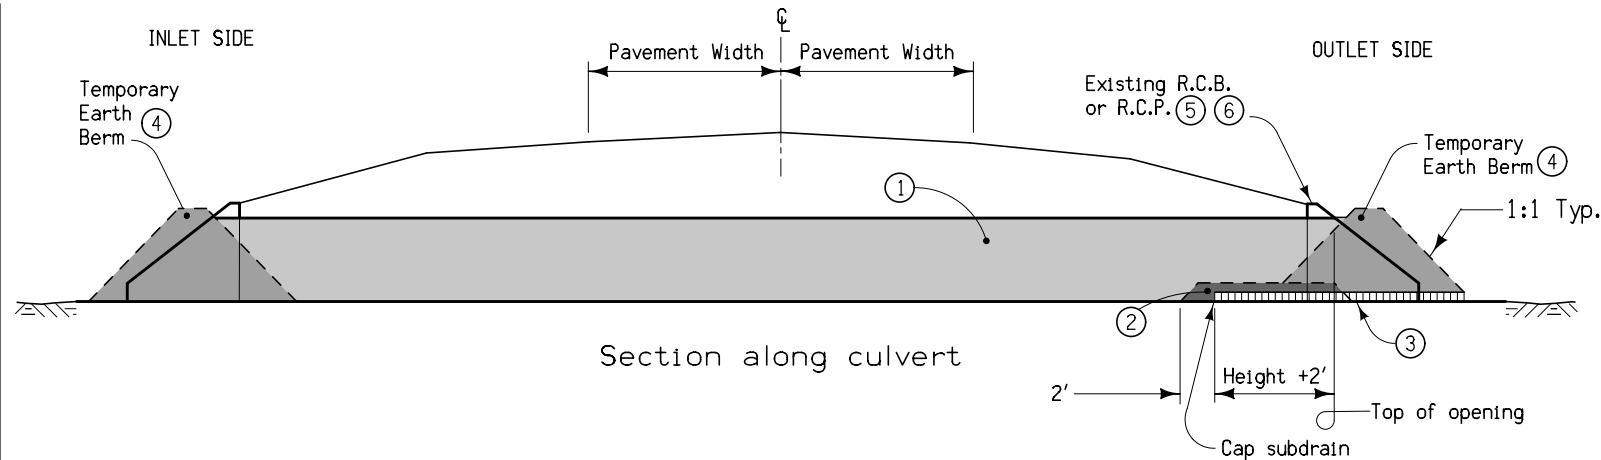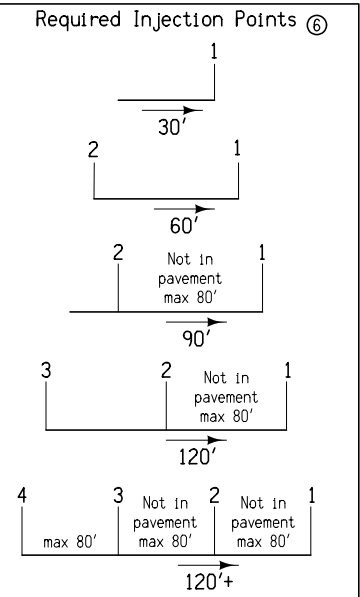

- ① Flowable Mortar.
- ② Granular Backfill.
- ③ 4" subdrain at flowline elevation of culvert shall be extended into the culvert a distance of 2' plus the height of the culvert. Granular Backfill covers subdrain and extends an additional 2'. Subdrain and granular backfill are incidental to flowable mortar.
- ④ Ends of culvert shall be plugged sufficiently to retain flowable mortar. Temporary earth berms are incidental to flowable mortar.
- ⑤ Removal of headwalls may be required.
- ⑥ Outlet shall be filled first. See injection point detail for additional information.

DETAILS OF CULVERT ABANDONMENT WITH FLOWABLE MORTAR
(Rectangular structures less than 8' in either height or width.
Circular structures less than 10' Dia.)

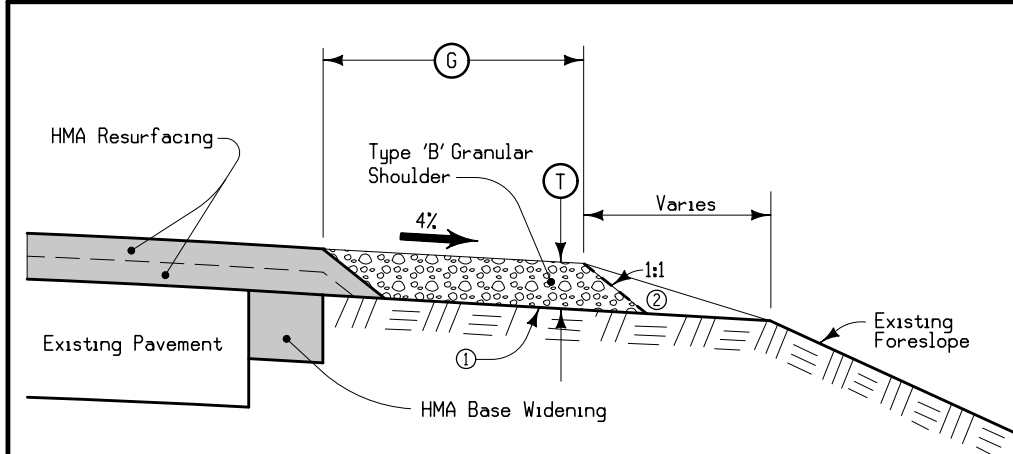

- Notes:
- ① Existing shoulder surface to be shaped to a uniform cross slope prior to placing granular shoulder material. Shape to ensure the thickness of the granular shoulder material is not less than the thickness of the resurfacing.
 - ② Nominal thickness adjusted to account for existing slopes.
 - ③ Placing granular shoulder material in advance of Class 13 Excavation for Widening and Base Widening shall be performed as part of the 'Granular Shoulders, Type B' bid item.

| ROAD IDENTIFICATION | LOCATION | | SIDE | ① | ② |
|---------------------|--------------------|----------|------|--------|----------|
| | STATION TO STATION | | | Inches | Feet |
| IA 9 | 16+50.0 | 21+50.0 | RT | 6 | 0 |
| | 21+50.0 | 514+00.0 | RT | 6 | 6.0 |
| | 514+00.0 | 517+60.0 | RT | 6 | 2.0 |
| | 517+60.0 | 554+00.0 | RT | 6 | 0 |
| | 554+00.0 | 800+15.0 | RT | 6 | 6.0 |
| | 800+15.0 | 800+85.0 | RT | 6 | 6.0-10.0 |
| | 16+50.0 | 501+00.0 | LT | 6 | 6.0 |
| | 501+00.0 | 514+00.0 | LT | 6 | 2.0 |
| | 514+00.0 | 555+00.0 | LT | 6 | 6.0 |
| | 555+00.0 | 560+00.0 | LT | 6 | 4.0 |
| | 560+00.0 | 769+60.0 | LT | 6 | 6.0 |
| | 769+60.0 | 771+00.0 | LT | 6 | 6.0-10.0 |

TYPICAL SECTION
FOR TYPE 'B'
GRANULAR SHOULDER
 ADJACENT TO HOT MIX ASPHALT
 RESURFACING

PROJECT DESCRIPTION

This project includes cold-in-place recycling and resurfacing of IA 9 in Allamakee county from 10th Ave NW in Waukon to South Road in Lansing in Allamakee county. The existing 24 foot average width HMA will be widened four feet on each side. The pavement will then be cold-in-place recycled three inches and have three inches of new HMA added. Existing pipes will be extended, longitudinal subdrains will be added and low tension cable guardrail will be updated. Centerline and shoulder rumble strips will also be included in this project. Shoulder widening work will be paid under Division 2 work. Allamakee county will extend unpaved sideroad radii under Division 3 work.

**UTILITIES
(NOT A POINT 25 PROJECT)**

This is NOT a POINT 25 project and is not subject to the provisions of IAC 761-115.25.

**ESTIMATED PROJECT QUANTITIES
(UP TO A 5 DIVISION PROJECT)**

Division 1: 100% DOT- Project #STP-009-9(71)--2C-03
Division 2: 100% DOT- Project #HSIPX-009-9(88)--3L-03
Division 3: 100% Allamakee County

| Item No. | Item Code | Item | Unit | Estimated | | | | | As Built | | | | | |
|----------|--------------|--|------|------------|------------|------------|------------|------------|----------|--------------|------------|------------|------------|------------|
| | | | | Division 1 | Division 2 | Division 3 | Division 4 | Division 5 | Total | Division 1 | Division 2 | Division 3 | Division 4 | Division 5 |
| | | | | | | | | | | | | | | |
| 1 | 2101-0850002 | CLEARING AND GRUBBING | UNIT | 934 | | | | | | 934 | | | | |
| 2 | 2102-2625000 | EMBANKMENT-IN-PLACE | CY | 909.6 | | | | | | 909.6 | | | | |
| 3 | 2102-2713070 | EXCAVATION, CLASS 13, ROADWAY AND BORROW | CY | 266.5 | | | | | | 266.5 | | | | |
| 4 | 2105-8425005 | TOPSOIL, FURNISH AND SPREAD | CY | | 603.0 | | | | | 603.0 | | | | |
| 5 | 2115-0100000 | MODIFIED SUBBASE | CY | 286.1 | | 475.2 | | | | 761.3 | | | | |
| 6 | 2121-7425020 | GRANULAR SHOULDERS, TYPE B | TON | | 37,055.5 | | | | | 37,055.5 | | | | |
| 7 | 2123-7450000 | SHOULDER CONSTRUCTION, EARTH | STA | | 1,537.40 | | | | | 1,537.40 | | | | |
| 8 | 2125-2225050 | RESHAPING DITCHES | STA | 39.50 | | | | | | 39.50 | | | | |
| 9 | 2212-5070310 | PATCHES, FULL-DEPTH REPAIR | SY | 316.0 | | | | | | 316.0 | | | | |
| 10 | 2212-5070330 | PATCHES BY COUNT (REPAIR) | EACH | 49 | | | | | | 49 | | | | |
| 11 | 2213-2713300 | EXCAVATION, CLASS 13, FOR WIDENING | CY | 429.1 | 11,740.8 | 950.4 | | | | 13,120.3 | | | | |
| 12 | 2213-6745700 | REMOVAL OF FLUMES | EACH | 7 | | | | | | 7 | | | | |
| 13 | 2214-5145150 | PAVEMENT SCARIFICATION | SY | 6,382.8 | | | | | | 6,382.8 | | | | |
| 14 | 2303-1031750 | HOT MIX ASPHALT STANDARD TRAFFIC, BASE COURSE, 3/4 IN. MIX | TON | 294.00 | 28,154.00 | | | | | 28,448.00 | | | | |
| 15 | 2303-1032500 | HOT MIX ASPHALT STANDARD TRAFFIC, INTERMEDIATE COURSE, 1/2 IN. MIX | TON | 27,280.00 | | 780.40 | | | | 28,060.40 | | | | |
| 16 | 2303-1033500 | HOT MIX ASPHALT STANDARD TRAFFIC, SURFACE COURSE, 1/2 IN. MIX, NO SPECIAL FRICTION REQUIREMENT | TON | 27,211.00 | | 260.10 | | | | 27,471.10 | | | | |
| 17 | 2303-1258283 | ASPHALT BINDER, PG 58-28S, STANDARD TRAFFIC | TON | 3,287.00 | 1,689.20 | 62.50 | | | | 5,038.70 | | | | |
| 18 | 2303-6911000 | HOT MIX ASPHALT PAVEMENT SAMPLES | LS | 1.00 | | | | | | 1.00 | | | | |
| 19 | 2303-7000610 | PAYMENT ADJUSTMENT INCENTIVE/DISINCENTIVE FOR HMA MIXTURE LABORATORY VOIDS (FORMULA - BY PAY FACTOR) | EACH | 79980 | | | | | | 79980 | | | | |
| 20 | 2303-7000620 | PAYMENT ADJUSTMENT INCENTIVE/DISINCENTIVE FOR HMA MIXTURE FIELD VOIDS (FORMULA - BY PAY FACTOR) | EACH | 79980 | | | | | | 79980 | | | | |
| 21 | 2315-8275025 | SURFACING, DRIVEWAY, CLASS A CRUSHED STONE | TON | 3,199.5 | | | | | | 3,199.5 | | | | |
| 22 | 2317-7000120 | PAYMENT ADJUSTMENT INCENTIVE/DISINCENTIVE FOR HMA PAVEMENT SMOOTHNESS (BY SCHEDULE) | EACH | 75937 | | | | | | 75937 | | | | |
| 23 | 2318-1001100 | COLD IN-PLACE RECYCLED ASPHALT PAVEMENT | SY | 299,640.0 | | | | | | 299,640.0 | | | | |
| 24 | 2318-1001220 | ASPHALT STABILIZING AGENT (FOAMED ASPHALT) | TON | 988.8 | | | | | | 988.8 | | | | |
| 25 | 2401-6745650 | REMOVAL OF EXISTING STRUCTURES | LS | 1.00 | | | | | | 1.00 | | | | |
| 26 | 2402-2720100 | EXCAVATION, CLASS 20, FOR ROADWAY PIPE CULVERT | CY | 999.4 | | | | | | 999.4 | | | | |
| 27 | 2416-0100018 | APRONS, CONCRETE, 18 IN. DIA. | EACH | 2 | | | | | | 2 | | | | |
| 28 | 2416-0100024 | APRONS, CONCRETE, 24 IN. DIA. | EACH | 1 | | | | | | 1 | | | | |
| 29 | 2416-0100030 | APRONS, CONCRETE, 30 IN. DIA. | EACH | 3 | | | | | | 3 | | | | |
| 30 | 2416-0101036 | REMOVE AND REINSTALL CONCRETE PIPE APRONS LESS THAN OR EQUAL TO 36 IN. | EACH | 34 | | | | | | 34 | | | | |
| 31 | 2416-0101136 | REMOVE AND REINSTALL CONCRETE PIPE APRONS GREATER THAN 36 IN. | EACH | 3 | | | | | | 3 | | | | |
| 32 | 2416-1160018 | CULVERT, CONCRETE ENTRANCE PIPE, 18 IN. DIA. | LF | 50 | | | | | | 50 | | | | |
| 33 | 2416-1240036 | CULVERT, 3000D CONCRETE ROADWAY PIPE, 36 IN. DIA. | LF | 42 | | | | | | 42 | | | | |
| 34 | 2416-1240048 | CULVERT, 3000D CONCRETE ROADWAY PIPE, 48 IN. DIA. | LF | 24 | | | | | | 24 | | | | |
| 35 | 2416-1541036 | REMOVE AND REINSTALL RIGID PIPE CULVERT LESS THAN OR EQUAL TO 36 IN. | LF | 258 | | | | | | 258 | | | | |
| 36 | 2416-1541136 | REMOVE AND REINSTALL RIGID PIPE CULVERT GREATER THAN 36 IN. | LF | 30 | | | | | | 30 | | | | |
| 37 | 2417-0225018 | APRONS, METAL, 18 IN. DIA. | EACH | 139 | | | | | | 139 | | | | |
| 38 | 2417-0225024 | APRONS, METAL, 24 IN. DIA. | EACH | 17 | | | | | | 17 | | | | |
| 39 | 2417-0225030 | APRONS, METAL, 30 IN. DIA. | EACH | 9 | | | | | | 9 | | | | |
| 40 | 2422-0360018 | APRONS, UNCLASSIFIED, 18 IN. DIA. | EACH | 1 | | | | | | 1 | | | | |
| 41 | 2422-1723018 | CULVERT, UNCLASSIFIED ROADWAY PIPE, 18 IN. DIA. | LF | 50 | | | | | | 50 | | | | |
| 42 | 2502-8212034 | SUBDRAIN, LONGITUDINAL, (SHOULDER) 4 IN. DIA. | LF | 35,396.5 | | | | | | 35,396.5 | | | | |
| 43 | 2502-8221306 | SUBDRAIN OUTLET, DR-306 | EACH | 161 | | | | | | 161 | | | | |
| 44 | 2505-4008130 | REMOVAL OF CABLE GUARDRAIL | LF | 7,120.0 | | | | | | 7,120.0 | | | | |
| 45 | 2505-6000111 | HIGH TENSION CABLE GUARDRAIL | LF | 6,330.0 | | | | | | 6,330.0 | | | | |
| 46 | 2505-6000121 | HIGH TENSION CABLE GUARDRAIL, END ANCHOR | EACH | 16 | | | | | | 16 | | | | |
| 47 | 2505-6000131 | HIGH TENSION CABLE GUARDRAIL, SPARE PARTS KIT | EACH | 1 | | | | | | 1 | | | | |
| 48 | 2506-4984000 | FLOWABLE MORTAR | CY | 5.7 | | | | | | 5.7 | | | | |
| 49 | 2507-3250005 | ENGINEERING FABRIC | SY | 698.0 | | | | | | 698.0 | | | | |
| 50 | 2507-6800061 | REVTMENT, CLASS E | TON | 396.0 | | | | | | 396.0 | | | | |
| 51 | 2507-8029000 | EROSION STONE | TON | 162.0 | | | | | | 162.0 | | | | |
| 52 | 2510-6745850 | REMOVAL OF PAVEMENT | SY | 3,044.4 | | | | | | 3,044.4 | | | | |
| 53 | 2512-1725206 | CURB AND GUTTER, P.C. CONCRETE, 2.0 FT. | LF | 55.0 | | | | | | 55.0 | | | | |
| 54 | 2515-6745600 | REMOVAL OF PAVED DRIVEWAY | SY | 1,213.3 | | | | | | 1,213.3 | | | | |
| 55 | 2520-3350015 | FIELD OFFICE | EACH | 1 | | | | | | 1 | | | | |
| 56 | 2526-8285000 | CONSTRUCTION SURVEY | LS | 1.00 | | | | | | 1.00 | | | | |
| 57 | 2527-9263109 | PAINTED PAVEMENT MARKING, WATERBORNE OR SOLVENT-BASED | STA | 9,883.60 | | | | | | 9,883.60 | | | | |
| 58 | 2528-8445110 | TRAFFIC CONTROL | LS | 1.00 | | | | | | 1.00 | | | | |
| 59 | 2528-8445113 | FLAGGERS | EACH | | | | | | | See Proposal | | | | |
| 60 | 2528-8445115 | PILOT CARS | EACH | | | | | | | See Proposal | | | | |
| 61 | 2529-8174010 | SUBBASE (PATCHES) | SY | 215.0 | | | | | | 215.0 | | | | |

**ESTIMATED PROJECT QUANTITIES
(UP TO A 5 DIVISION PROJECT)**

Division 1: 100% DOT- Project #STP-009-9(71)--2C-03
Division 2: 100% DOT- Project #HSIPX-009-9(88)--3L-03
Division 3: 100% Allamakee County

| Item No. | Item Code | Item | Unit | Quantities | | | | | | | | | | | | |
|----------|--------------|--|------|------------|------------|------------|------------|------------|----------|------------|------------|------------|------------|------------|--|--|
| | | | | Estimated | | | | | As Built | | | | | | | |
| | | | | Division 1 | Division 2 | Division 3 | Division 4 | Division 5 | Total | Division 1 | Division 2 | Division 3 | Division 4 | Division 5 | | |
| 62 | 2529-8174050 | PATCH SUBDRAIN | EACH | 17 | | | | | | | 17 | | | | | |
| 63 | 2533-4980005 | MOBILIZATION | LS | 1.00 | | | | | | | 1.00 | | | | | |
| 64 | 2548-0000100 | MILLED SHOULDER RUMBLE STRIPS, HMA SURFACE | STA | 1,412.2 | | | | | | | 1,412.2 | | | | | |
| 65 | 2548-0000110 | ASPHALT EMULSION FOR FOG SEAL (SHOULDER RUMBLE STRIPS) | GAL | 1,530.8 | | | | | | | 1,530.8 | | | | | |
| 66 | 2548-0000310 | MILLED CENTERLINE RUMBLE STRIPS, HMA SURFACE | STA | 706.1 | | | | | | | 706.1 | | | | | |
| 67 | 2601-2636015 | NATIVE GRASS SEEDING | ACRE | 0.3 | | | | | | | 0.3 | | | | | |
| 68 | 2601-2636043 | SEEDING AND FERTILIZING (RURAL) | ACRE | 1.2 | | | | | | | 1.2 | | | | | |
| 69 | 2601-2642100 | STABILIZING CROP - SEEDING AND FERTILIZING | ACRE | 1.5 | | | | | | | 1.5 | | | | | |
| 70 | 2602-0000030 | SILT FENCE FOR DITCH CHECKS | LF | 2,640.0 | | | | | | | 2,640.0 | | | | | |
| 71 | 2602-0000071 | REMOVAL OF SILT FENCE OR SILT FENCE FOR DITCH CHECKS | LF | 2,640.0 | | | | | | | 2,640.0 | | | | | |
| 72 | 2602-0000101 | MAINTENANCE OF SILT FENCE OR SILT FENCE FOR DITCH CHECK | LF | 252.0 | | | | | | | 252.0 | | | | | |
| 73 | 2602-0000312 | PERIMETER AND SLOPE SEDIMENT CONTROL DEVICE, 12 IN. DIA. | LF | 1,936.0 | | | | | | | 1,936.0 | | | | | |
| 74 | 2602-0000320 | PERIMETER AND SLOPE SEDIMENT CONTROL DEVICE, 20 IN. DIA. | LF | 7,832.0 | | | | | | | 7,832.0 | | | | | |
| 75 | 2602-0000350 | REMOVAL OF PERIMETER AND SLOPE SEDIMENT CONTROL DEVICE | LF | 9,768.0 | | | | | | | 9,768.0 | | | | | |
| 76 | 2602-0010010 | MOBILIZATIONS, EROSION CONTROL | EACH | 1 | | | | | | | 1 | | | | | |
| 77 | 2602-0010020 | MOBILIZATIONS, EMERGENCY EROSION CONTROL | EACH | 1 | | | | | | | 1 | | | | | |

ESTIMATE REFERENCE INFORMATION 100-4A
10-29-02

| Item No. | Item Code | Description |
|----------|--------------|--|
| 1 | 2101-0850002 | CLEARING AND GRUBBING Refer to Tabulation 110-17 for additional information. |
| - | - | - |
| 2 | 2102-2625000 | EMBANKMENT-IN-PLACE Refer to Tabulations 104-13 and 104-13A for additional information. Quantity is for fill for pipe extensions. The Contractor shall supply all fill material needed. Removal of small brush or debris in these area shall be considered incidental to this bid item. Material obtained from item "Excavation, Class 13, Widening" may be used for this work. Overhaul will not be paid for this item. |
| - | - | - |
| 3 | 2102-2713070 | EXCAVATION, CLASS 13, ROADWAY AND BORROW Refer to Tabulation 107-24. Item is for excavation of surplus material at existing cable guardrail locations. |
| - | - | - |
| 4 | 2105-8425005 | TOPSOIL, FURNISH AND SPREAD All disturbed areas not covered by concrete, asphalt, gravel or sod shall have a minimum of 4 inches of topsoil. The Contractor shall provide all the required topsoil. Topsoil from stripping and approved by the Engineer for placement may also be used. Stripping of topsoil for placement of fill is considered incidental to this bid item. Refer to Tabulation 103-10 for additional information. |
| - | - | - |
| 5 | 2115-0100000 | MODIFIED SUBBASE Refer to Tabulation 100-25. |
| - | - | - |
| 6 | 2121-7425020 | GRANULAR SHOULDERS, TYPE B Refer to Typical 7135 and Tabulation 112-9 for additional information. |
| - | - | - |
| 7 | 2123-7450000 | SHOULDER CONSTRUCTION, EARTH |
| - | - | - |
| 8 | 2125-2225050 | RESHAPING DITCHES Ditches shall be graded to a minimum of 1% to provide positive drainage, as determined by Engineer in the field. Refer to Tabulation 300-1 for locations. |
| - | - | - |
| 9 | 2212-5070310 | PATCHES, FULL-DEPTH REPAIR |
| 10 | 2212-5070330 | PATCHES BY COUNT (REPAIR) Refer to Tabulation 102-6C for additional information. |
| - | - | - |

ESTIMATE REFERENCE INFORMATION 100-4A
10-29-02

| Item No. | Item Code | Description |
|----------|--------------|---|
| 11 | 2213-2713300 | EXCAVATION, CLASS 13, FOR WIDENING Refer to Typical MK-1 through MK-2 and 7149 and Tabulation 100-25 and 112-9 for additional information. Excavation not used on the project shall become property of the Contractor and removed from the project. Overhaul will not be paid for this item. Excavate granular roadway in order to construct extended HMA fillets. Item will be paid at plan quantity for Division 3. |
| - | - | - |
| 12 | 2213-6745700 | REMOVAL OF FLUMES Refer to Tabulation 110-2 for additional information. |
| - | - | - |
| 13 | 2214-5145150 | PAVEMENT SCARIFICATION Refer to Typical MK-1 through MK-2 and Tabulations 100-25 and 102-16 for additional information. |
| - | - | - |
| 14 | 2303-1031750 | HOT MIX ASPHALT STANDARD TRAFFIC, BASE COURSE, 3/4 IN. MIX |
| 15 | 2303-1032500 | HOT MIX ASPHALT STANDARD TRAFFIC, INTERMEDIATE COURSE, 1/2 IN. MIX |
| 16 | 2303-1033500 | HOT MIX ASPHALT STANDARD TRAFFIC, SURFACE COURSE, 1/2 IN. MIX, NO SPECIAL FRICTION REQUIREMENT |
| 17 | 2303-1258283 | ASPHALT BINDER, PG 58-28S, STANDARD TRAFFIC |
| 18 | 2303-6911000 | HOT MIX ASPHALT PAVEMENT SAMPLES Refer to Typical MK-1, MK-2, and 7149 and Tabulation 100-25 and 112-9 for additional information. Estimated project quantities include an additional 5% for irregularities. Division 2 and 3 will be paid at plan quantity. |
| - | - | - |
| 19 | 2303-7000610 | PAYMENT ADJUSTMENT INCENTIVE/DISINCENTIVE FOR HMA MIXTURE LABORATORY VOIDS (FORMULA - BY PAY FACTOR) |
| 20 | 2303-7000620 | PAYMENT ADJUSTMENT INCENTIVE/DISINCENTIVE FOR HMA MIXTURE FIELD VOIDS (FORMULA - BY PAY FACTOR) Estimated 0.5 times the tons of HMA. |
| - | - | - |
| 21 | 2315-8275025 | SURFACING, DRIVEWAY, CLASS A CRUSHED STONE Refer to Tabulations 100-25 and 102-3 for additional information. |
| - | - | - |
| 22 | 2317-7000120 | PAYMENT ADJUSTMENT INCENTIVE/DISINCENTIVE FOR HMA PAVEMENT SMOOTHNESS (BY SCHEDULE) Estimated at 0.24 times the square yards of surface paving. |
| - | - | - |
| 23 | 2318-1001100 | COLD IN-PLACE RECYCLED ASPHALT PAVEMENT |
| 24 | 2318-1001220 | ASPHALT STABILIZING AGENT (FOAMED ASPHALT) Refer to Typical MK-1 through MK-2 and Tabulation 100-25 for additional information. Foamed asphalt shall be PG 52-34S. |
| - | - | - |
| 25 | 2401-6745650 | REMOVAL OF EXISTING STRUCTURES Refer to Tabulations 110-2 and 110-9 for additional information. |
| - | - | - |

ESTIMATE REFERENCE INFORMATION

| Item No. | Item Code | Description |
|----------|--------------|---|
| 26 | 2402-2720100 | EXCAVATION, CLASS 20, FOR ROADWAY PIPE CULVERT Refer to Tabulations 104-13 and 104-13A for additional information. |
| - | - | Silt inside the existing culverts shall be removed to the extent necessary for positive flowline creation. |
| 27 | 2416-0100018 | APRONS, CONCRETE, 18 IN. DIA. |
| 28 | 2416-0100024 | APRONS, CONCRETE, 24 IN. DIA. |
| 29 | 2416-0100030 | APRONS, CONCRETE, 30 IN. DIA. |
| 30 | 2416-0101036 | REMOVE AND REINSTALL CONCRETE PIPE APRONS LESS THAN OR EQUAL TO 36 IN. |
| 31 | 2416-0101136 | REMOVE AND REINSTALL CONCRETE PIPE APRONS GREATER THAN 36 IN. |
| 32 | 2416-1160018 | CULVERT, CONCRETE ENTRANCE PIPE, 18 IN. DIA. |
| 33 | 2416-1240036 | CULVERT, 3000D CONCRETE ROADWAY PIPE, 36 IN. DIA. |
| 34 | 2416-1240048 | CULVERT, 3000D CONCRETE ROADWAY PIPE, 48 IN. DIA. |
| 35 | 2416-1541036 | REMOVE AND REINSTALL RIGID PIPE CULVERT LESS THAN OR EQUAL TO 36 IN. |
| 36 | 2416-1541136 | REMOVE AND REINSTALL RIGID PIPE CULVERT GREATER THAN 36 IN. |
| 37 | 2417-0225018 | APRONS, METAL, 18 IN. DIA. |
| 38 | 2417-0225024 | APRONS, METAL, 24 IN. DIA. |
| 39 | 2417-0225030 | APRONS, METAL, 30 IN. DIA. |
| 40 | 2422-0360018 | APRONS, UNCLASSIFIED, 18 IN. DIA. |
| 41 | 2422-1723018 | CULVERT, UNCLASSIFIED ROADWAY PIPE, 18 IN. DIA. Refer to Tabulations 104-13, 104-13A and 110-2 for additional information. |
| 42 | 2502-8212034 | SUBDRAIN, LONGITUDINAL, (SHOULDER) 4 IN. DIA. |
| 43 | 2502-8221306 | SUBDRAIN OUTLET, DR-306 Refer to Typical MK-1, MK-2 and Tabulation 104-9 for additional information. Restoration of site is also incidental to outlet installation. |
| 44 | 2505-4008130 | REMOVAL OF CABLE GUARDRAIL Refer to Tabulations 110-7B and 110-13 for additional information. |
| 45 | 2505-6000111 | HIGH TENSION CABLE GUARDRAIL |
| 46 | 2505-6000121 | HIGH TENSION CABLE GUARDRAIL, END ANCHOR |
| 47 | 2505-6000131 | HIGH TENSION CABLE GUARDRAIL, SPARE PARTS KIT Refer to Tabulation 108-9A for additional information. Spare parts kit shall include a tension meter. Deliver tension meter to Joel Monroe, phone 563-880-0084. |
| 48 | 2506-4984000 | FLOWABLE MORTAR Refer to Typical 4315 and Tabulation 110-9. To be used to fill existing culvert at STA 517+50.0. Do not fill existing outlet box with mortar other than to facilitate new drainage to newly installed pipe out letting box. |
| 49 | 2507-3250005 | ENGINEERING FABRIC |
| 50 | 2507-6800061 | REVEITEMENT, CLASS E |
| 51 | 2507-8029000 | EROSION STONE Refer to Tabulation 100-23 for additional information. |
| 52 | 2510-6745850 | REMOVAL OF PAVEMENT Refer to Tabulation 110-1 for additional information. |
| 53 | 2512-1725206 | CURB AND GUTTER, P.C. CONCRETE, 2.0 FT. Refer to Tabulation 112-4 for additional information. |
| 54 | 2515-6745600 | REMOVAL OF PAVED DRIVEWAY Refer to Tabulation 110-8 for additional information. |
| 55 | 2520-3350015 | FIELD OFFICE |
| 56 | 2526-8285000 | CONSTRUCTION SURVEY |
| 57 | 2527-9263109 | PAINTED PAVEMENT MARKING, WATERBORNE OR SOLVENT-BASED Refer to Tabulation 108-22 for additional information. Final pavement markings shall be placed a minimum of 30 days after final HMA placement. |
| 58 | 2528-8445110 | TRAFFIC CONTROL Refer to Sheet J.1 for additional information. |
| 59 | 2528-8445113 | FLAGGERS |
| 60 | 2528-8445115 | PILOT CARS |
| 61 | 2529-8174010 | SUBBASE (PATCHES) |
| 62 | 2529-8174050 | PATCH SUBDRAIN Refer to Tabulation 102-6C for additional information. |
| 63 | 2533-4980005 | MOBILIZATION |

ESTIMATE REFERENCE INFORMATION

| Item No. | Item Code | Description |
|----------|--------------|---|
| 64 | 2548-0000100 | MILLED SHOULDER RUMBLE STRIPS, HMA SURFACE |
| 65 | 2548-0000110 | ASPHALT EMULSION FOR FOG SEAL (SHOULDER RUMBLE STRIPS) |
| 66 | 2548-0000310 | MILLED CENTERLINE RUMBLE STRIPS, HMA SURFACE Refer to Tabulation 112-10 for additional information. |
| 67 | 2601-2636015 | NATIVE GRASS SEEDING |
| 68 | 2601-2636043 | SEEDING AND FERTILIZING (RURAL) |
| 69 | 2601-2642100 | STABILIZING CROP - SEEDING AND FERTILIZING |
| 70 | 2602-0000030 | SILT FENCE FOR DITCH CHECKS Refer to Tabulation 110-18 for additional information. This item includes estimated locations for placement of "Silt Fence for Ditch Checks" to address possible erosion encountered during construction. Verify the specific locations with Engineer prior to placement. |
| 71 | 2602-0000071 | REMOVAL OF SILT FENCE OR SILT FENCE FOR DITCH CHECKS This item is included for "Silt Fence and Silt Fence for Ditch Check Removal", including removal to allow for replacement (replacement to be paid separately), or for areas that have achieved 70% permanent growth. |
| 72 | 2602-0000101 | MAINTENANCE OF SILT FENCE OR SILT FENCE FOR DITCH CHECK This item is included for clean-out and repair of "Silt Fence and Silt Fence for Ditch Checks" installed for the project. Estimated at 10% of "Silt Fence and Silt Fence for Ditch Check" quantities. |
| 73 | 2602-0000312 | PERIMETER AND SLOPE SEDIMENT CONTROL DEVICE, 12 IN. DIA. |
| 74 | 2602-0000320 | PERIMETER AND SLOPE SEDIMENT CONTROL DEVICE, 20 IN. DIA. |
| 75 | 2602-0000350 | REMOVAL OF PERIMETER AND SLOPE SEDIMENT CONTROL DEVICE Refer to Tabulation 100-19 for additional information. Verify specific locations with Engineer prior to placement. Quantity includes an additional 10%. Silt Fence may be substituted at no additional cost to the contracting authority at the discretion of the Engineer. |
| 76 | 2602-0010010 | MOBILIZATIONS, EROSION CONTROL |
| 77 | 2602-0010020 | MOBILIZATIONS, EMERGENCY EROSION CONTROL |

STANDARD ROAD PLANS

The following Standard Road Plans apply to construction work on this project.

| Number | Date | Title |
|--------|----------|---|
| BA-351 | 10-15-19 | High Tension Cable Guardrail |
| DR-101 | 04-18-17 | Pipe Culvert (Bedding and Backfill) |
| DR-102 | 04-21-15 | Pipe Culvert (Cover and Camber) |
| DR-103 | 04-21-15 | Pipe Culvert (Installation Details) |
| DR-104 | 04-19-16 | Depth of Cover Tables for Concrete and Corrugated Pipe |
| DR-121 | 10-17-17 | Connected Pipe Joints |
| DR-122 | 10-18-16 | Construction of Type "C" Concrete Adaptors for Pipe Culvert Connections |
| DR-201 | 10-16-18 | Concrete Aprons |
| DR-203 | 04-21-15 | Metal Pipe Aprons and Beveled Ends |
| DR-303 | 10-17-17 | Subdrains (Longitudinal) |
| DR-306 | 10-16-18 | Precast Concrete Headwall for Subdrain Outlets |
| DR-621 | 04-18-17 | Pipe Extension |
| DR-651 | 04-18-17 | Unclassified Pipe Culvert |
| EC-201 | 10-15-19 | Silt Fence |
| EC-301 | 10-18-16 | Rock Erosion Control (REC) |
| EC-502 | 04-21-15 | Seeding in Rural Areas |
| EW-105 | 04-21-15 | Reshaping Slopes and Ditches |
| EW-501 | 10-20-15 | Rural Entrance |
| EW-503 | 10-20-15 | Side Road Grading |
| PM-110 | 10-16-18 | Line Types |
| PM-120 | 10-21-14 | Stop Lines and Islands |
| PM-221 | 10-18-16 | Climbing Lane |
| PM-420 | 10-15-19 | Two-Lane Roadway with no Turn Lanes (One-Way Stop Condition) |
| PM-520 | 10-15-19 | Two-Lane Roadway with no Turn Lanes (Two-Way Stop Condition) |
| PR-140 | 04-21-15 | Subbase Patches |
| PR-201 | 10-21-14 | Runouts for Resurfacing |
| PR-202 | 10-21-14 | Notches for Resurfacing (with or without Runout) |
| PV-12 | 04-19-16 | Milled Shoulder Rumble Strips |
| PV-13 | 10-17-17 | Milled Centerline Rumble Strips |
| PV-102 | 10-18-16 | PCC Curb Details |
| PV-202 | 04-16-13 | Hot Mix Asphalt Resurfacing |
| PV-203 | 10-15-13 | HMA Base Widening |
| PV-301 | 04-19-11 | Superelevation Details Two Lane Roadway |
| SI-881 | 04-16-19 | Special Signs for Workzones |
| TC-1 | 10-15-19 | Work Not Affecting Traffic (Two-Lane or Multi-Lane) |
| TC-202 | 04-21-15 | Work Within 15 ft of Traveled Way |
| TC-213 | 10-15-19 | Lane Closure with Flaggers |
| TC-214 | 10-15-19 | Lane Closure with Flaggers for use with Pilot Car |
| TC-282 | 10-15-19 | Uneven Lanes |

INDEX OF TABULATIONS

| Tabulation | Tabulation Title | Sheet No. |
|-----------------|--|-------------|
| C Sheets | | |
| 100-1C | ESTIMATED PROJECT QUANTITIES (UP TO A 5 DIVISION PROJECT) | C.1 - C.2 |
| 100-1D | PROJECT DESCRIPTION | C.1 |
| 100-1U | UTILITIES | C.4 |
| 100-4A | ESTIMATE REFERENCE INFORMATION | C.2 - C.3 |
| 100-18 | SILT FENCES FOR DITCH CHECKS | C.7 |
| 100-19 | PERIMETER AND SLOPE SEDIMENT CONTROL DEVICE | C.6 |
| 100-23 | ROCK EROSION CONTROL | C.9 |
| 100-25 | HMA PAVEMENT | C.18 - C.19 |
| 100-34 | STORMWATER DRAINAGE BASIN AND STORAGE | C.6 |
| 102-3 | ACCESS POINTS AND SAFETY RAMPS | C.15 |
| 102-5 | EXISTING PAVEMENT | C.8 |
| 102-6C | FULL-DEPTH PATCHES | C.16 |
| 102-16 | NOTCHES AND RUNOUTS FOR RESURFACING | C.7 |
| 103-10 | TOPSOIL STRIPPING AND PLACEMENT | C.6 |
| 104-9 | LONGITUDINAL SUBDRAIN SHOULDER AND BACKSLOPE | C.10 - C.12 |
| 104-13 | FORESLOPE FLATTENING AND DRAINAGE STRUCTURES BY ROAD CONTRACTOR (MAINLINE PIPES) | C.12 - C.13 |
| 104-13A | FORESLOPE FLATTENING AND DRAINAGE STRUCTURES BY ROAD CONTRACTOR (SIDE ROAD AND ENTRANCE PIPES) | C.13 - C.14 |
| 105-4 | STANDARD ROAD PLANS | C.4 |
| 107-24 | GRADING FOR HIGH TENSION CABLE GUARDRAIL INSTALLATIONS | C.15 |
| 108-9A | HIGH TENSION CABLE GUARDRAIL | C.15 |
| 108-22 | PAVEMENT MARKING LINE TYPES | C.20 - C.21 |
| 110-1 | REMOVAL OF PAVEMENT | C.8 |
| 110-2 | REMOVAL OF EXISTING STRUCTURES | C.8 |
| 110-7B | REMOVAL OF CABLE GUARDRAIL | C.8 |
| 110-8 | REMOVAL OF FILLETS | C.7 |
| 110-9 | CULVERT ABANDONMENT | C.8 |
| 110-12A | POLLUTION PREVENTION PLAN | C.5 - C.6 |
| 110-13 | DELIVERY AND STOCKPILING | C.4 |
| 110-17 | CLEARING AND GRUBBING | C.9 |
| 112-4 | CURBS AND RAISED ISLANDS | C.8 |
| 112-9 | SHOULDERS | C.17 |
| 112-10 | MILLED RUMBLE STRIPS | C.21 |
| BD-1 | CULTURAL RESOURCES | C.4 |
| 300-1 | DITCH RESHAPING | C.7 |

UTILITIES

| | | |
|---|--|---|
| <p>Brian Jerviss Acentek (Fiber Distribution) (507)896-6231 bjerviss@acentek.net</p> | <p>Paul Foxwell Allamakee-Clayton Elec Co-op (Elec Transmission) (563)864-7611 pfoxwell@acrec.coop</p> | <p>Heather Dee Alliant Energy (Gas/Elec Distribution) (319)786-8196 rerow@alliantenergy.com</p> |
| <p>Brad Fleming Black Hills Energy (Gas Distribution) (402)221-2714 brad.fleming@blackhillscorp.com</p> | <p>Steve Parker Centurylink (Fiber Distribution) (515)265-0968 Steven.parker4@centurylink.com</p> | <p>Heath Draeger Lansing (Water) (563)538-4757 hdraeger@peopleservice.com</p> |
| <p>Chip Piper Mediacom Communications Corp (Cable TV) (563)387-0825 cpiper@mediacomcc.com</p> | <p>Mike Broderick Iowa Communications Network (Fiber Distribution) (563)387-0825 mike.broderick@iowa.gov</p> | <p>Jim Cooper Waukon (Water) (563)419-4213 cws@sbtek.net</p> |

DELIVERY AND STOCKPILING

| Item Description | Quantity | Units | Delivery Location | Contact Name & Number | Remarks |
|------------------|----------|-------|-------------------|---------------------------|---------|
| Guardrail posts | | | Waukon DOT shop | Joel Monroe, 563-880-0084 | |

CULTURAL RESOURCES

The Contractor shall avoid any ground disturbance and achieve low project vibration levels when working near these properties:

- Allamakee County Poor Farm Cemetery- near 877 Hwy 9
- St. Mary's Church Cemetery- 1831 Lycungus Rd
- Landmark Inn- 1172 Hwy 9
- Marsden on the Ridge- 1066 Hwy 9
- Lansing Ridge Cemetery-1353 Hwy 9
- Gethsemane Chapel Cemetery- 2212 Main St

AUTOMATIC TRAFFIC RECORDER

Automatic Traffic Recorder (ATR) installation is located within this project's construction limits (STA 789+90). Notify the Iowa DOT's Transportation Data Office (telephone number 515-239-1197) a minimum of 7 days prior to working near the ATR installation. Transportation Data personnel will locate and mark the ATR one time. Treat these ATR systems similar to other public utilities. The Contractor is responsible for paying for unapproved damage they have caused to the ATR system.

INDIVIDUAL STORM WATER PERMIT

This project is regulated by the requirements of Iowa Department of Natural Resources (DNR) National Pollutant Discharge Elimination System (NPDES) permit, Permit No. ##-##-##. A copy of this permit is available from the Iowa DOT Office of Contracts upon request. Co-permittee certification statement requirements from Standard Specifications Section 2602 apply.

STORM WATER BEST MANAGEMENT PRACTICES

When the following best management practices are used, they are intended to account for disturbed areas where storage volume cannot be provided: undisturbed foreslopes and ditches will act as vegetated buffers, silt fence placed downstream of disturbed areas in ditches where drainage leaves the ROW and at roadway culverts.

POLLUTION PREVENTION PLAN

This project is regulated by the requirements of the Iowa Department of Natural Resources (DNR) National Pollutant Discharge Elimination System (NPDES) General Permit No. 2 OR an Iowa Department of Natural Resources (DNR) National Pollutant Discharge Elimination System (NPDES) individual storm water permit. The Contractor shall carry out the terms and conditions of this permit and the Pollution Prevention Plan (PPP).

This Base PPP includes information on Roles and Responsibilities, Project Site Description, Controls, Maintenance Procedures, Inspection Requirements, Non-Storm Water Controls, Potential Sources of Off Right-of-Way Pollution, and Definitions. This plan references other documents rather than repeating the information contained in the documents. A copy of this Base Pollution Prevention Plan, amended as needed per plan revisions or by contract modification, will be readily available for review.

All contractors shall conduct their operations in a manner that controls pollutants, minimizes erosion, and prevents sediments from entering waters of the state and leaving the highway right-of-way. The prime contractor shall be responsible for compliance and implementation of the PPP for their entire contract. This responsibility shall be further shared with subcontractors whose work is a source of potential pollution as defined in this PPP.

I. ROLES AND RESPONSIBILITIES

- A. Designer:
 1. Prepares Base PPP included in the project plan.
 2. Prepares Notice of Intent (NOI) submitted to Iowa DNR.
 3. Signature authority on the Base PPP and NOI.
- B. Contractor/Subcontractor:
 1. Affected contractors/subcontractors are co-permittees with the IDOT and will sign a certification statement adhering to the requirements of the NPDES permit and this PPP plan. Affected contractors/subcontractors are anyone responsible for sediment or erosion controls or involved in land disturbing activities. All co-permittees are legally required under the Clean Water Act and the Iowa Administrative Code to ensure compliance with the terms and conditions of this PPP.
 2. Submit an Erosion Control Implementation Plan (ECIP) according to Specifications Section 2602 and any additional plan notes.
 3. Install and maintain appropriate controls.
 4. Supervise and implement good housekeeping practices.
 5. Conduct joint required inspections of the site with inspection staff.
 6. Comply with training and certification requirements of Specifications Section 2602.
 7. Signature authority on Co-Permittee Certification Statements and storm water inspection reports.
- C. RCE/Inspector:
 1. Update PPP whenever there is a change in design, construction, operation or maintenance, which has a significant effect on the discharge of pollutants from the project.
 2. Maintain an up-to-date record that identifies contractors and subcontractors as co-permittees.
 3. Make these plans available to the DNR upon their request.
 4. Conduct joint required inspections of the site with the contractor/subcontractor.
 5. Complete an inspection report after each inspection.
 6. Signature authority on storm water inspection reports and Notice of Discontinuation (NOD).

II. PROJECT SITE DESCRIPTION

- A. This Pollution Prevention Plan (PPP) is for the construction of HMA Pavement Widening with HMA Resurfacing.
- B. This PPP covers approximately 355.88 acres with an estimated 1.5 acres being disturbed. The portion of the PPP covered by this contract has 1.5 acres disturbed.
- C. The PPP is located in an area of one soil association (Downs-Fayette-Nordness). The estimated weighted average runoff coefficient number for this PPP after completion will be 0.30.
- D. Storm Water Site Map - Multiple sources of information comprise the base storm water site map including:
 1. Drainage patterns - Plan and Profile sheets and Situation plans.
 2. Proposed Slopes - Cross Sections.
 3. Areas of Soil Disturbance - construction limits shown on Plan and Profile sheets.
 4. Location of Structural Controls - Tabulations on C sheets.
 5. Locations of Non-structural Controls - Tabulations on C sheets.
 6. Locations of Stabilization Practices - generally within construction limits shown on Plan and Profile sheets.
 7. Surface Waters (including wetlands) - Project Location Map and Plan and Profile sheets.
 8. Locations where storm water is discharged - Plan and Profile sheets.
- E. The base site map is amended by contract modifications and progress payments (fieldbook entries) of completed erosion control work. Also, due to project phasing, erosion and sediment controls shown on project plans may not be installed until needed, based on site conditions. For example, silt fence ditch checks will typically not be installed until the ditch has been installed. Installed locations may also be modified from tabulation locations by field staff. Installed locations will be documented by fieldbook entries.
- F. Runoff from this work will flow into roadway ditches, unnamed drainage swales, Silver, Village, and Clear Creeks and the Mississippi River.

III. CONTROLS

- A. The contractor's ECIP specified in Article 2602.03 for accomplishment of storm water controls should clearly describe the intended sequence of major activities and for each activity define the control measure and the timing during the construction process that the measure will be implemented.
- B. Preserve vegetation in areas not needed for construction.
- C. Sections 2601 and 2602 of the Standard Specifications define requirements to implement erosion and sediment control measures. Actual quantities used and installed locations may vary from the Base PPP and amendment of the plan will be documented via fieldbook entries or by contract modification. Additional erosion and sediment control items may be required as determined by the inspector and/or contractor during storm water monitoring inspections. If the work involved is not applicable to any contract items, the work will be paid for according to Article 1109.03 paragraph B.
 1. EROSION AND SEDIMENT CONTROLS
 - a. Stabilization Practices
 - 1) Site plans will ensure that existing vegetation or natural buffers are preserved where attainable and disturbed portions of the site will be stabilized.
 - 2) Initialize stabilization of disturbed areas immediately after clearing, grading, excavating, or other earth disturbing activities have:
 - a) Permanently ceased on any portion of the site, or
 - b) Temporarily ceased on any portion of the site and will not resume for a period exceeding 14 calendar days.
 - 3) Staged permanent and/or temporary stabilizing seeding and mulching shall be completed as the disturbed areas are completed. Incomplete areas shall be stabilized according to paragraph III, C, 1, a, 2, b above.
 - 4) Permanent and Temporary Stabilization practices to be used for this project are located in the Estimated Project Quantities (100-0A, 100-1A, or 100-1C) and Estimate Reference Information (100-4A) located on the C sheets of the plan.

POLLUTION PREVENTION PLAN

Typical drawings detailing construction of the practices to be used on this project are referenced in the Standard Road Plans Tabulation.

- 5) Preservation of existing vegetation within right-of-way or easements will act as vegetative buffer strips.
- 6) Preservation of topsoil: Bid items to be used for this project are located in the Estimated Project Quantities (100-0A, 100-1A, or 100-1C) and Estimate Reference Information (100-4A) located on the C sheets of the plan. Additional information may be found in Tabulations in the C or T sheets of the plans or is referenced in Standard Specifications Section 2105.

- b. Structural Practices
 - 1) Structural practices will be implemented to divert flows from exposed soils and detain or otherwise limit runoff and the discharge of pollutants from exposed areas of the site. Additionally, structural practices may include: silt basins that provide 3600 cubic feet of storage per acre drained or equivalent sediment controls, outlet structures that withdraw water from surface when discharging basins, and controls to direct storm water to vegetated areas.
 - 2) Structural practices to be used for this project are located in the Estimated Project Quantities (100-0A, 100-1A, or 100-1C) and Estimate Reference Information (100-4A) located on the C sheets of the plan, as well as all other item specific Tabulations. Typical drawings detailing construction of the devices to be used on this project can be found on the B sheets of the plans or are referenced in the Standard Road Plans Tabulation.

- c. Storm Water Management
 - 1) Measures shall be installed during the construction process to control pollutants in storm water discharges that will occur after construction operations have been completed. This may include velocity dissipation devices at discharge locations and along length of outfall channel as necessary to provide a non-erosion velocity flow from structure to water course. If included with this project, these items are located in the Estimated Project Quantities (100-0A, 100-1A, or 100-1C) and Estimate Reference Information (100-4A) located on the C sheets of the plan, as well as all other item specific Tabulations. Typical drawings detailing construction of the practices to be used on this project are referenced in the Standard Road Plans Tabulation. The installation of these devices may be subject to Section 404 of the Clean Water Act.

2. OTHER CONTROLS

- a. Contractor disposal of unused construction materials and construction material wastes shall comply with applicable state and local waste disposal, sanitary sewer, or septic system regulations. In the event of a conflict with other governmental laws, rules and regulations, the more restrictive laws, rules or regulations shall apply.
 - 1) Vehicle Entrances and Exits - Construct and maintain entrances and exits to prevent tracking of sediments onto roadways.
 - 2) Material Delivery, Storage and Use - Implement practices to prevent discharge of construction materials during delivery, storage, and use.
 - 3) Stockpile Management - Install controls to reduce or eliminate pollution of storm water from stockpiles of soil and paving.
 - 4) Waste Disposal - Do not discharge any materials, including building materials, into waters of the state, except as authorized by a Section 404 permit.
 - 5) Spill Prevention and Control - Implement procedures to contain and clean-up spills and prevent material discharges to the storm drain system and waters of the state.
 - 6) Concrete Residuals and Washout Wastes - Designate temporary concrete washout facilities for rinsing out concrete trucks. Provide directions to truck drivers where designated washout facilities are located. Designated washout areas should be located at least 50 feet away from storm drains, streams or other water bodies. Care should be taken to ensure these facilities do not overflow during storm events.
 - 7) Concrete Grooving/Grinding Slurry - Do not discharge slurry to a waterbody or storm drain. Slurry may be applied on foreslopes or removed from the project.
 - 8) Vehicle and Equipment Storage and Maintenance Areas - Perform on site fueling and maintenance in accordance with all environmental laws such as proper storage of onsite fuels and proper disposal of used engine oil or other fluids on site. Employ washing practices that prevent contamination of surface and ground water from wash water.
 - 9) Litter Management - Ensure employees properly dispose of litter.
 - 10) Dewatering - Properly treat water to remove suspended sediment before it re-enters a waterbody or discharges off-site. Measures are also to be taken to prevent scour erosion at dewatering discharge point.

3. APPROVED STATE OR LOCAL PLANS

During the course of this construction, it is possible that situations will arise where unknown materials will be encountered. When such situations are encountered, they will be handled according to all federal, state, and local regulations in effect at the time.

IV. MAINTENANCE PROCEDURES

The contractor is required to maintain all temporary erosion and sediment control measures in proper working order, including cleaning, repairing, or replacing them throughout the contract period. This shall begin when the features have lost 50% of their capacity.

V. INSPECTION REQUIREMENTS

- A. Inspections shall be made jointly by the contractor and the contracting authority at least once every seven calendar days. Storm water monitoring inspections will include:
 1. Date of the inspection.
 2. Summary of the scope of the inspection.
 3. Name and qualifications of the personnel making the inspection.
 5. Review erosion and sediment control measures within disturbed areas for the effectiveness in preventing impacts to receiving waters.
 6. Major observations related to the implementation of the PPP.
 7. Identify corrective actions required to maintain or modify erosion and sediment control measures.
- B. Include storm water monitoring inspection reports in the Amended PPP. Incorporate any additional erosion and sediment control measures determined as a result of the inspection. Immediately begin corrective actions on all deficiencies found within 3 calendar days of the inspection.

VI. NON-STORM WATER DISCHARGES

This includes subsurface drains (i.e. longitudinal and standard subdrains) and slope drains. The velocity of the discharge from these features may be controlled by the use of patio blocks, Class A stone, erosion stone or other appropriate materials. This also includes uncontaminated groundwater from dewatering operations, which will be controlled as discussed in Section III of the PPP.

VII. POTENTIAL SOURCES OF OFF RIGHT-OF-WAY (ROW) POLLUTION

Silts, sediment, and other forms of pollution may be transported onto highway right-of-way (ROW) as a result of a storm event. Potential sources of pollution located outside highway ROW are beyond the control of this PPP. Pollution within highway ROW will be conveyed and controlled per this PPP.

VIII. DEFINITIONS

- A. Base PPP - Initial Pollution Prevention Plan.

POLLUTION PREVENTION PLAN

- B. Amended PPP - May include Plan Revisions or Contract Modifications for new items, storm water monitoring inspection reports, and fieldbook entries made by the inspector.
- C. IDR - Inspector's Daily Report - this contains the inspector's daily diary and bid item postings.
- D. Controls - Methods, practices, or measures to minimize or prevent erosion, control sedimentation, control storm water, or minimize contaminants from other types of waste or materials. Also called Best Management Practices (BMPs).
- E. Signature Authority - Representative from Designer, Contractor/Subcontractor, or RCE/Inspector authorized to sign various storm water documents.

CERTIFICATION STATEMENT

I certify under penalty of law that this document and all attachments were prepared under my direction or supervision in accordance with a system designed to assure that qualified personnel properly gathered and evaluated the information submitted. Based on my inquiry of the person or persons who manage the system, or those persons directly responsible for gathering the information, the information submitted is, to the best of my knowledge and belief, true, accurate, and complete. I am aware that there are significant penalties for submitting false information, including the possibility of fine and imprisonment for knowing violations.

Mary K Kelly
Signature

Mary K. Kelly
Printed or Typed Name

Signature

Printed or Typed Name

PERIMETER AND SLOPE SEDIMENT CONTROL DEVICE

Possible Standards: EC-204

| Location | | | Length of Installation | | | Remarks |
|---------------|-------------|------|------------------------|-------------|-------------|---------|
| Begin Station | End Station | Side | 9 inch Dia | 12 inch Dia | 20 inch Dia | |
| | | | LF | LF | LF | |
| 60+70.00 | 68+65.00 | RT | | | 795.0 | |
| 62+70.00 | 71+81.00 | LT | | | 911.0 | |
| 77+00.00 | 84+57.00 | RT | | | 757.0 | |
| 91+50.00 | 99+40.00 | LT | | | 790.0 | |
| 322+35.00 | 333+60.00 | RT | | | 1125.0 | |
| 410+00.00 | 418+47.00 | LT | | | 847.0 | |
| 527+50.00 | 536+62.50 | RT | | | 912.5 | |
| 743+75.00 | 753+57.50 | RT | | | 982.5 | |
| Mainline | pipe work | | | 1760.0 | | |
| | | | | 1760.0 | 7120.0 | TOTALS |

STORMWATER DRAINAGE BASIN AND STORAGE

Refer to EC Standards and 570s Details.

Summary of Stormwater Storage

| Basin No. | Drainage Basin Location | | | Discharge Point | Total Disturbed Area | Disturbed Area with Storage Provided | Disturbed Area without Storage Provided | Best Management Practice | Total Storage Volume Provided | Total Storage Volume Required | Storage Volume Met? | Remarks | | | | | | |
|-----------|-------------------------|-----------|------|-----------------|----------------------|--------------------------------------|---|---|-------------------------------|-------------------------------|---------------------|---------|-------|-------|-------|----|----|--------|
| | Station to Station | Side | Side | | | | | | | | | | Acres | Acres | Acres | CF | CF | Yes/No |
| | | | | | | | | | | | | | | | | | | |
| 1 | 15+50.00 | 119+13.00 | Both | | 0.3 | 0.3 | 0.0 | Silt Fence for Ditch Check (EC-201) Vegetated Buffer | 2931.2 | 1080.0 | Yes | | | | | | | |
| 1 | 15+50.00 | 119+13.00 | Both | | | | | | | | | | | | | | | |
| 1 | 119+13.00 | 506+21.00 | RT | | | | | Silt Fence for Ditch Check (EC-201) Vegetated Buffer | 23710.5 | | | | | | | | | |
| 1 | 119+13.00 | 506+31.00 | RT | | | | | | | | | | | | | | | |
| 2 | 119+13.00 | 260+64.00 | LT | | 0.3 | 0.3 | 0.0 | Silt Fence for Ditch Check (EC-201) Vegetated Buffer | 25599.6 | 1080.0 | Yes | | | | | | | |
| 2 | 119+13.00 | 260+64.00 | LT | | | | | | | | | | | | | | | |
| 3 | 260+64.00 | 506+21.00 | LT | | 0.2 | 0.2 | 0.0 | Silt Fence for Ditch Check (EC-201) Vegetated Buffer | 22733.5 | 720.0 | Yes | | | | | | | |
| 3 | 260+64.00 | 506+21.00 | LT | | | | | | | | | | | | | | | |
| 4 | 506+21.00 | 802+25.00 | Both | | 0.8 | 0.8 | 0.0 | Silt Fence for Ditch Check (EC-201) Vegetated Buffer | 18890.3 | 2880.0 | Yes | | | | | | | |
| 4 | 506+21.00 | 802+25.00 | Both | | | | | | | | | | | | | | | |
| | | | | | 1.6 | 1.6 | 0.0 | | 93865.1 | 5760.0 | | TOTALS | | | | | | |

TOPSOIL STRIPPING AND PLACEMENT

| Road Identification | Location | | | Anticipated Quantity | Topsoil Placement Thickness | Remarks | | |
|---------------------|-----------------|---------------|-------------|----------------------|-----------------------------|-----------------------|----|----|
| | Dir. of Traffic | Begin Station | End Station | | | | CY | IN |
| | | | | | | | | |
| IA 9 | | Various | | 488.0 | 4.0 | Ditch reshaping | | |
| | | Various | | 86.0 | 4.0 | Pipe work | | |
| | | Various | | 26.0 | 4.0 | Revetment | | |
| | | Various | | 3.0 | 4.0 | Clearing and grubbing | | |
| | | | | 603.0 | | TOTAL | | |

EMERALD ASH BORER

Any living, dead, cut or fallen material of the ash (Fraxinus spp.) including trees, nursery stock, logs, firewood, stumps, roots, branches, and composted or uncomposted ash chips can be freely moved within the yellow areas of the most recent Federal EAB Quarantine & Authorized Transit.

https://www.aphis.usda.gov/plant_health/plant_pest_info/emerald_ash_b/downloads/eab_quarantine_map.pdf.


Obtain appropriate Compliance Agreements from USDA APHIS PPQ prior to moving any of the above listed ash articles to areas outside the yellow zone on the map.

For questions, concerns, and general assistance, contact:
USDA APHIS PPQ, Iowa office, 515-414-3295

Or
Iowa Department of Agriculture & Land Stewardship
515-725-1470
Entomology@IowaAgriculture.gov

SILT FENCES FOR DITCH CHECKS

Possible Standard: EC-201 Possible Detail: 570-4

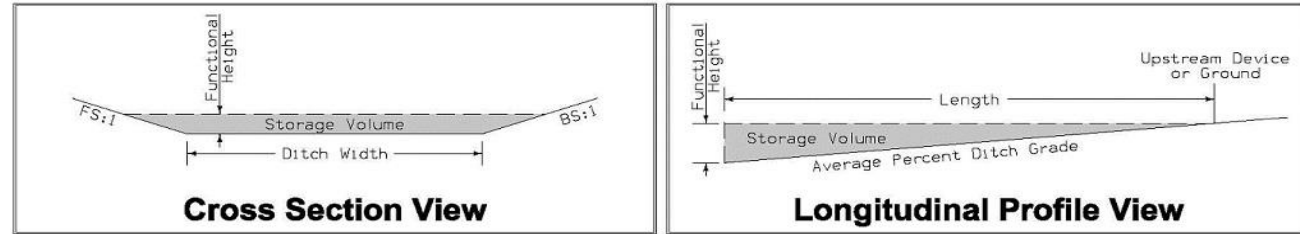

* The functional height used in the volume equation is 85% of effective height. Effective height is 1.58 feet as shown on EC-201.
* Volume equation: $[0.5 * Spacing * (0.5 * H^2 * FS + DW * H + 0.5 * H^2 * BS)]$

| Basin No. | Type | Location | | Bid Items | | | Stormwater Storage Volume Summary | | | | | | Remarks |
|-----------|------|--------------|------|-----------------|----------------|------------|-----------------------------------|----------------|----------------|--------------------------|------------|---------|---------|
| | | Station | Side | Installation LF | Maintenance LF | Removal LF | Foreslope FS:1 | Backslope BS:1 | Ditch Width FT | Avg. % Slope Ditch Grade | Volume* CF | | |
| | | | | | | | | | | | | Volume* | |
| 1 | 1 | 50+15.00 | RT | 30.0 | 3.0 | 30.0 | 4.0 | 10.0 | 10.0 | 4.4% | 456.0 | | |
| 1 | 1 | 74+85.00 | RT | 30.0 | 3.0 | 30.0 | 4.0 | 10.0 | 10.0 | 3.6% | 521.1 | | |
| 1 | 1 | 74+85.00 | LT | 30.0 | 3.0 | 30.0 | 4.0 | 10.0 | 10.0 | 3.6% | 521.1 | | |
| 1 | 1 | 76+63.00 | LT | 30.0 | 3.0 | 30.0 | 4.0 | 10.0 | 10.0 | 2.3% | 781.7 | | |
| 1 | 1 | 88+50.00 | RT | 30.0 | 3.0 | 30.0 | 4.0 | 10.0 | 10.0 | 5.9% | 325.7 | | |
| 1 | 1 | 88+50.00 | LT | 30.0 | 3.0 | 30.0 | 4.0 | 10.0 | 10.0 | 5.9% | 325.7 | | |
| 2 | 1 | 147+60.00 | LT | 30.0 | 3.0 | 30.0 | 4.0 | 10.0 | 10.0 | 0.5% | 4103.7 | | |
| 1 | 1 | 153+00.00 | RT | 30.0 | 3.0 | 30.0 | 4.0 | 10.0 | 10.0 | 0.5% | 4103.7 | | |
| 2 | 1 | 157+27.00 | LT | 30.0 | 3.0 | 30.0 | 4.0 | 10.0 | 10.0 | 0.5% | 4103.7 | | |
| 2 | 1 | 168+29.00 | LT | 30.0 | 3.0 | 30.0 | 4.0 | 10.0 | 10.0 | 0.3% | 4103.7 | | |
| 2 | 1 | 179+70.00 | LT | 30.0 | 3.0 | 30.0 | 4.0 | 10.0 | 10.0 | 4.0% | 521.1 | | |
| 2 | 1 | 188+00.00 | LT | 30.0 | 3.0 | 30.0 | 4.0 | 10.0 | 10.0 | 4.0% | 521.1 | | |
| 2 | 1 | 196+17.00 | LT | 30.0 | 3.0 | 30.0 | 4.0 | 10.0 | 10.0 | 1.0% | 2019.3 | | |
| 2 | 1 | 208+48.00 | LT | 30.0 | 3.0 | 30.0 | 4.0 | 10.0 | 10.0 | 1.0% | 2019.3 | | |
| 1 | 1 | 208+61.00 | RT | 30.0 | 3.0 | 30.0 | 4.0 | 10.0 | 10.0 | 1.0% | 2019.3 | | |
| 2 | 1 | 238+42.00 | LT | 30.0 | 3.0 | 30.0 | 4.0 | 10.0 | 10.0 | 0.6% | 4103.7 | | |
| 2 | 1 | 239+15.00 | LT | 30.0 | 3.0 | 30.0 | 4.0 | 10.0 | 10.0 | 0.6% | 4103.7 | | |
| 1 | 1 | 241+80.00 | RT | 30.0 | 3.0 | 30.0 | 4.0 | 10.0 | 10.0 | 0.1% | 4103.7 | | |
| 3 | 1 | 265+00.00 | LT | 30.0 | 3.0 | 30.0 | 4.0 | 10.0 | 10.0 | 0.3% | 4103.7 | | |
| 1 | 1 | 265+20.00 | RT | 30.0 | 3.0 | 30.0 | 4.0 | 10.0 | 10.0 | 0.3% | 4103.7 | | |
| 3 | 1 | 281+95.00 | LT | 30.0 | 3.0 | 30.0 | 4.0 | 10.0 | 10.0 | 0.8% | 2019.3 | | |
| 1 | 1 | 285+30.00 | RT | 30.0 | 3.0 | 30.0 | 4.0 | 10.0 | 10.0 | 0.8% | 2019.3 | | |
| 3 | 1 | 285+55.00 | LT | 30.0 | 3.0 | 30.0 | 4.0 | 10.0 | 10.0 | 1.0% | 2019.3 | | |
| 1 | 1 | 300+00.00 | RT | 30.0 | 3.0 | 30.0 | 4.0 | 10.0 | 10.0 | 1.1% | 1302.8 | | |
| 3 | 1 | 302+00.00 | LT | 30.0 | 3.0 | 30.0 | 4.0 | 10.0 | 10.0 | 1.1% | 1302.8 | | |
| 1 | 1 | 316+16.00 | RT | 30.0 | 3.0 | 30.0 | 4.0 | 10.0 | 10.0 | 0.8% | 2019.3 | | |
| 1 | 1 | 319+55.00 | RT | 30.0 | 3.0 | 30.0 | 4.0 | 10.0 | 10.0 | 1.0% | 2019.3 | | |
| 3 | 1 | 345+50.00 | LT | 30.0 | 3.0 | 30.0 | 4.0 | 10.0 | 10.0 | 0.3% | 4103.7 | | |
| 1 | 1 | 379+41.00 | RT | 30.0 | 3.0 | 30.0 | 4.0 | 10.0 | 10.0 | 0.1% | 4103.7 | | |
| 3 | 1 | 400+46.00 | LT | 30.0 | 3.0 | 30.0 | 4.0 | 10.0 | 10.0 | 0.4% | 4103.7 | | |
| 3 | 1 | 405+00.00 | LT | 30.0 | 3.0 | 30.0 | 4.0 | 10.0 | 10.0 | 0.4% | 4103.7 | | |
| 3 | 1 | 465+84.00 | LT | 30.0 | 3.0 | 30.0 | 4.0 | 10.0 | 10.0 | 1.8% | 977.1 | | |
| 1 | 1 | 485+82.00 | RT | 30.0 | 3.0 | 30.0 | 4.0 | 10.0 | 10.0 | 1.0% | 2019.3 | | |
| 4 | 1 | 508+96.00 | RT | 30.0 | 3.0 | 30.0 | 4.0 | 10.0 | 10.0 | 1.0% | 2019.3 | | |
| 4 | 1 | 560+55.00 | LT | 30.0 | 3.0 | 30.0 | 4.0 | 10.0 | 10.0 | 1.0% | 2019.3 | | |
| 4 | 1 | 622+40.00 | LT | 30.0 | 3.0 | 30.0 | 4.0 | 10.0 | 10.0 | 1.0% | 2019.3 | | |
| 4 | 1 | 632+50.00 | LT | 30.0 | 3.0 | 30.0 | 4.0 | 10.0 | 10.0 | 1.0% | 2019.3 | | |
| 4 | 1 | 649+60.00 | BOTH | 60.0 | 6.0 | 60.0 | 4.0 | 10.0 | 10.0 | 1.1% | 1302.8 | | |
| 4 | 1 | 670+25.00 | RT | 30.0 | 3.0 | 30.0 | 4.0 | 10.0 | 10.0 | 1.1% | 1302.8 | | |
| 4 | 1 | 710+75.00 | RT | 30.0 | 3.0 | 30.0 | 4.0 | 10.0 | 10.0 | 1.6% | 1302.8 | | |
| 4 | 1 | 734+35.00 | RT | 30.0 | 3.0 | 30.0 | 4.0 | 10.0 | 10.0 | 0.3% | 4103.7 | | |
| 4 | 1 | 735+36.00 | LT | 30.0 | 3.0 | 30.0 | 4.0 | 10.0 | 10.0 | 0.3% | 4103.7 | | |
| 4 | 1 | 755+69.00 | LT | 30.0 | 3.0 | 30.0 | 4.0 | 10.0 | 10.0 | 2.5% | 781.7 | | |
| 4 | 1 | 772+00.00 | LT | 30.0 | 3.0 | 30.0 | 4.0 | 10.0 | 10.0 | 1.0% | 2019.3 | | |
| 4 | 1 | 785+03.00 | BOTH | 30.0 | 3.0 | 30.0 | 4.0 | 10.0 | 10.0 | 1.0% | 2019.3 | | |
| 4 | 1 | 788+17.00 | BOTH | 60.0 | 6.0 | 60.0 | 4.0 | 10.0 | 10.0 | 1.0% | 2019.3 | | |
| a | 1 | Culvert work | | 1200.0 | 120.0 | 1200.0 | 4.0 | 10.0 | 10.0 | 1.0% | 2019.3 | | |
| | | | | 2640.0 | 264.0 | 2640.0 | | | | | 108130.5 | TOTALS | |

DITCH RESHAPING

| Side | Location | | Remarks |
|--------------------------|-----------|--------------|----------------------|
| | Station | Length (STA) | |
| Mainline Pipes | | | |
| Both | 50+15 | 1.5 | total for both sides |
| RT | 153+00 | 0.5 | |
| RT | 508+96 | 0.5 | |
| LT | 560+55 | 0.5 | |
| LT | 622+40 | 1.0 | |
| RT | 640+20 | 0.5 | |
| Both | 649+60 | 2.0 | total for both sides |
| RT | 670+25 | 0.5 | |
| RT | 686+00 | 1.0 | |
| RT | 710+75 | 0.5 | |
| RT | 734+35 | 0.5 | |
| RT | 765+70 | 0.5 | |
| Both | 785+03 | 1.0 | total for both sides |
| Both | 788+17 | 2.0 | total for both sides |
| Sideroads/Entrance Pipes | | | |
| Both | 74+85 RT | 1.0 | total for both sides |
| Both | 74+85 LT | 1.0 | total for both sides |
| Out | 76+63 LT | 0.5 | |
| Out | 88+50 RT | 0.5 | |
| Out | 88+50 LT | 0.5 | |
| Out | 147+60 LT | 0.5 | |
| Both | 157+27 LT | 1.0 | total for both sides |
| Out | 168+29 LT | 0.5 | |
| Both | 179+70 LT | 1.0 | total for both sides |
| Both | 188+00 LT | 1.0 | total for both sides |
| Both | 196+17 LT | 1.0 | total for both sides |
| In | 208+48 LT | 0.5 | |
| In | 208+61 RT | 0.5 | |
| Both | 238+42 LT | 1.0 | total for both sides |
| Both | 239+15 LT | 1.0 | total for both sides |
| In | 241+80 RT | 0.5 | |
| Both | 265+00 LT | 1.0 | total for both sides |
| Both | 265+20 RT | 1.0 | total for both sides |
| Both | 281+95 LT | 1.0 | total for both sides |
| Both | 285+30 RT | 1.0 | total for both sides |
| In | 285+55 LT | 0.5 | |
| Both | 300+00 RT | 1.0 | total for both sides |
| Out | 316+16 RT | 0.5 | |
| Both | 319+55 RT | 1.0 | total for both sides |
| Both | 345+81 LT | 1.0 | total for both sides |
| Both | 379+41 RT | 1.0 | total for both sides |
| Both | 400+46 LT | 1.0 | total for both sides |
| Both | 405+00 LT | 1.0 | total for both sides |
| Both | 465+84 LT | 1.0 | total for both sides |
| Both | 485+82 RT | 1.0 | total for both sides |
| Out | 632+50 LT | 0.5 | |
| Out | 735+36 LT | 0.5 | |
| In | 755+69 LT | 0.5 | |
| Out | 772+00 LT | 0.5 | |
| | | 39.5 | TOTAL |

REMOVAL OF FILLETS

* Not a Bid Item

| Location Station | Side | Area SY | Saw Cut* LF | Remarks |
|------------------|------|---------|-------------|--|
| Various | B | 840.0 | | Area beyond Class 13, existing fillets at 42 locations |
| Various | B | 373.3 | | Area beyond Class 13, existing fillets at 14 unpaved sideroads |
| | | 1213.3 | | TOTAL |

NOTCHES AND RUNOUTS FOR RESURFACING

Refer to PR-201 and PR-202.

① Bid item. Applies only to Types 'N1' and 'N3' on PR-202. Refer to 100-25 for remaining values.

| Location Station | Type of Notch or Runout | S | I | DI | L | M | Pavement Scarification SY | Remarks |
|--------------------|-------------------------|-----|-----|----|------|-----|---------------------------|----------------|
| | | IN | IN | IN | FT | IN | | |
| 15+50.00 | Type 'N3' | 2.0 | 1.0 | | 75.0 | 3.0 | | See Tab 100-25 |
| 802+25.00 | Type 'N3' | 2.0 | 1.0 | | 75.0 | 3.0 | | See Tab 100-25 |
| 33 Paved entrances | Type 'R2' | 2.0 | 1.0 | | 30.0 | | | |
| 6 Paved Side roads | Type 'R2' | 2.0 | 1.0 | | 30.0 | | | |

EXISTING PAVEMENT

| No. | Location | | | | | Year | Type | Project Number | Surface | | Base | | Subbase | | Removal | | Coarse Aggregate | | | Reinforcement | Remarks |
|-----|----------|-------|----------------|----------------------|--------------------|------------------------------|------|--|--------------------------|------------------|------|-------|---------|-------|---------|-------|------------------|---|--------------------------------------|---------------|---------|
| | County | Route | Dir. of Travel | Begin Ref. Loc. Sign | End Ref. Loc. Sign | | | | Type | Depth | Type | Depth | Type | Depth | Type | Depth | Source | Type | Durability Class | | |
| | | | | | | | | | | | | | | | | | | | | | |
| | 3 | 9 | Both | 279.56 | 282.25 | 1992 1980 | | FN-9-9(36)--21-03 F-9-9(17)--20-03 | AAC BAC | 2 3 | | | | | | | | McCabe Qry Churchtown | C.LST. C.LST. | | |
| | | | | 282.25 | 284.51 | 1992 1980 1964 1931 | | FN-9-9(36)--21-03 F-9-9(17)--20-03 FN-161*<1> P-677ABC | AAC BAC AAC PC7 | 2 3 3 7 | | | ATB | 3.5 | | | | McCabe Qry Churchtown Johnson Rose Spur- Dub | C.LST. C.LST. C.LST. C.LST. | | |
| | | | | 284.51 | 287.91 | 1992 1980 | | FN-9-9(36)--21-03 F-9-9(17)--20-03 | AAC BAC | 2 3 | | | ATB | 7 | | | | McCabe Qry Churchtown | C.LST. C.LST. | | |
| | | | | 287.91 | 290.13 | 1992 1980 1964 1931 | | FN-9-9(36)--21-03 F-9-9(18)--20-03 FN-161*<1> P-677ABC | AAC BAC AAC PC7 | 2 3 2 7 | | | | | | | | McCabe Qry Churchtown Johnson Rose Spur-Dub | C.LST. C.LST. C.LST. C.LST. | | |
| | | | | 290.13 | 293.25 | 1992 1980 | | FN-9-9(36)--21-03 FN-9-9(18)--20-03 | AAC BAC | 2 3 | | | | 3.5 | | | | McCable Qry Churchtown | C.LST. C.LST. | | |
| | | | | 293.25 | 294.46 | 1992 1980 1964 1931 | | FN-9-9(36)--21-03 FN-9-9(18)--20-03 FN-161*<1> P-677ABC | AAC RAC AAC PC7 | 2 3 2 7 | | | | | | | | McCabe Qry Churchtown Johnson Rose Spur-Dub | C.LST. C.LST. C.LST. C.LST. | | |

CULVERT ABANDONMENT

Refer to Details 4315 and 4316

* Not a bid item

| Location Station | Description | Fill Material | | 4" Perforated Subdrain* | Remarks |
|------------------|-----------------------------|-----------------|--------------------|-------------------------|---------|
| | | Flowable Mortar | Granular Backfill* | | |
| | | CY | TON | LF | |
| 517+50.0 LT | Existing 15" intake outfall | 5.7 | 0.5 | 6.0 | |

REMOVAL OF CABLE GUARDRAIL

* Not a bid item
① Lane(s) to which the installation is adjacent

| No. | Direction of Traffic | Location | | Type (High/Low Tension) | Cable | Post * Footings, Concrete | End Terminal* | Remarks |
|-----|----------------------|--------------------|-----------|-------------------------|-------------|---------------------------|---------------|---------|
| | | Station to Station | Side | | | | | |
| | | | | | Remove | Remove | Remove | |
| | | | | | LF | Yes/No | No. | |
| EB | | 60+70.00 | 68+65.00 | RT | Low Tension | 795.0 | Yes | 2 |
| EB | | 77+00.00 | 84+57.00 | RT | Low Tension | 757.0 | Yes | 2 |
| EB | | 322+35.00 | 333+60.00 | RT | Low Tension | 1125.0 | Yes | 2 |
| EB | | 527+50.00 | 536+62.50 | RT | Low Tension | 912.5 | Yes | 2 |
| EB | | 743+75.00 | 753+57.50 | RT | Low Tension | 982.5 | Yes | 2 |
| EB | | 62+70.00 | 71+81.00 | LT | Low Tension | 911.0 | Yes | 2 |
| EB | | 91+50.00 | 99+40.00 | LT | Low Tension | 790.0 | Yes | 2 |
| EB | | 410+00.00 | 418+47.00 | LT | Low Tension | 847.0 | Yes | 2 |
| | | | | | | 7120.0 | | |
| | | | | | | | | TOTAL |

CURBS AND RAISED ISLANDS

Refer to PV-20, PV-102, and 600s Detail Series.

① Bid Item

| Point No. | Station | Offset | Island Interior Area ① SY | Curb and Gutter | | | Remarks |
|-----------|-----------|--------|---------------------------|-----------------|-----------------|-------------|----------|
| | | | | Curb Type | Gutter Width FT | Length ① LF | |
| | 517+40.00 | RT | | 6" Standard PCC | 2.0 | 55.0 | New curb |
| | | | | | | 55.0 | TOTAL |

REMOVAL OF PAVEMENT

Refer to Tabulation 102-5

* Not a Bid Item

| Begin Station | End Station | Side | Pavement Type | Area | Saw Cut* | Remarks |
|---------------|-------------|------|---------------|--------|----------|-------------------------|
| | | | | SY | LF | |
| 16+50.00 | 21+50.00 | RT | HMA | 555.6 | | Existing paved shoulder |
| 520+00.00 | 532+70.00 | RT | HMA | 1411.1 | | Existing paved shoulder |
| 547+30.00 | 554+00.00 | RT | HMA | 744.4 | | Existing paved shoulder |
| 555+00.00 | 560+00.00 | LT | HMA | 333.3 | | Existing paved shoulder |
| | | | | 3044.4 | | TOTAL |

REMOVAL OF EXISTING STRUCTURES

| Location | Description | Remarks |
|--------------------------------------|---------------------------------|---|
| 23+10.0 RT | 4 existing 48" RCP sections | Replace with 4 new 48" RCP |
| 79+05.0 RT | Existing flume on mainline pipe | Replace with rock flume |
| 94+90.0 LT | 42' of existing pipe | Replace with new pipe |
| 94+90.0 LT | Existing flume on mainline pipe | Replace with rock flume |
| 135+25.0 RT | Existing flume on mainline pipe | Replace with rock flume |
| 314+40.0 RT | Existing flume on mainline pipe | Replace with rock flume |
| 517+50.0 RT | Existing flume on mainline pipe | Replace with rock flume |
| 531+97.0 RT | Existing flume on mainline pipe | Replace with rock flume |
| 765+70.0 LT | Existing flume on mainline pipe | Replace with rock flume |
| Numerous sideroad and entrance pipes | All 18" or 24" CMP | Cut up to 4', but majority 1', to install aprons and re-establish drainage flow |
| 785+00.0 LT | Entrance 15" CMP | Replace with 18" CMP |

CLEARING AND GRUBBING

| Location | | Work and Material Type | Trees, Stumps, and Logs and Down Timber Material Diameters | | | | | | | | | | | | | All Other Materials | | Estimated Quantities | | | Remarks |
|---|---------------------|-------------------------------|--|--------|---------|----------|----------|----------|----------|----------|----------|----------|----------|----------|------|---------------------|-------|----------------------|------|-----------------------|---------|
| Station to Station or Ref. Loc. Sign to Ref. Loc. Sign or Description | Direction of Travel | | 3"-6" | >6"-9" | >9"-12" | >12"-15" | >15"-18" | >18"-24" | >24"-30" | >30"-36" | >36"-42" | >42"-48" | >48"-60" | >60"-72" | >72" | Length | Width | Units | Area | Herbicide Application | |
| | | | FT | FT | Units | Acres | Each | FT | FT | Units | Acres | Each | | | | | | | | | |
| MAINLINE PIPES | | Trees - Clearing and Grubbing | 2 | 3 | | | | | | | | | | | | | | 14.9 | | | |
| 23+10.5 LT | | Trees - Clearing and Grubbing | 3 | | | | | | | | | | | | | | | 4.8 | | | |
| 29+90.0 LT | | Trees - Clearing and Grubbing | 1 | | | 1 | | | | | | | | | | | | 11.0 | | | |
| 68+25.0 Both | | Trees - Clearing and Grubbing | | 3 | | | | 1 | 1 | 1 | | | | | | | | 112.7 | | | |
| 79+05.0 RT | | Trees - Clearing and Grubbing | | 1 | | 1 | | | | | | | | | | | | 13.3 | | | |
| 94+90.0 Both | | Trees - Clearing and Grubbing | | | 1 | | | | | | | | | | | | | 6.7 | | | |
| 111+25.0 RT | | Trees - Clearing and Grubbing | | | | 1 | | | | | | | | | | | | 6.7 | | | |
| 121+50.0 LT | | Trees - Clearing and Grubbing | | | | 1 | | | | | | | | | | | | 18.4 | | | |
| 135+25.0 LT | | Trees - Clearing and Grubbing | | 3 | | 1 | | | | | | | | | | | | 0.4 | | | |
| 249+50.0 LT | | Brush - Clearing | | | | | | | | | | | | | 10.0 | 5.0 | | | | | |
| 281+85.0 LT | | Trees - Clearing and Grubbing | | | | 1 | | | | | | | | | | | | 6.7 | | | |
| 326+85.0 RT | | Trees - Clearing and Grubbing | | | | 1 | | | | | | | | | | | | 6.7 | | | |
| 346+50.0 RT | | Trees - Clearing and Grubbing | | 3 | | | | | | | | | | | | | | 11.7 | | | |
| 382+85.0 LT | | Trees - Clearing and Grubbing | | 1 | | | | | | | | | | | | | | 3.9 | | | |
| 520+90.0 RT | | Trees - Clearing and Grubbing | | | | | | 1 | | | | | | | | | | 13.5 | | | |
| 531+97.0 RT | | Brush - Clearing | | | | | | | | | | | | | 20.0 | 10.0 | | 1.6 | | | |
| 555+30.0 Both | | Trees - Clearing and Grubbing | | | | 11 | | | 2 | | | | | | | | | 161.4 | | | |
| 568+51.0 LT | | Trees - Clearing and Grubbing | | 3 | | | | | | | | | | | | | | 11.7 | | | |
| 572+68.0 LT | | Trees - Clearing and Grubbing | | 7 | | | | | | | | | | | | | | 27.3 | | | |
| 579+60.0 LT | | Trees - Clearing and Grubbing | | 3 | | | | | | | | | | | | | | 11.7 | | | |
| 584+12.0 Both | | Trees - Clearing and Grubbing | 12 | | 5 | 1 | | | 1 | | | | | | | | | 91.1 | | | |
| 594+75.0 Both | | Trees - Clearing and Grubbing | 6 | | 1 | | | 1 | | | | | | | | | | 29.8 | | | |
| 616+60.0 RT | | Trees - Clearing and Grubbing | 1 | | | | | 1 | 1 | | | | | | | | | 52.6 | | | |
| 675+75.0 RT | | Trees - Clearing and Grubbing | 2 | | | | | | | | | | | | 20.0 | 2.0 | | 3.5 | | | |
| 754+99.0 RT | | Trees - Clearing and Grubbing | | | | 2 | | | 1 | 1 | | | | | | | | 97.8 | | | |
| 765+70.0 RT | | Trees - Clearing and Grubbing | | 5 | | | | | | | | | | | | | | 19.5 | | | |
| 771+38.0 RT | | Trees - Clearing and Grubbing | | | | 5 | | | | | | | | | | | | 47.0 | | | |
| 788+17.0 LT | | Trees - Clearing and Grubbing | 2 | | | | | 1 | | | | | | | 40.0 | 20.0 | | 31.6 | | | |
| SIDEROAD/ENTRANCE PIPES | | Brush - Clearing | | | | | | | | | | | | | 20.0 | 10.0 | | 1.6 | | | |
| 21+81.0 RT | | Trees - Clearing and Grubbing | | | | 1 | | | 2 | | | | | | | | | 67.4 | | | |
| 110+00.0 RT | | Trees - Clearing and Grubbing | 3 | | | | | | | | | | | | | | | 4.8 | | | |
| 198+21.0 RT | | Trees - Clearing and Grubbing | 1 | | | | | | | | | | | | | | | 1.6 | | | |
| 474+62.0 RT | | Trees - Clearing and Grubbing | 3 | | | | | | | | | | | | | | | 4.8 | | | |
| 526+95.0 LT | | Trees - Clearing and Grubbing | 2 | | | | | | 1 | | | | | | | | | 32.2 | | | |
| 735+36.0 LT | | Trees - Clearing and Grubbing | 2 | | | | | | | | | | | | | | | 3.2 | | | |
| 787+00.0 RT | | Trees - Clearing and Grubbing | 2 | | | | | | | | | | | | | | | | | | |
| | | | | | | | | | | | | | | | | | | 933.6 | | | TOTAL |

ROCK EROSION CONTROL

Refer to EC-301 and Detail 570-8

| Location | | Side | Rock Erosion Control (REC) | | | | | Material Bid Quantities | | | Remarks | | | |
|---------------------|---------------|------|----------------------------|---------|----|--------|------------------|-------------------------|------------|-------------------|---------|-----------------------|----------------------------------|---------------|
| Road Identification | Begin Station | | End Station | L | W | Type 1 | Type 2 | Type 3 | Type 4 | Type 5 | | Eng. Fabric | Class E Revetment | Erosion Stone |
| | | | | Lt./Rt. | FT | FT | Rock Ditch Check | Rock Ditch | Rock Flume | Rock Splash Basin | | Rock Slope Protection | SY | TON |
| IA 9 | 79+05.00 | RT | 6 | 40 | | | | 1 | | | 40.0 | 34.0 | | |
| | 94+90.00 | LT | 6 | 60 | | | | 1 | | | 57.0 | 50.5 | | |
| | 135+25.00 | LT | 6 | 20 | | | | 1 | | | 22.0 | 17.0 | | |
| | 314+40.00 | LT | 8 | 10 | | | | | 1 | | 16.0 | 10.5 | | |
| | 508+96.00 | LT | 8.5 | 10 | | | | 1 | | | 17.0 | 11.0 | | |
| | 517+50.00 | RT | 7.5 | 40 | | | | 1 | | | 47.0 | 40.0 | | |
| | 520+90.00 | RT | 8 | 10 | | | | 1 | | | 16.0 | 11.0 | | |
| | 531+97.00 | RT | 8.5 | 50 | | | | 1 | | | 63.0 | 56.0 | | |
| | 568+51.00 | RT | 20 | 30 | | | | 1 | | | 84.0 | | 80.0 | |
| | 572+68.00 | LT | 20 | 30 | | | | 1 | | | 112.0 | 70.0 | 5' deep | |
| | 584+12.00 | LT | 10 | 25 | | | | 1 | | | 39.0 | 32.0 | | |
| | 616+60.00 | RT | 5 | 10 | | | 1 | | | | 22.0 | 15.0 | Both sides apron | |
| | 634+25.00 | RT | 10 | 25 | | | | 1 | | | 52.0 | 32.0 | 4' deep | |
| | 754+99.00 | RT | 20 | 20 | | | | 1 | | | 59.0 | | 53.0 | |
| | 765+70.00 | LT | 4 | 40 | | | | 1 | | | 30.0 | | 29.0 | |
| | 787+00.00 | RT | 6 | 20 | | | | 1 | | | 22.0 | 17.0 | Inc shoulder flume Entrance pipe | |
| | | | | | | | | | | | 698.0 | 396.1 | 162.0 | TOTALS |

LONGITUDINAL SUBDRAIN SHOULDER AND BACKSLOPE

Refer to Soils Sheets

* Not a bid item. Bridge berm quantities assume a trench depth of 24 inches.

| Line No. | Road or Lane Identification | Location | | Side | Longitudinal Subdrain (DR-303) | | | | | | | Subdrain Outlet | | Porous* Backfill CY | Class "A"* Crushed Stone CY | Remarks |
|----------|-----------------------------|--------------------|------------|------|--------------------------------|--------------|------------|--------------|--------------------------------|------------|--------------|--------------------------|--------------------------------|------------------------|--------------------------------|-----------------|
| | | Station to Station | Depth D | | Shoulder | | Backslope | | Bridge Berm (EW-203 or EW-204) | | | DR-303, DR-305 or DR-306 | | | | |
| | | | | | Size IN | Length FT | Size IN | Length FT | Standard Road Plan and Type | Size IN | Length FT | Station | Standard Road Plan and Type | | | |
| | | | | | | | | | | | | | | | | |
| 1 | NBL | 16+50.00 | 20+50.00 | RT | 36.0 | 4.0 | 460.0 | | | | | | 16+50.00 | DR-306 | 35.5 | |
| 2 | NBL | 20+50.00 | 23+05.00 | RT | 36.0 | 4.0 | 315.0 | | | | | | 20+50.00 | DR-306 | 24.3 | |
| 3 | NBL | 23+15.00 | 26+45.00 | RT | 36.0 | 4.0 | 390.0 | | | | | | 23+15.00 | DR-306 | 30.1 | |
| 4 | NBL | 62+00.00 | 66+00.00 | LT | 24.0 | 4.0 | 460.0 | | | | | | 26+45.00 | DR-306 | 21.3 | |
| 5 | NBL | 66+00.00 | 71+35.00 | LT | 24.0 | 4.0 | 595.0 | | | | | | 62+00.00 | DR-306 | 27.5 | |
| 6 | NBL | 111+00.00 | 115+00.00 | LT | 36.0 | 4.0 | 460.0 | 24.0 | | | | | 66+00.00 | DR-306 | 35.5 | |
| 7 | NBL | 115+00.00 | 119+00.00 | LT | 36.0 | 4.0 | 460.0 | | | | | | 71+35.00 | DR-306 | 35.5 | |
| 8 | NBL | 119+00.00 | 123+00.00 | LT | 36.0 | 4.0 | 460.0 | | | | | | 111+00.00 | DR-306 | 35.5 | |
| 9 | NBL | 123+00.00 | 127+10.00 | LT | 36.0 | 4.0 | 470.0 | | | | | | 115+00.00 | DR-306 | 36.3 | |
| 10 | NBL | 127+20.00 | 131+00.00 | LT | 36.0 | 4.0 | 440.0 | | | | | | 119+00.00 | DR-306 | 34.0 | |
| 11 | NBL | 131+00.00 | 135+20.00 | LT | 36.0 | 4.0 | 480.0 | | | | | | 123+00.00 | DR-306 | 37.0 | |
| 12 | NBL | 144+00.00 | 148+00.00 | LT | 36.0 | 4.0 | 460.0 | | | | | | 127+10.00 | DR-306 | 35.5 | |
| 13 | NBL | 148+00.00 | 152+00.00 | LT | 36.0 | 4.0 | 460.0 | | | | | | 131+00.00 | DR-306 | 35.5 | |
| 14 | NBL | 152+00.00 | 156+00.00 | LT | 36.0 | 4.0 | 460.0 | | | | | | 135+20.00 | DR-306 | 35.5 | |
| 15 | NBL | 156+00.00 | 160+00.00 | LT | 36.0 | 4.0 | 460.0 | | | | | | 144+00.00 | DR-306 | 35.5 | |
| 16 | NBL | 160+00.00 | 164+00.00 | LT | 36.0 | 4.0 | 460.0 | | | | | | 148+00.00 | DR-306 | 35.5 | |
| 17 | NBL | 164+00.00 | 168+00.00 | LT | 36.0 | 4.0 | 460.0 | | | | | | 152+00.00 | DR-306 | 35.5 | |
| 18 | NBL | 168+00.00 | 171+90.99 | LT | 36.0 | 4.0 | 451.0 | | | | | | 156+00.00 | DR-306 | 34.8 | |
| 19 | NBL | 171+90.39 | 176+00.00 | LT | 36.0 | 4.0 | 469.6 | | | | | | 160+00.00 | DR-306 | 36.2 | |
| 20 | NBL | 176+00.00 | 180+00.00 | LT | 36.0 | 4.0 | 460.0 | | | | | | 164+00.00 | DR-306 | 35.5 | |
| 21 | NBL | 180+00.00 | 184+80.00 | RT | 36.0 | 4.0 | 540.0 | | | | | | 168+00.00 | DR-306 | 41.7 | |
| 22 | NBL | 184+90.00 | 188+00.00 | RT | 36.0 | 4.0 | 370.0 | | | | | | 171+90.99 | DR-306 | 28.5 | |
| 23 | NBL | 188+00.00 | 192+00.00 | RT | 36.0 | 4.0 | 460.0 | | | | | | 176+00.00 | DR-306 | 35.5 | |
| 24 | NBL | 192+00.00 | 196+00.00 | RT | 36.0 | 4.0 | 460.0 | | | | | | 180+00.00 | DR-306 | 35.5 | |
| 25 | NBL | 196+00.00 | 201+00.00 | RT | 36.0 | 4.0 | 560.0 | | | | | | 184+80.00 | DR-306 | 43.2 | |
| 26 | NBL | 210+00.00 | 214+26.00 | RT | 36.0 | 4.0 | 486.0 | | | | | | 188+00.00 | DR-306 | 37.5 | |
| 27 | NBL | 214+36.00 | 218+00.00 | LT | 36.0 | 4.0 | 424.0 | | | | | | 192+00.00 | DR-306 | 32.7 | |
| 28 | NBL | 218+00.00 | 222+00.00 | LT | 36.0 | 4.0 | 460.0 | | | | | | 196+00.00 | DR-306 | 35.5 | |
| 29 | NBL | 222+00.00 | 226+00.00 | LT | 36.0 | 4.0 | 460.0 | | | | | | 201+00.00 | DR-306 | 35.5 | |
| 30 | NBL | 226+00.00 | 230+00.00 | LT | 36.0 | 4.0 | 460.0 | | | | | | 210+00.00 | DR-306 | 35.5 | |
| 31 | NBL | 230+00.00 | 234+00.00 | LT | 36.0 | 4.0 | 460.0 | | | | | | 214+26.00 | DR-306 | 35.5 | |
| 32 | NBL | 234+00.00 | 238+00.00 | RT | 36.0 | 4.0 | 460.0 | | | | | | 218+00.00 | DR-306 | 35.5 | |
| 33 | NBL | 238+00.00 | 242+00.00 | LT | 36.0 | 4.0 | 460.0 | | | | | | 222+00.00 | DR-306 | 35.5 | |
| 34 | NBL | 242+00.00 | 246+00.00 | LT | 36.0 | 4.0 | 460.0 | | | | | | 226+00.00 | DR-306 | 35.5 | |
| 35 | NBL | 246+00.00 | 249+45.00 | LT | 36.0 | 4.0 | 405.0 | | | | | | 230+00.00 | DR-306 | 31.3 | |
| 36 | NBL | 249+55.00 | 254+00.00 | LT | 36.0 | 4.0 | 525.7 | | | | | | 234+00.00 | DR-306 | 40.6 | Includes STA EQ |
| 37 | NBL | 254+00.00 | 258+00.00 | RT | 36.0 | 4.0 | 460.0 | | | | | | 238+00.00 | DR-306 | 35.5 | |
| 38 | NBL | 258+00.00 | 262+00.00 | RT | 36.0 | 4.0 | 460.0 | | | | | | 242+00.00 | DR-306 | 35.5 | |
| 39 | NBL | 262+00.00 | 266+00.00 | RT | 36.0 | 4.0 | 460.0 | | | | | | 246+00.00 | DR-306 | 35.5 | |

LONGITUDINAL SUBDRAIN SHOULDER AND BACKSLOPE

Refer to Soils Sheets

* Not a bid item. Bridge berm quantities assume a trench depth of 24 inches.

| Line No. | Road or Lane Identification | Location | | Side | Longitudinal Subdrain (DR-303) | | | | | | | Subdrain Outlet | | Porous* Backfill CY | Class "A"* Crushed Stone CY | Remarks |
|----------|-----------------------------|--------------------|------------|------|--------------------------------|--------------|------------|--------------|--------------------------------|------------|--------------|--------------------------|--------------------------------|------------------------|-----------------------------------|-----------------|
| | | Station to Station | Depth D | | Shoulder | | Backslope | | Bridge Berm (EW-203 or EW-204) | | | DR-303, DR-305 or DR-306 | | | | |
| | | | | | Size IN | Length FT | Size IN | Length FT | Standard Road Plan and Type | Size IN | Length FT | Station | Standard Road Plan and Type | | | |
| | | | | | | | | | | | | | | | | |
| 40 | NBL | 266+00.00 | 270+00.00 | RT | 36.0 | 4.0 | 460.0 | | | | | | 266+00.00 | DR-306 | 35.5 | |
| 41 | NBL | 270+00.00 | 274+00.00 | RT | 36.0 | 4.0 | 460.0 | | | | | | 270+00.00 | DR-306 | 35.5 | |
| 42 | NBL | 274+00.00 | 278+00.00 | RT | 36.0 | 4.0 | 460.0 | | | | | | 274+00.00 | DR-306 | 35.5 | |
| 43 | NBL | 278+00.00 | 282+00.00 | LT | 36.0 | 4.0 | 460.0 | | | | | | 278+00.00 | DR-306 | 35.5 | |
| 44 | NBL | 282+00.00 | 286+00.00 | LT | 36.0 | 4.0 | 460.0 | | | | | | 282+00.00 | DR-306 | 35.5 | |
| 45 | NBL | 286+00.00 | 290+00.00 | LT | 36.0 | 4.0 | 460.0 | | | | | | 286+00.00 | DR-306 | 35.5 | |
| 46 | NBL | 290+00.00 | 294+00.00 | LT | 36.0 | 4.0 | 460.0 | | | | | | 290+00.00 | DR-306 | 35.5 | |
| 47 | NBL | 294+00.00 | 298+00.00 | LT | 36.0 | 4.0 | 460.0 | 24.0 | | | | | 294+00.00 | DR-306 | 35.5 | |
| 48 | NBL | 303+95.00 | 307+95.00 | LT | 36.0 | 4.0 | 460.0 | 24.0 | | | | | 303+95.00 | DR-306 | 35.5 | |
| 49 | NBL | 307+95.00 | 311+95.00 | LT | 36.0 | 4.0 | 459.1 | | | | | | 307+95.00 | DR-306 | 35.4 | Includes STA EQ |
| 50 | NBL | 311+95.00 | 314+35.00 | LT | 36.0 | 4.0 | 300.0 | 24.0 | | | | | 311+95.00 | DR-306 | 23.1 | |
| 51 | NBL | 319+75.00 | 323+75.00 | LT | 36.0 | 4.0 | 460.0 | 24.0 | | | | | 319+75.00 | DR-306 | 35.5 | |
| 52 | NBL | 323+75.00 | 326+80.00 | LT | 36.0 | 4.0 | 364.4 | | | | | | 323+75.00 | DR-306 | 28.1 | Includes STA EQ |
| 53 | NBL | 326+90.00 | 331+75.00 | LT | 36.0 | 4.0 | 545.0 | | | | | | 326+90.00 | DR-306 | 42.1 | |
| 54 | NBL | 331+75.00 | 335+00.00 | LT | 36.0 | 4.0 | 385.0 | | | | | | 331+75.00 | DR-306 | 29.7 | |
| 55 | NBL | 344+00.00 | 348+00.00 | RT | 36.0 | 4.0 | 460.0 | | | | | | 344+00.00 | DR-306 | 35.5 | |
| 56 | NBL | 348+00.00 | 352+00.00 | RT | 36.0 | 4.0 | 460.0 | | | | | | 348+00.00 | DR-306 | 35.5 | |
| 57 | NBL | 352+00.00 | 356+00.00 | RT | 36.0 | 4.0 | 460.0 | | | | | | 352+00.00 | DR-306 | 35.5 | |
| 58 | NBL | 356+00.00 | 360+00.00 | RT | 36.0 | 4.0 | 460.0 | | | | | | 356+00.00 | DR-306 | 35.5 | |
| 59 | NBL | 360+00.00 | 364+00.00 | RT | 36.0 | 4.0 | 460.0 | | | | | | 360+00.00 | DR-306 | 35.5 | |
| 60 | NBL | 364+00.00 | 368+00.00 | RT | 36.0 | 4.0 | 460.0 | | | | | | 364+00.00 | DR-306 | 35.5 | |
| 61 | NBL | 368+00.00 | 372+00.00 | LT | 36.0 | 4.0 | 451.7 | | | | | | 368+00.00 | DR-306 | 34.9 | Includes STA EQ |
| 62 | NBL | 372+00.00 | 376+00.00 | LT | 36.0 | 4.0 | 460.0 | | | | | | 372+00.00 | DR-306 | 35.5 | |
| 63 | NBL | 376+00.00 | 380+00.00 | LT | 36.0 | 4.0 | 460.0 | | | | | | 376+00.00 | DR-306 | 35.5 | |
| 64 | NBL | 380+00.00 | 384+00.00 | LT | 36.0 | 4.0 | 460.0 | | | | | | 380+00.00 | DR-306 | 35.5 | |
| 65 | NBL | 384+00.00 | 388+00.00 | LT | 36.0 | 4.0 | 460.0 | | | | | | 384+00.00 | DR-306 | 35.5 | |
| 66 | NBL | 388+00.00 | 393+50.00 | LT | 36.0 | 4.0 | 610.0 | 24.0 | | | | | 388+00.00 | DR-306 | 47.1 | |
| 67 | NBL | 756+50.00 | 760+50.00 | LT | 36.0 | 4.0 | 460.0 | 24.0 | | | | | 756+50.00 | DR-306 | 35.5 | |
| 68 | NBL | 760+50.00 | 764+50.00 | LT | 36.0 | 4.0 | 460.0 | | | | | | 760+50.00 | DR-306 | 35.5 | |
| 69 | NBL | 764+50.00 | 768+50.00 | LT | 36.0 | 4.0 | 460.0 | | | | | | 764+50.00 | DR-306 | 35.5 | |
| 70 | NBL | 768+50.00 | 771+00.00 | LT | 36.0 | 4.0 | 310.0 | | | | | | 768+50.00 | DR-306 | 23.9 | |
| 71 | NBL | 771+00.00 | 775+00.00 | LT | 36.0 | 4.0 | 460.0 | | | | | | 771+00.00 | DR-306 | 35.5 | |
| 72 | NBL | 775+00.00 | 779+00.00 | LT | 36.0 | 4.0 | 460.0 | | | | | | 775+00.00 | DR-306 | 35.5 | |
| 73 | NBL | 779+00.00 | 783+00.00 | LT | 36.0 | 4.0 | 460.0 | | | | | | 779+00.00 | DR-306 | 35.5 | |
| 74 | NBL | 783+00.00 | 787+00.00 | LT | 36.0 | 4.0 | 460.0 | | | | | | 783+00.00 | DR-306 | 35.5 | |
| 75 | NBL | 787+00.00 | 791+00.00 | LT | 36.0 | 4.0 | 460.0 | | | | | | 787+00.00 | DR-306 | 35.5 | |
| 76 | NBL | 791+00.00 | 795+00.00 | LT | 36.0 | 4.0 | 460.0 | | | | | | 791+00.00 | DR-306 | 35.5 | |
| 77 | NBL | 795+00.00 | 799+00.00 | LT | 36.0 | 4.0 | 460.0 | | | | | | 795+00.00 | DR-306 | 35.5 | |

FORESLOPE FLATTENING AND DRAINAGE STRUCTURES BY ROAD CONTRACTOR (MAINLINE PIPES)

Refer to Standard Road Plans DR-121, DR-122, and DR-213.

* Not a bid item

| Existing Information | | New Information | | Length of New Const. | Flow Line Elevations | | Dimensions | | | | Removal and Reinstallation of Culvert Aprons and Pipes | | | | New Apron No. | | Apron Guard* (DR-213) | Type 'C' Connections* (DR-122) | | Connected Pipe Joint* (DR-121) | Embank.- In-Place | Class 20 | Remarks | | | | | |
|----------------------|-----------------------------|-----------------|-----------------|----------------------|----------------------|-------|------------|-------|-----------------|-------|--|-------|------------------|----|---------------|-----|-----------------------|--------------------------------|------|--------------------------------|-------------------|----------|---------------------------|-----|------|----|----|----|
| Location | Size and Type of Culvert | Size | Type of Culvert | | LEFT | RIGHT | Total (LF) | | Extensions (LF) | | Aprons | | Culvert Sections | | IN | OUT | | NO. | TYPE | | | | | NO. | TYPE | CY | CY | |
| | | | | | | | LEFT | RIGHT | LEFT | RIGHT | LEFT | RIGHT | NO.* | FT | | | | | NO.* | | | | | | | | | FT |
| 616+60.0 | 8' / 5' x 5' x 88' RCB | | | | | | | | | | | | | | | | | | | | | | See 100-23, 110-17 | | | | | |
| 622+40.0 | 4' x 6' x 98' RCB | | | | | | | | | | | | | | | | | | | | | | See 300-1 | | | | | |
| 634+25.0 | 4' x 5.5' x 84' RCB | | | | | | | | | | | | | | | | | | | | | | See 100-23 | | | | | |
| 640+20.0 | 24" x 144' RCP | | | | | | | | | | | | | 1 | | | | | | | | | See 300-1 | | | | | |
| 649+60.0 | Triple 10' x 8' x 89' RCB | | | | | | | | | | | | | | | | | | | | | | See 300-1 | | | | | |
| 663+75.0 | 36" x 102' RCP | | | | | | | | | | | | | 1 | | | | | | | | | See 300-1 | | | | | |
| 670+25.0 | 36" x 106' RCP | | | | | | | | | | | | | 1 | | | | | | | | | See 300-1 | | | | | |
| 675+75.0 | 36" x 126' RCP | | | | | | | | | | | | | 1 | | | | | | | | | See 110-17 | | | | | |
| 686+00.0 | 36" x 112.5' RCP | | | | | | | | | | | | | 1 | | | | | | | | | See 300-1 | | | | | |
| 694+85.0 | Triple 12' x 6' x 87' RCB | | | | | | | | | | | | | | | | | | | | | | | | | | | |
| 710+75.0 | 30" x 149' RCP | 30" | RCP | | | | | | | | | | | 1 | | | | | | | | | See 300-1 | | | | | |
| 723+75.0 | 12' x 10' x 48.5' RCB | | | | | | | | | | | | | | | | | | | | | | | | | | | |
| 734+35.0 | 4' x 4', 48" x 96' RCB/RCP | | | | | | | | | | | | | | | | | | | | | | See 300-1 | | | | | |
| 754+99.0 | 8' x 6' x 122' RCB | | | | | | | | | | | | | | | | | | | | | | See 100-23, 110-17 | | | | | |
| 765+70.0 | 24" x 155' RCP | | | | | | | | | | | | | 1 | | | | | | | | | See 100-23, 110-17, 300-1 | | | | | |
| 771+38.0 | 2' x 2', 30" x 117' RCB/RCP | | | | | | | | | | | | | 1 | | | | | | | | | See 110-17 | | | | | |
| 777+66.0 | 2' x 2', 24" x 117' RCB/RCP | | | | | | | | | | | | | | | | | | | | | | | | | | | |
| 784+65.0 | intake-15" x 32' RCP | | | | | | | | | | | | | | | | | | | | | | See 300-1 | | | | | |
| 785+03.0 | 4' x 4', 48" x 33' RCB/RCP | | | | | | | | | | | | | 1 | | | | | | | | | See 110-17, 300-1 | | | | | |
| 788+17.0 | 3' x 3', 42" x 122' RCB/RCP | | | | | | | | | | | | | | | | | | | | | | | | | | | |
| | | | | | | | | | | | | | | | | | | | | | | | 645.0 | | | | | |
| | | | | | | | | | | | | | | | | | | | | | | | 883.4 | | | | | |
| | | | | | | | | | | | | | | | | | | | | | | | TOTALS | | | | | |

FORESLOPE FLATTENING AND DRAINAGE STRUCTURES BY ROAD CONTRACTOR (SIDE ROAD AND ENTRANCE PIPES)

Refer to Standard Road Plans DR-121, DR-122, and DR-213.

* Not a bid item

| Existing Information | | New Information | | Length of New Const. | Flow Line Elevations | | Dimensions | | | | Removal and Reinstallation of Culvert Aprons and Pipes | | | | New Apron No. | | Apron Guard* (DR-213) | Type 'C' Connections* (DR-122) | | Connected Pipe Joint* (DR-121) | Embank.- In-Place | Class 20 | Remarks | | | | | |
|----------------------|--------------------------|-----------------|-----------------|----------------------|----------------------|-------|------------|-------|-----------------|-------|--|-------|------------------|----|---------------|-----|-----------------------|--------------------------------|------|--------------------------------|-------------------|----------|------------|-----|------|----|----|----|
| Location | Size and Type of Culvert | Size | Type of Culvert | | LEFT | RIGHT | Total (LF) | | Extensions (LF) | | Aprons | | Culvert Sections | | IN | OUT | | NO. | TYPE | | | | | NO. | TYPE | CY | CY | |
| | | | | | | | LEFT | RIGHT | LEFT | RIGHT | LEFT | RIGHT | NO.* | FT | | | | | NO.* | | | | | | | | | FT |
| SIDE ROADS | | | | | | | | | | | | | | | | | | | | | | | | | | | | |
| 241+80.0 RT | 18" x 88' CMP | 18 | CMP | | | | | | | | | | | | 1 | 1 | | | | | | 2.5 | 5.5 | | | | | |
| 289+54.7 RT | 24" x 56' CMP | | | | | | | | | | | | | | | 1 | | | | | | 1.5 | 4.0 | | | | | |
| 361+41.6 LT | 24" x 49' CMP | 24 | CMP | | | | | | | | | | | | | | | | | | | | | | | | | |
| 387+84.9 RT | 24" x 68' CMP | | | | | | | | | | | | | | | | | | | | | | | | | | | |
| 753+20.0 LT | 30" x CMP | 30 | CMP | | | | | | | | | | | | 1 | 1 | | | | | | 6.0 | 12.0 | | | | | |
| 754+55.0 LT | 18" x 94' CMP | 18 | CMP | | | | | | | | | | | | 1 | 1 | | | | | | 2.5 | 5.5 | | | | | |
| ENTRANCE | | | | | | | | | | | | | | | | | | | | | | | | | | | | |
| 19+74.0 LT | 18" x ' CMP | 18 | CMP | | | | | | | | | | | | 1 | | | | | | | 1.0 | | | | | | |
| 21+81.0 RT | 30" x 138' CMP | 30 | CMP | | | | | | | | | | | | 1 | | | | | | | 1.5 | See 110-17 | | | | | |
| 40+32.0 LT | 18" x 62' CMP | 18 | CMP | | | | | | | | | | | | 1 | 1 | | | | | | 2.0 | | | | | | |
| 52+05.0 LT | 36/30" x 118' CMP | 30 | CMP | | | | | | | | | | | | 1 | 1 | | | | | | 3.0 | | | | | | |
| 52+50.0 RT | 18" x 102' CMP | 18 | CMP | | | | | | | | | | | | 1 | 1 | | | | | | 2.0 | | | | | | |
| 53+50.0 LT | 30" x ' CMP | 30 | CMP | | | | | | | | | | | | 1 | 1 | | | | | | 3.0 | | | | | | |
| 69+95.0 RT | 18" x 170' CMP | 18 | CMP | | | | | | | | | | | | 1 | 1 | | | | | | 2.0 | | | | | | |
| 72+70.0 LT | 18" x ' CMP | 18 | CMP | | | | | | | | | | | | 1 | 1 | | | | | | 2.0 | | | | | | |
| 74+85.0 RT | 18" x 56' CMP | 18 | CMP | | | | | | | | | | | | 1 | 1 | | | | | | 2.0 | See 300-1 | | | | | |
| 74+85.0 LT | 18" x ' CMP | 18 | CMP | | | | | | | | | | | | 1 | 1 | | | | | | 2.0 | See 300-1 | | | | | |
| 76+63.0 LT | 18" x 56' CMP | 18 | CMP | | | | | | | | | | | | 1 | 1 | | | | | | 2.0 | See 300-1 | | | | | |
| 88+50.0 RT | 18" x 64' CMP | 18 | CMP | | | | | | | | | | | | 1 | 1 | | | | | | 2.0 | See 300-1 | | | | | |
| 88+55.0 LT | 18" x 64' CMP | 18 | CMP | | | | | | | | | | | | 1 | 1 | | | | | | 2.0 | See 300-1 | | | | | |
| 98+65.0 RT | 24" x 64' CMP | 24 | CMP | | | | | | | | | | | | 1 | 1 | | | | | | 3.0 | | | | | | |
| 99+81.0 LT | 24" x 70' CMP | 24 | CMP | | | | | | | | | | | | 1 | 1 | | | | | | 3.0 | | | | | | |
| 110+00.0 RT | 18" x 56' CMP | 18 | CMP | | | | | | | | | | | | 1 | 1 | | | | | | 2.0 | See 110-17 | | | | | |
| 125+23.0 RT | 18" x 120' CMP | 18 | CMP | | | | | | | | | | | | 1 | 1 | | | | | | 2.0 | | | | | | |
| 142+04.0 RT | 18" x 88' CMP | 18 | CMP | | | | | | | | | | | | 1 | 1 | | | | | | 2.0 | | | | | | |
| 147+60.0 LT | 18" x ' CMP | 18 | CMP | | | | | | | | | | | | 1 | 1 | | | | | | 2.0 | See 300-1 | | | | | |
| 157+27.0 LT | 18" x 64' CMP | 18 | CMP | | | | | | | | | | | | 1 | 1 | | | | | | 2.0 | See 300-1 | | | | | |
| 160+98.0 RT | 18" x 64' CMP | 18 | CMP | | | | | | | | | | | | 1 | 1 | | | | | | 2.0 | | | | | | |
| 168+29.0 LT | 18" x 72' CMP | 18 | CMP | | | | | | | | | | | | 1 | 1 | | | | | | 2.0 | See 300-1 | | | | | |
| 179+70.0 LT | 18" x ' CMP | 18 | CMP | | | | | | | | | | | | 1 | 1 | | | | | | 2.0 | See 300-1 | | | | | |

FORESLOPE FLATTENING AND DRAINAGE STRUCTURES BY ROAD CONTRACTOR (SIDE ROAD AND ENTRANCE PIPES)

Refer to Standard Road Plans DR-121, DR-122, and DR-213.

* Not a bid item


| Existing Information | | New Information | | Length of New Const. | Flow Line Elevations | | Dimensions | | | | Removal and Reinstallation of Culvert Aprons and Pipes | | | | New Apron No. | | Apron Guard* (DR-213) | Type 'C' Connections* (DR-122) | | Connected Pipe Joint* (DR-121) | Embank.- In-Place | Class 20 | Remarks | |
|----------------------|--------------------------|-----------------|-----------------|----------------------|----------------------|-------|------------|----|-----------------|----|--|-------|------------------|----|---------------|-----|-----------------------|--------------------------------|------|--------------------------------|-------------------|--------------------|---------|-----|
| Location | Size and Type of Culvert | Size | Type of Culvert | | LEFT | RIGHT | Total (LF) | | Extensions (LF) | | Aprons | | Culvert Sections | | IN | OUT | | NO. | TYPE | | | | | |
| | | | | | | | IN | FT | NO.* | FT | LEFT | RIGHT | NO.* | FT | | | | | NO. | | | | | NO. |
| 184+39.0 RT | 18" x 56' CMP | 18 | CMP | | | | | | | | | | | 1 | 1 | | | | | 2.0 | | | | |
| 188+00.0 LT | 18" x 56' CMP | 18 | CMP | | | | | | | | | | | 1 | 1 | | | | | 2.0 | | See 300-1 | | |
| 196+17.0 LT | 18" x 56' CMP | 18 | CMP | | | | | | | | | | | 1 | 1 | | | | | 2.0 | | See 300-1 | | |
| 198+21.0 RT | 18" x 56' CMP | 18 | CMP | | | | | | | | | | | 1 | 1 | | | | | 2.0 | | See 110-17 | | |
| 207+20.0 RT | 18" x ' CMP | 18 | CMP | | | | | | | | | | | 1 | 1 | | | | | 2.0 | | | | |
| 208+48.0 LT | 18" x 78' CMP | 18 | CMP | | | | | | | | | | | 1 | 1 | | | | | 2.0 | | See 300-1 | | |
| 208+61.0 RT | 18" x 64' CMP | 18 | CMP | | | | | | | | | | | 1 | 1 | | | | | 2.0 | | See 300-1 | | |
| 231+17.0 RT | 18" x 100' CMP | 18 | CMP | | | | | | | | | | | 1 | 1 | | | | | 2.0 | | | | |
| 238+42.0 LT | 18" x 56' CMP | 18 | CMP | | | | | | | | | | | 1 | 1 | | | | | 2.0 | | See 300-1 | | |
| 239+15.0 LT | 18" x ' CMP | 18 | CMP | | | | | | | | | | | 1 | 1 | | | | | 2.0 | | See 300-1 | | |
| 241+80.0 RT | 18" x 88' CMP | 18 | CMP | | | | | | | | | | | 1 | 1 | | | | | 2.0 | | See 300-1 | | |
| 265+00.0 LT | 18" x 52' CMP | 18 | CMP | | | | | | | | | | | 1 | 1 | | | | | 2.0 | | See 300-1 | | |
| 265+20.0 RT | 18" x ' CMP | 18 | CMP | | | | | | | | | | | 1 | 1 | | | | | 2.0 | | See 300-1 | | |
| 281+95.0 LT | 18" x 48' CMP | 18 | CMP | | | | | | | | | | | 1 | 1 | | | | | 2.0 | | See 300-1 | | |
| 285+30.0 RT | 18" x 62' CMP | 18 | CMP | | | | | | | | | | | 1 | 1 | | | | | 2.0 | | See 300-1 | | |
| 285+55.0 LT | 18" x 56' CMP | 18 | CMP | | | | | | | | | | | 1 | 1 | | | | | 2.0 | | See 300-1 | | |
| 289+60.0 LT | 18" x 80' CMP | 18 | CMP | | | | | | | | | | | 1 | 1 | | | | | 2.0 | | | | |
| 300+00.0 RT | 18" x ' CMP | 18 | CMP | | | | | | | | | | | 1 | 1 | | | | | 2.0 | | See 300-1 | | |
| 302+00.0 LT | 18" x ' CMP | 18 | CMP | | | | | | | | | | | 1 | 1 | | | | | 2.0 | | See 300-1 | | |
| 316+16.0 RT | 18" x 88' CMP | 18 | CMP | | | | | | | | | | | 1 | 1 | | | | | 2.0 | | See 300-1 | | |
| 317+28.0 LT | 18" x 96' CMP | 18 | CMP | | | | | | | | | | | 1 | 1 | | | | | 2.0 | | | | |
| 319+55.0 RT | 18" x 56' CMP | 18 | CMP | | | | | | | | | | | 1 | 1 | | | | | 2.0 | | See 300-1 | | |
| 345+81.0 LT | 18" x 94' CMP | 18 | CMP | | | | | | | | | | | 1 | 1 | | | | | 2.0 | | See 300-1 | | |
| 347+40.0 LT | 18" x 104' CMP | 18 | CMP | | | | | | | | | | | 1 | 1 | | | | | 2.0 | | | | |
| 349+00.0 LT | 18" x 96' CMP | 18 | CMP | | | | | | | | | | | 1 | 1 | | | | | 2.0 | | | | |
| 351+23.0 LT | 18" x 64' CMP | 18 | CMP | | | | | | | | | | | 1 | 1 | | | | | 2.0 | | | | |
| 352+81.0 LT | 18" x 72' CMP | 18 | CMP | | | | | | | | | | | 1 | 1 | | | | | 2.0 | | | | |
| 345+50.0 LT | 18" x CMP | 18 | CMP | | | | | | | | | | | 1 | 1 | | | | | 2.0 | | | | |
| 379+35.0 LT | 18" x 64' CMP | 18 | CMP | | | | | | | | | | | 1 | 1 | | | | | 2.0 | | | | |
| 379+41.0 RT | 18" x 88' CMP | 18 | CMP | | | | | | | | | | | 1 | 1 | | | | | 2.0 | | See 300-1 | | |
| 395+00.0 LT | 18" x 80' CMP | 18 | CMP | | | | | | | | | | | 1 | 1 | | | | | 2.0 | | | | |
| 400+46.0 LT | 18" x 96' CMP | 18 | CMP | | | | | | | | | | | 1 | 1 | | | | | 2.0 | | See 300-1 | | |
| 403+00.0 LT | 24" x ' CMP | 24 | CMP | | | | | | | | | | | 1 | 1 | | | | | 3.0 | | | | |
| 405+00.0 LT | 18" x 38' CMP | 18 | CMP | | | | | | | | | | | 1 | 1 | | | | | 2.0 | | See 300-1 | | |
| 430+63.0 RT | 18" x 44' CMP | 18 | CMP | | | | | | | | | | | 1 | 1 | | | | | 2.0 | | | | |
| 437+31.0 LT | 18" x 68' CMP | 18 | CMP | | | | | | | | | | | 1 | 1 | | | | | 2.0 | | | | |
| 451+00.0 RT | 18" x 102' CMP | 18 | CMP | | | | | | | | | | | 1 | 1 | | | | | 2.0 | | | | |
| 452+00.0 RT | 18" x 80' CMP | 18 | CMP | | | | | | | | | | | 1 | 1 | | | | | 2.0 | | | | |
| 465+84.0 LT | 18" x 64' CMP | 18 | CMP | | | | | | | | | | | 1 | 1 | | | | | 2.0 | | See 300-1 | | |
| 474+62.0 RT | 18" x 48' CMP | 18 | CMP | | | | | | | | | | | 1 | 1 | | | | | 2.0 | | See 110-17 | | |
| 485+82.0 RT | 18" x ' CMP | 18 | CMP | | | | | | | | | | | 1 | 1 | | | | | 2.0 | | See 300-1 | | |
| 499+50.0 RT | 18" x 64' CMP | 18 | CMP | | | | | | | | | | | 1 | 1 | | | | | 2.0 | | | | |
| 508+59.0 RT | 18" x 46' CMP | 18 | CMP | | | | | | | | | | | 1 | 1 | | | | | 2.0 | | | | |
| 526+95.0 RT | 18" x 54' CMP | 18 | CMP | | | | | | | | | | | 1 | 1 | | | | | 1.0 | | See 110-17 | | |
| 539+55.0 LT | 24" x 84' CMP | 24 | CMP | | | | | | | | | | | 1 | 1 | | | | | 3.0 | | | | |
| 543+71.0 RT | 18" x 74' CMP | 18 | CMP | | | | | | | | | | | 1 | 1 | | | | | 2.0 | | | | |
| 594+50.0 RT | 24" x 92' CMP | 24 | CMP | | | | | | | | | | | 1 | 1 | | | | | 3.0 | | | | |
| 615+23.0 LT | 18" x 56' CMP | 18 | CMP | | | | | | | | | | | 1 | 1 | | | | | 2.0 | | | | |
| 632+50.0 LT | 24" x 70' CMP | 24 | CMP | | | | | | | | | | | 1 | 1 | | | | | 3.0 | | See 300-1 | | |
| 655+17.0 LT | 24" x 62' CMP | 24 | CMP | | | | | | | | | | | 1 | 1 | | | | | 3.0 | | | | |
| 690+52.0 LT | 18" x 56' CMP | 18 | CMP | | | | | | | | | | | 1 | 1 | | | | | 2.0 | | | | |
| 723+23.0 LT | 30" x 76' | 30 | CMP | | | | | | | | | | | 1 | 1 | | | | | 3.0 | | | | |
| 726+38.4 RT | 18" x ' CMP | 18 | CMP | | | | | | | | | | | 1 | 1 | | | | | 2.0 | | | | |
| 735+36.0 LT | 24" x 102' CMP | 24 | CMP | | | | | | | | | | | 1 | 1 | | | | | 3.0 | | See 110-17, 300-1 | | |
| 755+10.0 LT | 18" x ' CMP | 18 | CMP | | | | | | | | | | | 1 | 1 | | | | | 2.0 | | | | |
| 755+69.0 LT | 18" x 70' CMP | 18 | CMP | | | | | | | | | | | 1 | 1 | | | | | 2.0 | | See 300-1 | | |
| 765+00.0 LT | 18" x ' CMP | 18 | CMP | | | | | | | | | | | 1 | 1 | | | | | 2.0 | | | | |
| 772+00.0 LT | 18" x ' CMP | | | | | | | | | | | | | | | | | | | | | See 300-1 | | |
| 785+00.0 LT | 15" x ' RCP | 18 | RCP | 50 | | | 25 | 25 | | | | | | 1 | 1 | | | | | 16.0 | | | | |
| 787+00.0 RT | 18" x ' CMP | 18 | CMP | | | | | | | | | | | 1 | 1 | | | | | 1.0 | | See 100-23, 110-17 | | |
| | | | | | | | | | | | | | | | | | | | | 197.9 | 27.1 | TOTALS | | |

FULL-DEPTH PATCHES

Possible Standards: PR-101, PR-102, PR-103, PR-104, PR-105 and PR-140.

| Count | Location | | | Dimension | | | PCC Patches | | | | HMA Patches | Composite HMA | Subbase Patches | Subbase Patch w/ 'EF' Joint | Patch Subdrain | 'CD' Joints | 'CT' Joints | 'EF' Joints | Anchor Lugs Removal | Remarks |
|------------|----------|-------------------------|--------|-----------|-------|-----------------|-------------|----------------|--------|------------------|-------------|------------------|-----------------|-----------------------------|----------------|-------------|-------------|-------------|---------------------|---------------|
| | Station | Reference Location Sign | Lane | Length | Width | Patch Thickness | With Dowels | Without Dowels | C R C | Ramp with Dowels | | | | | | | | | | |
| | | | | | | | PR-103 | PR-102 | PR-104 | PR-105 | | | | | | | | | | |
| L, R, or B | FT | FT | IN | SY | SY | SY | SY | SY | TON | SY | SY | PR-101 or PR-140 | No. | No. | No. | No. | | | | |
| 1 | 16+60 | | LT | 4.0 | 23.0 | 5.0 | | | | | 10.2 | | 10.6 | | | | | | | |
| 1 | 85+50 | | RT OUT | 40.0 | 6.0 | 5.0 | | | | | 26.7 | | 30.4 | | | | | | | CLIMBING LANE |
| 1 | 87+15 | | RT OUT | 12.0 | 12.0 | 5.0 | | | | | 16.0 | | 17.1 | | | | | | | CLIMBING LANE |
| 1 | 93+25 | | RT OUT | 30.0 | 6.0 | 5.0 | | | | | 20.0 | | 22.8 | | | | | | | CLIMBING LANE |
| 1 | 94+90 | | RT OUT | 8.0 | 6.0 | 5.0 | | | | | 5.3 | | 6.1 | | | | | | | CLIMBING LANE |
| 1 | 94+90 | | LT | 8.0 | 6.0 | 5.0 | | | | | 5.3 | | | | 1 | | | | | |
| 1 | 228+35 | | RT | 4.0 | 12.0 | 15.0 | | | | | 5.3 | | | | 1 | | | | | |
| 1 | 228+35 | | LT | 4.0 | 12.0 | 15.0 | | | | | 5.3 | | 5.7 | | | | | | | |
| 1 | 229+60 | | RT | 4.0 | 12.0 | 15.0 | | | | | 5.3 | | | | 1 | | | | | |
| 1 | 229+60 | | LT | 4.0 | 12.0 | 15.0 | | | | | 5.3 | | 5.7 | | | | | | | |
| 1 | 237+15 | | RT | 4.0 | 12.0 | 15.0 | | | | | 5.3 | | | | 1 | | | | | |
| 1 | 237+15 | | LT | 4.0 | 12.0 | 15.0 | | | | | 5.3 | | 5.7 | | | | | | | |
| 1 | 238+50 | | RT | 6.0 | 12.0 | 15.0 | | | | | 8.0 | | | | 1 | | | | | |
| 1 | 238+50 | | LT | 6.0 | 12.0 | 15.0 | | | | | 8.0 | | 8.6 | | | | | | | |
| 1 | 239+20 | | RT | 4.0 | 12.0 | 15.0 | | | | | 5.3 | | | | 1 | | | | | |
| 1 | 239+20 | | LT | 4.0 | 12.0 | 15.0 | | | | | 5.3 | | 5.7 | | | | | | | |
| 1 | 258+20 | | RT | 4.0 | 12.0 | 15.0 | | | | | 5.3 | | 5.7 | | | | | | | |
| 1 | 258+20 | | LT | 4.0 | 12.0 | 15.0 | | | | | 5.3 | | | | 1 | | | | | |
| 1 | 272+76 | | RT | 4.0 | 12.0 | 15.0 | | | | | 5.3 | | 5.7 | | | | | | | |
| 1 | 272+76 | | LT | 4.0 | 12.0 | 15.0 | | | | | 5.3 | | | | 1 | | | | | |
| 1 | 273+65 | | RT | 4.0 | 12.0 | 15.0 | | | | | 5.3 | | 5.7 | | | | | | | |
| 1 | 273+65 | | LT | 4.0 | 12.0 | 15.0 | | | | | 5.3 | | | | 1 | | | | | |
| 1 | 294+00 | | RT | 4.0 | 12.0 | 5.0 | | | | | 5.3 | | 5.7 | | | | | | | |
| 1 | 296+05 | | RT | 4.0 | 12.0 | 5.0 | | | | | 5.3 | | 5.7 | | | | | | | |
| 1 | 296+05 | | LT | 4.0 | 12.0 | 5.0 | | | | | 5.3 | | 5.7 | | | | | | | |
| 1 | 296+75 | | RT | 4.0 | 12.0 | 5.0 | | | | | 5.3 | | 5.7 | | | | | | | |
| 1 | 296+75 | | LT | 4.0 | 12.0 | 5.0 | | | | | 5.3 | | 5.7 | | | | | | | |
| 1 | 297+60 | | RT | 4.0 | 12.0 | 5.0 | | | | | 5.3 | | 5.7 | | | | | | | |
| 1 | 297+60 | | LT | 4.0 | 12.0 | 5.0 | | | | | 5.3 | | 5.7 | | | | | | | |
| 1 | 298+10 | | RT | 4.0 | 12.0 | 5.0 | | | | | 5.3 | | | | 1 | | | | | |
| 1 | 298+10 | | LT | 4.0 | 12.0 | 5.0 | | | | | 5.3 | | 5.7 | | | | | | | |
| 1 | 367+00 | | RT | 4.0 | 12.0 | 5.0 | | | | | 5.3 | | 5.7 | | | | | | | |
| 1 | 367+00 | | LT | 4.0 | 12.0 | 5.0 | | | | | 5.3 | | | | 1 | | | | | |
| 1 | 367+50 | | RT | 4.0 | 12.0 | 5.0 | | | | | 5.3 | | 5.7 | | | | | | | |
| 1 | 367+50 | | LT | 4.0 | 12.0 | 5.0 | | | | | 5.3 | | | | 1 | | | | | |
| 1 | 369+60 | | RT | 4.0 | 12.0 | 5.0 | | | | | 5.3 | | | | 1 | | | | | |
| 1 | 369+60 | | LT | 4.0 | 12.0 | 5.0 | | | | | 5.3 | | 5.7 | | | | | | | |
| 1 | 374+15 | | RT | 4.0 | 12.0 | 5.0 | | | | | 5.3 | | | | 1 | | | | | |
| 1 | 374+15 | | LT | 4.0 | 12.0 | 5.0 | | | | | 5.3 | | 5.7 | | | | | | | |
| 1 | 374+70 | | RT | 4.0 | 12.0 | 5.0 | | | | | 5.3 | | | | 1 | | | | | |
| 1 | 374+70 | | LT | 4.0 | 12.0 | 5.0 | | | | | 5.3 | | 5.7 | | | | | | | |
| 1 | 376+81 | | RT | 4.0 | 12.0 | 5.0 | | | | | 5.3 | | | | 1 | | | | | |
| 1 | 376+81 | | LT | 4.0 | 12.0 | 5.0 | | | | | 5.3 | | 5.7 | | | | | | | |
| 1 | 377+40 | | RT | 4.0 | 12.0 | 5.0 | | | | | 5.3 | | | | 1 | | | | | |
| 1 | 377+40 | | LT | 4.0 | 12.0 | 5.0 | | | | | 5.3 | | | | | | | | | |
| 1 | 486+30 | | RT | 4.0 | 12.0 | 14.0 | | | | | 5.3 | | | | | | | | | No subbase |
| 1 | 486+30 | | LT | 4.0 | 12.0 | 14.0 | | | | | 5.3 | | | | | | | | | No subbase |
| 1 | 496+00 | | RT | 5.0 | 8.0 | 14.0 | | | | | 4.4 | | | | | | | | | No subbase |
| 1 | 496+00 | | LT | 5.0 | 8.0 | 14.0 | | | | | 4.4 | | | | | | | | | No subbase |
| 49 | | | | | | | | | | | 316.4 | | 215.3 | | 17 | | | | | TOTALS |

HMA PAVEMENT


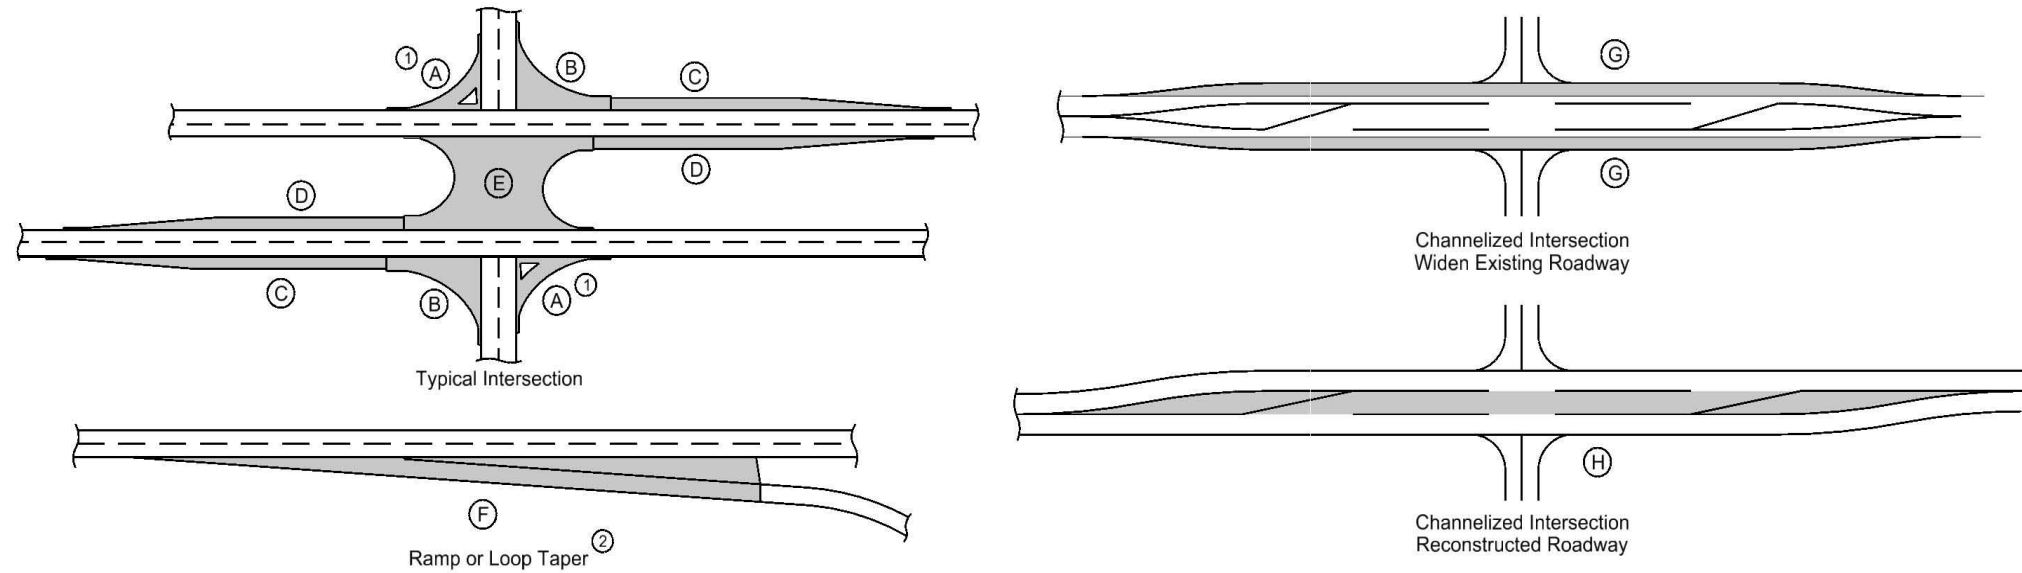


- ① Does not include raised island area or curb. Refer to tabulation 112-4 for quantities.
- ② Refer to PV-410, PV-411, PV-412, and PV-414.
- ③ Quantity includes Pavement Header.

Calculations assume a surface course unit weight (lbs/cf) of 147, an intermediate course unit weight (lbs/cf) of 147, a base course unit weight (lbs/cf) of 145, and a special backfill unit weight (lbs/cf) of 140.

| Road Identification | Direction of Travel | Location Station to Station | | Mainline | | | Area ③ | | | | | | Hot Mix Asphalt Pavement | | | | | | Bid Items | | | | | Remarks | | | | | | | | |
|---------------------|---------------------|--------------------------------|----------|-------------|--------------|------------|-----------|---------|---------|---------|---------|-----------|--------------------------|---------|---------|--------|--------------|------|---------------|-------|-----------------|----------------------|----------------------|---------|--------------------------|----------------------------|------------------------|------------------------------|------|------|------|-------|
| | | | | Width FT | Length FT | Area SY | A ① SY | B SY | C SY | D SY | E SY | F ② SY | G SY | H SY | Surface | | Intermediate | | Cold-In-Place | | Surface TONS | Intermediate TONS | Foam Asphalt TONS | | Special Backfill TONS | Excavation, Class 13 CY | Modified Subbase CY | Pavement Scarification SY | | | | |
| | | | | | | | | | | | | | | | TONS | SY | TONS | SY | Width | SY | | | | | | | | | TONS | TONS | TONS | TONS |
| IA 9 | EB | 15+50.0 | 16+25.0 | 46.0 | 75.0 | 383.3 | | | | | | | | 42.3 | 383.6 | 21.2 | 385.2 | | | | 2.5 | 1.3 | | | | | | 383.3 | | | | |
| | EB | 16+25.0 | 21+50.0 | 50.0 | 525.0 | 2916.7 | | | | | | | | 321.7 | 2918.3 | 161.6 | 2930.7 | | | | 19.3 | 9.7 | | | | | | 2916.7 | | | | |
| | EB | 21+50.0 | 32+00.0 | 44.0 | 1050.0 | 5133.3 | | | | | | | | 566.3 | 5136.6 | 284.9 | 5169.0 | 44.0 | 5133.3 | 34.0 | 17.1 | 16.9 | | | | | | | | | | |
| | EB | 32+00.0 | 38+60.0 | 44-32 | 660.0 | 2786.7 | | | | | | | | 307.5 | 2788.7 | 154.7 | 2806.0 | 32.0 | 2346.7 | 18.4 | 9.3 | 7.7 | | | | | | 440.0 | | | | |
| | EB | 38+60.0 | 70+20.0 | 32.0 | 3160.0 | 11235.6 | | | | | | | | 1239.8 | 11245.3 | 623.7 | 11313.6 | 32.0 | 11235.6 | 74.4 | 37.4 | 37.1 | | | | | | | | | | |
| | EB | 70+20.0 | 75+00.0 | 32-44 | 480.0 | 2026.7 | | | | | | | | 223.6 | 2028.1 | 112.5 | 2040.7 | 32.0 | 1706.7 | 13.4 | 6.7 | 5.6 | | | | | | 320.0 | | | | |
| | EB | 75+00.0 | 109+03.5 | 44.0 | 3403.5 | 16639.1 | | | | | | | | 1835.6 | 16649.6 | 923.6 | 16754.6 | 44.0 | 16639.1 | 110.1 | 55.4 | 54.9 | | | | | | | | | | |
| STA EQ | EB | | | | | | | | | | | | | | | | | | | | | | | | | | | | | | | |
| | EB | 109+36.1 | 113+00.0 | 44.0 | 363.9 | 1779.1 | | | | | | | | 196.3 | 1780.2 | 98.8 | 1791.5 | 44.0 | 1779.1 | 11.8 | 5.9 | 5.9 | | | | | | | | | | |
| | EB | 113+00.0 | 119+60.0 | 44-32 | 660.0 | 2786.7 | | | | | | | | 307.5 | 2788.7 | 154.7 | 2806.0 | 32.0 | 2346.7 | 18.4 | 9.3 | 7.7 | | | | | | | | | | |
| | EB | 119+60.0 | 171+91.0 | 32.0 | 5231.0 | 18599.1 | | | | | | | | 2052.3 | 18615.2 | 1032.4 | 18728.2 | 32.0 | 18599.1 | 123.1 | 61.9 | 61.4 | | | | | | | | | | |
| STA EQ | EB | | | | | | | | | | | | | | | | | | | | | | | | | | | | | | | |
| | EB | 171+90.4 | 253+29.5 | 32.0 | 8139.1 | 28939.1 | | | | | | | | 3193.3 | 28964.2 | 1606.3 | 29140.0 | 32.0 | 28939.1 | 191.6 | 96.4 | 95.5 | | | | | | | | | | |
| STA EQ | EB | | | | | | | | | | | | | | | | | | | | | | | | | | | | | | | |
| | EB | 253+08.8 | 308+16.6 | 32.0 | 5507.8 | 19583.4 | | | | | | | | 2160.9 | 19600.4 | 1087.0 | 19719.4 | 32.0 | 19583.4 | 129.7 | 65.2 | 64.6 | | | | | | | | | | |
| STA EQ | EB | | | | | | | | | | | | | | | | | | | | | | | | | | | | | | | |
| | EB | 308+17.5 | 326+03.1 | 32.0 | 1785.6 | 6348.8 | | | | | | | | 700.6 | 6354.3 | 352.4 | 6392.9 | 32.0 | 6348.8 | 42.0 | 21.1 | 21.0 | | | | | | | | | | |
| STA EQ | EB | | | | | | | | | | | | | | | | | | | | | | | | | | | | | | | |
| | EB | 326+03.7 | 371+12.7 | 32.0 | 4509.0 | 16032.1 | | | | | | | | 1769.1 | 16046.0 | 889.9 | 16143.4 | 32.0 | 16032.1 | 106.1 | 53.4 | 52.9 | | | | | | | | | | |
| STA EQ | EB | | | | | | | | | | | | | | | | | | | | | | | | | | | | | | | |
| | EB | 371+21.1 | 470+76.8 | 32.0 | 9955.8 | 35398.3 | | | | | | | | 3906.1 | 35429.1 | 1964.9 | 35644.2 | 32.0 | 35398.3 | 234.4 | 117.9 | 116.8 | | | | | | | | | | |
| STA EQ | EB | | | | | | | | | | | | | | | | | | | | | | | | | | | | | | | |
| | EB | 471+06.0 | 501+00.0 | 32.0 | 2994.0 | 10645.4 | | | | | | | | 1174.7 | 10654.7 | 590.9 | 10719.4 | 32.0 | 10645.4 | 70.5 | 35.5 | 35.1 | | | | | | | | | | |
| | EB | 501+00.0 | 514+00.0 | 36.0 | 1300.0 | 5200.0 | | | | | | | | 573.7 | 5204.0 | 288.6 | 5236.1 | 32.0 | 4622.2 | 34.4 | 17.3 | 15.3 | | | | | | | | | | |
| | EB | 514+00.0 | 517+60.0 | 36-48 | 360.0 | 1680.0 | | | | | | | | 185.3 | 1681.1 | 93.3 | 1691.7 | 32.0 | 1280.0 | 11.1 | 5.6 | 4.2 | | | | | | | | | | 577.8 |
| | EB | 517+60.0 | 518+80.0 | 32-44 | 120.0 | 506.7 | | | | | | | | 55.9 | 507.0 | 28.1 | 510.2 | 32.0 | 426.7 | 3.4 | 1.7 | 1.4 | | | | | | | | | | 400.0 |
| | EB | 518+80.0 | 555+00.0 | 44.0 | 3620.0 | 17697.8 | | | | | | | | 1952.4 | 17709.0 | 982.4 | 17820.7 | 44.0 | 17697.8 | 117.1 | 58.9 | 58.4 | | | | | | | | | | |
| | EB | 555+00.0 | 560+00.0 | 46.0 | 500.0 | 2555.6 | | | | | | | | 281.9 | 2557.1 | 141.9 | 2573.3 | 44.0 | 2444.4 | 16.9 | 8.5 | 8.1 | | | | | | | | | | 111.1 |
| | EB | 560+00.0 | 644+20.0 | 44.0 | 8420.0 | 41164.4 | | | | | | | | 4541.2 | 41190.4 | 2284.9 | 41450.3 | 44.0 | 41164.4 | 272.5 | 137.1 | 135.8 | | | | | | | | | | |
| | EB | 644+20.0 | 650+80.0 | 44-32 | 660.0 | 2786.7 | | | | | | | | 307.5 | 2788.7 | 154.7 | 2806.0 | 32.0 | 2346.7 | 18.4 | 9.3 | 7.7 | | | | | | | | | | 440.0 |
| | EB | 650+80.0 | 752+66.4 | 32.0 | 10186.4 | 36218.1 | | | | | | | | 3996.5 | 36249.6 | 2010.4 | 36469.6 | 32.0 | 36218.1 | 239.8 | 120.6 | 119.5 | | | | | | | | | | |
| STA EQ | EB | | | | | | | | | | | | | | | | | | | | | | | | | | | | | | | |
| | EB | 752+20.8 | 769+60.0 | 32.0 | 1739.2 | 6183.9 | | | | | | | | 682.4 | 6189.2 | 343.3 | 6226.8 | 32.0 | 6183.9 | 40.9 | 20.6 | 20.4 | | | | | | | | | | |
| | EB | 769+60.0 | 771+00.0 | 32-31 | 140.0 | 490.0 | | | | | | | | 54.1 | 490.4 | 27.2 | 493.4 | 31.0 | 482.2 | 3.2 | 1.6 | 1.6 | | | | | | | | | | |
| | EB | 771+00.0 | 800+15.0 | 31.0 | 2915.0 | 10040.6 | | | | | | | | 1108.0 | 10049.6 | 557.3 | 10110.3 | 31.0 | 10040.6 | 66.5 | 33.4 | 33.1 | | | | | | | | | | |
| | EB | 800+15.0 | 801+25.0 | 31-30 | 110.0 | 372.8 | | | | | | | | 41.1 | 373.1 | 20.7 | 375.4 | | | 2.5 | 1.2 | | | | | | | | | | | |
| | EB | 801+25.0 | 801+50.0 | 30.0 | 25.0 | 84.7 | | | | | | | | 9.3 | 84.8 | 4.7 | 85.3 | | | 0.6 | 0.3 | | | | | | | | | | | |
| | EB | 801+50.0 | 802+25.0 | 30.0 | 75.0 | 254.2 | | | | | | | | 28.0 | 254.4 | 14.1 | 255.4 | | | 1.7 | 0.8 | | | | | | | | | | | |
| 10th Ave NW | LT | 15+96.0 | | 30.0 | | 123.7 | | | | | | | | 13.6 | 123.7 | 6.8 | 123.7 | | | 0.8 | 0.4 | | | | | | | | | | | |
| Makee Dr NE | RT | 44+72.3 | | 10.0 | | 232.6 | | | | | | | | 25.6 | 232.6 | 12.8 | 232.6 | | | 1.5 | 0.8 | | | | | | | | | | | |
| Green Valley Rd | LT | 44+72.3 | | 30.0 | | 200.0 | | | | | | | | 22.1 | 200.0 | 11.0 | 200.0 | | | 1.3 | 0.7 | | | | | | | | | | | |
| Radio Park Ln | RT | 52+85.0 | | 30.0 | | 100.0 | | | | | | | | 11.0 | 100.0 | 5.5 | 100.0 | | | 0.7 | 0.3 | | | | | | | | | | | |
| A44/Iron Mine Dr | RT | 119+13.5 | | 10.0 | | 256.4 | | | | | | | | 28.3 | 256.4 | 14.1 | 256.4 | | | 1.7 | 0.8 | | | | | | | | | | | |



HMA PAVEMENT

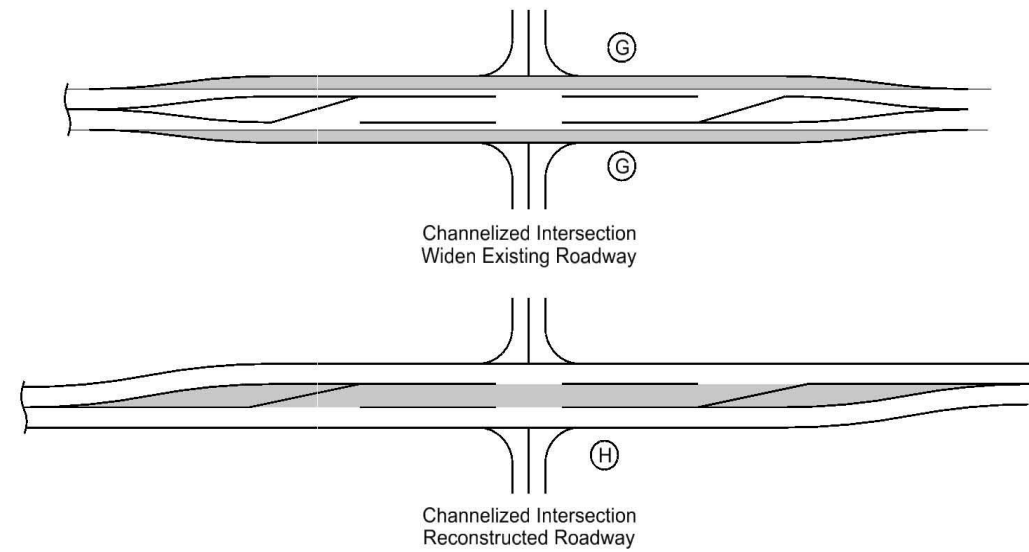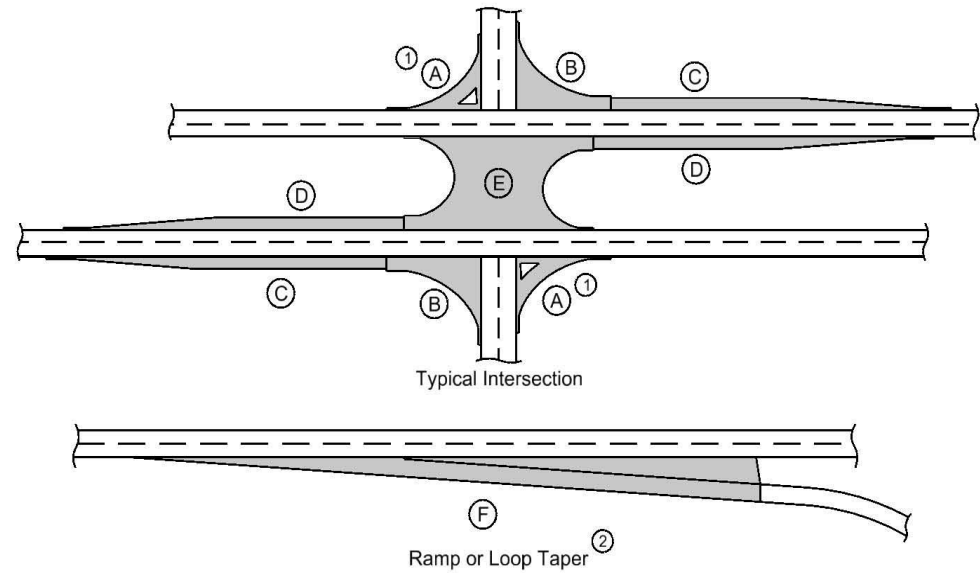

- ① Does not include raised island area or curb. Refer to tabulation 112-4 for quantities.
- ② Refer to PV-410, PV-411, PV-412, and PV-414.
- ③ Quantity includes Pavement Header.

Calculations assume a surface course unit weight (lbs/cf) of 147, an intermediate course unit weight (lbs/cf) of 147, a base course unit weight (lbs/cf) of 145, and a special backfill unit weight (lbs/cf) of 140.

| Road Identification | Direction of Travel | Station to Station | Mainline | | | Area ③ | | | | | | | | Hot Mix Asphalt Pavement | | | | | | | | | | Remarks | | | | | | |
|---------------------|---------------------|--------------------|----------|--------|-------|--------|---|---|---|---|-----|---|---|--------------------------|----------|---------|----------|---------------|----|--------|----------|--------|------------------|---------|----------------------|------------------|------------------------|--------|--------|--------|
| | | | Width | Length | Area | A ① | B | C | D | E | F ② | G | H | Surface | | | | Cold-In-Place | | Binder | | | Special Backfill | | Excavation, Class 13 | Modified Subbase | Pavement Scarification | | | |
| | | | | | | | | | | | | | | TONS | SY | TONS | SY | Width | SY | TONS | TONS | TONS | | | | | | TONS | | |
| A44/Iron Mine Dr | LT | 119+13.5 | 30.0 | | 166.7 | | | | | | | | | 18.4 | 166.7 | 9.2 | 166.7 | | | | 1.1 | 0.6 | | | | | | | | |
| Howard Rd | LT | 169+36.6 | 10.0 | | 93.1 | | | | | | | | | 10.3 | 93.1 | 5.1 | 93.1 | | | | 0.6 | 0.3 | | | | | | | | |
| Moose Rd | LT | 211+55.0 | 10.0 | | 111.6 | | | | | | | | | 12.3 | 111.6 | 6.1 | 111.6 | | | | 0.7 | 0.4 | | | | | | | | |
| Dug Rd | RT | 248+02.7 | 10.0 | | 160.1 | | | | | | | | | 17.7 | 160.1 | 8.8 | 160.1 | | | | 1.1 | 0.5 | | | 26.7 | | | | | |
| X20-Lycurgus Rd | LT | 260+45.2 | 30.0 | | 166.7 | | | | | | | | | 18.4 | 166.7 | 9.2 | 166.7 | | | | 1.1 | 0.6 | | | | | | | | |
| Plein Rd | LT | 276+14.8 | 10.0 | | 111.9 | | | | | | | | | 12.3 | 111.9 | 6.2 | 111.9 | | | | 0.7 | 0.4 | | | | | | | | |
| Pheasant Rd | RT | 289+54.7 | 10.0 | | 98.0 | | | | | | | | | 10.8 | 98.0 | 5.4 | 98.0 | | | | 0.6 | 0.3 | | | | | | | | |
| Clonkitty Rd | RT | 307+20.7 | 10.0 | | 137.6 | | | | | | | | | 15.2 | 137.6 | 7.6 | 137.6 | | | | 0.9 | 0.5 | | | 22.9 | | | | | |
| French Creek Rd | LT | 320+20.1 | 10.0 | | 149.9 | | | | | | | | | 16.5 | 149.9 | 8.3 | 149.9 | | | | 1.0 | 0.5 | | | 25.0 | | | | | |
| Gun Tower Rd | LT | 361+41.6 | 10.0 | | 147.9 | | | | | | | | | 16.3 | 147.9 | 8.2 | 147.9 | | | | 1.0 | 0.5 | | | | | | | | |
| Hilltop Rd | RT | 387+84.9 | 10.0 | | 149.0 | | | | | | | | | 16.4 | 149.0 | 8.2 | 149.0 | | | | 1.0 | 0.5 | | | | | | | | |
| Village Creek Rd | RT | 413+61.4 | 10.0 | | 131.0 | | | | | | | | | 14.4 | 131.0 | 7.2 | 131.0 | | | | 0.9 | 0.4 | | | 21.8 | | | | | |
| Hawk View Rd | LT | 419+21.5 | 10.0 | | 116.1 | | | | | | | | | 12.8 | 116.1 | 6.4 | 116.1 | | | | 0.8 | 0.4 | | | | | | | | |
| Bluebell Rd | RT | 434+70.5 | 10.0 | | 146.1 | | | | | | | | | 16.1 | 146.1 | 8.1 | 146.1 | | | | 1.0 | 0.5 | | | | | | | | |
| High Point Rd | LT | 452+05.2 | 10.0 | | 104.1 | | | | | | | | | 11.5 | 104.1 | 5.7 | 104.1 | | | | 0.7 | 0.3 | | | | | | | | |
| Dry Ridge Dr | RT | 506+70.9 | 10.0 | | 107.9 | | | | | | | | | 11.9 | 107.9 | 5.9 | 107.9 | | | | 0.7 | 0.4 | | | 18.0 | | | | | |
| Bolder Dr | LT | 518+89.1 | 10.0 | | 111.6 | | | | | | | | | 12.3 | 111.6 | 6.1 | 111.6 | | | | 0.7 | 0.4 | | | | | | | | |
| X6A/Mays Prairie | LT | 526+95.0 | 10.0 | | 116.4 | | | | | | | | | 12.8 | 116.4 | 6.4 | 116.4 | | | | 0.8 | 0.4 | | | 19.4 | | | | | |
| Gander Hill Rd | RT | 646+53.2 | 10.0 | | 126.1 | | | | | | | | | 13.9 | 126.1 | 7.0 | 126.1 | | | | 0.8 | 0.4 | | | 21.0 | | | | | |
| X6A/Four Mile Dr | LT | 652+30.9 | 10.0 | | 133.0 | | | | | | | | | 14.7 | 133.0 | 7.3 | 133.0 | | | | 0.9 | 0.4 | | | 22.2 | | | | | |
| Gruber Ridge Rd | LT | 697+25.0 | 10.0 | | 165.6 | | | | | | | | | 18.3 | 165.6 | 9.1 | 165.6 | | | | 1.1 | 0.5 | | | 27.6 | | | | | |
| Valley Rd | LT | 726+38.4 | 10.0 | | 106.2 | | | | | | | | | 11.7 | 106.2 | 5.9 | 106.2 | | | | 0.7 | 0.4 | | | | | | | | |
| Driftwood Ln | LT | 755+39.0 | 10.0 | | 60.9 | | | | | | | | | 6.7 | 60.9 | 3.4 | 60.9 | | | | 0.4 | 0.2 | | | | | | | | |
| Creek View Ln | LT | 756+88.0 | 10.0 | | 52.9 | | | | | | | | | 5.8 | 52.9 | 2.9 | 52.9 | | | | 0.3 | 0.2 | | | | | | | | |
| Clear Creek Blvd | RT | 759+31.0 | 10.0 | | 74.0 | | | | | | | | | 8.2 | 74.0 | 4.1 | 74.0 | | | | 0.5 | 0.2 | | | | | | | | |
| South Rd | RT | 801+45.2 | 30.0 | | 95.6 | | | | | | | | | 10.5 | 95.6 | 5.3 | 95.6 | | | | 0.6 | 0.3 | | | | | | | | |
| 33 Paved drives | | Various | 30.0 | | | | | | | | | | | 303.2 | 2750.0 | 151.6 | 2750.0 | | | | 18.2 | 9.1 | | | | | | | | |
| | | | | | | | | | | | | | | 34564.9 | 313513.9 | 17386.0 | 315391.8 | | | | 299640.4 | 2073.9 | 1043.2 | 988.8 | | | 286.1 | 6382.8 | TOTALS | |
| DIVISION 3 | | | | | | | | | | | | | | | | | | | | | | | | | | | | | | |
| Makee Dr NE | RT | 44+72.3 | 40.0 | | 535.3 | | | | | | | | | 59.0 | 535.3 | 118.0 | 535.3 | | | | 3.5 | 7.1 | | | 178.4 | 89.2 | | | | |
| A44/Iron Mine Dr | RT | 119+13.5 | 40.0 | | 362.2 | | | | | | | | | 39.9 | 362.2 | 79.9 | 362.2 | | | | 2.4 | 4.8 | | | 120.7 | 60.4 | | | | |
| Dug Rd | RT | 248+02.7 | 40.0 | | 291.1 | | | | | | | | | 32.1 | 291.1 | 64.2 | 291.1 | | | | 1.9 | 3.9 | | | 97.0 | 48.5 | | | | |
| Clonkitty Rd | RT | 307+20.7 | 40.0 | | 238.4 | | | | | | | | | 26.3 | 238.4 | 52.6 | 238.4 | | | | 1.6 | 3.2 | | | 79.5 | 39.7 | | | | |
| French Creek Rd | LT | 320+20.1 | 40.0 | | 295.3 | | | | | | | | | 32.6 | 295.3 | 65.1 | 295.3 | | | | 2.0 | 3.9 | | | 98.4 | 49.2 | | | | |
| Village Creek Rd | RT | 413+61.4 | 40.0 | | 212.1 | | | | | | | | | 23.4 | 212.1 | 46.8 | 212.1 | | | | 1.4 | 2.8 | | | 70.7 | 35.4 | | | | |
| Dry Ridge Dr | RT | 506+70.9 | 40.0 | | 188.9 | | | | | | | | | 20.8 | 188.9 | 41.7 | 188.9 | | | | 1.2 | 2.5 | | | 63.0 | 31.5 | | | | |
| X6A/Mays Prairie | LT | 526+95.0 | 40.0 | | 226.9 | | | | | | | | | 25.0 | 226.9 | 50.0 | 226.9 | | | | 1.5 | 3.0 | | | 75.6 | 37.8 | | | | |
| Gander Hill Rd | RT | 646+53.2 | 40.0 | | 144.8 | | | | | | | | | 16.0 | 144.8 | 31.9 | 144.8 | | | | 1.0 | 1.9 | | | | | | | | |
| X6A/Four Mile Dr | LT | 652+30.9 | 40.0 | | 276.3 | | | | | | | | | 30.5 | 276.3 | 60.9 | 276.3 | | | | 1.8 | 3.7 | | | 92.1 | 46.1 | | | | |
| Gruber Ridge Rd | LT | 697+25.0 | 40.0 | | 224.4 | | | | | | | | | 24.7 | 224.4 | 49.5 | 224.4 | | | | 1.5 | 3.0 | | | 74.8 | 37.4 | | | | |
| | | | | | | | | | | | | | | 330.3 | 2995.9 | 660.6 | 2995.9 | | | | 19.8 | 39.6 | | | 950.4 | 475.2 | | | | TOTALS |

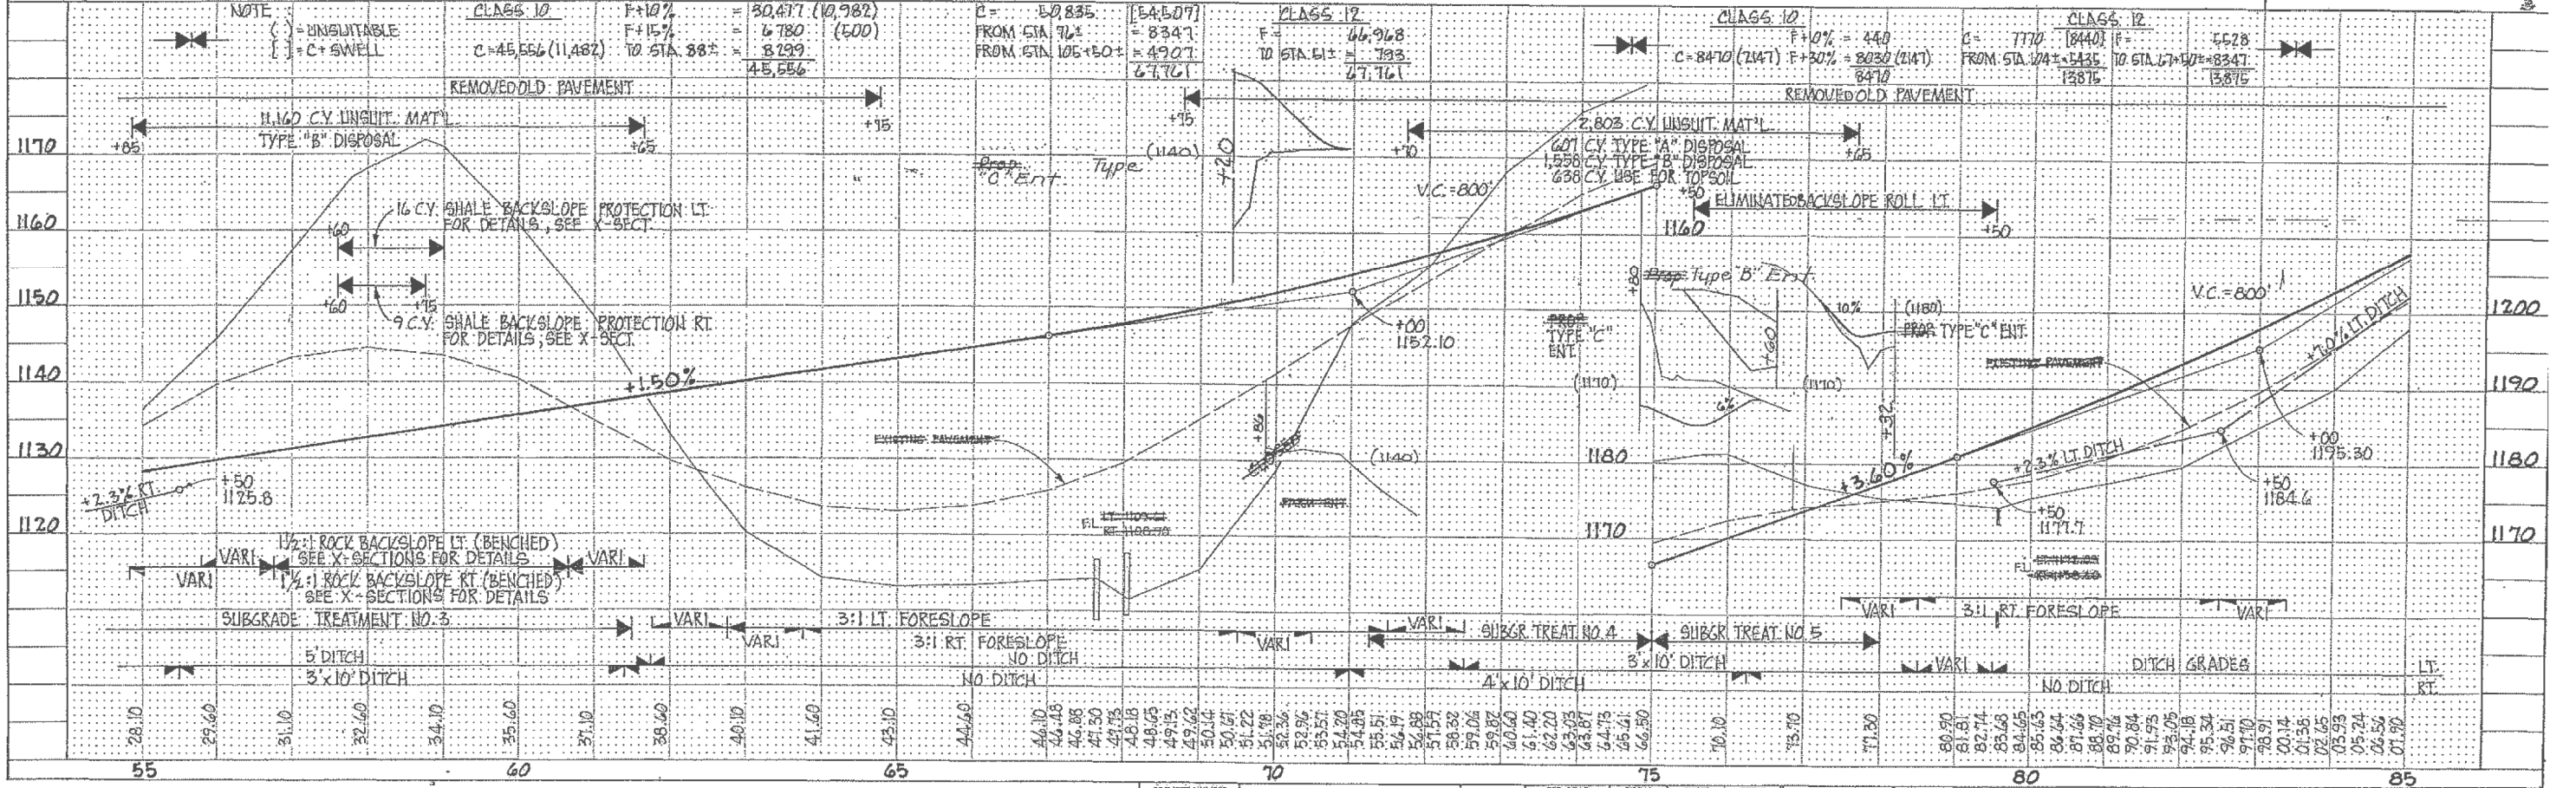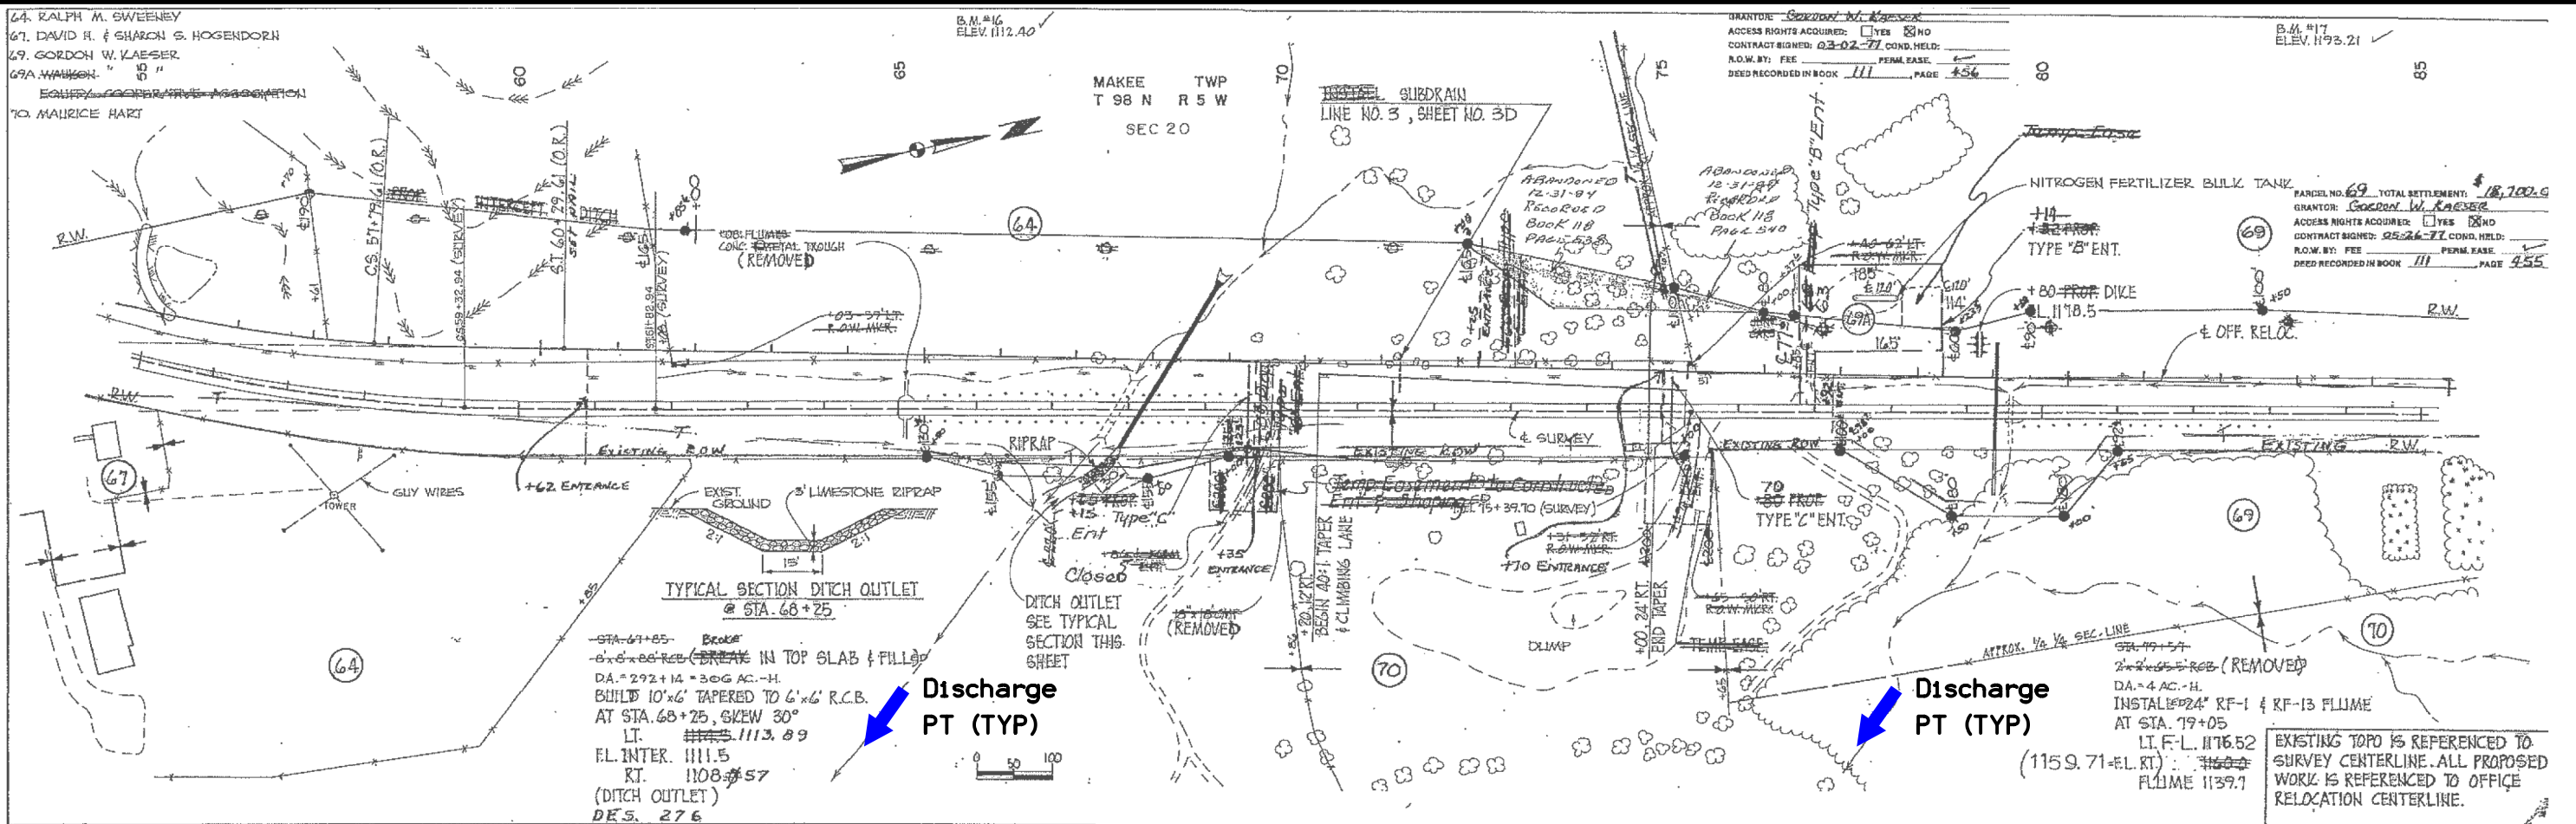

| CLASS | DESCRIPTION | FROM STA. | TO STA. | AMOUNT |
|----------|----------------------|-----------|---------|--------|
| CLASS 10 | REMOVED OLD PAVEMENT | 70 | 105 | 10,982 |
| CLASS 12 | REMOVED OLD PAVEMENT | 105 | 150 | 1,000 |
| CLASS 10 | REMOVED OLD PAVEMENT | 174 | 214 | 4,440 |
| CLASS 12 | REMOVED OLD PAVEMENT | 174 | 214 | 1,387 |

69 GORDON W. KAESER
70 MAURICE HART
71 OLIVER & MARGERY RODERICK

BM. 17 X
ELEV. 1238.30

Discharge
PT (TYP)

PARCEL NO. 71 TOTAL SETTLEMENT = 2,500.00
GRANTOR: OLIVER & RODERICK
ACCESS RIGHTS ACQUIRED: YES NO
CONTRACT SIGNED: 8-18-77 COND. HELD:
R.O.W. BY: FEE PERM. EASE
DEED RECORDED IN BOOK 107 PAGE 81-83

PARCEL NO. 70 TOTAL SETTLEMENT: \$865.00
GRANTOR: MAURICE HART
ACCESS RIGHTS ACQUIRED: YES NO
CONTRACT SIGNED: 2-21-78 COND. HELD:
R.O.W. BY: FEE PERM. EASE
DEED RECORDED IN BOOK 111 PAGE 457

INSTALL SUBDRAIN
LINE NO. 4, SHEET NO. 3D


STA. 95+50 Breaker
INSTALL 24" x 16" RCP (REMOVED)
DA = 14 AC. - R.
INSTALL 24" RF-1 & RF-13 FLUME
AT STA. 94+90, SKEW 5°
FLUME 1216.7
F.L. RT. 1234.35
RT. 1257.26

CURVE DATA (OFF RELOC.)
ΔC = 12°15'30"
D = 2°00'00"
T = 307.63'
L = 412.92'
E = 16.41'
R = 2,864.19'
S = 8.065'
C = 245'
Δ = 16°15'30"
Ts = 2°00'00"
Ls = 200'
Ts = 509.29'
Es = 29.66'
Xc = 199.98'
Yc = 2.33'
LT = 133.34'
ST = 66.67'
LC = 199.99'
P = 0.58'
K = 100.00'

CURVE DATA (SURVEY)
Δ = 17°17'30" RT.
Ts = 2°00'00"
Ls = 435.60'
Ts = 884.53'
Es = 32.93'
Xc = 2864.79'

STA. 10+74
INSTALL 24" RF-1 & RF-13 FLUME
AT STA. 11+25, SKEW 15°
LT. 1312.78
F.L. RT. 1312.78
FLUME 1300.2



EXISTING TOPO IS REFERENCED TO SURVEY CENTERLINE. ALL PROPOSED WORK IS REFERENCED TO OFFICE RELOCATION CENTERLINE.

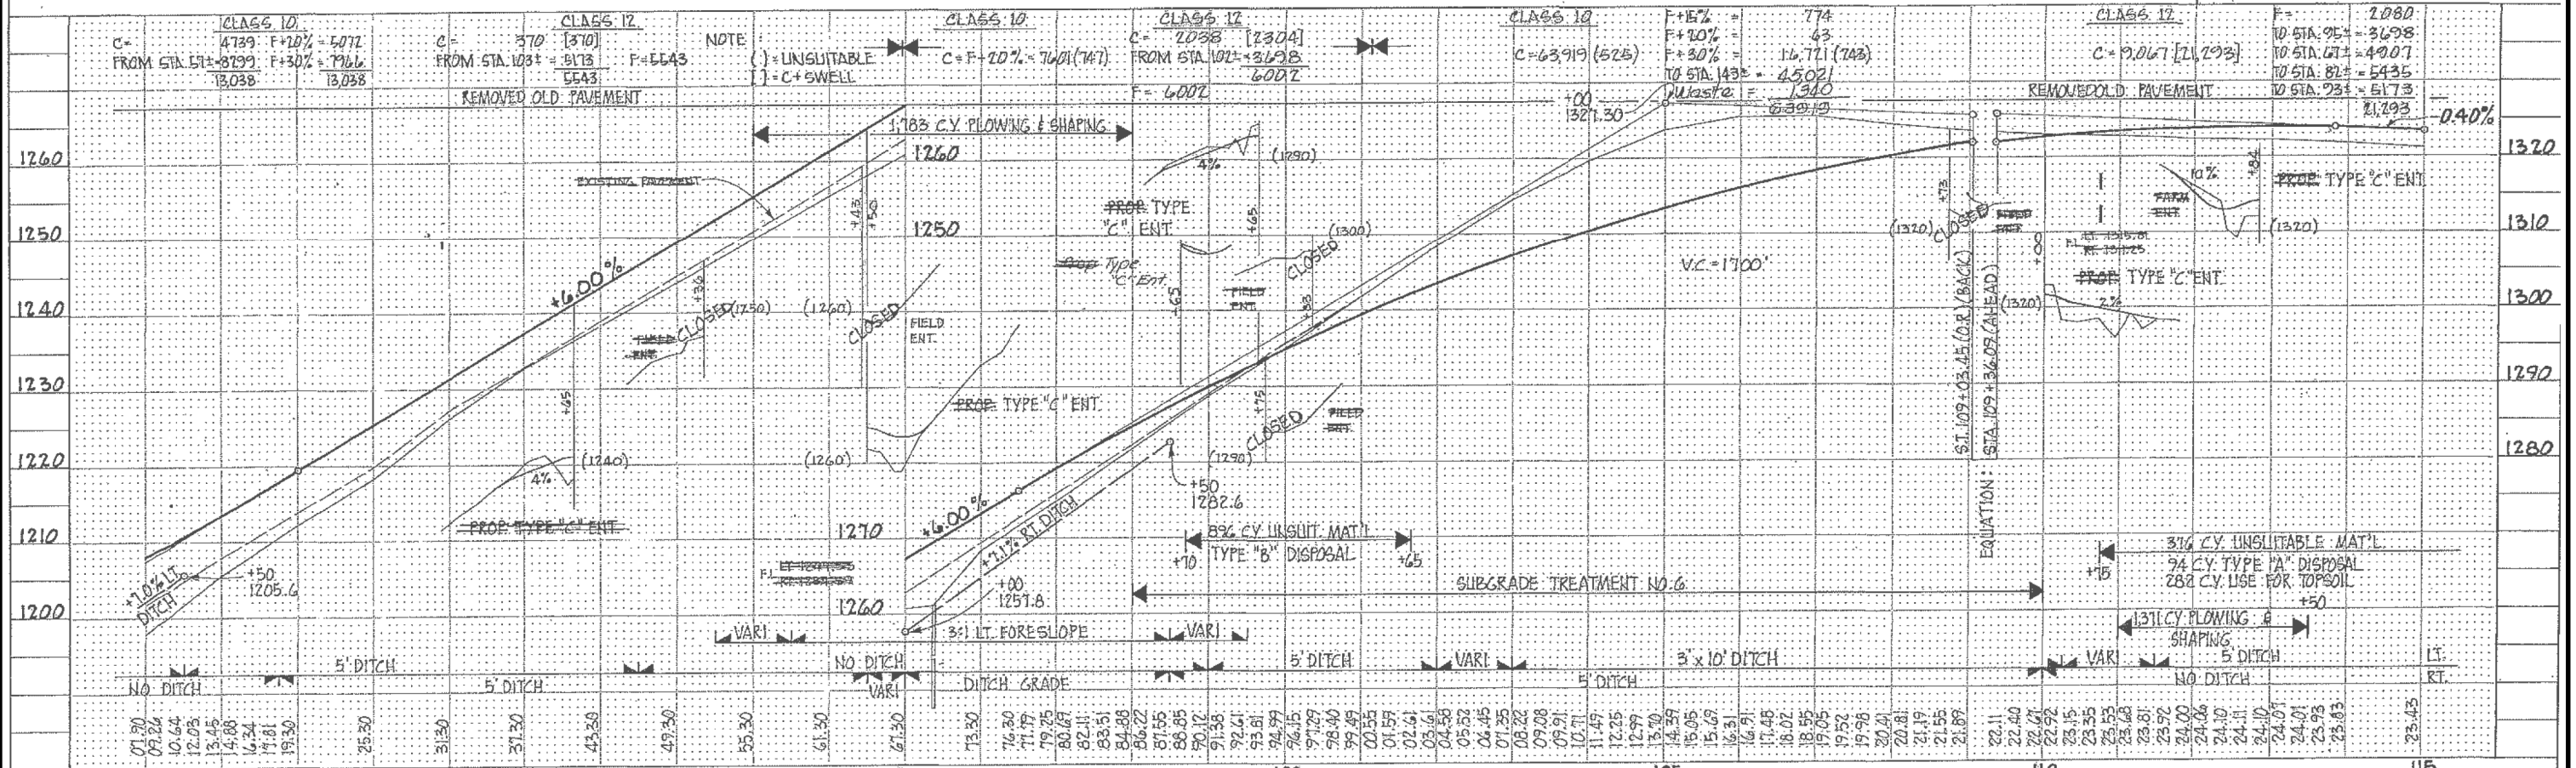

AS-BUILT PLANS, FOR INFORMATION ONLY

ALLAMAKEE COUNTY

| | | | | | | | | | | |
|-------|---------------------|-------------|-----------|--------------|------------------|-------|---------------------|-------------|-----------|--------------|
| STATE | FED. ROAD DIST. NO. | FISCAL YEAR | SHEET NO. | TOTAL SHEETS | PROJECT NUMBER | STATE | FED. ROAD DIST. NO. | FISCAL YEAR | SHEET NO. | TOTAL SHEETS |
| IOWA | | | | | F-9-9(14)--20-03 | IOWA | | | 11 | 24 |

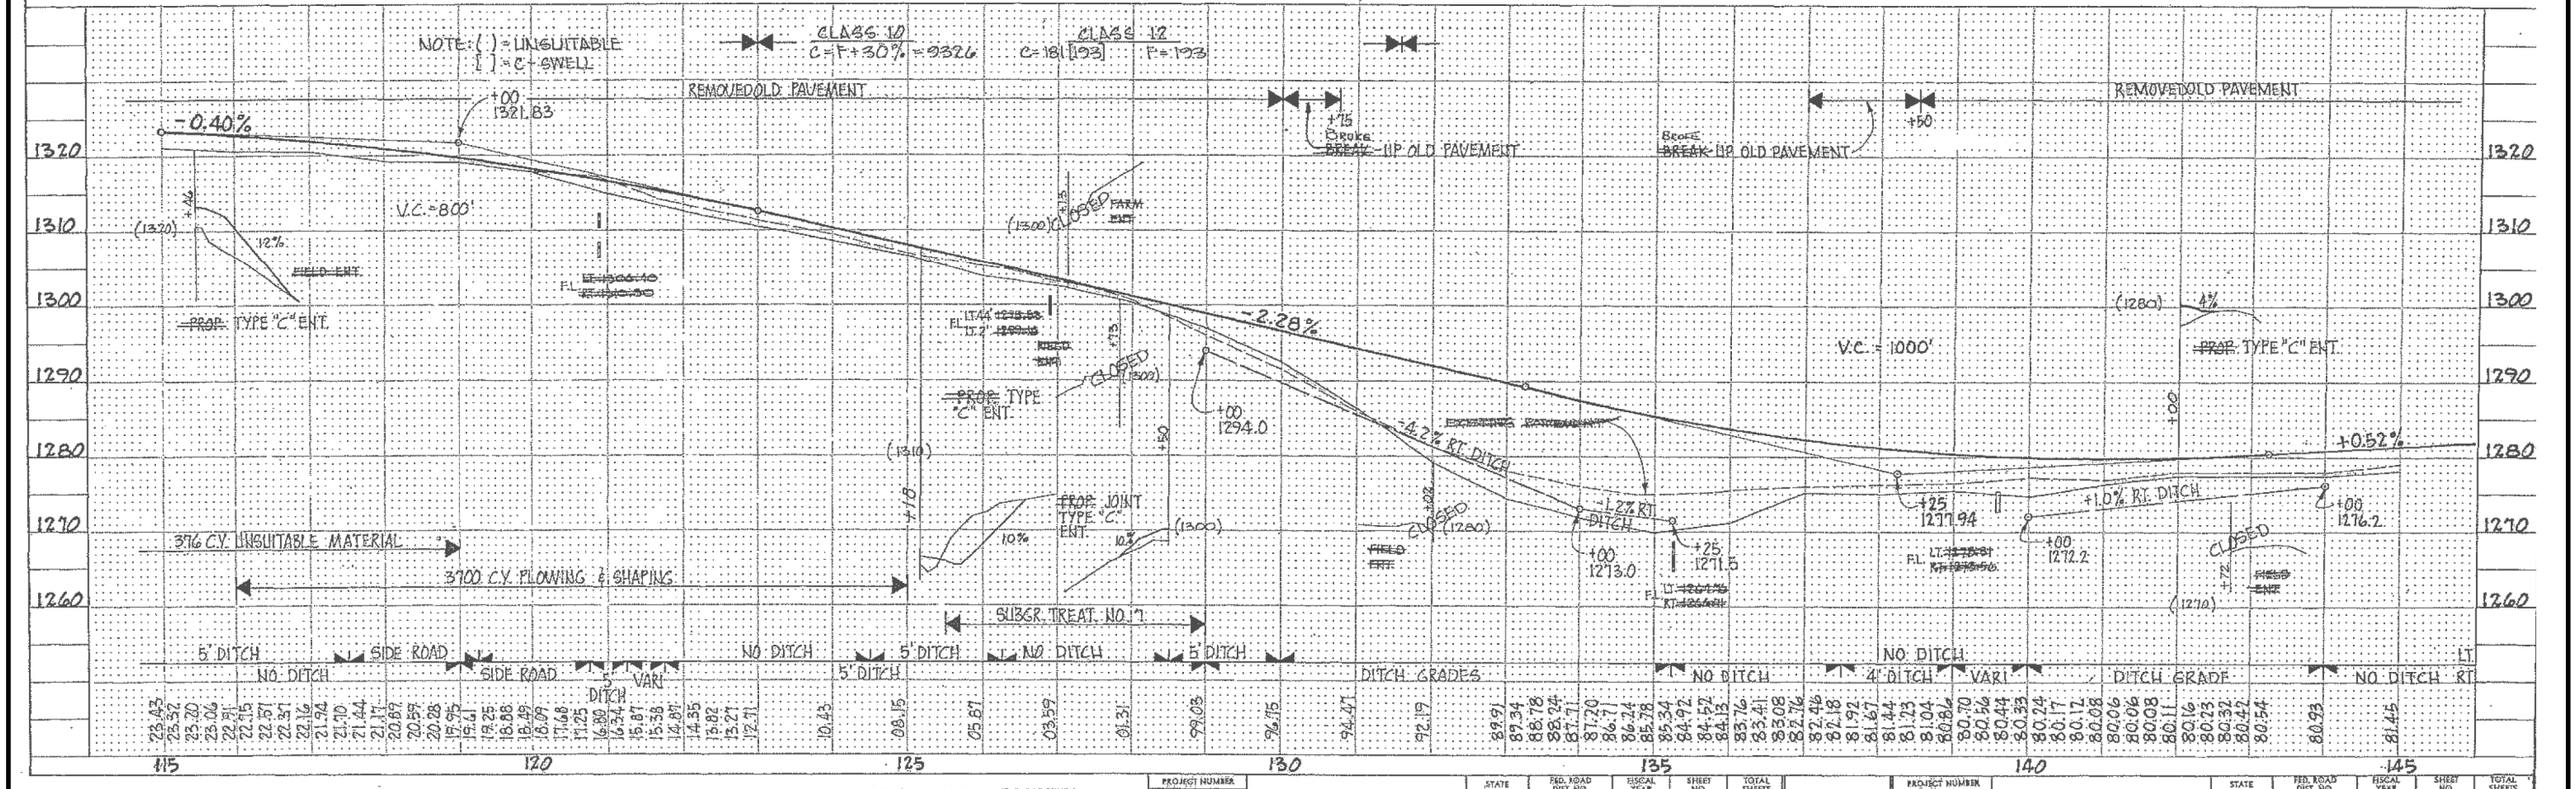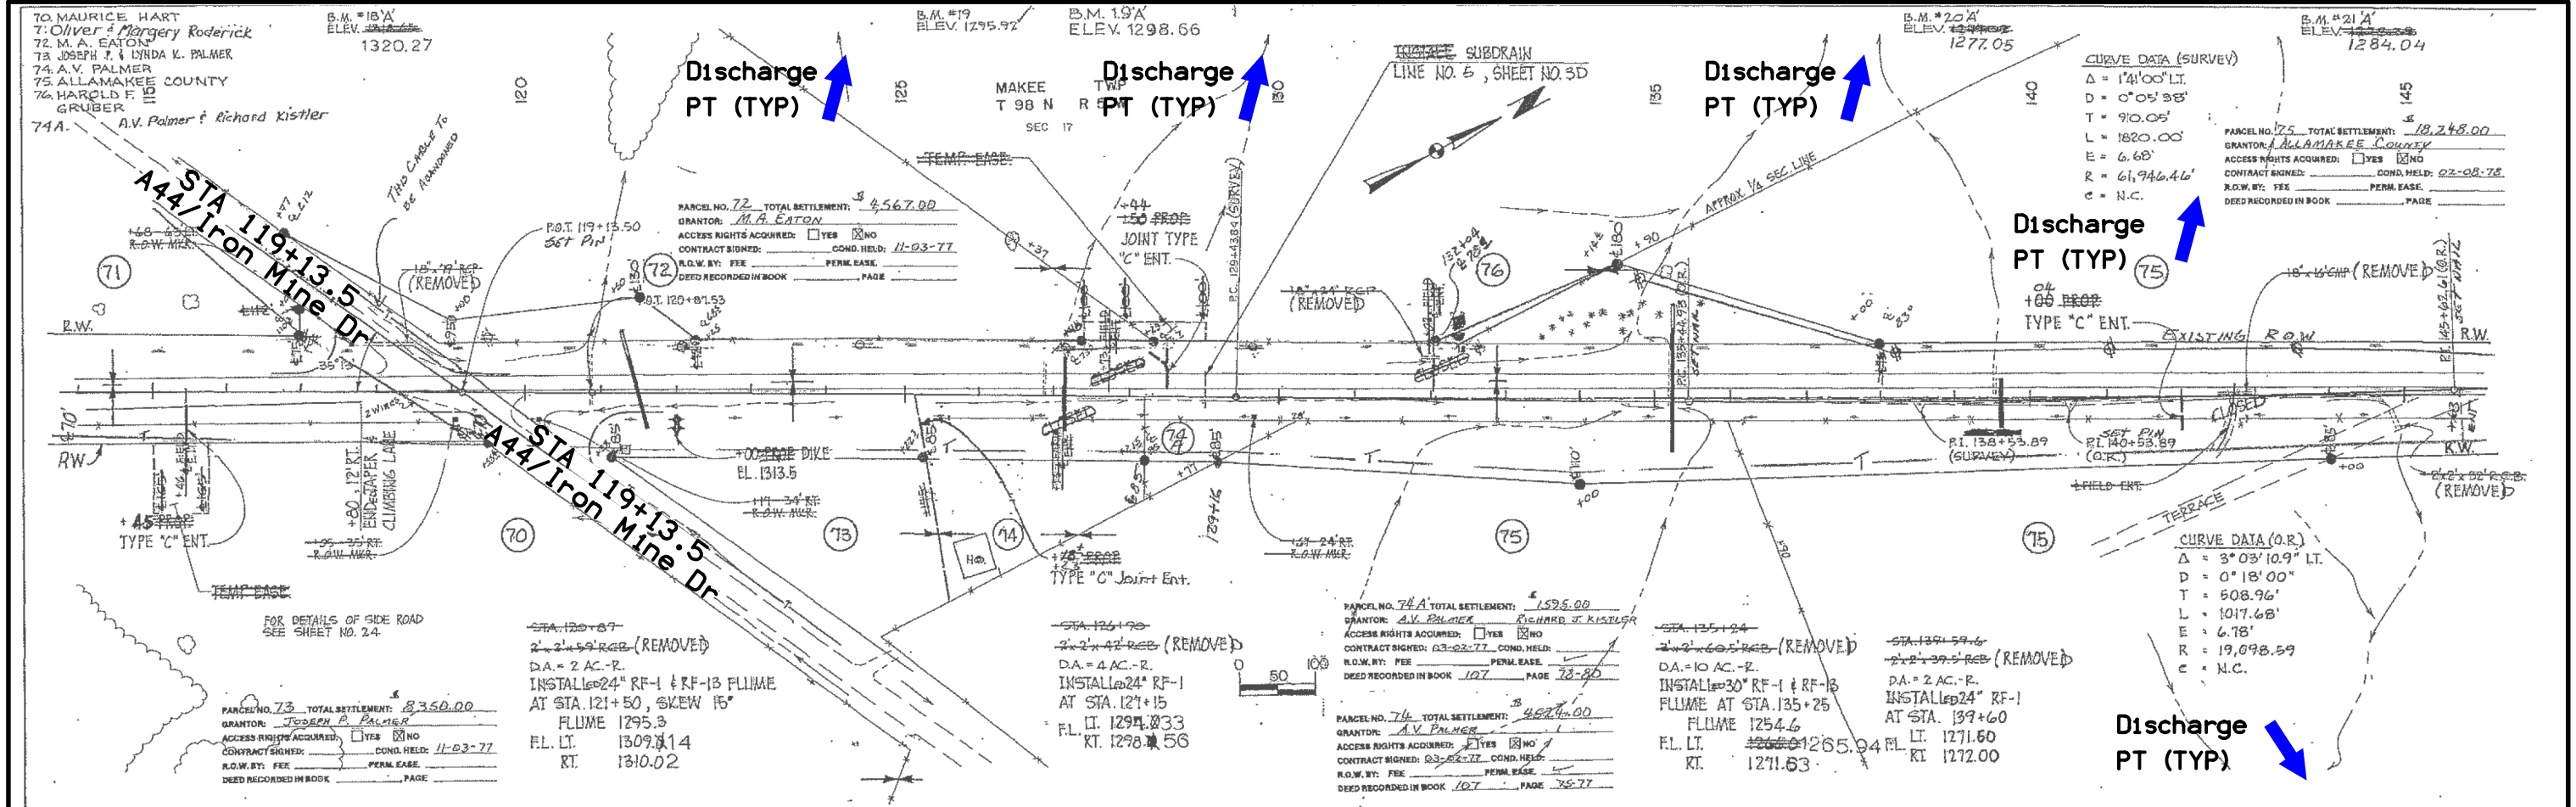


AS-BUILT PLANS, FOR INFORMATION ONLY

ALLAMAKEE COUNTY

| STATE | FED. ROAD DIST. NO. | FISCAL YEAR | SHEET NO. | TOTAL SHEETS |
|-------|---------------------|-------------|-----------|--------------|
| IOWA | | | | |

PROJECT NUMBER F-9-9(14)--20-03

| STATE | FED. ROAD DIST. NO. | FISCAL YEAR | SHEET NO. | TOTAL SHEETS |
|-------|---------------------|-------------|-----------|--------------|
| IOWA | | | 12 | 241 |

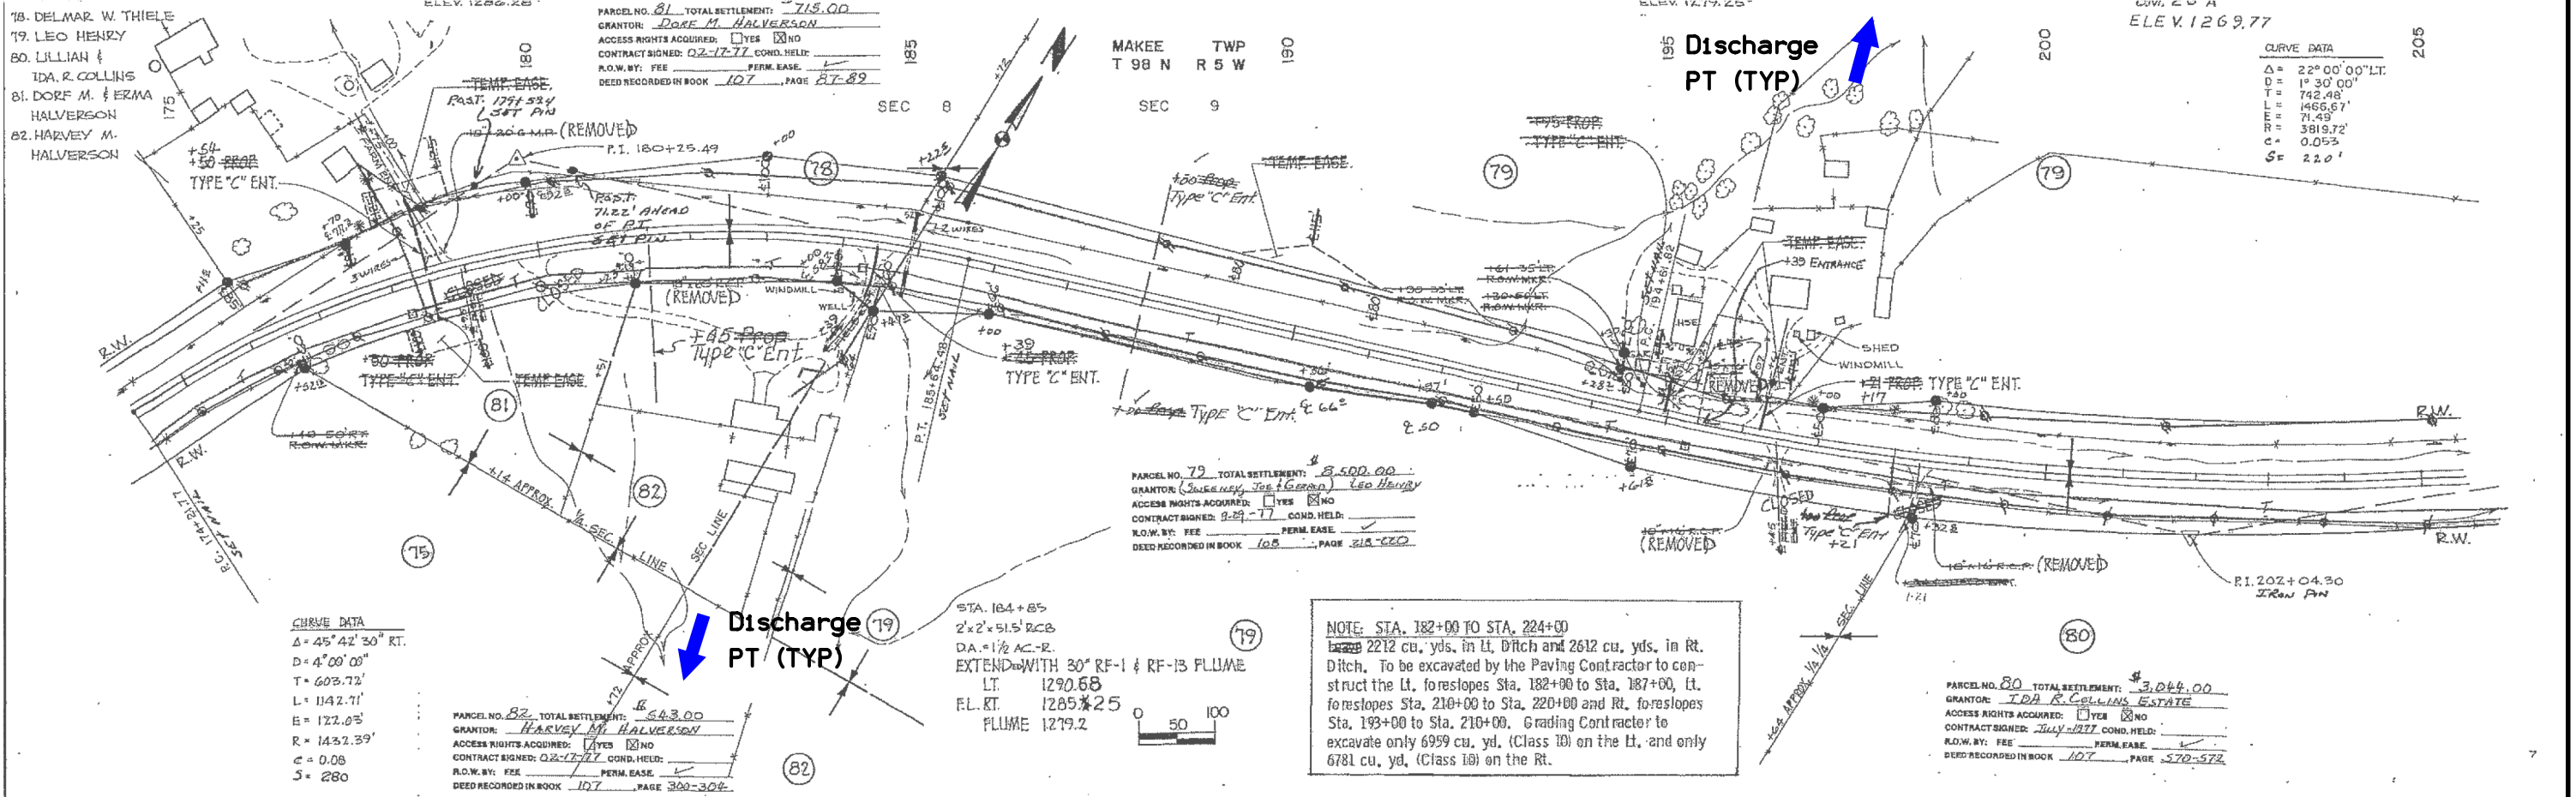

CURVE DATA
 Δ = 45° 42' 30" RT.
 D = 4' 00" 00"
 T = 603.72'
 L = 1142.71'
 E = 122.85'
 R = 1432.39'
 C = 0.08
 SF = 280

PARCEL NO. 82 TOTAL SETTLEMENT: \$54,300
 GRANTOR: HARVEY M. HALVERSON
 ACCESS RIGHTS ACQUIRED: YES NO
 CONTRACT SIGNED: 02-17-17 COND. HELD:
 R.O.W. BY: FEE PERM. EASE:
 DEED RECORDED IN BOOK 107 PAGE 300-304

STA. 184+85
 2' x 2' x 51.5' RCB
 D.A. = 1/2 AC-2
 EXTEND WITH 30° RF-1 & RF-13 PLUME
 LT. 1290.68
 F.L. RT. 1285.25
 PLUME 1279.2

NOTE: STA. 182+00 TO STA. 224+00
 Excavate 2212 cu. yds. in Lt. Ditch and 2612 cu. yds. in Rt. Ditch. To be excavated by the Paving Contractor to construct the Lt. foreslopes Sta. 182+00 to Sta. 187+00, Lt. foreslopes Sta. 210+00 to Sta. 220+00 and Rt. foreslopes Sta. 193+00 to Sta. 210+00. Grading Contractor to excavate only 6999 cu. yd. (Class 10) on the Lt. and only 6781 cu. yd. (Class 10) on the Rt.

PARCEL NO. 80 TOTAL SETTLEMENT: \$3,044.00
 GRANTOR: IDA R. COLLINS ESTATE
 ACCESS RIGHTS ACQUIRED: YES NO
 CONTRACT SIGNED: July-1917 COND. HELD:
 R.O.W. BY: FEE PERM. EASE:
 DEED RECORDED IN BOOK 107 PAGE 570-572


| LEFT | CLASS 12 | F = 0 | TO STA. 169+ = 42 | CLASS 10 (See Note Above) | F = 50% | TO STA. 170+ = 91 | CLASS 12 | F = 0 | TO STA. 170+ = 91 | NOTE: () = UNSUITABLE [] = C + SWELL | RIGHT |
|------|-------------|-------|-------------------|--|---------|-------------------|-------------|-------|-------------------|---|----------|
| 1300 | C = 96 [42] | | | C = 9171 (58) Retain for Paving: 2212 (58) 91.77 | | | C = 80 [91] | | | CLASS 10 F=50% (See Note Above) TO STA. 228+ = 2211 TO STA. 232+ = 312 Retain for Paving: 2612 9393 | 1300 |
| 1290 | | | | 58 CY UNSUIT. MARL (LT) TYPE 'B' DISPOSAL | | | | | | ELIMINATED BACKSLOPE ROLL LEFT | 1290 |
| 1280 | | | | | | | | | | | 1280 |
| 1270 | | | | | | | | | | | 1270 |
| 1260 | | | | | | | | | | | 1260 |
| 1250 | | | | | | | | | | | 1250 |
| 1240 | | | | | | | | | | | 1240 |
| | 4' DITCH | | | 4' DITCH | | | | | | | LT RT |

AS-BUILT PLANS, FOR INFORMATION ONLY

ALLAMAKEE COUNTY

| | | | | | | | | | | |
|-------|---------------------|-------------|-----------|--------------|------------------|-------|---------------------|-------------|-----------|--------------|
| STATE | FED. ROAD DIST. NO. | FISCAL YEAR | SHEET NO. | TOTAL SHEETS | PROJECT NUMBER | STATE | FED. ROAD DIST. NO. | FISCAL YEAR | SHEET NO. | TOTAL SHEETS |
| IOWA | 5 | | | | F-9-9(14)--20-03 | IOWA | 5 | | 12 | 741 |

76. IRVIN C. BANGS ESTATE (FEE), FRANCIS C. REGAN (C.P.)
 101. HERMAN H. KERNDT (FEE), DONALD W. KERNDT (C.P.)
 102. DONALD R. ALDRICH (C.P.)

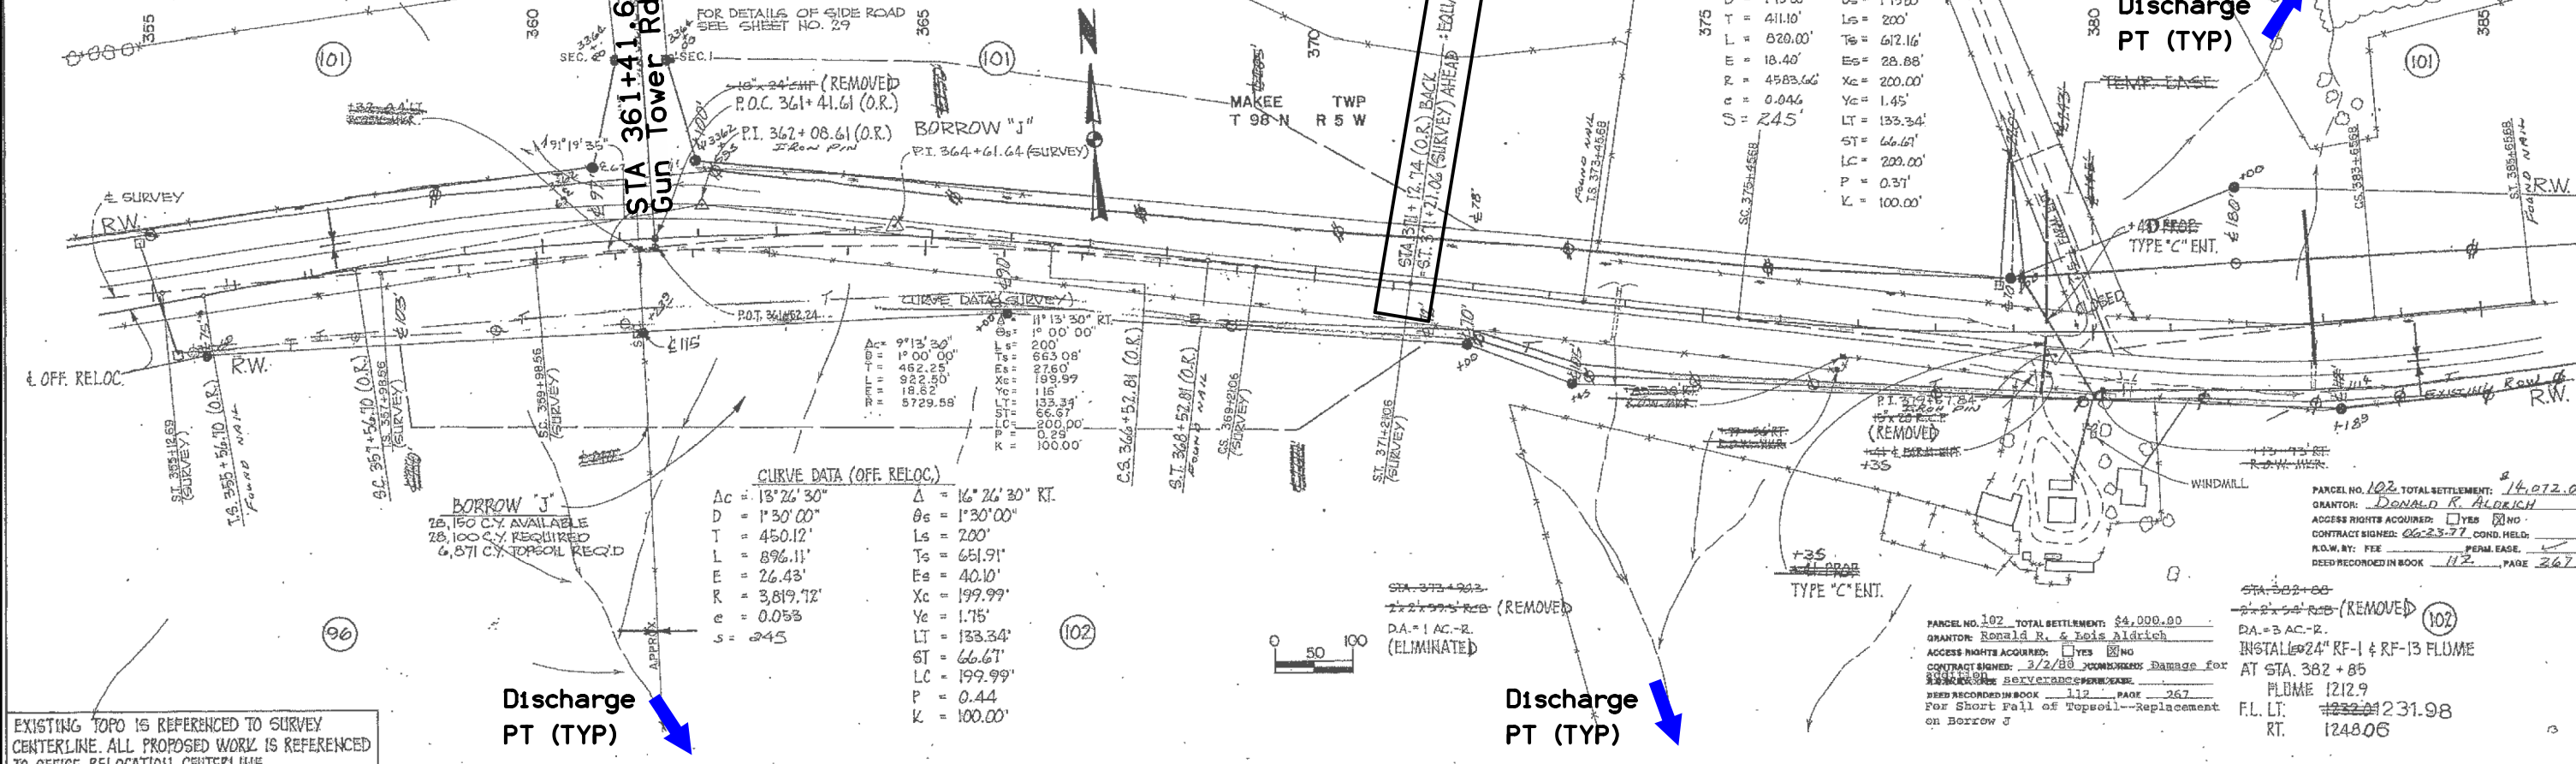

CURVE DATA (SURVEY)

| | |
|----------------|------------------|
| Δc = 10°15'00" | Δ = 12°45'00" LT |
| D = 1°15'00" | θs = 1°15'00" |
| T = 411.10' | Ls = 200' |
| E = 820.00' | Ts = 612.16' |
| M = 18.40' | Eθ = 28.88' |
| R = 4583.66' | Xc = 200.00' |
| α = 0.046 | Yc = 1.45' |
| U = 245' | LT = 133.34' |
| | ST = 66.67' |
| | LC = 200.00' |
| | P = 0.31' |
| | K = 100.00' |


CURVE DATA (OFF RELOC.)

| | |
|----------------|------------------|
| Δc = 13°26'30" | Δ = 16°26'30" RT |
| D = 1°30'00" | θs = 1°30'00" |
| T = 450.12' | Ls = 200' |
| E = 896.11' | Ts = 651.91' |
| M = 26.43' | Eθ = 40.10' |
| R = 3,819.72' | Xc = 199.99' |
| α = 0.053 | Yc = 1.75' |
| s = 245 | LT = 133.34' |
| | ST = 66.67' |
| | LC = 199.99' |
| | P = 0.44' |
| | K = 100.00' |


CURVE DATA (OFF RELOC.)

| | |
|----------------|------------------|
| Δc = 13°26'30" | Δ = 16°26'30" RT |
| D = 1°30'00" | θs = 1°30'00" |
| T = 450.12' | Ls = 200' |
| E = 896.11' | Ts = 651.91' |
| M = 26.43' | Eθ = 40.10' |
| R = 3,819.72' | Xc = 199.99' |
| α = 0.053 | Yc = 1.75' |
| s = 245 | LT = 133.34' |
| | ST = 66.67' |
| | LC = 199.99' |
| | P = 0.44' |
| | K = 100.00' |

EXISTING TOPO IS REFERENCED TO SURVEY CENTERLINE. ALL PROPOSED WORK IS REFERENCED TO OFFICE RELOCATION CENTERLINE.

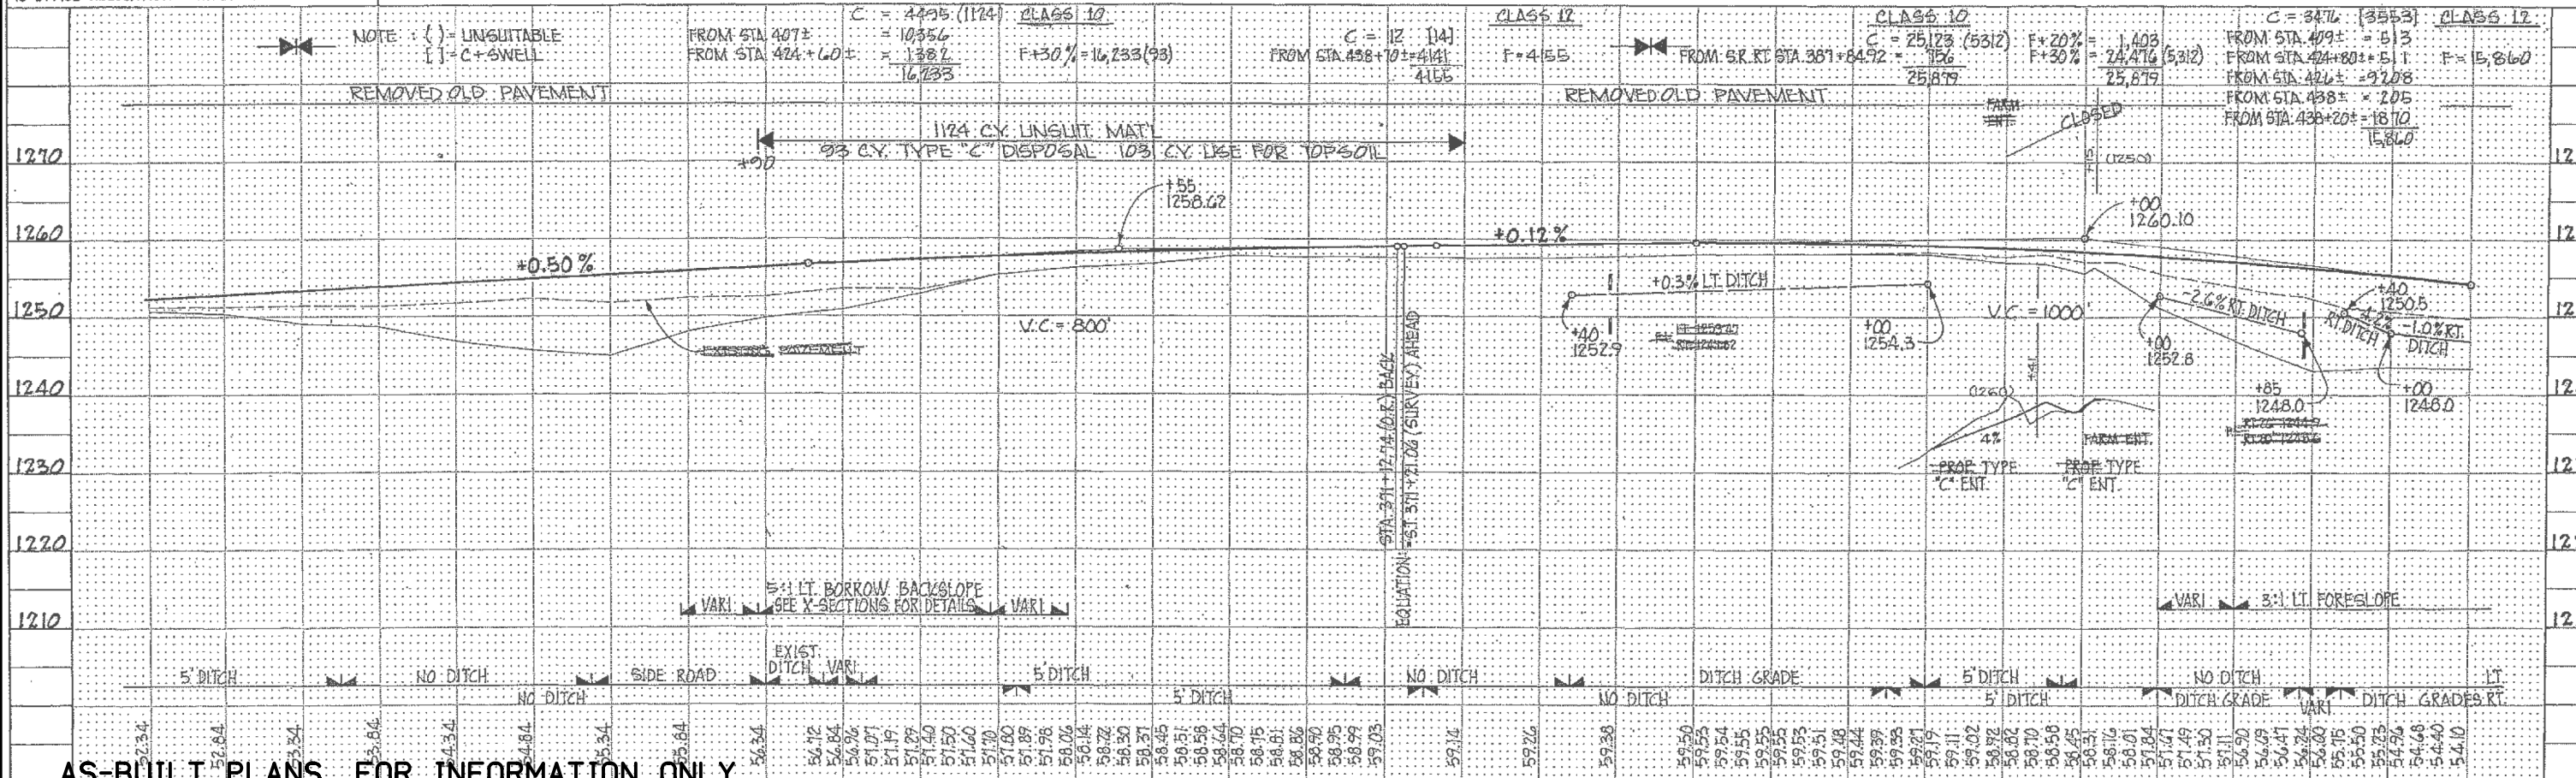

| | | | | | | |
|-----|-----|-----|-----|-----|-----|-----|
| 355 | 360 | 365 | 370 | 375 | 380 | 385 |
|-----|-----|-----|-----|-----|-----|-----|

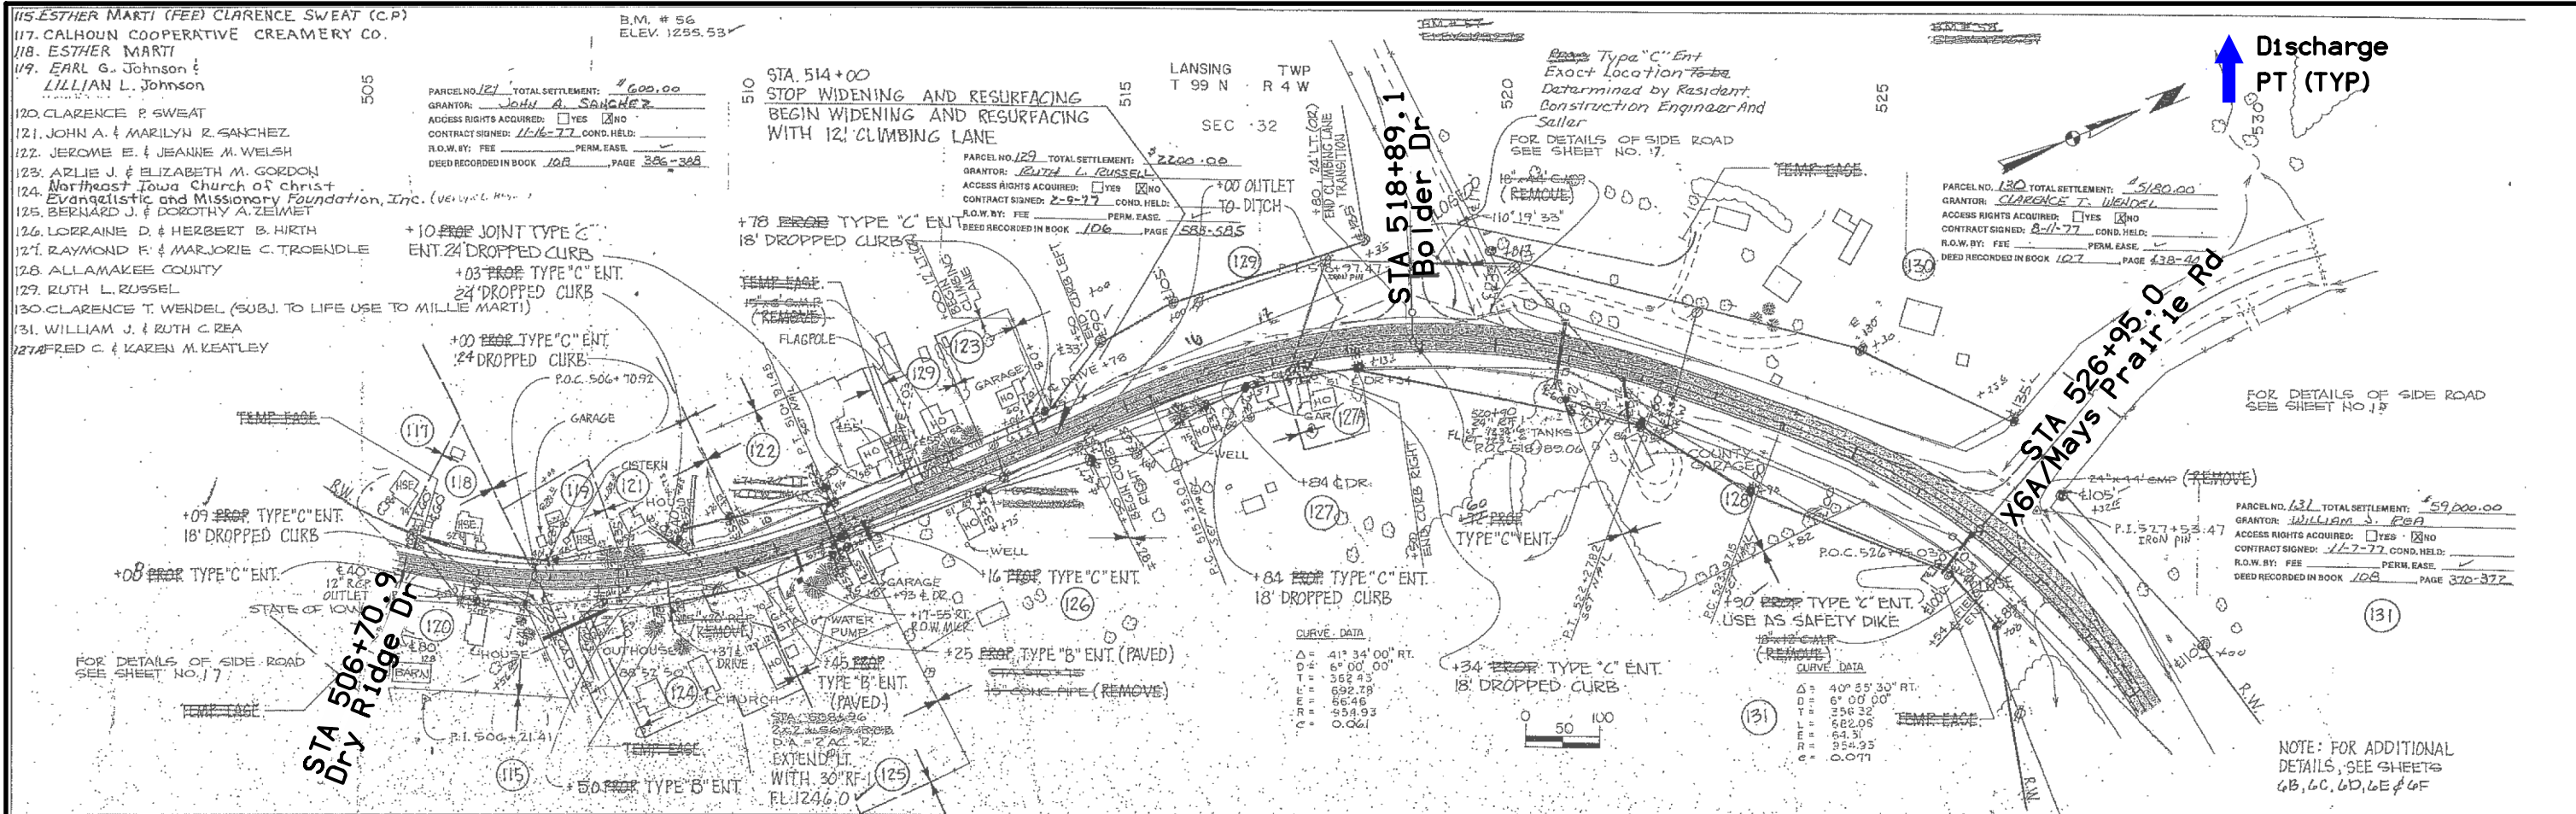

| STATION | CLASS 10 | CLASS 10 | CLASS 12 | CLASS 10 | CLASS 12 | CLASS 10 | CLASS 12 |
|---------|-------------------------------------|-----------------------------|-------------------------------------|-------------------------------------|--|-------------------------------------|-------------------------------------|
| 505 | C = F + 50% = 440 | REMOVE OLD PAVEMENT | C = 157 [16] | C = F + 20% = 2347 | SEE CROSS SECTIONS FOR DETAILS OF LT BACKSLOPE | C = 1776 [18,202] | C = 1776 [18,202] |
| 510 | PROF. TYPE "C" ENT. 24 DROPPED CURB | PROF. TYPE "B" ENT. (PAVED) | PROF. TYPE "C" ENT. 18 DROPPED CURB | PROF. TYPE "C" ENT. 18 DROPPED CURB | PROF. TYPE "C" ENT. 18 DROPPED CURB | PROF. TYPE "C" ENT. 18 DROPPED CURB | PROF. TYPE "C" ENT. 18 DROPPED CURB |
| 515 | PROF. TYPE "C" ENT. 24 DROPPED CURB | PROF. TYPE "B" ENT. (PAVED) | PROF. TYPE "C" ENT. 18 DROPPED CURB | PROF. TYPE "C" ENT. 18 DROPPED CURB | PROF. TYPE "C" ENT. 18 DROPPED CURB | PROF. TYPE "C" ENT. 18 DROPPED CURB | PROF. TYPE "C" ENT. 18 DROPPED CURB |
| 520 | PROF. TYPE "C" ENT. 24 DROPPED CURB | PROF. TYPE "B" ENT. (PAVED) | PROF. TYPE "C" ENT. 18 DROPPED CURB | PROF. TYPE "C" ENT. 18 DROPPED CURB | PROF. TYPE "C" ENT. 18 DROPPED CURB | PROF. TYPE "C" ENT. 18 DROPPED CURB | PROF. TYPE "C" ENT. 18 DROPPED CURB |
| 525 | PROF. TYPE "C" ENT. 24 DROPPED CURB | PROF. TYPE "B" ENT. (PAVED) | PROF. TYPE "C" ENT. 18 DROPPED CURB | PROF. TYPE "C" ENT. 18 DROPPED CURB | PROF. TYPE "C" ENT. 18 DROPPED CURB | PROF. TYPE "C" ENT. 18 DROPPED CURB | PROF. TYPE "C" ENT. 18 DROPPED CURB |
| 530 | PROF. TYPE "C" ENT. 24 DROPPED CURB | PROF. TYPE "B" ENT. (PAVED) | PROF. TYPE "C" ENT. 18 DROPPED CURB | PROF. TYPE "C" ENT. 18 DROPPED CURB | PROF. TYPE "C" ENT. 18 DROPPED CURB | PROF. TYPE "C" ENT. 18 DROPPED CURB | PROF. TYPE "C" ENT. 18 DROPPED CURB |

131. WILLIAM J. & RUTH C. REA
 132. JOHN T. & HAZEL HENNESSY

B.M. #59
 ELEV. 1125.15

B.M. #60A
 ELEV. 1082.38



B.M. #61B
 ELEV. 1013.77

B.M. #62B
 ELEV. 1014.00

LANSING TWP
 T 99 N R 4 W
 SEC 28

CURVE DATA
 Δ = 26° 25' 33" LT.
 D = 77.50 00'
 T = 266.59
 L = 513.00'
 E = 45.18
 P = 753.94'
 C = 0.0860



PARCEL NO. 132 TOTAL SETTLEMENT: \$7645.00
 GRANTEE: JOHN T. HENNESSY
 ACCESS RIGHTS ACQUIRED: YES NO
 CONTRACT SIGNED: 6-28-77 COND. HELD: YES NO
 R.O.W. BY: FEE PERM. EASE
 DEED RECORDED IN BOOK 107 PAGE 414-417

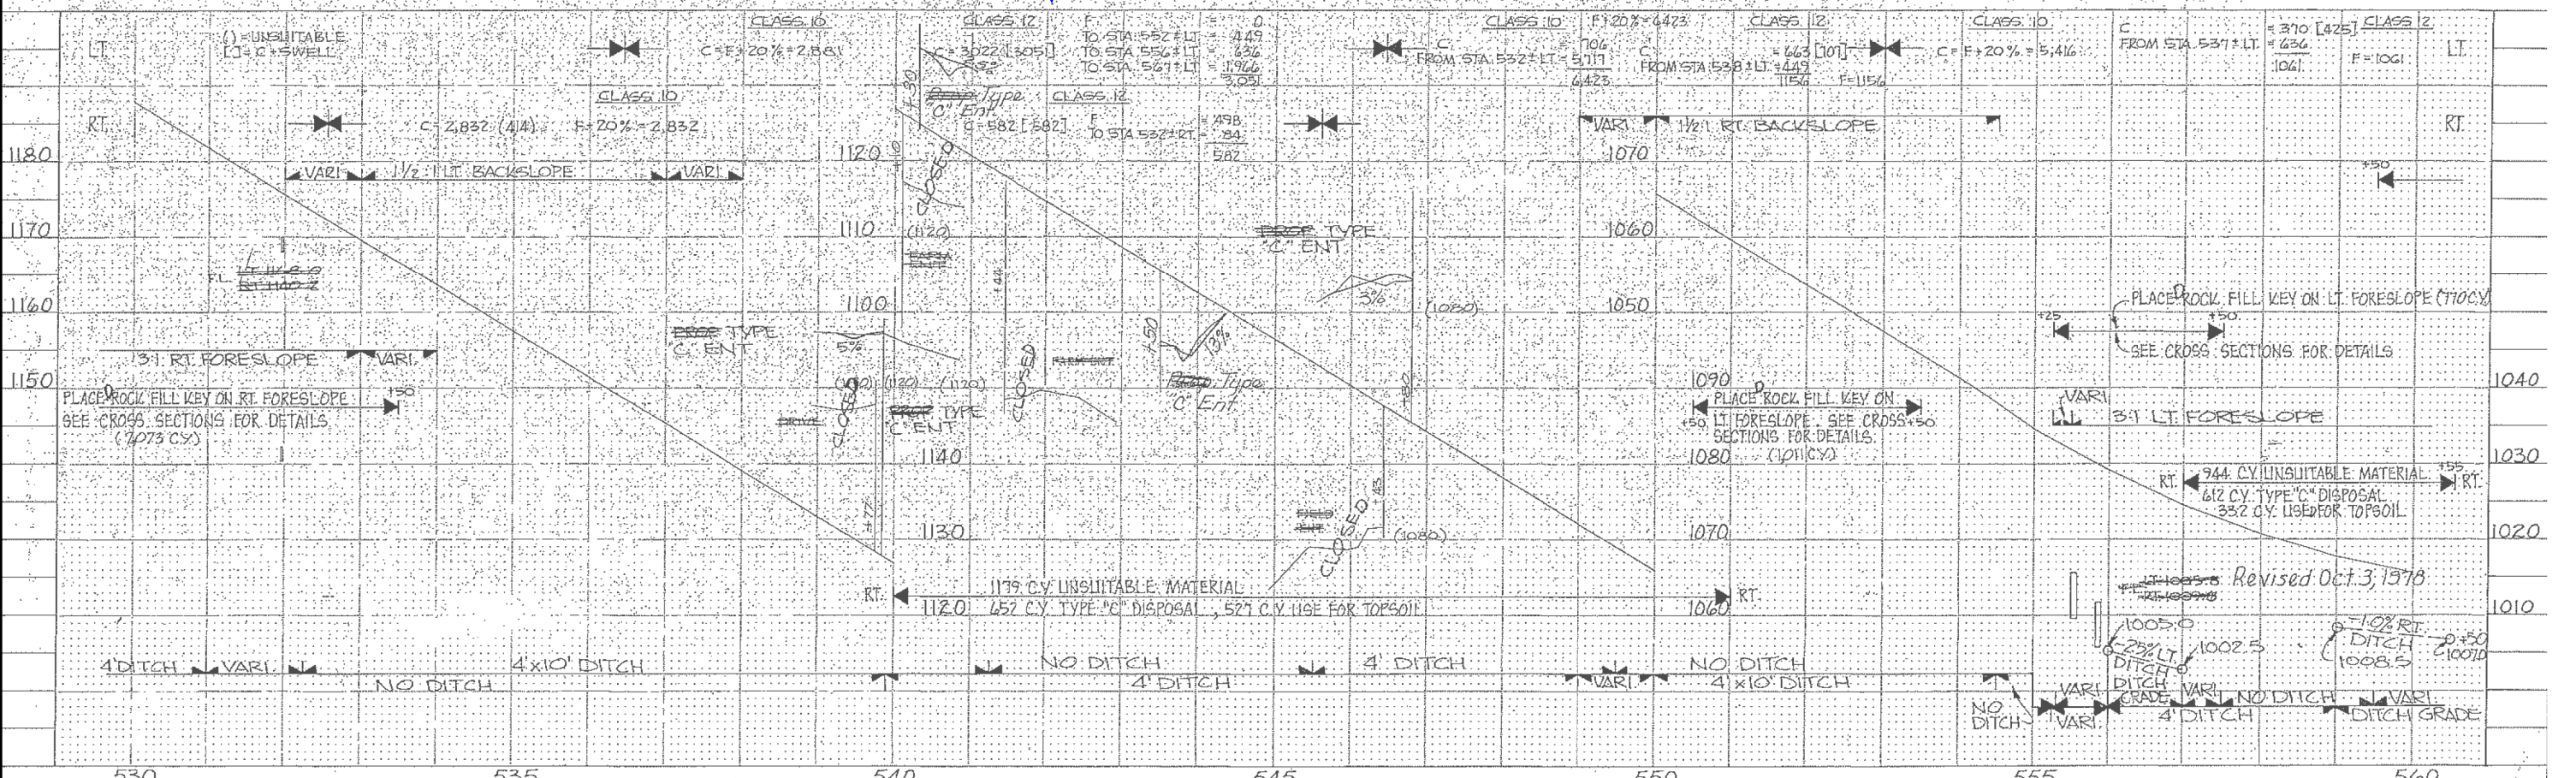
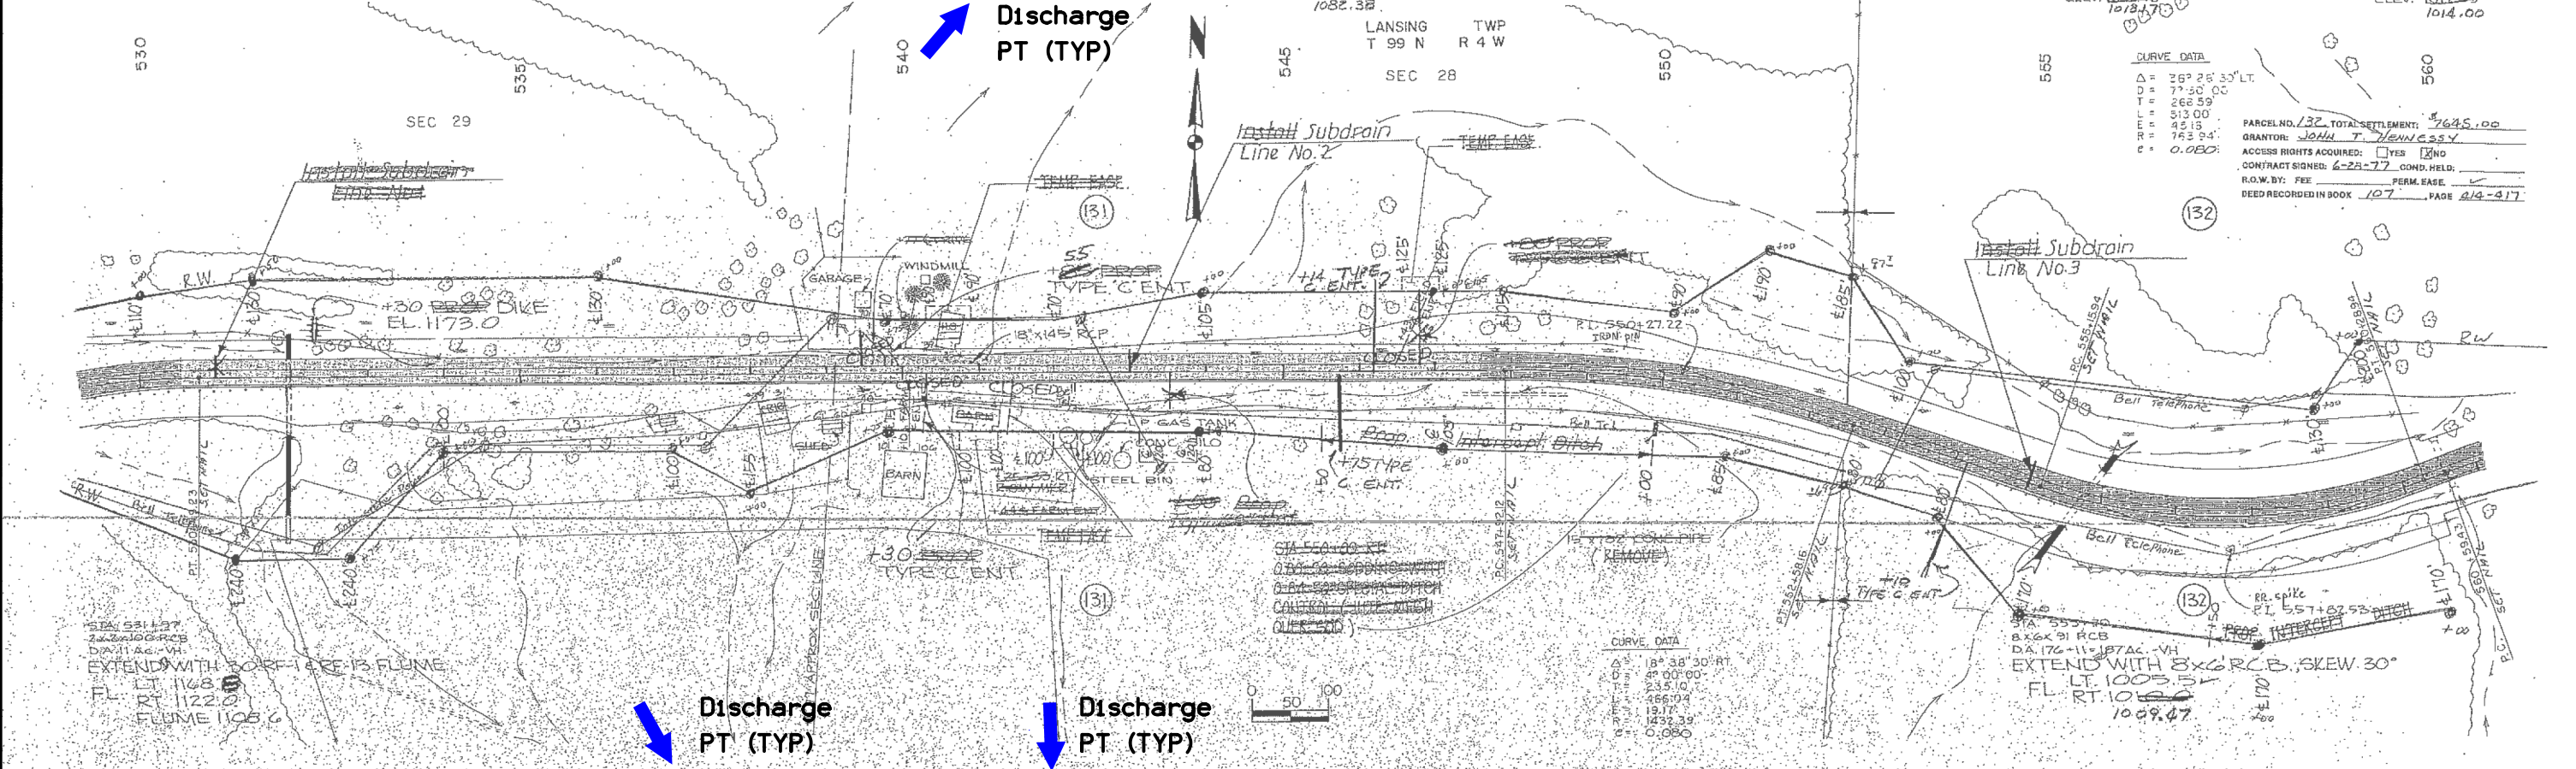


| | | | | | | | | |
|------------------|-----|-----|----------------|-------|---------------------|-------------|-----------|--------------|
| 530 | 535 | 540 | 545 | 550 | 555 | 560 | | |
| ALLAMAKEE COUNTY | | | PROJECT NUMBER | STATE | FED. ROAD DIST. NO. | FISCAL YEAR | SHEET NO. | TOTAL SHEETS |
| | | | | IOWA | 5 | | 7 | 204 |

AS-BUILT PLANS, FOR INFORMATION ONLY



FILE NO. ENGLISH DESIGN TEAM KELLY \ MEISE \ NIE ALLAMAKEE COUNTY PROJECT NUMBER STP-9-9(71)-2C-03/HSIPX-9-9(88)-3L-03 SHEET NUMBER D.19

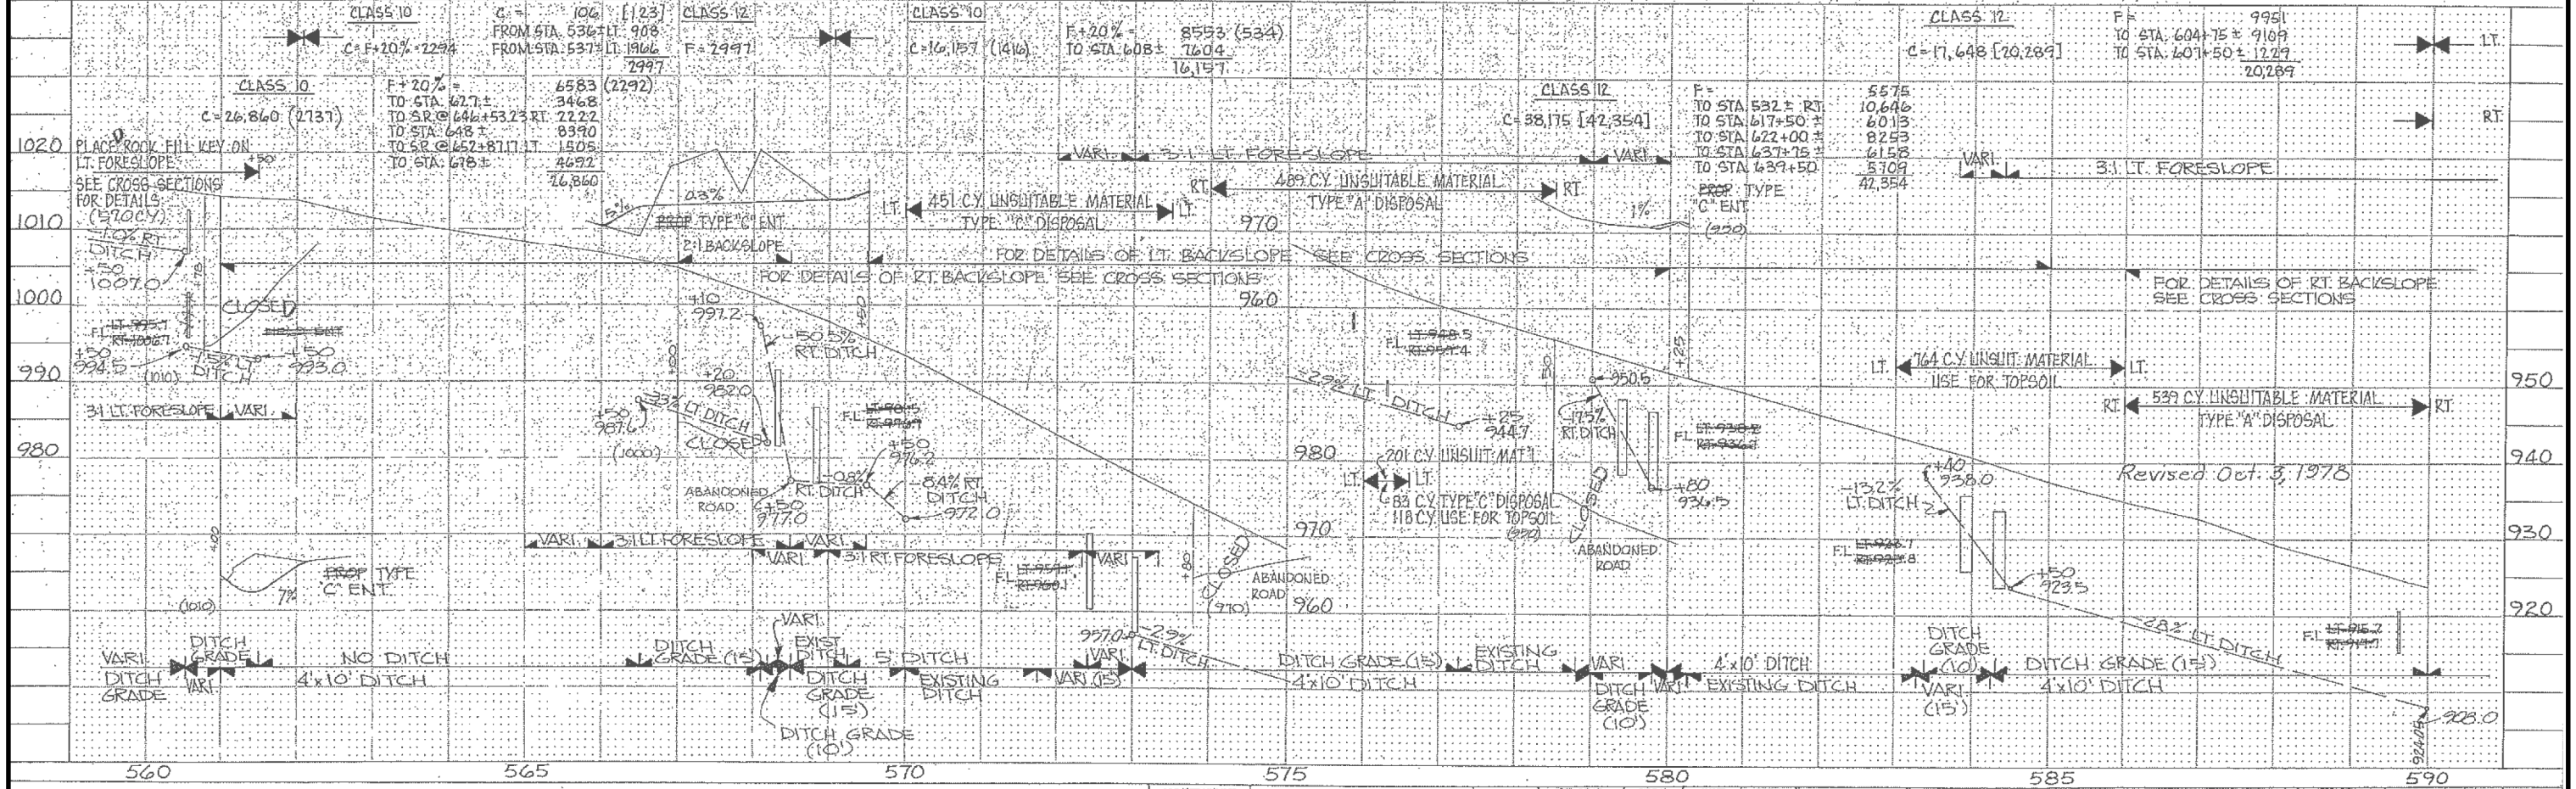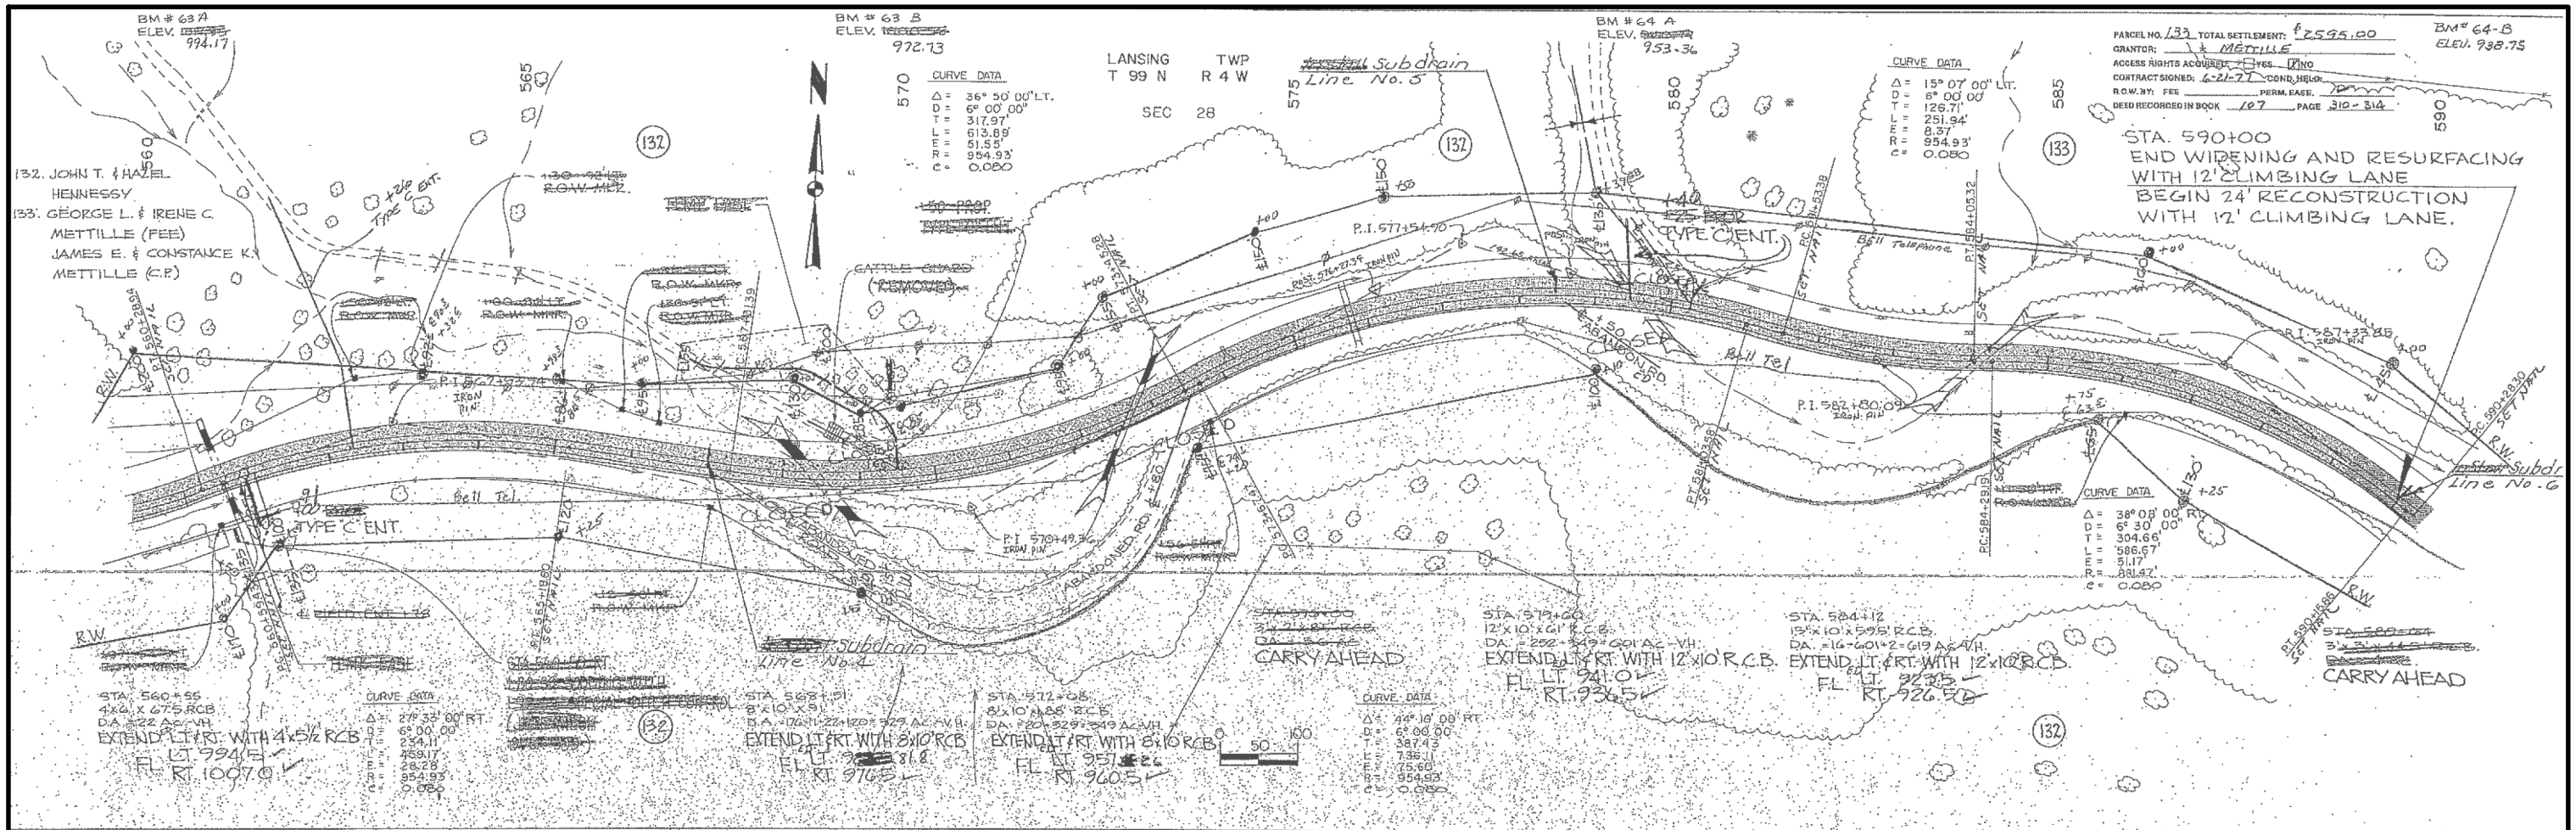

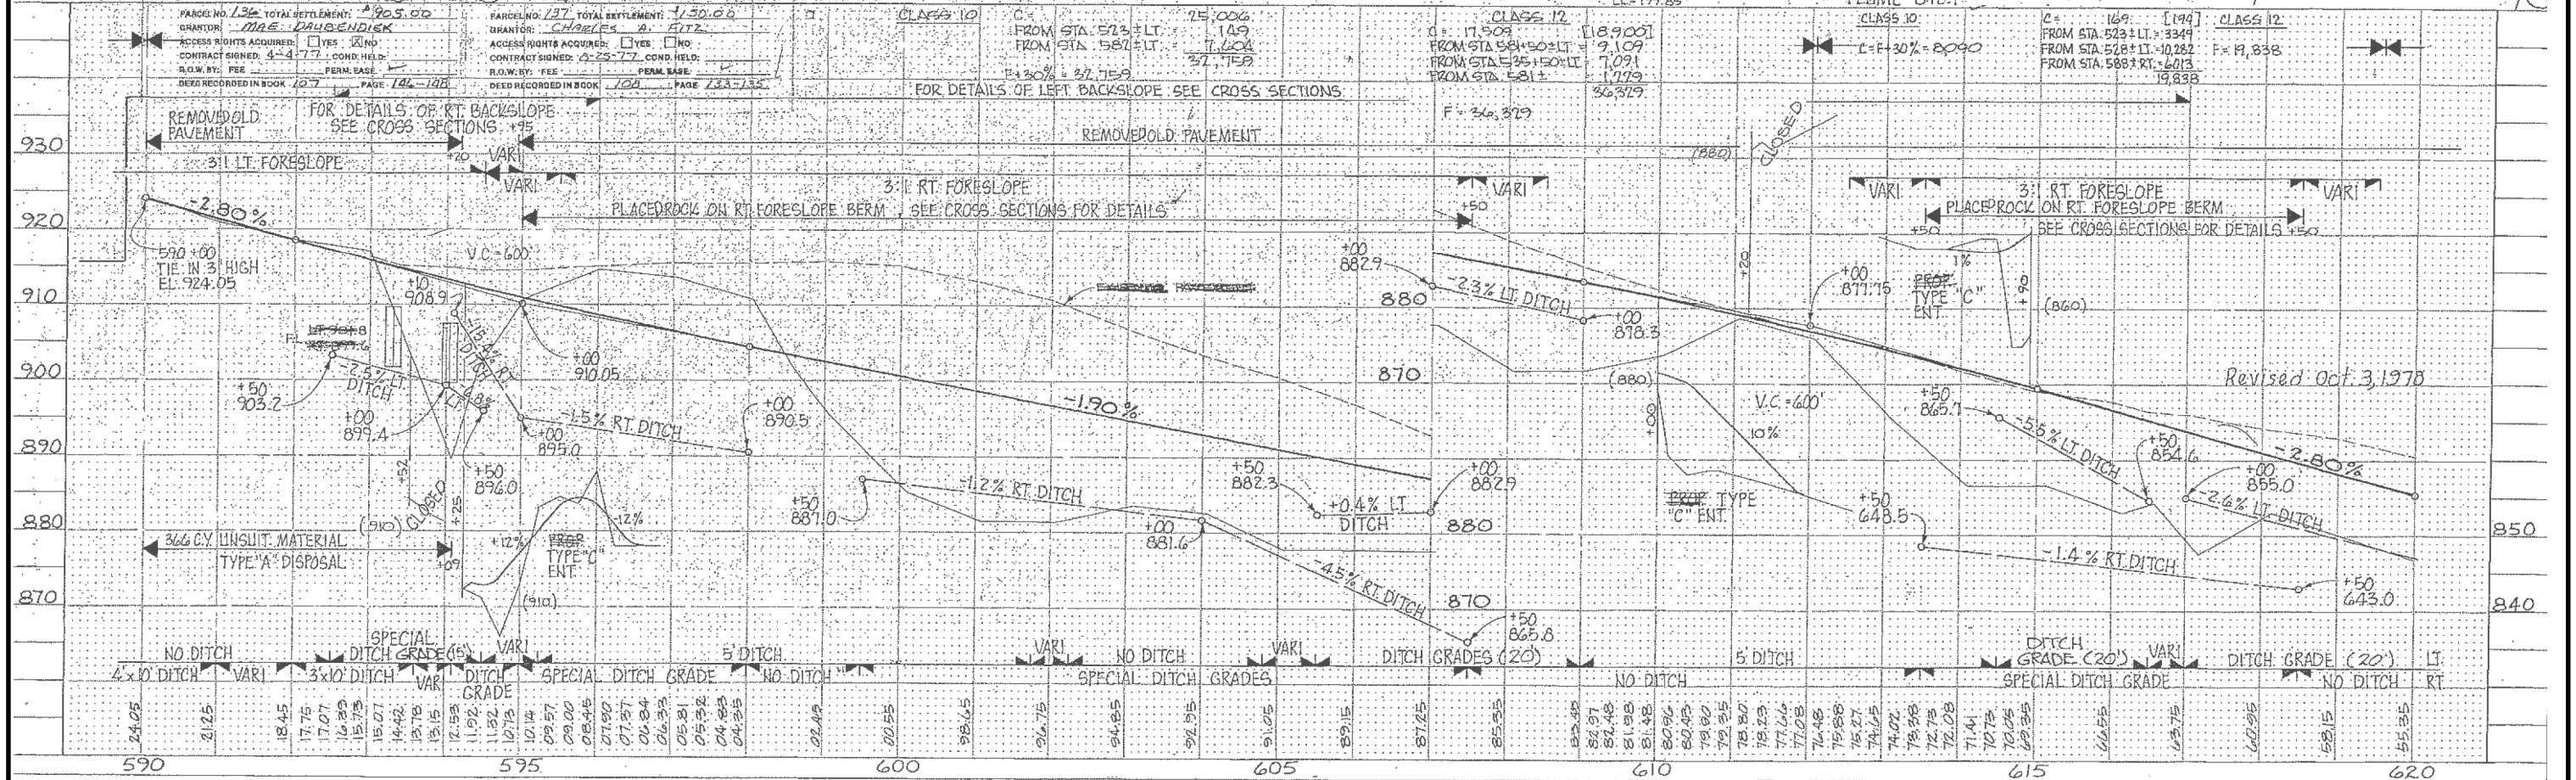
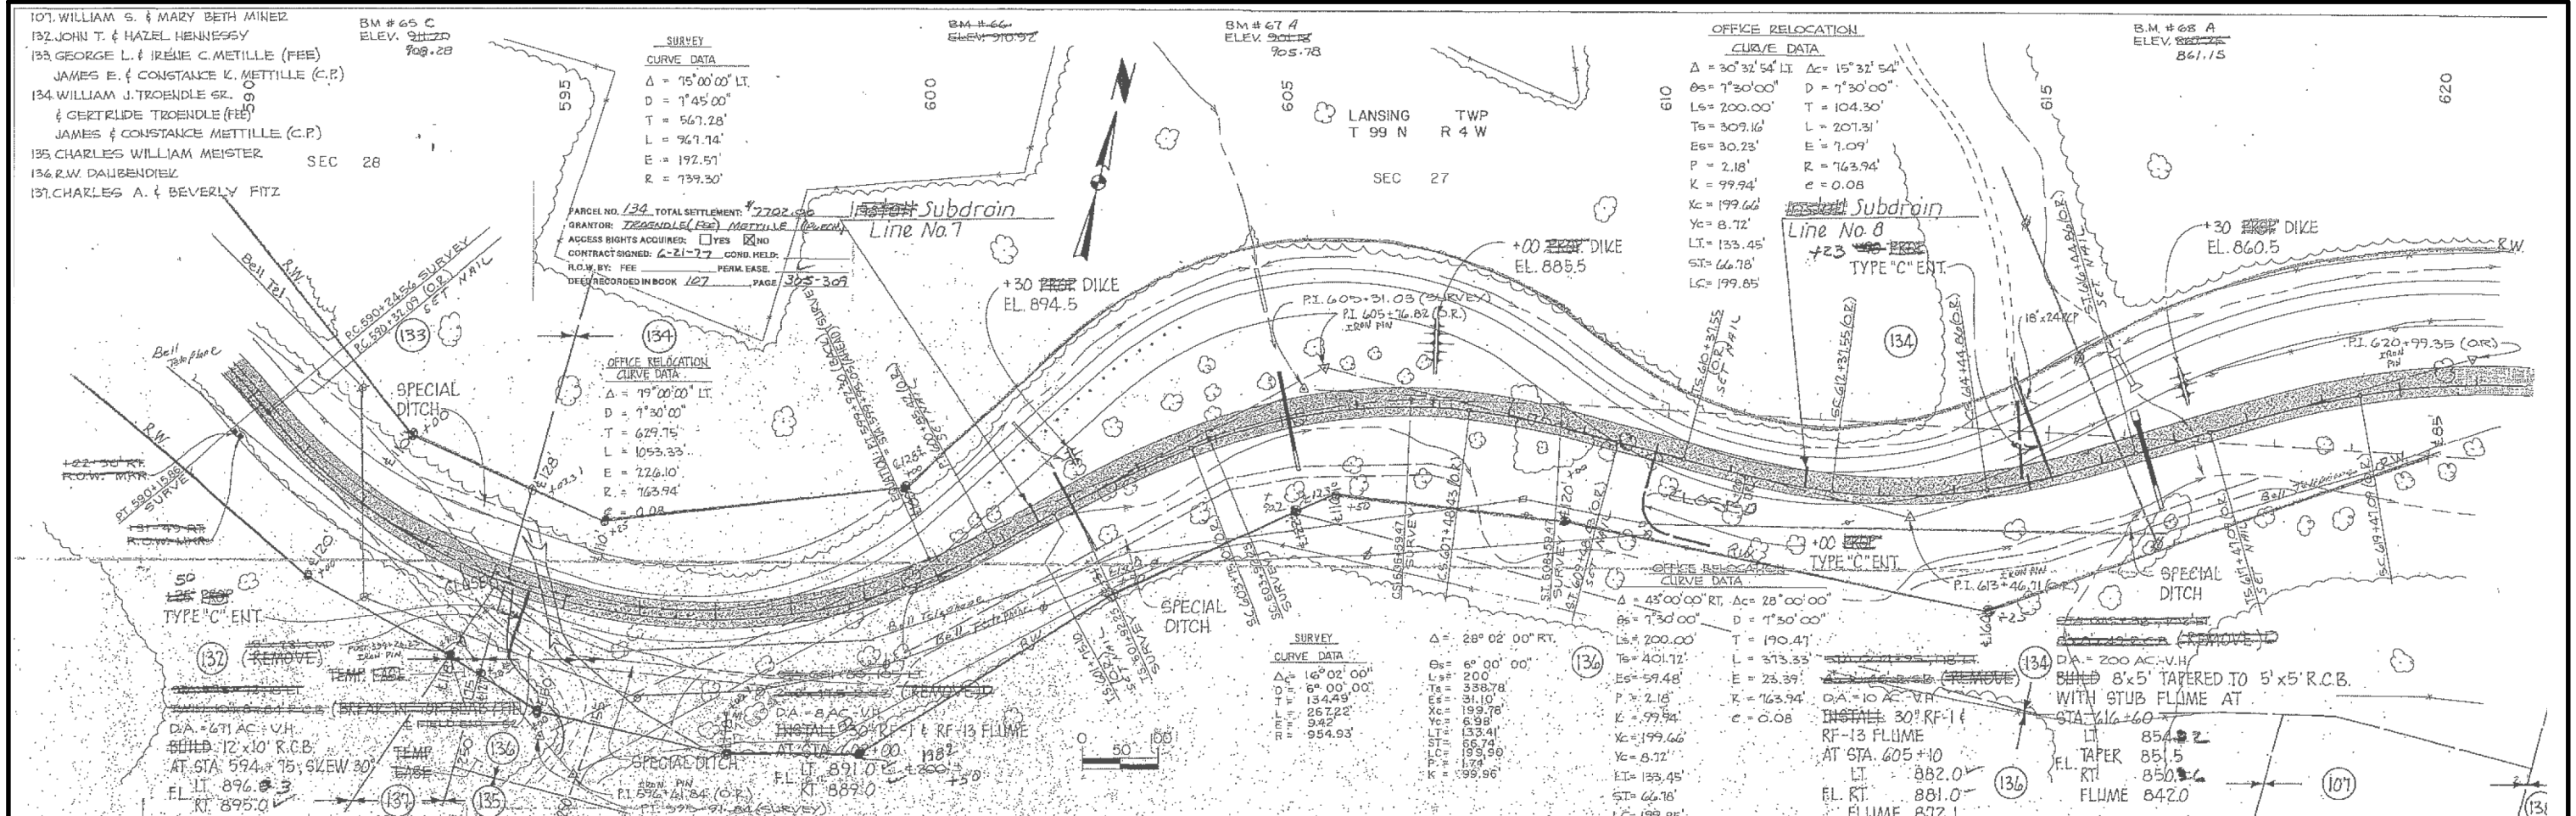


| | | | | |
|-------------|------------------------|-------------------|----------------|-------------------|
| STATE: IOWA | FED. ROAD DIST. NO.: 8 | FISCAL YEAR: 2003 | SHEET NO.: 204 | TOTAL SHEETS: 264 |
| STATE: IOWA | FED. ROAD DIST. NO.: 8 | FISCAL YEAR: 2003 | SHEET NO.: 204 | TOTAL SHEETS: 264 |

AS-BUILT PLANS, FOR INFORMATION ONLY

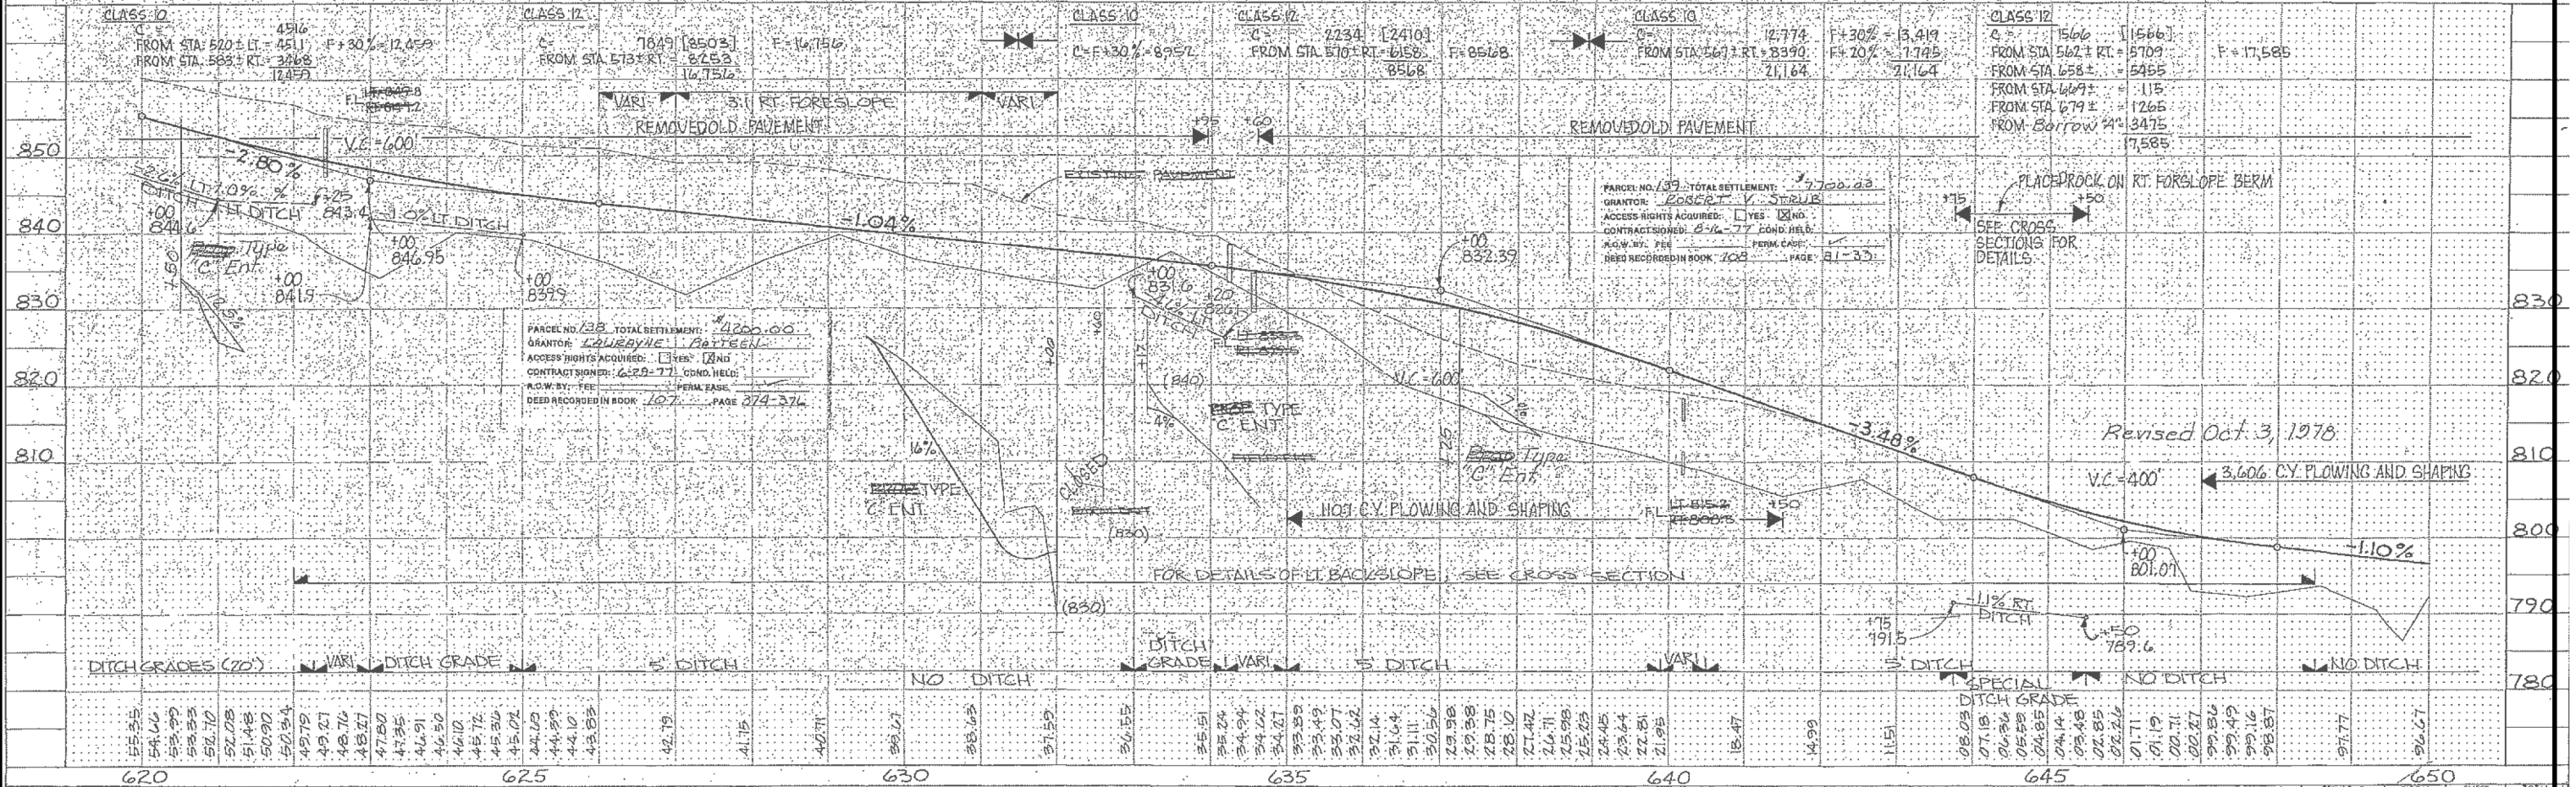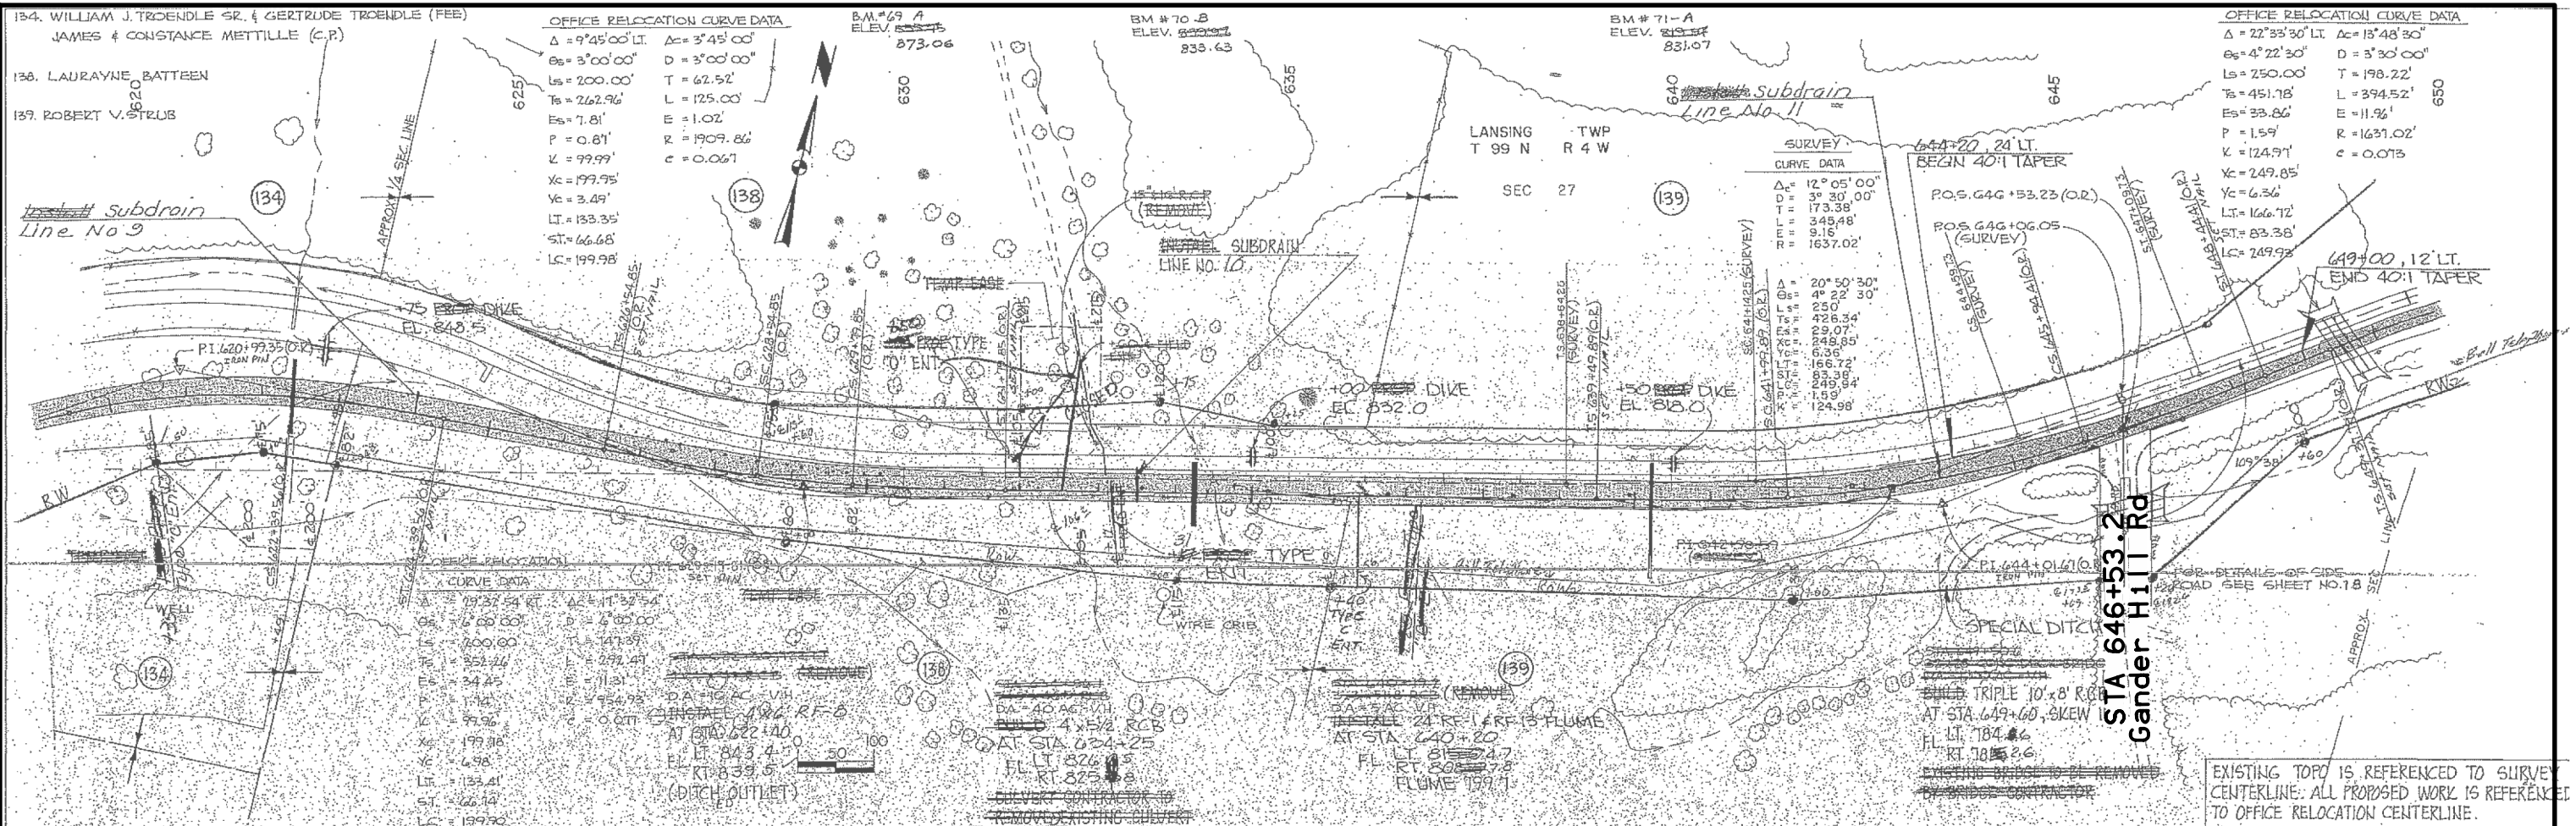


| | | | | | | | | | | | | | | | | | | | | | | | | | | | | | | | | | | | | | | | |
|---|
| AS-BUILT PLANS, FOR INFORMATION ONLY | | | | | ALLAMAKEE COUNTY | | | | | PROJECT NUMBER | | | | | STATE | | | | | FED. ROAD DIST. NO. | | | | | FISCAL YEAR | | | | | SHEET NO. | | | | | TOTAL SHEETS | | | | |
| FILE NO. | | | | | ENGLISH | | | | | DESIGN TEAM KELLY \ MEISE \ NIE | | | | | ALLAMAKEE COUNTY | | | | | PROJECT NUMBER | | | | | STP-009-9(71)--2C-03 | | | | | SHEET NUMBER | | | | | D.22 | | | | |
| 12:40:21 PM 10/1/2019 | | | | | tmeise | | | | | pw:\ntPwInt1.dot.int.lan:PWMain\Documents\Projects\0300902015\DistrictDesign\03009071_001.sht | | 
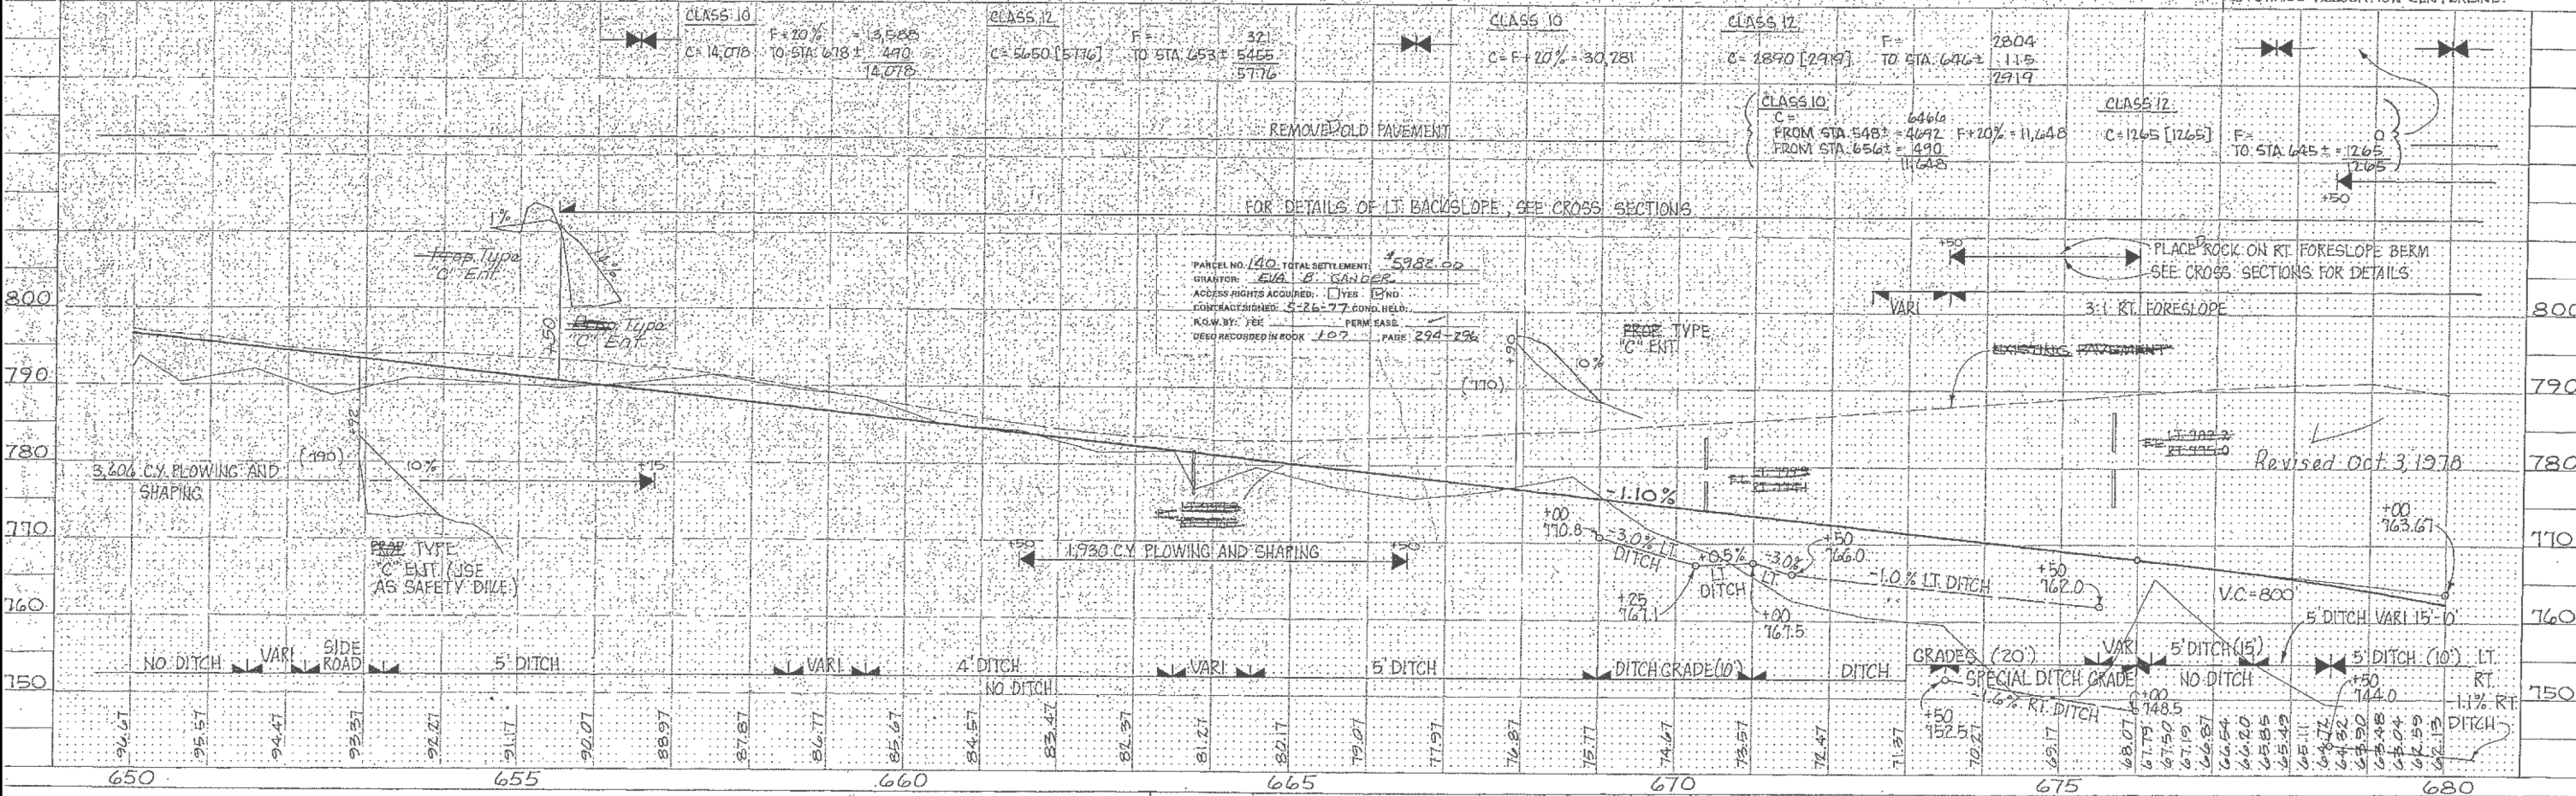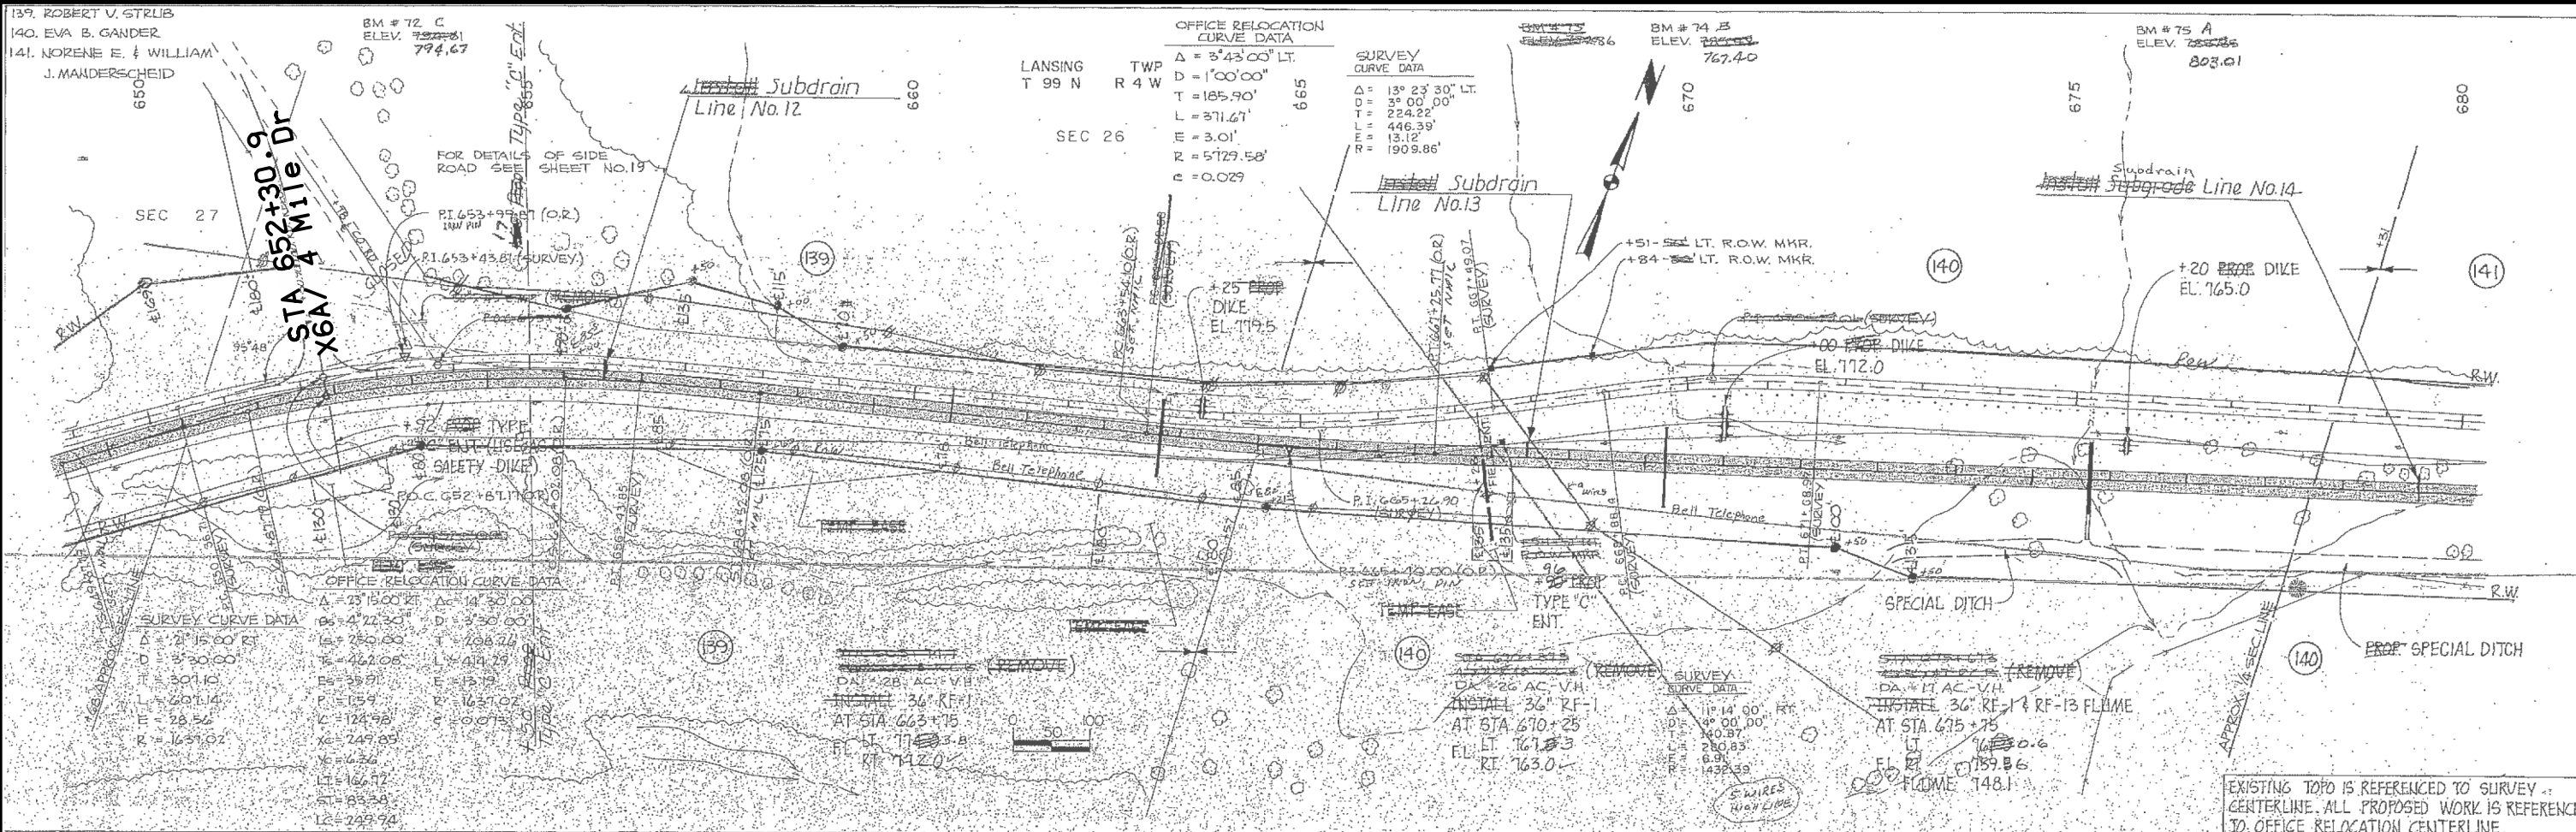

| | | | | | | | | | | | | | | | |
|--------------------------------------|---------------------|-------------|-----------|--------------|------------------|---------------------|-------------|-----------|--------------|-----------------|-------|---------------------|-------------|-----------|--------------|
| AS-BUILT PLANS, FOR INFORMATION ONLY | | | | | ALLAMAKEE COUNTY | | | | | PROJECT NUMBER | | | | | |
| STATE | FED. ROAD DIST. NO. | FISCAL YEAR | SHEET NO. | TOTAL SHEETS | STATE | FED. ROAD DIST. NO. | FISCAL YEAR | SHEET NO. | TOTAL SHEETS | PROJECT NUMBER | STATE | FED. ROAD DIST. NO. | FISCAL YEAR | SHEET NO. | TOTAL SHEETS |
| IOWA | 5 | | | | IOWA | 5 | | | | FN9-9(18)-20-03 | IOWA | 5 | | 11 | 264 |

| SURVEY CURVE DATA | | OFFICE RELOCATION CURVE DATA | |
|------------------------------------|------------------------------------|------------------------------------|------------------------------------|
| $\Delta = 13^{\circ} 54' 30''$ LT. | $\Delta = 17^{\circ} 22' 34''$ LT. | $\Delta = 17^{\circ} 22' 34''$ LT. | $\Delta = 17^{\circ} 22' 34''$ LT. |
| $D = 4^{\circ} 00' 00''$ | $\Theta = 5^{\circ} 00' 00''$ | $\Theta = 5^{\circ} 00' 00''$ | $\Theta = 5^{\circ} 00' 00''$ |
| $T = 174.71$ | $L = 250'$ | $L = 250'$ | $L = 250'$ |
| $R = 10.62$ | $Ts = 344.13'$ | $Ts = 344.13'$ | $Ts = 344.13'$ |
| $R = 1432.39'$ | $E = 18.47'$ | $E = 18.47'$ | $E = 18.47'$ |
| | $P = 1.82'$ | $P = 1.82'$ | $P = 1.82'$ |
| | $K = 124.91'$ | $K = 124.91'$ | $K = 124.91'$ |
| | $Xc = 249.81'$ | $Xc = 249.81'$ | $Xc = 249.81'$ |
| | $Yc = 7.27'$ | $Yc = 7.27'$ | $Yc = 7.27'$ |
| | $LT = 166.73'$ | $LT = 166.73'$ | $LT = 166.73'$ |
| | $ST = 83.40'$ | $ST = 83.40'$ | $ST = 83.40'$ |
| | $LC = 249.92'$ | $LC = 249.92'$ | $LC = 249.92'$ |

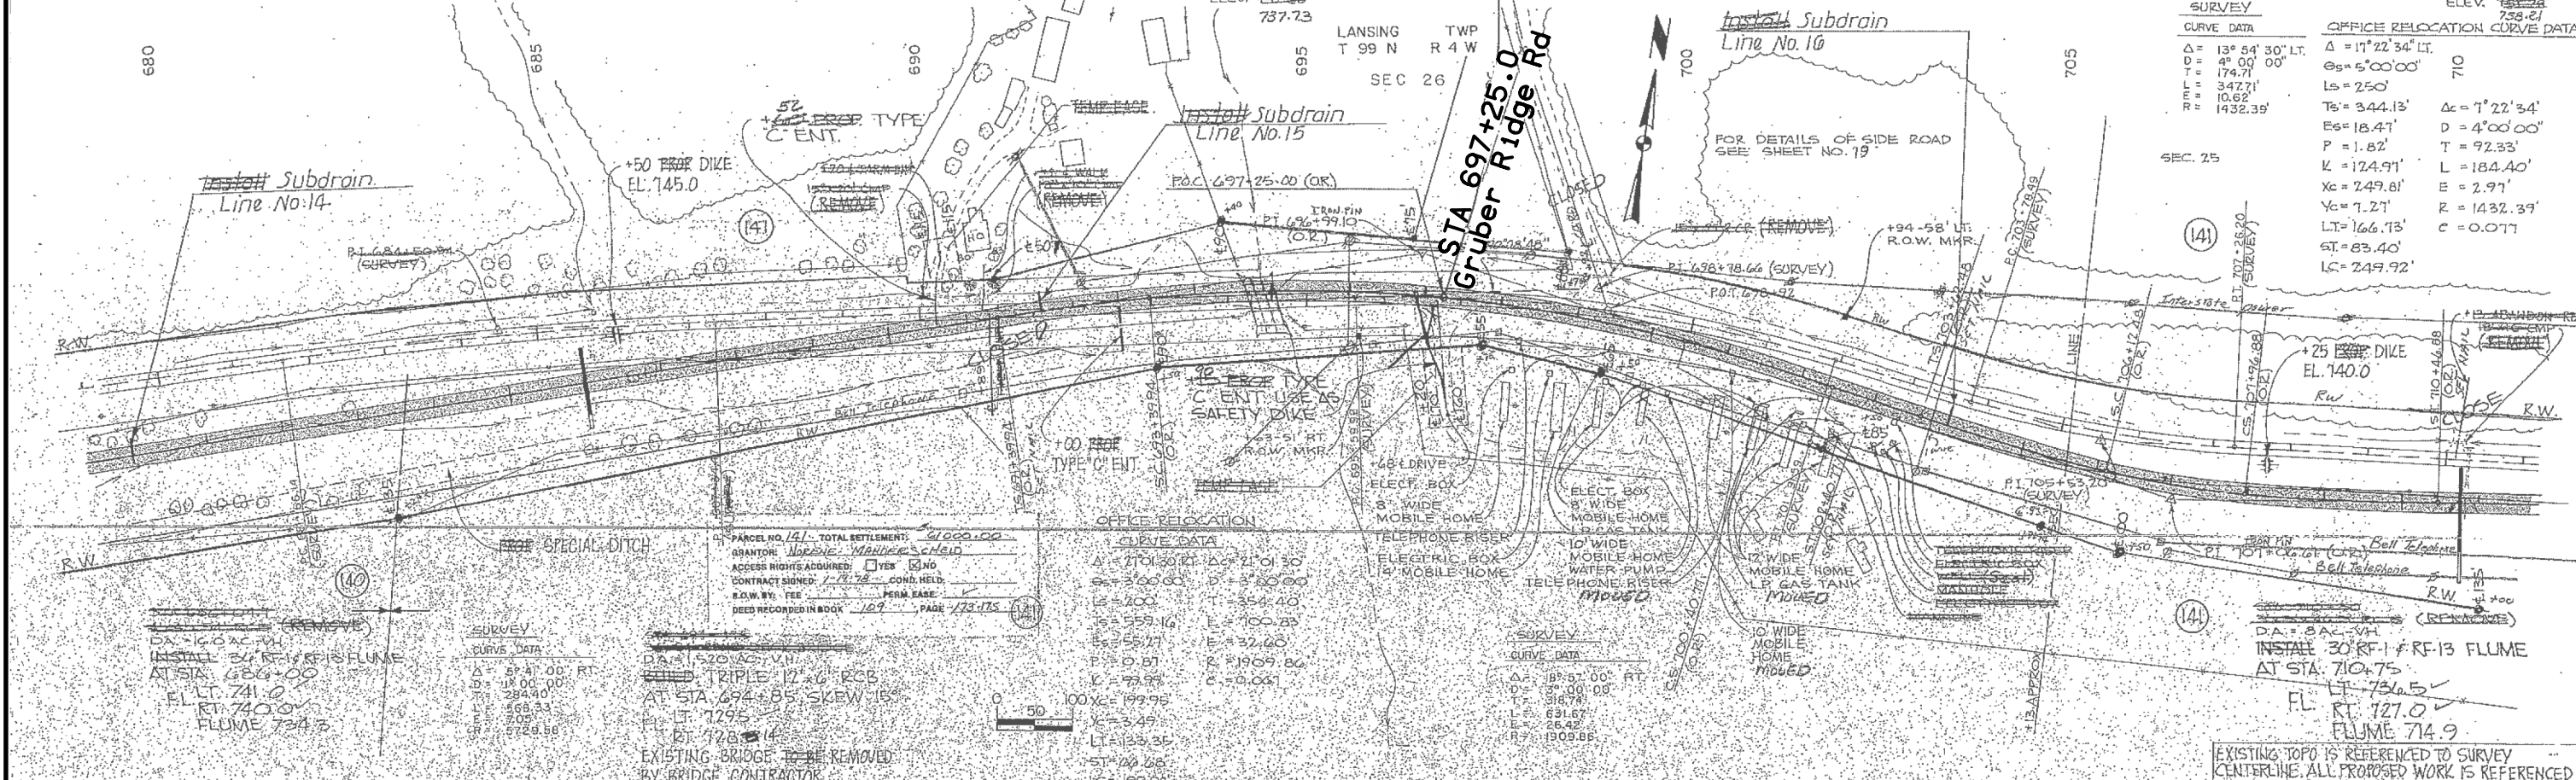


PARCEL NO. 141 - TOTAL SETTLEMENT: \$1000.00
 GRANTOR: Norene E. Manderschied
 ACCESS RIGHTS ACQUIRED: YES NO
 CONTRACT SIGNED: 1/17/78 COND. HELD:
 E.O.W. BY: FEE PERM. EASE:
 DEED RECORDED IN BOOK 109 PAGE 173-175

CURVE DATA
 $A = 2701.30$ RT $\Delta = 21^{\circ} 01' 30''$
 $\Theta = 3^{\circ} 00' 00''$ $D = 3^{\circ} 00' 00''$
 $L = 400'$ $T = 354.40'$
 $Ts = 559.16'$ $E = 100.83'$
 $E = 32.60'$
 $P = 0.87'$ $R = 1969.86'$
 $K = 93.95'$ $C = 0.001'$
 $100\% VC = 199.95'$
 $VC = 3.49'$
 $LT = 133.34'$
 $ST = 10.68'$
 $LC = 199.96'$



SURVEY CURVE DATA
 $\Delta = 18^{\circ} 5' 00''$ RT
 $D = 3^{\circ} 00' 00''$
 $T = 316.74'$
 $L = 631.67'$
 $E = 26.42'$
 $R = 1909.85'$

DA = 84'-0" V.H.
 INSTALL 30" RT-11 & RT-13 FLUME
 AT STA. 710+75
 FL. RT. 736.5
 FL. RT. 736.5
 FLUME 714.9



EXISTING TOPO IS REFERENCED TO SURVEY CENTERLINE. ALL PROPOSED WORK IS REFERENCED TO OFFICE RELOCATION CENTERLINE.

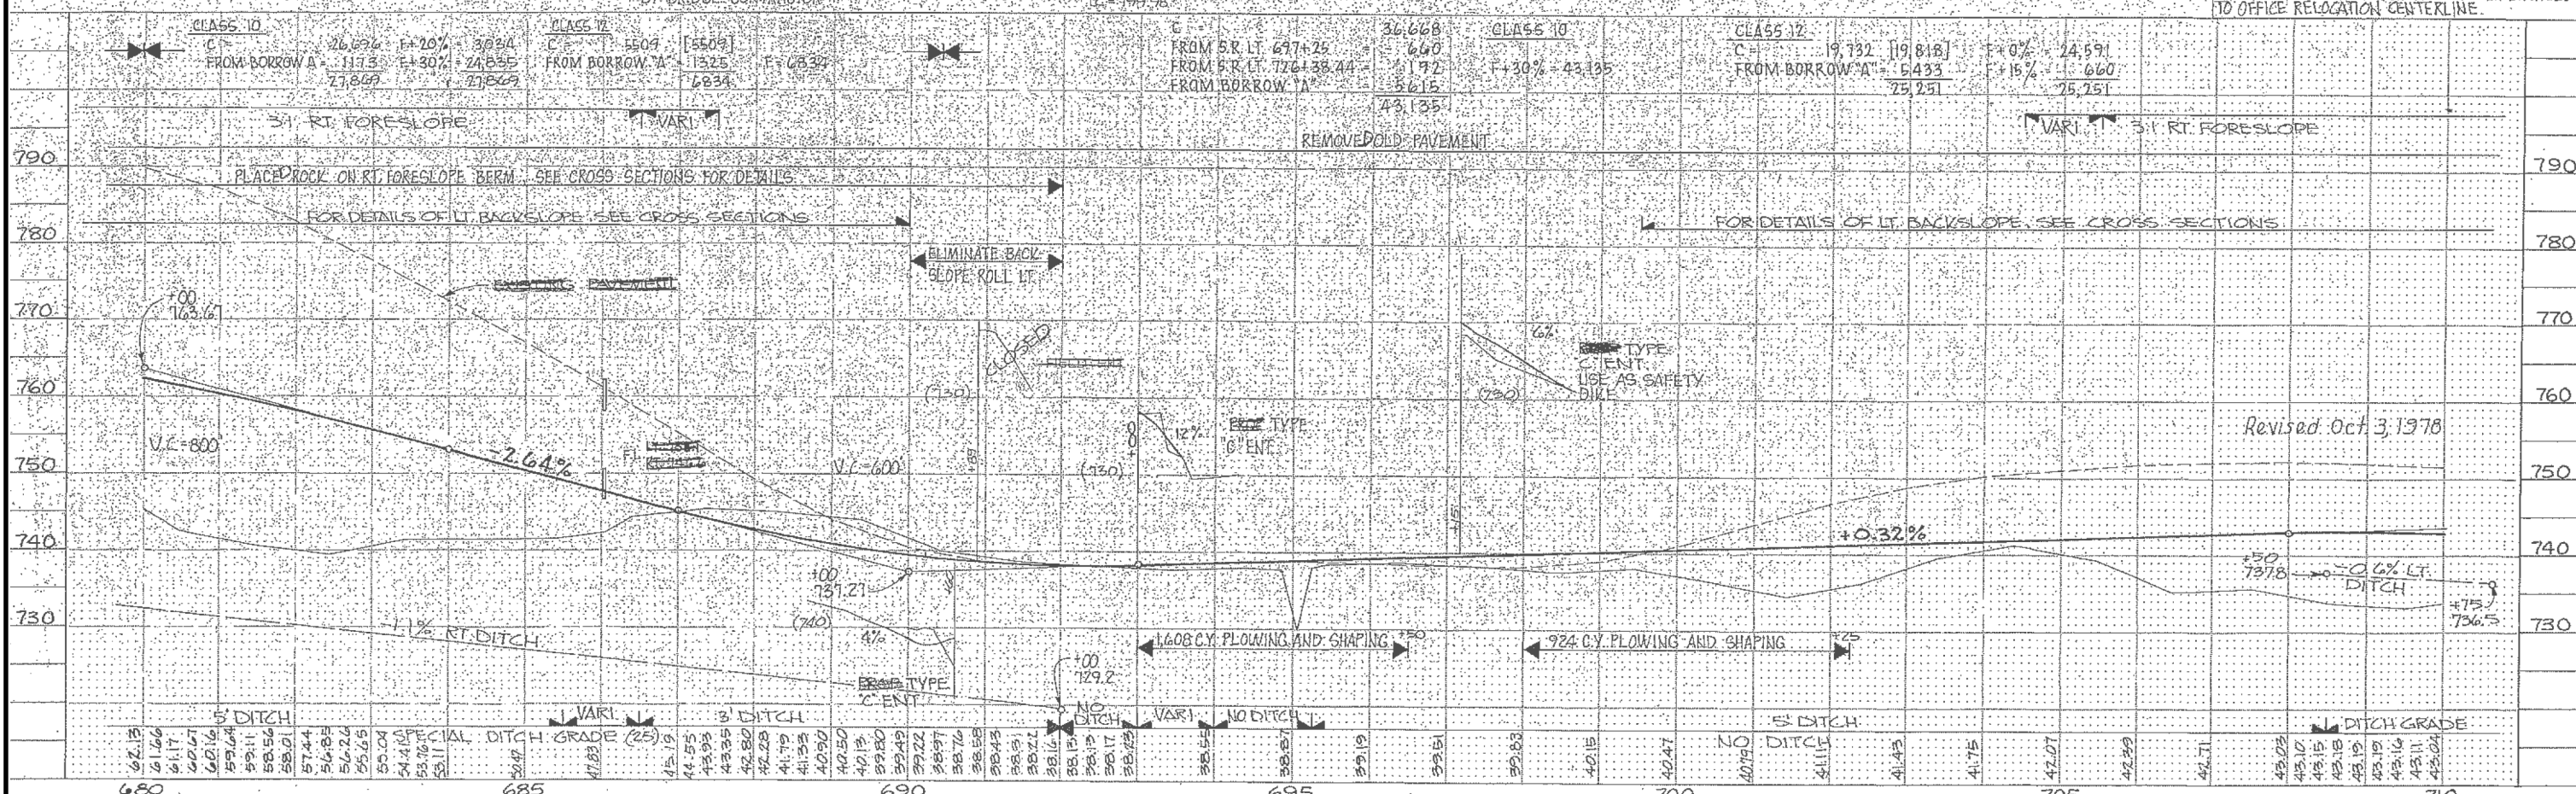

| CLASS ID | CLASS 12 | CLASS 10 | CLASS 12 |
|----------------------|----------------------|----------------------|----------------------|
| FROM BORROW A - 1113 | FROM BORROW A - 1125 | FROM S.R. LT. 697+25 | FROM BORROW A - 1932 |
| 27,809 | 1,834 | 640 | 19,818 |
| | | 1,172 | 6,433 |
| | | 5,615 | 75,251 |
| | | 43,135 | 24,591 |
| | | | 660 |
| | | | 75,251 |

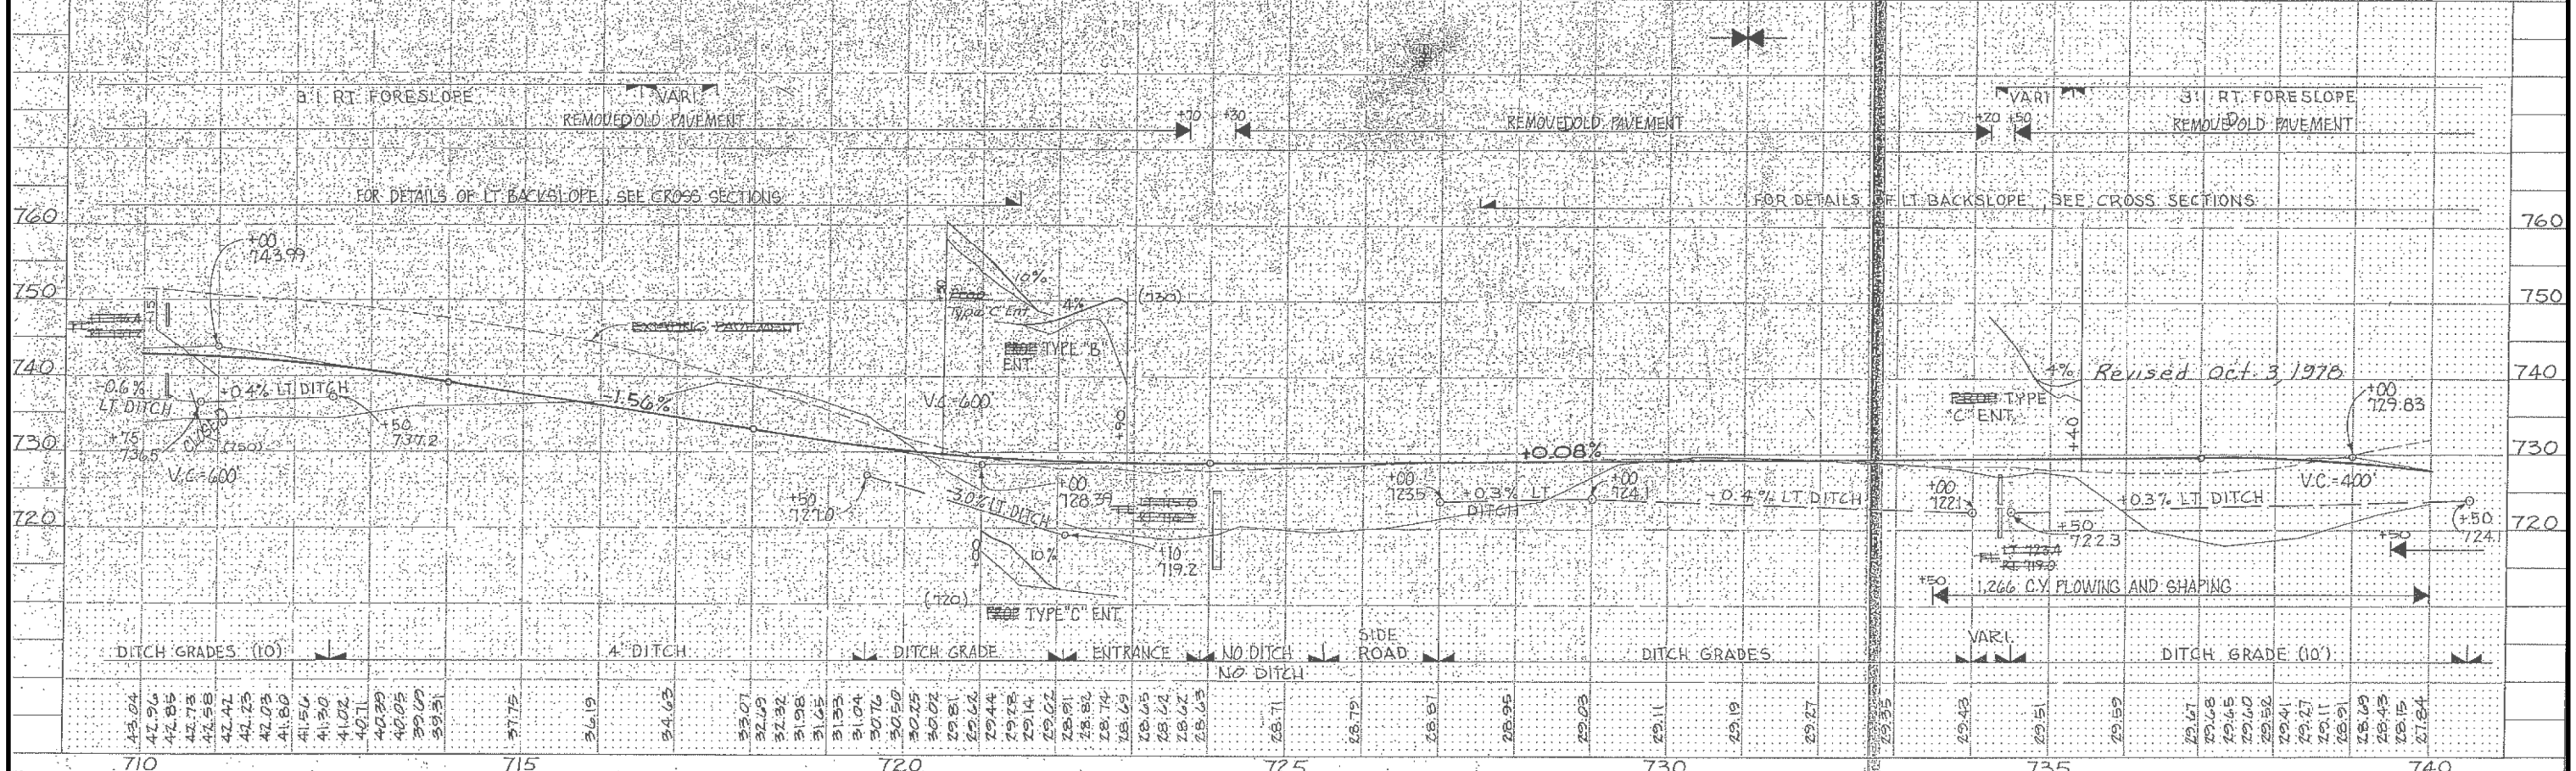
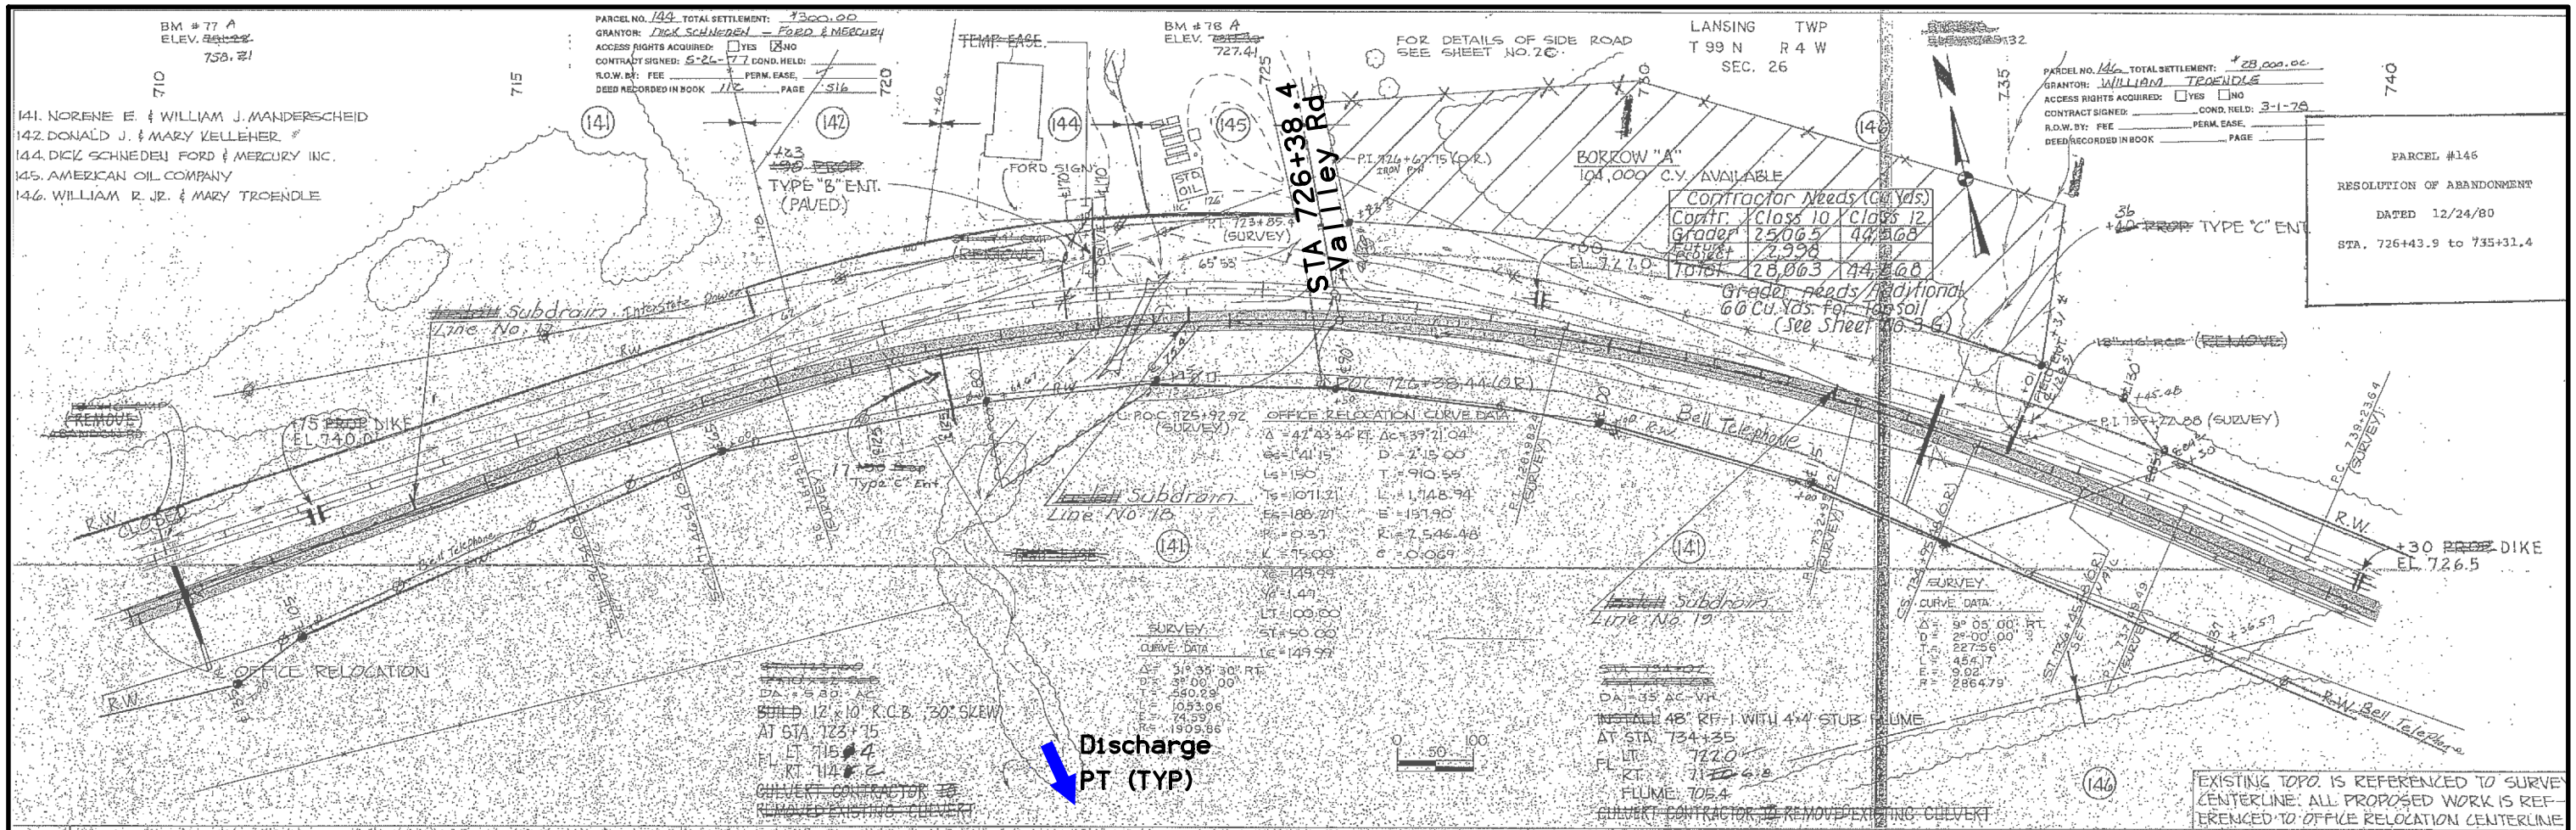


| | | | | | | | | | | | | | | | | | | | | | | | | | | | | | | | | | | |
|--------------------------------------|--|--|--|--|------------------|--|--|--|--|----------------|--|--|--|--|-------|--|--|--|--|-------------|--|--|--|--|-----------|--|--|--|--|--------------|--|--|--|--|
| AS-BUILT PLANS, FOR INFORMATION ONLY | | | | | ALLAMAKEE COUNTY | | | | | PROJECT NUMBER | | | | | STATE | | | | | FISCAL YEAR | | | | | SHEET NO. | | | | | TOTAL SHEETS | | | | |
| FN 9-9(18)--20-03 | | | | | IOWA | | | | | 5 | | | | | 2003 | | | | | 13 | | | | | 264 | | | | | | | | | |

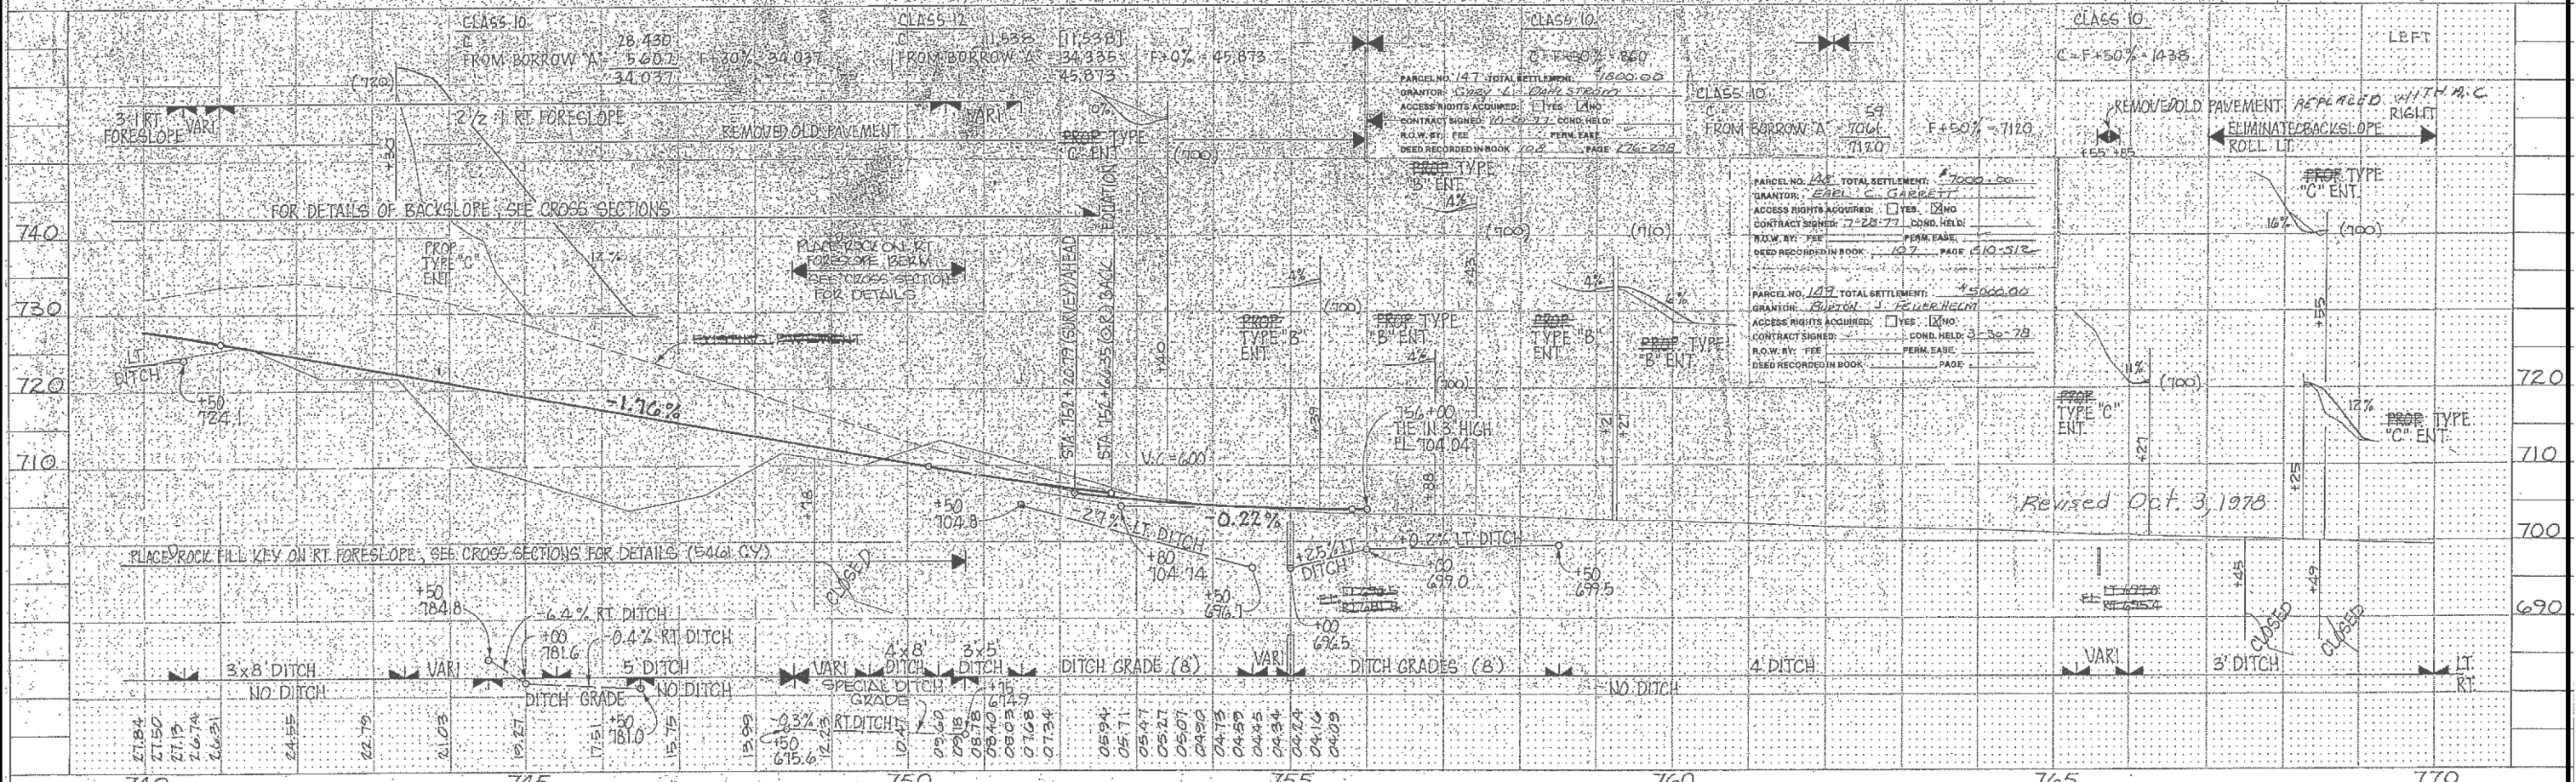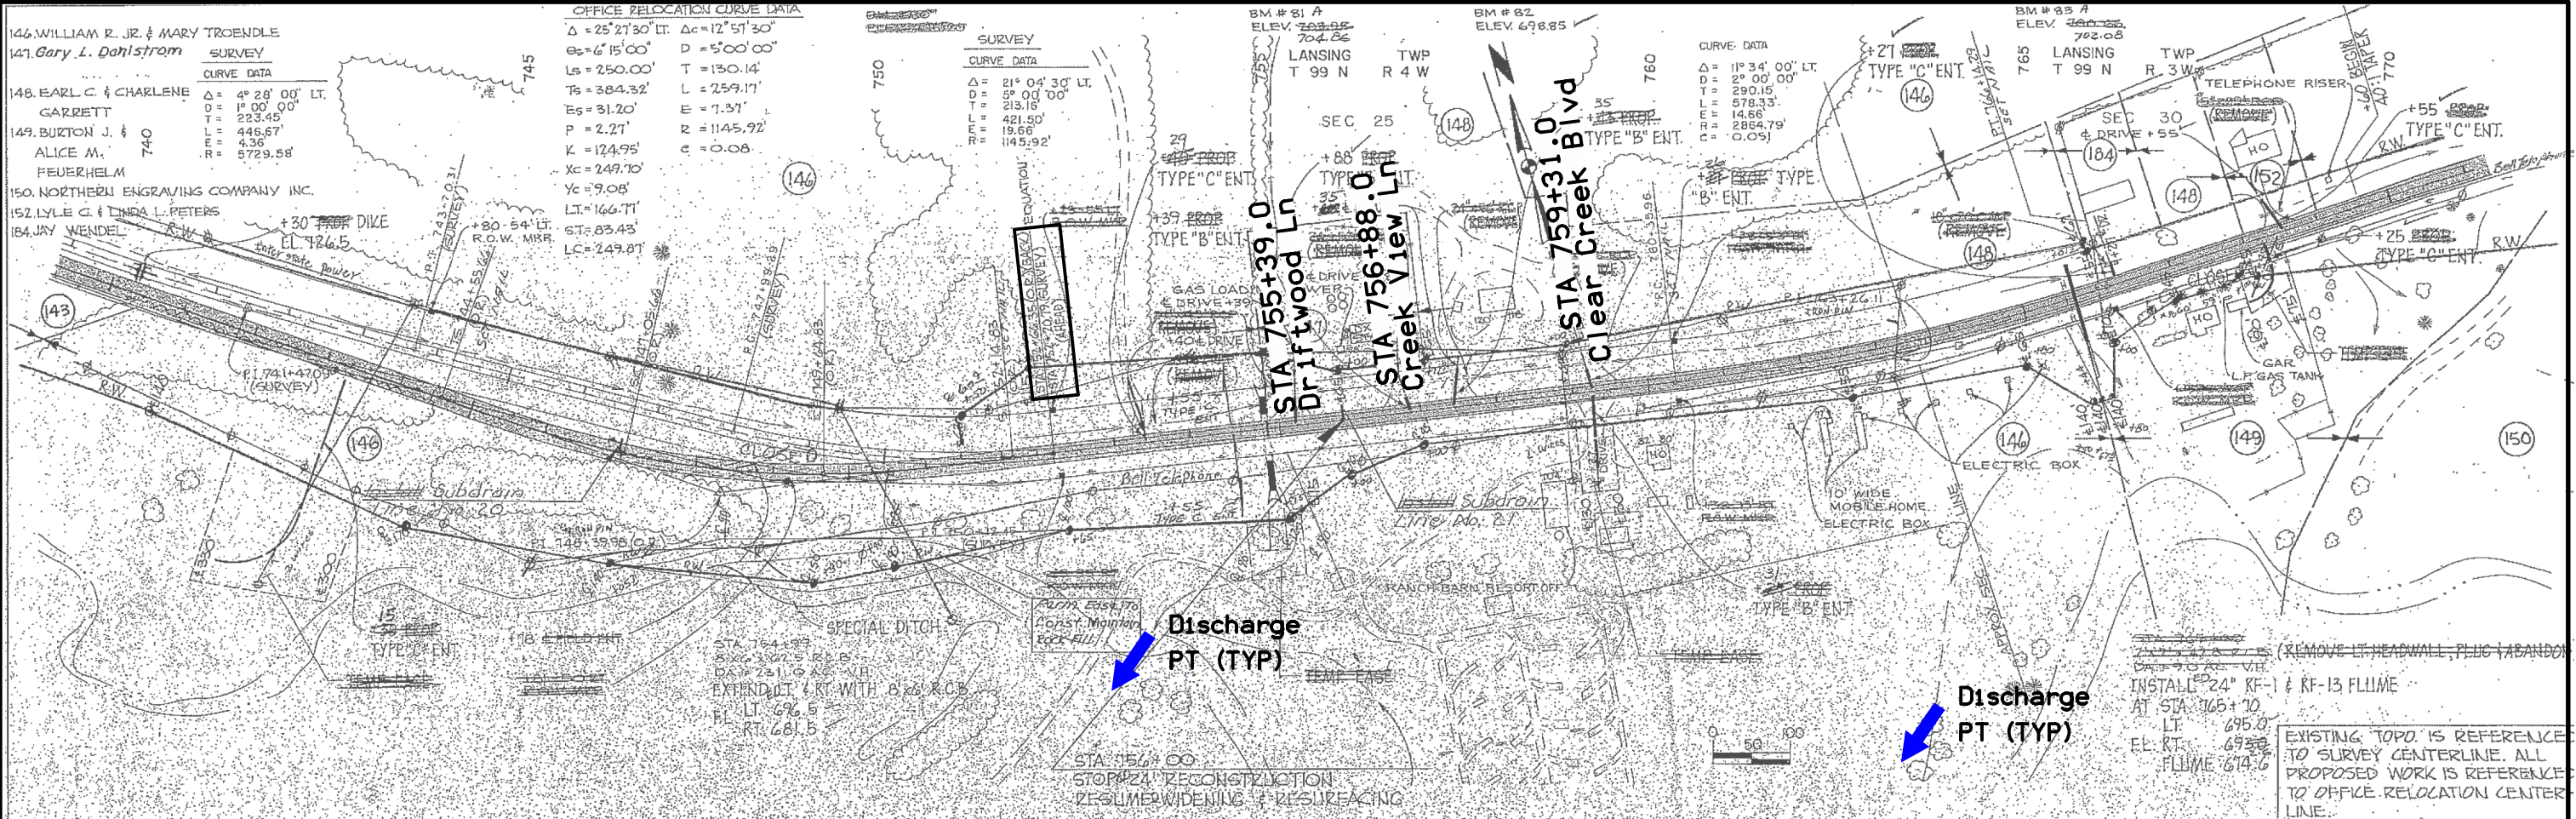

AS-BUILT PLANS, FOR INFORMATION ONLY ALLAMAKEE COUNTY PROJECT NUMBER STATE IOWA FED. ROAD DIST. NO. 5 FISCAL YEAR 2003 SHEET NO. 14 TOTAL SHEETS 264

FILE NO. ENGLISH DESIGN TEAM KELLY \ MEISE \ NIE ALLAMAKEE COUNTY PROJECT NUMBER STP-009-9(71)--2C-03 SHEET NUMBER D.26

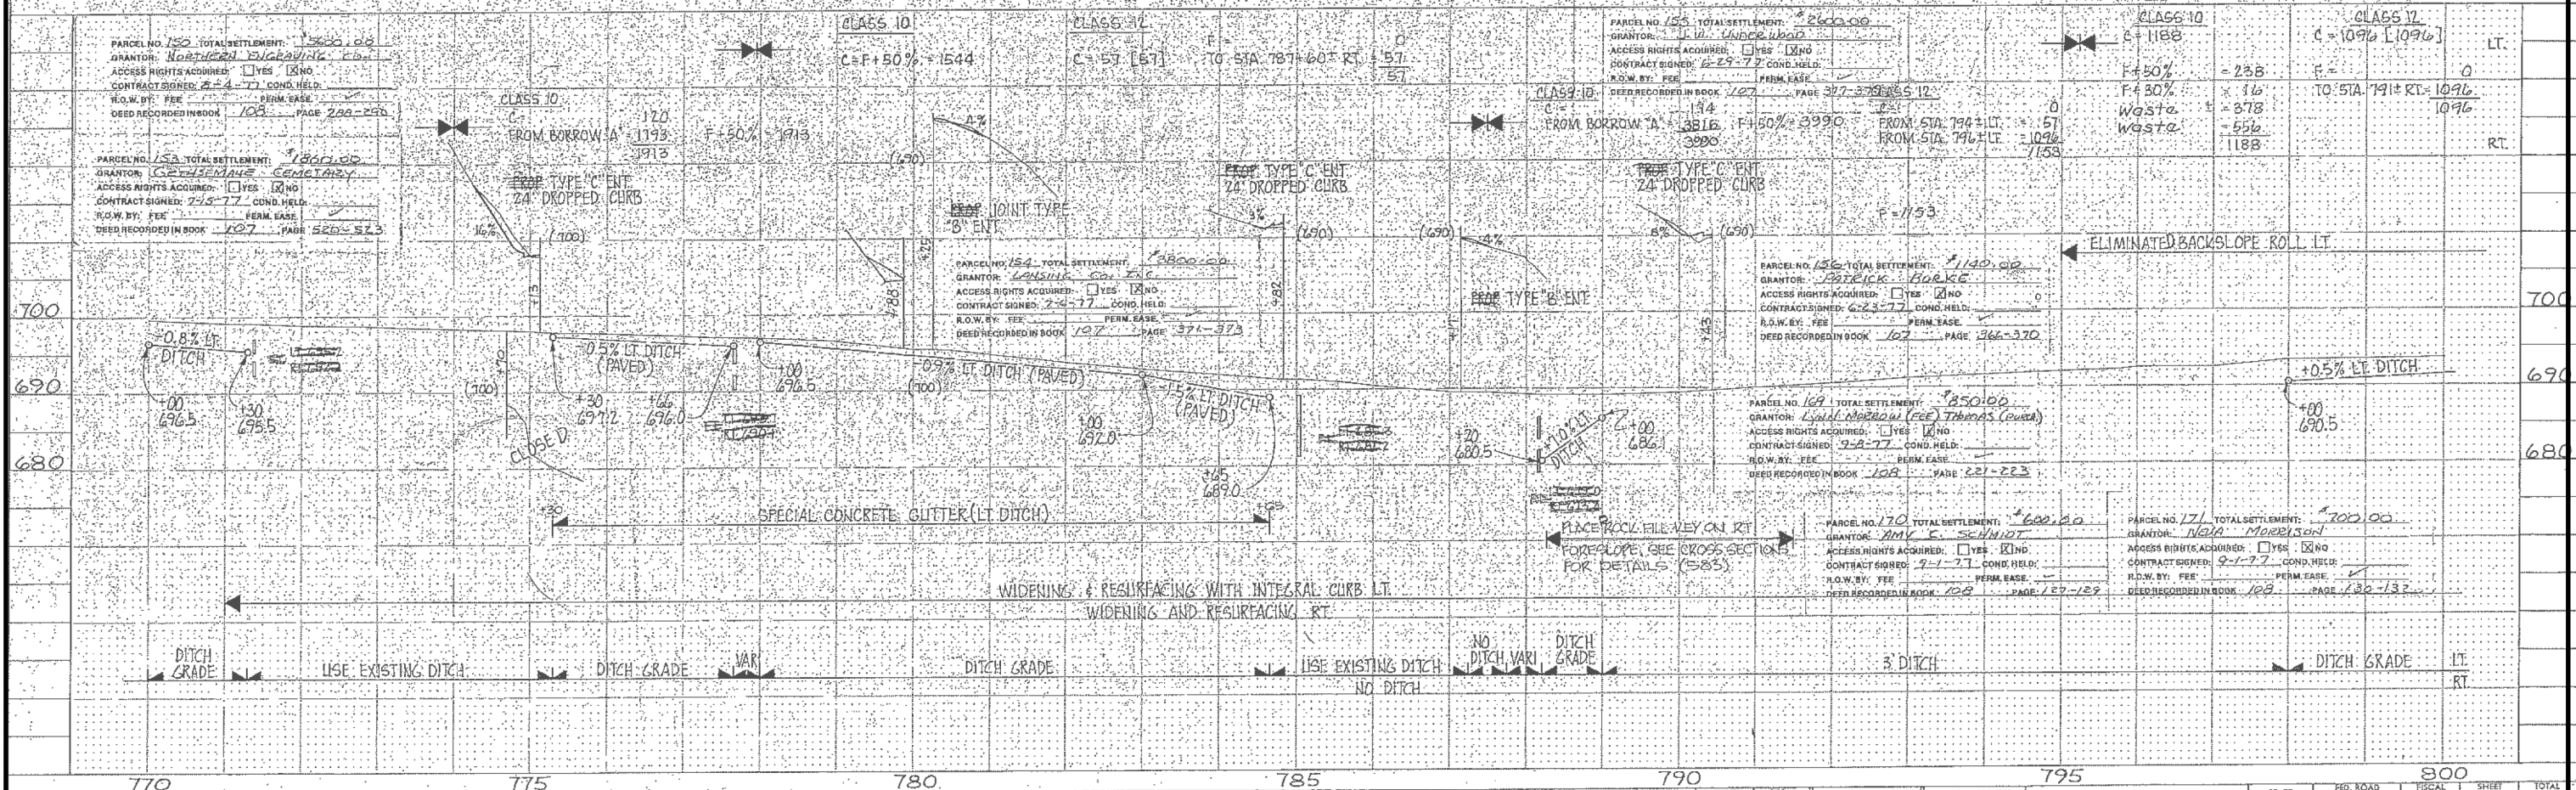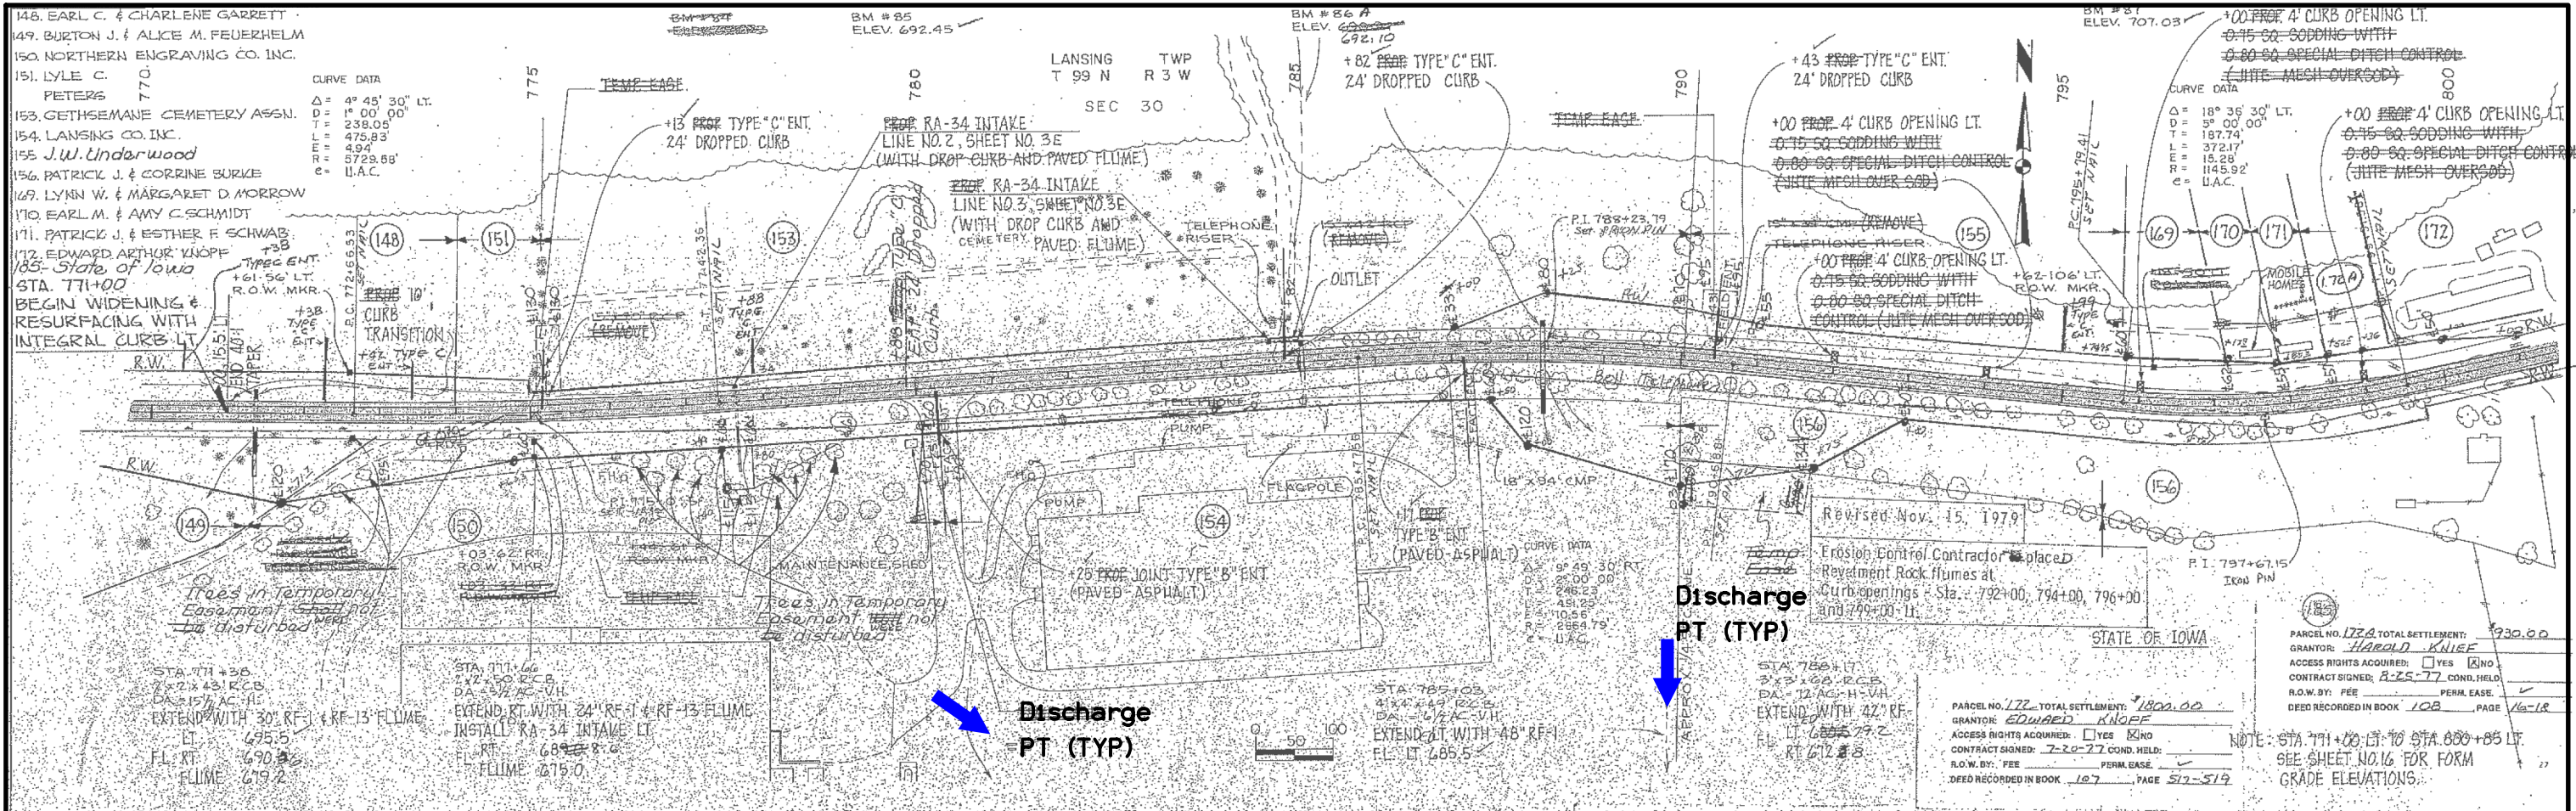

| | | | | | | | | | | | | | |
|--------------------------------------|------------------|----------------|-------------|---------------------|-------------|-----------|--------------|------------------|-------------|---------------------|-------------|-----------|--------------|
| AS-BUILT PLANS, FOR INFORMATION ONLY | ALLAMAKEE COUNTY | PROJECT NUMBER | STATE: IOWA | FED. ROAD DIST. NO. | FISCAL YEAR | SHEET NO. | TOTAL SHEETS | PROJECT NUMBER | STATE: IOWA | FED. ROAD DIST. NO. | FISCAL YEAR | SHEET NO. | TOTAL SHEETS |
| | | | | | | | | FN9-9(18)--20-03 | | | | 15 | 269 |

| | | | | | | | | |
|----------|---------|-------------|---------------------|------------------|----------------|----------------------|--------------|------|
| FILE NO. | ENGLISH | DESIGN TEAM | KELLY \ MEISE \ NIE | ALLAMAKEE COUNTY | PROJECT NUMBER | STP-009-9(71)--2C-03 | SHEET NUMBER | D.27 |
|----------|---------|-------------|---------------------|------------------|----------------|----------------------|--------------|------|



- 156. PATRICK J. & CORRINE BURKE
- 157. THOMAS VINCENT & VICTORIA ANN SPINNER
- 158. ROBERT J. & JANET R. PROTSMAN
- 160. LEO A. & MILDRED L. STIRN
- 161. NORBERT R. SPINNER
- 172. EDWARD ARTHUR KNOPF
- 174. CLARENCE W. & DELORES M. FEE
- 182. ERNEST J. & ALICE D. LUYSTER

Em. 87 A
Elev. 693.67

CURB FORM GRADE ELEVATIONS STA. 771+00 TO 800+85

| STATION | FORM GRADE | STATION | FORM GRADE | STATION | FORM GRADE | STATION | FORM GRADE |
|---------|------------|---------|------------|---------|------------|---------|------------|
| 771+00 | 99.40 | 779+00 | 96.51 | 787+00 | 90.29 | 795+00 | 91.81 |
| 771+25 | 99.27 | 779+25 | 96.28 | 787+25 | 90.17 | 795+25 | 91.84 |
| 771+50 | 99.14 | 779+50 | 96.05 | 787+50 | 90.04 | 795+50 | 91.88 |
| 771+75 | 99.02 | 779+75 | 95.83 | 787+75 | 89.91 | 795+75 | 91.91 |
| 772+00 | 98.89 | 780+00 | 95.69 | 788+00 | 89.79 | 796+00 | 91.94 |
| 772+25 | 98.76 | 780+25 | 95.31 | 788+25 | 89.80 | 796+25 | 91.97 |
| 772+50 | 98.63 | 780+50 | 95.02 | 788+50 | 89.82 | 796+50 | 92.00 |
| 772+75 | 98.49 | 780+75 | 94.74 | 788+75 | 89.83 | 796+75 | 92.03 |
| 773+00 | 98.36 | 781+00 | 94.45 | 789+00 | 89.84 | 797+00 | 92.12 |
| 773+25 | 98.28 | 781+25 | 94.31 | 789+25 | 89.91 | 797+25 | 92.20 |
| 773+50 | 98.21 | 781+50 | 94.15 | 789+50 | 89.98 | 797+50 | 92.35 |
| 773+75 | 98.13 | 781+75 | 94.01 | 789+75 | 90.05 | 797+75 | 92.45 |
| 774+00 | 98.05 | 782+00 | 93.86 | 790+00 | 90.12 | 798+00 | 92.51 |
| 774+25 | 97.98 | 782+25 | 93.67 | 790+25 | 90.17 | 798+25 | 92.56 |
| 774+50 | 97.92 | 782+50 | 93.49 | 790+50 | 90.23 | 798+50 | 92.62 |
| 774+75 | 97.86 | 782+75 | 93.29 | 790+75 | 90.29 | 798+75 | 92.67 |
| 775+00 | 97.79 | 783+00 | 93.10 | 791+00 | 90.34 | 799+00 | 92.72 |
| 775+25 | 97.69 | 783+25 | 92.87 | 791+25 | 90.39 | 799+25 | 92.80 |
| 775+50 | 97.59 | 783+50 | 92.66 | 791+50 | 90.43 | 799+50 | 92.84 |
| 775+75 | 97.47 | 783+75 | 92.43 | 791+75 | 90.48 | 799+75 | 92.89 |
| 776+00 | 97.37 | 784+00 | 92.21 | 792+00 | 90.53 | 800+00 | 92.92 |
| 776+25 | 97.32 | 784+25 | 91.98 | 792+25 | 90.55 | 800+25 | 92.97 |
| 776+50 | 97.28 | 784+50 | 91.76 | 792+50 | 90.57 | 800+50 | 92.99 |
| 776+75 | 97.25 | 784+75 | 91.53 | 792+75 | 90.58 | 800+75 | 92.94 |
| 777+00 | 97.20 | 785+00 | 91.30 | 793+00 | 91.06 | 800+85 | 92.28 |
| 777+25 | 97.15 | 785+25 | 91.20 | 793+25 | 91.13 | | |
| 777+50 | 97.10 | 785+50 | 91.12 | 793+50 | 91.27 | | |
| 777+75 | 97.05 | 785+75 | 91.03 | 793+75 | 91.41 | | |
| 778+00 | 97.01 | 786+00 | 90.94 | 794+00 | 91.53 | | |
| 778+25 | 96.98 | 786+25 | 90.78 | 794+25 | 91.67 | | |
| 778+50 | 96.75 | 786+50 | 90.61 | 794+50 | 91.72 | | |
| 778+75 | 96.64 | 786+75 | 90.45 | 794+75 | 91.78 | | |

STA 802+25.0
END PROJECT

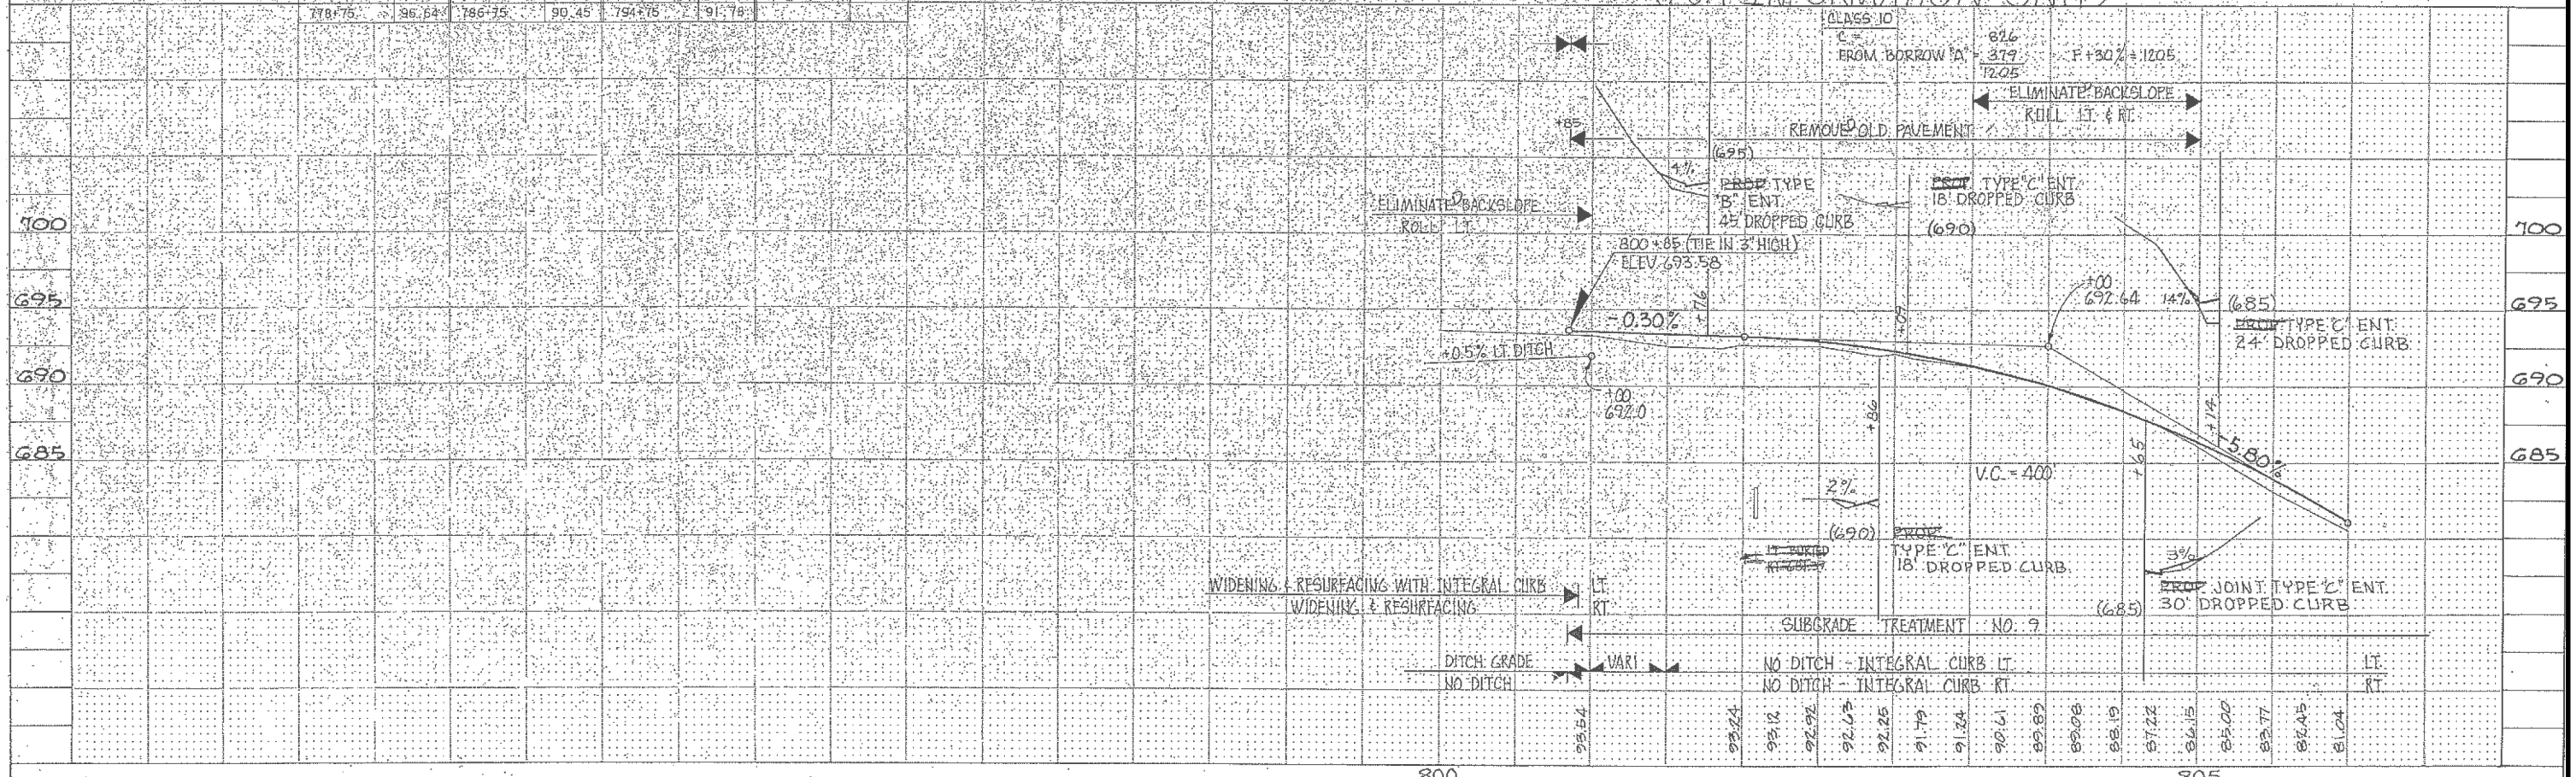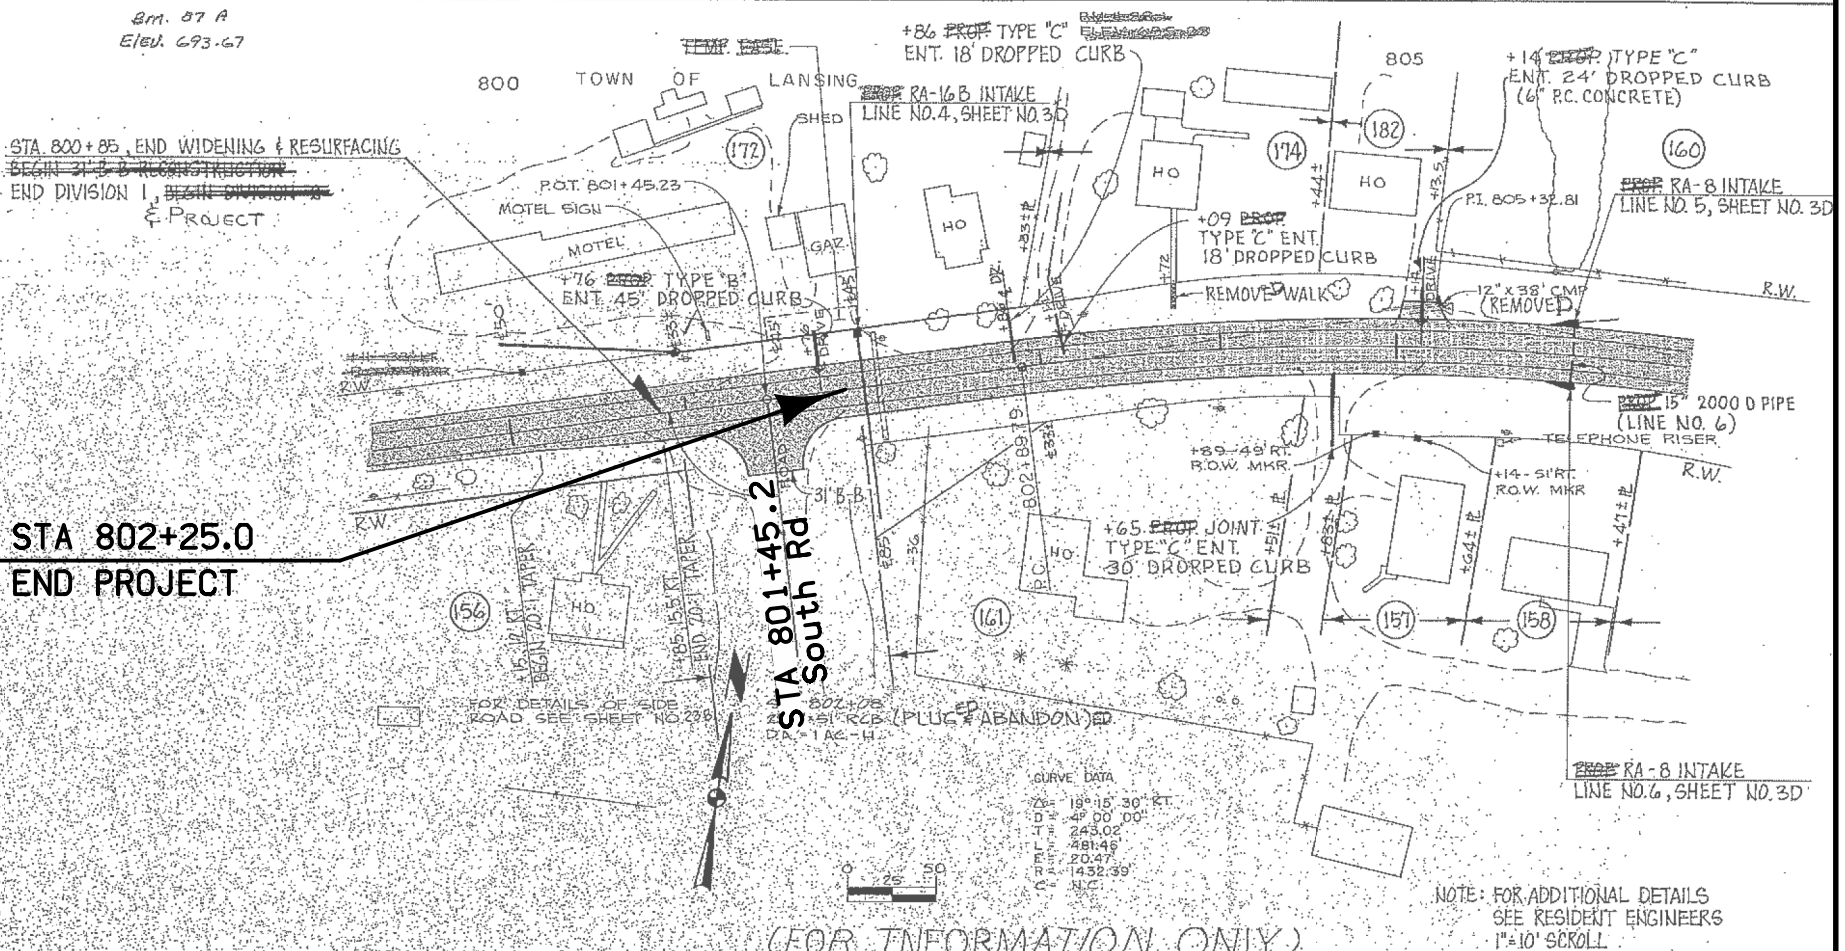

511 TRAVEL RESTRICTIONS

| Route | Direction | County | Location Description | Feature Crossed | Object Type | Maint. Bridge No., Structure ID, or FHWA No. | Type of Restriction | Existing Measurement | Construction Measurement | Construction Measurement as Signed | Projected As Built Measurement | Remarks |
|-------|-----------|--------|--------------------------|-----------------|-------------|--|------------------------|-------------------------|-----------------------------|--|--------------------------------------|---------|
| | | | No restrictions expected | | | | | | | | | |
| | | | | | | | | | | | | |

108-26A
08-01-08

STAGING NOTES

1) IA 9 traffic to be detoured.

1.1) Contractor shall replace and repair mainline pipes between Waukon and A44/Iron Mine Rd.

2) Install subdrains and perform pipe work.

3) Perform patching.

4) Construct base widening and installation of paved shoulders.

5) Perform scarification in urban areas.

6) Perform Cold-In-Place recycling.

7) Place HMA.

8) Place final pavement markings and rumble strips.

108-23A
08-01-08

TRAFFIC CONTROL PLAN

Stage 1 - The Contractor shall close IA 9 to traffic for the replacement and repair of the mainline culverts at STA 23+10 and STA 94+90 as specified in Tabulation 104-13. See Sheet J.2 for the traffic control layout. The Iowa DOT will coordinate the traffic control and signage until Stage 1 work is complete.

Stage 2- After completion of the Stage 1 work, through traffic shall be maintained at all times during construction.



The Contractor shall coordinate traffic control with other project in the area.

111-01
04-17-12

COORDINATED OPERATIONS

Other work in progress during the same period of time will include the construction of the projects listed. Coordinate operations with those of other contractors working within the same area.

| Project | Type of Work |
|----------------------------|--------------|
| To be discussed at pre-con | |
| | |
| | |

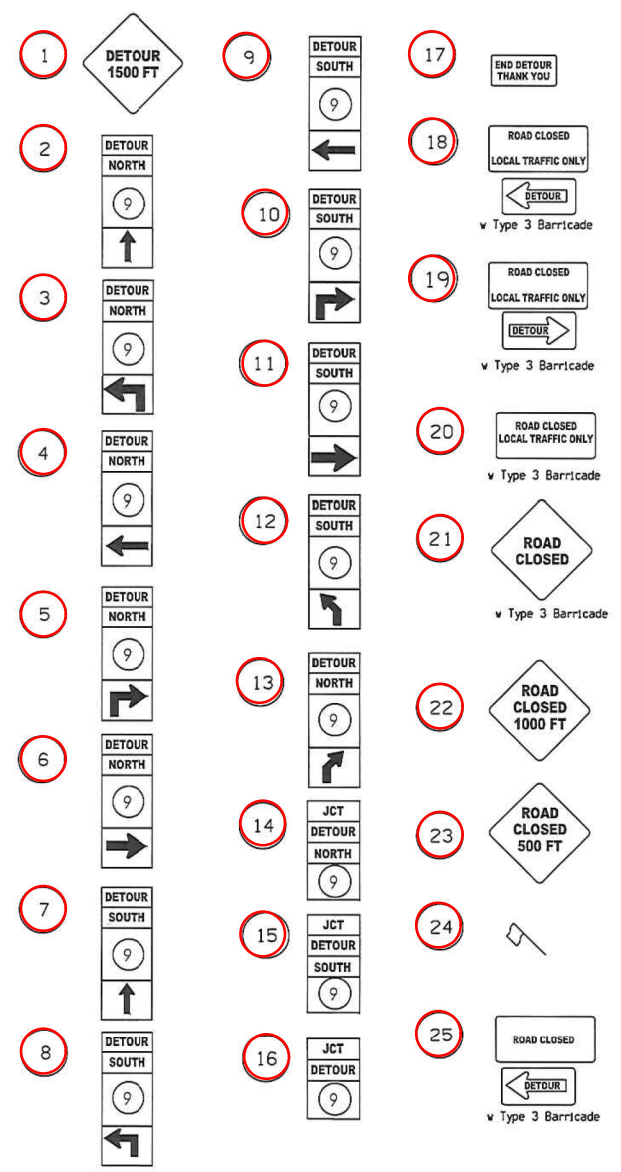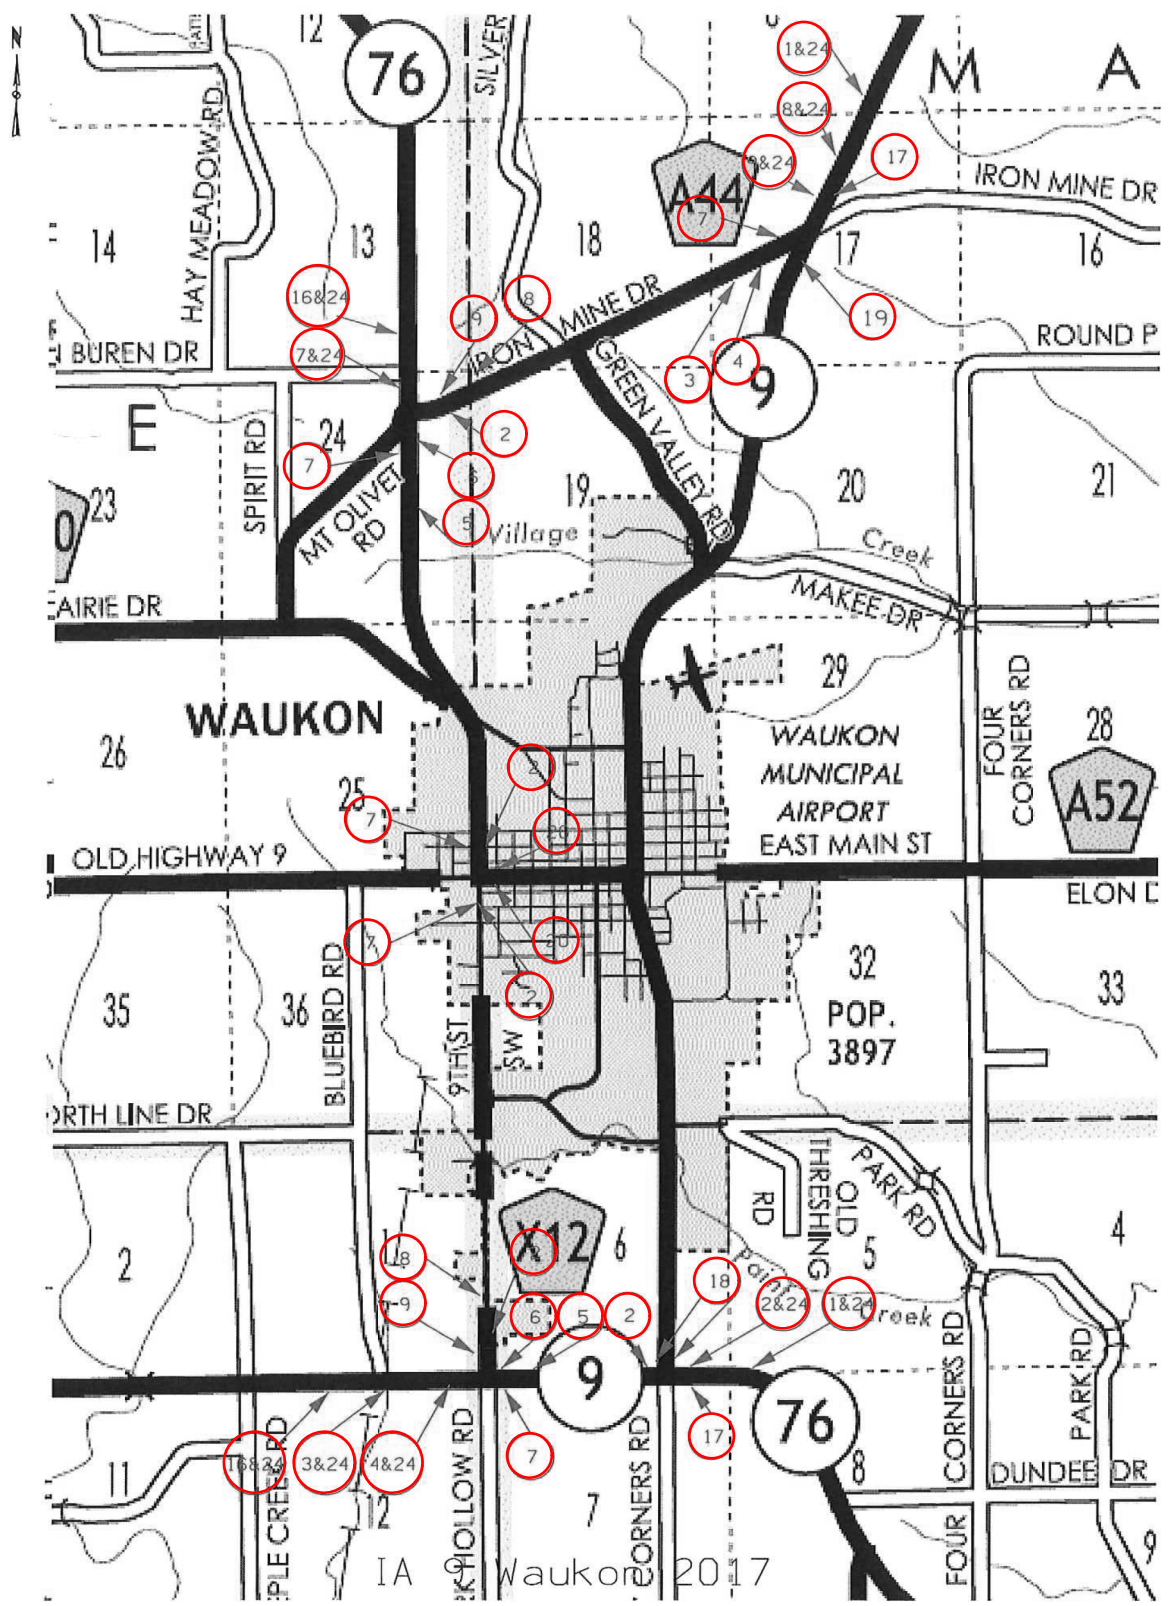

SIGN INVENTORY FOR DETOUR

| I.D. number | Size |
|--|-------------------------------------|
| JCT | M2-1 24" x 12" |
| DETOUR | M4-8 24" x 12" |
| EAST | M3-2 24" x 12" |
| WEST | M3-4 24" x 12" |
| ← | M6-1 24" x 12" |
| ↙ | M5-1B 24" x 24" |
| ↘ | M5-1 24" x 24" |
| ↔ | M6-4 24" x 24" |
| ↕ | M6-6 24" x 24" |
| ↑ | M6-3 24" x 12" |
| ↗ | M5-2 24" x 24" |
| 9 | M1-5A 24" x 24" |
| ROAD CLOSED MILES AHEAD LOCAL TRAFFIC ONLY | R11-3a 60" x 30" |
| ← | M4-10 48" x 18" |
| END DETOUR THANK YOU # 812 514056 | 60" x 36" |
| DETOUR 1500 FT | W20-2 48" x 48" with Flag Trees |
| High Level Warning Devices (Flag Trees) | Refer to section 6F.62 in the MUTCD |
| ROAD CLOSED | R11-2 48" x 48" with Flag Trees |
| ROAD CLOSED 1000 FT | W20-3 48" x 48" with Flag Trees |
| ROAD CLOSED 500 FT | W20-3 48" x 48" with Flag Trees |

SHEET PROVIDED FOR INFORMATION ONLY
DETOUR SIGNED BY THE
IOWA DEPARTMENT OF TRANSPORTATION