No.	DESCRIPTION					
A Sheets	Title Sheets					
A.1	Title Sheet					
A.2	Location Map Sheet					
C Sheets	Quantities and General Information					
C.1	Estimated Project Quantities and Reference Notes					
C.2	Project Description					
C.2	Standard Road Plans					
C.2	Index of Tabulations					
C.2	General Notes					
C.2 Tabulations						
CS Sheets	Soils Tabulations					
CS.1	Soils Tabulations					
D Sheets	Mainline Plan and Profile Sheets					
* D.1 - 5	US 6 As-Builts (For Information Only)					
J Sheets	Traffic Control and Staging Sheets					
J.1	Traffic Control Plan					
O Sheets	Soils Sheets					
* 0.1	U.S. 6 Site No. 1 Soils Sheet					
* Q.2	U.S. 6 Site No. 2 Soils Sheet					
Q.3	U.S. 6 Site No. 1 General Notes					
Q.4	U.S. 6 Site No. 2 General Notes					
W Sheets	Mainline Cross Sections					
W.1 - 3	Site 2 Cross Sections					
	* Color Plan Sheets					



PLANS OF PROPOSED IMPROVEMENT ON THE

ROAD

MUSCATINE SLIDE REPAIR

1.2 mi E of Co Rd X46 to 1.1 mi W of IA 38 (2 Locations)

SCALES: As Noted

Refer to the Proposal Form for list of applicable specifications.

Value Engineering Saves. Refer to Article 1105.14 of the Specifications.



REVISIONS

For Project Location Map Refer to Sheet No. A.02

DESIGN DATA RURAL 2019 AADT

20-- AADT _--_ V.P.D. _--_ V.P.H. 20-- DHV TRUCKS

ı	Total		
ı	Design	ESALs	

-	SHEET NO.	NAME	TYPE
	A.1	Paul W. Flattery	Primary Signature Block
	M• 1	Taul W. Hactery	Titilially Signature block
	CS.1	Mark A. Dell	Geotechnical Design
-			

INDEX OF SEALS

ROADWAY DESIGN

I hereby certify that this engineering document was prepared by me or under my direct personal supervision and that I am a duly licensed Professional Engineer under the laws o the State of Iowa.

18

PROJECT IDENTIFICATION NUMBER 19-70-006-010

> PROJECT NUMBER STPN-006-8(41)--2J-70 R.O.W. PROJECT NUMBER STPN-006-8(42)--2J-70

01-04-2022

Printed or Typed Name My license renewal date is December 31, 2023

Pages or sheets covered by this seal: A.1-A.2, C.1-C.2, D.1-D.5, J.1


DESIGN TEAM Flattery \ Jack ENGLISH

MUSCATINE COUNTY

STPN-006-8(41)--2J-70 PROJECT NUMBER

SHEET NUMBER

A. 1

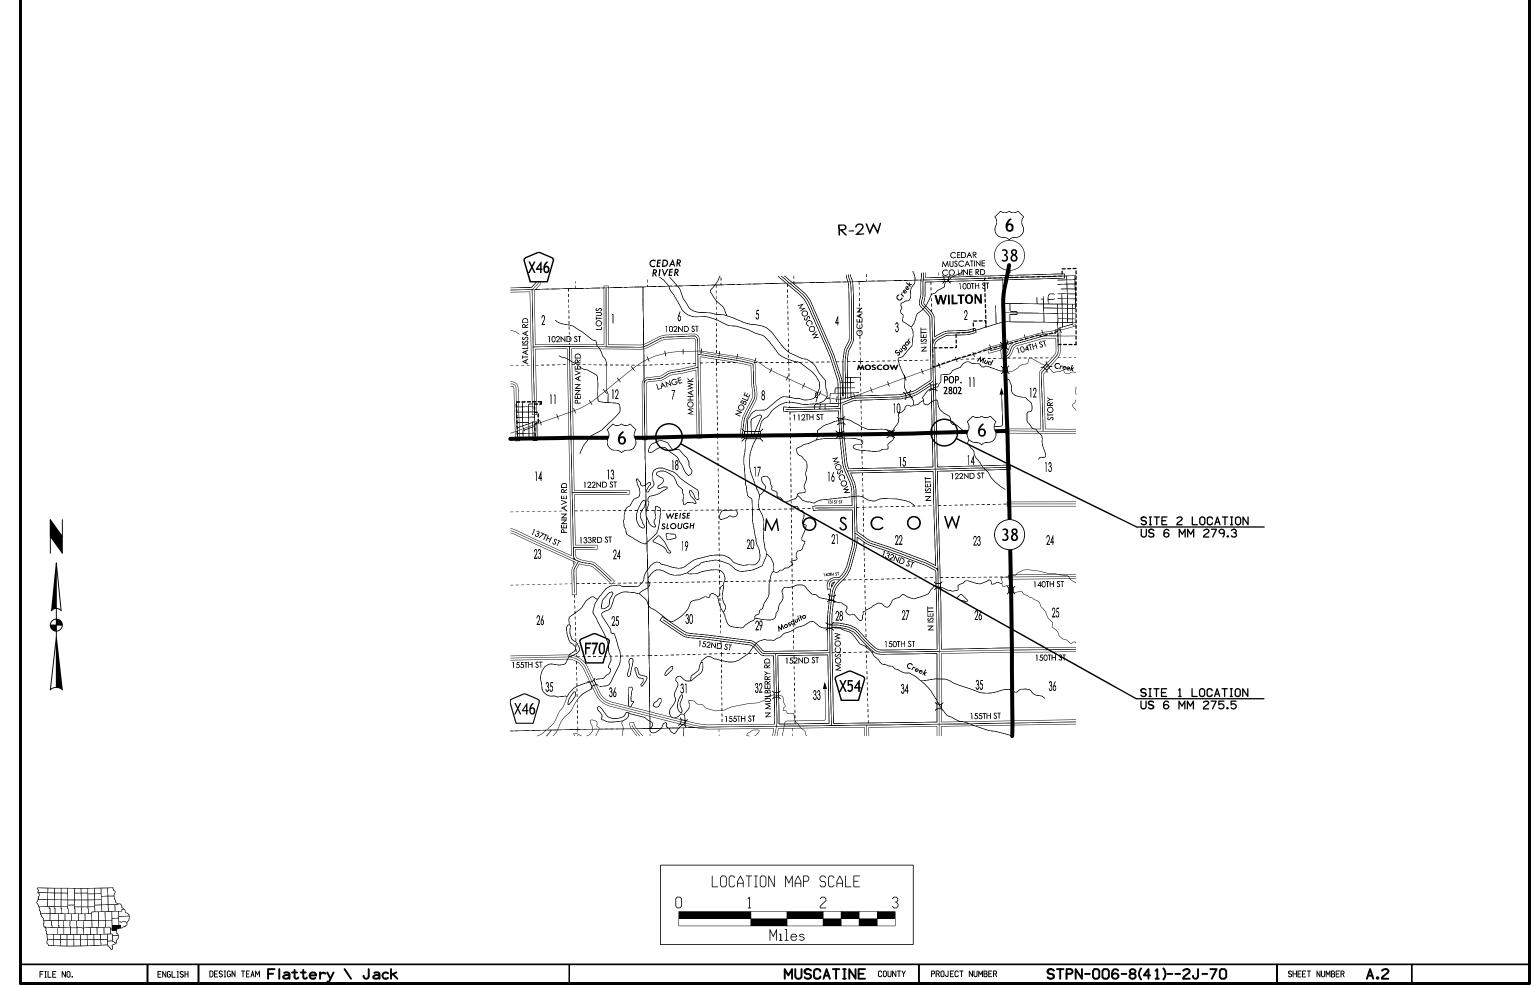

ESTIMATED PROJECT QUANTITIES AND REFERENCE NOTES

Item no.	Item Code	Item	Unit	Quantities Estimated Roadway Items	Estimate Reference Notes
1	2102-2710090	EXCAVATION, CLASS 10, WASTE	CY	261	See Tab. 103-12 in the CS Sheets and the Q Sheets for locations and details. Overhaul will not be measured or paid for, but shall be considered incidental to excavation on this project.
2	2505-6000111	HIGH TENSION CABLE GUARDRAIL	LF	350	See Tab. 108-9A for locations and details.
3	2505-6000121	HIGH TENSION CABLE GUARDRAIL, END ANCHOR	EACH	2	
4	2507-2638620	MACADAM STONE SLOPE PROTECTION	SY	240	See Tab. 103-12 in the CS Sheets and the Q Sheets for locations and details.
5	2507-3250005	ENGINEERING FABRIC	SY	526	See Tab. 100-23 and Tab. 103-12 in the CS Sheets and the Q Sheets for locations and details.
6	2507-6800021	REVETMENT, CLASS B	TON	220	See Tab. 103-12 in the CS Sheets and the Q Sheets for locations and details.
7	2507-6800061	REVETMENT, CLASS E	TON	34	See Tab. 100-23 in the CS Sheets and the Q Sheets for locations and details.
8	2507-8029000	EROSION STONE	TON	465	See Tab. 103-12 in the CS Sheets and the Q Sheets for locations and details.
9	2526-8285000	CONSTRUCTION SURVEY	LS	1	
10	2528-8445110	TRAFFIC CONTROL	LS	1	
11	2533-4980005	MOBILIZATION	LS	1	

Roadway Items: Roadway Items

Design Team :Flattery\Jack County Name :Muscatine Project Number:STPN-006-8(41)--2J-70 08/31/2021 11:50 AM SHEET C.1

100-1D 10-18-05

PROJECT DESCRIPTION

This project is for repairs at 2 locations on US 6 in Muscatine County. The first site will involve installing a rock flume for scour protection and the second site will involve repairing the foreslope and adding scour protection and cable guardrail.

105-4 10-18-11

STANDARD ROAD PLANS

	STANDARD ROAD PLANS								
		The following Standard Road Plans apply to construction work on this project.							
Number	Date	te Title							
BA-351	10-19-21	High Tension Cable Guardrail							
EW-302	2 10-20-15 Special Shaping for High Tension Cable Guardrail at Median Obstacles								
TC-1	10-15-19 Work Not Affecting Traffic (Two-Lane or Multi-Lane)								
TC-202	10-19-21	Work Within 15 ft of Traveled Way							

108-9A 04-20-10

①Lane(s) to which the installation is adjacent.

HIGH TENSION CABLE GUARDRAIL

insta	allation is a	djacent.				Refer to B	BA-351.			
		Location	on Dimensions					Bid Ite	ems	
No.	Direction of 1 Traffic	Station	Side	Offset D ₀	Approach C _A	Obstacle C _o	Trailing C _T	Protection Length $(C_A+C_\theta+C_T)$	End Anchor	Remarks
				FT	FT	FT	FT	FT	No.	
	WB	903+95.00	Out	6.0	145.0	100.0	105.0	350.0	2	
	TOTALS:							350.0	2	

262-6 10-18-05

UTILITIES

(NOT A POINT 25 PROJECT)

This is NOT a POINT 25 project and is not subject to the provisions of IAC 761-115.25.

FILE NO. ENGLISH DESIGN TEAM Flattery\Jack

MUSCATINE COUNTY PROJECT NUMBER

STPN-006-8(41)--2J-70

SHEET NUMBER C

100-23 04-17-18


ROCK EROSION CONTROL


				R	efer to	EC-301 and De	tail 570-8	3						
Lo					Rock Erosion Control (REC)					ial Bid Quan	itities			
						Type 1	Type 1 Type 2		Type 4	Type 5	Eng.	Class E	Erosion	
Road Identification	Begin Station	End Station	Side			Rock Ditch	Rock Ditch	Rock Flume	Rock Splash		Fabric	Revetment	Stone	Remarks
	1900 1000000000000000000000000000000000		Lt./Rt.	FT	FT FT	Check	Ditth	Fiume	Basin	Protection	SY	TON	TON	
US 6	699+49.00	699+74.00	Rt	43	6			x			32.0	34.0		
= = ==														
				1				1		1		1		


103-12 MOD


7	1	T	D	C	D	E	D	Λ	T	R	
9	_	4	$\boldsymbol{\nu}$	_	\mathbf{n}	L	г	Н	4	n	


Site No.	Loca Begin Sta.	End Sta.	Side	Class 13 Excavation Waste	Embankment-in- Place	Excavation, Roadway and Borrow	Class 10 Waste	Class "B" Revetment	Engineering Fabric	Erosion Stone	 Macadam Stone Slope Protection SY	Top: Furnish & Spread CY	soil Strip, Salvage & Spread CY	Remarks
2	901+70.00	902+40.00	1				261	220	494	465	240			
													THE PROPERTY OF THE PROPERTY O	

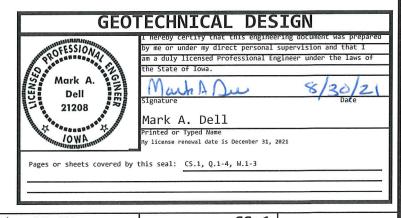


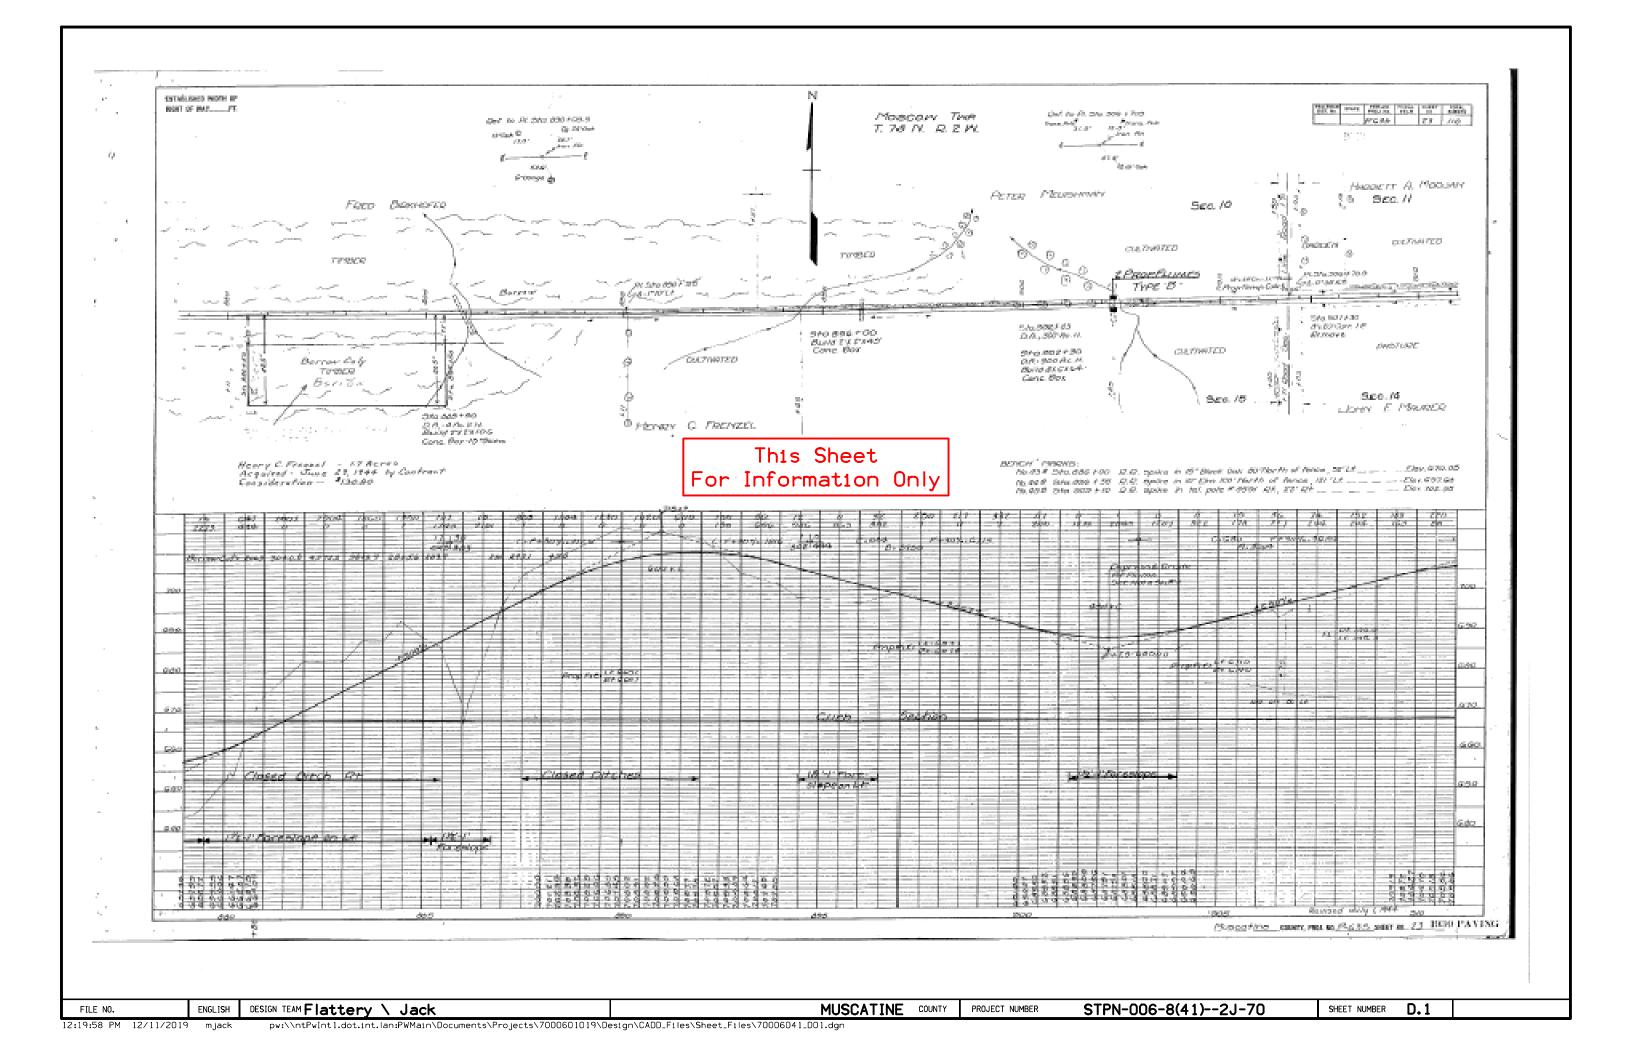

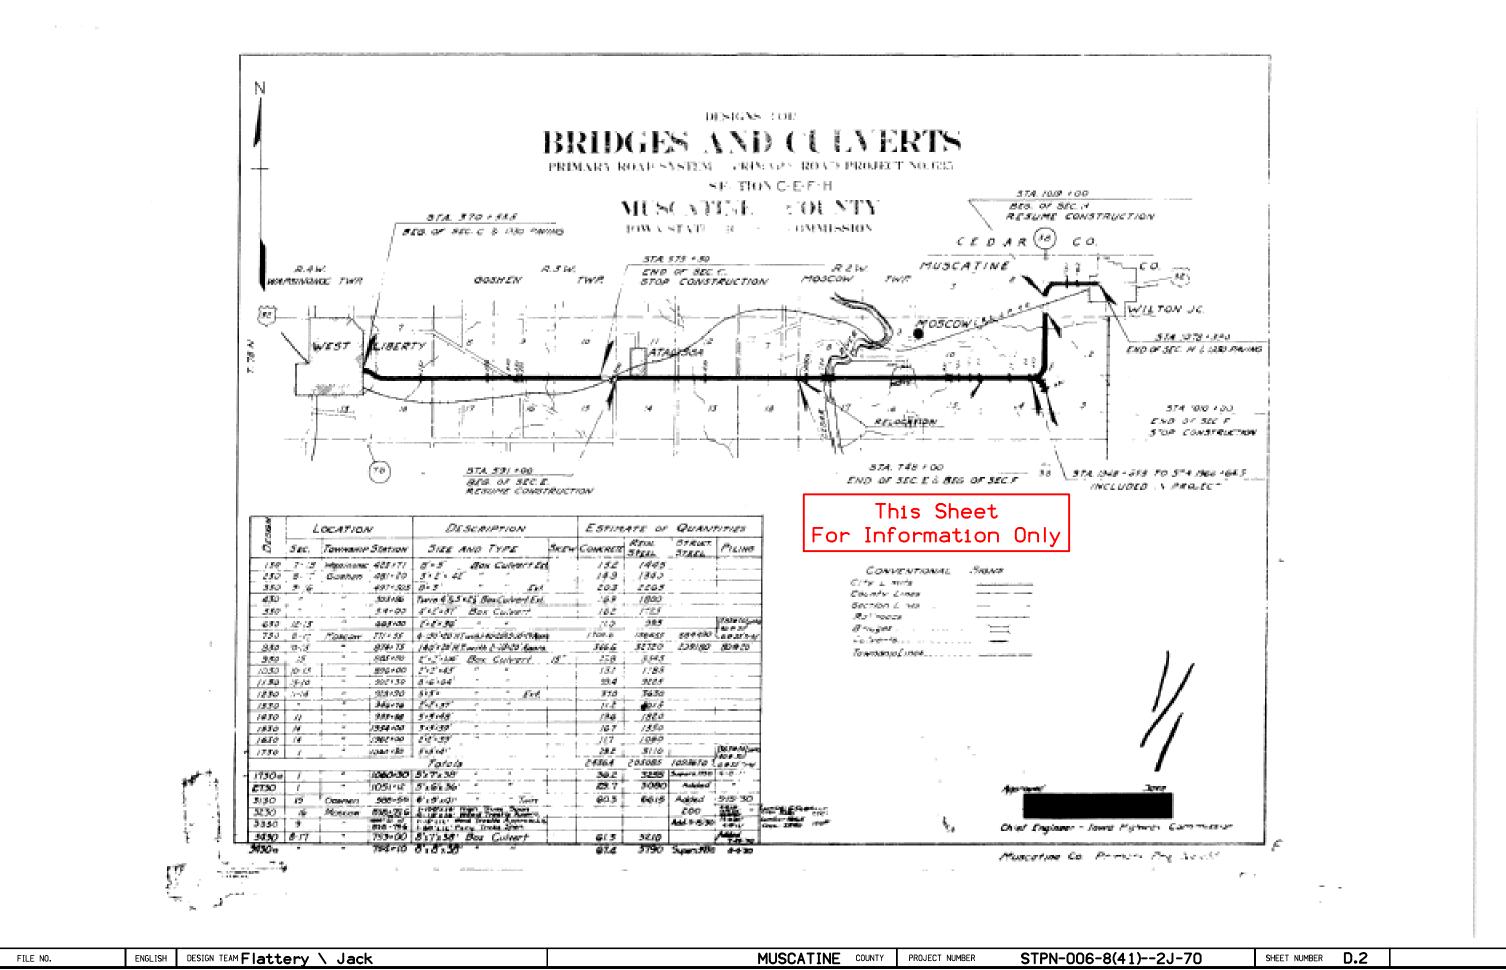

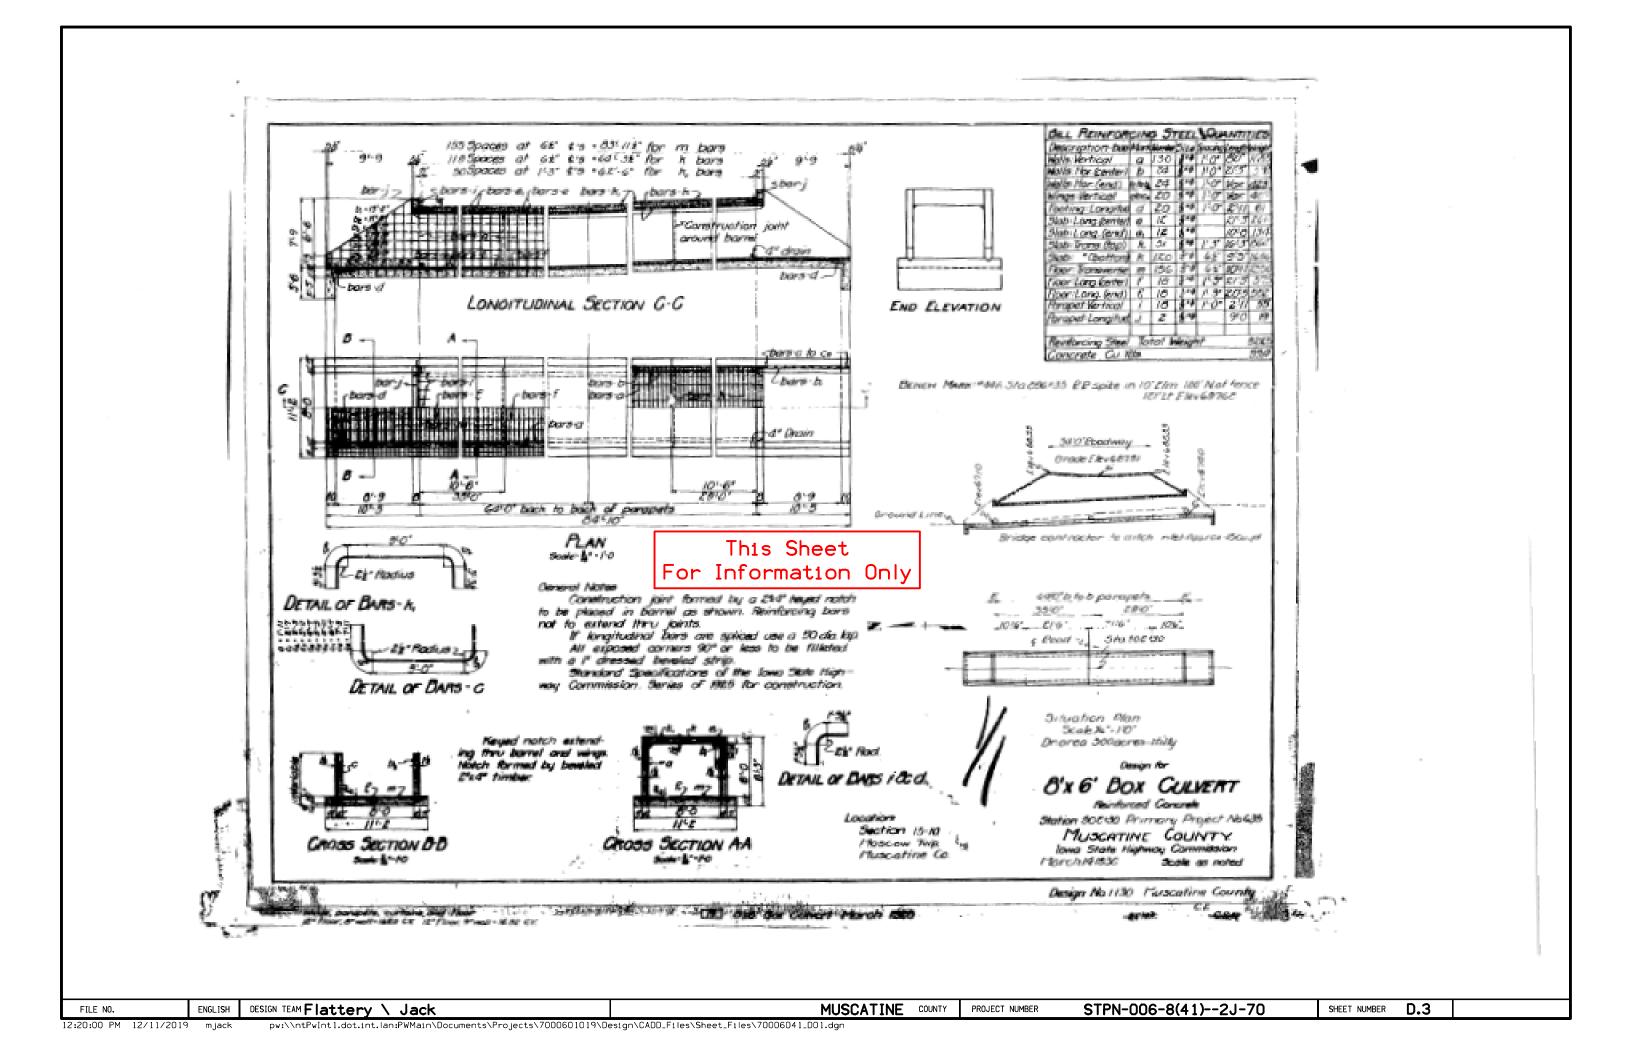

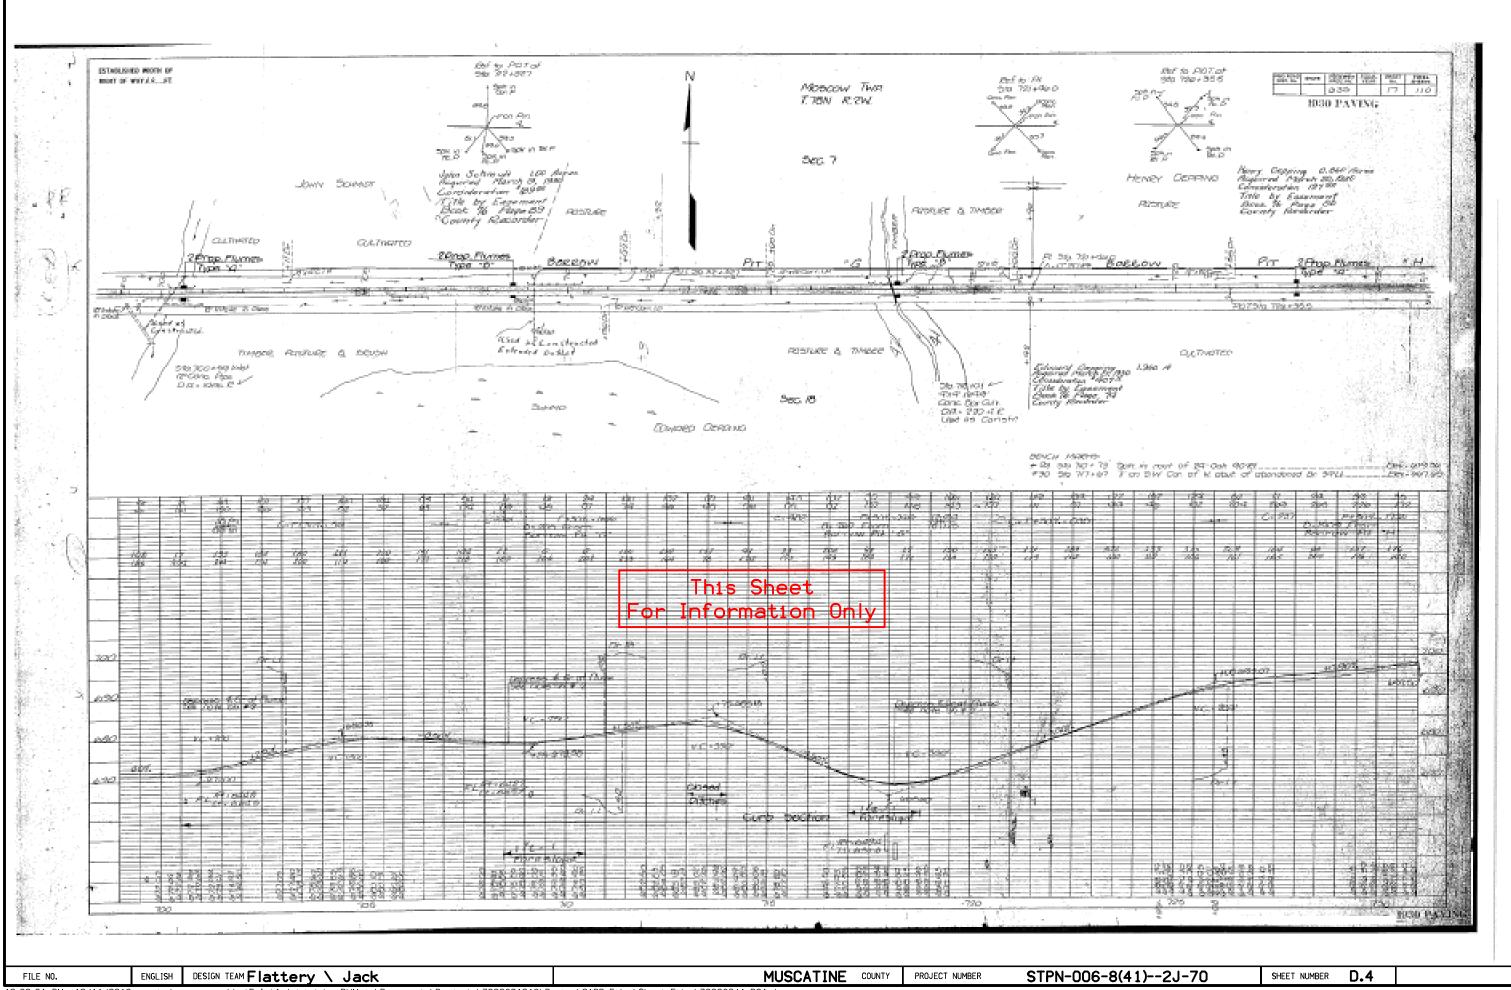

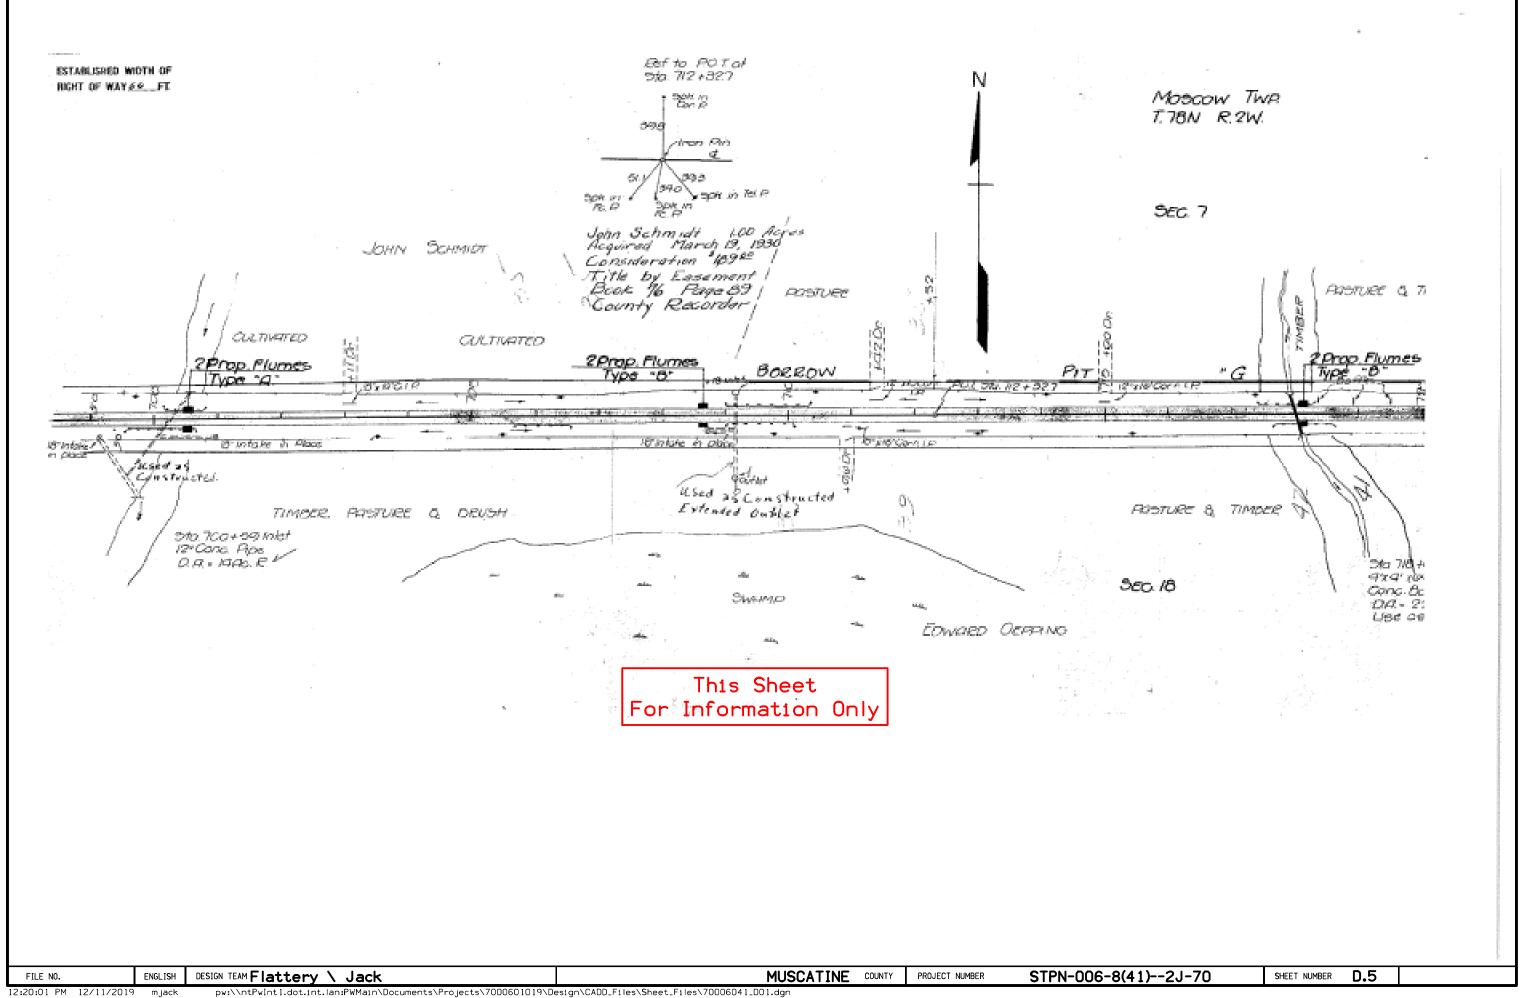

	108-23A 08-01-08
TRAFFIC CONTROL PLAN	
on US 6 shall be maintained at all times.	
	į
	1

108-25 10-21-14

511 TRAVEL RESTRICTIONS

Route	Direction County	Location Description	Feature Crossed	Object Type	Maint. Bridge No., Structure ID, or FHWA No.	Type of Restriction	Existing Measurement	Construction Measurement	Construction Measurement as Signed	Projected As Built Measurement	Remarks
		None anticipated at this time.									

111-01 04-17-12


COORDINATED OPERATIONS


Other work in progress during the same period of time will include the construction of the projects listed. Coordinate operations with those of other contractors working within the same area.

Project	Type of Work					
None Provided						

FILE NO. ENGLISH DESIGN TEAM Flattery\Jack

MUSCATINE COUNTY PROJECT NUMBER STPN-006-8(41)--2J-70 SHEET NUMBER J.1

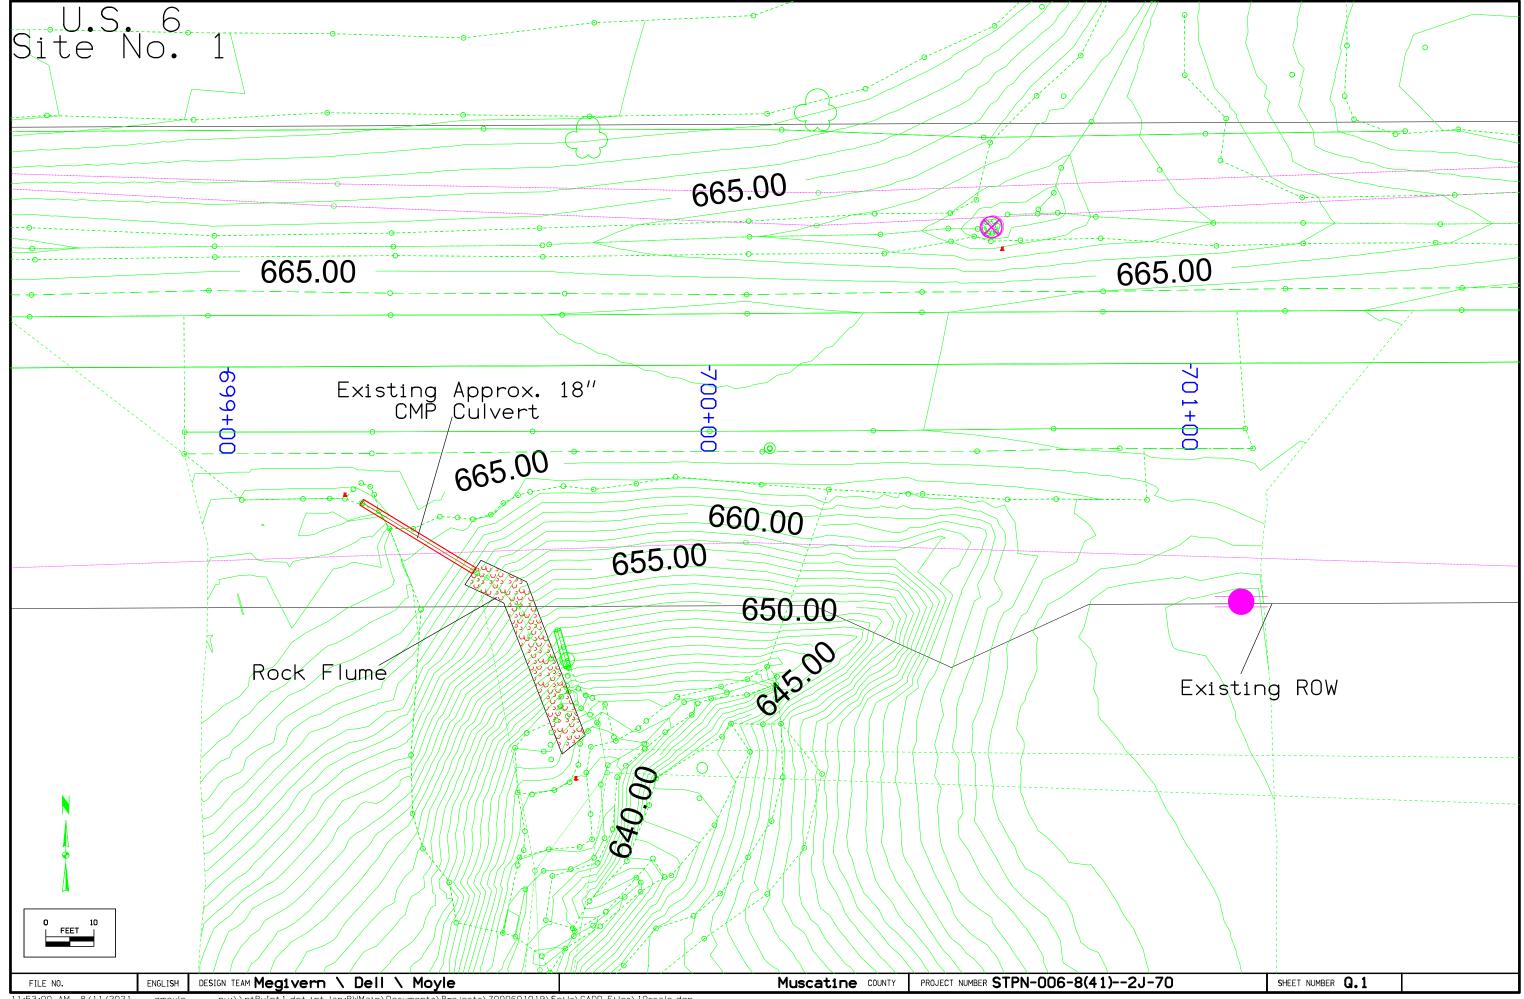

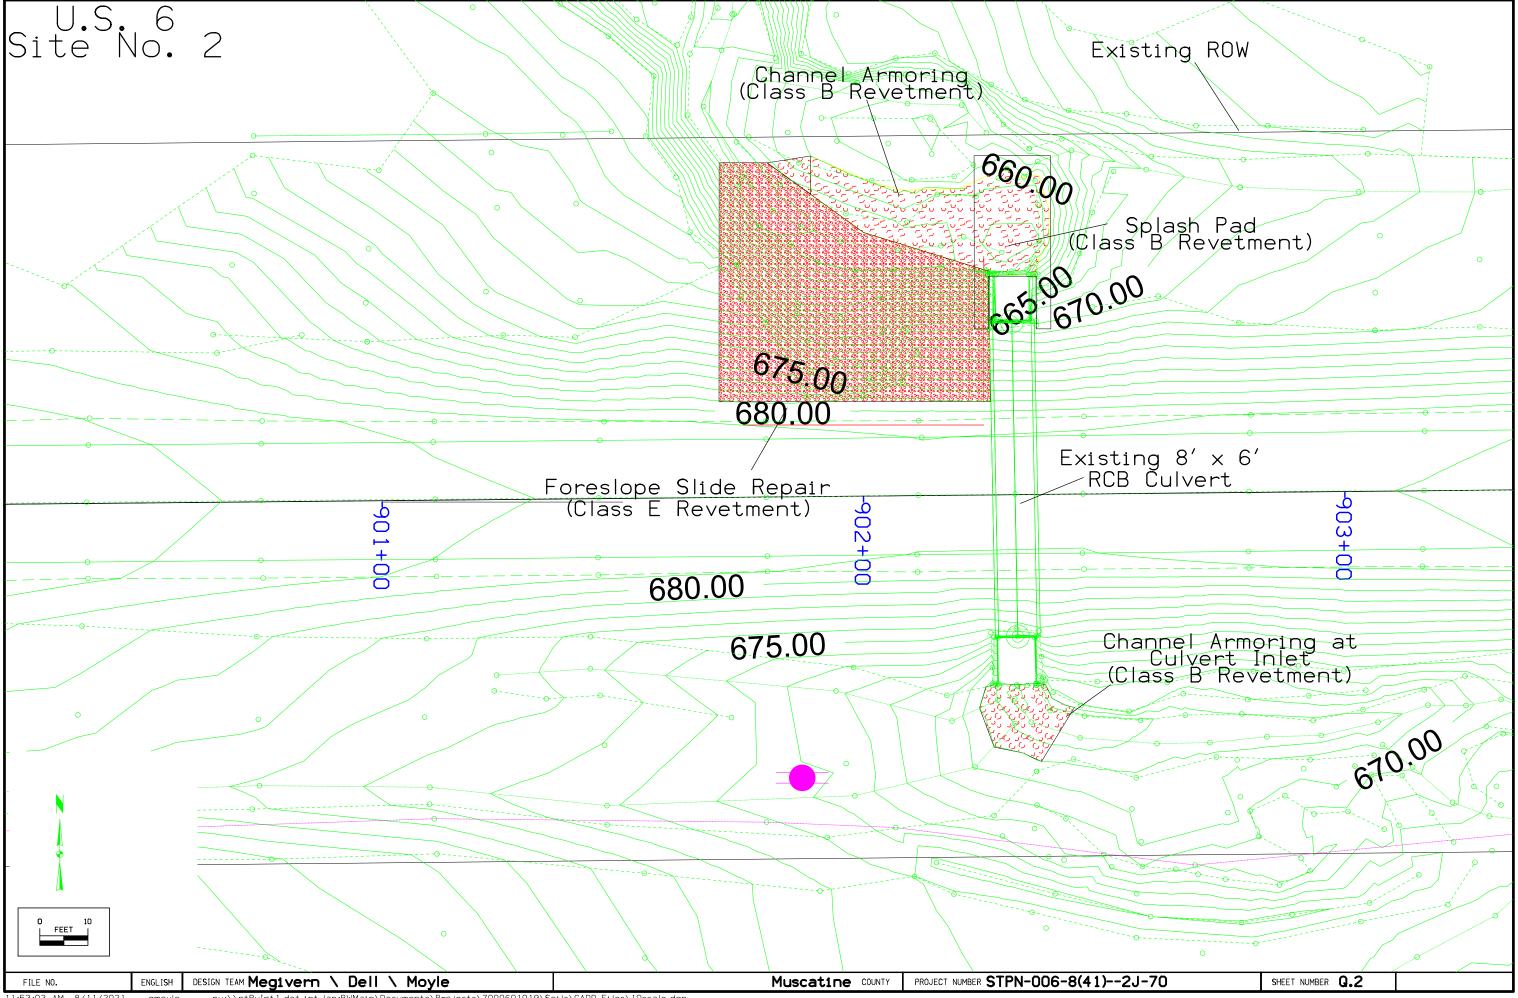

US 6, Muscatine Co. Site No. 1, near Station 699+71 Scour Protection

GENERAL NOTES:

The design intent is to install a rock flume at the outlet of an existing 18-inch diameter CMP culvert located on the south (right) side of US 6. This culvert conveys water that flows within the south roadway ditch down into an existing drainage ravine. The culvert outlet is located within Iowa DOT Right of Way near Station 699+50 at an offset of about 43 feet right of roadway centerline. However, be aware that the rock flume will extend off of DOT ROW into State of Iowa property managed by the Iowa State Conservation Commission (DNR). Refer to the Q.1 Sheet for the plan location of the existing CMP culvert and proposed flume.

As a result of previous erosion, the end of the existing CMP culvert currently extends about 6 to 8 feet out beyond the face of the foreslope surrounding the pipe. Prior to constructing the rock flume, that portion of the eroded foreslope immediately surrounding the pipe shall be rebuilt up to the mid-point of the pipe using Erosion Stone underlain with Engineering Fabric.

The rock flume shall begin at the invert elevation of the outlet (660.5 feet) and extend downslope to about Elevation 639 feet. The 6-foot wide flume shall be constructed using Class E Revetment underlain with Engineering Fabric. Refer to the Standard Road Plan for Rock Erosion Control (EC-301) and the Rock Erosion Control tab (100-23) for additional details. Any exposed Erosion Stone shall be armored with Class E Revetment.

Some amount of clearing and grubbing will be necessary to reconstruct the foreslope and to construct the rock flume. However, removal of any existing vegetation shall be kept to a minimum.

US 6, Muscatine Co. Site No. 2, between Station 901+65 and 902+26 Slide Repair and Scour Protection

GENERAL NOTES:

The design intent is to repair the foreslope slide that has occurred along the north side of the US 6 near the City of Moscow, Iowa, from Station 901+65 to Station 902+26. Be aware that the actual limits of the repair may be found to have changed (enlarged) at the time of construction due to continued slope movements.

The eastern limits of the proposed repair corresponds to the end segment of an existing 8'x 6' RCB culvert protruding from the foreslope at Station 902+30. The drainage channel below the culvert outlet has degraded so that the present channel bottom at the outlet is about 4 to 5 feet below the invert elevation of the culvert. The erosion has also migrated toward the roadway resulting in the slope instability.

To make the repair, cut benches in the existing foreslope and waste excavated material off-site. Place engineering fabric meeting Standard Specification 4196.01-3 on the benches, overlapping the edges of the laid fabric a minimum of 2 feet on the sides and ends. Place Erosion Stone on the fabric to rebuild the slope to an approximate 1.5:1 or slightly flatter angle of repose. Erosion Stone on the rebuilt foreslope shall then be capped with a 1-foot thick layer of Macadam Stone Base Materials (Gradation No. 13, without choke stone coarse). Due to the relative steepness of the rebuilt slope, minor benches in the Erosion Stone may be necessary prior to placing the Macadam Stone. The rebuilt foreslope shall transition back to the existing foreslope and channel bank geometries to the west of the repair.

To help maintain the integrity of the roadway, the foreslope shall be benched in segments having a maximum longitudinal (parallel to the roadway) length of 25 feet, starting at the bottom of the slope and working upward. The excavated benches shall not be left exposed overnight. Rather, each excavated/opened segment of the foreslope shall be rebuilt with the Erosion Stone prior to quitting for the day or continuing on to the next segment. Difficulties maintaining a stable slope during construction shall be immediately reported to the Engineer.

A portion of the channel near the rebuilt foreslope and at the RCB culvert outlet shall be armored using Class B Revetment to protect the new foreslope toe. The armoring shall have a minimum thickness of at least 3 feet, have a top elevation of about 660 feet and be underlain with Engineering Fabric. Refer to the cross-sections on the W sheets for details regarding excavation of the cut benches, the rebuilt foreslope and the toe armoring.

The channel armoring shall increase in thickness near the outlet of the RCB culvert to create a relatively level splash pad. The top of this pad shall match the invert elevation the outlet (approximate Elevation 662.79 feet) and have overall top plan dimensions of about 10 feet by 10 feet.

The channel shall also be armored at the inlet with a minimum 3-foot thickness of Class B Revetment underlain with Engineering Fabric. The armoring shall have a top elevation to match the inlet invert elevation (approximately 666 feet) and overall plan dimensions of about 15 feet by 15 feet.

