

TOTAL SHEETS	198
PROJECT NUMBER	NHSX-151-3(112)--3H-57
R.O.W. PROJECT NUMBER	NHS-151-3(112)--19-57
PROJECT IDENTIFICATION NUMBER	92-57140-5

Form 520003wd (11-03)

I hereby certify that this project was constructed in accordance with the contract documents, the "as-built" plans were prepared under my supervision, and that I am a duly licensed Professional Engineer under the laws of the State of Iowa.

Kent L. Ellis *Kent L. Ellis* 1/7/09
 Project Engineer Date

My license renewal date is December 31, 2009

2000 Flynn Company, Inc. Carroll Kraegel
 Year Contractor Project Inspector


Iowa Department of Transportation
Project Development Division

PLANS OF PROPOSED IMPROVEMENT ON THE
PRIMARY ROAD SYSTEM
LINN/JONES COUNTY
Springville to Anamosa
 On U.S. 151
 from N.E. of Springville to N.E. of Anamosa

SCALES: As Noted

The Iowa Department of Transportation Metric Standard Specifications for Highway and Bridge Construction, series of 1995, plus current supplemental specifications and special provisions shall apply to construction work on this project.

Value Engineering Saves. Refer to Standard Notation 203-4 on Sheet C.03

*** 150 ***

INDEX OF SHEETS	
NO.	DESCRIPTION
A.01-A.02	Title Sheet and Legend
A.03	Revision Sheet
B.01-B.10	Typical Cross Sections
C.01-C.21	Estimate of Quantities and General Information
D.01-D.25	Plan and Profile Sheets - Mainline
E.01-E.08	Plans and Profile Sheets - Sideroad
F.01	Plan and Profile Sheets - Detour
G.01-G.18	Reference Ties and Bench Marks and Feno Monuments
J.01-J.09	Staging and Traffic Control Sheets
K.01-K.10	Interchange Geometric Staking, Jointing and Edge Profiles
L.01-L.35	Intersection Geometric Staking, Jointing and Edge Profiles
R.01-R.02	Borrow Sheets
T.01-T.02	Tabulation of Earthwork
U.01-U.08	Standards and Special Detail
V.01-V.18	Culvert Situation Plans, Also Bridges
172-198	PLAN REVISION - 130 th ST. CURVE SB LANE SANITARY SEWER-WATER MAIN EXTENSION 130 th ST.

PROJECT LENGTH SUMMARY			
		105-1	
		09-27-94	
DIV.	LOCATION	m	km
ROADWAY	Sta. 15+40.000 to Sta. 187+10.000	17,170.000	17.170
	STA. EQUATION (SHORTENS PROJECT)		
	Sta. 85+77.352(BK.) = Sta. 85+76.444 (AHD.)	0.908	0.0009
	Subtotal	17,169.092	17.169
BRIDGES	Sta. 76+09.371 to 76+70.389	61.018	0.061
	Sta. 133+99.717 to Sta. 135+32.717	133.000	0.133
	Sta. 157+59.890 to Sta. 158+08.140	48.250	-0.048
	TOTAL LENGTH OF PROJECT	16,926.824	16.926

METRIC STANDARD ROAD PLANS							
The following Standard Road Plans shall be considered applicable to construction work on this project.							
NUMBER	DATE	NUMBER	DATE	NUMBER	DATE	NUMBER	DATE
RC-16A	10/27/98	RF-14	04/25/00	RH-53	10/03/00	RS-2	10/27/98
RC-16B	9/21/99	RF-19C	10/03/00	RK-19A	10/03/00	RS-3	06/06/95
RE-3A	10/03/00	RF-19E	10/03/00	RK-19B	10/03/00	RS-26A	10/28/97
RE-7	10/03/00	RF-30A	03/28/95	RL-1A	10/03/00	RS-50B	02/11/00
RE-47	10/03/00	RF-30B	01/12/99	RL-1B	10/03/00	RS-63A	04/30/96
RE-48A	12/08/95	RF-31	10/28/97	RL-2A	10/03/00	RS-63B	04/30/96
RE-53	10/03/00	RF-38(1)	10/03/00	RL-7	12/13/94	RS-65B	06/06/95
RE-65A	10/03/00	RF-38(2)	10/03/00	RL-9	10/03/00	RS-66(1)	9/21/99
RE-67	10/03/00	RH-19	09/27/94	RL-12	10/03/00	RV-4	04/25/00
RE-68	10/03/00	RH-22	01/12/99	RL-14	01/12/99	RV-5	04/25/00
RE-69A	10/03/00	RH-37D	01/12/99	RL-9	12/08/95	RV-8	04/25/00
RE-76	10/03/00	RH-41B	10/03/00	RL-12	06/06/95	RV-9	04/25/00
RF-1	10/03/00	RH-41D	10/03/00	RL-13	12/13/94		
RF-2	06/06/95	RH-50	04/27/99	RL-14	01/12/99		
RF-3	10/03/00	RH-51	10/03/00	RP-1	04/28/98		
RF-5	10/03/00	RH-52	03/26/96	RP-3	04/28/98		

INDEX OF SEALS		
SHEET NO.	NAME	TYPE
A.01	ROBERT L. LENTZ	Primary Signature Block
C.06	ROBERT L. STANLEY	Geotechnical Design
E.01	MONICA M. SMITH	Side Road Design

DESIGN DATA RURAL			
2-11-00	101-4		
2001 AADT	6,640	V.P.D.	
2021 AADT	7,950	V.P.D.	
2021 DHV	850	V.P.H.	
TRUCKS	11	%	
Total			
Design ESALs			


REVISIONS	
PLAN REVISION	4/03/2001
PLAN REVISION	4/08/2002
PLAN REVISION	4/25/2002
PLAN REVISION	4/08/2004
SIGNATURE BLOCK ON PAGE A-03	

I hereby certify that this plan was prepared under my supervision and that engineering decisions with regard to the design were made by me or by other duly licensed Professional Engineers under the laws of the State of Iowa.

Robert L. Lentz 4 Oct 00
 Signature Date
 Robert L. Lentz
 Printed or Typed Name

My license renewal date is December 31, 2000.

Pages or sheets covered by this seal: A.01-A.02 B.01-B.10, C.01- C.05, C.13-C.21
 D.01-D.25, E.08, F.01, G.01-G.18, J.01-J.09, K.01-K.10, L.01-L.31, R.01-R.02
 T.01-T.02, U.01-U.08, V.01-V.18, W.01-W.14, X.01-X.06

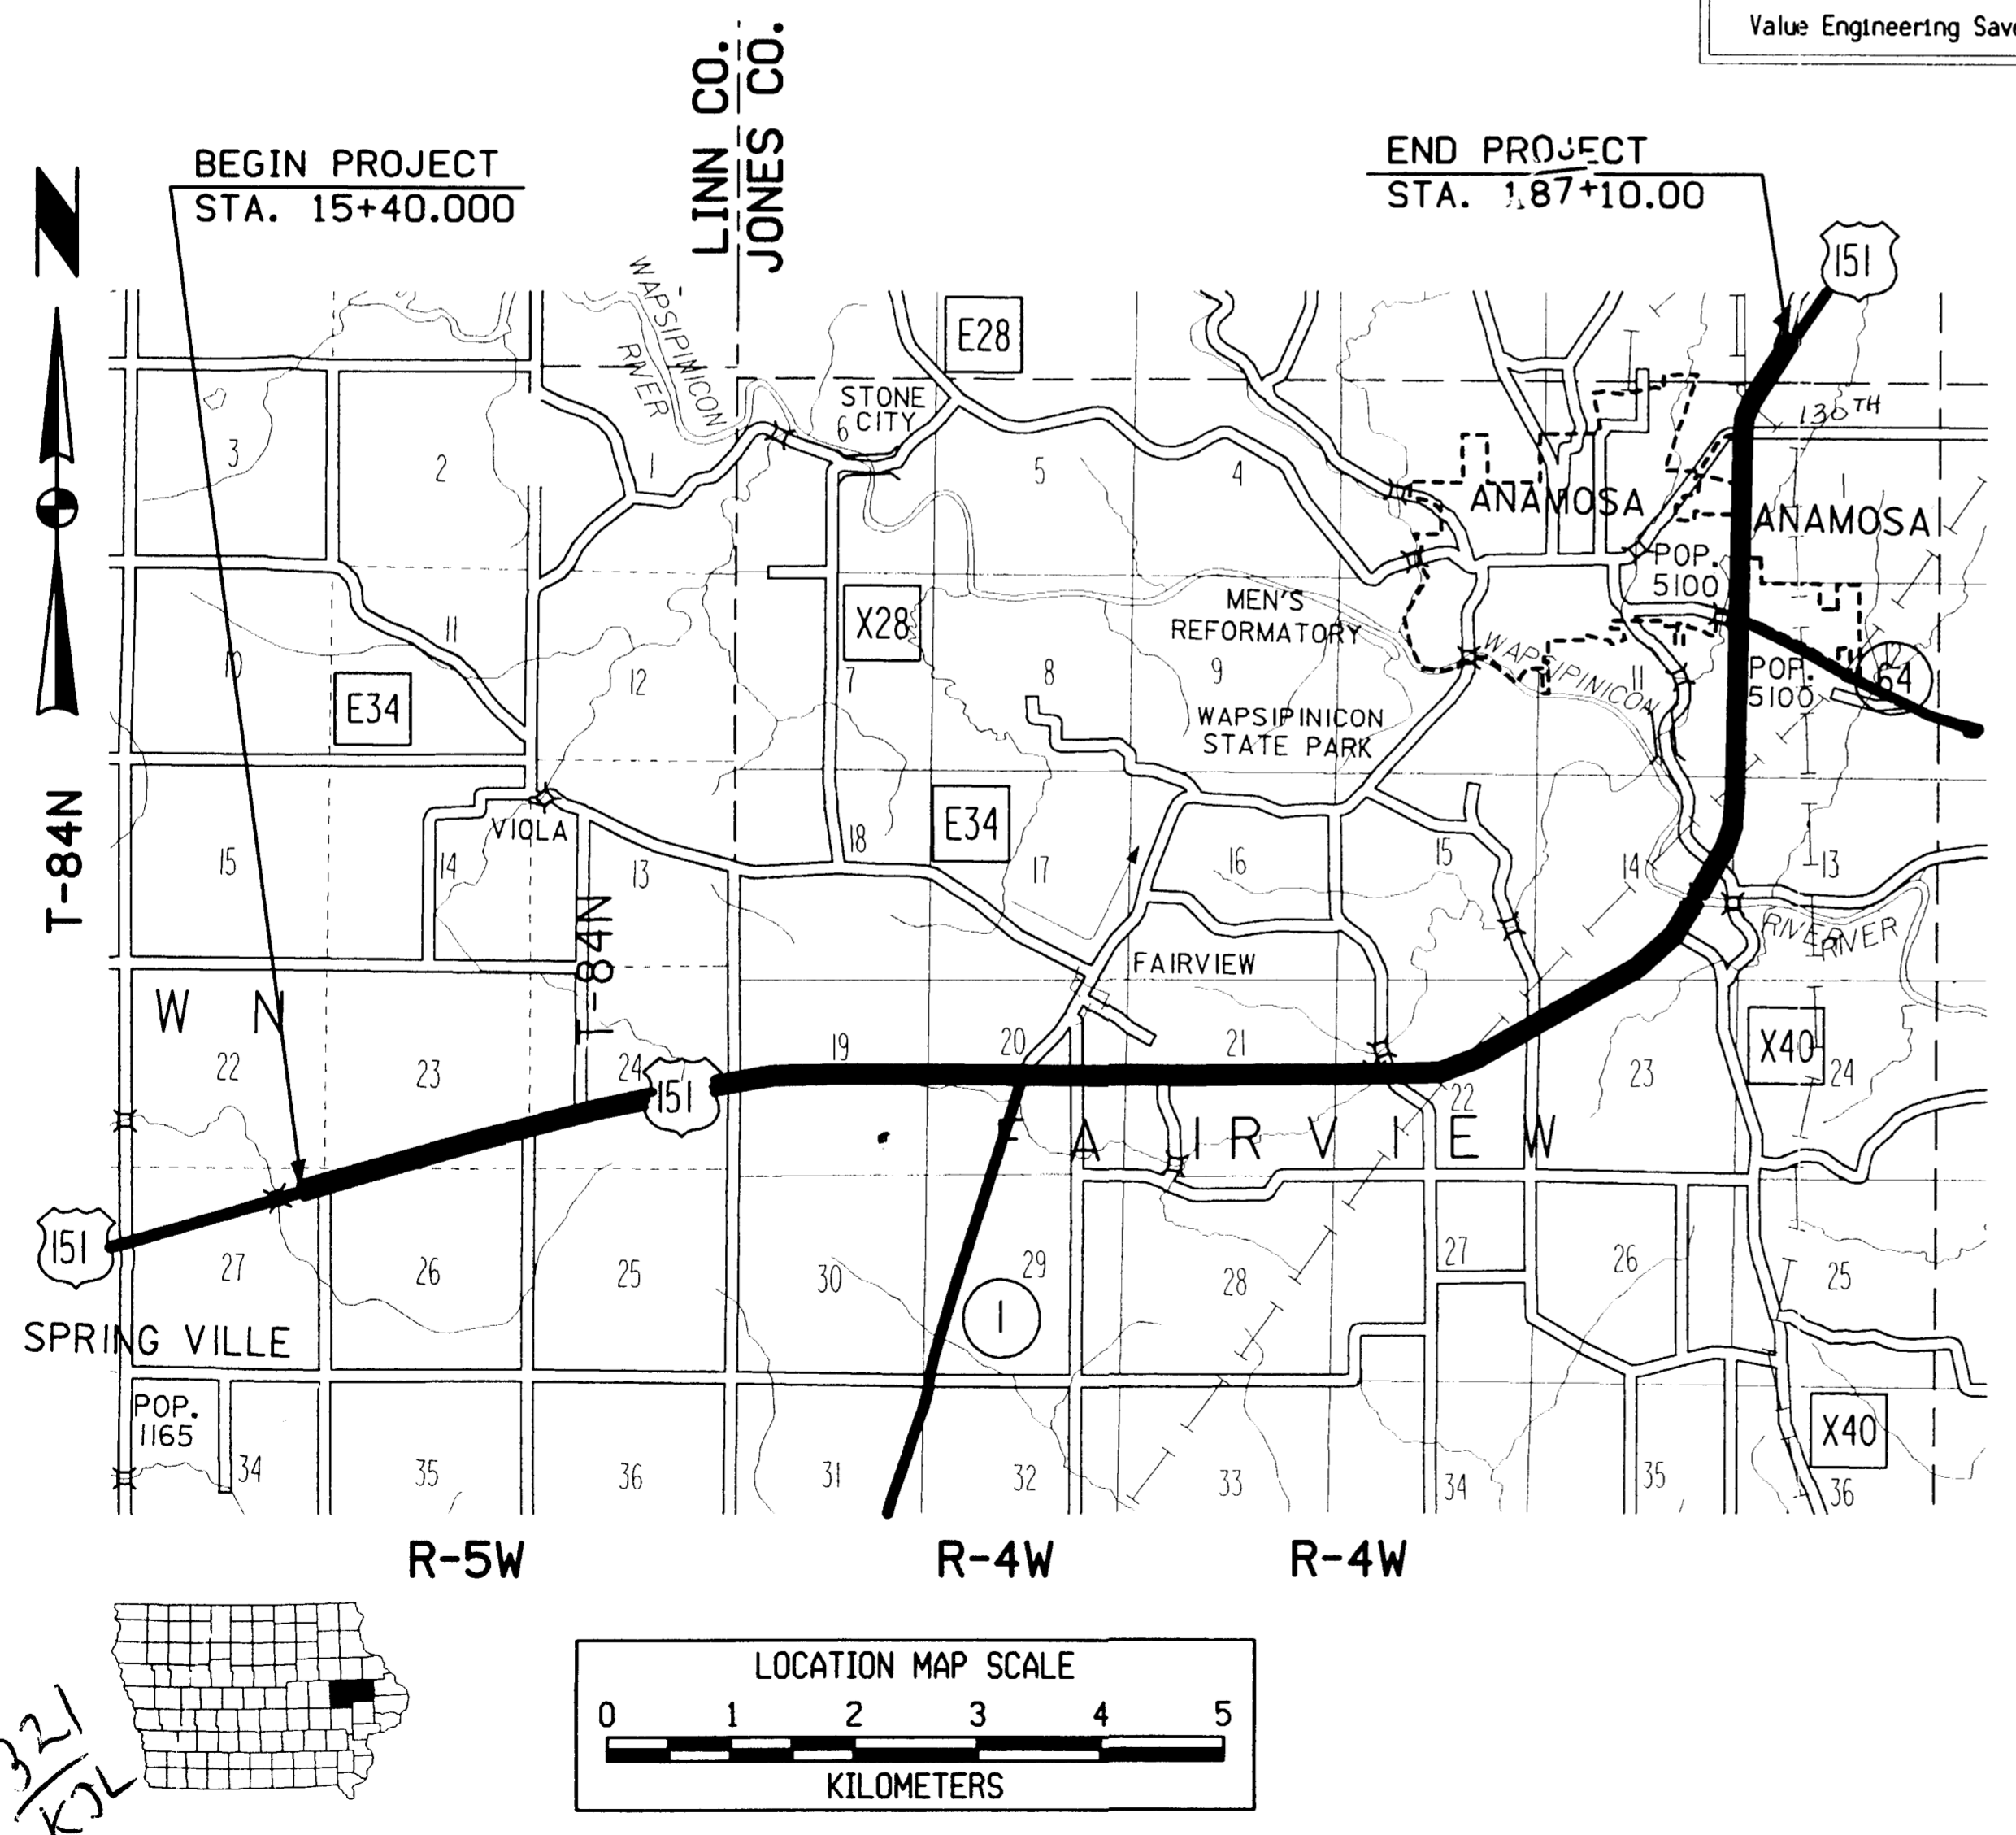

STANDARD SYMBOLS

	Interstate Highway Symbol		Fire Hydrant		Guardrail (Beam or Cable)
	U.S. Highway Symbol		Water Hydrant (Rural)		Guard Post (one or two)
	Iowa Highway Symbol		Septic Tank		Guard Post (over two)
	County Road Highway Symbol		Cistern		Filler Pipe
	Evergreen Tree		L.P. Gas Tank (No Footing)		Gas Valve
	Deciduous Tree		Underground Storage Tank		Water Valve
	Fruit Tree		Latrine		Speed Limit Sign
	Shrub (Bushes)		Luminaire		Mile Marker Post
	Timber		Traffic Signal		SIGN Sign
	Hedge		Traffic Signal with Luminaire		WHU Water Hook Up
	Stump		Telephone Pedestal		RT Radio Tower
	Swamp		TVP Television Pedestal		EB Electric Box
	Rock Outcrop		Telephone Pole		TCB Traffic Signal Control Box
	Broken Concrete		Telephone Pole (Second Company)		RRB Rail Road Signal Control Box
	Revetment (Rip Rap)		Telephone Pole (Third Company)		TSB Telephone Switch Box
	Cemetery		Telephone Pole (Fourth Company)		G/W Guy Wire
	Grave		Telephone Pole (Fifth Company)		TM Fiber Optics Marker
	Cave		Power Pole		Access Control Fencing
	Sink Hole		Power Pole (Second Company)		
	Board Fence		Power Pole (Third Company)		
	Chain Link Fence		Power Pole (Fourth Company)		
	Barbwire Fence		Power Pole (Fifth Company)		
	Security Fence		Electrical Highline Tower (Metal or Concrete)		
	Woven Fence		Telephone Riser Pole		
	Barbwire and Woven Fence		Power Riser Pole		
	Terrace		Telegraph Pole		
	Earth Dam or Dike (Existing)		Satellite TV Dish		
	Earth Dam or Dike (Proposed)		Existing Water Line		
	Tile Outlet		Existing Water Line (Second Company)		
	Edge of Water		Existing Sanitary Sewer Line		
	Existing Drainage		Existing Telephone Line		
	Proposed Drainage		Existing Telephone Line (Second Company)		
	Right of Way Rail or Lot Corner		Existing Fiber Optics Telephone Line		
	Concrete Monument		Existing Storm Sewer Line		
	Well		Existing Gas Line		
	Windmill		Existing High Pressure Gas Line		
	Beehive Intake		Existing Gas Line (Second Company)		
	Existing Intake		Existing High Pressure Gas Line (Second Company)		
	Proposed Intake		Existing Power Line		
	Existing Utility Access (Manhole)		Existing Power Line (Second Company)		
	Proposed Utility Access (Manhole)		Cable Television Line		

UTILITY LEGEND

	Iowa D.O.T. Maintenance Building 704 E. First Street Anamosa, Iowa 52205
	IES Utilities Inc. 105 Kraiburg Boulevard Lisbon, Iowa 52253 1-319-455-0075
	Linn County Rural Electric Cooperative Association 999 35th Street P.O. Box 69 Marion, Iowa 52302 1-319-377-1587
	Maquaketa Valley Rural Electric Cooperative Association 109 North Humber Street Anamosa, Iowa 52205 1-319-462-3542
	Iowa Communications Network Hoover Building, Level A Des Moines, Iowa 50319 1-515-242-5314
	MCI Telecommunications Corporation 500 Second Avenue S.E. Cedar Rapids, Iowa 52401 1-319-375-1908
	Martelle Coop Telephone Association P.O. Box 128 Martelle, Iowa 52305 1-319-482-2381
	Amoco Pipeline Company 2192 N. Hwy 965 North Liberty, Iowa 52317 1-800-548-6482
	Northern Natural Gas 5557 County D Platteville, Wisconsin 53818 1-608-348-2738
	Martelle Coop Telephone Association P.O. Box 128 Martelle, Iowa 52305 1-319-482-2381
	Springville Co-Operative Telephone Association, Inc. 207 Broadway Street Springville, Iowa 52336 1-319-227-7111
	U.S. West Communications 615 3rd Avenue SE Cedar Rapids, Iowa 52401 1-319-399-7820
	City of Anamosa City Hall 107 S. Ford Street Anamosa, Iowa 52205
	City of Anamosa City Hall 107 S. Ford Street Anamosa, Iowa 52205

RIGHT OF WAY LEGEND

	Proposed Right of Way
	Existing Right of Way
	Existing and Proposed Right of Way
	Easement and Existing Right of Way
	Borrow
	Easement (Temporary)
	Easement
	Excess
	Property Line
	A/C Access Control

CONVENTIONAL SIGNS

	Survey Line
	Section Corner
	Proposed Profile Grade
	Railroad
	Field Tile
	Culverts
	Stream


Legend And Symbol Information Sheet

(Symbols are Typical Only, actual size may vary)

dgn = L:\WORK\PROJECT\39922\cadd\40turn\40a03.dgn
 prf = \WA501\DATA\LOT\COPIER\40a03.prf
 pen table = L:\lot\tables\half.ft.tbl
 levels = 1-63
 date = Wed May 1 11:22:16 2002


LISTING OF PROJECT REVISIONS		
		111-23 09-27-94
DATE	SHEET NO.	DESCRIPTION OF REVISIONS
		<u>Revised Pavement Joints</u>
04-03-01	A.03	Add Sheet for Listing of Project Revisions, 111-23.
	L.02	Revise Pavement Joint Layouts.
	L.04	
	L.06	
	L.08	
	L.11	
	L.13	
	L.15	
	L.17	
	L.19	
	L.21	
	L.23	
	L.26	
	L.28	
	L.31	
		<u>Modified Horizontal Curve at 130th St.</u>
04-08-02	A.03	Revise 111-23 for 04-08-02 plan revision.
	B.03	Modify Typical X-29, revise Station limits.
	B.06	Revise Station limits, Typical 7110.
	C.05	Add Subgrade Treatment #6, #7 to Tab. 103-3.
	C.13	Revise Station limit and quantities, Sta. 173+20, Tab. 110-1.
	C.15	Revise Station limits and quantities, Tab. X-50.
	C.20	Add Station limits and quantities for Curve Reconstruction at 130th Street.
	D.23	Revise notes, add Curve Reconstruction centerline.
	D.24	Revise notes, add Curve Reconstruction centerline.
	E.08	Revise notes, add Curve Reconstruction centerline.
	G.05	Add Curve Reconstruction Centerline.
	G.06	Add Curve Reconstruction Centerline.
	L.27	Remove callouts at NW quadrant, add reference to L.32 - L.35.
	L.28	Remove joints at NW quadrant, add reference to L.32 - L.35.
	L.29	Revise edge profile, SB U.S. 151 to WB 130th St.
	L.32	Add sheet showing new intersection design.
	L.33	Add sheet showing new pavement jointing layout.
	L.34	Add sheet showing new intersection design.
	L.35	Add sheet showing new pavement jointing layout.

LISTING OF PROJECT REVISIONS		
		111-23 09-27-94
DATE	SHEET NO.	DESCRIPTION OF REVISIONS
		<u>Added Right-Turn Lane at County Road X-40</u>
04-25-02	A.03	Revise 111-23 for 04-25-02 Plan Revisions.
	B.04	Add Typical 2205 Modified.
	C.05	Revised Tabulation 103-3 and 104-3.
	C.15	Revised Tabulation X-50.
	C.17	Revised Tabulation 108-22.
	C.20	Revised Tabulation 108-22.
	D.16	Add Right-Turn Lane.
	D.17	Add Right-Turn Lane.
	D.18	Add Right Ditch.
	E.06	Add Right-Turn Lane.
	L.22	Revise Grades for Right-Turn Lane.
	L.23	Revise Joints for Right-Turn Lane.
	L.24	Revise Edge Profiles Right-Turn Lane.
	T.02	Revise Tabulation 107-28.
	W.15	Add Cross Sections for Right-Turn Lane.
	W.16	Add Cross Sections for Right-Turn Lane.
	W.17	Add Cross Sections for Right-Turn Lane.
04-08-04		MODIFIED HORIZONTAL CURVE AT 130 ST. SB LANE
01-07-04		SANITARY SEWER - WATER MAIN EXTENSION - 130 ST.



ROBERT L. LENTZ
8720
IOWA

I hereby certify that this plan was prepared under my supervision and that engineering decisions with regard to the design were made by me or by other duly licensed Professional Engineers under the laws of the State of Iowa.

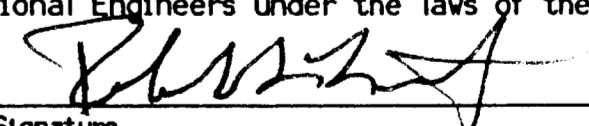
 Signature _____ Date 1 May 02
 Robert L. Lentz
 Printed or Typed Name

My license renewal date is December 31, 2003.

Pages or sheets covered by this seal:


04/03/01 Revision: A.03, L.02, L.04, L.06, L.08, L.11, L.13, L.15, L.17, L.19, L.21, L.23, L.26, L.28, L.31

04/08/02 Revision: A.03, B.03, B.06, C.05, C.13, C.15, C.20, D.23, D.24, E.08, G.05, G.06, L.27, L.28, L.29, L.32, L.33, L.34, L.35

04/25/02 Revision: A.03, B.04, C.05, C.15, C.17, C.20, D.16, D.17, D.18, E.06, L.22, L.23, L.24, T.02, W.15, W.16, W.17

5103
Modified
Dimensions in mm unless noted.

Notes:
Normal section shown may be modified appropriately in areas of superelevated curves or other locations specifically designated by the engineer. For details of subgrade superelevation, see other Detail Drawings.
Centerline median shall coincide with centerline survey shown on plans unless specified otherwise.
For typical cross sections of ditches and backslopes for roadway in cut, refer to other detail drawings within the plans.
① Refer to Detail Project Plan and Cross Sections for specific locations of foreslope.
② Slope is not to be steeper than 4:1.
③ Through median grades both Eastbound and Westbound lane foreslopes will vary.
M Design depth of median ditch.

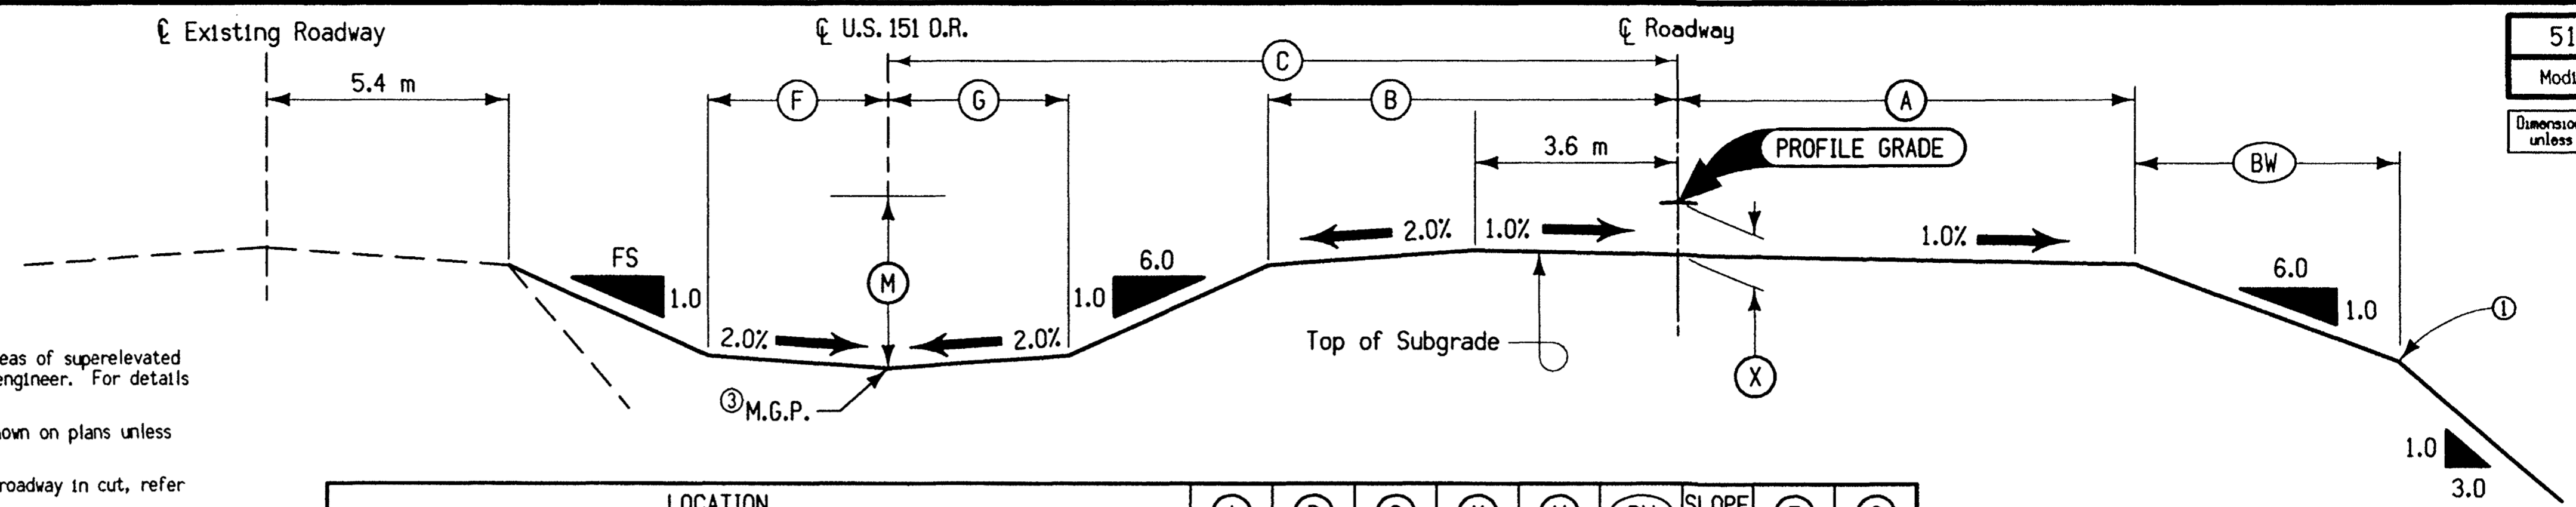


LOCATION			A	B	C	X	M	BW	SLOPE	F	G	
ROAD IDENTIFICATION	STATION TO STATION		m	m	m	mm	m	m	FS ②	m	m	
Mainline	15+40.00	23+00.00	Lt.	9.6	8.4	14.0	520	1.3	5.1	6.0	Var.	1.5
Mainline	51+85.00	52+30.00	Lt.	9.6	8.4	14.0	520	1.3	5.1	6.0	Var.	1.5
Mainline	131+10.00	131+60.00	Rt.	9.6	8.4	14.0	520	1.3	5.1	Var.	1.5	1.5
Mainline	172+90	175+80.00	Rt.	9.6	8.4	14.0	520	1.3	5.1	6.0	Var.	1.5

TYPICAL CROSS SECTION FOR GRADING (Two Lanes)



3217
01-12-99
Dimensions in mm unless noted.

Notes:
Normal section shown may be modified appropriately in areas of superelevated curves or other locations specifically designated by the Engineer.
① Refer to Standard Road Plan RF-19C for details of subdrain installation.
② Rumble Strip required. Refer to Standard Road Plan RH-410 for details of Roughness Pattern.

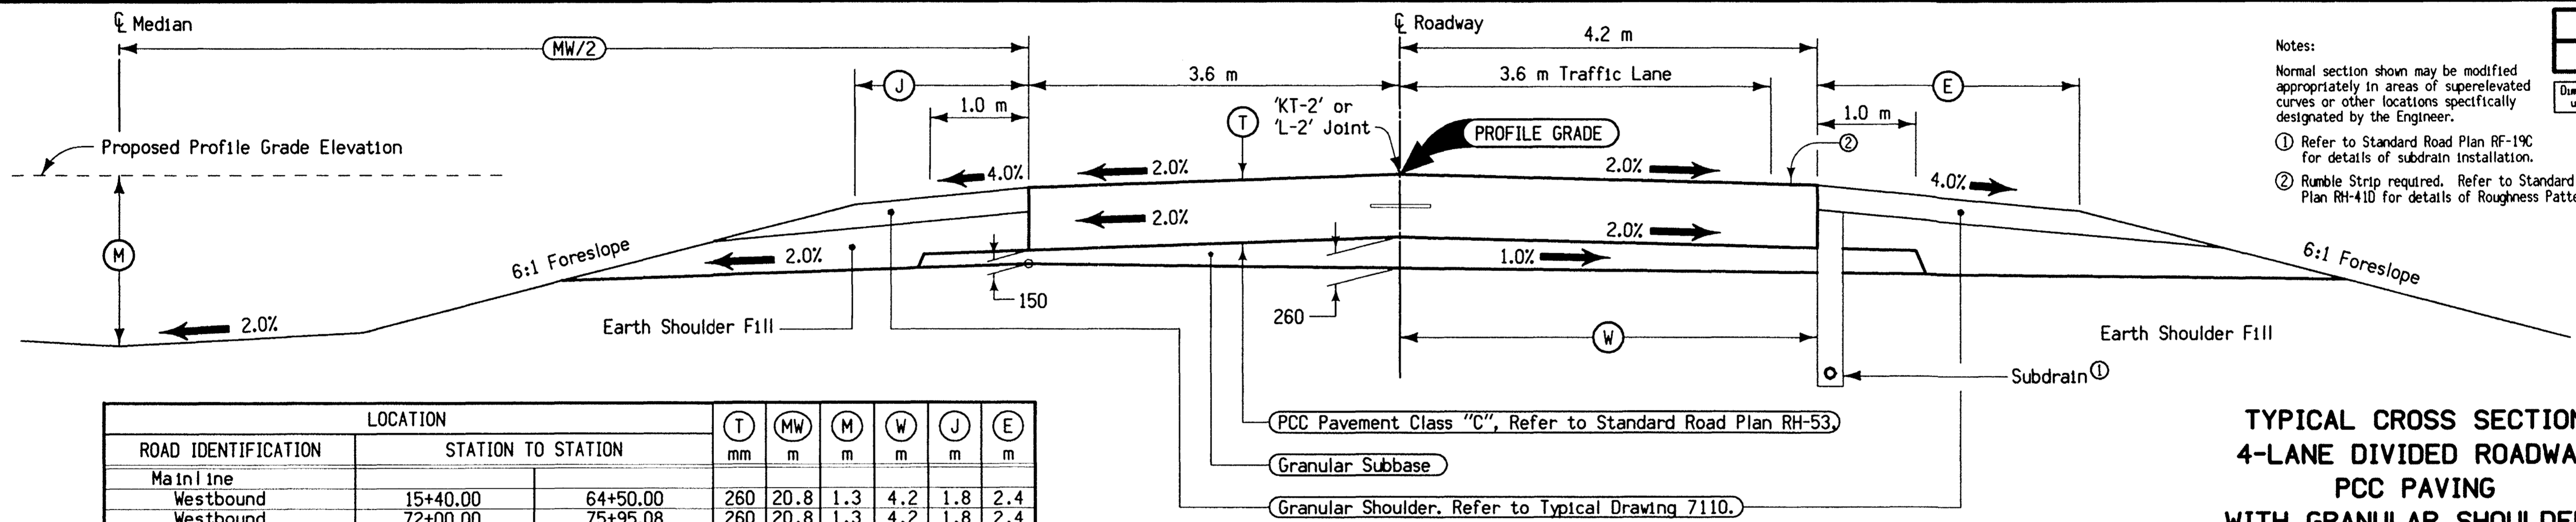


LOCATION			T	MW	M	W	J	E
ROAD IDENTIFICATION	STATION TO STATION		mm	m	m	m	m	m
Mainline								
Westbound	15+40.00	64+50.00	260	20.8	1.3	4.2	1.8	2.4
Westbound	72+00.00	75+95.08	260	20.8	1.3	4.2	1.8	2.4
Westbound	76+99.57	84+00.00	260	20.8	1.3	4.2	1.8	2.4
Westbound	154+50.00	157+41.56	260	20.8	1.3	4.2	1.8	2.4
Westbound	158+45.51	164+00.00	260	20.8	1.3	4.2	1.8	2.4
Eastbound	21+00.00	24+00.00	260	20.8	1.3	4.2	1.8	2.4
Eastbound	967+95.00	968+98.23	260	20.8	1.3	4.2	1.8	2.4
Eastbound	68+98.23	75+75.07	260	20.8	1.3	4.2	1.8	2.4
Eastbound	76+84.86	133+77.91	260	20.8	1.3	4.2	1.8	2.4
Eastbound	135+54.53	157+41.56	260	20.8	1.3	4.2	1.8	2.4
Eastbound	158+45.51	187+10.00	260	20.8	1.3	4.2	1.8	2.4




TYPICAL CROSS SECTION 4-LANE DIVIDED ROADWAY PCC PAVING WITH GRANULAR SHOULDERS

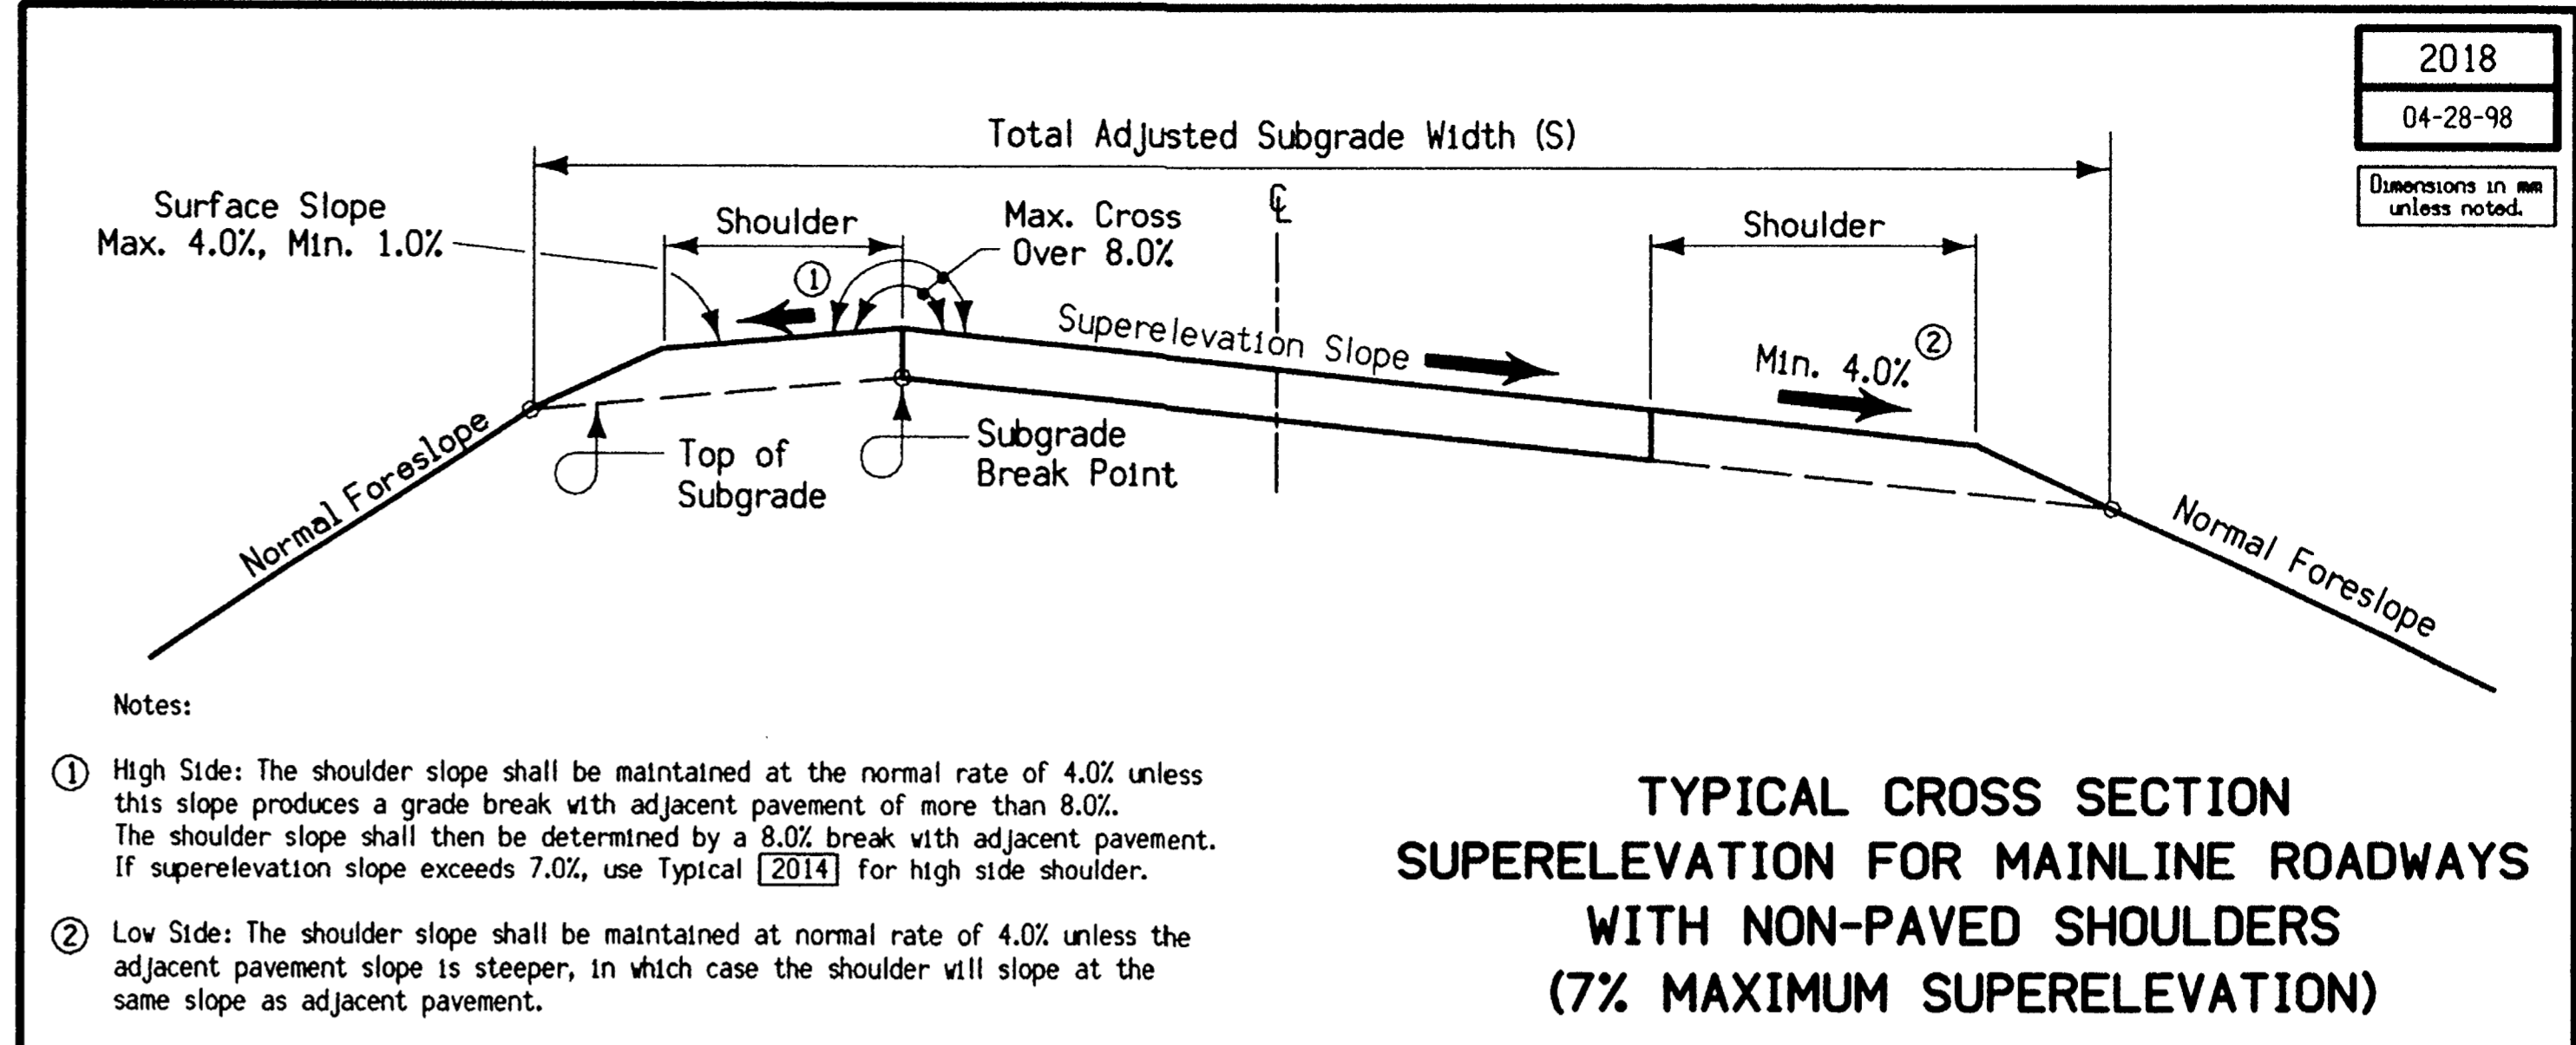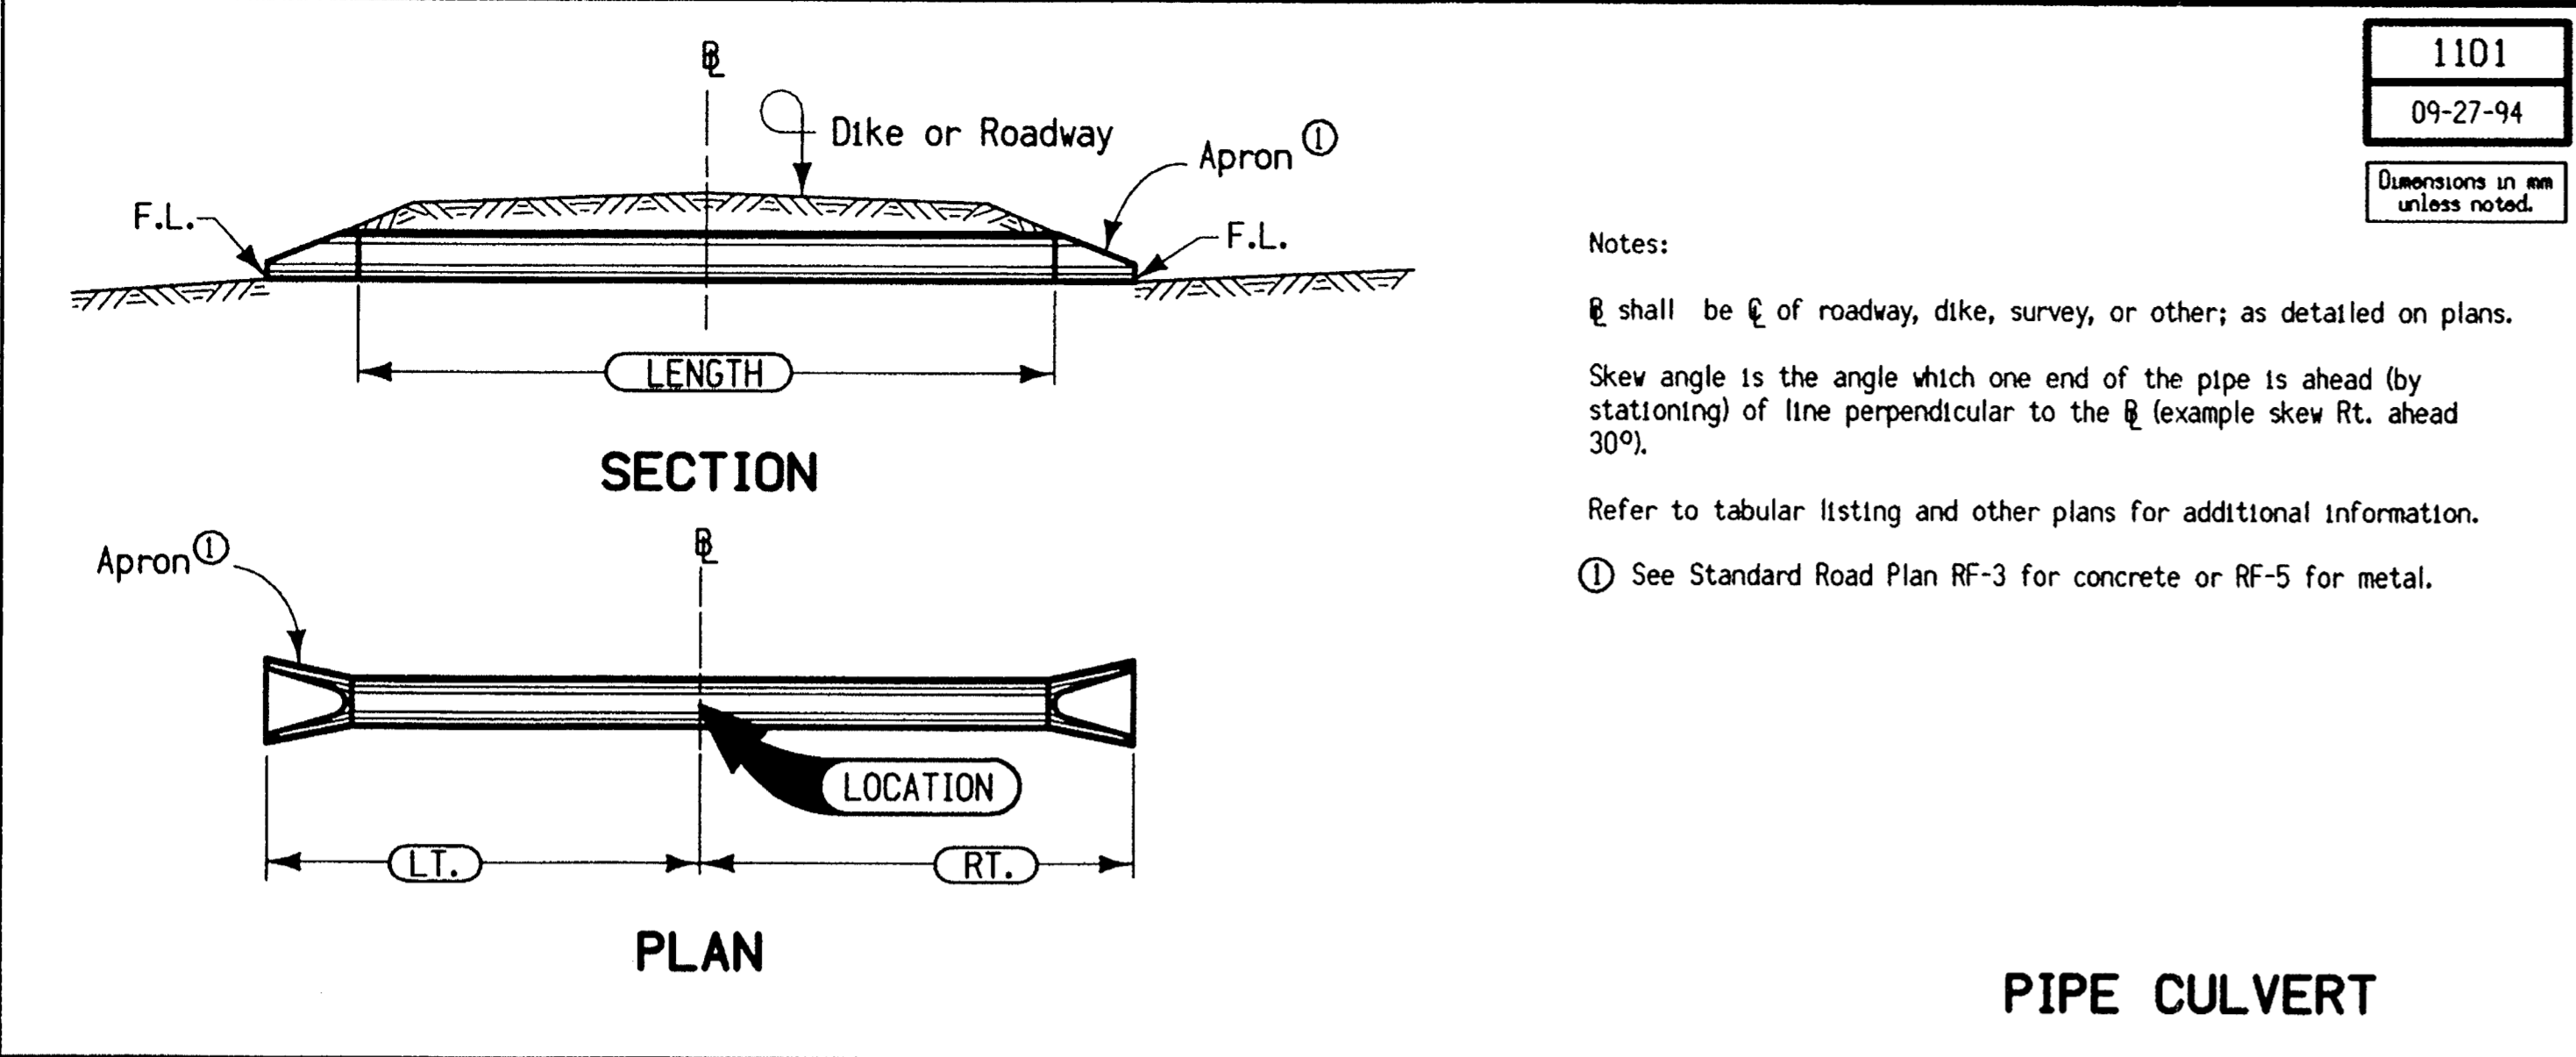


SHOULDER DIMENSIONS (m)			
Roadway Pavement Width	Shoulder Width (E)	(A)	(B)
3.6	0.9	0.9	-
	1.2	1.2	-
	1.5	0.9	0.6
	1.8	0.9	0.9
	2.4	0.9	1.5
(3.6 Operational Width)	(3.0 Operational Width)		
4.2	2.4	0.6	1.8

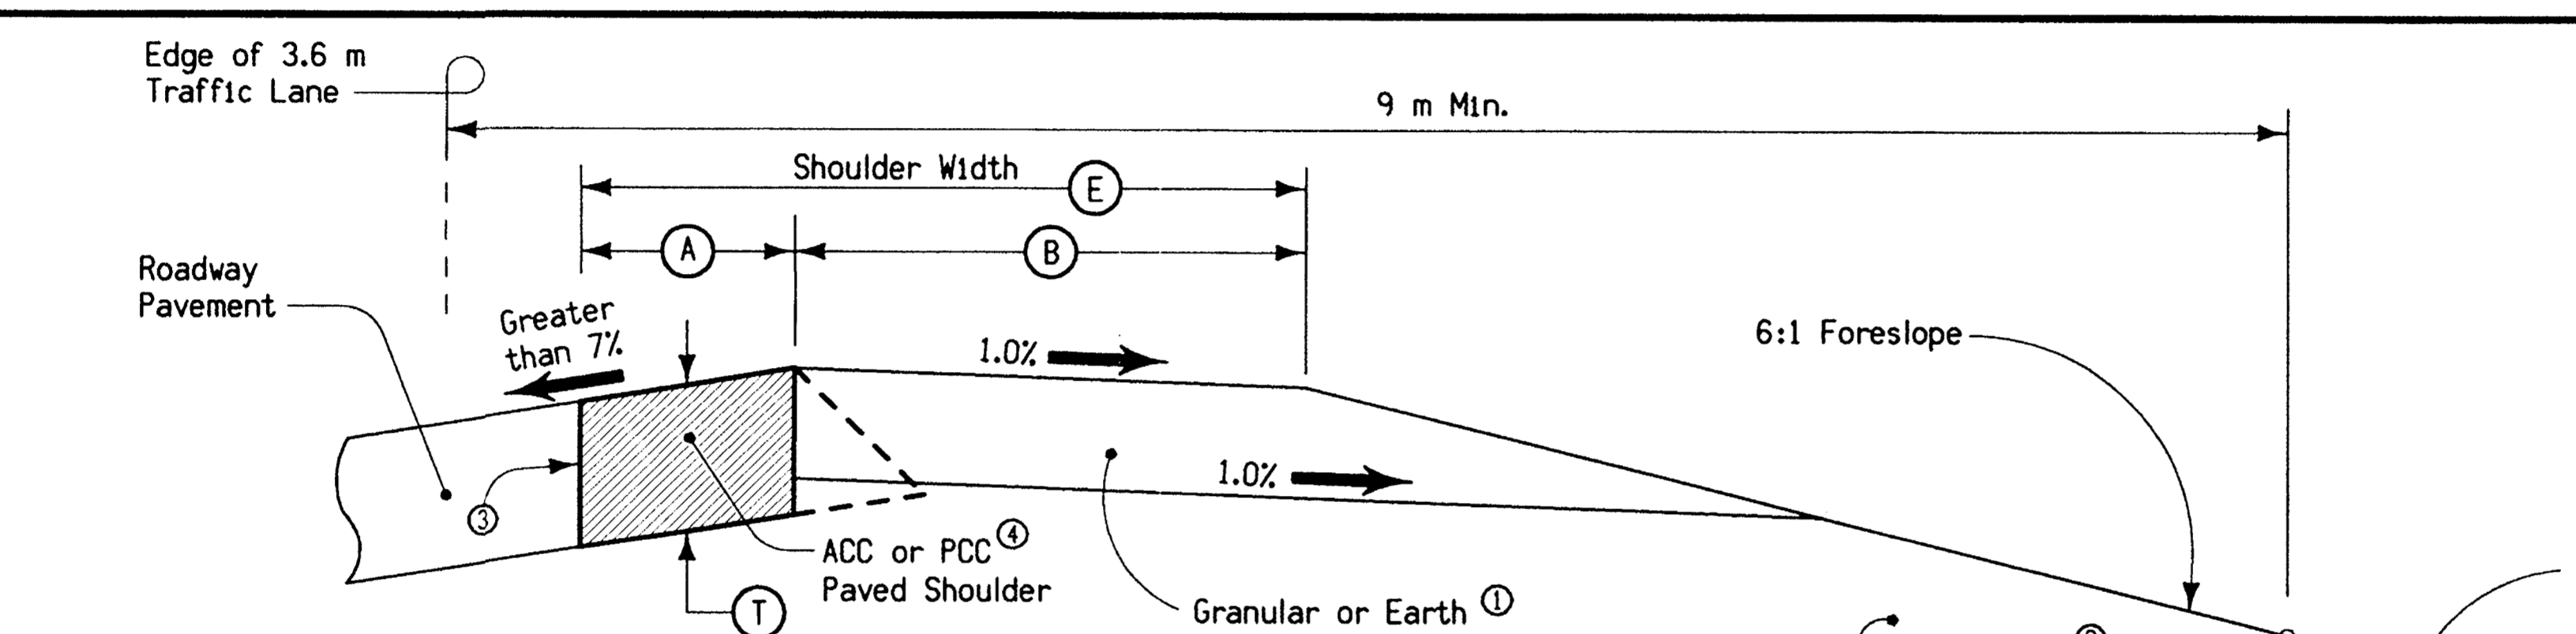

LOCATION				PAVED SHOULDER TYPE	(T) mm	(E) m
ROAD IDENTIFICATION	STATION TO STATION	SIDE				
U.S. 151 Mainline	139+00	142+14	Rt.	PCC	260	2.4

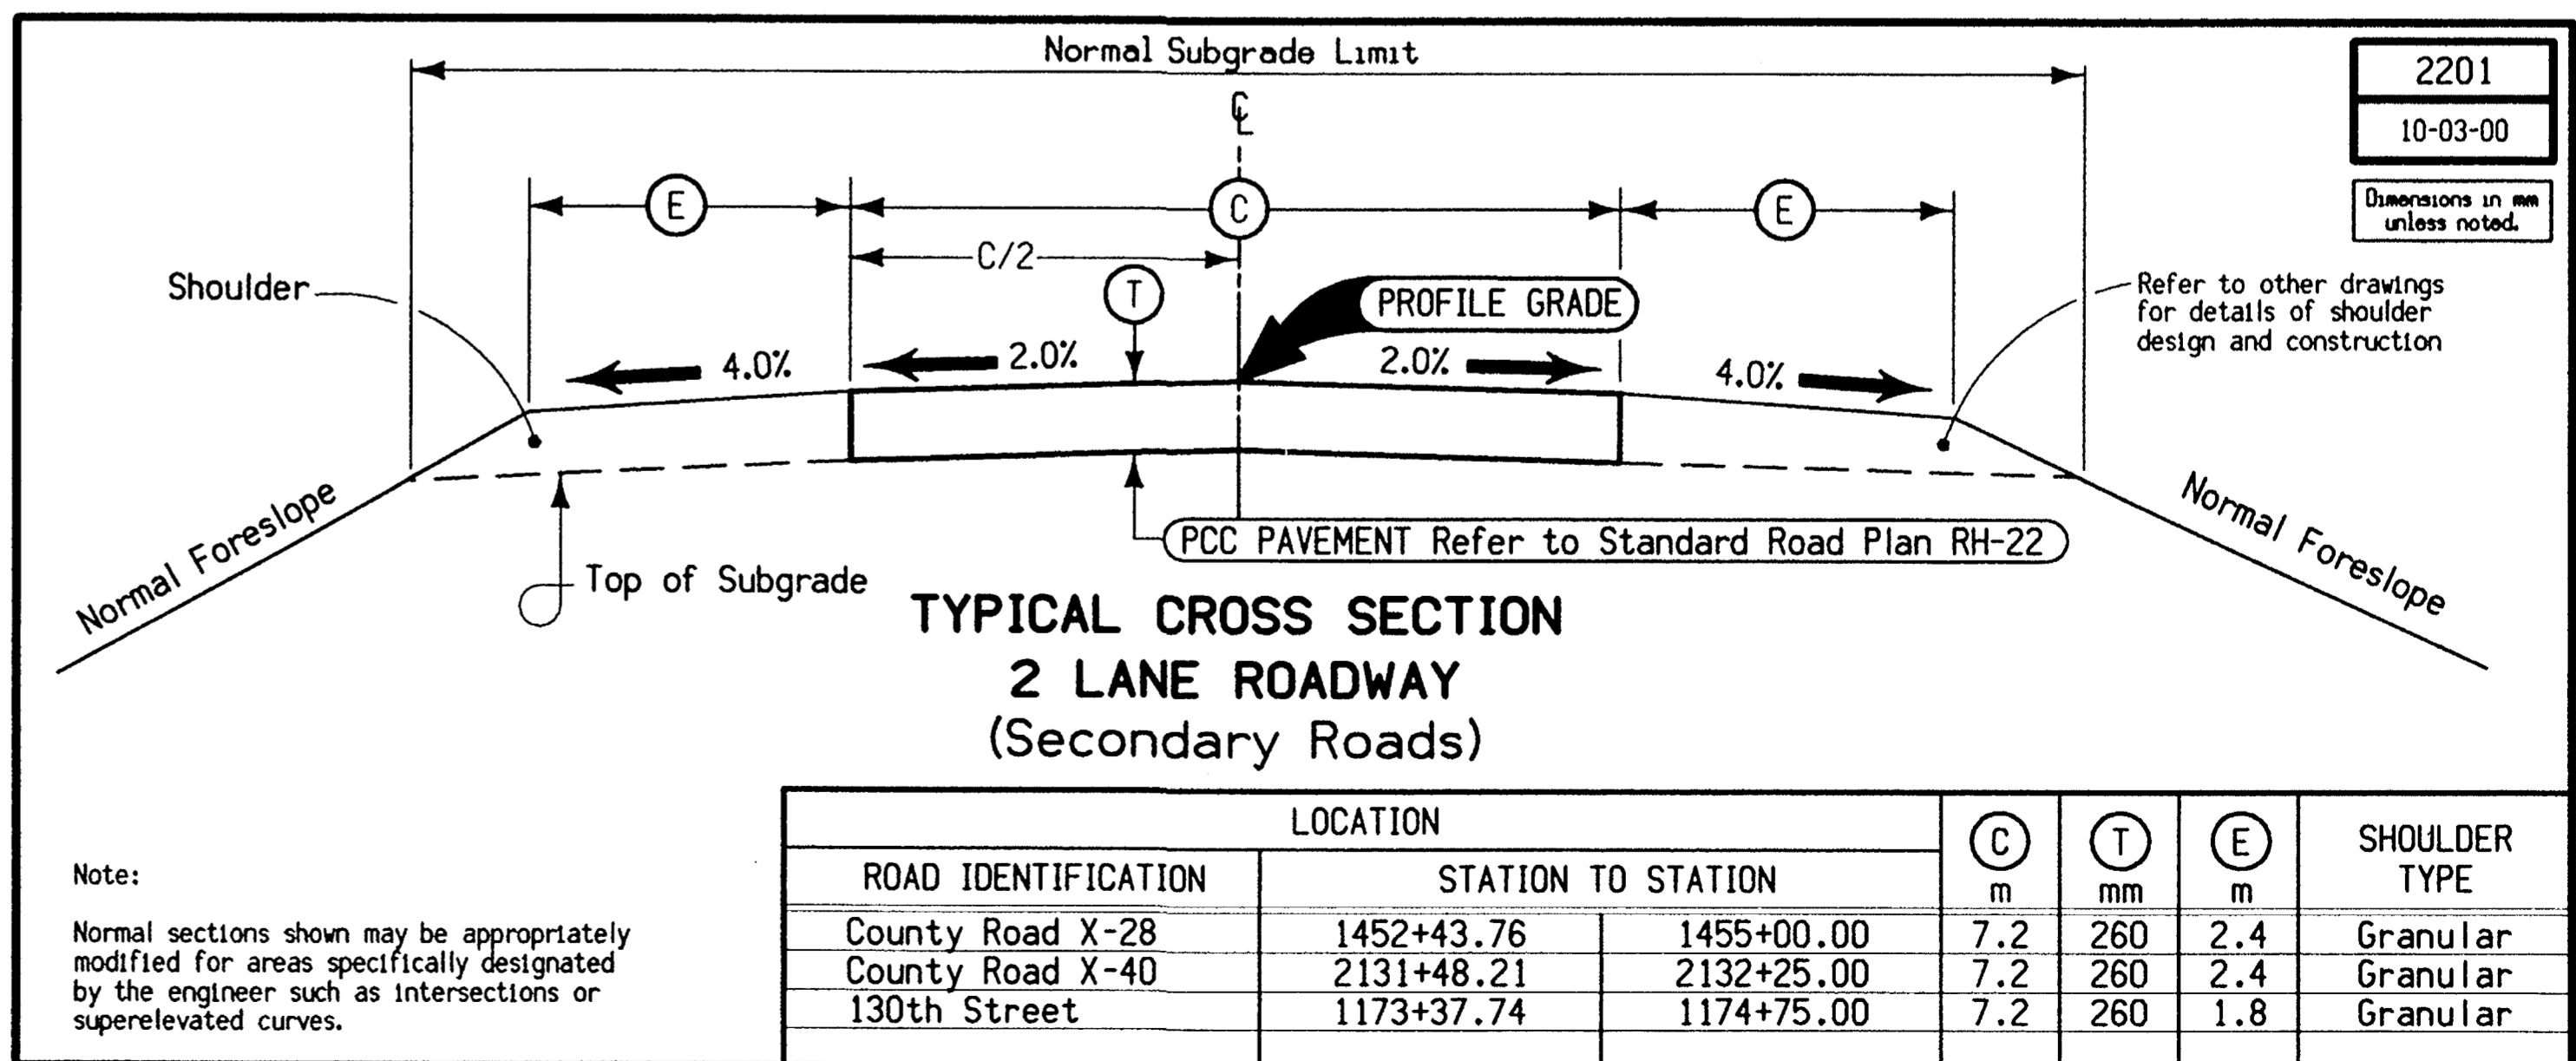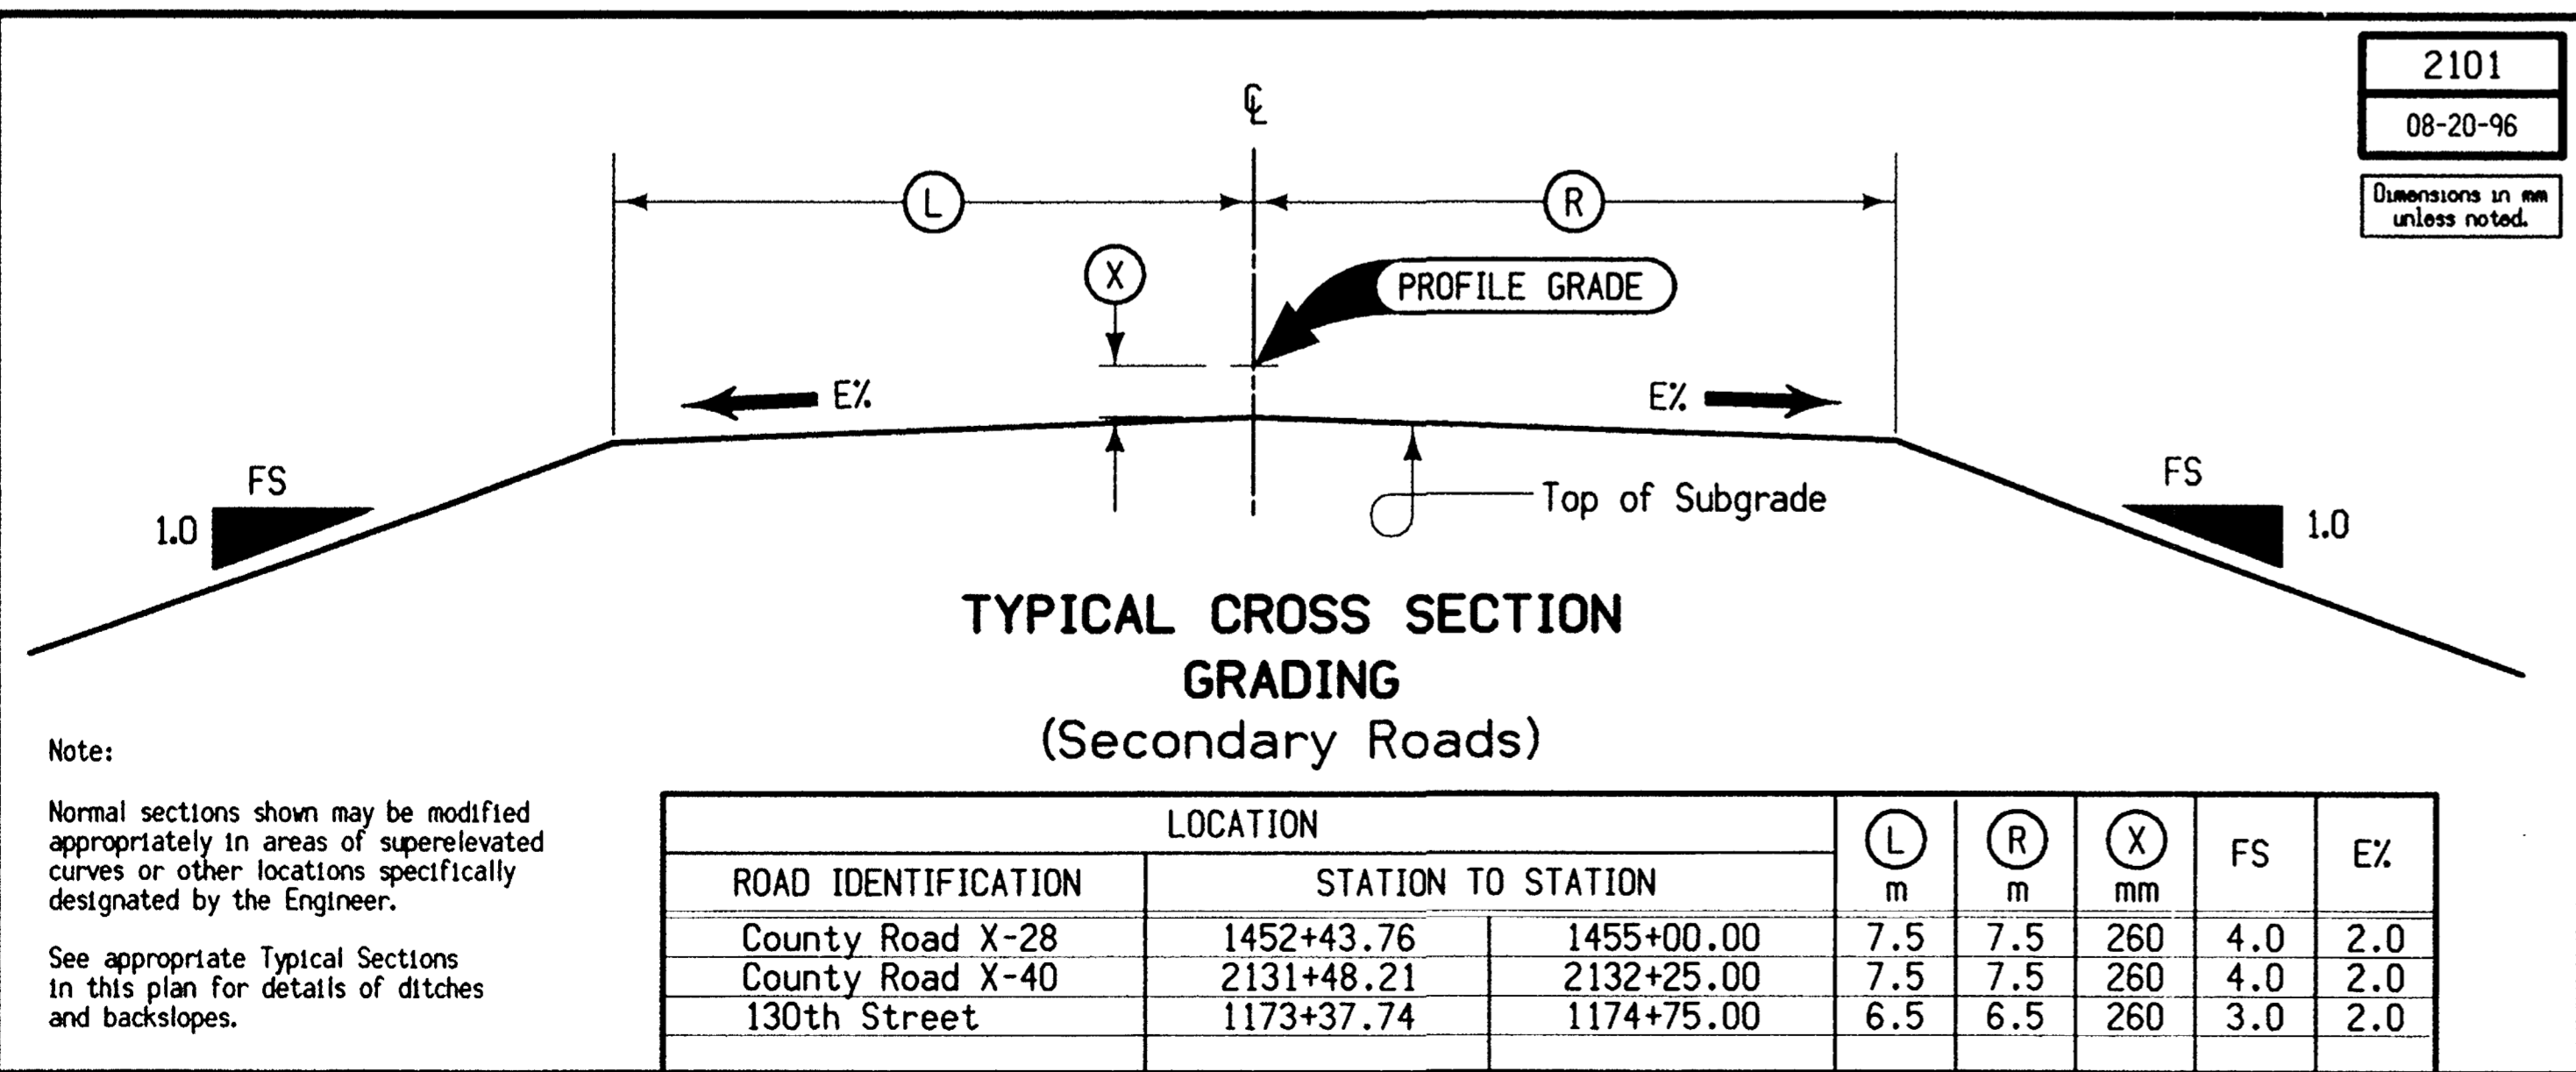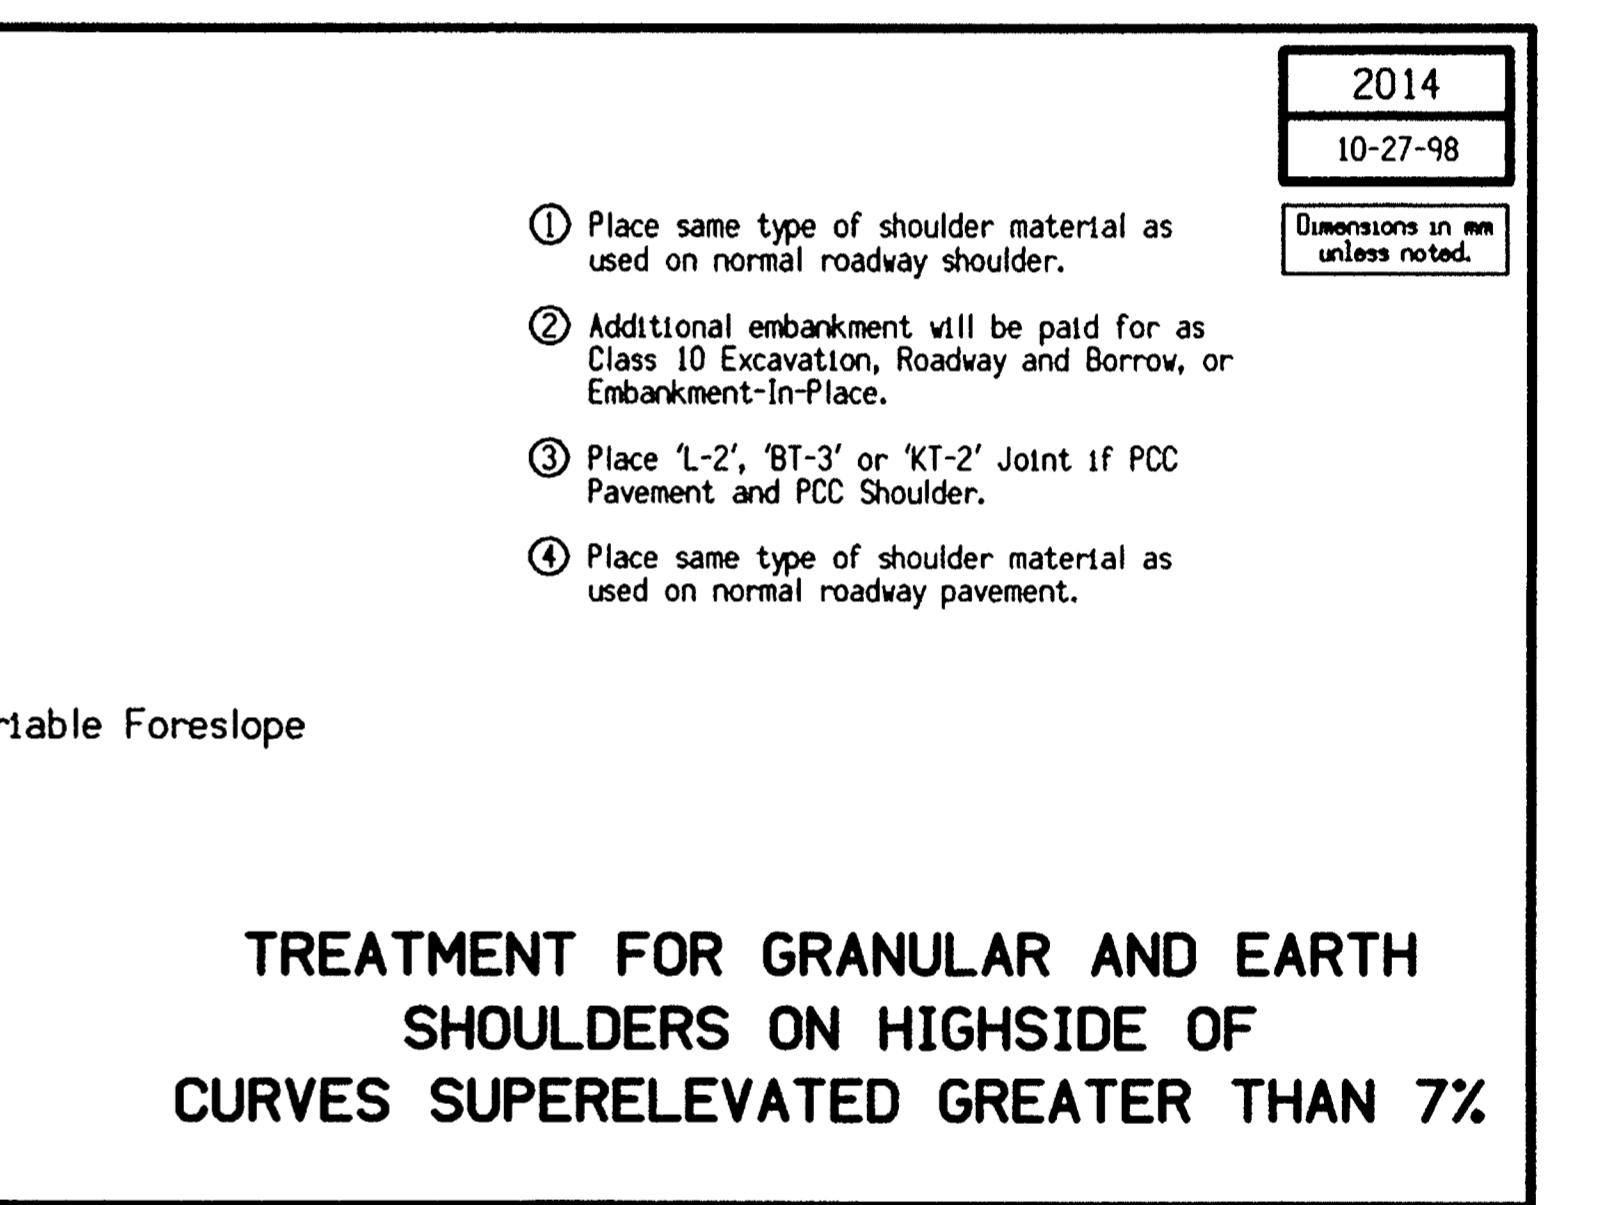

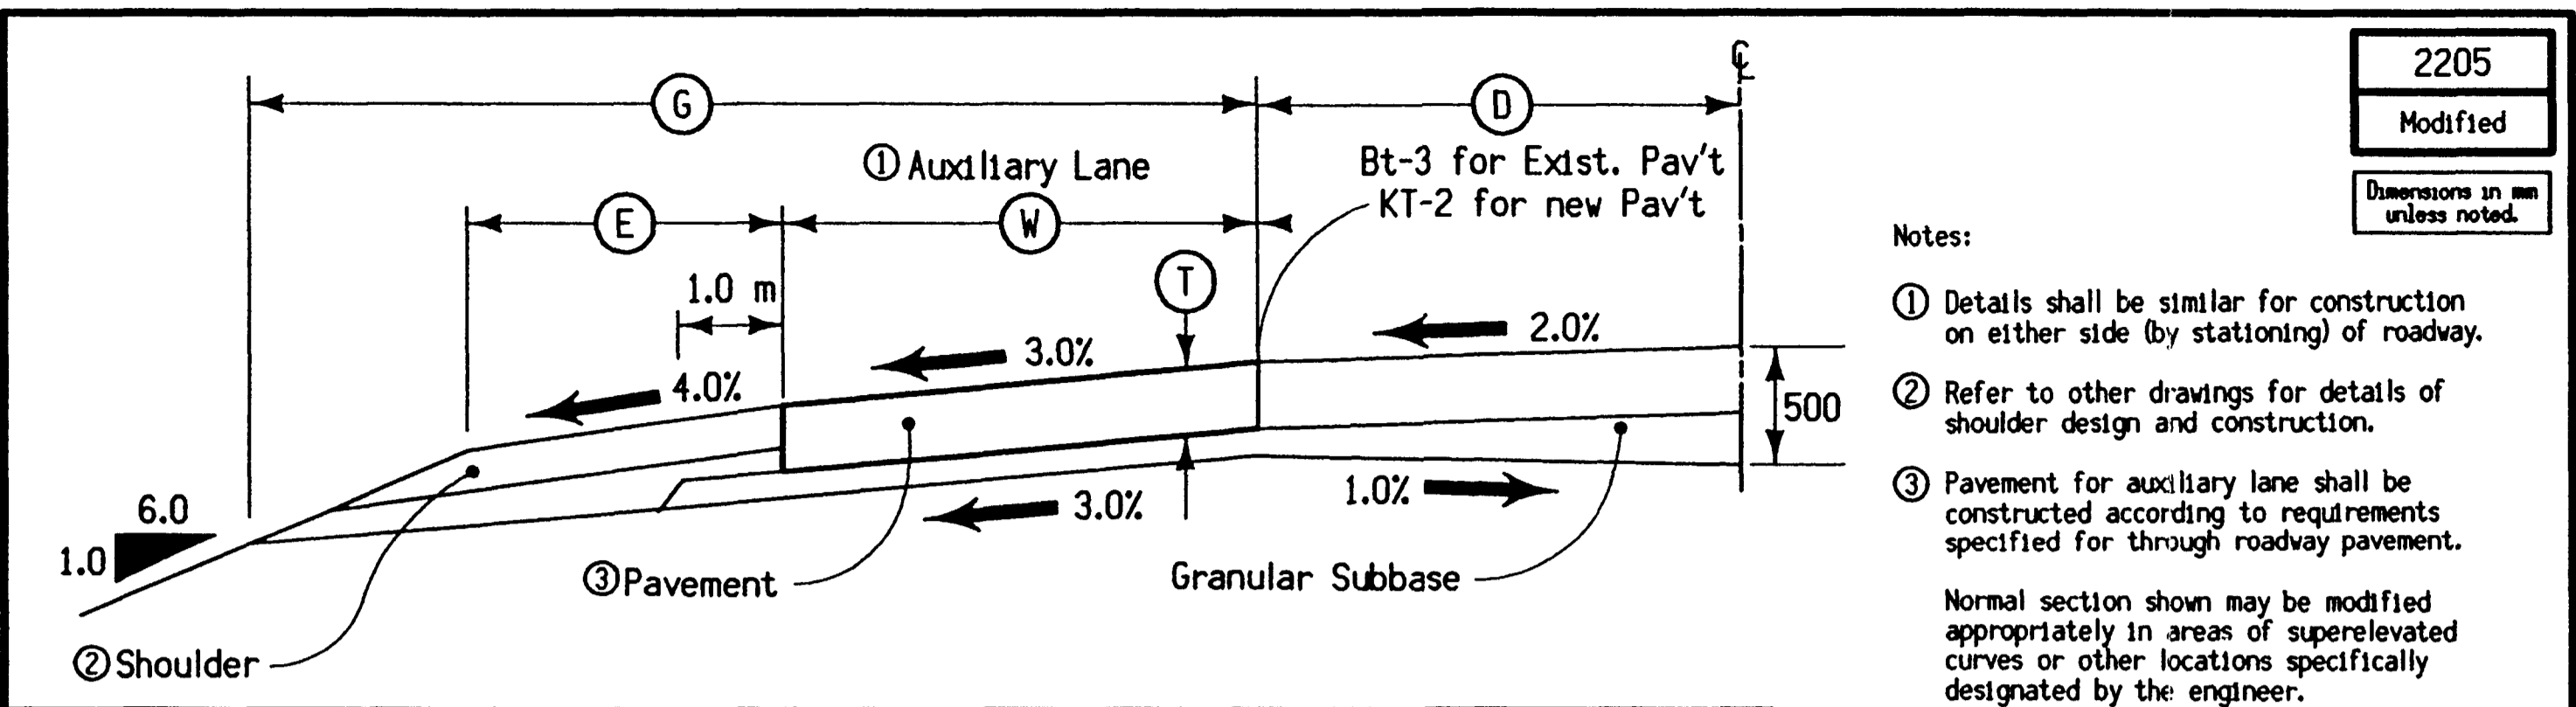


LOCATION		SIDE	D m	E m	W m	G m	T mm	
ROAD IDENTIFICATION	STATION TO STATION							
Mainline	18+40.00	18+90.00	WBL	3.6	1.8	3.6	8.8	260
Mainline	35+46.00	35+96.00	WBL	3.6	1.8	3.6	8.8	260
Mainline	38+73.00	39+23.00	EBL	3.6	1.8	3.6	8.8	260
Mainline	51+30.03	51+80.00	EBL	3.6	1.8	3.6	8.8	260
Mainline	52+34.00	52+84.00	WBL	3.6	1.8	3.6	8.8	260
Mainline	64+08.70	64+58.70	EBL	3.6	1.8	3.6	8.8	260
Mainline	86+27.00	86+77.00	EBL	3.6	1.8	3.6	8.8	260
Mainline	87+21.00	87+71.00	WBL	3.6	1.8	3.6	8.8	260
Mainline	* 94+49.50	94+99.50	EBL	3.6	1.8	3.6	8.8	260
Mainline	104+37.00	104+87.00	EBL	3.6	1.8	3.6	8.8	260
Mainline	105+43.00	105+96.22	WBL	3.6	1.8	3.6	8.8	260
Mainline	113+34.50	113+84.50	EBL	3.6	1.8	3.6	8.8	260
Mainline	117+63.01	117+13.00	EBL	3.6	1.8	3.6	8.8	260
Mainline	117+60.00	118+10.00	WBL	3.6	1.8	3.6	8.8	260
Mainline	131+58.43	132+08.97	WBL	3.6	1.8	3.6	8.8	260
Mainline	136+89.00	137+39.00	EBL	3.6	1.8	3.6	8.8	260
Mainline	137+88.00	138+38.00	WBL	3.6	1.8	3.6	8.8	260
Mainline	172+42.95	172+92.73	EBL	3.6	1.8	3.6	8.8	260
Mainline	173+43.08	173+93.00	WBL	3.6	1.8	3.6	8.8	*
Mainline	180+00.50	180+50.50	EBL	3.6	1.8	3.6	8.8	260

**GRADING AND PAVING
TYPICAL HALF SECTION
PROPOSED LEFT TURN LANE**

* 260mm PCC with 75mm HMA overlay on turn lane and adjacent mainline paving.

2205
Modified
Dimensions in mm unless noted.


- Notes:
- Details shall be similar for construction on either side (by stationing) of roadway.
 - Refer to other drawings for details of shoulder design and construction.
 - Pavement for auxiliary lane shall be constructed according to requirements specified for through roadway pavement.
- Normal section shown may be modified appropriately in areas of superelevated curves or other locations specifically designated by the engineer.
- See Typical Cross Section for details of ditches and backslopes.
- Refer to Intersection Details (L sheets) for additional information.
- Section view is in direction of traffic.

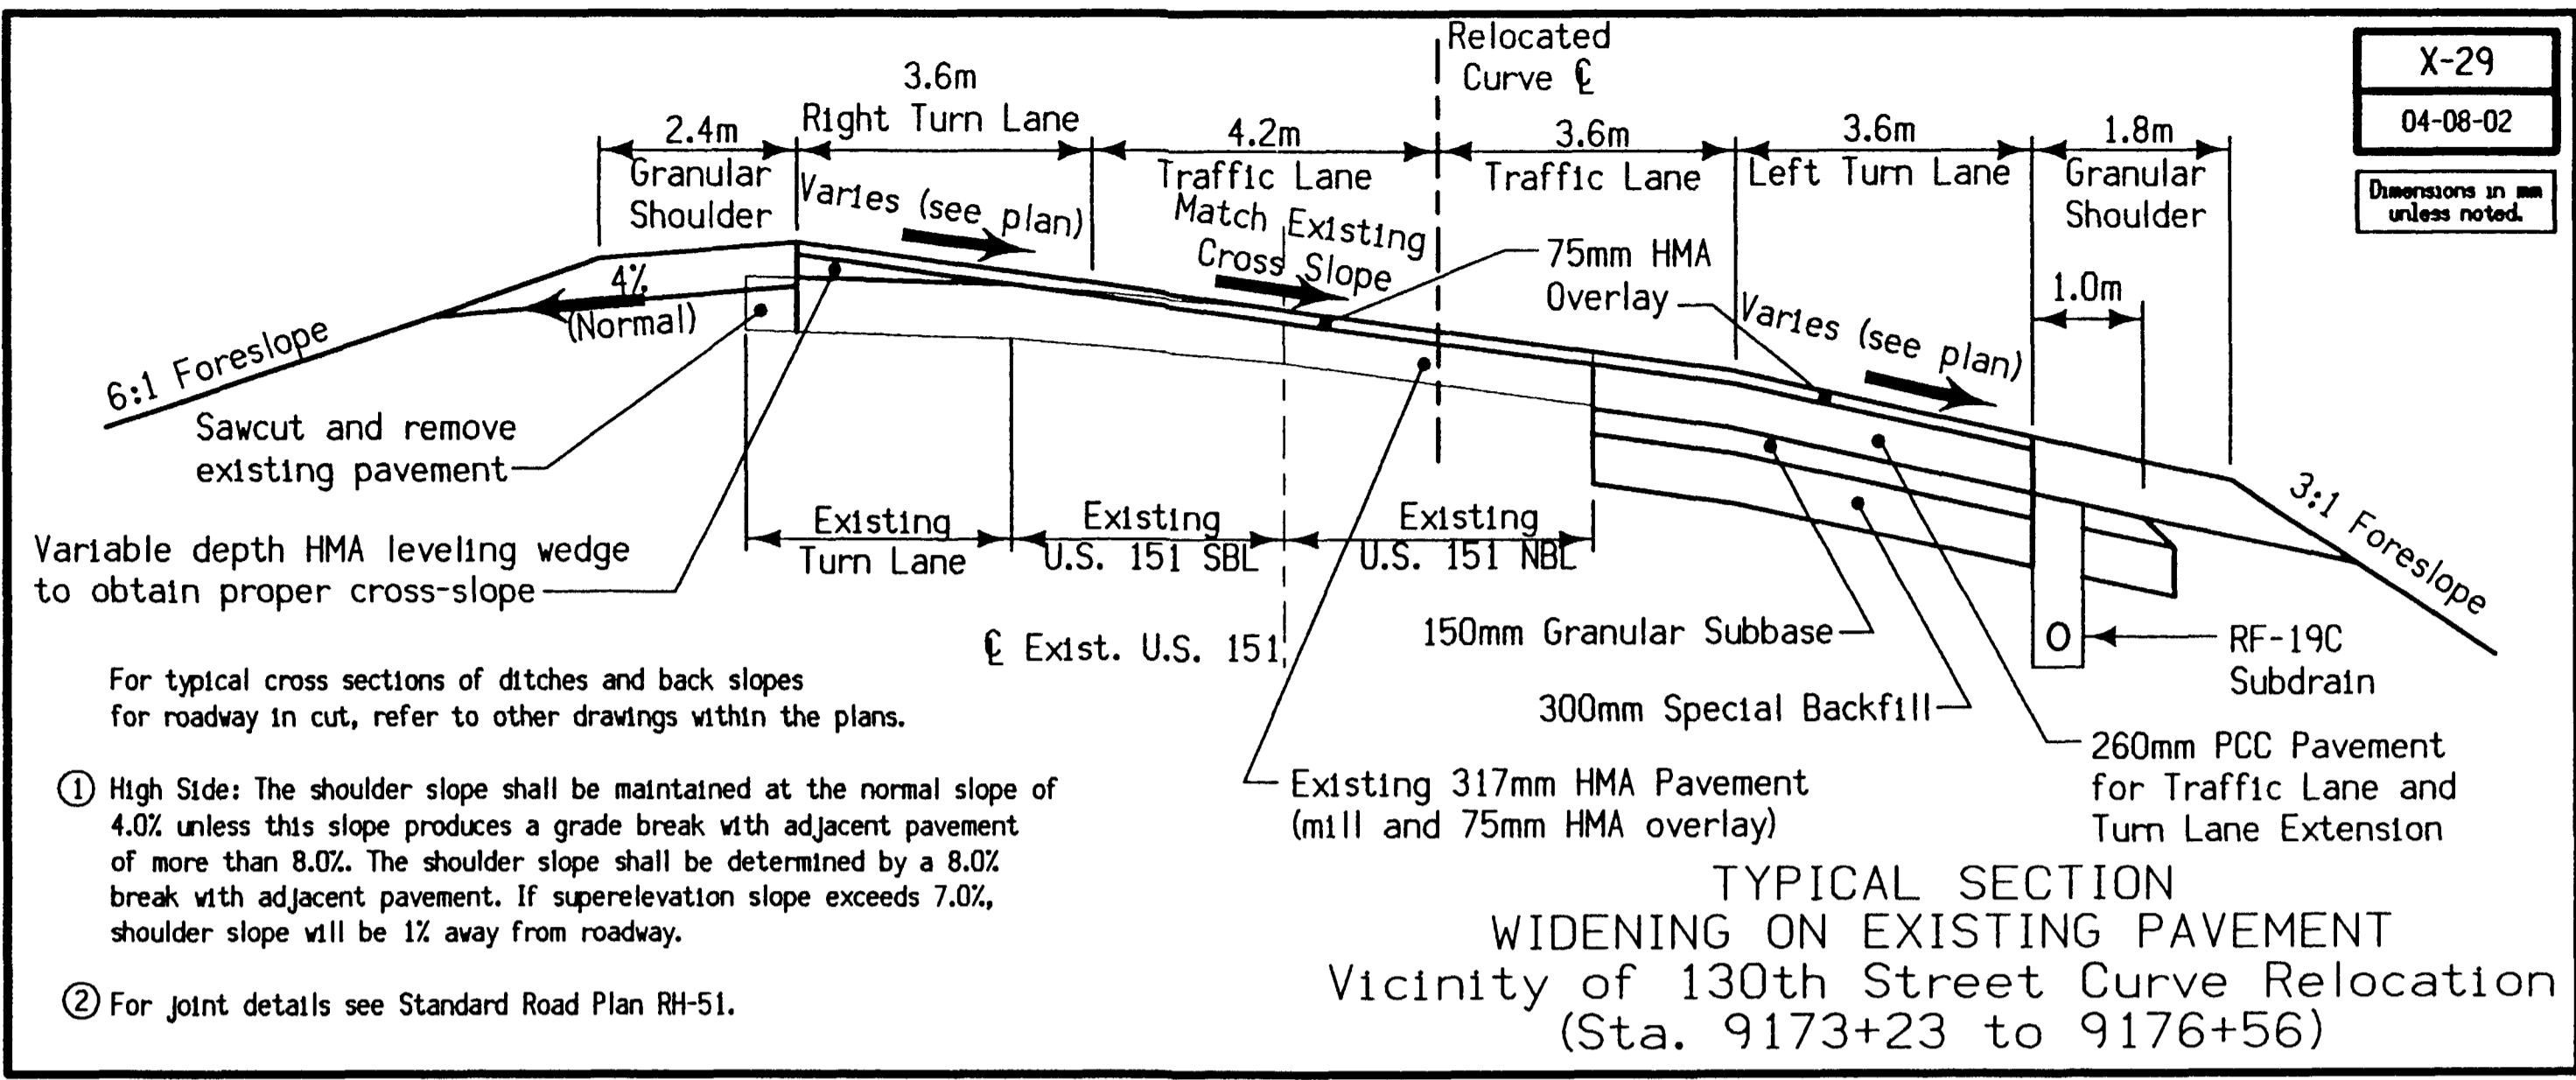

- Notes:
- High Side: The shoulder slope shall be maintained at the normal slope of 4.0% unless this slope produces a grade break with adjacent pavement of more than 8.0%. The shoulder slope shall be determined by a 8.0% break with adjacent pavement. If superelevation slope exceeds 7.0%, shoulder slope will be 1% away from roadway.
 - For joint details see Standard Road Plan RH-51.

**TYPICAL SECTION
WIDENING ON EXISTING PAVEMENT
Vicinity of 130th Street Curve Relocation
(Sta. 9173+23 to 9176+56)**


X-29
04-08-02
Dimensions in mm unless noted.

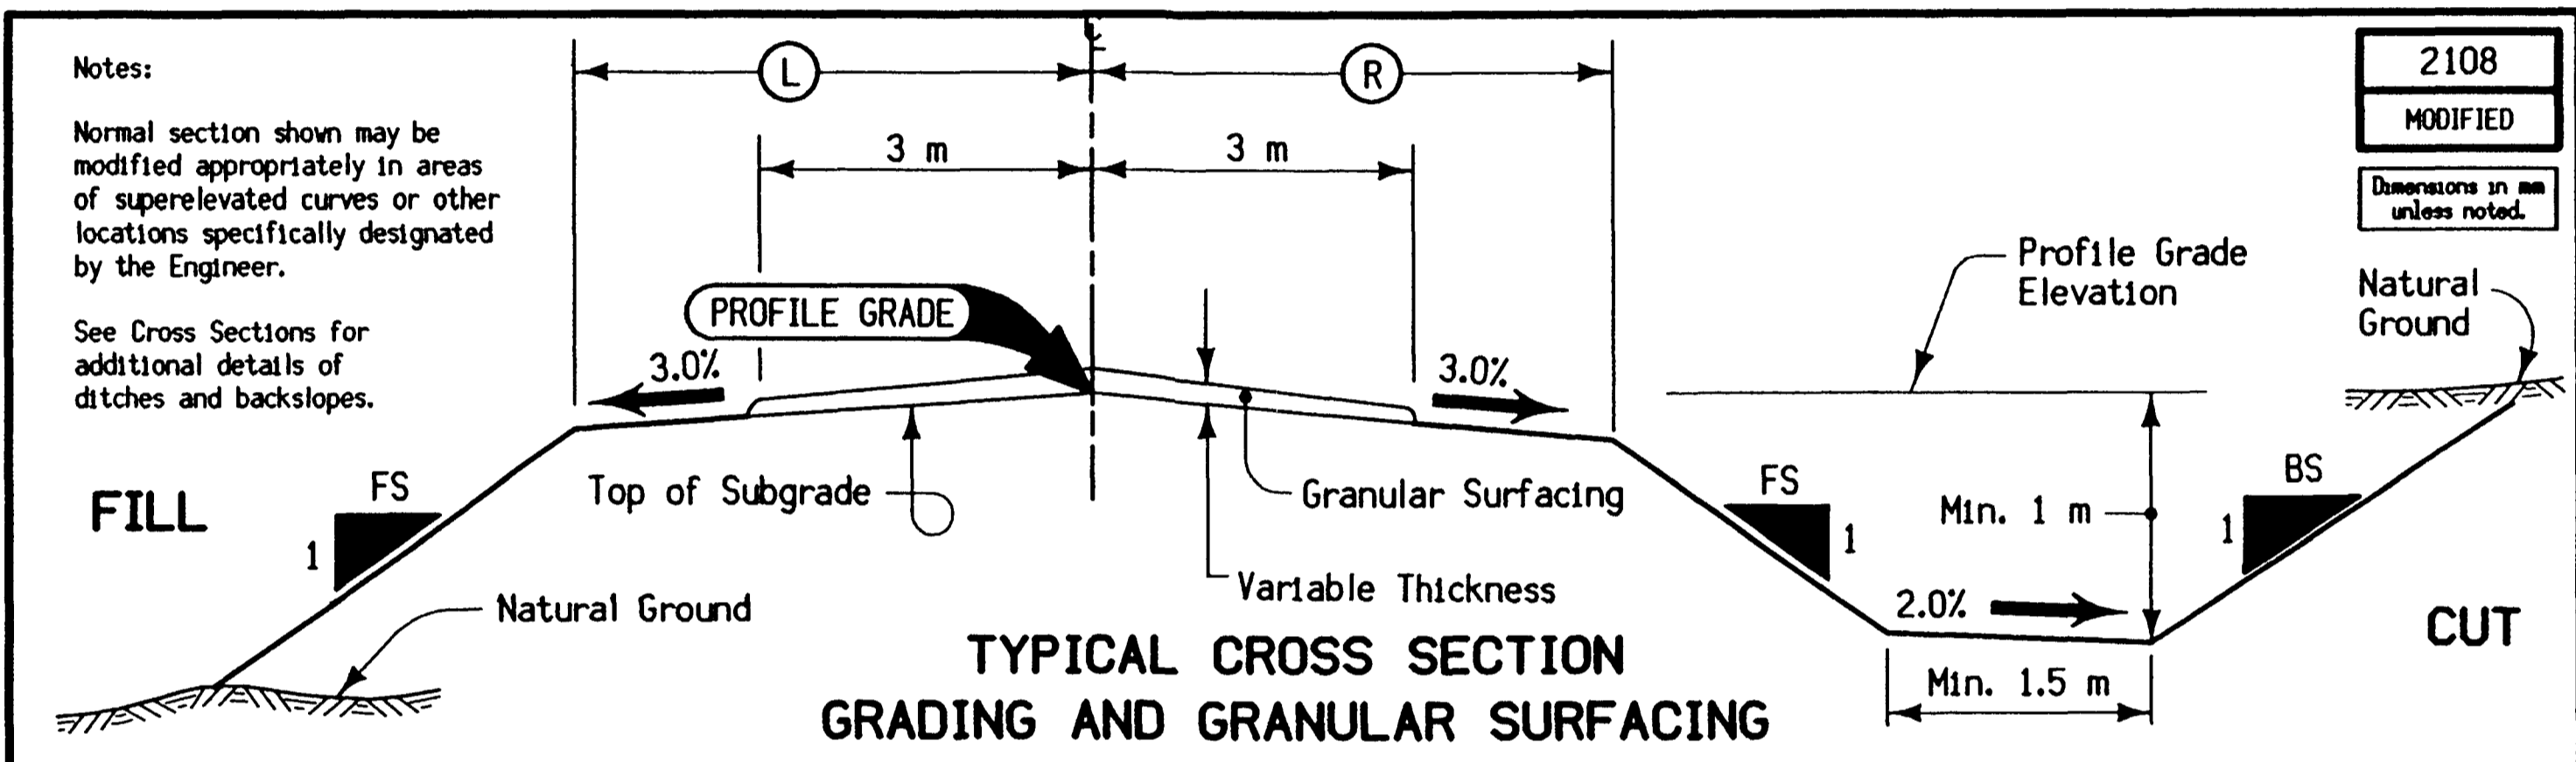

- Notes:
- Normal section shown may be modified appropriately in areas of superelevated curves or other locations specifically designated by the Engineer.
- See Cross Sections for additional details of ditches and backslopes.

LOCATION		DIMENSIONS		SLOPES	
ROAD IDENTIFICATION	STATION TO STATION	L	R	FS	BS
Side Road		4.2	4.2	3.0	2.5

2108
MODIFIED
Dimensions in mm unless noted.

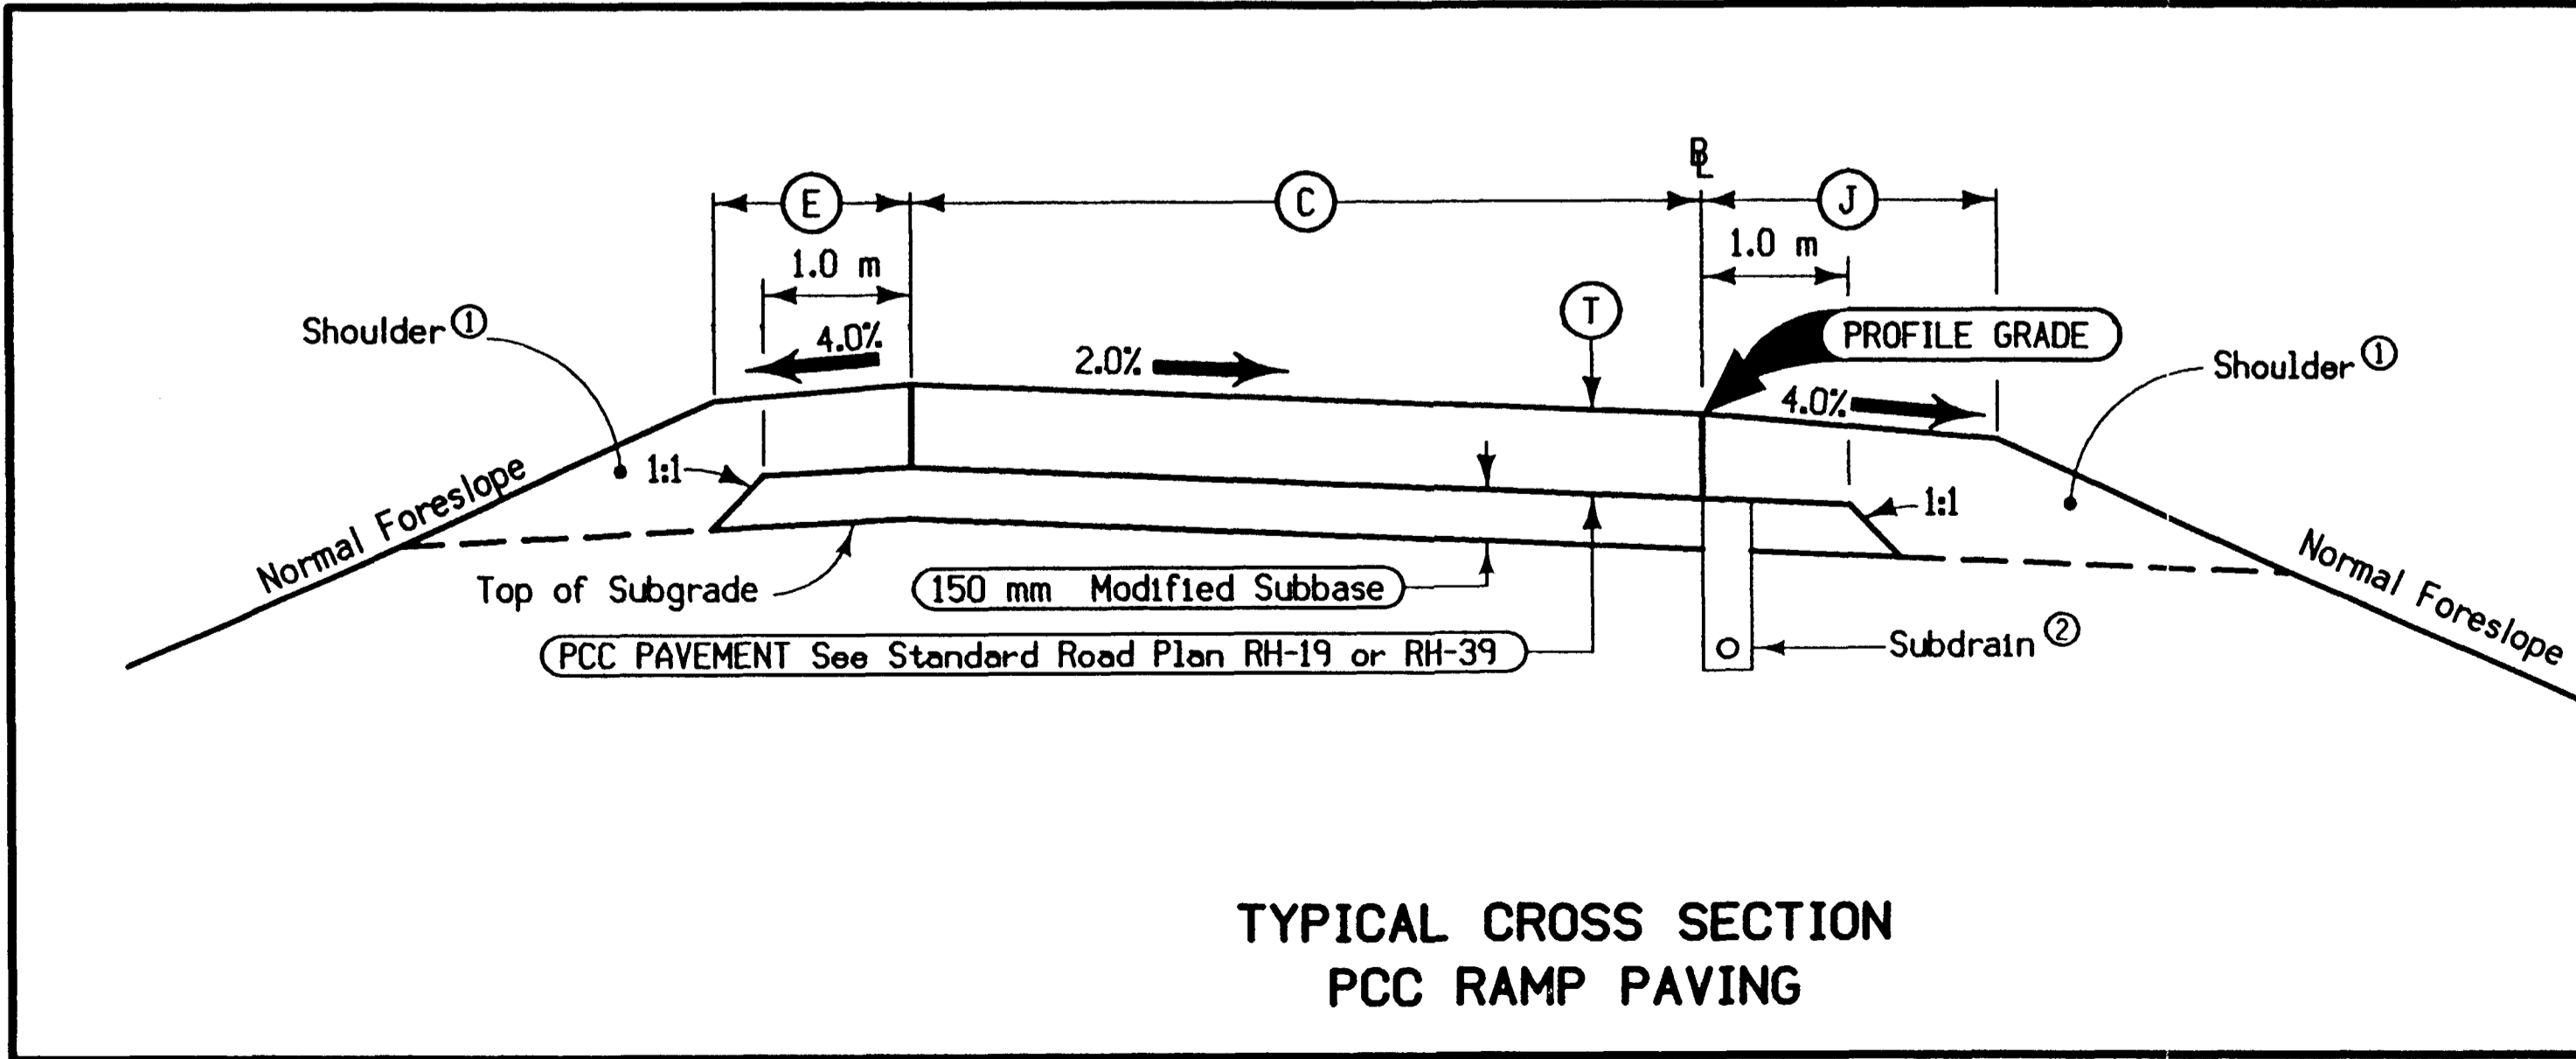

**TYPICAL CROSS SECTION
PCC RAMP PAVING**


- Notes:
- Subbase may be constructed to a width greater than that indicated.
- Any such extra width of subbase shall be considered incidental to other work and not be measured for payment.
- Section view is in direction of traffic.
- Normal section shown may be appropriately modified for areas specifically designated by the Engineer, such as intersections or superelevated curves.
- Refer to other drawing for details of shoulder design and construction.
 - Refer to Standard Road Plan RF-19C for details of subdrain installation.

LOCATION			DIMENSIONS				SHOULDER TYPE	
INTERCHANGE	RAMP	STATION TO STATION	T mm	C m	E m	J m		
(L) Iowa Highway 1	B	2076+75.252	2079+40.00	260	5.5	1.2	1.8	Paved
(R) Iowa Highway 1	C	3075+30.00	3080+10.36	260	4.8	1.2	1.8	Paved
(R) Iowa Highway 64	B	6153+10.00	6157+20.00	260	4.8	1.2	1.8	Paved
(L) Iowa Highway 64	C	7154+94.349	7156+55.32	260	5.5	1.2	1.8	Paved
(L) Iowa Highway 64	D	8161+88.02	8164+00.00	260	4.8	1.2	1.8	PAVED
(L) Iowa Highway 1	D	4082+62.15	4084+00.00	260	4.8	1.2	1.8	PAVED

2503
04-25-00
Dimensions in mm unless noted.

dgn = I:\WORK\project\39922\cadd\anacurve\PAVE\57151112.tbl
levels = 1-63
pen table = I:\object\tables\half.tbl


2512A
Mod.
Dimensions in mm unless noted.

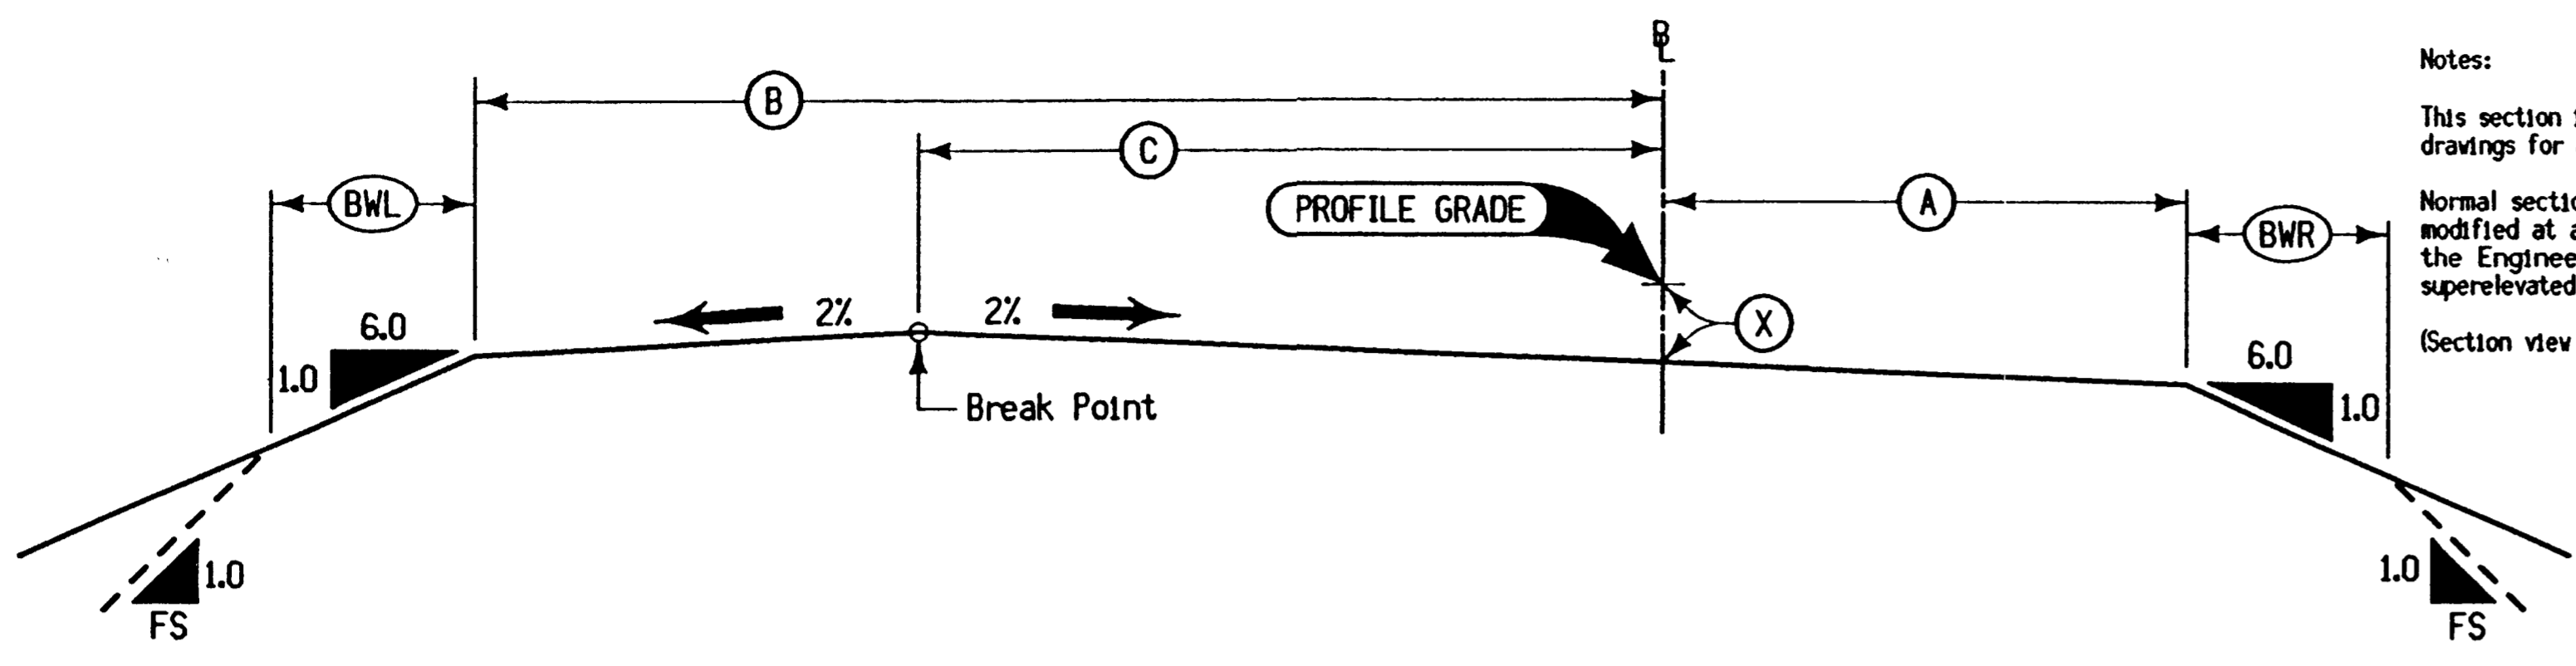

Notes:
This section is typical only. Refer to other drawings for additional details.
Normal section shown may be appropriately modified at areas specifically designated by the Engineer, such as intersections or superelevated curves.
(Section view is in direction of Traffic)

LOCATION			DIMENSIONS						
INTERCHANGE	RAMP	STATION TO STATION	(A)	(B)	(C)	(X)	FS	(BWL)	(BWR)
			m	m	m	mm	m	m	m
	RAMP		4.8	9.1	4.8	410	3.0	6.4	5.7
	LOOP		4.8	9.8	5.5	410	3.0	6.5	5.7


TYPICAL CROSS SECTION RAMP GRADING

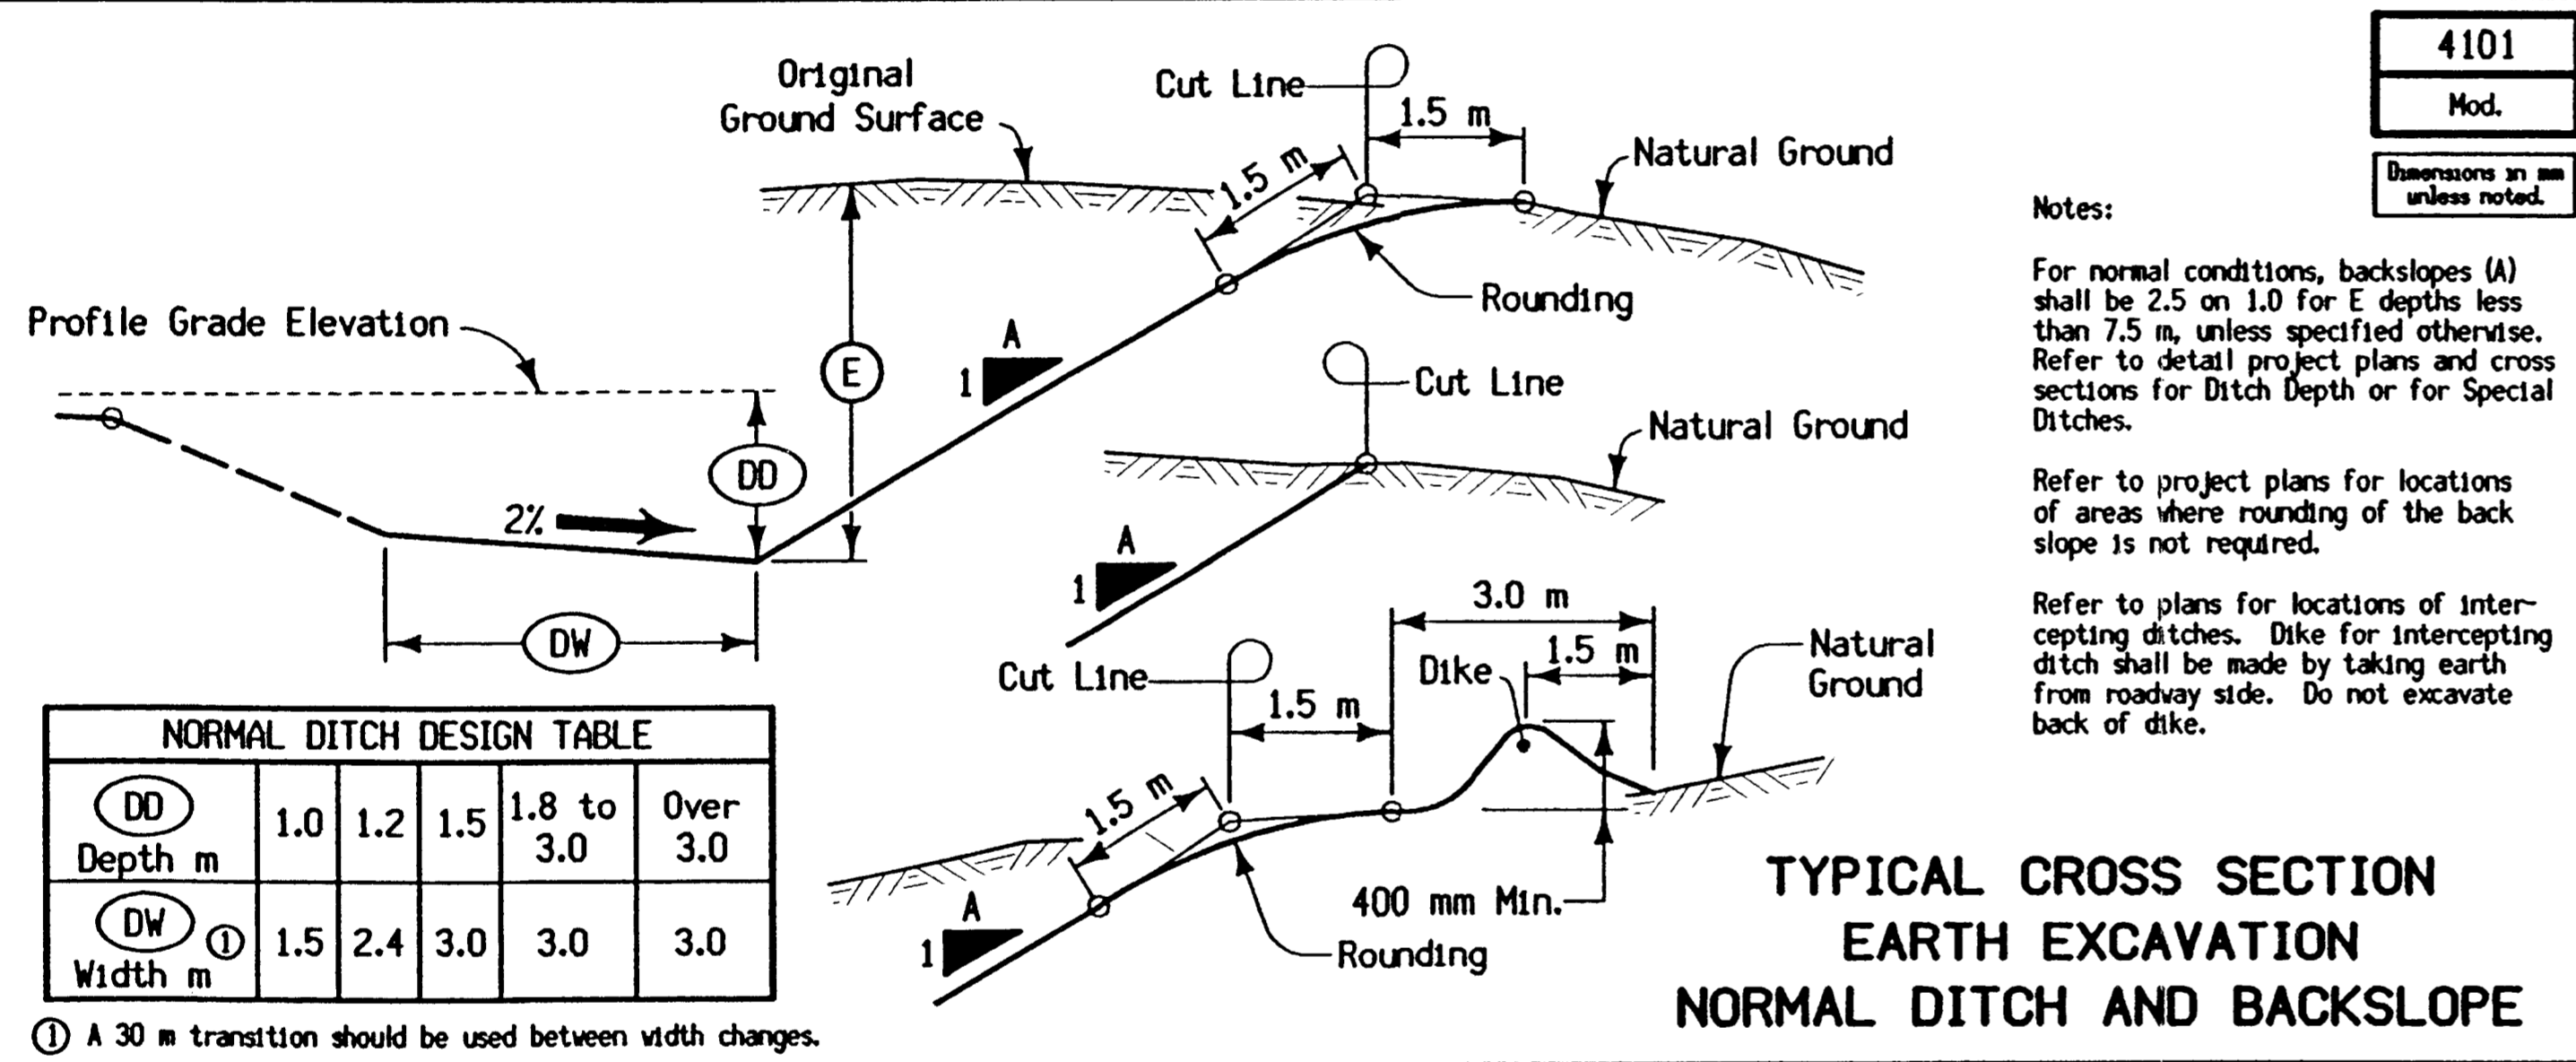

Notes:
For normal conditions, backslopes (A) shall be 2.5 on 1.0 for E depths less than 7.5 m, unless specified otherwise. Refer to detail project plans and cross sections for Ditch Depth or for Special Ditches.
Refer to project plans for locations of areas where rounding of the back slope is not required.
Refer to plans for locations of intercepting ditches. Dike for intercepting ditch shall be made by taking earth from roadway side. Do not excavate back of dike.

(DD) Depth m	1.0	1.2	1.5	1.8 to 3.0	Over 3.0
(DW) Width m	1.5	2.4	3.0	3.0	3.0



TYPICAL CROSS SECTION EARTH EXCAVATION NORMAL DITCH AND BACKSLOPE

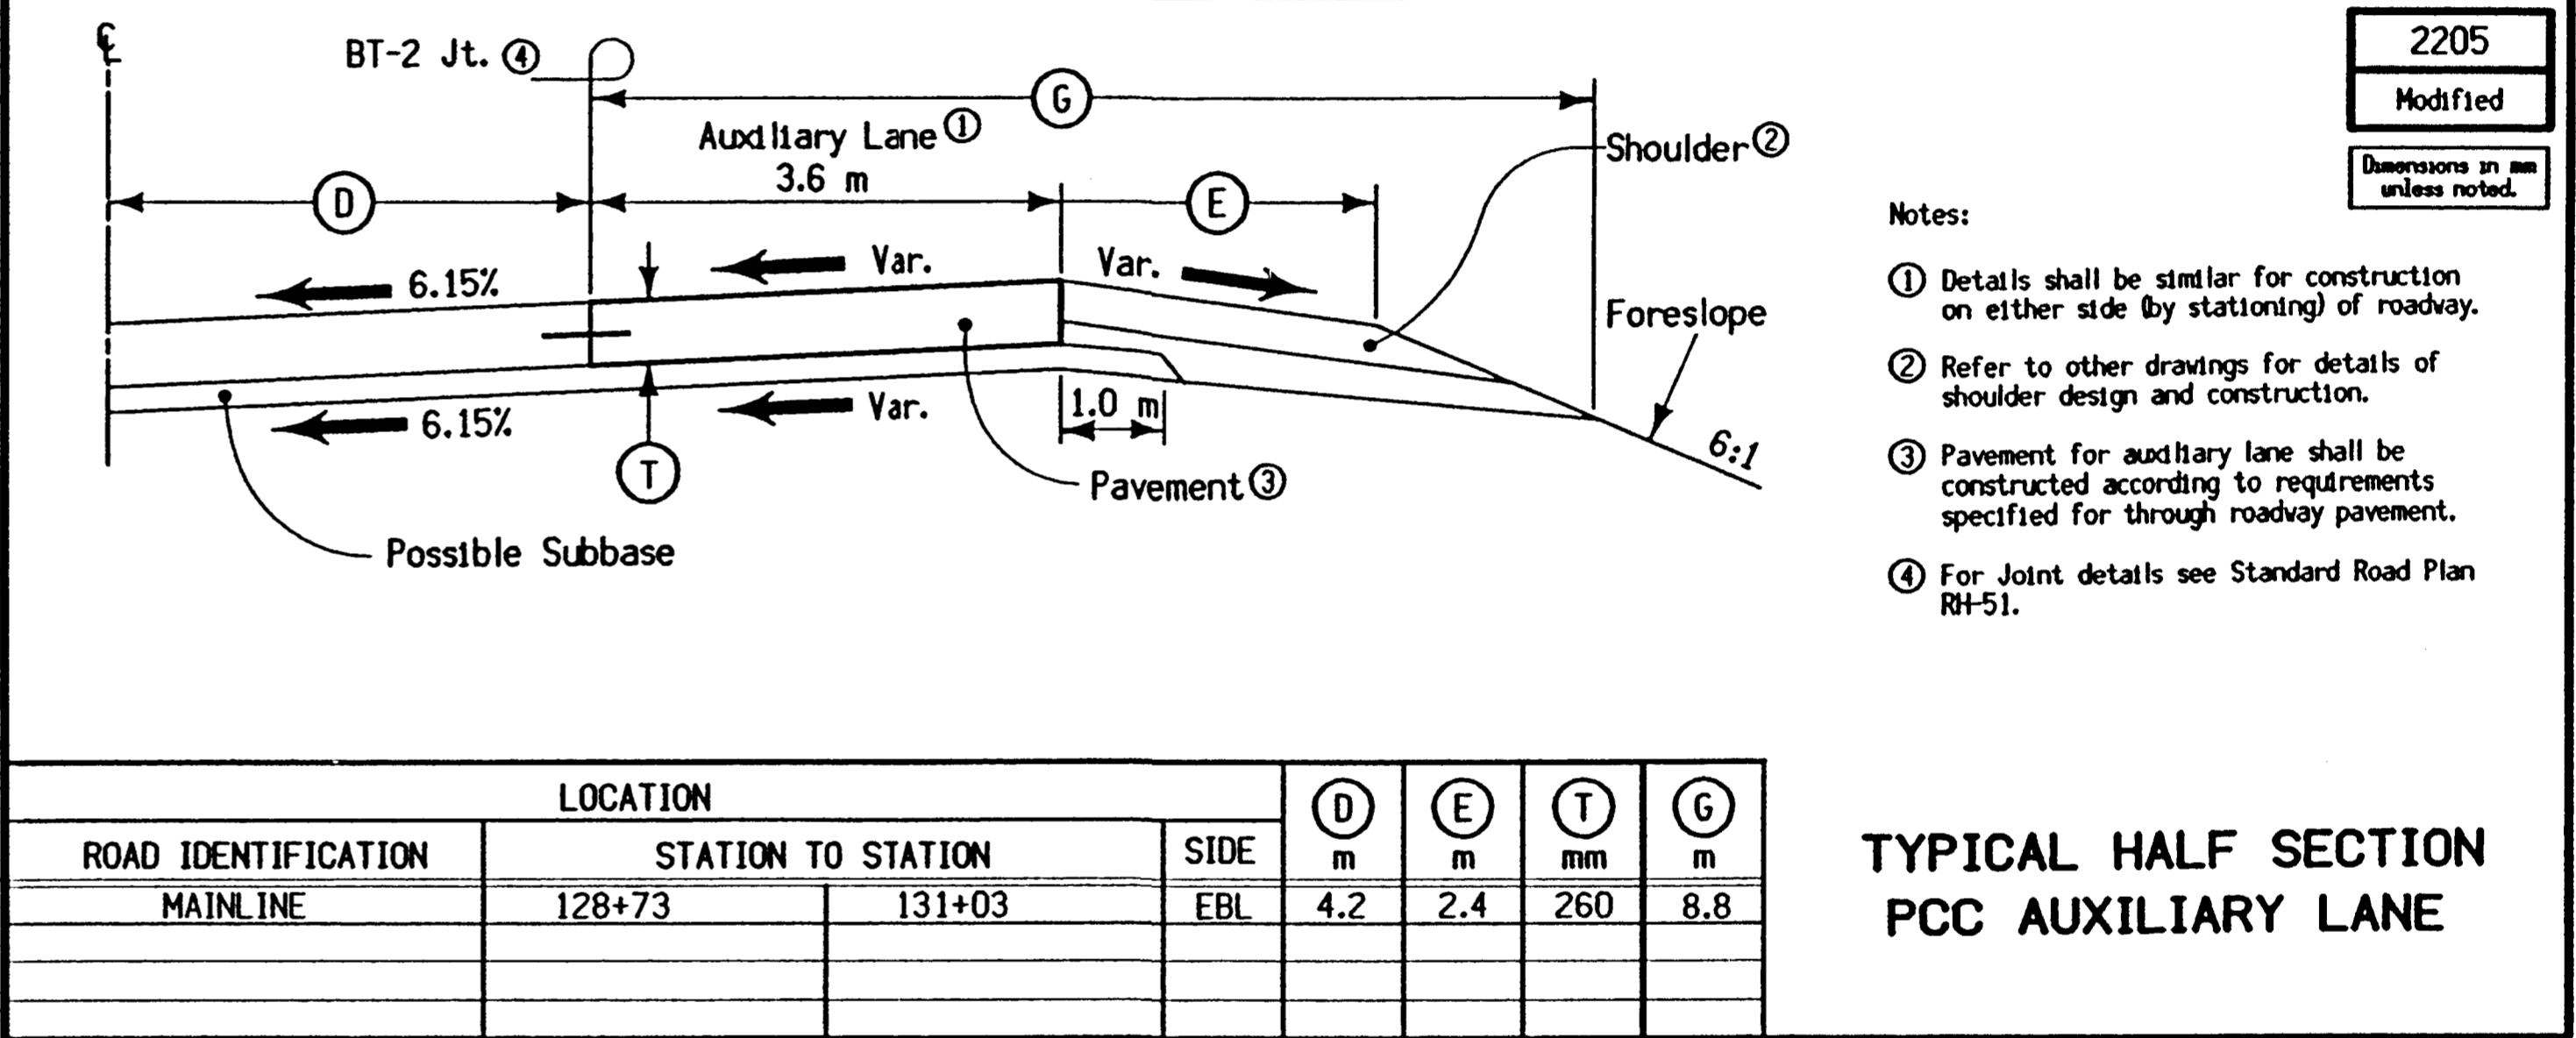

Notes:
① Details shall be similar for construction on either side (by stationing) of roadway.
② Refer to other drawings for details of shoulder design and construction.
③ Pavement for auxiliary lane shall be constructed according to requirements specified for through roadway pavement.
④ For Joint details see Standard Road Plan RH-51.

LOCATION			(D)	(E)	(T)	(G)	
ROAD IDENTIFICATION	STATION TO STATION	SIDE	m	m	mm	m	
MAINLINE	128+73	131+03	EBL	4.2	2.4	260	8.8





TYPICAL HALF SECTION PCC AUXILIARY LANE

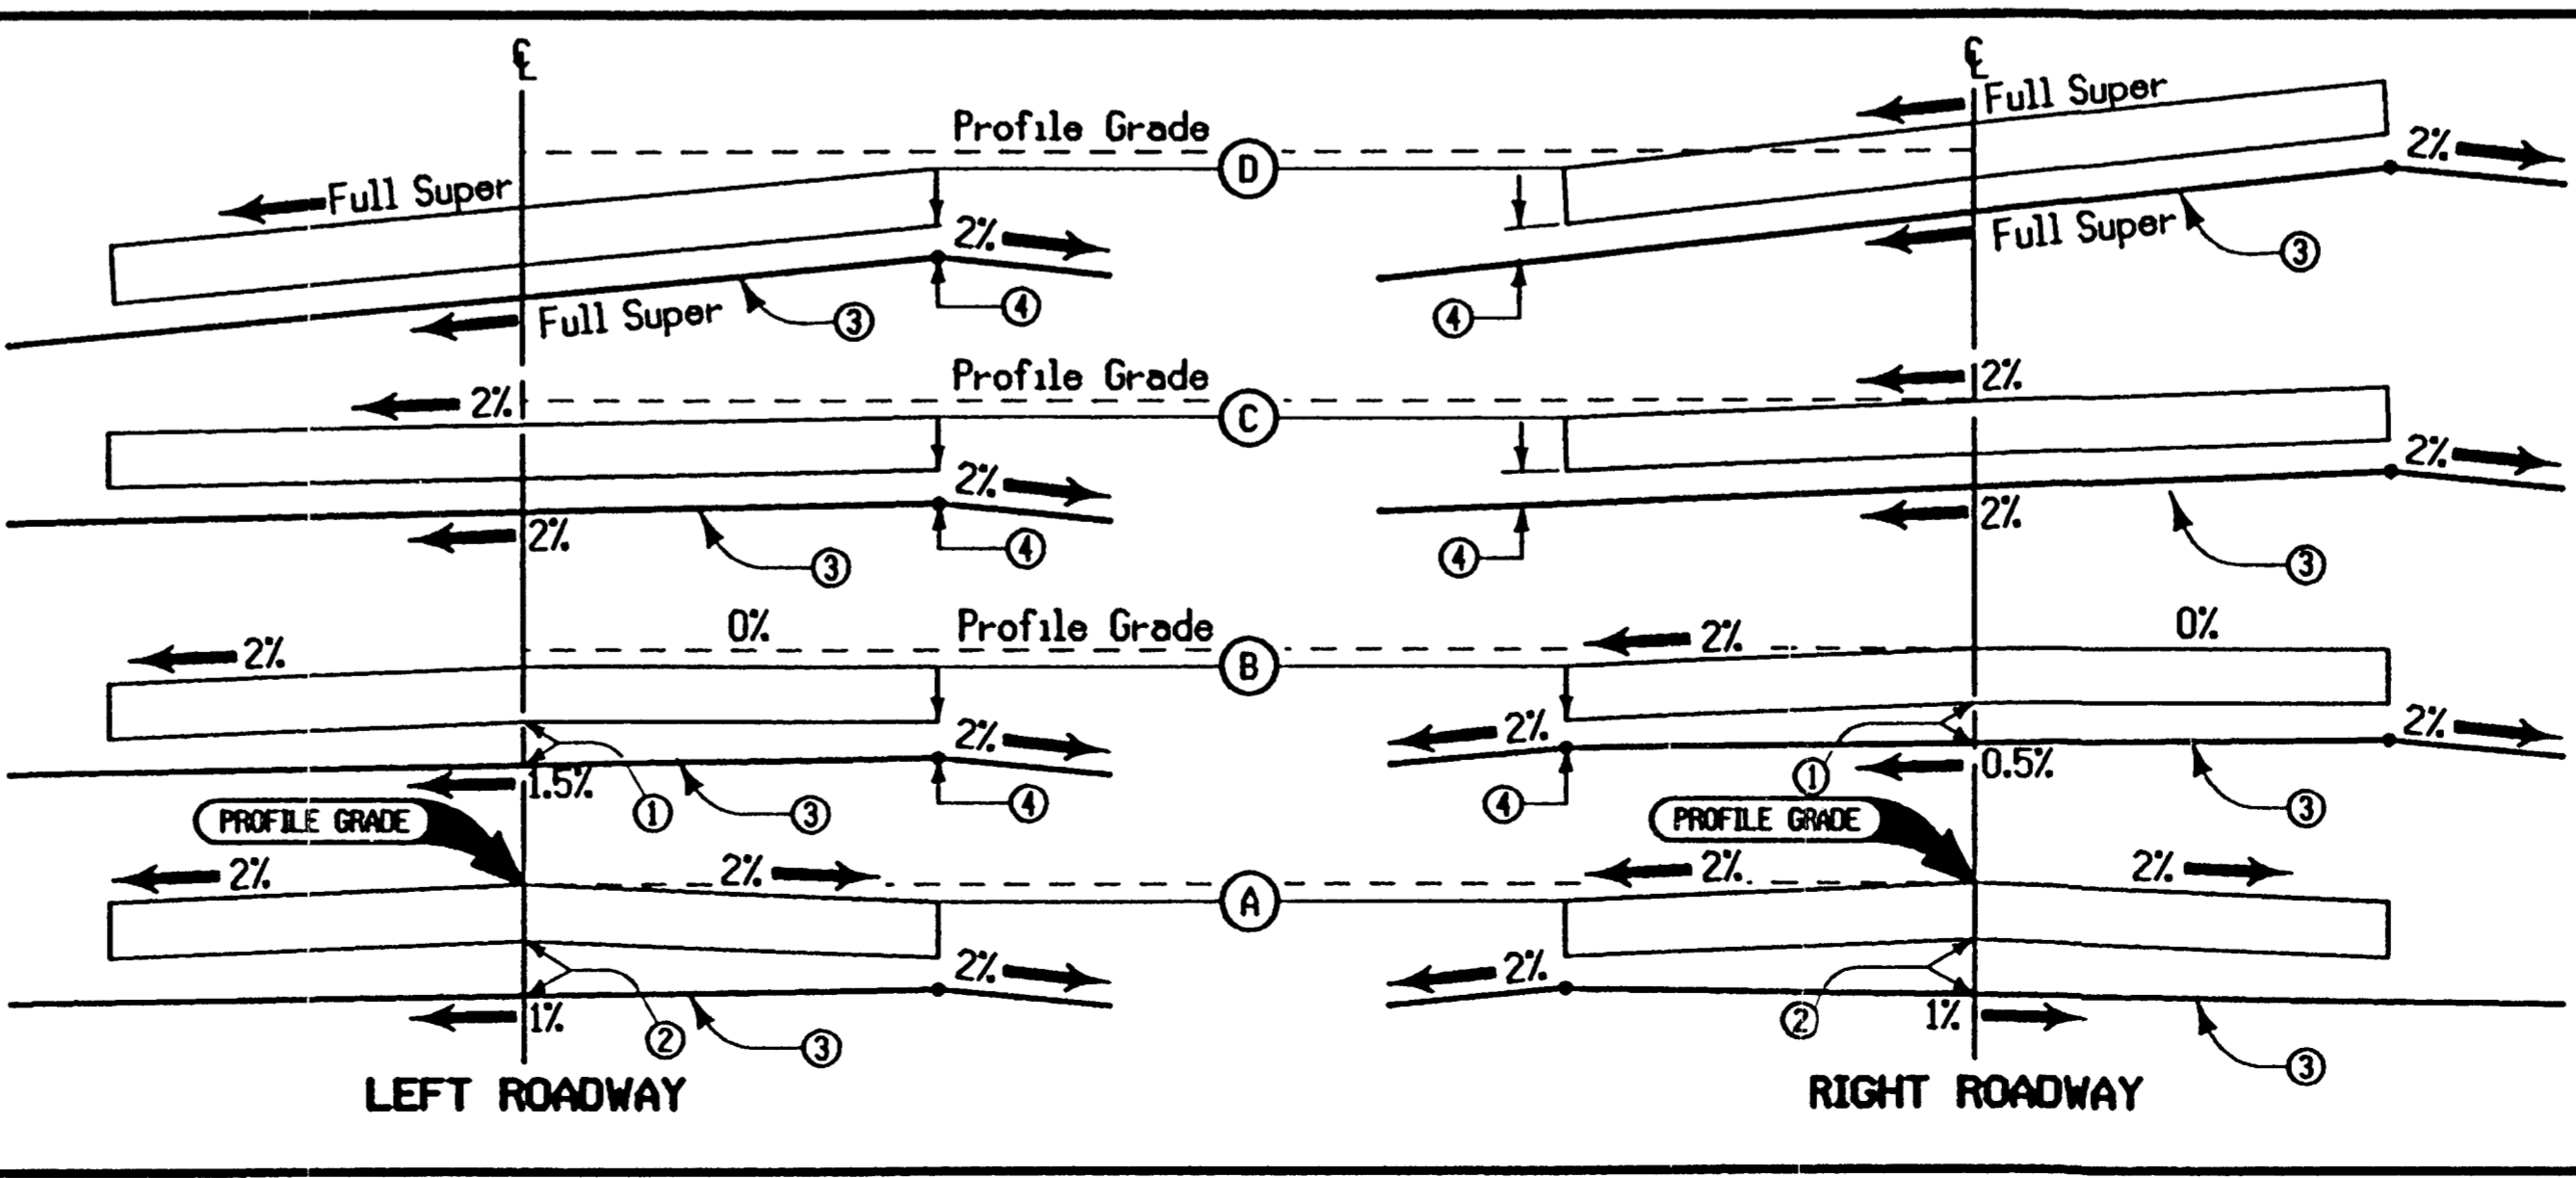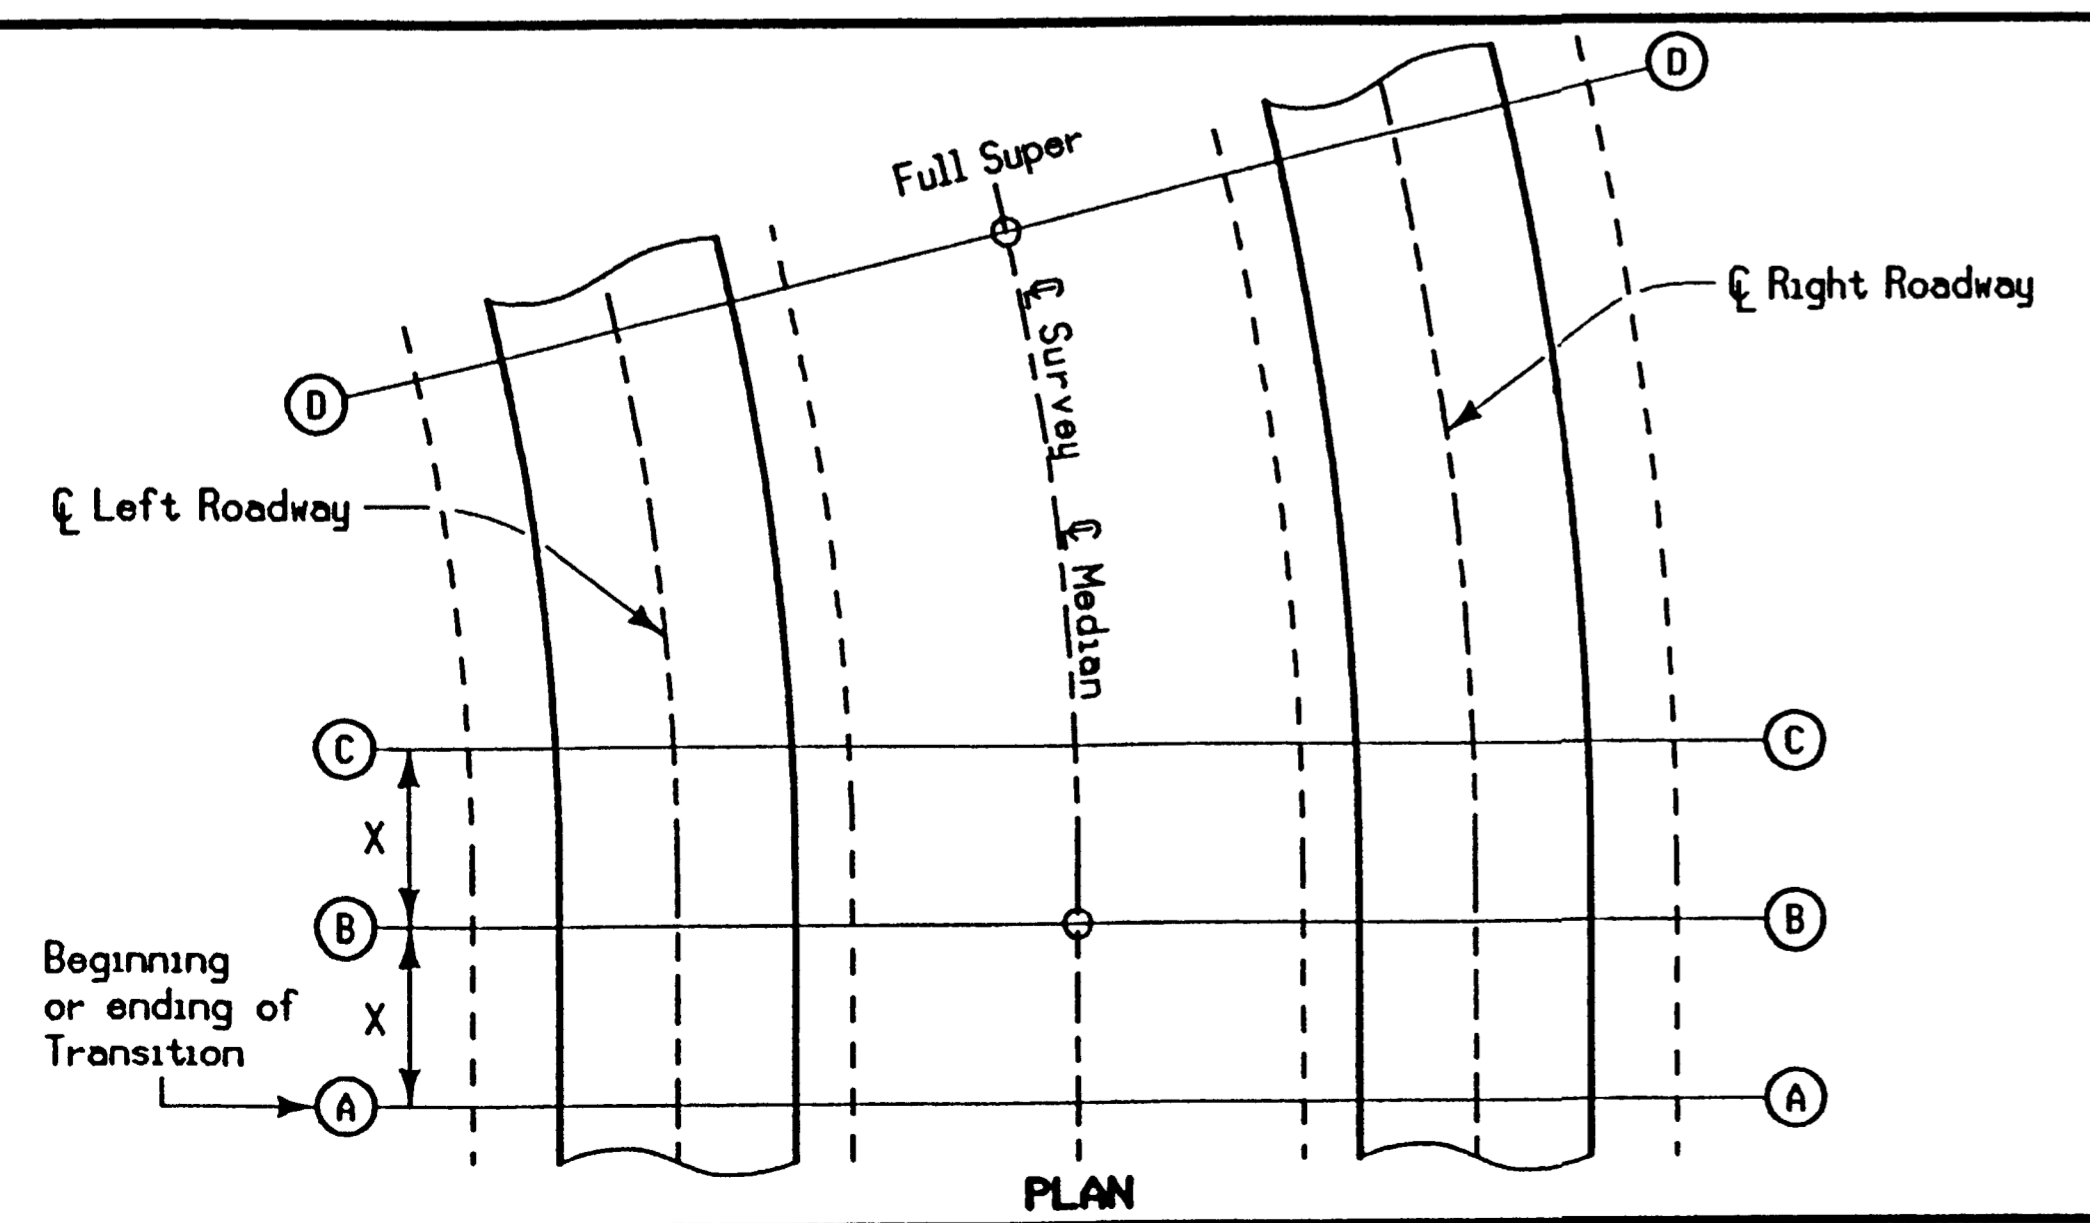


NOTES:
The intent of this detail is to show the different slopes between the subgrade and roadway pavement through the superelevated curve.
For superelevation data, see Tabulation of Circular Curve Data or Plan and Profile sheets. For details of pavement superelevation, see Standard Road Plan RP-2.
① 200 mm
② 260 mm
③ Subgrade Surface
④ 150 mm

GRADING SUPERELEVATION NORMAL 1/2 SUBGRADE SLOPE DIVIDED ROADWAY

dgn = L:\WORK\PROJECT\39922\cadd\X40\turn\X40b01.dgn
levels = 1-63
pen table = L:\plot\tables\half\ft.tbl

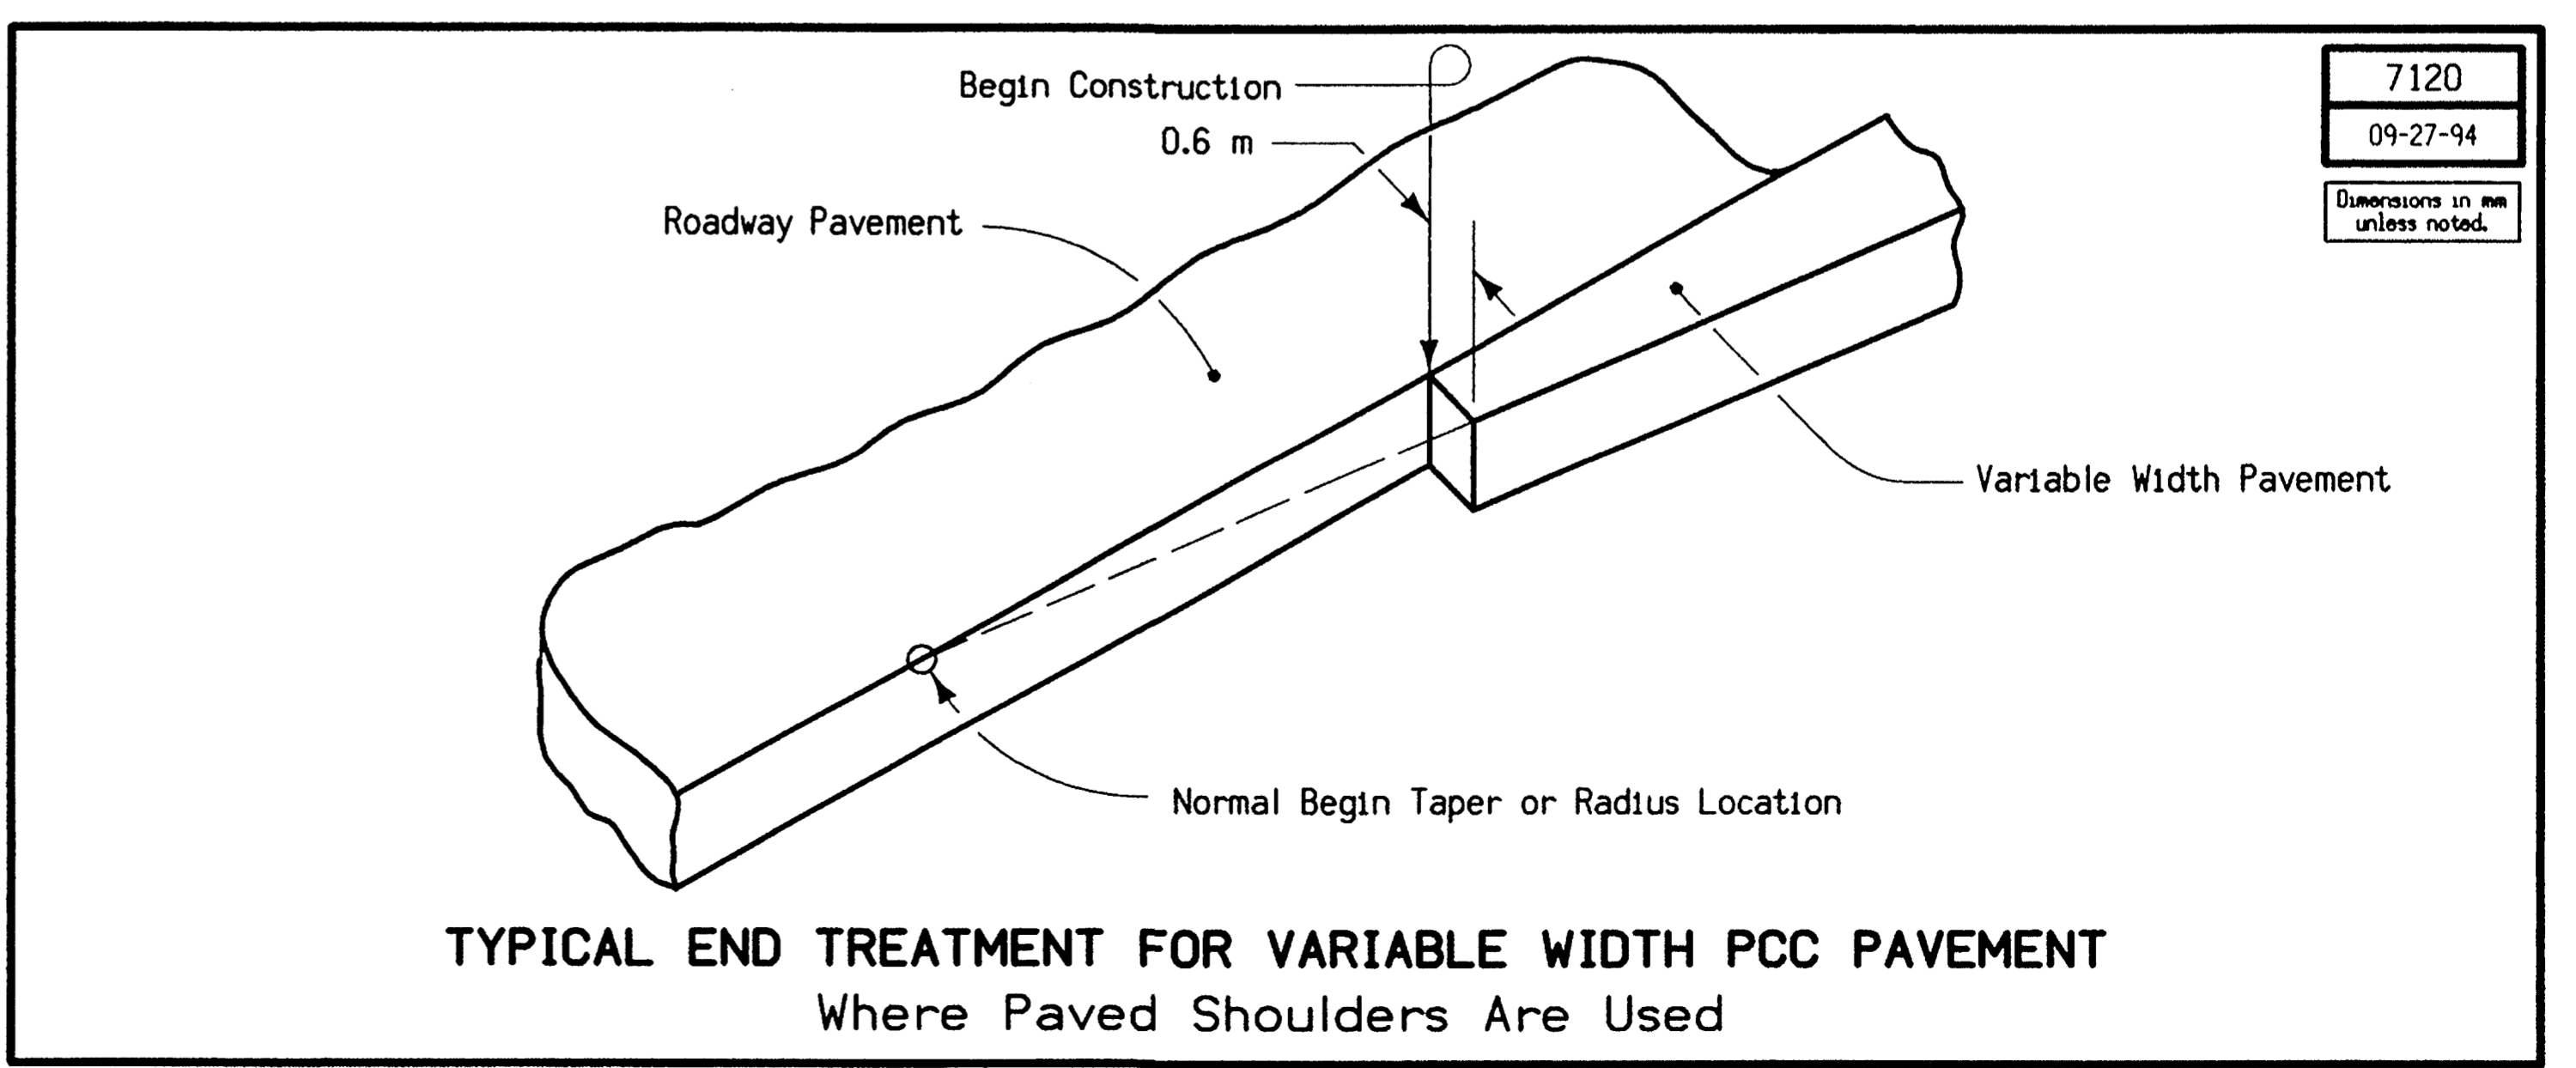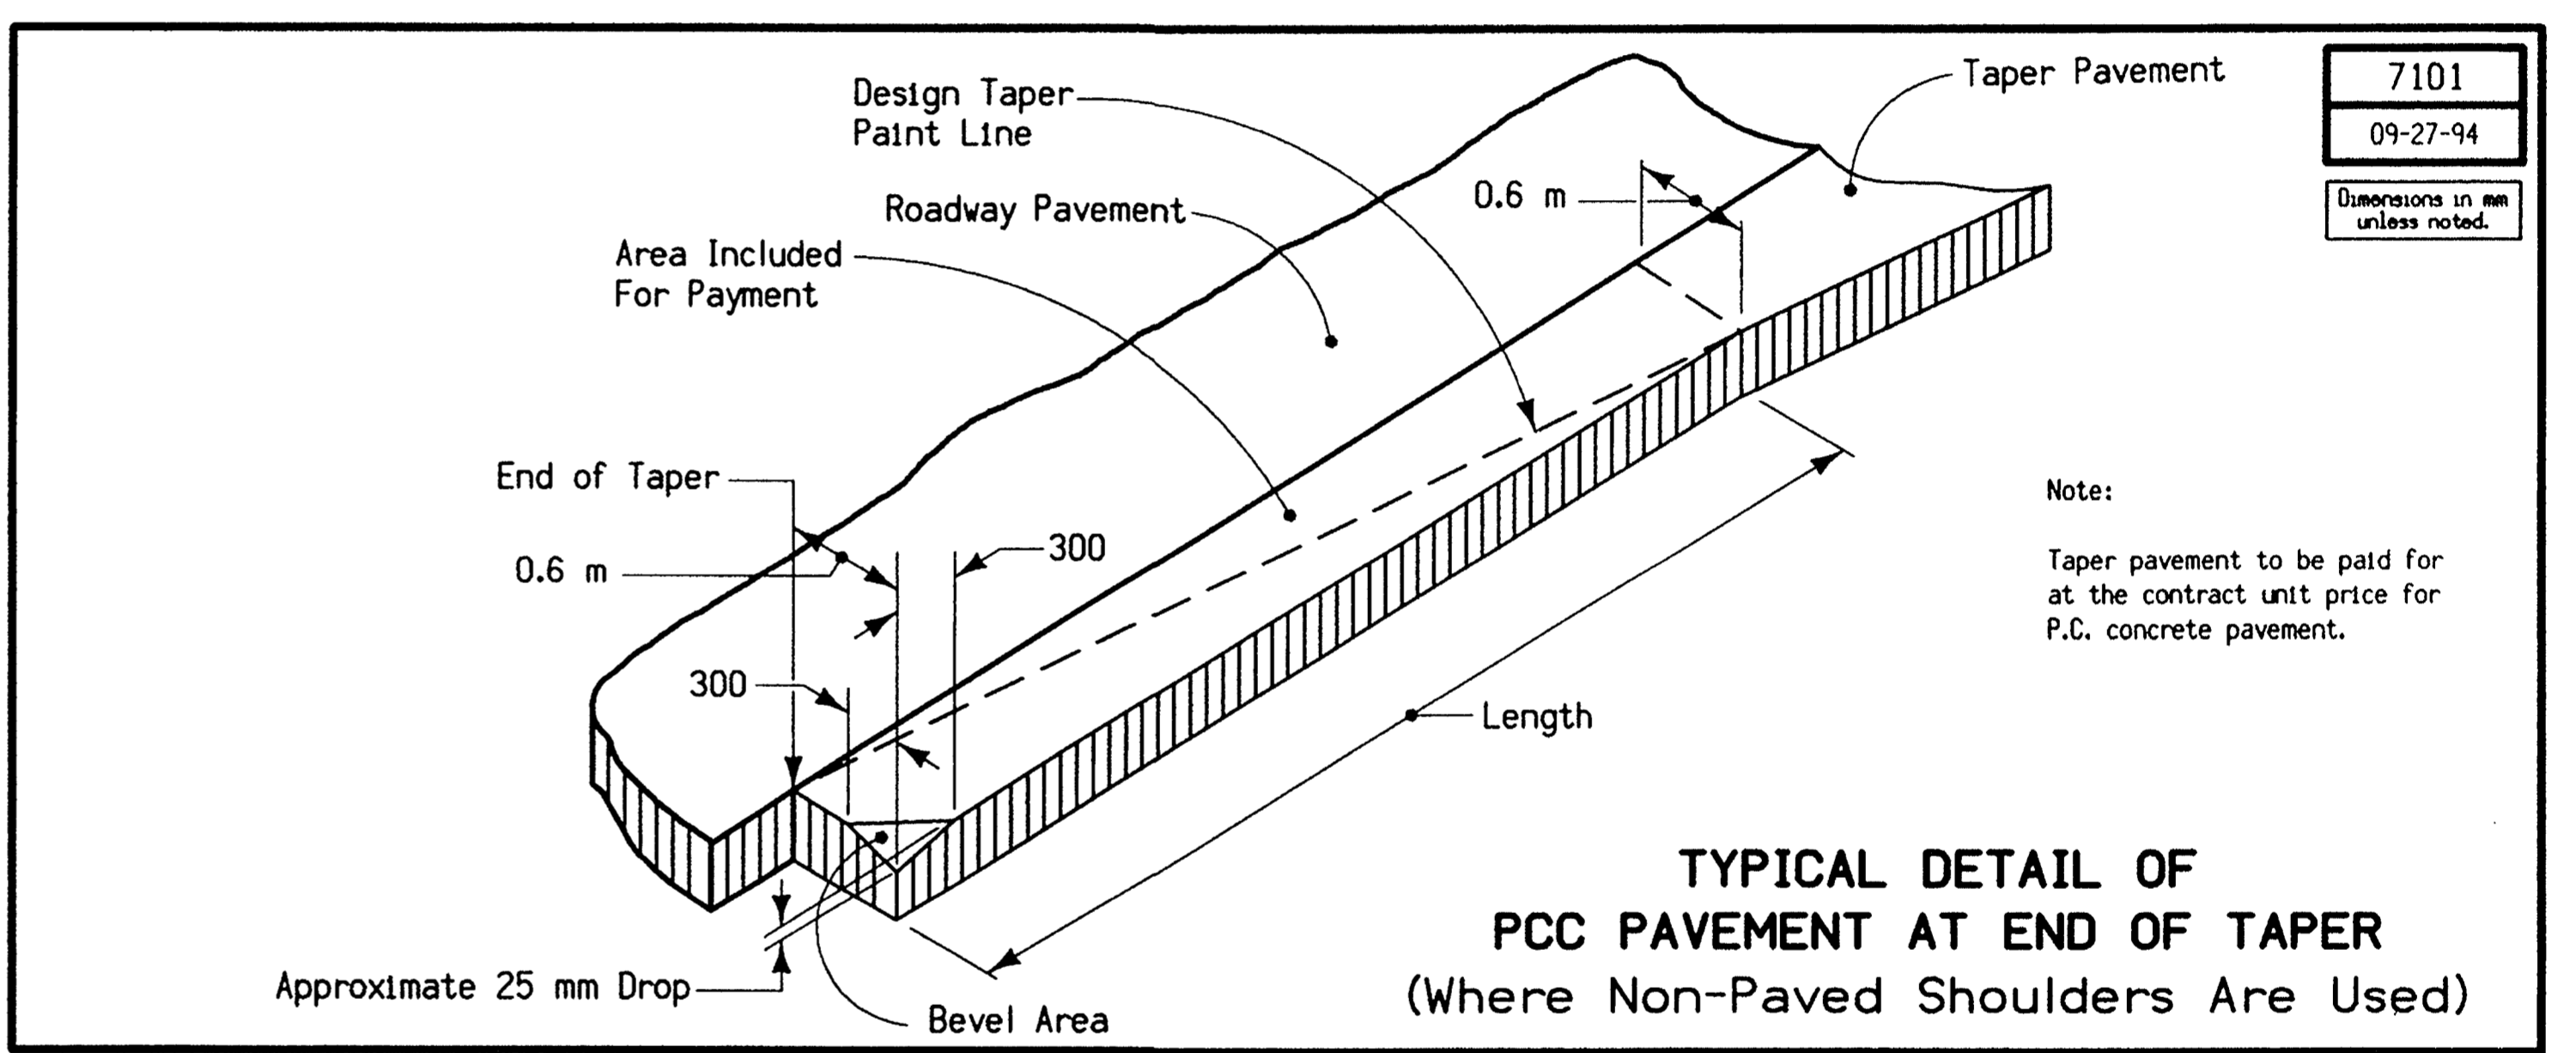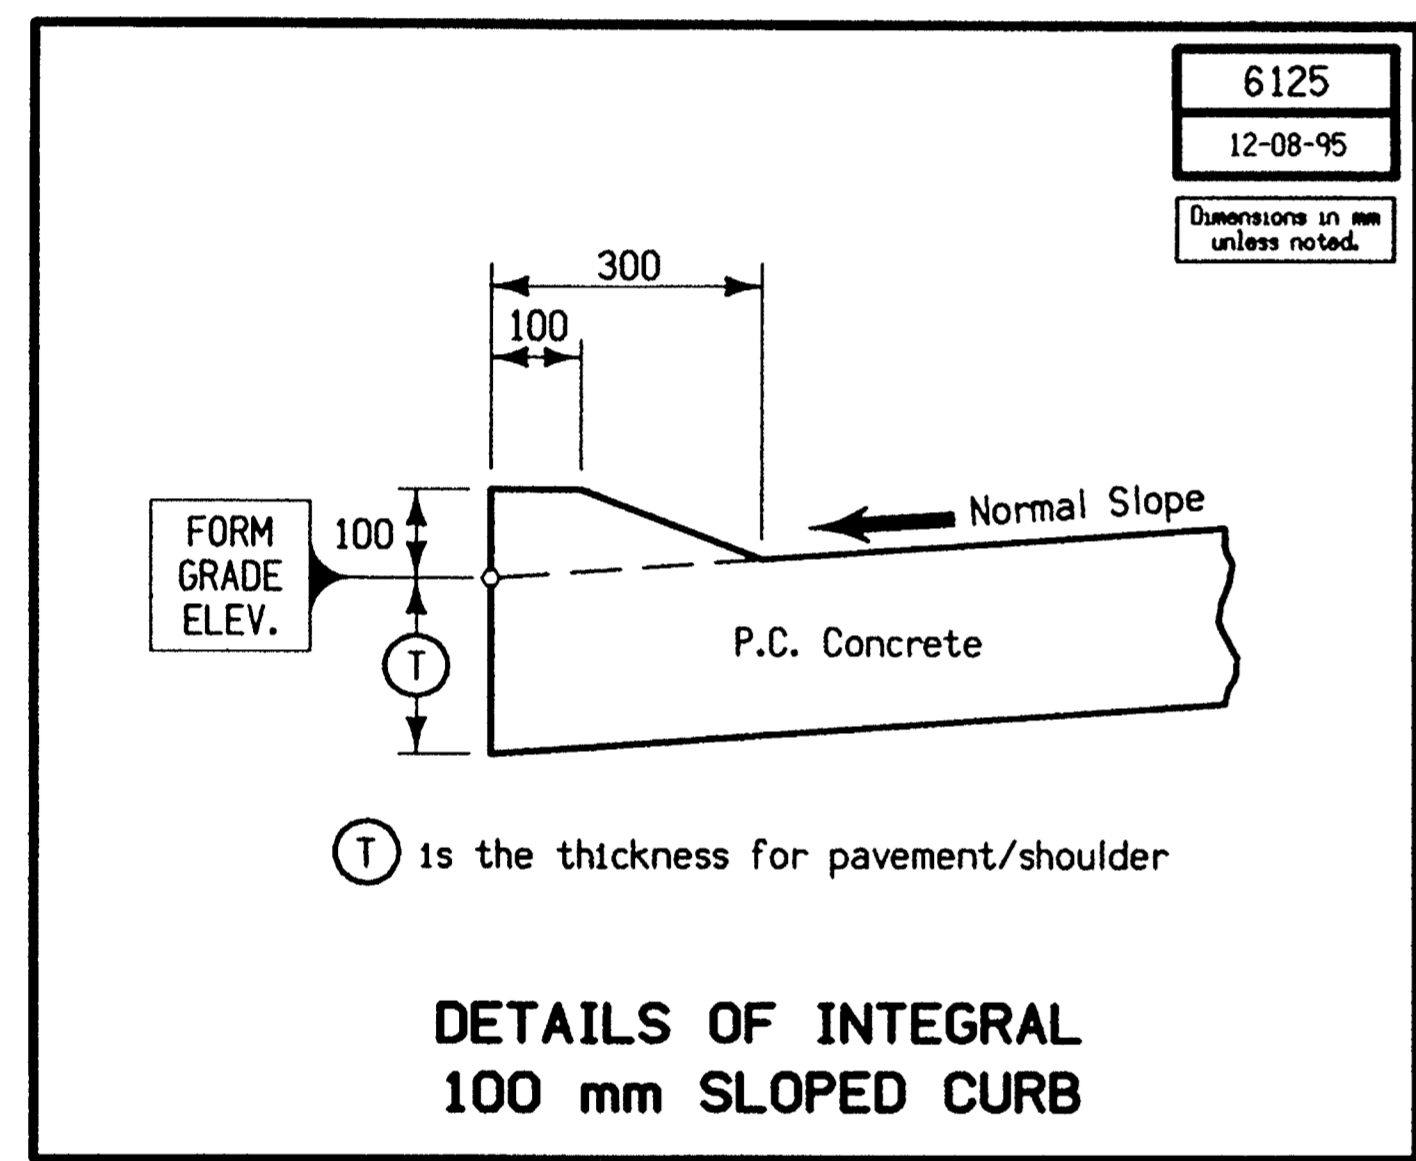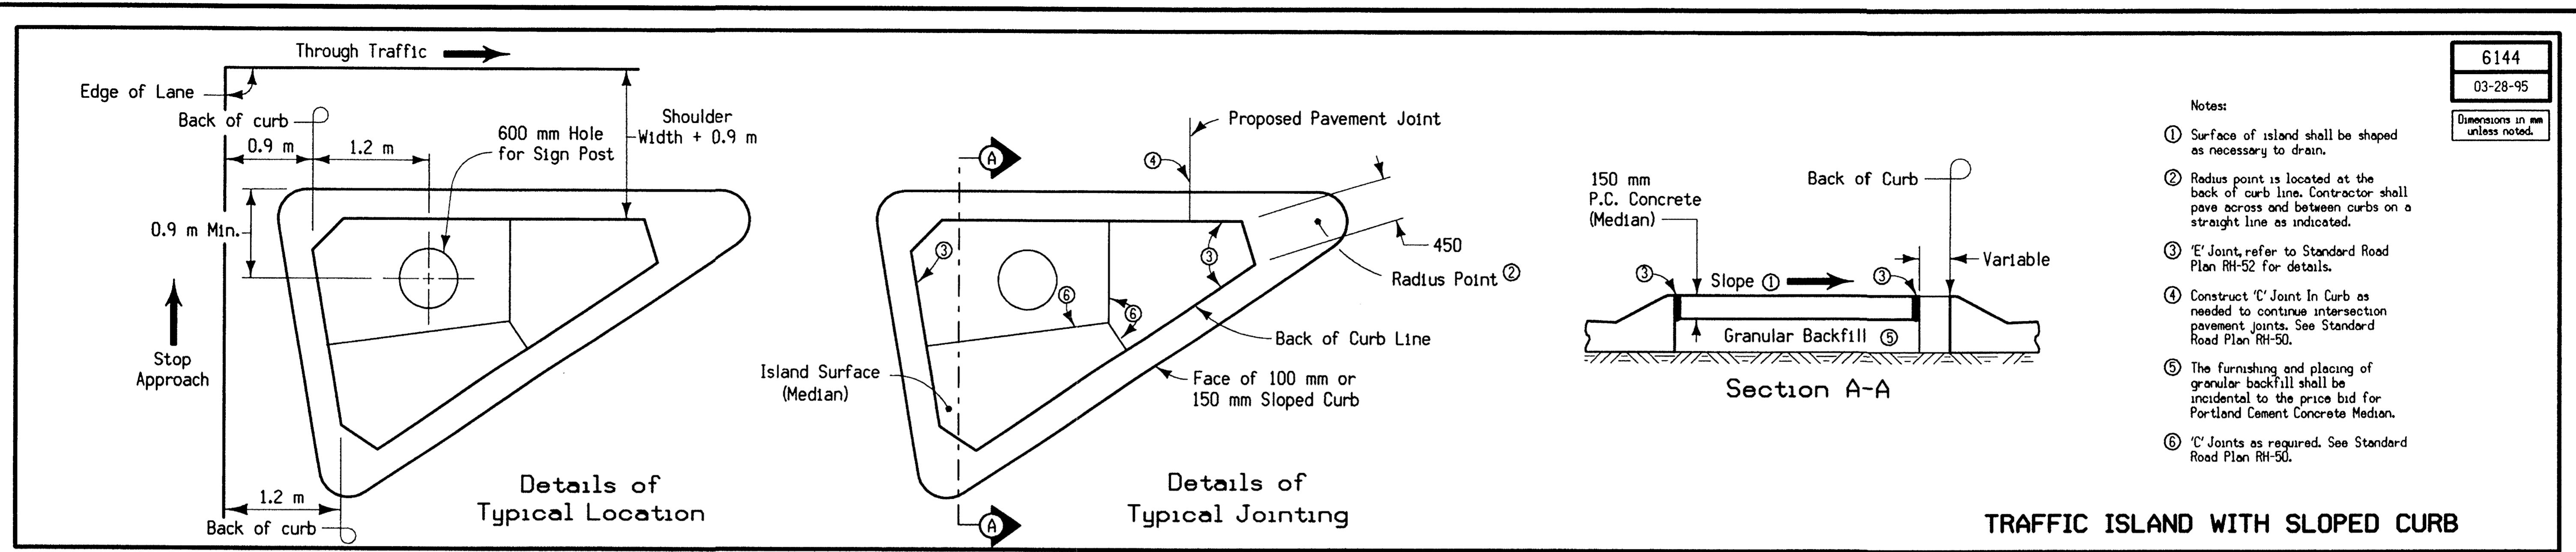

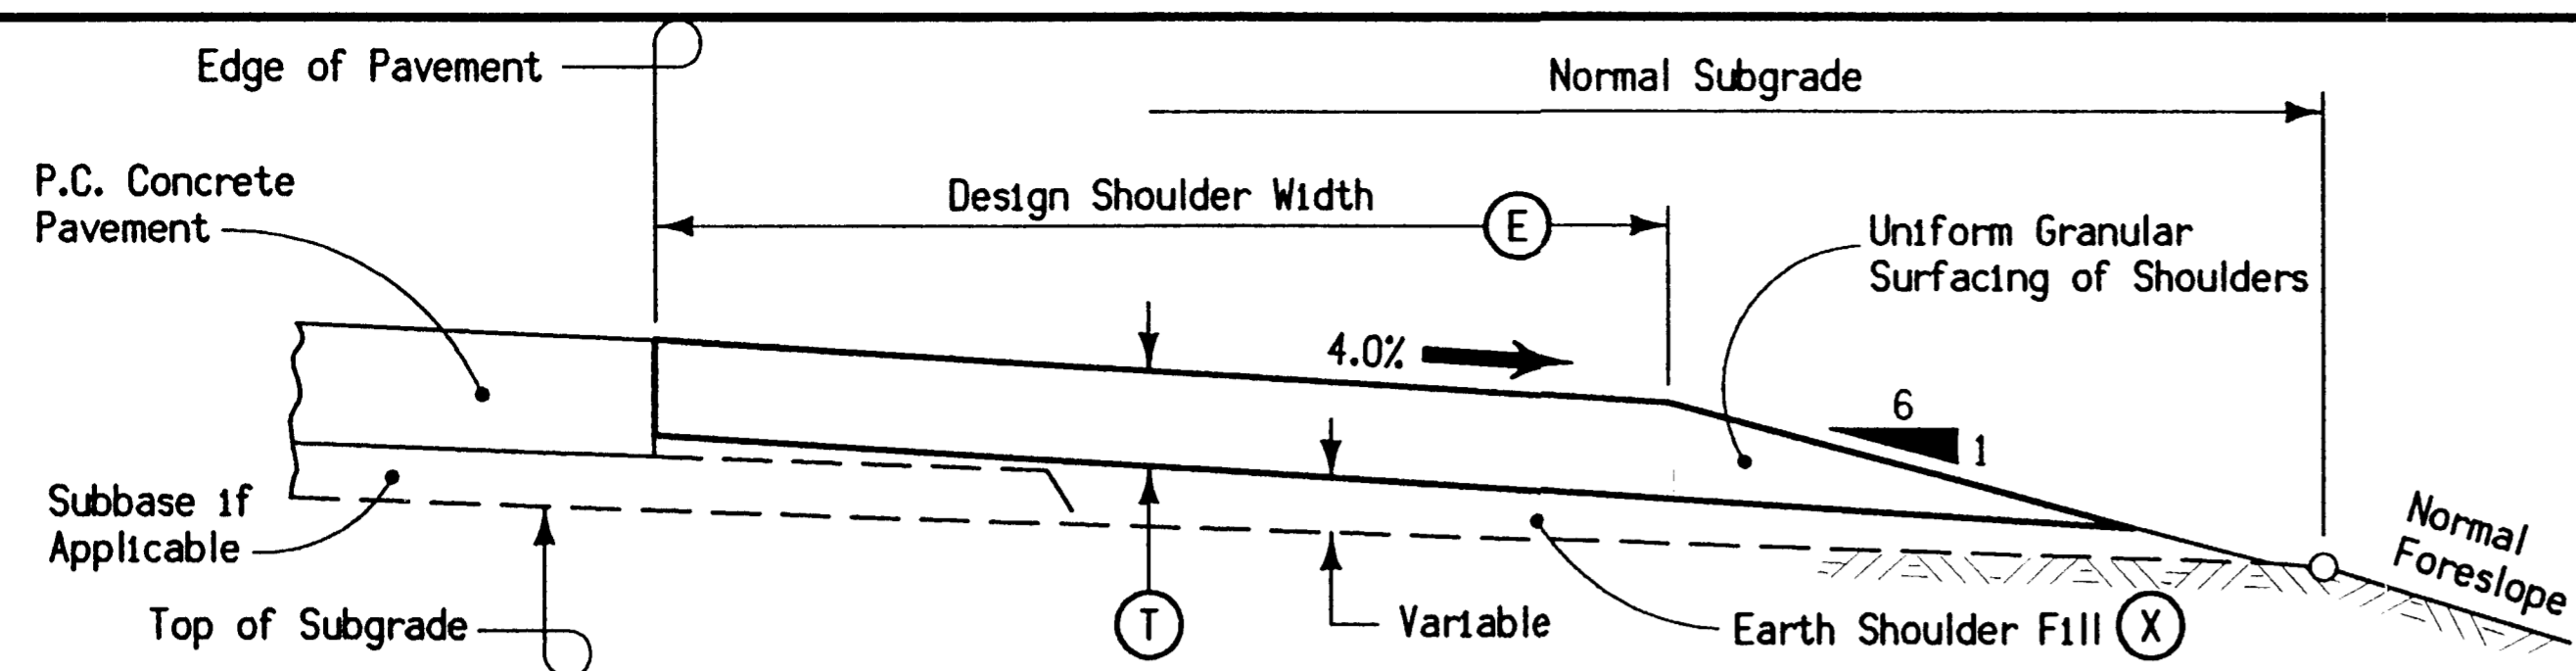


7110
Modified
Dimensions in mm unless noted.

**TYPICAL SECTION
TYPE 'A' OR 'B' GRANULAR SHOULDER
Adjacent to PCC Pavement**

Note:
Earth Shoulder fill requires approximately (X) cubic meters of excavation, including 40% for shrinkage, per station.
See Standard Road Plan RH-37D for construction requirements.

LOCATION		(E)	(T)	SIDE	(X)		
ROAD IDENTIFICATION	STATION TO STATION	m	mm		m ³		
Mainline							
Westbound	15+40	64+50	2.4	150	Lt.	125.3	
	15+40	65+75	1.8	150	Rt.	92.5	
	72+00	82+00	2.4	150	Lt.	125.3	
	72+00	84+00	1.8	150	Rt.	92.5	
	83+10	84+00	1.8	150	Lt.	92.5	
	154+50	164+00	1.8	150	Rt.	92.5	
	154+50	162+10	2.4	150	Lt.	125.3	
	163+10	164+00	1.8	150	Lt.	92.5	
	173+19	176+25	2.4	150	Rt.	125.3	
	(Relocated Curve)	9173+40	9176+56	1.8	150	Rt.	92.5
	Eastbound	21+00	24+00	2.4	150	Rt.	125.3
		21+00	24+00	1.8	150	Lt.	92.5
67+95		74+30	2.4	150	Rt.	125.3	
74+30		75+78	1.8	150	Rt.	92.5	
76+85		80+10	2.4	150	Rt.	125.3	
80+90		83+50	1.8	150	Rt.	92.5	
83+50		151+07	2.4	150	Rt.	125.3	
151+07		153+10	1.8	150	Rt.	92.5	
152+95		156+55	2.4	150	Rt.	125.3	
158+30		161+50	1.8	150	Rt.	92.5	
161+50		187+10	2.4	150	Rt.	125.3	
67+95		187+10	1.8	150	Lt.	92.5	
X-28	1452+50	1455+00	2.4	150	Lt.	37.9	
	1452+50	1455+00	2.4	150	Rt.	37.9	
X-40	2131+46	2132+25	2.4	150	Lt.	37.9	
	2131+46	2132+25	2.4	150	Rt.	37.9	
130th Street	1173+35	1174+75	1.8	150	Lt.	34.7	
	1173+35	1174+75	1.8	150	Rt.	34.7	
X-Over @ Sta. 4+50	700+37	702+78	1.2	150	Rt.	0.0	
	701+95	704+16	1.2	150	Lt.	0.0	

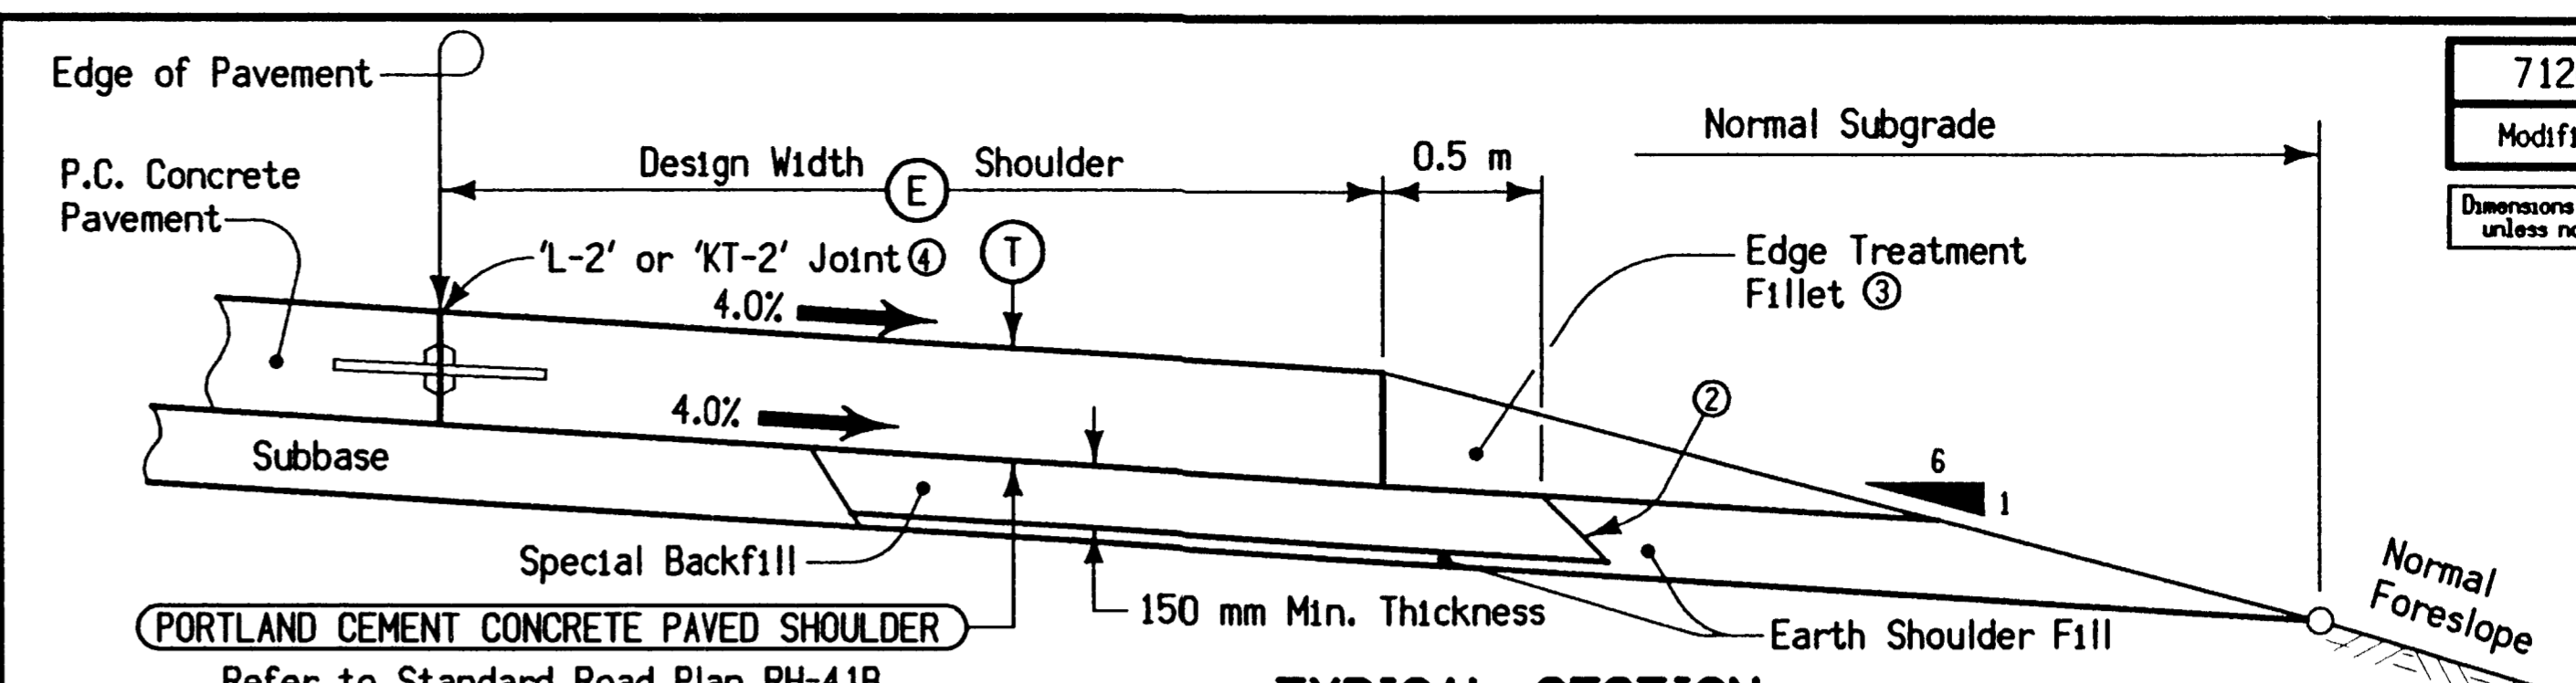


7126
Modified
Dimensions in mm unless noted.

**TYPICAL SECTION
Full Depth PCC Paved Shoulder**

- ① Per station per side. See Standard Road Plan RH-418 for basis of estimate.
- ② Approximately 1:1 Slope
- ③ Refer to appropriate detail drawings.
- ④ When ① is less than 200 mm use 'BT-1' Joint. When ① is equal to or more than 200 mm use 'L-2', 'KT-2' or modified 'BT-3'. Modified 'BT-3' requires a keyway. See Standard Road Plan RH-51 for joint details.
- ⑤ Bid Items
- ⑥ See Tab. 112-9
- ⑦ Earth Shoulder fill requires approximately (X) cubic meters of excavation, including 40% for shrinkage, per station.
- ⑧ Included with special backfill under ramps and tapers. See tab. X-50 on Sheet C.15 for details.
- ⑨ Max breakover is 7%. When superelevation exceeds 7%, paved shoulders high side will have a 1% slope on to Ramp or Loop.

LOCATION			DIMENSIONS		QUANTITIES ①		
ROAD IDENTIFICATION	STATION TO STATION	SIDE	(T)	(E)	SURFACE AREA m ² ⑤	VOLUME m ³ ⑦	SPECIAL BACKFILL Mg ⑧
IA-1 Loop B	2076+60	2079+39	LT	260	1.2	(6)	21.4 (8)
	2076+60	2079+39	RT	260	1.8	(6)	21.4 (8)
IA-1 Ramp C	3075+08	3080+90	RT	260	1.8	(6)	21.4 (8)
	3075+00	3076+00	LT	260	1.8	(6)	21.4 (8)
IA-64 Ramp C	3076+00	3080+10	LT	260	1.2	(6)	21.4 (8)
	6153+10	6157+20	RT	260	1.8	(6)	21.4 (8)
IA-64 Loop C	6153+00	6156+62	LT	260	1.2	(6)	21.4 (8)
	6156+62	6157+20	LT	260	1.8	(6)	21.4 (8)
IA-64 Loop C	7154+94	7157+50	RT	260	1.8	(6)	21.4 (8)
	7154+94	7156+55	LT	260	1.2	(6)	21.4 (8)

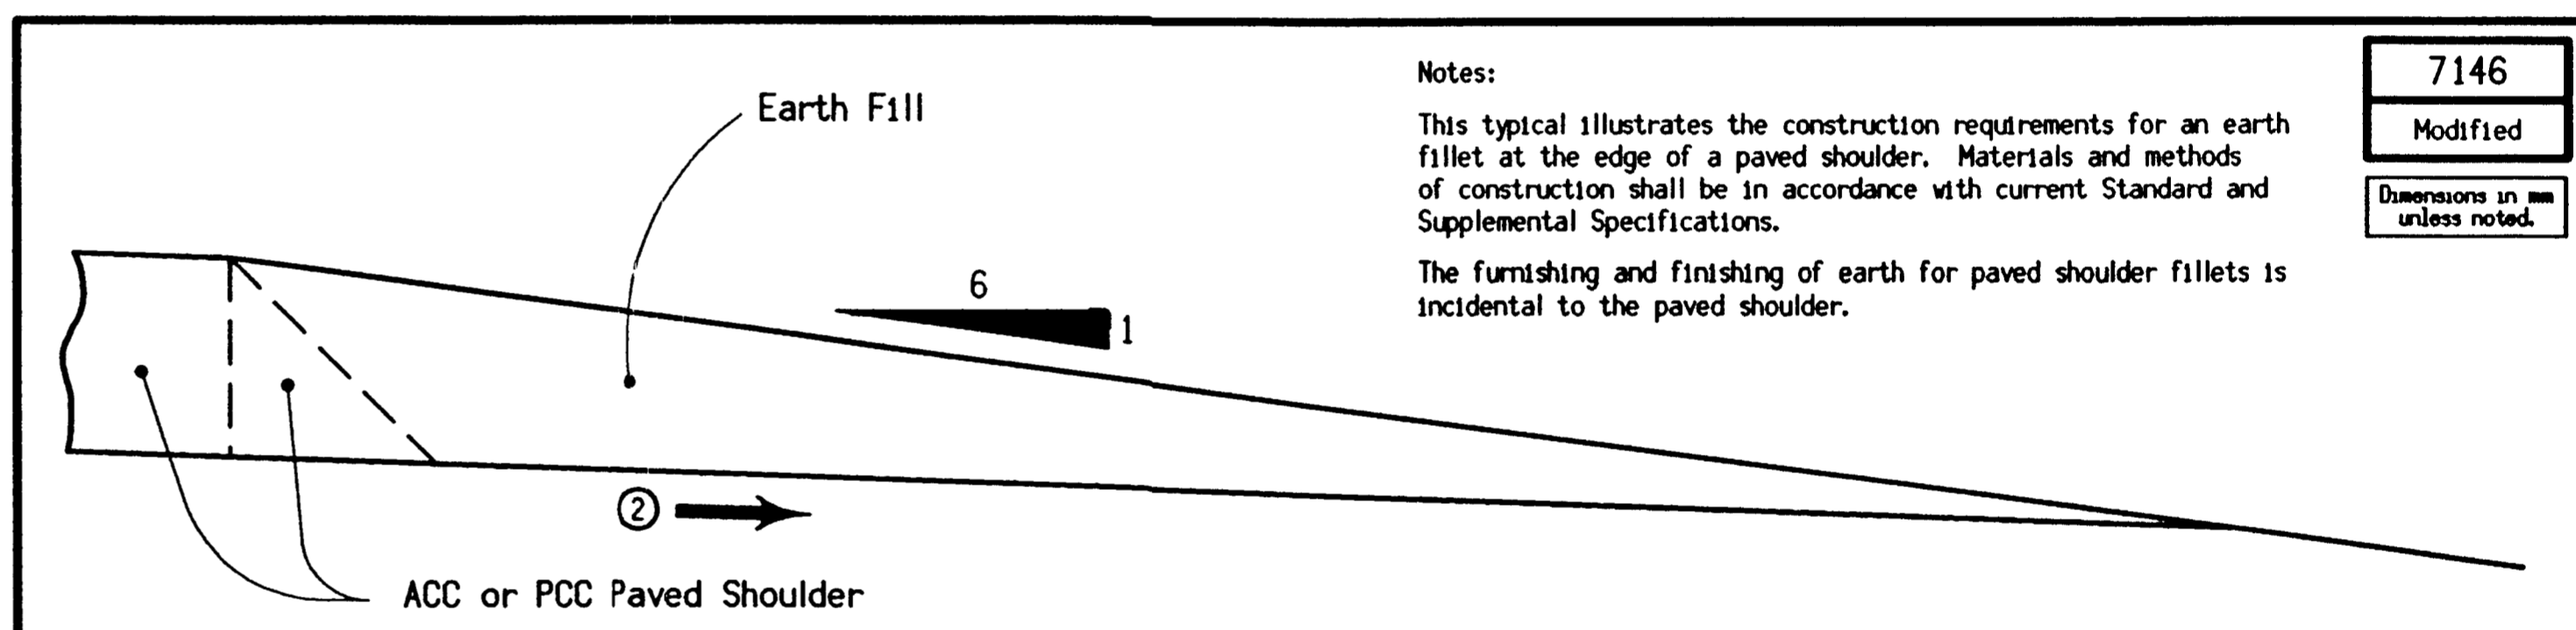

7146
Modified
Dimensions in mm unless noted.





Notes:
This typical illustrates the construction requirements for an earth fillet at the edge of a paved shoulder. Materials and methods of construction shall be in accordance with current Standard and Supplemental Specifications.
The furnishing and finishing of earth for paved shoulder fillets is incidental to the paved shoulder.



LOCATION			QUANTITIES ①
ROAD IDENTIFICATION	STATION TO STATION	SIDE	EARTH FILL m ³
			40% Shrink
IA-1 Loop B	2076+60	2079+39	LT 37.6
	2076+60	2079+39	RT 37.6
IA-1 Ramp C	3075+08	3080+90	RT 37.6
	3075+00	3076+00	LT 37.6
IA-64 Ramp C	3076+00	3080+10	LT 37.6
	6153+10	6157+20	RT 37.6
IA-64 Ramp C	6153+00	6156+62	LT 37.6
	6156+62	6157+20	LT 37.6
IA-64 Loop C	7154+94	7157+50	RT 37.6
	7154+94	7156+55	LT 37.6





- ① Not a bid item. Quantities are per station per side.
- ② Match slope of under side of shoulder pavement.






**EARTH FOR
PAVED SHOULDER FILLET**

dgn = i:\WORK\project\39922\cadd\anacurve\PAVE\57151112.b05
levels = 1-63
pen table = i:\plot\tables\half.tbl

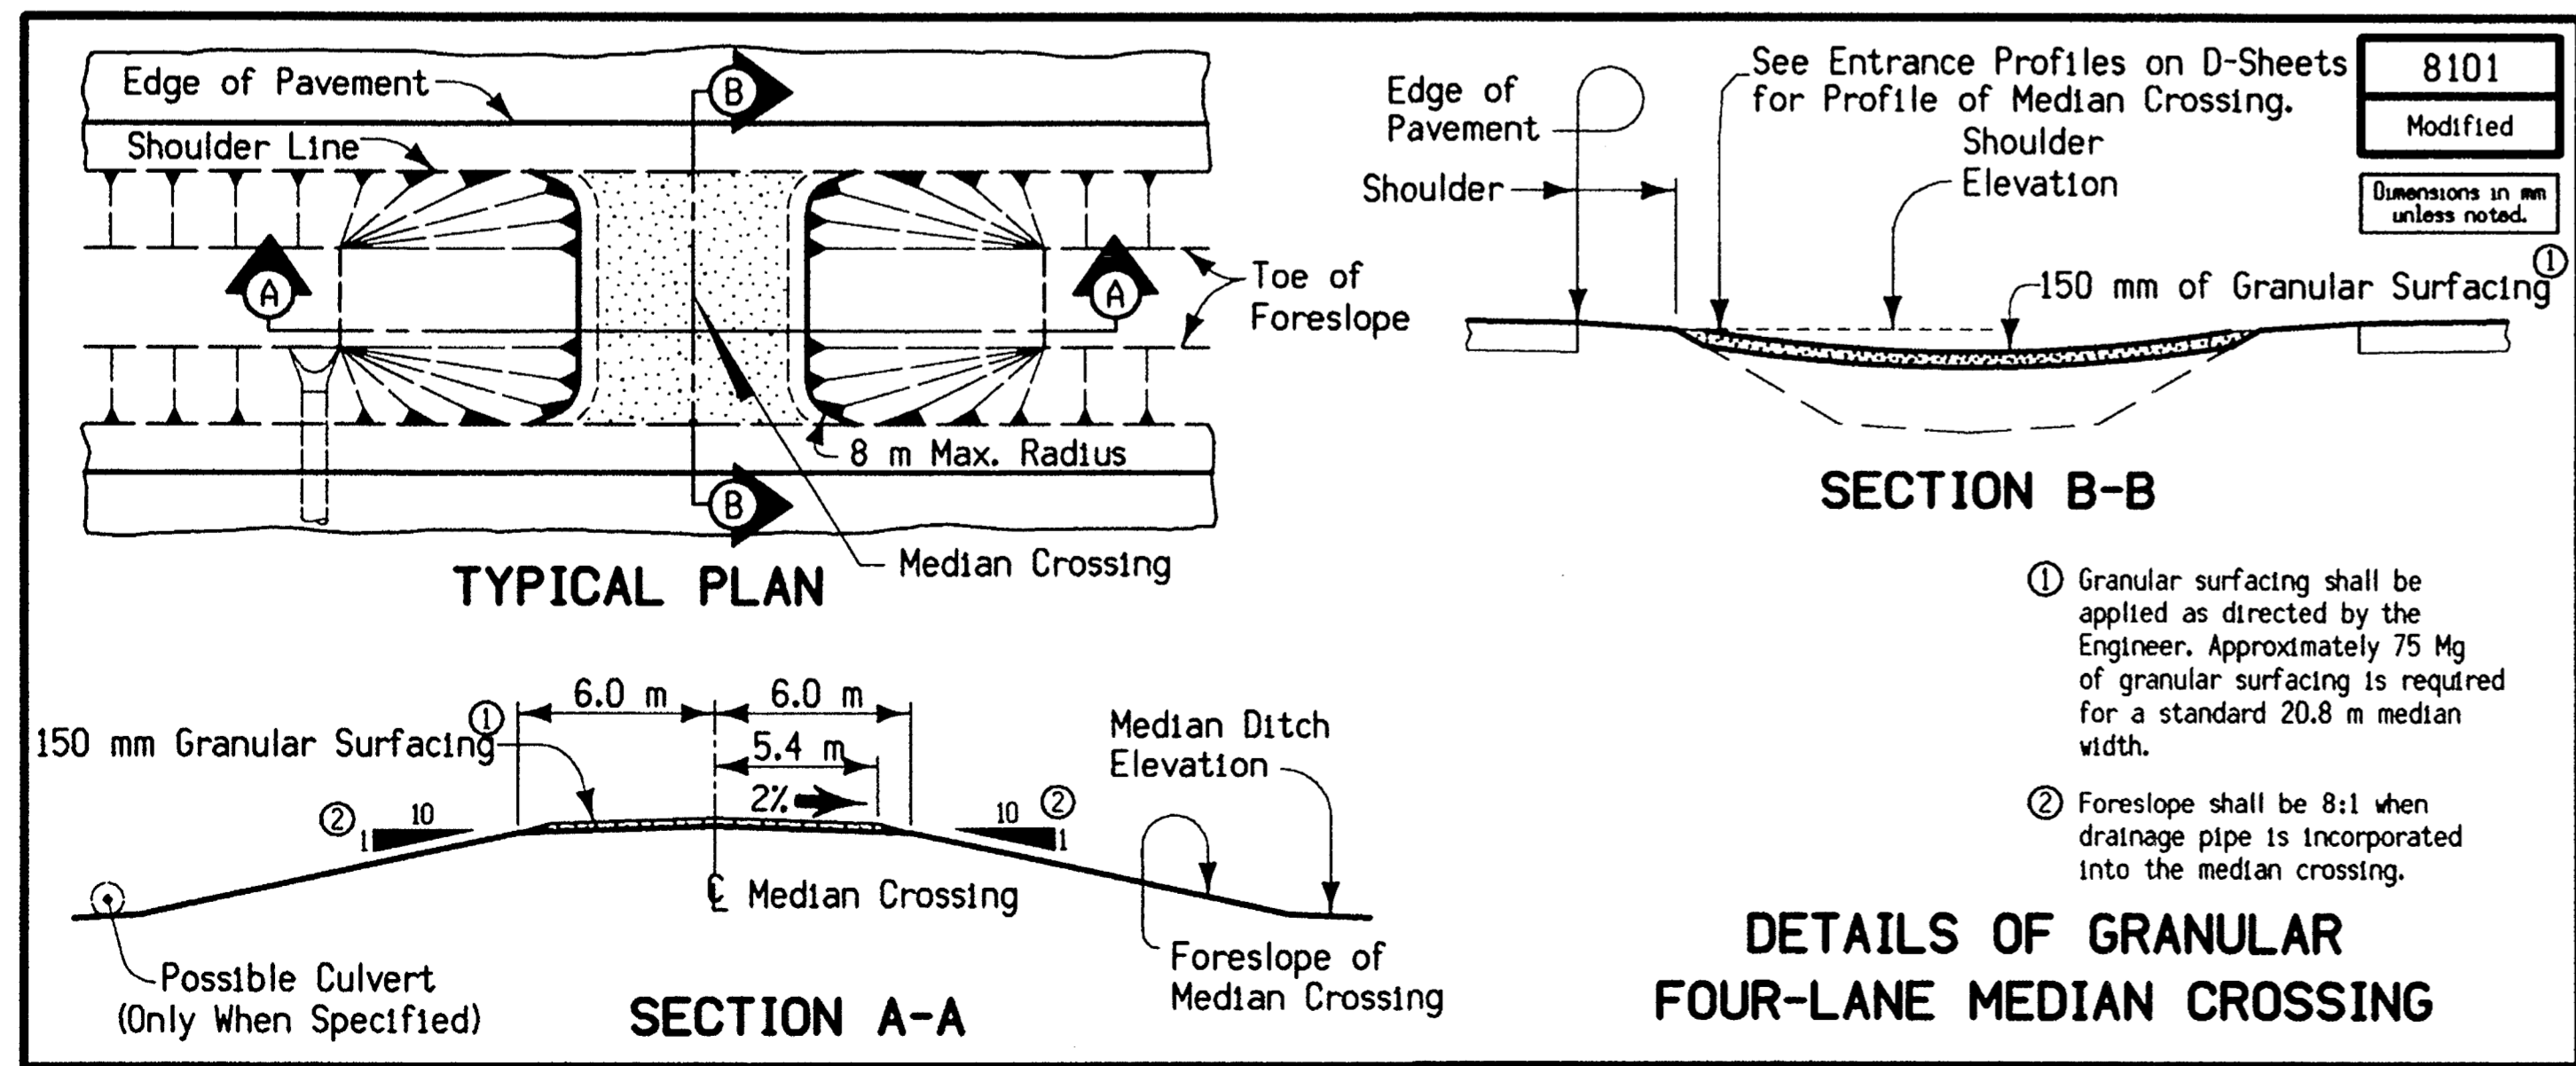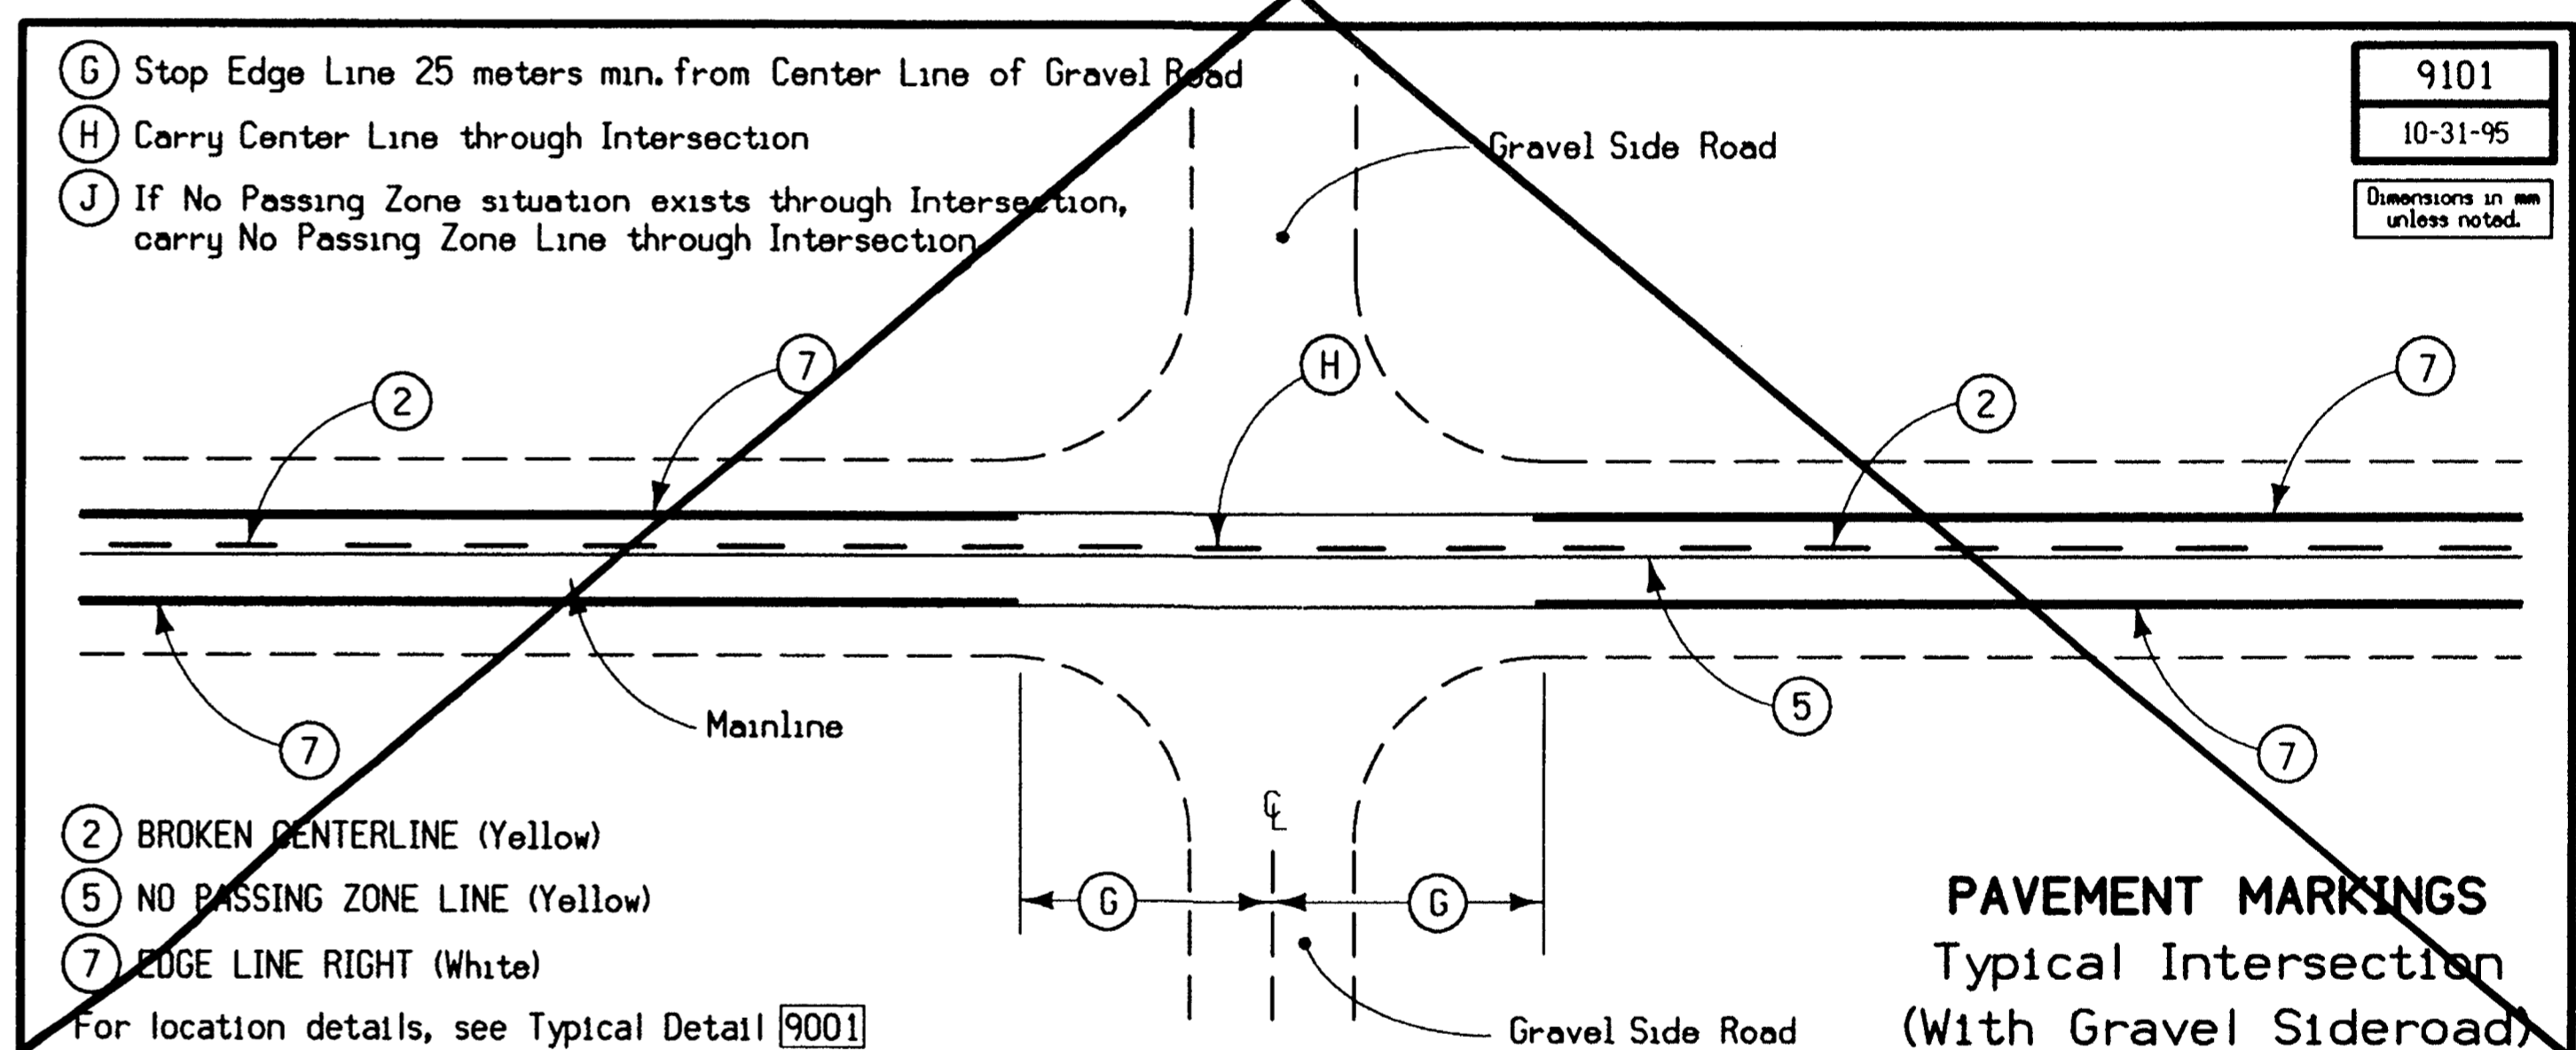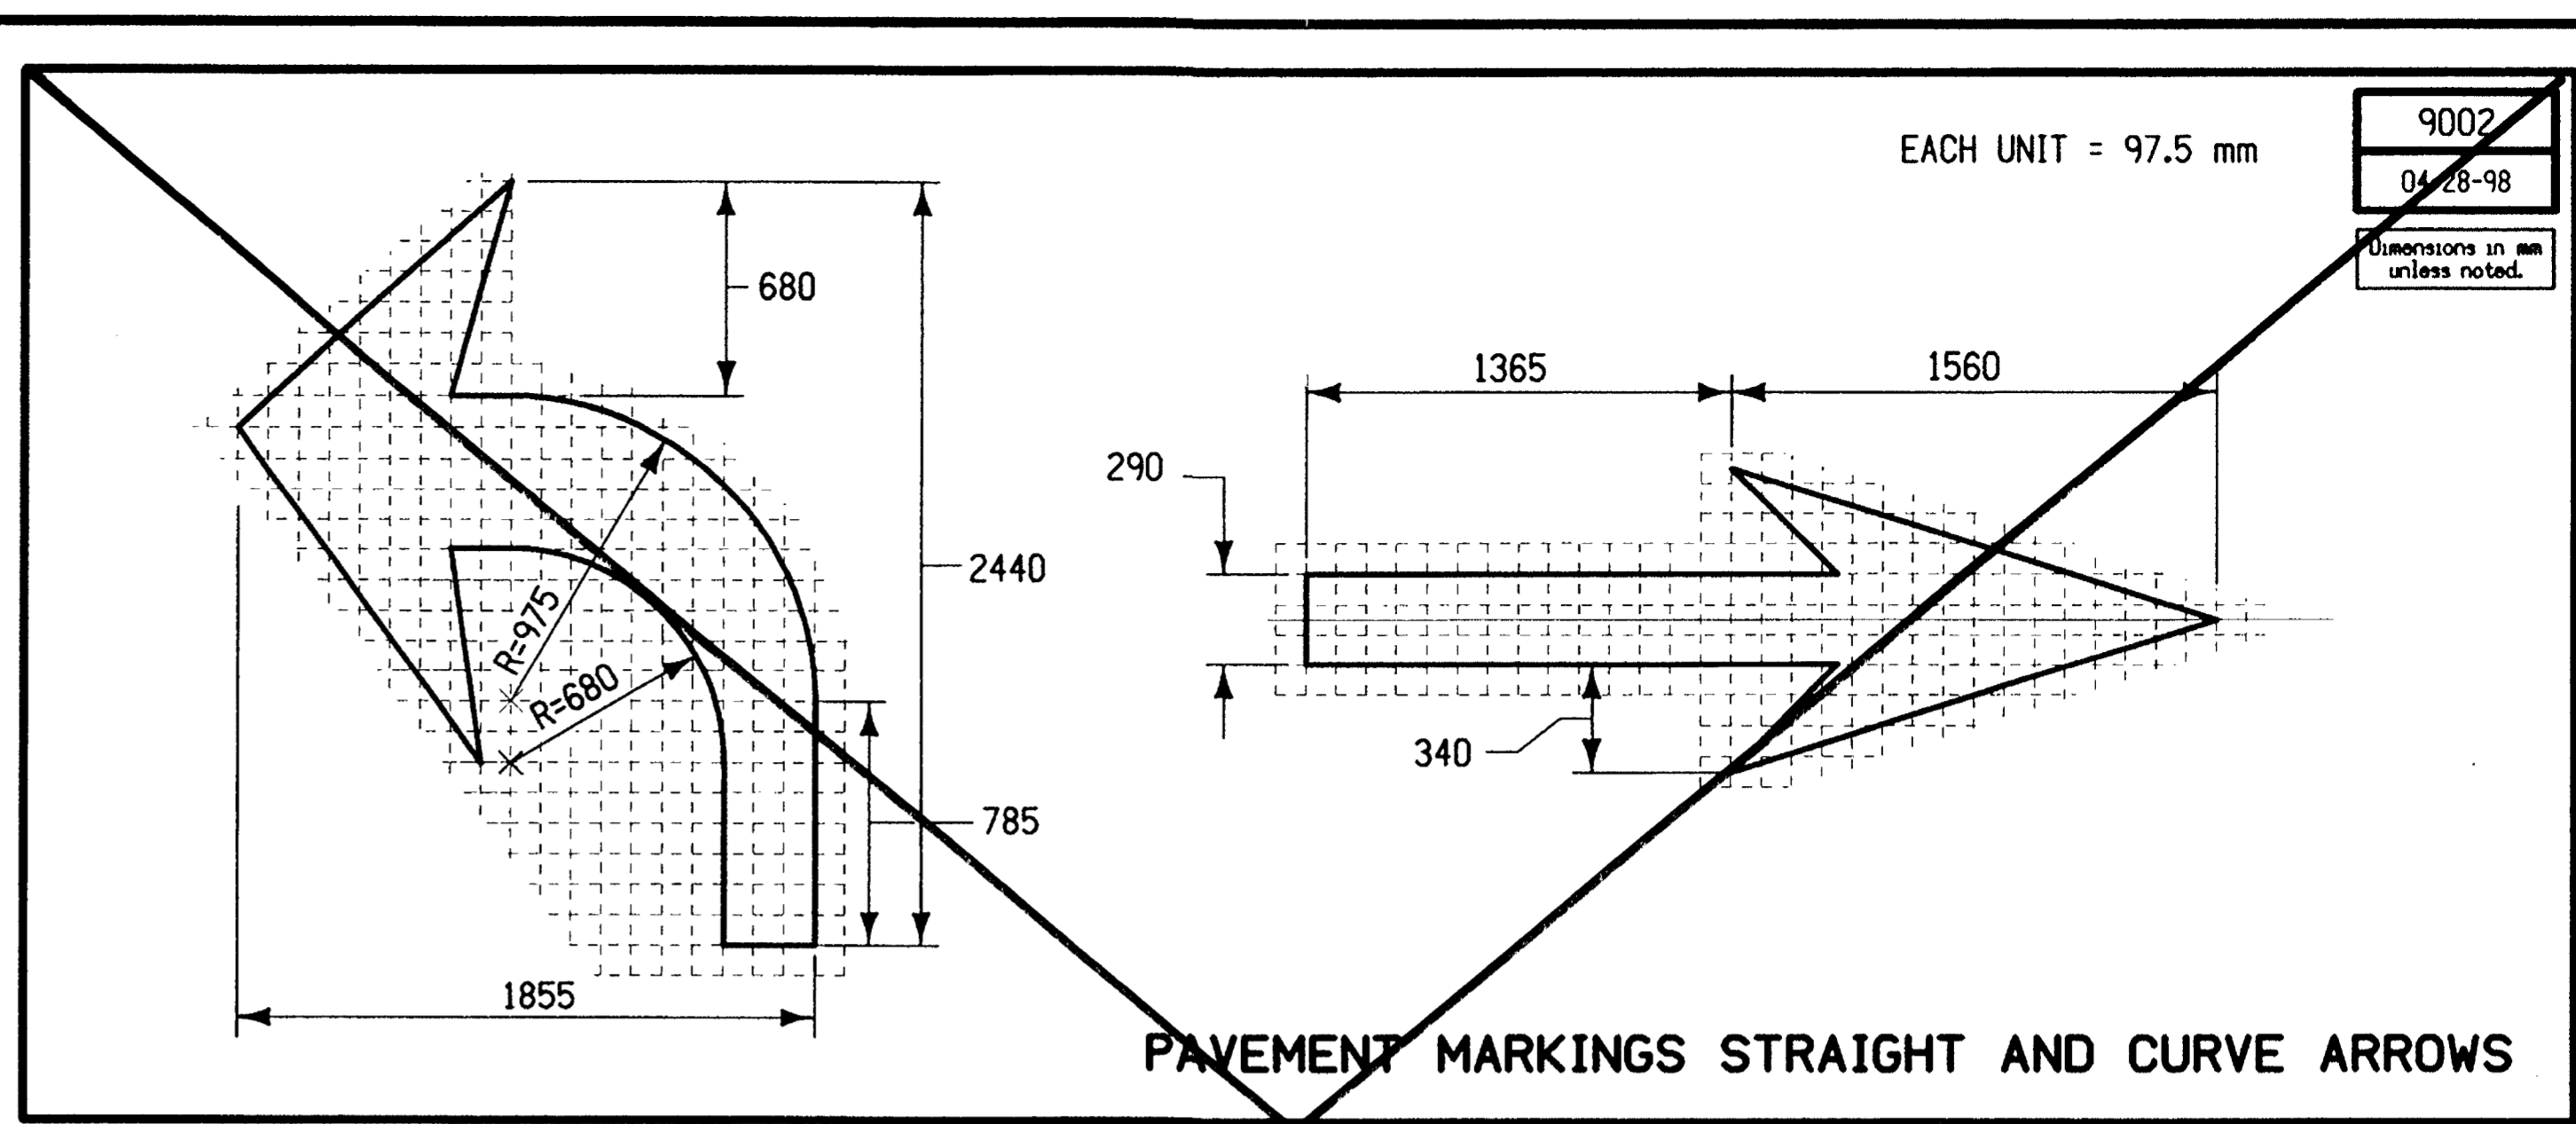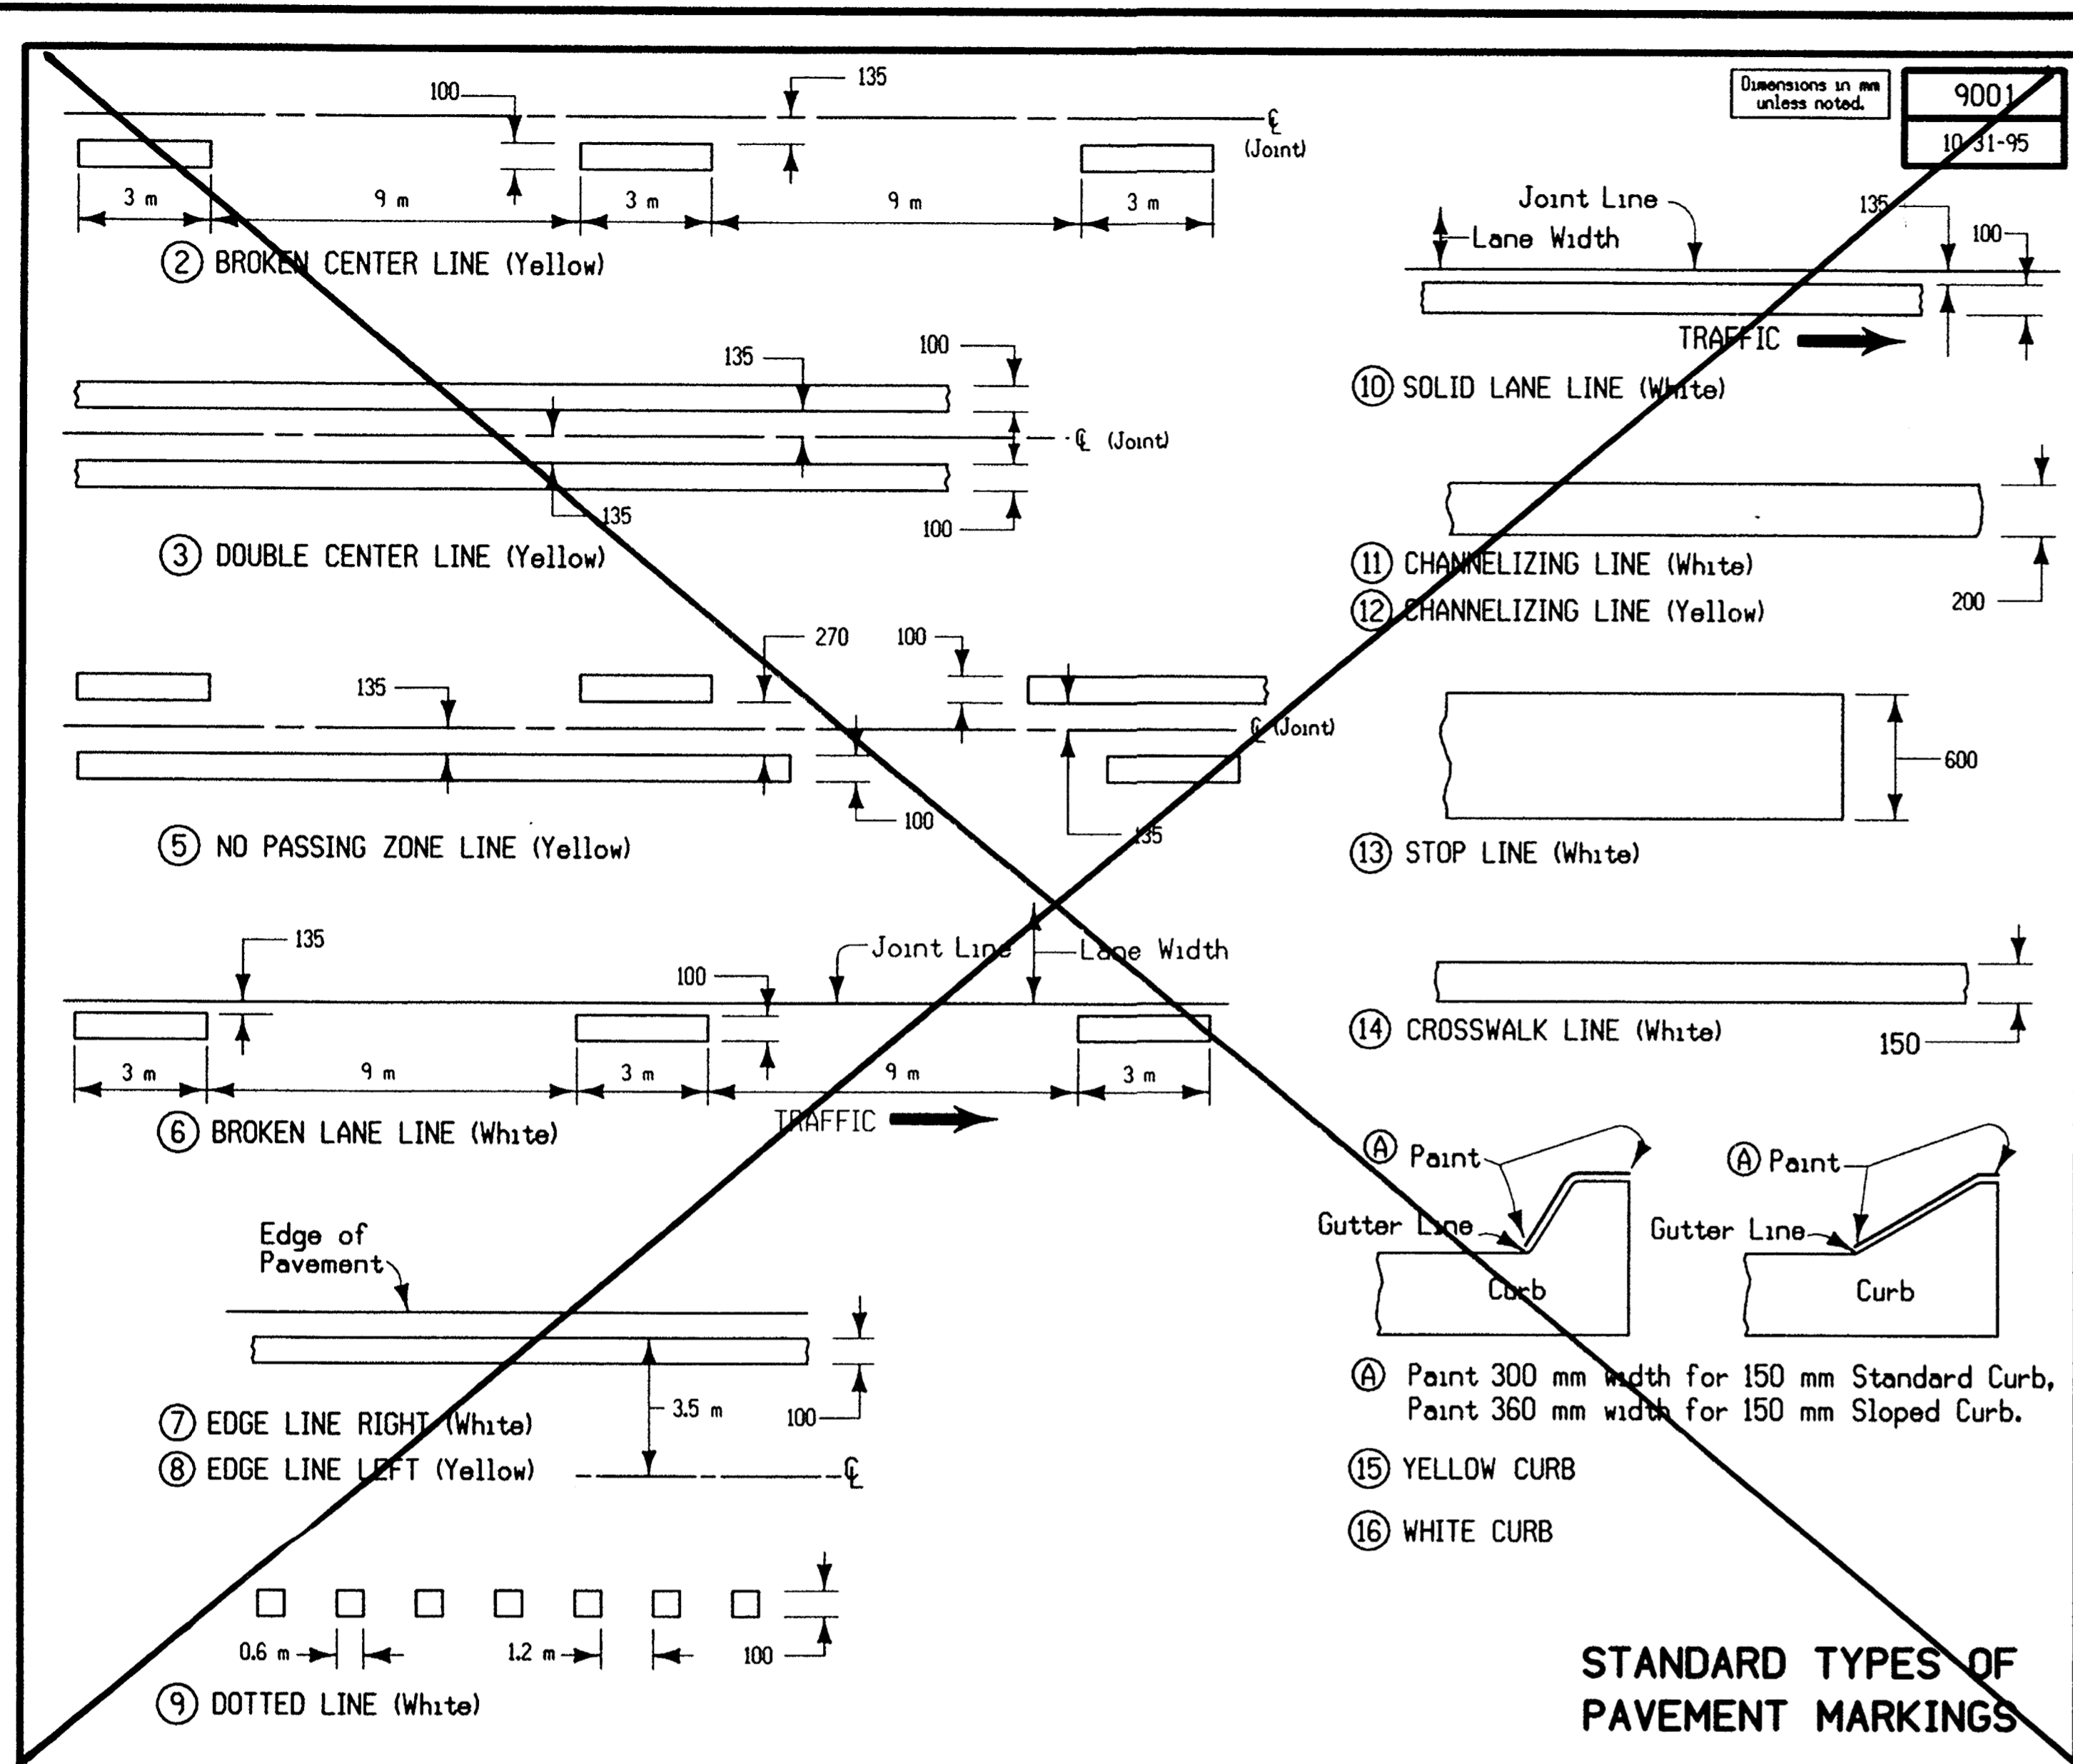

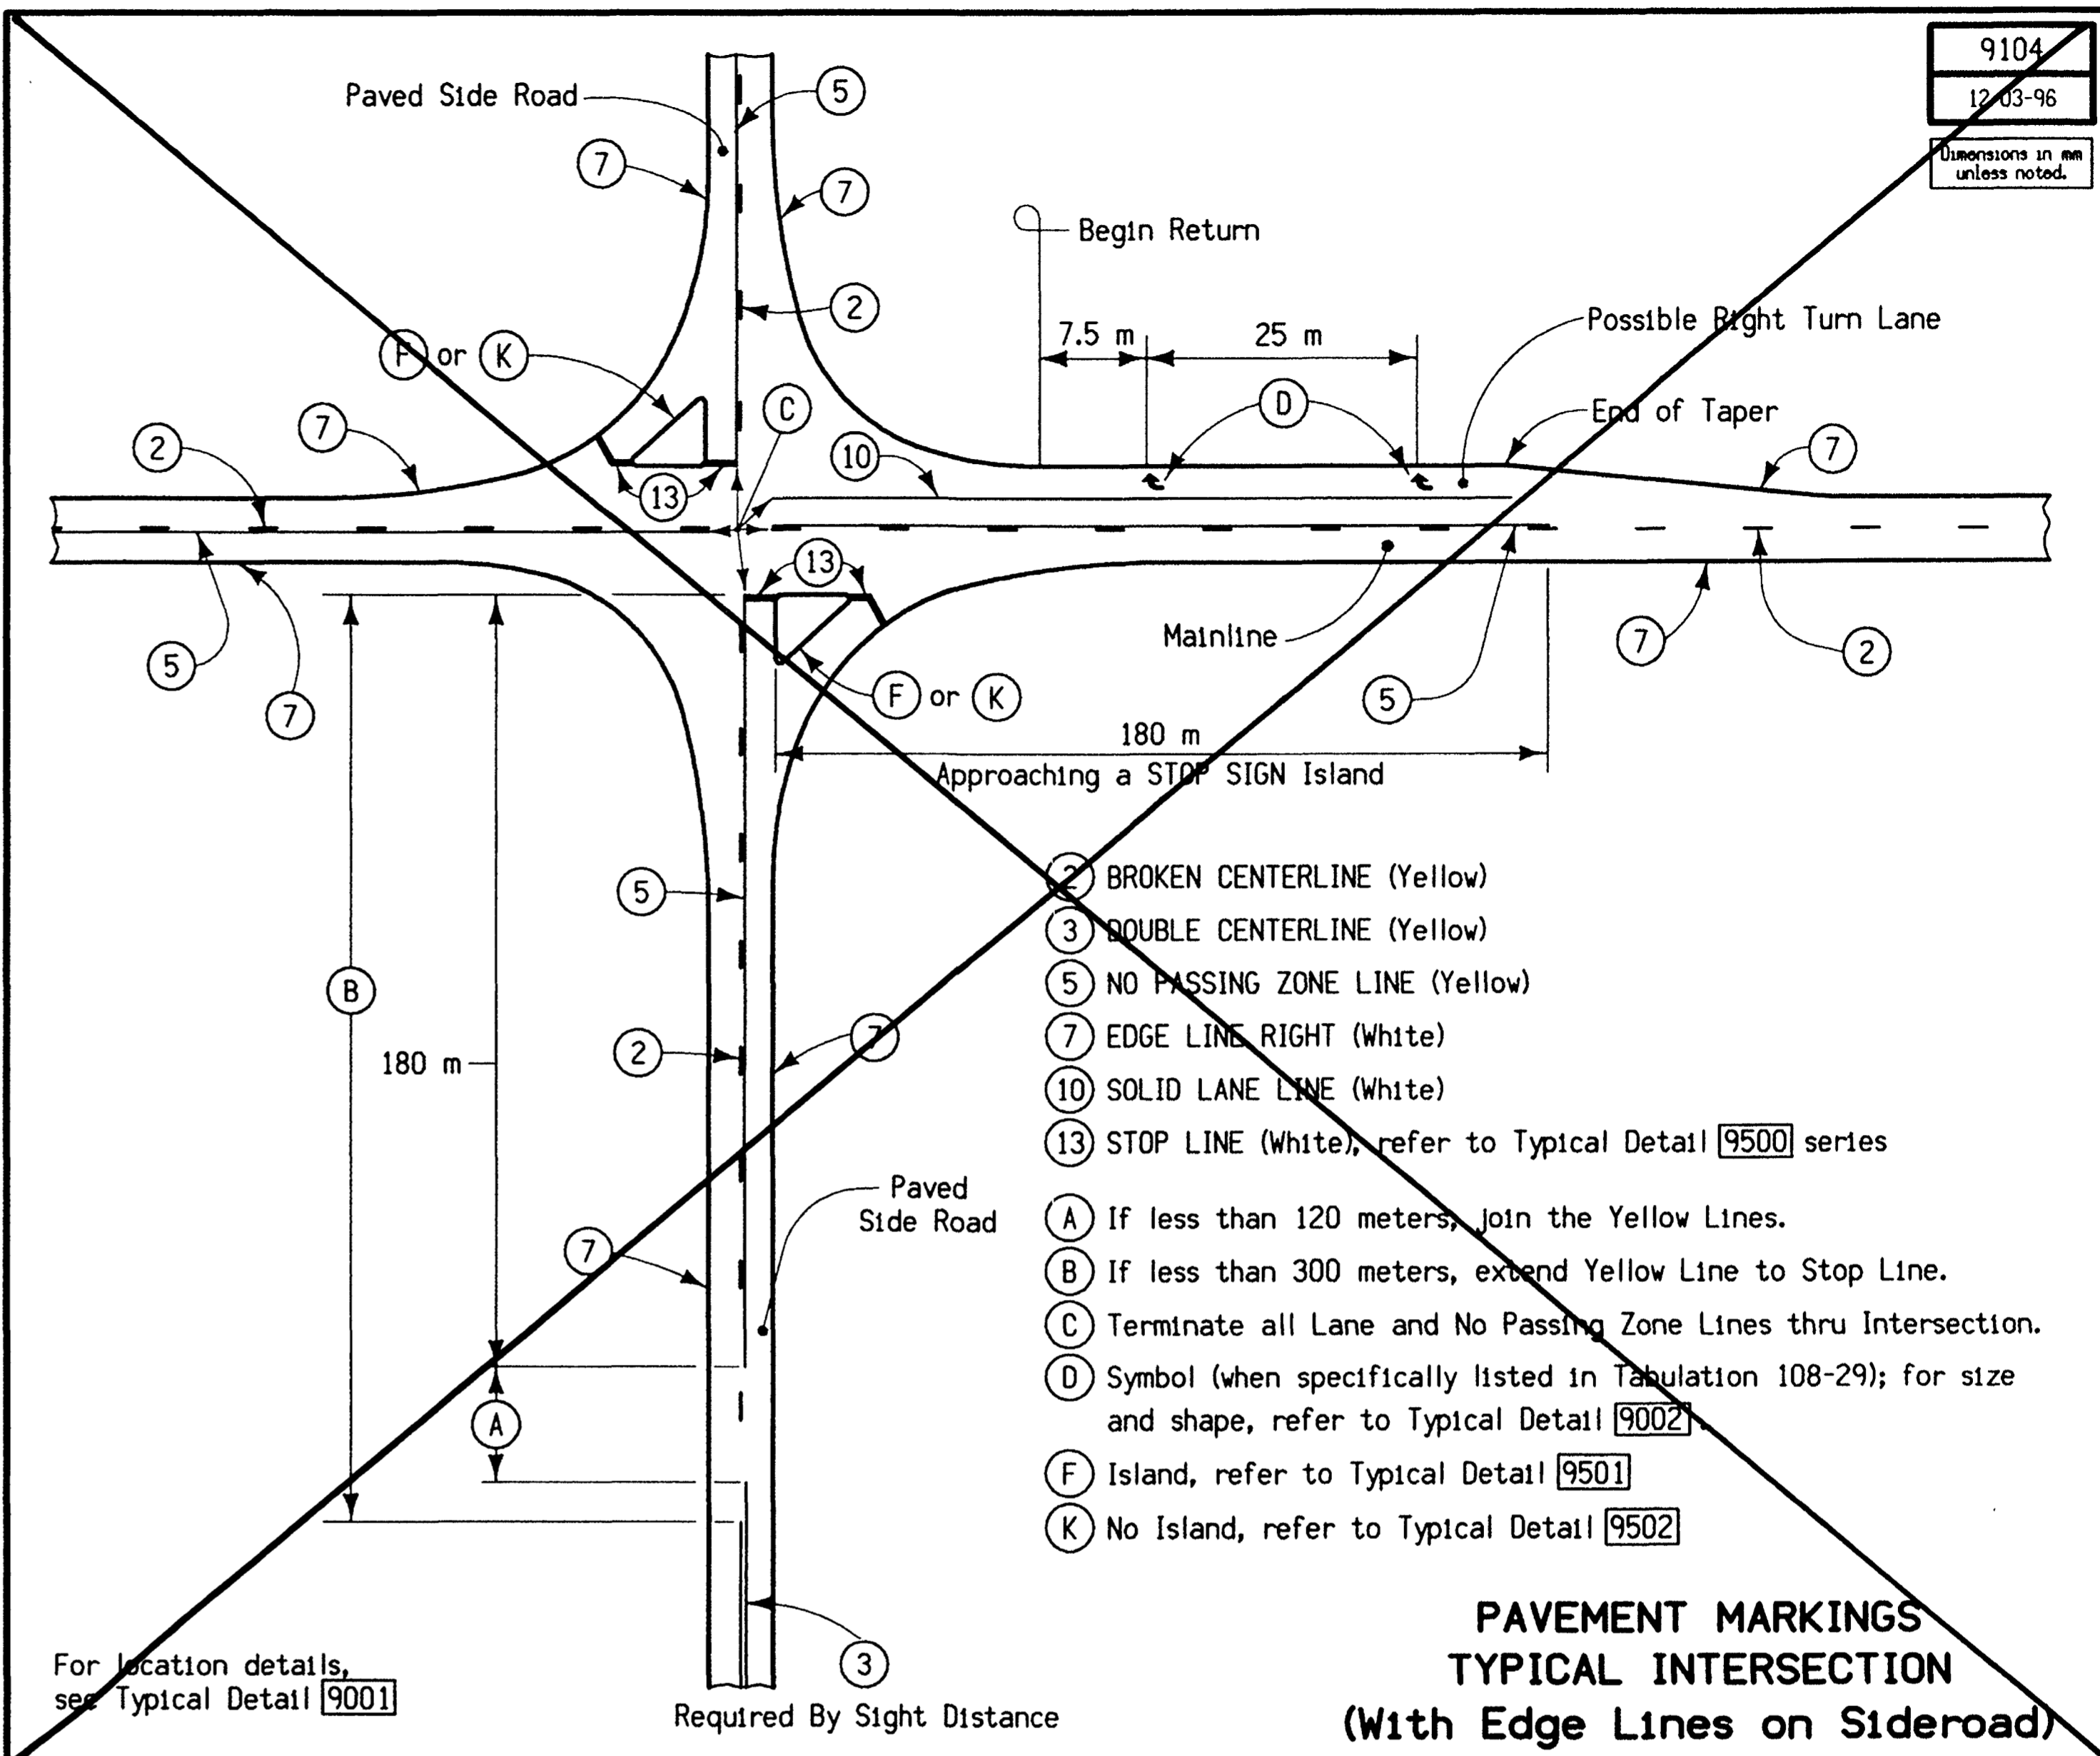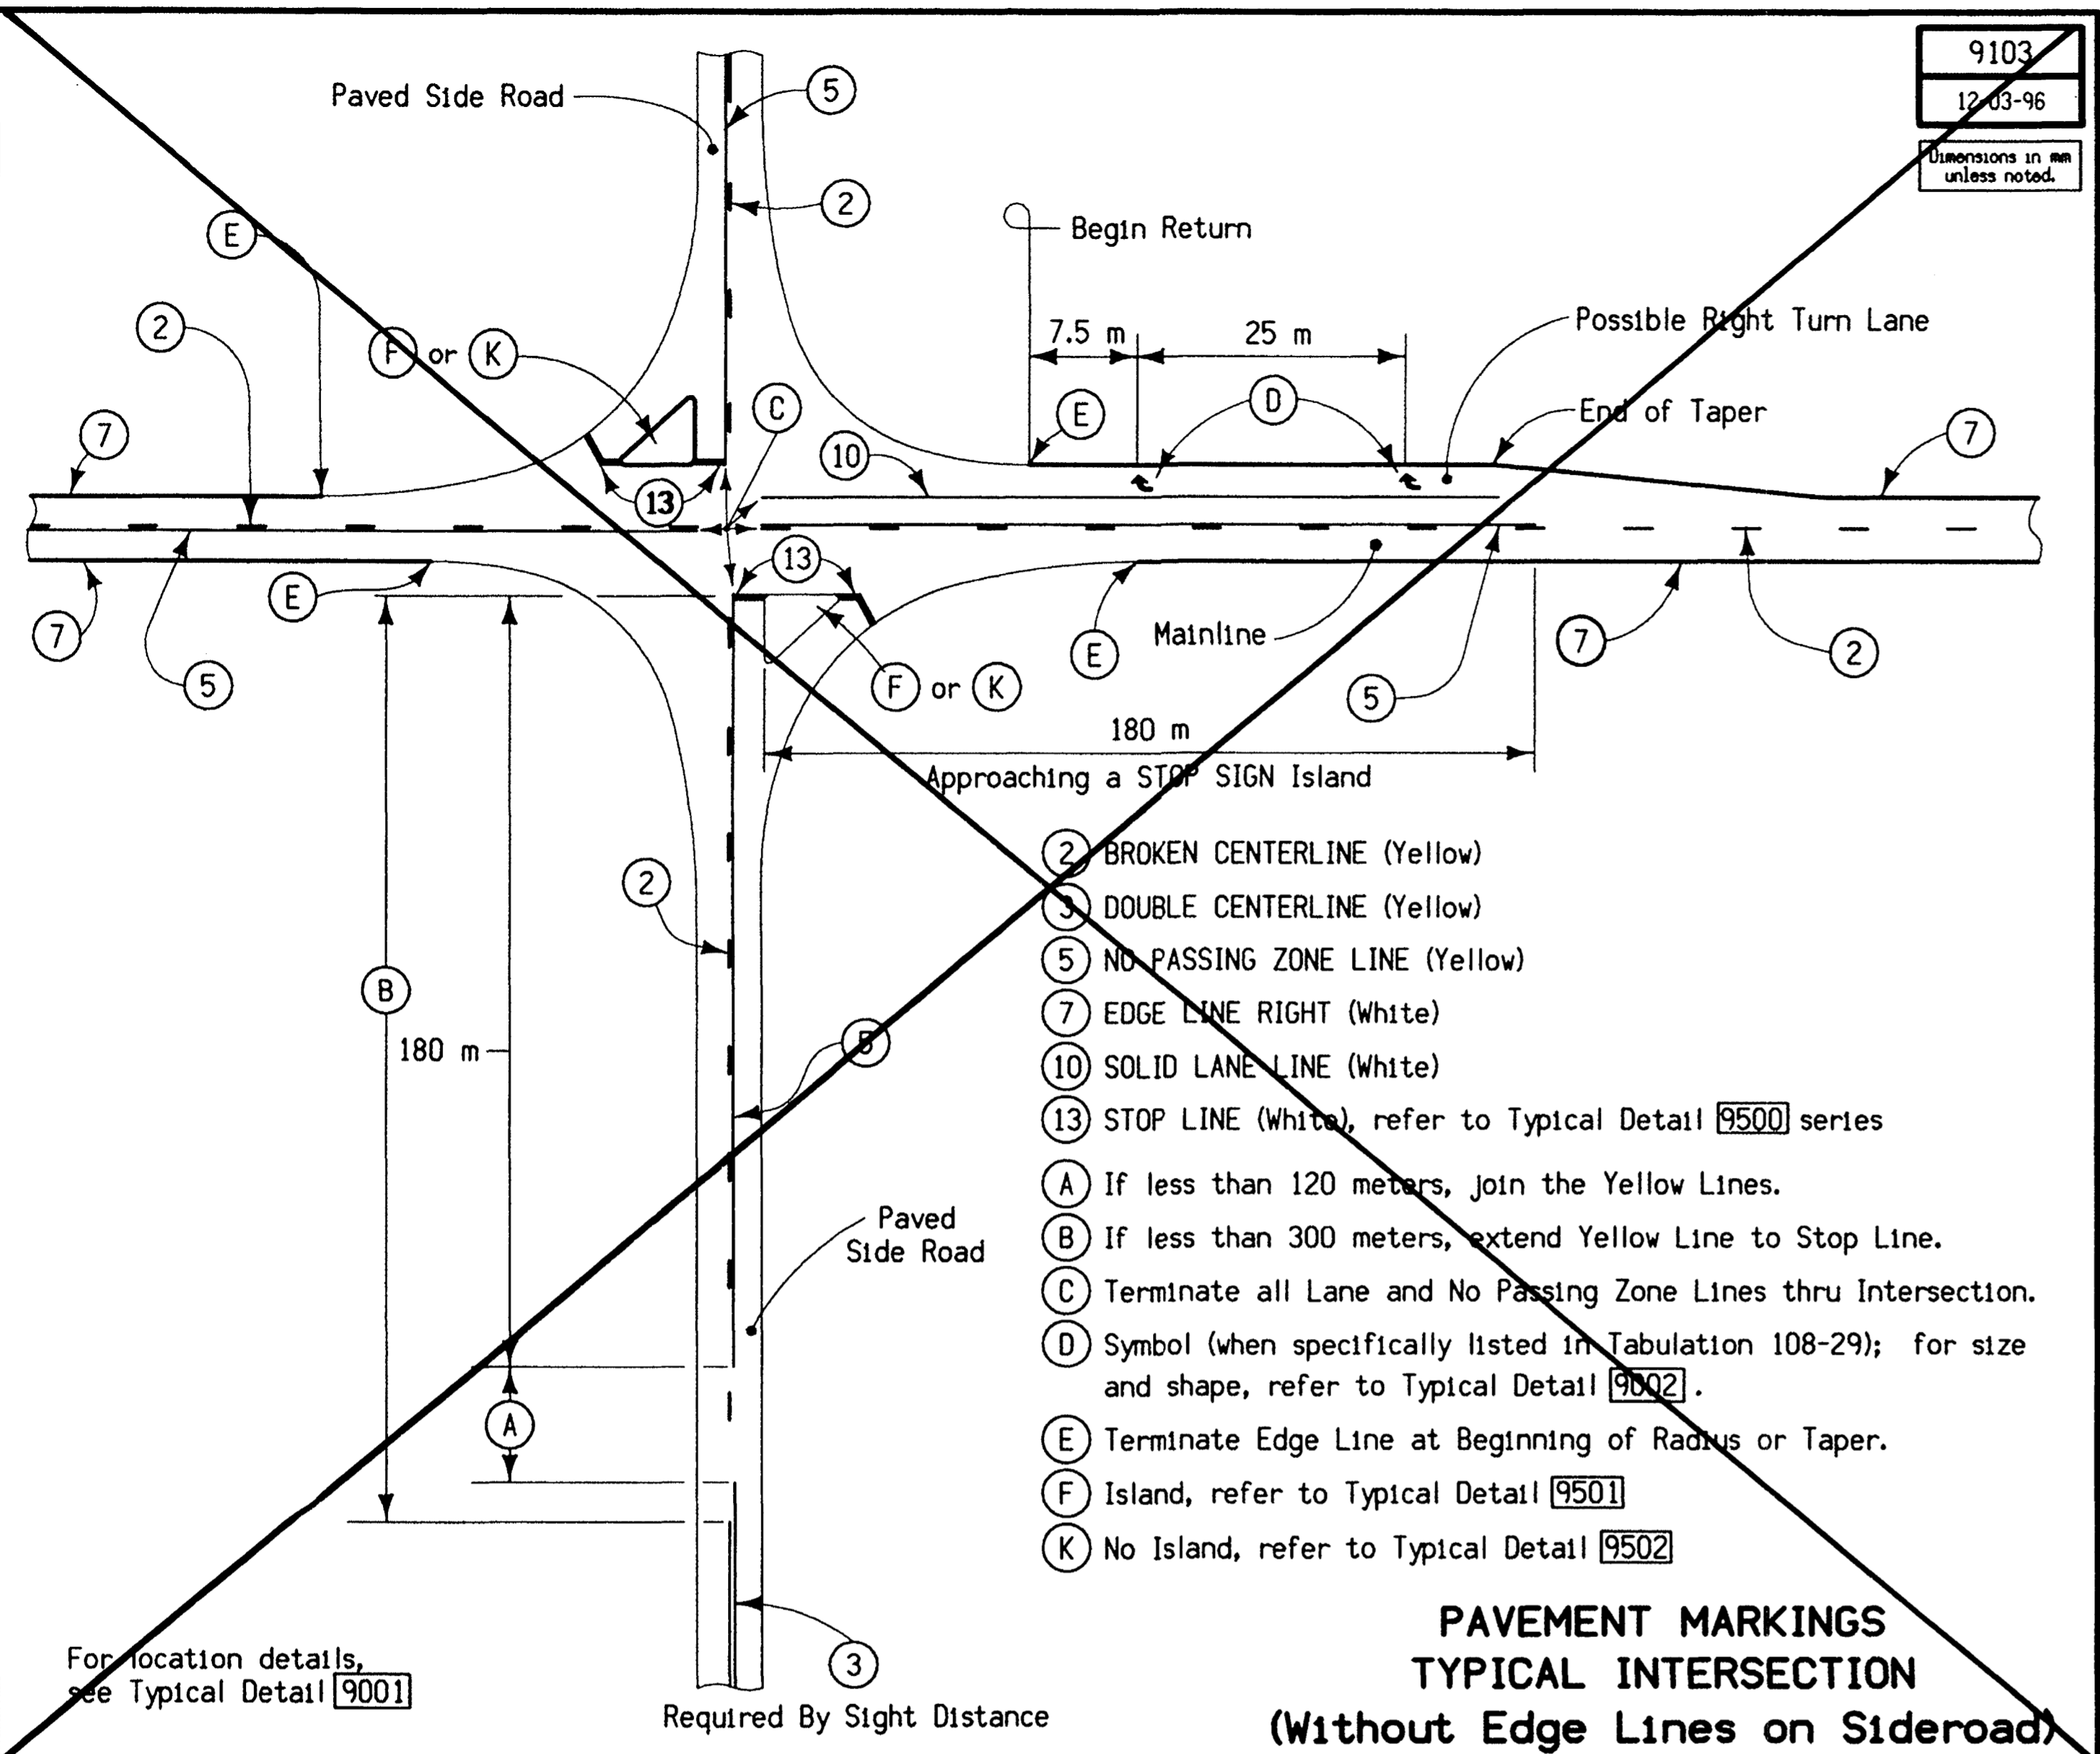

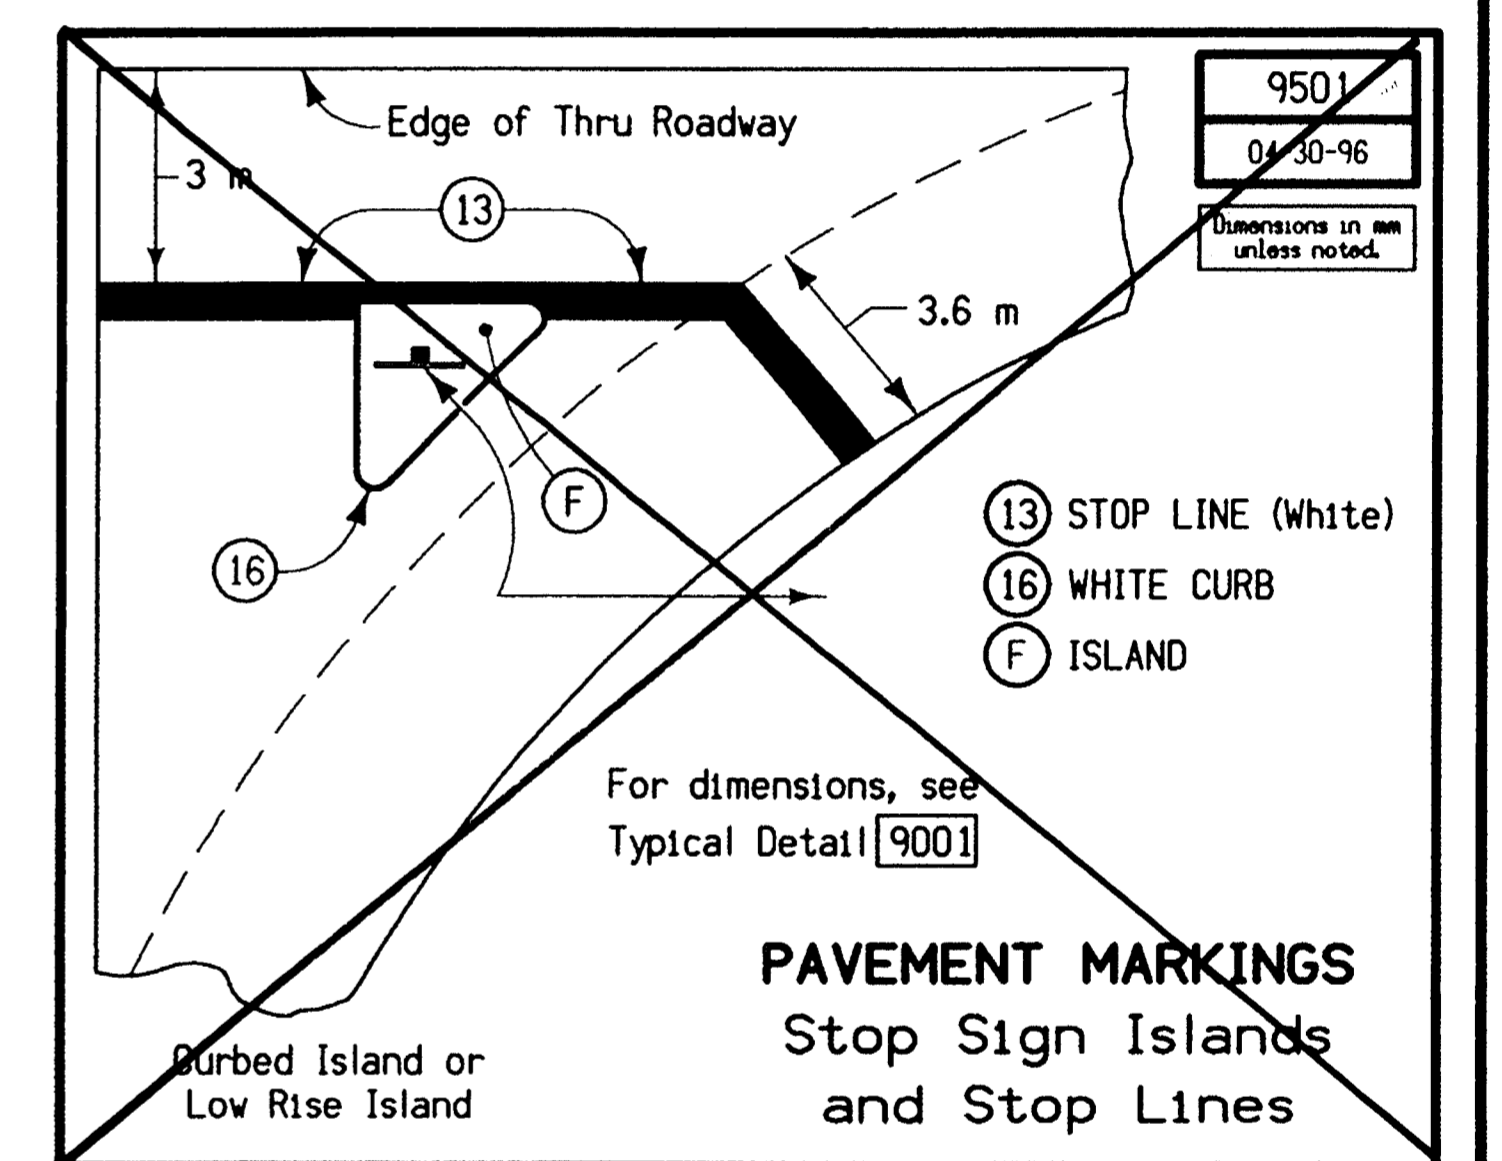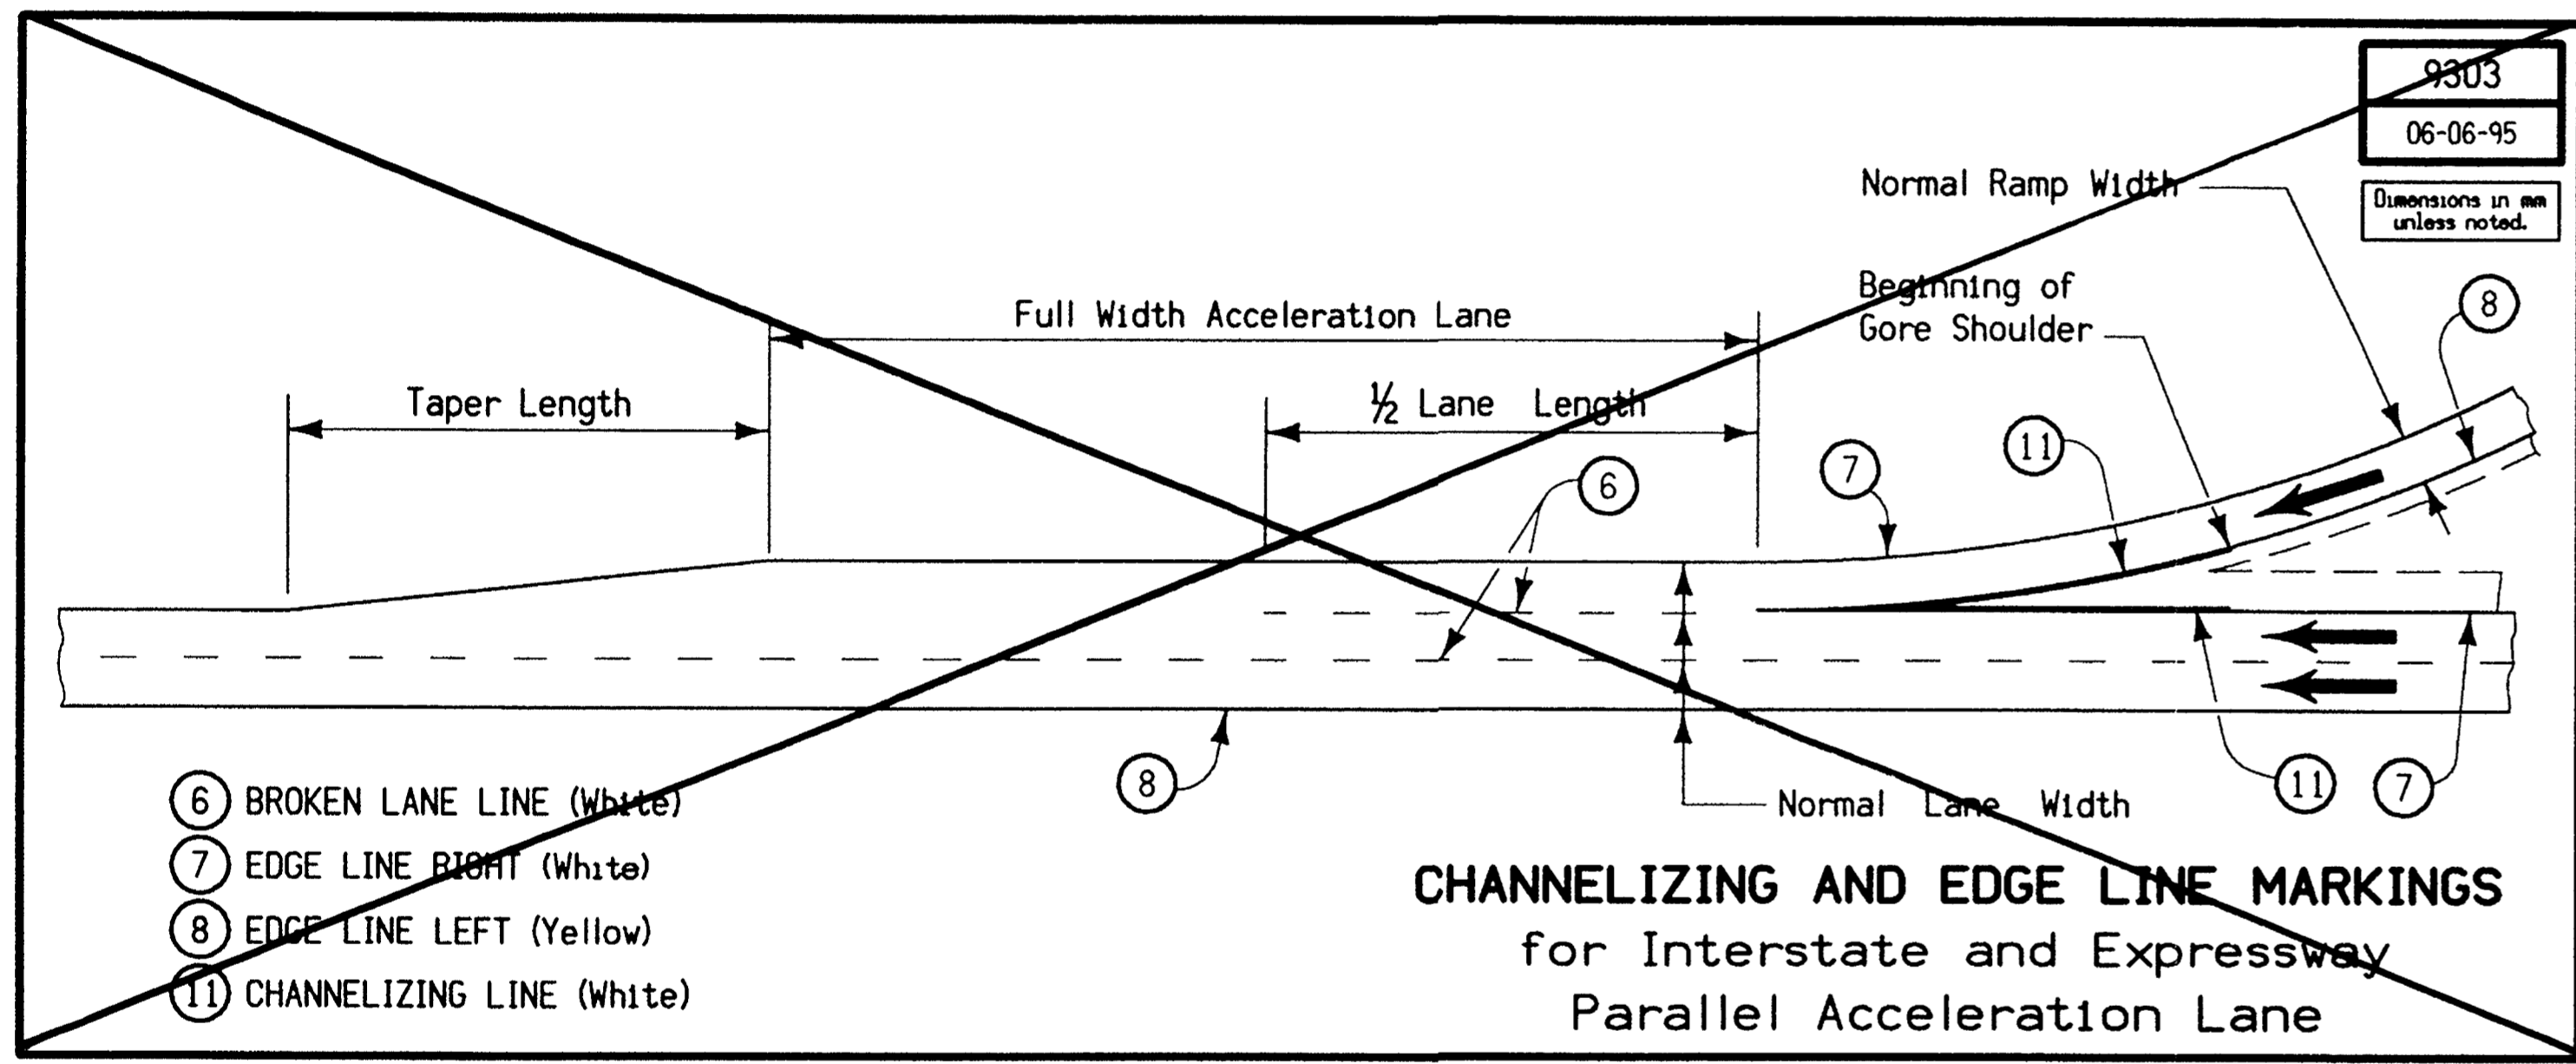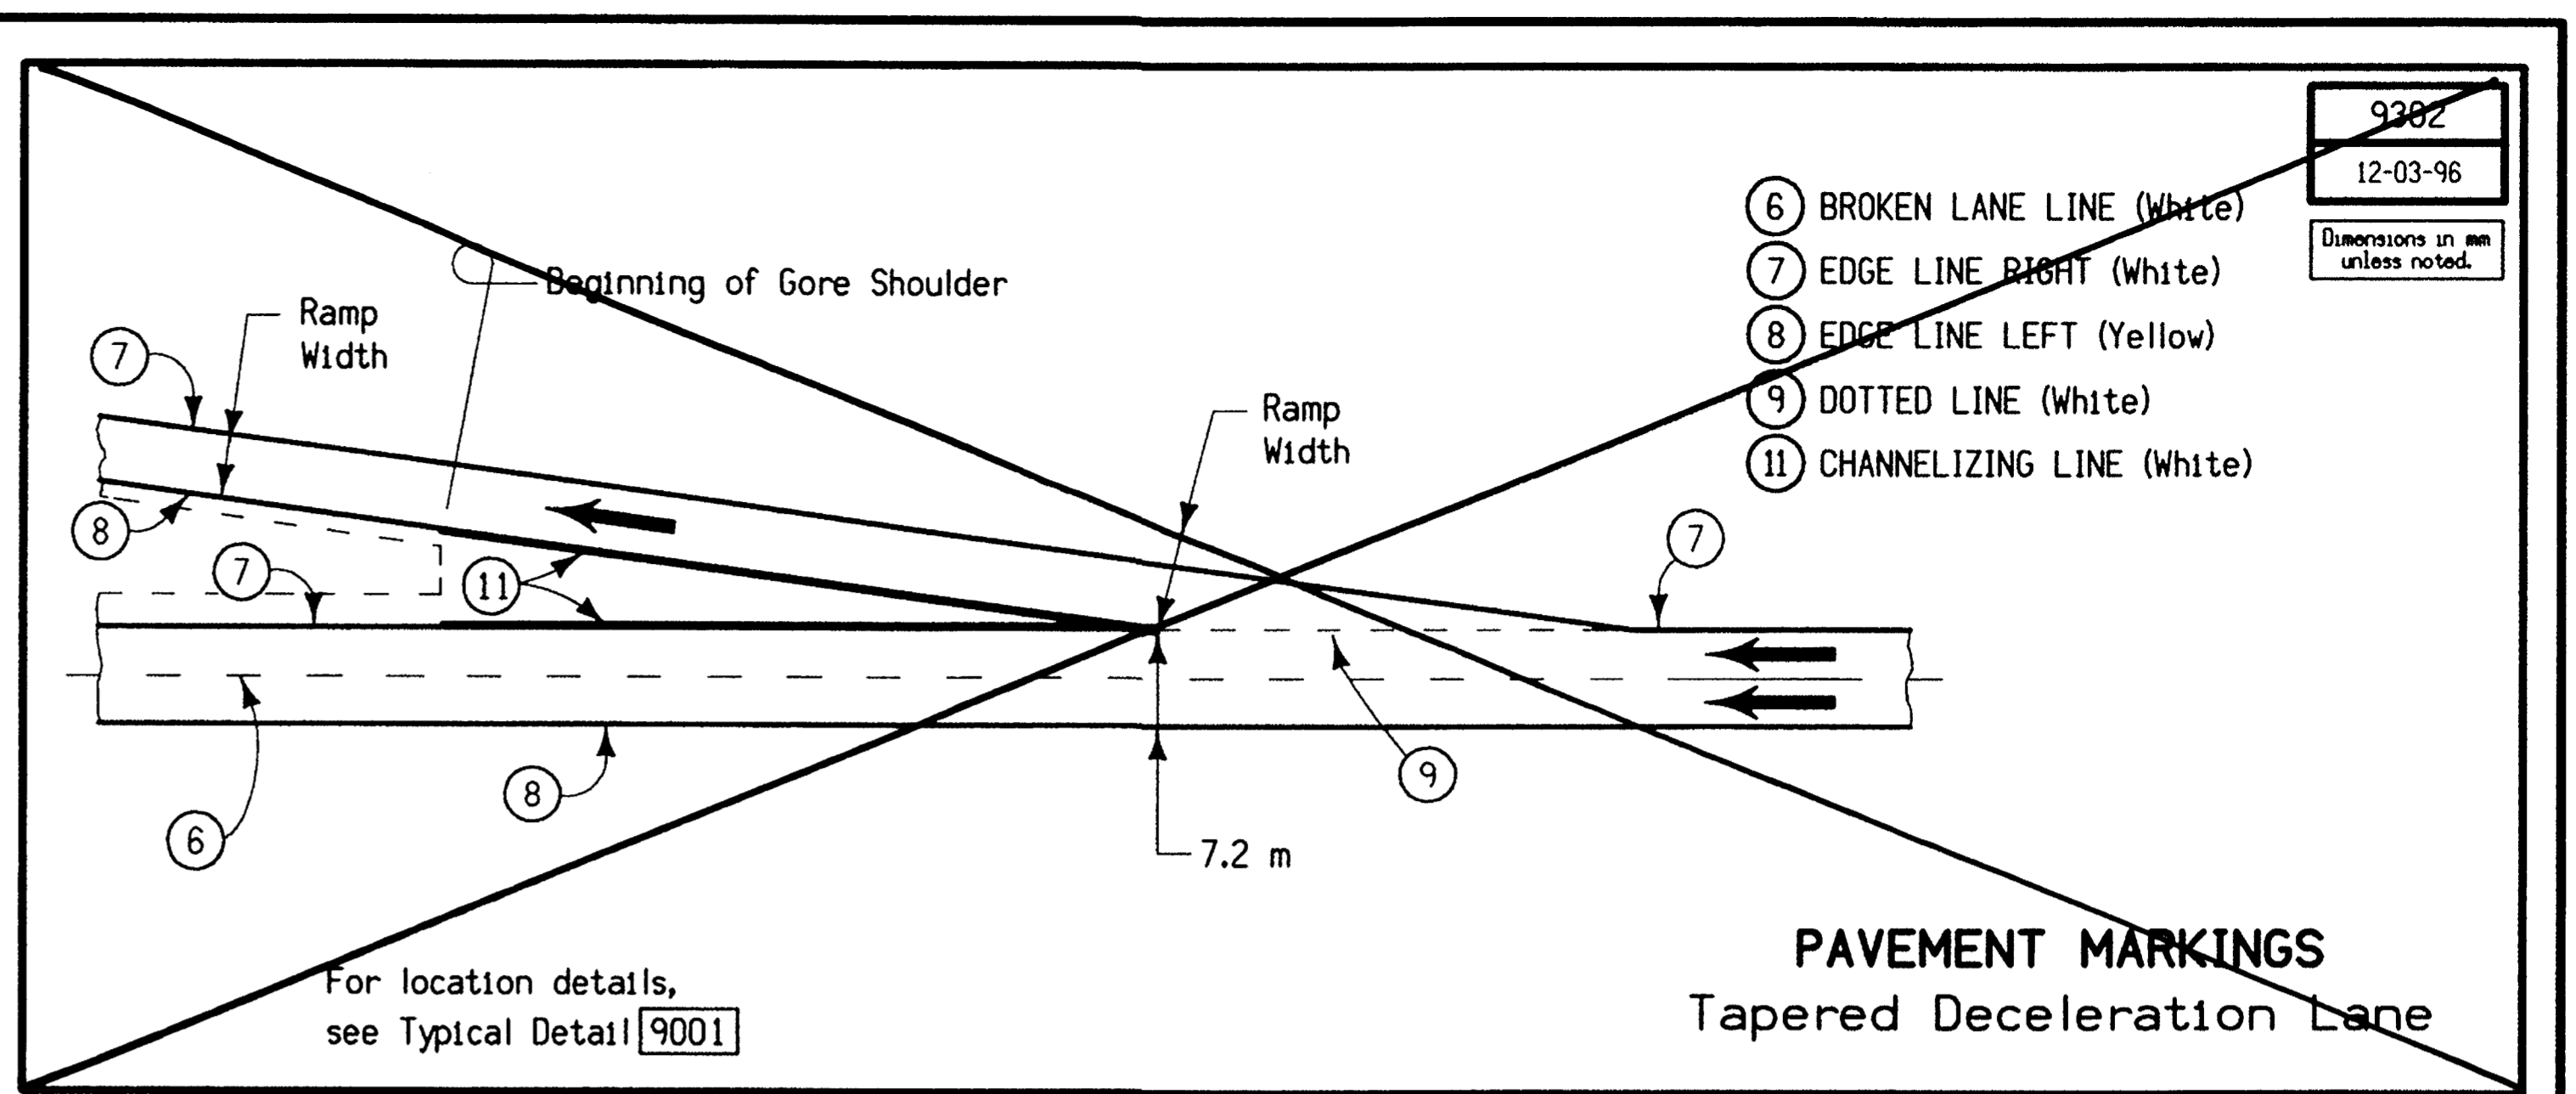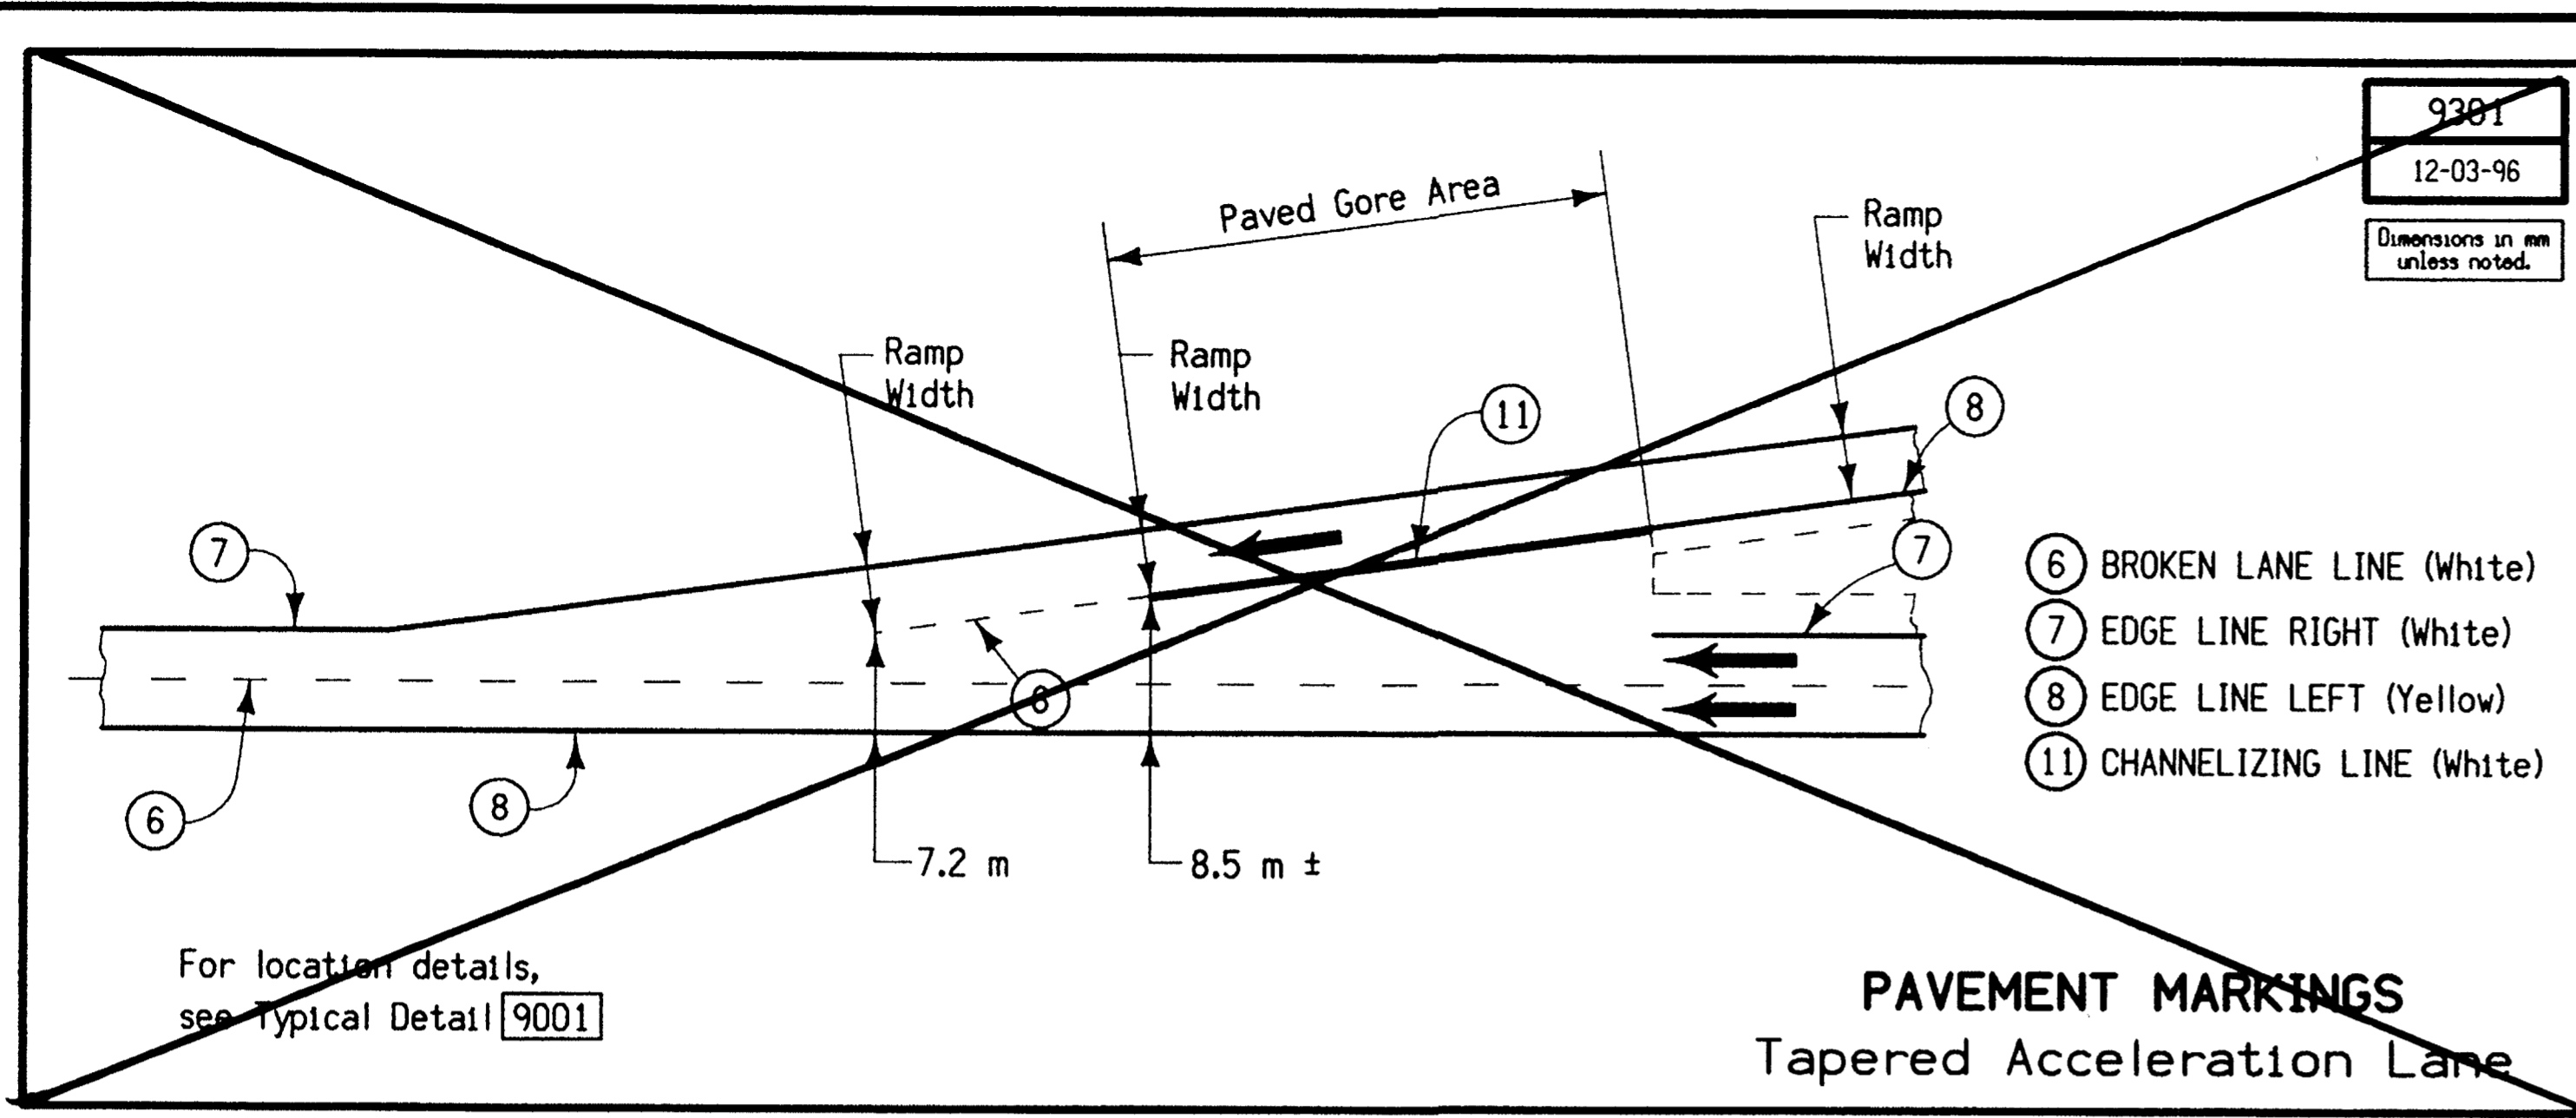

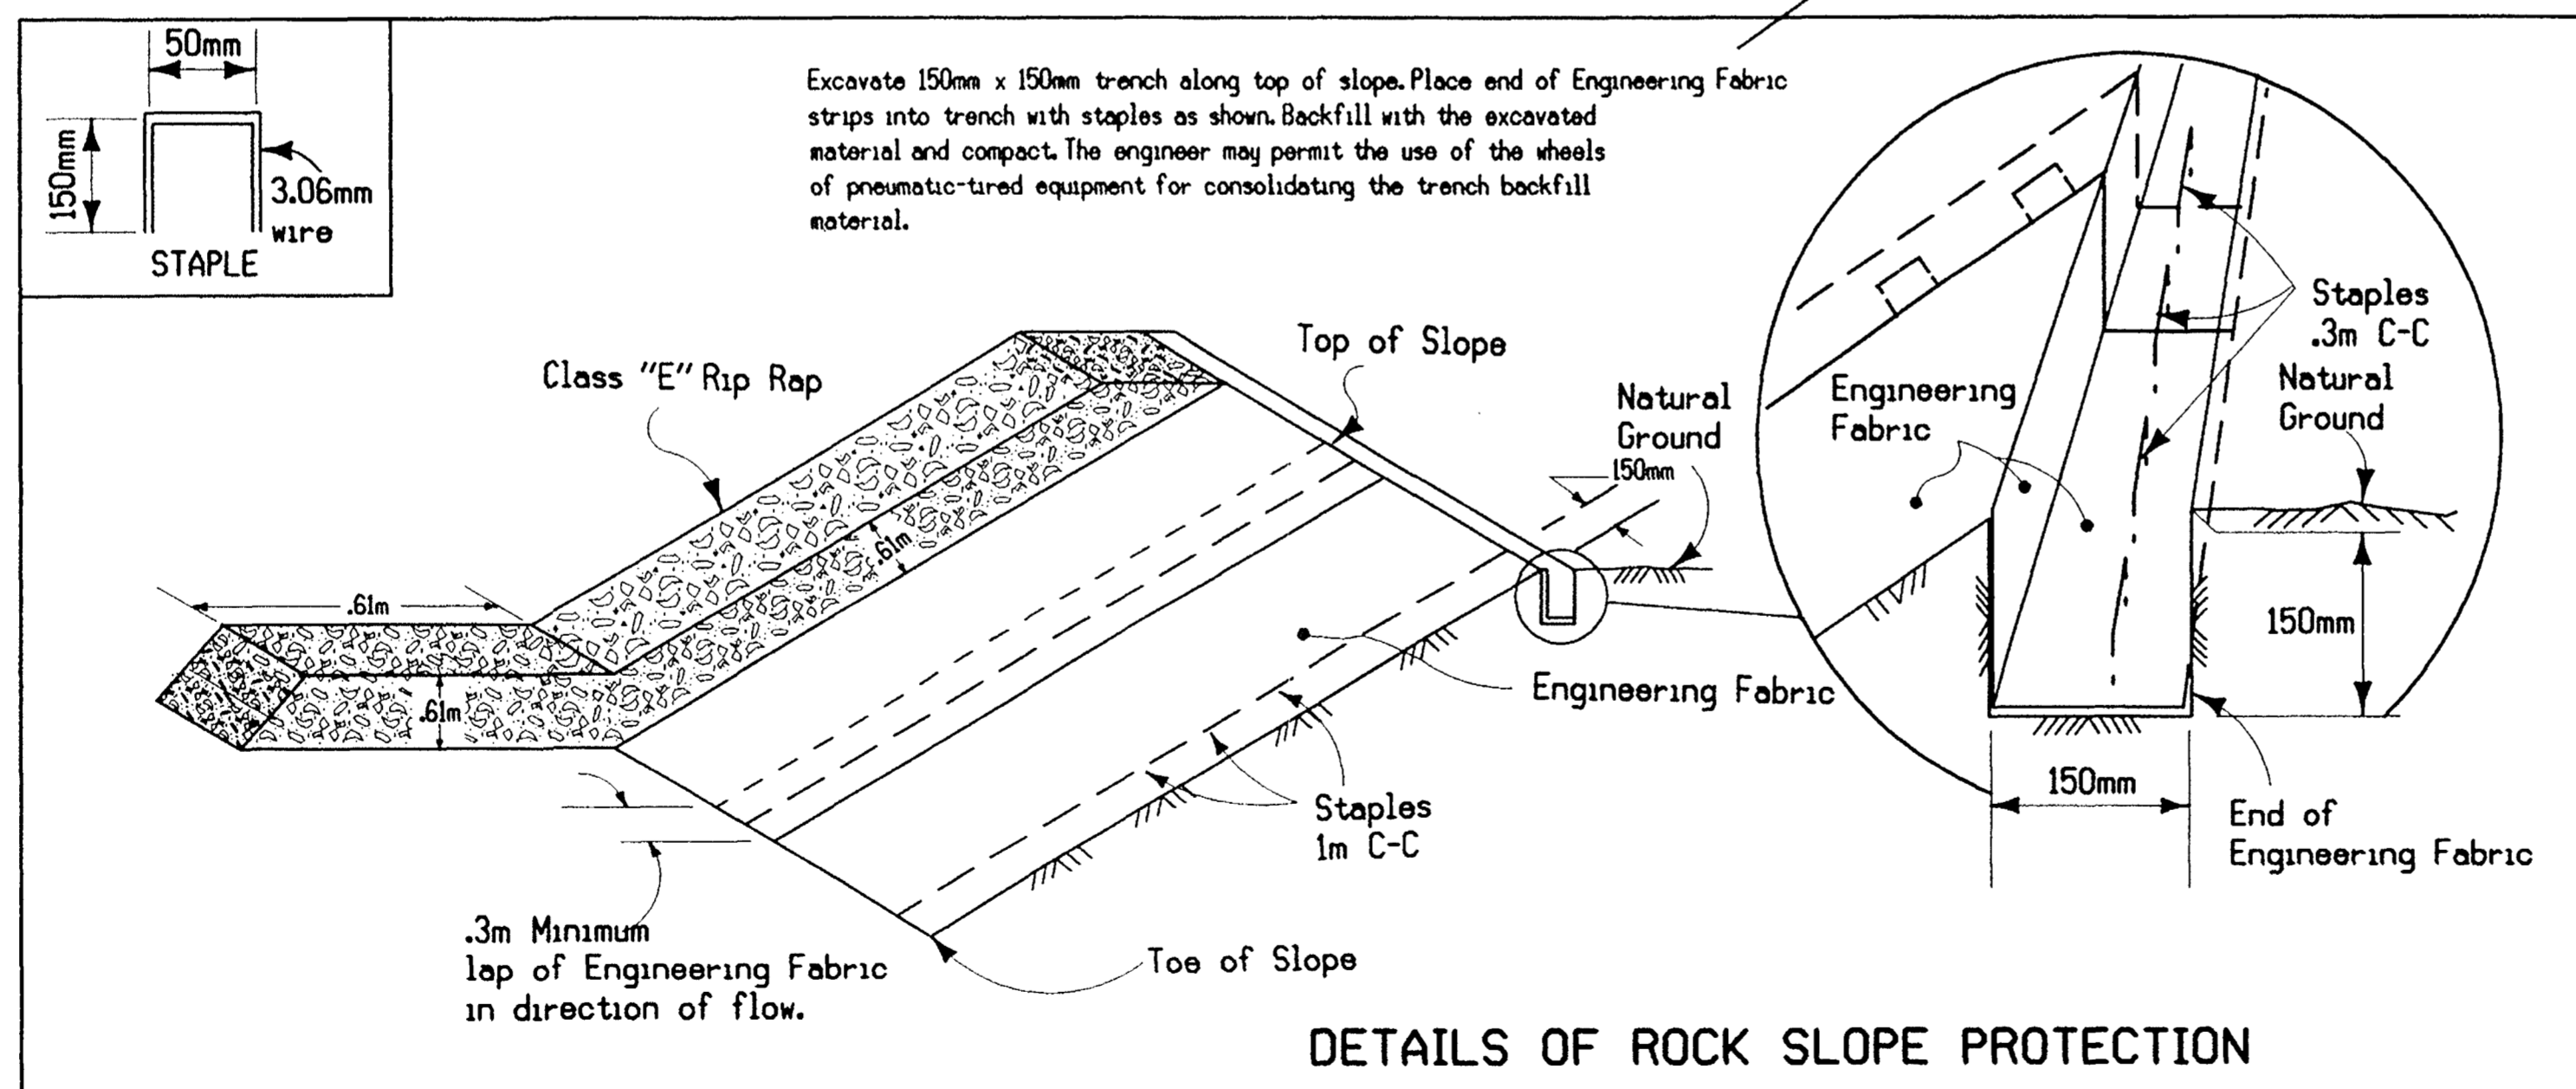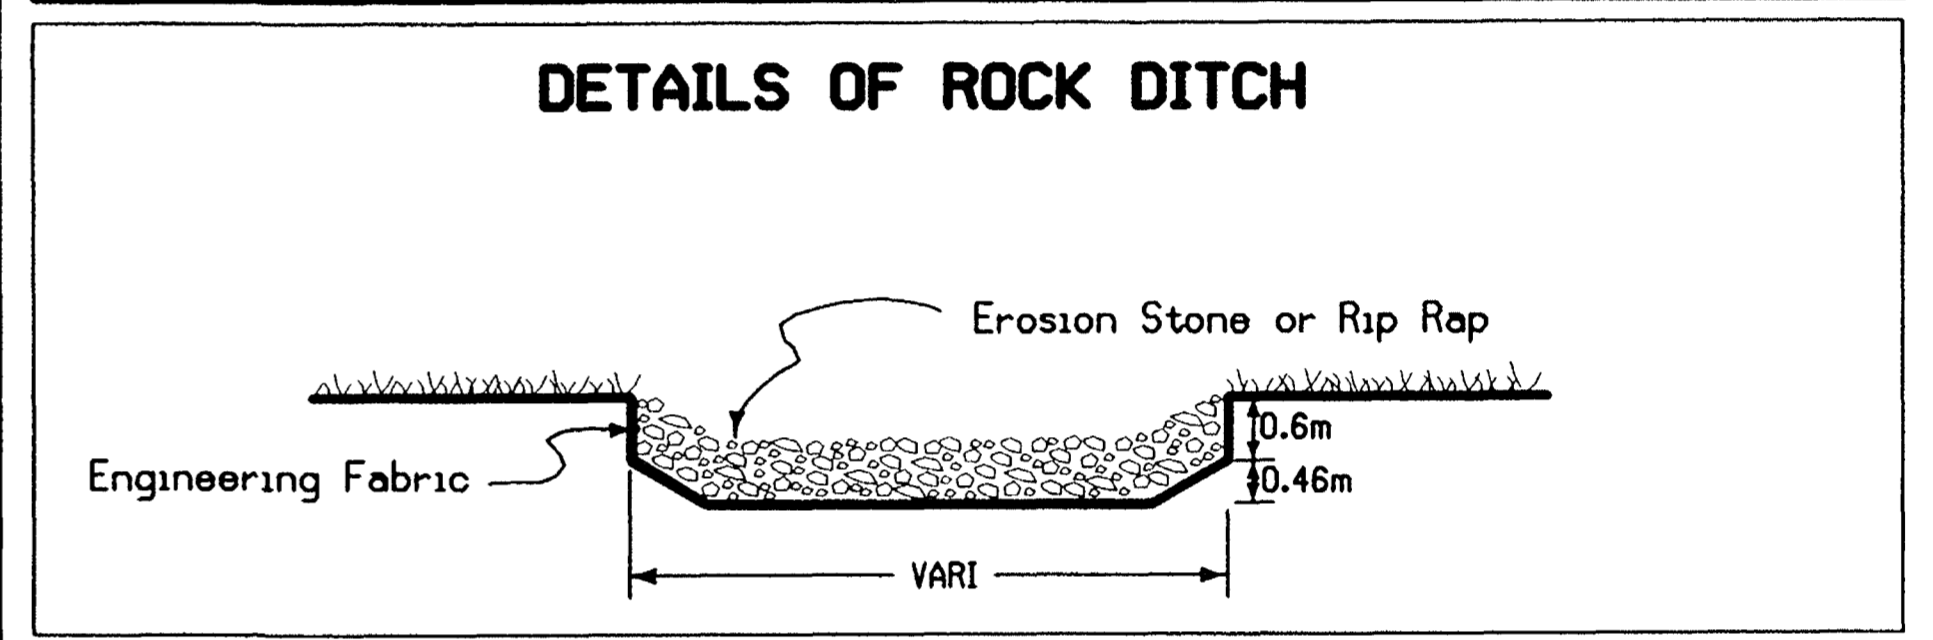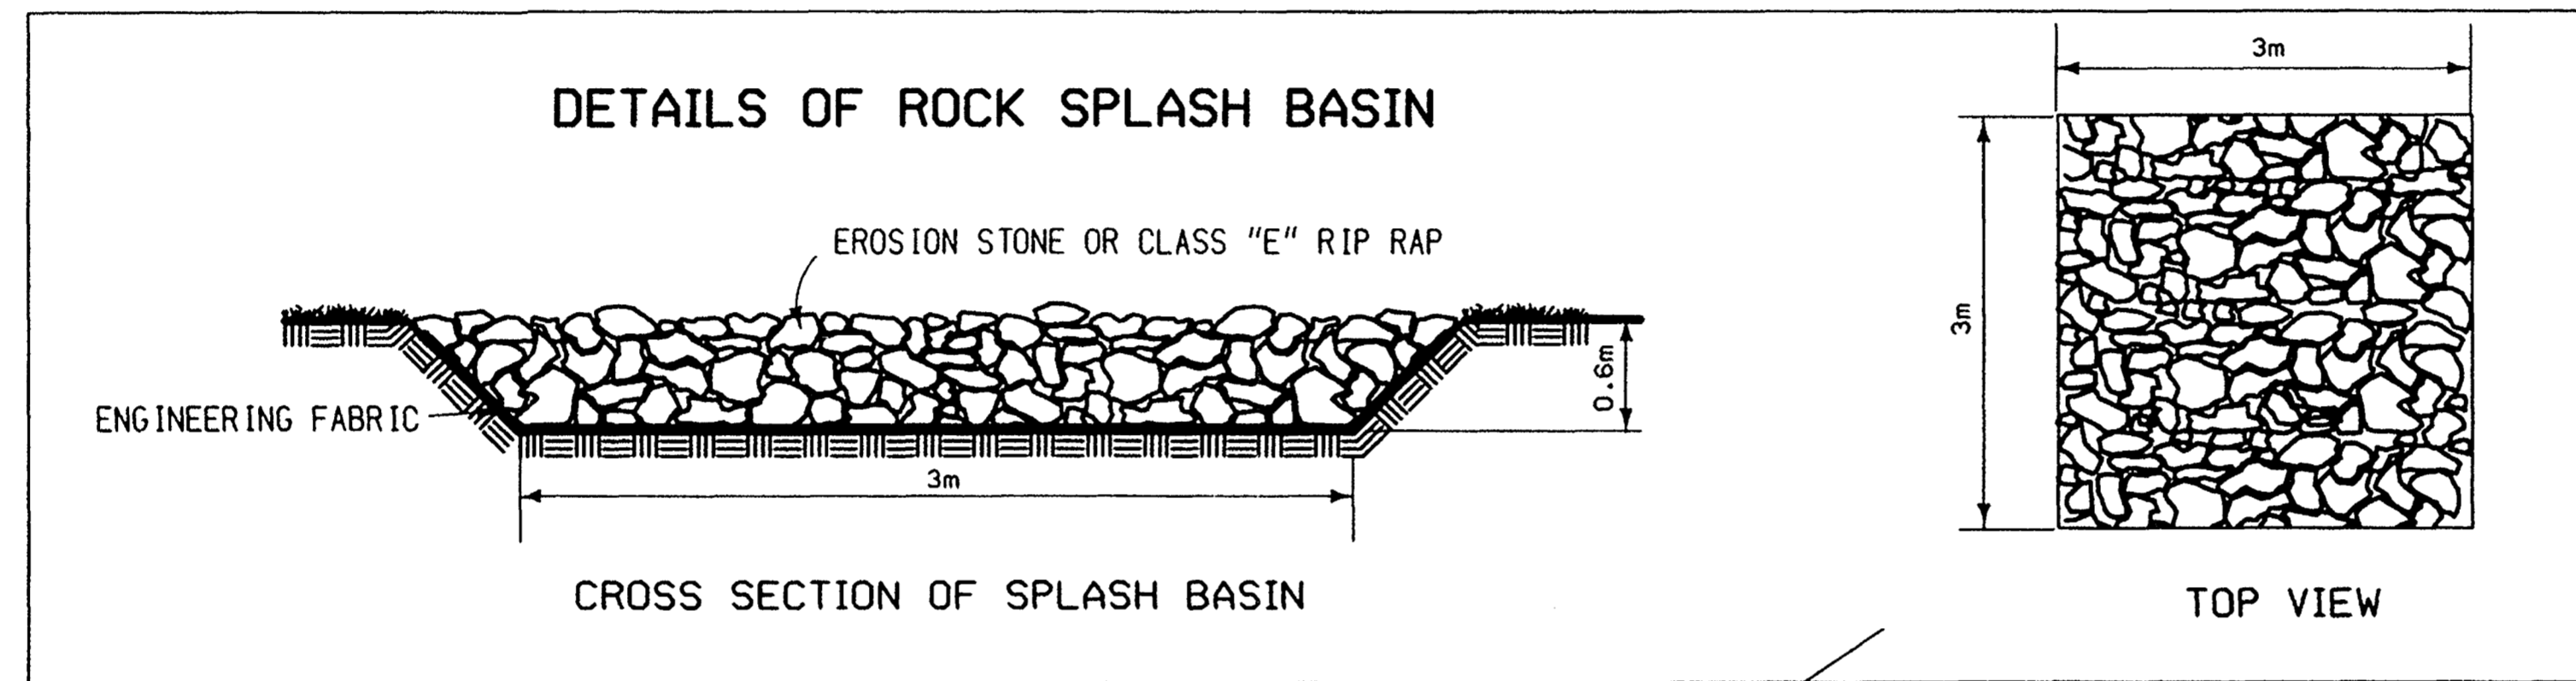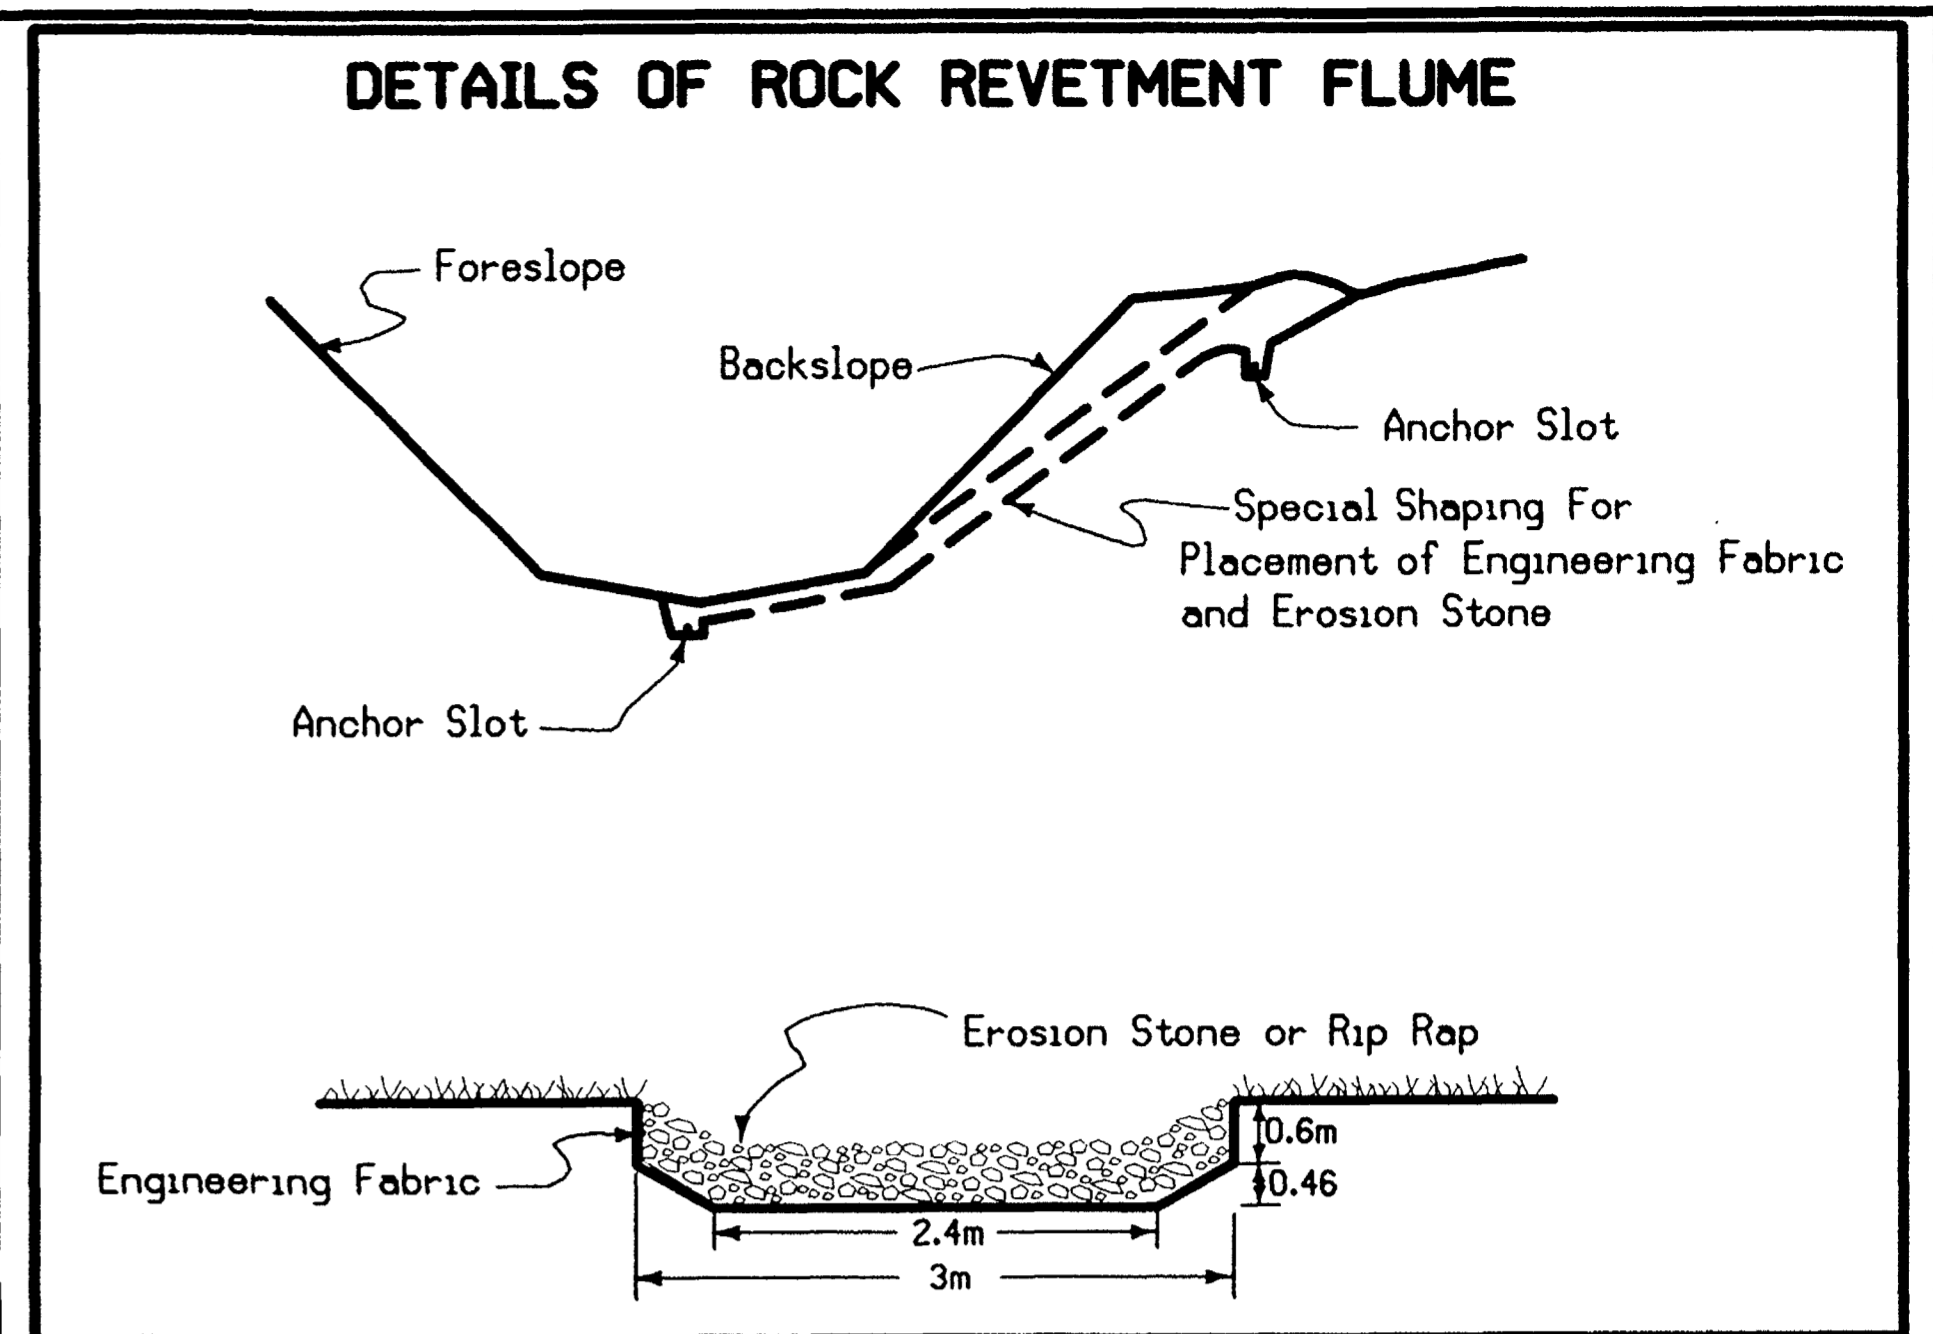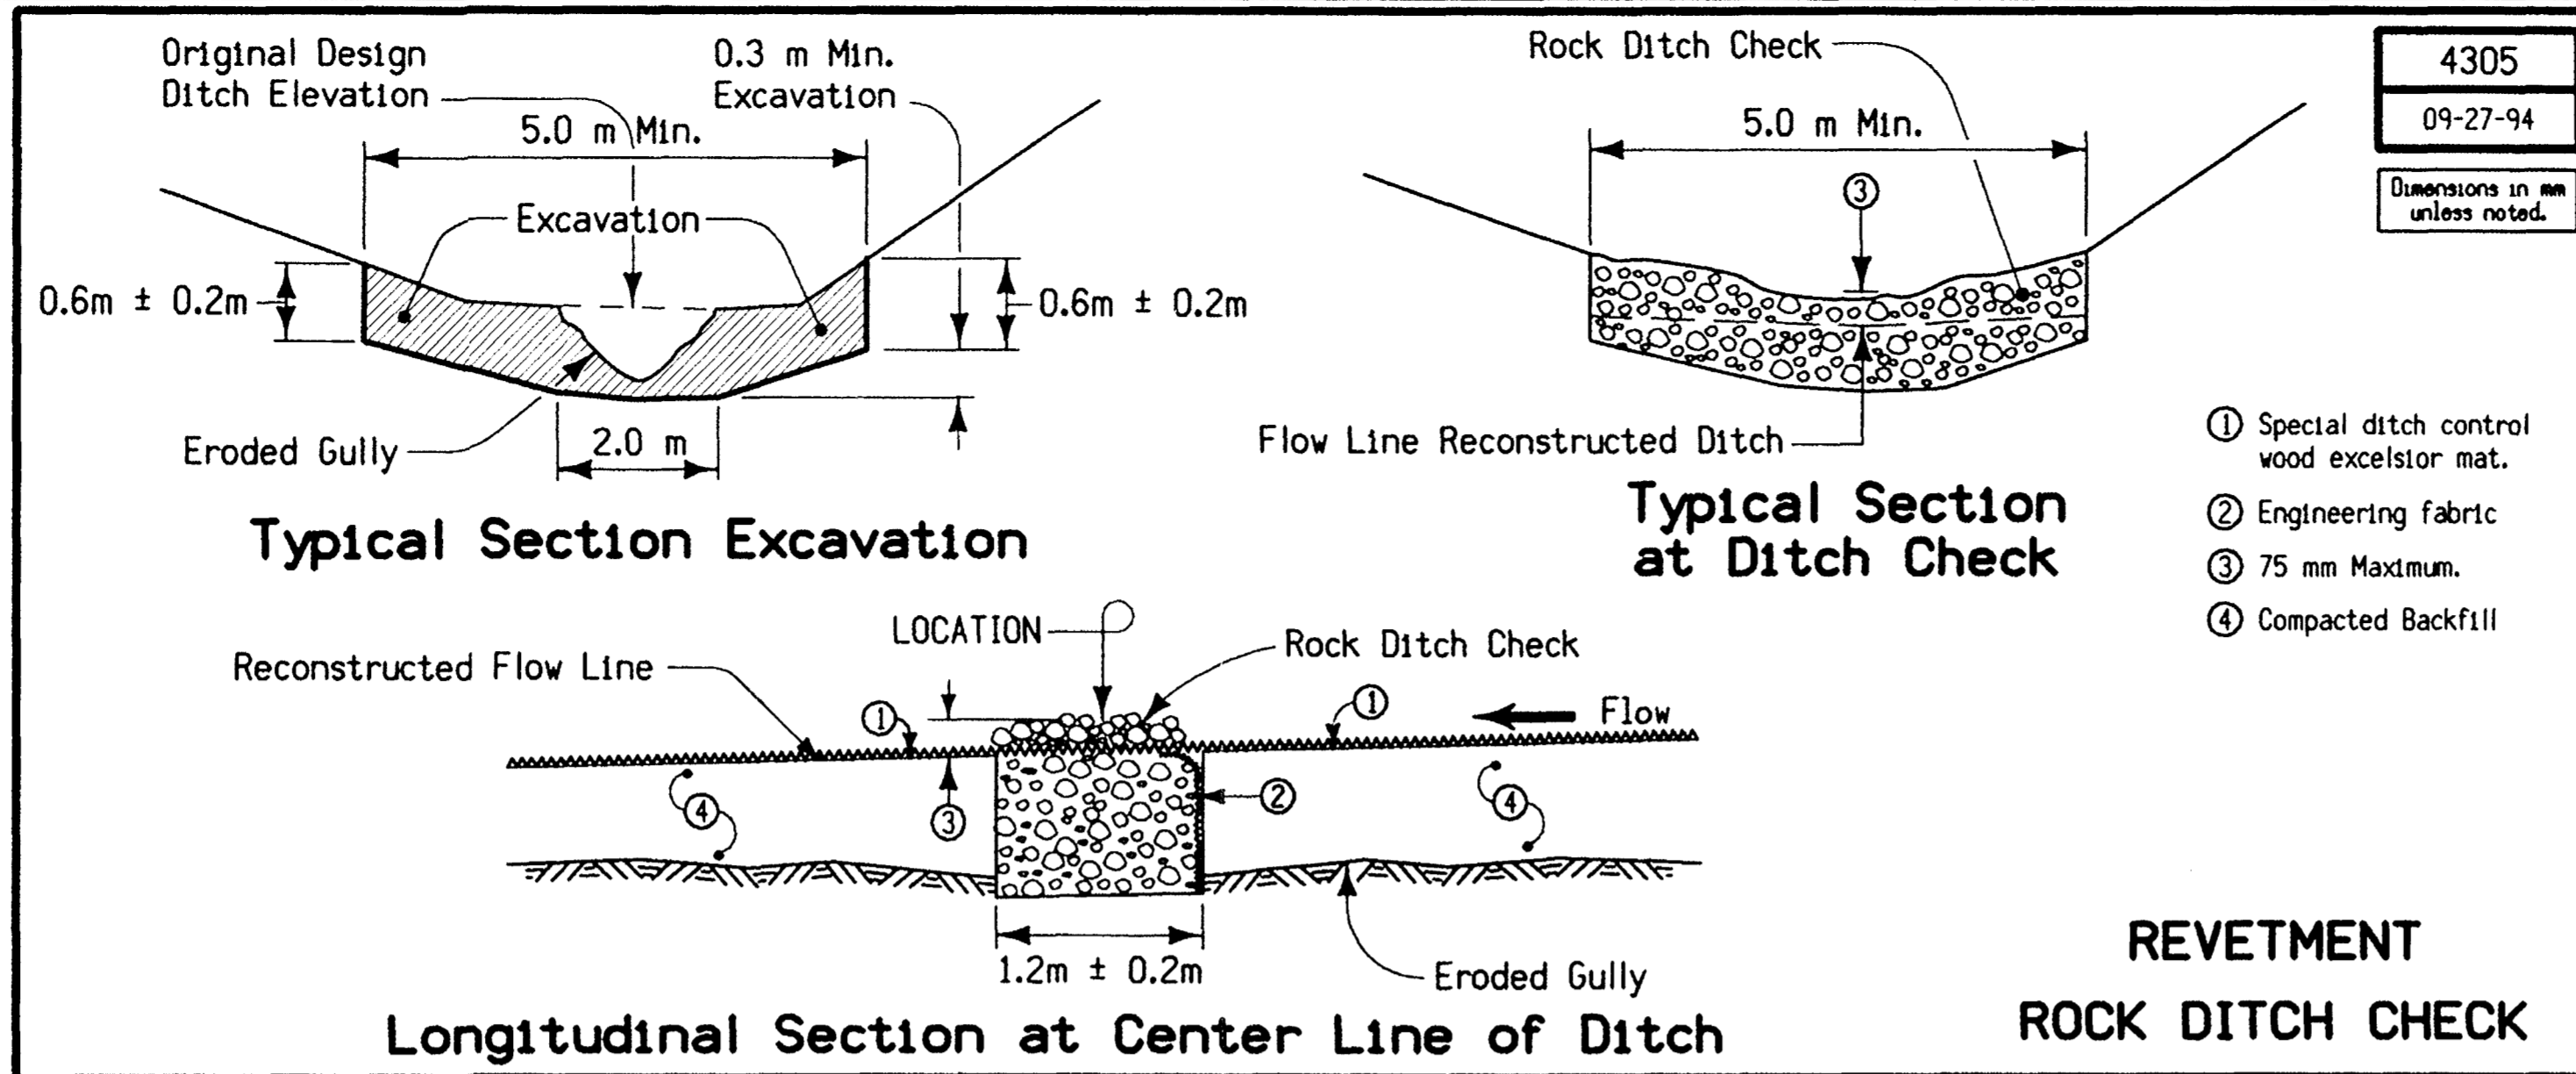

As Built Project Quantities				
Prop. Line	Item Code	Item Description	Units	Quantity Placed
900	2102-100100	CL 10 EXCAVATION RDWY+BORROW	M3	22,606.00
910	2102-230100	SPECIAL BACKFILL MATL	MG	17,650.16
920	2105-100100	TOPSOIL STRIP SALVAGE+SPREAD	M3	0
930	2105-101000	TOPSOIL SPREAD	M3	11,000.00
940	2111-100000	GRANULAR SUBBASE	M2	202,211.03
950	2115-100000	MODIFIED SUBBASE	M3	2,737.33
960	2121-100100	GRANULAR SHLD TYPE A	MG	38,843.98
970	2122-200260	PAVED SHLD PCC 260 MM	M2	5,613.68
980	2122-220000	PAVED SHLD, PCC (PANEL FOR RF-38/RF-39)	M2	82.52
990	2123-100200	EARTH SHLD CONSTRUCTION	M	43,730.20
1000	2301-104260	STD/S-F PCC PAVT QM-C CL 3I 260 MM	M2	180,734.11
1010	2301-400150	MEDIAN PCC 150 MM	M2	39.93
1020	2301-500000	BRIDGE APPROACH SECTION	M2	2,492.23
1030	2301-600100	PCC PAVT SAMPLE	LS	1
1040	2301-990000	QUALITY MANAGEMENT - CONCRETE	M3	41,592.43
1050	2312-110100	GRANULAR SURF ON RD CL A CR STONE	MG	3,098.77
1060	2315-110100	DRIVEWAY SURF CL A CR STONE	MG	374.37
1070	2399-100110	DETOUR PAVT	M2	7,408.84
1080	2402-220000	EXCAVATION CL 20-RDWY PIPE CULV	M3	280
1090	2416-100600	CONC 100D RDWY PIPE CULV 600 MM	M	24.92
1100	2416-100750	CONC 100D RDWY PIPE CULV 750 MM	M	13.45
1110	2416-240600	CONC PIPE APRON 600 MM	EACH	4
1120	2416-240750	CONC PIPE APRON 750 MM	EACH	2
1130	2416-320600	PIPE APRON GUARD (RF-26) 600 MM	EACH	0
1140	2417-060375	CMP RDWY CULV 375 MM	M	28
1150	2417-340300	METAL APRON 300 MM	EACH	5
1160	2417-430375	BEVELED PIPE+GUARD 375 MM	EACH	2
1170	2417-450525	CORR METAL SLOT DRAIN 525MM/150MM GRATE	M	41.5
1180	2422-100450	UNCL ENT PIPE CULV 450 MM	M	18.3
1190	2422-300450	UNCL APRON 450 MM	EACH	2
1200	2502-250100	LONGITUDINAL SUBDRAIN (SHLD) 100 MM	M	32,351.00
1210	2502-300195	SUBDRAIN OUTLET RF-19E	EACH	464
1220	2503-020300	CORR METAL STORM SWR 300 MM	M	127.3
1230	2503-500380	BRIDGE END DRAIN RF-38	EACH	5
1240	2505-000110	RMV G'DRAIL	M	138.3
1250	2505-001000	INSTALL OF GRAIL	M	628.652
1260	2505-100530	G'RAIL END ANCHOR BEAM RE-53	EACH	6
1270	2505-100690	G'RAIL END ANCHOR BEAM RE-69	EACH	18
1280	2505-100761	G'RAIL TERMINAL, BEAM, RE-76	EACH	6
1290	2507-001500	REVTMENT CL E	MG	654.798
1300	2507-002000	EROSION STONE	MG	398.746
1310	2507-004000	ENGINEERING FABRIC	M2	1,846.69
1320	2510-001000	RMVL OF PAVT	M2	24,921.38
1330	2518-000100	SAFETY CLOSURE	EACH	41
1340	2518-010310	PERMANENT RD CLOSURE (RURAL) RE-3A	M	12
1350	2519-201800	CHAIN LINK FENCE 1.8 M (RC-10)	M	128
1360	2520-100100	FIELD LABORATORY	EACH	1
1370	2524-110000	TYPE A SIGN SHEET ALUM	M2	13.42
1380	2524-201610	WOOD POST-TYPE A OR B SIGN, 100 X 100 MM	M	85.97
1390	2525-002000	SILT FENCE	M	330.2
1400	2525-003000	SILT FENCE-DITCH CHECK	M	1,221.00
1410	2525-008010	CLEANOUT OF SILT FENCE	M	0
1420	2525-008020	CLEANOUT OF SILT FENCE - DITCH CHECK	M	549.9
1430	2526-001000	CONSTRUCTION SURVEY	LS	1
1440	2527-101000	PAINTED PAVT MARK	M	112,174.97
1450	2527-103000	REMOVABLE TAPE MARK	EACH	2,367.00
1460	2527-106000	TEMPORARY DELINEATOR	EACH	0
1470	2527-107000	RAISED PAVT MARKER	EACH	417
1480	2527-108000	PAVT MARK RMVD	M	54,200.75
1490	2528-101000	TRAFFIC CONTROL	LS	1
1500	2528-104000	TEMPORARY TRAFFIC SIGNAL	EACH	0
1510	2528-105000	TEMPORARY FLOODLIGHT LUMINAIRE	EACH	12
1520	2528-107000	FLAGGER	DAY	77.5
1530	2533-100000	MOBILIZATION	LS	0
1540	2601-103000	STABILIZE CROP SEED+FERTILIZE	HA	55.193
1550	2601-103100	STABILIZE CROP SEED+FERTILIZE (URBAN)	HA	0
1560	2601-104100	FERTILIZE	HA	0
1570	2601-104200	MULCH	HA	0
1580	2601-108140	SLOPE PROTECTION WOOD EXCEL MAT RC-14	M2	1,690.40
1590	2601-109000	WATER	KL	68.12
1600	2601-110000	MOW	HA	0

Contract Modifications:				
1885	2105-102000	TOPSOIL STRIP+STKP	M3	11,000.00
1900	2102-220100	SELECTED BACKFILL MATL	M3	5,142.00
1905	2599-999903	(CUBIC METER ITEM) Over Depth Excavation	M3	1,435.00
1910	2533-100000	MOBILIZATION	LS	1
1915	2599-999916	(LUMP SUM ITEM) Turn Lane and Crossover Relocation Costs	LS	1
1920	2599-999917	(UNIT ITEM) Replace Bridge End Posts	UNIT	3
1925	2506-100000	FLOWABLE MORTAR	M3	5.35
1930	2599-999902	(SQUARE METER ITEM) Concrete Design Mixture Adjustment (QM-C)	M2	148,970.29
1935	2599-999916	(LUMP SUM ITEM) Adjust Stringline	LS	1
1940	2599-999916	(LUMP SUM ITEM) Remobilization and Additional Paving Costs	LS	1
1950	2515-100150	PCC DRIVEWAY 150 MM	M2	262.92
1955	2599-999916	(LUMP SUM ITEM) Temporary HMA Paving	LS	1
1960	2599-999916	(LUMP SUM ITEM) Relocate Speed Limit Signs	LS	1
1970	2527-101020	PAINTED PAVT MARK, SOLVENT-BASED	M	2,846.90
1975	2527-104020	PAINTED SYMBOL+LEGEND, SOLVENT-BASED	EACH	20
1980	2527-108000	PAVT MARK RMVD	M	1,382.50
1985	2528-101000	TRAFFIC CONTROL	LS	1
1990	2599-999916	(LUMP SUM ITEM) Remobilizing Paving Crew	LS	1
1995	2599-999916	(LUMP SUM ITEM) Raise RA-62 Intake	LS	1
2000	2527-101020	PAINTED PAVT MARK, SOLVENT-BASED	M	13,442.25
2015	2599-999915	(EACH ITEM) Price Adjustment for Trainee Reimbursement	EACH	-1
2020	2599-999916	(LUMP SUM ITEM) Pavement Thickness Incentive (Mainline Only)	LS	1
2090	2599-999915	(EACH ITEM) Asphalt Wedge Removal at Crossovers	EACH	9
2095	2599-999915	(EACH ITEM) Clean Out Silt Basin	EACH	11
2100	2599-999915	(EACH ITEM) Drill and Tie Pipe Joints	EACH	6
2105	2599-999916	(LUMP SUM ITEM) Standpipe, 600mm, CMP	LS	1
2110	2599-999901	(METER ITEM) Removal of Silt Fence - Ditch Checks	M	579.7
2115	2599-999902	(SQUARE METER ITEM)	M2	730.686
2120	2213-100300	EXCAVATION CL 13-WIDEN	M3	6,199.04
2125	2416-281000	RMV+REINSTALL CONC APRON <= TO 1000 MM	EACH	2
2130	2417-161000	RMV+REINSTALL CP CULV <= TO 1000 MM	M	4.2
2135	2525-005000	SILT BASIN	EACH	3
2140	6200-500171	PRICE ADJ/FUEL ADJUSTMENT Fuel Adjustment	EACH	-1,475.24
2280	2599-999916	(LUMP SUM ITEM) Removal of Excess Material	LS	1
2285	6200-230120	PRICE ADJ/PCC PAVT THICKNESS, INCENTIVE Price Adj/PCC Pavt Thickness, Incentive	M2	36,422.05
2290	6200-230110	PRICE ADJ/PCC PAVT THICKNESS, DEFICIENT Pavement Thickness Disincentive	M2	-5,916.45
2300	2599-999916	(LUMP SUM ITEM) Traffic Control	LS	1
2350	6200-500031	PRICE ADJ/AIR CONTENT TEST DEVIATION Adjustment for Non-Complying Air Content	EACH	-2,905.87
2355	2123-100200	EARTH SHLD CONSTRUCTION	M	11,225.00
2360	6200-700041	PRICE ADJ/INCENTIVE-PCC PAVT SMOOTHNESS	EACH	1

Contract Modification Reference Information		
Item No.	Item Code	Item Description
1900	2102-220100	Tabulation 103-3 on Plan Sheet C.05 called for Special Backfill from Sta. Sta. 15+40 to 23+50. The grading subcontractor requested to place 0.60M of Select Backfill in Lieu of 0.30m of Special Backfill. This would make the pavement sub grade uniform since Selected Backfill was used for the road way on each side of this area. Item includes 5,142.00 M3.
1920	2599-999917	The end posts on the exiting bridge at Sta. 134+66 were not designed for the attachment of formed steel thrie beam guardrail. Three corners of the bridge are to be retrofitted with formed steel thrie beam guardrail
2105	2599-999916	To control silt from running through a crossroad pipe and depositing onto Fawn Creek golf course, a retaining structure was manufactured to fit in the inlet apron of the crossroad pipe to slow the flow of runoff and allow the silt to settle on the right-of-way before entering the pipe.
2130	2417-161000	Sections of the exiting pipe culverts at Sta. 184+09.8 & 1173+82.4 needed to be removed and relayed before they could be extended to remove large gaps that developed in the existing installation near the edge of the foreslope.
2355	2123-100200	An Item for flattening of the median foreslopes and grading the inside median shoulder from 10ft to 6ft along the existing lanes were not included on the paving plans from Sta. 24+00 - 183+66.

ESTIMATED PROJECT QUANTITIES

100-1A
07-15-97

ITEM NO.	ITEM CODE	ITEM	UNIT	TOTAL	AS BUILT QUAN.
1	2102--100100	CLASS 10 EXCAVATION, ROADWAY AND BORROW	M3	22606	
2	2102--230100	SPECIAL BACKFILL MATERIAL	MG	19251	
3	2105--100100	TOPSOIL, STRIP, SALVAGE AND SPREAD	M3	13000	
4	2105--101000	TOPSOIL, SPREAD	M3	11000	
5	2111--100000	GRANULAR SUBBASE	M2	203243	
6	2115--100000	MODIFIED SUBBASE	M3	1534	
7	2121--100100	GRANULAR SHOULDERS, TYPE A	MG	36973	
8	2122--200260	PAVED SHOULDER, PORTLAND CEMENT CONCRETE 260 MM	M2	4888	
9	2122--220000	PAVED SHOULDER, PORTLAND CEMENT CONCRETE (PAVED SHOULDER PANEL FOR RF-38 OR RF-39 BRIDGE END DRAIN)	M2	89.3	
10	2123--100200	EARTH SHOULDER CONSTRUCTION	M	42486	
11	2301--104260	STANDARD OR SLIP FORM PORTLAND CEMENT CONCRETE PAVEMENT P.C., CLASS 31 DURABILITY 260 MM	M2	178828	
12	2301--400150	MEDIUM PORTLAND CEMENT CONCRETE 150 MM	MG	42	
13	2301--500000	BRIDGE APPROACH SECTION	M2	2682.2	
14	2301--600100	PORTLAND CEMENT CONCRETE PAVEMENT SAMPLES	LS	1	
15	2301--990000	QUALITY MANAGEMENT - CONCRETE	M3	46495	
16	2312--110100	GRANULAR SURFACING ON ROAD, CLASS A CRUSHED STONE	MG	2430	
17	2315--110100	DRIVEWAY SURFACING, CLASS A CRUSHED STONE	MG	507	
18	2399--100110	DETOUR PAVEMENT	M2	5629	
19	2402--220000	EXCAVATION, CLASS 20, FOR ROADWAY PIPE CULVERT	M3	436	
20	2416--100600	CONCRETE 1000 ROADWAY PIPE CULVERT 600 MM DIA	M	65.84	
21	2416--100750	CONCRETE 1000 ROADWAY PIPE CULVERT 750 MM DIA	M	15.85	
22	2416--240600	CONCRETE PIPE APRONS 600 MM DIA	EACH	6	
23	2416--240750	CONCRETE PIPE APRONS 750 MM DIA	EACH	2	
24	2416--320600	PIPE APRON GUARD (RF-26) 600 MM	EACH	2	
25	2417--060375	CORRUGATED METAL ROADWAY PIPE CULVERT 375 MM DIA	M	28	
26	2417--340300	METAL APRONS 300 MM DIA	EACH	5	
27	2417--400375	BEVELLED PIPE AND GUARD, 375 MM	EACH	2	
28	2417--450625	CORRUGATED METAL SLOTTED DRAIN 525 MM WITH 150 MM GRATE	M	41.5	
29	2422--100450	UNCLASSIFIED ENTRANCE PIPE CULVERT 450 MM DIA	M	18.30	
30	2422--300450	UNCLASSIFIED APRONS 450 MM DIA	EACH	2	
31	2502--250100	LONGITUDINAL SUBDRAIN (SHOULDER) 100 MM DIA	M	38981	
32	2502--300195	SUBDRAIN OUTLET, RF-19E	EACH	494	
33	2503--020300	CORRUGATED METAL STORM SEWER PIPE 300 MM DIA	M	127.3	
34	2503--600380	BRIDGE END DRAIN, RF-38	EACH	5	
35	2505--000110	REMOVAL OF GUARDRAIL	M	71	
36	2505--001800	INSTALLATION OF GUARDRAIL	M	621	
37	2505--100530	GUARDRAIL, END ANCHORAGE, BEAM, RE-53	EACH	6	
38	2505--100690	GUARDRAIL, END ANCHORAGE, BEAM, RE-69	EACH	18	
39	2505--100761	GUARDRAIL TERMINAL, BEAM, RE-76	EACH	6	
40	2506--110300	OBJECT MARKER, TYPE 3	EACH	10	
41	2507--001500	REVTMENT, CLASS E	MG	50	
42	2507--002000	EROSION STONE	MG	50	
43	2507--004000	ENGINEERING FABRIC	M2	100	
44	2510--001000	REMOVAL OF PAVEMENT	M2	23843	
45	2518--000100	SAFETY CLOSURE	EACH	37	
46	2518--010310	ROAD CLOSURE (RURAL), PERMANENT, RE-3A	M	12	
47	2519--201800	CHAIN LINK FENCE, 1.8 M HEIGHT (RC-10)	M	200	
48	2520--100100	FIELD LABORATORY	EACH	1	
49	2524--110000	TYPE A SIGNS, SHEET ALUMINUM	M2	13.42	
50	2524--201010	WOOD POSTS FOR TYPE A OR B SIGNS, 100 X 100 MM	M	38.7	
51	2525--002000	SILT FENCE	M	2689	
52	2525--003000	SILT FENCE FOR DITCH CHECKS	M	188	
53	2525--008010	CLEANOUT OF SILT FENCE	M	6719	
54	2525--008020	CLEANOUT OF SILT FENCE FOR DITCH CHECK	M	1558	
55	2526--001000	CONSTRUCTION SURVEY	LS	1	
56	2527--101000	PAINTED PAVEMENT MARKING	M	82688	
57	2527--103000	REMOVABLE TAPE MARKING	M	9045	
58	2527--106000	TEMPORARY DELINEATORS	EACH	134	
59	2527--107000	RAISED PAVEMENT MARKERS	EACH	180	
60	2527--108000	PAVEMENT MARKINGS REMOVED	M	16612	
61	2528--101000	TRAFFIC CONTROL	LS	1	
62	2528--104000	TEMPORARY TRAFFIC SIGNALS	EACH	1	
63	2528--105000	TEMPORARY FLOODLIGHTING LUMINAIRE	EACH	1	
64	2528--107000	FLAGGERS	DAY	80	
65	2533--100000	MOBILIZATION	LS	1	
66	2601--103000	STABILIZING CROP SEEDING AND FERTILIZING	HA	38	
67	2601--103100	STABILIZING CROP SEEDING AND FERTILIZING (URBAN)	HA	2	
68	2601--104100	FERTILIZING	HA	15	
69	2601--104200	MULCHING	HA	15	
70	2601--108140	SLOPE PROTECTION, WOOD EXCELSTOR MAT (RC-14)	M2	2000	
71	2601--109000	WATERING	KL	40	
72	2601--110000	MOWING	HA	114	

REFERENCE INFORMATION

100-4B
07-15-97

Data listed below is for informational purposes only and shall not constitute a basis for any extra work orders.

ITEM NO.	ITEM CODE	DESCRIPTION
1	2102--100100	ITEM INCLUDES 5,817 CU. M. OF BORROW FOR STAGE I, 3,605 CU. M. OF WASTE FOR STAGE II, AND 1,150 CU. M. OF WASTE FOR STAGE III. BORROW MATERIAL IS AVAILABLE IN EITHER BORROW SITE 'A' OR BORROW SITE 'B'. WASTE MATERIAL CAN BE UTILIZED AS EARTH SHOULDER FILL. OVERHAUL WILL NOT BE MEASURED OR PAID FOR, BUT SHALL BE CONSIDERED INCIDENTAL TO ROADWAY EXCAVATION ON THIS PROJECT.
2	2102--230100	ITEM INCLUDES 6,076 MG FROM TAB. X-51 FROM SHEET C.15 AND 13,175 FROM TAB. 103-3 SHEET C.05.
3	2105--100100	SEE R.01 AND R.02 FOR LOCATIONS AND DETAILS.
4	2105--101000	
5	2111--100000	HAULING EQUIPMENT AND OTHER TRAFFIC WILL NOT BE ALLOWED ON THE COMPLETED GRANULAR SUBBASE. SEE TAB. X-50, SHEET C.15 FOR LOCATION AND DETAILS.
6	2115--100000	SEE TAB. X-50, SHEET C.15 FOR LOCATION AND DETAILS.
7	2121--100100	SEE TYPICAL 7110, SHEET B.06 FOR LOCATION AND DETAILS.
8	2122--200260	SEE TYPICAL 7146, SHEET B.06 AND TAB. 112-9, SHEET C.13 FOR LOCATION AND DETAILS. SEE RH-410 FOR RUMBLE STRIP LAYOUT AND JOINTING INFORMATION.
9	2122--220000	SEE TAB. 104-8, SHEET C.05 FOR LOCATIONS AND DETAILS.
10	2123--100200	INCLUDES 39,539 M AS PER TYPICAL 7110 ON SHEET B.06 AND 2,897 AS PER TYPICAL 7126 AND 7146 SHEET B.06. ITEM WILL INCLUDE 41,249 CU. M. OF EARTH SHOULDER FILL AS PER TYPICAL 7110, 620 CU. M. OF EARTH SHOULDER FILL AS PER TYPICAL 7126 AND 1,089 CU. M. OF EARTH SHOULDER FILL AS PER TYPICAL 7126 SHEET B.06. EARTH SHOULDER FILL MATERIAL SHALL BE INCIDENTAL TO THIS ITEM. NO PAYMENT FOR OVERHAUL WILL BE ALLOWED FOR EARTH SHOULDER FILL MATERIAL.
11	2301--104260	THE CONTRACTOR SHALL USE 'CD' JOINTS 6:1 SKEW AT 6 M SPACING. SEE TAB. X-50, SHEET C.15 FOR LOCATIONS AND DETAILS.
12	2301--400150	ITEM IS FOR THE PAVING OF THE STOP ISLANDS. SEE THE INTERSECTION SHEETS FOR LOCATIONS AND DETAILS.
13	2301--500000	SEE TAB. 112-6, SHEET C.13 FOR LOCATION AND DETAILS.
16	2312--110100	ITEM IS FOR THE RECONSTRUCTION OF GRANULAR SIDE ROADS NEAR THE NEW MAINLINE PAVING. EACH SIDEROAD WILL REQUIRE AN ESTIMATED 138 MG OF GRANULAR MATERIAL TO MATCH NEW MAINLINE GRADE. ITEM IS ALSO FOR THE CONSTRUCTION OF GRANULAR MEDIANS WHICH WILL TOTAL 1,602 MG.
17	2315--110100	ITEM IS FOR THE CONSTRUCTION OF DRIVE AT STA. 18+14. SEE TAB. 102-1, SHEET C.04 FOR LOCATION AND DETAILS. ITEM IS ALSO FOR THE RECONSTRUCTION OF ENTRANCES TO MEET NEW MAINLINE PAVING. EACH DRIVEWAY WILL REQUIRE AN ESTIMATED 35 MG OF GRANULAR MATERIAL TO MATCH NEW MAINLINE GRADE.
18	2399--100110	IT SHALL BE THE CONTRACTOR'S OPTION TO USE CLASS "A" P.C. CONCRETE, TYPE "B" A.C. CONCRETE BASE (CLASS 1), AN APPROVED COMMERCIAL MIX, OR A MIX OF HIGHER QUALITY FOR THE PAVED DETOUR SURFACE. THE PAVEMENT THICKNESS SHALL BE 200 MM FOR P.C. CONCRETE AND 250 MM FOR A.C. CONCRETE. A. THE AREA OF THE DETOUR PAVEMENT CONSTRUCTED OF THE TYPE, CLASS AND THICKNESS SPECIFIED WILL BE DETERMINED FROM THE DIMENSIONS SHOWN IN THE CONTRACT DOCUMENTS. SEE TAB. X-51, SHEET C.15, SHEET U.07, J SHEETS AND F SHEETS FOR LOCATIONS AND DETAILS. B. FOR THE AREA OF THE DETOUR PAVEMENT AS MEASURED ABOVE, THE CONTRACTOR WILL BE PAID THE CONTRACT PRICE PER SQUARE METER. THESE PAYMENTS SHALL BE FULL COMPENSATION FOR FURNISHING ALL TOOLS, MATERIALS, LABOR, AND EQUIPMENT NECESSARY FOR CONSTRUCTION OF THE PAVEMENT IN ACCORDANCE WITH THE CONTRACT DOCUMENTS. C. REMOVAL SHALL BE PAID FOR AS PAVEMENT REMOVAL.
19	2402--220000	SEE TAB. 104-3, SHEET C.05 FOR LOCATION AND DETAILS.
20	2416--100600	
21	2416--100750	
22	2416--240600	
23	2416--240750	
24	2416--320600	
26	2417--340300	SEE TAB. 104-8, SHEET C.05 FOR LOCATION AND DETAILS.
25	2417--060375	ITEMS ARE FOR MEDIAN CROSSOVER. SEE SHEETS U.07 AND U.08 FOR LOCATIONS AND DETAILS.
27	2417--430375	
28	2417--450525	
29	2422--100450	SEE TAB. 102-1, SHEET C.04 FOR LOCATION AND DETAILS.
30	2422--300450	

REFERENCE INFORMATION

100-4B
07-15-97

Data listed below is for informational purposes only and shall not constitute a basis for any extra work orders.

ITEM NO.	ITEM CODE	DESCRIPTION
31	2502--250100	SEE TAB. 104-9, SHEETS C.06-C.12 FOR LOCATIONS AND DETAILS. INCLUDES 14,677 MG OF POROUS BACKFILL WHICH IS INCIDENTAL TO THIS BID ITEM. THE EXCAVATION MATERIAL SHALL BE REMOVED AND DISPOSED OF AS PER STANDARD NOTE 213-1, OR USED AS EARTH SHOULDER FILL, OR WASTED ON FORESLOPES AS DIRECTED BY THE ENGINEER.
32	2502--300195	
33	2503--020300	SEE TAB. 104-8, SHEET C.05 FOR LOCATION AND DETAILS.
34	2503--500380	
35	2505--000110	SEE TAB. 110-7A, SHEET C.13 FOR LOCATION AND DETAILS. ITEM WILL INCLUDE REMOVAL OF GUARDRAIL POSTS AND END ANCHORAGES NECESSARY TO REMOVE GUARDRAIL AND SHALL BE CONSIDERED INCIDENTAL TO THIS ITEM.
36	2505--001000	SEE TAB. 108-8A AND TAB. 108-19, SHEET C.21 FOR LOCATION AND DETAILS. ITEM INCLUDES 103 M AS PER TAB. 108-8A AND 518 M AS PER TAB. 108-19.
37	2505--100530	SEE TAB. 108-8A AND TAB. 108-19, SHEET C.21 FOR LOCATION AND DETAILS.
38	2505--100690	
39	2505--100761	
40	2505-110300	SEE TAB. 108-17, SHEET C.13 FOR LOCATION AND DETAILS.
41	2507--001500	FOR CONSTRUCTION OF ROCK DITCHES, FLUMES, CHECKS OR SLOPE PROTECTION AT VARIOUS LOCATIONS AS DIRECTED BY THE ENGINEER. THE EXCAVATION AND SHAPING FOR THE UNIFORM PLACEMENT OF THE RIP RAP SHALL BE INCIDENTAL TO THIS WORK. REFER TO DETAILS ON SHEET B.10.
42	2507--002000	FOR CONSTRUCTION OF ROCK DITCHES, FLUMES, CHECKS OR SLOPE PROTECTION AT VARIOUS LOCATIONS AS DIRECTED BY THE ENGINEER. MATERIALS SHALL BE NOMINAL 150 MM (-80MM+100MM) WELL GRADED STONE AS APPROVED BY THE ENGINEER. ALL NECESSARY EXCAVATION AND SHAPING TO PROVIDE A UNIFORM FLOWLINE IN THE CENTER OF THE DITCH SHALL BE INCIDENTAL TO THIS WORK. NO COMPENSATION WILL BE ALLOWED. REFER TO DETAILS ON SHEET B.10.
43	2507--004000	ENGINEERING FABRIC SHALL BE MATERIAL AS SPECIFIED FOR EMBANKMENT EROSION CONTROL, ARTICLE 4196.01C. MATERIAL SHALL BE MEASURED IN SQ. M. OF ACTUAL AREA COVERED. REFER TO DETAILS ON SHEET B.10.
44	2510--001000	ITEM IS FOR REMOVAL OF PAVEMENT AS DESCRIBED IN TAB. 110-1, SHEET C.13 (20863 SQ. M.) AND TAB. X-51, SHEET C.15 (2980 SQ. M.) FOR PAVEMENT TYPE INFORMATION SEE TAB. 102-5, SHEET C.04. REMOVED PAVEMENT SHALL BECOME THE PROPERTY OF THE CONTRACTOR AND DISPOSED OF AS PER STANDARD NOTATION NO. 213-1.
45	2518--000100	SEE TAB. 108-13A, SHEET C.13 FOR LOCATION AND DETAILS.
46	2518--010310	SEE TAB. 102-4, SHEET C.04 FOR LOCATION AND DETAILS.
47	2519--201800	ITEM IS FOR THE INSTALLATION OF CHAIN LINK FENCE IN GAPS LEFT BY PREVIOUS PROJECT. PLACEMENT SHALL BE DIRECTED BY THE ENGINEER.
49	2524--110000	SEE TABULATION X-60 ON SHEET C.04 FOR LOCATIONS AND DETAILS.
50	2524--201010	
51	2525--002000	SEE TAB. 100-17, SHEET C.04 FOR LOCATION AND DETAILS.
53	2525--008010	
52	2525--003000	SEE TAB. 100-18, SHEET C.04 FOR LOCATION AND DETAILS.
54	2525--008020	
56	2527--101000	SEE TAB. 108-22, SHEETS C.16-C.20 FOR LOCATION AND DETAILS.
57	2527--103000	
60	2527--108000	
58	2527--106000	ITEM IS FOR THE INSTALLATION AND REMOVAL OF TEMPORARY DELINEATORS AS PROPOSED BY THE TRAFFIC CONTROL SHEETS J.01-J.08.
59	2527--107000	SEE TRAFFIC CONTROL SHEET J.09 FOR LOCATIONS AND DETAILS.
61	2528--101000	ITEM IS FOR ALL TOOLS, MATERIALS, LABOR, AND EQUIPMENT NECESSARY FOR TRAFFIC CONTROL AS DESCRIBED ON SHEETS J.01-J.08. ITEM DOES NOT INCLUDE PAVEMENT MARKINGS, REMOVABLE TAPE MARKINGS, REMOVAL OF PAVEMENT MARKINGS, TEMPORARY FLOODLIGHT LUMINAIRE AND TEMPORARY DELINEATORS. THESE ITEMS ARE PAID FOR SEPARATELY AND ARE NOT INCLUDED IN THIS BID ITEM.
62	2528--104000	ITEM IS FOR A PROPOSED SIGNALIZED HAUL ROAD CROSSING AT STA. 1073+50, IOWA 1 RAMP 'A'.
63	2528--105000	SEE TAB. 108-27, SHEET C.13 FOR LOCATION AND DETAILS. TWO LIGHTS ARE NOT TO BE REMOVED BY THIS PROJECT.

REFERENCE INFORMATION

100-4B
07-15-97

Data listed below is for informational purposes only and shall not constitute a basis for any extra work orders.

ITEM NO.	ITEM CODE	DESCRIPTION
66	2601--103000	INCLUDED FOR ALL RURAL AREAS OF THE RIGHT OF WAY AS DESIGNATED BY THE ENGINEER. SEED MIXTURE (RURAL) SPRING--MARCH 1 TO MAY 20 OATS 72 KG PER HECTARE WINTER RYE 63 KG PER HECTARE RED CLOVER 6 KG PER HECTARE TIMOTHY 6 KG PER HECTARE SUMMER--MAY 21 TO JULY 20 OATS 108 KG PER HECTARE ANNUAL RYEGRASS 39 KG PER HECTARE RED CLOVER 6 KG PER HECTARE TIMOTHY 6 KG PER HECTARE FALL--JULY 21 TO SEPTEMBER 30 OATS 72 KG PER HECTARE WINTER RYE 125 KG PER HECTARE RED CLOVER 6 KG PER HECTARE TIMOTHY 6 KG PER HECTARE FERTILIZER: RATE--500 KG OF 13-13-13 OR EQUIVALENT CHEMICALLY COMBINED COMMERCIAL FERTILIZER PER HECTARE.
67	2601--103100	INCLUDED FOR ALL URBAN AREAS OF THE RIGHT OF WAY AS DESIGNATED BY THE ENGINEER. SEED MIXTURE (URBAN) SPRING--MARCH 1 TO MAY 20 ANNUAL RYEGRASS 28 KG PER HECTARE BLUEGRASS, KY (PARK) 17 KG PER HECTARE PERENNIAL RYEGRASS 17 KG PER HECTARE SUMMER--MAY 21 TO JULY 20 ANNUAL RYEGRASS 51 KG PER HECTARE BLUEGRASS, KY (PARK) 17 KG PER HECTARE PERENNIAL RYEGRASS 17 KG PER HECTARE FALL--JULY 21 TO SEPTEMBER 30 ANNUAL RYEGRASS 28 KG PER HECTARE BLUEGRASS, KY (PARK) 17 KG PER HECTARE PERENNIAL RYEGRASS 17 KG PER HECTARE FERTILIZER: RATE--500 KG OF 13-13-13 OR EQUIVALENT CHEMICALLY COMBINED COMMERCIAL FERTILIZER PER HECTARE.
68	2601--104100	FERTILIZER: RATE--500 KG OF 13-13-13 OR EQUIVALENT CHEMICALLY COMBINED COMMERCIAL FERTILIZER PER HECTARE.
69	2601--104200	AREAS DISTURBED BUT NOT SEEDED WITH STABILIZING CROP BY SEPTEMBER 30 SHALL BE SCARIFIED TO A 75 MM DEPTH, FERTILIZED AND MULCHED. ALL MULCH TO BE CONSOLIDATED INTO THE SOIL WITH THE MULCH STABILIZER. MULCH: RATE--3.5 MEGAGRAMS OF DRY CEREAL STRAW PER HECTARE.
70	2601--108140	LOCATIONS TO BE DESIGNATED BY THE ENGINEER. SHAPING OF ERODED SLOPES WILL BE INCIDENTAL TO THIS ITEM. REFER TO STANDARD ROAD PLAN RC-14.
71	2601--109000	INCLUDES ONE WATERING OF THE SPECIAL DITCH CONTROL AND SLOPE PROTECTION. RATE: 20 L PER SQ. M. REFER TO ARTICLE 2601.19 FOR SCHEDULE AND PROCEDURE ONLY. ADDITIONAL WATERINGS (3) MAY BE REQUIRED AT THE DISCRETION OF THE ENGINEER SUBJECT TO LOCAL WEATHER CONDITIONS AND WILL BE PAID FOR AT THE CONTRACT UNIT PRICE.
72	2601--110000	ALL AREAS DISTURBED AND SEEDED TO STABILIZED CROP DURING GRADING AND PAVING SHALL BE MOWED IN OCTOBER OR NOVEMBER PRIOR TO FREEZING CONDITIONS.

09-27-94 203-1
Plan and profile sheets included in the project are for the purpose of alignment, location and specific directions for the work to be performed under this contract. Irrelevant data on these sheets is not to be considered a part of this contract.

10-27-98 203-2
During construction of this project, the contractor will be required to coordinate his operations with those of other contractors working within the same area. Other work in progress during the same period of the time will include construction of the following projects:

Project	Type of Work
NHSX-151-3(111)--3H-57	RCB Culverts
NHS-151-4(65)--19-53	Wapsi River Bridge
NHS-151-4(66)--19-53	Ia. 1 Interchange Bridge
NHSX-151-4(102)--3H-57	Hwy. 151 Grading-West
NHS-151-4(67)--34-53	Ia. 64 Interchange Bridge
NHSX-151-4(64)--3H-53	RCB Culverts
NHSX-151-4(63)--3H-53	Hwy. 151 Grading-East

The contractor shall submit to the Engineer a schedule for performing work items. Some items cannot be completed until prior work by other contractors has been completed. The contractor's schedule must therefore be coordinated with the schedules of others by the Engineer to obtain a schedule that is mutually acceptable. The contractor shall then perform the work as to conform to the accepted schedule.

07-15-97 203-4
The contractor is encouraged to take full advantage of specification 1105.15 - Value Engineering Incentive Proposal. A pamphlet and conceptual proposal form will be available at the preconstruction conference.

09-27-94 204-2
All holes resulting from operations of the contractor, including removal of guardrail posts, fence posts, utility poles, or foundation studies, shall be filled and consolidated to finished grade as directed by the engineer to prevent future settlement. The voids shall be filled as soon as practical - preferably the day created and not later than the following day. Any portion of the right-of-way or project limits (including borrow areas and operation sites) disturbed by any such operations shall be restored to an acceptable condition. This operation shall be considered incidental to other bid items in project.

09-27-94 204-4
All guardrail materials that are removed and not reused on this project shall become the property of the contractor. Any material to be used on this project that is damaged due to the carelessness of the contractor shall be replaced at the contractor's expense without cost to the State of Iowa.

09-27-94 213-1
It shall be the contractor's responsibility to provide waste areas or disposal sites for excess material (excavated material or broken concrete) which is not desirable to be incorporated into the work involved on this project. No payment for overhaul will be allowed for material hauled to these sites. No material shall be placed within the right-of-way, unless specifically stated in the plans or approved by the engineer.

09-27-94 213-2
The contractor's attention is directed to the following consideration in regard to removal and replacement of topsoil in borrow areas: Quantities estimated for topsoil are calculated on the basis of a uniform removal of topsoil to a depth of 0.3 meters. The material removed is to be spread uniformly to a minimum depth of 0.2 meters over the borrow area upon completion of excavation work.

09-27-94 213-3
All borrow areas, stockpile areas, haul roads and areas used for equipment on this project will require subsoil tillage to an average depth of 0.4 meters to 0.5 meters prior to placement of topsoil and/or stabilizing crop seeding. Such tillage shall be accomplished on maximum of one meter centers and at right angles to the finished slope of the borrow.

Equipment used to accomplish the tillage shall be equipped with an arrowhead-type shoe so as to provide lateral displacement and limit the movement of the subsoil to the surface. It shall be approved by the Engineer for the use intended. This work will be considered incidental to other work on the project and no payment will be allowed. It is intended that following subsoil tillage, the area remains in a "loosened" condition. Additional compaction or the operation of heavy equipment, other than required for topsoil placement and shaping shall not be allowed on areas which have received subsoil tillage.

10-27-98 213-4
The contractor shall apply necessary moisture to the construction area and haul roads to prevent the spread of dust. Refer to Article 1107.07 of the current Standard Specifications for additional details.

09-27-94 213-7
Unless otherwise directed or authorized, all asphaltic cement concrete and other bituminous materials which are not specifically addressed or described in the plans shall become the property of the contractor. The contractor, in accordance with current rules and regulations of the Iowa Department of Natural Resources, may:

1. With the approval of the Engineer, blend or otherwise process the material for use with shoulder or special backfill aggregate, for use on the project.
2. With the approval of the Engineer, place with material in areas designated by the Engineer as Soil Aggregate Subbase without extra charge.
3. Remove the material from the project and stockpile for the contractor's future use.

04-25-00 214-1
The roadbed shall be trimmed to within 15 millimeters of the final subgrade elevation. Trimmed material shall be placed in a windrow on either foreslope for use in earth shoulder fill after paving. No ponding of water shall be allowed by the stored material.

Trimming of material shall be included in excavation required for Earth Shoulder Construction. Granular surfacing material, if placed over the winter, is included in the trimmed volume.

09-27-94 221-3
Estimated quantity for new concrete pavement includes all integral curb, all street returns and special areas of repairs to connecting pavements.

09-27-94 221-4
In order to avoid any unnecessary surface breaks or premature spalling, the contractor is cautioned to exercise extreme care when performing any of the necessary saw cutting operations for the proposed pavement removal.

09-27-94 222-2
To obtain the correct form grades at low points where intakes are located, the contractor must exercise extreme care when paving full width pavements. This may require pouring one half of the pavement at a time or other methods approved by the engineer.

09-27-94 223-1
Construction of fillets at non-paved entrances is not required on this project. However, the engineer may require the construction of fillets at individual locations where deemed necessary.

09-27-94 232-5
The contractor shall not disturb desirable grass areas and desirable trees outside the construction limits. The contractor will not be permitted to park or service vehicles and equipment or use these areas for storage of materials. Storage, parking and service area(s) will be subject to the approval of the resident engineer.

09-27-94 232-8
The top 150 millimeters of the disturbed areas shall be free of rock and debris and shall be suitable for the establishment of vegetation, subject to the approval of the Engineer.

10-28-97 232-10
The contractor is expected to have materials, equipment, and labor available on a daily basis to install and maintain erosion control features on the project. This may involve seeding, silt fence, rock ditch checks, silt basins, or silt dikes.

09-27-94 241-1
Road contractor is to use due caution in working over and around all tile lines. Breaks in the tile line due to the contractor's carelessness are to be replaced at his expense without cost to the State of Iowa. Any tile lines broken or disturbed by our cut lines will be replaced as directed by the engineer in charge of construction and at the State of Iowa's expense.

09-27-94 251-1
The contractor shall be responsible to maintain access to individual properties during construction. Relocated access shall be completed to individual properties prior to removal of existing access. If the permanent access cannot be completed prior to removal of the existing access, the contractor shall provide and maintain an alternate access. Temporary Granular Surfacing will be paid for as a contract item or by extra work.

09-27-94 251-2
The contractor is hereby notified that removal of any existing traffic markers, warning devices or guardrail barriers shall be scheduled subject to the approval of the Engineer. The contractor may be required to place temporary warning devices at certain locations where replacement features are not installed the same day during which any such removals take place.

09-27-94 251-3
A plan for stage construction of local accesses which are required to remain open to traffic during construction shall be submitted by the contractor for approval by the engineer.

10-31-95 251-4
The centerline pavement marking shall always be placed on one side of the roadway except where a "No Passing Zone" line is used, at which point it is placed on the opposite side of the roadway. The centerline shall be placed on the same side of the roadway as to match existing markings near the project.

09-27-94 251-5
On all new or reconstructed pavements, the location of "NO PASSING" zone lines shall be located in the field. The locations of the proposed "NO PASSING" zone lines shown on the pavement marking tabulation is for estimating quantities only.

03-26-96 254-1
An incident management plan, provided by the Transportation Center, will be discussed at the pre-construction conference.

09-27-94 261-2
Before performing earthwork, tiling, or excavation within 91.4 meters of an existing pipeline, the contractor shall notify the pipeline company and the pipeline company shall mark the location of the pipeline as required by Section 479.47 of the Code of Iowa. The contractor shall exercise all due caution when working in the vicinity of pipelines carrying combustible or toxic materials which are present on this project. Pipeline location shown on the plans represents the best information available at the time of plan preparation.

Profile grade for mainline paving is defined at the center of the lanes. The superelevation rotation point for mainline paving is the inside edge of lanes, with a constant drop from profile grade of 0.072 m.

NOTE:
The top 0.3m of roadway subgrade over a width of 17m(to within 0.5m of the subgrade hinge points at 6:1 foreslope) has been stabilized with fly ash products between the following stations:

- 34+00 to 42+00; Prairie Creek 'Ecostone' at 14% of dry soil weight
- 42+00 to 50+00; Prairie Creek Stoker Ash at 7% of dry soil weight
- 89+00 to 97+00; Prairie Creek 'Ecostone' at 14% of dry soil weight
- 97+00 to 105+00; Prairie Creek Stoker Ash at 7% of dry soil weight

TABULATION OF SILT FENCES			
		100-17 09-27-94	
LOCATION		LENGTH	REMARKS
STATION TO STATION	SIDE	m	
PLACEMENT			
Mainline			
81+90	83+60	LT	188
161+90	163+91.2	LT	225
130th Street			
1173+75	1174+75	LT	112
1173+75	1174+75	RT	112
X-28 Linn-Jones Road			
1452+55.6	1455+00	LT	490
1452+55.6	1455+00	RT	490
Co. Road X-40			
2131+59.8	2132+25	LT	131
2131+59.8	2132+25	RT	131
10% of Existing Silt Fence			
Total Silt Fence			2689
CLEANOUTS			
Placed by this contract			
50% of Existing Silt Fence			4030
Total Silt Fence Cleanouts			6719

LOCATIONS OF ROAD CLOSURE BARRICADES			
		102-4 10-03-00	
LOCATION		STANDARD ROAD PLAN	REMARKS
No.	Station	(W) meters	
1	187+30 East Bound Lane	RE-3A	

TABULATION OF EXISTING PAVEMENT							
		102-5 09-27-94					
NO.	LOCATION	EXISTING PAVEMENT Type	COARSE AGGREGATE		PAVEMENT THICKNESS mm	REINFORCEMENT Type	DETAIL TYPICAL
			GRAVEL	CRUSHED STONE			
US HWY. 151							
1	15+40 TO 25+37	PCC		X	SPRINGVILLE	I	254
1	15+40 TO 25+37	AAC		X	B. - SPRINGVILLE		51
2		AAC		X	ANAMOSA-VERNON		38
3		PC7			BELLEVUE	I	178
25+37 TO 52+09							
1		BSC					
2		AAC		X	B. - SPRINGVILLE		51
3		AAC		X	ANAMOSA-VERNON		38
4		PC7	X		BELLEVUE	I	178
52+09 TO 62+23							
1		BSC					
2		AAC		X	BOWSER-SPRINGVILLE		51
3		AAC		X	ANAMOSA-VERNON		38
4		AAC		X	BALLOU-OLIN		38
5		PC7	X	X	DUBUQUE	I	178
62+23 TO 75+75							
1		AAC		X	BOWSER-SPRINGVILLE		51
2		AAC		X	ANAMOSA-VERNON		38
3		AAC		X	BALLOU-OLIN		38
4		PC7	X	X	DUBUQUE	I	178
75+75 TO 179+23							
1		AAC		X	STONE CITY		38
2		AAC		X	ANAMOSA-VERNON		114
179+23 TO 201+60							
1		AAC		X	SAUSER	I	38
2		PCC		X	FARMERS-BEHRENS	I	254
IA. HWY. 1							
1	1571+50 TO 1575+30	AAC			STONE CITY		114
2		AAC		X	ANAMOSA-VERNON		38
3		AAC		X	BALLOU-OLIN		38
4		PC7	X	X	OTIS	I	191
IA. HWY. 64							
1	2157+88 TO 2161+50	AAC		X	ANAMOSA-VERNON		38

TABULATION OF SPECIAL EVENTS		
		102-15 09-27-94
EVENT	LOCATION	DATE
HILL CLIMBER'S COMPETITION	STA. 134+00 RT.	First Sunday in June and September

TABULATION OF SILT FENCES FOR DITCH CHECKS			
		100-18 09-27-94	
LOCATION STATION		SIDE	REMARKS
	m		
PLACEMENT			
Mainline			
82+10		LT	6
82+60		LT	6
83+20		LT	6
83+80		LT	6
Co. Road X-40			
2131+80		RT	6
2132+00			6
130th Street			
1173+80		LT	6
1174+70		LT	6
10% of Existing Silt Fence			140
Total			188
CLEAN OUTS			
Placed by this contract			
100% of Existing Silt Fence			1370
Total Silt Fence Clean Outs			1558

SIGN SCHEDULE						
						X-60 Modified
SIGN NO.	LOCATION, SIDE	MUTCD TYPE	SIZE (mm)	AREA (SQ. M)	100mm x 100mm Wood Posts (L.M.)	COMMENTS
1	178+66 EBL RT	W9-2F	1200x1200	1.44	10.97	Lane Ends Merge Left
2	179+66 EBL LT	W4-2B	1200x1200	1.44	10.97	Lane Ends
3	179+66 EBL RT	W4-2B	1200x1200	1.44	10.97	Lane Ends
4	181+96 EBL LT	W6-1B	1200x1200	1.44	10.97	Divided Highway
5	181+96 EBL LT	R5-9A	1000x700	0.70		Wrong Way
6	181+96 EBL RT	W6-1B	1200x1200	1.44	10.97	Divided Highway
7	181+96 EBL RT	R5-9A	1000x700	0.70		Wrong Way
8	185+25 CL	R5-1	750x750	0.56	4.30	Do Not Enter
9	185+75 CL	W6-3D	1200x1200	1.44	10.97	Two Way Traffic
10	185+75 CL	R5-1	750x750	0.56		Do Not Enter
11	187+80 WBL LT	W14-3	1200x1500x1500	0.82	4.88	No Passing Zone
12	191+18 WBL RT	W6-1B	1200x1200	1.44	10.97	Divided Highway
TOTALS				13.42	85.97	

POINTS OF ACCESS (RL-7)							
						102-1 03-26-96	
LOCATION (RL-7)		PIPE CULVERT (RF-30A or RF-30B)		SURFACE MATERIAL			
Station	Side	(W) TYPE	(H) Size	APRON No.	Mg		
			450 mm m				
			600 mm m				
Mainline							
18+14	LT	7.2 C	0.75	18.3	2	227	

PROPOSED SUBGRADE TREATMENT

103-3
MODIFIED

NO.	LOCATION	DESCRIPTION			TYPE	QUANTITY		POLYMER GRID m ²	AVAILABLE FROM		REMARKS
	Station to Station	Side	Depth	Width	Material + Shrink %	m ³	Mg		Quantity	Station to Station	
1	15+40 to 23+50		0.3	9.2	Special Backfill 4132						Includes Cross Over & Storage Lanes @ Sta. 18+14
2	51+00 to 53+50		0.3	9.2	Special Backfill 4132						Includes Cross Over & Storage Lanes @ Sta. 52+09
3	128+50 to 133+80		0.3	9.2	Special Backfill 4132						Includes Cross Over & Storage Lanes
4	1452+45 to 1455+00 X-28		0.3	9.2	Special Backfill 4132						
5	2131+48 to 2132+25 X-40		0.3	9.2	Special Backfill 4132						
TOTALS							13,804.73				

DRAINAGE STRUCTURE BY ROAD CONTRACTOR

104-3
10-03-00

* Not a bid item

LOCATION	TYPE	SIZE mm	KIND OF PIPE	LENGTH NEW CONST. m	BEDDING CLASS	DESIGN COVER (ft)	CAMBER %	APRON NO.		ADAPTORS* RF-2	CONNECTED PIPE JOINT* RF-14	FLOW LINE ELEVATIONS			DIMENSIONS m				SKEW AHEAD Degrees		DIKE			CLASS 20 m ³	EMBANKMENT IN PLACE m ³	REMARKS	
								Inlet	Outlet			Lt.	Rt.	Other	Total		Extensions		Lt.	Rt.	Rt.	Location Station	Top Elevation				Type
															Lt.	Rt.	Lt.	Rt.	Lt.	Rt.	Lt.	Rt.	Lt.				
183+20 EBL 184+009.8	1101 Med.	600	1000	20.12 1.8	C	0.8		1	1	3	6	278.190	277.990		10.02	13.83									50		Pipe Apron Guard ADDED FROM GRADING PROJECT
130th Street 1173+82.4	1101	750	1000	15.85	C	2.6		1	1	3	6	259.31	258.290		11.30	11.96			29						230		
98+003.9	1101 MED	600	1000	2.4																							ADDED TO EXISTING PIPE
181+000.5	1101 MED	600	1000	2.4																							ADDED TO EXISTING PIPE
															TOTAL							880					

- ① Refer to Standard Road Plan RF-38
- ② Not a Bid Item

TABULATION OF BRIDGE END DRAIN

104-8
02-11-00

LOCATION	Bridge Station	Bridge Corner	Distance DI-1 or DI-2 ①	SHOULDER ①		PCC m ²	Polymer Grid m ² ②	INSTALLATION INFORMATION					SPECIAL BACKFILL Mg ②	REMARKS
				Panels Required A B C or D				Elevation			Length			
								(A)	(B)	(C)	(L1)	(L2)		
76+39														
WBL	NW	10.5	B	14.31	16.68	290.081	290.051	288.301	282.523	2.78	24.7	16.9	(1) Sta. 76+07.5 Lt.	
EBL	SW	10.5	C/D	25.37	26.16	289.622	289.592	287.842	280.893	2.18	28.8	13.2	(1) Sta. 76+01.7 Rt.	
134+66														
EBL	SE	6.6	C	14.98	16.68	241.409	241.379	239.629	235.098	2.78	21.1	33.8	(1) Sta. 135+43.9 Rt.	
157+90														
WBL	NW	6.6	C	15.10	16.68	254.729	254.699	252.949	245.300	2.78	24.6	16.9	(1) Sta. 158+34.0 Lt.	
EBL	NE	9.8	B	12.76	13.08	254.824	254.794	253.044	247.150	2.18	28.1	13.2	(1) Sta. 158+27.2 Rt.	
TOTALS	5			82.53							127.3			
(1) Additional Polymer Grid and Granular Subbase Along Pavement Edges is Accounted for Under the Bridge Approach Tabulation.														

dgn = L:\WORK\PROJECT\39922\cadd\X40turn\X40c01.dgn
 levels = 1-3, 5-63
 pen table = 1:10plot\tables\halfwt.tbl

**TABULATION OF LONGITUDINAL SUBDRAIN
SHOULDER AND BACKSLOPE**

104-9
03-28-95

*Not a bid item

- ① Refer to Standard Road Plan RF-19C.
- ② Refer to Soils Sheets

Line No.	Road or Lane Ident.	LOCATION			Depth ① m	LONGITUDINAL SUBDRAIN				SUBDRAIN OUTLET RF-19E or RF-22		POROUS BACKFILL* Mg	CLASS "A" CRUSHED STONE * Mg	REMARKS
		Station to Station	Side	Shoulder ①		Backslope ②		Station	Type					
				Dia. mm		Length m	Dia. mm			Length m				
1	US 151	15+40	17+00	LT	1.1	100	168			15+40	E	72.7	0.9	
										17+00	E		0.9	
2	US 151	17+00	18+50	LT	1.1	100	159			17+00	E	68.6	0.9	
										18+50	E		0.9	
3	US 151	18+50	20+00	LT	1.1	100	160			18+50	E	68.6	0.9	
										20+00	E		0.9	
4	US 151	20+00	21+50	LT	1.1	100	160			20+00	E	68.6	0.9	
										21+50	E		0.9	
5	US 151	21+50	22+95	LT	1.1	100	156			21+50	E	68.6	0.9	
										22+95	E		0.9	
6	US 151	22+95	24+50	LT	1.1	100	165			22+95	E	68.6	0.9	
										24+50	E		0.9	
7	US 151	24+50	26+00	LT	1.1	100	159			24+50	E	68.6	0.9	
										26+00	E		0.9	
8	US 151	26+00	26+55	LT	1.1	100	66			26+00	E	28.8	0.9	
										26+55	E		0.9	
9	US 151	26+63	27+05	LT	1.1	100	52			26+63	E	16.3	0.9	
										27+05	E		0.9	
10	US 151	27+15	28+50	LT	1.1	100	145			27+15	E	62.3	0.9	
										28+50	E		0.9	
11	US 151	28+50	30+00	LT	1.1	100	160			28+50	E	68.6	0.9	
										30+00	E		0.9	
12	US 151	30+00	31+50	LT	1.1	100	160			30+00	E	68.6	0.9	
										31+50	E		0.9	
13	US 151	31+50	32+30	LT	1.1	100	91			31+50	E	39.3	0.9	
										32+30	E		0.9	
14	US 151	32+33	34+00	LT	1.1	100	179			32+33	E	72.7	0.9	
										34+00	E		0.9	
15	US 151	34+00	35+42	LT	1.1	100	152			34+00	E	64.4	0.9	
										35+42	E		0.9	
16	US 151	35+47	37+00	LT	1.1	100	163			35+47	E	68.6	0.9	
										37+00	E		0.9	
17	US 151	37+00	38+50	LT	1.1	100	160			37+00	E	68.6	0.9	
										38+50	E		0.9	
18	US 151	38+50	39+20	LT	1.1	100	81			38+50	E	35.1	0.9	
										39+20	E		0.9	
19	US 151	39+28	40+50	LT	1.1	100	133			39+28	E	56.0	0.9	
										40+50	E		0.9	
20	US 151	40+50	41+15	LT	1.1	100	75			40+50	E	33.0	0.9	
										41+15	E		0.9	
21	US 151	41+22	41+44	LT	1.1	100	33			41+22	E	16.3	0.9	
										41+44	E		0.9	
22	US 151	41+62	43+00	LT	1.1	100	148			41+62	E	62.3	0.9	
										43+00	E		0.9	
23	US 151	43+00	43+85	LT	1.1	100	95			43+00	E	39.3	0.9	
										43+85	E		0.9	
24	US 151	43+97	45+50	LT	1.1	100	170			43+97	E	72.7	0.9	
										45+50	E		0.9	
25	US 151	45+50	47+00	LT	1.1	100	161			45+50	E	68.6	0.9	
										47+00	E		0.9	
26	US 151	47+00	48+50	LT	1.1	100	161			47+00	E	68.6	0.9	
										48+50	E		0.9	
27	US 151	48+50	49+45	LT	1.1	100	108			48+50	E	41.4	0.9	
										49+45	E		0.9	
28	US 151	49+45	51+00	LT	1.1	100	166			49+45	E	70.6	0.9	
										51+00	E		0.9	
29	US 151	51+00	51+58	LT	1.1	100	68			51+00	E	26.8	0.9	
										51+58	E		0.9	
											E		0.9	
31	US 151	52+18	54+00	LT	1.1	100	190			52+18	E	58.1	0.9	
										54+00	E		0.9	
32	US 151	54+00	55+17	LT	1.1	100	127			54+00	E	53.9	0.9	
										55+17	E		0.9	
33	US 151	55+22	56+72	LT	1.1	100	158			55+22	E	68.6	0.9	
										56+72	E		0.9	
34	US 151	56+72	58+28	LT	1.1	100	166			56+72	E	68.6	0.9	
										58+28	E		0.9	
35	US 151	58+33	60+00	LT	1.1	100	175			58+33	E	74.8	0.9	
										60+00	E		0.9	
36	US 151	59+75	61+45	LT	1.1	100	180			59+75	E	76.9	0.9	
										61+45	E		0.9	

I hereby certify that this plan was prepared under my supervision and that engineering decisions with regard to the design were made by me or by other duly licensed Professional Engineers under the laws of the State of Iowa.

Robert L. Stanley

Signature Date

Printed or Typed Name

My license renewal date is December 31, 2000.

Pages or sheets covered by this seal: C.06-C.12

20-198

① Refer to Standard Road Plan RF-19C.
② Refer to Soils Sheets

**TABULATION OF LONGITUDINAL SUBDRAIN
SHOULDER AND BACKSLOPE**

*Not a bid item

Line No.	Road or Lane Ident.	LOCATION			LONGITUDINAL SUBDRAIN				SUBDRAIN OUTLET RF-19E or RF-22		POROUS BACKFILL*	CLASS "A" CRUSHED STONE *	REMARKS	
		Station to Station		Side	Depth (D) m	Shoulder ①		Backslope ②		Station				Type
						Dia. mm	Length m	Dia. mm	Length m		Mg	Mg		
37	US 151	61+46	63+00	LT	1.1	100	169			2 @ 61+46 63+00	E	66.5	0.9	
38	US 151	63+00	64+53	LT	1.1	100	162			2 @ 63+00 64+53	E	70.6	0.9	
39	US 151	72+05	73+50	LT	1.1	100	153			2 @ 72+05 73+50	E	68.6	0.9	
40	US 151	73+50	75+85	LT	1.1	100	253			2 @ 73+50 75+85	E	104.1	0.9	
41	US 151	77+05	78+50	LT	1.1	100	158			2 @ 77+05 78+50	E	72.7	0.9	
42	US 151	78+50	80+00	LT	1.1	100	163			2 @ 78+50 80+00	E	68.6	0.9	
43	US 151	80+00	81+80	LT	1.1	100	194			2 @ 80+00 81+80	E	79.0	0.9	OUTLET THRU RAMP AT STA. 81+75.
44	US 151	81+80	83+00	LT	1.1	100	120			2 @ 81+80 83+00	E	68.6	0.9	ALONG RAMP TAPER.
45	US 151	83+00	84+50	LT	1.1	100	150			2 @ 83+00 84+50	E	58.1	0.9	ALONG RAMP TAPER.
46	US 151	84+50	85+84	LT	1.1	100	134			2 @ 84+50 85+84	E	60.2	0.9	START PRESENT ROADWAY.
47	US 151	85+84	87+55	LT	1.1	100	185			2 @ 85+84 87+55	E	76.9	0.9	
48	US 151	87+55	89+00	LT	1.1	100	153			2 @ 87+55 89+00	E	68.6	0.9	
49	US 151	89+00	90+52	LT	0.6	100	156			2 @ 89+00 90+52	E	32.5	0.9	
50	US 151	90+52	92+03	LT	0.6	100	155			2 @ 90+52 92+03	E	32.5	0.9	
51	US 151	92+03	93+10	LT	0.6	100	113			2 @ 92+03 93+10	E	22.6	0.9	
52	US 151	93+10	94+60	LT	1.1	100	156			2 @ 93+10 94+60	E	68.6	0.9	
52-A		94+60	95+14	LT	1.1	100	57			2 @ 94+60 95+14	E	68.6	0.9	
53	US 151	95+28	96+70	LT	1.1	100	153			2 @ 95+28 96+70	E	68.6	0.9	SKEWED OUTLET
54	US 151	96+70	98+00	LT	1.1	100	132			2 @ 96+70 98+00	E	68.6	0.9	
55	US 151	98+25	98+94	LT	1.1	100	76			2 @ 98+25 98+94	E	68.6	0.9	SKEWED OUTLET
56	US 151	98+94	100+45	LT	1.1	100	155			2 @ 98+94 100+45	E	68.6	0.9	
57	US 151	100+45	101+94	LT	1.1	100	153			2 @ 100+45 101+94	E	68.6	0.9	
58	US 151	101+94	103+45	LT	1.1	100	157			2 @ 101+94 103+45	E	68.6	0.9	
59	US 151	103+45	103+86	LT	1.1	100	57			2 @ 103+45 103+86	E	22.6	0.9	
60	US 151	103+86	104+82	LT	1.1	100	118			2 @ 103+86 104+82	E	72.7	0.9	
61	US 151	105+33	106+95	LT	1.1	100	170			2 @ 105+33 106+95	E	68.6	0.9	
62	US 151	106+95	108+47	LT	1.1	100	156			2 @ 106+95 108+47	E	68.6	0.9	
63	US 151	108+47	109+31	LT	1.1	100	86			2 @ 108+47 109+31	E	68.6	0.9	
64	US 151	109+54	111+40	LT	1.1	100	197			2 @ 109+54 111+40	E	68.6	0.9	
65	US 151	111+40	112+90	LT	1.1	100	160			2 @ 111+40 112+90	E	68.6	0.9	
66	US 151	112+90	113+77	LT	1.1	100	93			2 @ 112+90 113+77	E	68.6	0.9	
67	US 151	114+20	115+74	LT	1.1	100	164			2 @ 114+20 115+74	E	56.0	0.9	
68	US 151	115+74	117+23	LT	1.1	100	153			2 @ 115+74 117+23	E	56.0	0.9	
69	US 151	117+68	118+39	LT	1.1	100	75			2 @ 117+68 118+39	E	68.6	0.9	
70	US 151	118+39	119+93	LT	1.1	100	163			2 @ 118+39 119+93	E	68.6	0.9	
71	US 151	119+93	121+44	LT	1.1	100	157			2 @ 119+93 121+44	E	68.6	0.9	
72	US 151	121+44	122+95	LT	1.1	100	165			2 @ 121+44 122+95	E	68.6	0.9	

- ① Refer to Standard Road Plan RF-19C.
- ② Refer to Soils Sheets

TABULATION OF LONGITUDINAL SUBDRAIN SHOULDER AND BACKSLOPE

104-9
03-28-95

*Not a bid item

Line No.	Road or Lane Ident.	LOCATION				Side	LONGITUDINAL SUBDRAIN				SUBDRAIN OUTLET RF-19E or RF-22		POROUS BACKFILL* Mg	CLASS "A" CRUSHED STONE * Mg	REMARKS
		Station to Station		Depth Ⓣ m	Shoulder ①		Backslope ②		Station	Type					
					Dia. mm		Length m	Dia. mm			Length m				
73	US 151	201	122+95	124+36	LT	1.1	100	145			122+95	E	68.6	0.9	
74	US 151	202	124+36	125+98	LT	1.1	100	170			2 @ 124+36	E	68.6	0.9	
75	US 151	203	125+98	127+63	LT	1.1	100	171			2 @ 125+98	E	68.6	0.9	
76	US 151	204	128+00	129+02	LT	1.1	100	108			127+63 128+00	E	68.6	0.9	
77	US 151	205	129+02	130+54	LT	1.1	100	152			2 @ 129+02	E	68.6	0.9	
78	US 151	206	130+54	131+59	LT	1.1	100	120			2 @ 130+54	E	68.6	0.9	
78-A		207	131+68	132+25				60			131+68	E	68.6	0.9	DEPTH = 0.76M
79	US 151	208	132+25	133+30	LT	1.1	100	111			2 @ 132+25	E	68.6	0.9	DEPTH = 0.76M
80	US 151	209	135+40	135+96	LT	1.1	100	60			133+30 135+40	E	20.5	0.9	
81	US 151	210	135+96	137+31	LT	1.1	100	144			2 @ 135+96	E	76.9	0.9	
82	US 151	211	137+87	138+85	LT	1.1	100	104			137+31 137+87	E	68.6	0.9	
83	US 151	212	138+85	140+21	LT	1.1	100	136			2 @ 138+85	E	68.6	0.9	
84	US 151	213	140+21	141+89	LT	1.1	100	182			2 @ 140+21	E	68.6	0.9	
85	US 151	214	141+89	143+41	LT	1.1	100	152			2 @ 141+89	E	68.6	0.9	
86	US 151	215	143+41	144+95	LT	1.1	100	162				E	68.6	0.9	
87	US 151	216	144+95	146+14	LT	1.1	100	117			2 @ 144+95	E	68.6	0.9	
88	US 151	217	146+14	147+70	LT	1.1	100	167			2 @ 146+14	E	68.6	0.9	
89	US 151	218	147+70	149+48	LT	1.1	100	186			2 @ 147+70	E	68.6	0.9	
90	US 151	219	149+48	150+00	LT	1.1	100	56			2 @ 149+48	E	68.6	0.9	
91	US 151	220	154+40	155+30	LT	1.1	100	99			150+00	E	47.7	0.9	
92	US 151	221	155+30	156+80	LT	1.1	100	163			2 @ 155+30	E	68.6	0.9	
93	US 151	222	156+80	157+45	LT	1.1	100	72			2 @ 156+80	E	33.0	0.9	
94	US 151	223	158+44	160+00	LT	1.1	100	170			157+45 158+44	E	71.1	0.9	
95	US 151	224	160+00	161+40	LT	1.1	100	152			2 @ 160+00	E	68.6	0.9	
96	US 151	225	161+91	163+50	LT	1.1	100	159			161+40 161+91	E	47.7	0.9	
97	US 151	226	163+50	163+85	LT	1.1	100	35			2 @ 163+50	E	62.3	0.9	ALONG RAMP TAPER.
98	US 151	227	164+05	165+50	LT	1.1	100	145			163+85 164+05 165+50	E	66.5	0.9	

① Refer to Standard Road Plan RF-19C.
 ② Refer to Soils Sheets

TABULATION OF LONGITUDINAL SUBDRAIN SHOULDER AND BACKSLOPE

104-9
 03-28-95
 *Not a bid item

Line No.	Road or Lane Ident.	LOCATION		Side	LONGITUDINAL SUBDRAIN				SUBDRAIN OUTLET RF-19E or RF-22		POROUS BACKFILL*	CLASS "A" CRUSHED STONE *	REMARKS	
		Station to Station	Depth ⓓ m		Shoulder ①		Backslope ②		Station	Type				
					Dia. mm	Length m	Dia. mm	Length m			Mg	Mg		
117	US 151	140	20+66	22+00	RT	0.6	100	141		20+66	E	32.5	0.9	
118	US 151	149	22+00	23+50	RT	0.6	100	164		2 @ 22+00	E	32.5	0.9	
119	US 151	150	23+50	24+00	RT	0.6	100	59		2 @ 23+50	E	12.7	0.9	
120	US 151	151	24+00	25+50	RT	0.6	100	150		2 @ 24+00	E	32.5	0.9	
121	US 151	152	25+50	26+75	RT	0.6	100	132		2 @ 25+50	E	26.5	0.9	
122	US 151	153	26+75	28+00	RT	0.6	100	133		2 @ 26+75	E	27.5	0.9	
123	US 151	154	28+00	29+50	RT	0.6	100	158		2 @ 28+00	E	32.5	0.9	
124	US 151	155	29+50	31+00	RT	0.6	100	145		2 @ 29+50	E	32.5	0.9	
125	US 151	156	31+00	32+50	RT	0.6	100	161		2 @ 31+00	E	32.5	0.9	
126	US 151	157	32+50	34+00	RT	1.1	100	155		2 @ 32+50	E	68.6	0.9	
127	US 151	158	34+00	34+97	RT	1.1	100	162		2 @ 34+00 34+97	E	68.6	0.9	
128	US 151	159	35+31	37+00	RT	0.6	100	171		35+31	E	32.5	0.9	
129	US 151	160	37+00	38+50	RT	0.6	100	154		2 @ 37+00	E	32.5	0.9	
130	US 151	161	38+50	40+00	RT	1.1	100	154		2 @ 38+50	E	68.6	0.9	
131	US 151	162	40+00	41+53	RT	1.1	100	160		2 @ 40+00	E	67.7	0.9	
132	US 151	163	41+53	43+00	RT	1.1	100	156		2 @ 41+53	E	67.3	0.9	
133	US 151	164	43+00	44+50	RT	1.1	100	158		2 @ 43+00	E	68.6	0.9	
134	US 151	165	44+50	45+90	RT	1.1	100	141		2 @ 44+50	E	64.4	0.9	
135	US 151	166	45+90	47+85	RT	1.1	100	201		2 @ 45+90 47+85	E	72.7	0.9	
136	US 151	167	47+91	48+89	RT	1.1	100	110		47+91	E	68.6	0.9	
137	US 151	168	48+89	50+50	RT	1.1	100	162		2 @ 48+89	E	68.6	0.9	
138	US 151	169	50+50	51+74	RT	1.1	100	128		2 @ 50+50 51+74	E	64.4	0.9	
139	US 151	170	52+24	53+50	RT	1.1	100	130		52+24	E	72.7	0.9	
140	US 151	171	53+50	55+00	RT	1.1	100	160		2 @ 53+50	E	68.6	0.9	
141	US 151	172	55+00	56+50	RT	1.1	100	147		2 @ 55+00 56+50	E	68.6	0.9	
142	US 151	173	60+10	61+55	RT	1.1	100	150		60+10 61+55	E	64.4	0.9	
143	US 151	174	61+81	63+00	RT	1.1	100	125		61+81	E	68.6	0.9	
144	US 151	175	63+00	64+50	RT	1.1	100	159		2 @ 63+00 64+50	E	68.6	0.9	

① Refer to Standard Road Plan RF-19C.
 ② Refer to Soils Sheets

**TABULATION OF LONGITUDINAL SUBDRAIN
 SHOULDER AND BACKSLOPE**

104-9
 03-28-95
 *Not a bid item

Line No.	Road or Lane Ident.	LOCATION			LONGITUDINAL SUBDRAIN				SUBDRAIN OUTLET RF-19E or RF-22		POROUS BACKFILL*	CLASS "A" CRUSHED STONE *	REMARKS	
		Station to Station	Side	Depth (D) m	Shoulder ①		Backslope ②		Station	Type				
					Dia. mm	Length m	Dia. mm	Length m			Mg	Mg		
145	US 151	176	64+50	65+67	RT	1.1	100	128						
									2 @ 64+50	E	56.0	0.9		
									2 @ 65+57	E		0.9		
146	US 151	177	65+67	67+25	RT	1.1	100	169						AT STA. 66+75 BEGIN NEW CONSTRUCTION N.B. LANE
									2 @ 67+25	E	68.6	0.9		
									68+15	E	43.5	0.9		
147	US 151	178	67+25	68+15	RT	1.1	100	99						
									68+20	E	60.2	0.9		
148	US 151	135	68+20	69+50	RT	1.1	100	141						
									2 @ 69+50	E	68.6	0.9		
149	US 151	134	69+50	71+00	RT	1.1	100	161						
									2 @ 71+00	E	68.6	0.9		
150	US 151	133	71+00	72+50	RT	1.1	100	162						
									2 @ 72+50	E	68.6	0.9		
151	US 151	132	72+50	74+00	RT	1.1	100	163						
									2 @ 74+00	E	83.2	0.9		
152	US 151	131	74+00	75+50	RT	1.1	100	168						
									75+50	E	72.7	0.9		
153	US 151	179	76+82	78+50	RT	1.1	100	177						
									2 @ 78+50	E	72.7	0.9		
154	US 151	173	78+50	79+50	RT	1.1	100	113						
									79+50	E		0.9		
155	US 151	174	80+10	81+50	RT	1.1	100	150						ALONG RAMP TAPER.
									80+10	E	64.4	0.9		
156	US 151	175	81+50	83+00	RT	1.1	100	170						ALONG RAMP TAPER.
									2 @ 81+50	E	68.6	0.9		
157	US 151	176	83+00	84+50	RT	1.1	100	182						
									2 @ 83+00	E	68.6	0.9		
158	US 151	177	84+50	85+30	RT	1.1	100	94						
									85+30	E	39.3	0.9		
159	US 151	71	85+30	86+80	RT	1.1	100	165						
									2 @ 86+80	E	68.6	0.9		
160	US 151	70	86+80	88+50	RT	1.1	100	181						
									2 @ 88+50	E	76.9	0.9		
161	US 151	69	88+50	90+13	RT	1.1	100	175						
									90+13	E	68.6	0.9		
162	US 151	68	90+18	91+50	RT	1.1	100	165						
									90+18	E	68.6	0.9		
163	US 151	67	91+50	93+00	RT	1.1	100	163						
									2 @ 91+50	E	68.6	0.9		
164	US 151	66	93+00	94+50	RT	1.1	100	164						
									2 @ 93+00	E	68.6	0.9		
									2 @ 94+50	E		0.9		
165	US 151	65	94+50	95+00	RT	1.1	100	64						
165 A	US 151	64	95+05	96+00	RT	1.1	100	106						
166	US 151	63	96+00	97+50	RT	1.1	100	163						
									2 @ 95+05	E	68.6	0.9		
									2 @ 96+00	E		0.9		
167	US 151	62	97+50	99+00	RT	1.1	100	162						
									2 @ 97+50	E	68.6	0.9		
168	US 151	61	99+00	100+50	RT	1.1	100	163						
									2 @ 99+00	E	68.6	0.9		
169	US 151	60	100+50	102+00	RT	1.1	100	165						
									2 @ 100+50	E	68.6	0.9		
170	US 151	59	102+00	103+50	RT	1.1	100	165						
									2 @ 102+00	E	68.6	0.9		
171	US 151	58	103+50	103+80	RT	1.1	100	43						
									2 @ 103+80	E	18.4	0.9		
172	US 151	57	103+80	105+50	RT	1.1	100	186						
									2 @ 105+50	E	76.9	0.9		
173	US 151	56	105+50	107+00	RT	1.1	100	158						
									2 @ 107+00	E	66.5	0.9		
174	US 151	55	107+00	107+50	RT	1.1	100	56						
									2 @ 107+50	E	25.5	0.9		
175	US 151	54	107+53	109+00	RT	1.1	100	142						
									107+53	E	67.3	0.9		
176	US 151	53	109+00	109+50	RT	1.1	100	63						
									2 @ 109+00	E	30.9	0.9		
177	US 151	52	109+50	111+00	RT	1.1	100	137						
									2 @ 109+50	E	63.1	0.9		
178	US 151	51	111+00	112+50	RT	1.1	100	147						
									2 @ 111+00	E	68.6	0.9		
179	US 151	50	112+25	113+50	RT	1.1	100	136						
									112+50	E	58.1	0.9		
180	US 151	49	113+50	114+95	RT	1.1	100	151						
									2 @ 113+50	E	68.6	0.9		
									114+95	E		0.9		

- ① Refer to Standard Road Plan RF-19C.
- ② Refer to Soils Sheets

**TABULATION OF LONGITUDINAL SUBDRAIN
SHOULDER AND BACKSLOPE**

104-9
03-28-95

*Not a bid item

Line No.	Road or Lane Ident.	LOCATION			Side	LONGITUDINAL SUBDRAIN				SUBDRAIN OUTLET RF-19E or RF-22		POROUS BACKFILL* Mg	CLASS "A" CRUSHED STONE * Mg	REMARKS
		Station to Station	Depth (D) m	Shoulder ①		Backslope ②		Station	Type					
				Dia. mm		Length m	Dia. mm			Length m				
181	US 151	114+95	115+80	RT	1.1	100	95			114+95	E	35.9	0.9	
182	US 151	115+80	117+00	RT	1.1	100	133			a @ 115+80	E	57.3	0.9	
183	US 151	117+00	118+50	RT	1.1	100	162			a @ 117+00	E	68.6	0.9	
184	US 151	118+50	120+00	RT	1.1	100	161			a @ 118+50	E	68.6	0.9	
185	US 151	120+00	121+50	RT	1.1	100	162			a @ 120+00	E	68.6	0.9	
186	US 151	121+50	123+00	RT	1.1	100	162			a @ 121+50	E	68.6	0.9	
187	US 151	123+00	124+50	RT	1.1	100	161			a @ 123+00	E	68.6	0.9	
188	US 151	124+50	126+00	RT	1.1	100	162			a @ 124+50	E	68.6	0.9	
189	US 151	126+00	127+45	RT	1.1	100	155			a @ 126+00	E	76.9	0.9	
190	US 151			RT	1.1	100				127+45	E	10.0	0.9	
191	US 151	127+50	129+00	RT	1.1	100	155			127+50	E	62.3	0.9	MEDIAN SIDE.
192	US 151	129+00	130+50	RT	1.1	100	162			a @ 129+00	E	68.6	0.9	MEDIAN SIDE.
193	US 151	130+50	131+00	RT	1.1	100	56			a @ 130+50	E	28.8	0.9	MEDIAN SIDE.
194	US 151			RT	1.1	100				131+00	E	41.4	0.9	MEDIAN SIDE.
195	US 151	131+82	133+00	RT	1.1	100	144			131+82	E	58.1	0.9	
196	US 151	133+00	133+74	RT	1.1	100	94			a @ 133+00	E	39.3	0.9	
197	US 151	135+58	136+30	RT	1.1	100	91			133+74	E		0.9	
198	US 151	136+30	138+00	RT	1.1	100	193			135+58	E	35.9	0.9	
199	US 151	138+00	138+92	RT	1.1	100	169			a @ 136+30	E	76.9	0.9	
200	US 151	138+75	140+25	RT	MED 0.6	100	162			a @ 138+00	E	47.7	0.9	
201	US 151	140+25	141+55	RT	MED 0.6	100	140			138+92	E	32.5	0.9	MEDIAN SIDE.
202	US 151	141+60	143+05	RT	MED 0.6	100	149			138+75	E		0.9	
203	US 151	142+75	144+25	RT	1.1	100	165			a @ 140+25	E	32.5	0.9	MEDIAN SIDE.
204	US 151	144+25	145+75	RT	1.1	100	163			141+55	E	27.5	0.9	MEDIAN SIDE.
205	US 151	145+75	147+25	RT	1.1	100	159			141+60	E		0.9	
206	US 151	147+25	147+77	RT	1.1	100	59			143+05	E	68.6	0.9	
207	US 151	148+75	148+89	RT	1.1	100	30			142+75	E		0.9	
208	US 151	150+25	151+75	RT	1.1	100	163			a @ 144+25	E	68.6	0.9	
209	US 151	151+75	152+95	RT	1.1	100	137			a @ 145+75	E	68.6	0.9	
210	US 151	153+00	154+50	RT	1.1	100	157			a @ 147+25	E	68.6	0.9	
211	US 151	154+50	155+30	RT	1.1	100	94			a @ 147+77	E	68.6	0.9	
212	US 151	155+30	156+55	RT	1.1	100	131			a @ 148+75	E	68.6	0.9	
213	US 151	156+92	157+33	RT	1.1	100	49			a @ 149+05	E		0.9	
214	US 151	158+45	159+95	RT	1.1	100	165			a @ 150+25	E	68.6	0.9	ALONG RAMP TAPER.
215	US 151	160+00	161+49	RT	1.1	100	162			E	56.0	0.9	ALONG RAMP TAPER.	
216	US 151	161+49	162+00	RT	1.1	100	65			E	70.6	0.9	OUTLET ACROSS RAMP AT STA. 152+95.	
										a @ 154+50	E	39.3	0.9	
										a @ 155+30	E		0.9	
										E	58.1	0.9		
										156+92	E	38.0	0.9	OUTLET ACROSS RAMP AT STA. 156+55.
										157+33	E		0.9	ALONG LOOP TAPER.
										158+45	E	75.7	0.9	ALONG COLLECTOR LANE.
										159+95	E		0.9	
										160+00	E	68.6	0.9	ALONG COLLECTOR LANE.
										E		0.9		
										a @ 161+49	E	26.8	0.9	
										162+00	E		0.9	

① Refer to Standard Road Plan RF-19C.
 ② Refer to Soils Sheets

**TABULATION OF LONGITUDINAL SUBDRAIN
 SHOULDER AND BACKSLOPE**

104-9
 03-28-95
 *Not a bid item

Line No.	Road or Lane Ident.	LOCATION		Side	Depth (D) m	LONGITUDINAL SUBDRAIN		SUBDRAIN OUTLET RF-19E or RF-22		POROUS BACKFILL* Mg	CLASS "A" CRUSHED STONE * Mg	REMARKS			
		Station	to Station			Shoulder ①		Backslope ②					Station	Type	
						Dia. mm	Length m	Dia. mm	Length m						
217	US 151	3	162+00	163+49	RT	1.1	100	163		162+00	E	68.6	0.9		
218	US 151	4	163+49	164+13	RT	1.1	100	74		2 @ 163+49	E	20.5	0.9		
219	US 151	5	164+35	165+49	RT	1.1	100	139		164+13 164+35	E	66.5	0.9		
220	US 151	6	165+49	167+00	RT	1.1	100	162		2 @ 165+49	E	68.6	0.9		
221	US 151	7	167+00	168+50	RT	1.1	100	160		2 @ 167+00	E	68.6	0.9		
222	US 151	8	168+50	169+99	RT	1.1	100	157		2 @ 168+50	E	68.6	0.9		
223	US 151	9	169+99	171+49	RT	1.1	100	161		2 @ 169+99	E	68.6	0.9		
224	US 151	10	171+49	173+00	RT	1.1	100	140		2 @ 171+49	E	68.6	0.9		
225	US 151	11	173+82	174+55	RT	1.1	100	86		173+00 173+82	E	68.6	0.9		
226	US 151	12	174+55	176+00	RT	1.1	100	155		2 @ 174+55	E	68.6	0.9		
227	US 151	13	176+00	177+54	RT	1.1	100	162		2 @ 176+00	E	68.6	0.9		
228	US 151	14	177+54	178+54	RT	1.1	100	118		2 @ 177+54	E	68.6	0.9		
229	US 151	15	178+75	180+50	RT	1.1	100	192		178+54 178+75	E	68.6	0.9		
230	US 151	16	180+50	182+00	RT	1.1	100	168		2 @ 180+50	E	68.6	0.9		
231	US 151	17	182+00	183+20	RT	1.1	100	137		2 @ 182+00	E	68.6	0.9		
232	US 151	18	183+25	185+00	RT	1.1	100	194		183+20 183+25	E	68.6	0.9		
233	US 151	19	185+00	186+50	RT	1.1	100	172		2 @ 185+00	E	68.6	0.9		
234	US 151	20	186+50	187+00	RT	1.1	100	65		2 @ 186+50	E	37.2	0.9		
235	LOOP B	180	2076+72	2078+25	RT	1.1	100	169		187+00 2076+72	E	68.6	0.9	LOOP B AT IA 1.	
236	LOOP B	136	2078+25	2079+25	RT	1.1	100	110		2078+25 2079+25	E	47.7	0.9		
237	LOOP B	137	2079+25	2080+45	RT	1.1	100	116		2 @ 2079+25	E	56.0	0.9		
238	RAMP C	138	3074+90	3076+00	RT	1.1	100	117		2080+45	E	51.8	0.9	RAMP C AT IA 1.	
239	RAMP C	139	3076+60	3077+50	LT	1.1	100	94		3074+90 3076+00 3076+60	E	68.6	0.9		
240	RAMP C	140	3077+50	3078+25	LT	1.1	100	84		2 @ 3077+50	E	37.2	0.9		
241	RAMP C	141	3078+00	3079+50	RT	1.1	100	163		3078+25 3078+00	E	68.6	0.9		
242	RAMP C	142	3079+50	3080+10	RT	1.1	100	72		2 @ 3079+50	E	30.9	0.9		
243	RAMP B	113	6152+95	6154+50	RT	1.1	100	168		3080+10 6152+95	E	68.6	0.9	RAMP B AT IA 64.	
244	RAMP B	114	6154+50	6155+30	LT	1.1	100	88		2 @ 6154+50	E	30.9	0.9		
245	RAMP B	115	6155+30	6156+00	RT	1.1	100	76		2 @ 6155+30	E	43.5	0.9		
246	RAMP B	116	6156+64	6157+33	RT	1.1	100	75		6156+00	E	10.0	0.9	AROUND RETURN.	
247	LOOP C	117	7154+20	7155+00	RT	1.1	100	186		6156+64 6157+33	E	70.6	0.9		
247	LOOP C	118	7155+00	7156+57	RT	1.1	100	169		7154+20	E	70.6	0.9	LOOP C AT IA 64.	
		119	7156+57	7156+85	RT	1.1	100	38		2 @ 7155+00 7156+57	E	70.6	0.9		
TOTALS :											14677.4				

POLLUTION PREVENTION PLAN

110-12
09-27-94

All contractors / subcontractors shall conduct their operations in a manner that minimizes erosion and prevents sediments from leaving the highway right-of-way. The prime contractor shall be responsible for compliance and implementation of the Pollution Prevention Plan (PPP) for their entire contract. This responsibility shall be further shared with subcontractors whose work is a source of potential pollution as defined in this PPP.

1. SITE DESCRIPTION

This Pollution Prevention Plan (PPP) is for the construction on the four-lane improvement of U.S. 151 from the existing four-lane highway east of Springville to north of Anamosa.

This PPP covers approximately 200 hectares with an estimated 122 hectares being disturbed.

The project is located in an area of 3 soil associations (Fayette, Dinsdale-Tama, Kenyon-Floyd-Clyde). The estimated average SCS runoff curve number for this PPP after completion will be 66.3.

Refer to the grading plans (Linn and Jones counties, NHSX-151-3(102)--3H-57 and NHSX-151-4(63)--3H-53) for locations of typical slopes, ditch grades, and major structural and non-structural controls. A copy of this plan will be on file at the project engineer's office. Runoff from this project will flow into various unnamed ditches and waterways, Dutch Creek and Fawn Creek which flow into the Wapsipinicon River and East Big Creek which flows into the Cedar River.

POTENTIAL SOURCES OF POLLUTION:
Site sources of pollution generated as a result of this work relate to silts and sediment which may be transported as a result of a storm event. However, this PPP provides conveyance for other (non-project related) operations. These other operations have storm water runoff, the regulation of which is beyond the control of this PPP. Potentially this runoff can contain various pollutants related to site-specific land uses. Examples are:

Rural Agricultural Activities:
Runoff from agricultural land use can potentially contain chemicals including herbicides, pesticides, fungicides and fertilizers.

Commercial and Industrial Activities:
Runoff from commercial, industrial, and commerce land use may contain constituents associated with the specific operation. Such operations are subject to potential leaks and spills which could be commingled with runoff from the facility. Pollutants associated with commercial and industrial activities are not readily available since they are typically proprietary.

POLLUTION PREVENTION PLAN

110-12
09-27-94

2. CONTROLS

Prior to beginning grading, excavation or clearing and grubbing operations, silt fence shall be placed along the perimeter of the areas to be disturbed at locations where runoff can move offsite. Vegetation in areas not needed for construction shall be preserved. As areas reach their final grade, additional silt fences, silt basins, intercepting ditches, sod flumes, letdowns, bridge end drains, and earth dikes shall be installed as specified in the plans and/or as required by the project engineer. This will include using silt fence as ditch checks and to protect intakes. Temporary stabilizing seeding shall be completed as the disturbed areas are constructed. If construction activity is not planned to occur in a disturbed area for at least 21 days, the area shall be stabilized by temporary seeding or mulching within 14 days. No more than 70,000 square meters of exposed erodible area is allowed in any one grading spread without permission of the project engineer. Other stabilizing methods shall be used outside the seeding period.

This work shall be done in accordance with Section 2525 of the Standard Specification. If the work involved is not applicable to any contract items, the work shall be paid for according to Article 1109.03 paragraph B.

As the work progresses, additional erosion control items such as sod flumes, ditch checks, rock outlet protection, and letdown structures and other appropriate measures shall be installed by the grading contractors as determined by the engineer after field investigation. The construction will be completed with the establishment of permanent perennial vegetation of all disturbed areas by the grading contractors.

3. OTHER CONTROLS

Contractor disposal of unused construction materials and construction material wastes shall comply with applicable state and local waste disposal, sanitary sewer, or septic system regulations. In the event of a conflict with other governmental laws, rules and regulations, the more restrictive laws, rules or regulations shall apply.

APPROVED STATE OR LOCAL PLANS:
During the course of this construction, it is possible that situations will arise where unknown materials will be encountered. When such situations are encountered, they will be handled according to all federal, state, and local regulations in effect at the time.

4. MAINTENANCE

The contractor is required to maintain all temporary erosion control measures in proper working order, including cleaning, repairing or replacing them throughout the contract period. Cleaning of silt control devices shall begin when the features have lost 50% of their capacity.

POLLUTION PREVENTION PLAN

110-12
09-27-94

5. INSPECTIONS

Inspections shall be made jointly by the contractor and the contracting authority every seven calendar days and after each rain event that is 13mm or greater. The contractor shall immediately begin corrective action on all deficiencies found. The findings of this inspection shall be recorded in the project diary. This PPP may be revised based on the findings of the inspection. The contractor shall implement all revisions. All corrective actions shall be completed within 3 calendar days of the inspection.

6. NON-STORM DISCHARGES

This includes subsurface drains (i.e. longitudinal and standard subdrains), slope drains and bridge end drains. The velocity of the discharge from these features may be controlled by the use of patio blocks, Class A stone or erosion stone.

TABULATION OF NEW PAVEMENT

X-50
06-03-99

ROAD IDENTIFICATION	STATION TO STATION		TYPE (mm)	AREA (m2)	GRANULAR SUBBASE		MODIFIED SUBBASE		REMARKS
					(under roadway) (m2)	(under shoulder) (m2)	(under roadway) (m3)	(under shoulder) (m3)	
Mainline WBL	15+40	23+00	260 PCC	5925	5925	1413.71	---	---	Stage II
	23+00	64+50	260 PCC	32425	32425	7927.64	---	---	Stage I
	72+00	75+95	260 PCC	3090	3090	791.62	---	---	Stage I
	77+00	82+50	260 PCC	4290	4290	1054.33	---	---	Stage I
	82+50	84+00	260 PCC	1295	1295	204.60	---	---	Stage II (includes Ramp D gore area)
	83+00	84+00	260 PCC	695	695	99.74	---	---	Stage III (Ramp D taper area)
	154+50	157+42	260 PCC	2180	2180	584.00	---	---	Stage I
	158+46	162+00	260 PCC	2640	2640	712.48	---	---	Stage I
	162+00	164+00	260 PCC	1530	1530	205.98	---	---	Stage II (includes Ramp D gore area)
	163+00	164+00	260 PCC	945	945	101.44	---	---	Stage III (Ramp D taper area)
	173+20	175+80	260 PCC	1120	1120	307.27	---	---	Stage II (right turn lane)
Mainline EBL	21+00	24+00	260 PCC	1175	1175	299.39	---	---	Stage IV (Lt. lane)
	21+00	24+00	260 PCC	1175	1175	298.85	---	---	Stage IV (Rt. lane)
	67+95	75+75	260 PCC	6080	6080	1411.19	---	---	Stage I
	76+85	133+78	260 PCC	44535	44535	10177.49	---	---	Stage I
	135+55	157+35	260 PCC	17198	17198	4098.99	---	---	Stage I
	158+39	187+25	260 PCC	22450	22450	5356.90	---	---	Stage I
Median Crossovers	18+14		260 PCC	1115	1115	220.44	---	---	Stage I
	35+22		260 PCC	850	850	186.60	---	---	Stage I
	39+46		260 PCC	810	810	194.14	---	---	Stage I
	52+10		260 PCC	1470	1470	351.46	---	---	Stage I
	64+75		260 PCC	1000	1000	258.87	---	---	Stage I
	86+97		260 PCC	1110	1110	276.01	---	---	Stage I
	98+18		260 PCC				---	---	Stage I
	105+15		260 PCC	1340	1340	302.83	---	---	Stage I
	114+03		260 PCC	685	685	174.73	---	---	Stage I
	117+37		260 PCC	1350	1350	280.45	---	---	Stage I
	131+32		260 PCC	1150	1150	189.31	---	---	Stage I
	137+62		260 PCC	1210	1210	276.64	---	---	Stage I
	173+19		260 PCC	1270	1270	295.03	---	---	Stage I
	180+74		260 PCC	820	820	194.33	---	---	Stage I
Ramps / Loops	4083+62	4084+00	260 PCC						
	2076+75	2079+40	260 PCC	2215	137.50	49.74	194.75	81.94	Stage I (IA 1B) - includes ramp taper
	3075+30	3080+10	260 PCC	4400	243.44	114.45	416.56	143.78	Stage I (IA 1C) - includes ramp taper
	6152+95	6157+20	260 PCC	3800	196.02	59.51	373.98	134.23	Stage I (IA 64B) - includes ramp taper
	7154+95	7156+55	260 PCC	2625	255.04	120.33	138.71	50.53	Stage I (IA 64C) - includes ramp taper
	8161+88	8164+00	260 PCC						
Slideroads	1453+03	1455+00	260 PCC	1420	---	---	---	---	Stage I (X-28)
	2132+00	2132+25	260 PCC	180	---	---	---	---	Stage I (X-40)
	1174+00	1174+75	260 PCC	540	---	---	---	---	Stage I (130th Street)
Added Rt. Turn Lane	128+19	131+31	260 PCC	1020	1020				
	TOTALS			180,734.105		202,211.03		27,377.33	
				ACTUAL AMOUNT PLACED		ACTUAL AMOUNT PLACED		ACTUAL AMOUNT PLACED	

TABULATION OF DETOUR PAVEMENT

X-51
06-03-99

STATION TO STATION	SHEET NO.	SPECIAL BACKFILL (Mg)	DETOUR PAVEMENT (Sq. m)
3+10	7+65	590	1275
20+40	24+60	418	400
20+40	24+60	418	400
81+90	84+60	312	385
84+00	85+20	131	145
162+40	164+60	228	235
164+00	165+20	127	140
184+16	186+84	3852	2649 (1)
TOTALS		3845.43	5629

(1) Pavement Will Not Be Removed By This Contract.

dgn = L:\WORK\PROJECT\39922\cadd\X40turn\X40c14.dgn
levels = 1-63
pen table = I:\plot\tables\half.tbl

TABULATION OF PAVEMENT MARKINGS

108-22
10-31-95

- ② Broken Center Line (Yellow)
- ⑤ No-Passing Zone Line (Yellow)
- ⑦ Edge Line Right (White)
- ⑩ Dotted Line (White)
- ⑪ Channelizing Line (White)
- ⑬ Stop Line (White)
- ⑮ Yellow Curb
- ③ Double Center Line (Yellow)
- ⑥ Broken Lane Line (White)
- ⑧ Edge Line Left (Yellow)
- ⑩ Solid Lane Line (White)
- ⑫ Channelizing Line (Yellow)
- ⑭ Crosswalk Line (White)
- ⑯ White Curb

ROAD IDENTIFICATION	LOCATION STATION TO STATION		SIDE L R		LENGTH (m)												REMARKS			
					②	③	⑤	⑥	⑦	⑧	⑨	⑩	⑪	⑫	⑬	⑭		⑮	⑯	
US HWY 151																				
STAGE II																				
*** Removals for Ia. 1 Ent. Ramp 'A', Exit Ramp 'D'			Main line,	Ia. 64 Ent. Ramp 'A' and Exit Ramp 'D'		***														
Ia. 1 Ent. Ramp 'A'	1071+00	1071+35	X					35										Remove Removable Tape Marking		
	1071+00	1071+80				80												Remove Removable Tape Marking		
	1071+00	1071+80		X				80										Remove Removable Tape Marking		
	1071+35	1077+05	X					570										Pavement Marking Removed		
	1071+80	1077+07				520												Pavement Marking Removed		
	1071+80	1077+07	X					520										Pavement Marking Removed		
Ia. 1 Exit Ramp 'D'	4077+05	4081+90	X					485										Pavement Marking Removed		
	4076+92			X						18							Pavement Marking Removed			
	4076+92	4081+90				485												Pavement Marking Removed		
	4076+95	4081+90		X				495										Pavement Marking Removed		
Main line	68+60	69+50	WBL					90										Pavement Marking Removed		
	68+60	69+50	WBL	CL		90												Pavement Marking Removed		
	68+60	69+50	WBL	WBL				90										Pavement Marking Removed		
	69+50	71+00	WBL					150										Remove Removable Tape Marking		
	69+50	71+00	WBL			150												Remove Removable Tape Marking		
	69+50	71+00	WBL	WBL				150										Remove Removable Tape Marking		
	81+90	84+00	WBL					310										Remove Removable Tape Marking		
	81+90	84+00	WBL	CL		310												Remove Removable Tape Marking		
	81+90	84+00	WBL	WBL				310										Remove Removable Tape Marking		
	84+00	85+00	WBL					100										Pavement Marking Removed		
	84+00	85+00	WBL	CL		100												Pavement Marking Removed		
	84+00	85+00	WBL	WBL				100										Pavement Marking Removed		
	85+00	88+00	WBL			300												Pavement Marking Removed		
	92+00	100+00	WBL					800										Pavement Marking Removed		
	124+50	132+80	WBL					830										Pavement Marking Removed		
	144+00	150+00	WBL					600										Pavement Marking Removed		
	151+00	154+30	WBL					330										Pavement Marking Removed		
	151+00	154+30	WBL			330												Remove Removable Paint Marking		
	151+00	154+30	WBL	WBL				330										Remove Removable Paint Marking		
	162+00	166+50	WBL					450										Pavement Marking Removed		
	162+00	164+40	CL	CL		240												Remove Removable Tape Marking		
	164+40	166+50	CL	CL		210												Pavement Marking Removed		
	162+00	164+40	WBL	WBL				240										Remove Removable Tape Marking		
	164+40	166+50	WBL	WBL				240										Pavement Marking Removed		
	166+50	187+00	WBL	CL		2050												Pavement Marking Removed		
	166+50	187+00	WBL	WBL				2050										Pavement Marking Removed		
Ia. 64 Ent. Ramp 'A'	5154+30	5158+08	X					378										Pavement Marking Removed		
	5154+30	5158+12	CL	CL		382												Pavement Marking Removed		
	5158+12			X														Pavement Marking Removed		
	5154+30	5158+15		X				385										Pavement Marking Removed		
Ia. 64 Exit Ramp 'D'	8158+20	8162+05	X					385										Pavement Marking Removed		
	8158+20	8162+05	CL	CL		385												Pavement Marking Removed		
	8158+20	8162+05		X				385										Pavement Marking Removed		
*** Markings for Crossover at Sta. 4+50 and Crossover 'B'			***																	
Main line	0+10	2+50	EBL					240										Removable Tape Marking		
	2+50	7+30	EBL	CL				480										Removable Tape Marking		
	7+30	23+00	EBL	CL		1570												Removable Tape Marking		
Crossover	700+00	701+45	X						145										Removable Tape Marking	
	701+45	704+15	X						270											
	700+00	703+15		X						315										Removable Tape Marking
	703+15	704+15		X						100										Removable Tape Marking
	702+79	703+73		X						75										Removable Tape Marking - Painted Channelized Island

TABULATION OF PAVEMENT MARKINGS

108-22
10-31-95

- ② Broken Center Line (Yellow)
- ③ Double Center Line (Yellow)
- ⑤ No-Passing Zone Line (Yellow)
- ⑥ Broken Lane Line (White)
- ⑦ Edge Line Right (White)
- ⑧ Edge Line Left (Yellow)
- ⑨ Dotted Line (White)
- ⑩ Solid Lane Line (White)
- ⑪ Channelizing Line (White)
- ⑫ Channelizing Line (Yellow)
- ⑬ Stop Line (White)
- ⑭ Crosswalk Line (White)
- ⑮ Yellow Curb
- ⑯ White Curb

ROAD IDENTIFICATION	LOCATION		SIDE		LENGTH (m)																REMARKS
	STATION TO	STATION FROM	L	R	②	③	⑤	⑥	⑦	⑧	⑨	⑩	⑪	⑫	⑬	⑭	⑮	⑯			
Mainline / Crossover	64+50 EBL	64+40 WBL	X																290		
	67+40	71+20	WBL																380	Removable Tape Marking	
	64+50	65+50		EBL															100	Removable Tape Marking	
	65+50 EBL	69+00 WBL		X															350		
	69+00	71+80		WBL															280	Removable Tape Marking	
64+50	67+95		EBL	CL							345								Removable Tape Marking		
*** Markings for Ia. 1 Ent. Ramp 'A' and Exit Ramp 'D' ***																					
Ia. 1 Ent. Ramp 'A'	1071+20	1077+05	X						585												
	1071+70	1077+07		X							537										
Ia. 1 Exit Ramp 'D'	4077+05	4081+90	X						485												
	4076+92			X															26		
	4076+95	4081+90		X						495											
*** Markings for Hwy. 151, WB Lanes ***																					
Mainline	17+59 WBL	17+95 EBL	X							78											
	18+10	18+90		WBL								80									
	18+40 EBL	19+26 WBL	X							146											
	34+68 WBL	35+05 EBL	X							64											
	35+29	35+96		WBL									67								
	35+47 EBL	36+32 WBL	X							129											
	38+38 EBL	39+18 WBL	X							129											
	38+73	39+40		EBL									67								
	39+66 WBL	40+00 EBL	X							68											
	50+96 EBL	51+50 WBL	X							177											
	51+30	51+90		EBL									60								
	52+15	52+84		WBL									69								
	52+63 EBL	53+20 WBL	X							178											
	64+70	65+41		WBL																	
	81+90	85+00		WBL										310						Removable Tape Marking	
	81+90	85+00			WBL														310	Removable Tape Marking	
	85+00	153+50		WBL						6850											
	85+00	162+00		WBL	CL			7700													
	85+00	162+00			WBL						7700										
	87+01	87+71		WBL										70							
105+16	105+94		WBL										78								
117+40	118+10		WBL										70								
131+36	132+09		WBL										73								
137+67	138+35		WBL										68								
162+00	165+00		WBL											300					Removable Tape Marking		
162+00	165+00			WBL														300	Removable Tape Marking		
165+00	172+60		WBL						760												
165+00	172+70			WBL									770								
166+00	183+25		WBL	CL			1725														
173+20	173+90		WBL										70								
173+20	175+30			WBL									210								
173+55	180+55		WBL																		
174+25	180+45		WBL						700												
180+90	184+75			WBL						385											
180+95	183+55		WBL							260											
128+73	131+31			WBL									258						For Rt. Turn Lane		
*** Markings for Hwy. 151, EB Lanes ***																					
Mainline	63+75 EBL	64+50 WBL	X							130										Turning Lane Marking - Wrap Around to 64+50 WBL	
	64+10	64+70		EBL									60								
	65+75 WBL	65+00 EBL	X								130									Turning Lane Marking - Wrap Around to 65+00 EBL	
	65+00	85+90		EBL									2090								
	67+95	180+26		EBL	CL			11231												Center Line - R	
	67+95	74+25			EBL					630										Exit Loop Taper Marking	
	74+25	76+70			EBL					240											
	74+25	75+05			EBL															Exit Loop Taper Marking	
	75+05	76+35			EBL									124						Exit Loop Taper Marking	
	75+05	76+35			EBL									123							
	76+35	76+70			EBL					35										Exit Loop Taper Marking	
	76+35	80+10			EBL					375											
	80+10	81+05			EBL									97							

dgn = L:\WORK\PROJECT\39922\cadd\X40turn\X40c14.dgn
 levels = 1-63
 pen table = I:\plot\tables\half.tbl

TABULATION OF PAVEMENT MARKINGS

108-21
10-31-95

- ② Broken Center Line (Yellow)
- ③ Double Center Line (Yellow)
- ⑤ No-Passing Zone Line (Yellow)
- ⑥ Broken Lane Line (White)
- ⑦ Edge Line Right (White)
- ⑧ Edge Line Left (Yellow)
- ⑨ Dotted Line (White)
- ⑩ Solid Lane Line (White)
- ⑪ Channelizing Line (White)
- ⑫ Channelizing Line (Yellow)
- ⑬ Stop Line (White)
- ⑭ Crosswalk Line (White)
- ⑮ Yellow Curb
- ⑯ White Curb

ROAD IDENTIFICATION	LOCATION		SIDE		LENGTH (m)											REMARKS			
	STATION TO STATION		L	R	②	③	⑤	⑥	⑦	⑧	⑨	⑩	⑪	⑫	⑬		⑭	⑮	⑯
	Exit Loop B	2076+70	2079+40	X						269	285								
	2076+70	2079+40		X															
Entrance Ramp C	3074+76	3080+90		X					633										
	3074+90	3076+00	CL	CL		110													
	3074+93			X										30					
	3075+04	3076+00		X					116										
	3076+00	3080+10		X						410									
X-28	1452+50	1455+00		X					267										
	1452+50	1455+00		X					293										
	1452+47	1455+00	CL	CL		253													
	1452+47			X										18					
X-40	2131+46	2132+25		X					92										
	2131+48	2132+25	CL	CL		74													
	2131+50	2132+25		X					103										
	2131+51			X										23					
Exit Ramp B	6153+10	6157+40		X					487										
	6153+10	6156+60		X					352										
	6156+60	6157+60	CL	CL		100													
	6156+60	6157+72		X					126										
	6157+60			X										30					
Entrance Loop C	7154+95	7157+95		X															
	7154+95	7156+55		X															
130th Street	1173+35	1174+75		X					153										
	1173+38	1174+75	CL	CL		137													
	1173+45	1174+75		X					174										
	1173+35			X										21					
Stage III																			
*** Removals for Mainline ***																			
Mainline	0+10	2+50	EBL						240									Remove Removable Tape Marking	
	2+50	7+30	EBL	CL					480									Remove Removable Tape Marking	
	7+30	23+00	EBL	CL		1570												Remove Removable Tape Marking	
Crossover	700+00	701+45		X						145								Remove Removable Tape Marking	
	703+15	704+15		X							100							Remove Removable Tape Marking	
	702+79	703+73		X							75							Remove Removable Tape Marking - Painted Channelized Island	
Mainline / Crossover	67+40	71+20	WBL							380								Remove Removable Tape Marking	
	64+50	65+50		EBL							100							Remove Removable Tape Marking	
	69+00	71+80		WBL							280							Remove Removable Tape Marking	
	64+50	67+95	EBL	CL					345									Remove Removable Tape Marking	
Mainline	81+90	85+00	WBL							310								Remove Removable Tape Marking	
	81+90	85+00		WBL							310							Remove Removable Tape Marking	
	162+00	165+00	WBL							300								Remove Removable Tape Marking	
	162+00	165+00		WBL							300							Remove Removable Tape Marking	
*** Markings for Hwy. 151, WB Lanes ***																			
Mainline	15+40	85+00	WBL	CL			6960												
	15+40	39+30		WBL				2390											
	15+40	17+59		WBL					219										
	17+26	34+68		WBL					1542										
	36+32	39+18		WBL					286										
	39+66	51+50		WBL					1184										
	39+80	51+65		WBL				1185											
	52+50	71+80		WBL				1930											
	53+20	64+50		WBL					1130										
	65+77	85+00		WBL					1923										
	71+80	82+05		WBL				1025											

TABULATION OF PAVEMENT MARKINGS

108-22
10-31-95

- | | | | | | | |
|-------------------------------|---------------------------------|---------------------------|---------------------------|------------------------------|--------------------------|---------------|
| ② Broken Center Line (Yellow) | ⑤ No-Passing Zone Line (Yellow) | ⑦ Edge Line Right (White) | ⑨ Dotted Line (White) | ⑪ Channelizing Line (White) | ⑬ Stop Line (White) | ⑮ Yellow Curb |
| ③ Double Center Line (Yellow) | ⑥ Broken Lane Line (White) | ⑧ Edge Line Left (Yellow) | ⑩ Solid Lane Line (White) | ⑫ Channelizing Line (Yellow) | ⑭ Crosswalk Line (White) | ⑯ White Curb |

ROAD IDENTIFICATION	LOCATION		SIDE		LENGTH (m)											REMARKS					
	STATION TO	STATION	L	R	②	③	⑤	⑥	⑦	⑧	⑨	⑩	⑪	⑫	⑬		⑭	⑮	⑯		
	82+05	85+00		WBL					295												
	162+00	165+00		WBL					300												
	162+00	163+39		WBL									139								
	162+00	163+39		WBL									139								
	162+00	165+00		WBL	CL			300													
	162+00	165+00		WBL						300											
	163+39	164+12		WBL							73										
Stage IV																					
Mainline	20+40	24+60		EBL					420												
	20+40	21+00		EBL					60										Removable Tape Marking		
	21+00	24+00		EBL					300												
	24+00	24+60		EBL					60										Removable Tape Marking		
Stage V																					
	20+40	21+00		EBL					60										Remove Removable Tape Marking		
	24+00	24+60		EBL					60										Remove Removable Tape Marking		
Mainline	20+40	24+60		EBL					420												
	20+40	21+00		EBL					60										Removable Tape Marking		
	21+00	24+00		EBL					300												
	24+00	24+60		EBL					60										Removable Tape Marking		
Stage VI																					
	20+40	21+00		EBL					60										Remove Removable Tape Marking		
	24+00	24+60		EBL					60										Remove Removable Tape Marking		
Mainline	21+00	24+00		EBL					300												
	21+00	24+00		EBL	CL		300														
	21+00	24+00		EBL				300													
LENGTH SUBTOTALS					0	1570	0	0	0	1305	0	0	1135	1165	0	0	0	0	0	0	
					0	2680	0	0	1605	1305	0	0	1135	1165	0	0	0	0	0	0	
					0	463	285	28386	31053	33847	518	1897	2292	1153	130	0	0	0	0	0	
					0	4222	300	2230	7053	65	0	0	0	0	32	0	0	0	0	0	
QUANTITY FACTORS					0.25	2.00	1.00	0.25	1.00	1.00	0.33	1.00	2.00	2.00	6.00	1.50					
TOTALS					0	3140	0	0	0	1305	0	0	2270	2330	0	0	0	0	0	0	0
					0	5360	0	0	1605	1305	0	0	2270	2330	0	0	0	0	0	0	
					0	928	285	7097	31053	33847	171	1897	4584	2306	780	0	0	0	0	0	
					0	8444	300	558	7053	65	0	0	0	0	192	0	0	0	0	0	

Removable Tape Marking, TOTAL = 2367.00 METERS
Pavement Marking, TOTAL = 112,174.968 METERS
Pavement Marking Removed, TOTAL = 54,200.75 METERS

dgn = L:\WORK\PROJECT\39922\cadd\X40turn\X40c14.dgn
 levels = 1-63
 plotfile = I:\plot\tables\haifw4.tbl

TABULATION OF STEEL BEAM GUARDRAIL AT BRIDGE END POST, CONCRETE BARRIER AND RAILROAD SIGNALS

108-8A
10-03-00



Refer to Standard Road Plans RE-63, RE-65A and RE-65B



LOCATION				LAYOUT INFORMATION					MATERIALS REQUIRED					BID ITEMS				REMARKS				
No.	Direction of Traffic	End	Side	Station	STANDARD ROAD PLAN	CASE	L2	STS (5.715)	VT	VF	ET (11.430)	STS		CRT Posts 150x200x1830 with 150x200 mm Spacer Blocks (5)	Posts ④ 200x200x1830 with 200x200 mm Spacer Blocks (3)	Posts ⑤ 250x250x1830 with 200x200 mm Spacer Blocks	Formed Steel Beam Guardrail (STS)+(VT)+(VF)+(ET)		Anchorage and Terminal Systems			
												Thrie Beam (7.62)	Transition Section (1.905)						(VT)+(VF)+(ET) 'W' Beam	No.	No.	No.
																	No.		No.	No.	No.	
1	EB	A	0	76+32.765	RE-65A	F	---	5.715	0	0	11.430	7.62	1.095	11.403	5	3	3	17.145	---	1	---	1
2	WB	A	0	76+47.015	RE-65A	F	---	5.715	0	0	11.430	7.62	1.095	11.403	5	3	3	17.145	---	1	---	1
3	WB	A	0	134+56.036	RE-65A	F	---	5.715	0	0	11.430	7.62	1.095	11.403	5	3	3	17.145	---	1	---	1
4	EB	A	0	134+66.217	RE-65A	F	---	5.715	0	0	11.430	7.62	1.095	11.403	5	3	3	17.145	---	1	---	1
5	EB	A	0	157+87.246	RE-65A	F	---	5.715	0	0	11.430	7.62	1.095	11.403	5	3	3	17.145	---	1	---	1
6	WB	A	0	157+93.534	RE-65A	F	---	5.715	0	0	11.430	7.62	1.095	11.403	5	3	3	17.145	---	1	---	1



TABULATION OF STEEL BEAM GUARDRAIL FOR STANDARD ROAD PLAN RE-67

108-19
10-03-00

LOCATION		① APPROACH SIDE LAYOUT LENGTHS			② TRAILING SIDE LAYOUT LENGTHS				MATERIALS REQUIRED					BID ITEMS			REMARKS						
NO.	Direction of Traffic	STATION	STS (5.715)	Section for Skewed Bridge	Curve #1	RE-53 Section (3.810)	Tangent Section	Curve #2	Section for Skewed Bridge	Adjustment Section	STS (5.715)	STS		'W' Beam (A)+(T) -11.43	Posts (sized in mm)				Formed Steel Beam Guardrail (A)+(T)	Anchorage and Terminal Systems			
												Thrie Beam (15.24)	Transition Section (2) @ (1.905)		200x200x1830 with 200x200 Spacer Blocks	250x250x1830 with 200x200 Spacer Blocks (6)		200x200x1830 without Spacer Blocks (2)		150x150x1830 without Spacer Blocks (1)	No.	No.	No.
																		m	No.	No.	No.		
1	EB	76+04.037	5.715	----	34.290	3.810	13.335	13.335	----	17.145	5.715	15.24	(2) @ 1.905	81.915	45	6	2	1	93.345	1	2	----	
2	WB	76+75.603	5.715	----	34.290	3.810	13.335	13.335	----	17.145	5.715	15.24	(2) @ 1.905	81.915	45	6	2	1	93.345	1	2	----	
3	EB	133+97.752	5.715	----	34.290	3.810	13.335	13.335	----	1.905	5.715	15.24	(2) @ 1.905	66.675	37	6	2	1	78.105	1	2	----	
4	WB	135+24.492	5.715	----	34.290	3.810	13.335	13.335	----	1.905	5.715	15.24	(2) @ 1.905	66.675	37	6	2	1	78.105	1	2	----	
5	EB	157+57.922	5.715	----	34.290	3.810	13.335	13.335	----	11.430	5.715	15.24	(2) @ 1.905	76.20	42	6	2	1	87.631	1	2	----	
6	WB	158+22.858	5.715	----	34.290	3.810	13.335	13.335	----	11.430	5.715	15.24	(2) @ 1.905	76.20	42	6	2	1	87.631	1	2	----	

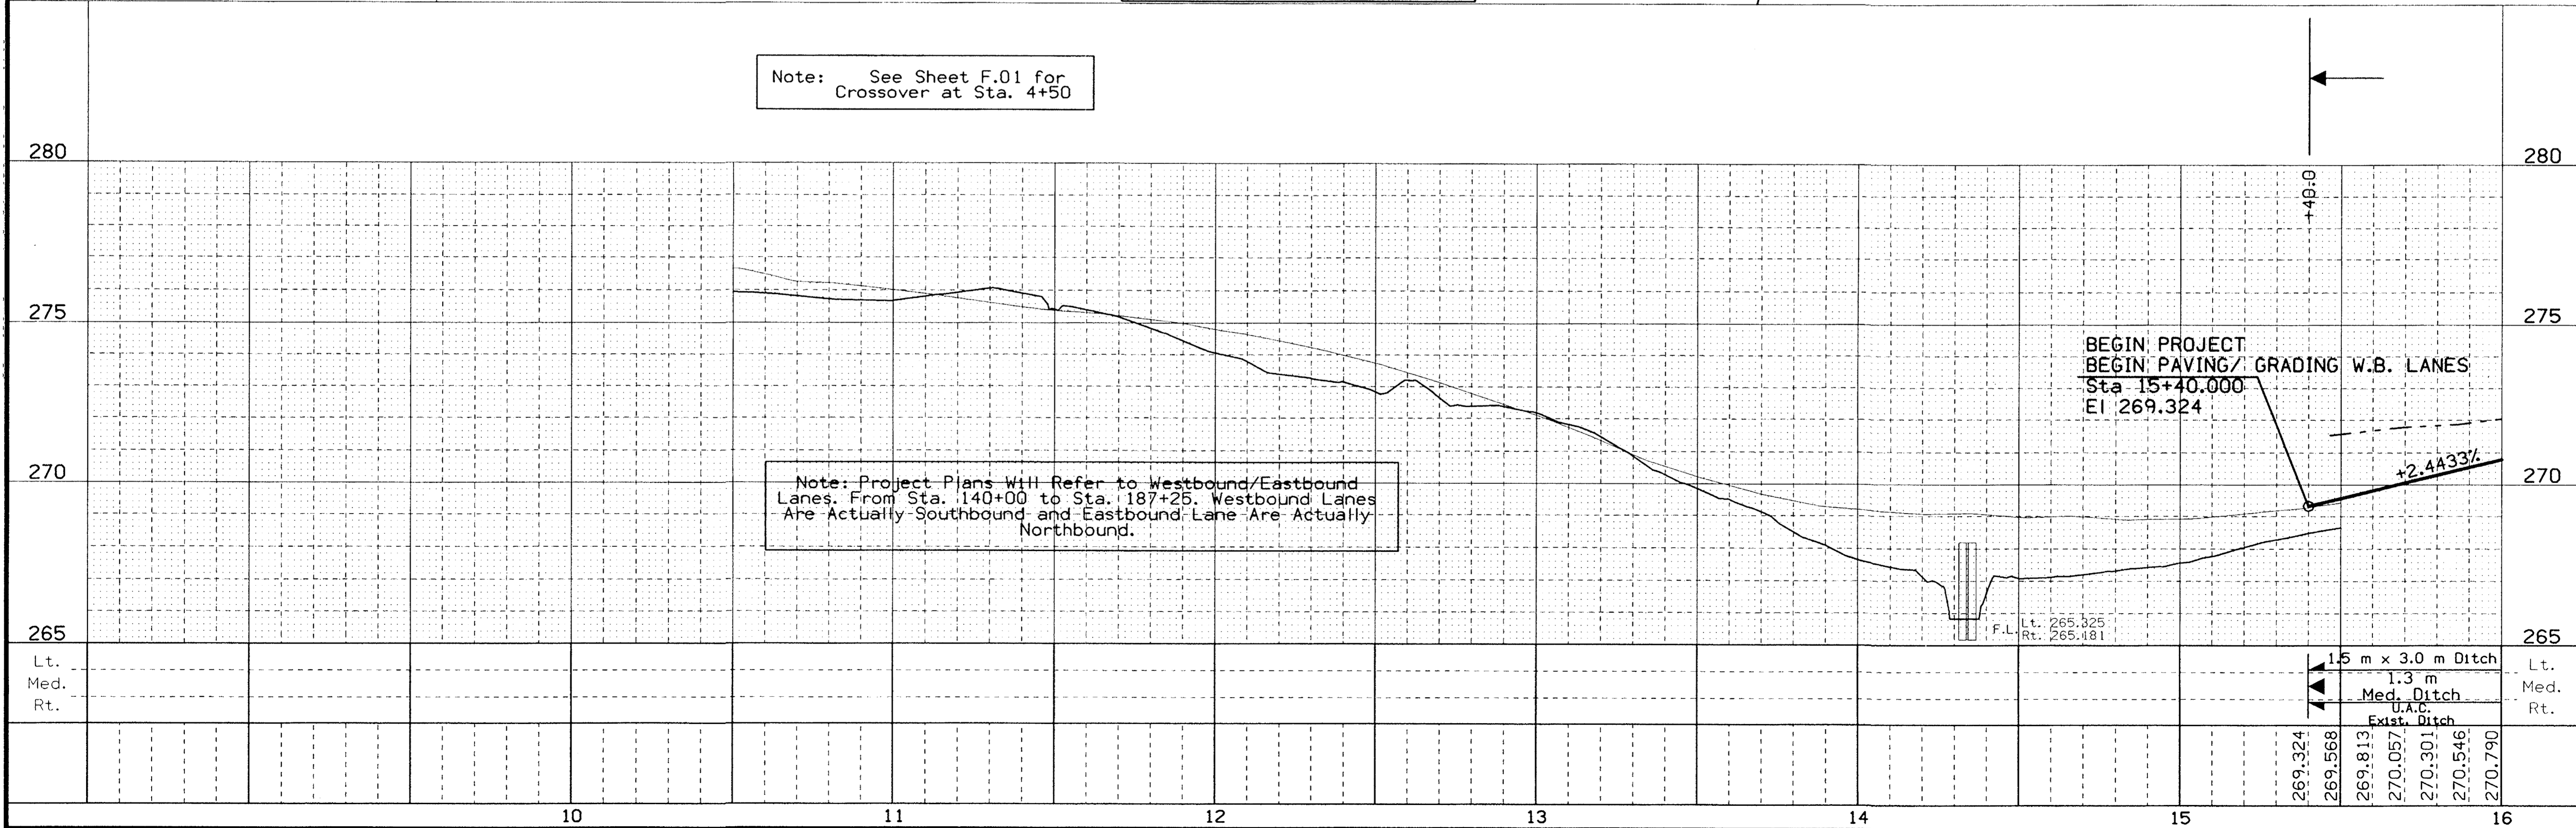
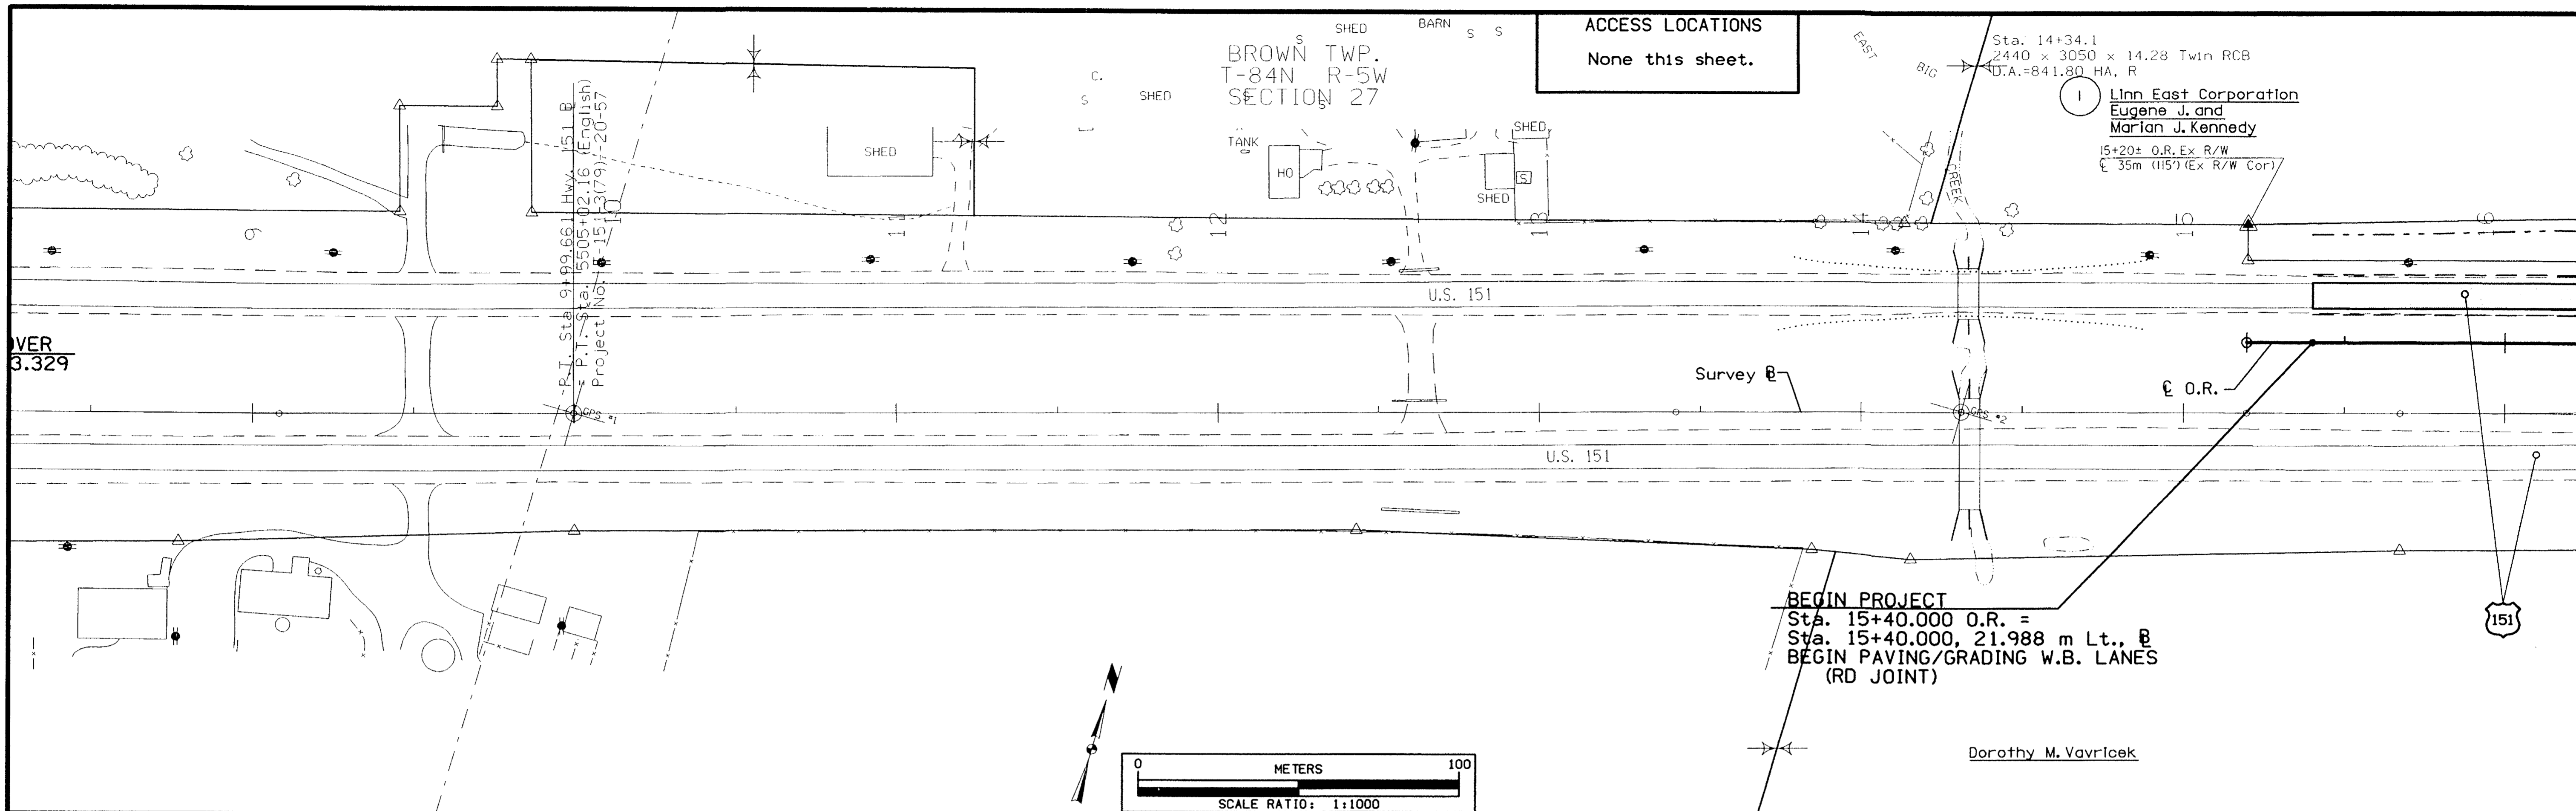


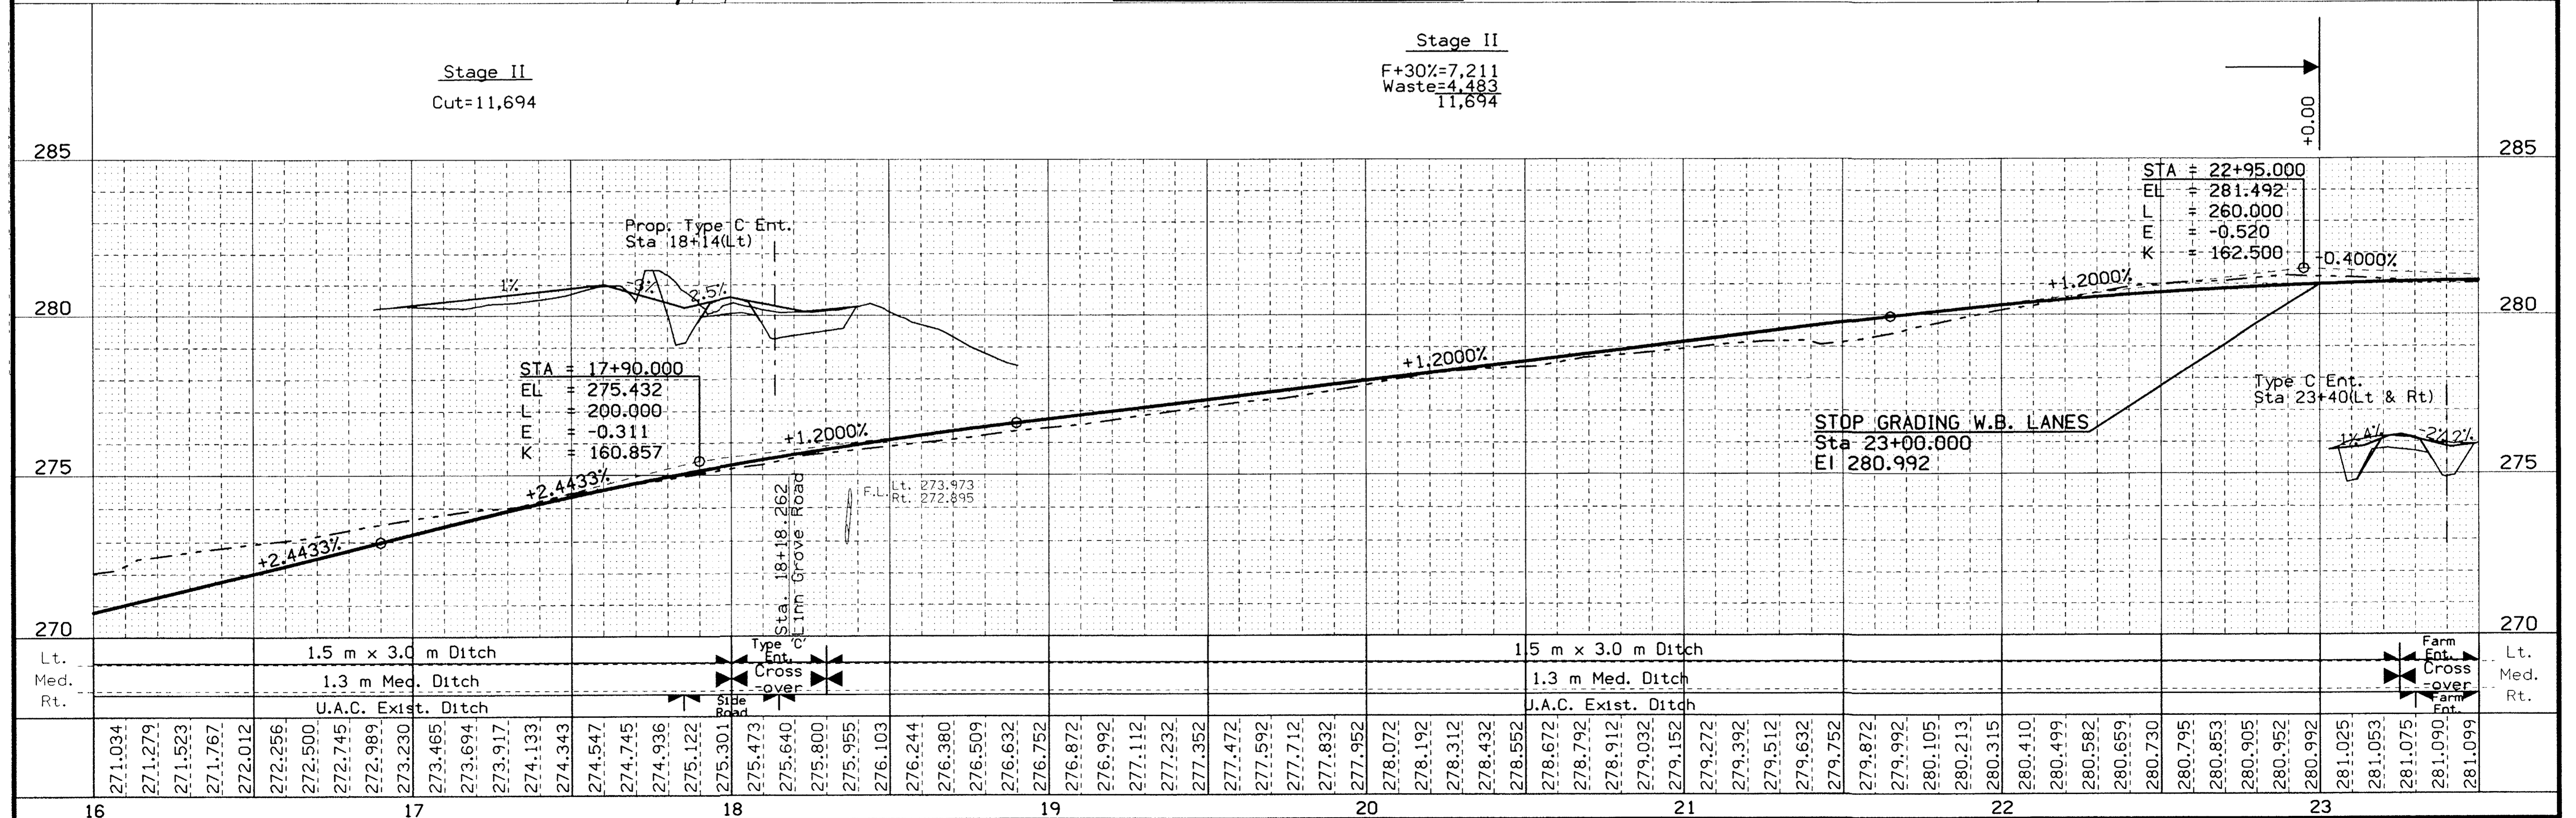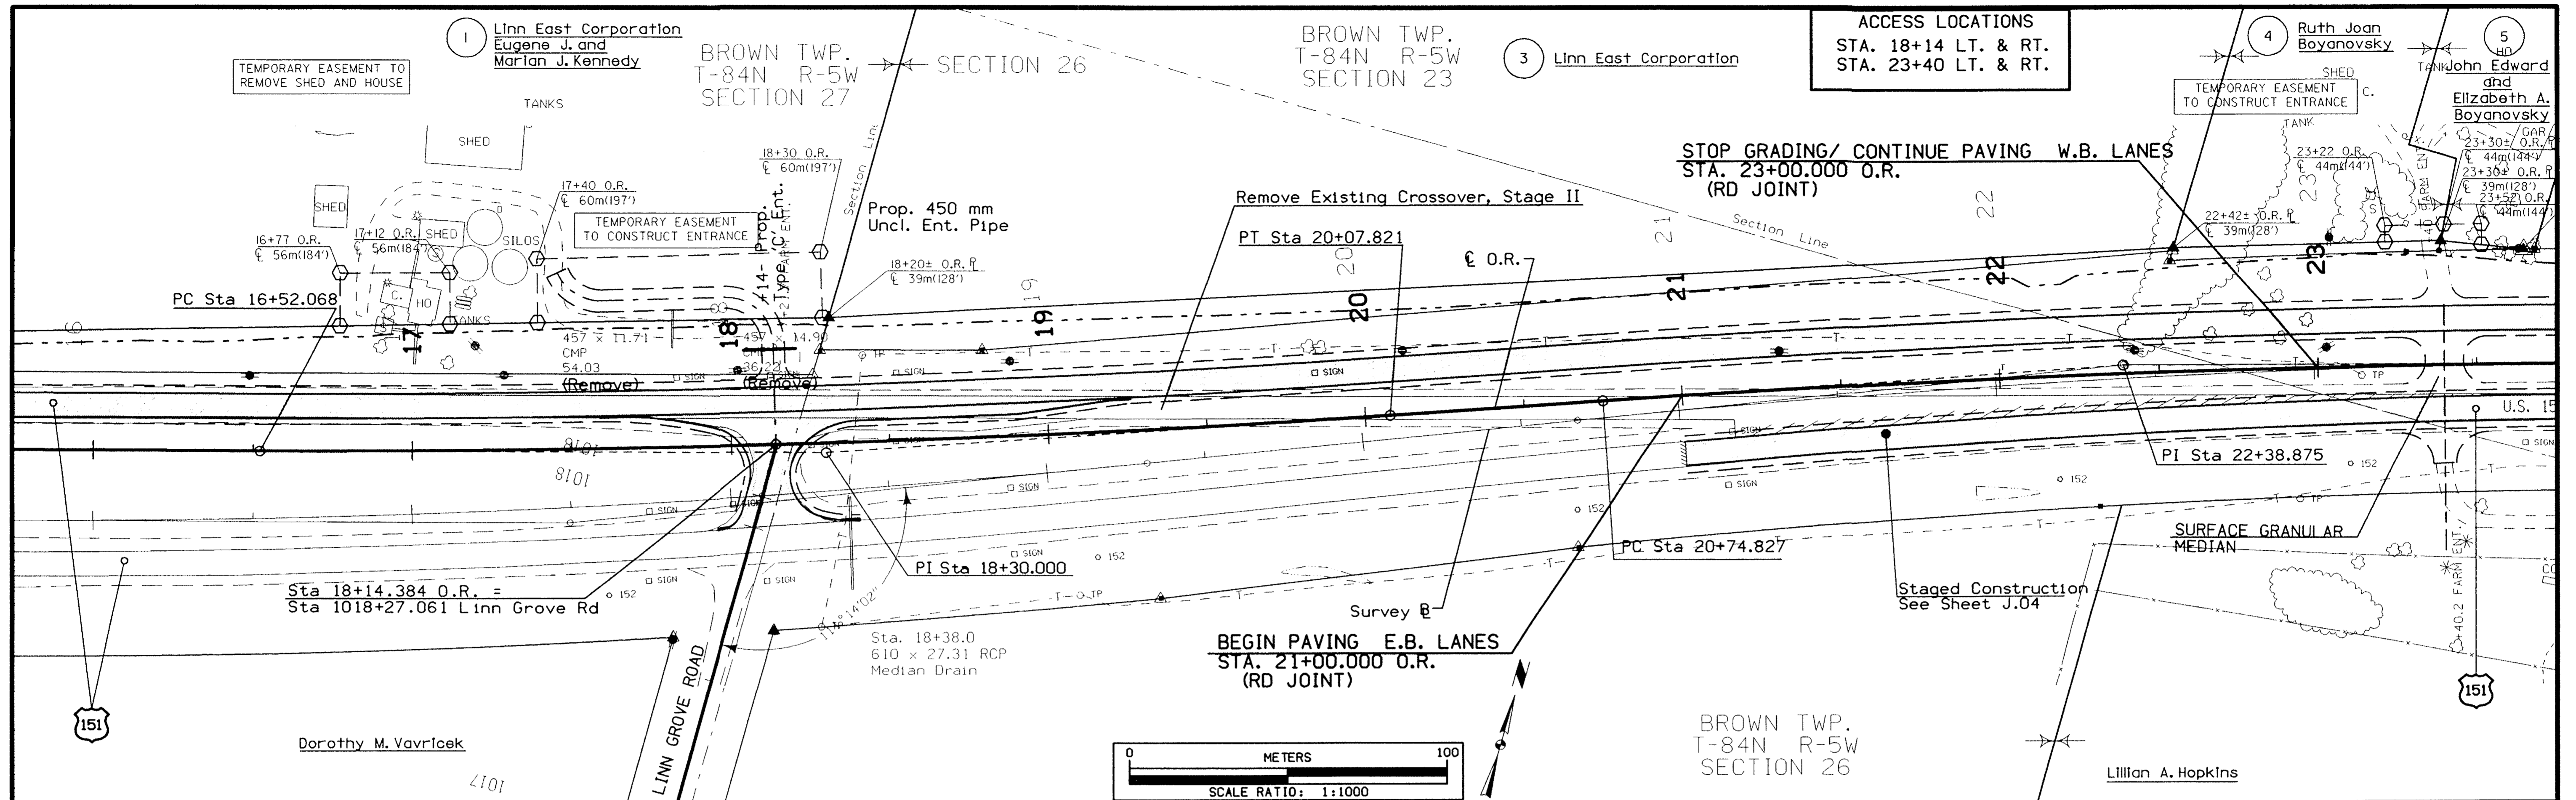

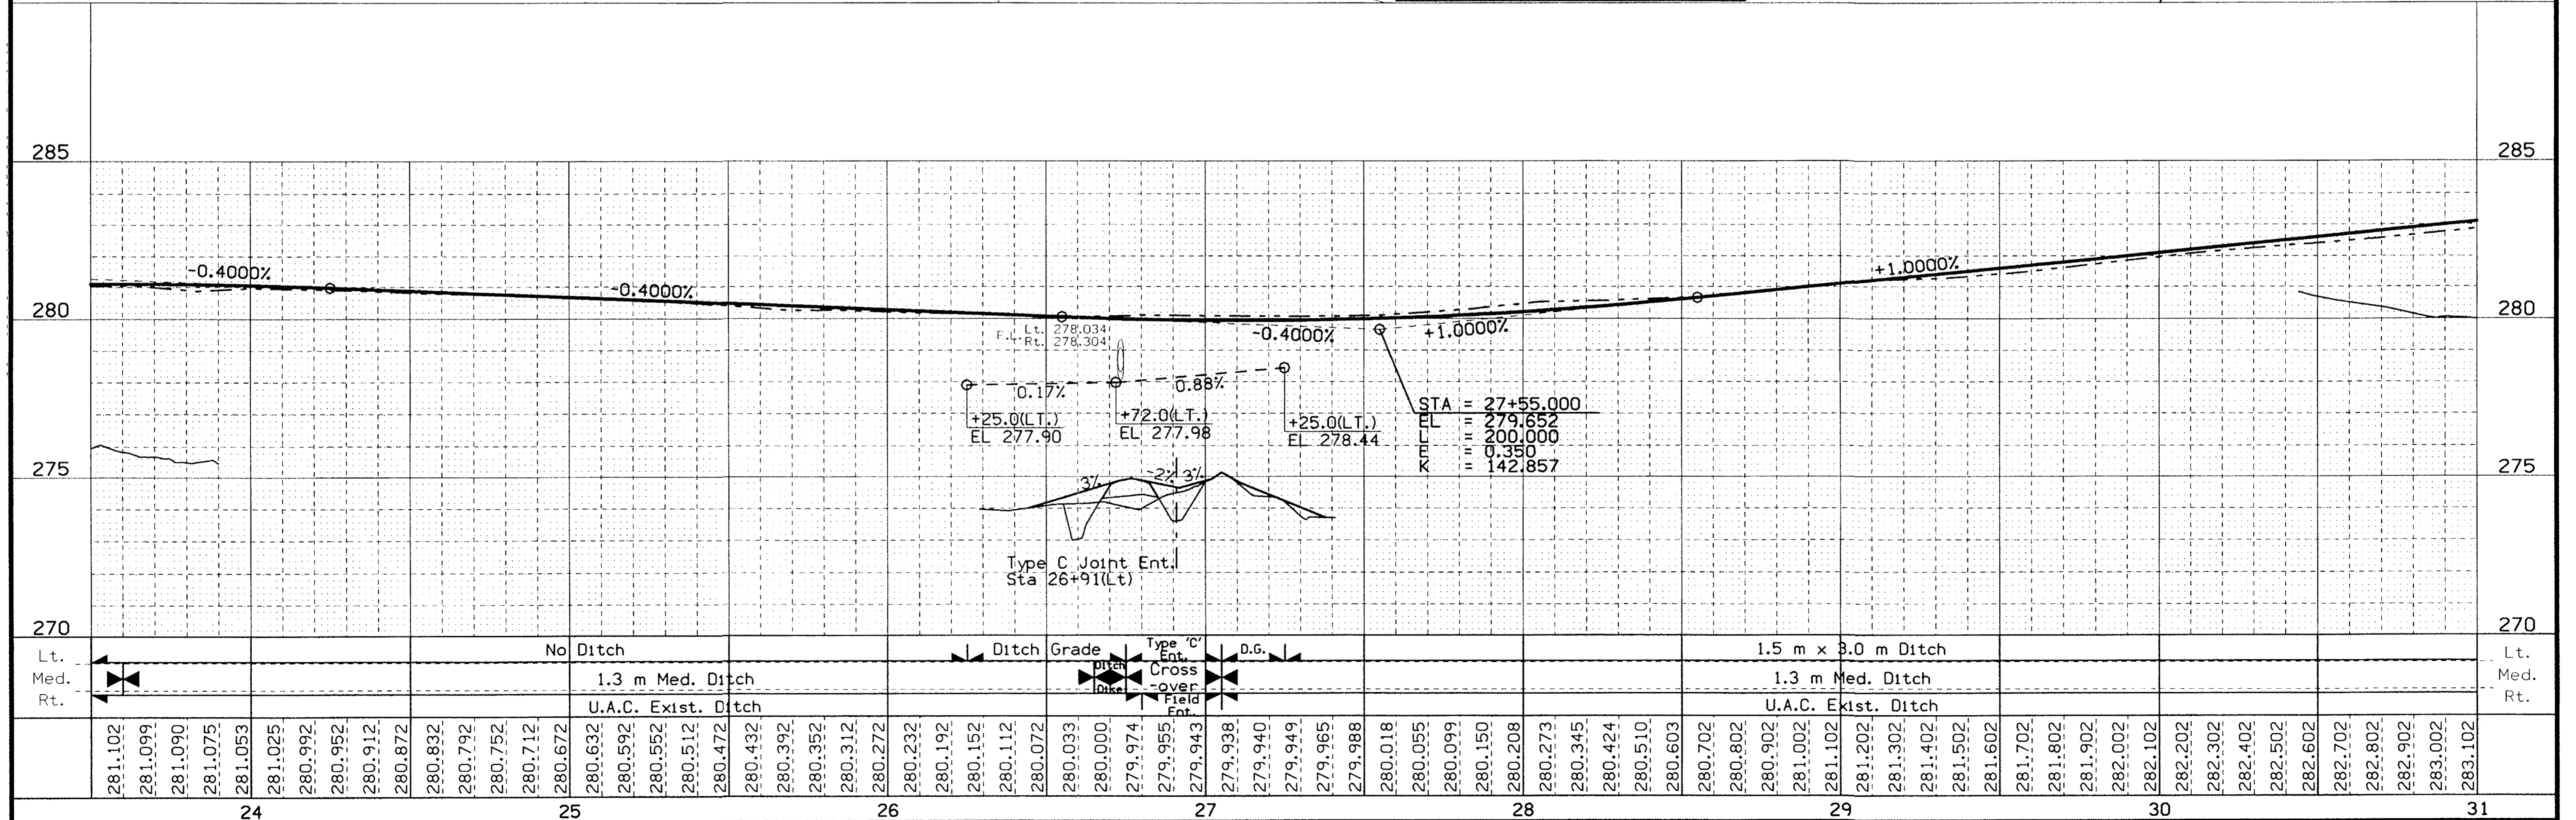
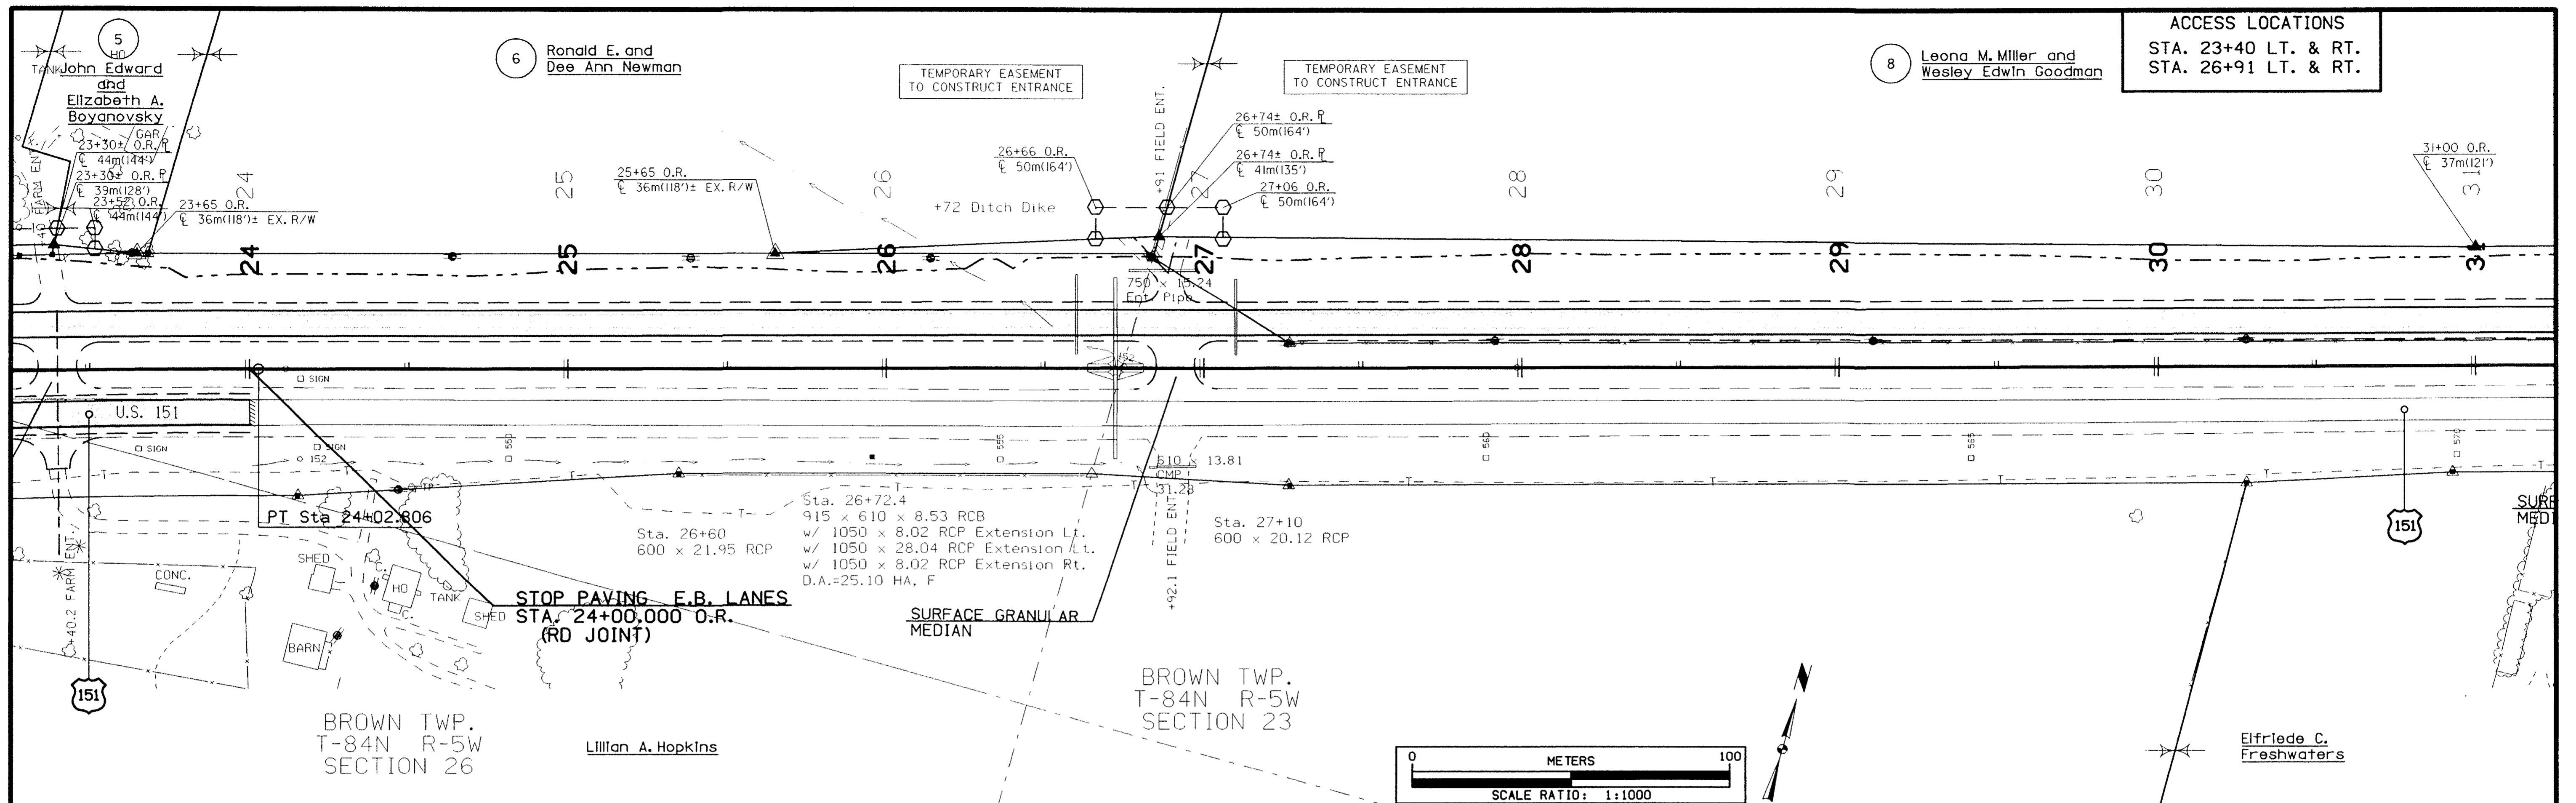




DESIGN TEAM	Skogerboe / EARTH TECH	METRIC	IOWA DOT * OFFICE OF ROAD DESIGN	Linn/Jones	COUNTY	PROJECT NUMBER	NHSX-151-3(112)--3H-57	SHEET NUMBER	D.03
-------------	------------------------	--------	----------------------------------	------------	--------	----------------	------------------------	--------------	------

date = Thu Oct 5 13:20:21 2000 prf = \\WATS01\DATA\PL0T\PL463P\d03h.prf

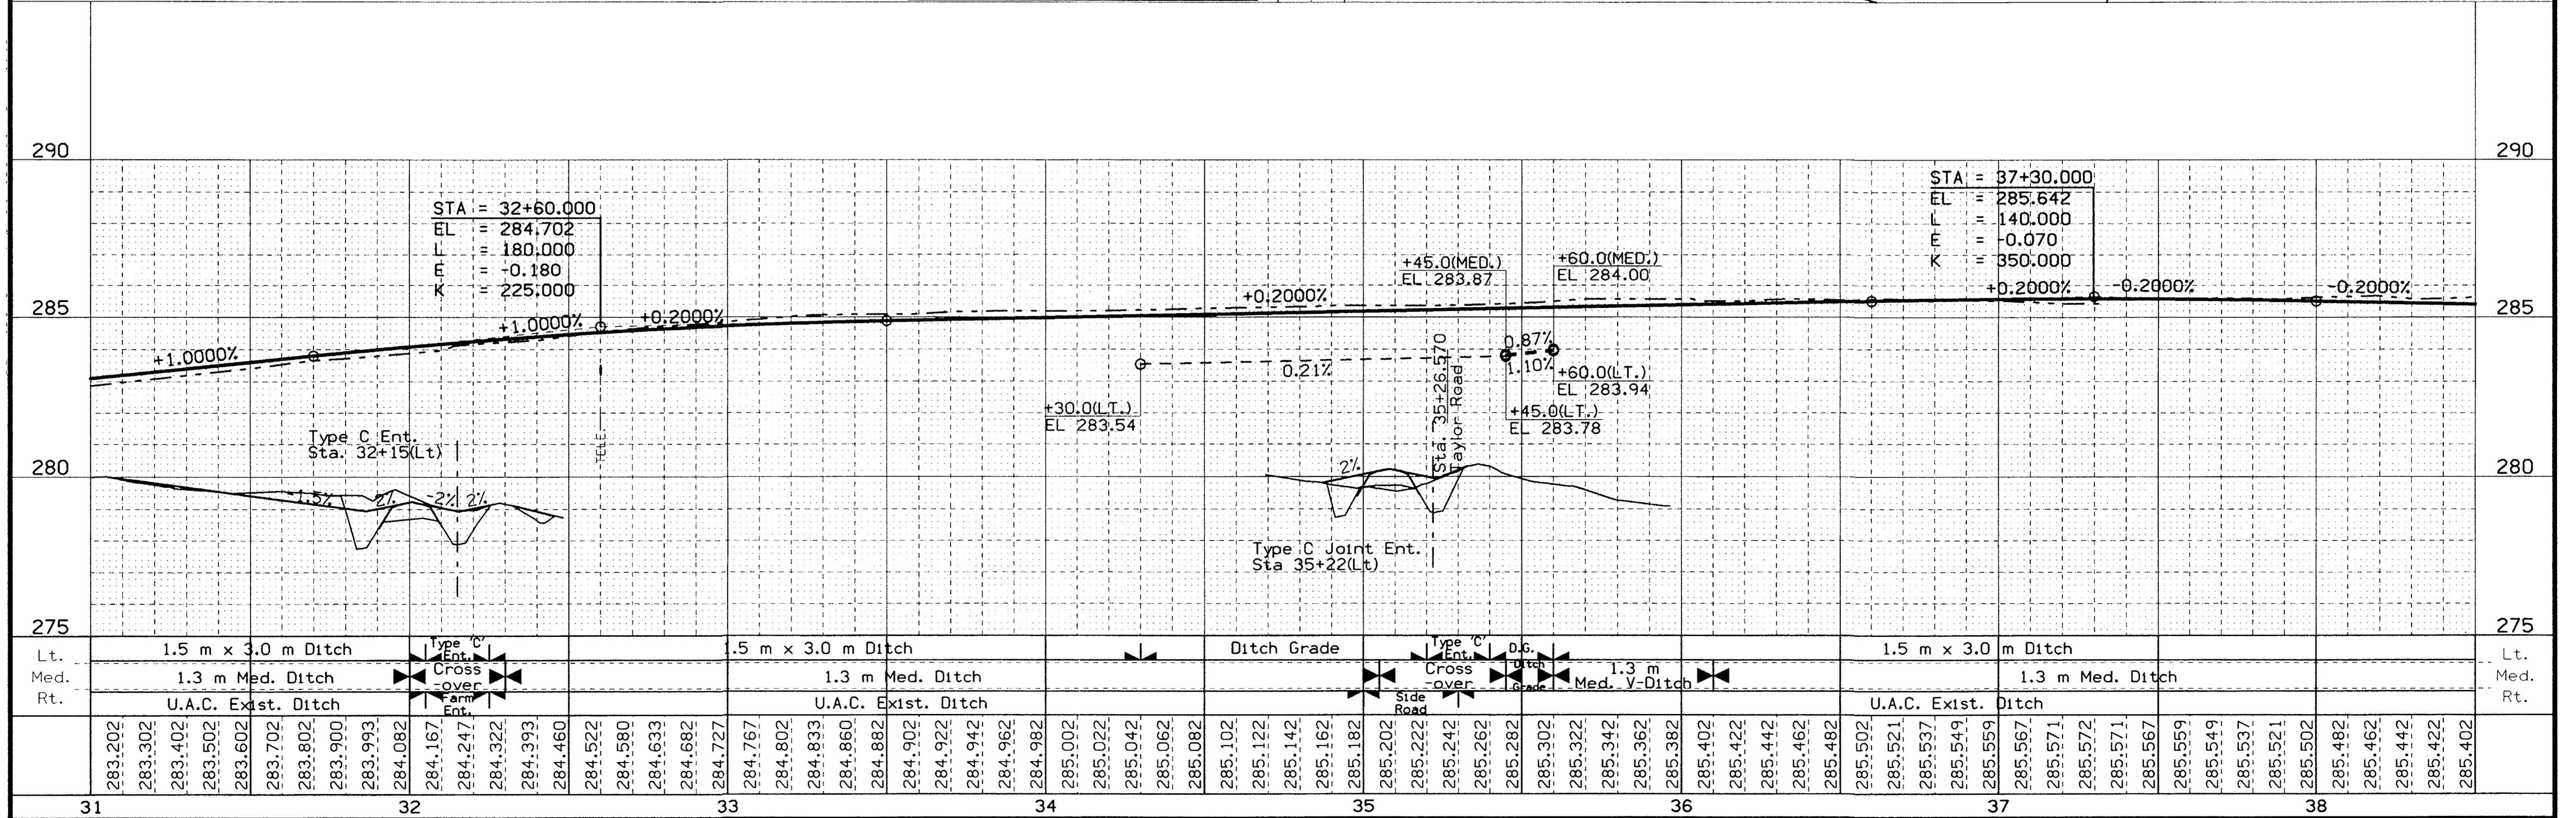
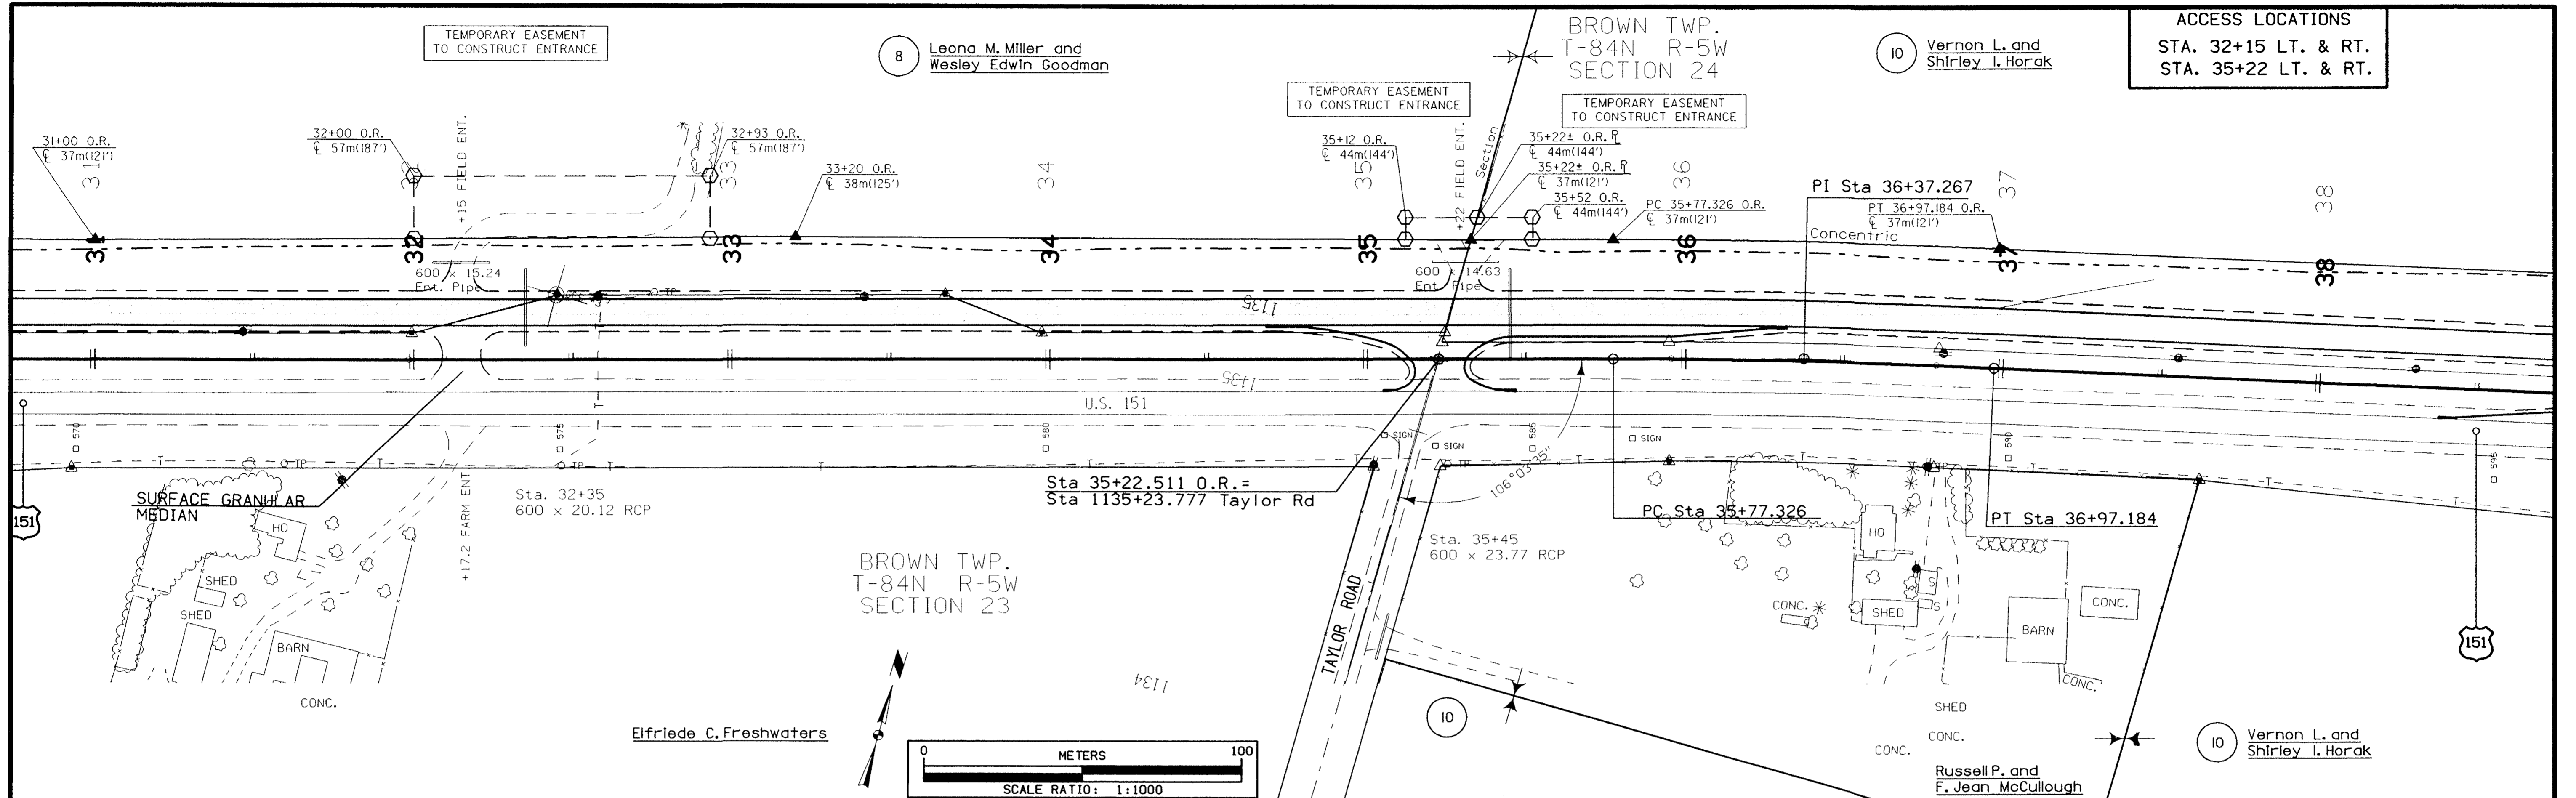


283.202	283.302	283.402	283.502	283.602	283.702	283.802	283.900	283.993	284.082	284.167	284.247	284.322	284.393	284.460	284.522	284.580	284.633	284.682	284.727	284.767	284.802	284.833	284.860	284.882	284.902	284.922	285.502	285.521	285.537	285.549	285.559	285.571	285.571	285.567	285.559	285.549	285.537	285.521	285.502	285.482	285.462	285.442	285.422	285.402
---------	---------	
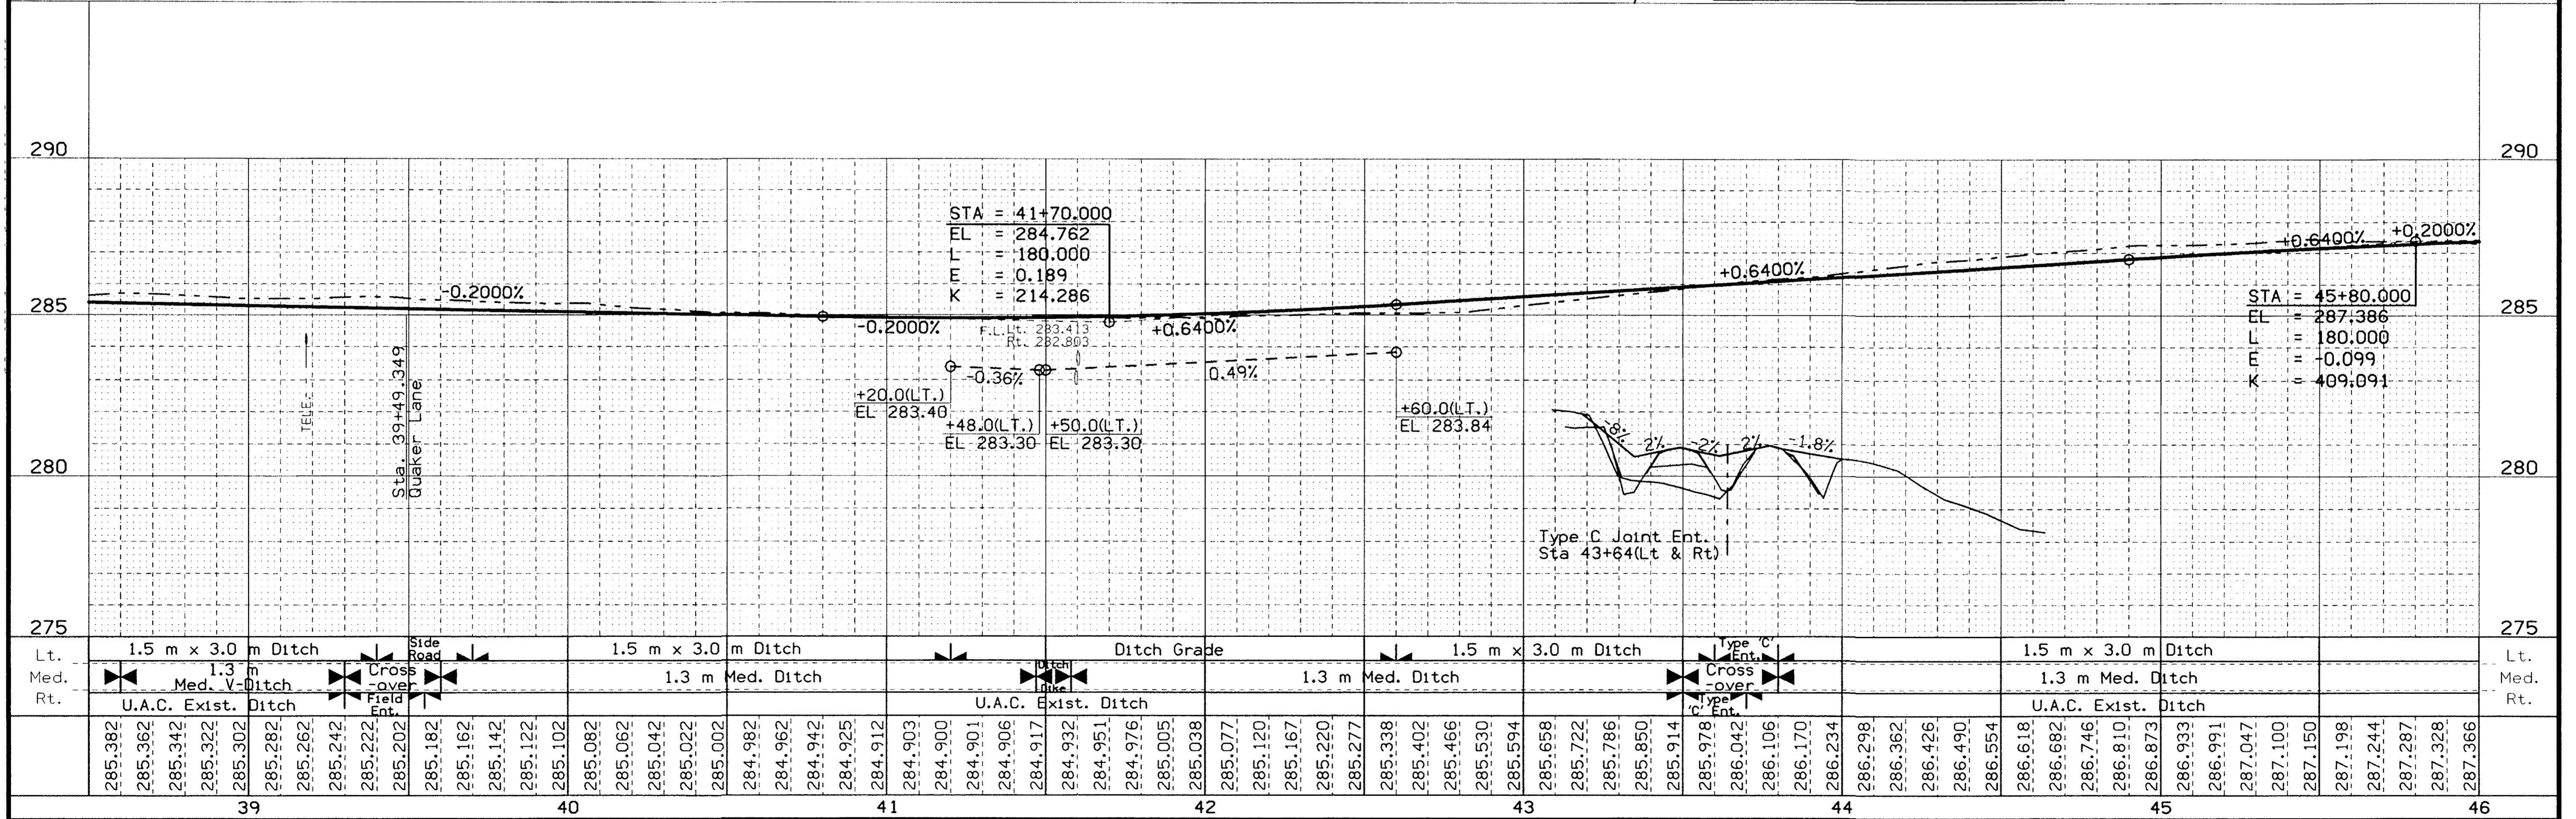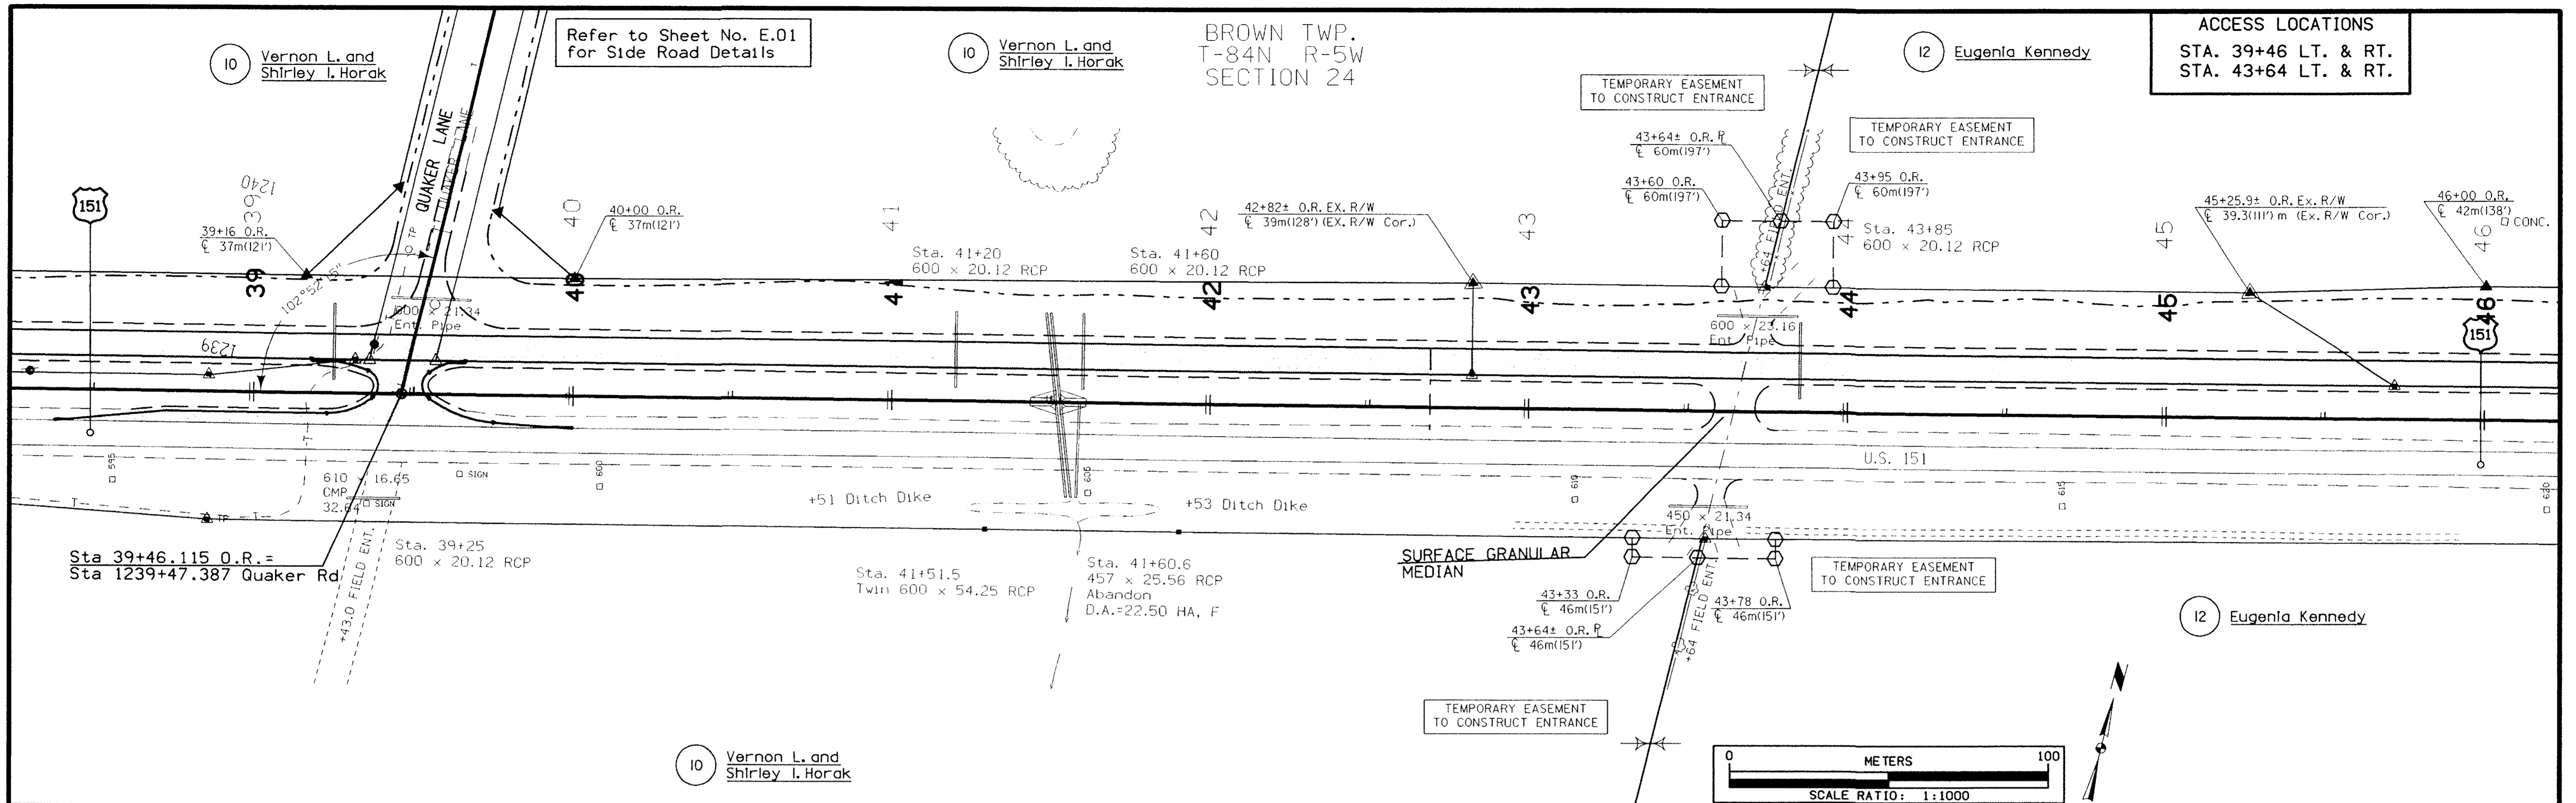

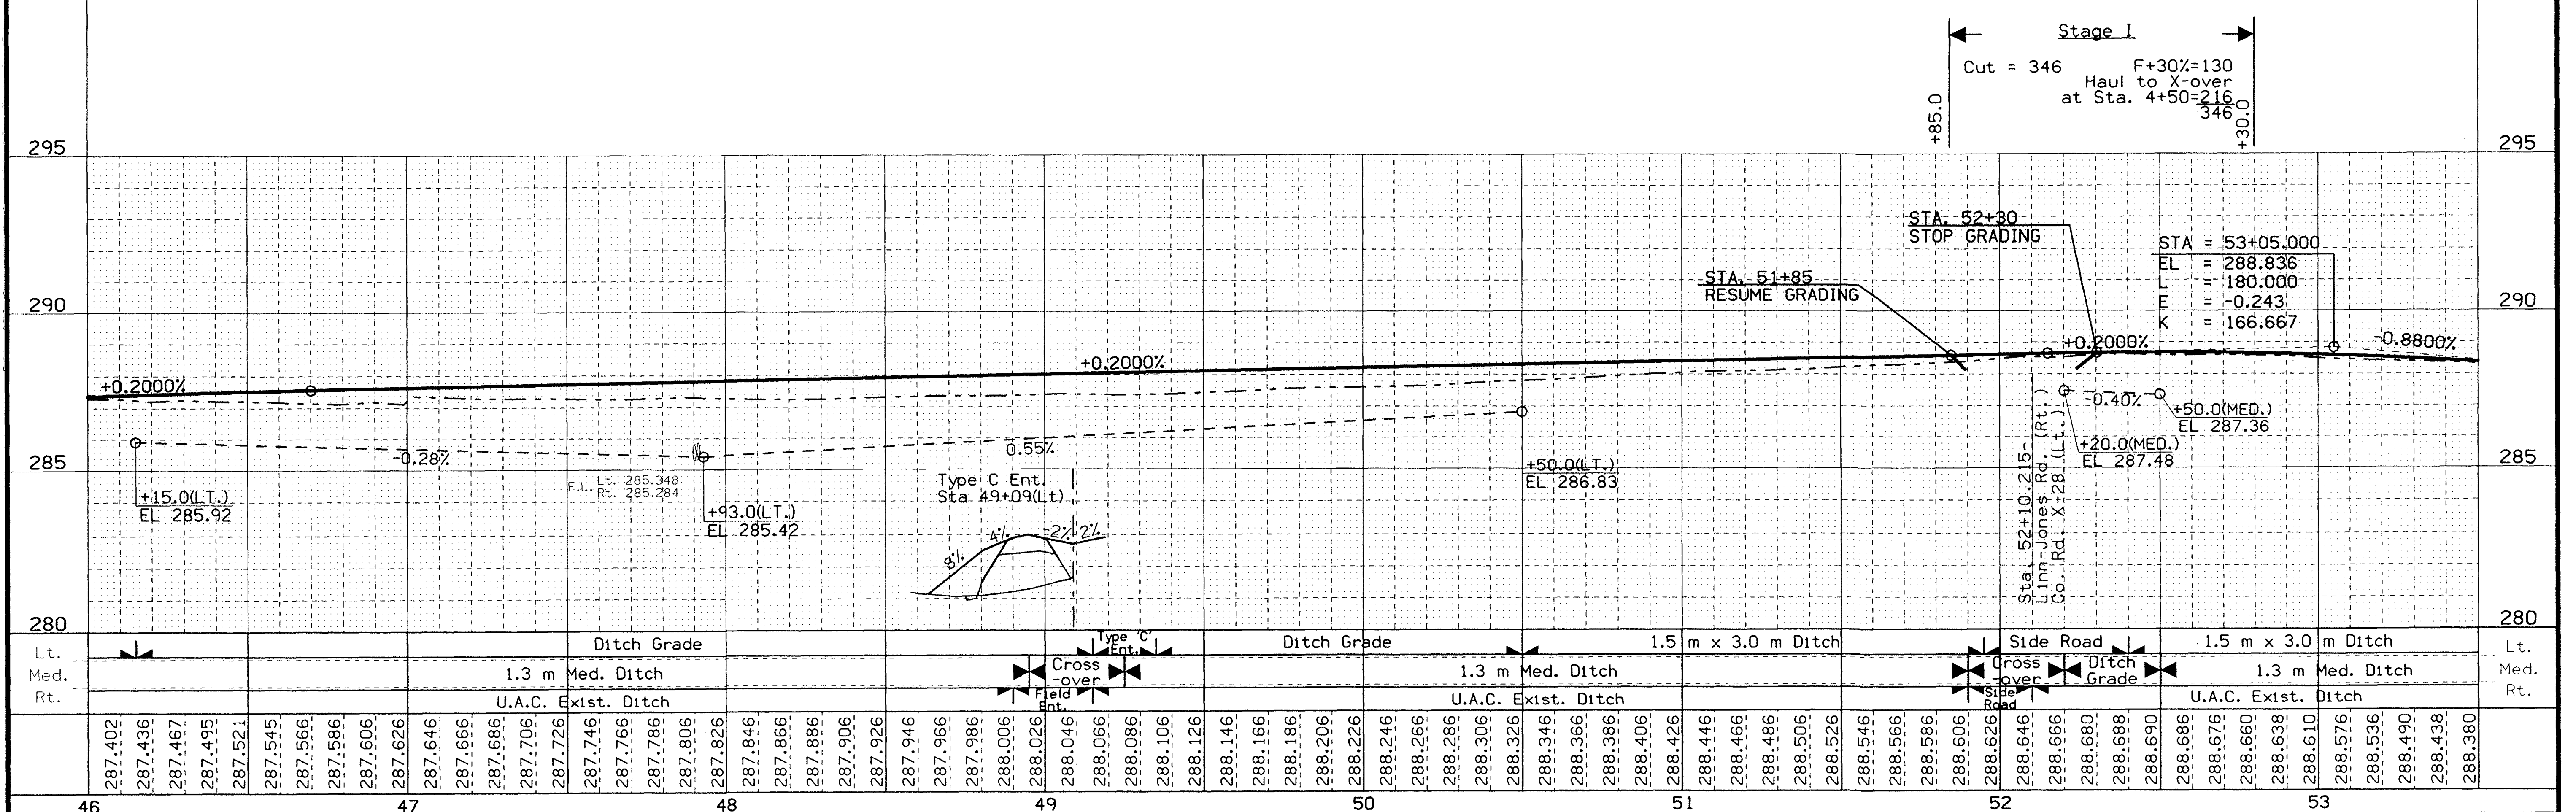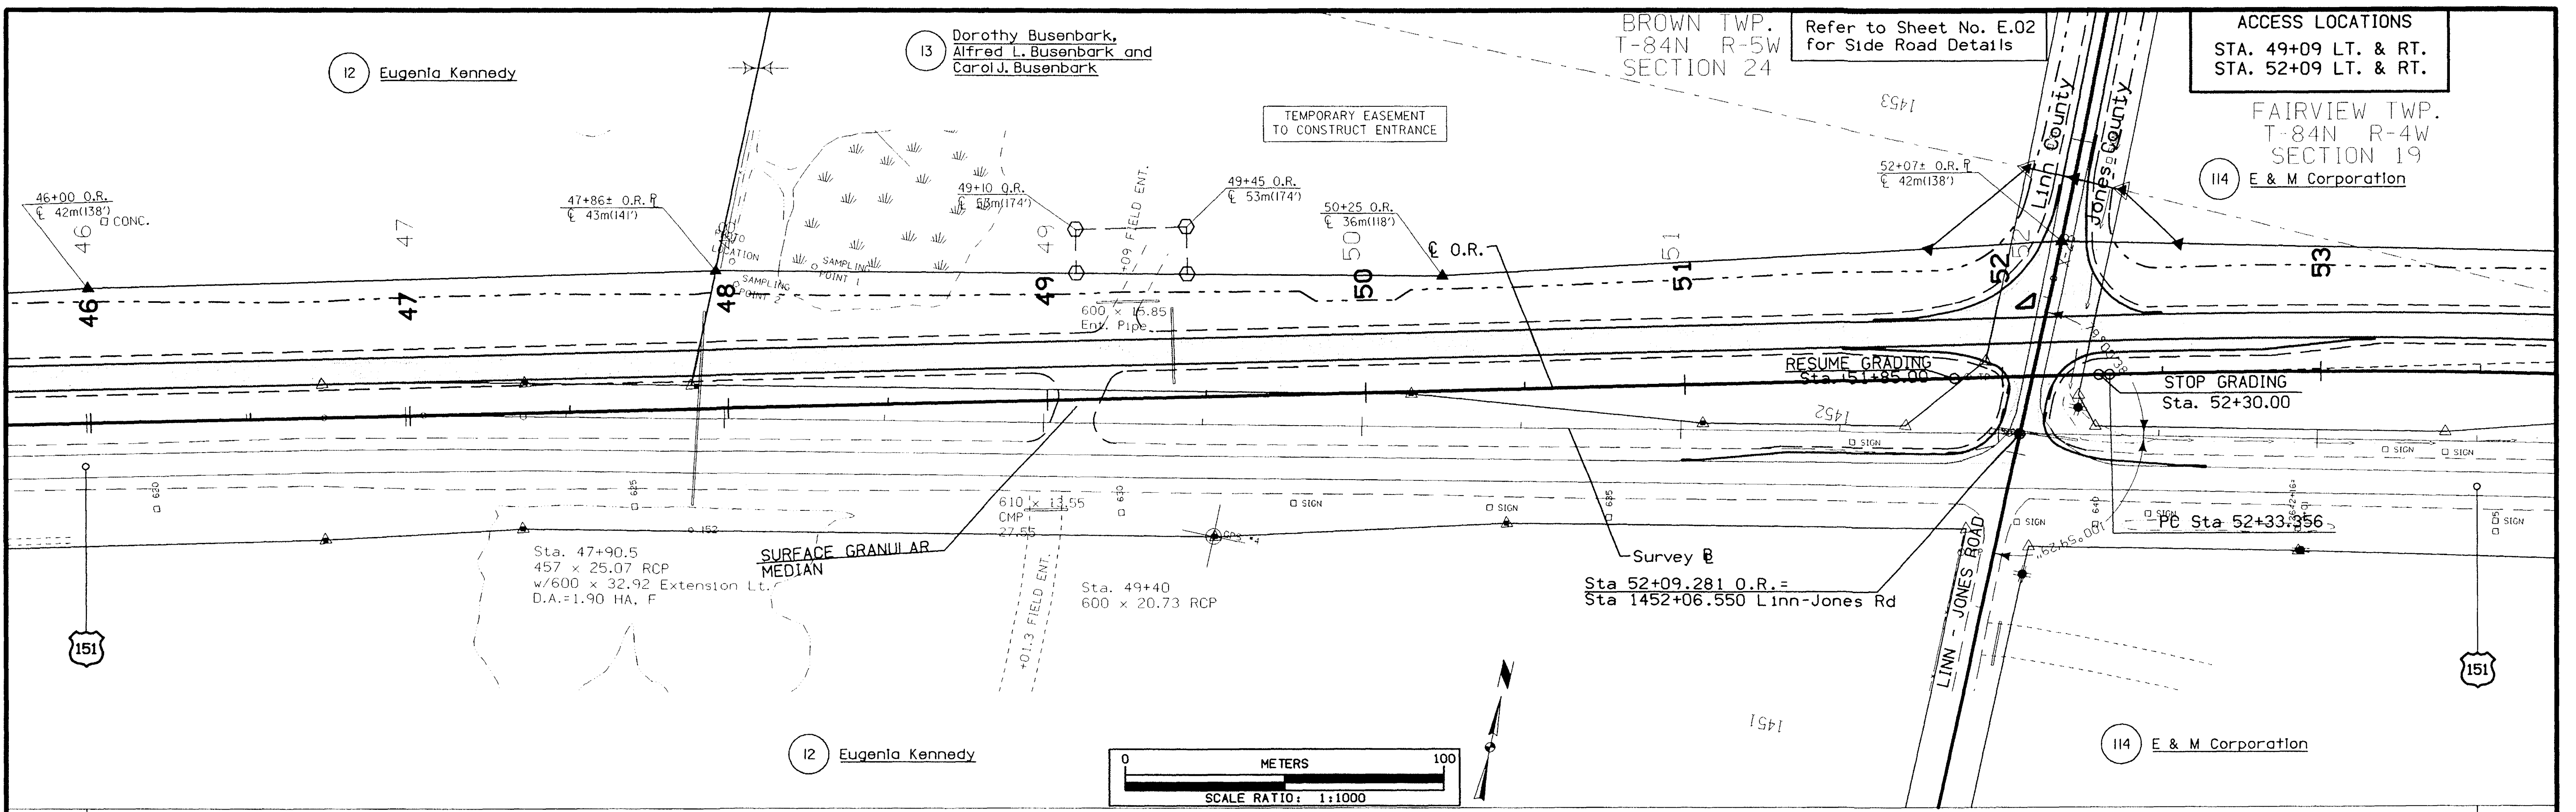



DESIGN TEAM	Skogerboe / EARTH TECH	METRIC	IOWA DOT * OFFICE OF ROAD DESIGN	Linn/Jones	COUNTY	PROJECT NUMBER	NHSX-151-3(112)-3H-57	SHEET NUMBER	D.06
-------------	------------------------	--------	----------------------------------	------------	--------	----------------	-----------------------	--------------	------


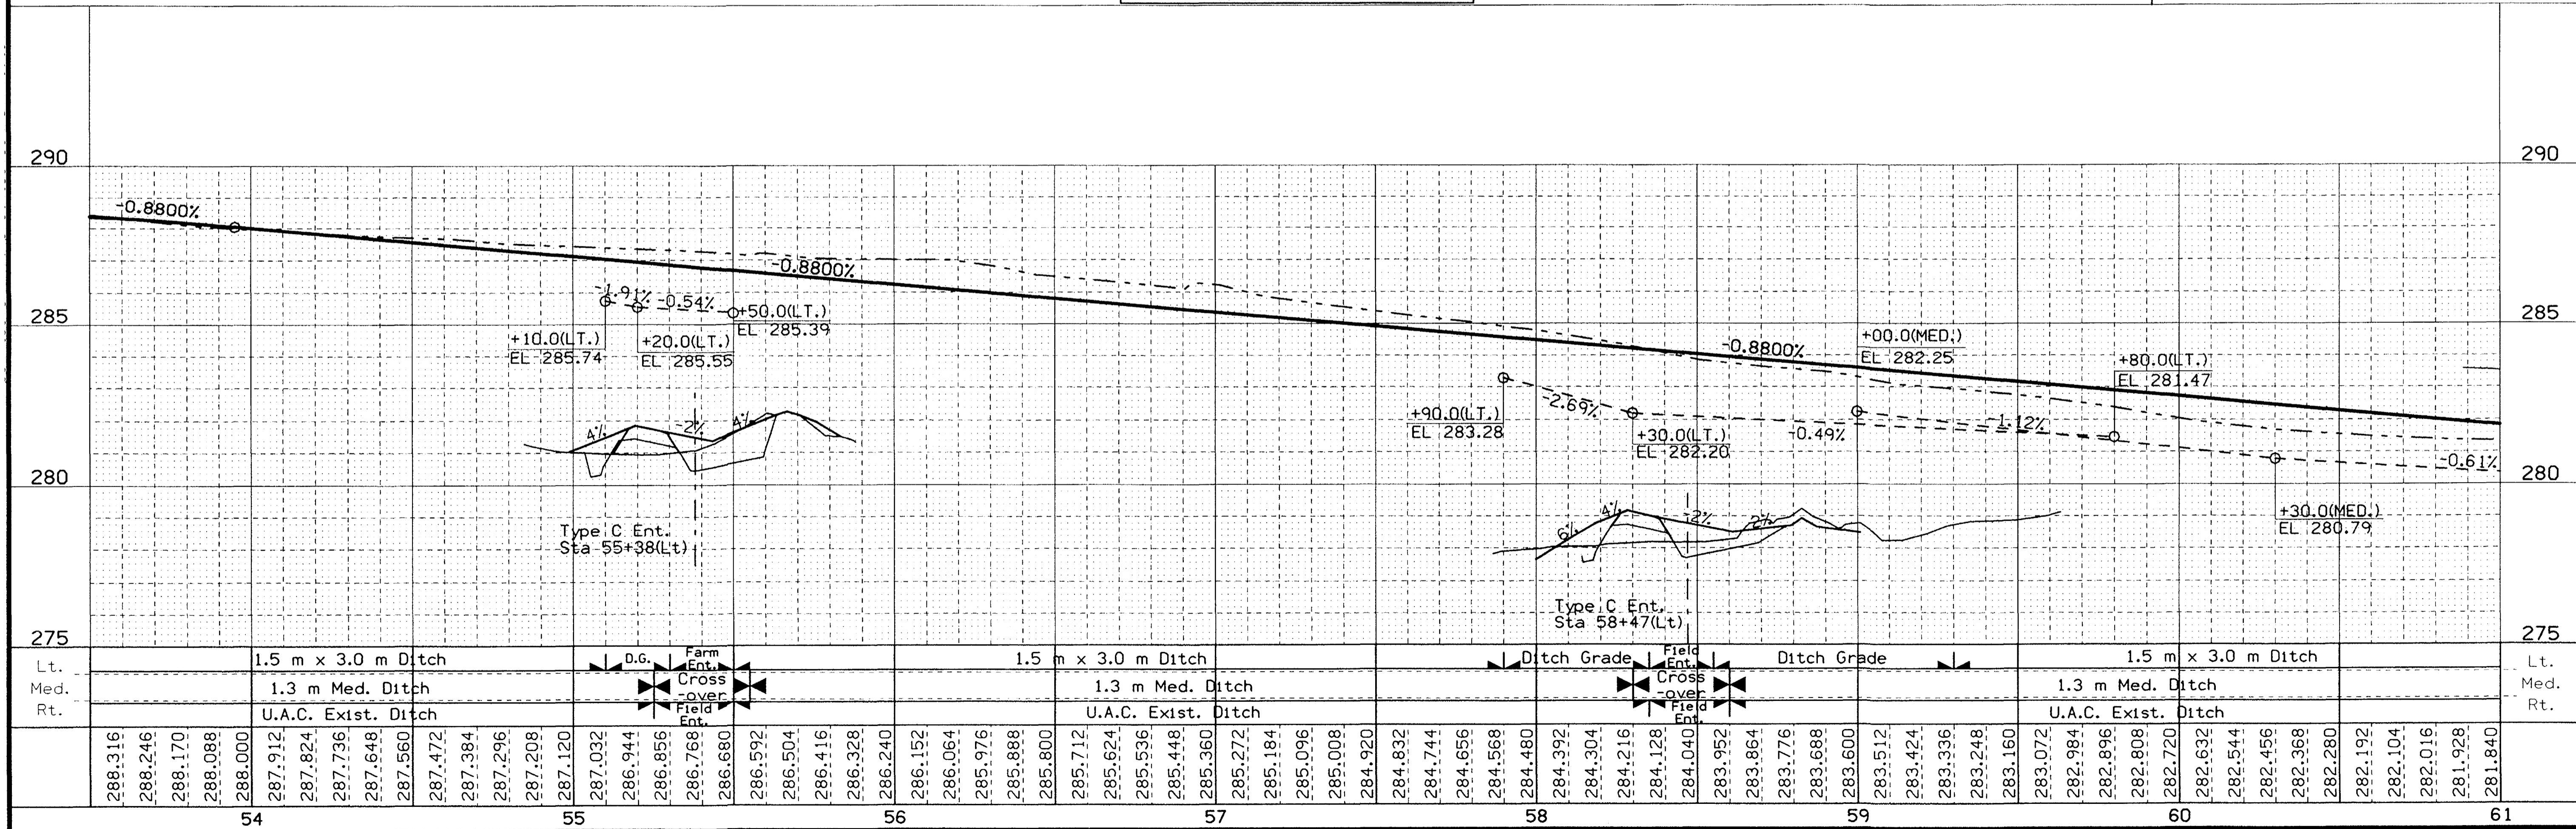
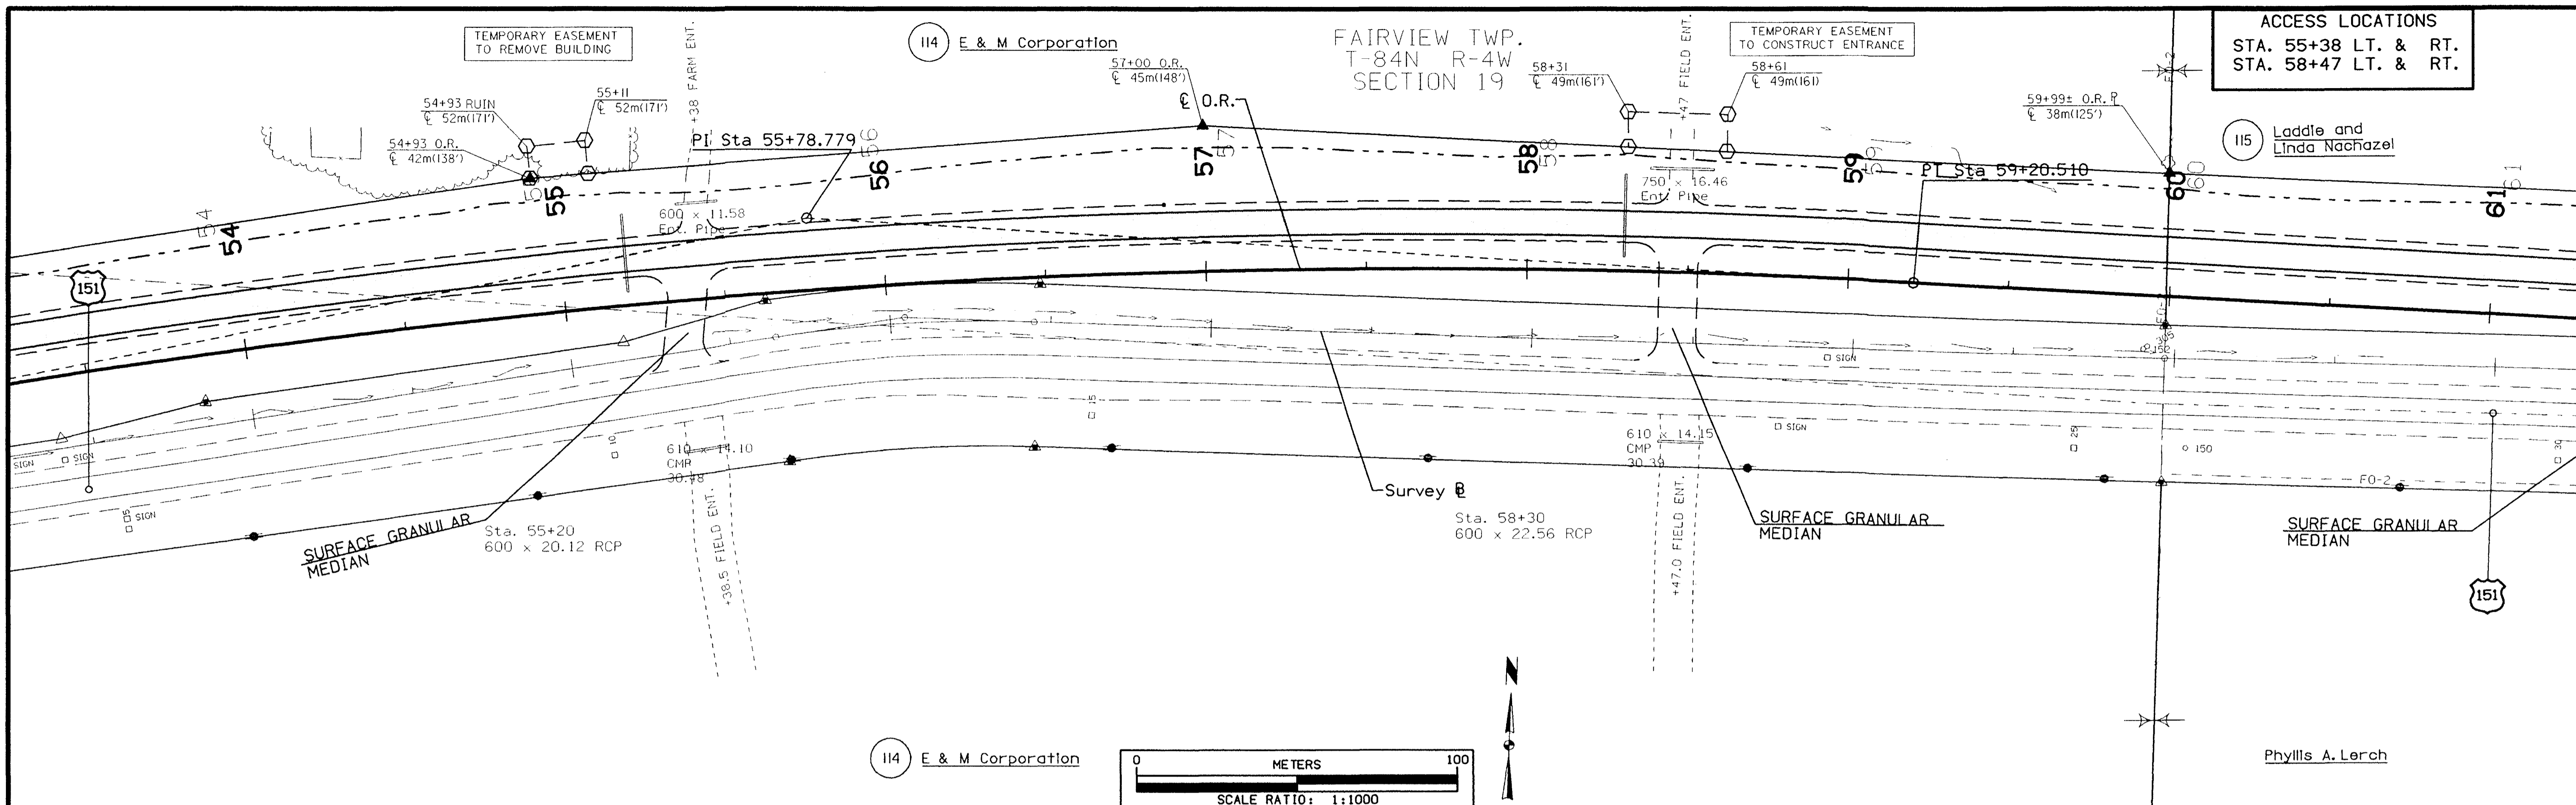


DESIGN TEAM	Skogerboe / EARTH TECH	METRIC	IOWA DOT * OFFICE OF ROAD DESIGN	Linn/Jones	COUNTY	PROJECT NUMBER	NHSX-151-3(112)--3H-57	SHEET NUMBER	D.07
-------------	------------------------	--------	----------------------------------	------------	--------	----------------	------------------------	--------------	------

date = Thu Oct 5 13:21:42 2000 prf = \\WATSO1\DATA\PL0T\PL463P\nd07h.prf

42-198

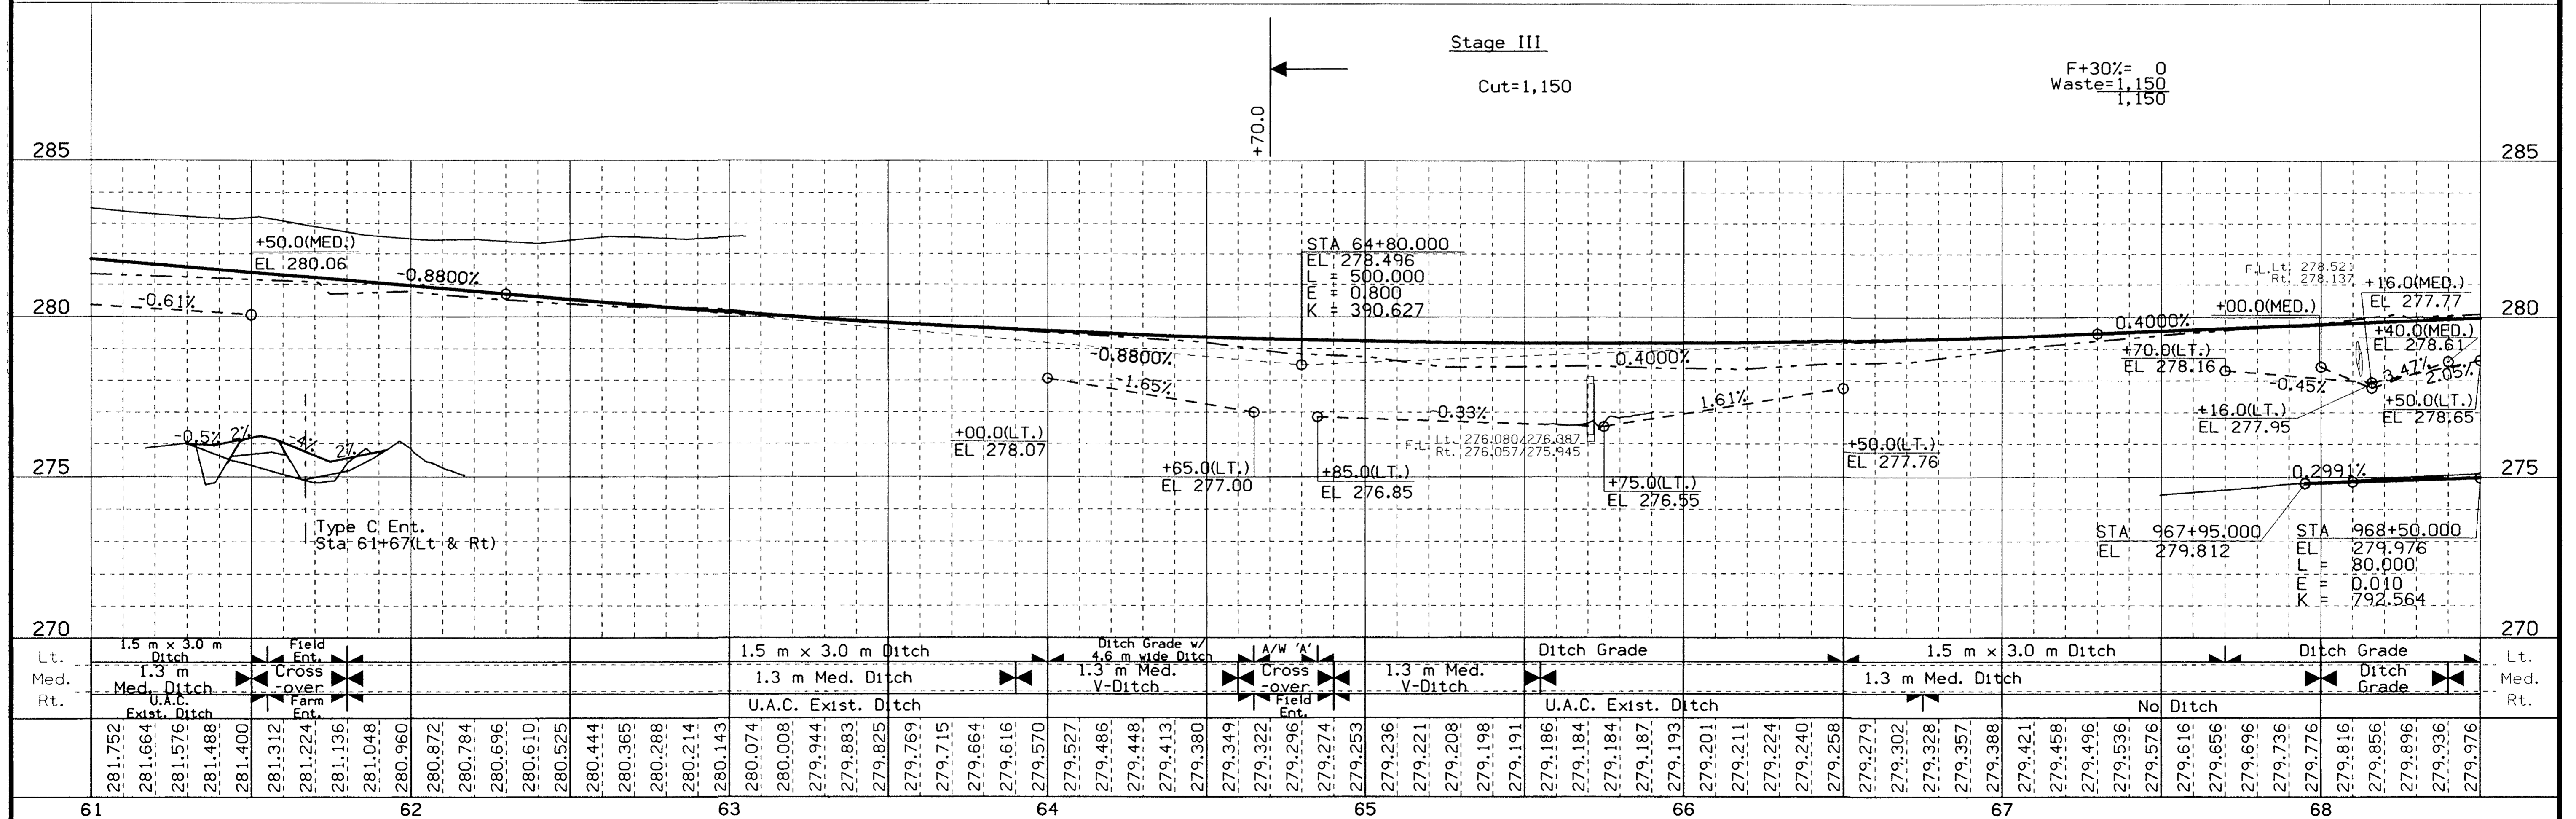
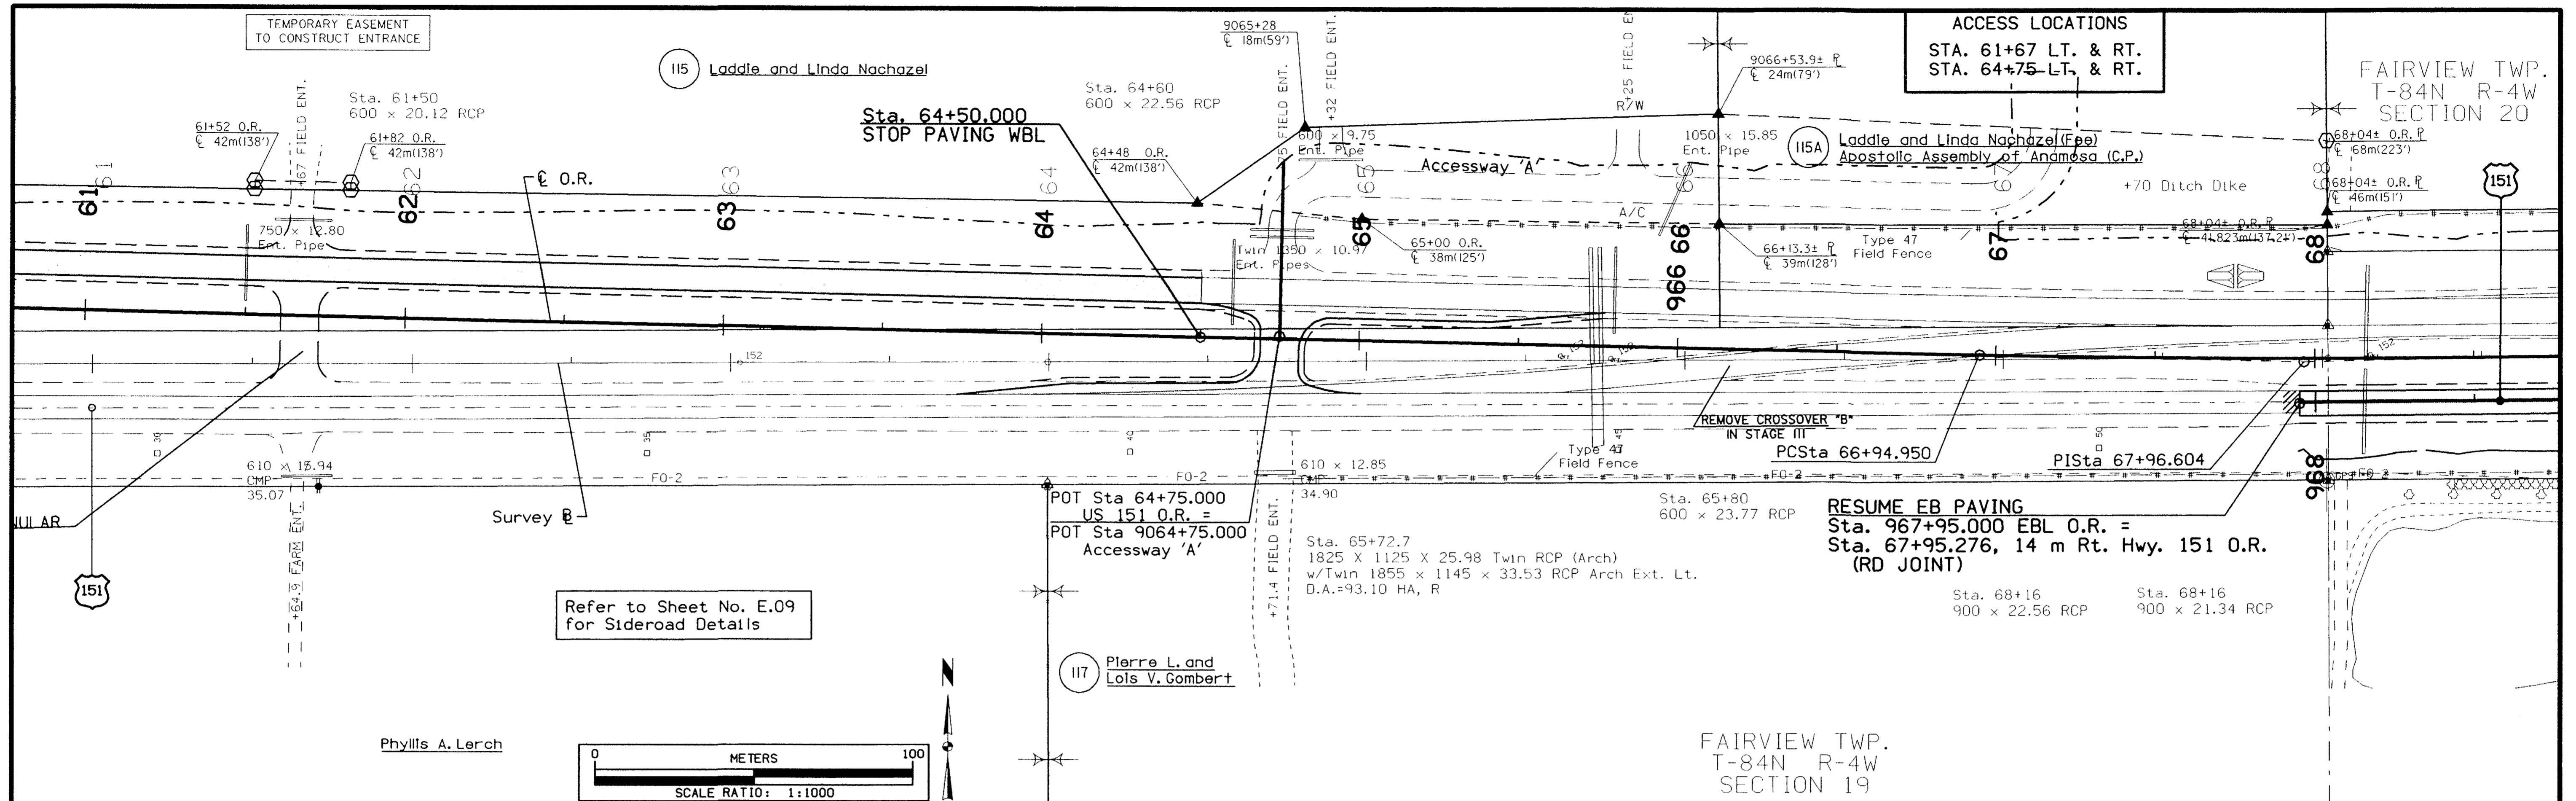


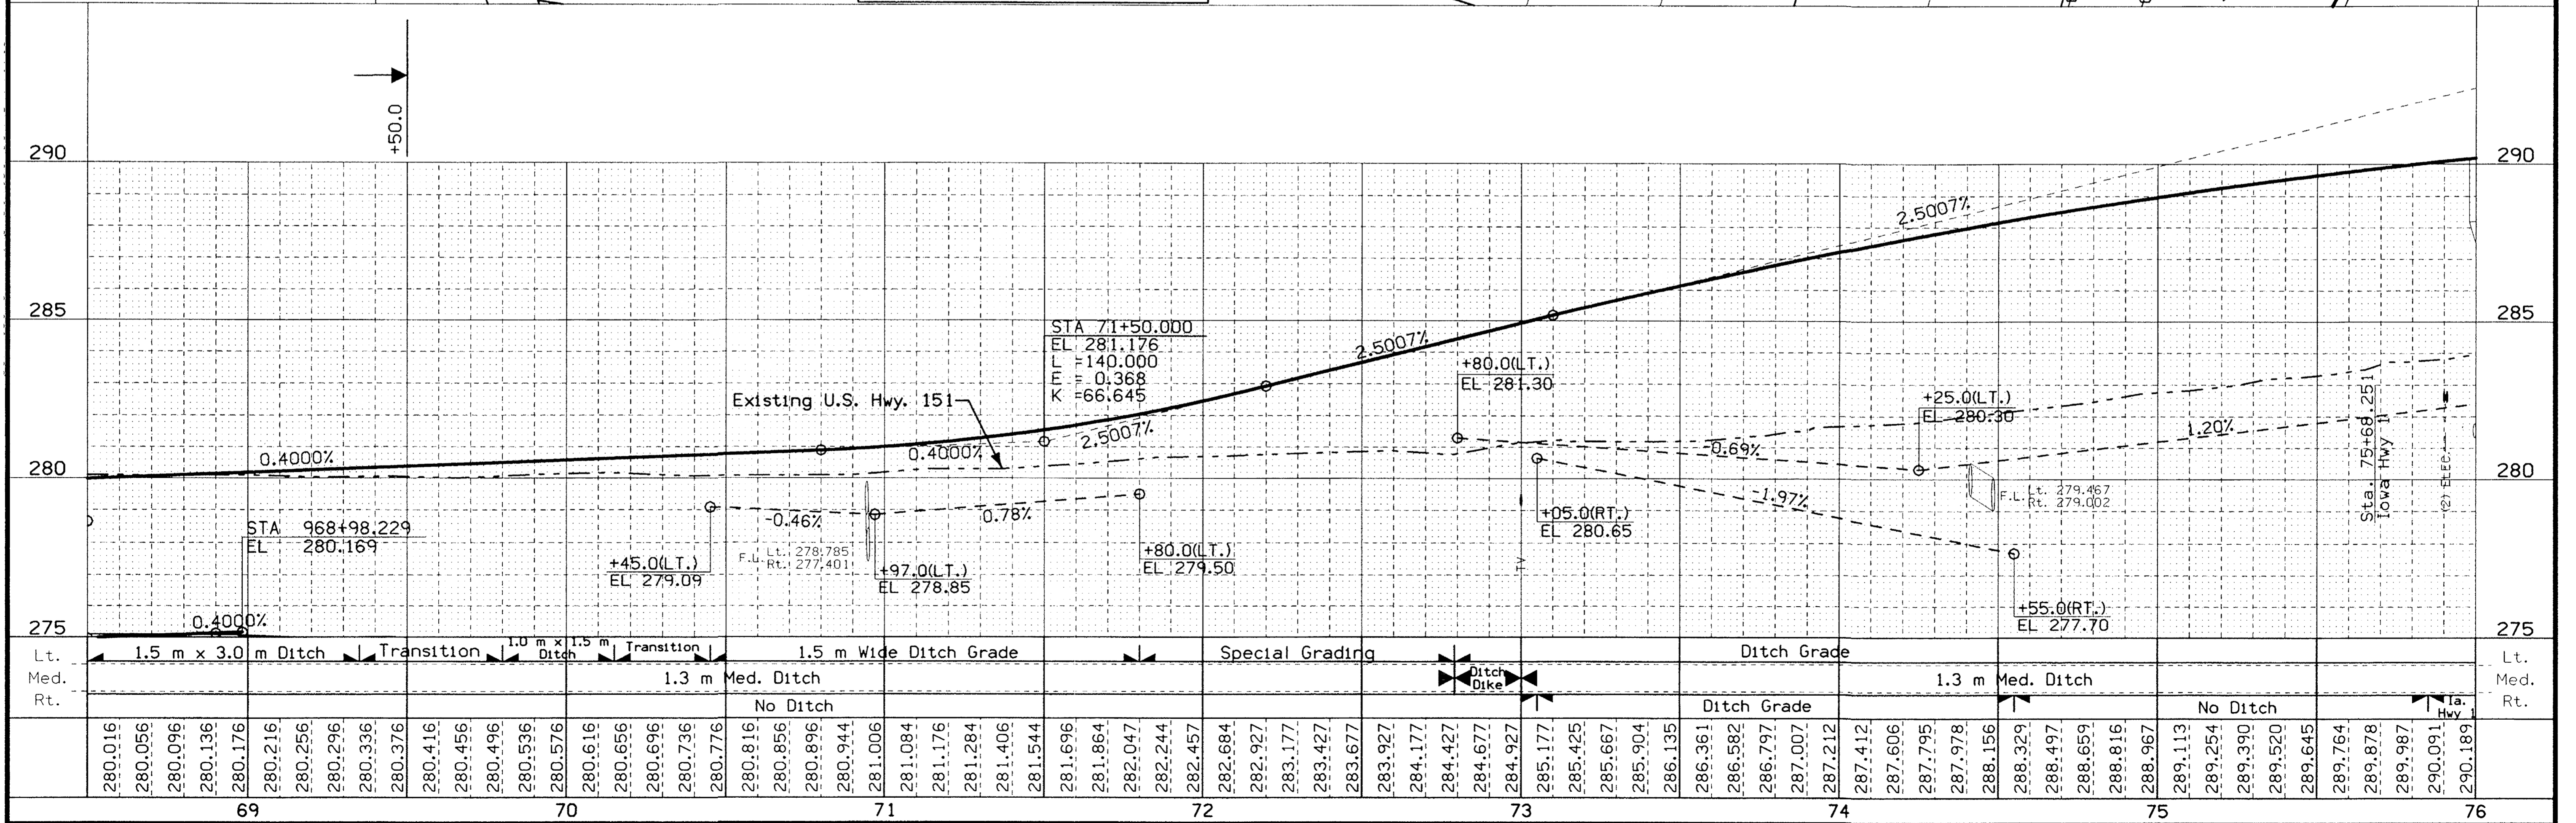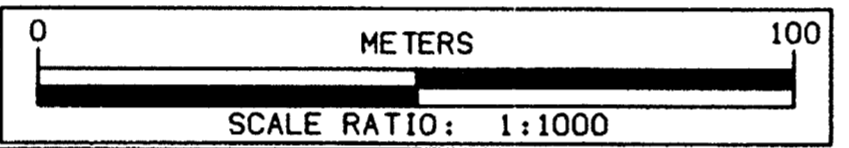
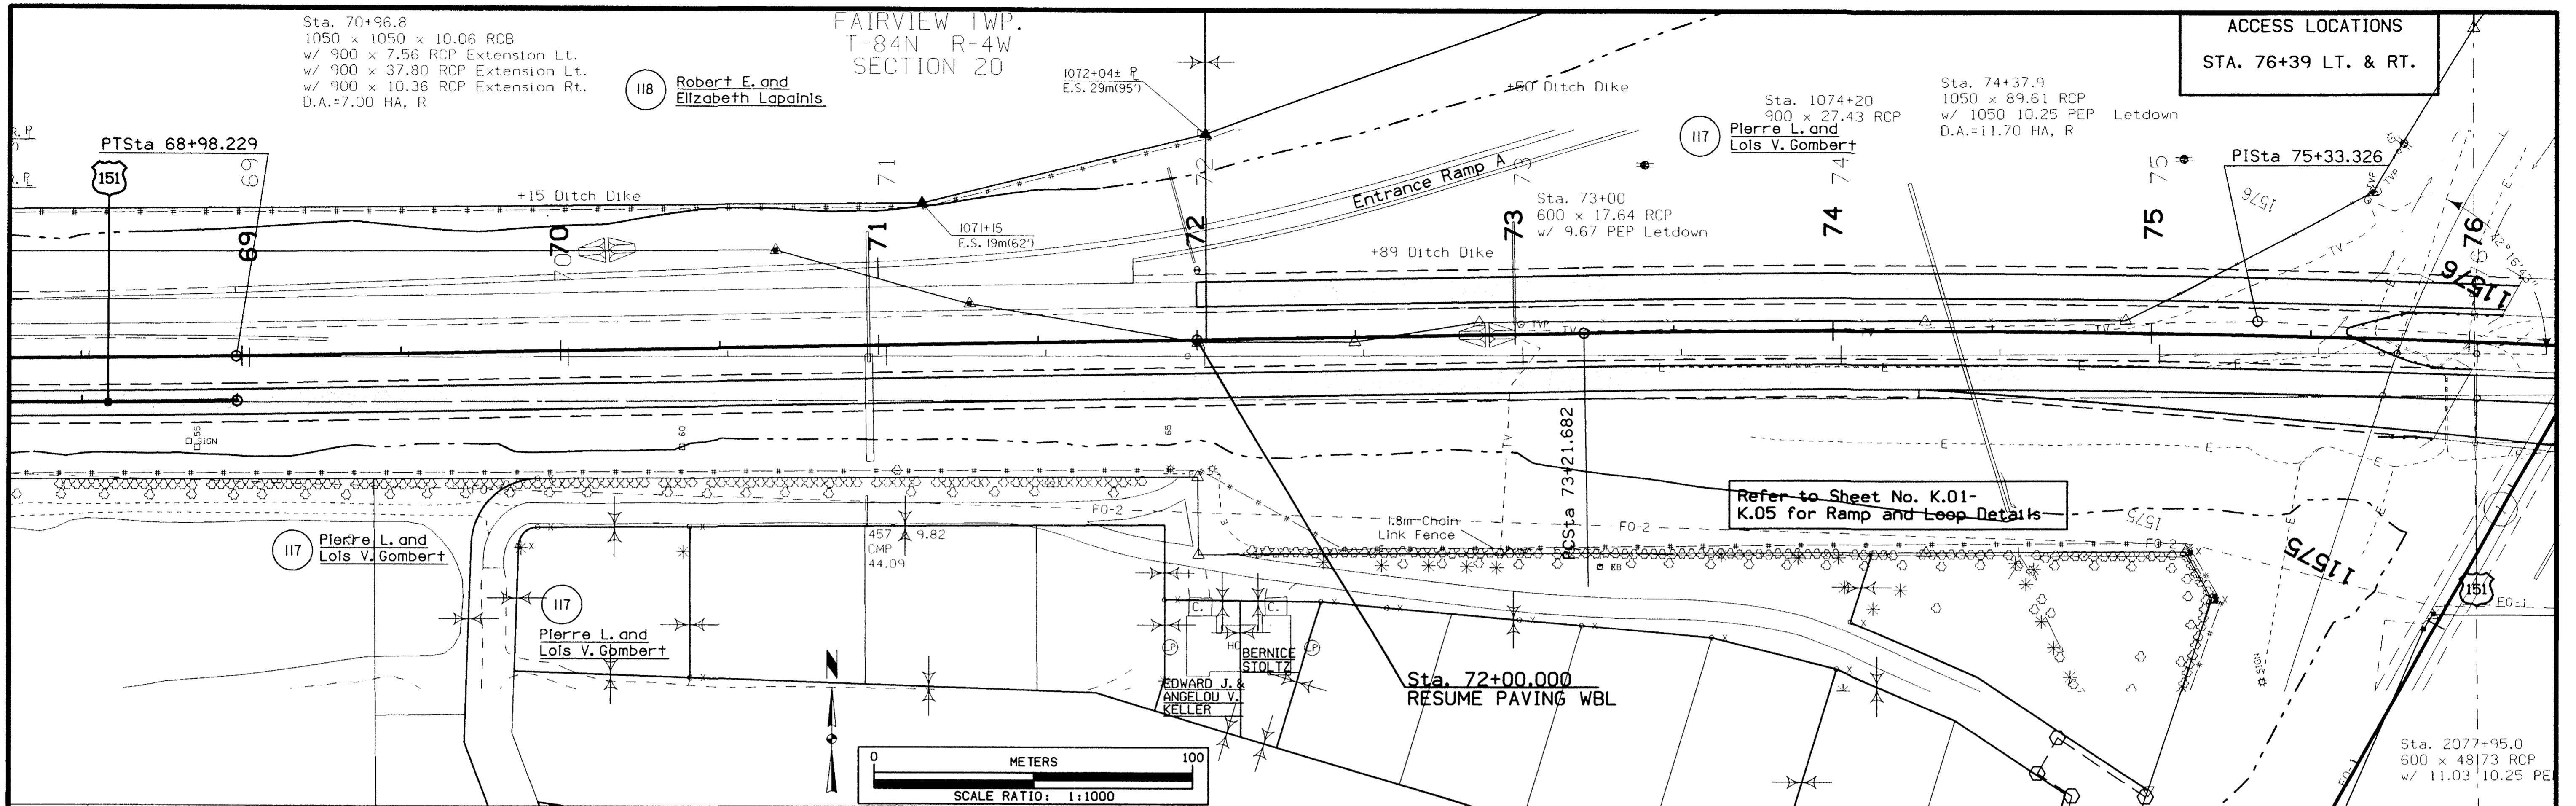


DESIGN TEAM	Skogerboe / EARTH TECH	METRIC	IOWA DOT * OFFICE OF ROAD DESIGN	Linn/Jones	COUNTY	PROJECT NUMBER	NHSX-151-3(112)--3H-57	SHEET NUMBER	D.09
-------------	------------------------	--------	----------------------------------	------------	--------	----------------	------------------------	--------------	------

date = Thu Oct 5 13:22:20 2000 prf = \\WATS01\DATA\PL0T\PL463P\nd09h.prf

44-198

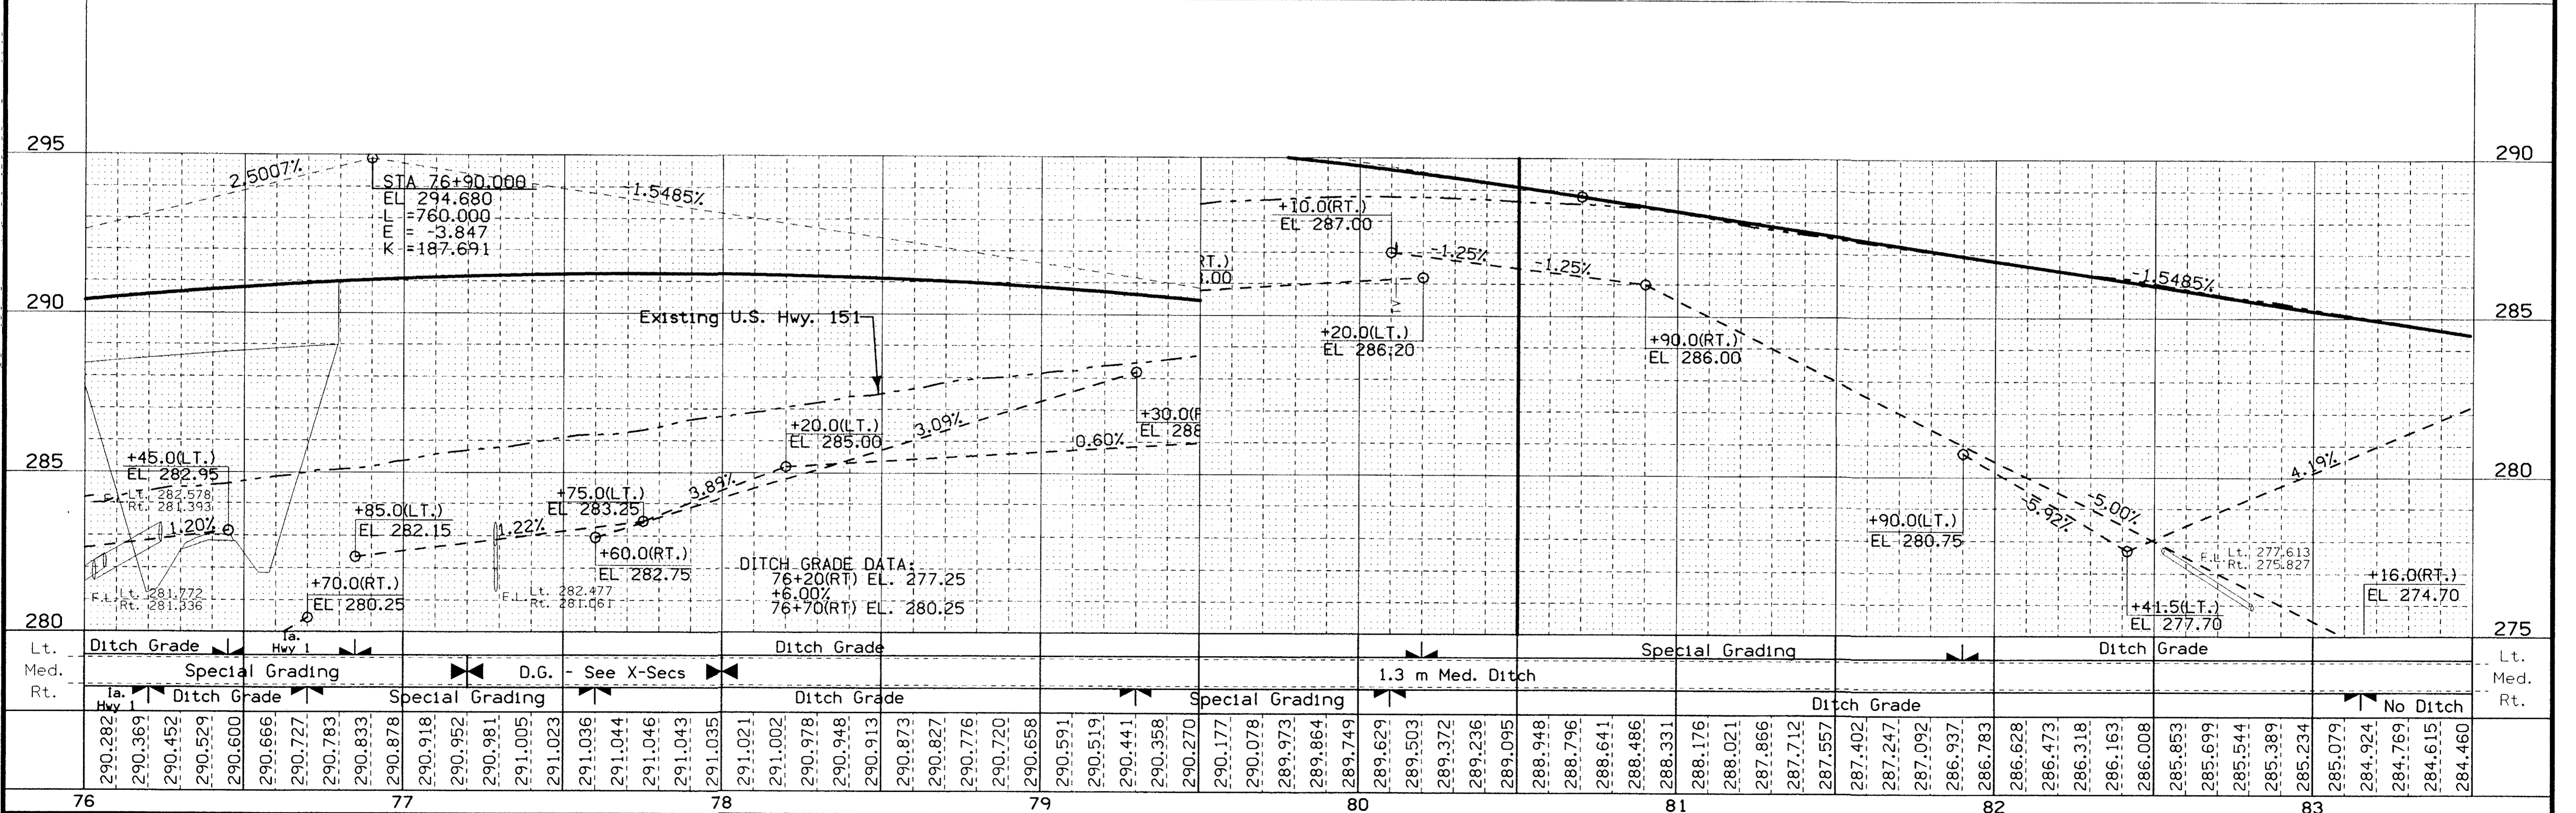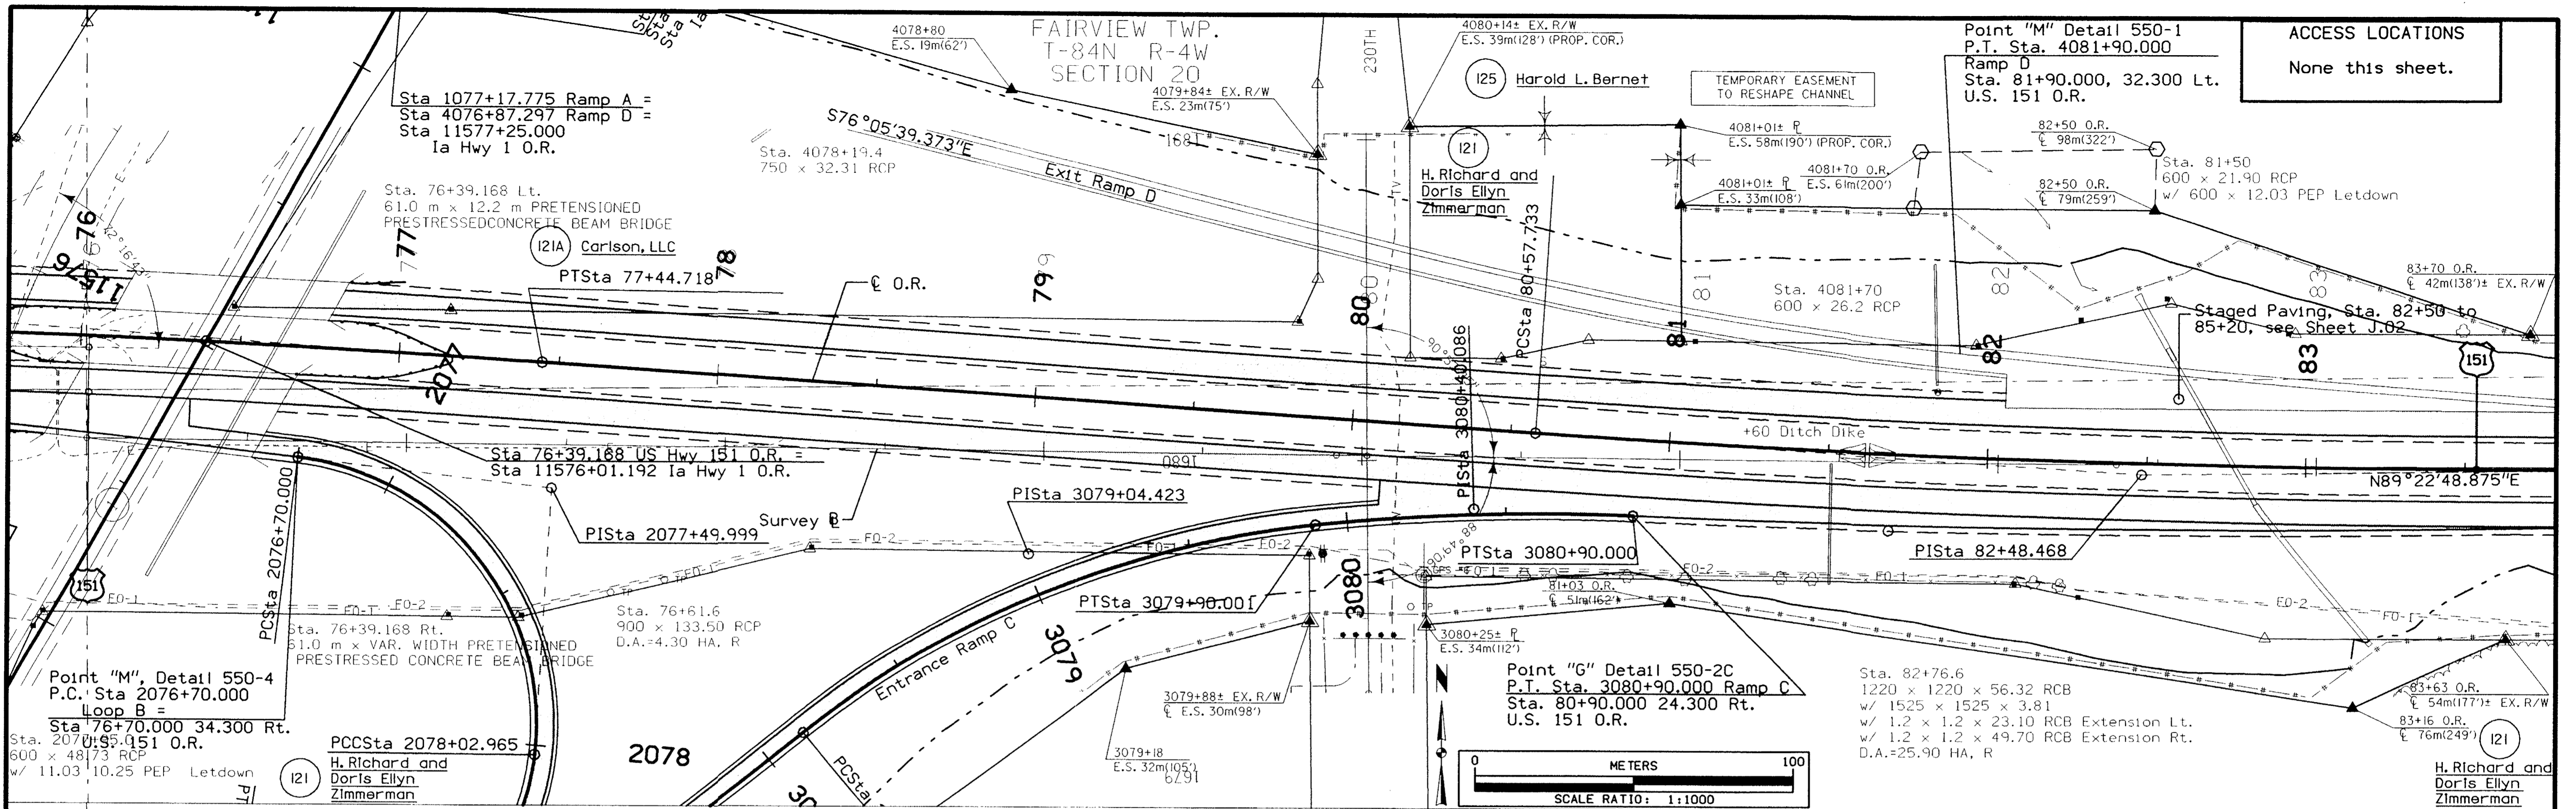

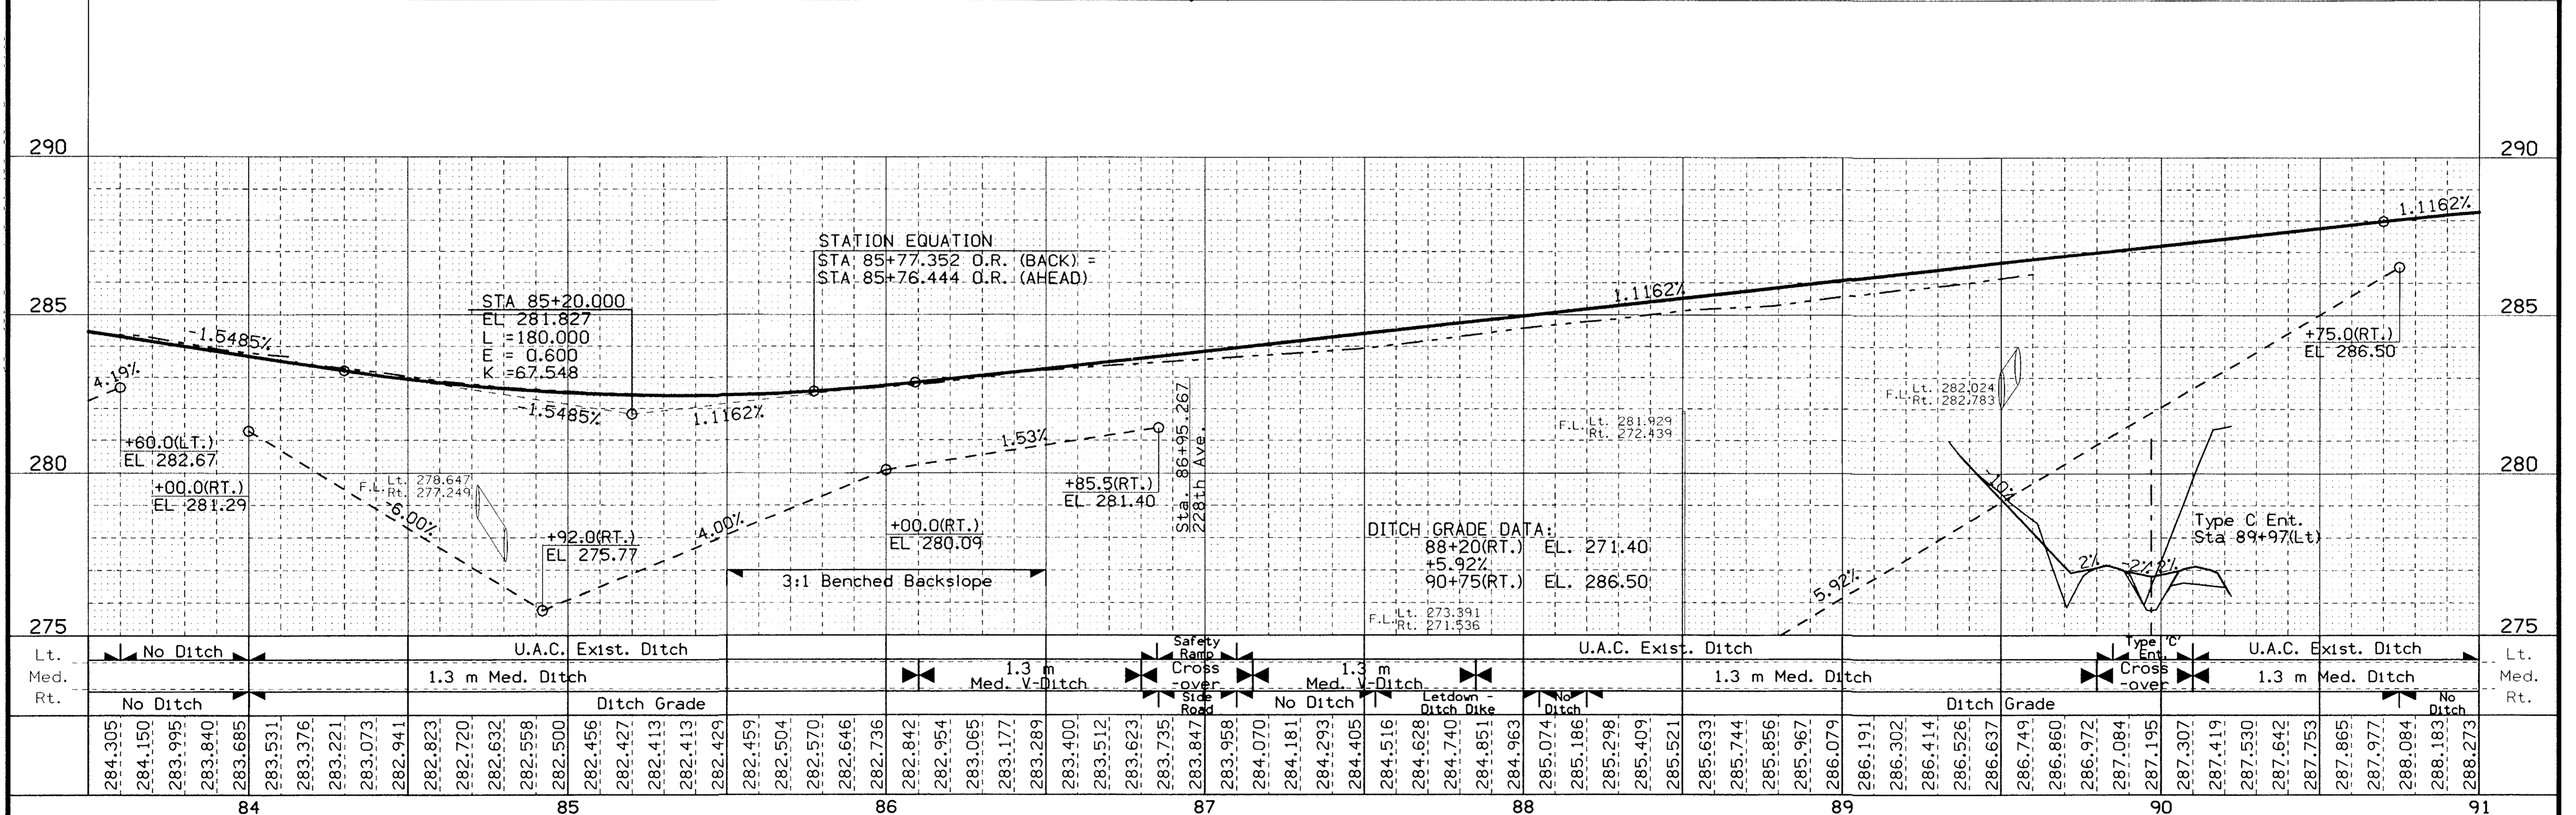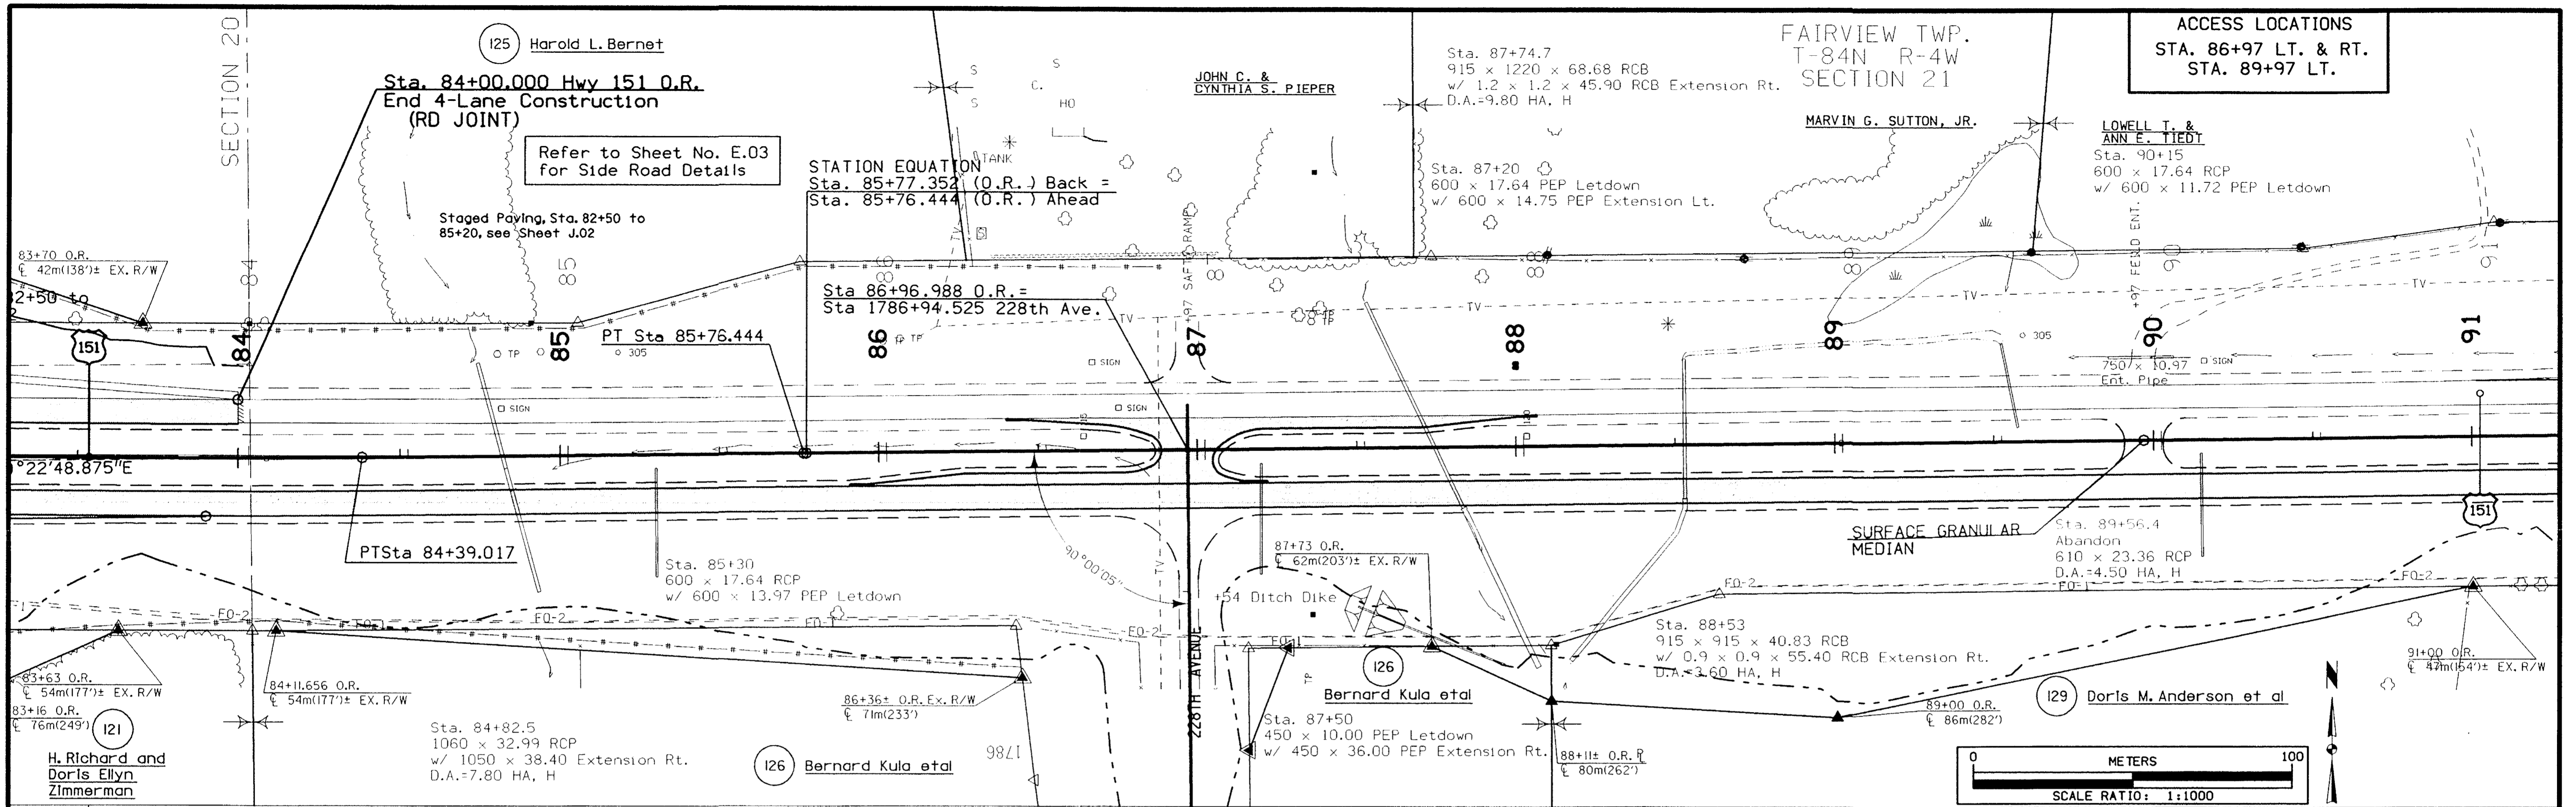

FAIRVIEW TWP.
T-84N R-4W
SECTION 21

Sta. 93+30.2
610 x 915 x 64.63 RCB
w/ 0.9 x 0.9 x 54.20 RCB Extension Rt.
D.A.=4.10 HA, H

Sta. 94+83.8
610 x 915 x 58.98 RCB
w/ 0.9 x 0.9 x 45.40 RCB Extension Rt.
D.A.=1.50 HA, H

LOWELL T. &
ANN E. TIEDT



Sta. 95+00
600 x 17.64 PEP Letdown
w/ 600 x 37.79 PEP Extension Rt.

ACCESS LOCATIONS
STA. 95+18 LT. & RT.
STA. 98+18 LT. & RT.



LYLE & PATRICIA A. THEISEN

Sta. 98+03.9
600 x 16.42 PEP Letdown
w/ 600 x 35.57 PEP Extension Rt.

GARY L. & PHYLLIS C. HUSMANN

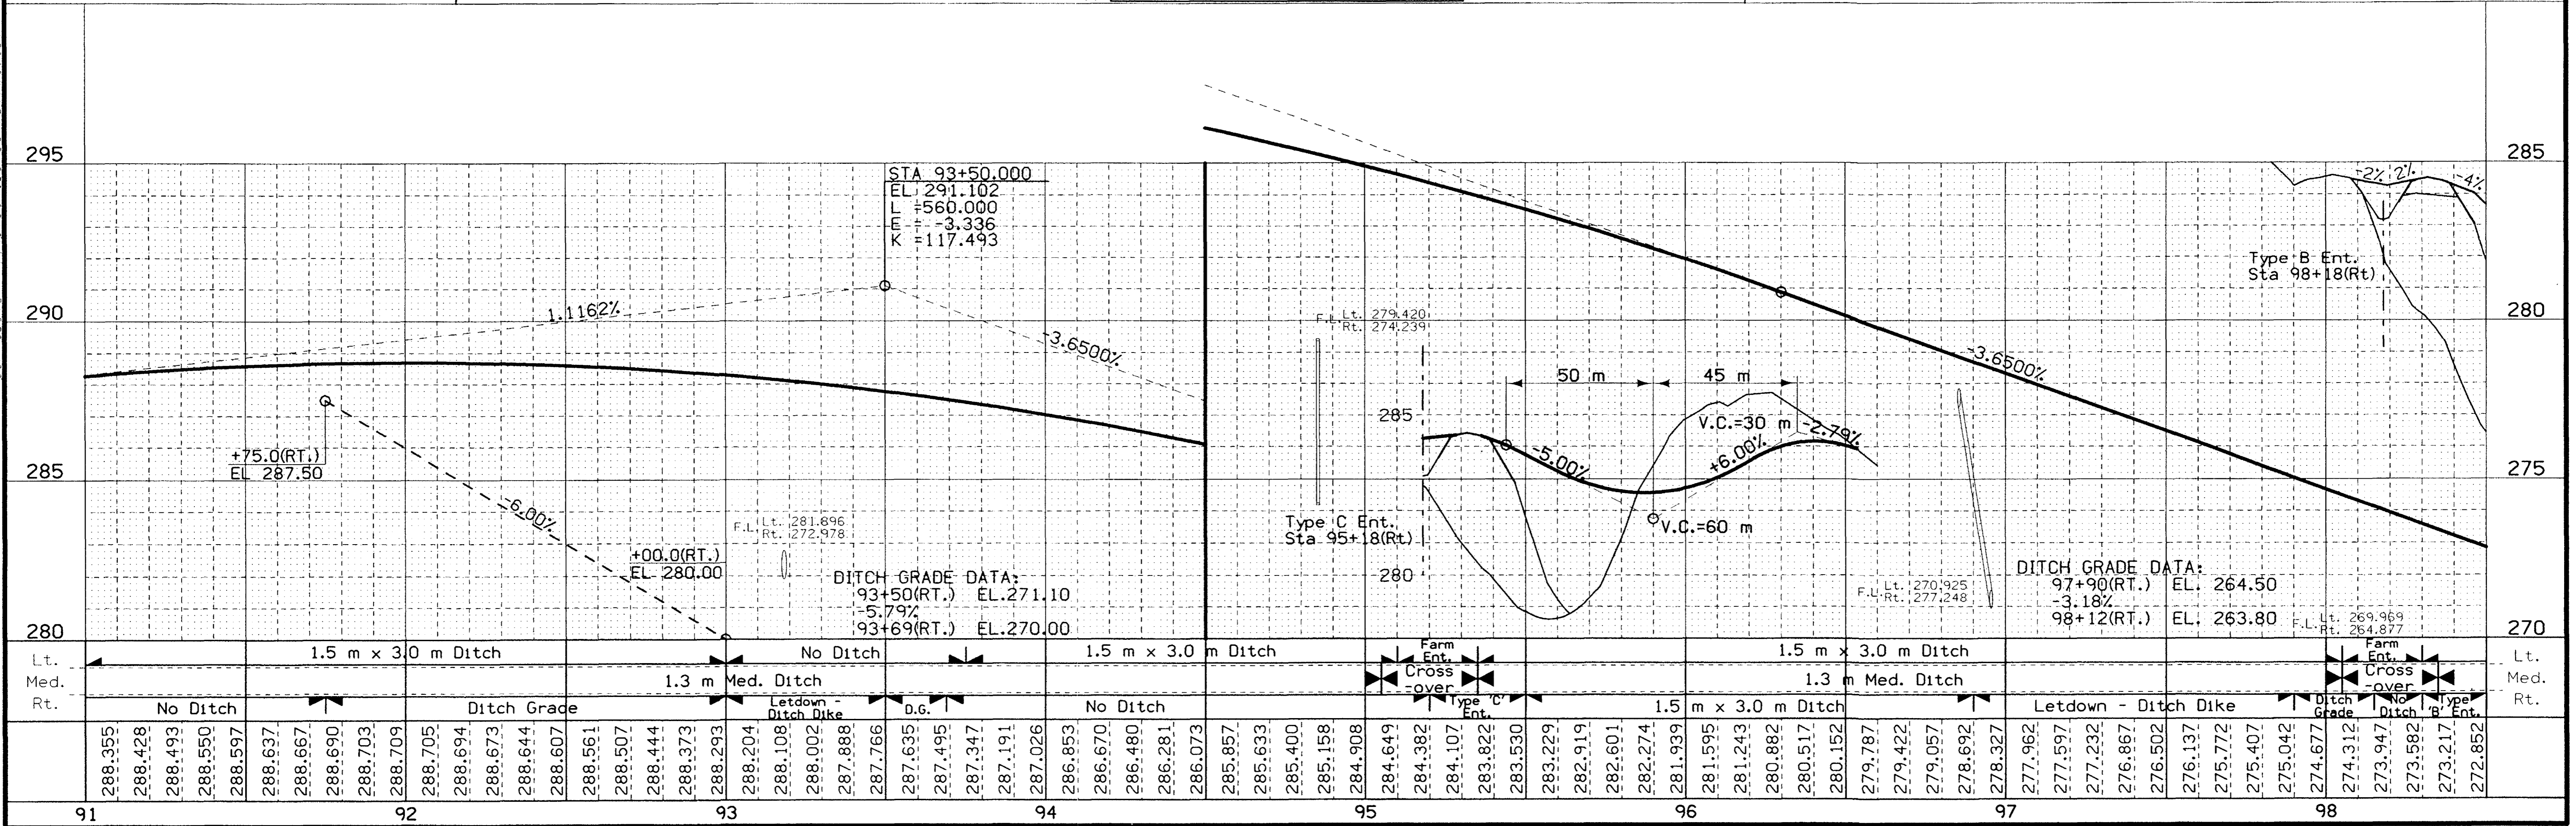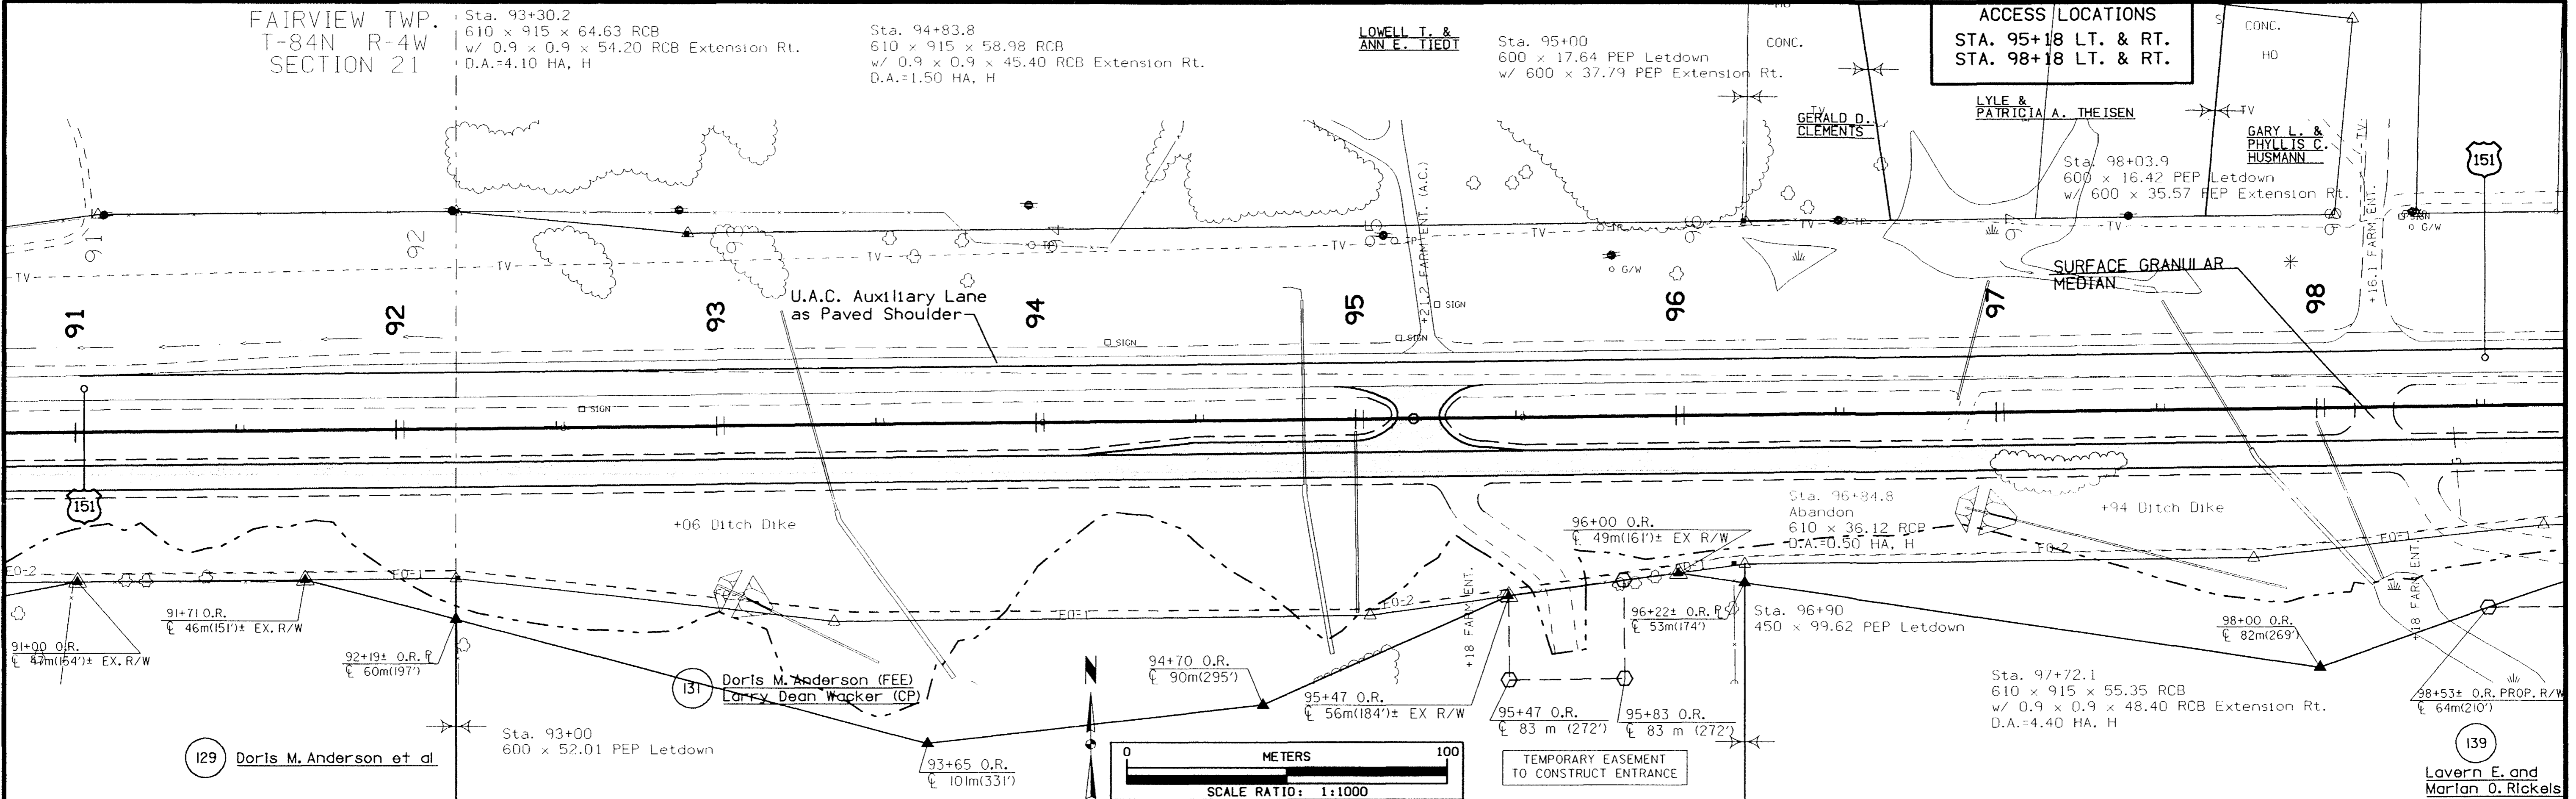

91	288.355	288.428	288.493	288.550	288.597	288.637	288.667	288.690	288.703	288.709	288.705	288.694	288.673	288.644	288.607	288.561	288.507	288.444	288.373	288.293	288.204	288.108	288.002	287.888	287.766	287.635	287.495	287.347	287.191	287.026	286.853	286.670	286.480	286.281	286.073	285.857	285.633	285.400	285.158	284.908	284.649	284.382	284.107	283.822	283.530	283.229	282.919	282.601	282.274	281.939	281.595	281.243	280.882	280.517	280.152	279.787	279.422	279.057	287.692	278.327	277.962	277.597	277.232	276.867	276.502	276.137	275.772	275.407	275.042	274.677	274.312	273.947	273.582	273.217	272.852
----	---------	---------	
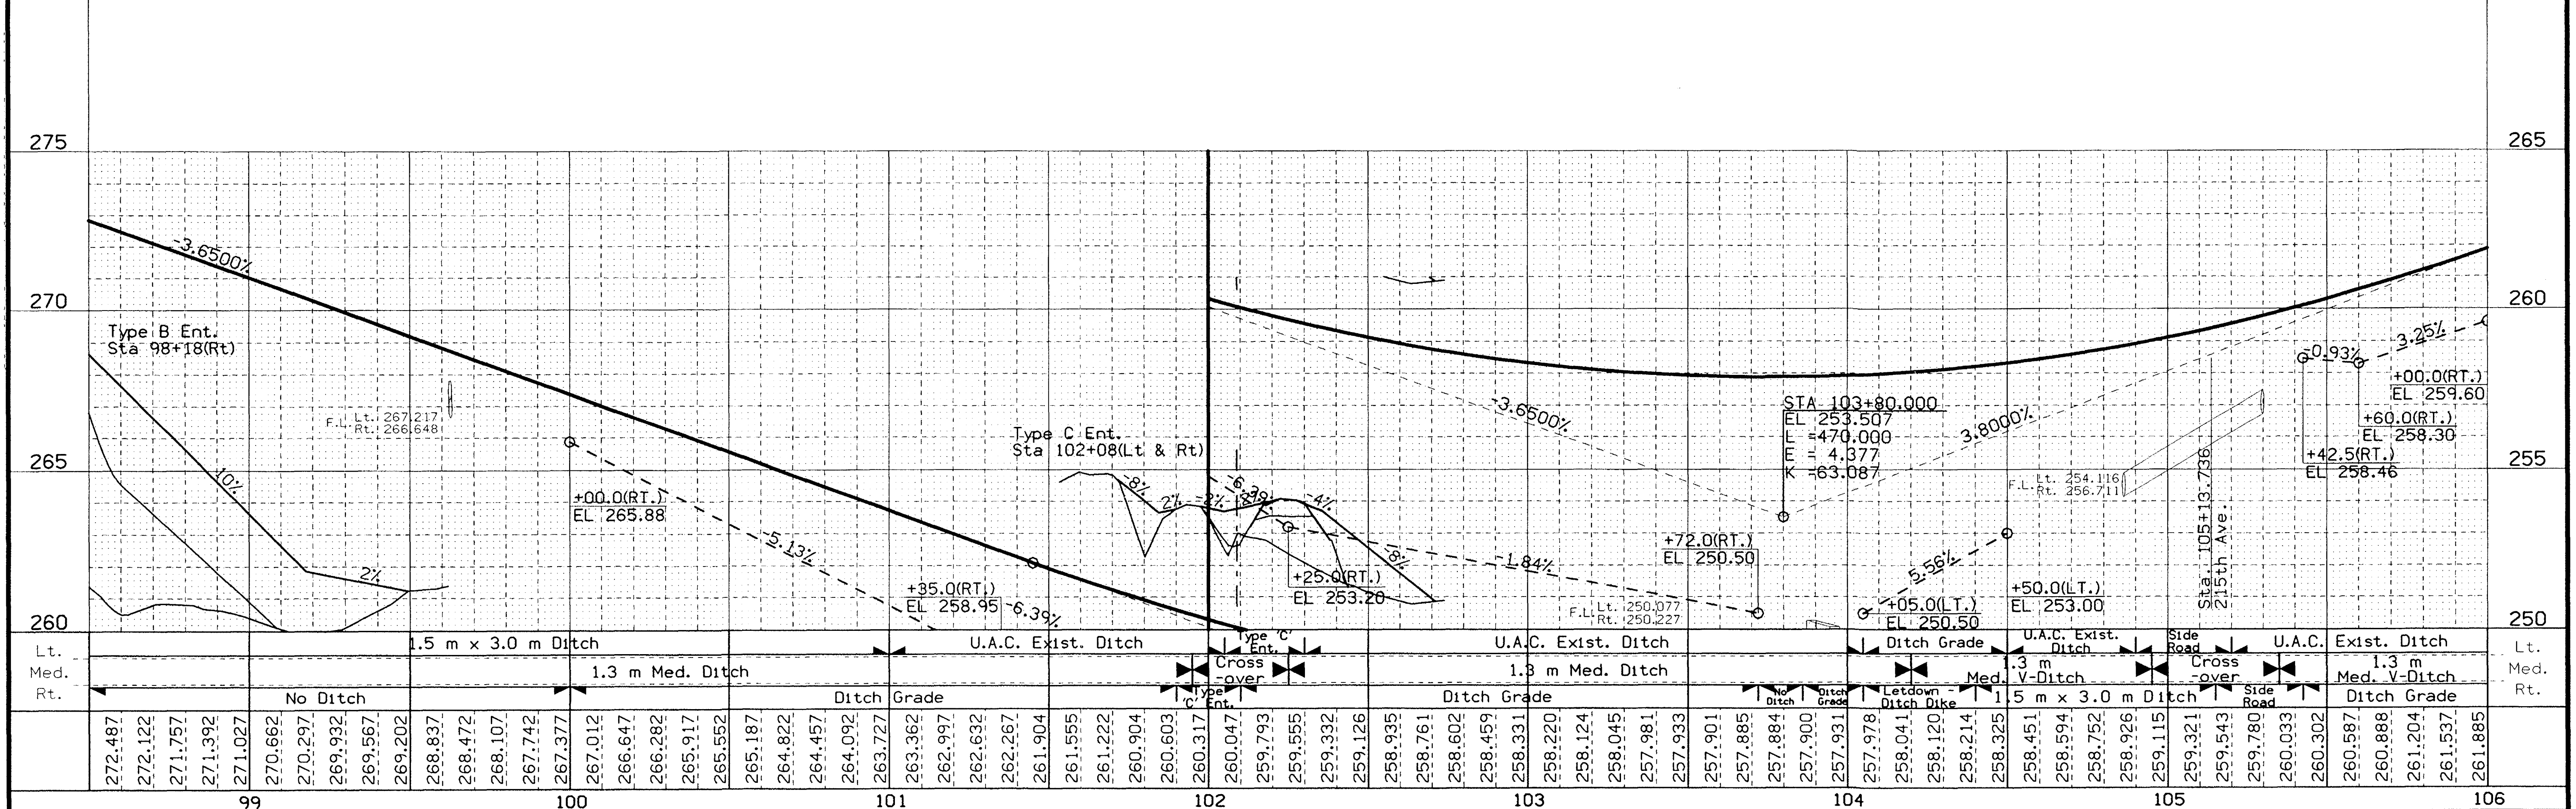
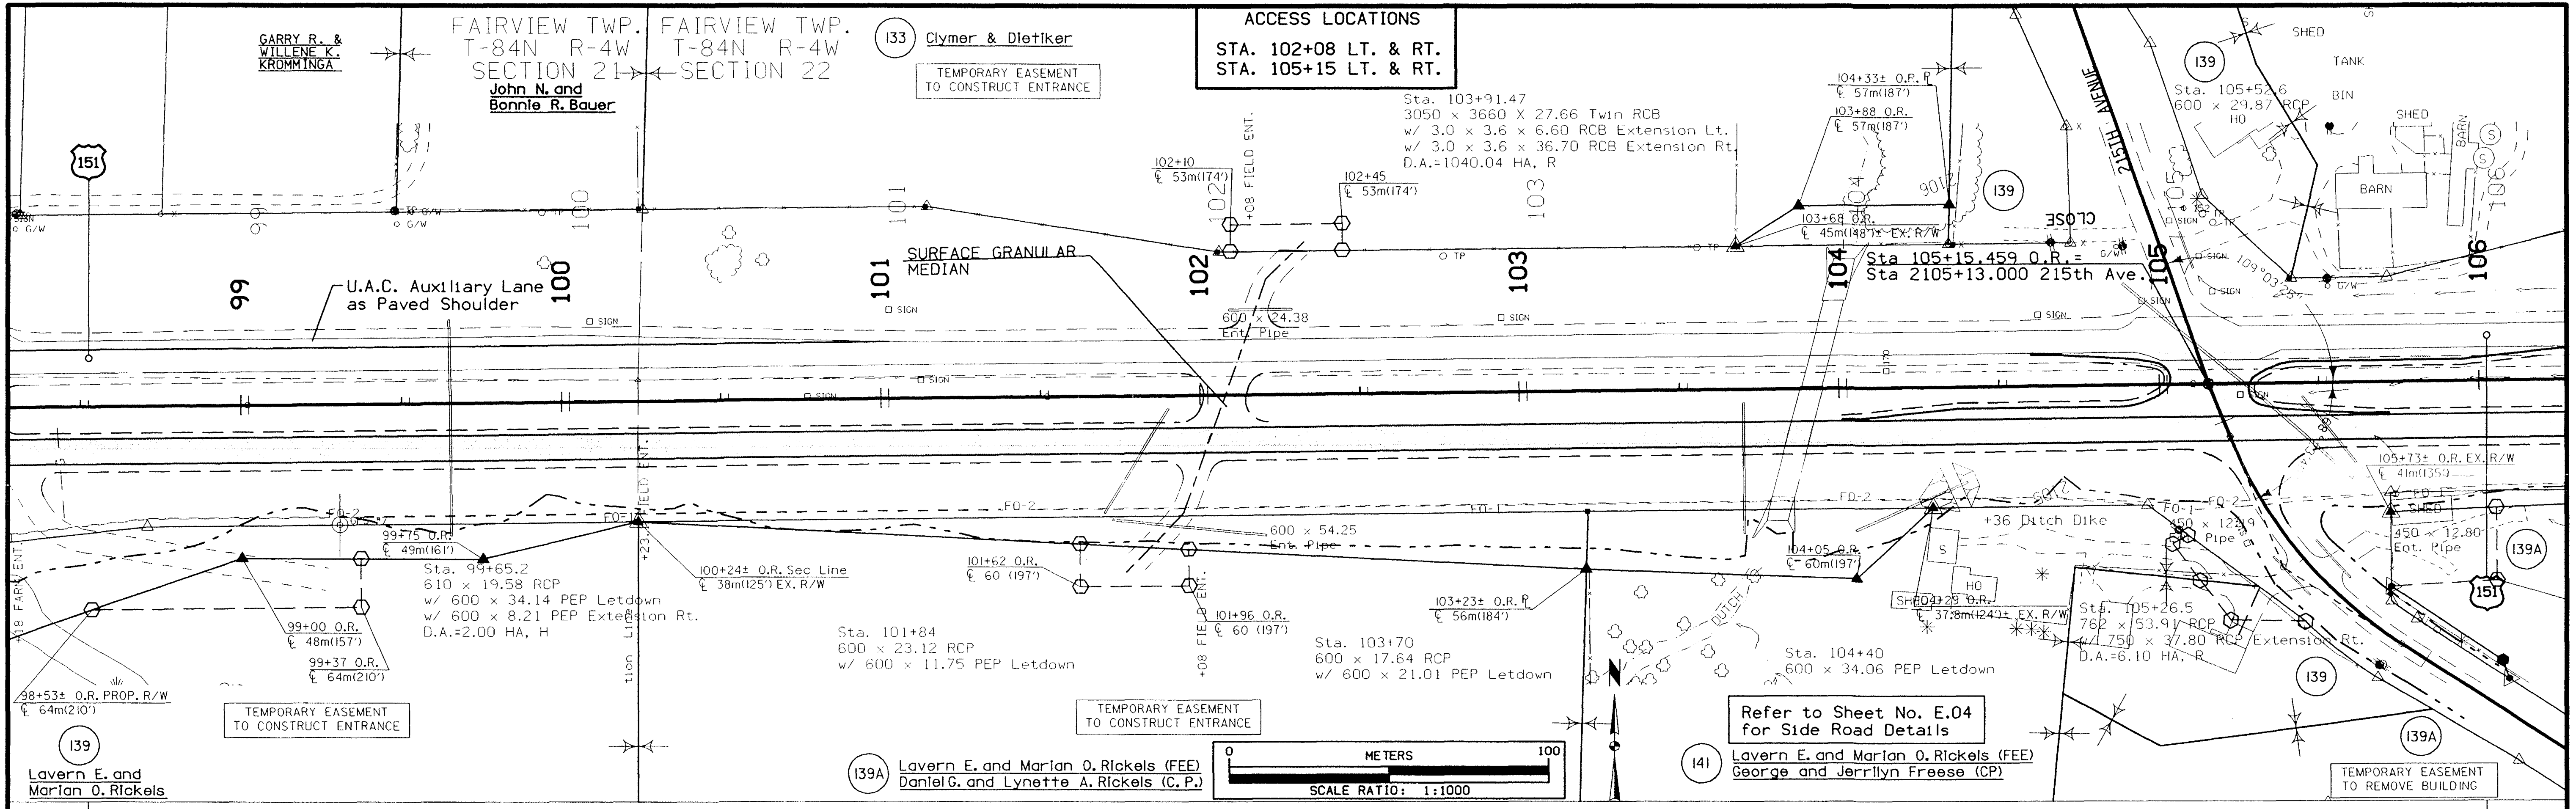


DESIGN TEAM	Skogerboe / EARTH TECH	METRIC	IOWA DOT * OFFICE OF ROAD DESIGN	Linn/Jones	COUNTY	PROJECT NUMBER	NHSX-151-3(112)--3H-57	SHEET NUMBER	D.13
-------------	------------------------	--------	----------------------------------	------------	--------	----------------	------------------------	--------------	------

date = Thu Oct 5 13:23:55 2000



prf = \\WATS01\DATA\PL0T\PL463P\d13h.prf

48-198

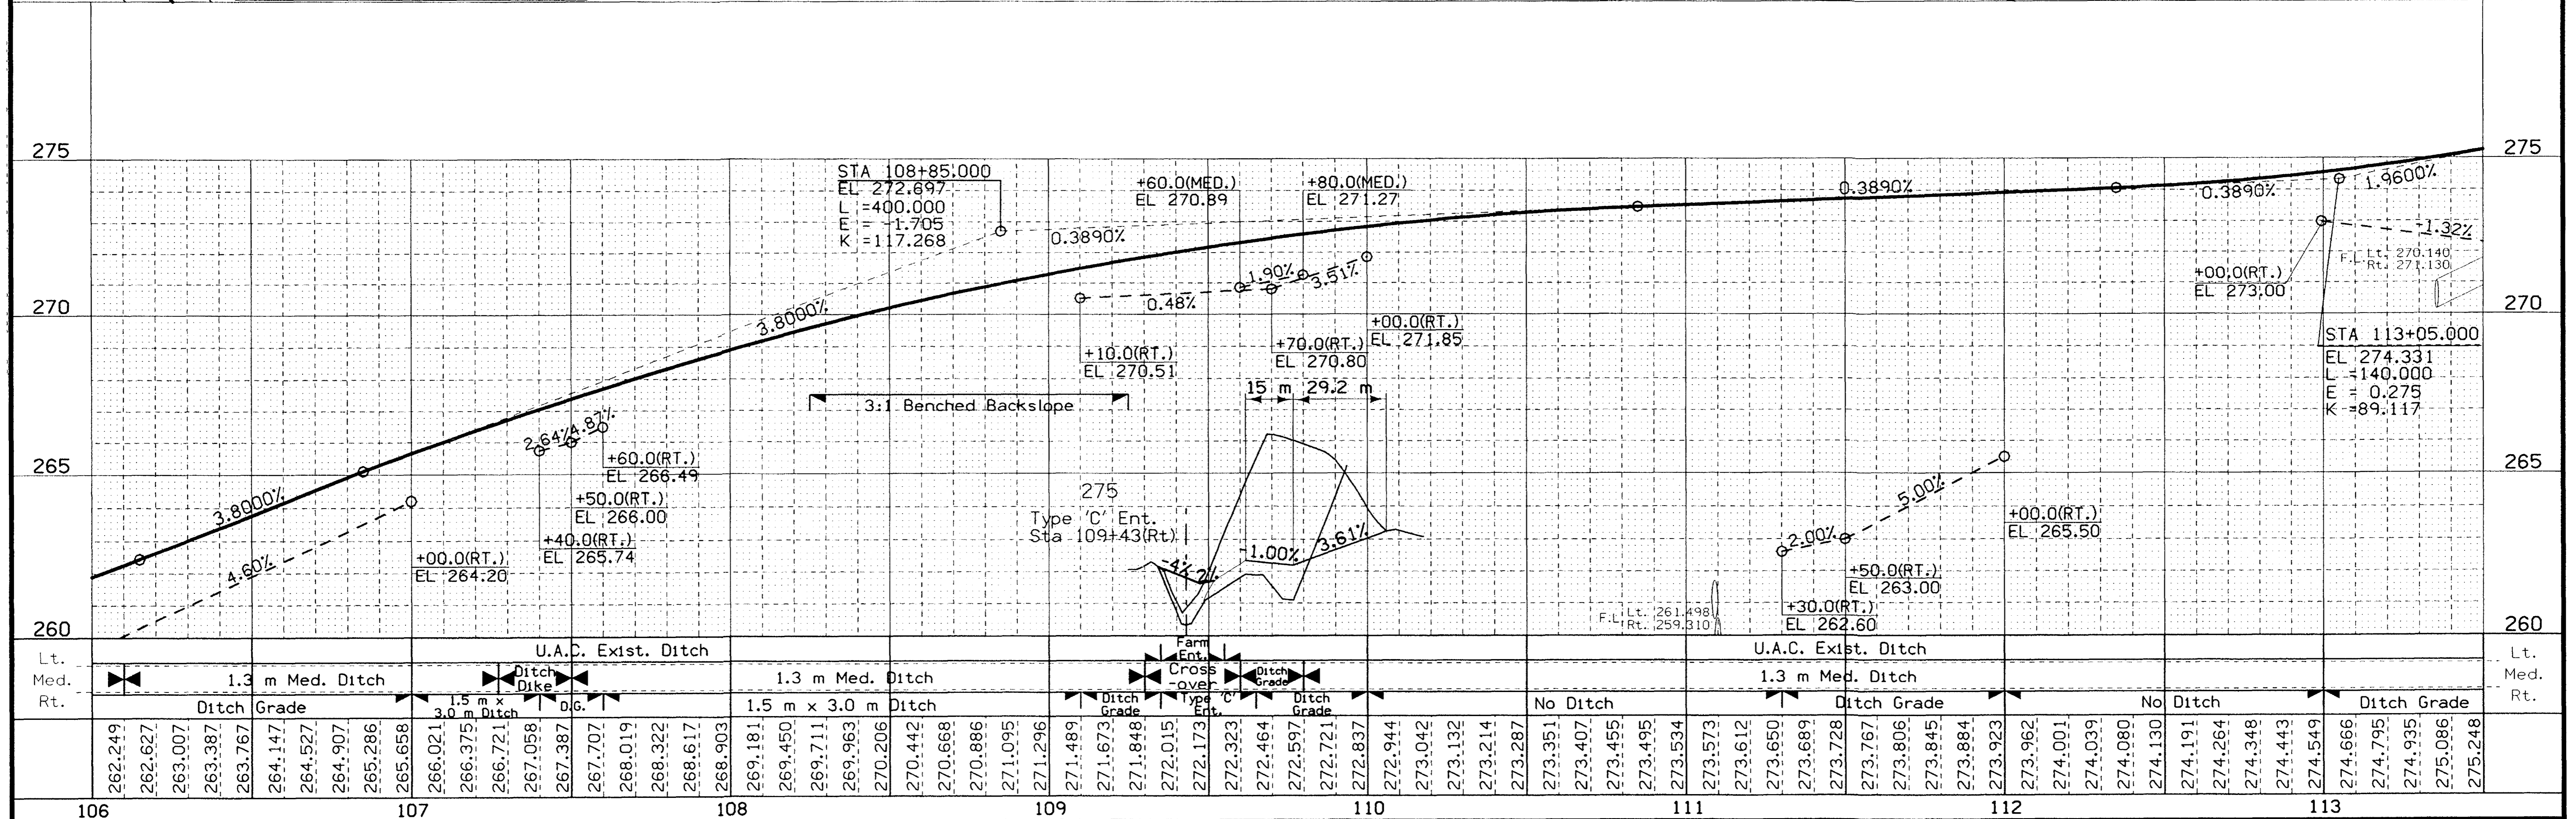
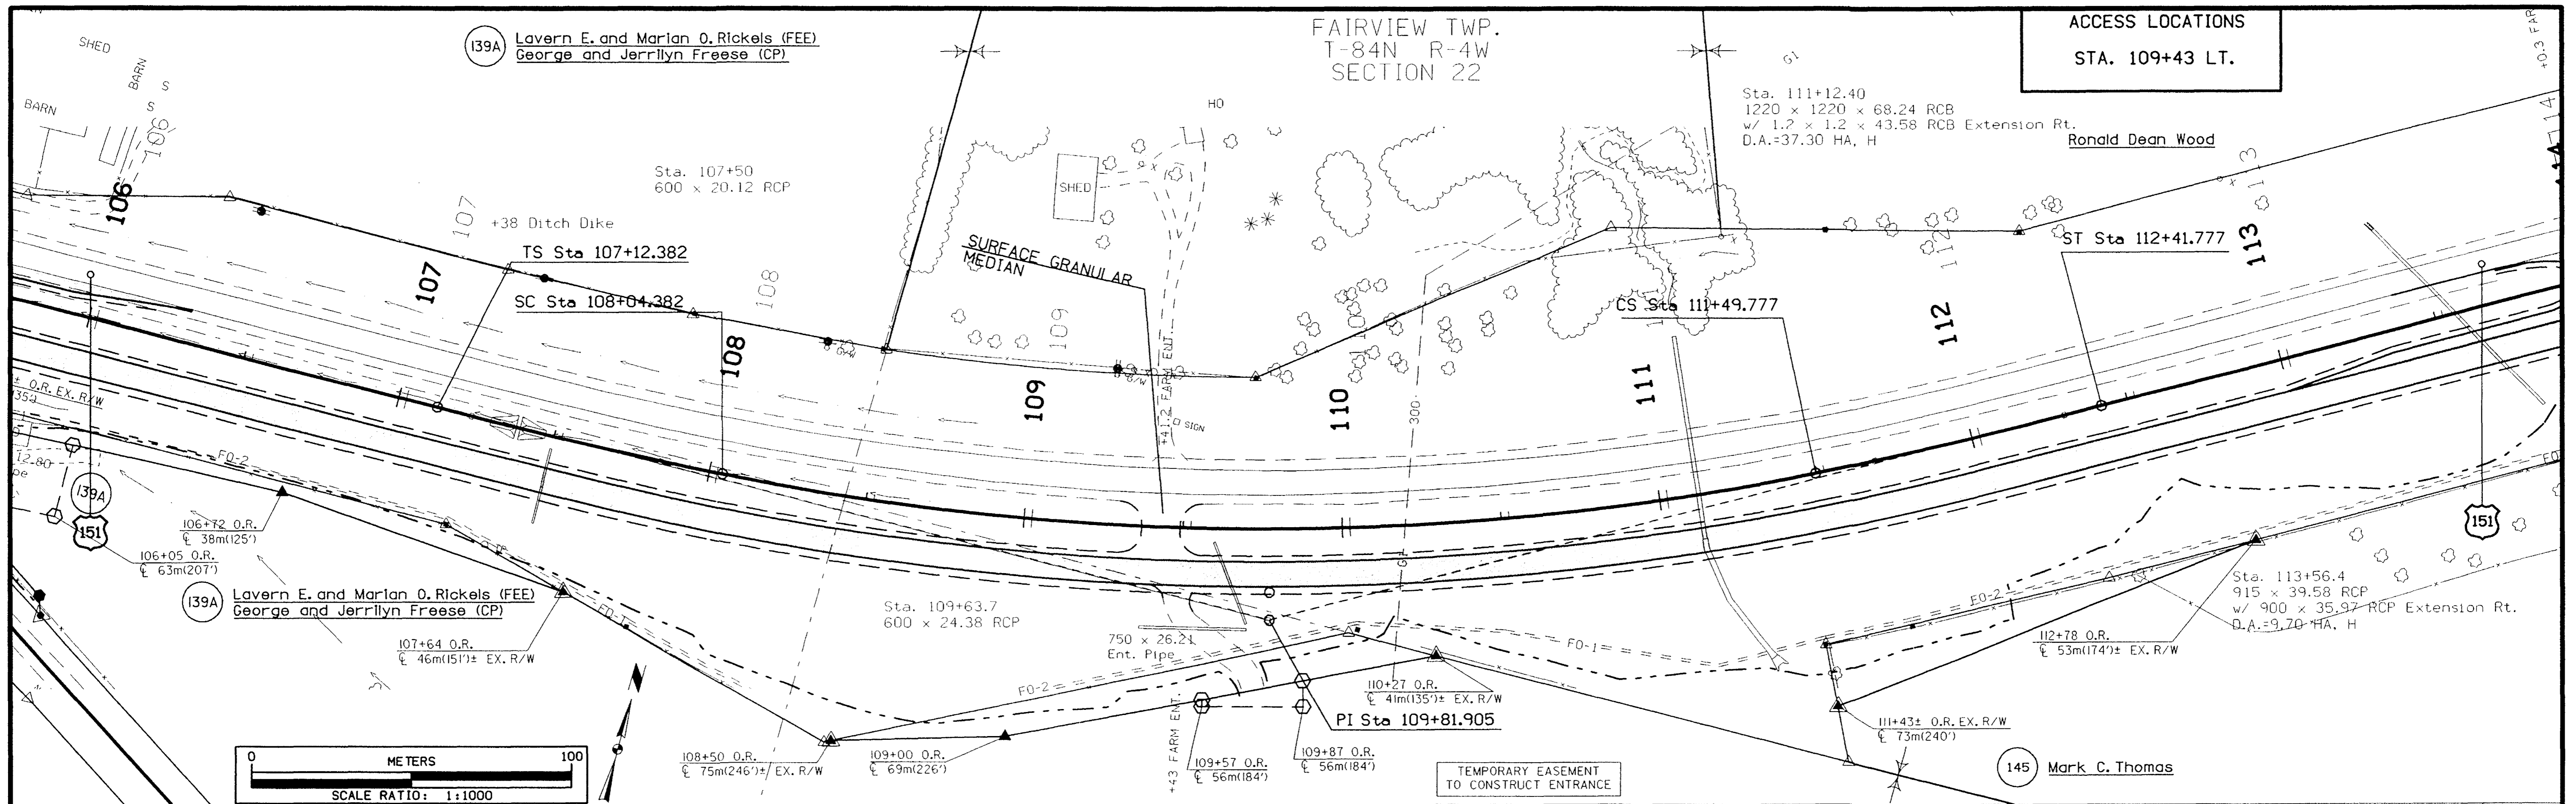


106	107	108	109	110	111	112	113	
262.249	262.627	263.007	263.387	263.767	264.147	264.527	264.907	
265.286	265.658	266.021	266.375	266.721	267.058	267.387	267.707	
268.019	268.322	268.617	268.903	269.181	269.450	269.711	269.963	
270.206	270.442	270.668	270.886	271.095	271.296	271.489	271.673	
271.848	272.015	272.173	272.323	272.464	272.597	272.721	272.837	
272.944	273.042	273.132	273.214	273.287	273.351	273.407	273.455	
273.495	273.534	273.573	273.612	273.650	273.689	273.728	273.767	
273.806	273.845	273.884	273.923	273.962	274.001	274.039	274.080	
274.130	274.191	274.264	274.348	274.443	274.549	274.666	274.795	
274.935	275.086	275.248						

49-198

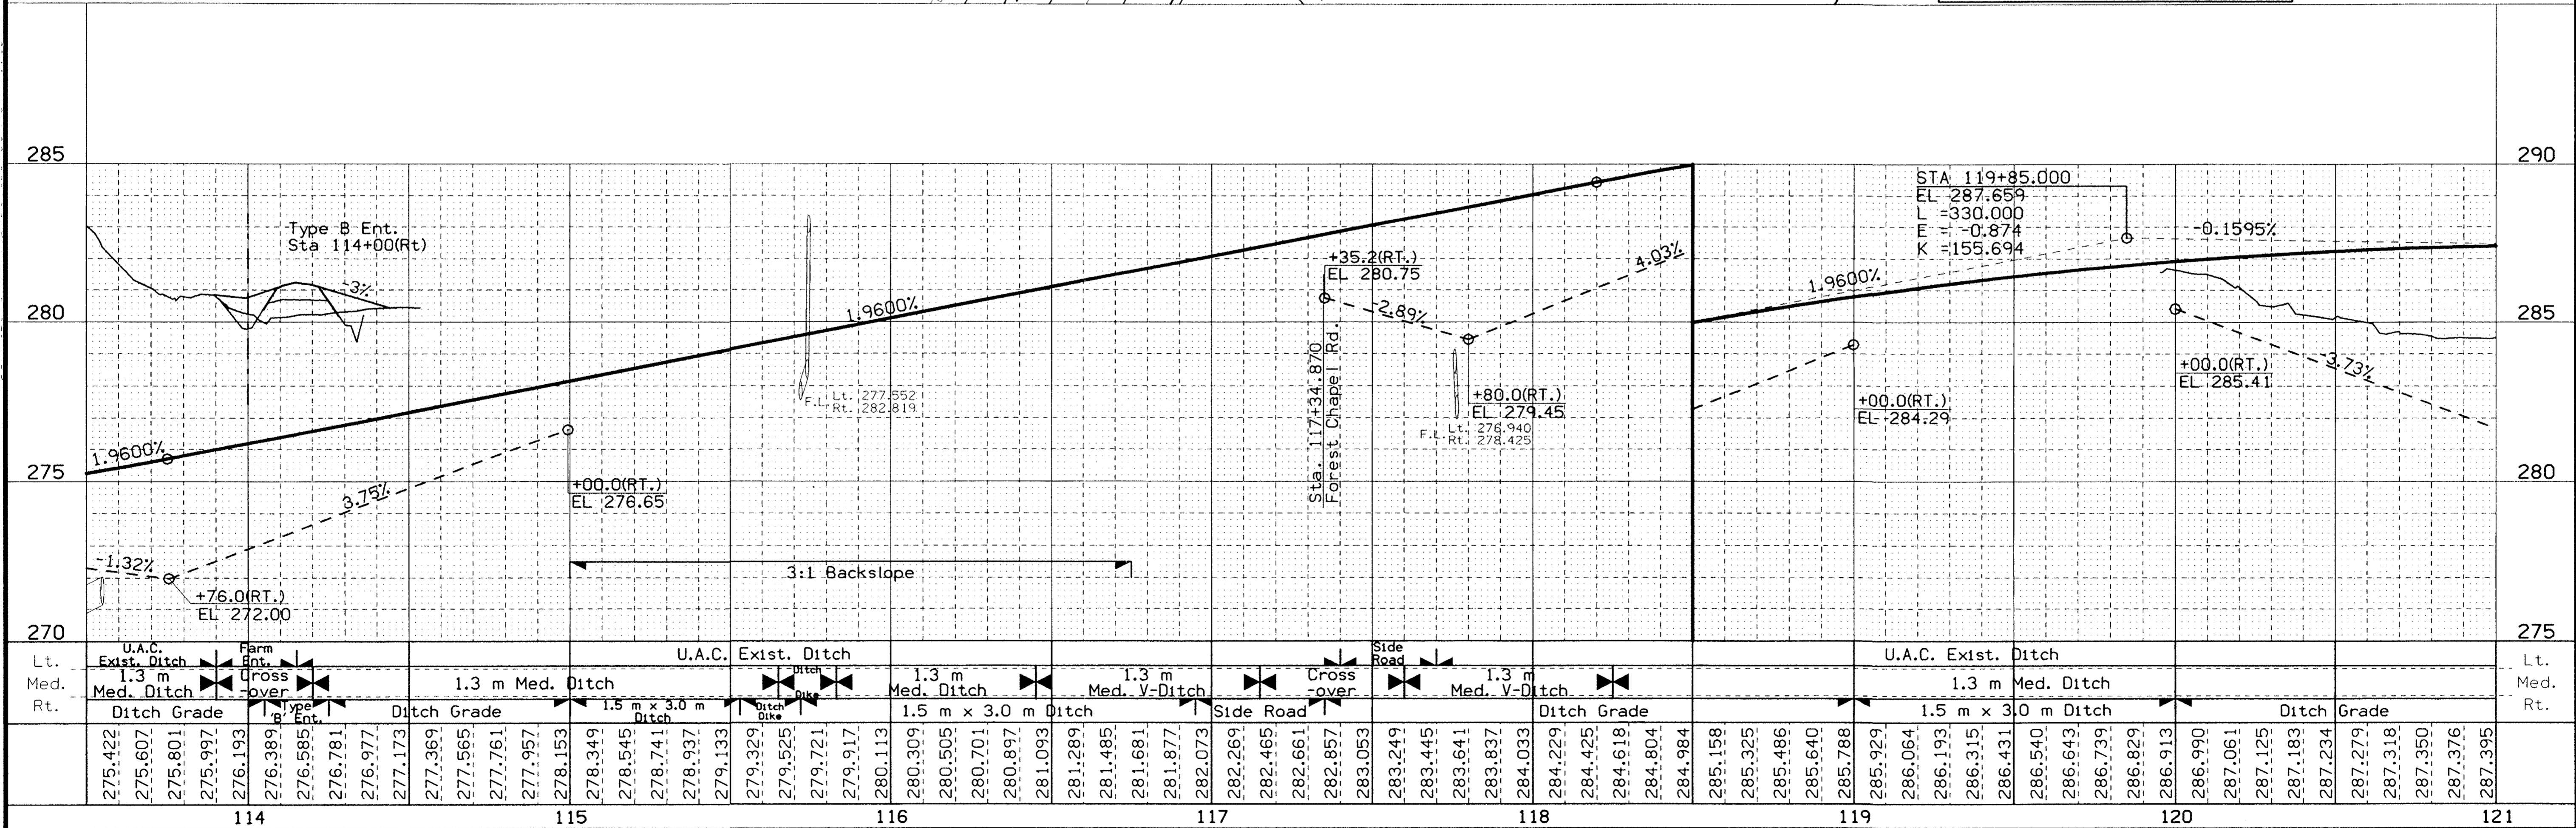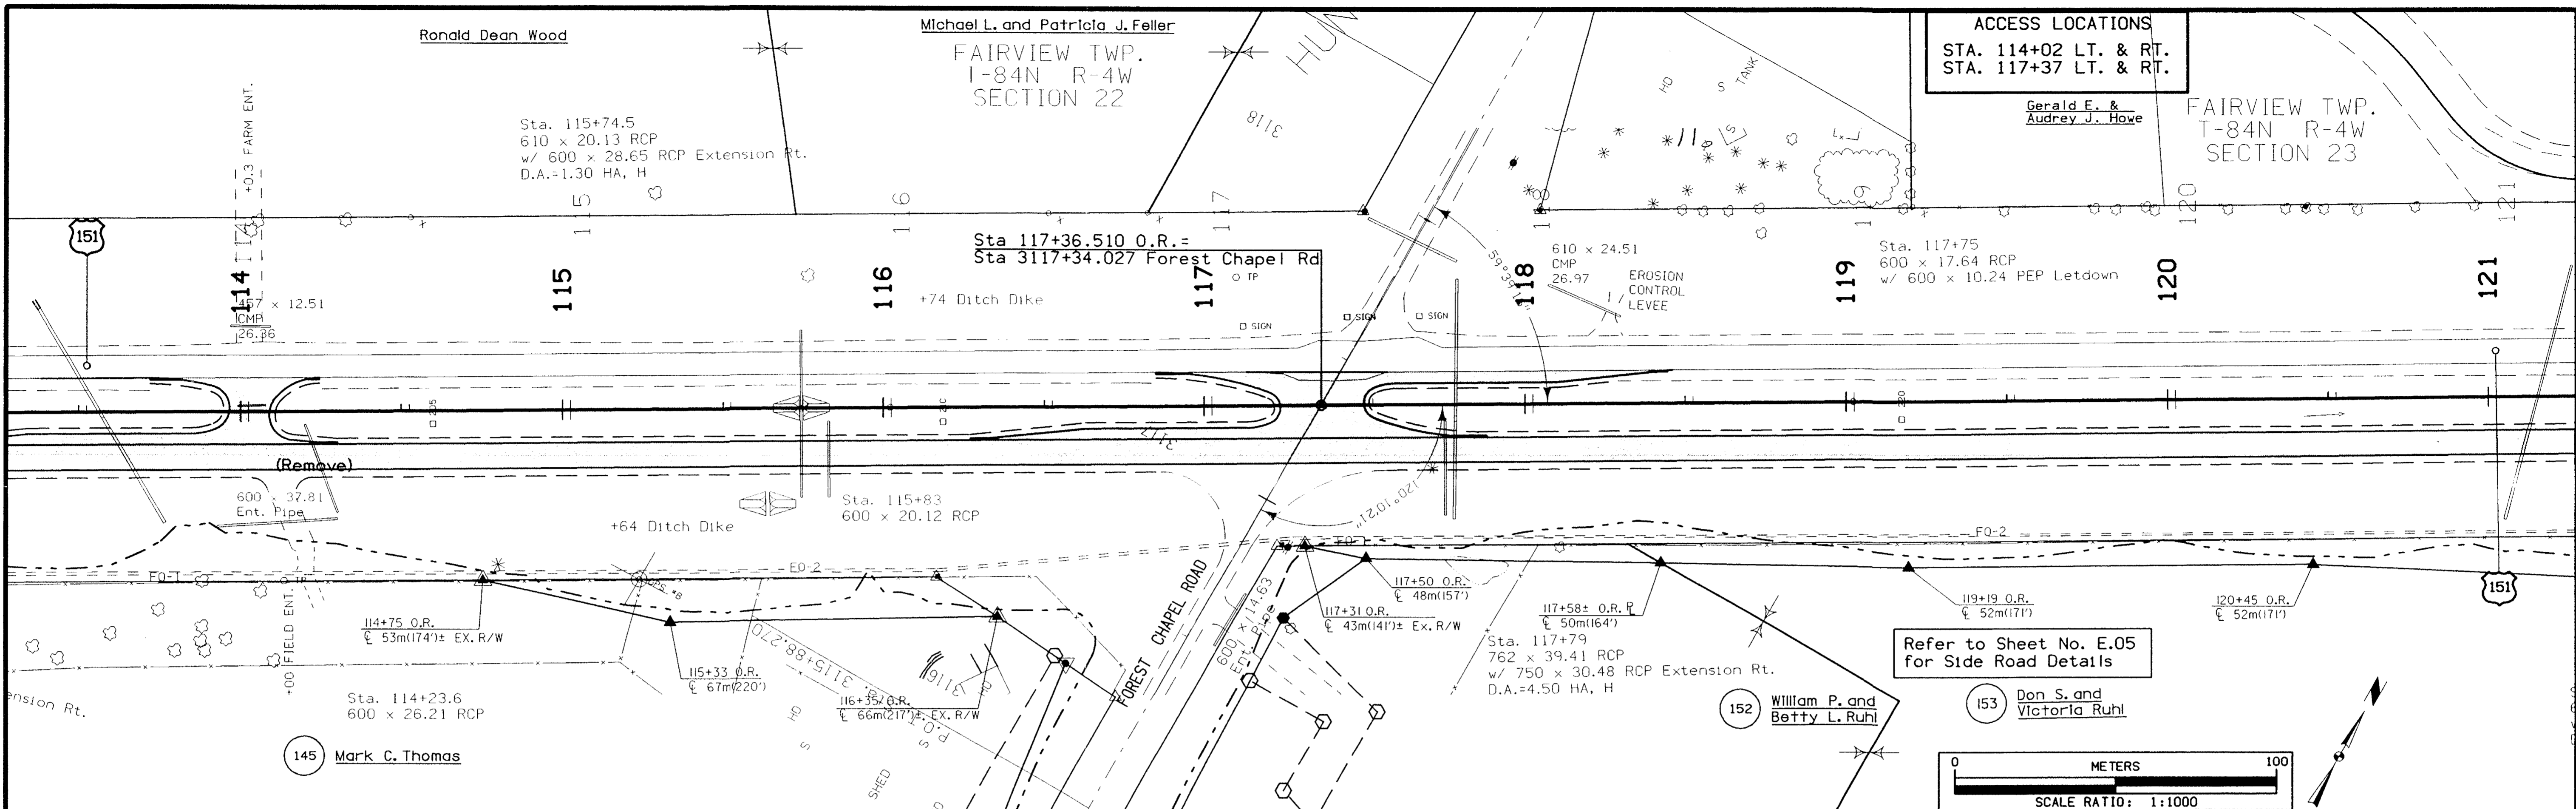


DESIGN TEAM	Skogerboe / EARTH TECH	METRIC	IOWA DOT * OFFICE OF ROAD DESIGN	Linn/Jones	COUNTY	PROJECT NUMBER	NHSX-151-3(112)--3H-57	SHEET NUMBER	D.15
-------------	------------------------	--------	----------------------------------	------------	--------	----------------	------------------------	--------------	------

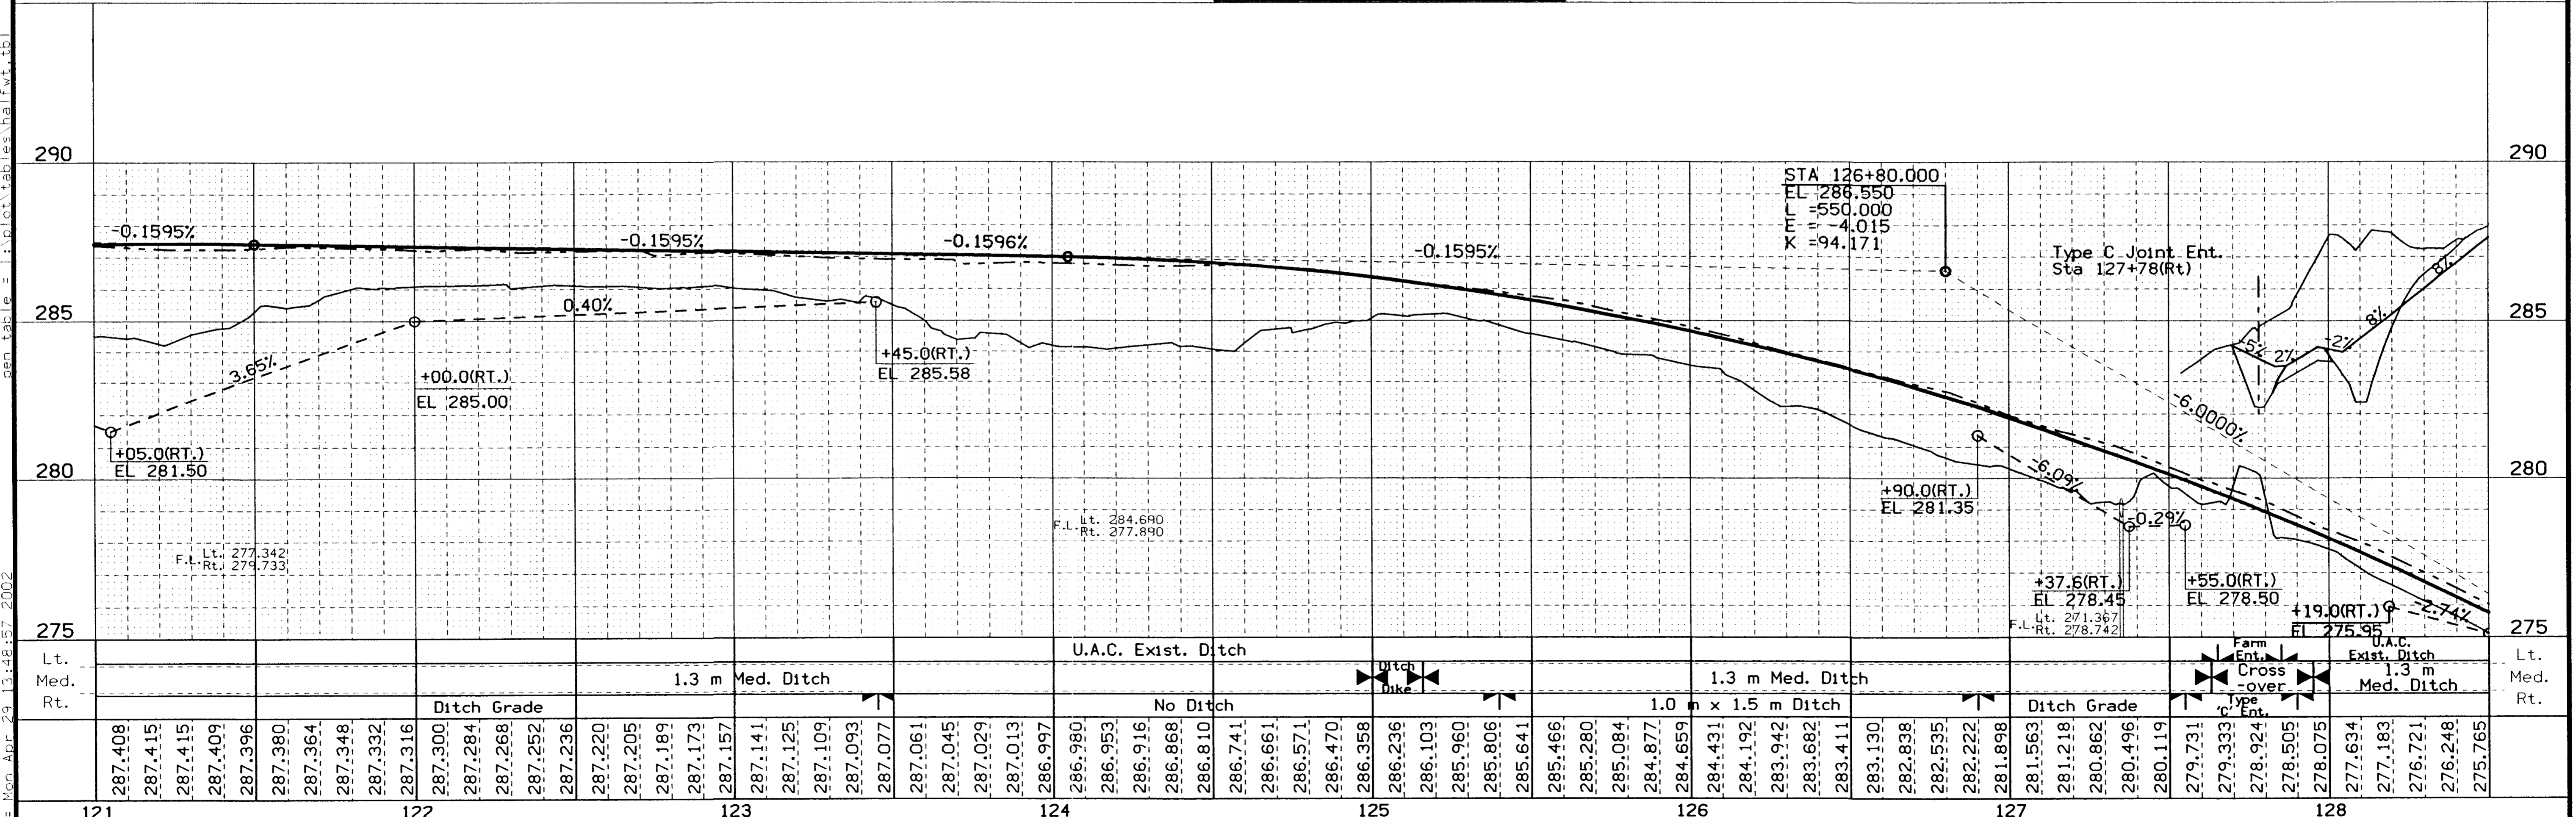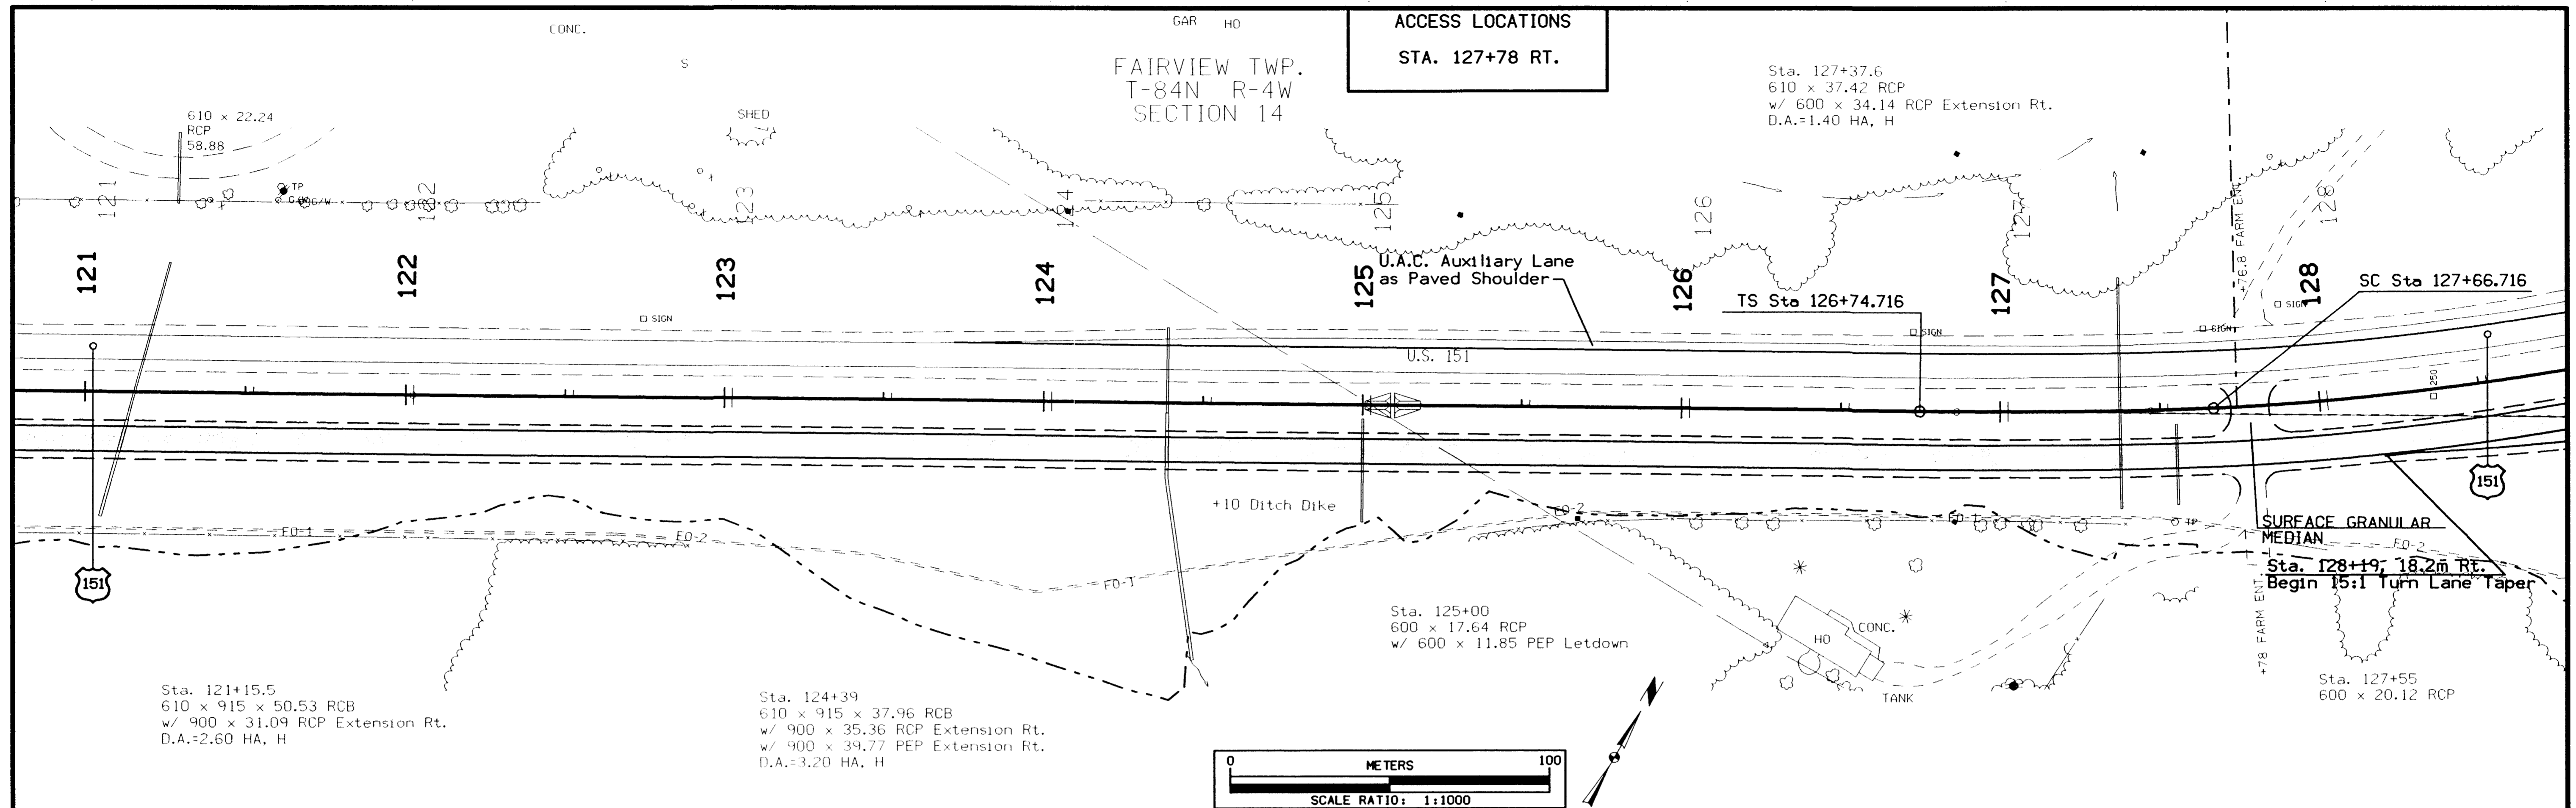


pgn = L:\WORK\PROJECT_30922\cadd\X40\turn\X40d16.dgn.
 levels = 1-4,7,8,62
 prf = \WATSON\DATA\PLOT\COPIER\X40d16.prf
 date = Mon, Apr 29, 2002 13:48:57
 pen table = 1:plot,tables,half,wt.tbl

ACCESS LOCATIONS
STA. 131+32 RT.


FAIRVIEW TWP.
T-84N R-4W
SECTION 14

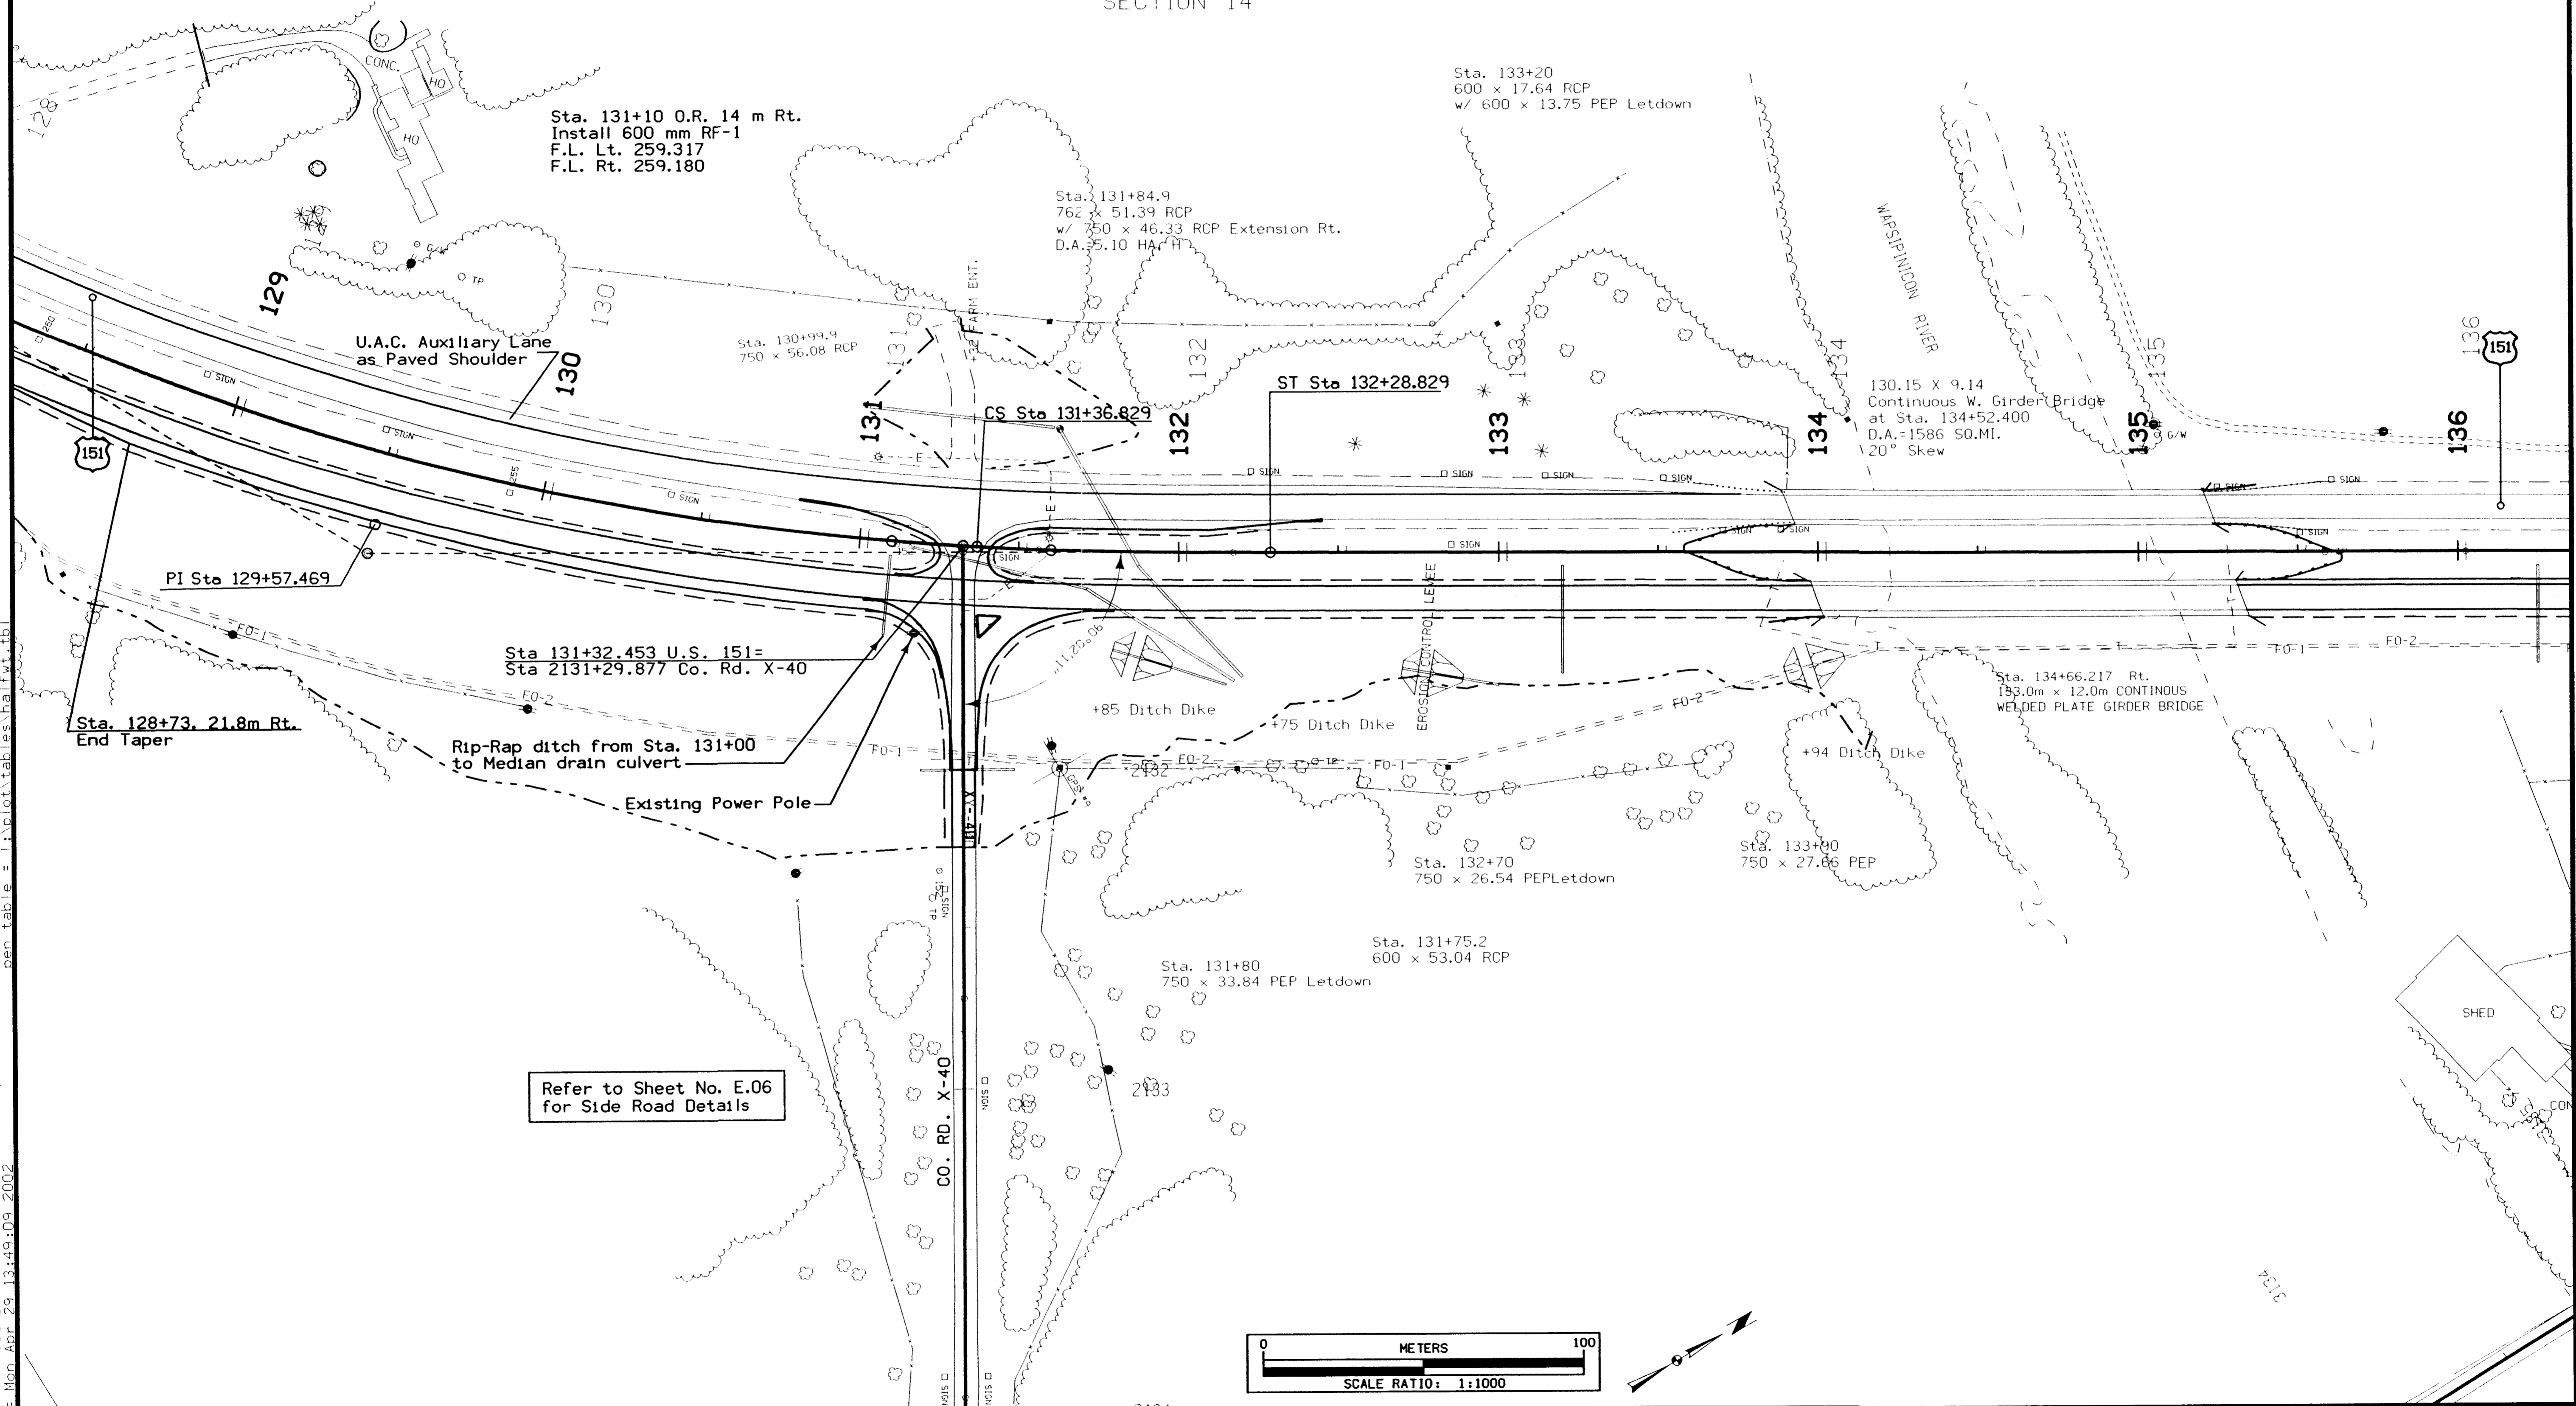

Refer to Sheet No. E.06
for Side Road Details


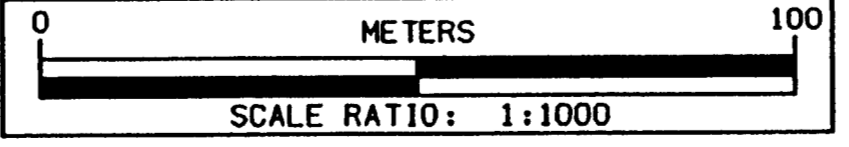


dgn = L:\WORK\PROJECT_39922\cadd\X40\turn\X40d17.dgn
 prf = \\WATSO1\DATA\PLT\COPIER\X40d17.prf
 Date = Mon Apr 29 13:49:09 2002
 pen_table = L:\plot\tables\hal.fwt.tbl
 levels = 1-4,7,8,62


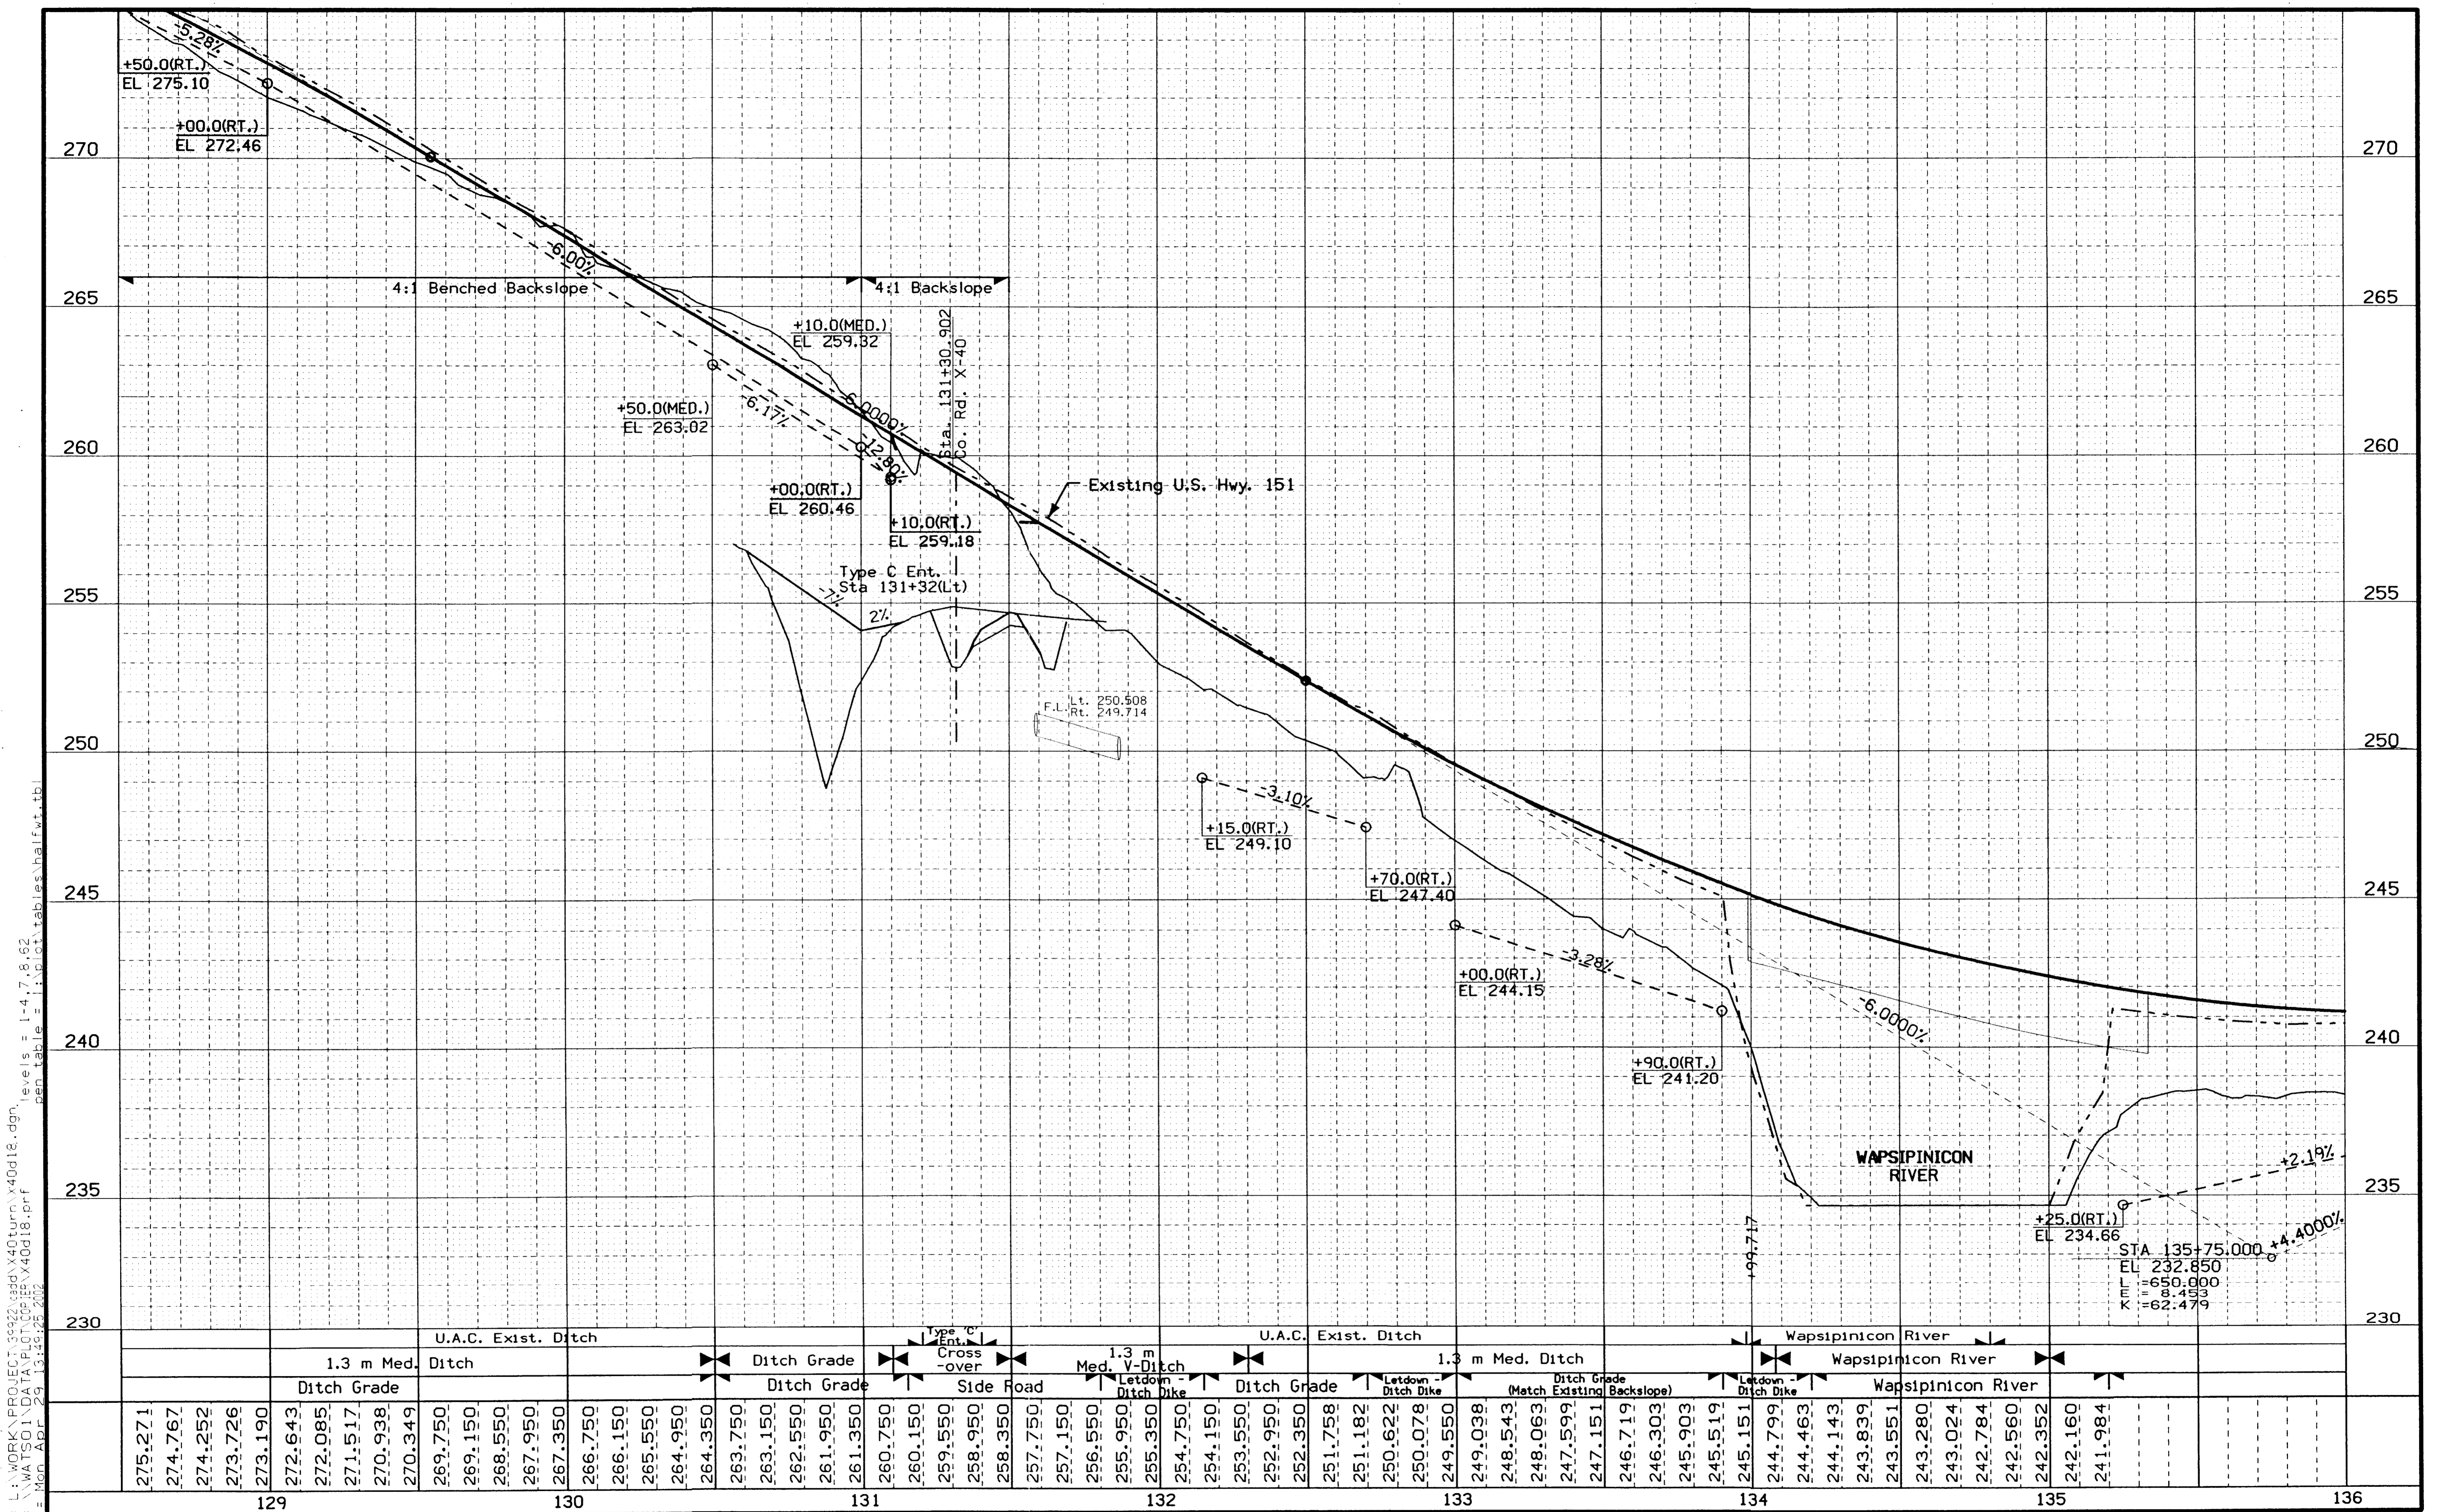


dcn = L:\WORK\PROJECT\3922\3922\3922\40turn_X40d18.dgn
 prf = \WA\TSD\1\DATA\10\COPIES\X40d18.prf
 date = Mon Apr 29 13:46:25 2002
 levels = 1-4,7,8,62
 pen table = L:\pic\tables\half.tbl



275.271	274.767	274.252	273.726	273.190	272.643	272.085	271.517	270.938	270.349	269.750	269.150	268.550	267.950	267.350	266.750	266.150	265.550	264.950	264.350	263.750	263.150	262.550	261.950	261.350	260.750	260.150	259.550	258.950	258.350	257.750	257.150	256.550	255.950	255.350	254.750	254.150	253.550	252.950	252.350	251.758	251.182	250.622	250.078	249.550	249.038	248.543	248.063	247.599	247.151	246.719	246.303	245.903	245.519	245.151	244.799	244.463	244.143	243.839	243.551	243.280	243.024	242.784	242.560	242.352	242.160	241.984
129										130					131					132					133					134					135					136																										
Ditch Grade										U.A.C. Exist. Ditch					Ditch Grade					Side Road					U.A.C. Exist. Ditch					1.3 m Med. Ditch					Wapsipinicon River					Wapsipinicon River																										
Ditch Grade										Ditch Grade					Ditch Grade					Ditch Grade					Ditch Grade					Ditch Grade					Ditch Grade					Ditch Grade					Ditch Grade																					

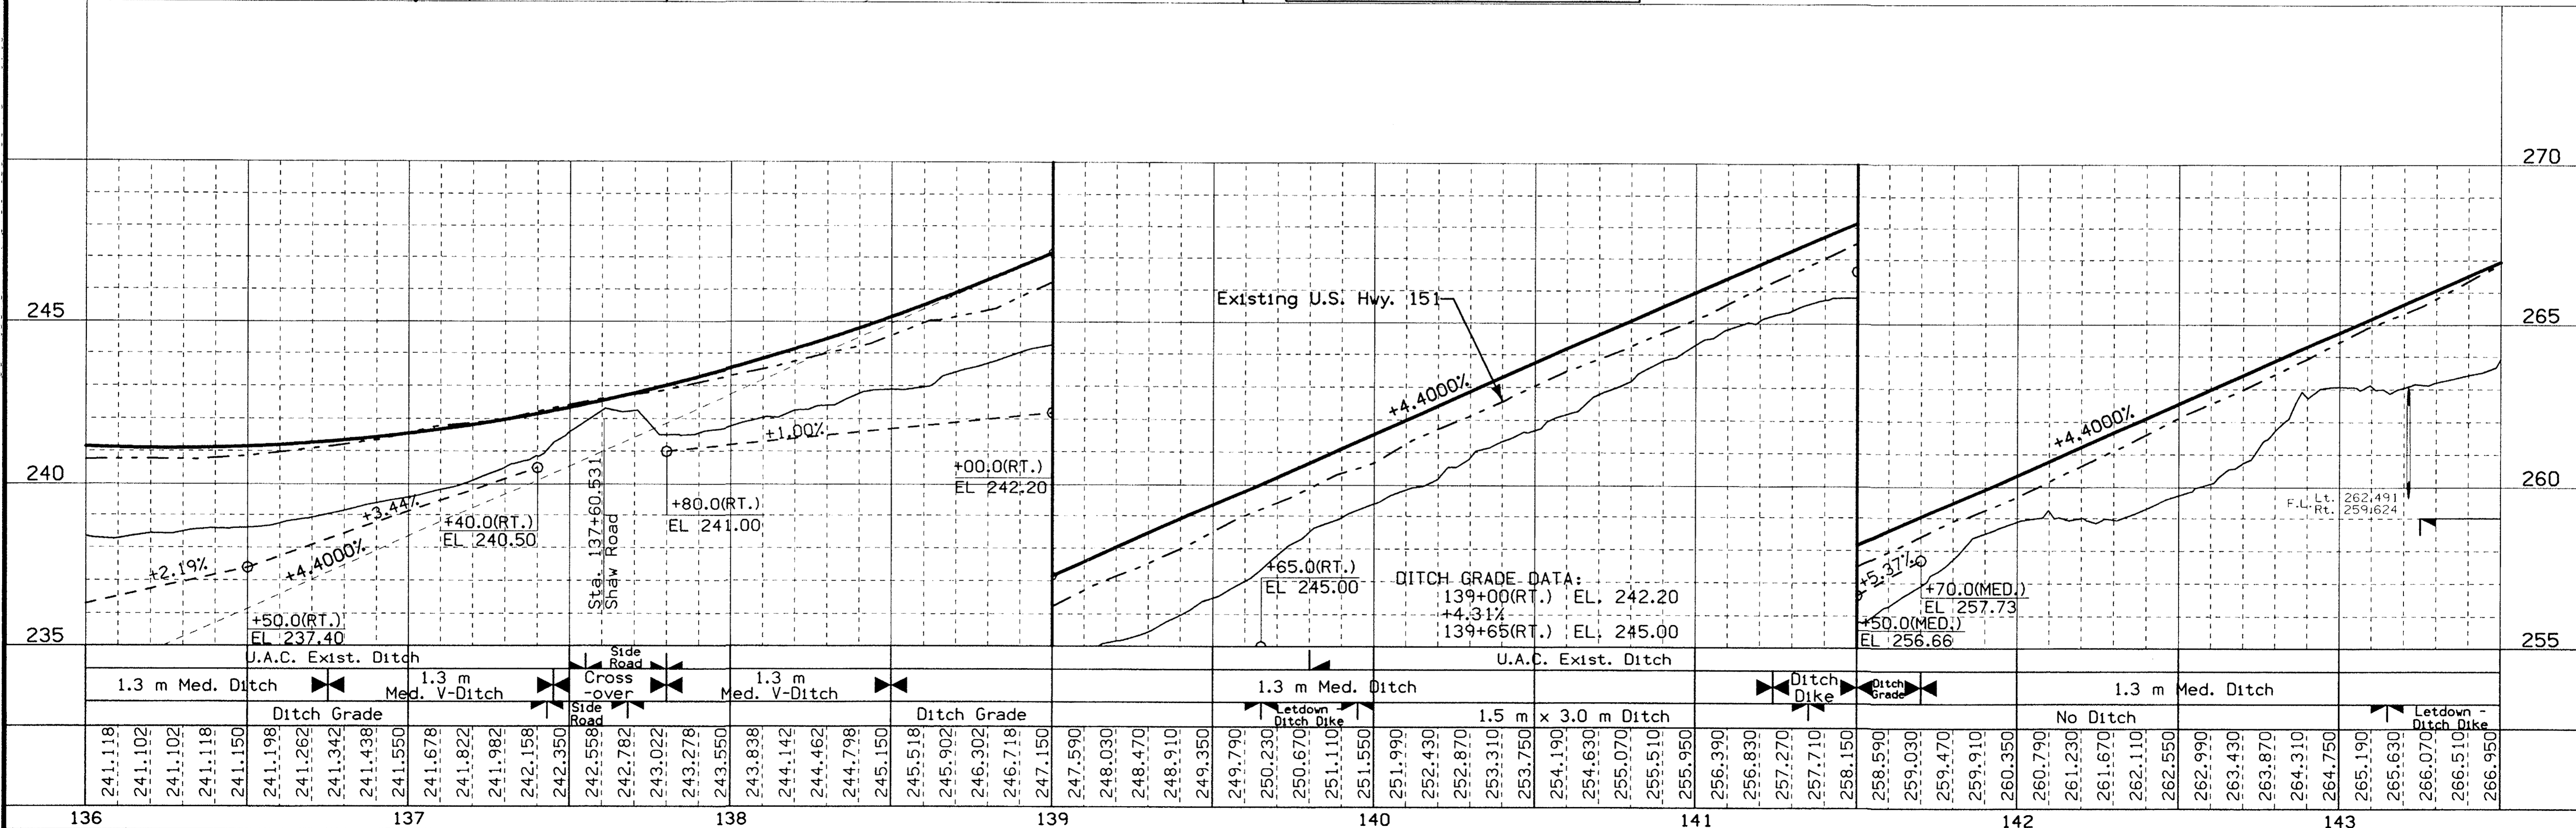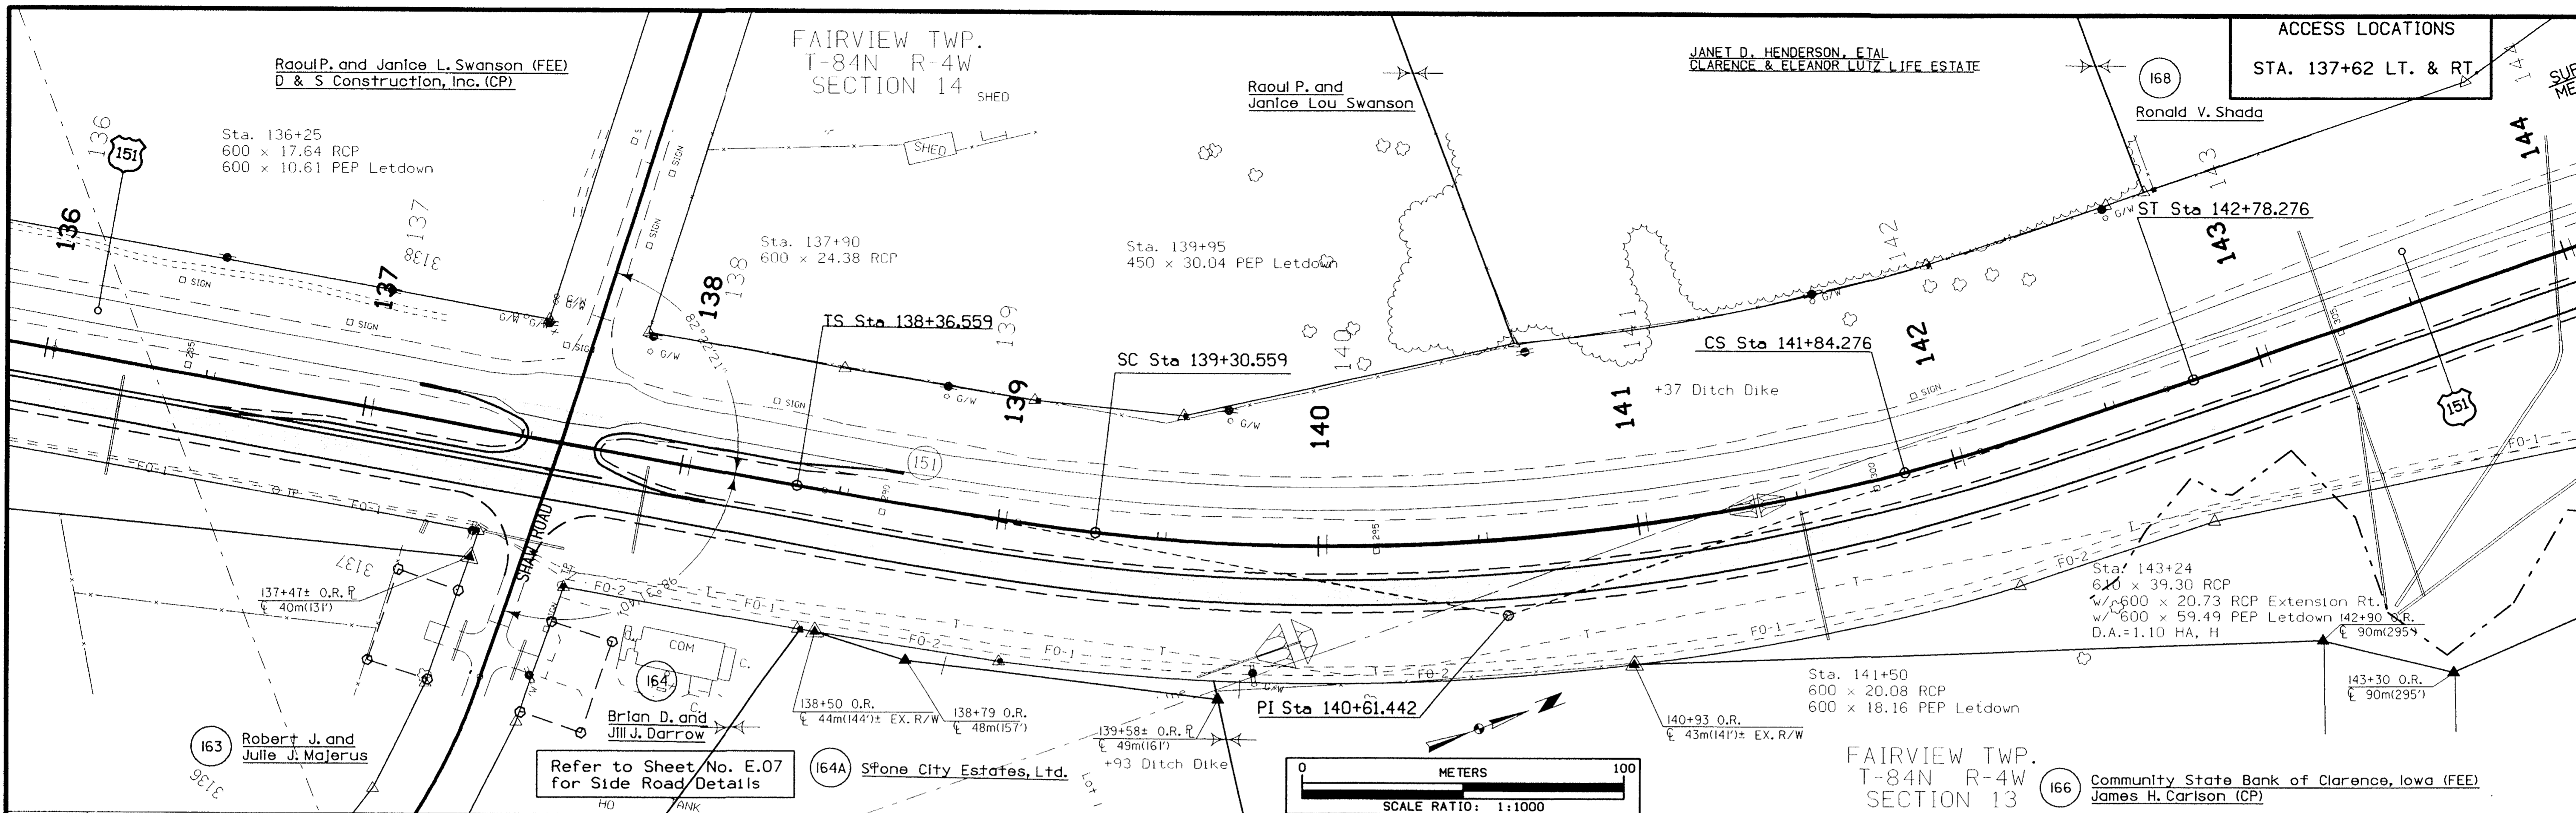



54-198

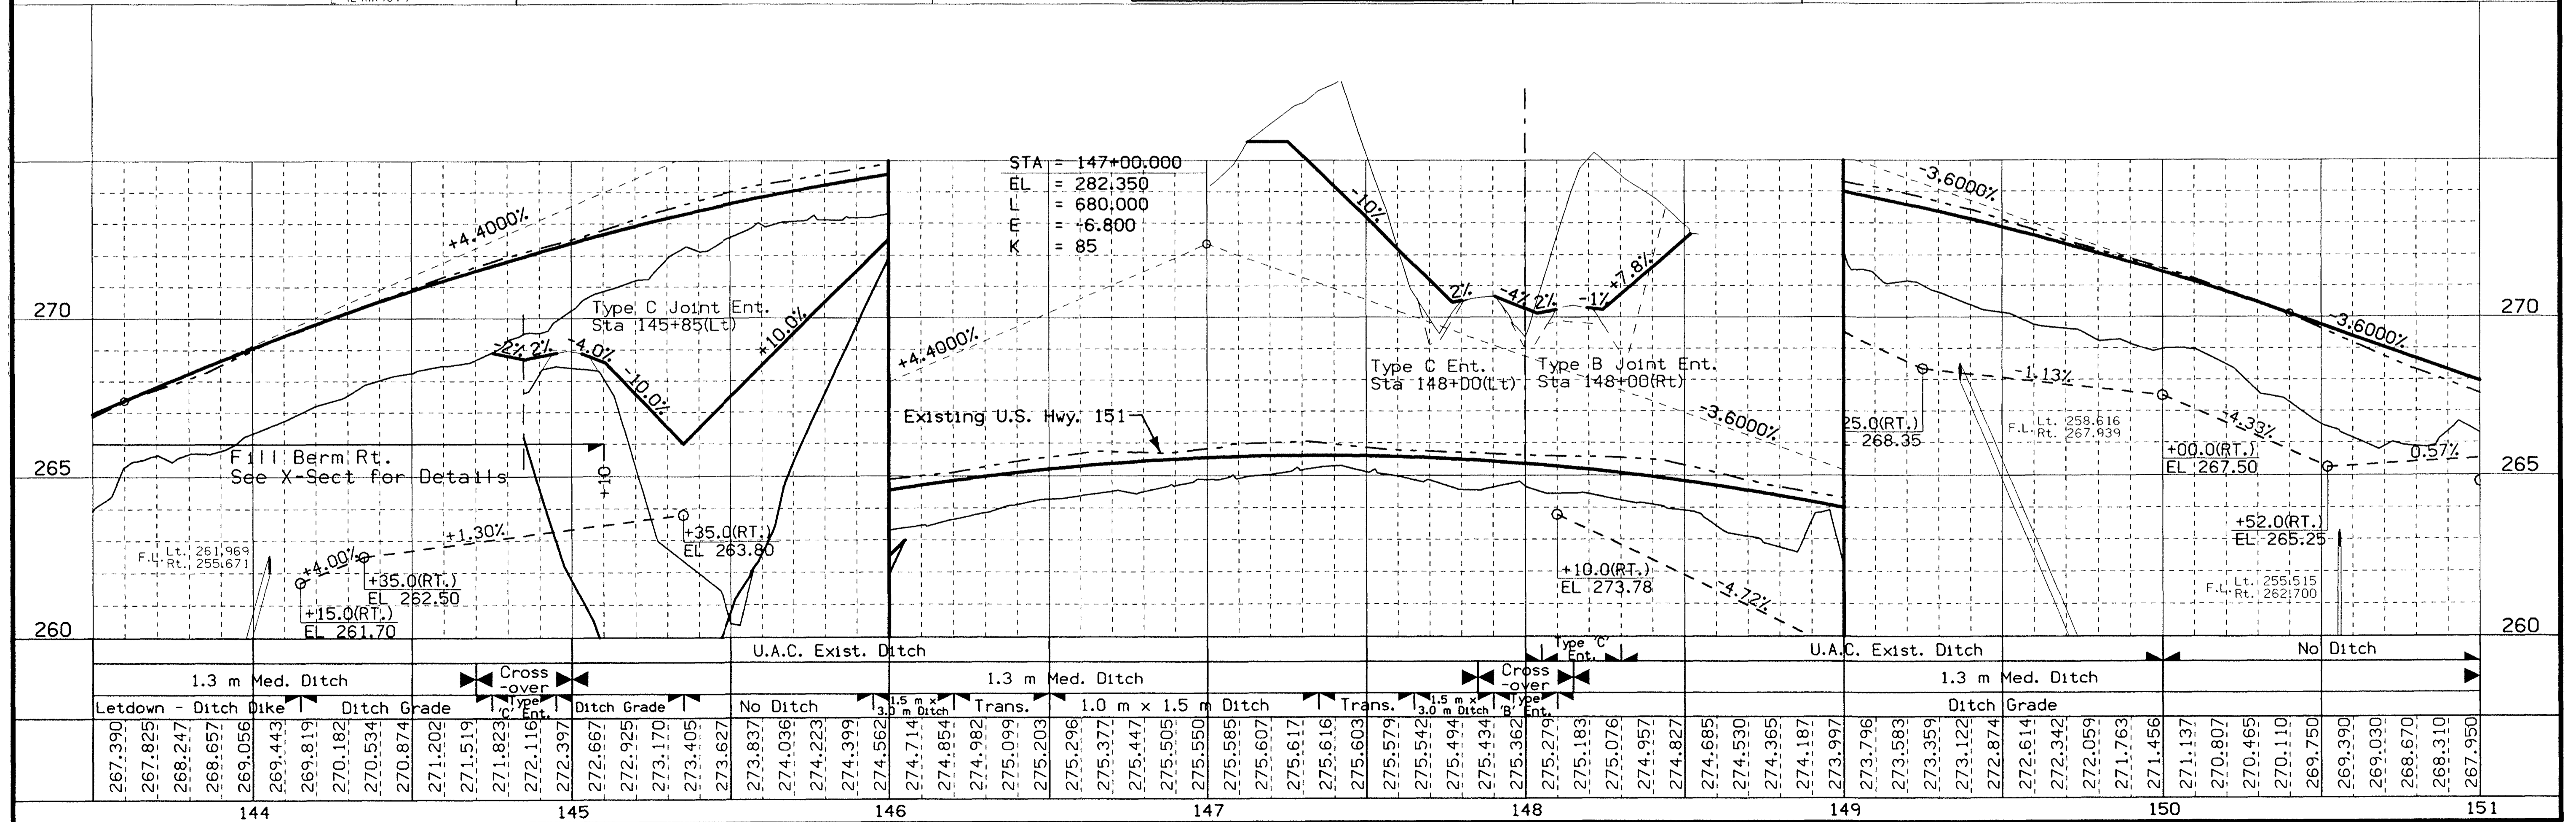
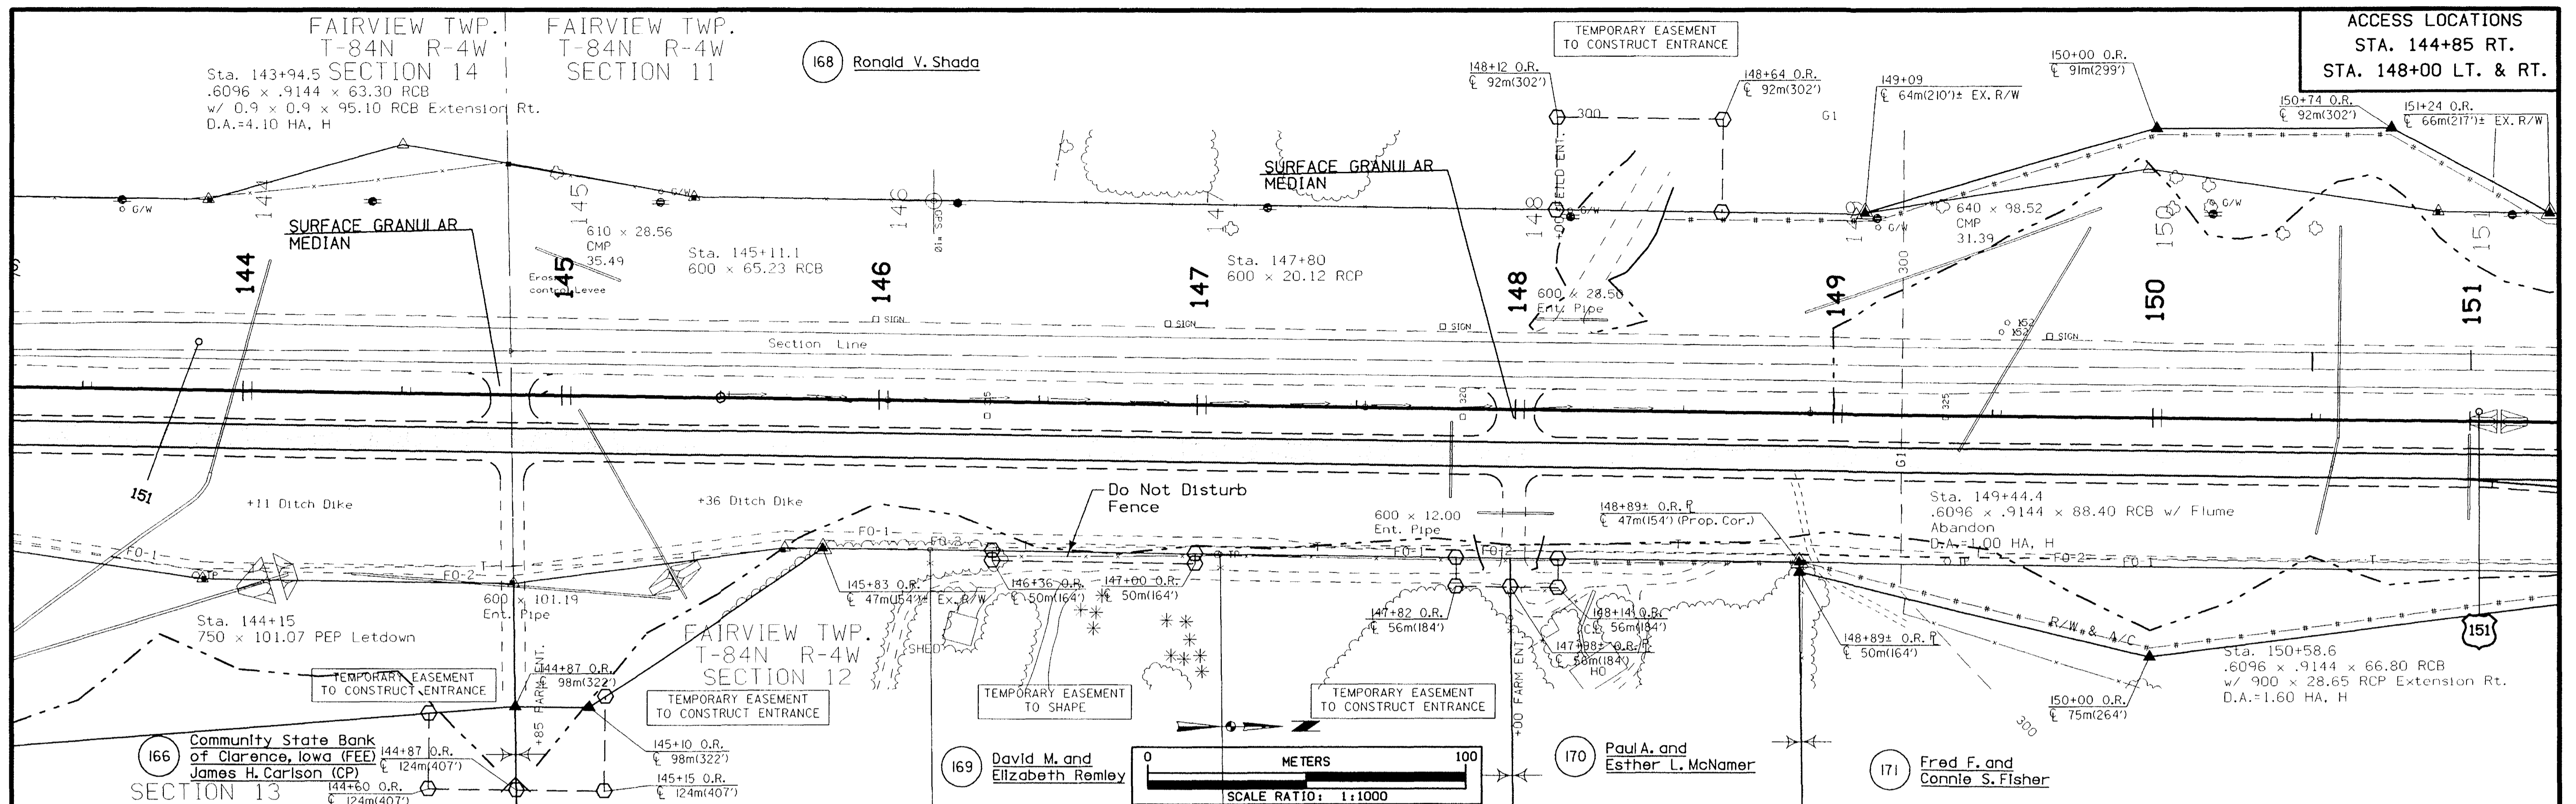


267.390	267.825	268.247	268.657	269.056	269.443	269.819	270.182	270.534	270.874	271.202	271.519	271.823	272.116	272.397	272.667	272.925	273.170	273.405	273.627	273.837	274.036	274.223	274.399	274.562	274.714	274.854	274.982	275.099	275.203	275.296	275.377	275.447	275.505	275.550	275.585	275.607	275.617	275.616	275.603	275.579	275.542	275.494	275.434	275.362	275.279	275.183	275.076	274.957	274.827	274.685	274.530	274.365	274.187	273.997	273.796	273.583	273.359	273.122	272.874	272.614	272.342	272.059	271.763	271.456	271.137	270.807	270.465	270.110	269.750	269.390	269.030	268.670	268.310	267.950
---------	---------	
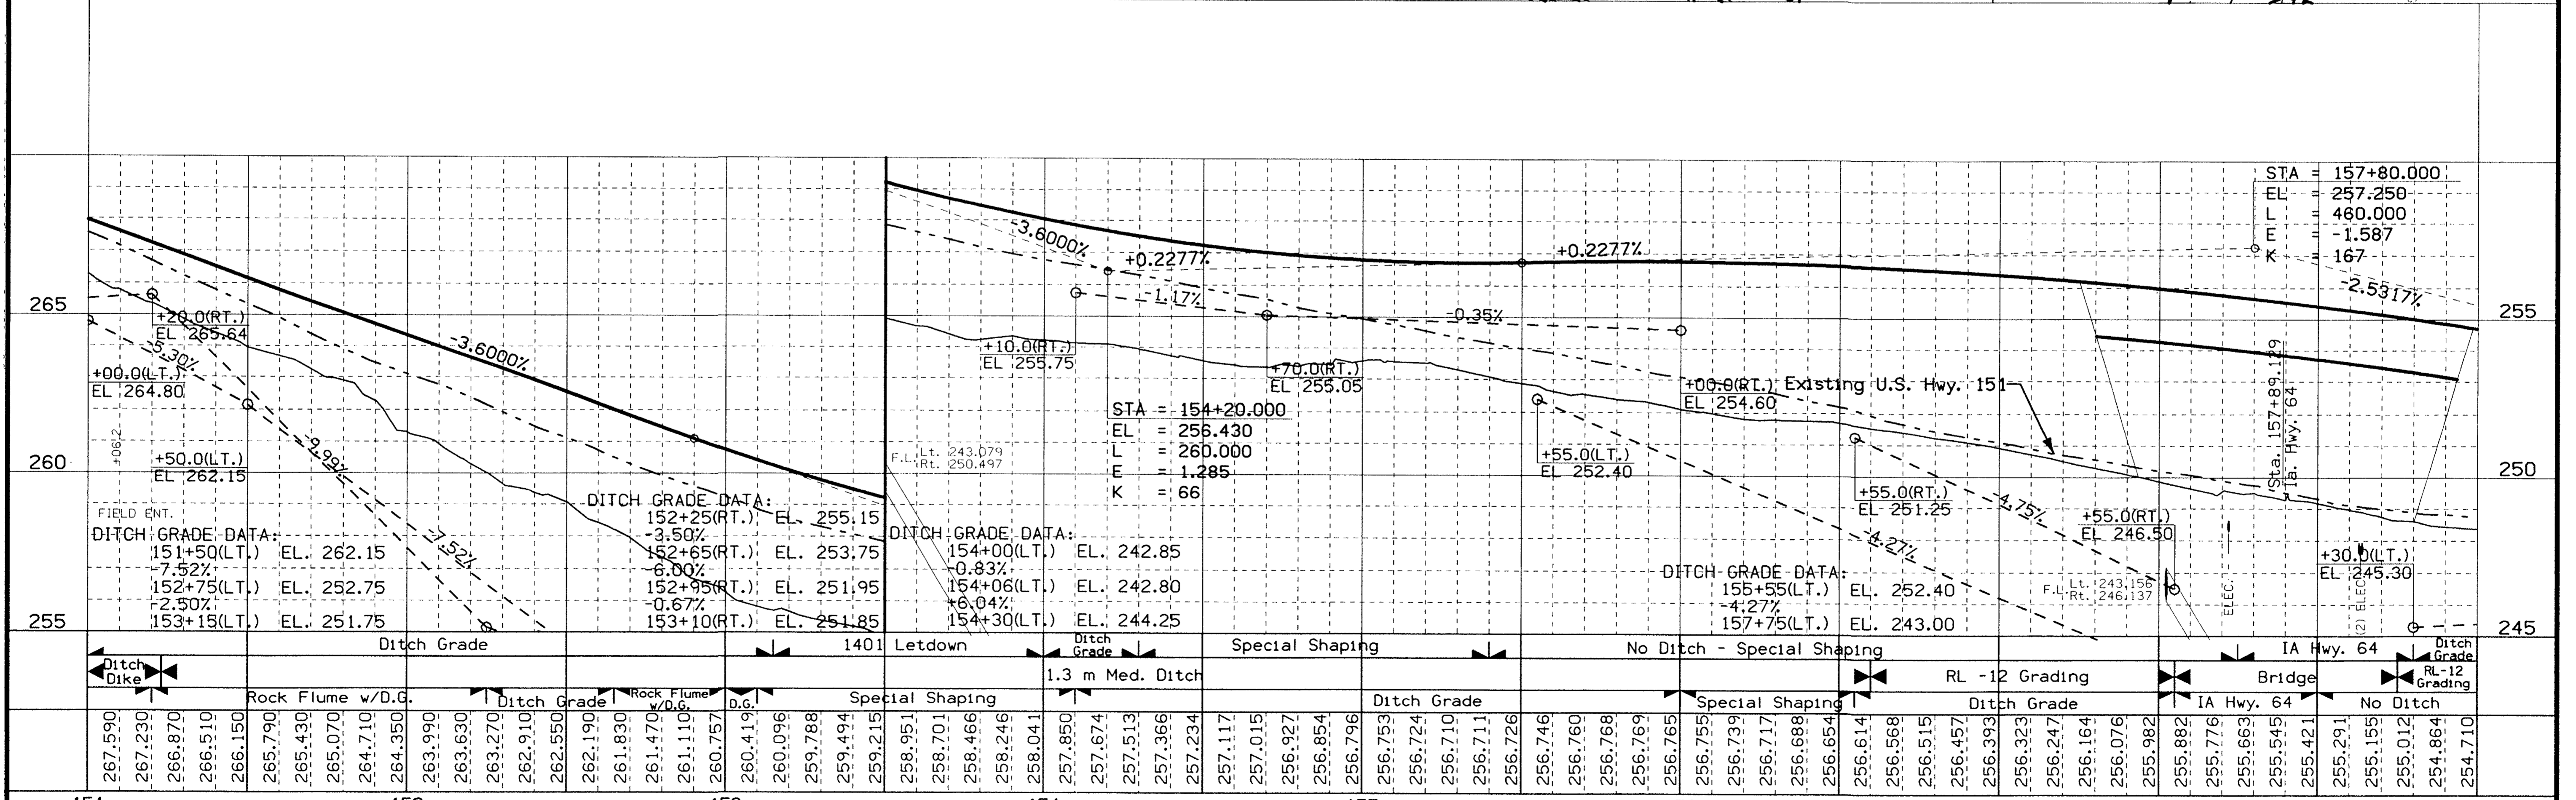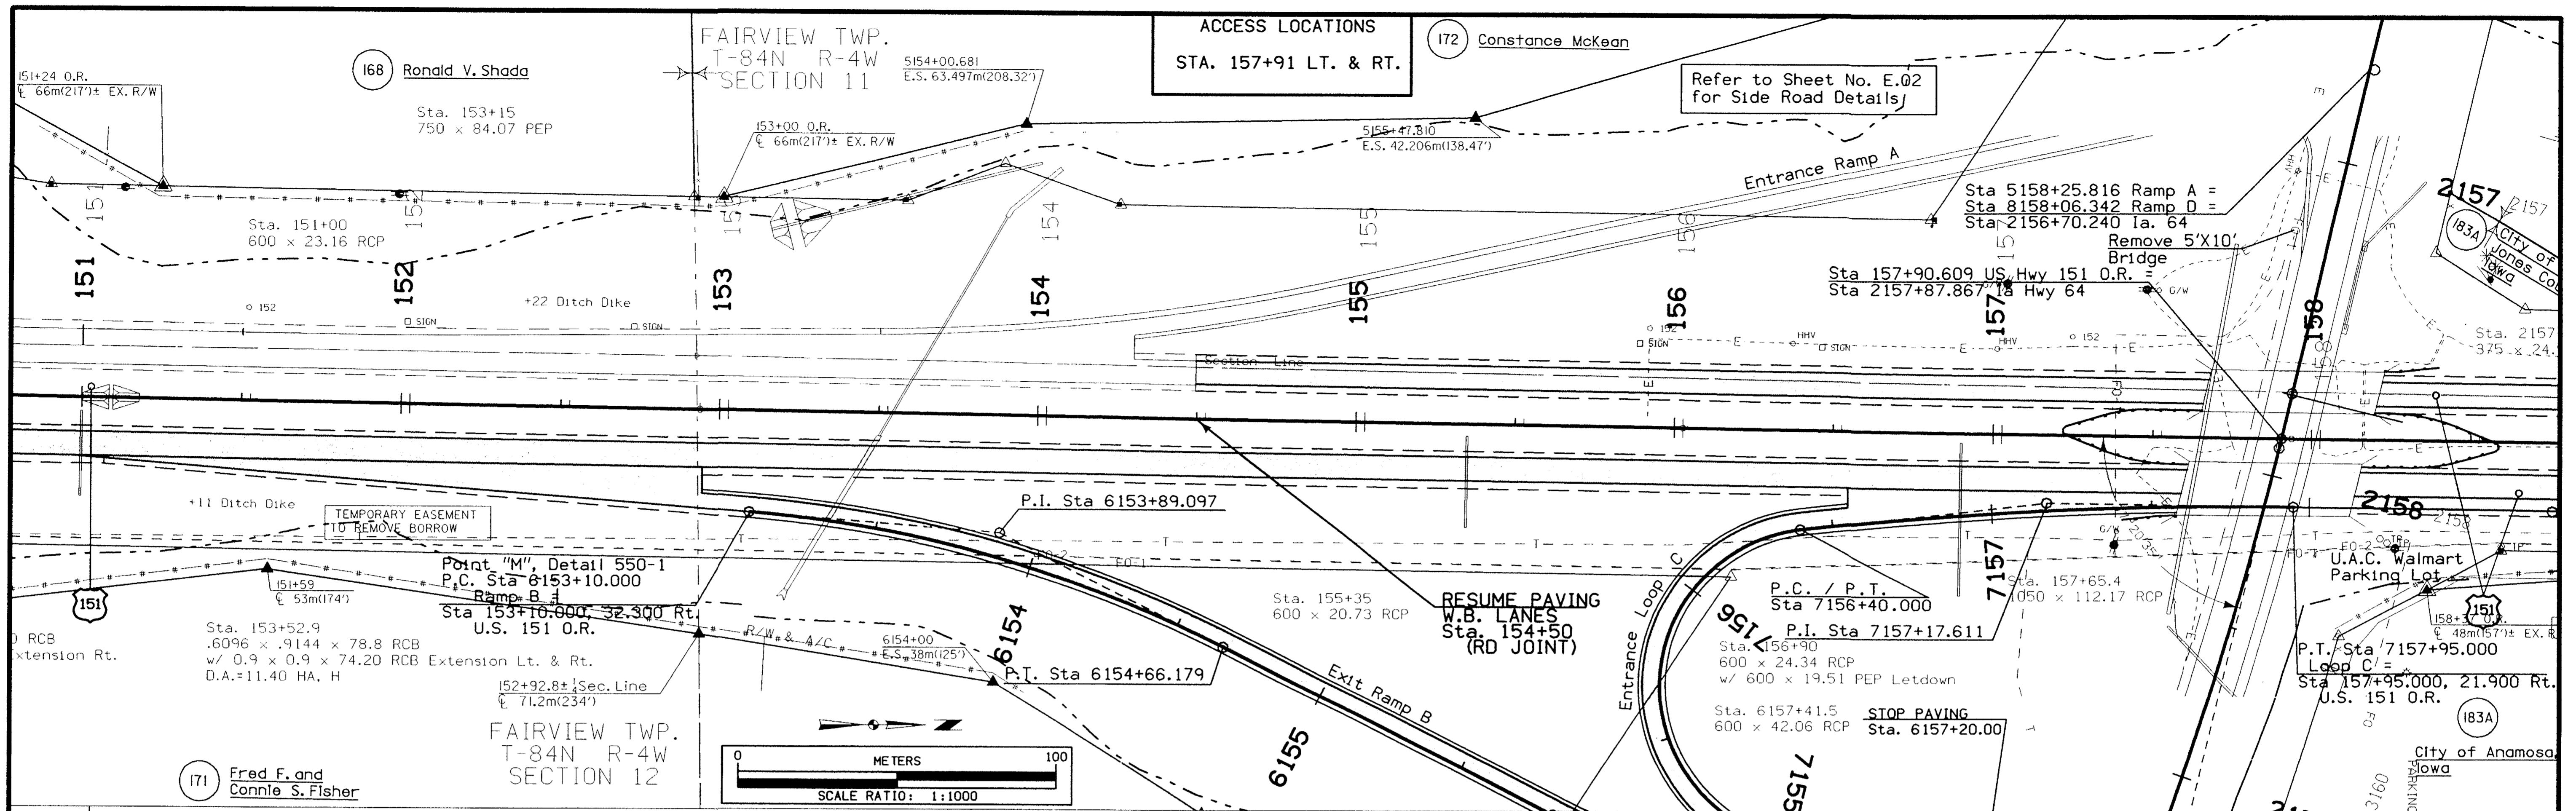

151	152	153	154	155	156	157	158																																																																			
Ditch Dike	Ditch Grade	Rock Flume w/D.G.	Ditch Grade	Rock Flume w/D.G.	Special Shaping	1.3 m Med. Ditch	Special Shaping	Ditch Grade	Special Shaping	No Ditch - Special Shaping	RL -12 Grading	Bridge	IA Hwy. 64	RL -12 Grading	No Ditch																																																											
267.590	267.290	266.870	266.510	266.150	265.790	265.430	265.070	264.710	264.350	263.990	263.630	263.270	262.910	262.550	262.190	261.830	261.470	261.110	260.757	260.419	260.096	259.788	259.494	259.215	258.951	258.701	258.466	258.246	258.041	257.850	257.674	257.513	257.366	257.234	257.117	257.015	256.927	256.854	256.796	256.753	256.724	256.710	256.711	256.726	256.746	256.760	256.768	256.769	256.765	256.755	256.739	256.717	256.688	256.654	256.614	256.568	256.515	256.457	256.393	256.323	256.247	256.164	256.076	255.982	255.882	255.776	255.663	255.545	255.421	255.291	255.155	255.012	254.864	254.710

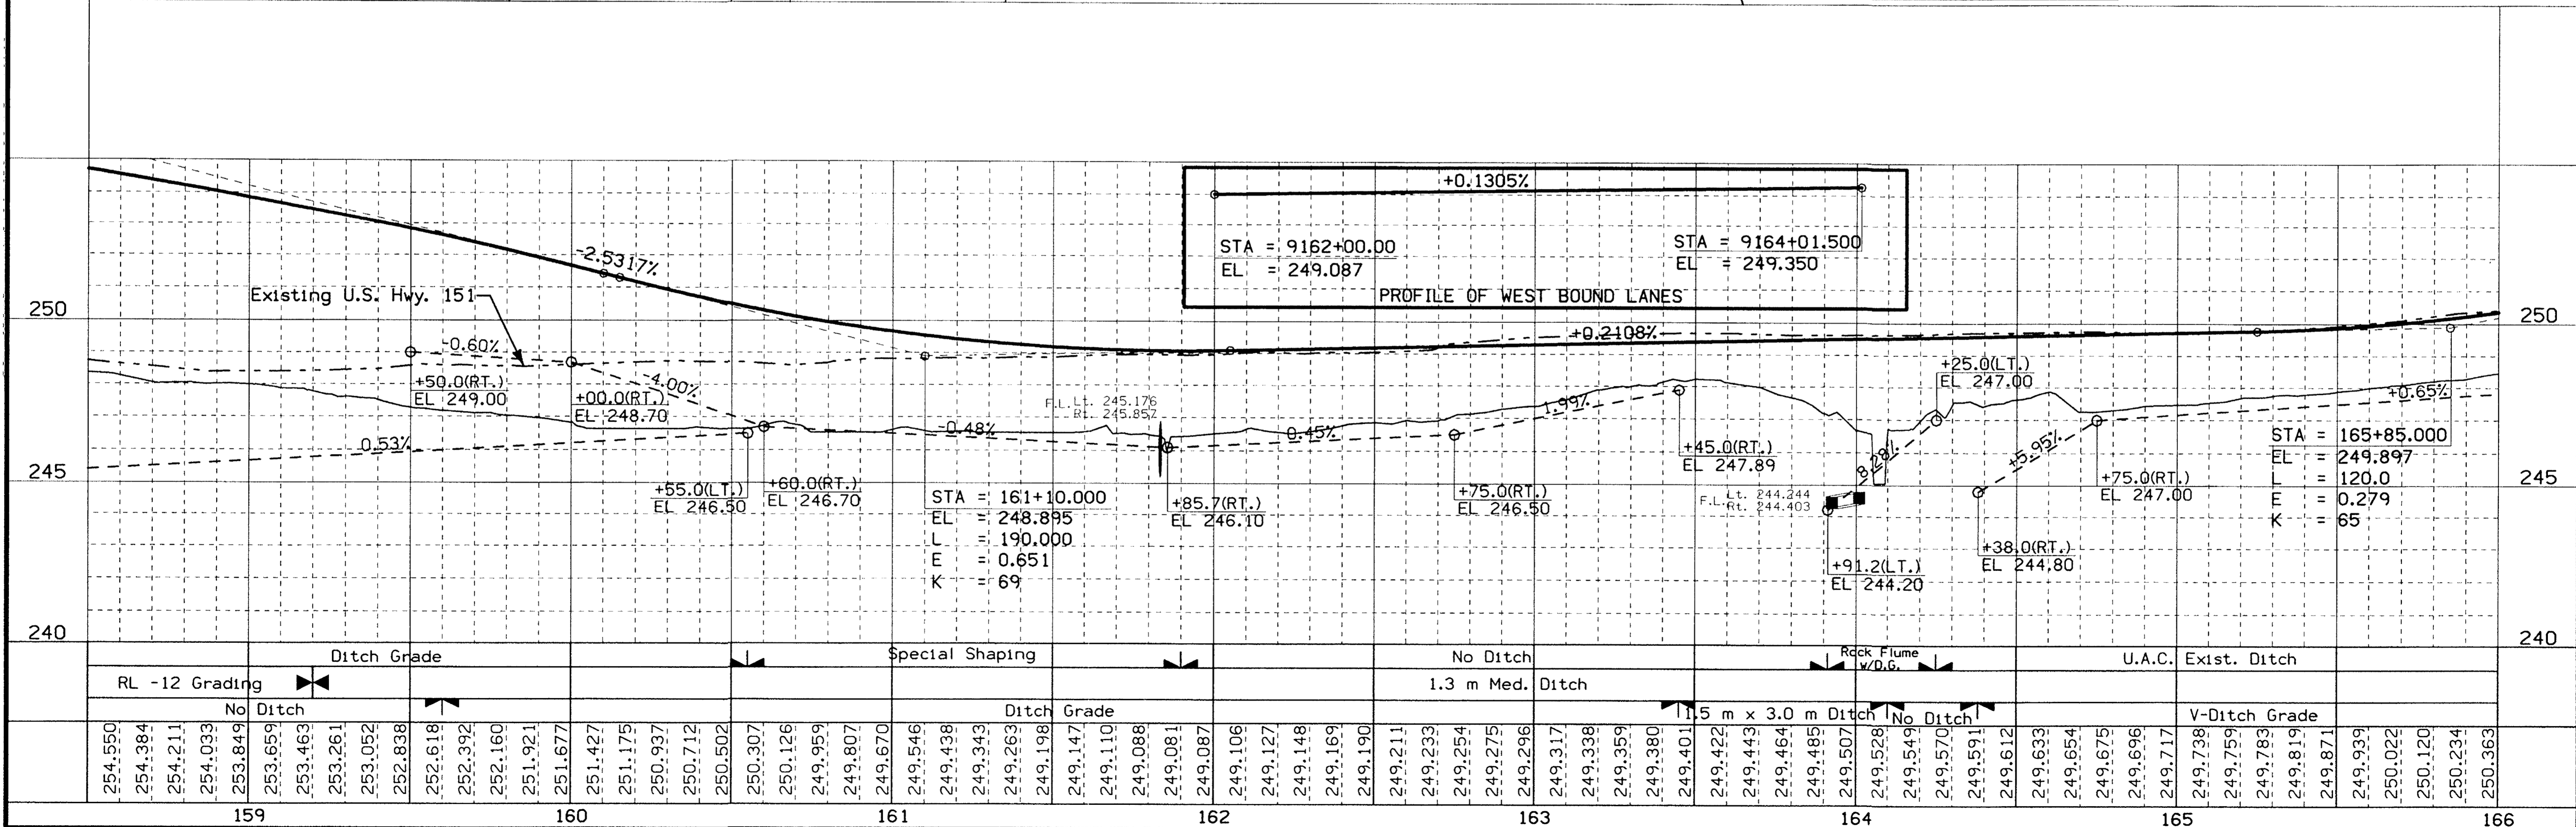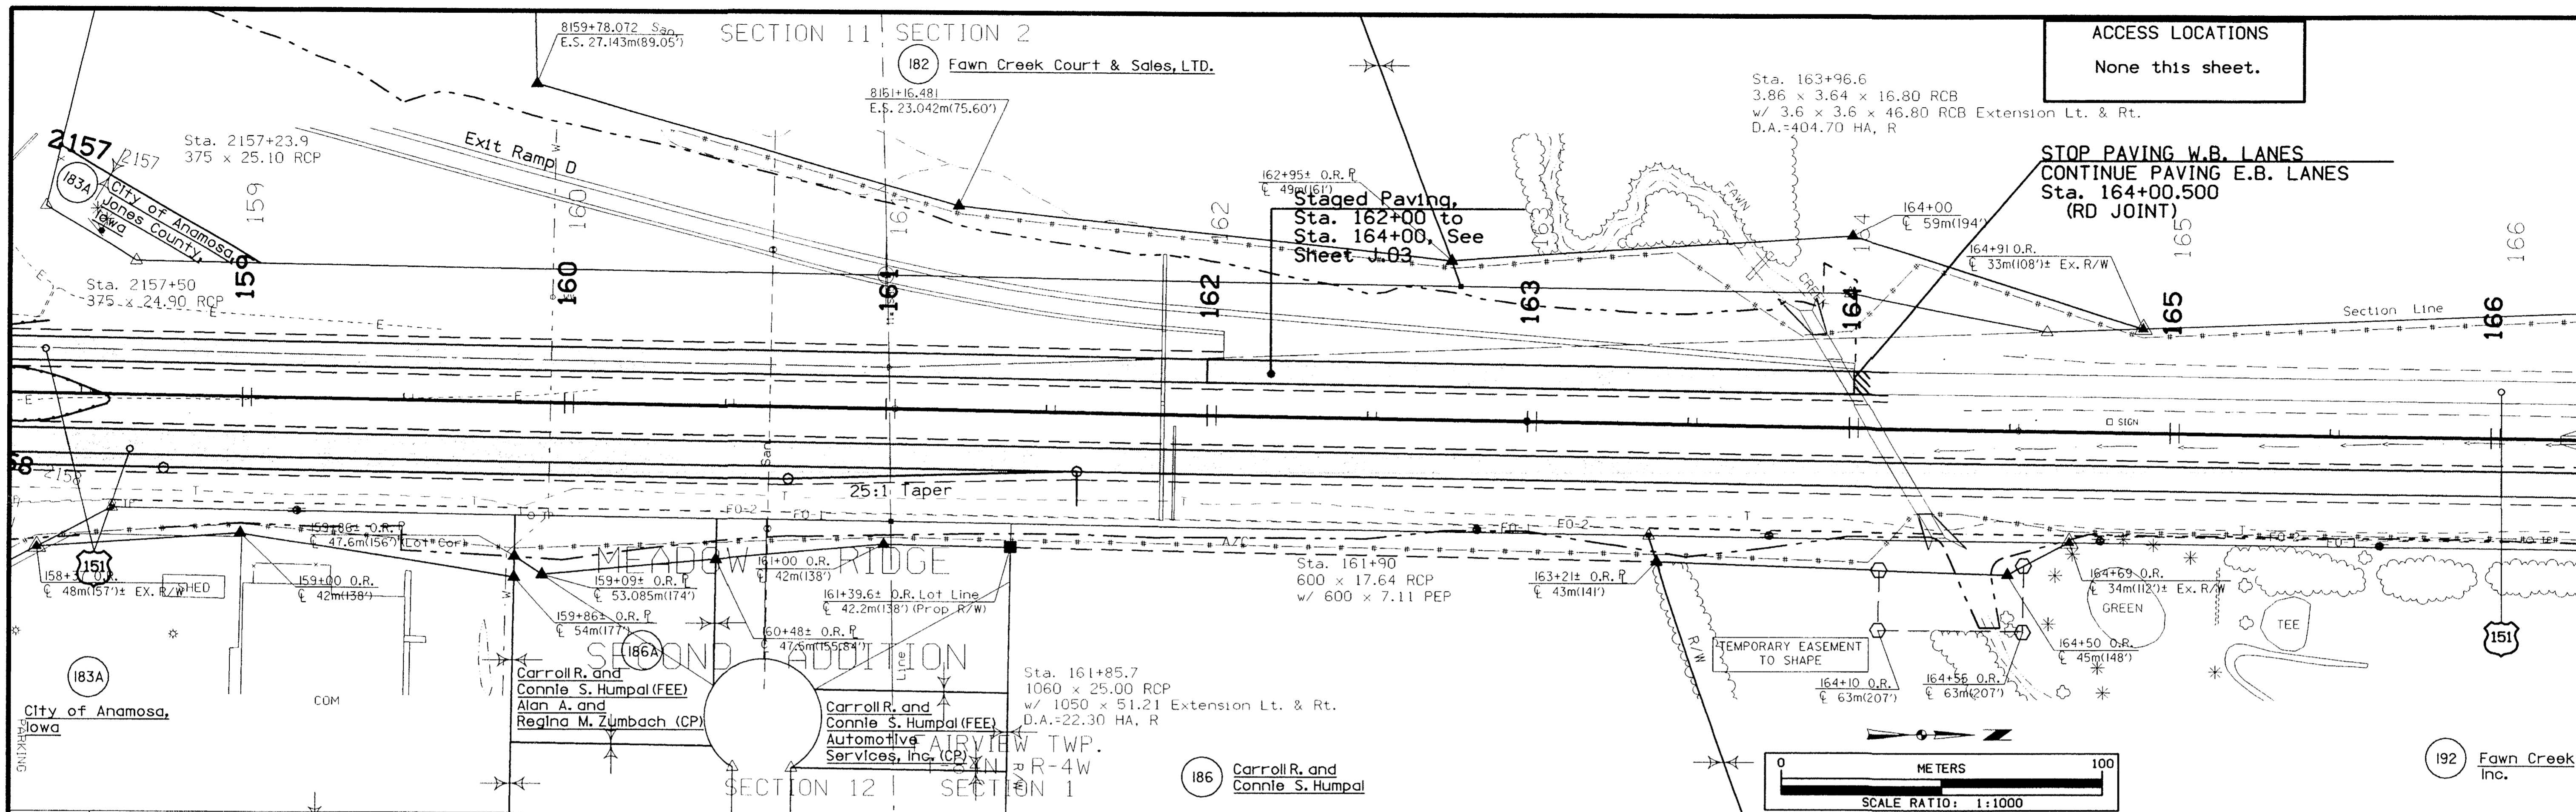

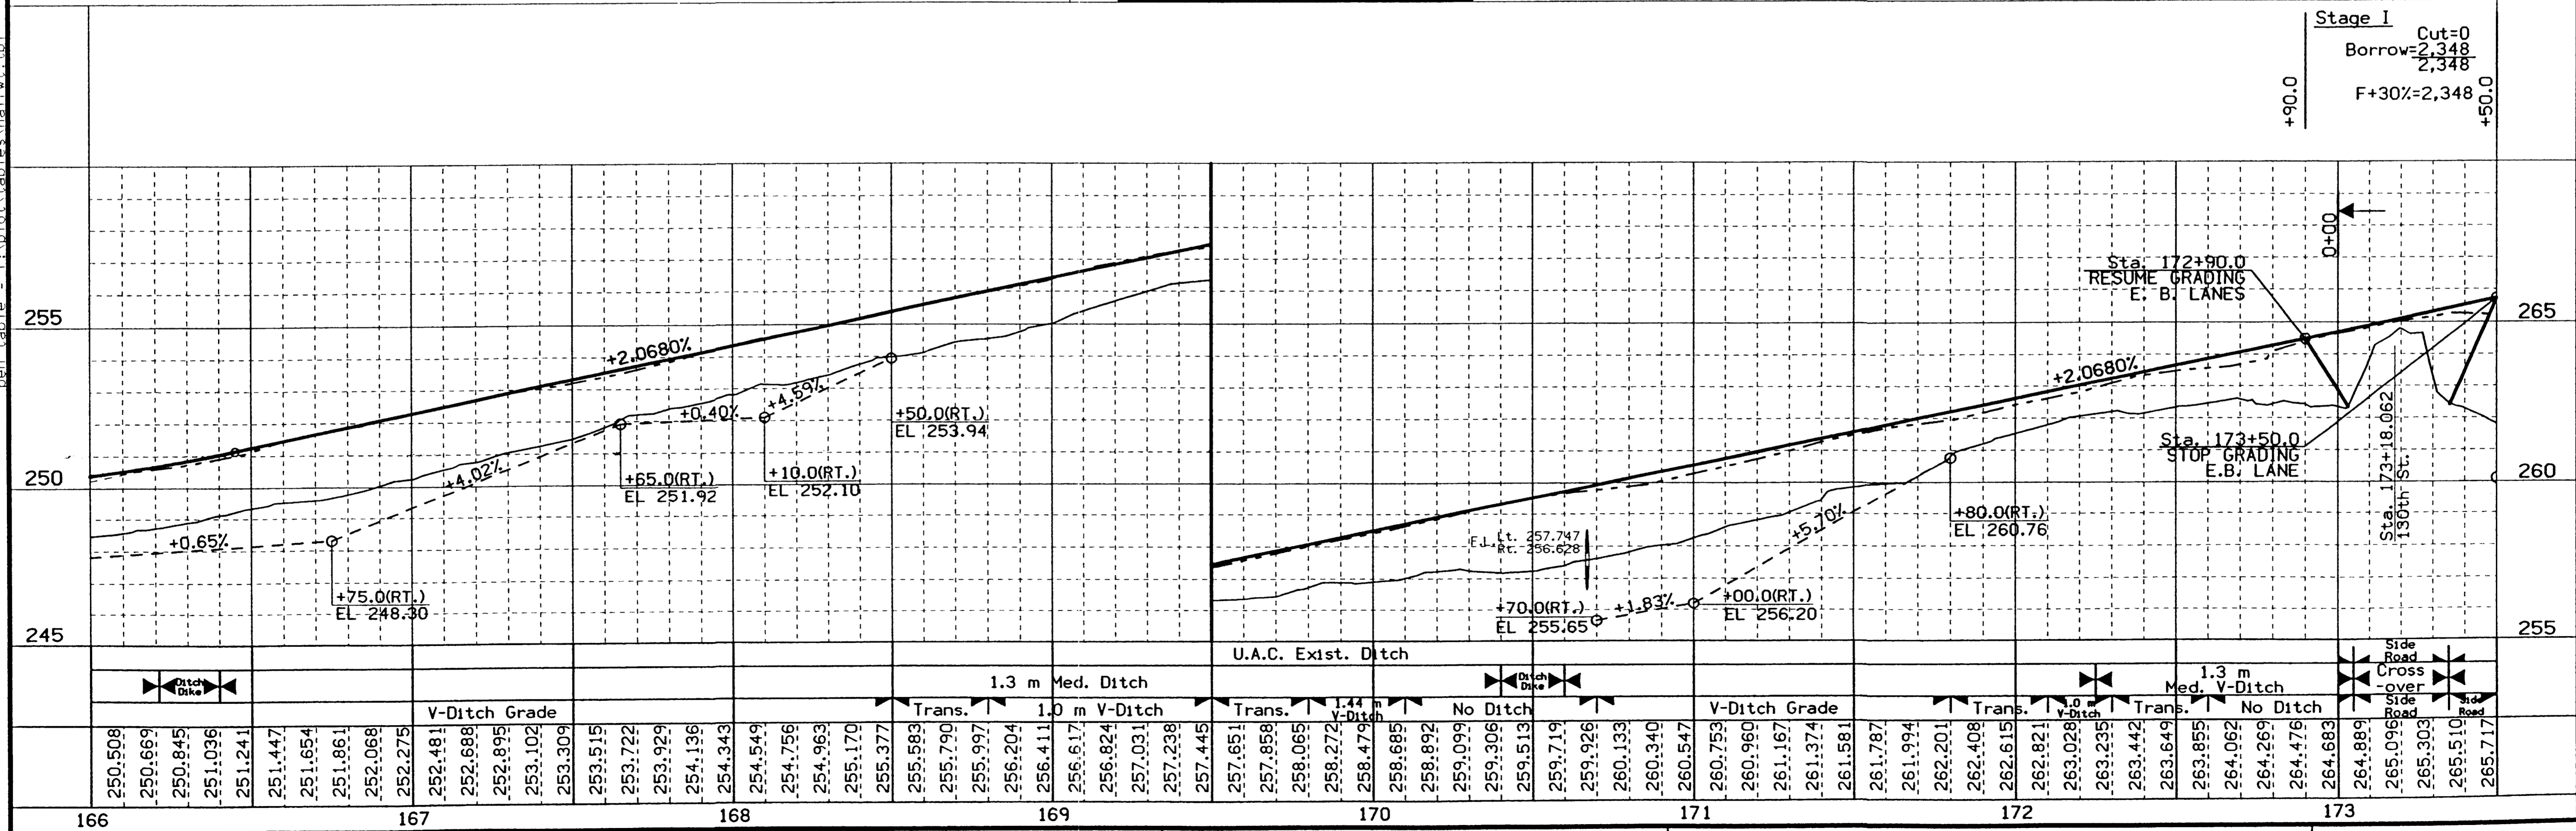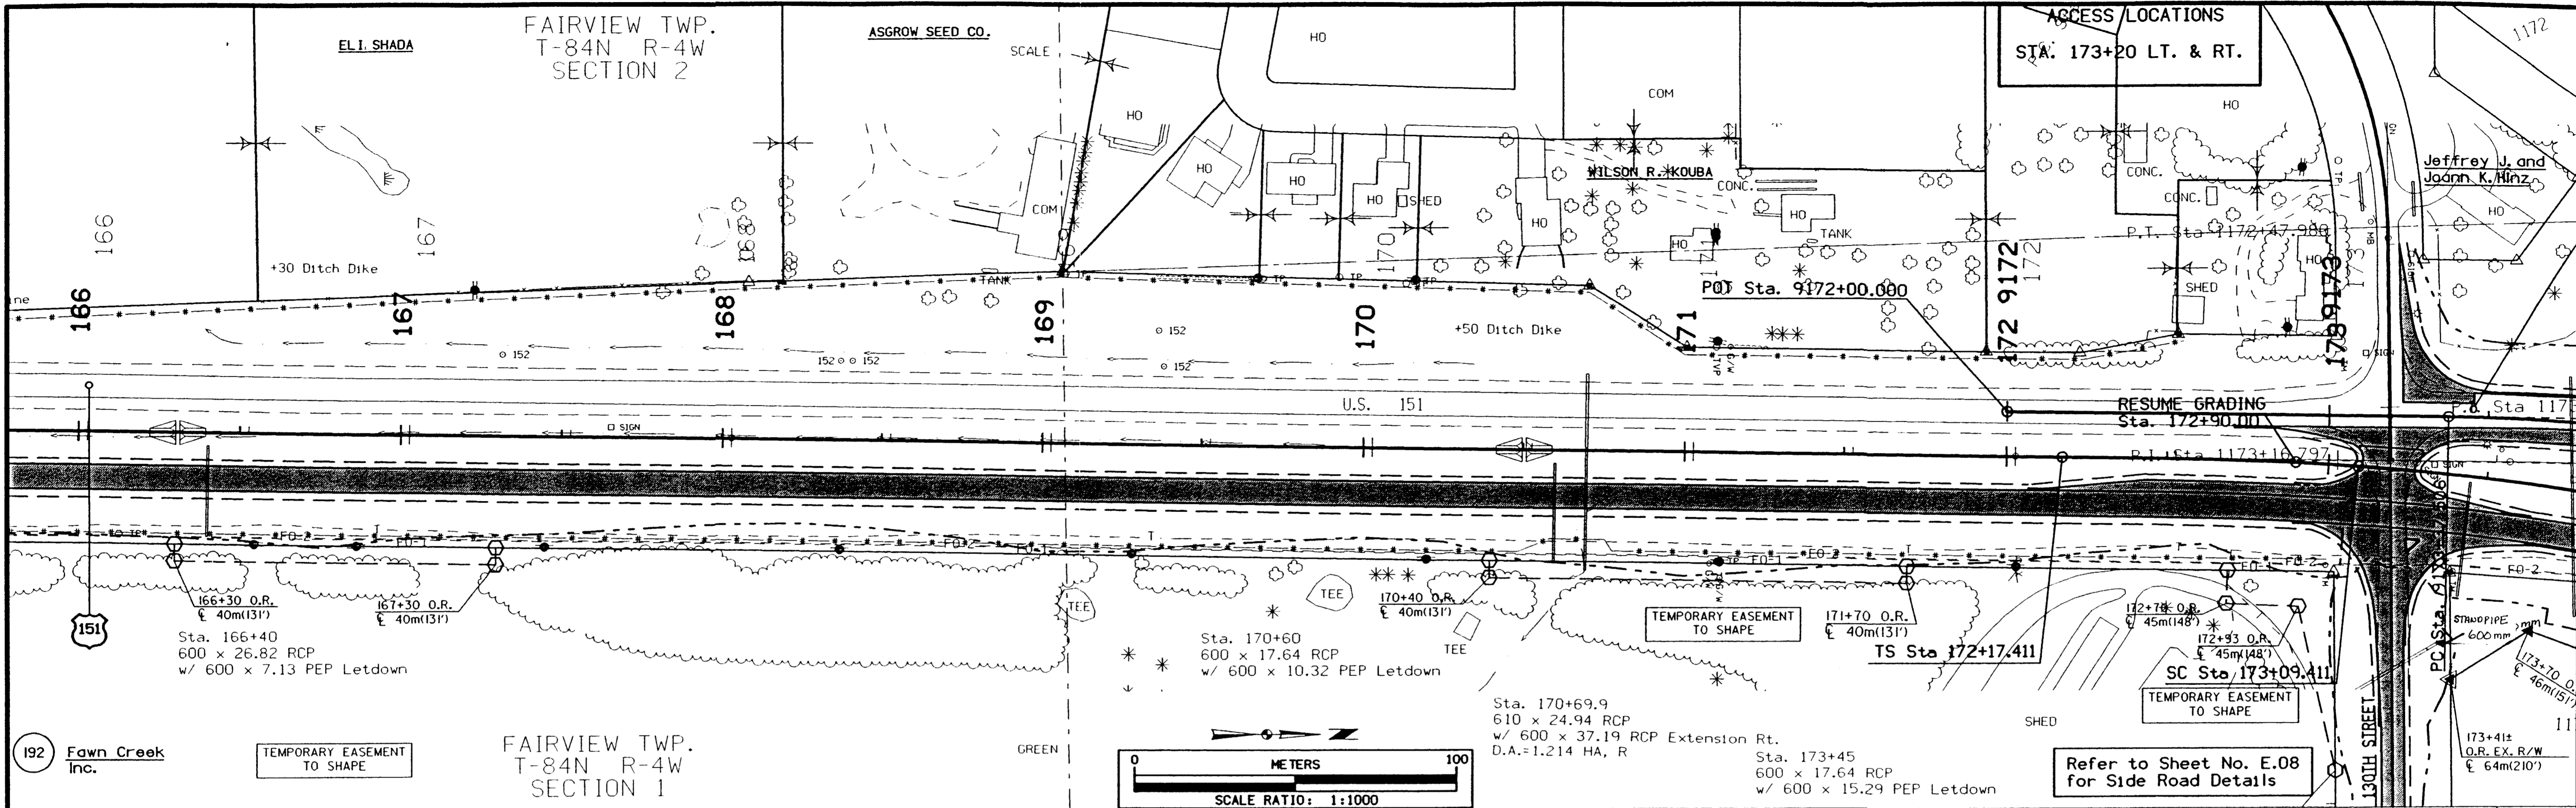

DESIGN TEAM	Skogerboe	METRIC	IOWA DOT * OFFICE OF ROAD DESIGN	Linn/Jones	COUNTY	PROJECT NUMBER	NHSX-151-3(112)--3H-57	SHEET NUMBER	D.23
-------------	-----------	--------	----------------------------------	------------	--------	----------------	------------------------	--------------	------

206 D. A. Downing and C. R. McNamara
dba MACDOW, a partnership



FAIRVIEW TWP.
T-84N R-4W
SECTION 1

CASS TWP.
T-85N R-4W
SECTION 36

ACCESS LOCATIONS
STA. 177+15 LT. & RT.
STA. 180+73 LT. & RT.


Gilbert W. and
Dorothy Schocker

See Sheet Nos. L.32 to L.35
for Turn Lane and
Pavement Widening Details

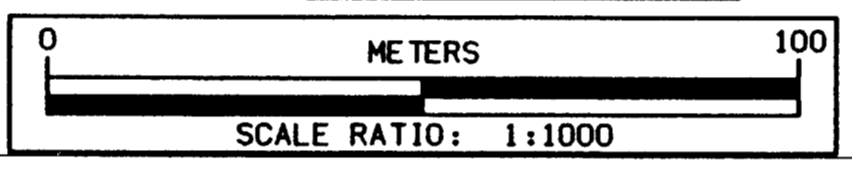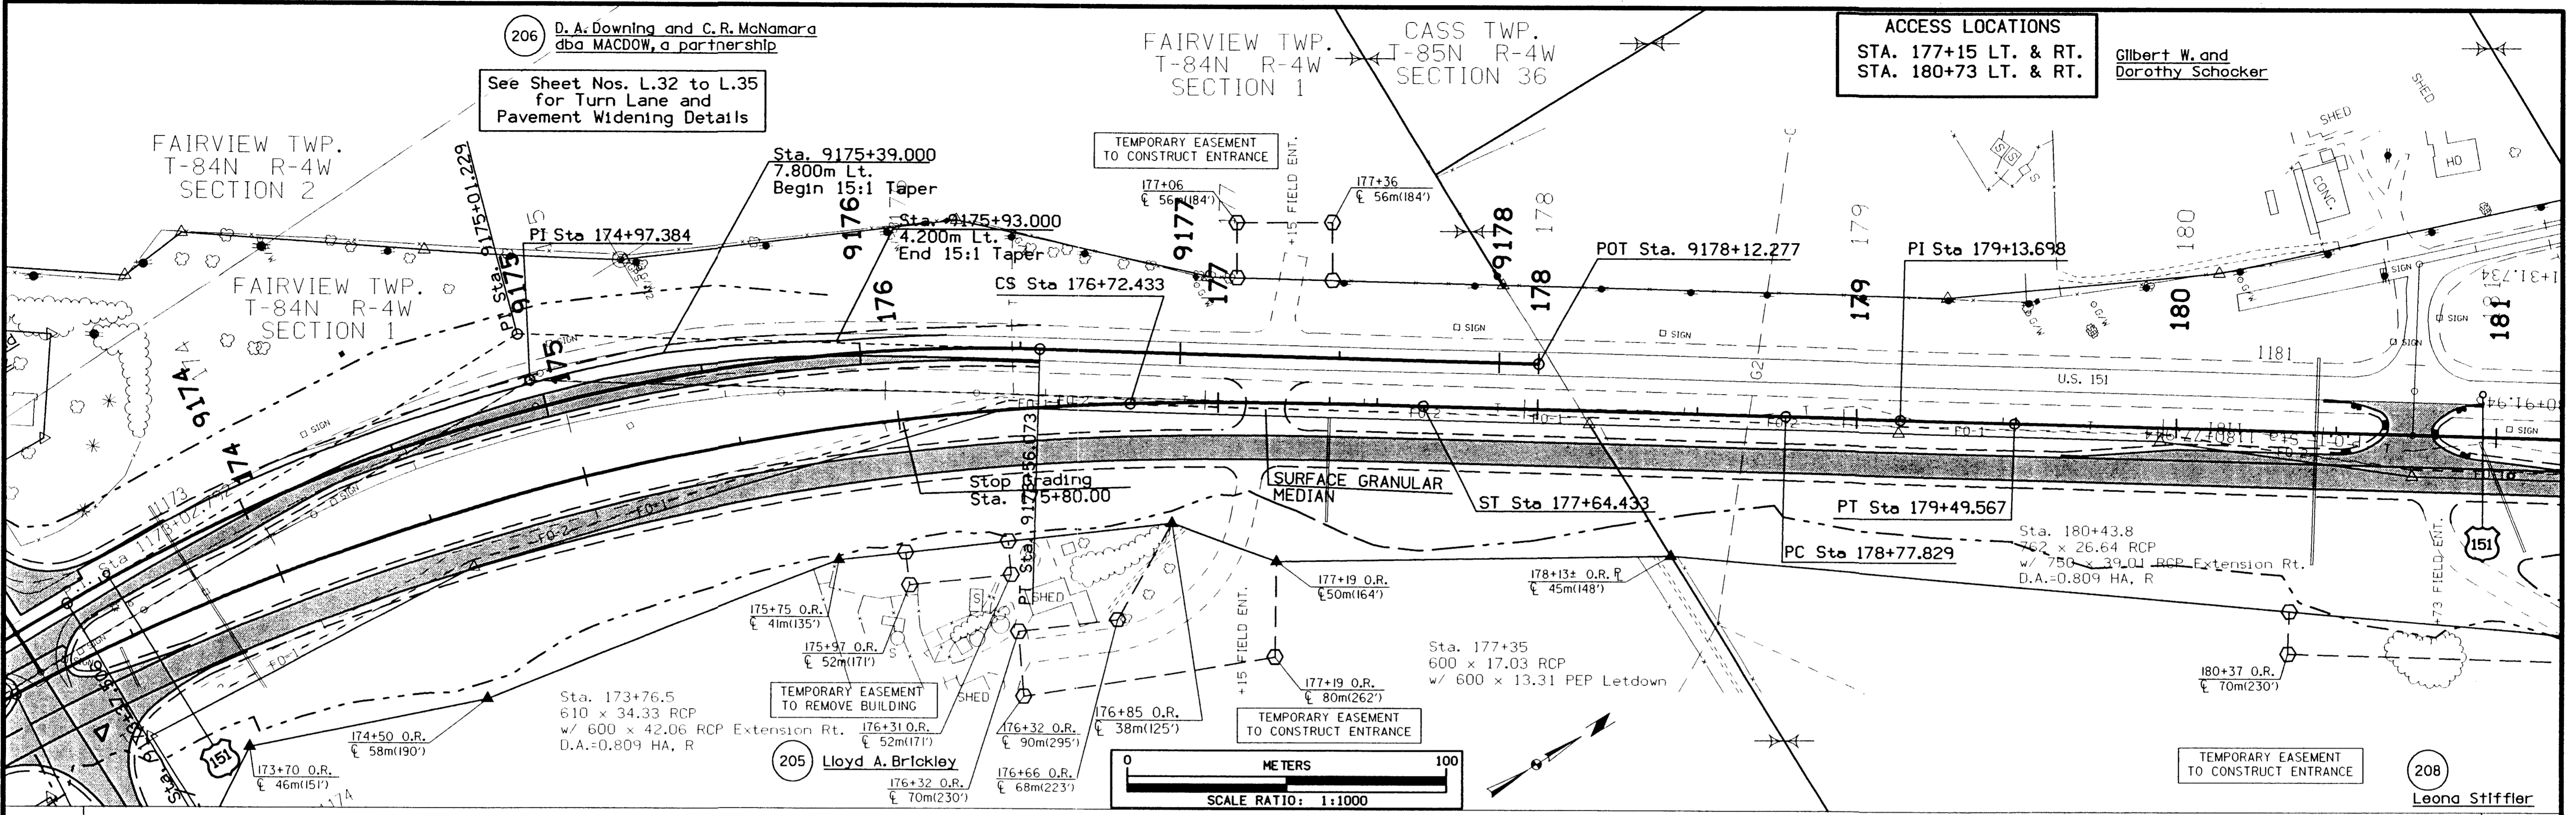

208 Leona Stiffler



Cut=1,491
Borrow=874
F+30%=2,369

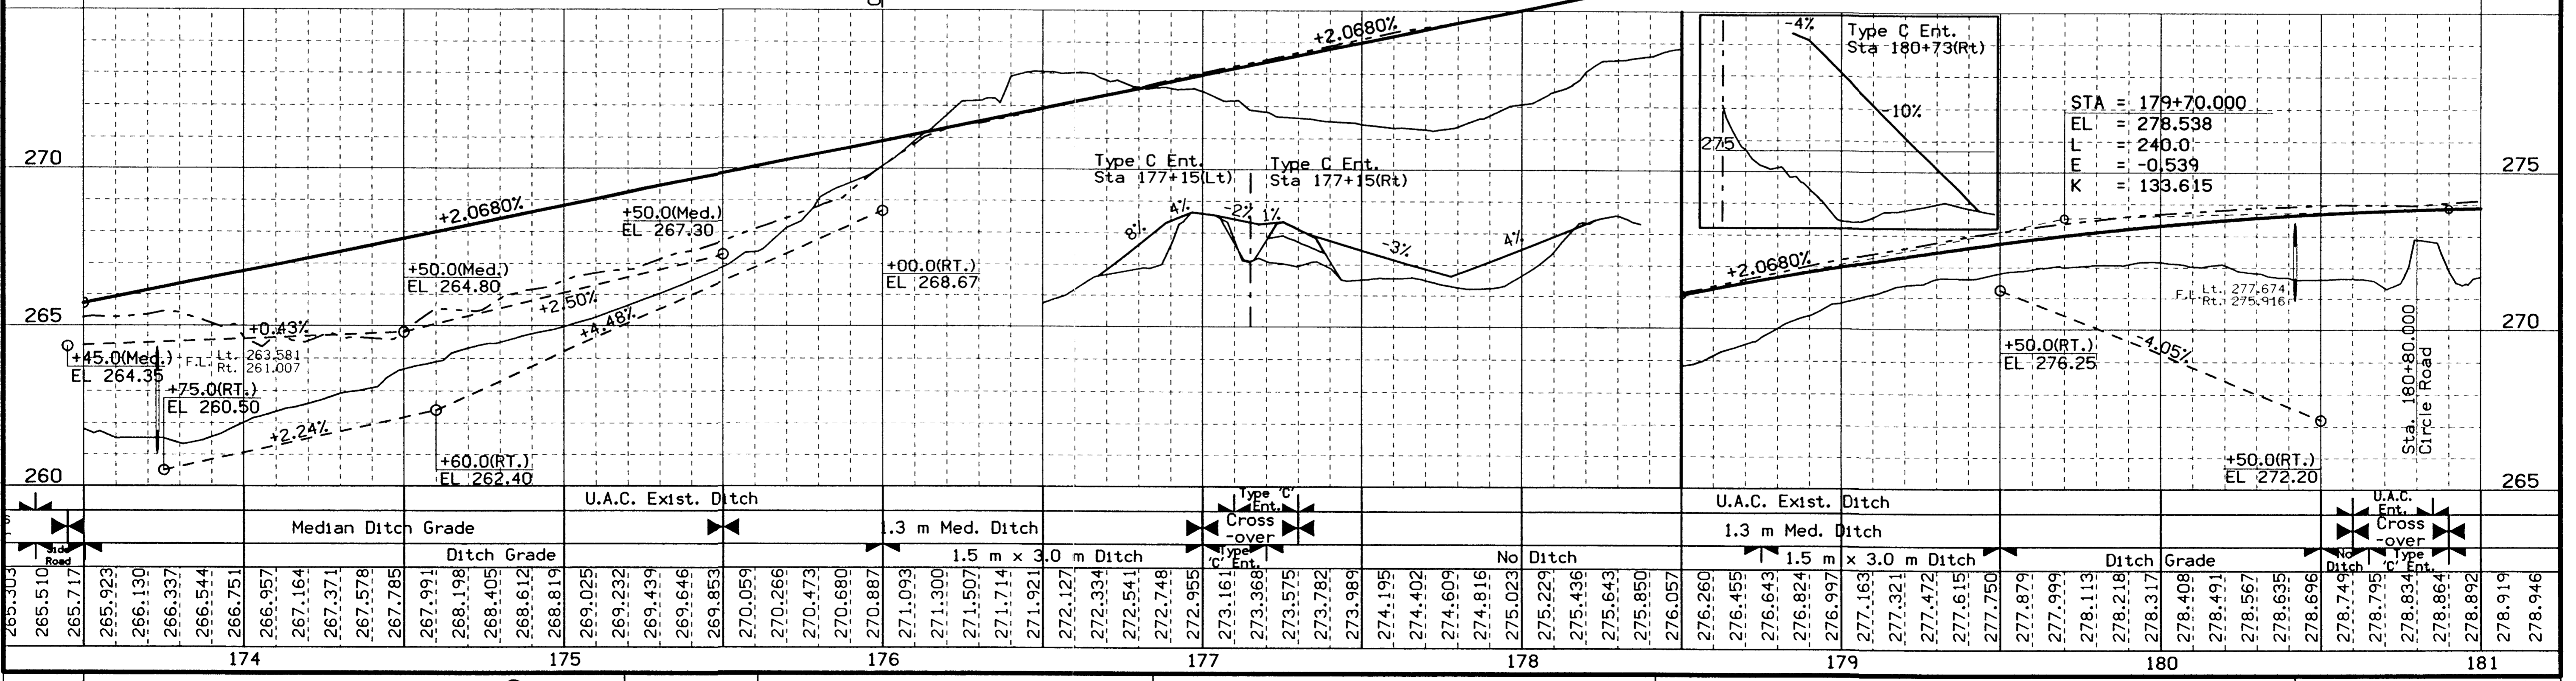

DESIGN TEAM	Skogerboe / earth	METRIC	IOWA DOT * OFFICE OF ROAD DESIGN	Linn/Jones	COUNTY	PROJECT NUMBER	NHSX-151-3(112)--3H-57	SHEET NUMBER	D.24
-------------	-------------------	--------	----------------------------------	------------	--------	----------------	------------------------	--------------	------


Revised 04/08/02
59-198

dgn = I:\WORK\project_36922_cadd\anacurve\PAVE\57151112.d24
 levels = 1-4,7,8
 pen table = I:\Plot\tables\hal.fvt.tbl

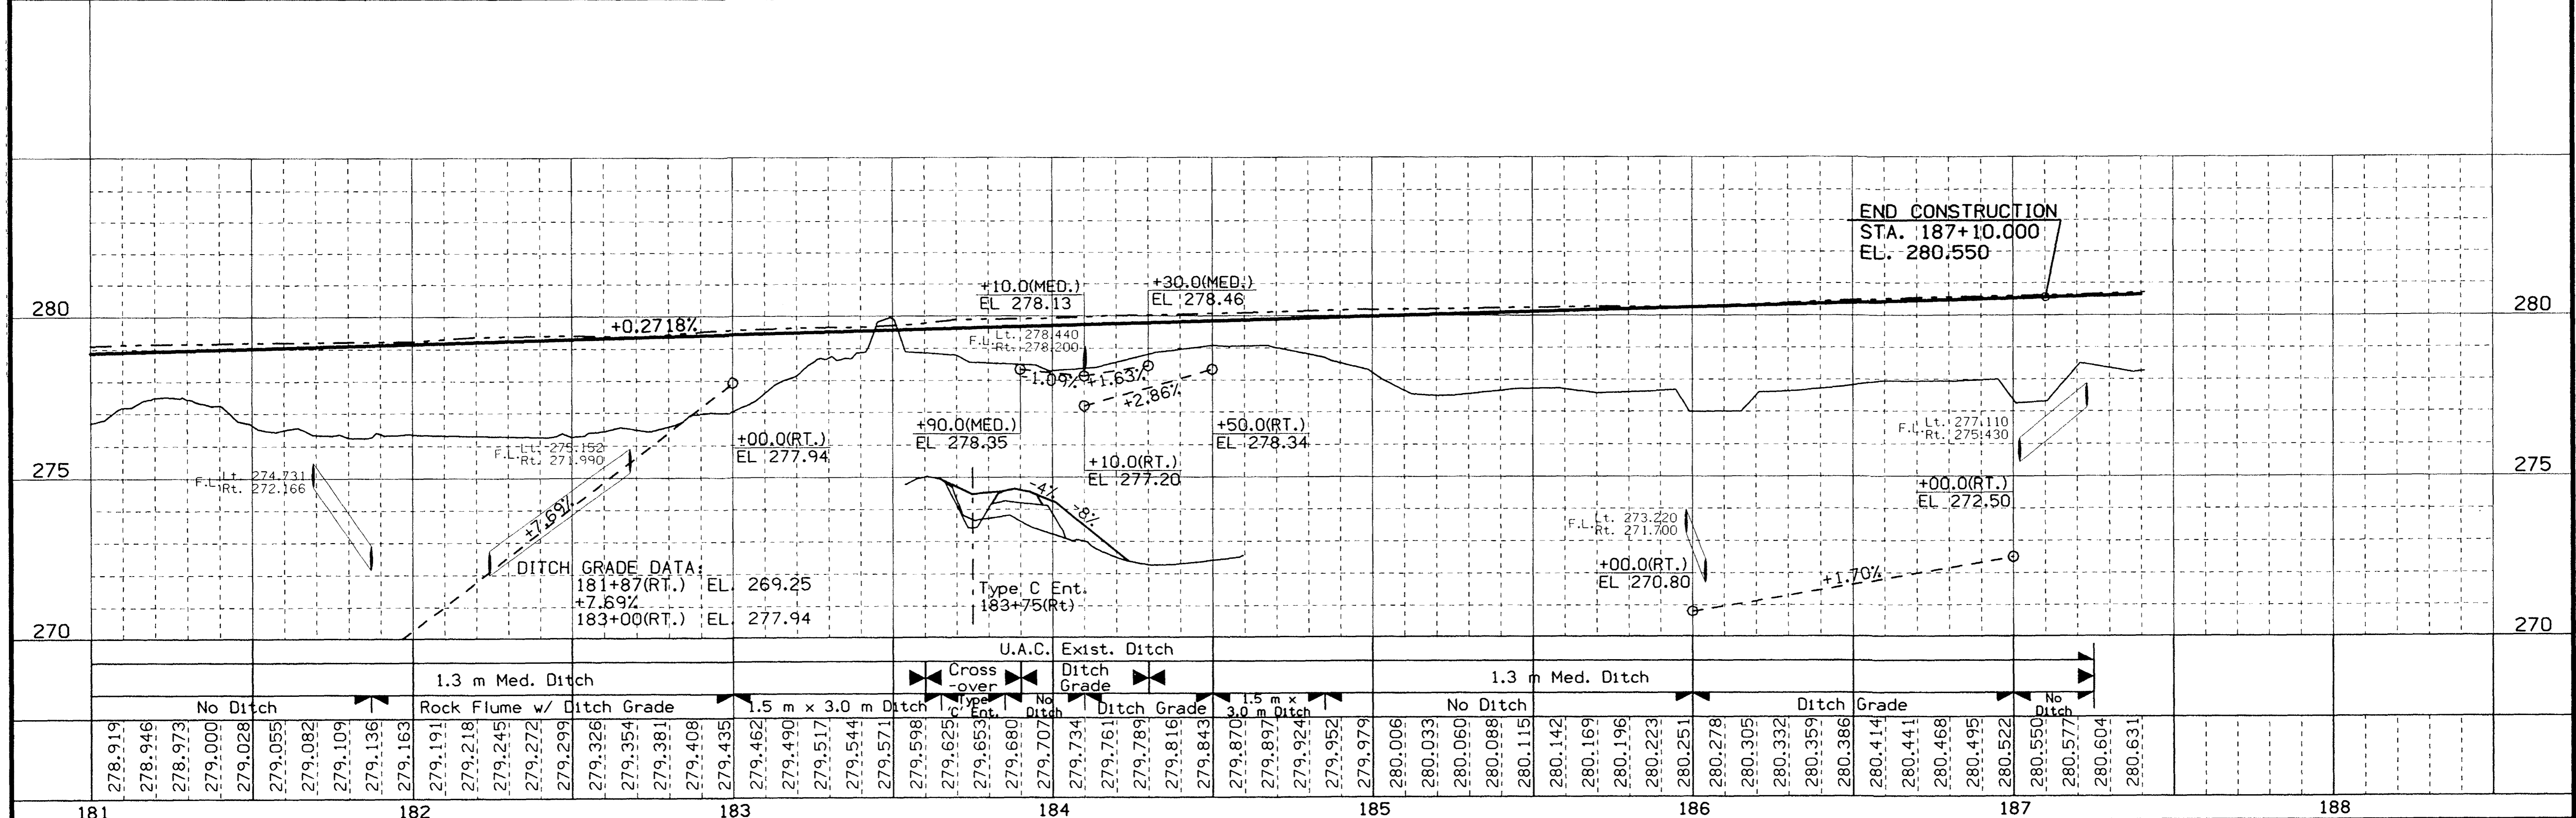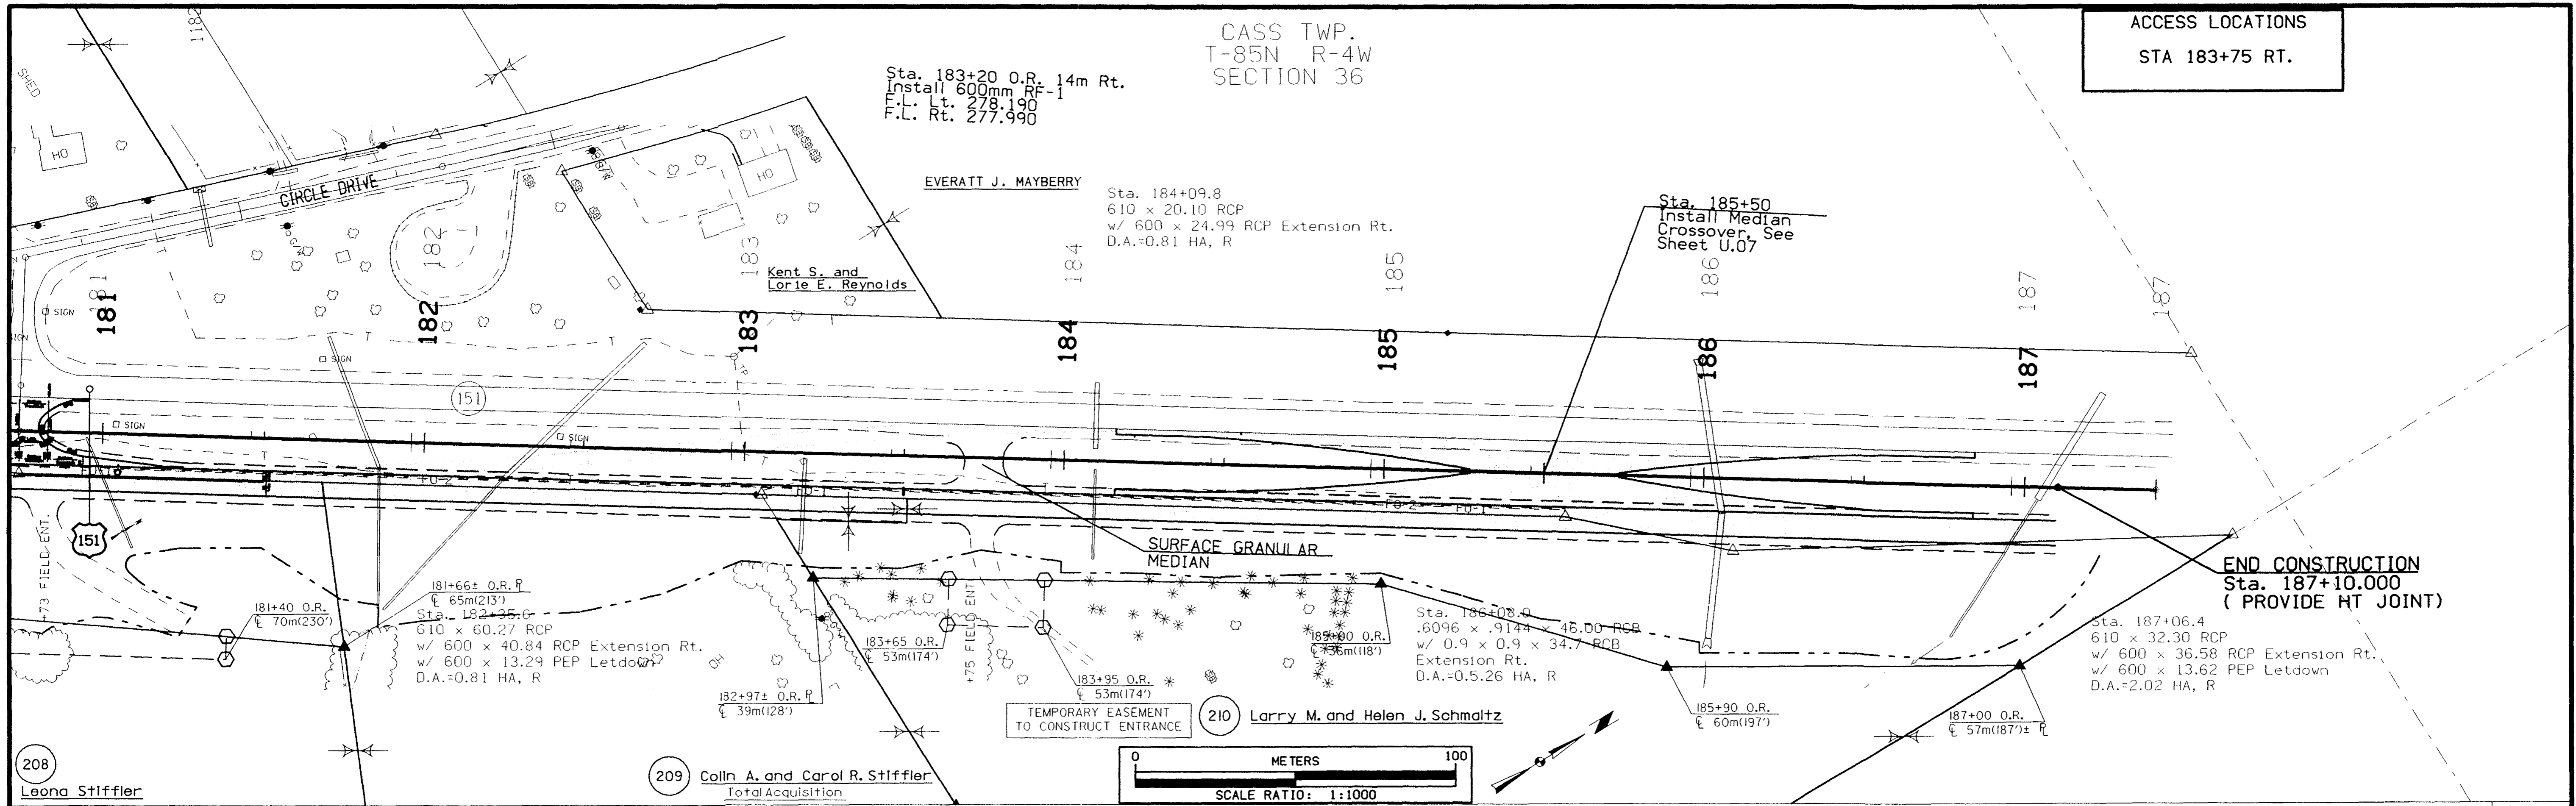

10 Vernon L. and Shirley I. Horak
 BROWN TWP.
 T-84N R-5W
 SECTION 24


For Main Line Details
 Refer to Sheet No. D.05

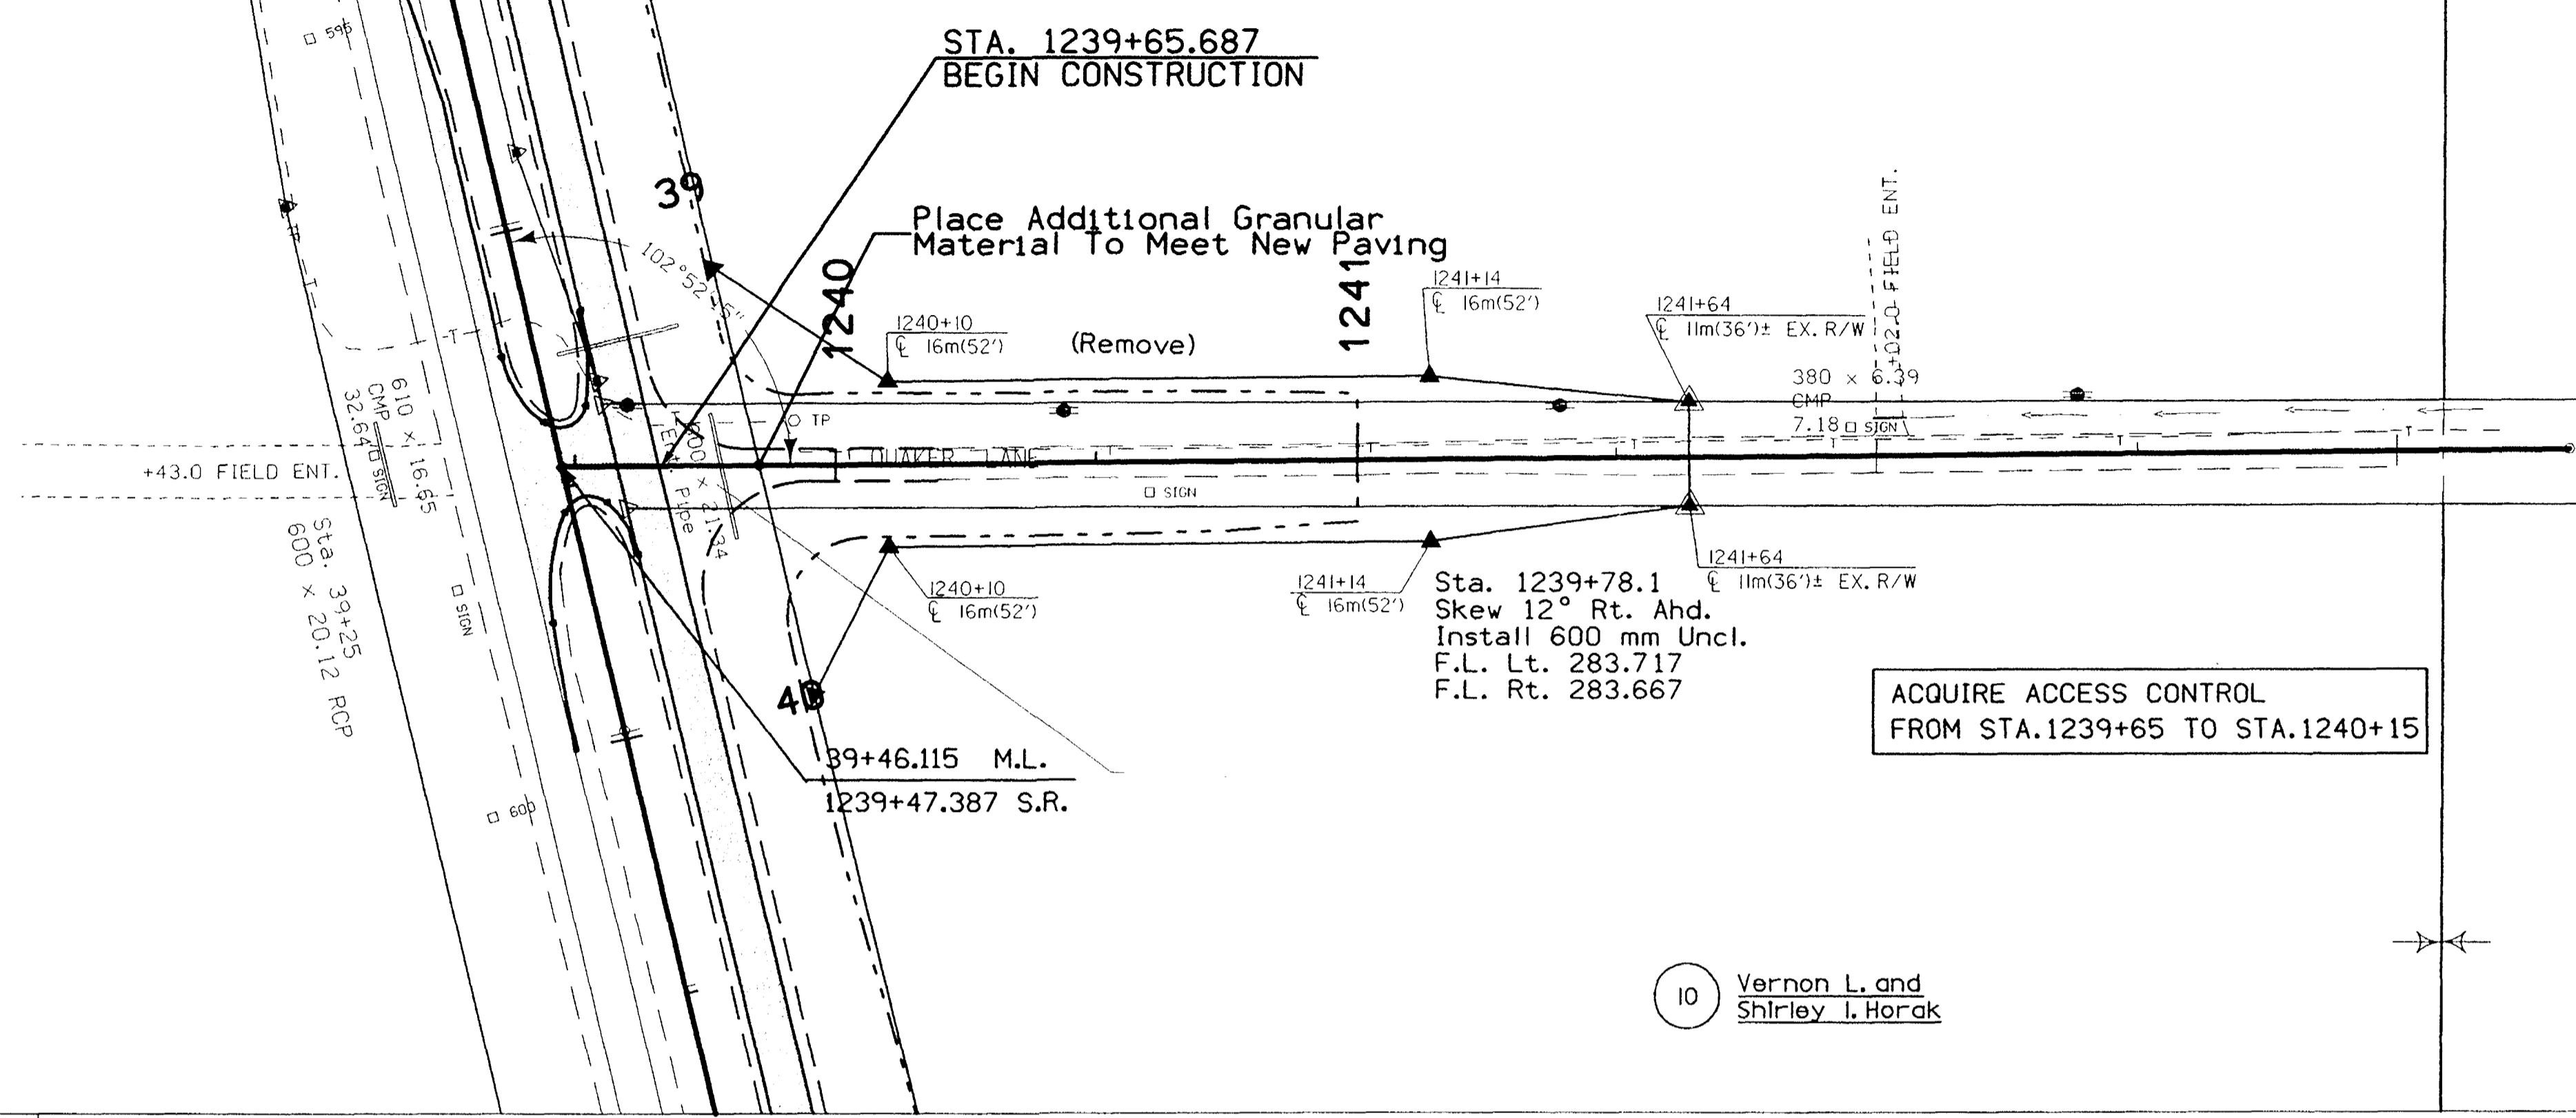


I hereby certify that this plan was prepared under my supervision and that engineering decisions with regard to the design were made by me or by other duly licensed Professional Engineers under the laws of the State of Iowa.

Monica Smith 10/5/00
 Signature Date
 MONICA M. SMITH
 Printed or Typed Name
 My license renewal date is December 31, 2001.

Pages or sheets covered by this seal: E.01-E.07


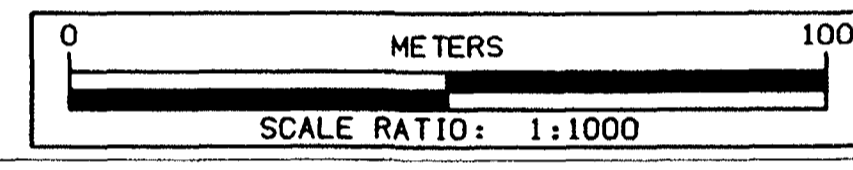


QUAKER LANE

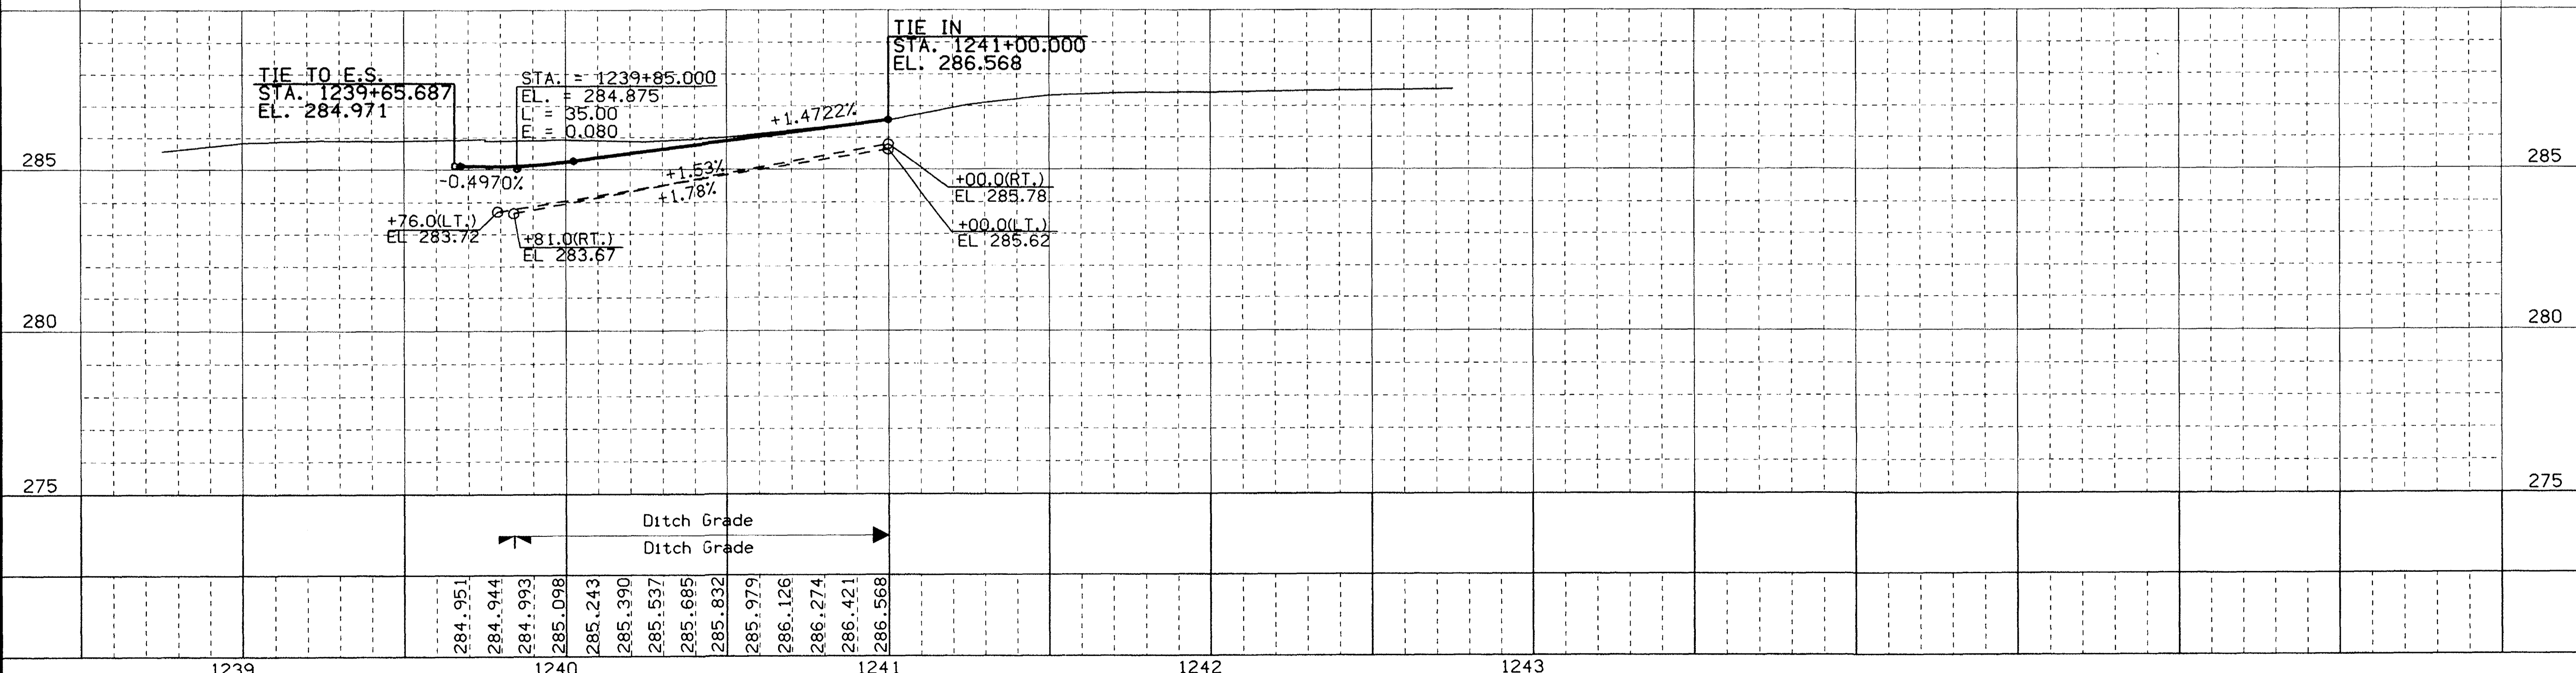

dgn = I:\WORK\project\34120\cadd\PAVE\57151112.e01
 level = 1-59.61-63
 pen-table = I:\PLOT\tbl\es\half\wt.tbl
 date = Thu Oct 5 11:23:59 2000
 prf = \\WATSOI\DATA\PL0T\PL463P\e31h.prf

61-198

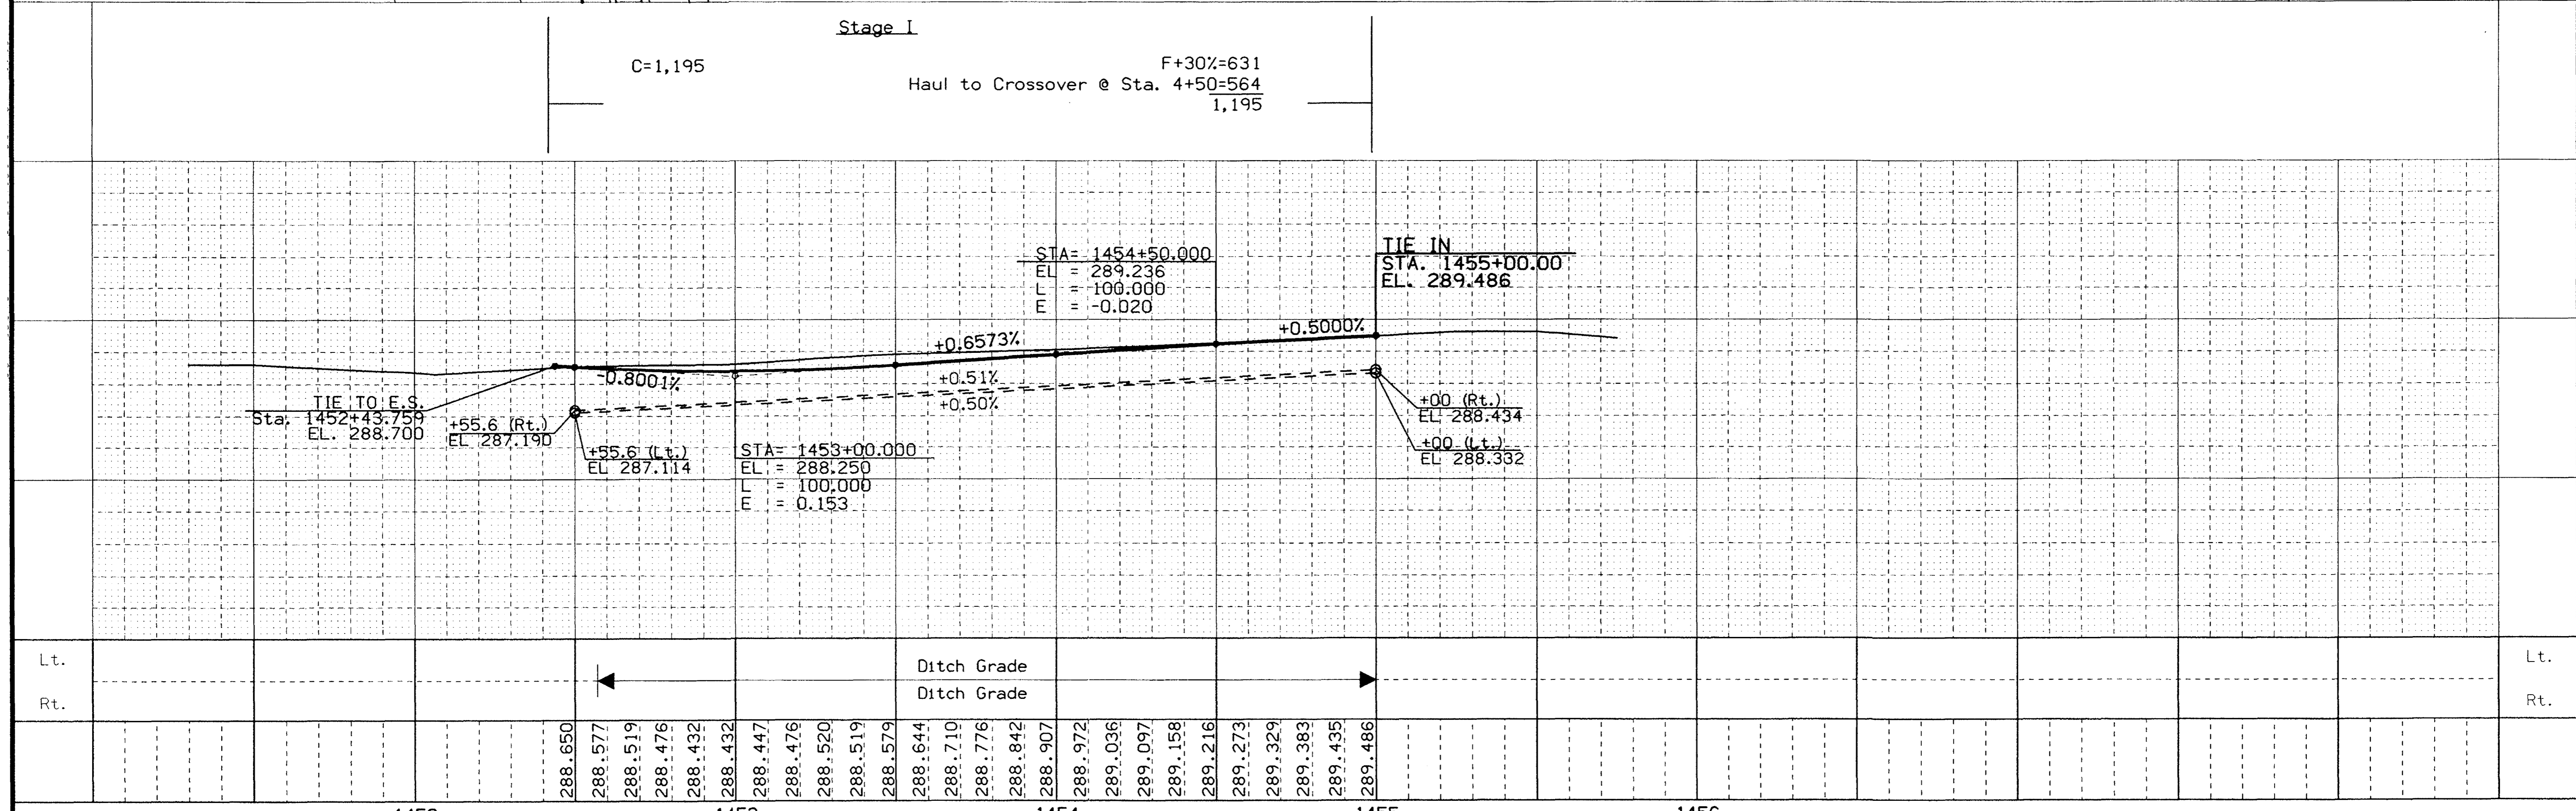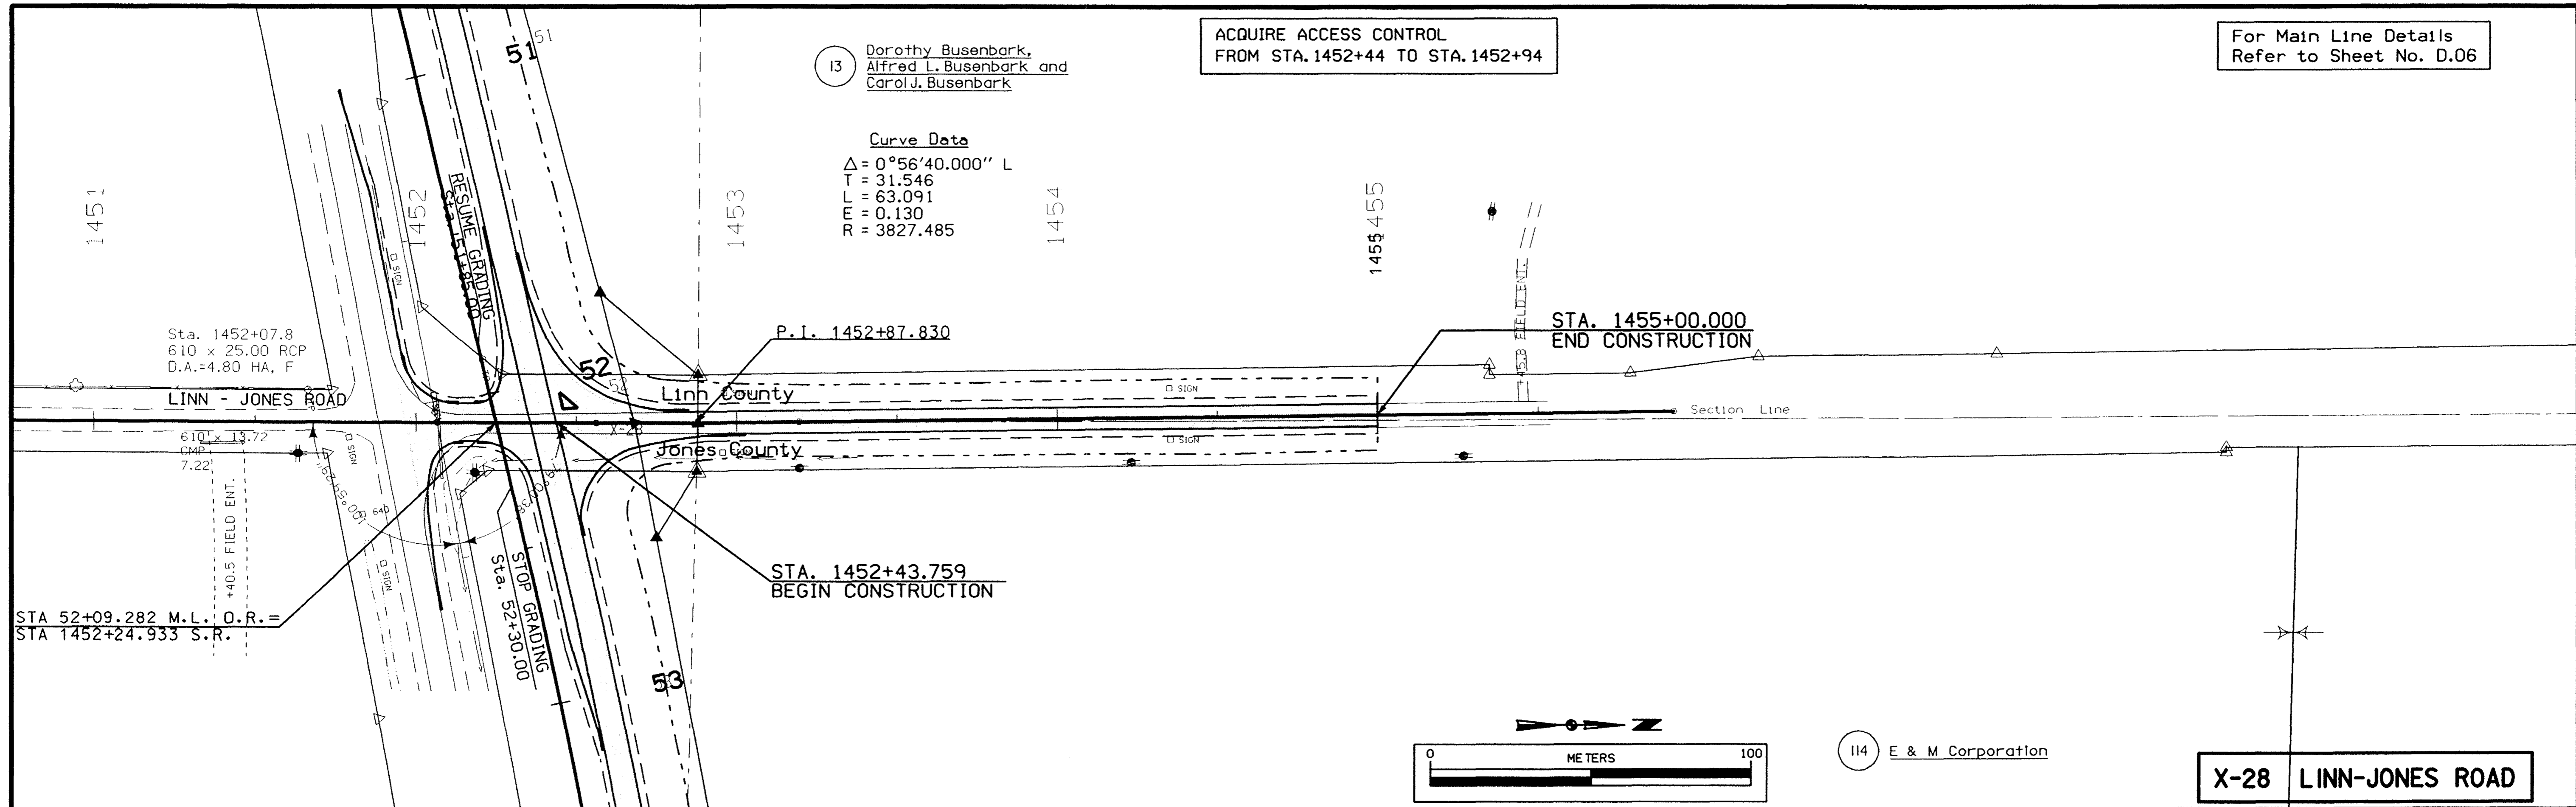

FAIRVIEW TWP.
T-84N R-4W
SECTION 21

For Main Line Details
Refer to Sheet No. D.11

Curve Data
 $\Delta = 24^\circ 52' 48.000''$ R
 T = 22.755
 L = 44.792
 E = 2.480
 R = 103.151

I26 Bernard Kula et al


I29 Doris M. Anderson et al

STA. 1786+76.225
END CONSTRUCTION

JOHN C. &
CYNTHIA S. PIEPER


STA. 86+96.988 M.L. =
STA. 1786+94.514 S.R.

Place Additional Granular Material
To Meet New Paving

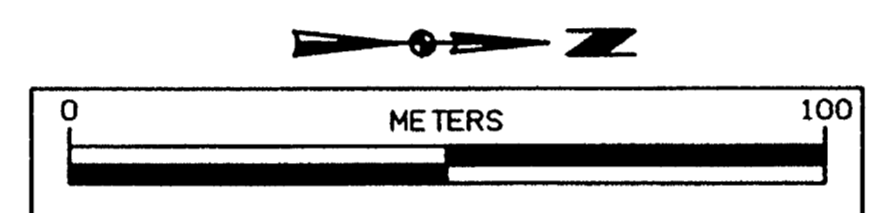



ACQUIRE ACCESS CONTROL
FROM STA. 1786+26 TO STA. 1786+76

228th. Ave.

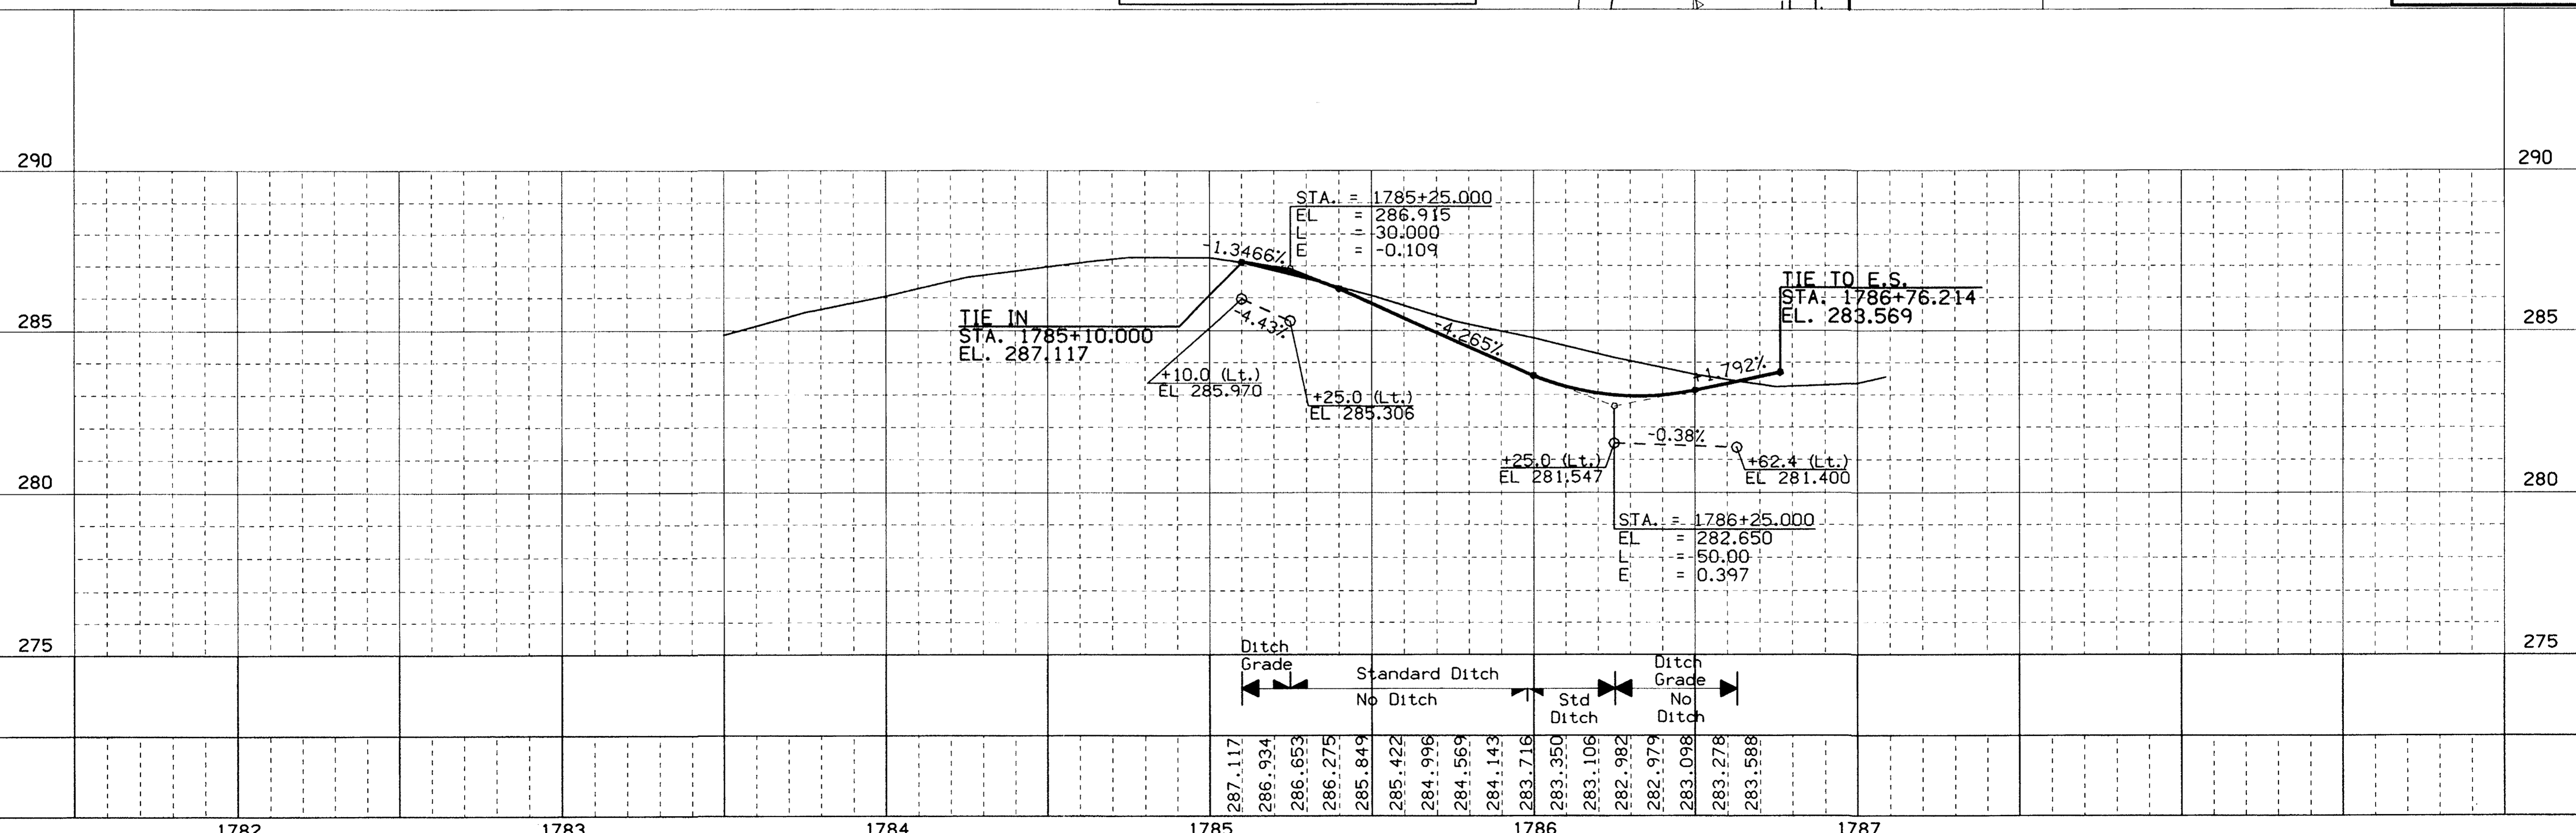

dgn = I:\WORK\project\34120\cadd\PAVE\57151112.e03
 levels = 1-59,61-63
 pen table = I:\plot\tables\half.tbl



63-198

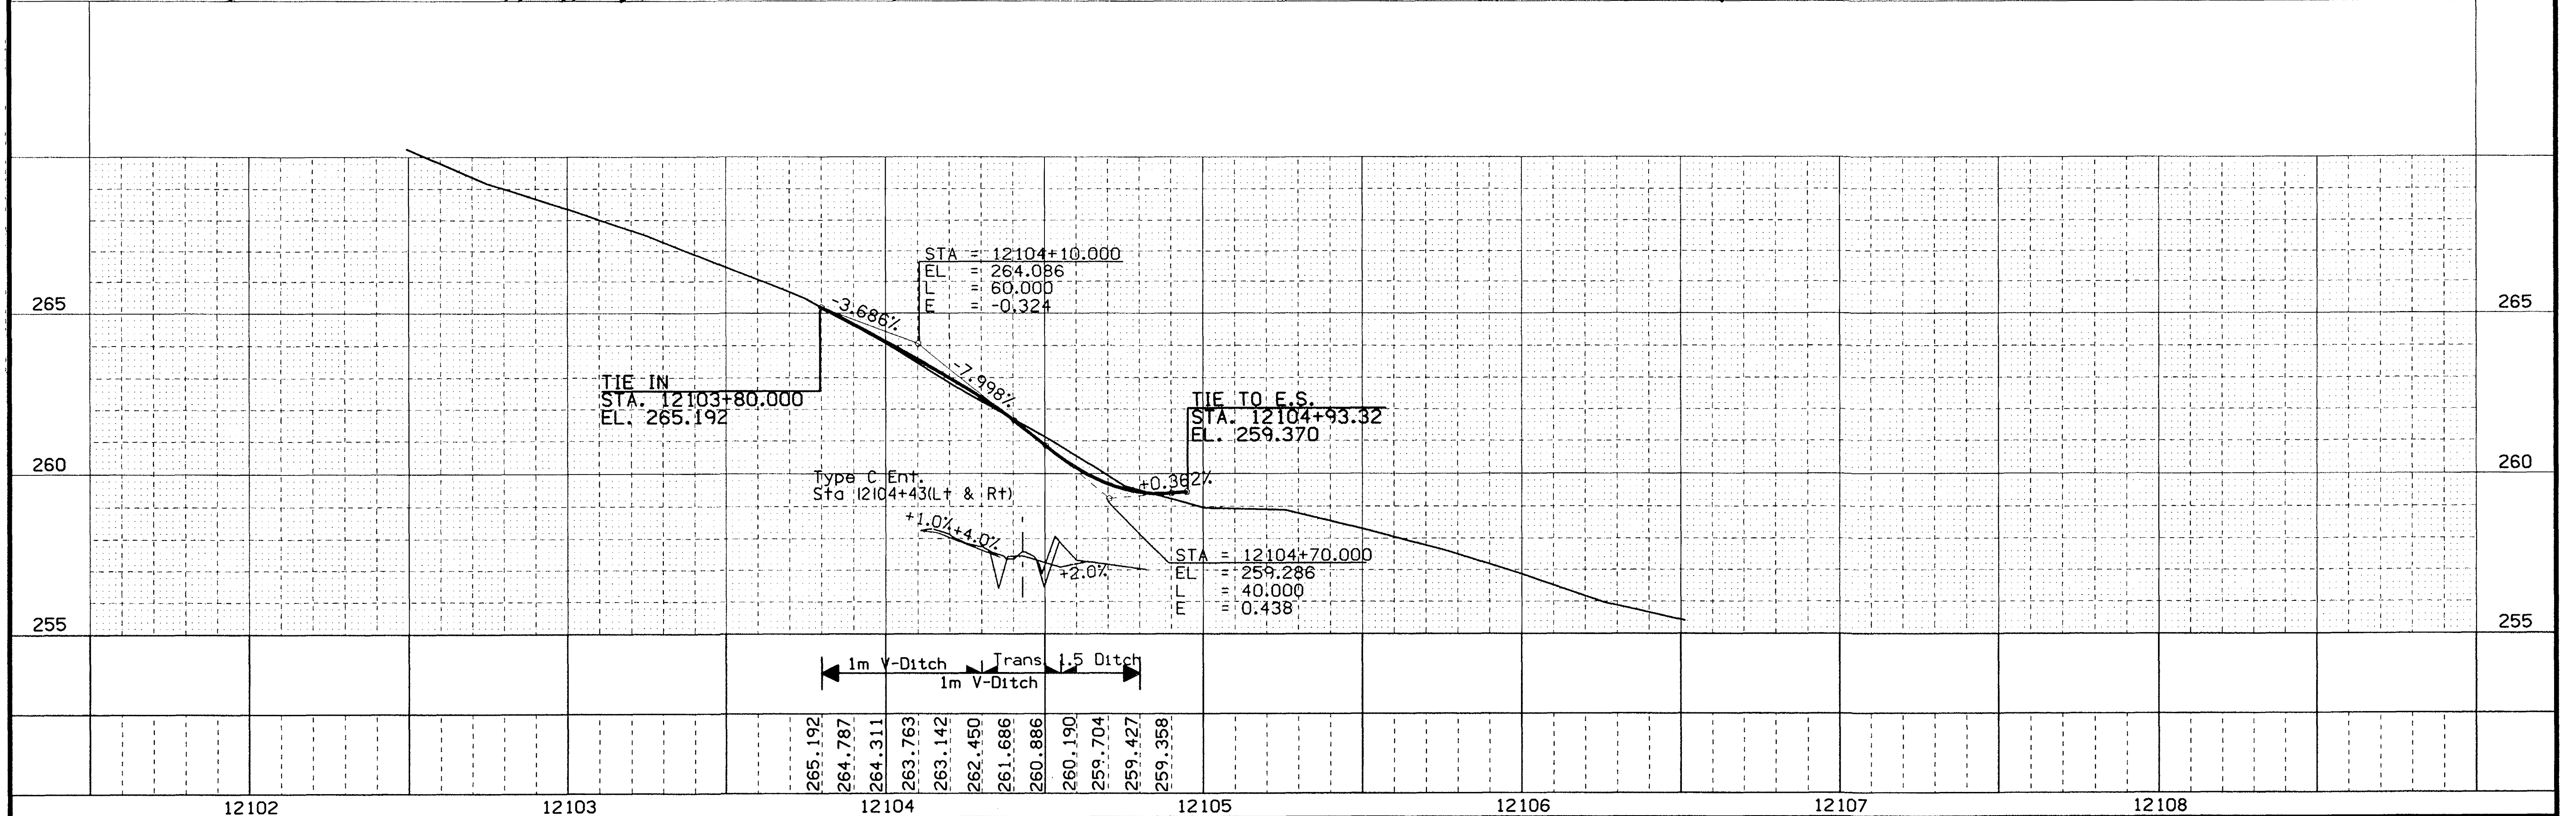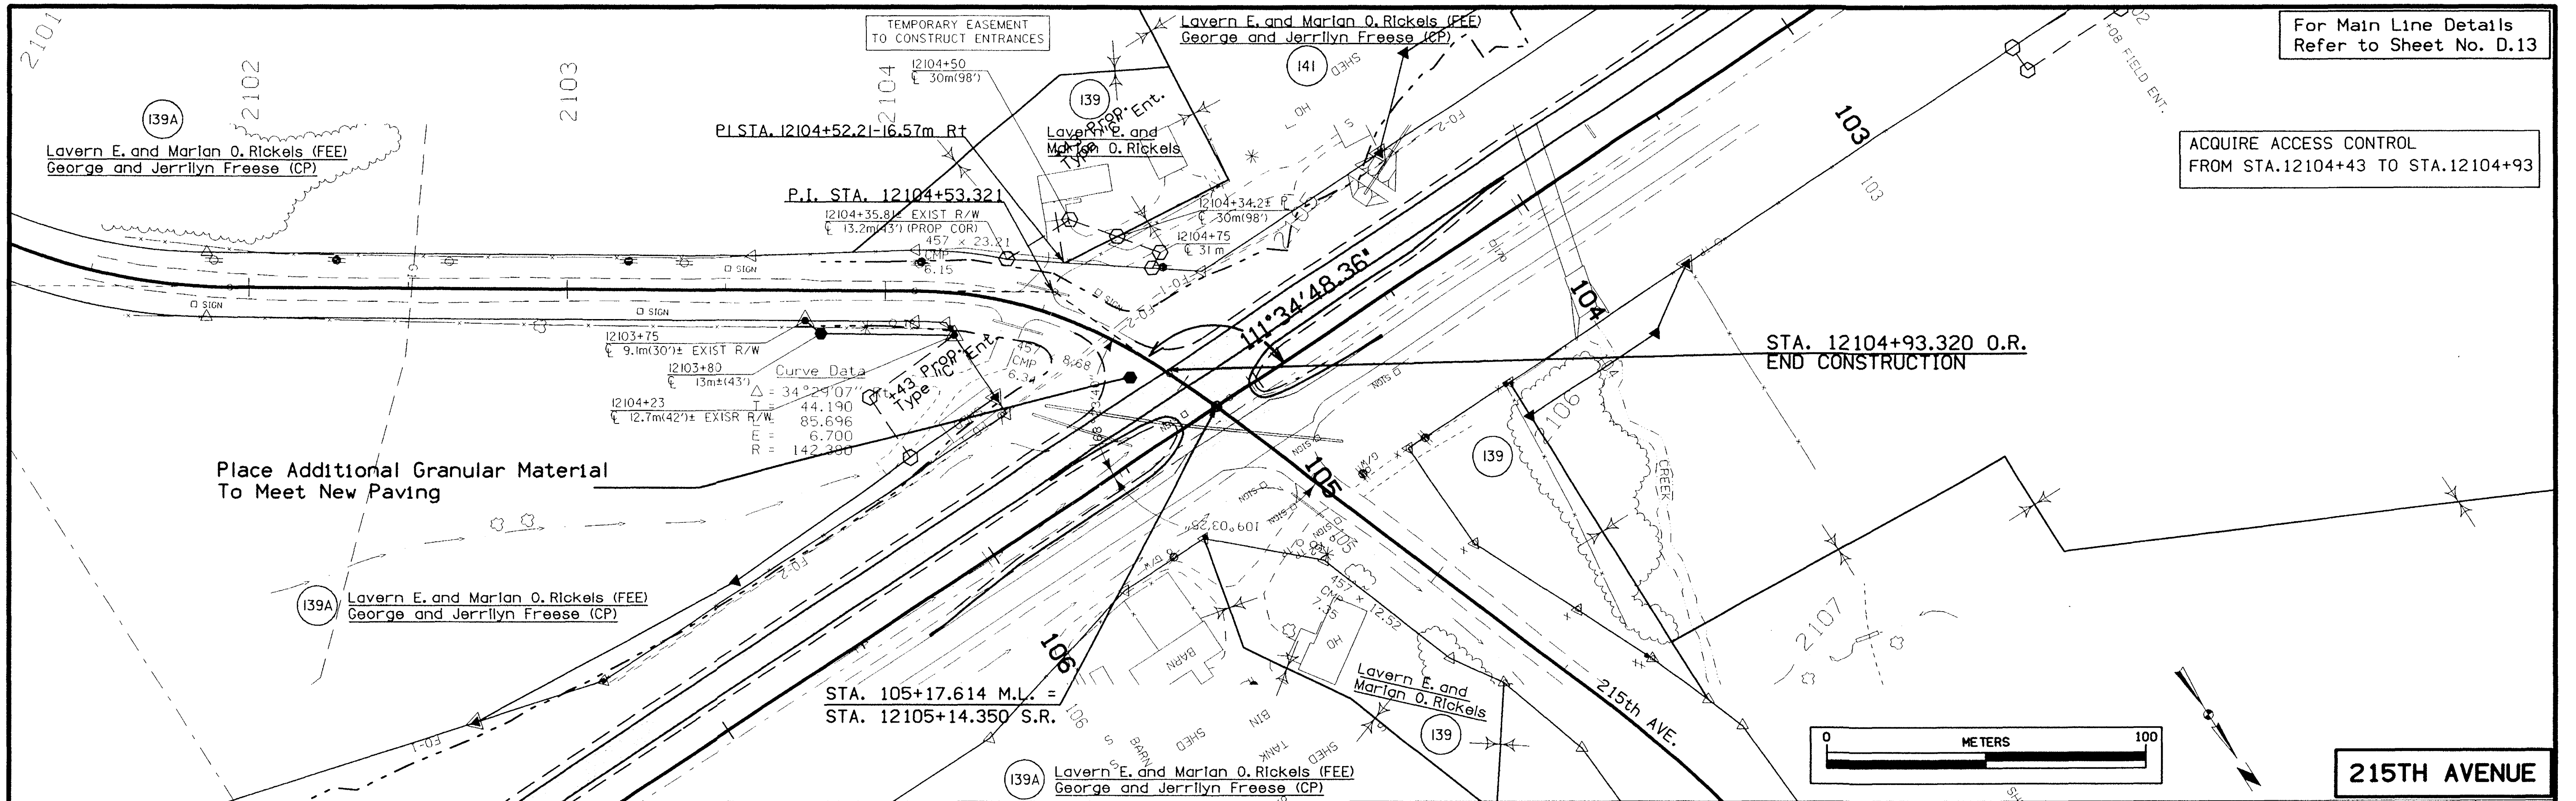

ACQUIRE ACCESS CONTROL FROM STA. 3116+63 TO STA. 3117+12


145 Mark C. Thomas

For Main Line Details Refer to Sheet No. D.15

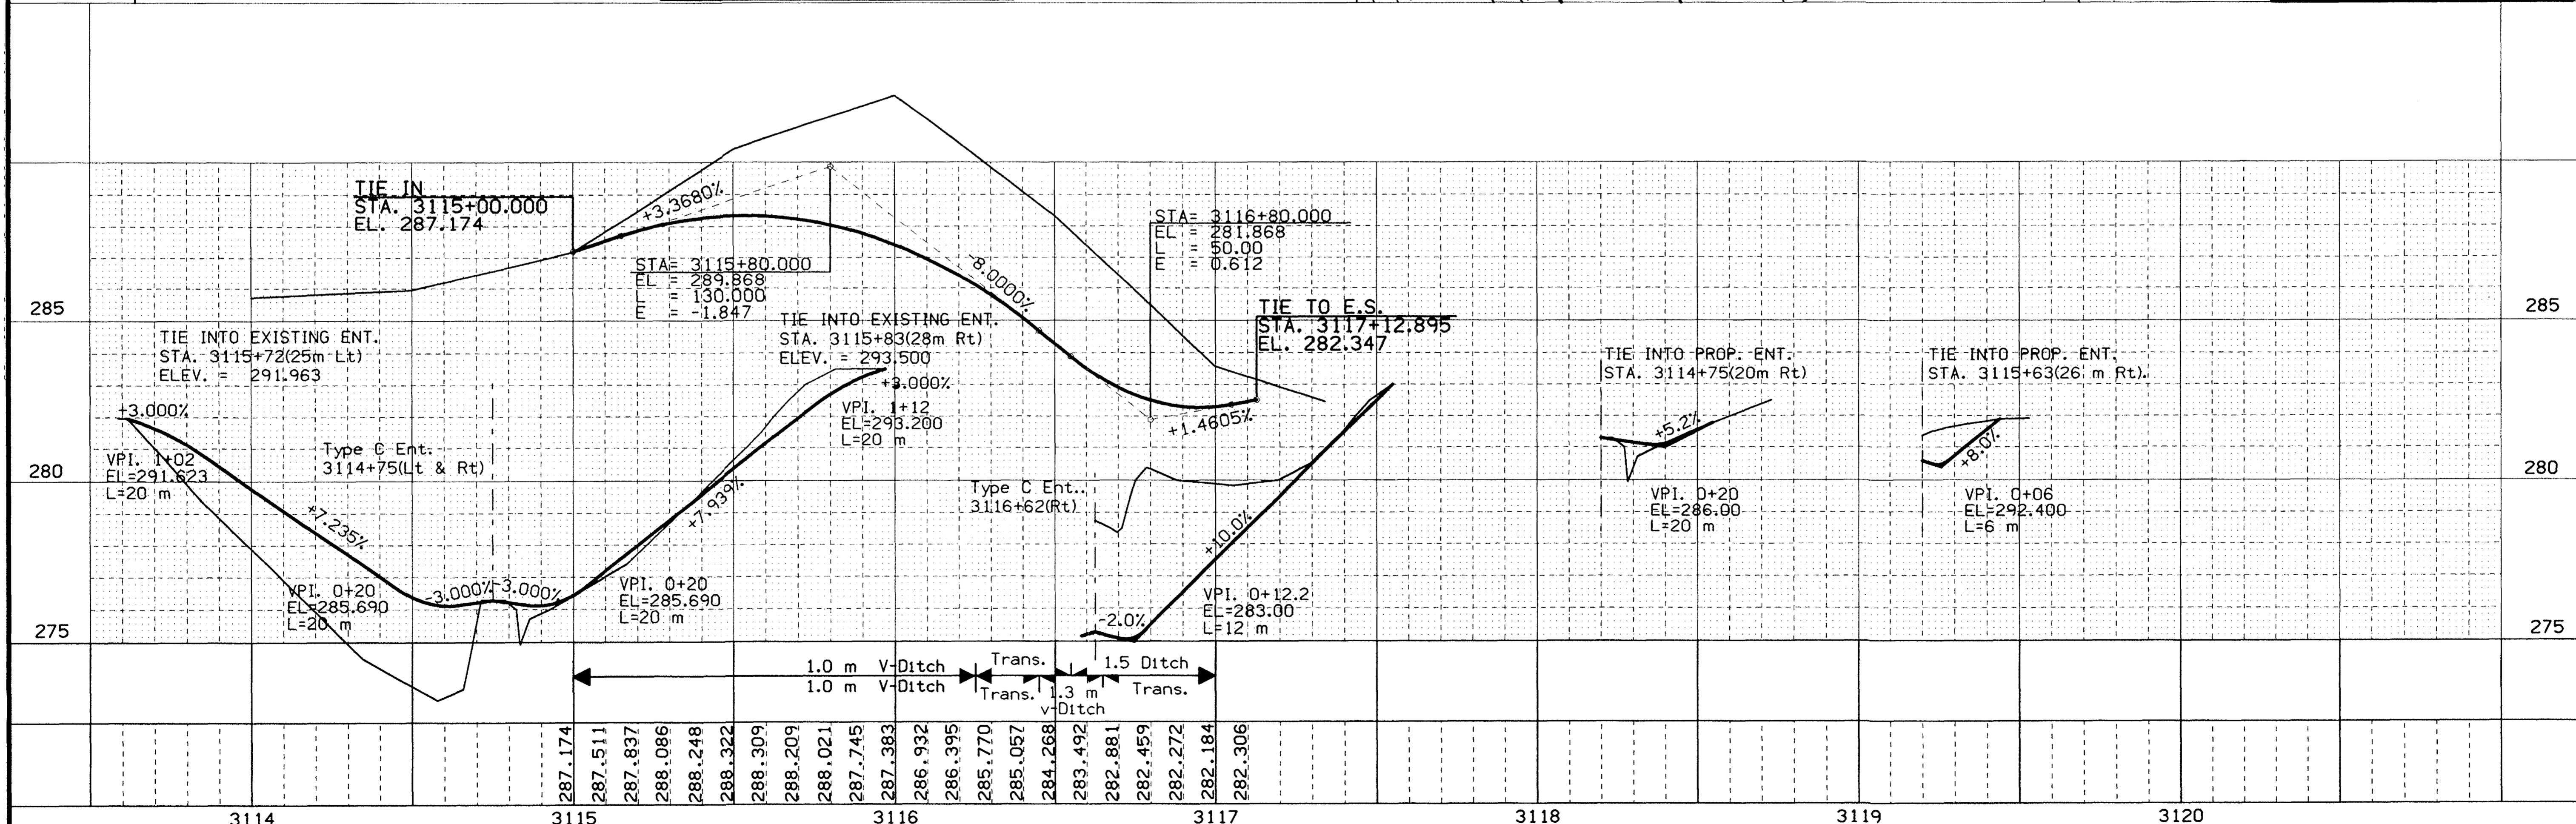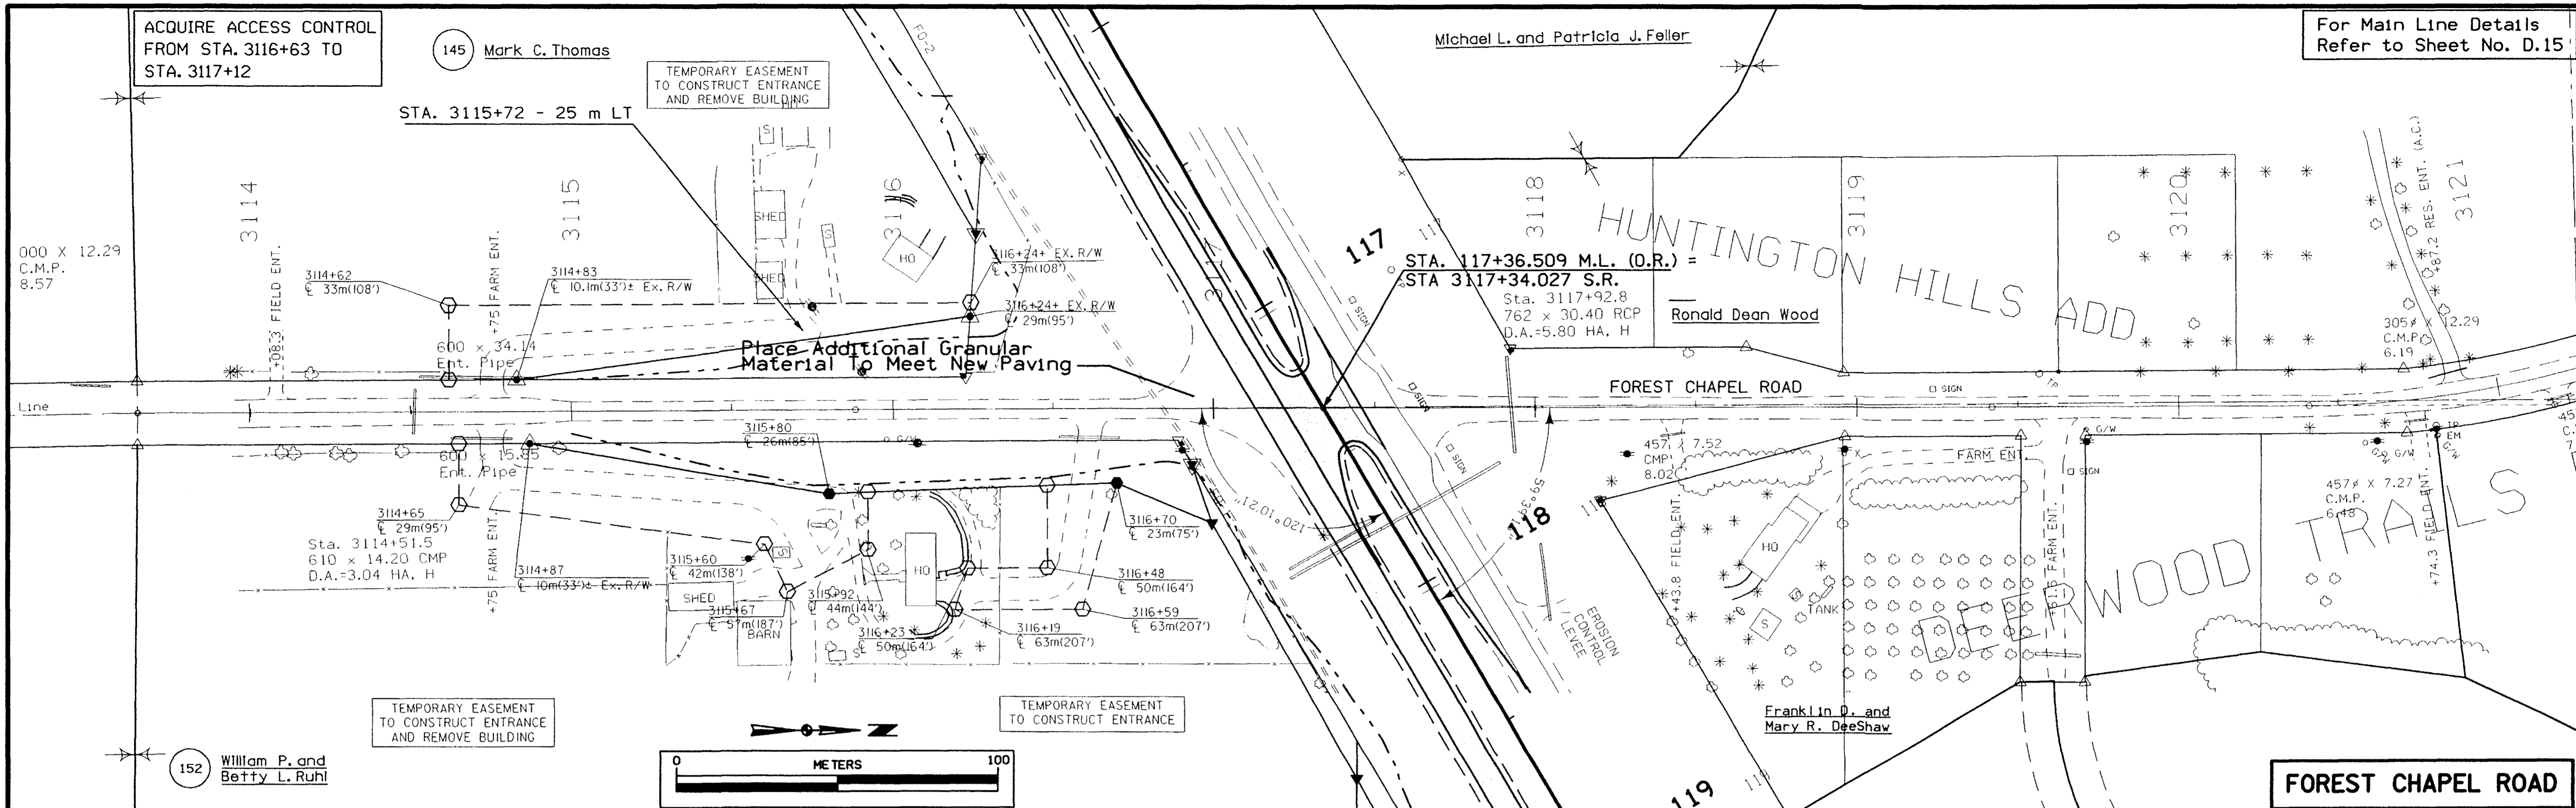

3114	3115	3116	3117	3118	3119	3120
------	------	------	------	------	------	------


For Main Line Details
Refer to Sheet No. D.17

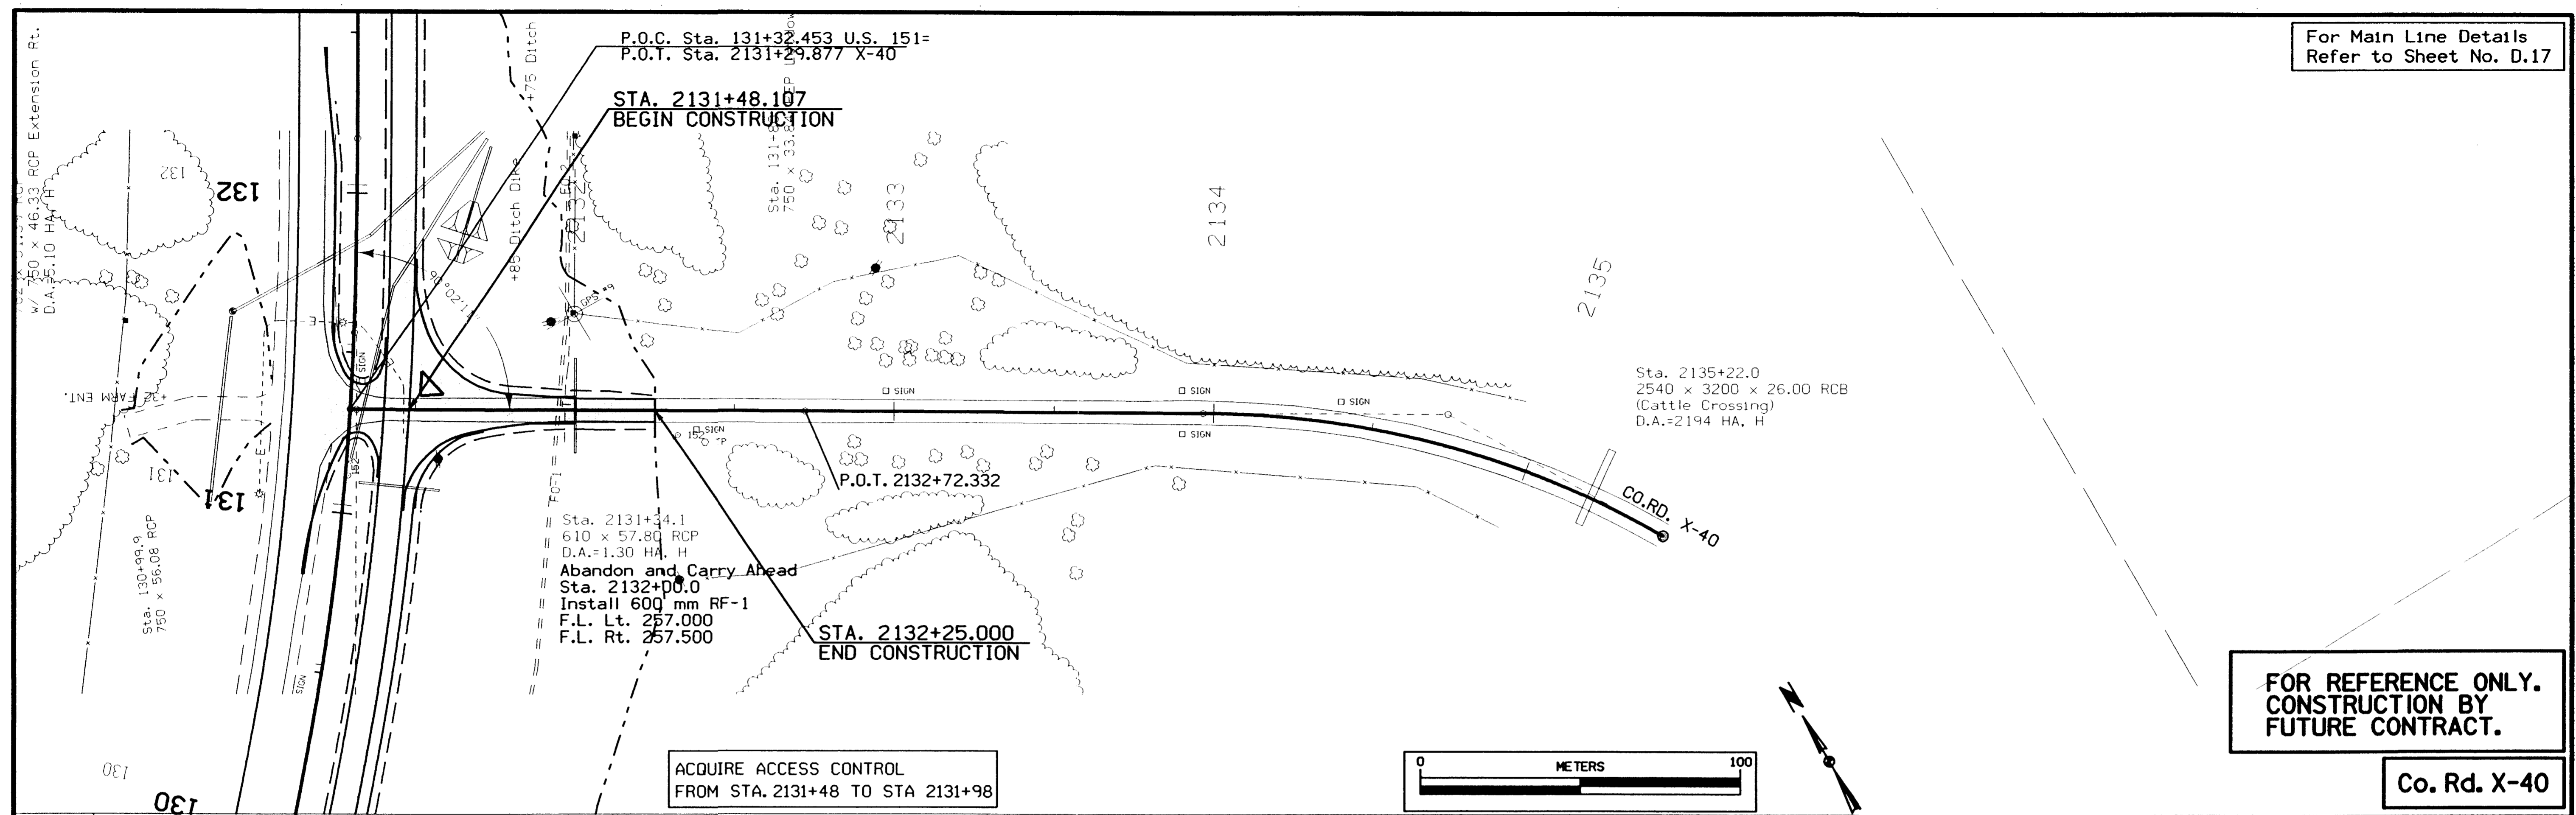



FOR REFERENCE ONLY.
CONSTRUCTION BY
FUTURE CONTRACT.

Co. Rd. X-40

Grading Completed By Previous Project.
Paving Is To Be Completed By This Project.

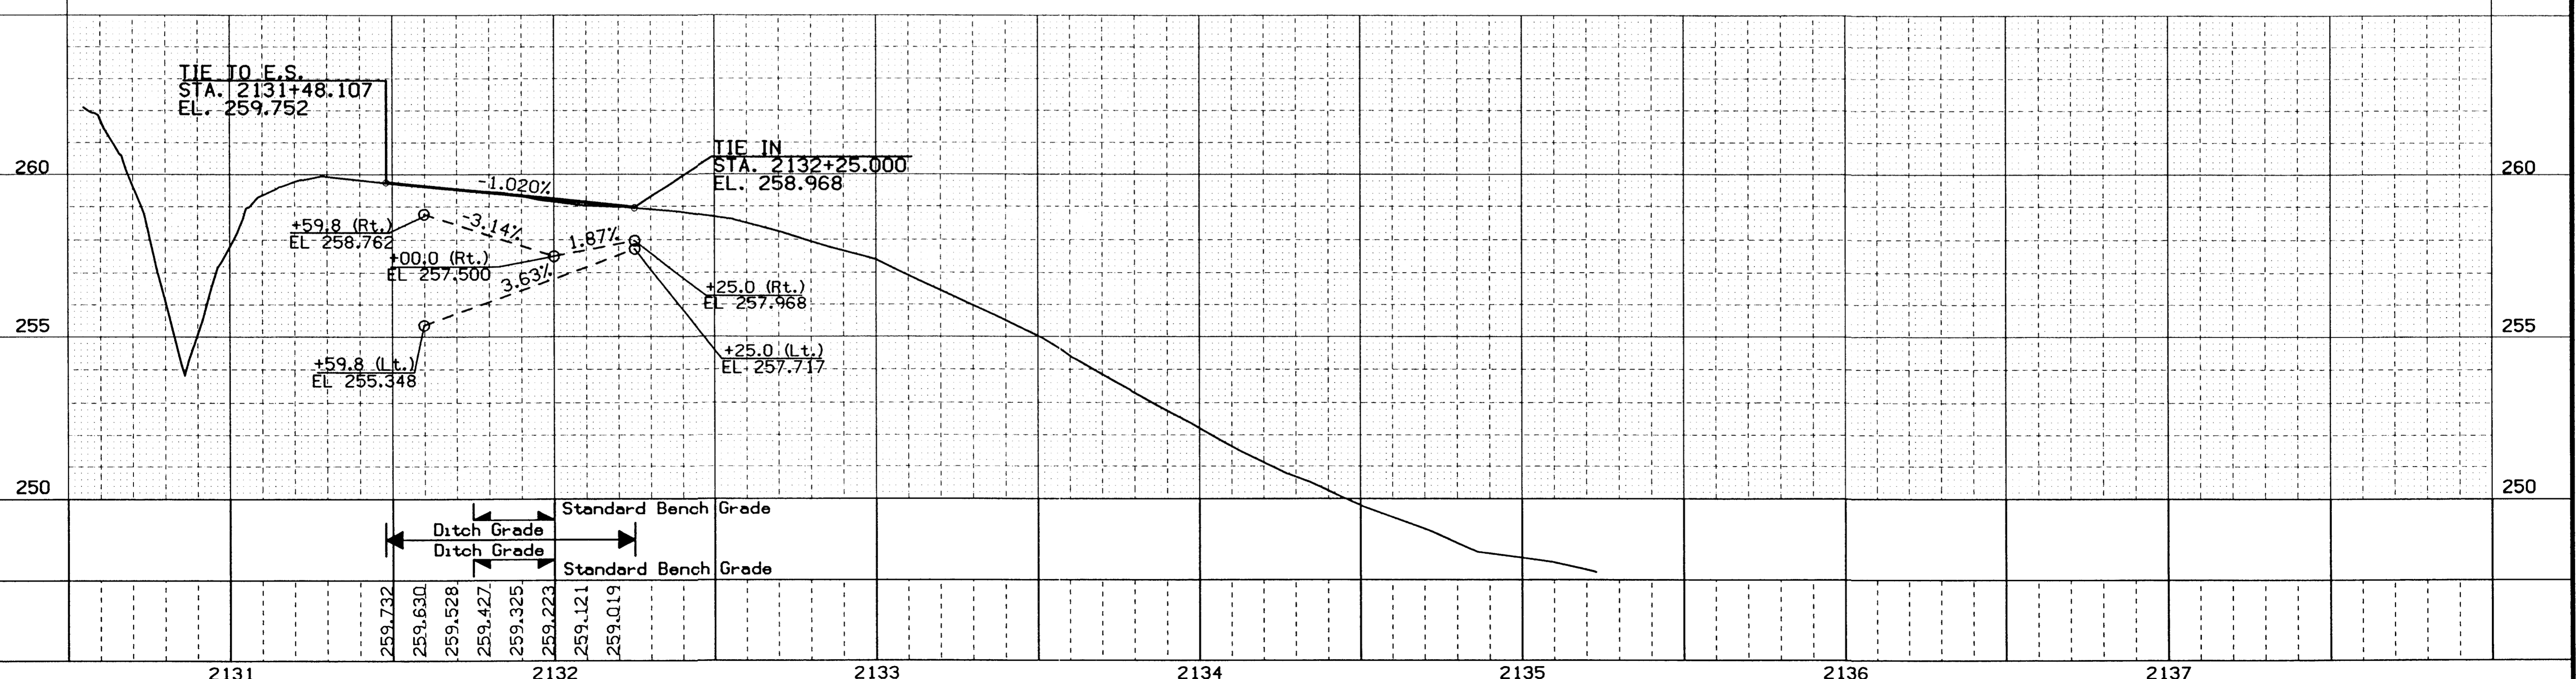


dgn = L:\WORK\PROJECT\39922\cadd\40turn\40e06.dgn
 levels = 1-4,7,8,62
 pff = \\WA1501\DATA\PLT\COPYLER\40e06.prf
 date = Mon Apr 29 13:45:53 2002
 pen table = L:\p\gt\tables\halfwt.tbl

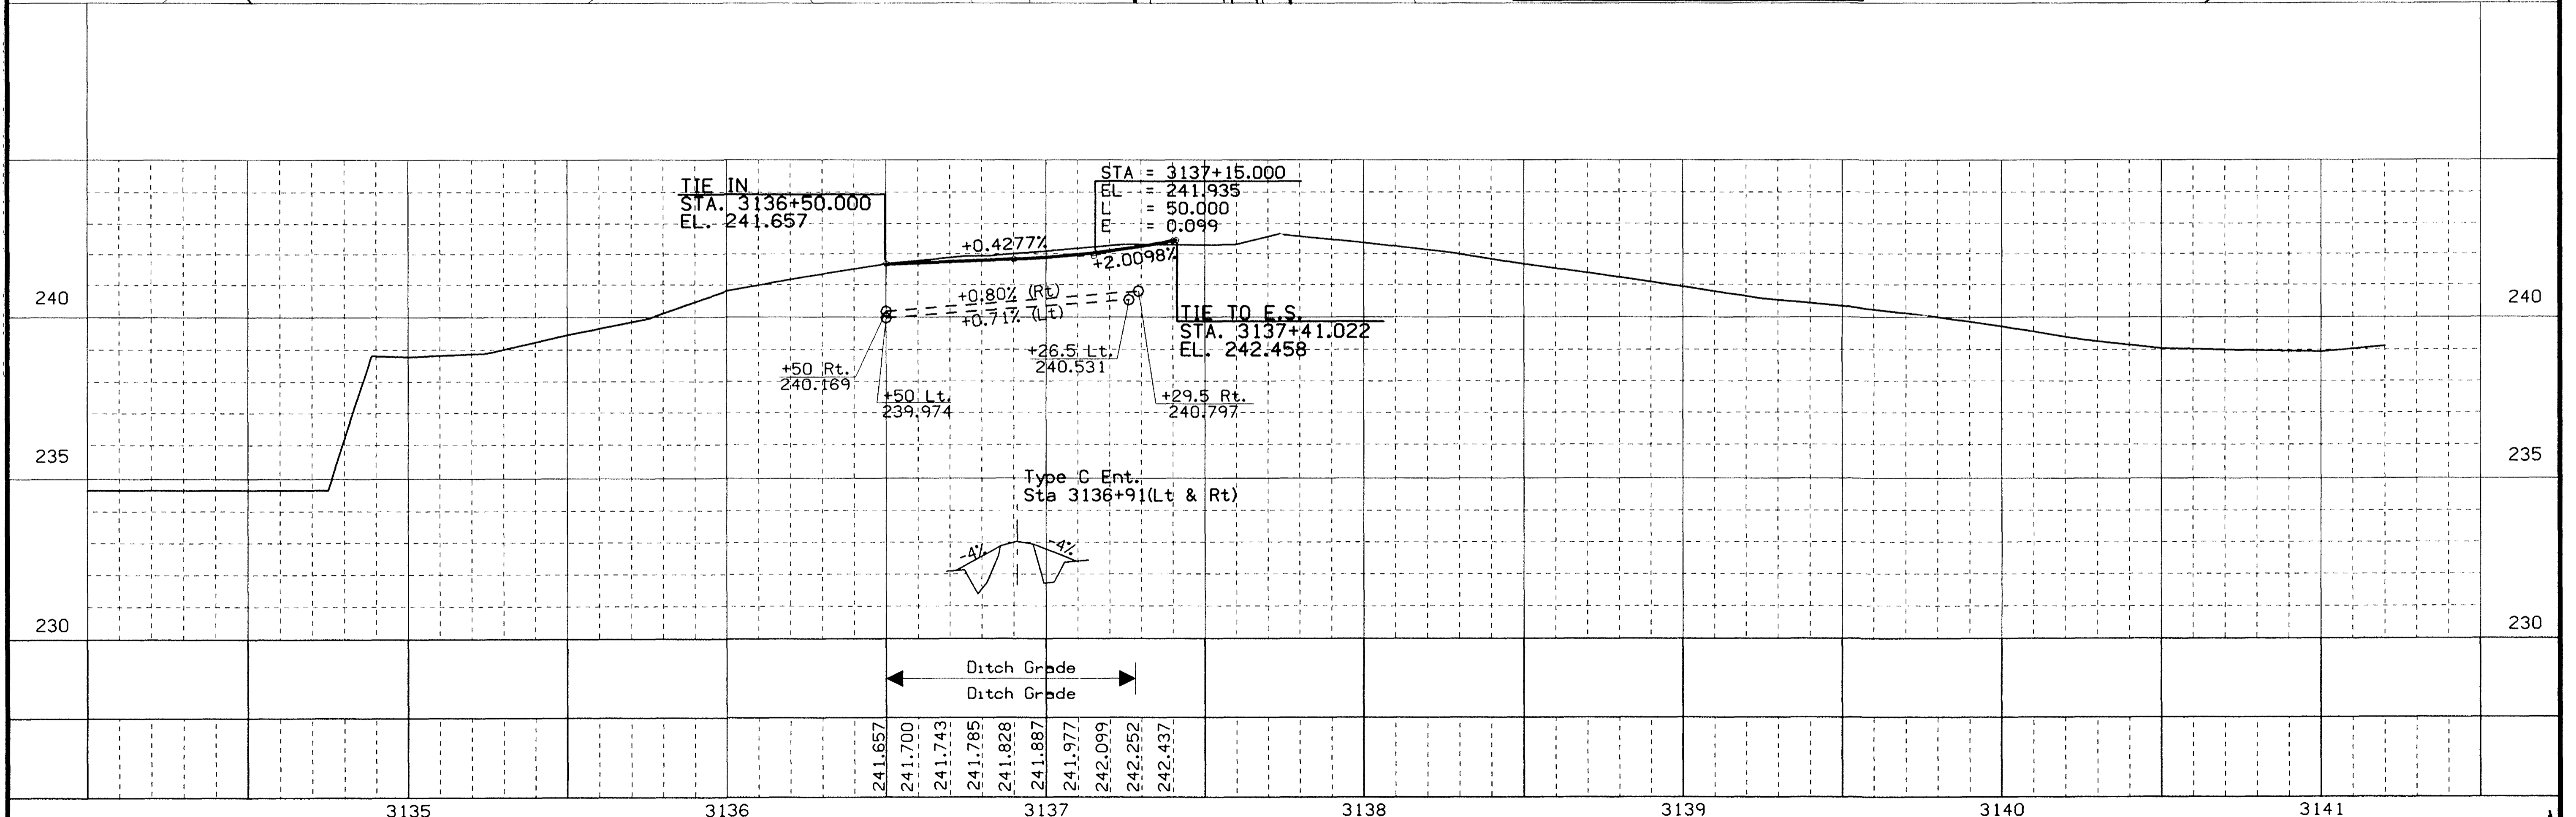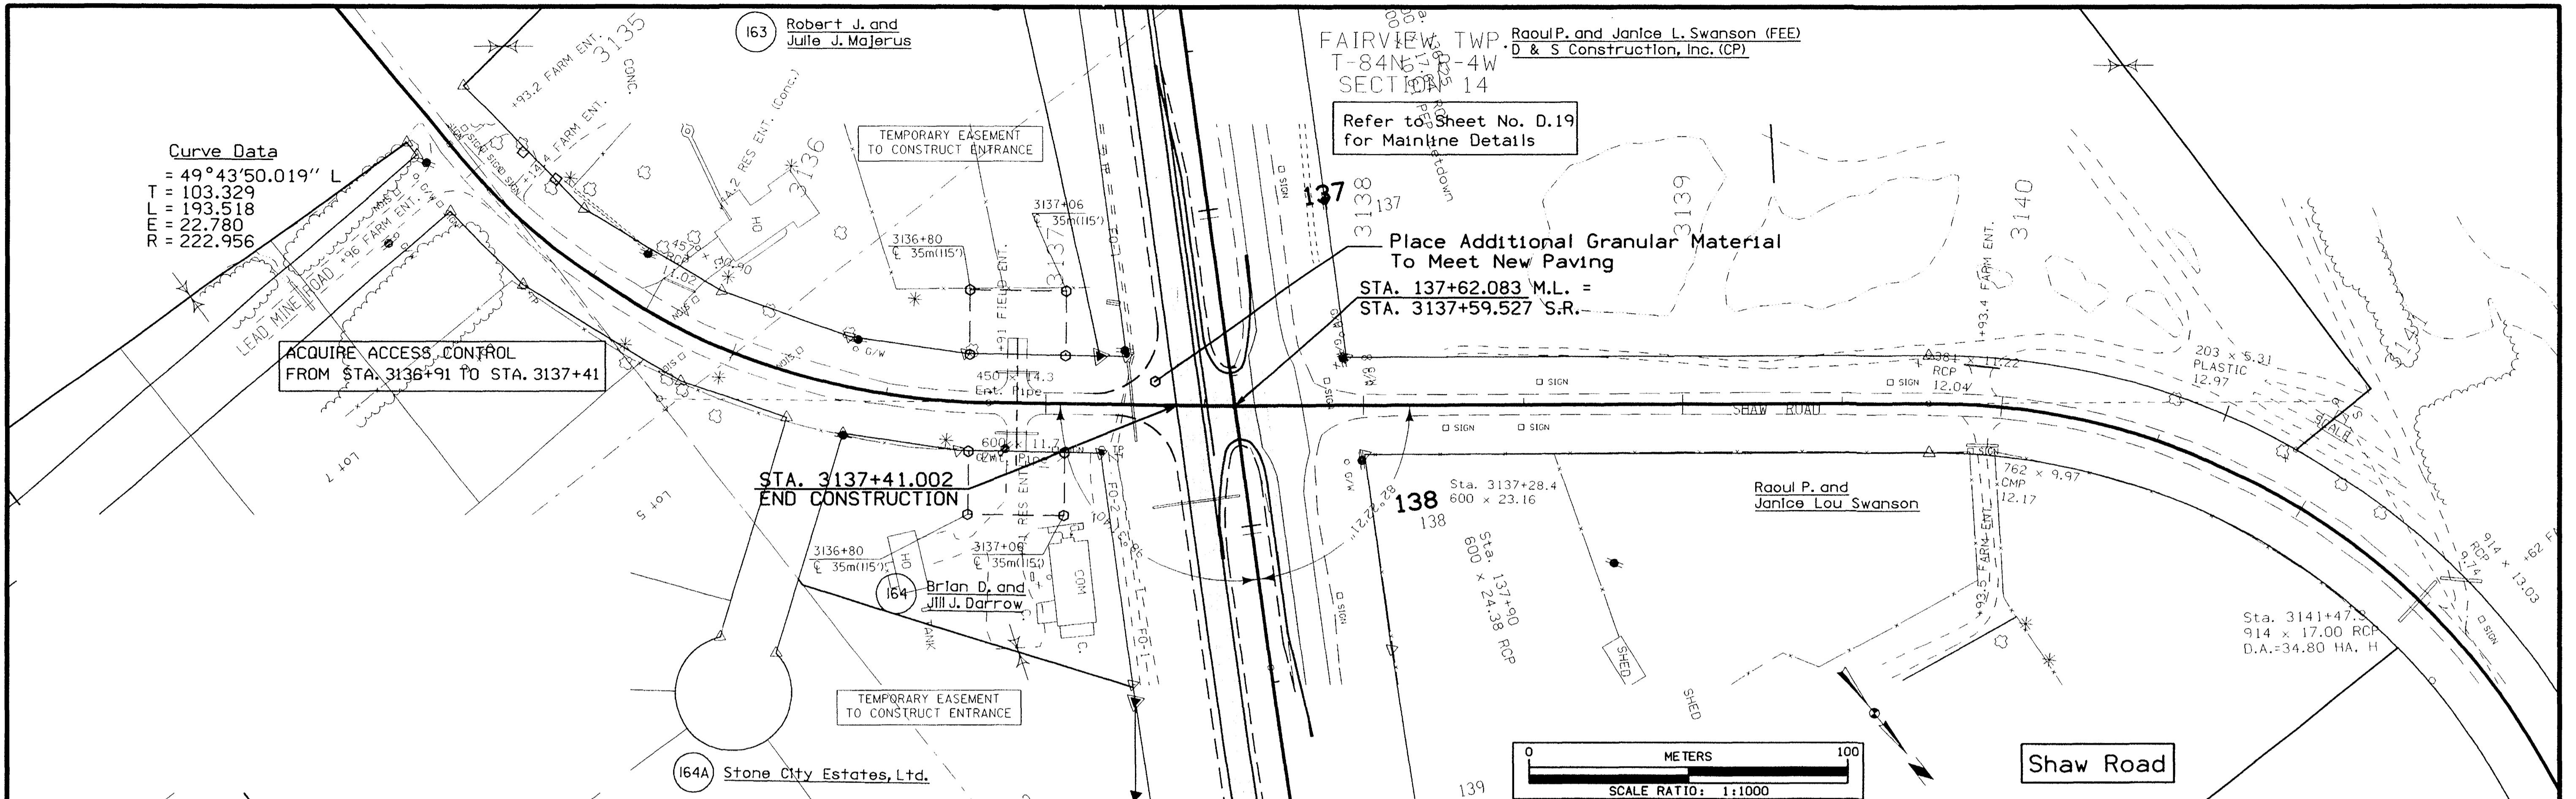


206 D. A. Downing and C. R. McNamara
dba MACDON, a partnership

205 Lloyd A. Brickley



FAIRVIEW TWP.
T-84N R-4W
SECTION 1

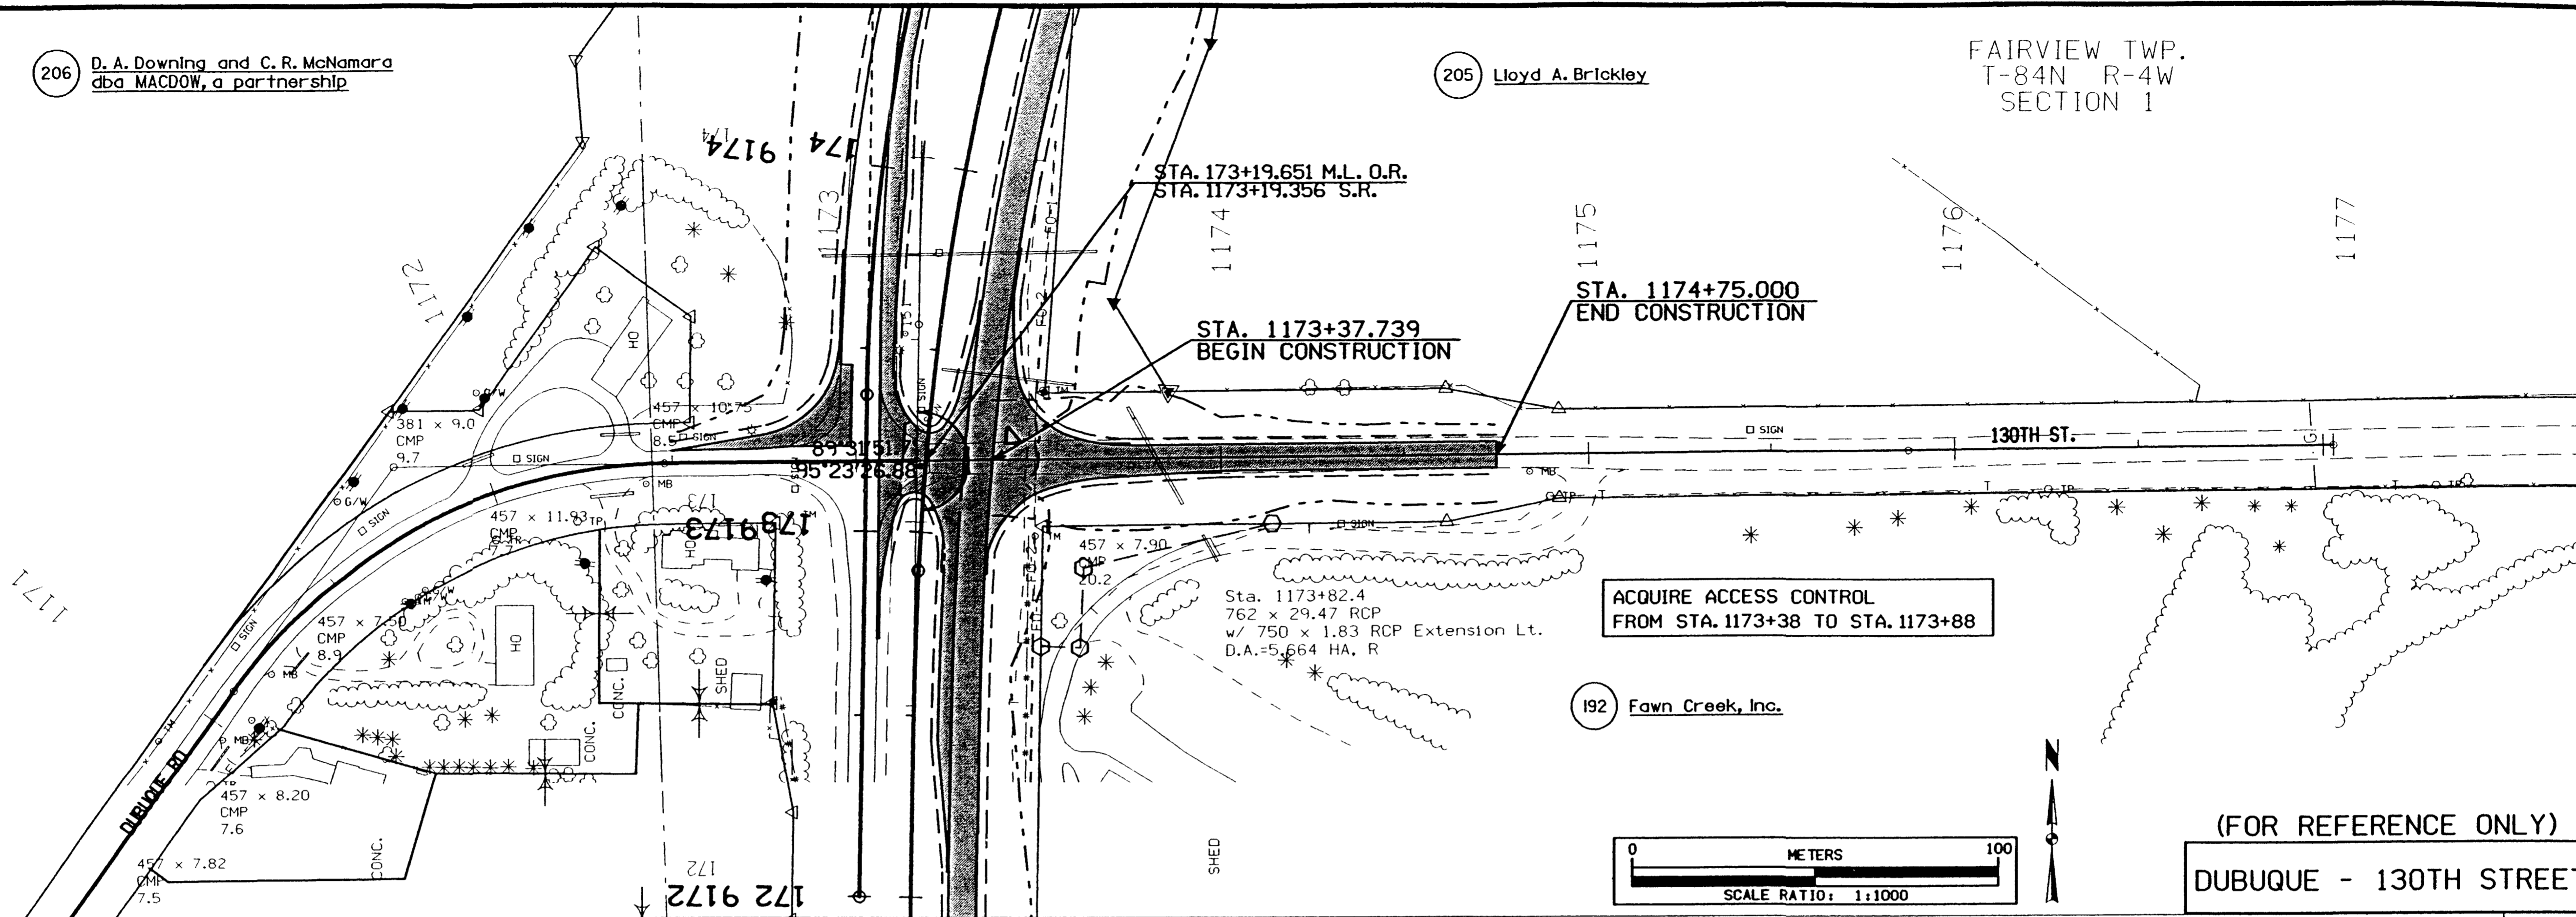



Stage I
Cut=913
Borrow=875
1,788
F+30%=1,788


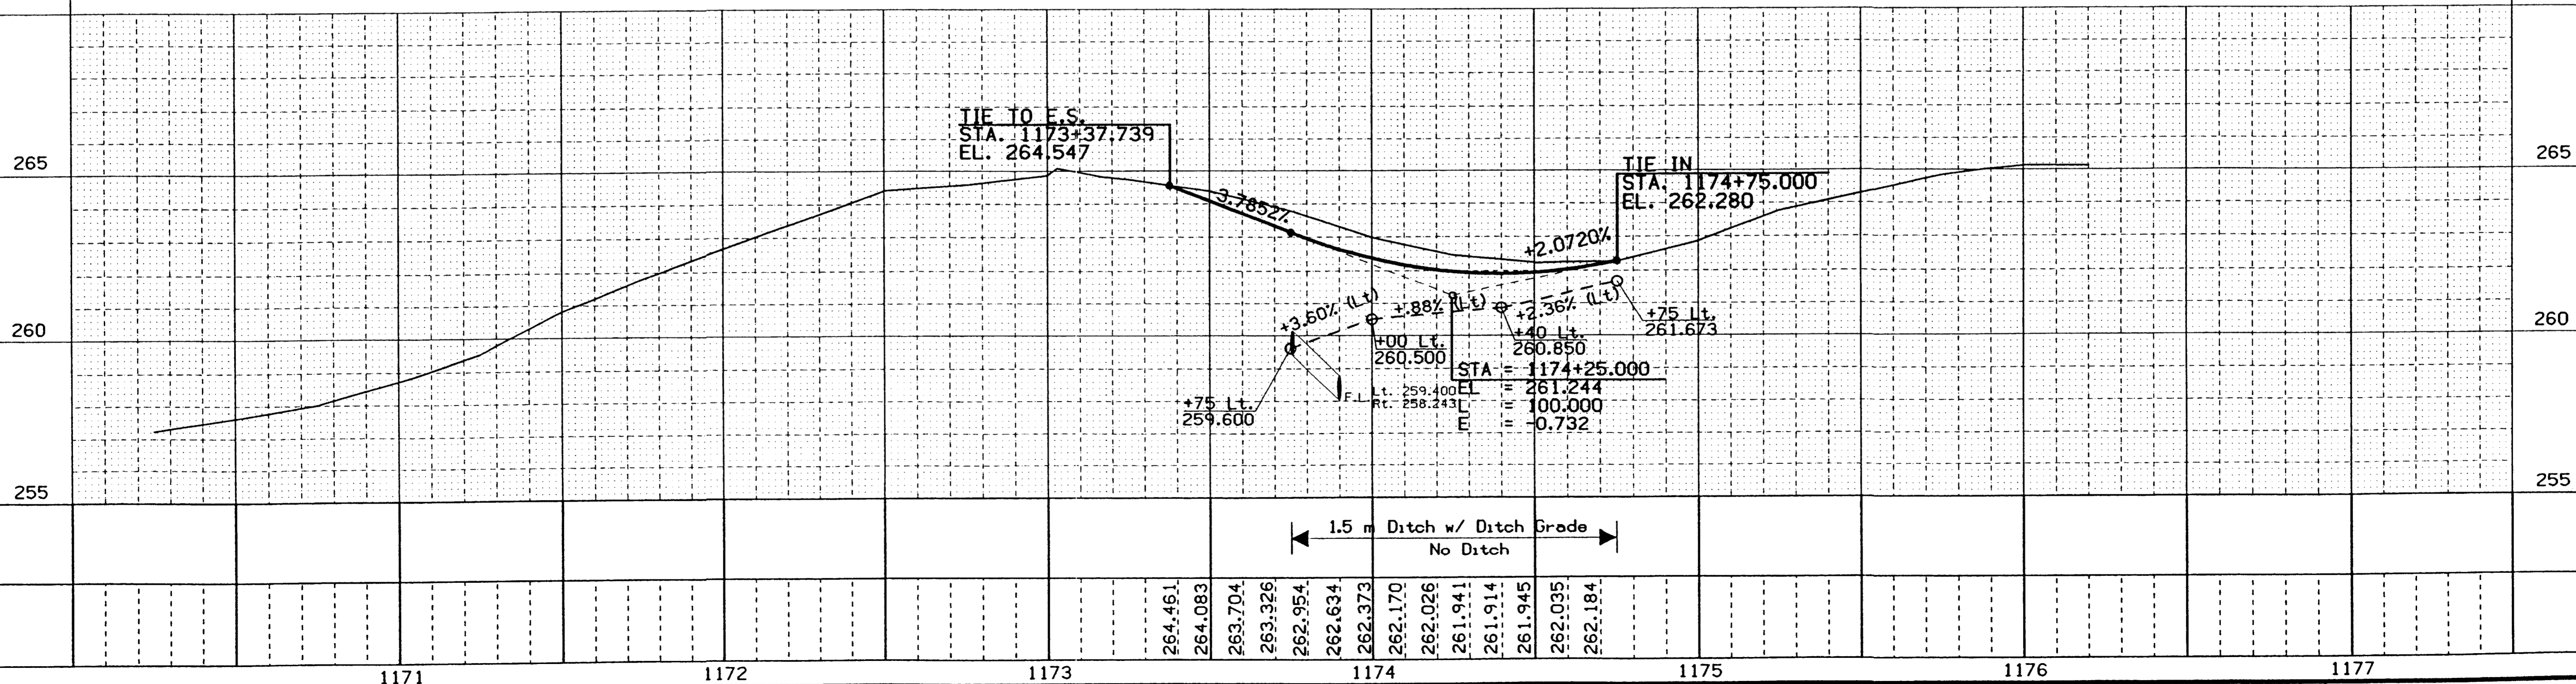



dgn = I:\WORK\project\39922\cadd\anacurve\PAVE\57151112.e08
 levels = 1-4,7,8
 pen table = I:\plot\tables\half.tbl

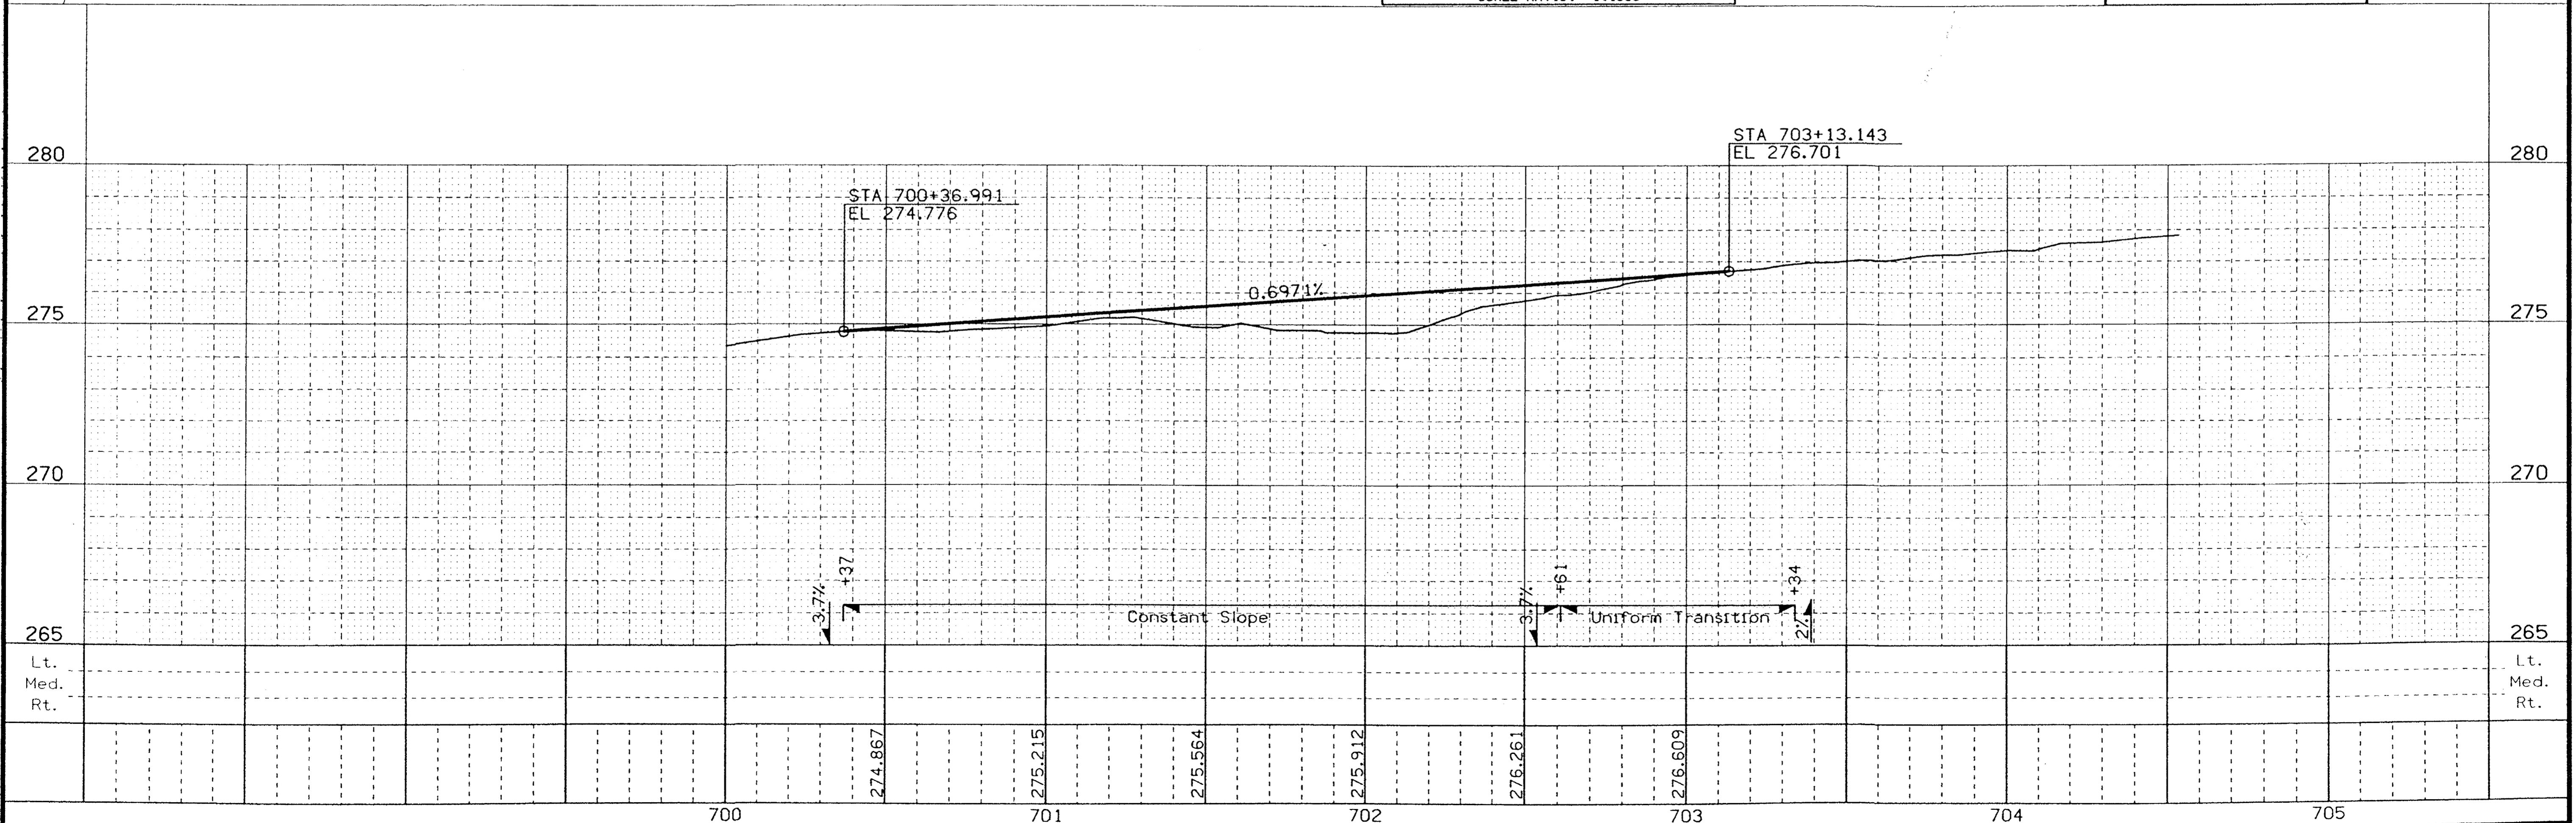
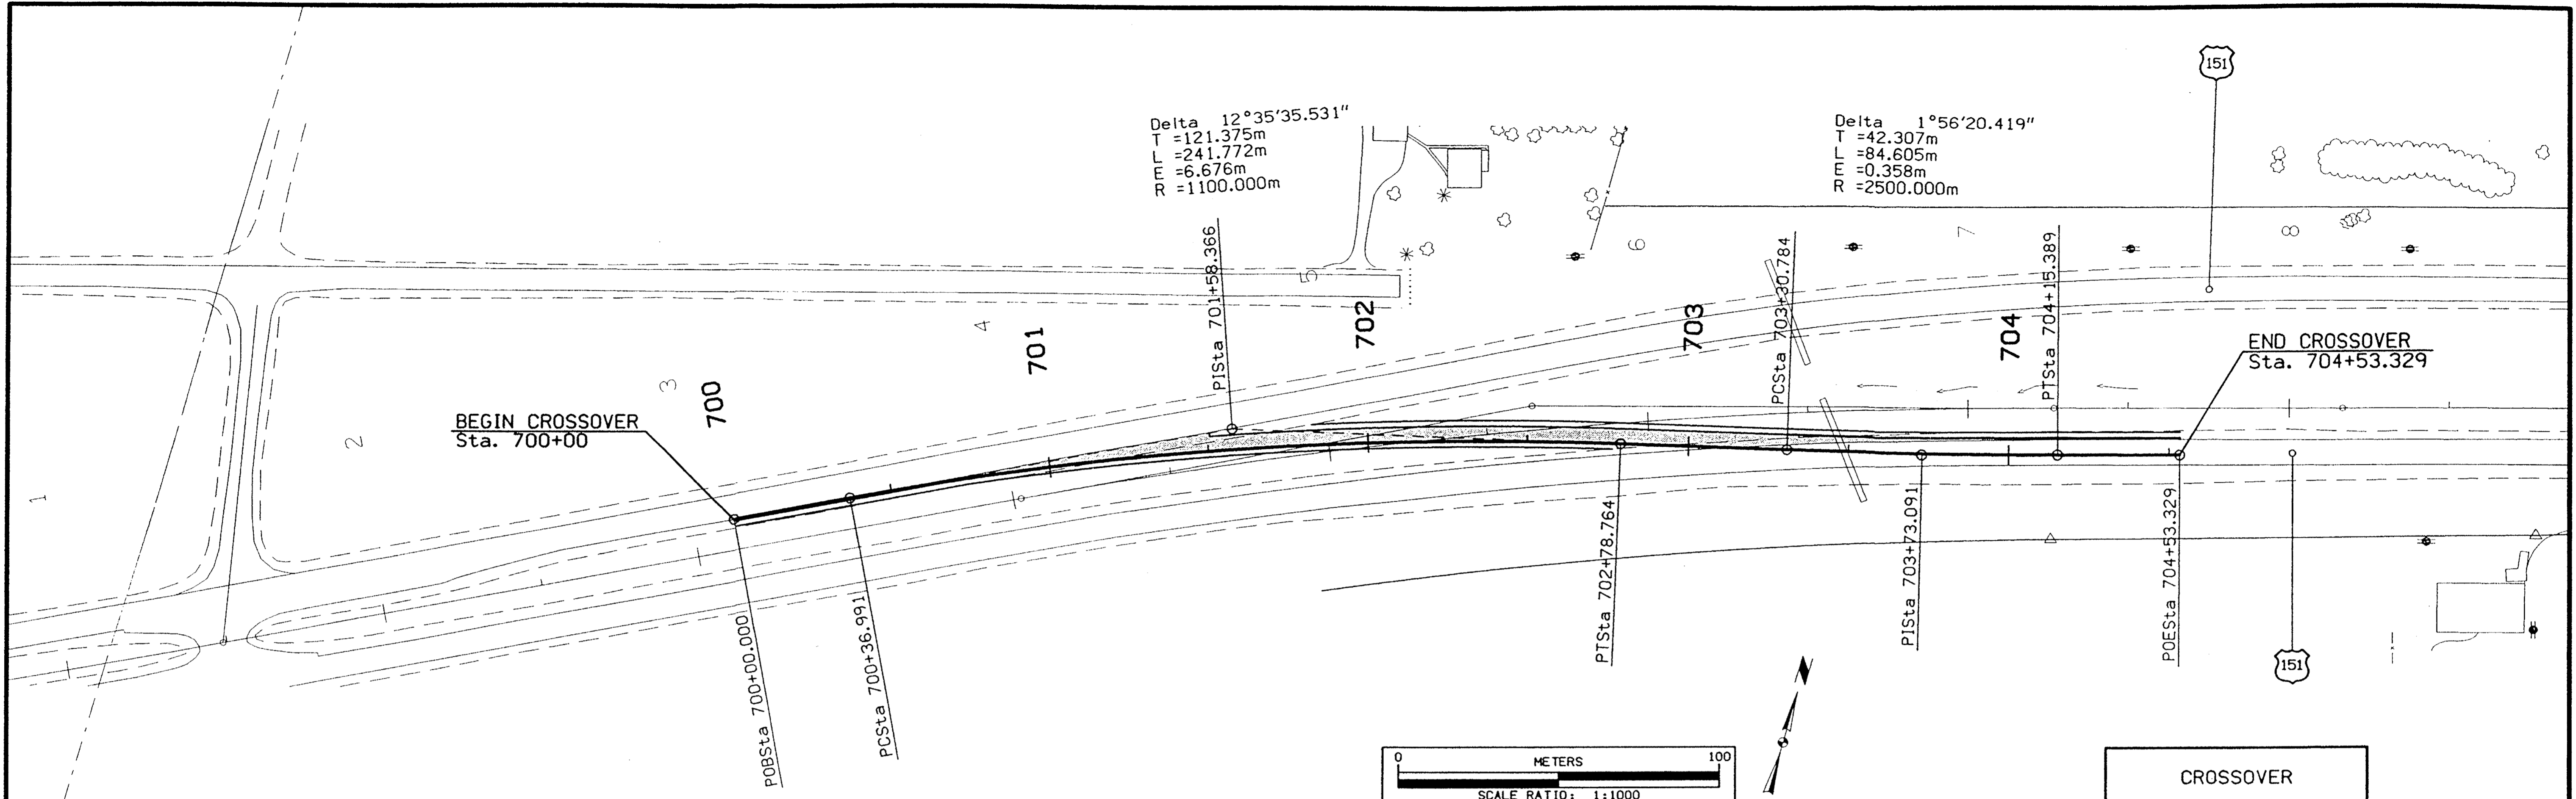


DESIGN TEAM	Skogerboe /	METRIC	IOWA DOT * OFFICE OF ROAD DESIGN	Jones	COUNTY	PROJECT NUMBER	NHSX-151-3(112)--3H-57	SHEET NUMBER	F.01
-------------	-------------	--------	----------------------------------	-------	--------	----------------	------------------------	--------------	------


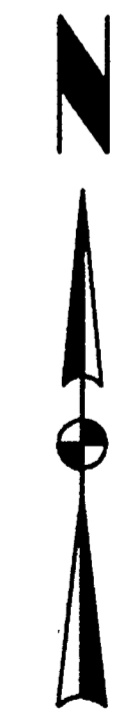
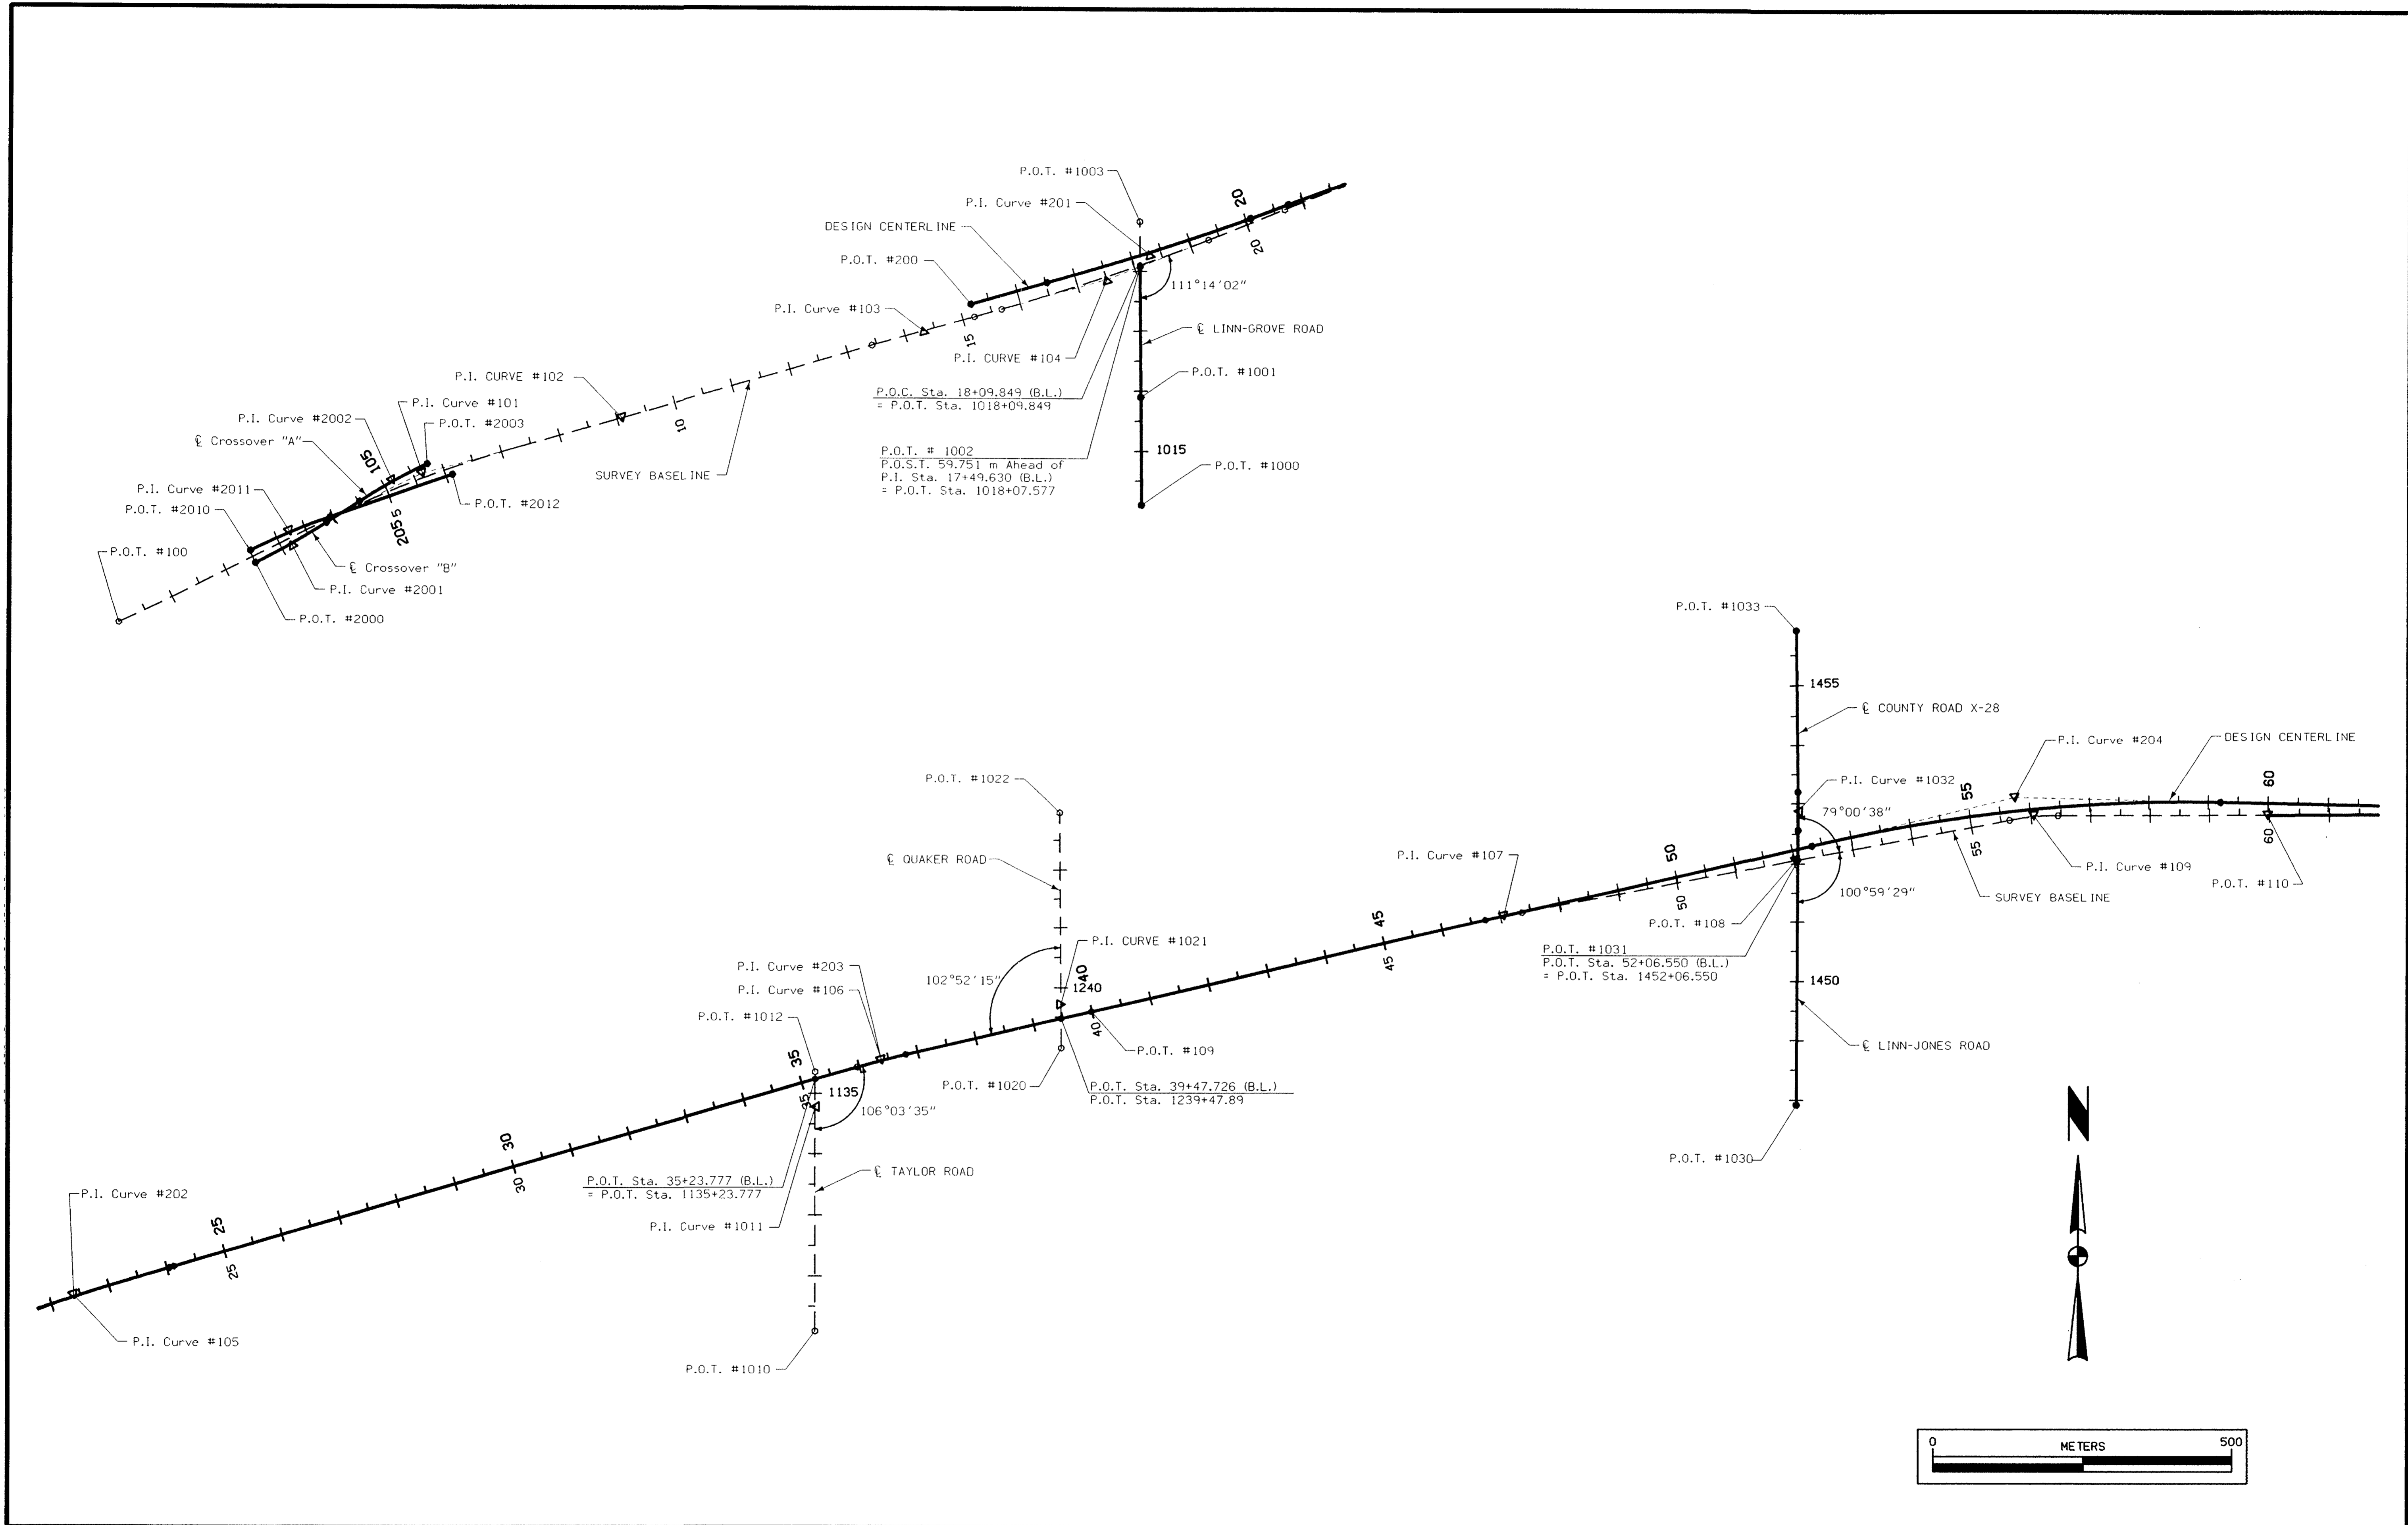


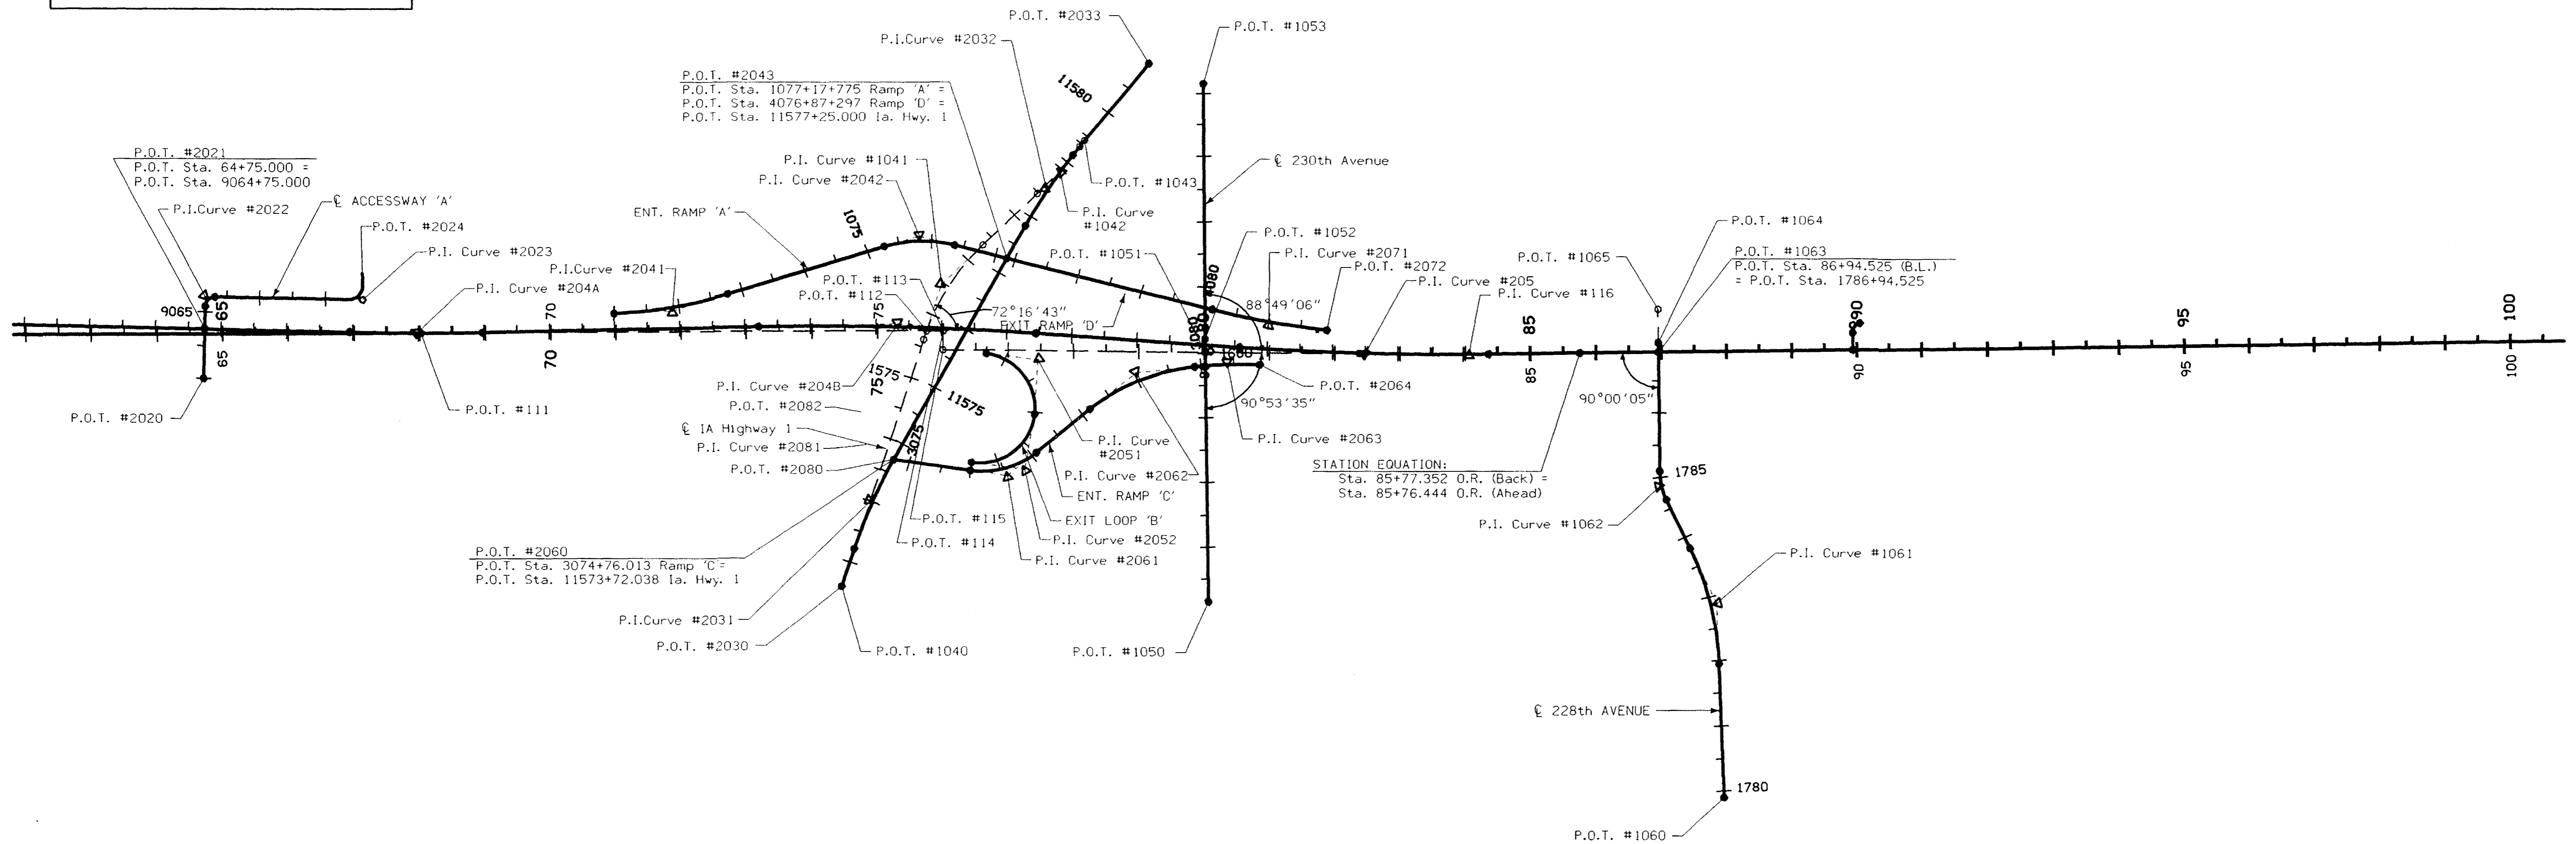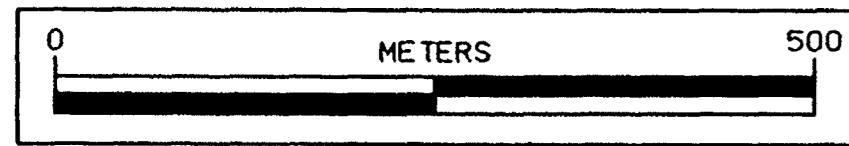

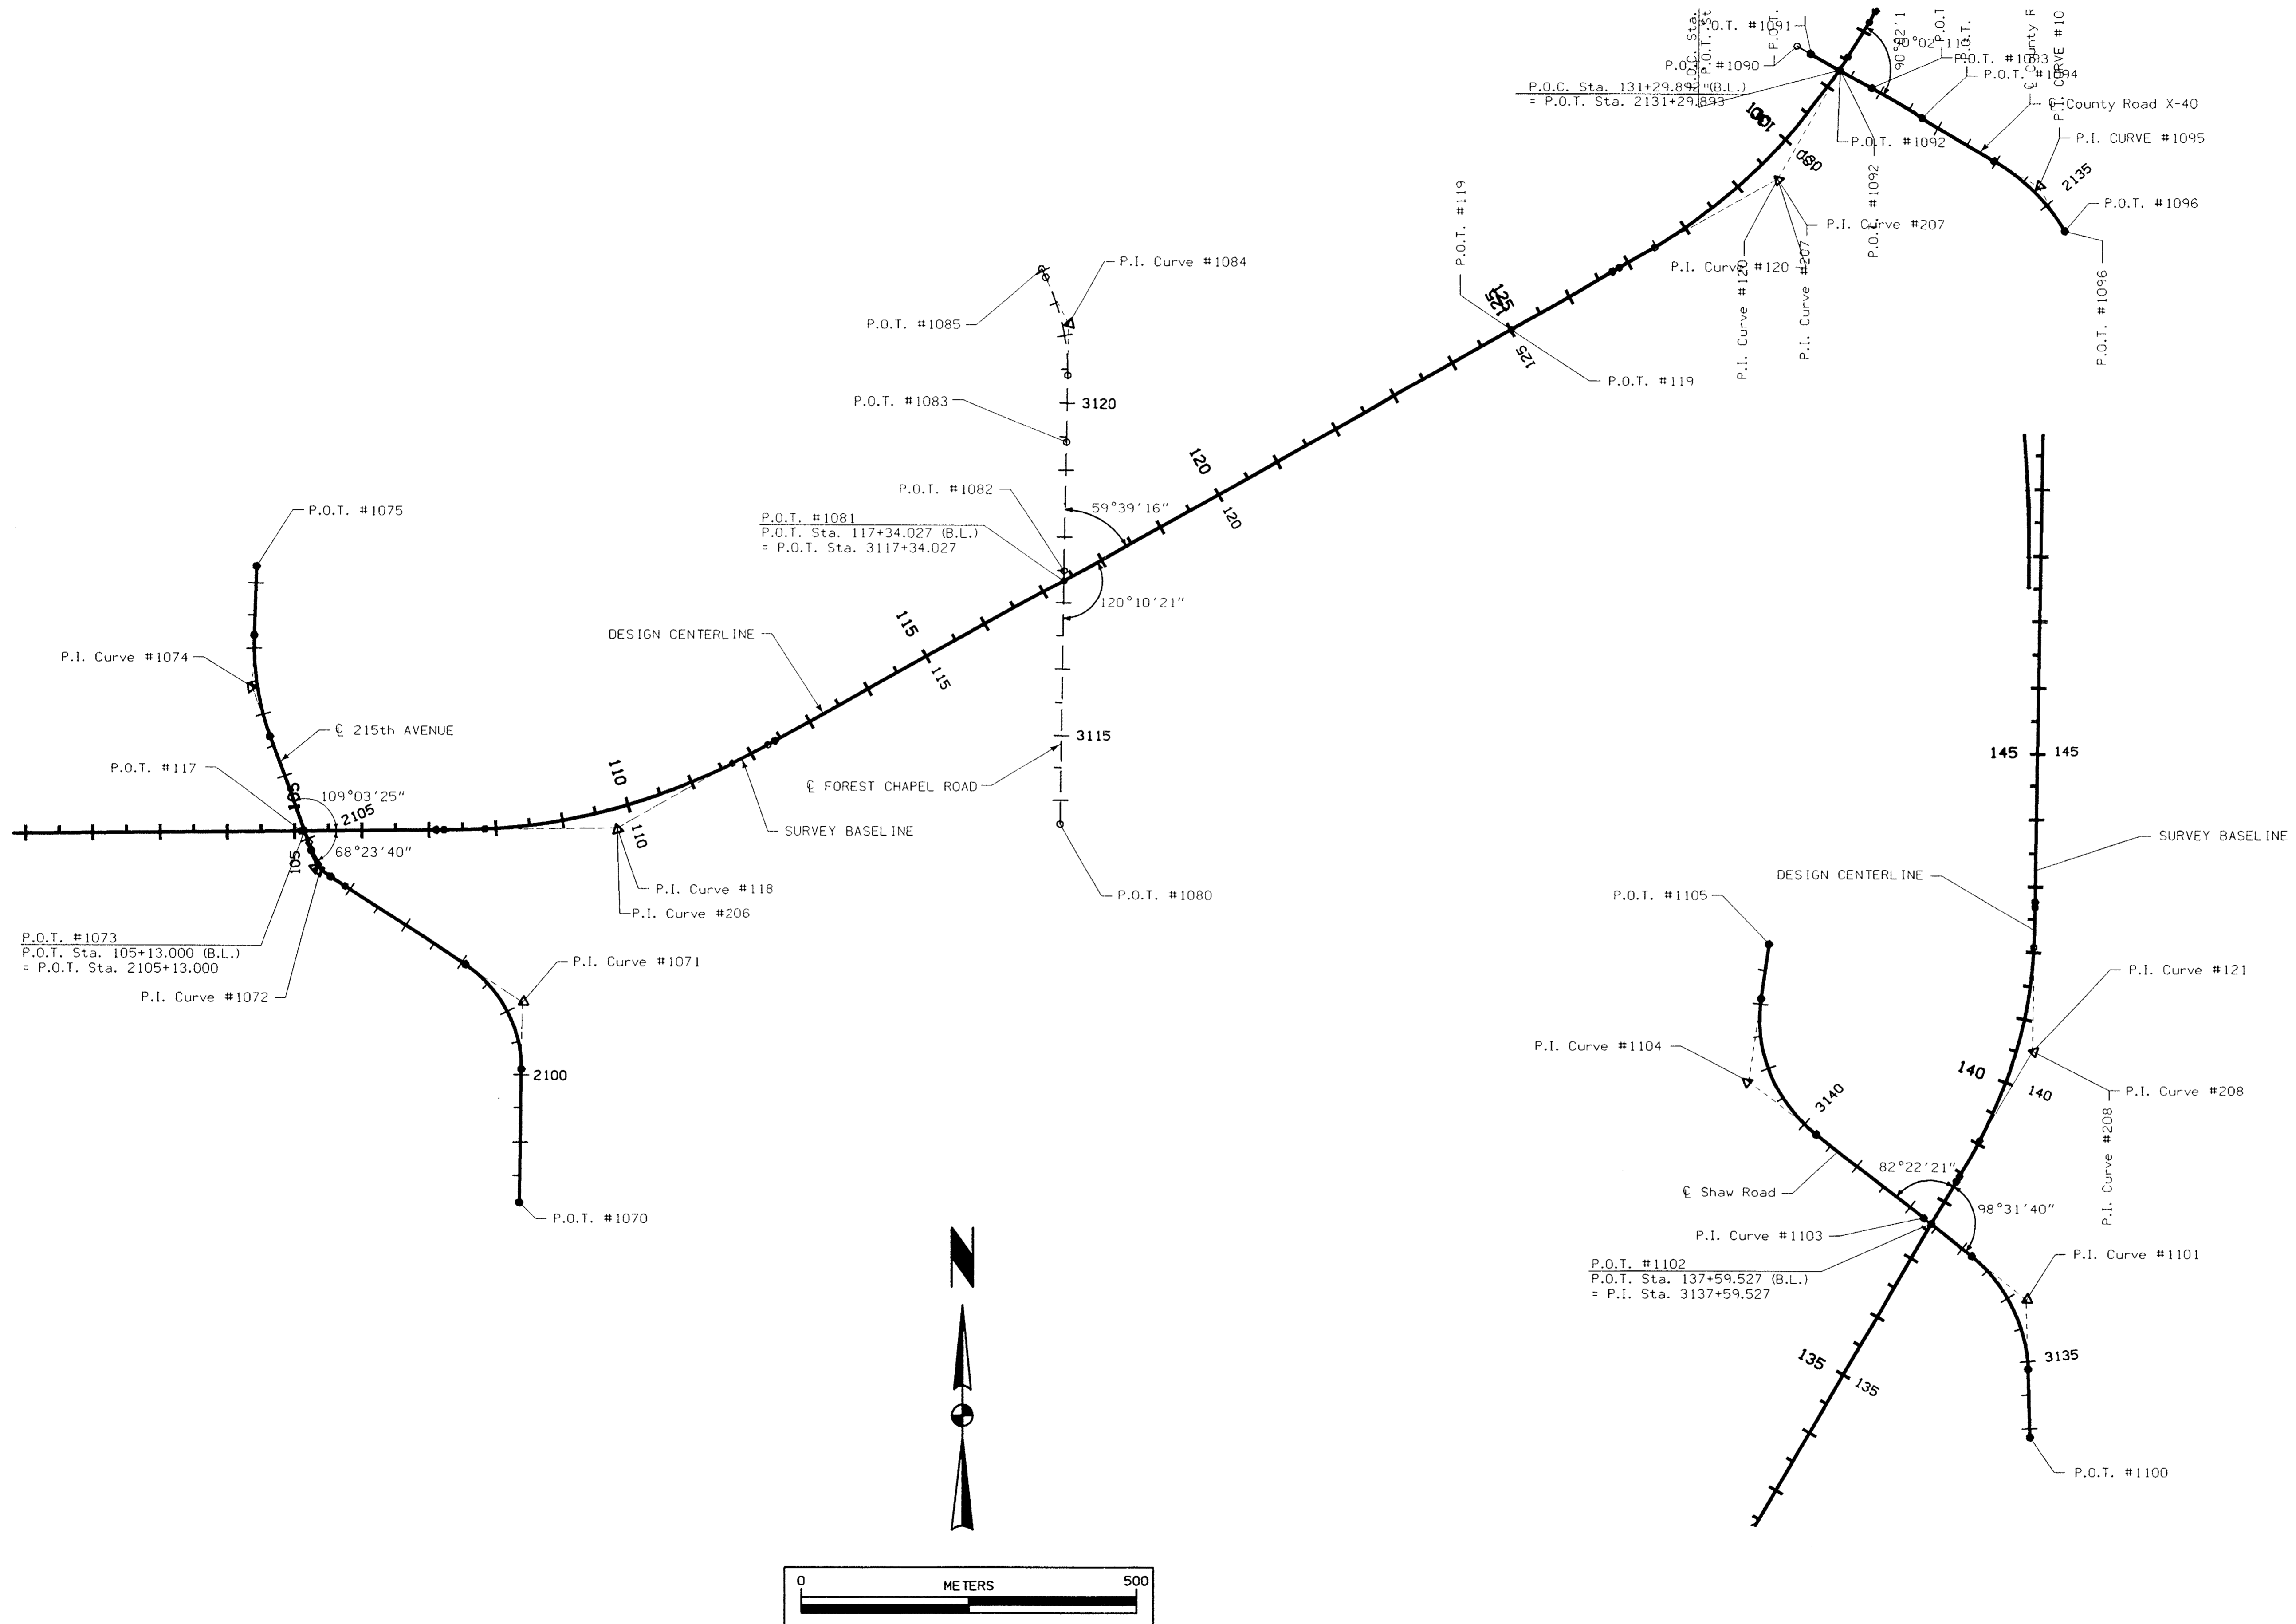

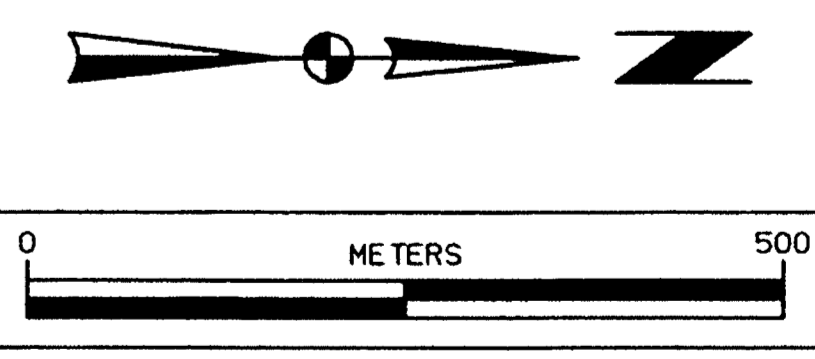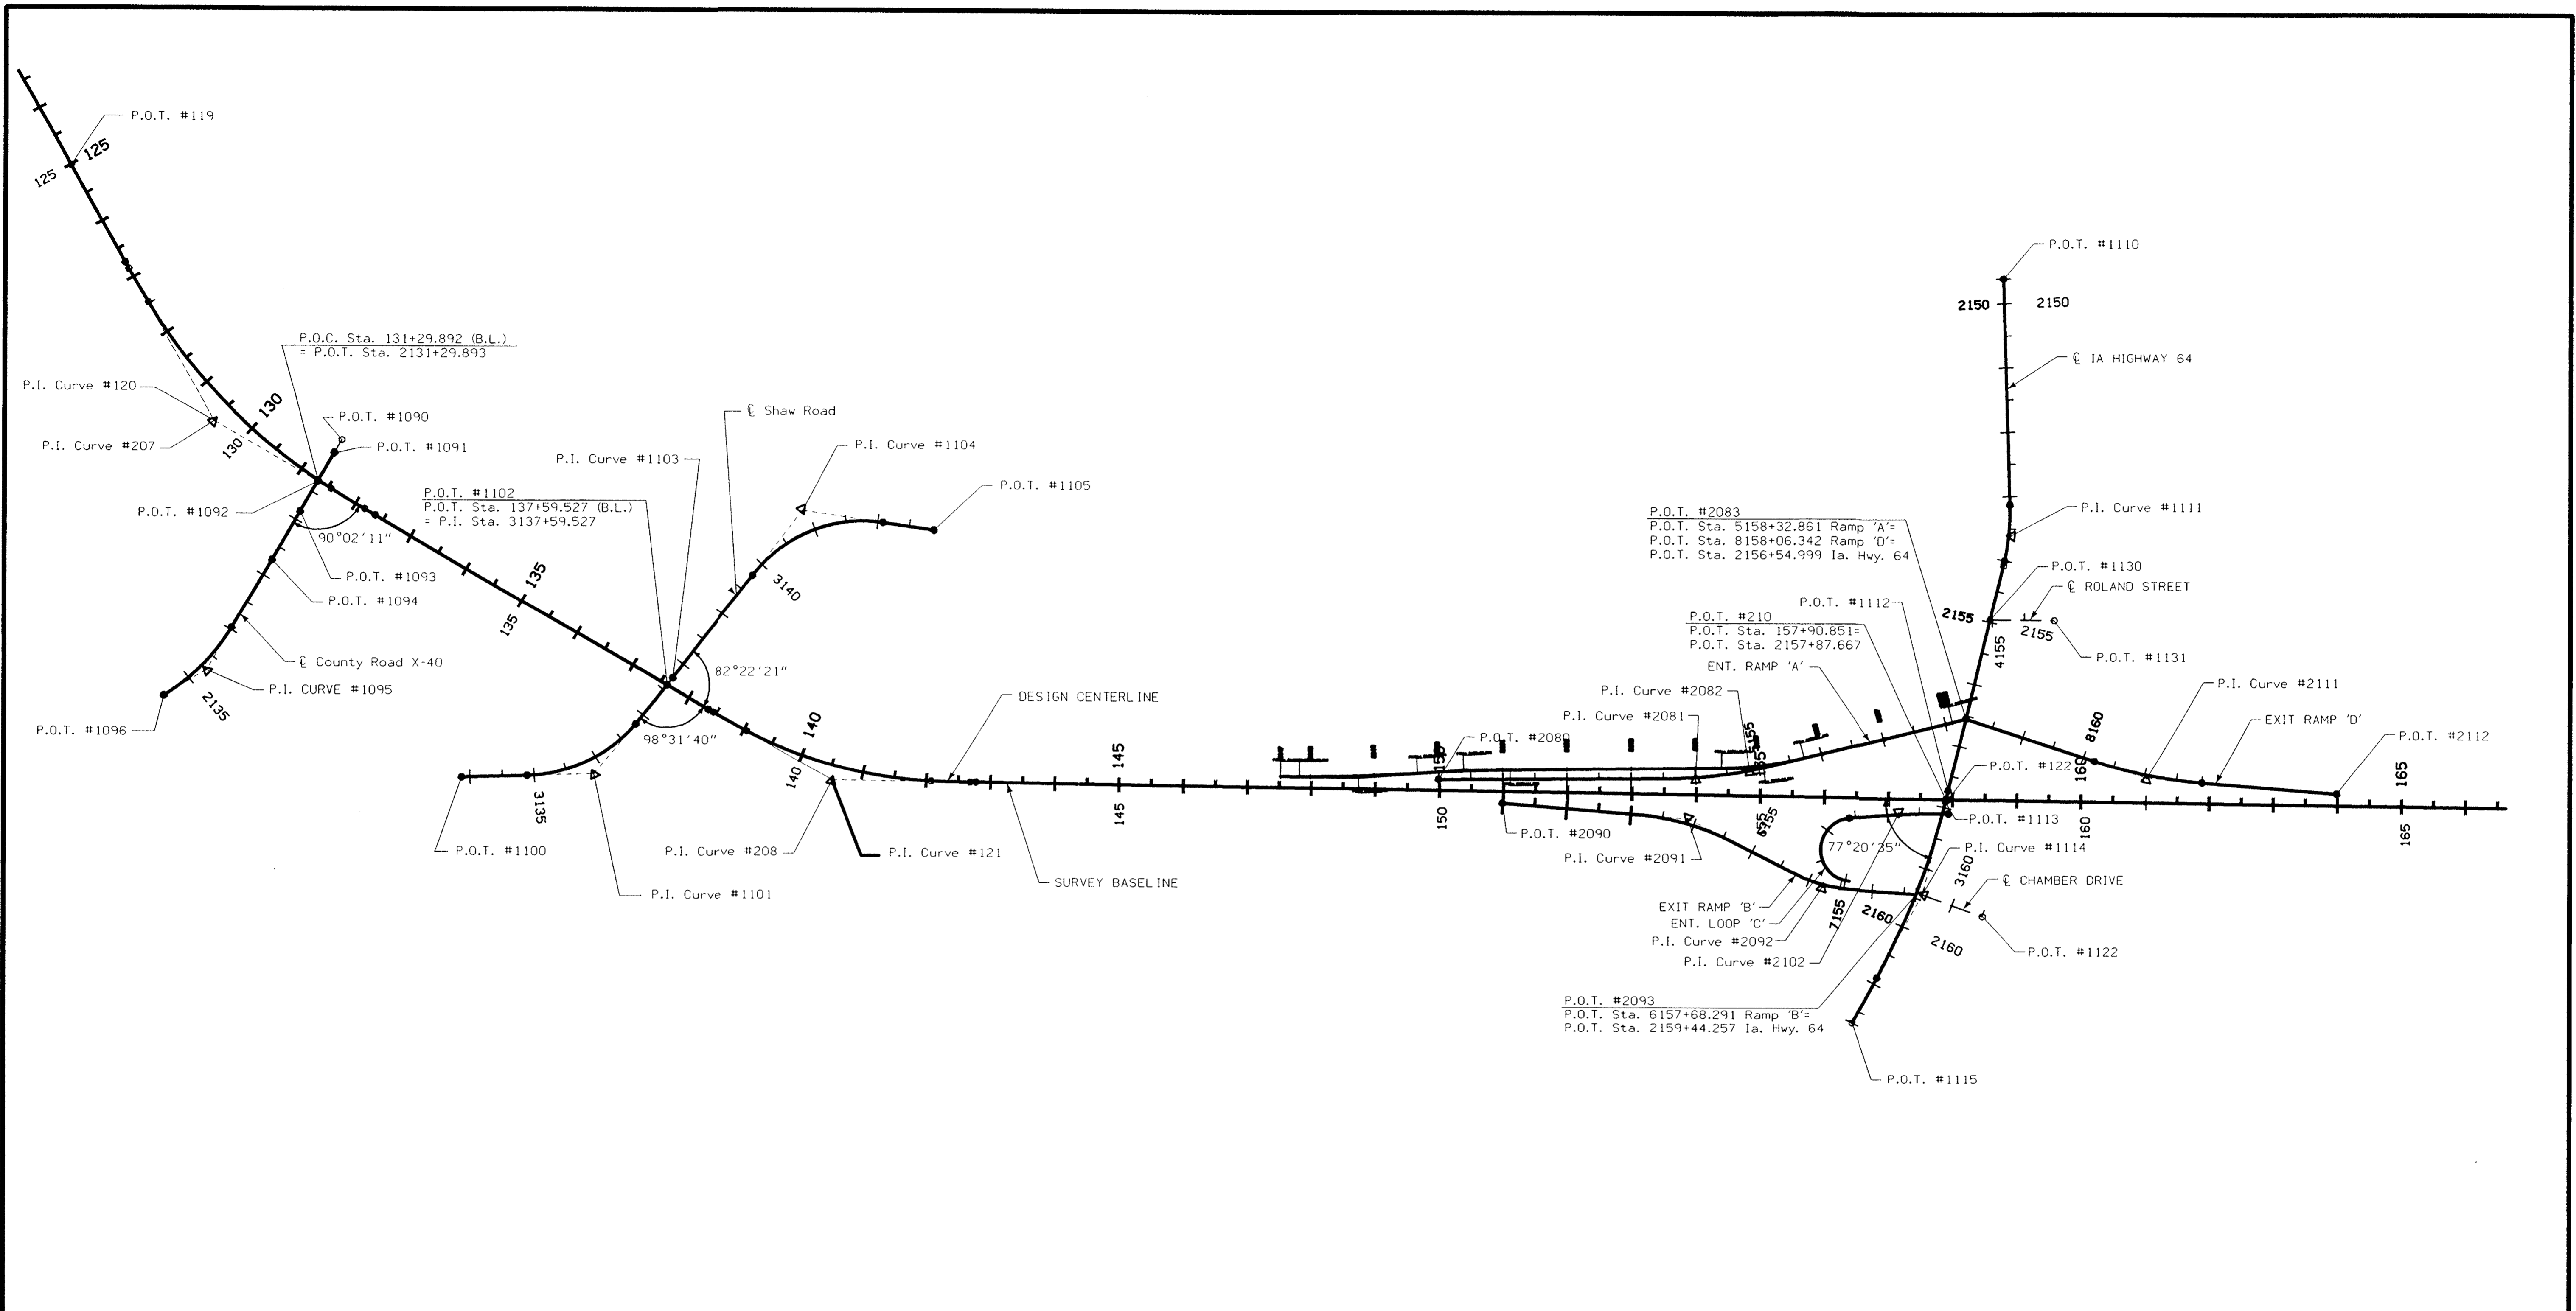


**GEOMETRIC LAYOUT
STA. 165+00 TO STA. 187+50**

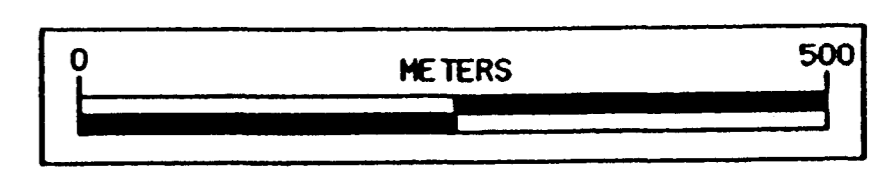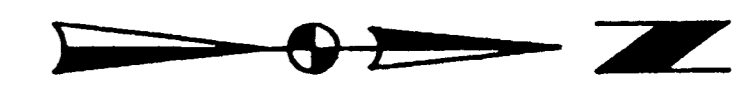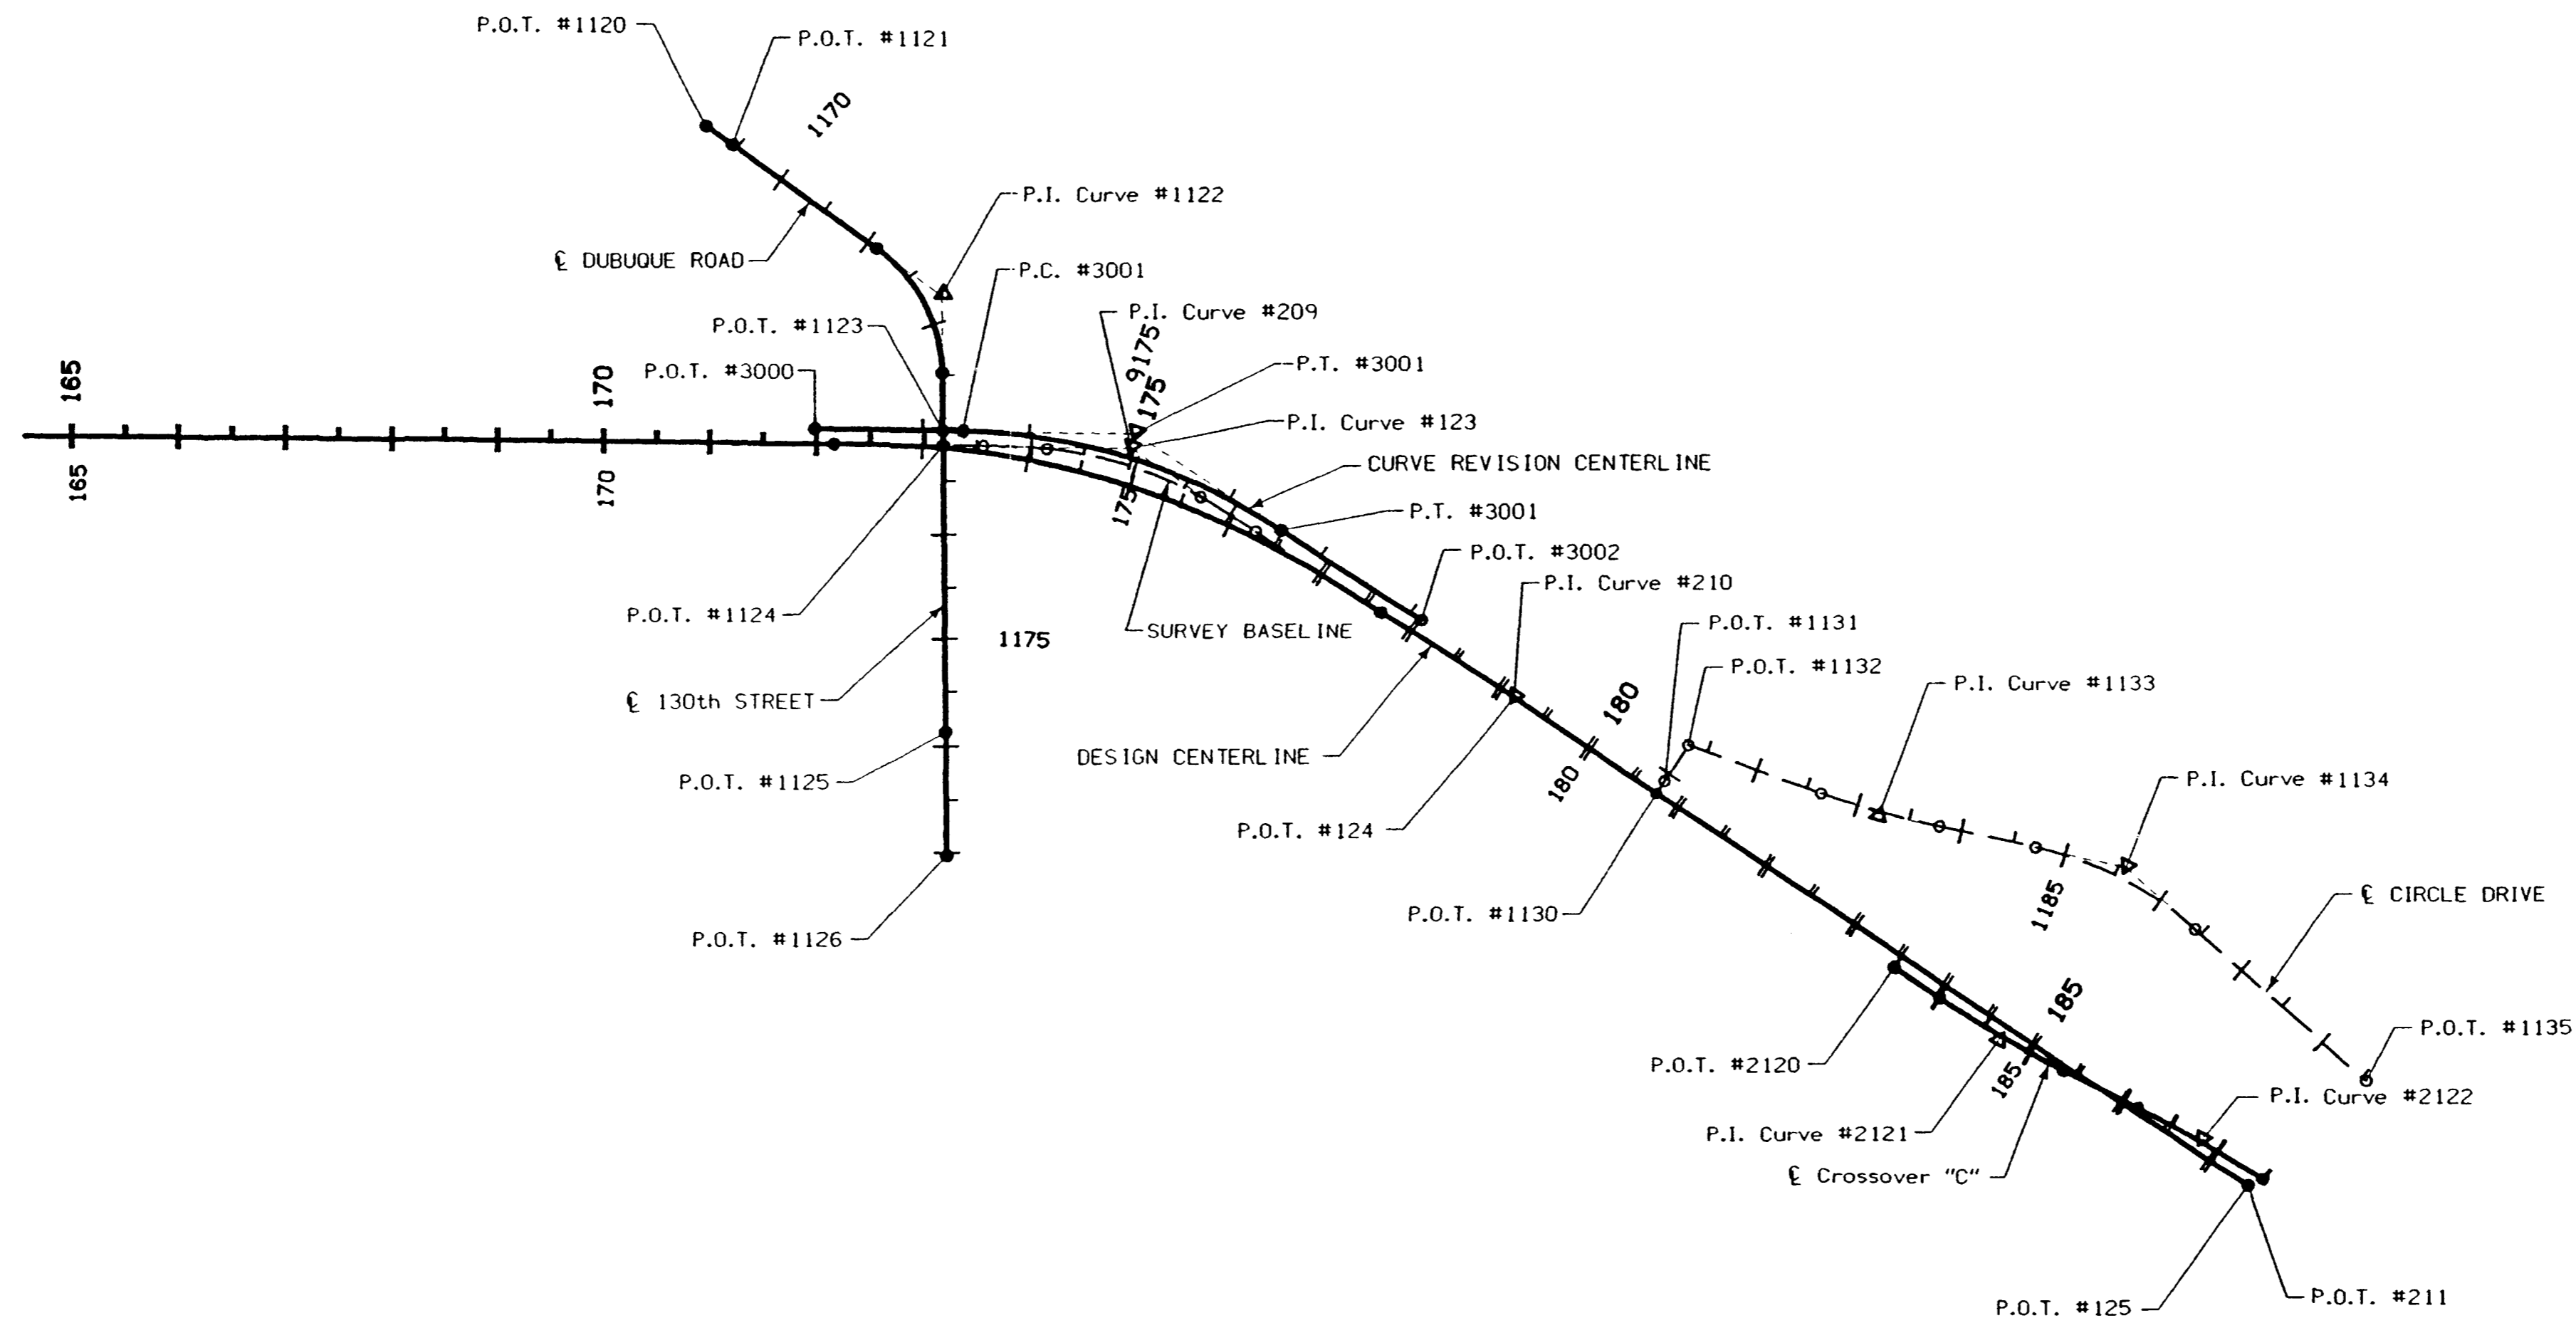

**GEOMETRIC LAYOUT
STA. 165+00 TO STA. 187+50**


dgn = I:\WORK\project\39922\cadd\anacurve\PAVE\57151112.g05
 level = 1-63
 pen table = I:\plot\tables\half.tbl

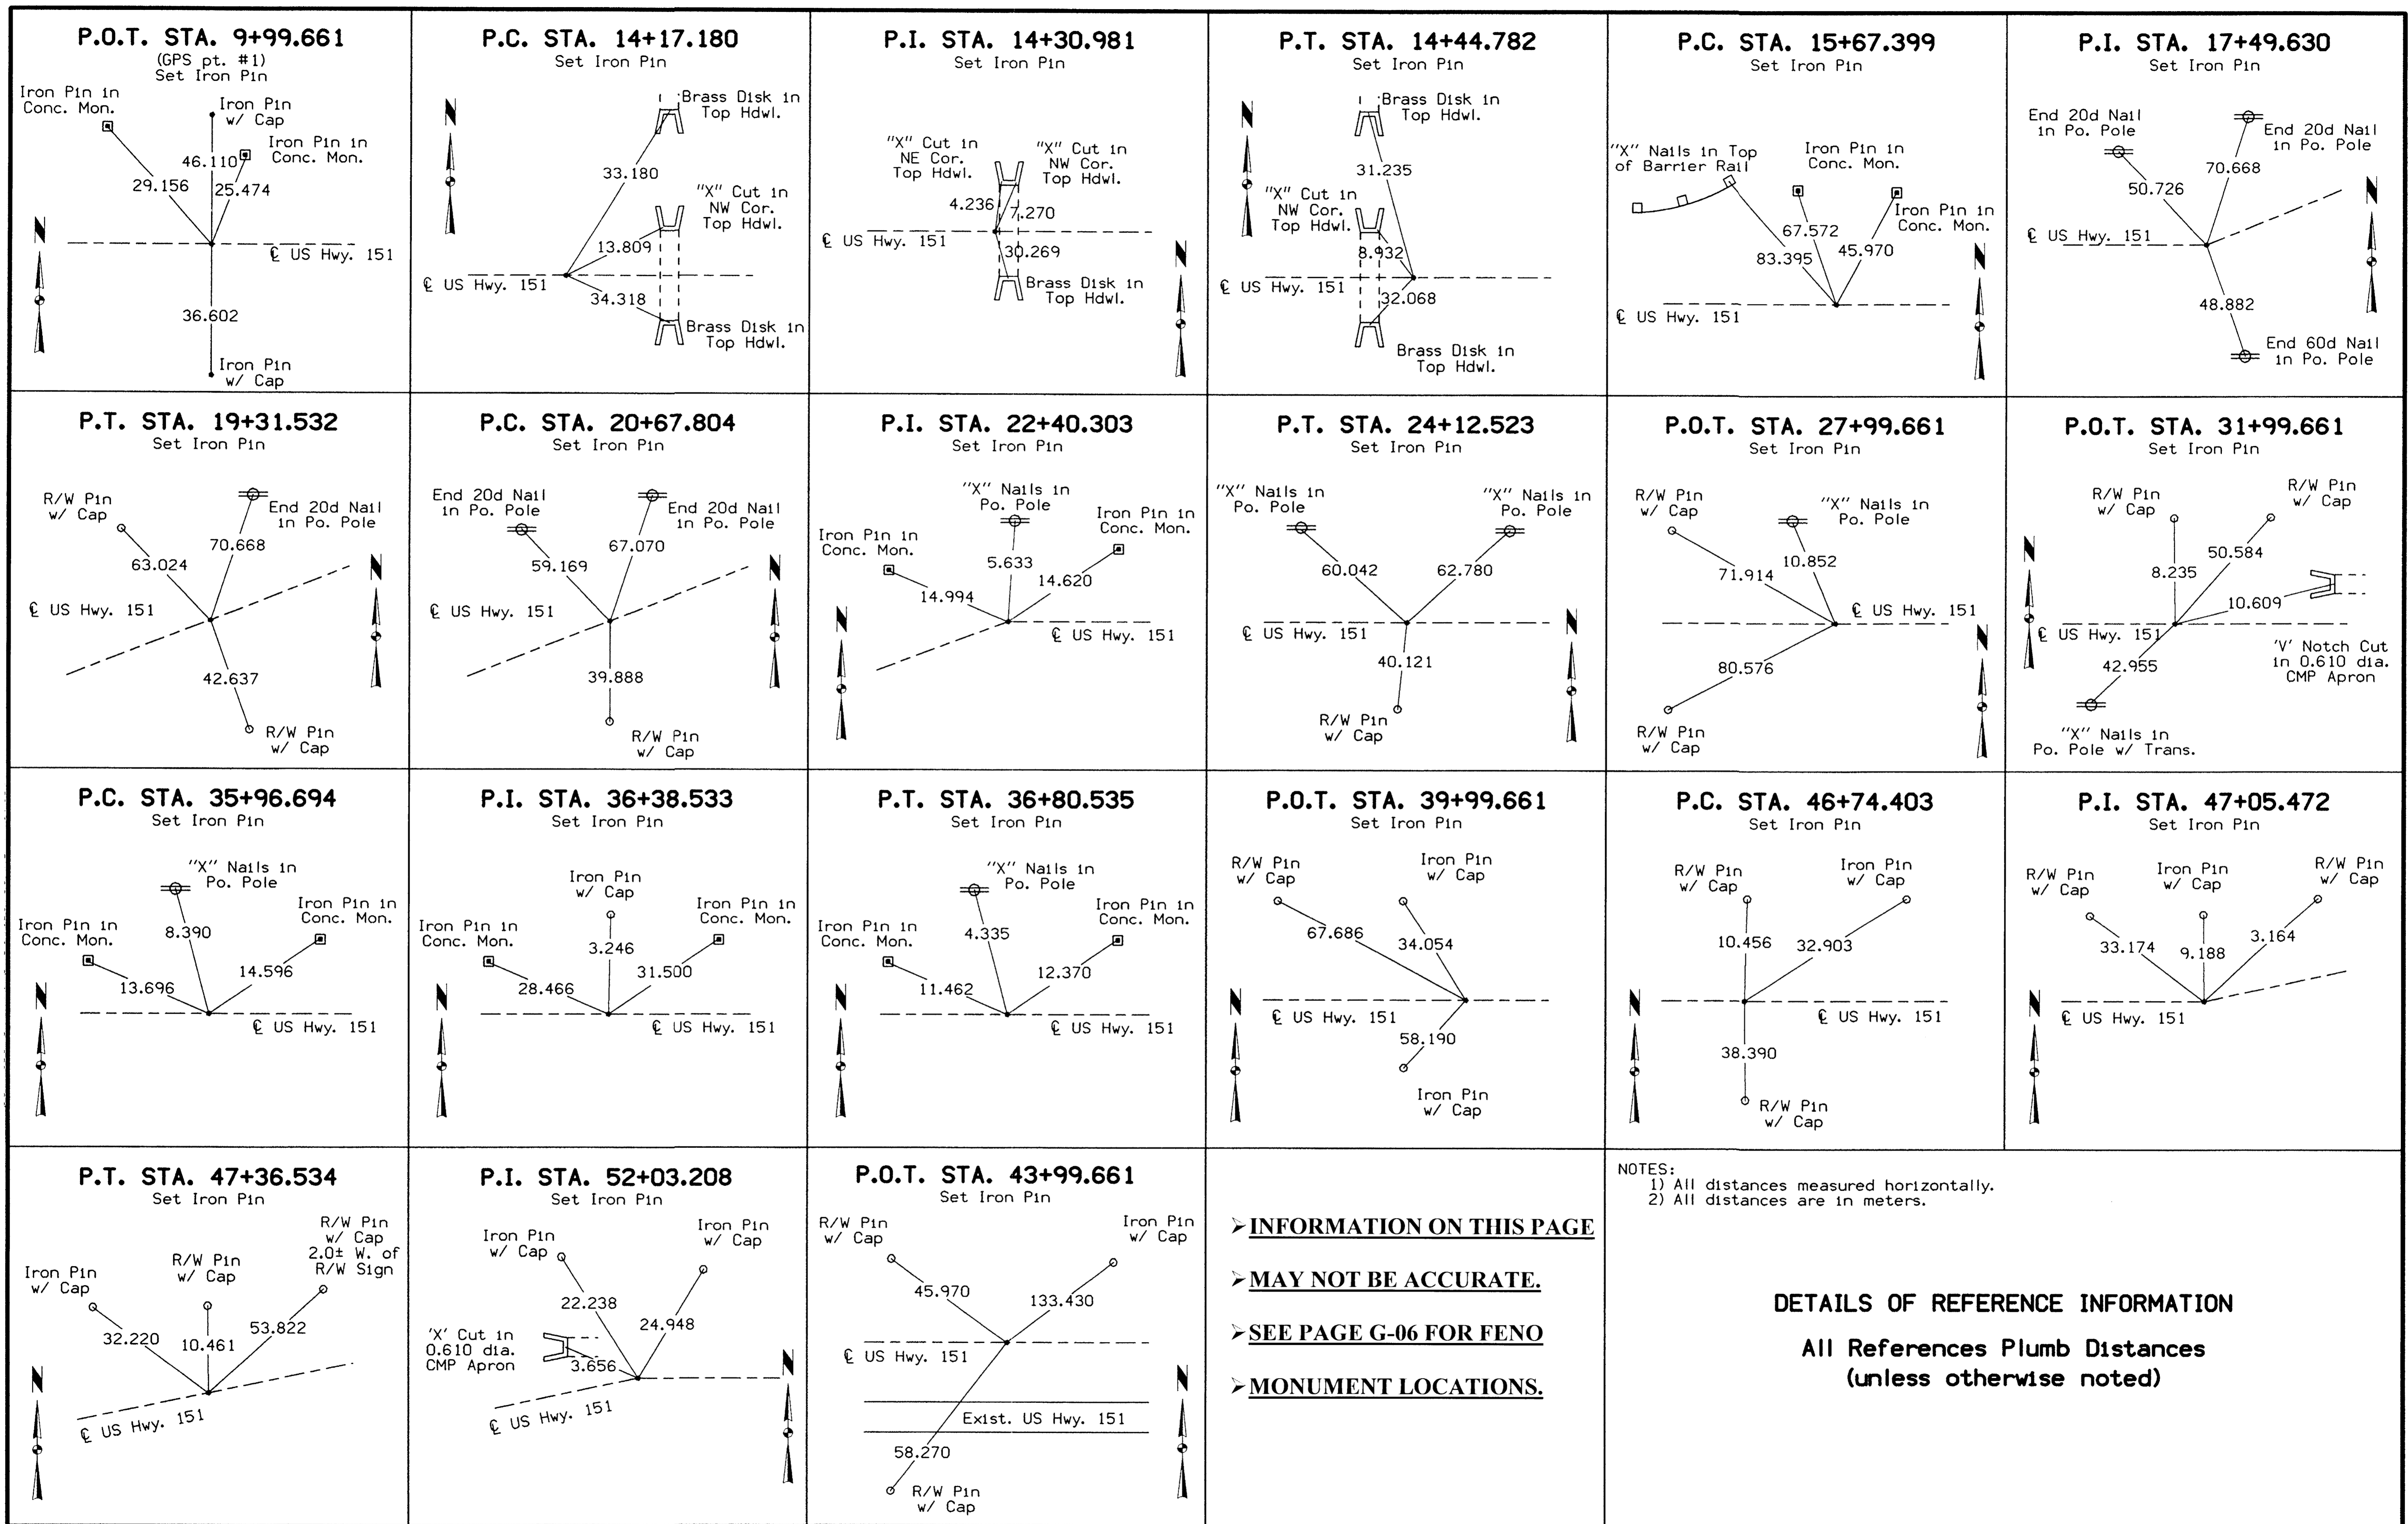


NOTES:
1) All distances measured horizontally.
2) All distances are in meters.

> INFORMATION ON THIS PAGE
> MAY NOT BE ACCURATE.
> SEE PAGE G-06 FOR FENO
> MONUMENT LOCATIONS.

DETAILS OF REFERENCE INFORMATION
All References Plumb Distances
(unless otherwise noted)

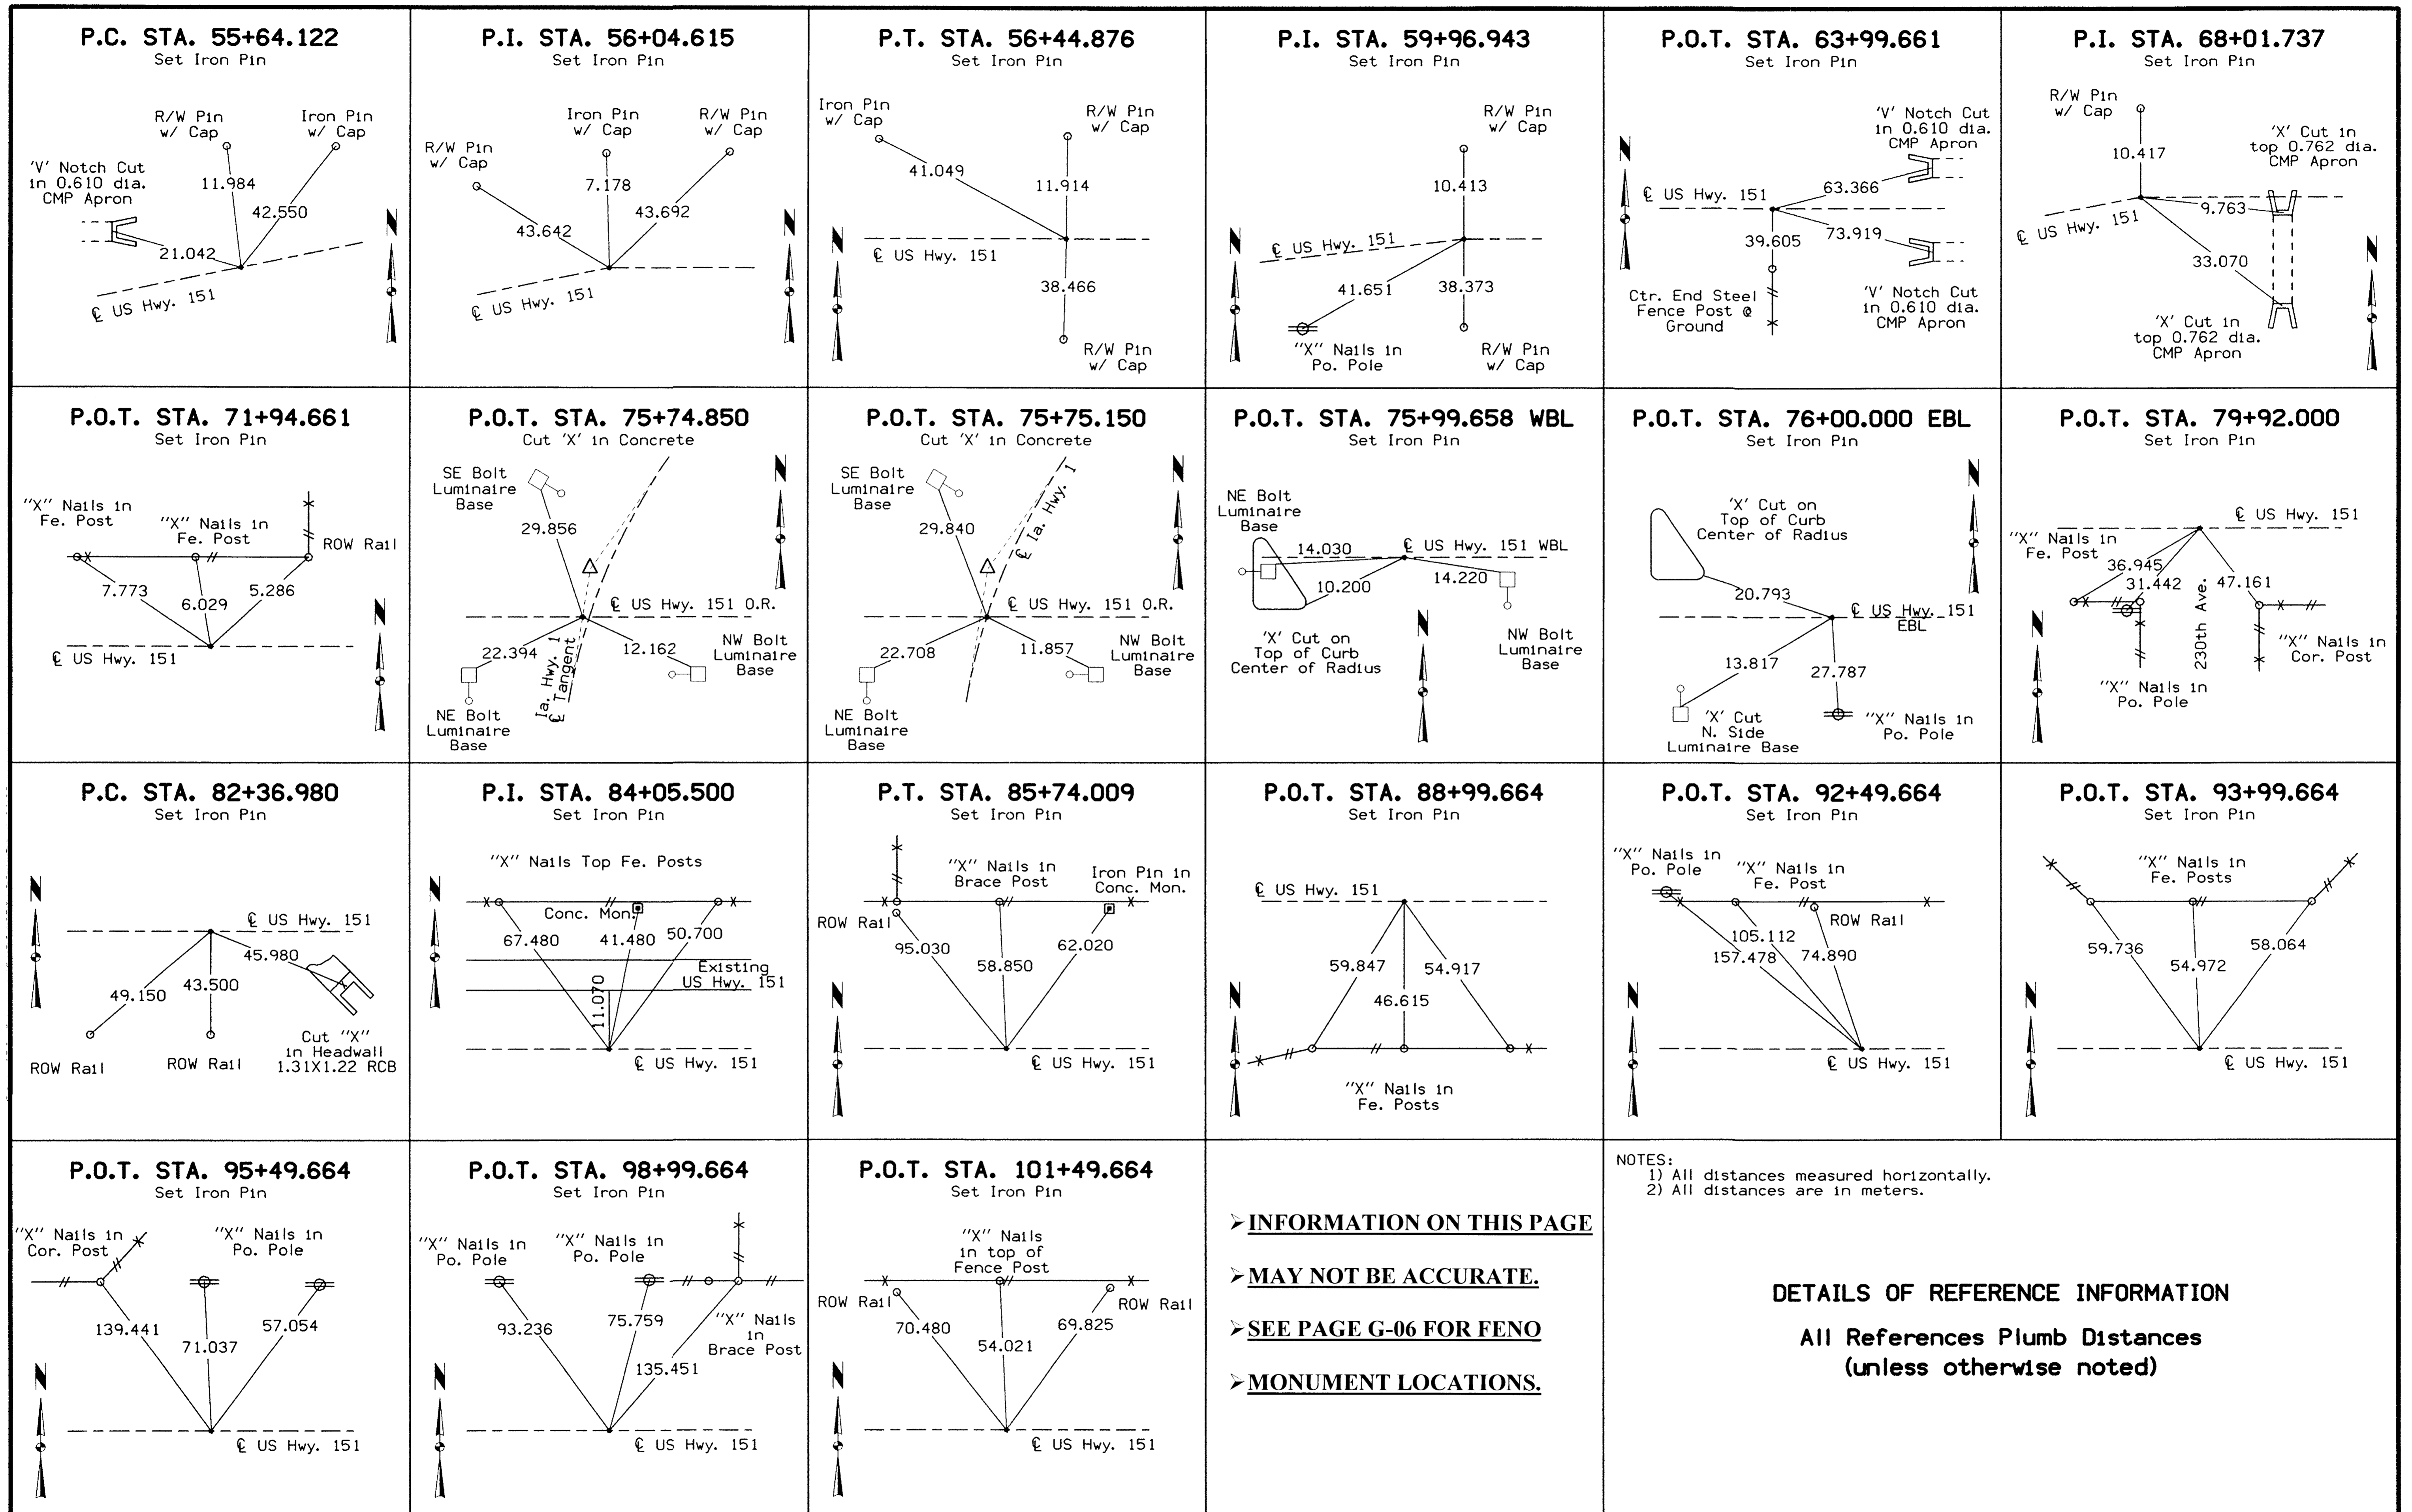


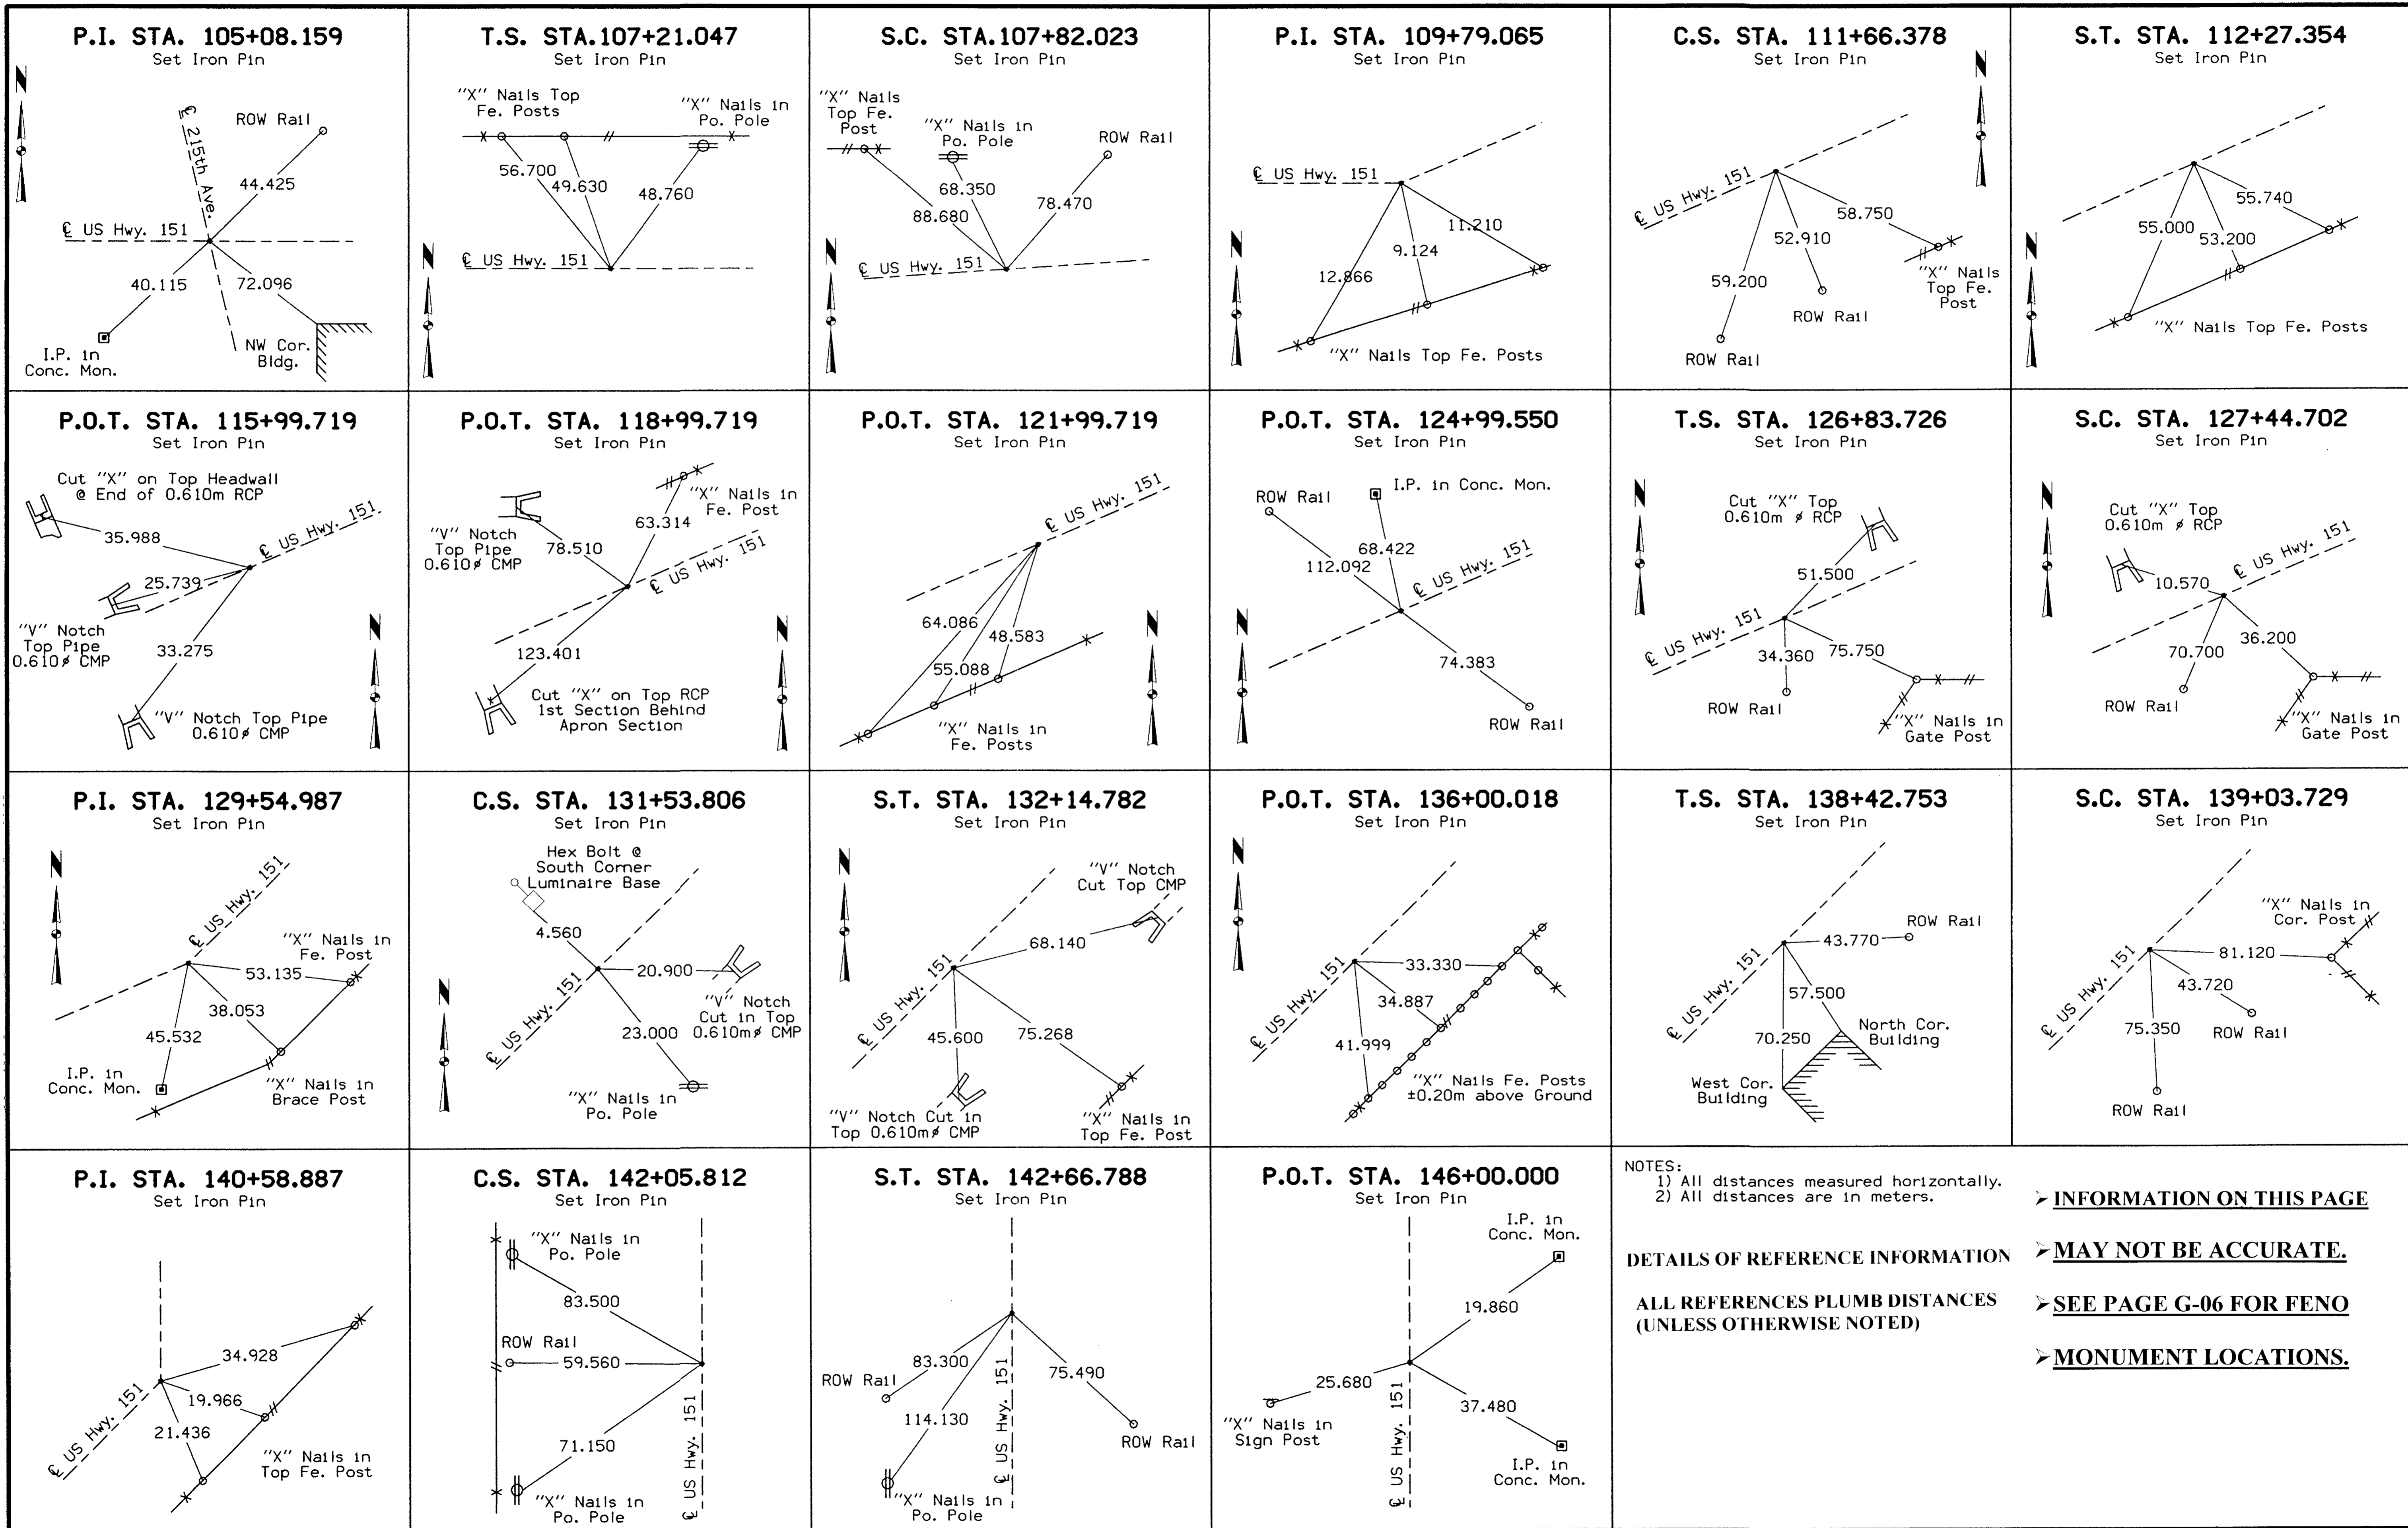

NOTES:
 1) All distances measured horizontally.
 2) All distances are in meters.

DETAILS OF REFERENCE INFORMATION
 ALL REFERENCES PLUMB DISTANCES
 (UNLESS OTHERWISE NOTED)

➤ **INFORMATION ON THIS PAGE**
 ➤ **MAY NOT BE ACCURATE.**
 ➤ **SEE PAGE G-06 FOR FENO**
 ➤ **MONUMENT LOCATIONS.**

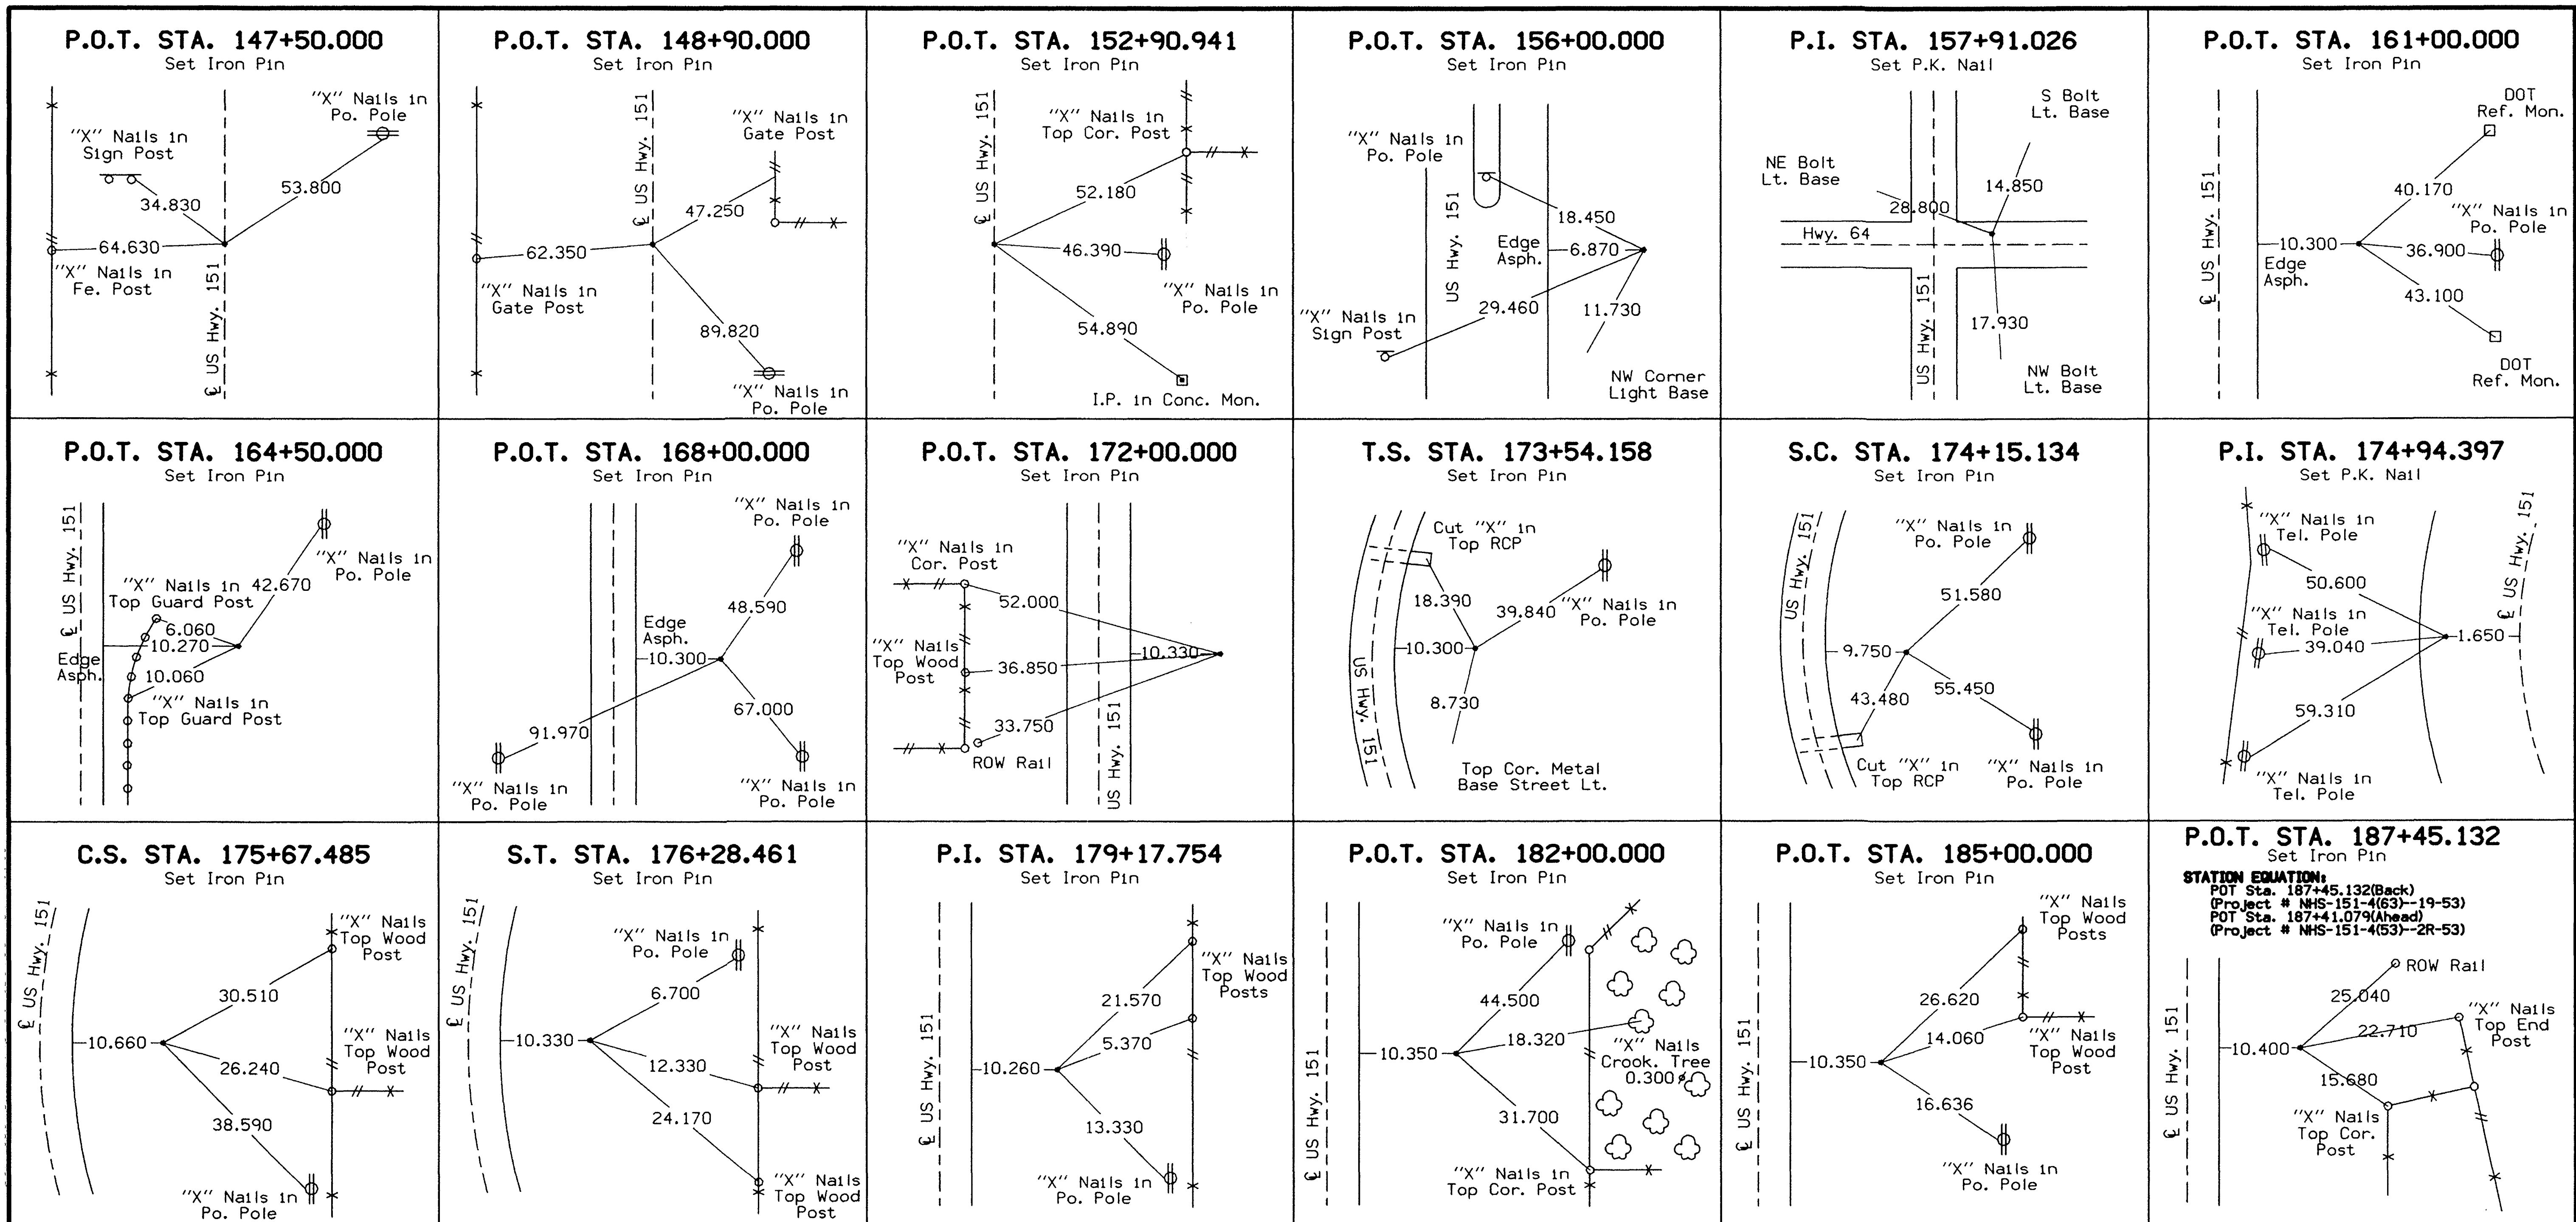



NOTES:
 1) All distances measured horizontally.
 2) All distances are in meters.

➤ INFORMATION ON THIS PAGE
 ➤ MAY NOT BE ACCURATE.
 ➤ SEE PAGE G-06 FOR FENO
 ➤ MONUMENT LOCATIONS.

DETAILS OF REFERENCE INFORMATION
 All References Plumb Distances
 (unless otherwise noted)

STATION EQUATION:
 POT Sta. 187+45.132(Back)
 Project # NHS-151-4(63)-19-53
 POT Sta. 187+41.079(Ahead)
 Project # NHS-151-4(53)-2R-53

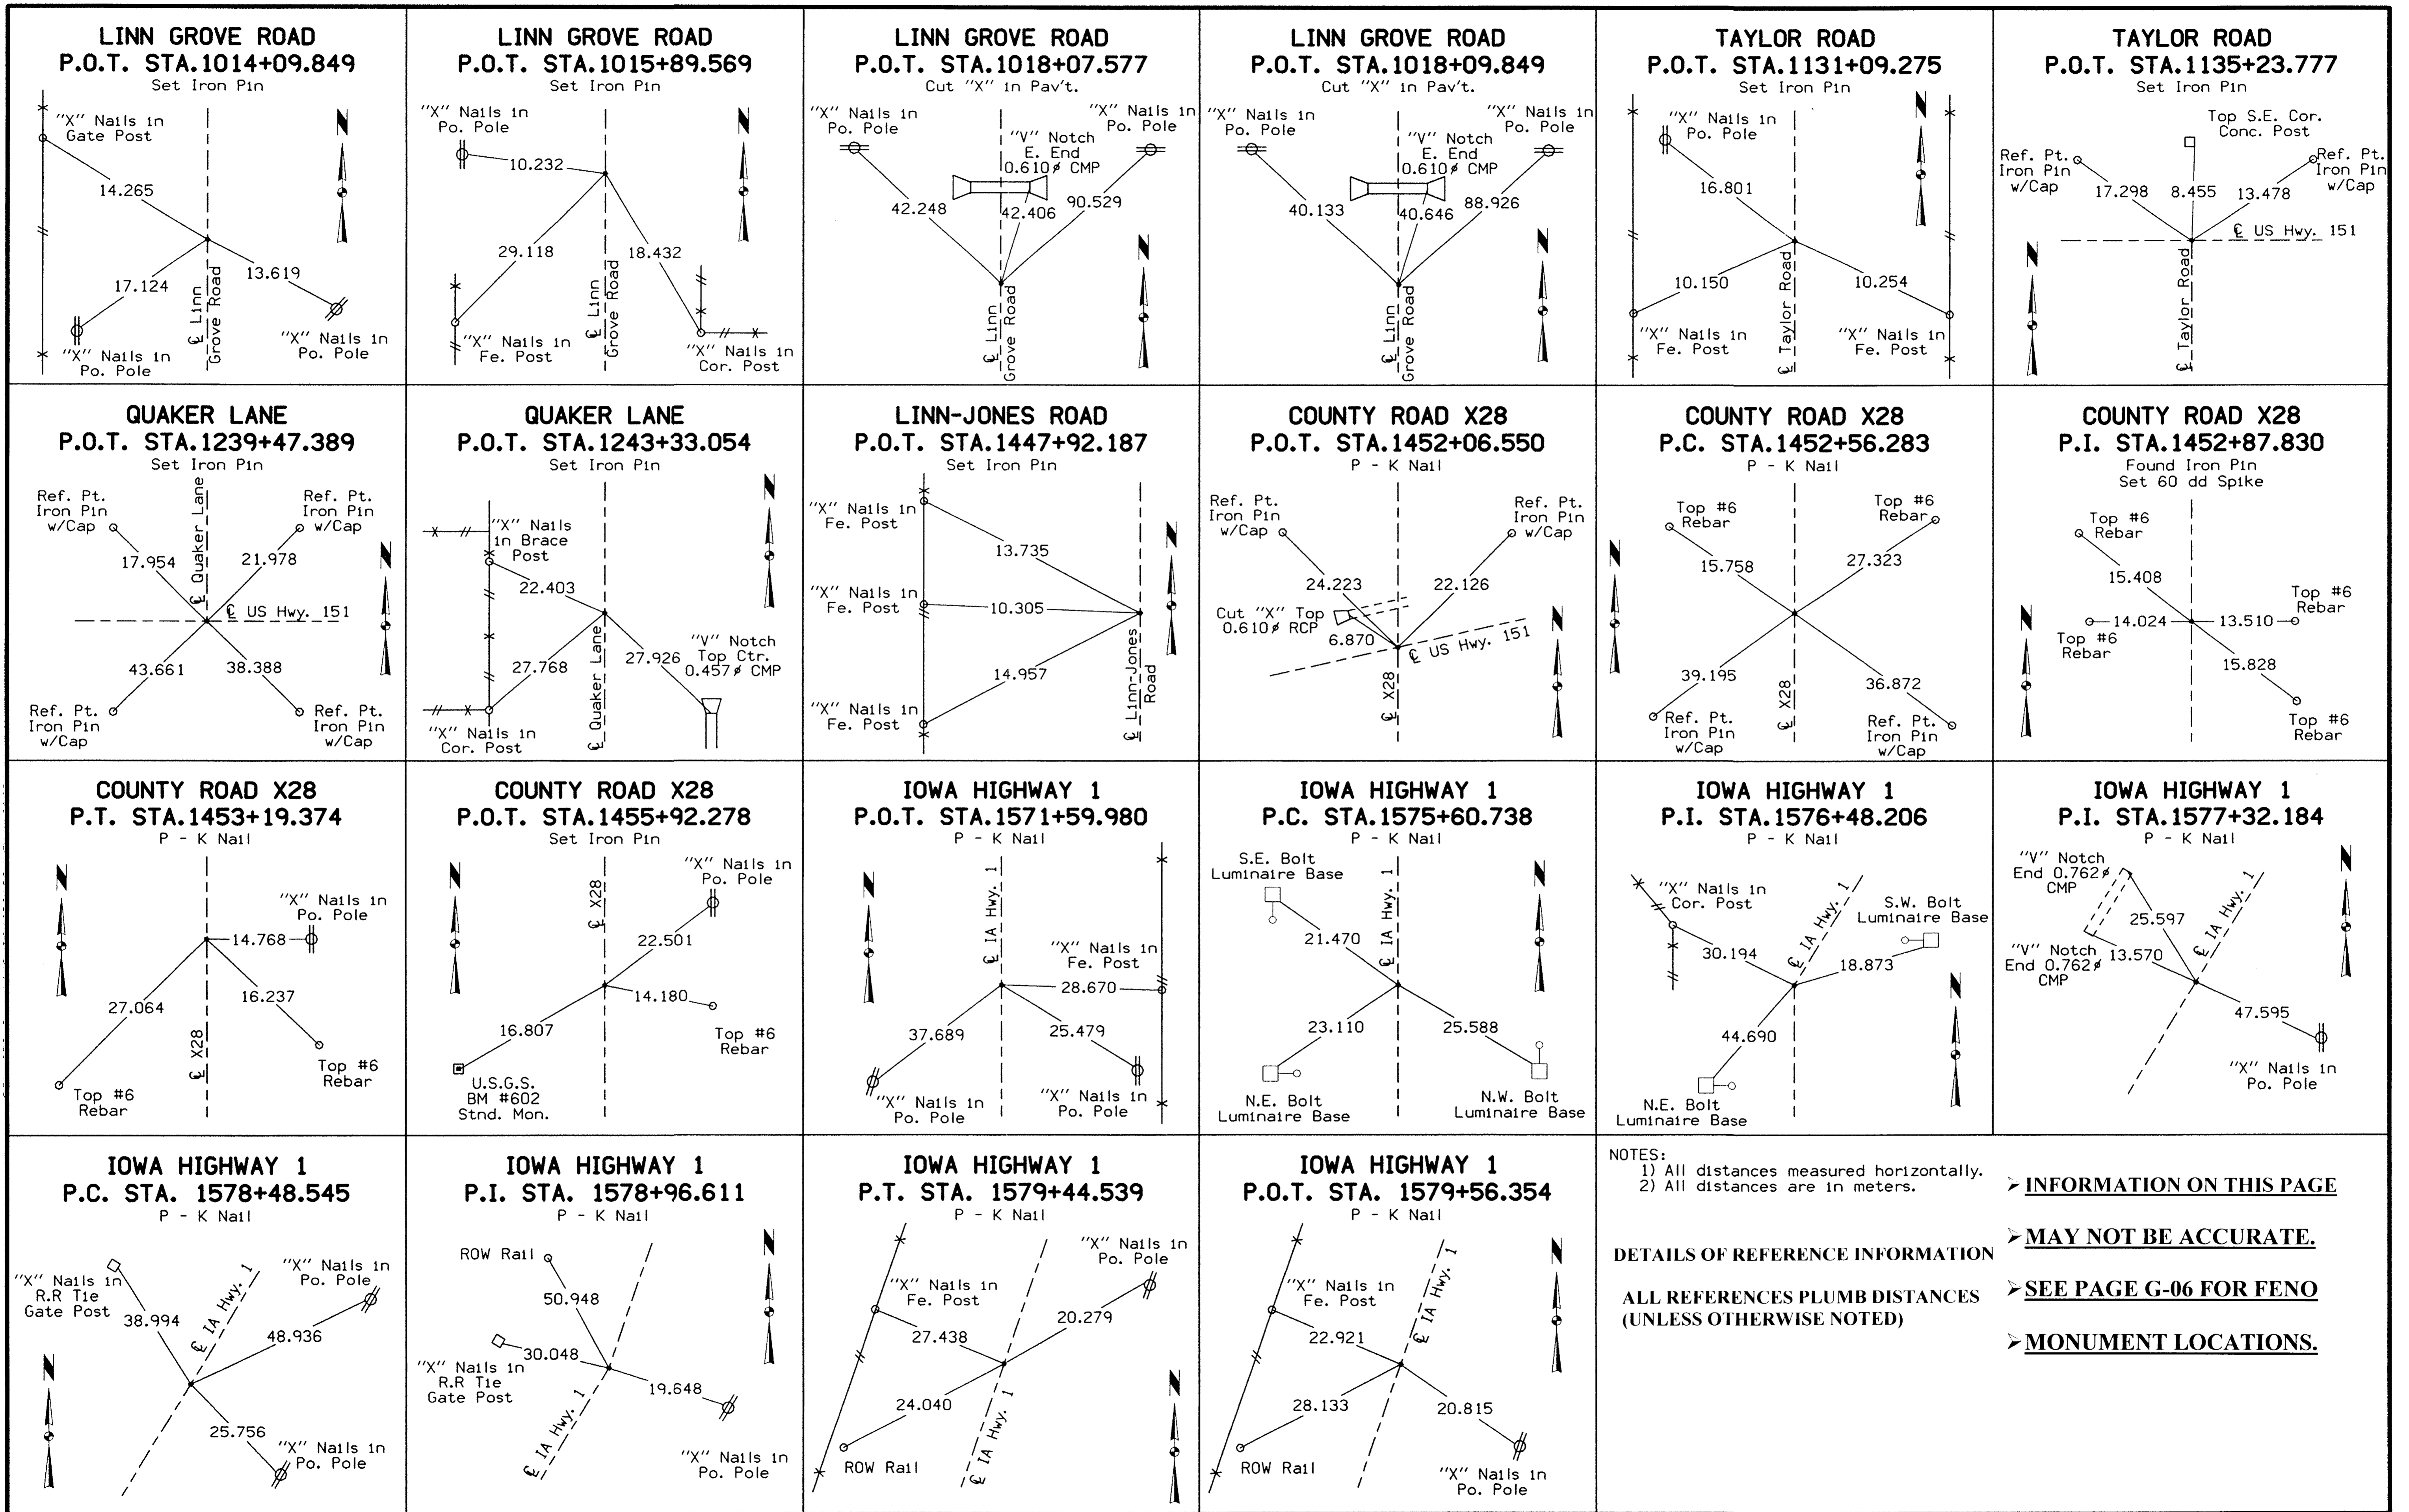























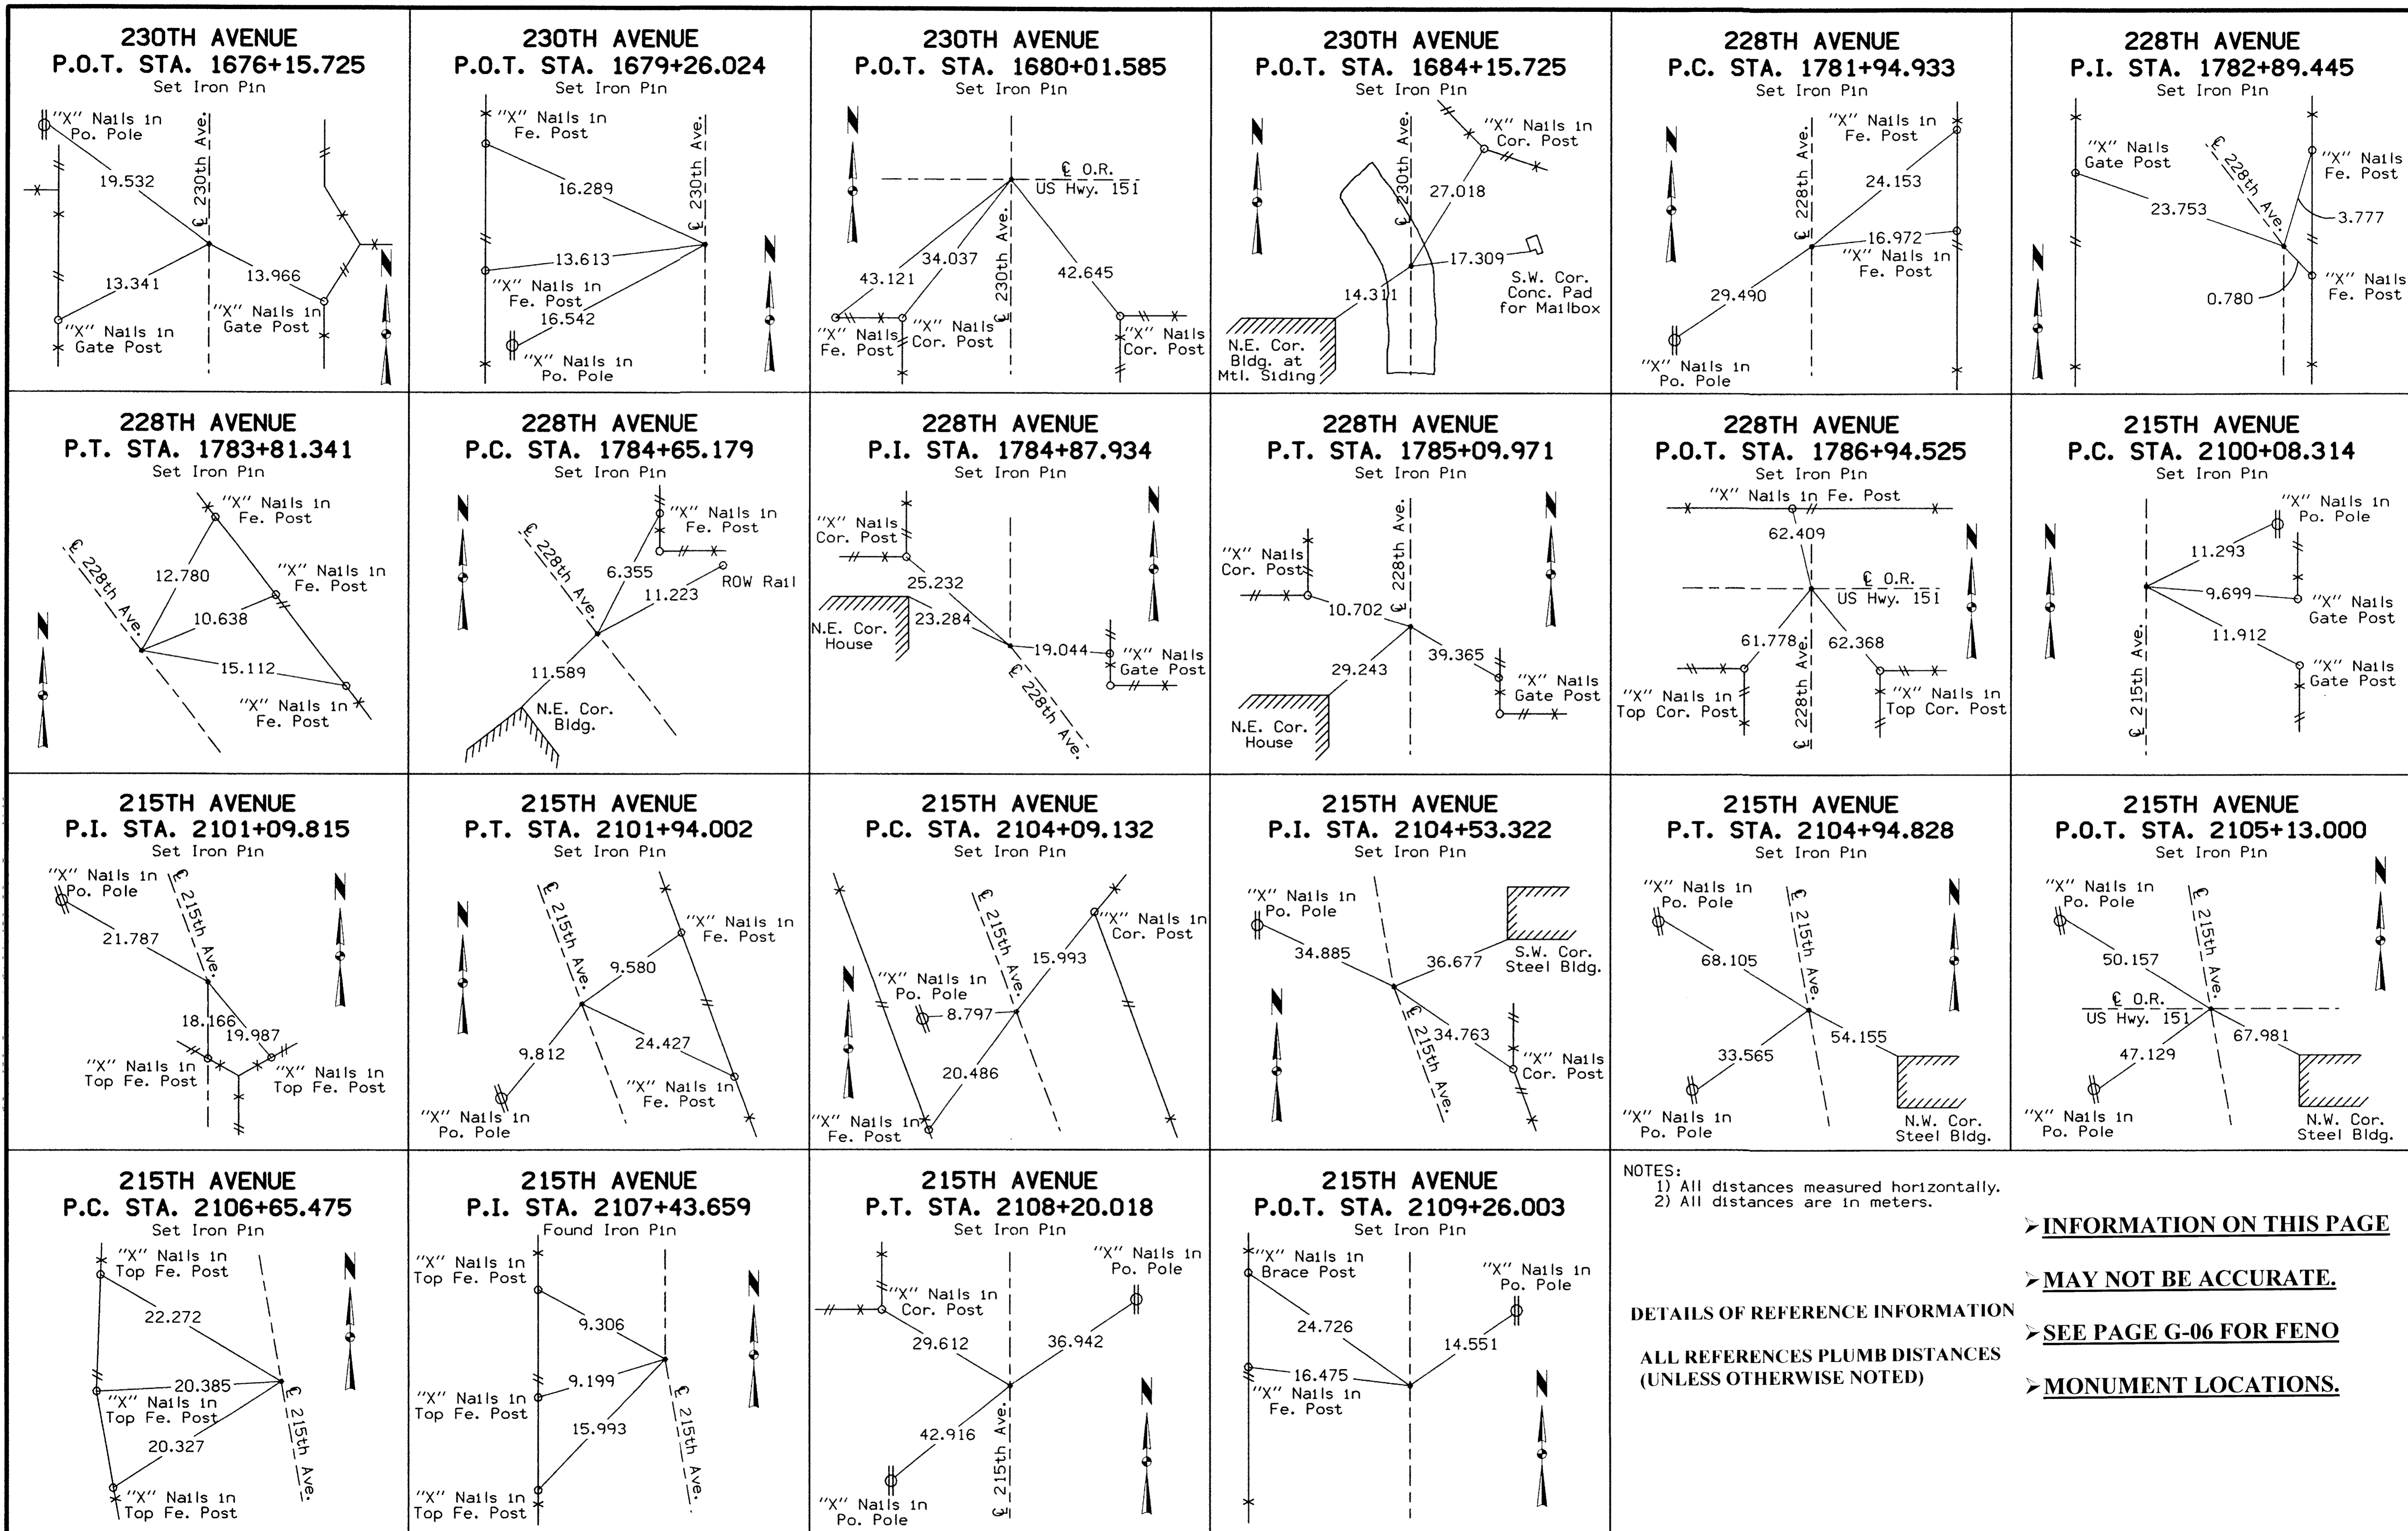


NOTES:
 1) All distances measured horizontally.
 2) All distances are in meters.

➤ INFORMATION ON THIS PAGE
➤ MAY NOT BE ACCURATE.
➤ SEE PAGE G-06 FOR FENO
➤ MONUMENT LOCATIONS.

DETAILS OF REFERENCE INFORMATION
ALL REFERENCES PLUMB DISTANCES
(UNLESS OTHERWISE NOTED)

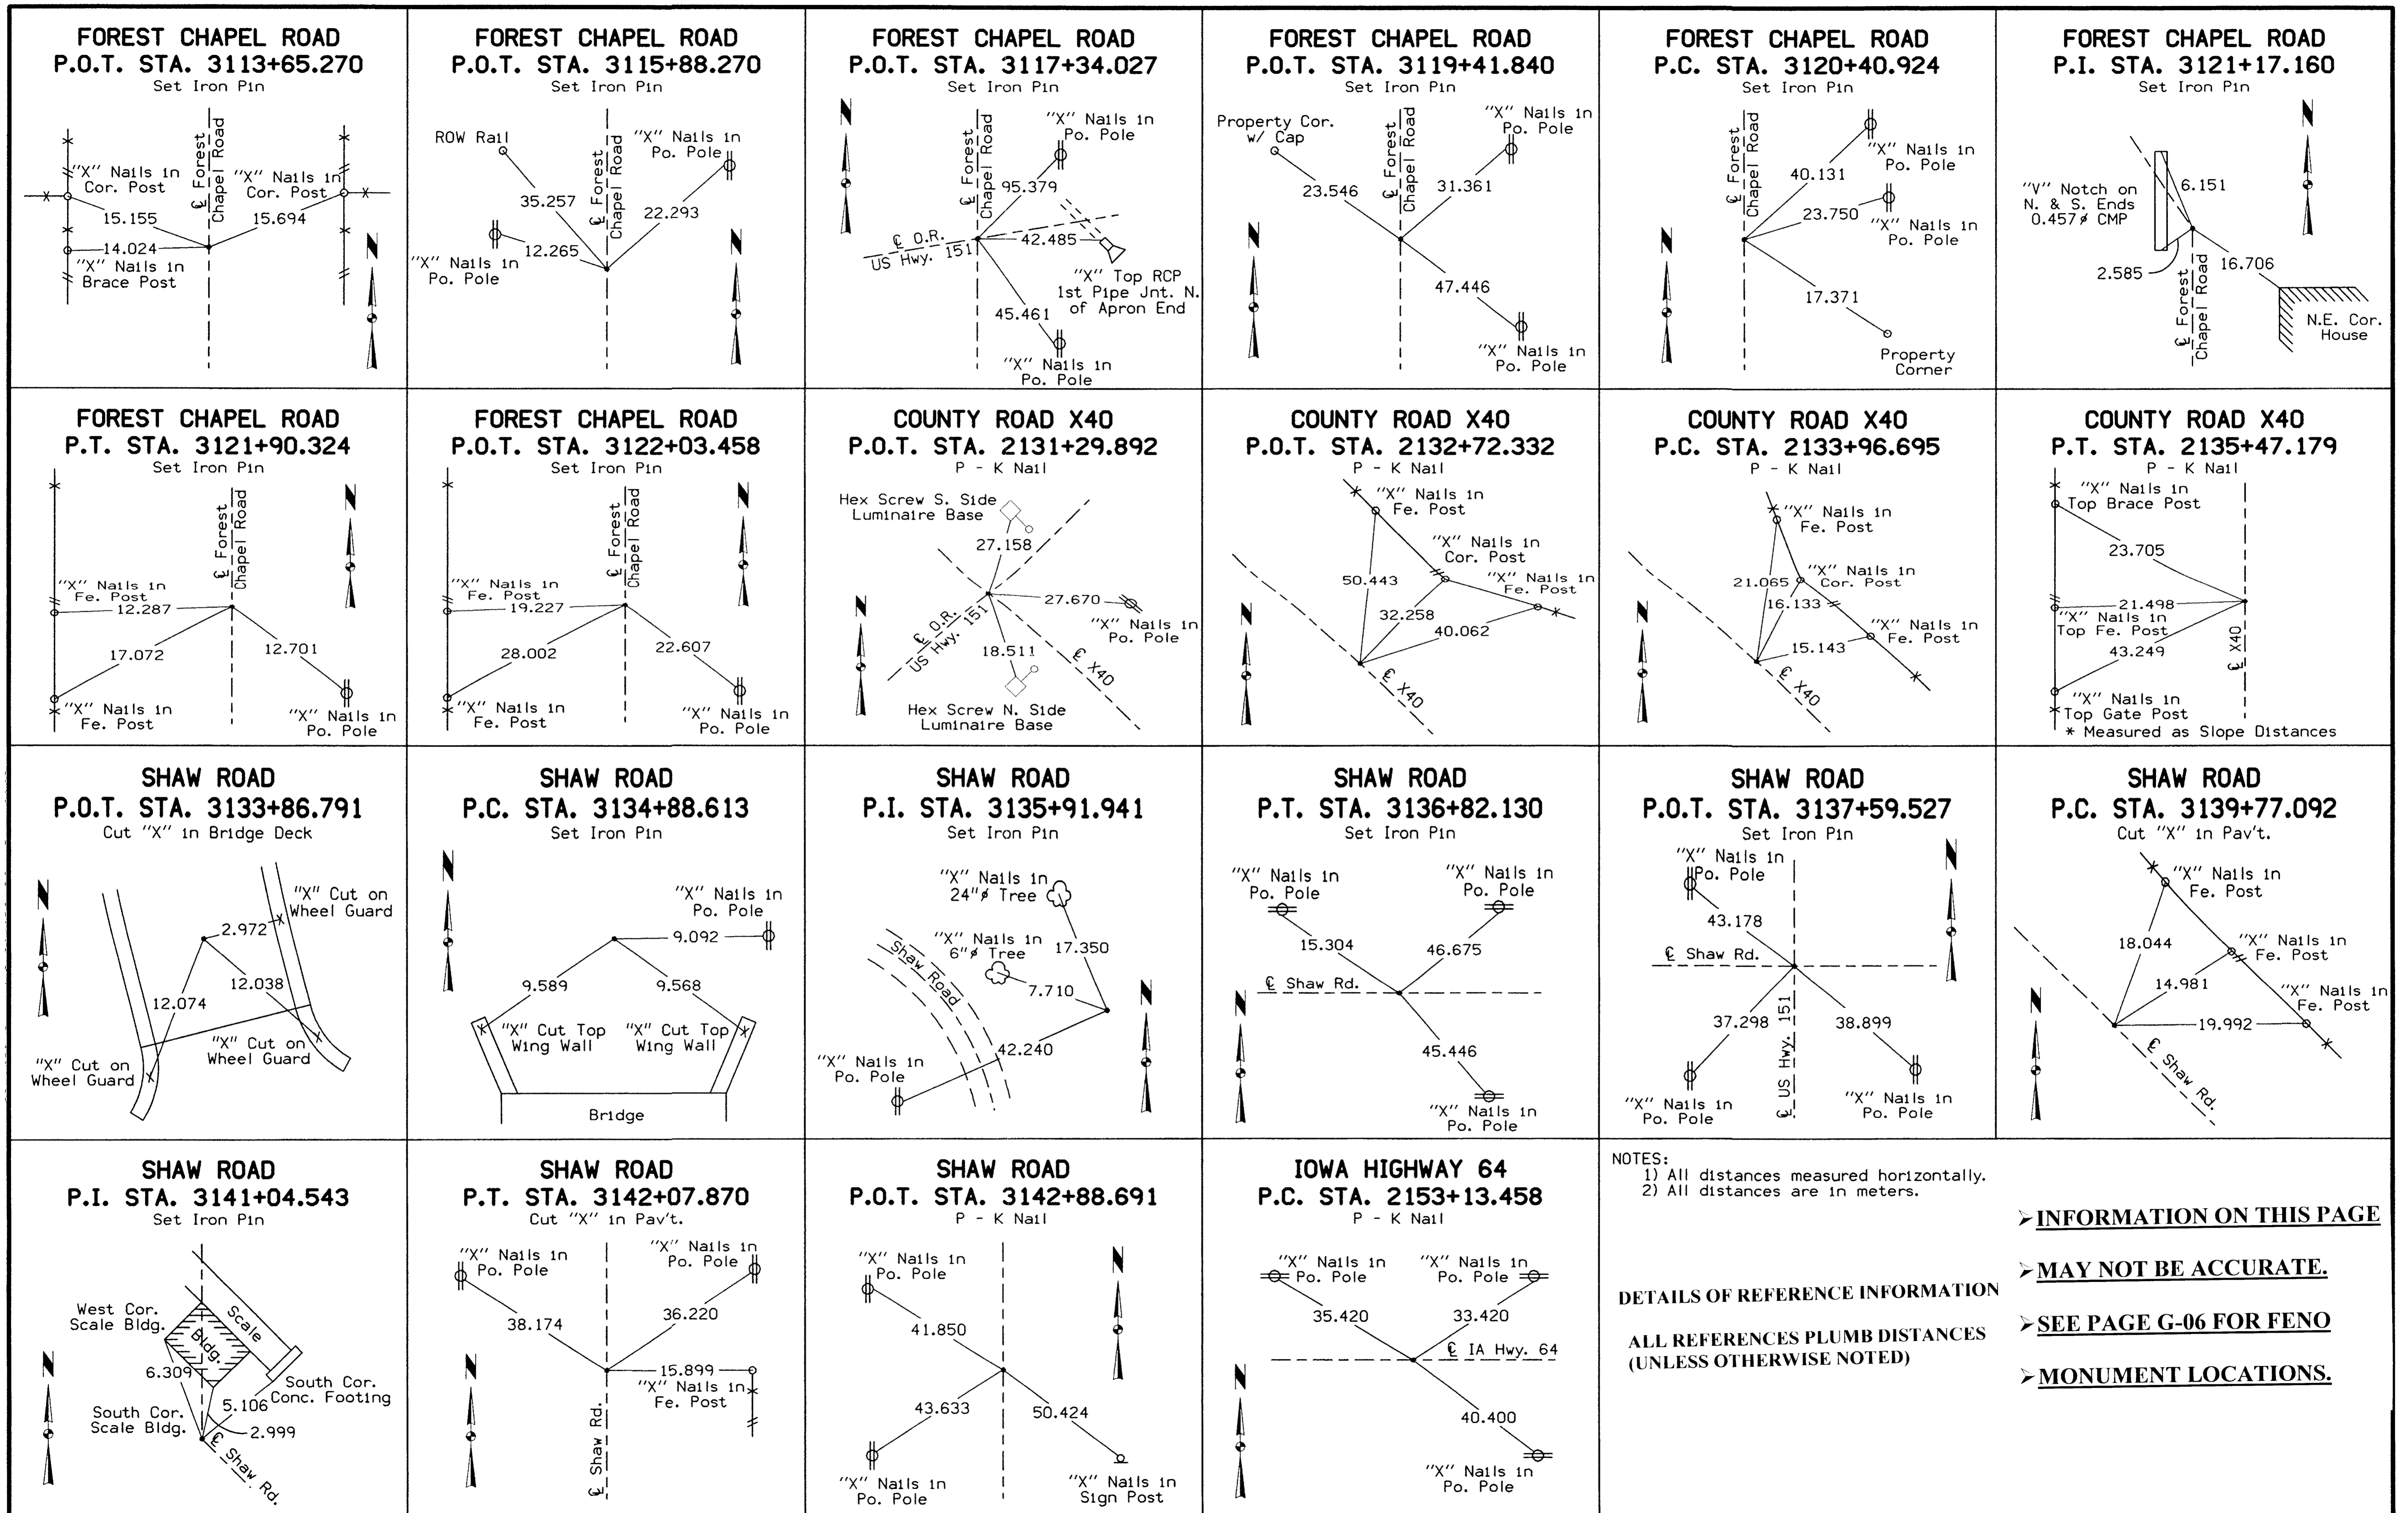

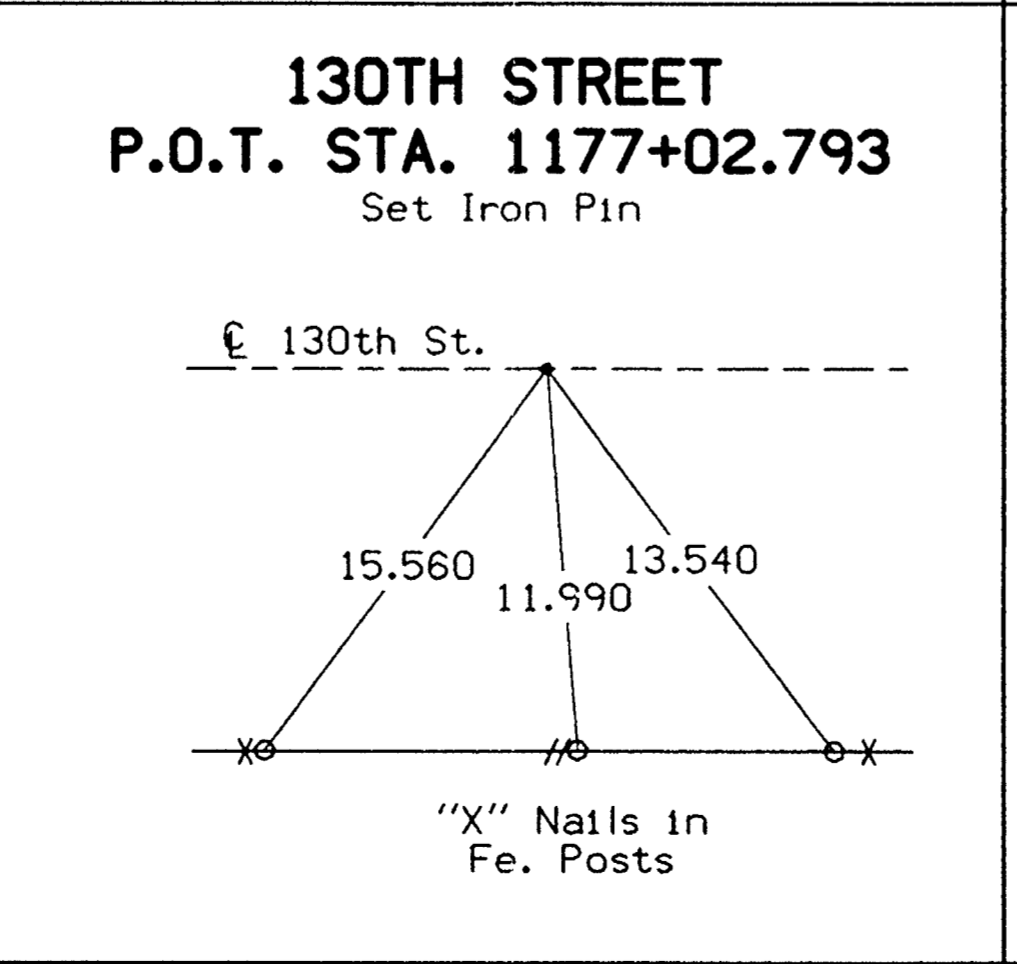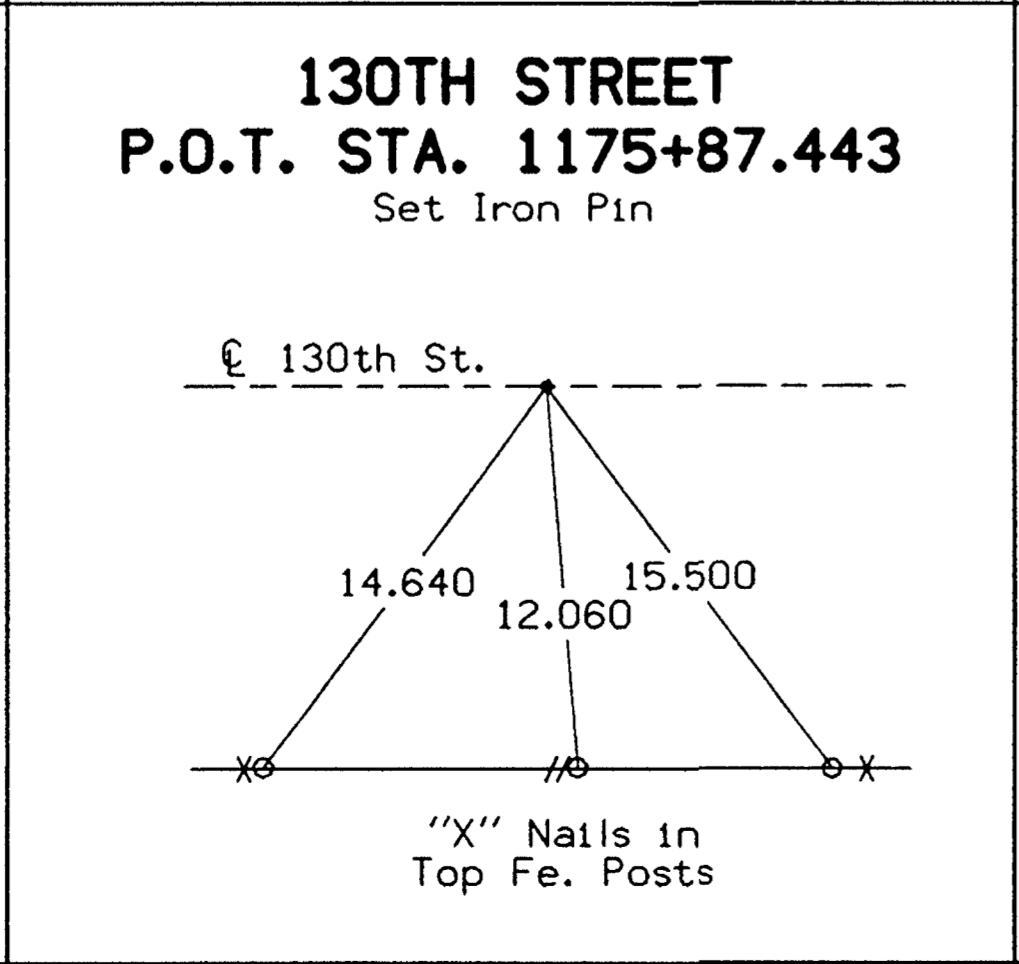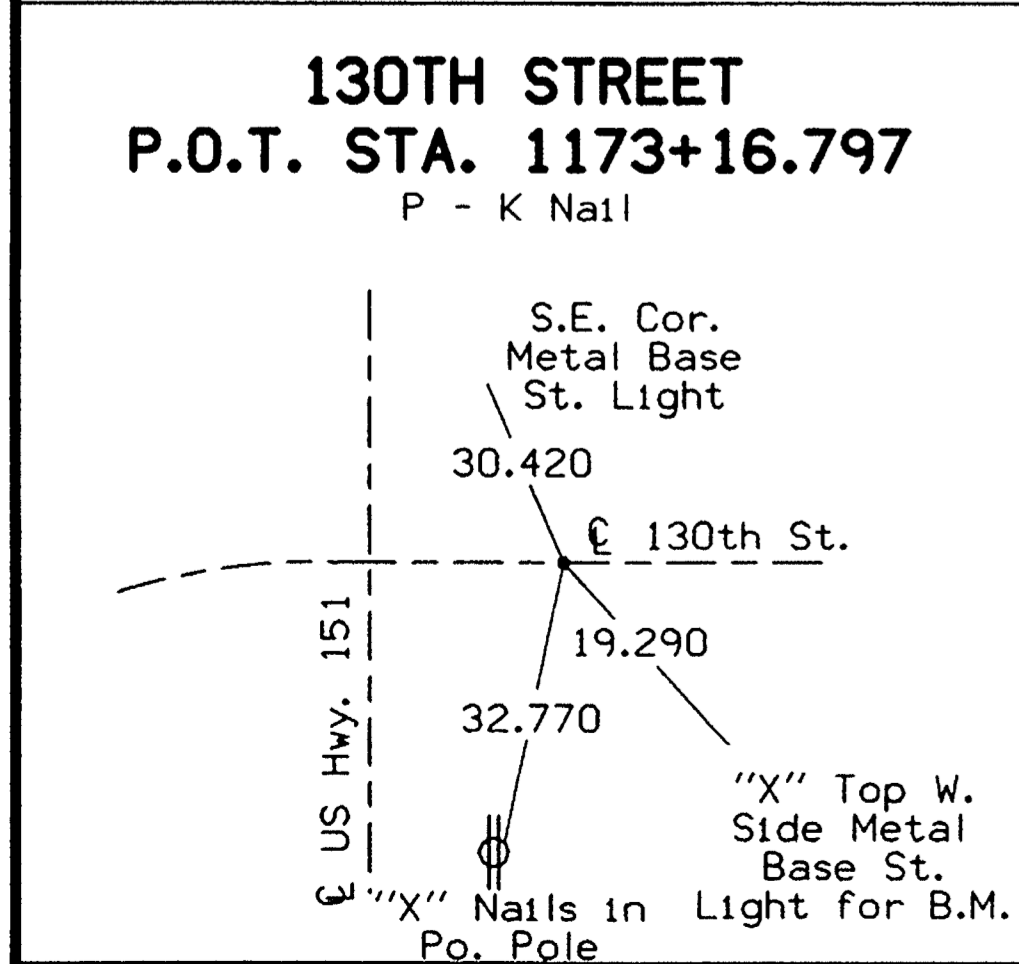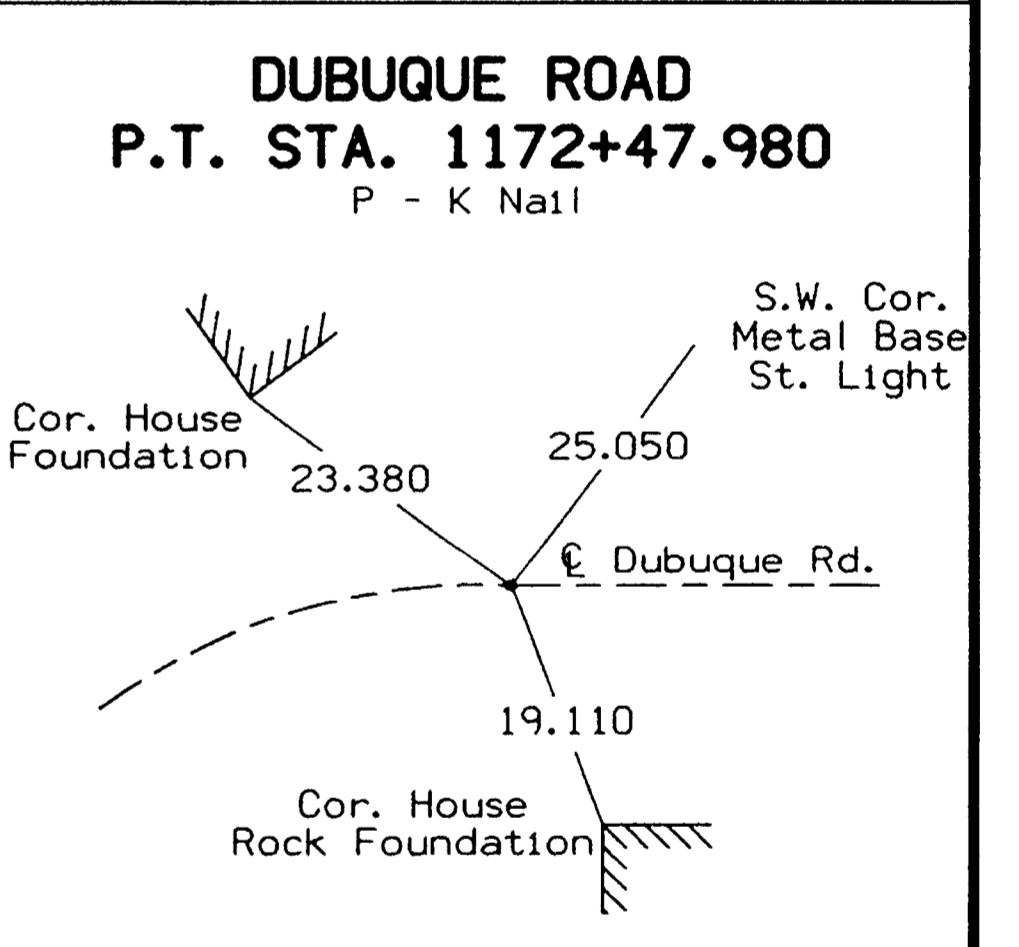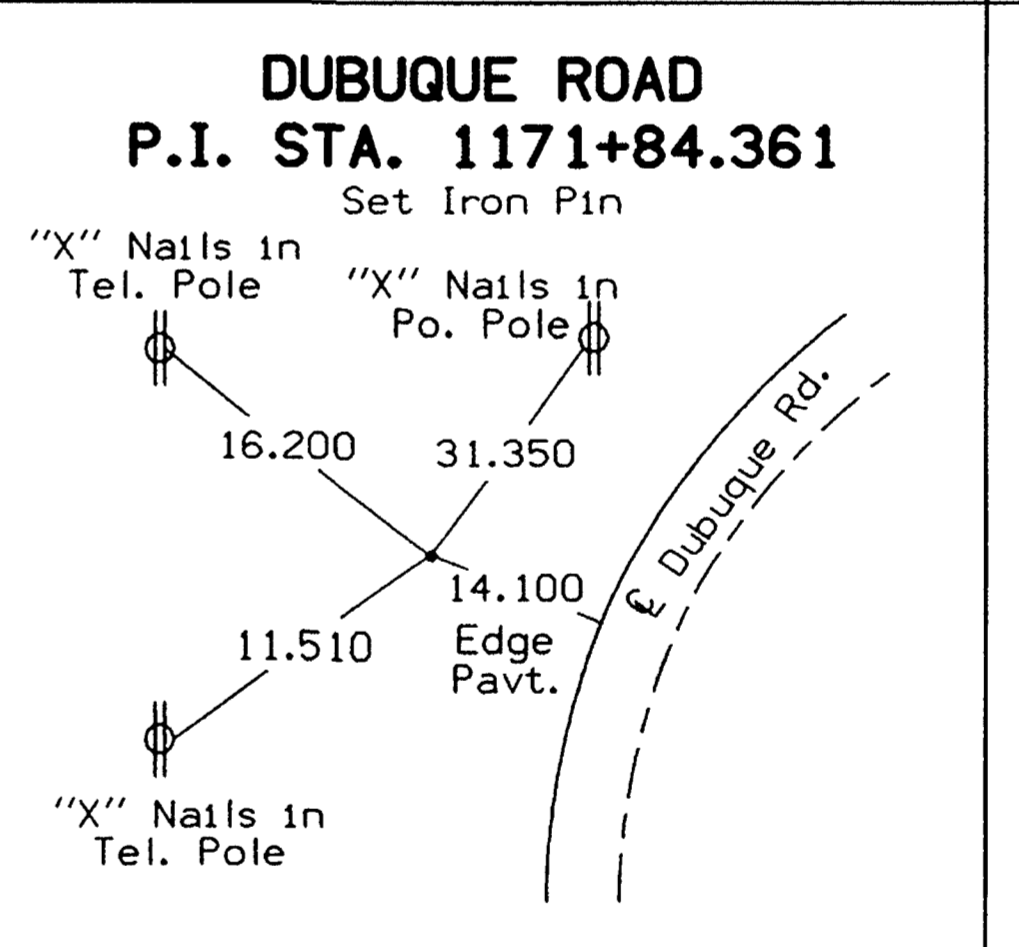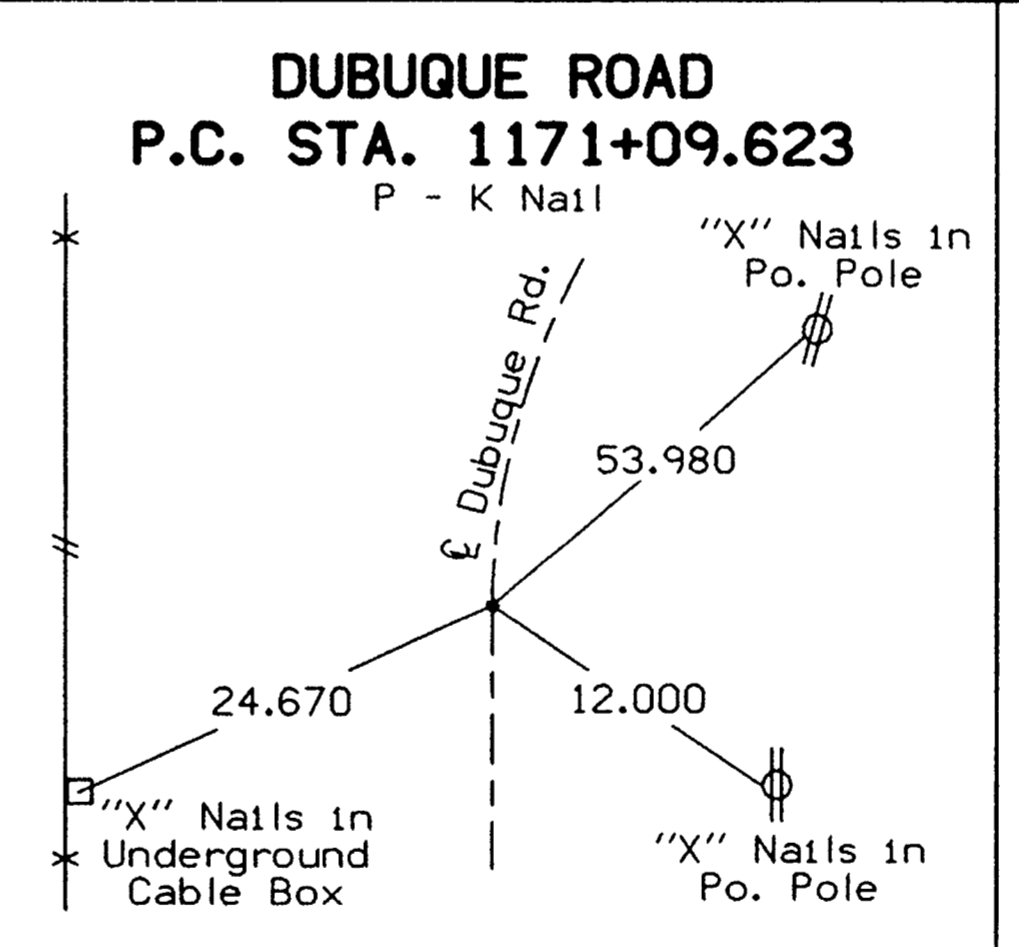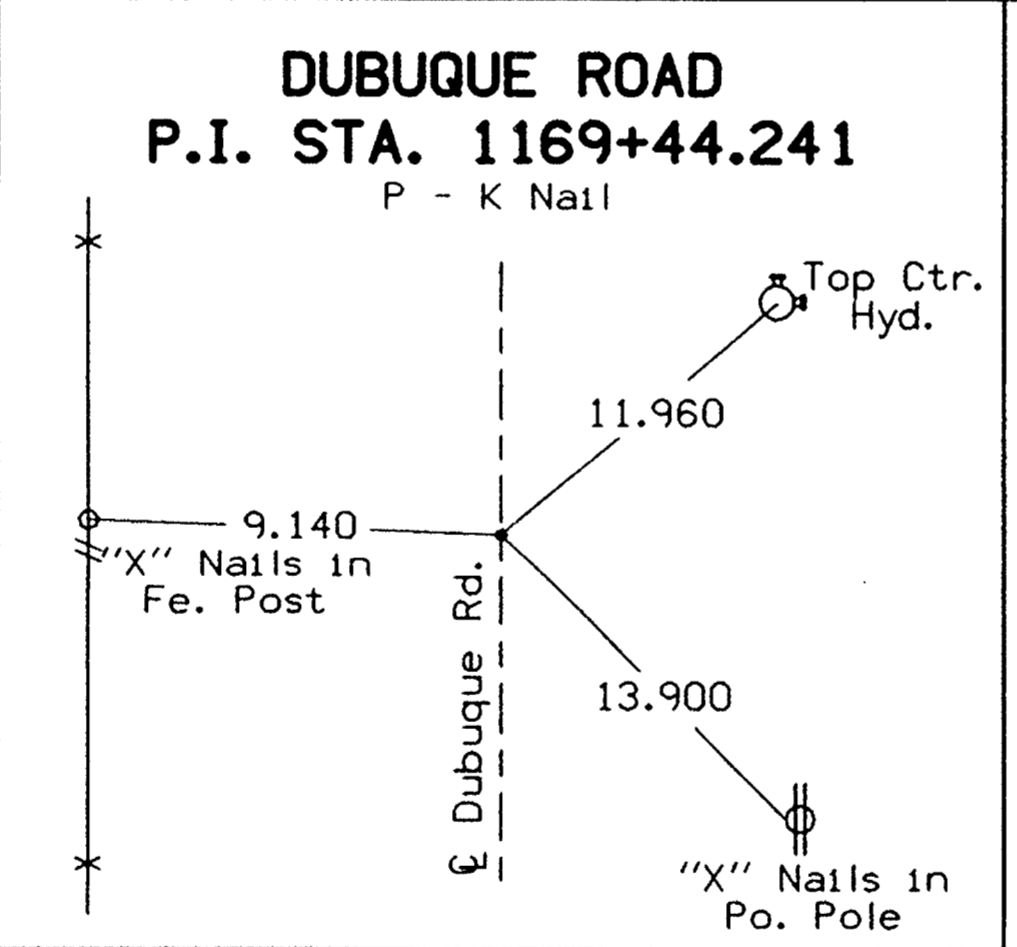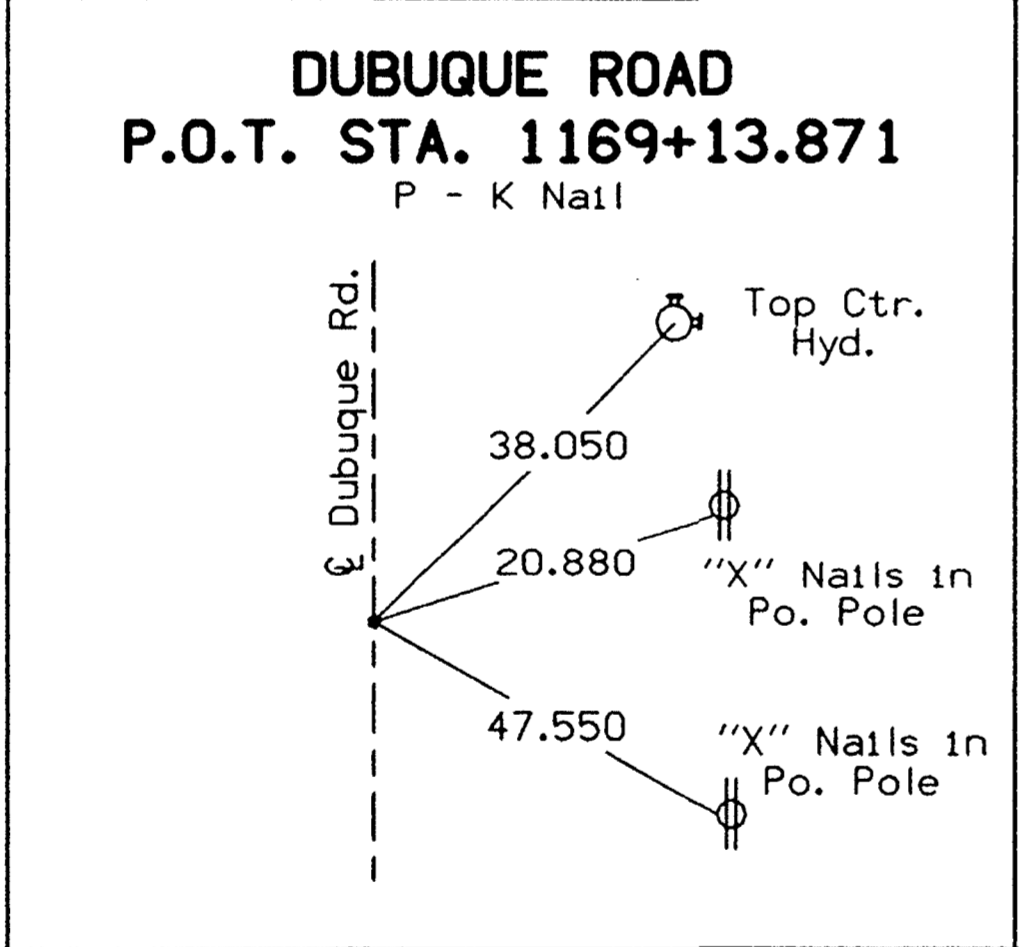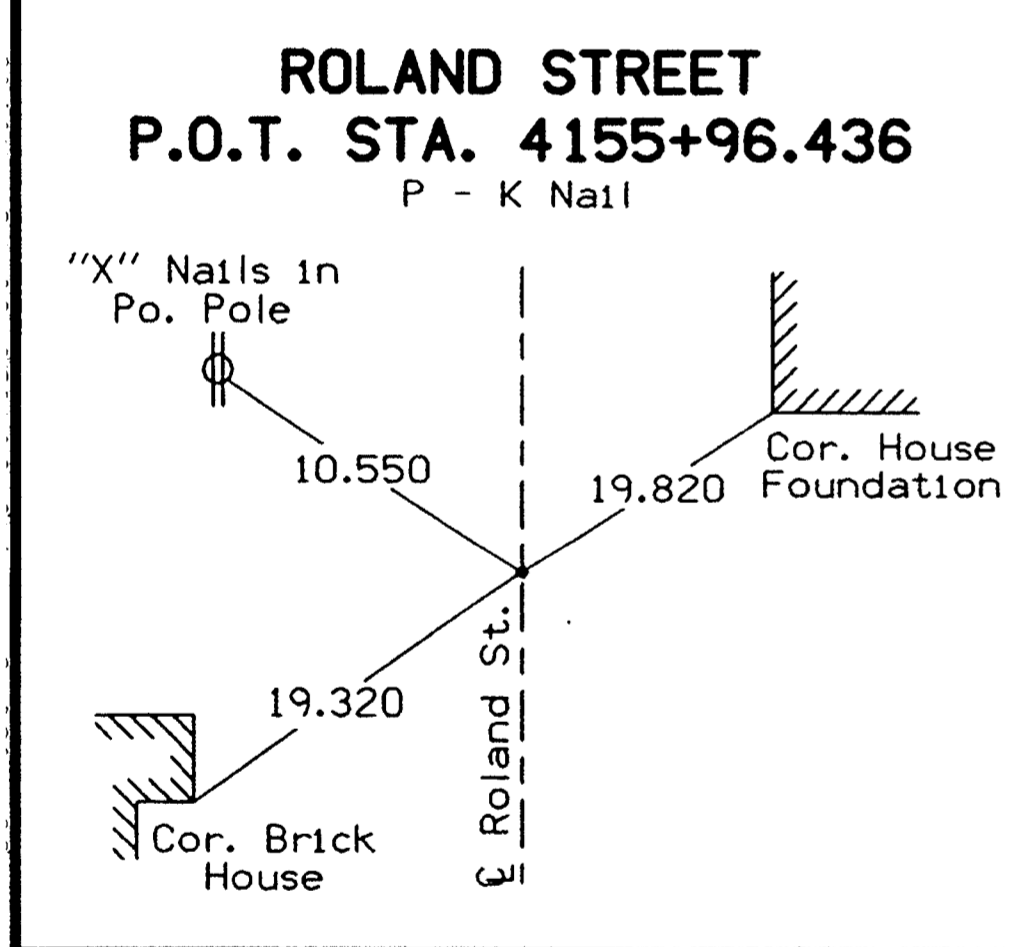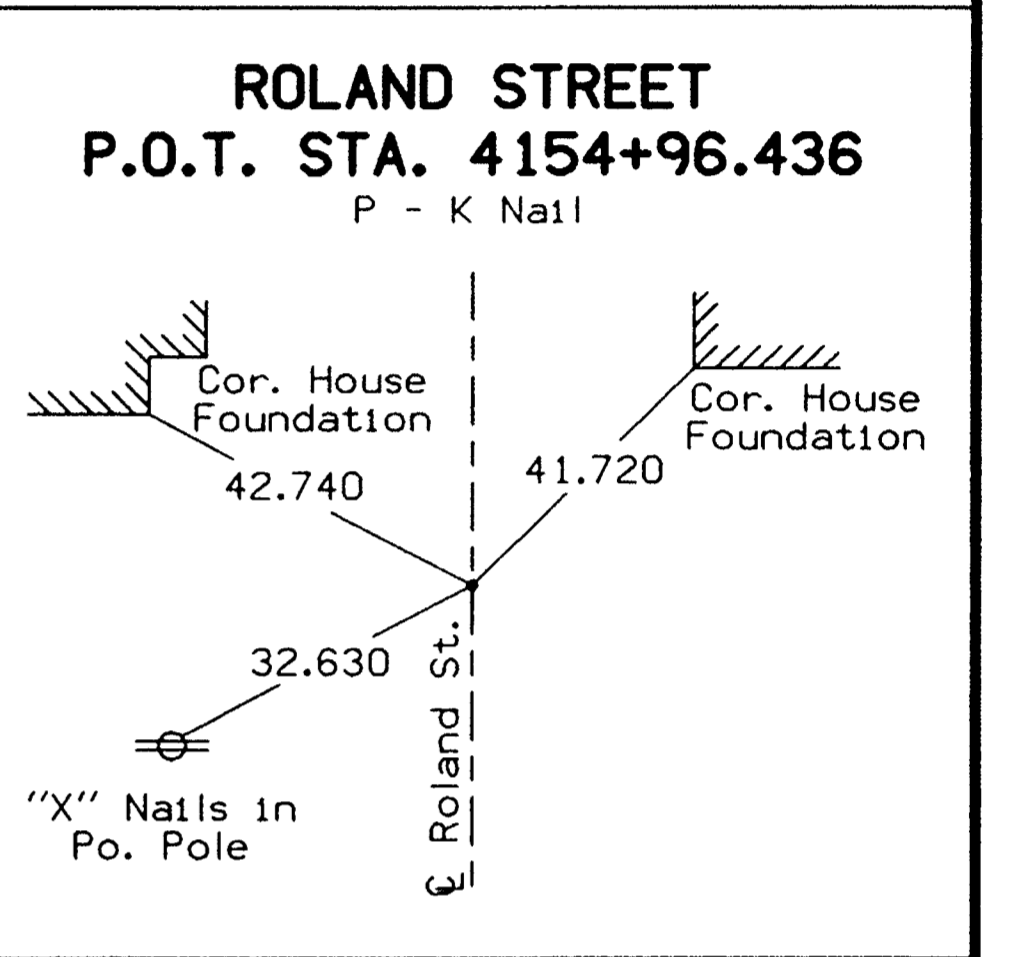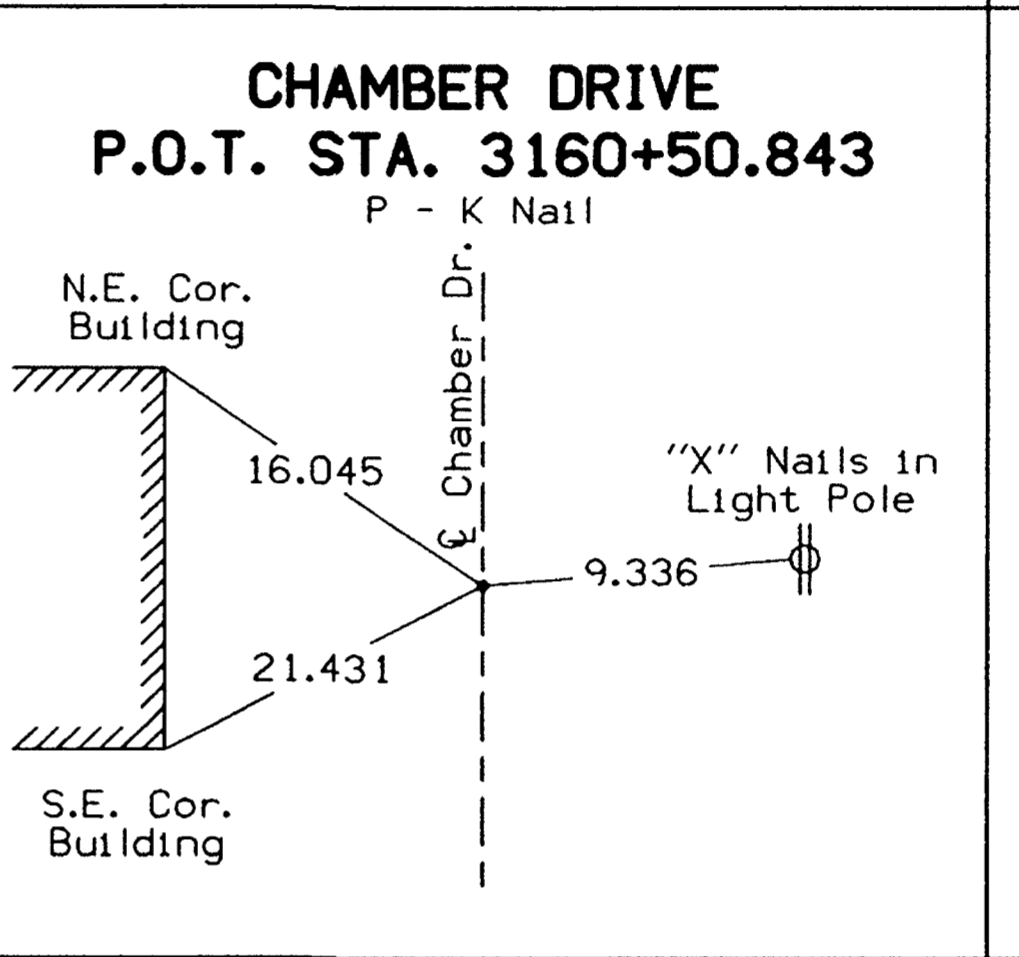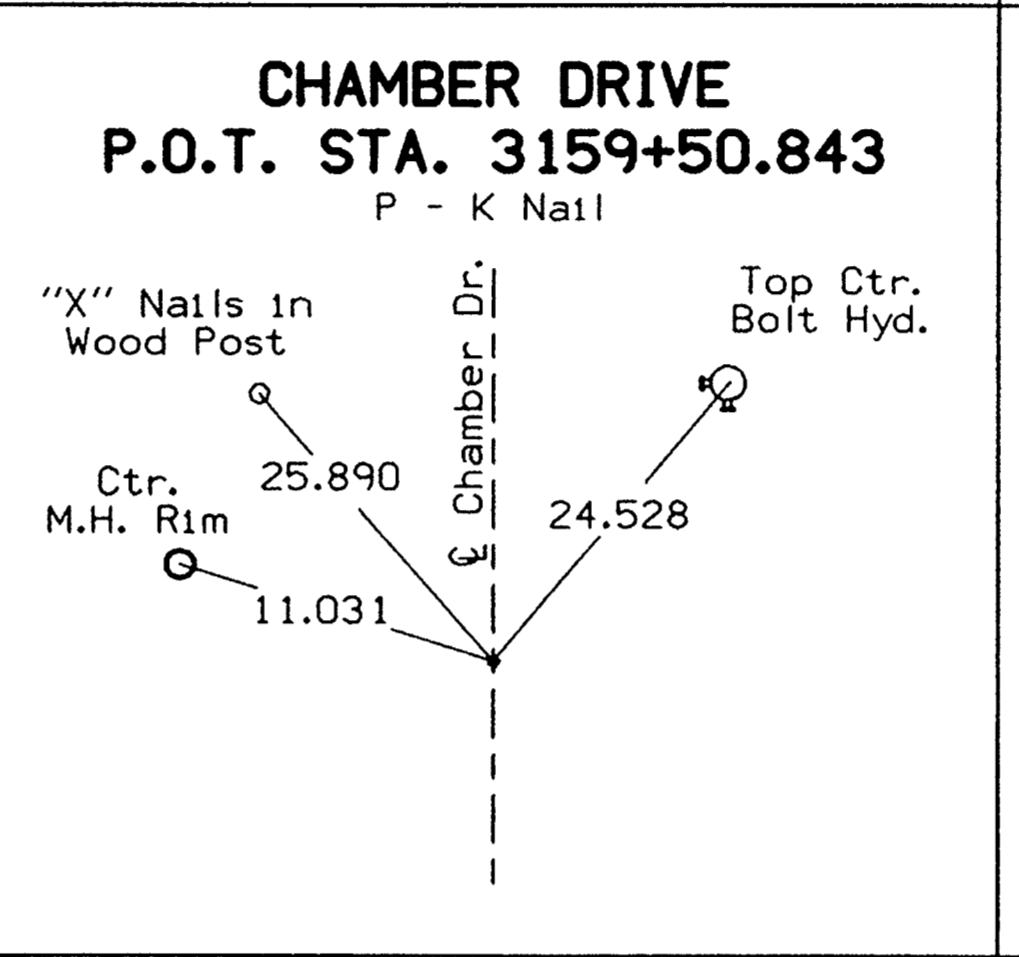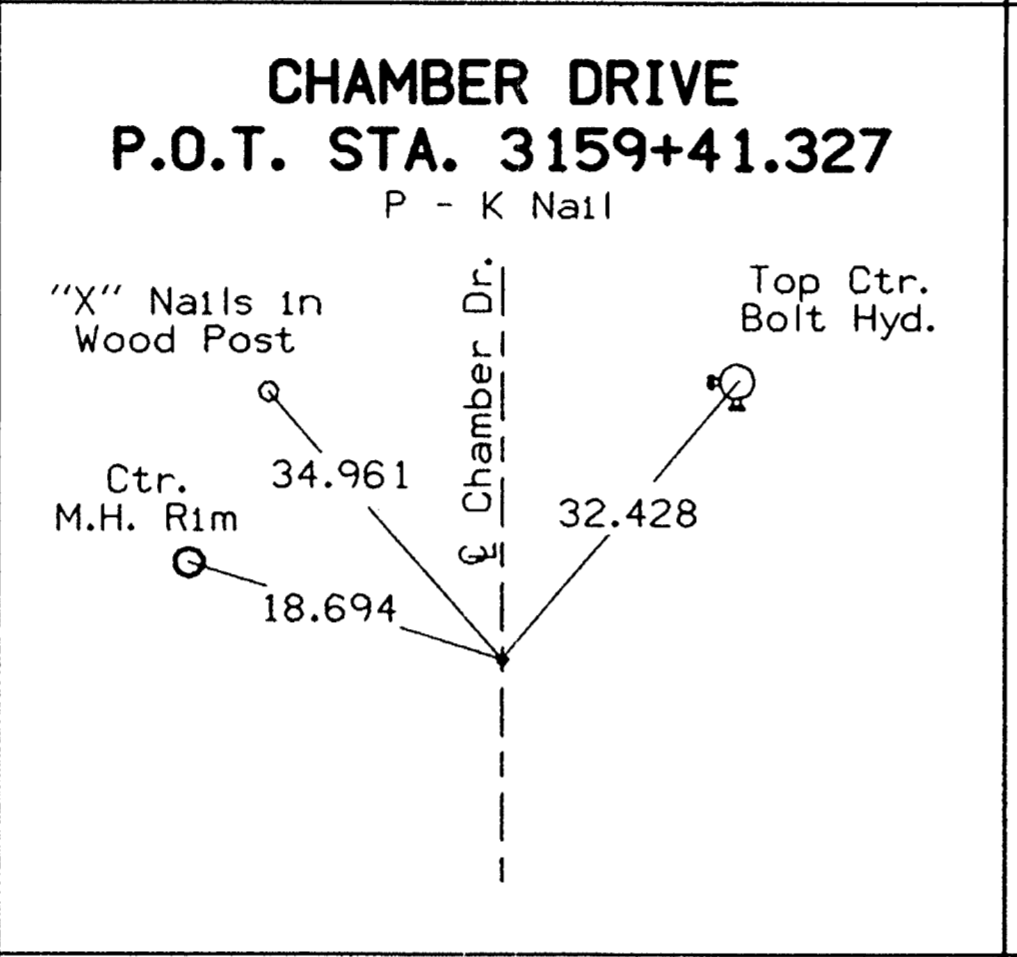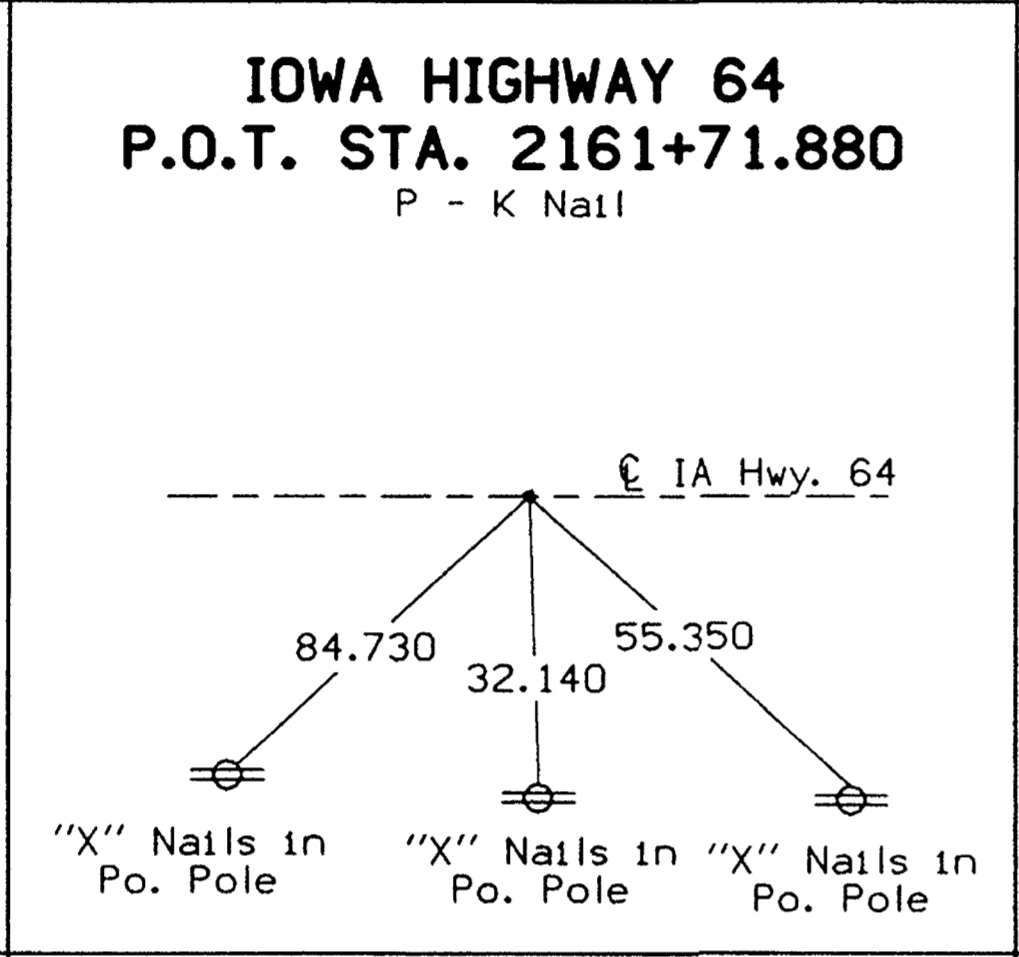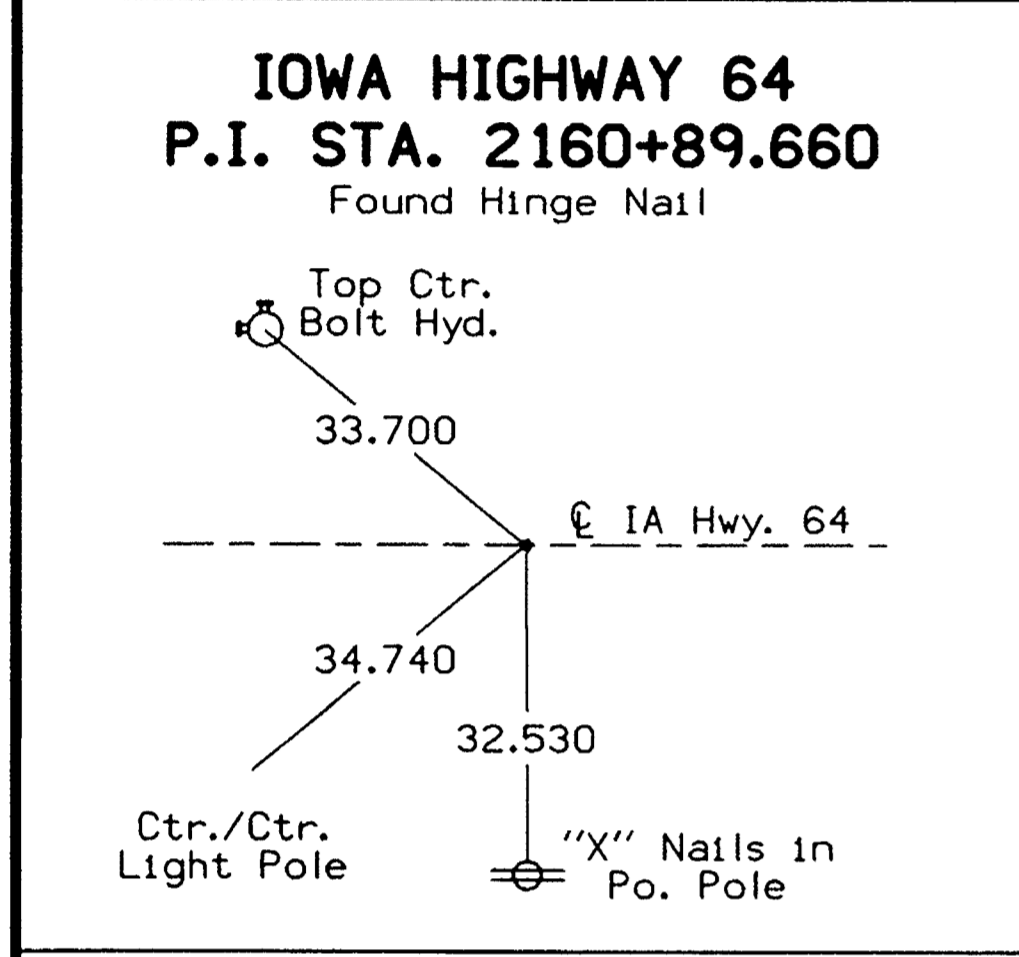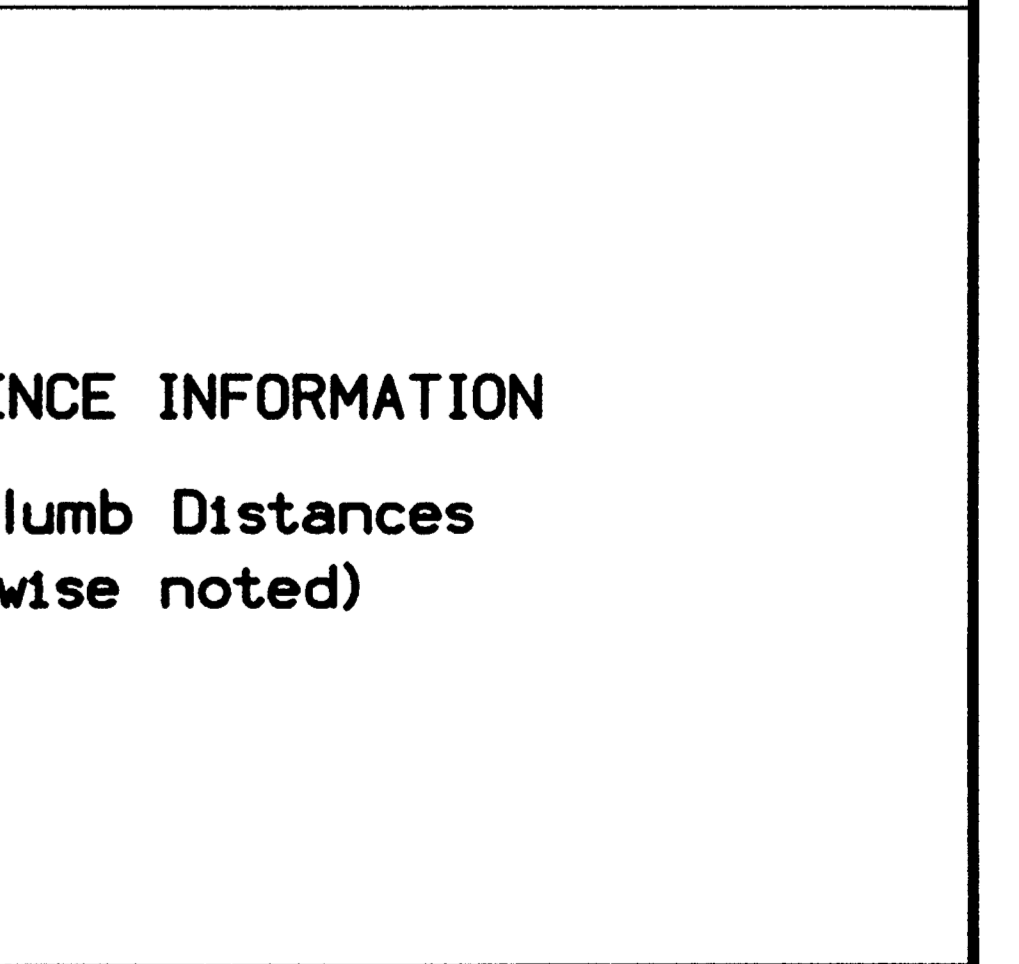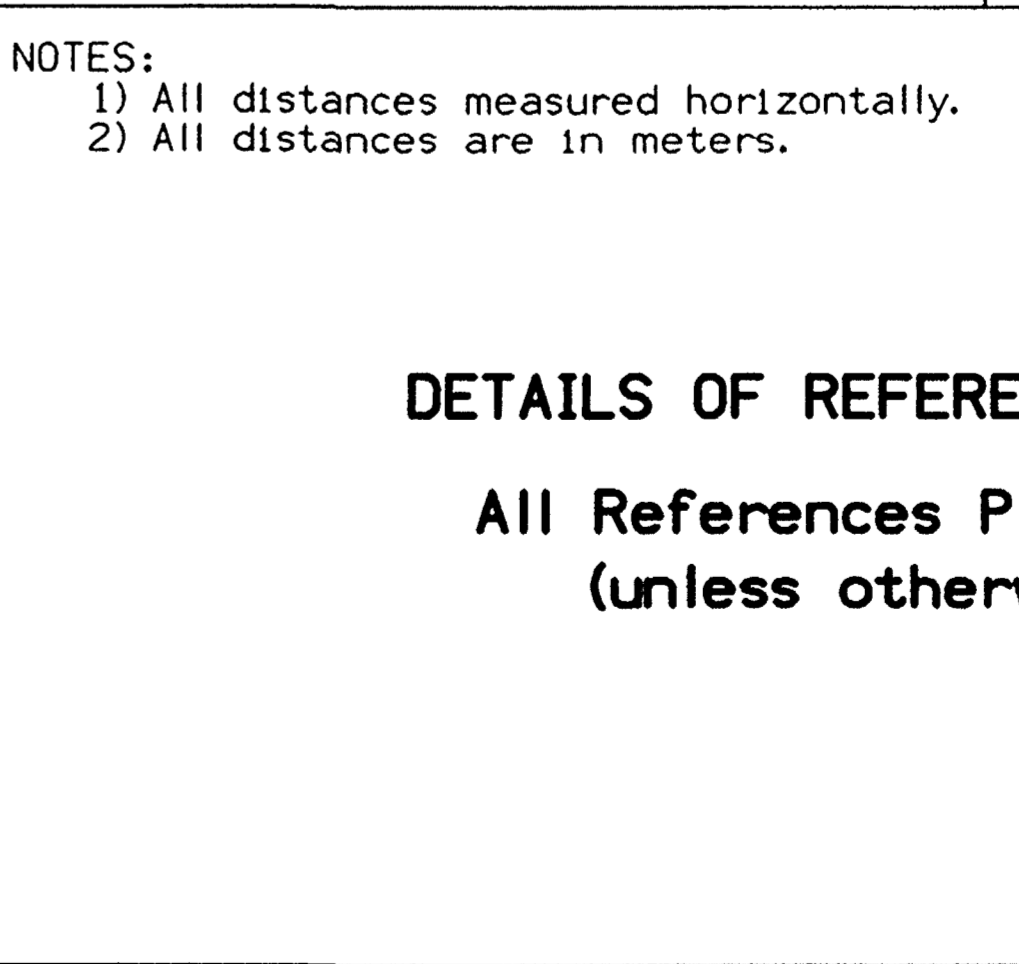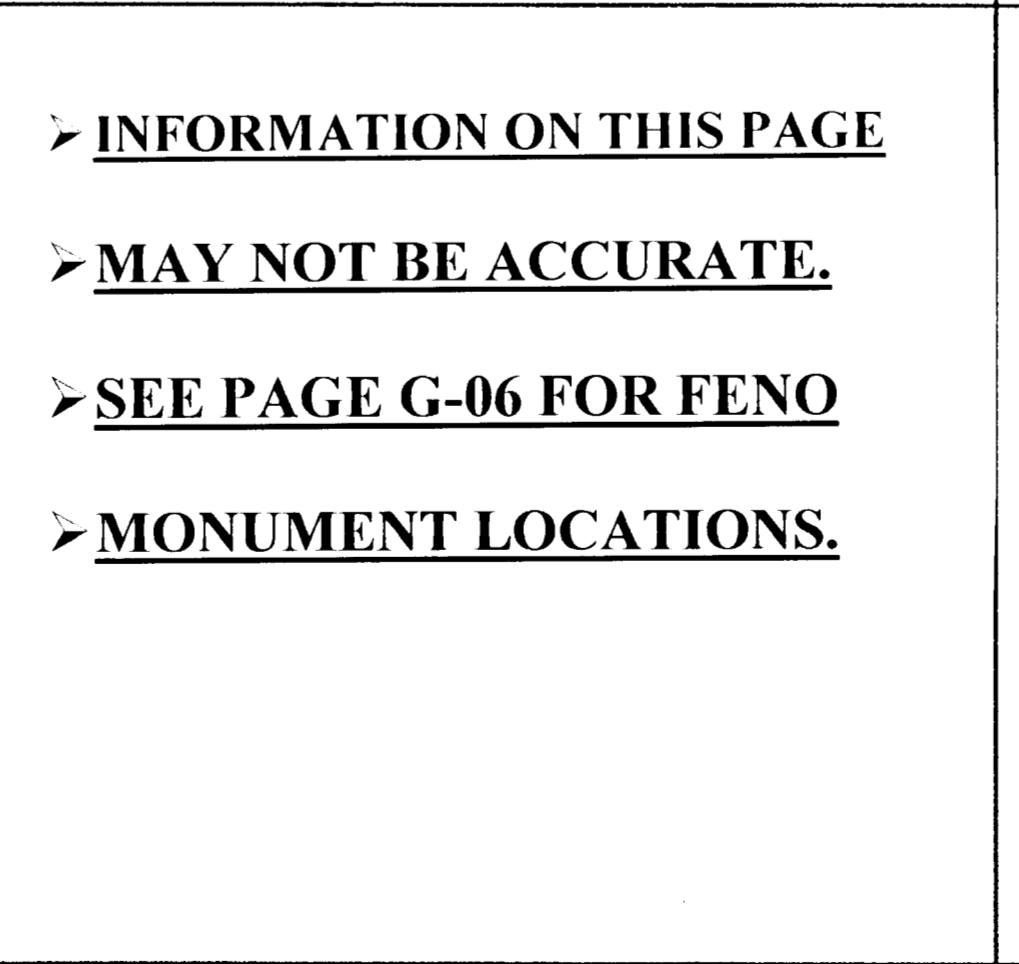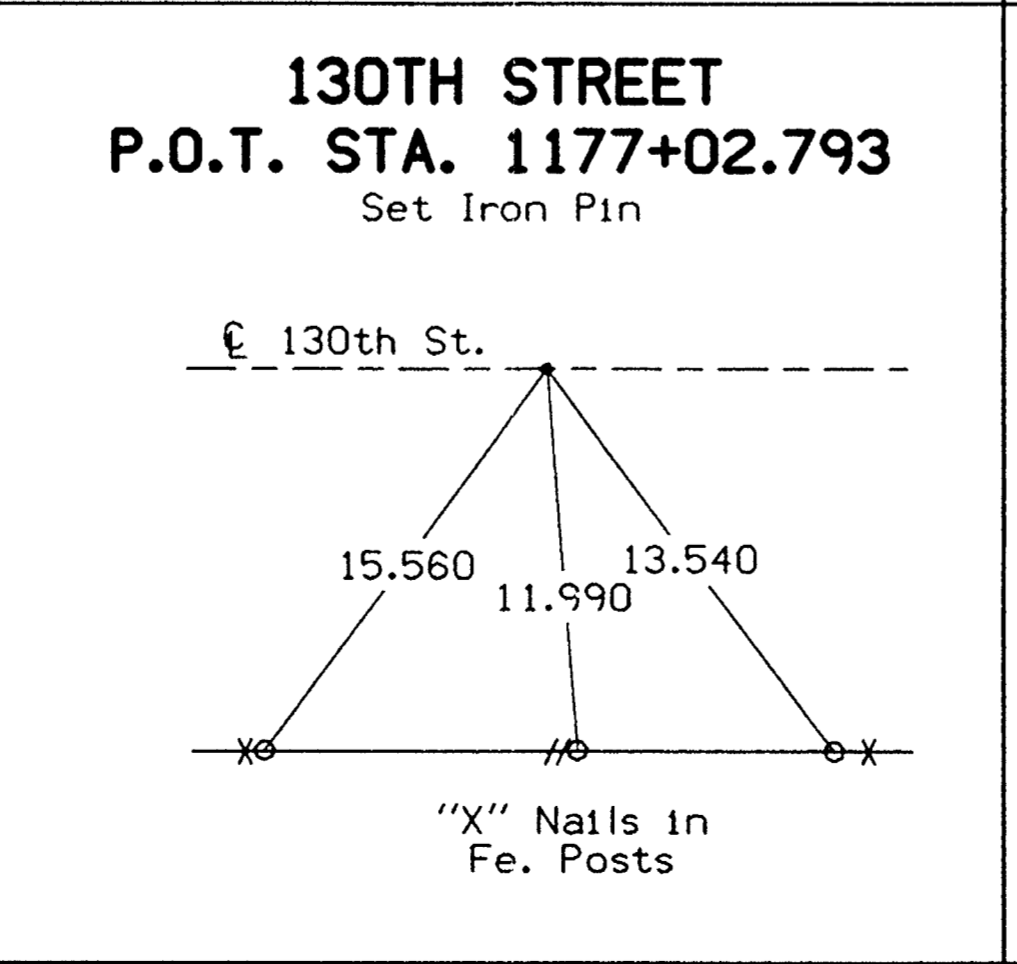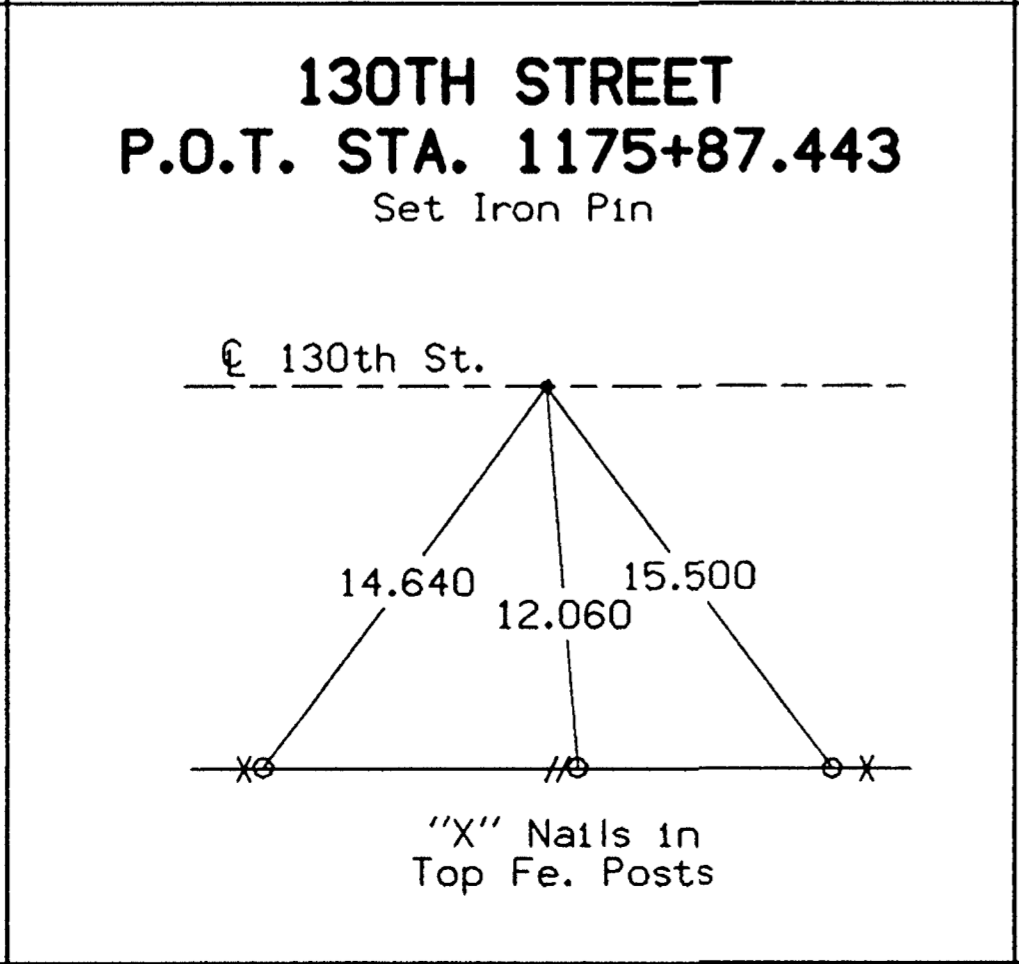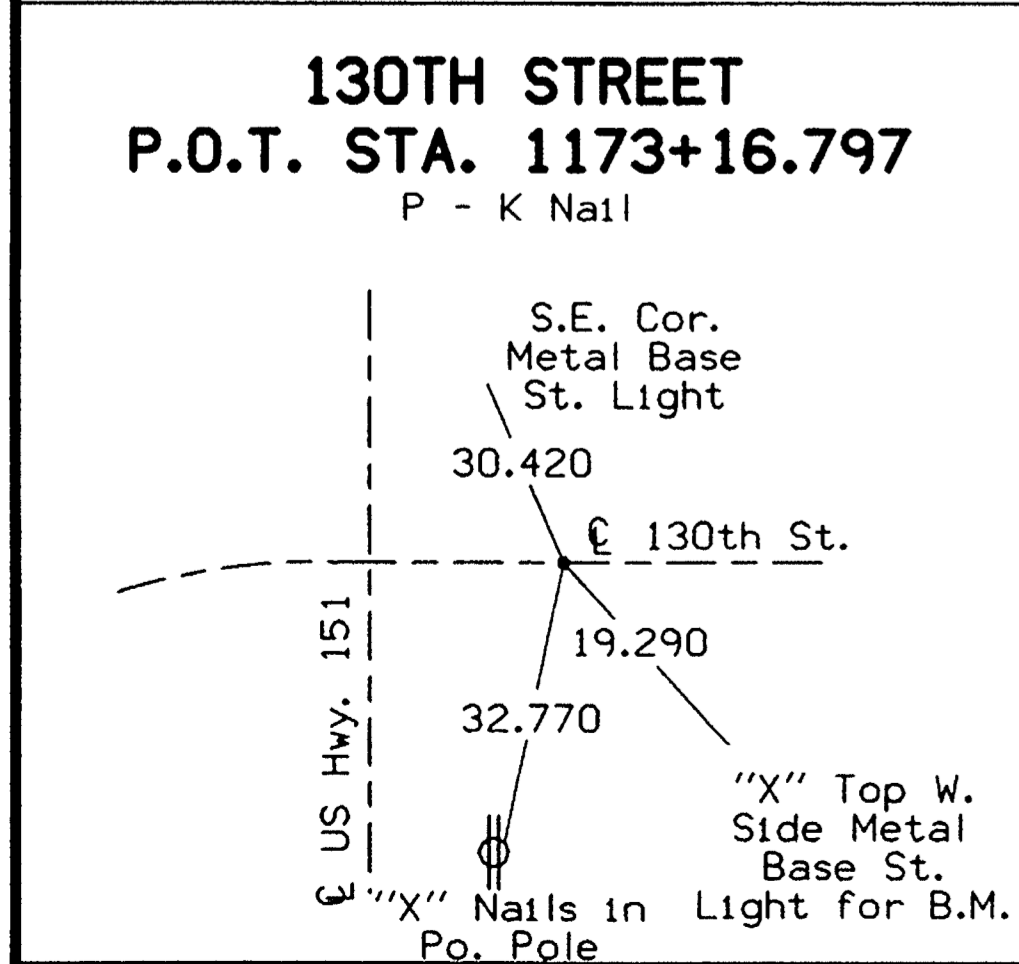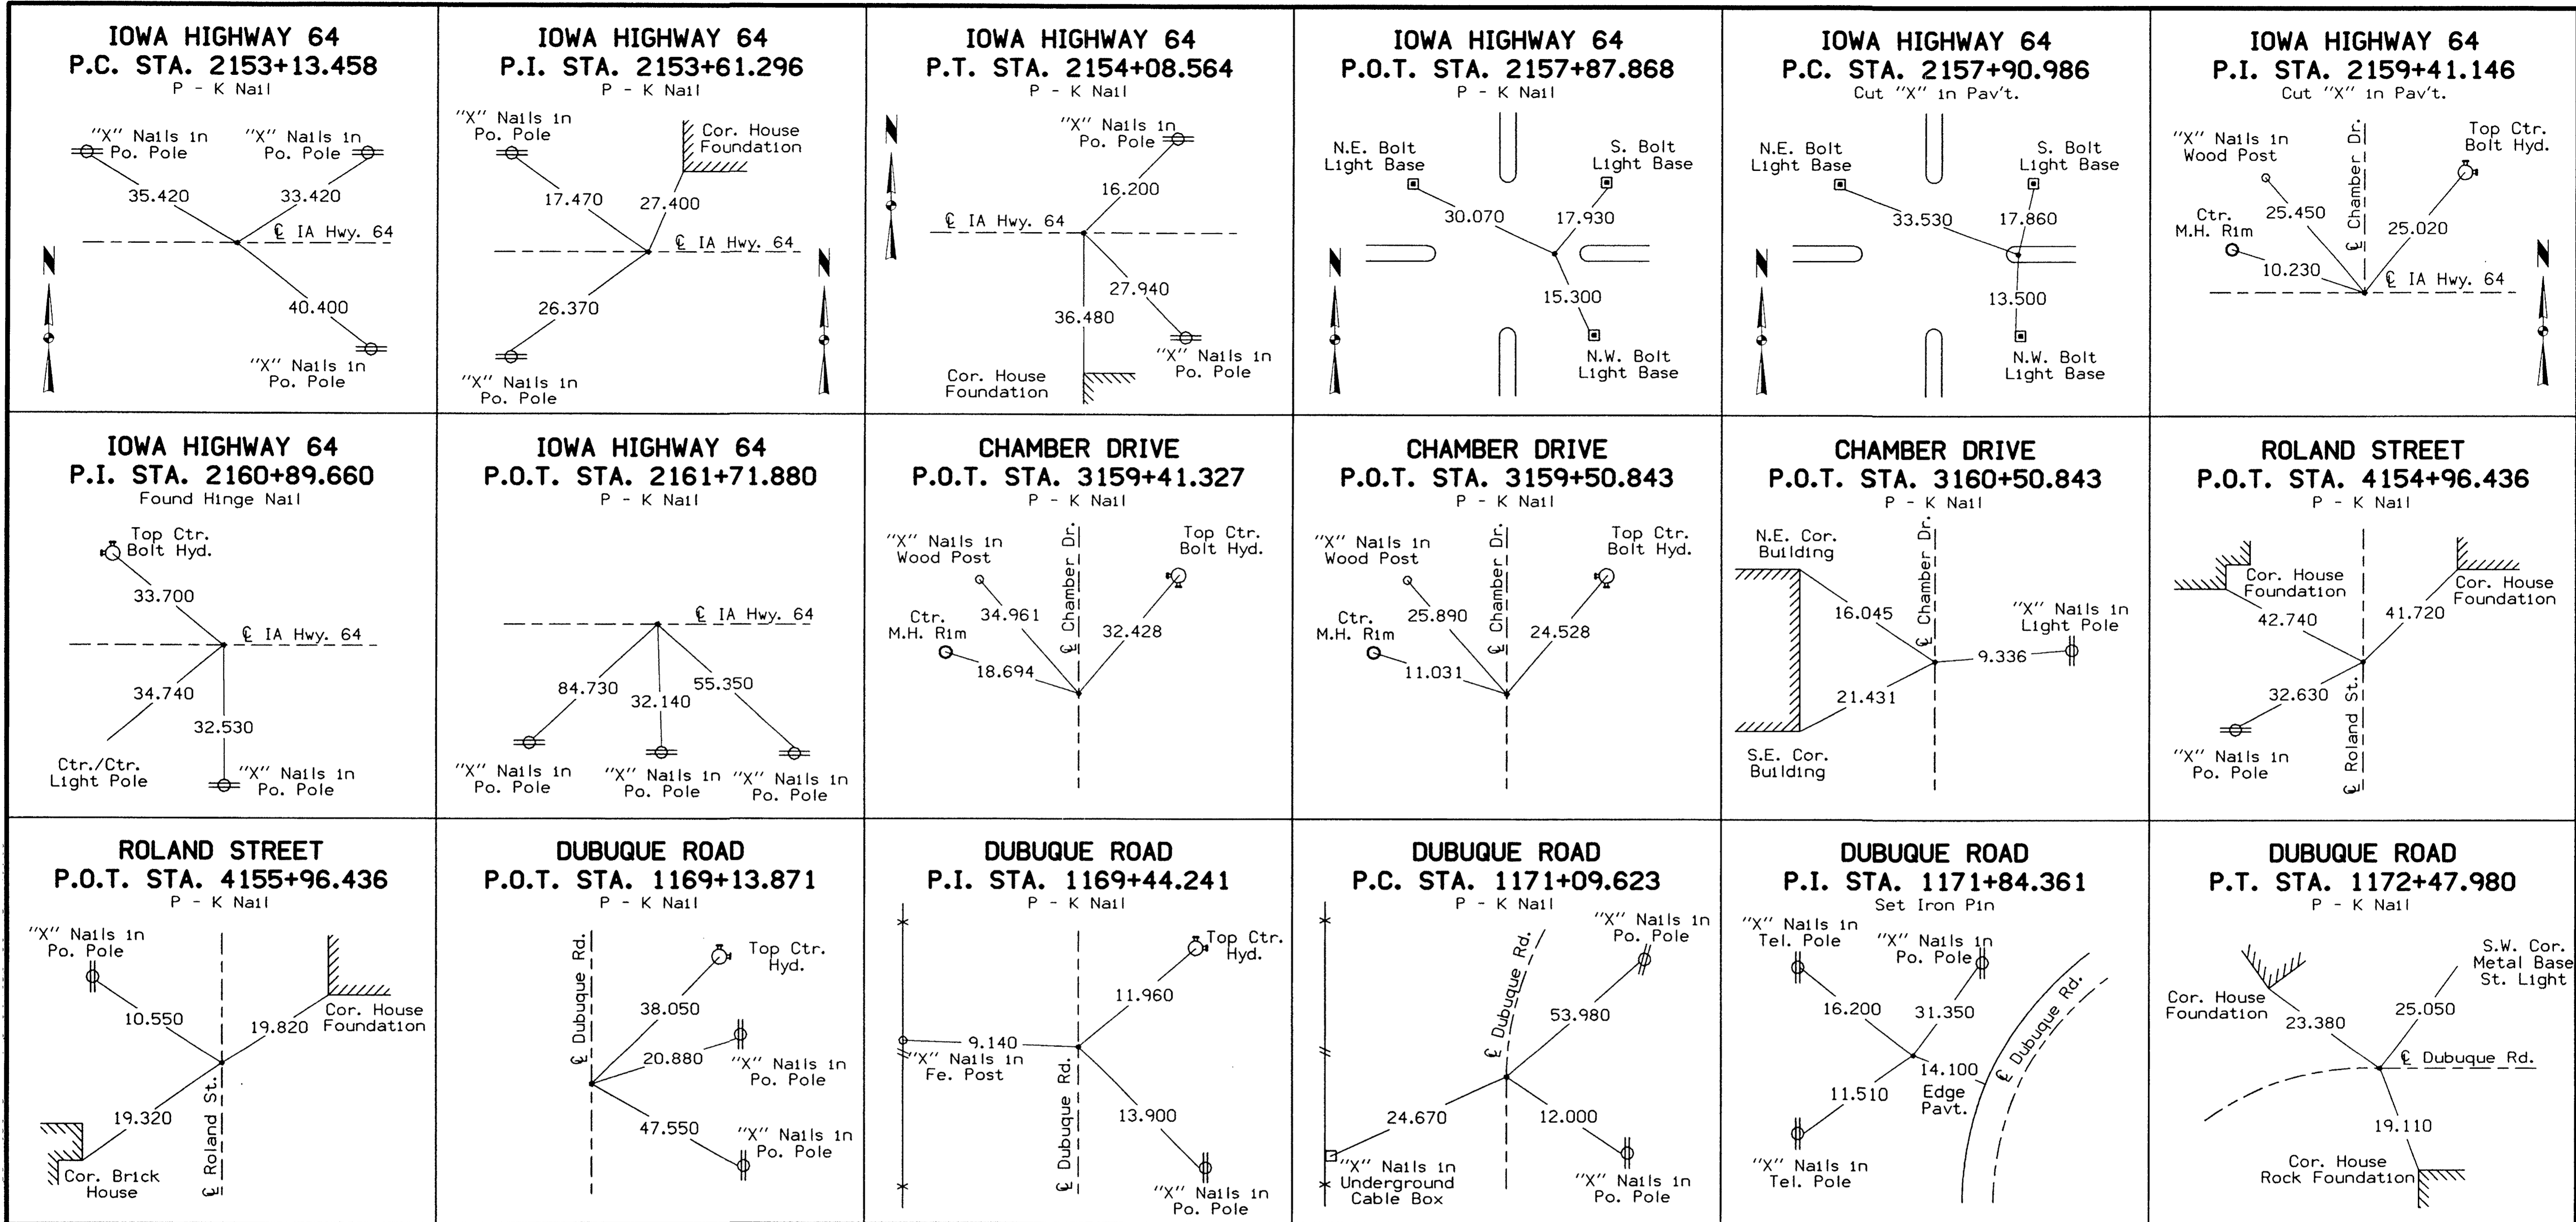

➤ **INFORMATION ON THIS PAGE**

➤ **MAY NOT BE ACCURATE.**


➤ **SEE PAGE G-06 FOR FENO**

➤ **MONUMENT LOCATIONS.**

NOTES:
1) All distances measured horizontally.
2) All distances are in meters.

DETAILS OF REFERENCE INFORMATION

All References Plumb Distances (unless otherwise noted)

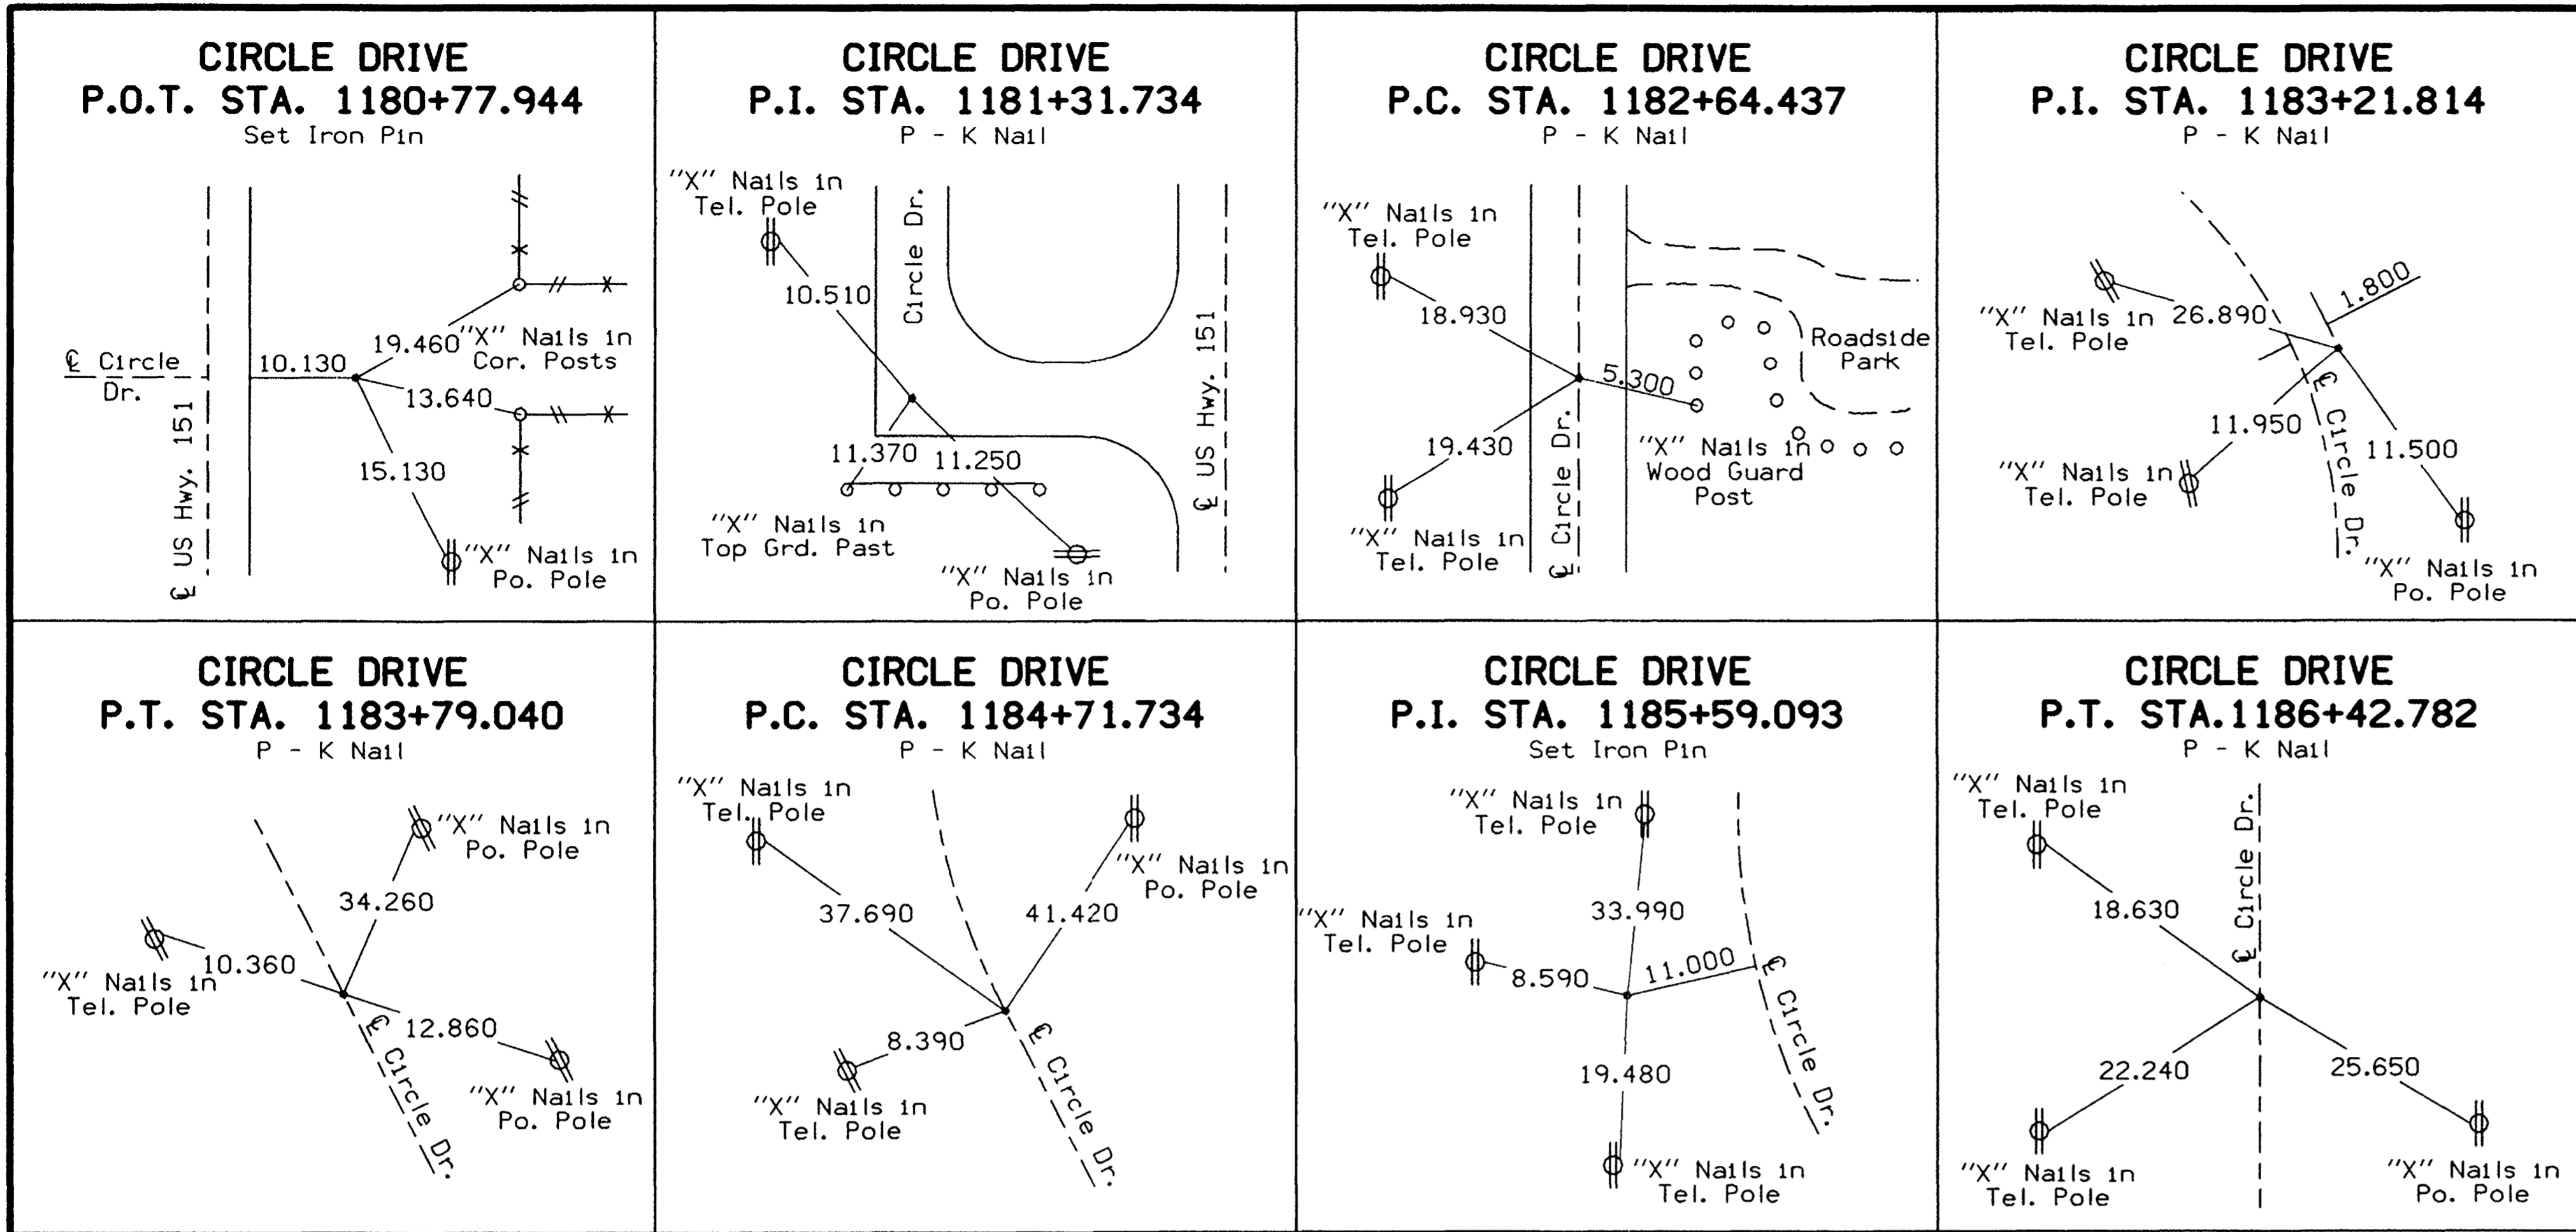

- INFORMATION ON THIS PAGE
- MAY NOT BE ACCURATE.
- SEE PAGE G-06 FOR FENO
- MONUMENT LOCATIONS.

NOTES:
 1) All distances measured horizontally.
 2) All distances are in meters.

DETAILS OF REFERENCE INFORMATION
All References Plumb Distances
(unless otherwise noted)

BENCH MARKS

- BM 1 - 60 dd Spike Corner Post, Sta. 10+40.000 38.000m Rt. - Elev. 276.472
- BM 2 - D.O.T. Plug Top Ctr. Twin R.C.B., Sta. 14+34.000 30.000m Rt. - Elev. 269.547
- BM 3 - 60 dd Spike Po.Po. @ S.W. Cor. Hwy 151 and Linn-Grove Road, Sta. 17+79.357 43.344m Rt. - Elev. 271.706
- BM 4 - 60 dd Spike Corner Post, Sta. 22+27.922 51.806m Rt. - Elev. 280.483
- BM 5 - 60 dd Spike Po.Po., Sta. 24+47.813 38.228m Rt. - Elev. 280.840
- BM 6 - Top D.O.T. R-O-W Pin, Sta. 27+28.208 37.20m Rt. - Elev. 279.013
- BM 7 - 60 dd Spike Po.Po., Sta. 31+78.000 36.000m Rt. - Elev. 283.949
- BM 8 - 60 dd Spike Po.Po., Sta. 35+03.577 33.353m Rt. - Elev. 284.521
- BM 9 - 60 dd Spike Po.Po., Sta. 36+79.123 32.263m Rt. - Elev. 285.652
- BM 10 - Top D.O.T. Ref. Pt. Pin @ S.E. Cor. Hwy 151 & Quaker Lane, Sta. 39+55.257 37.574m Rt. - Elev. 284.850
- BM 11 - Top D.O.T. R-O-W Pin, Sta. 43+57.127 39.911m Rt. - Elev. 285.946
- BM 12 - Top D.O.T. R-O-W Pin, Sta. 46+73.989 38.433m Rt. - Elev. 286.389
- BM 13 - 60 dd Spike Po.Po. @ S.E. Cor. Hwy 151 and Co. Rd. X-28, Sta. 52+07.907 44.456m Rt. - Elev. 288.328
- BM 14 - 60 dd Spike Po.Po., Sta. 55+62.677 38.400m Rt. - Elev. 286.364
- BM 15 - 60 dd Spike Po.Po., Sta. 58+60.256 37.899m Rt. - Elev. 283.131
- BM 16 - 60 dd Spike Po.Po., Sta. 61+70.502 38.330m Rt. - Elev. 279.926
- BM 17 - "X" Cut Top South End West Pipe of Twin 48" R.C.P., Sta. 65+70.801 27.284m Rt. - Elev. 277.363
- BM 18 - Top Cap G.P.S. Pt. #5, Sta. 68+07.000 24.390m Rt. - Elev. 277.905
- BM 19 - "X" Cut N.W. Cor. Conc. Mail Box Pad for Subdivision, Sta. 71+70.000 40.000m Rt. - Elev. 278.240
- BM 20 - Fnd "X" Cut on S. Hdwl for 42" R.C.P., Sta. 74+50.000 40.000m Rt. - Elev. 280.453
- BM 21 - "X" Cut on Top 24" Lt. Base @ S.E. Cor. Hwy 151 & Hwy 1, Sta. 75+95.947 28.954m Rt. - Elev. 283.607
- BM 22 - 60 dd Spike Po.Po. @ S.W. Cor. Hwy 151 and 230th Ave., Sta. 79+90.000 30.000m Rt. - Elev. 290.258
- BM 23 - 60 dd Spike Cor. Post, Sta. 84+01.087 53.000m Rt. - Elev. 284.085
- BM 24 - 60 dd Spike Cor. Post @ S.W. Cor. Hwy 151 and 228th Ave., Sta. 86+80.000 60.000m Rt. - Elev. 286.329
- BM 25 - 60 dd Spike Po.Po., Sta. 89+60.000 59.000m Lt. - Elev. 283.305
- BM 26 - 60 dd Spike Po.Po., Sta. 92+86.797 67.027m Lt. - Elev. 285.351
- BM 27 - 60 dd Spike West Wood Gate Post, Sta. 95+56.469 54.437m Rt. - Elev. 284.700
- BM 28 - 60 dd Spike Cor. Post, Sta. 100+20.621 37.825m Rt. - Elev. 264.905
- BM 29 - Cut "V" on Top Ctr. 4" Steel Guardrail Post for Snowmobile Trail over Twin R.C.B., Sta. 107+21.884 34.855m Rt. - Elev. 256.472
- BM 30 - 60 dd Spike Cor. Post, Sta. 107+21.584 34.855m Rt. - Elev. 268.115
- BM 31 - 60 dd Spike Cor. Post, Sta. 110+01.398 32.290m Rt. - Elev. 274.658
- BM 32 - 60 dd Spike West Gate Post, Sta. 114+15.441 53.466m Rt. - Elev. 275.670
- BM 33 - 60 dd Spike Po.Po. @ S.E. Cor. Hwy 151 and Forest Chapel Road, Sta. 117+23.024 44.048m Rt. - Elev. 285.862
- BM 34 - 60 dd Spike Wood Fence Post, Sta. 121+05.301 43.769m Rt. - Elev. 283.656
- BM 35 - Top D.O.T. R-O-W Rail, Sta. 125+65.307 34.800m Rt. - Elev. 287.159
- BM 36 - 60 dd Spike Po.Po. @ N.E. Cor. Hwy 151 and Co. Rd. X-40, Sta. 131+46.548 22.137m Rt. - Elev. 258.816
- BM 37 - Top U.S.G.S. Brass Cap @ S.W. Top Abutment Hwy 151 Bridge over Wapsi. River, Sta. 133+86.101 19.638m Lt. - Elev. 245.096
- BM 38 - 60 dd Spike Po.Po. @ S.E. Cor. Hwy 151 and Shaw Road, Sta. 137+37.530 31.863m Rt. - Elev. 248.167
- BM 39 - 60 dd Spike Po.Po., Sta. 142+66.177 50.853m Lt. - Elev. 265.429
- BM 40 - 60 dd Spike Cor. Post, Sta. 148+88.331 47.049m Rt. - Elev. 271.395
- BM 41 - 60 dd Spike Po.Po., Sta. 152+90.000 46.000m Rt. - Elev. 252.833
- BM 42 - 60 dd Spike Po.Po. @ S.E. Cor. Hwy 151 and Hwy 64, Sta. 157+35.431 34.578m Rt. - Elev. 249.112
- BM 43 - Fnd " " 3' N. of E. End N. Island, N. of Jct. Hwy 151 & Hwy 64, Sta. 158+04.796 9.079m Lt. - Elev. 249.167
- BM 44 - Fnd Brass Plug Top Ctr. E. Hdwl. Box Culvert @ Hwy 151 & Fawn Creek 1/4 Mi. N. of Jct. Hwy 151 and Hwy 64, Sta. 164+00.685 6.850m Lt. - Elev. 249.170

NHSX-151-3(112)--3H-57 (Springville to Anamosa)
Final Bench Marks

Bench Mark	Description	Elevation
1	60dd Spike Corner Post, Sta. 10+40.000 38.000m Rt.	276.472
2	D.O.T. Plug Top Center Twin R.C.B. 14+34.000 30.000m Rt.	269.547
3	60dd Spike Power Pole @ S.W. Corner Hwy. 151 & Linn-Grove Rd. 17+79.357 43.344m Rt.	271.706
4	60dd Spike Power Pole 24+47.813 38.228 Rt.	280.84
5	Top D.O.T. R-O-W Pin 27+28.208 37.20 Rt.	279.013
6	60dd Spike Power Pole 31+78.000 36.000m Rt.	283.949
7	60dd Spike Power Pole 35+03.577 33.353m Rt.	284.521
8	Top D.O.T. Ref. Point Pin @ S.E. corner Hwy. 151 & Quaker Lane 39+55.257 37.574m Rt.	284.85
9	Top D.O.T. R-O-W Pin 43+57.127 39.911m Rt.	285.946
10	Top D.O.T. R-O-W Pin 46+73.989 38.433m Rt.	286.389
11	60dd Spike Power Pole 55+62.677 38.400m Rt.	286.364
12	60dd Spike Power Pole 58+68.256 37.899m Rt.	283.131
13	60dd Spike Power Pole 61+70.502 38.330m Rt.	279.926
14	"X" Cut Top South End West Pipe of Twin 48" R.C.P. 65+70.801 27.284m Rt.	277.363
15	Top Cap G.P.S. Point # 5 68+07.000 24.390m Rt.	277.905
16	"X" Cut N.W. Corner Conc. Mail Box Pad for Subdivision 71+70.000 40.000m Rt.	278.24
17	60dd Spike Corner Post 84+01.087 53.000m Rt.	284.085
18	60dd Spike Power Pole 89+60.000 59.000m Lt.	283.305
19	60dd Spike Power Pole 92+86.799 67.027m Lt.	285.351
20	60dd Spike West Gate Post 114+15.441 53.466m Rt.	275.67
21	Top R-O-W Rail 125+65.307 34.800m Rt.	287.159
22	Top U.S.G.S. Brass Cap @ S.W. Top Abut. Hwy. 151 Bridge over Wapsi River 133+86.101 19.638m Lt.	245.096
23	60dd Spike Corner Post 148+88.331 47.049m Rt.	271.395
24	Sta. 164+08.9, Brass Plug W. Headwall (culv. Ext.)	248.758

BENCH MARK TABULATION

Culvert Design	Station	Location Description	Elevation
Culvert Design 398	82 + 46	53 m Lt., IDOT Brass Plug in Hdwl of 1.2 m x 1.2 m RCB Extension	279.378
Culvert Design 498	87 + 55	43 m Lt., IDOT Brass Plug in Hdwl of Existing Sect. of 0.9 m x 1.2 m To 1.2 m x 1.2 m RCB Ext.	274.928
Culvert Design 598	88 + 53	25 m Lt., IDOT Brass Plug in Hdwl of Existing Section of 0.9 m x 0.9 m RCB Extension	283.254
Culvert Design 698	93 + 21	35 m Lt., IDOT Brass Plug in Hdwl of Existing Sect. of 0.6 m x 0.9 m To 0.9 m x 0.9 m RCB Ext.	283.232
Culvert Design 798	94 + 83.8	38 m Lt., IDOT Brass Plug in Hdwl of Existing Sect. of 0.6 m x 0.9 m To 0.9 m x 0.9 m RCB Ext.	280.704
Culvert Design 898	97 + 52	35.6 m Lt., IDOT Brass Plug in Hdwl of Existing Sect. of 0.6 m x 0.9 m To 0.9 m x 0.9 m RCB Ext.	271.271
Culvert Design 998	103 + 82	34 m Rt., Cut 'X' in Center of Hdwl of Twin 3.0 m x 3.6 m RCB Extension	259.160
Culvert Design 1098	111 + 28	54 m Rt., IDOT Brass Plug in Hdwl of 1.2 m x 1.2 m RCB Extension	264.396
Culvert Design 1898	11573 + 39	21 m Rt., Cut 'X' in Center of East Hdwl of 3.0 m x 2.4 m RCB Extension	273.744

STAGING NOTES

108-26

09-27-94

Construction activity in this area may disrupt traffic on U.S. 151 and side roads. Therefore, it is advisable to adopt a construction sequence which directs activities in an orderly manner to maintain most traffic patterns at all times.

The items of work are staged so that U.S. Hwy. 151 through traffic may be maintained at all times.

Staging notes will refer to westbound / eastbound lanes. From Sta. 140+00 to Sta. 187+25 westbound lanes are actually southbound and eastbound lanes are actually northbound.

Stage I

Traffic:

Hwy. 151 - Traffic to remain as is.
Co. Rd. X-28 - Road will be closed to through traffic. Utilize RS-26A for traffic control. It is anticipated that an off-site detour will be provided by others.
Co. Rd. X-40 - Road will be closed to through traffic. Utilize RS-26A for traffic control. It is anticipated that an off-site detour will be provided by others.
130th Street - Road will be closed during construction. Utilize RS-26A for traffic control. Access to golf course shall remain open at all times.

Construction:

Grade and Pave crossover, Survey Sta. 4+50. See sheet F.01 for details.
Grade and Pave crossover Sta. 182+80. See Detail 531-3 on Sheet U.01.
Grade and Pave county roads X-28, X-40, and 130th St.
Pave westbound lanes Sta. 23+00 to 64+50, 72+00 to 76+13, 76+80 to 82+50, 154+50 to 157+66, 158+21 to 162+00.
Pave eastbound lanes Sta. 67+95.276 to 75+99, 76+65 to 133+99.717, 135+32.717 to 157+59, 158+14 to 187+10.
Pave Loop B and Ramp C of the IA highway 1 interchange.
Pave Ramp B and Loop C of the IA highway 64 interchange.
Place detour pavement on Rt. shoulder Sta. 84+00 to Sta. 85+20. See Detail Sheet J.02.
Place detour pavement on Rt. shoulder Sta. 164+00 to Sta. 165+20. See Detail Sheet J.03.

Stage II

Traffic:

Hwy. 151 - Westbound traffic to remain as in Stage I, except, close westbound crossover Sta. 20+00 and route westbound traffic on new crossover, Survey Sta. 4+50 (traffic control detail J.07) and move traffic onto detour pavement, Sta's. 84+00 to 85+20 (traffic control detail J.05) and 164+00 to 165+00 (traffic control detail J.05). Keep head to head traffic on existing US 151 Sta. 6+50 to Sta. 64+00. Close Crossover B to eastbound traffic (traffic control detail J.08) and route eastbound traffic on new eastbound lanes to Sta. 182+00. Open crossover at Sta. 185+50 to eastbound traffic (permanent traffic control detail J.09).
Ramps / Loops - Open to traffic Loop B and Ramp C of the Ia. Hwy. 1 Interchange. Open to traffic Ramp B and Loop C of the Ia. Hwy. 64 Interchange.
Sideroads - Open Co. Rd. X-28, Co. Rd. X-40 and 130th Street to Traffic.

Construction:

Remove existing crossover Sta. 15+40 to 23+00.
Grade and Pave westbound US 151 Sta. 15+40 to 23+00.
Grade and Pave westbound lanes Sta. 82+50 to Sta. 84+00 including Ramp D gore area. Place detour pavement on Lt. shoulder 81+90 to Sta. 84+60. See Detail Sheet J.02
Grade and Pave westbound Sta. 162+00 to Sta. 164+00 including Ramp D gore area. Place detour pavement on Lt. shoulder Sta. 162+40 to Sta. 164+60. See Detail Sheet J.03.
Grade and Pave right turn lane on westbound lanes from Sta. 173+20 to Sta. 175+80. Traffic Control per RS-63A.

Stage III

Traffic:

Hwy. 151 - Open westbound lanes to westbound traffic. Close Crossover at Sta. 4+50 and Crossover B at Sta. 66. Move westbound traffic onto detour pavement and Lt. lane Sta. 81+90 to Sta. 84+60 (traffic control per RS-63A and RS-65B), and Sta. 162+40 to Sta. 164+60 (traffic control per RS-63A and RS-65B).
Open eastbound lanes to traffic.

Construction:

Remove Crossover B, Sta. 64-68
Remove detour pavement and grade and pave westbound Rt. lane and Ramp D taper area Sta. 83+00 to Sta. 84+00. See Detail Sheet J.02.
Remove detour pavement on westbound lane Rt. shoulder Sta. 84+00 to Sta. 85+20 and restore granular shoulders. See Detail Sheet J.02.
Remove detour pavement and grade and pave westbound Rt. lane and Ramp D taper area Sta. 163+05 to Sta. 164+00. See Detail Sheet J.03.
Remove detour pavement on westbound lane Rt. shoulder Sta. 164+00 to Sta. 165+20 and restore granular shoulders. See Detail Sheet J.03.
Place detour pavement on eastbound Rt. shoulder Sta. 20+40 to Sta. 24+60. See Detail Sheet J.04.

Stage IV

Traffic:

Hwy. 151 - All lanes open to traffic, except, close eastbound Lt. lane Sta. 20+40 to Sta. 24+60 and move traffic Rt. onto detour pavement (traffic control detail J.06).

Construction:

Remove eastbound Lt. lane pavement and remaining crossover and grade and pave Sta. 21+00 to Sta. 24+00.
Place detour pavement on eastbound Lt. shoulder Sta. 20+40 to Sta. 24+60. See Detail Sheet J.04.
Remove detour pavement on westbound lane Lt. shoulder Sta. 81+90 to Sta. 84+60 and restore granular shoulder. See Detail Sheet J.02.
Remove detour pavement on westbound lane Lt. shoulder Sta. 162+40 to Sta. 164+60 and restore granular shoulder. See Detail Sheet J.03.

STAGING NOTES

108-26

09-27-94

Stage V

Traffic:

Hwy. 151 - All lanes open to traffic, except, close eastbound Rt. lane Sta. 20+40 to Sta. 24+60 and move traffic Lt. onto detour pavement (traffic control detail J.06).

Construction:

Remove eastbound Rt. lane pavement and detour pavement and grade and pave Sta. 21+00 to Sta. 24+00. See Detail Sheet J.04.

Stage VI

Traffic:

Hwy. 151 - All lanes open to traffic.

Construction:


Remove eastbound detour pavement on Lt. shoulder and restore granular shoulder Sta. 21+00 to Sta. 24+00. See Detail Sheet J.04.

TRAFFIC CONTROL PLAN


108-23A

09-27-94


1. Traffic will be maintained on US Hwy. 151 at all times. Local access will be provided as noted in Staging Notes Tabulation 108-26.
2. Traffic control on this project shall be in accordance with Standard Road Plans RS-2, RS-3, RS-26A, RS-50B, RS-63A, RS-63B, RS-65B, RS-66(1) and Detail Sheets J.05 - J.09 contained in the plans. For additional complementary information, refer to Part VI of the Manual of Uniform Traffic Control Devices and to the current Standard Specifications.
3. The contractor shall coordinate traffic control with other projects in the area. Other work in progress during the same period of time will include, but will not be limited to construction of the following projects: NHSX-151-4(65)--3H-53, NHSX-151-4(66)--3H-53 and NHS-151-4(67)--3H-53, NHSX-151-3(102)--3H-57 and NHSX-151-4(63)--3H-53.
4. All traffic control devices shall be furnished, erected, maintained, and removed by the contractor.
5. Where possible, all post-mounted signs shall be placed at least 0.6 m beyond the curb or edge of shoulder.
6. The location for storage equipment by the contractor during non-working hours shall be as approved by the engineer in charge of construction.
7. The engineer may require modifications to the pavement marking details shown. Conflicting permanent edge lines, centerlines, or lane lines shall be removed. As applicable, permanent edge lines, centerlines, and lane lines shall be placed before the roadway is returned to normal traffic. The current Standard Specifications and Supplemental Specifications shall apply.
8. Proposed sign spacing may be modified as approved by the engineer to meet existing field conditions or to prevent obstruction of the motorist's view of permanent signing.
9. Permanent signing that conveys a message contrary to the message of the temporary signing and not applicable to the working conditions shall be covered by the contractor when directed by the engineer.
10. Proposed changes in the traffic control plan shall be reviewed with the Office of Construction before changes are made.
11. The bid item "Traffic Control" shall include the cost for all traffic measures required of the contractor except for those which are separate bid items or are incidental to other bid items.

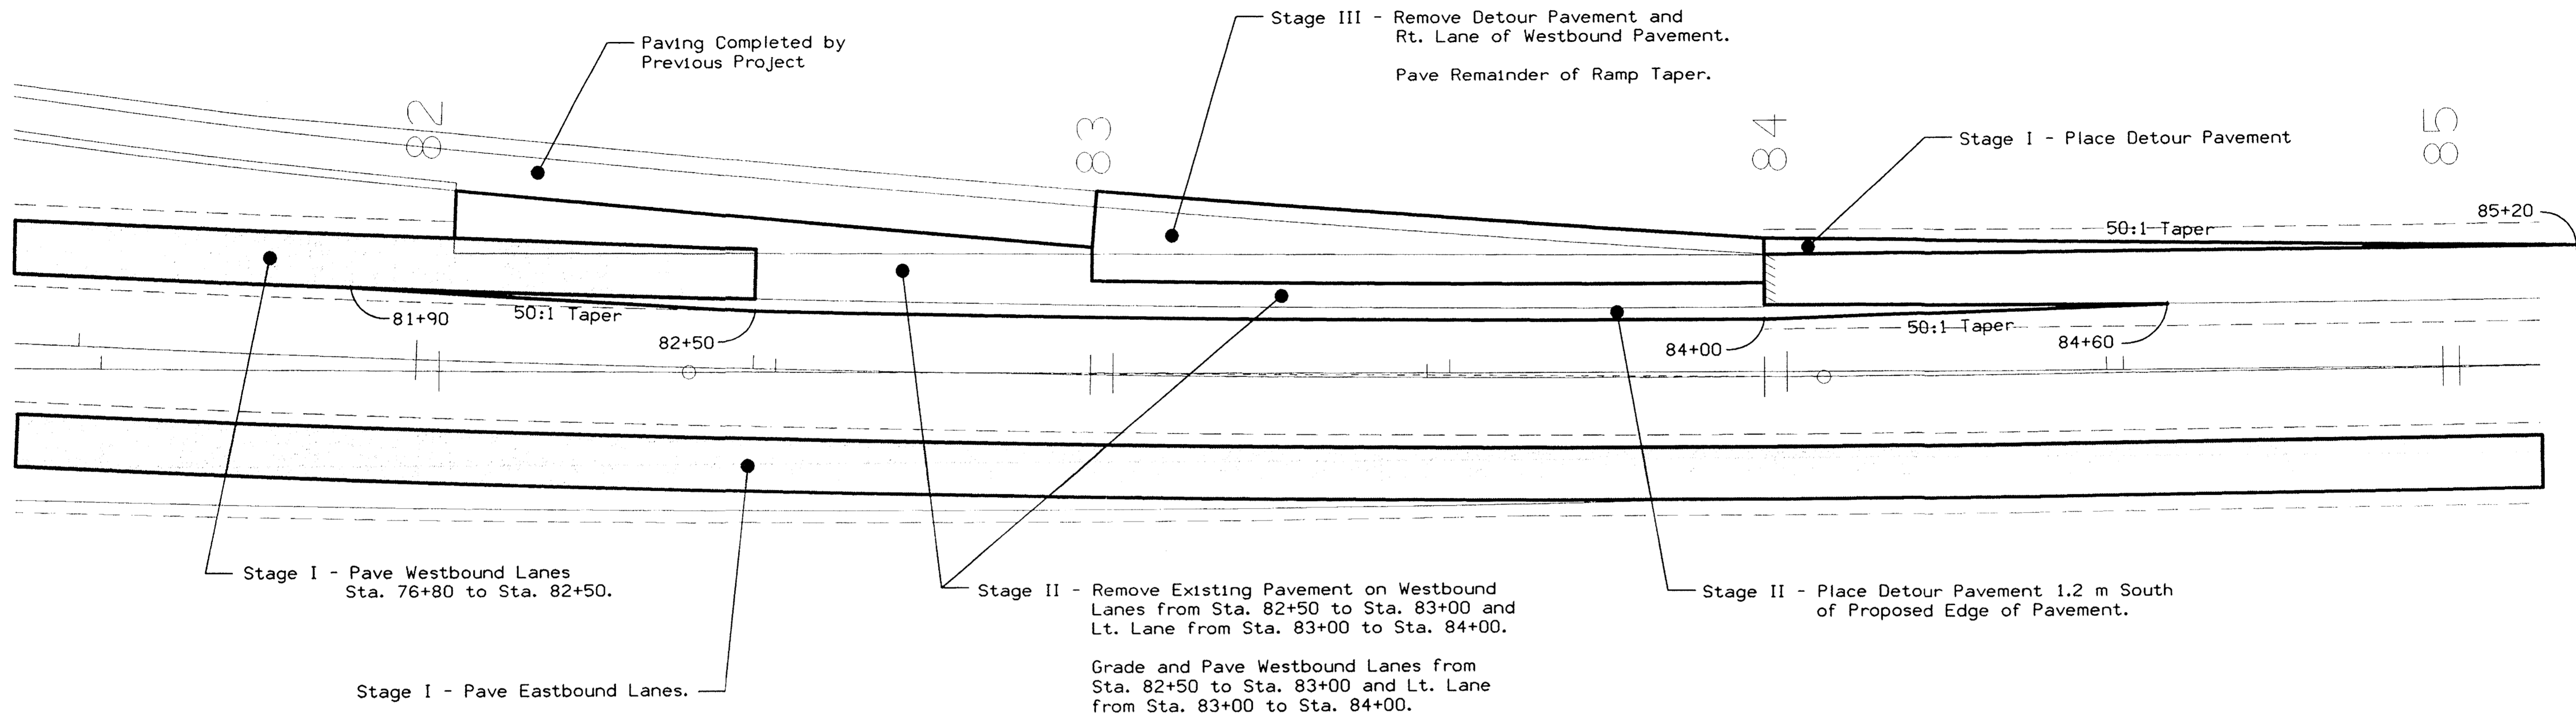


NOTE: TRAFFIC CONTROL PER RS-3 FOR PLACEMENT AND REMOVAL OF DETOUR PAVEMENT ALONG U.S. 151.

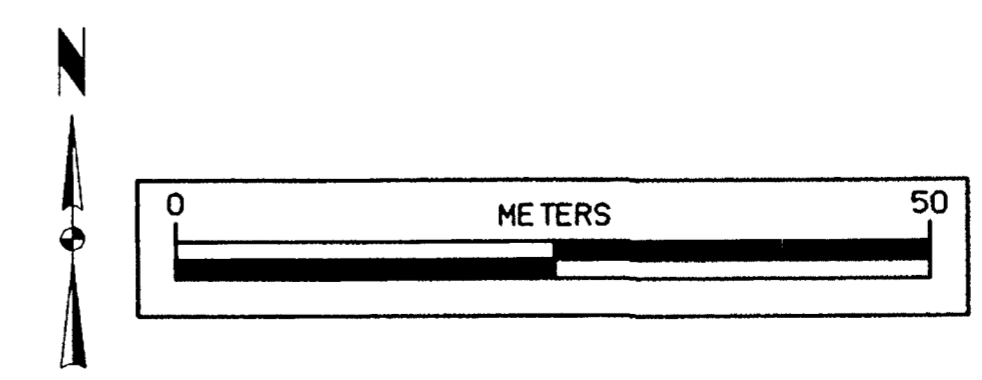


STAGING DETAIL
FOR WESTBOUND LANES
STA. 82+00 TO STA. 84+00

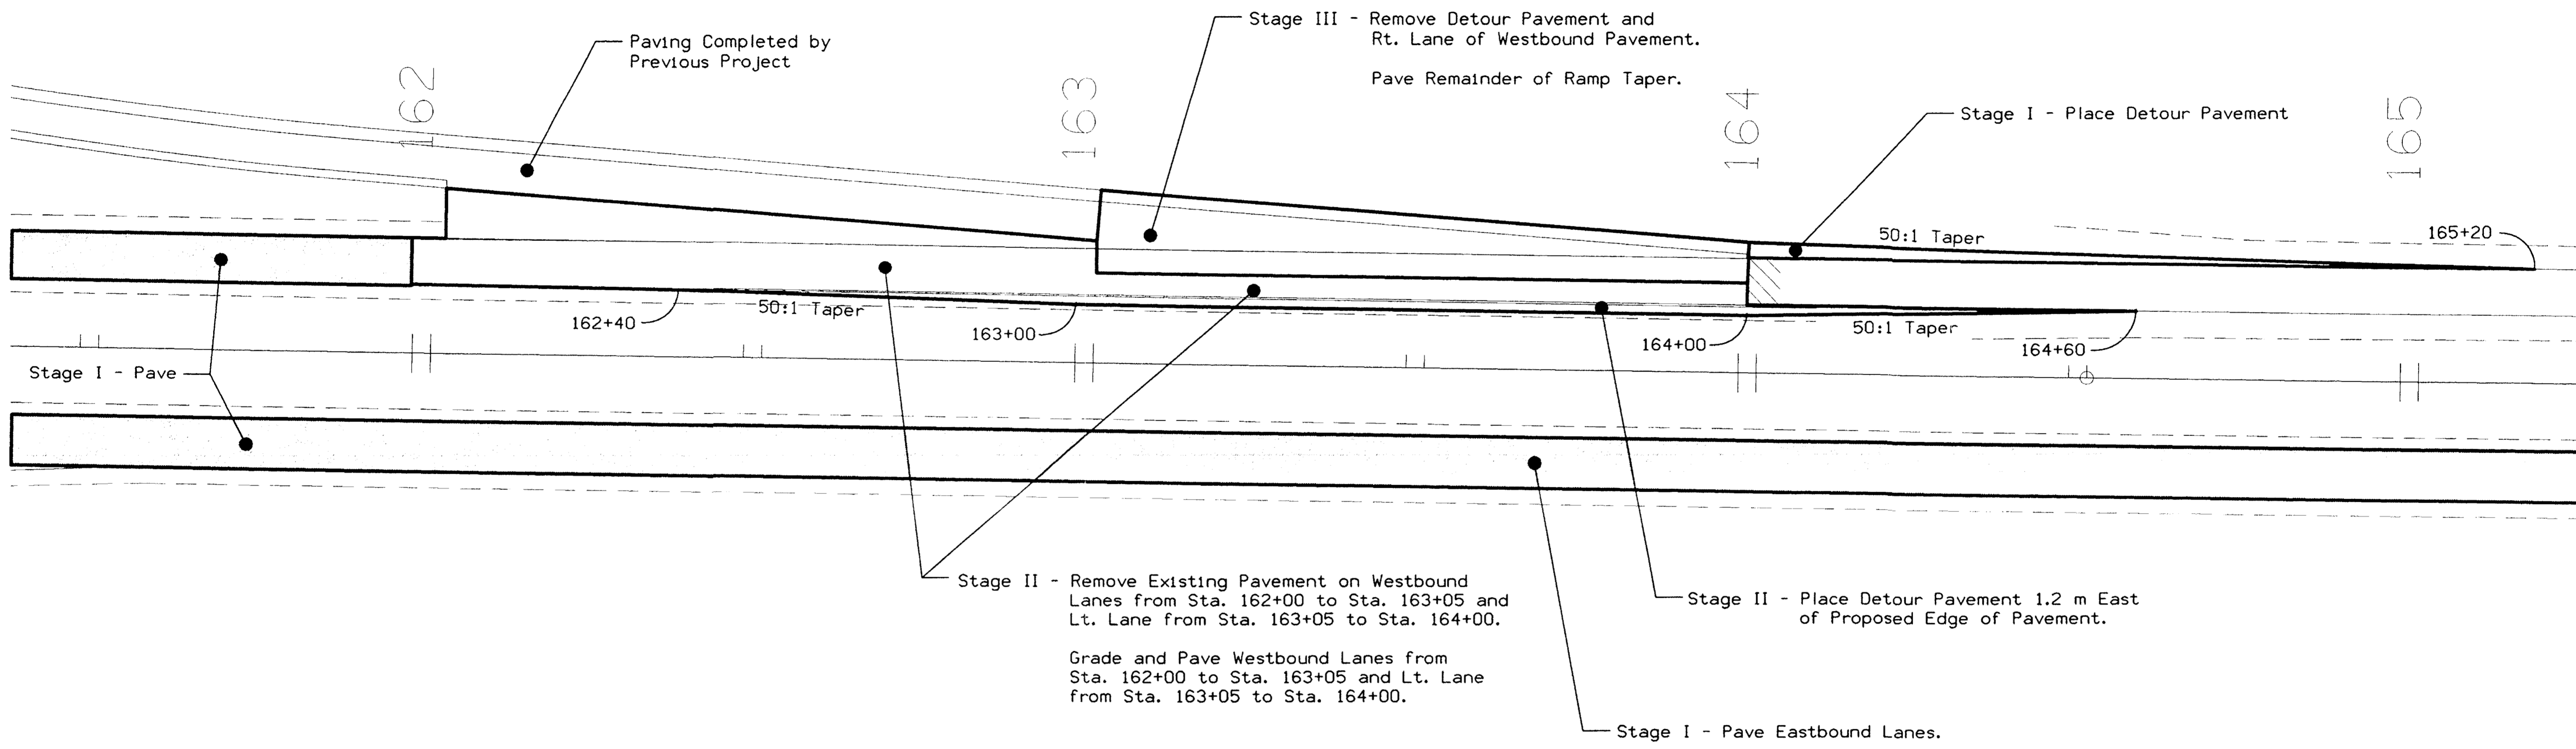


NOTE: TRAFFIC CONTROL PER RS-3 FOR PLACEMENT AND REMOVAL OF DETOUR PAVEMENT ALONG U.S. 151

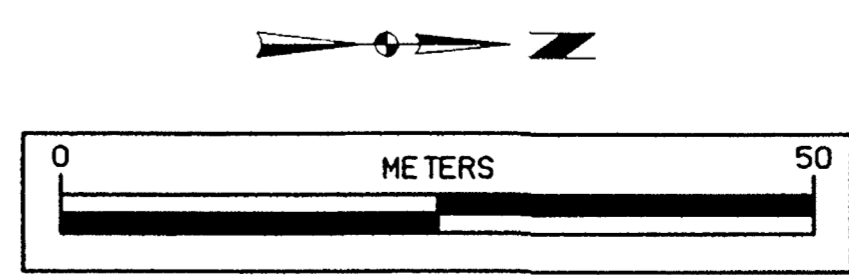


STAGING DETAIL
FOR WESTBOUND LANES
STA. 162+00 TO STA. 165+00

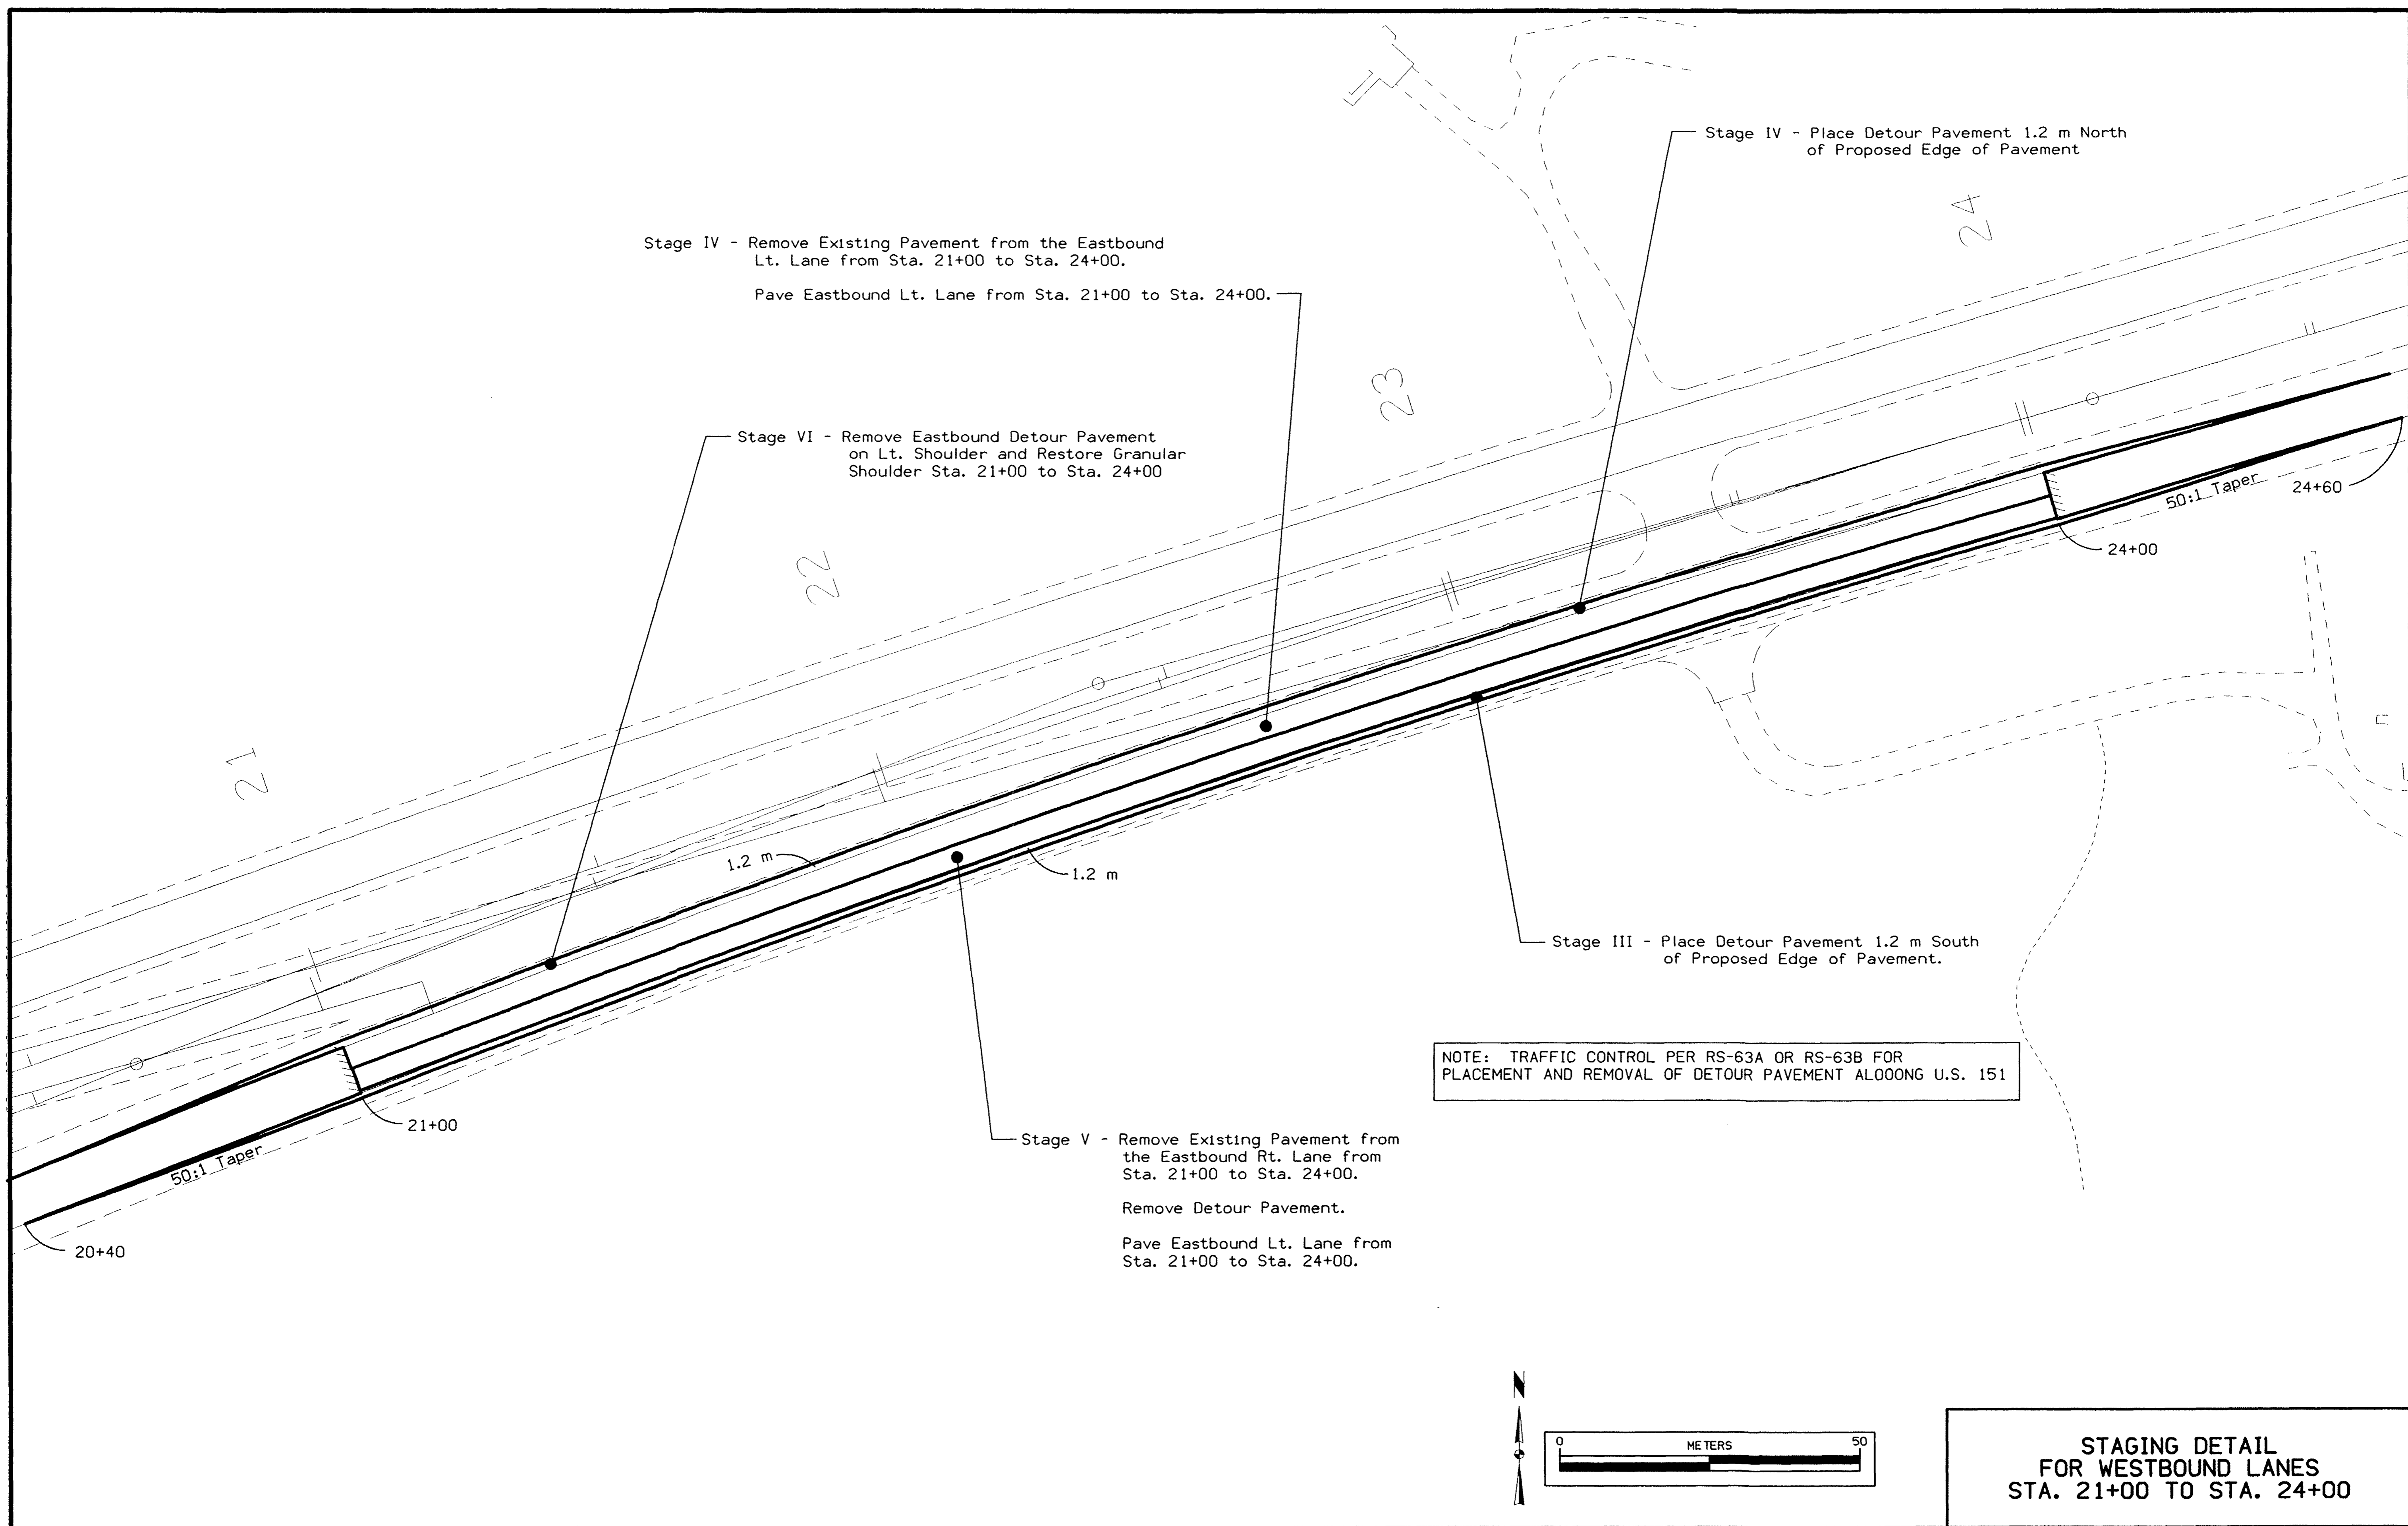

NOTE: TRAFFIC CONTROL PER RS-63A OR RS-63B FOR PLACEMENT AND REMOVAL OF DETOUR PAVEMENT ALONG U.S. 151

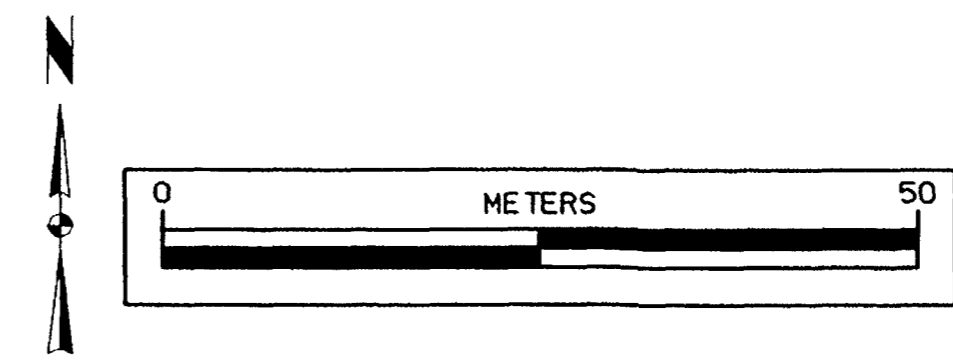

STAGING DETAIL
FOR WESTBOUND LANES
STA. 21+00 TO STA. 24+00

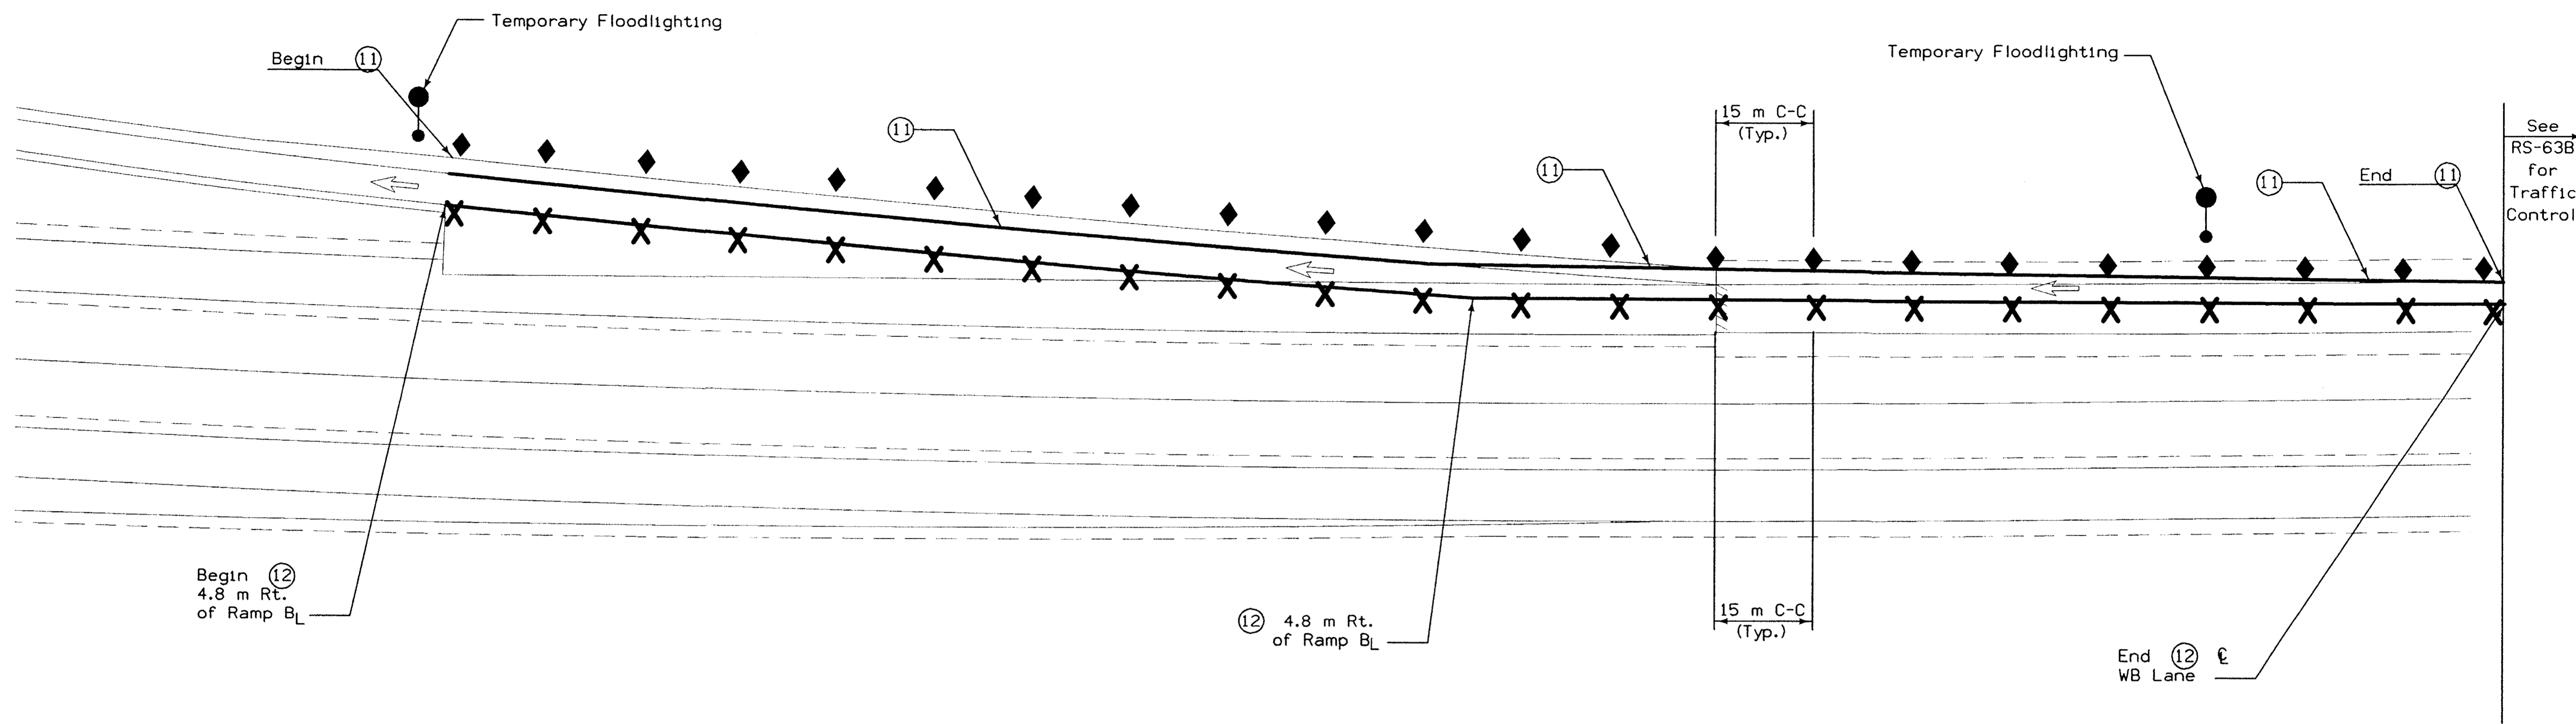

LEGEND

- Paint Lines
- Note: (X) Refers to pavement marking type (see tabulation 108-22).
- (11) Channelizing (White)
- (12) Channelizing (Yellow)
- X Drum
- ◆ Delineator
- Temporary Floodlighting


GENERAL NOTES:

1. The Contractor shall be responsible for the placement and removal of temporary white edgelines and yellow "No Passing" lines. The Contractor shall also be responsible for the removal and replacement of the existing dashed yellow centerline and white edgelines as required by the Traffic Control Layout.
2. For temporary Floodlighting, see Detail Sheet 570-2.
3. Poles for temporary floodlighting and auxiliary poles used to furnish power to signals or floodlights shall be offset 9 meters from the travelled way unless there are right-of-way restrictions. Clearance on overhead wiring for signals and floodlighting shall be a minimum of 6 meters.
4. Post mounted white delineators shall be erected in accordance with Standard Road Plan RE-7.



**TRAFFIC CONTROL
LAYOUT FOR STAGE II
STA. 84+00 AND STA. 164+00**

See RS-63A for Left Lane Run Around
 RS-63B for Right Lane Run Around

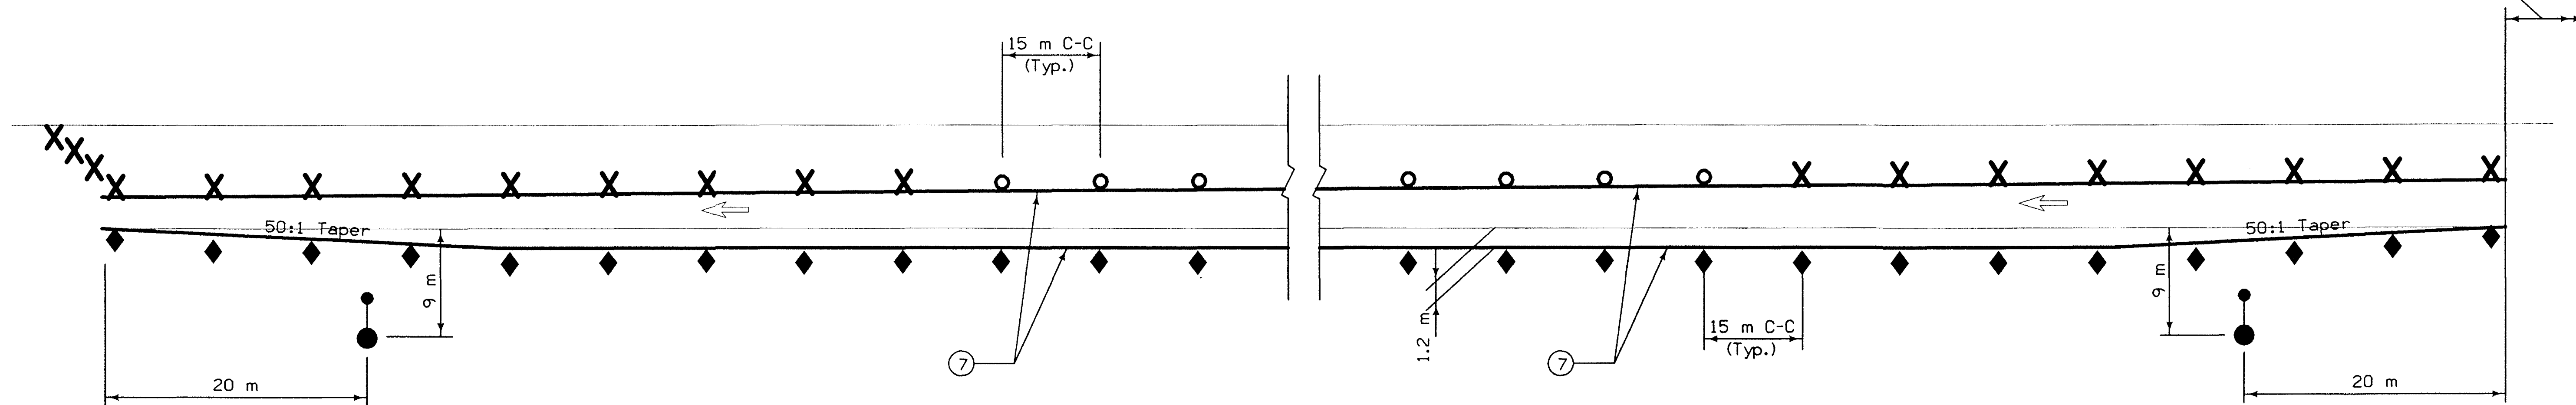


LEGEND

- Paint Lines
- Note: (X) Refers to pavement marking type (see tabulation 108-22).
- (7) Edge Line Right (White)
- X Drum
- ◆ Single White Delineators (Mount back to back)
- Temporary Floodlighting
- Channelizing Device (Vertical Panel, Type I or Type II Barricade) (To Be Weighted)

GENERAL NOTES:

1. The Contractor shall be responsible for the placement and removal of temporary white edgelines. The Contractor shall also be responsible for the placement of markings as specified in tab. 108-22.
2. For Temporary Floodlighting, see Detail Sheet 570-2.
3. Pole for Temporary Floodlighting, when specified in the project plans, shall be offset 9 meters from the traveled way unless there are right-of-way restrictions.
4. Clearance on overhead wiring shall be a minimum 5.5 meters. Auxiliary poles used to furnish power to floodlighting shall be offset 9 meters from the traveled way unless there are right-of-way restrictions.
5. Post-mounted white delineators shall be erected in accordance with Standard Road Plan RE-7.

**SHOULDER RUN-AROUND
 TRAFFIC CONTROL DETAIL**

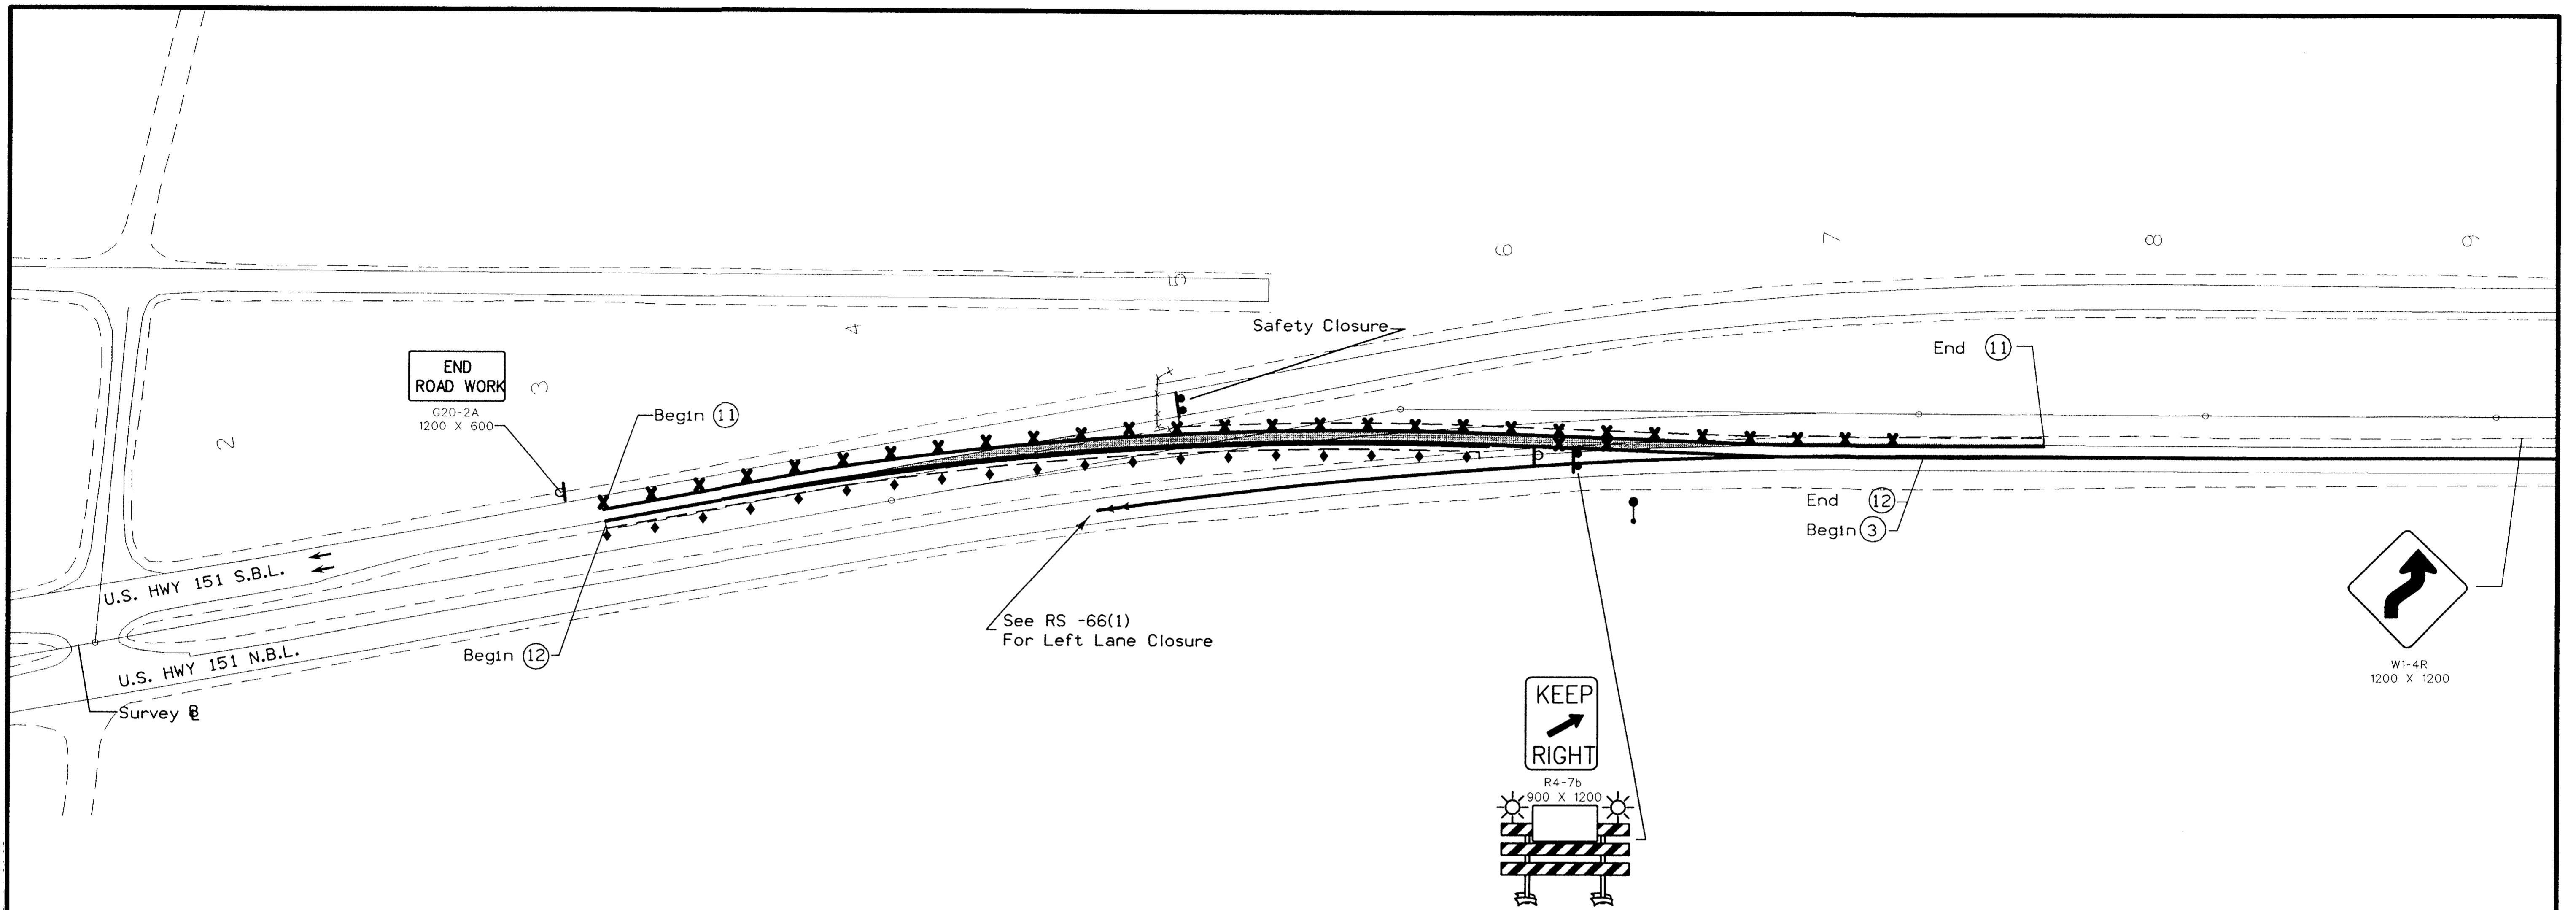


GENERAL NOTES


1. The Contractor shall be responsible for the placement and removal of temporary white edgelines. The Contractor shall also be responsible for the placement of markings as specified in tab. 108-22.
2. For Temporary Floodlighting, see Detail Sheet 570-2, Sheet U.02
3. Pole for Temporary Floodlighting, when specified in the project plans, shall be offset 9 meters from the traveled way unless there are right-of-way restrictions.
4. Clearance on overhead wiring shall be a minimum 5.5 meters. Auxiliary poles used to furnish power to floodlighting shall be offset 9 meters from the traveled way unless there are right-of-way restrictions.
5. Post-mounted white delineators shall be erected in accordance with Standard Road Plan RE-7.
6. Safety closure to be paid for as per Standard and Supplemental specifications Section 2518.

LEGEND

- Paint Lines
- Note: (X) Refers to pavement marking type (see tabulation 108-22).
- (3) Double Center Line (Yellow)
- (11) Channelizing Line White
- (12) Channelizing Line Yellow
- ▨ Detour Pavement
- Orange Plastic Safety fence
- ⊥ Type III Barricade
- x Drum
- p Sign
- ◆ Delineator
- ! Temporary Floodlighting

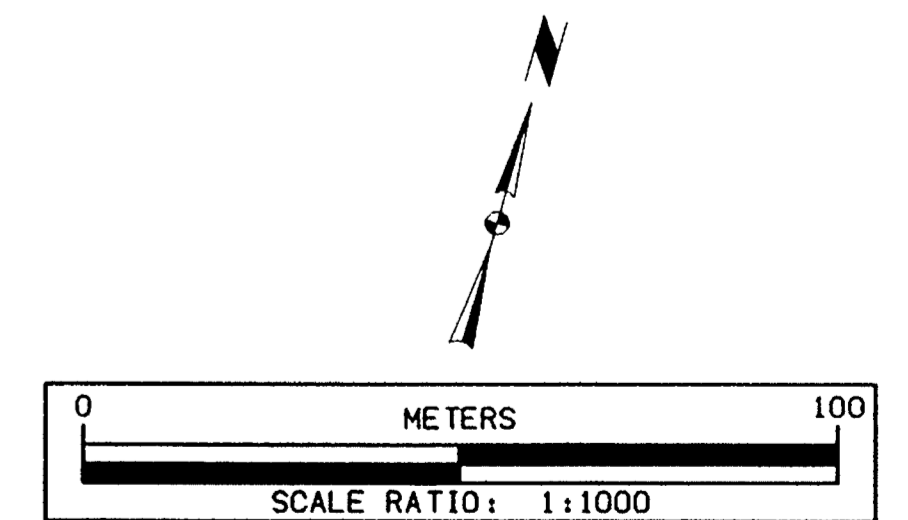

**STAGE II TRAFFIC CONTROL
STA. 4+50.**

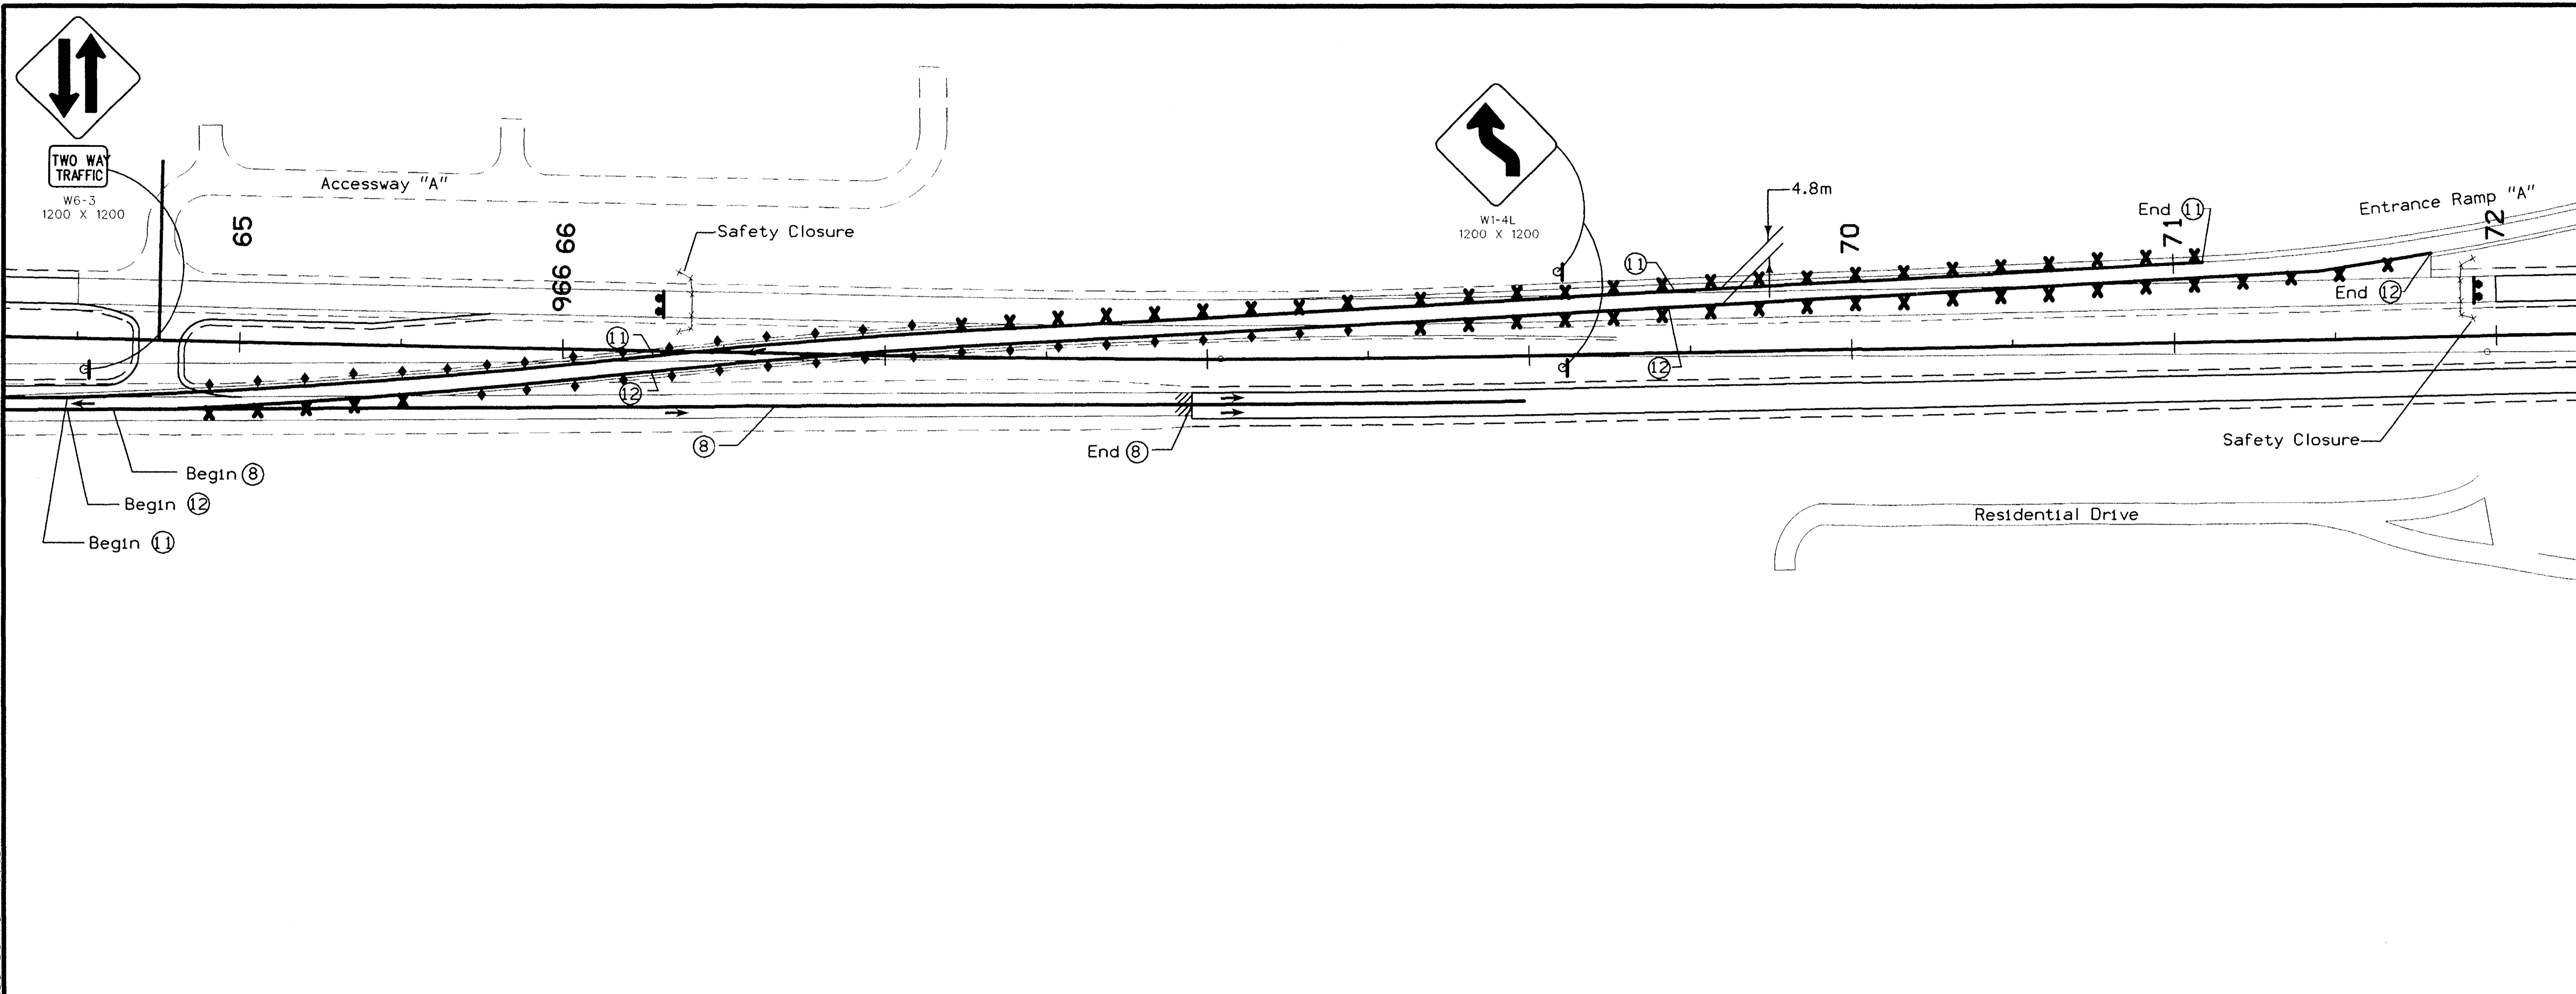


GENERAL NOTES


1. The Contractor shall be responsible for the placement and removal of temporary white edgelines. The Contractor shall also be responsible for the placement of markings as specified in tab. 108-22.
2. For Temporary Floodlighting, see Detail Sheet 570-2, Sheet U.02
3. Pole for Temporary Floodlighting, when specified in the project plans, shall be offset 9 meters from the traveled way unless there are right-of-way restrictions.
4. Clearance on overhead wiring shall be a minimum 5.5 meters. Auxiliary poles used to furnish power to floodlighting shall be offset 9 meters from the traveled way unless there are right-of-way restrictions.
5. Post-mounted white delineators shall be erected in accordance with Standard Road Plan RE-7.
6. Safety closure to be paid for as per Standard and Supplemental specifications Section 2518.

LEGEND

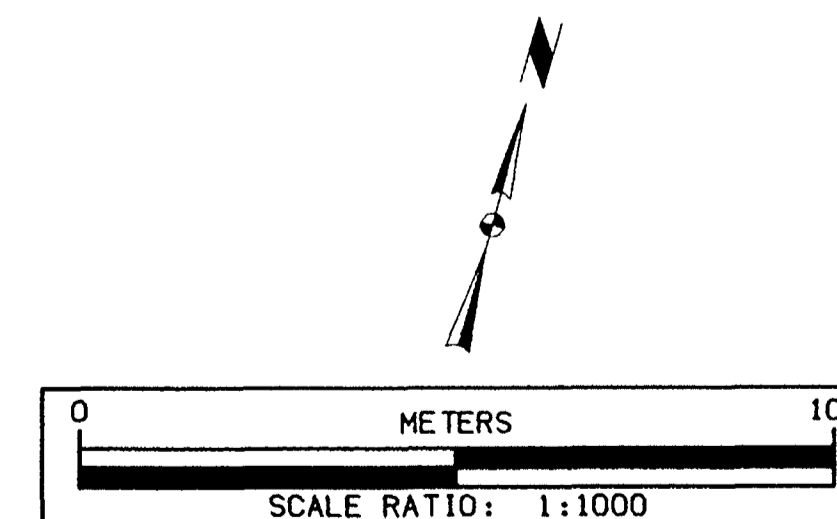



- Paint Lines
- Note: (X) Refers to pavement marking type (see tabulation 108-22).
- (8) Edge Line Left Yellow
- (11) Channelizing Line White
- (12) Channelizing Line Yellow
- ▨ Detour Pavement
- Orange Plastic Safety fence
- ⊞ Type III Barricade
- X Drum
- ⊞ Sign
- ◆ Delineator
- ⊞ Temporary Floodlighting

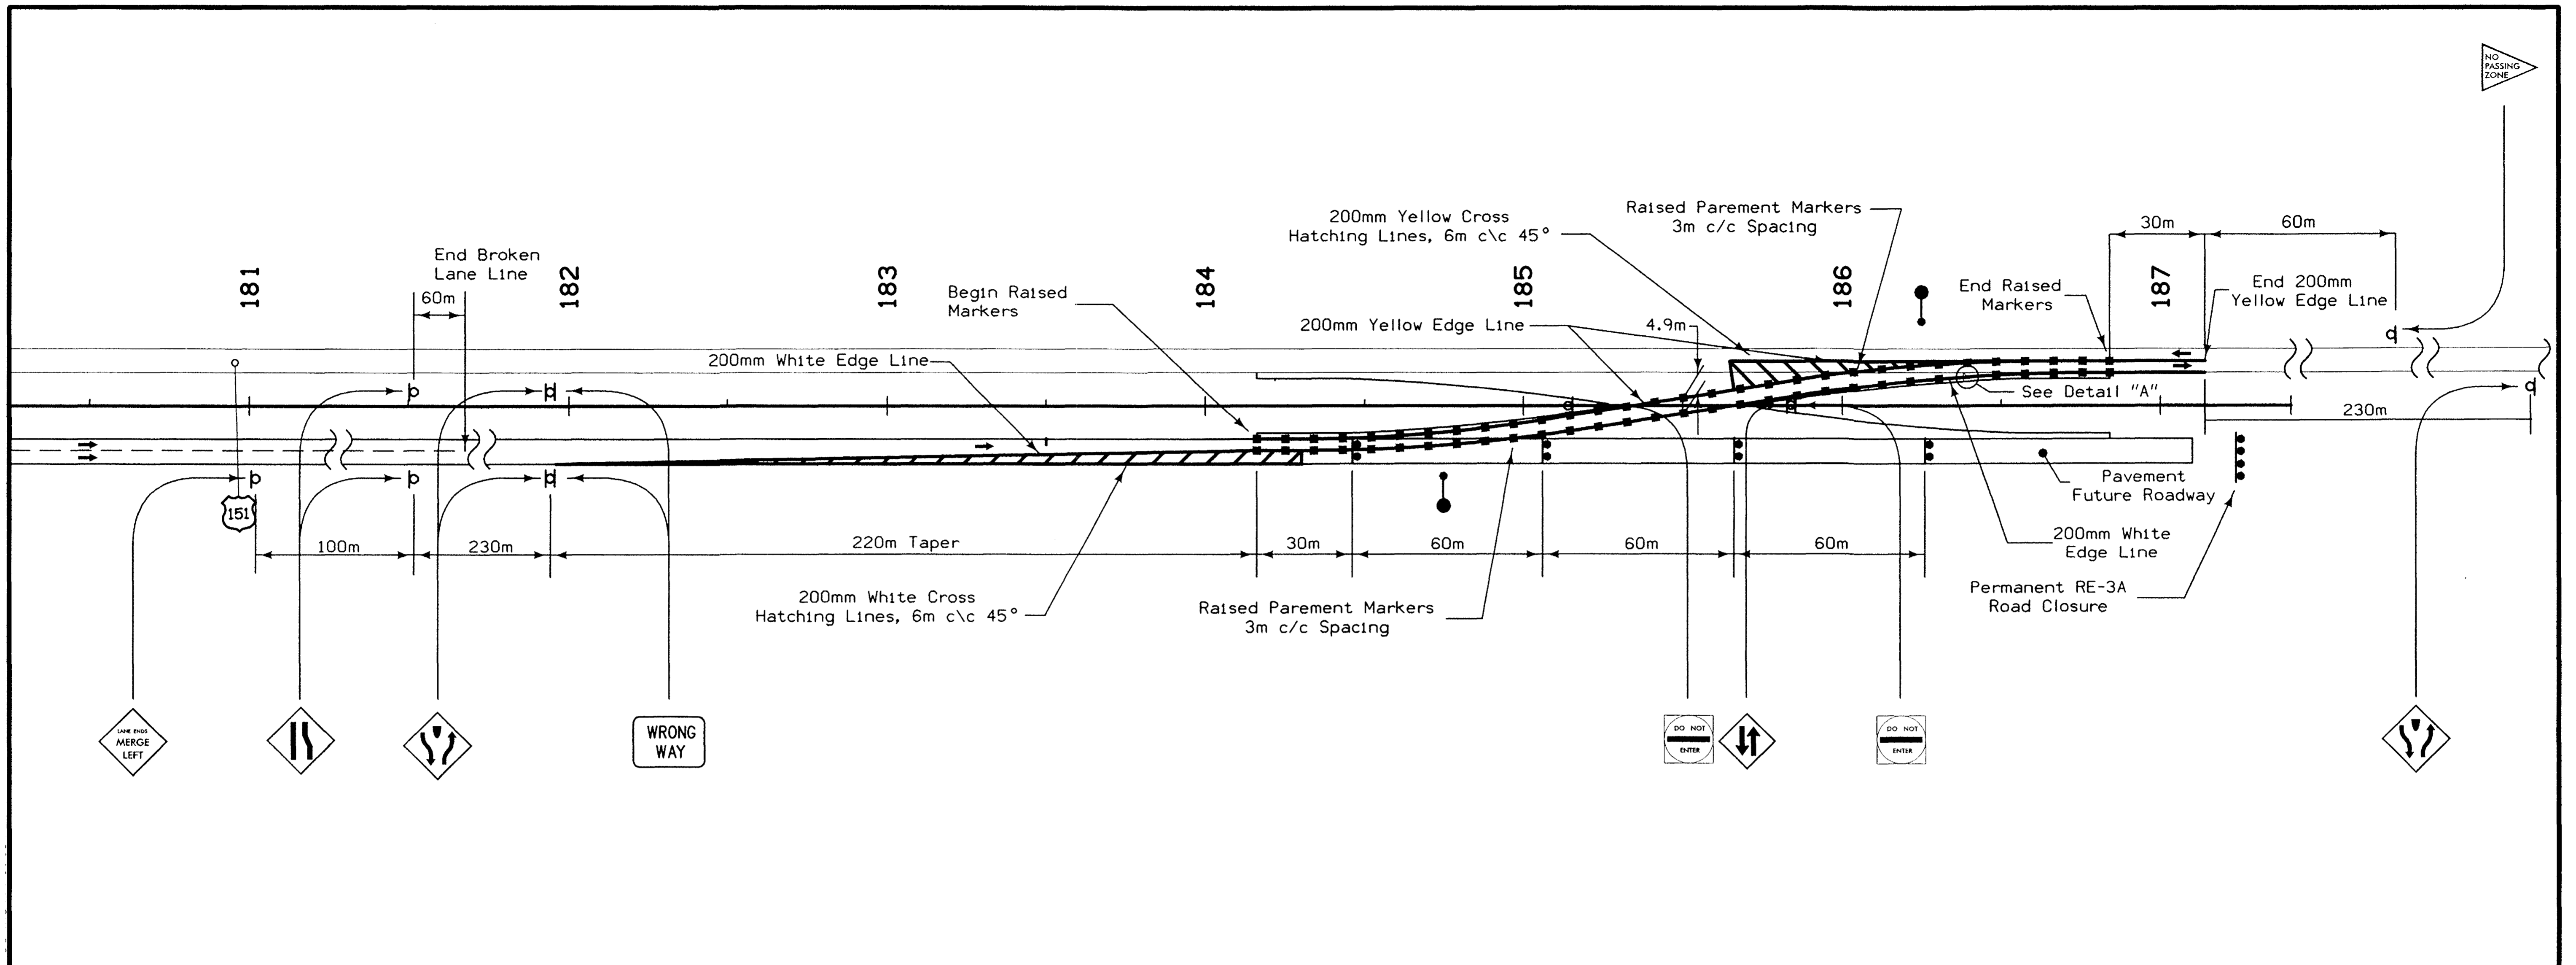


**STAGE II TRAFFIC CONTROL
DETAIL FOR CROSSOVER
"B" STA 67+00**



LEGEND

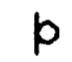
-  Type III Barricade
-  Raised Pavement Marker
-  Sign
-  TEMPORARY FLOOD LIGHTING

1. Warning signs are yellow with black legend and symbols.
2. Type III barricades shall conform to section 3f-1 of the "Manual on Uniform Traffic Control Devices."

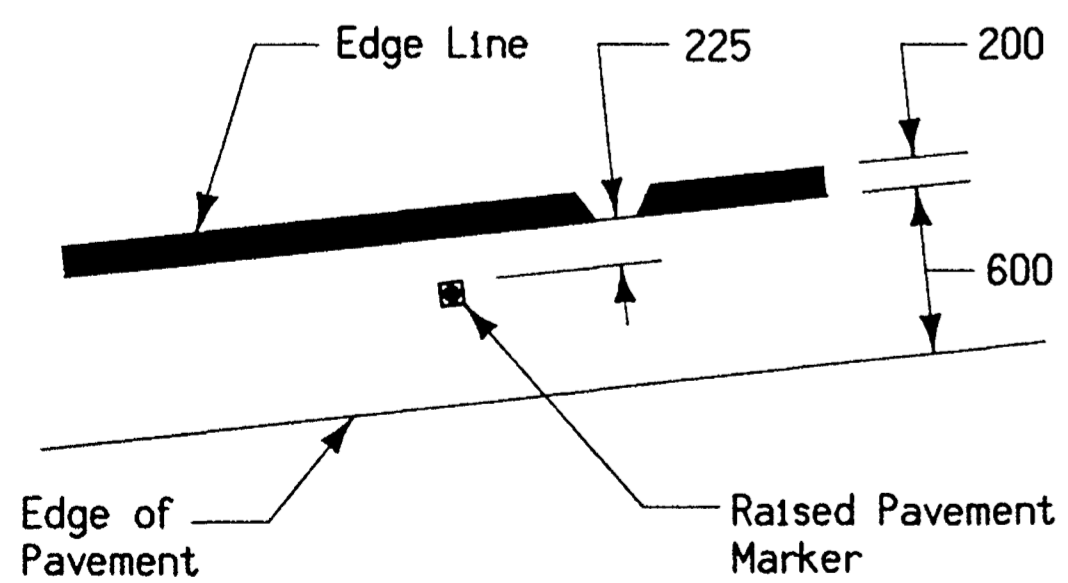




DETAIL 'A'
TYPICAL EDGE LINE AND
PAVEMENT MARKER PLACEMENT

Traffic Control and Signing
Detail For Median Crossover
at Sta. 185+50

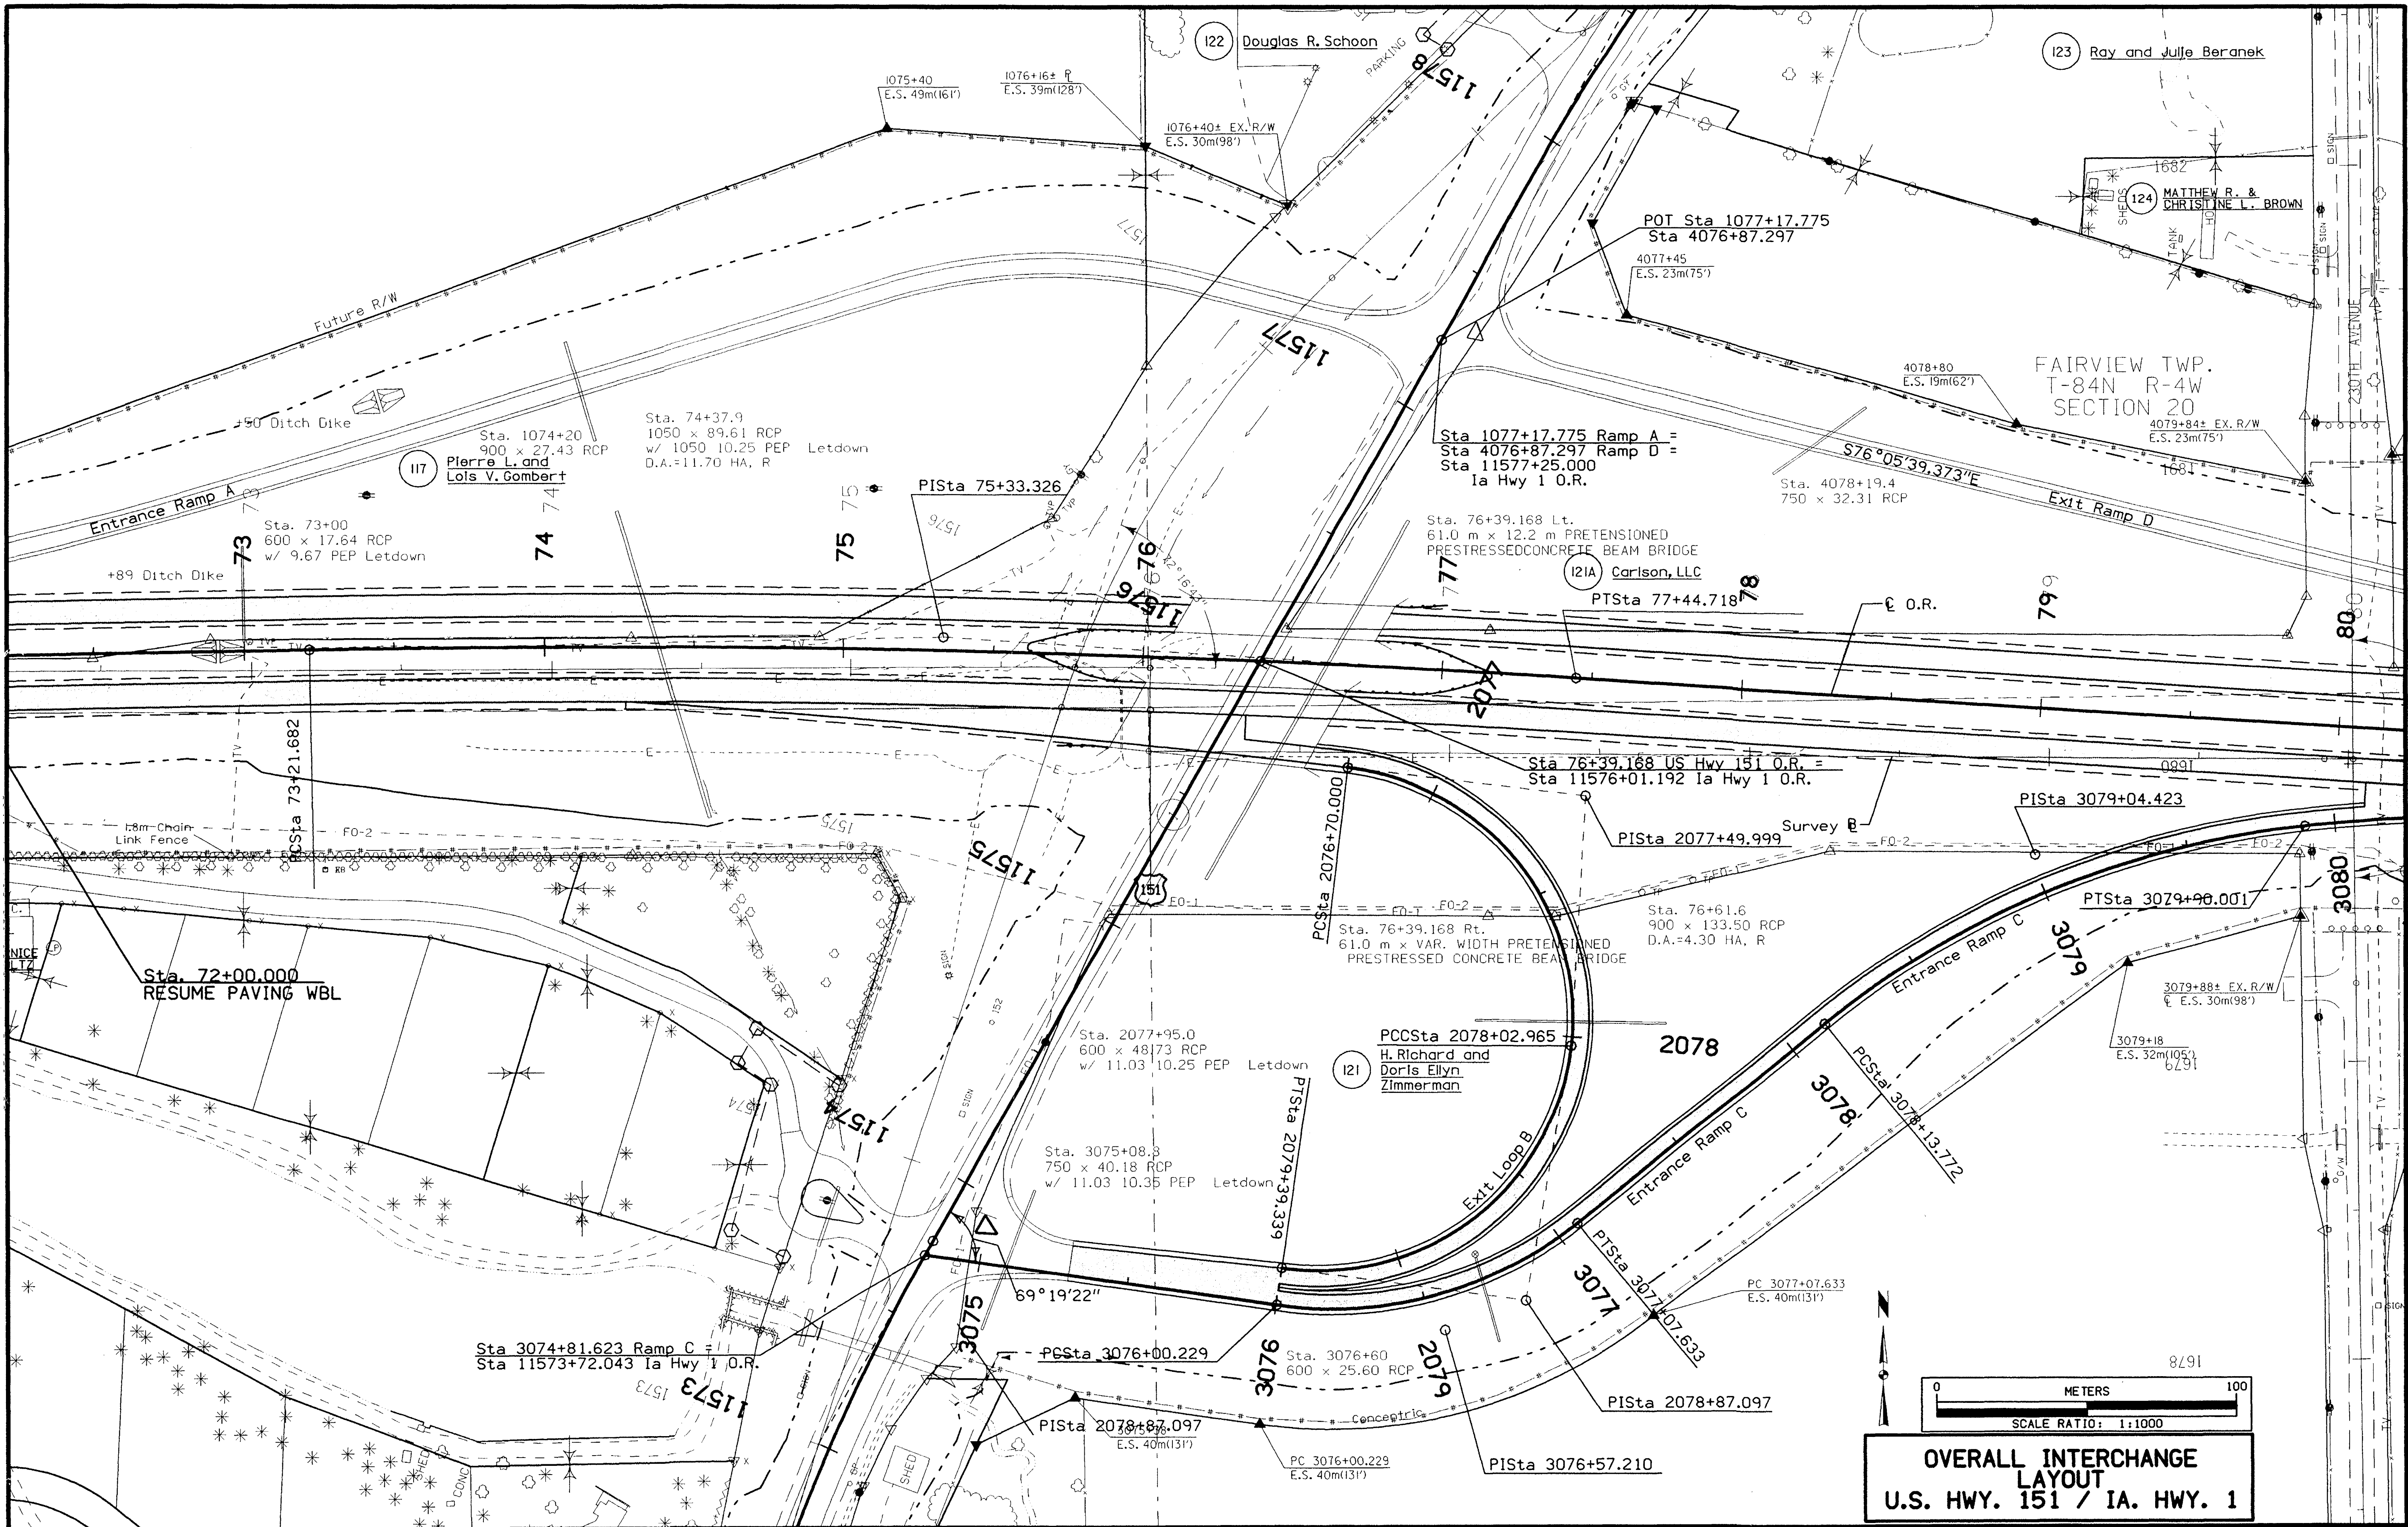



OVERALL INTERCHANGE LAYOUT
U.S. HWY. 151 / IA. HWY. 1

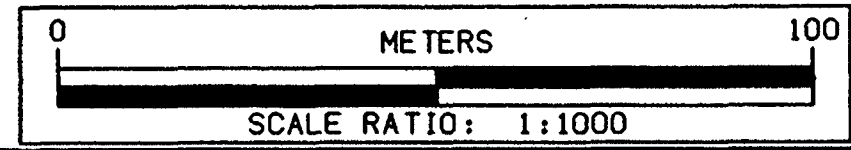

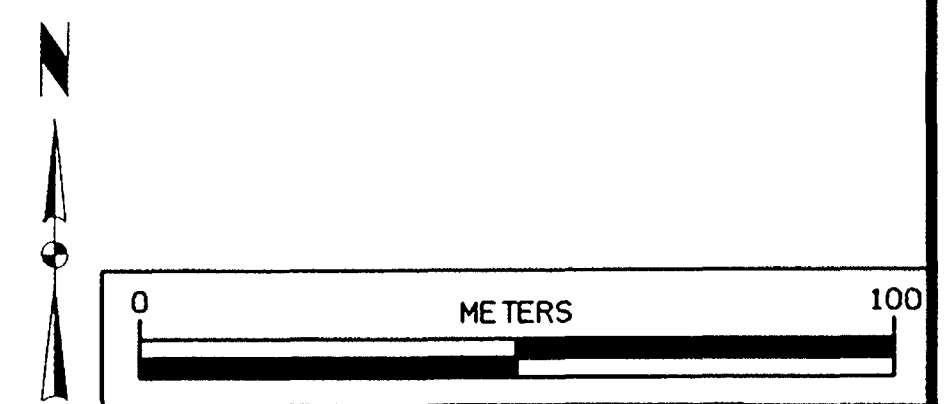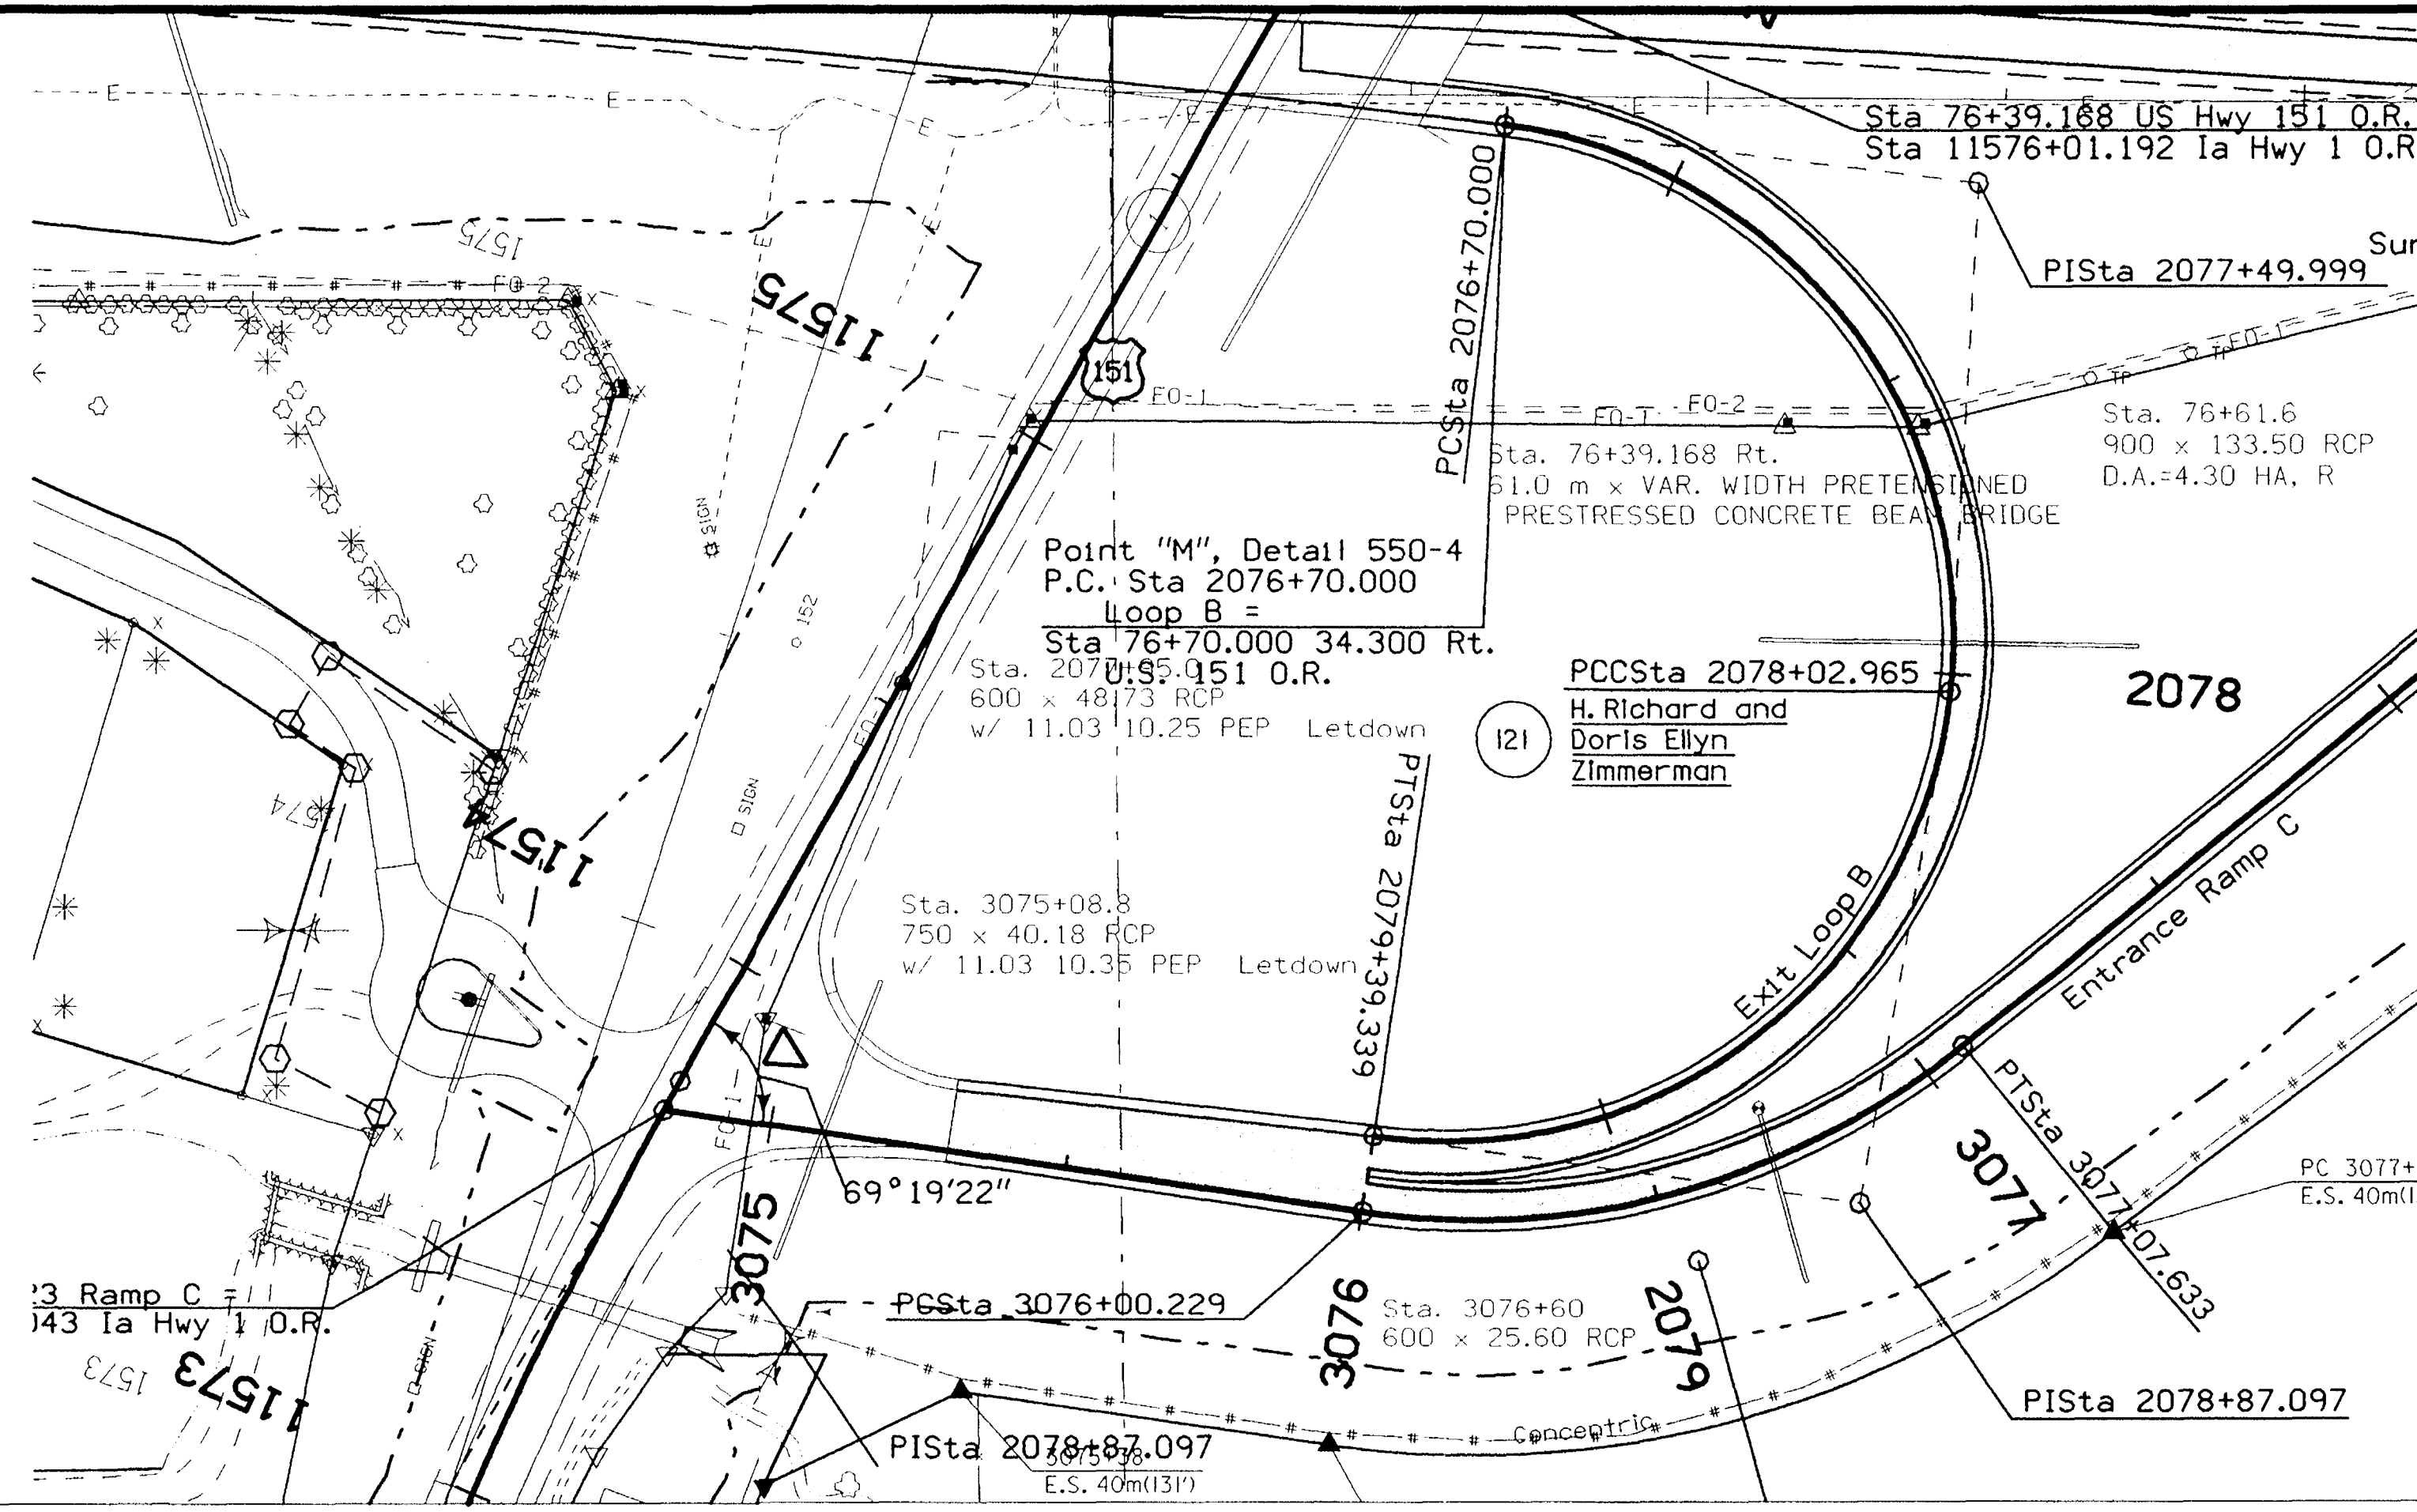


EXIT LOOP B

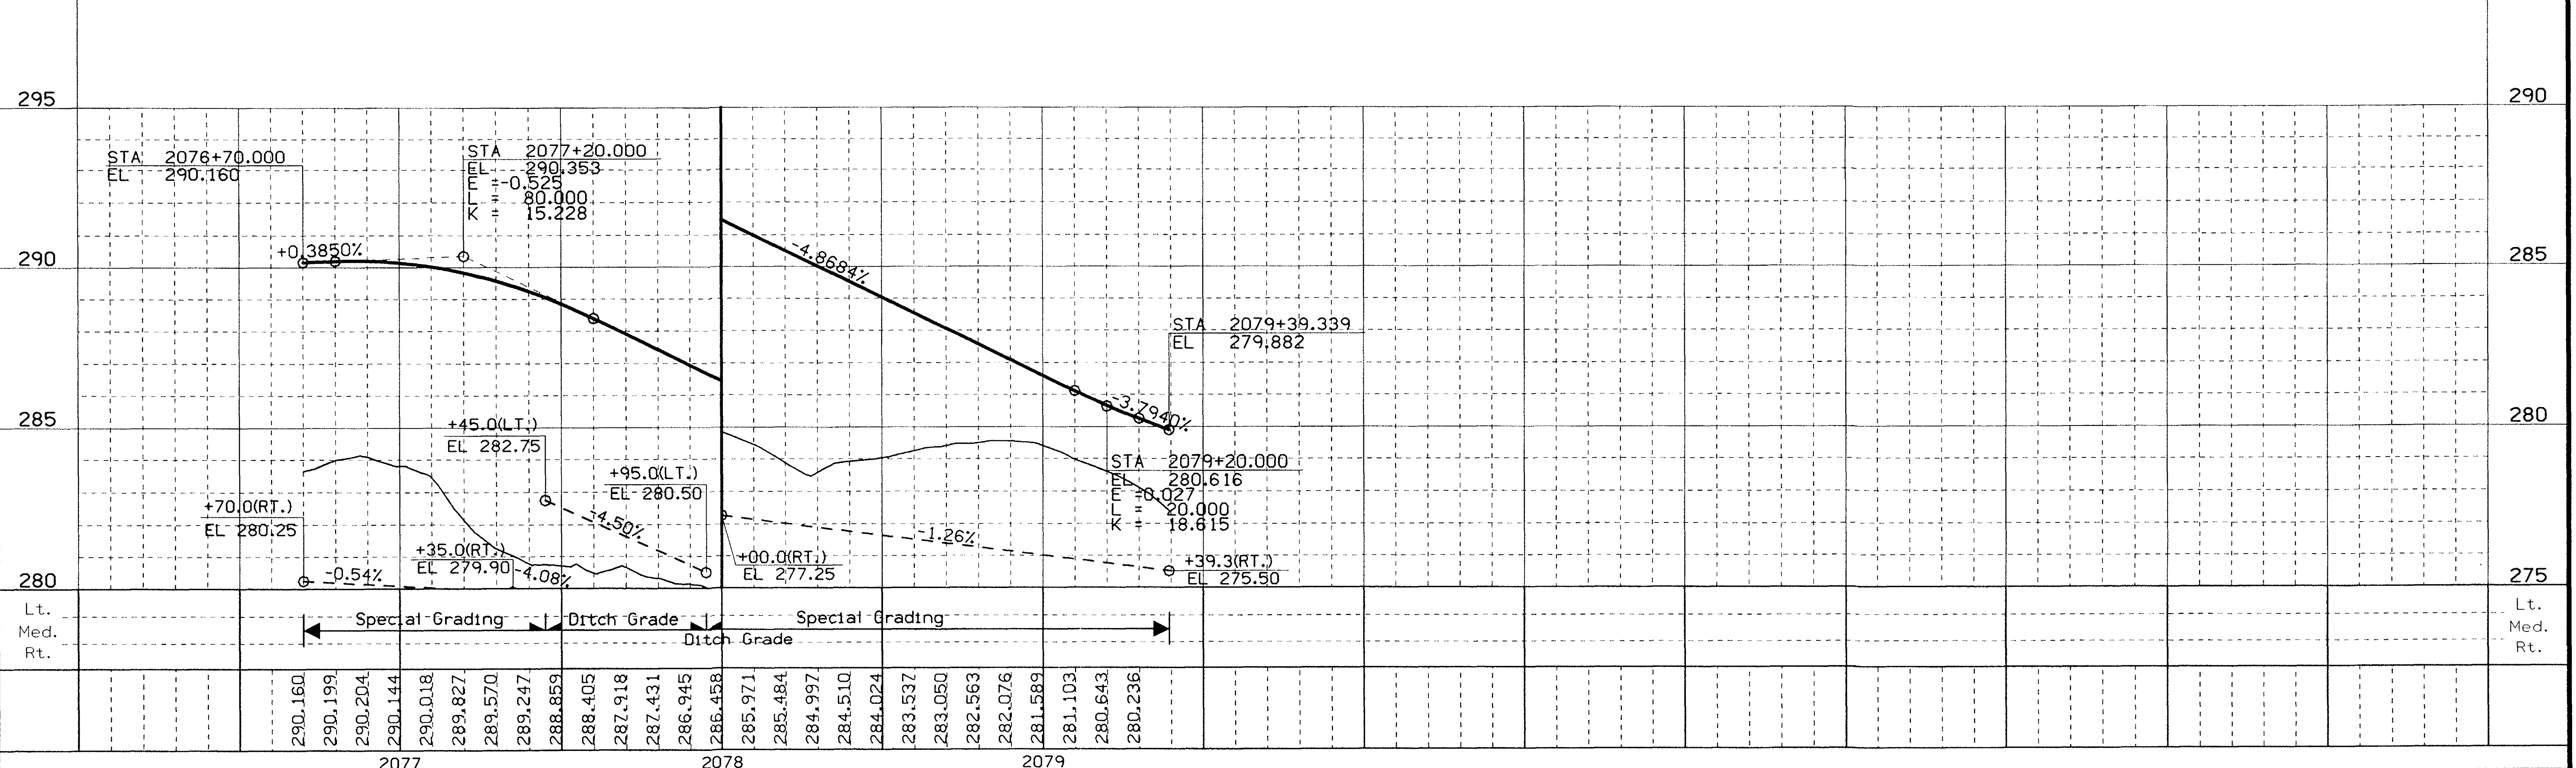

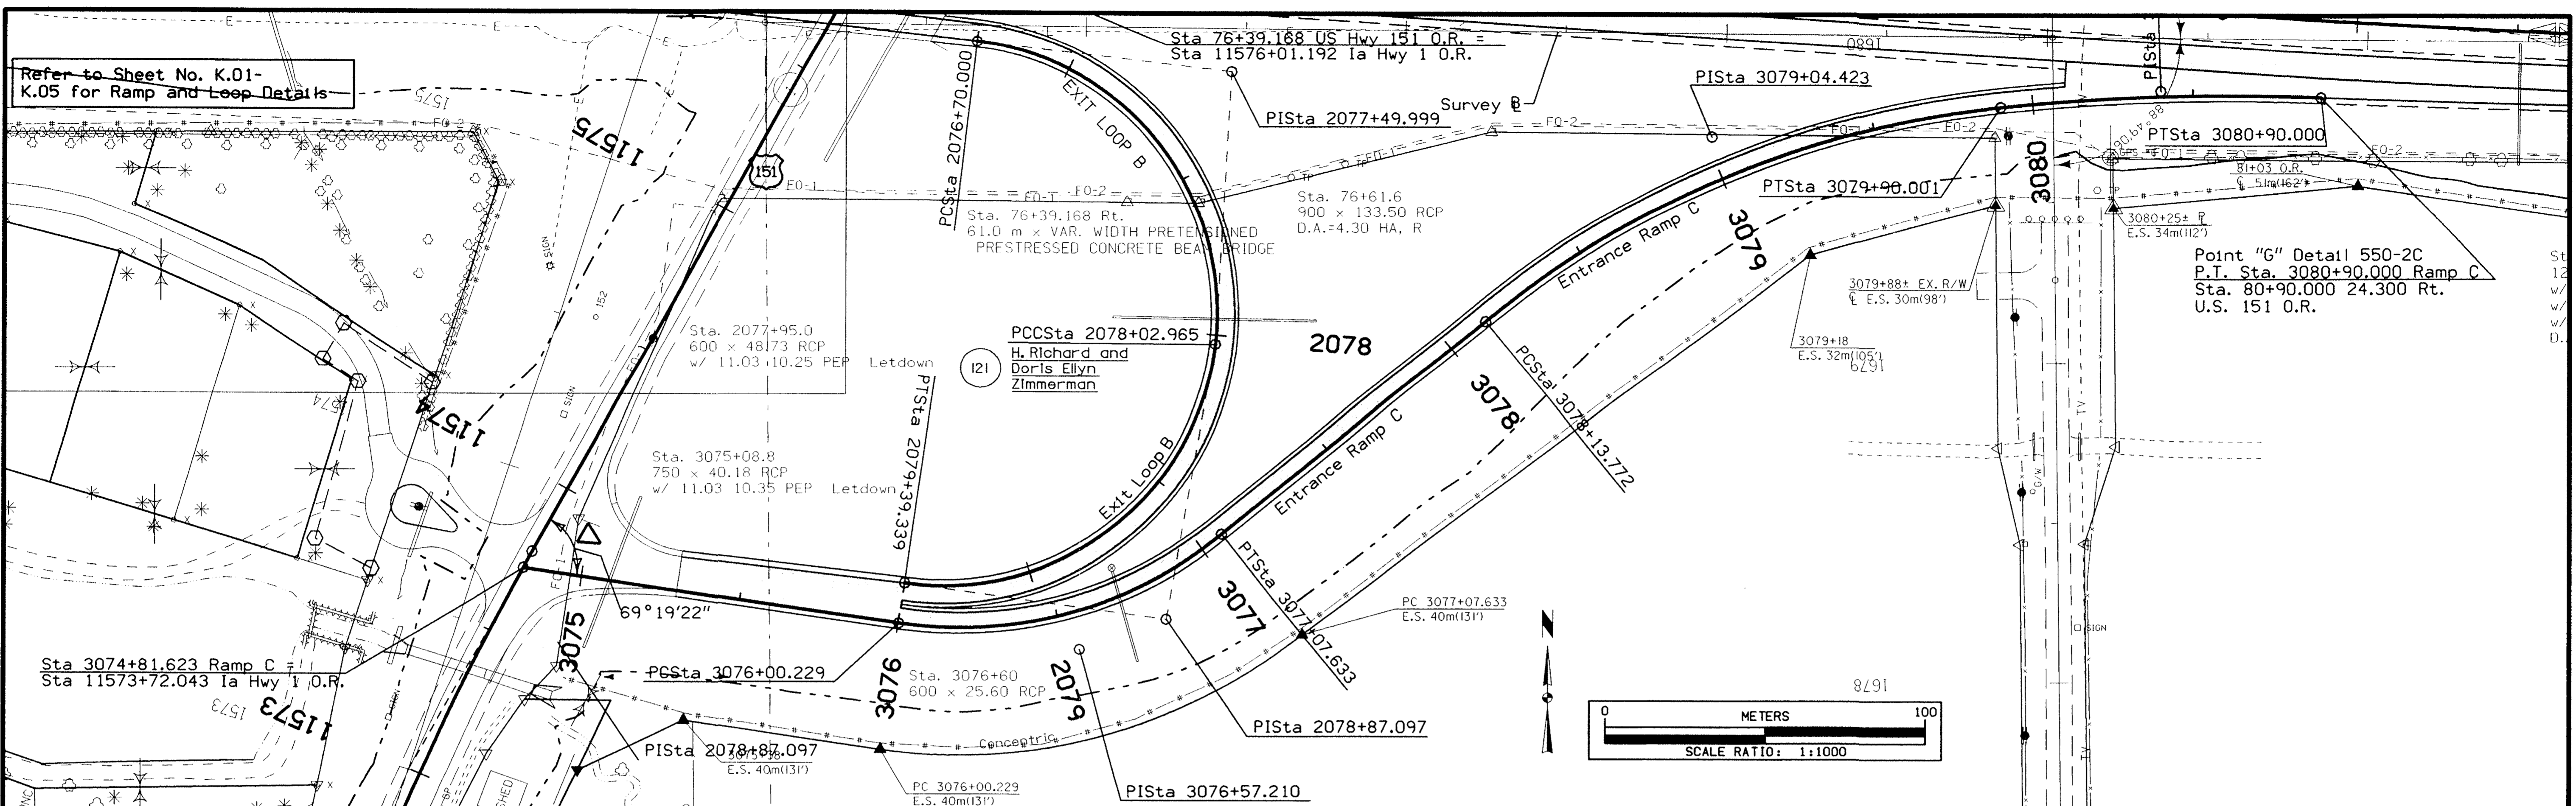

ENTRANCE RAMP C

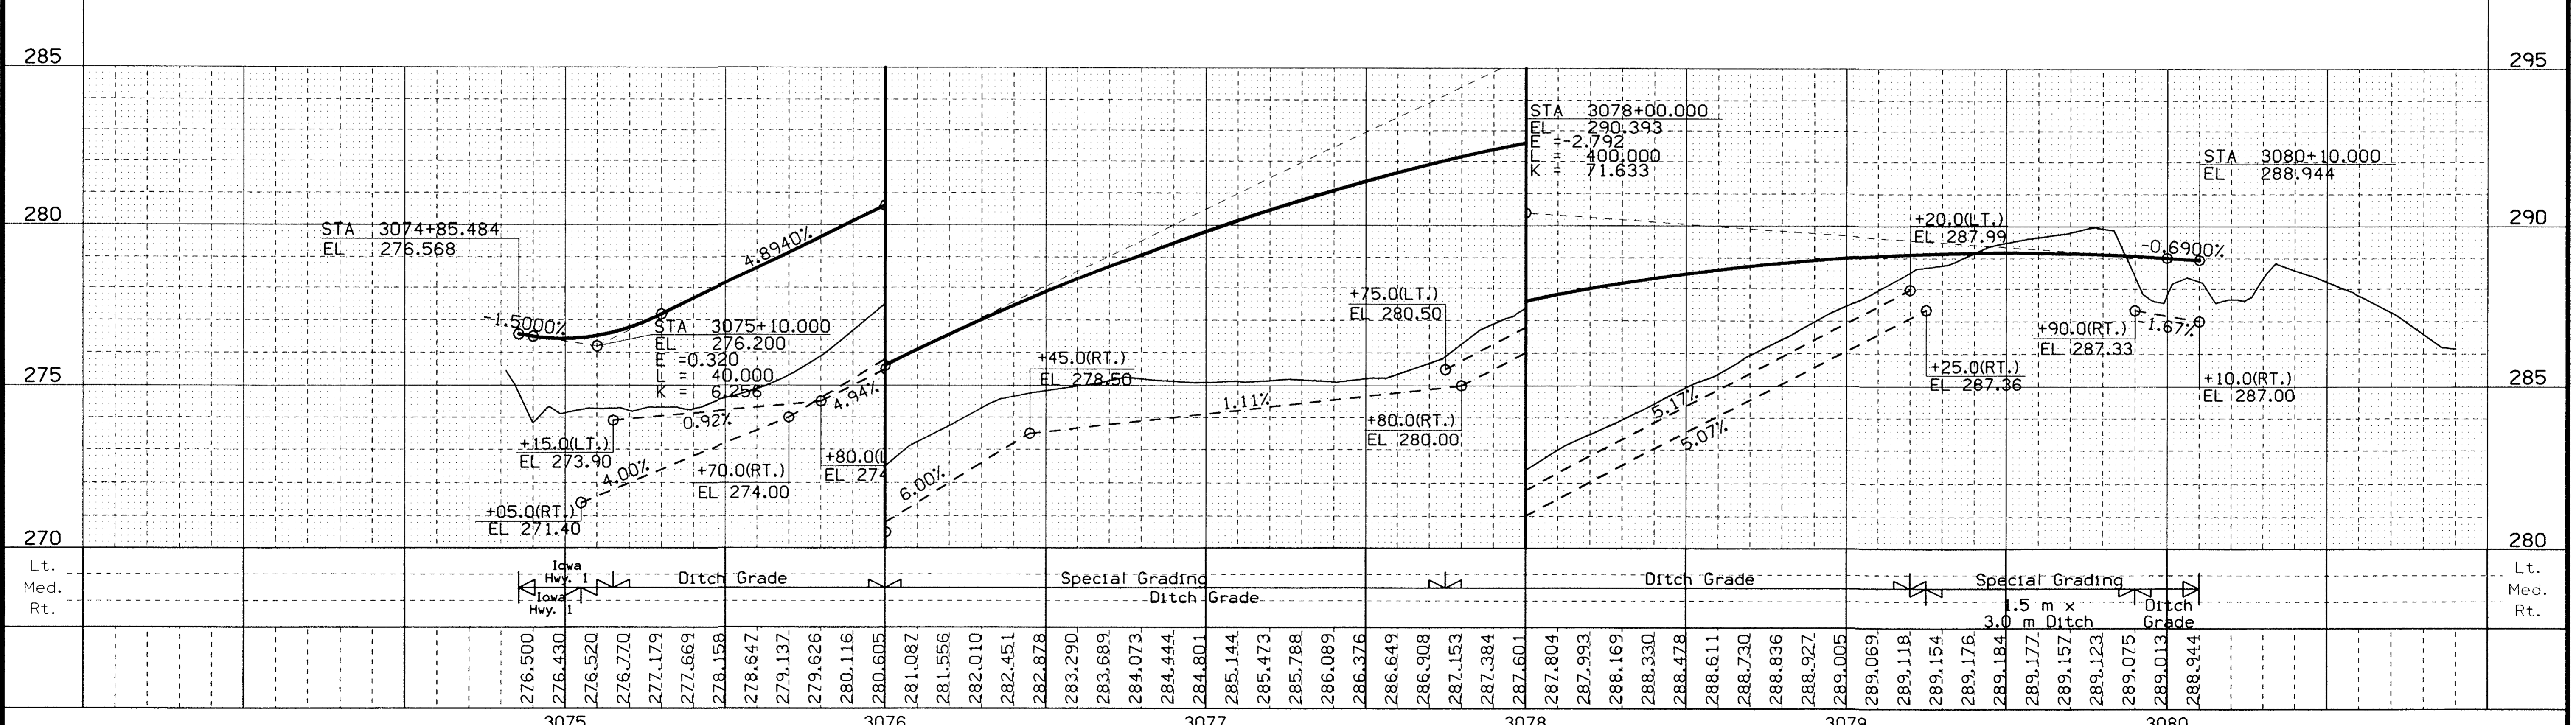

99-198

* NOTE:
Elevations to be confirmed
at time of construction
using cross-slope and existing
pavement edge elevation.

CIRCULAR CURVE DATA


101-10C
09-27-94

NO.	Δ	R	T	L	E
B-1	8.372	140	10.246	20.456	0.374
B-2	50.637	27	12.773	23.862	2.869
B-3	13.123	150	17.253	34.355	0.989
B-4	22.785	30	6.045	11.930	0.603
B-5	84.484	23	20.886	33.914	8.068
B-6	108.495	15	20.835	28.404	10.672
B-7	11.999	50	5.255	10.471	0.275
B-8	50.437	14	6.593	12.324	1.475
B-9	72.313	10	7.307	12.621	2.385
B-10	33.919	10	3.050	5.920	0.455
B-11	127.790	14	28.685	31.269	17.919
B-12	41.257	15	5.647	10.801	1.028
B-13	88.465	15	14.603	23.160	5.935
B-14	143.965	1.5	4.612	3.769	3.350
B-15	215.805	6	---	22.599	---

ISLAND DATA


101-13
09-27-94

POINT NO.	LOCATION	ELEVATION
①	Sta. 11573+87.603, 11.100 Rt.	276.652
②	Sta. 11573+93.557, 11.100 Rt.	276.730
③	Sta. 3075+04.289, 10.770 Lt.	276.681

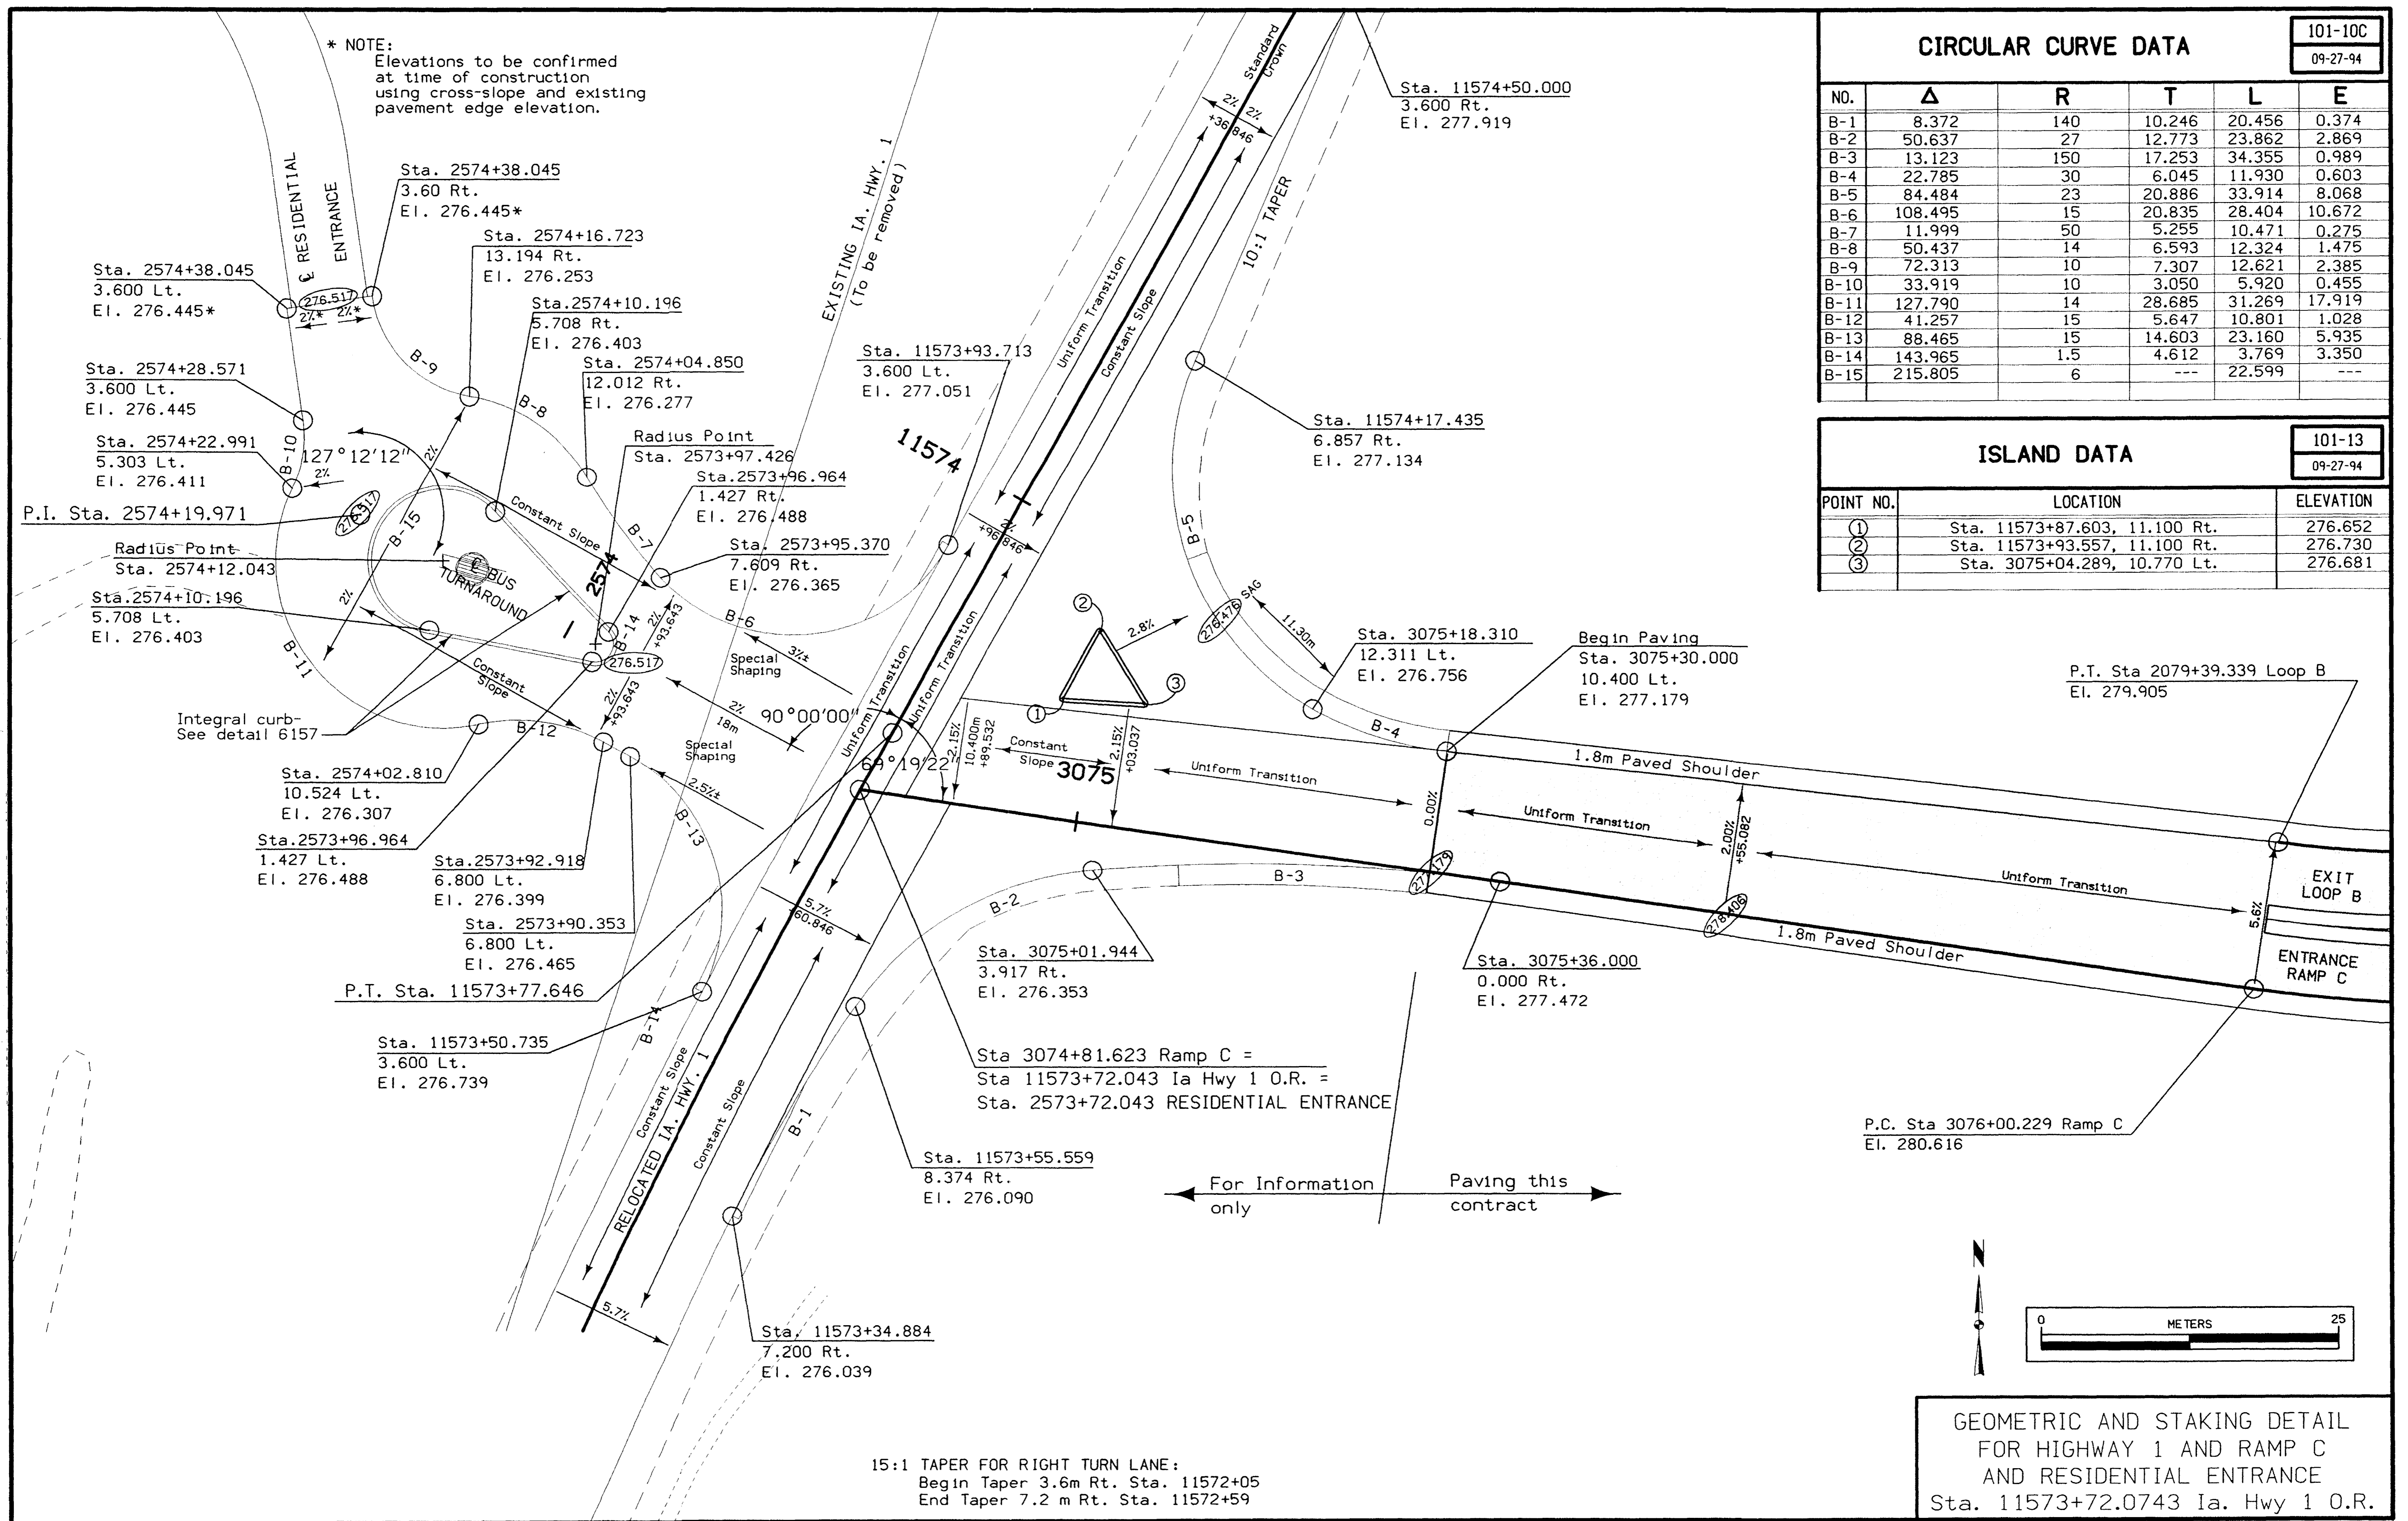


15:1 TAPER FOR RIGHT TURN LANE:
Begin Taper 3.6m Rt. Sta. 11572+05
End Taper 7.2 m Rt. Sta. 11572+59

GEOMETRIC AND STAKING DETAIL
FOR HIGHWAY 1 AND RAMP C
AND RESIDENTIAL ENTRANCE
Sta. 11573+72.0743 Ia. Hwy 1 O.R.

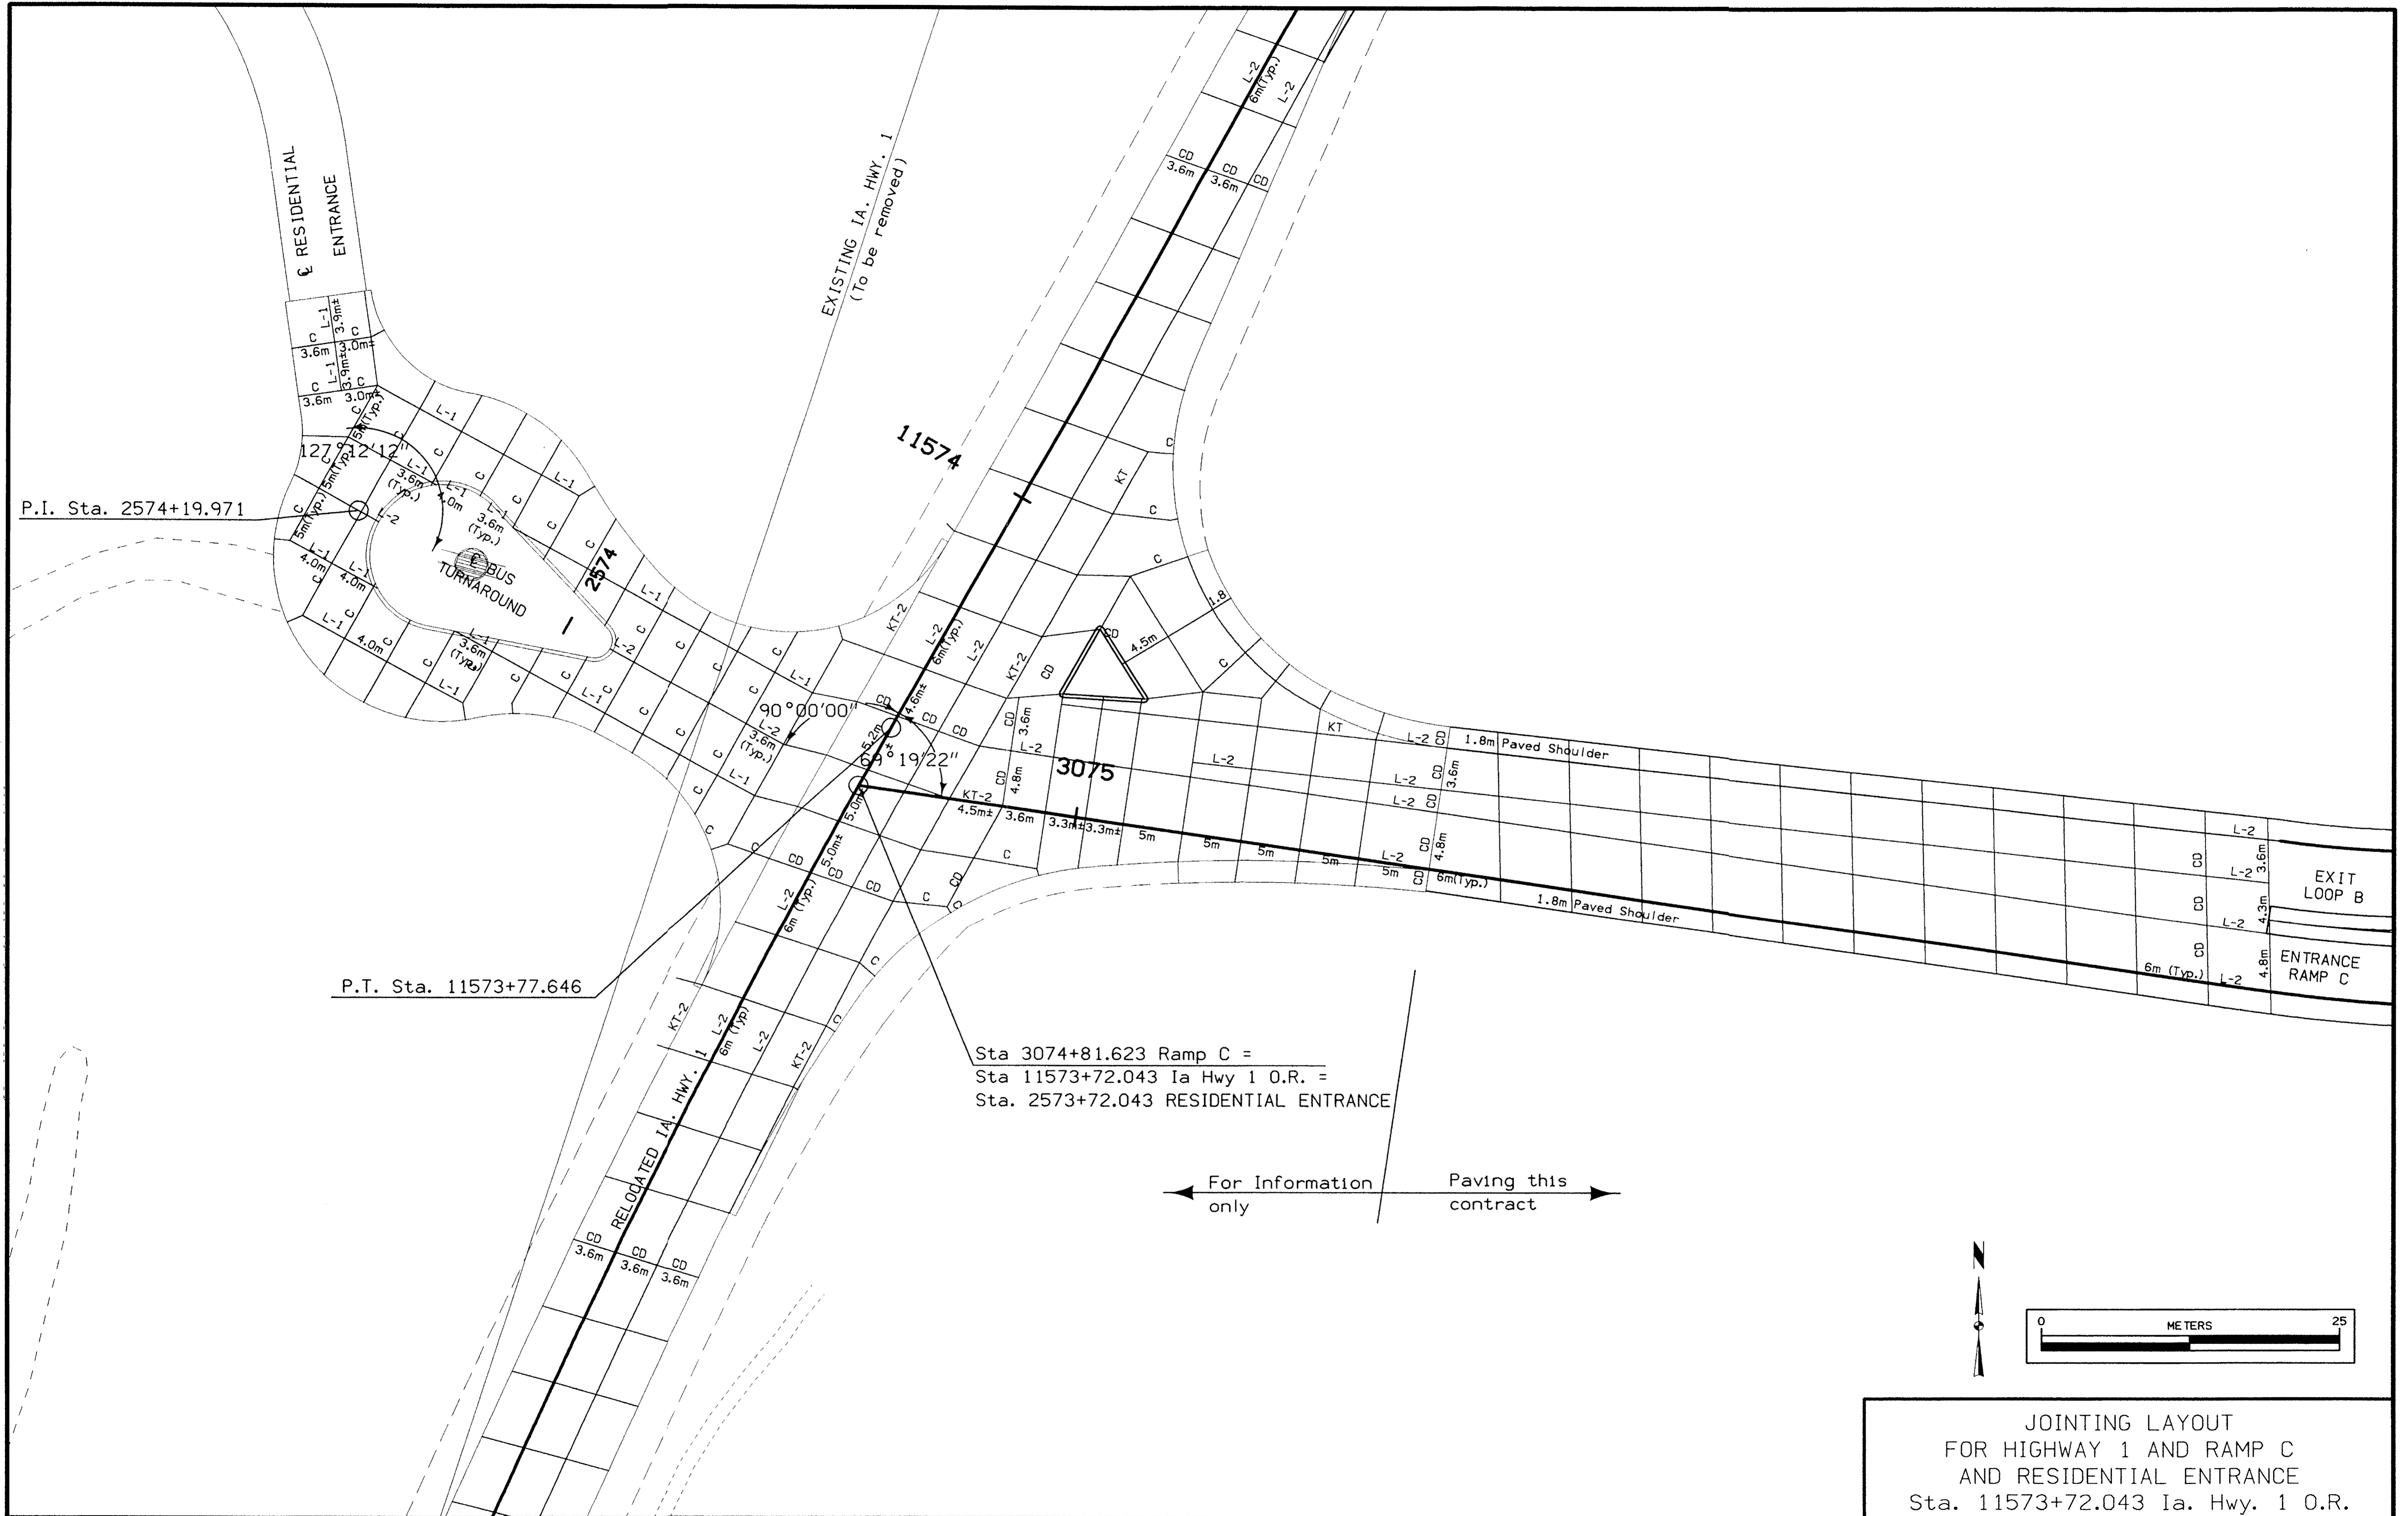


Sta 3074+81.623 Ramp C =
 Sta 11573+72.043 Ia Hwy 1 O.R. =
 Sta. 2573+72.043 RESIDENTIAL ENTRANCE

← For Information only Paving this contract →


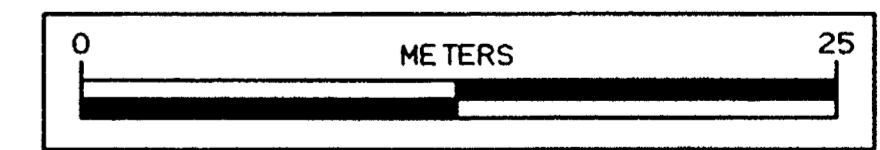


JOINTING LAYOUT
 FOR HIGHWAY 1 AND RAMP C
 AND RESIDENTIAL ENTRANCE
 Sta. 11573+72.043 Ia. Hwy. 1 O.R.

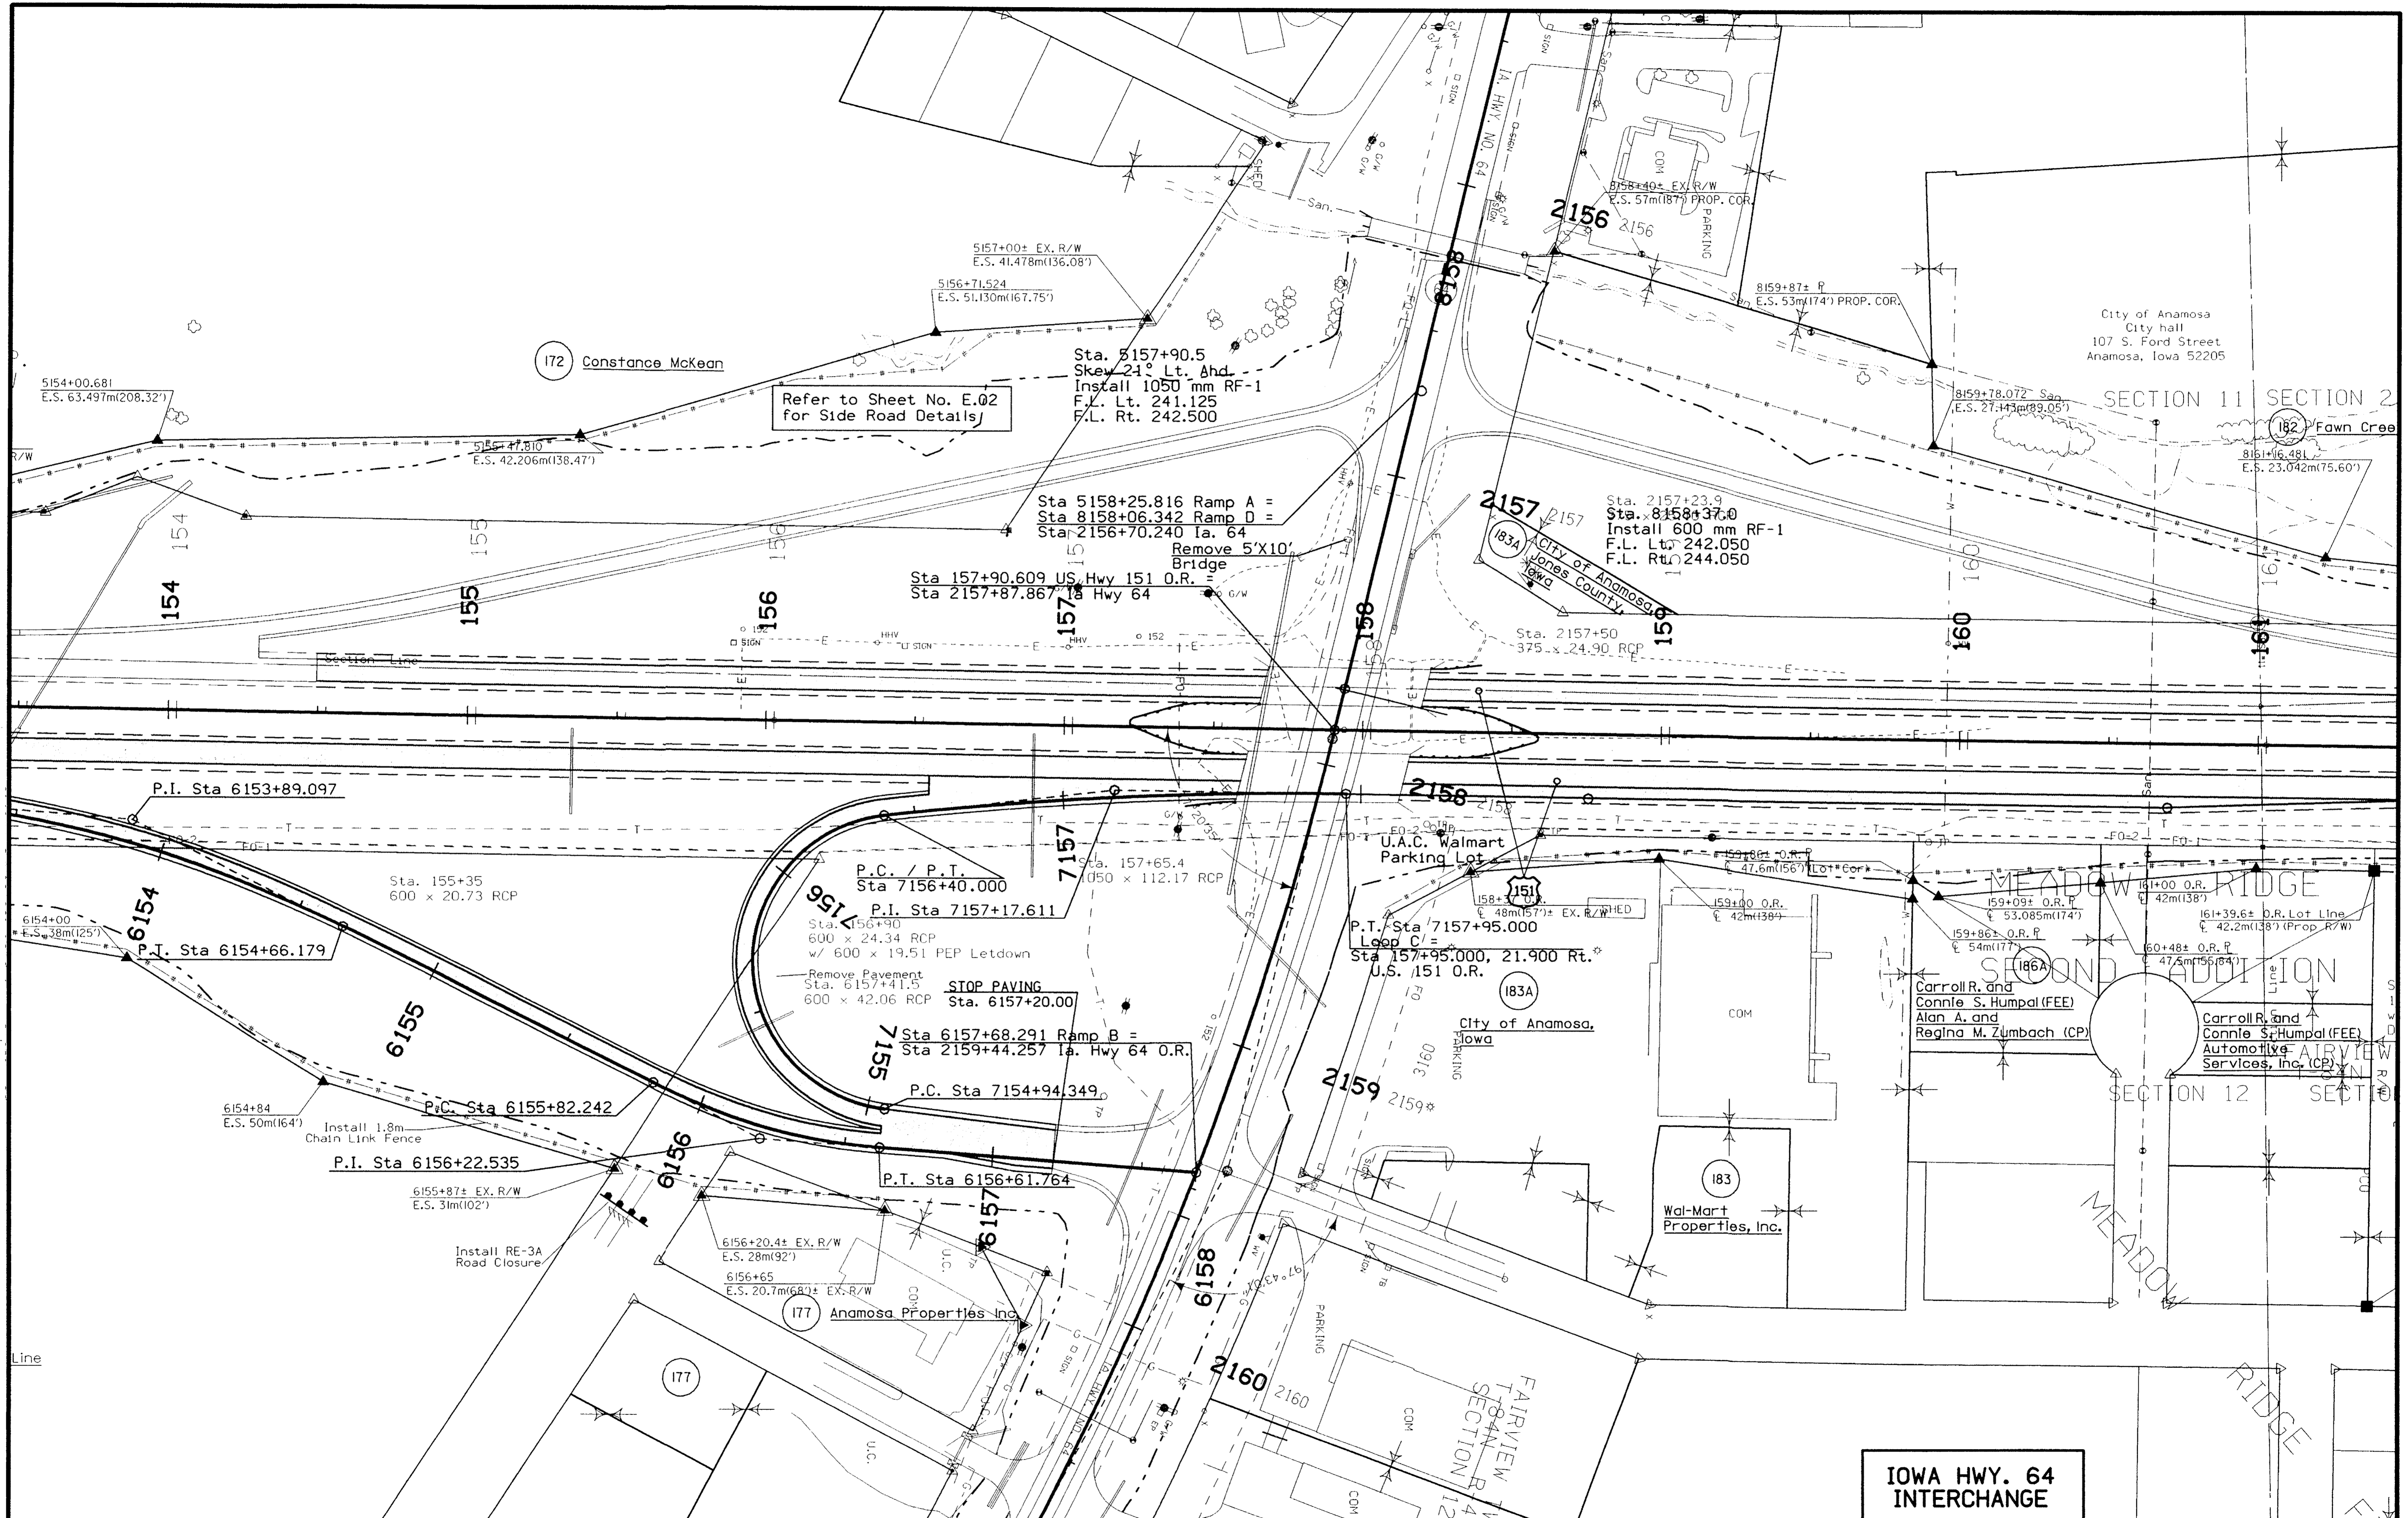


Refer to Sheet No. E.02
for Side Road Details

IOWA HWY. 64
INTERCHANGE

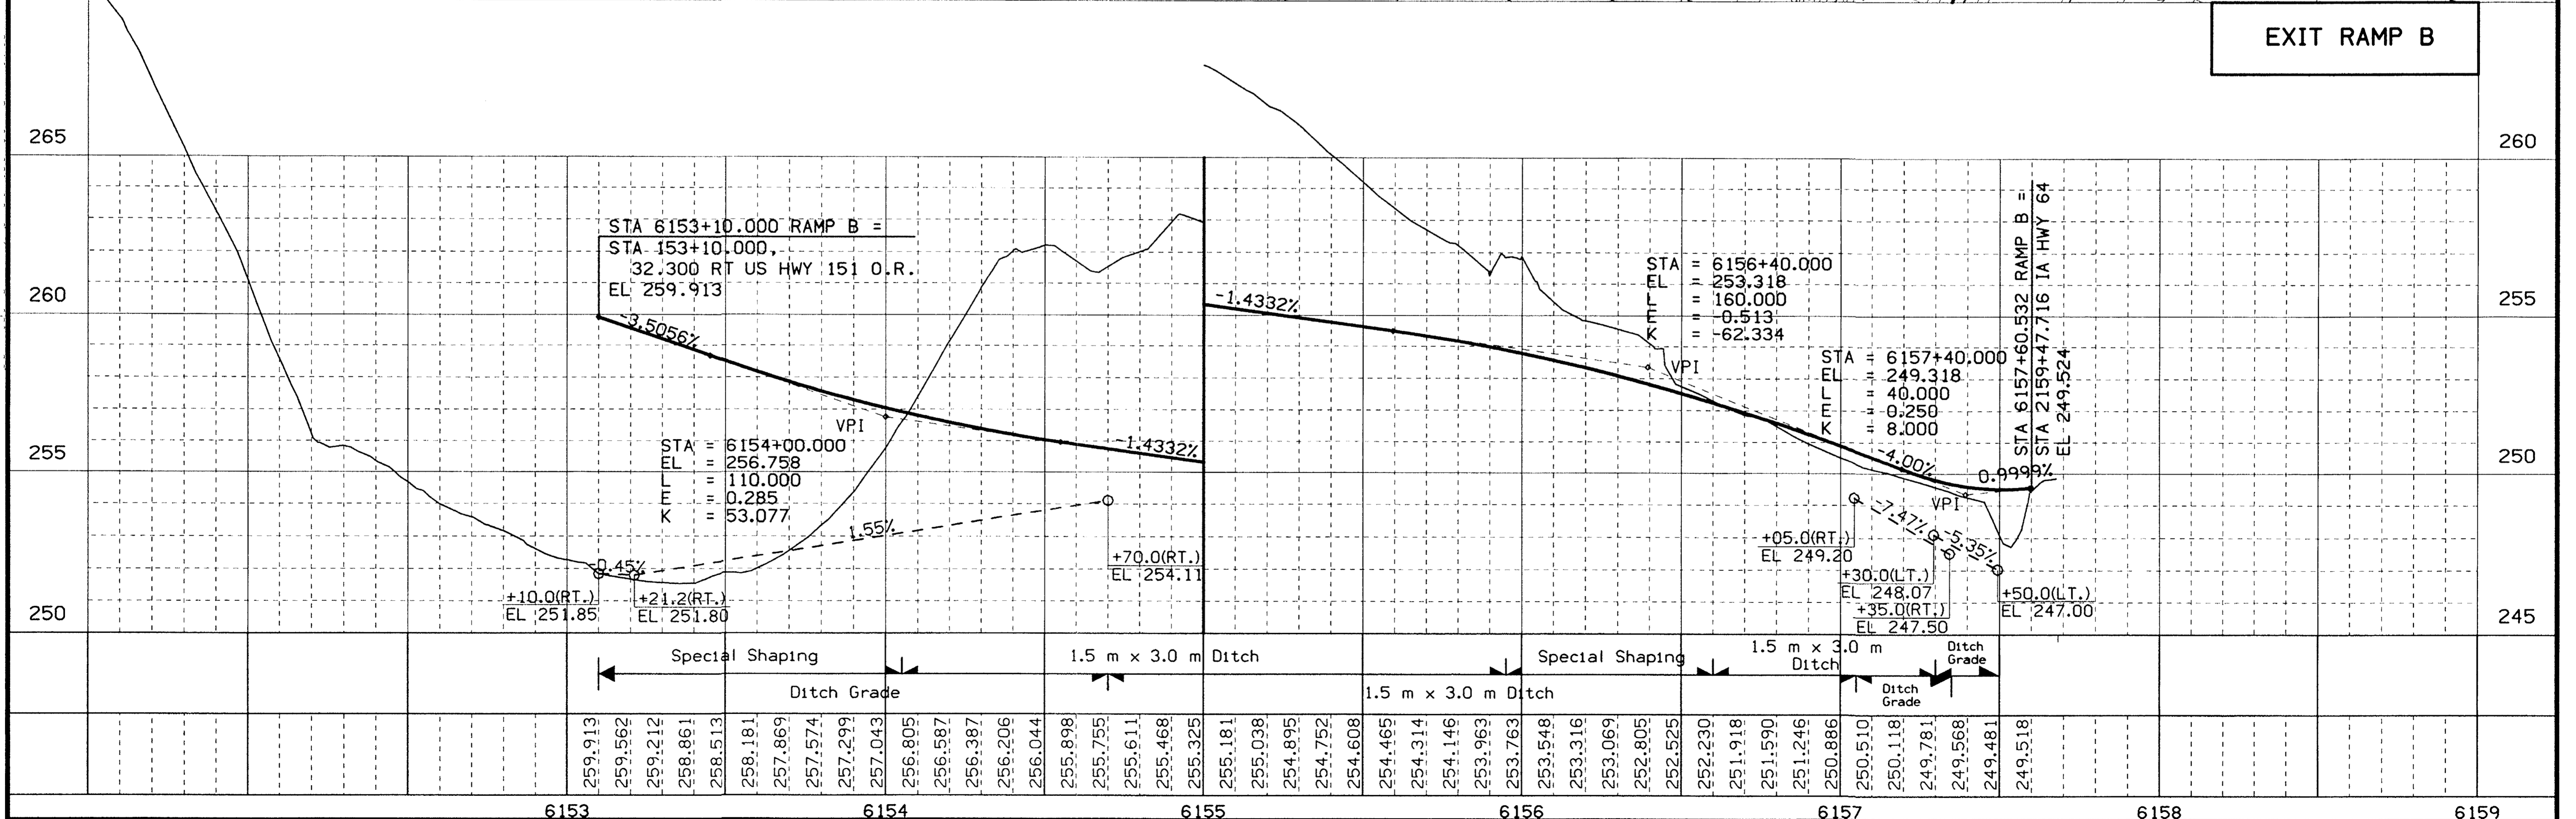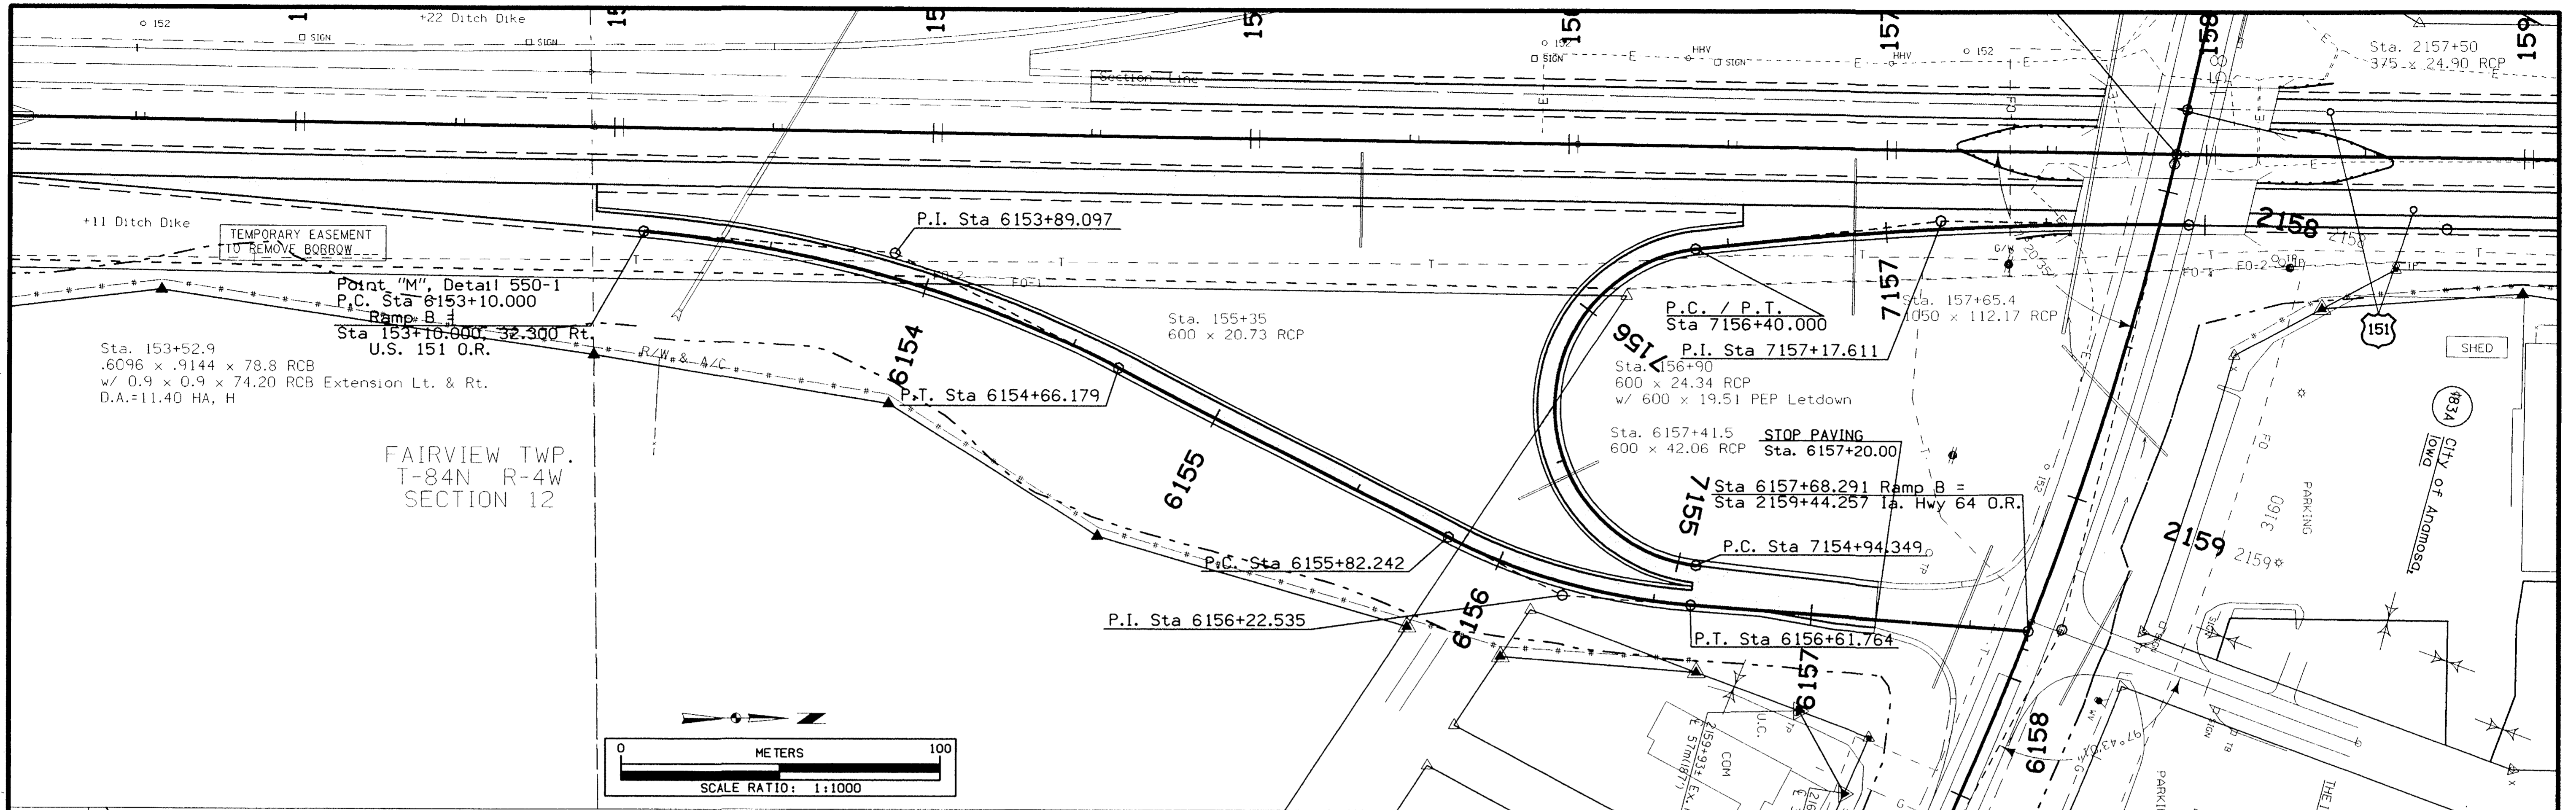


6153	6154	6155	6156	6157	6158	6159
------	------	------	------	------	------	------

DESIGN TEAM Skogerboe / EARTH TECH METRIC IOWA DOT * OFFICE OF ROAD DESIGN Linn/Jones COUNTY PROJECT NUMBER NHSX-151-3(112)--3H-57 SHEET NUMBER K.07

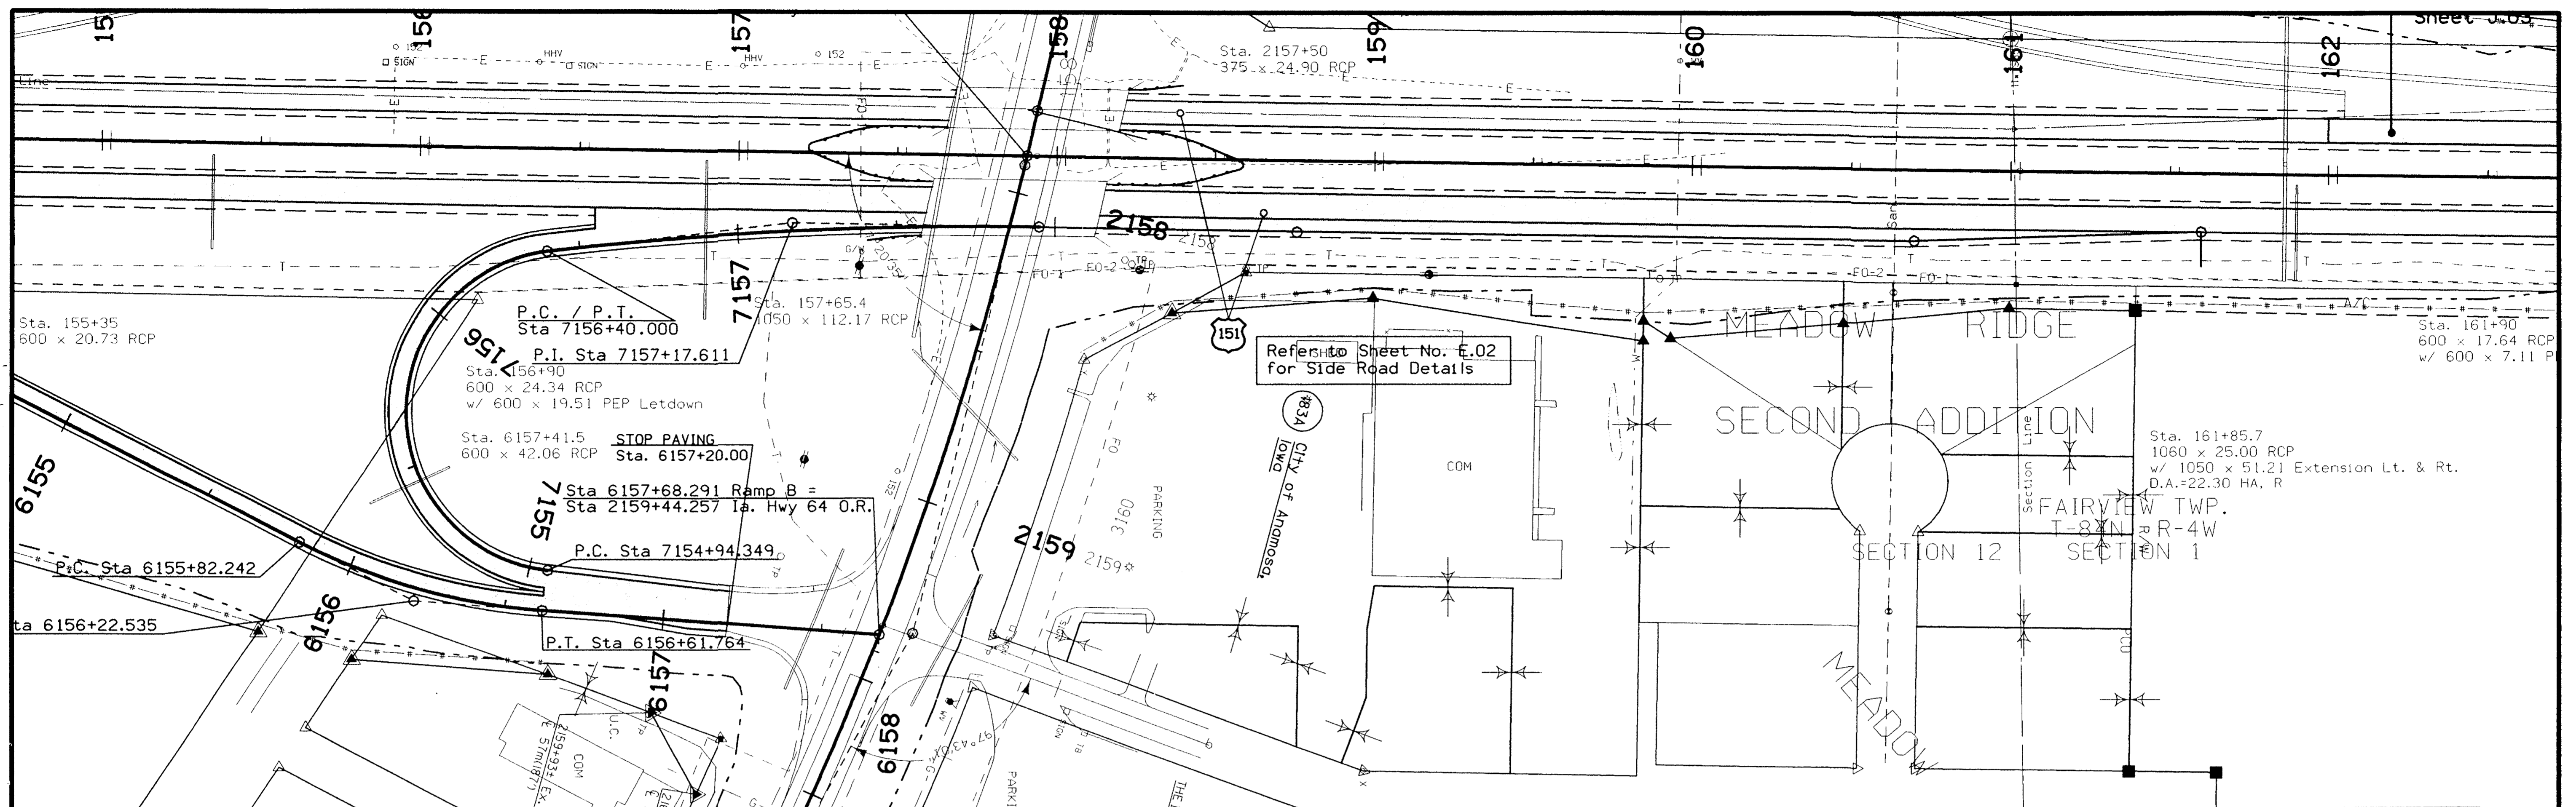

ENTRANCE LOOP C

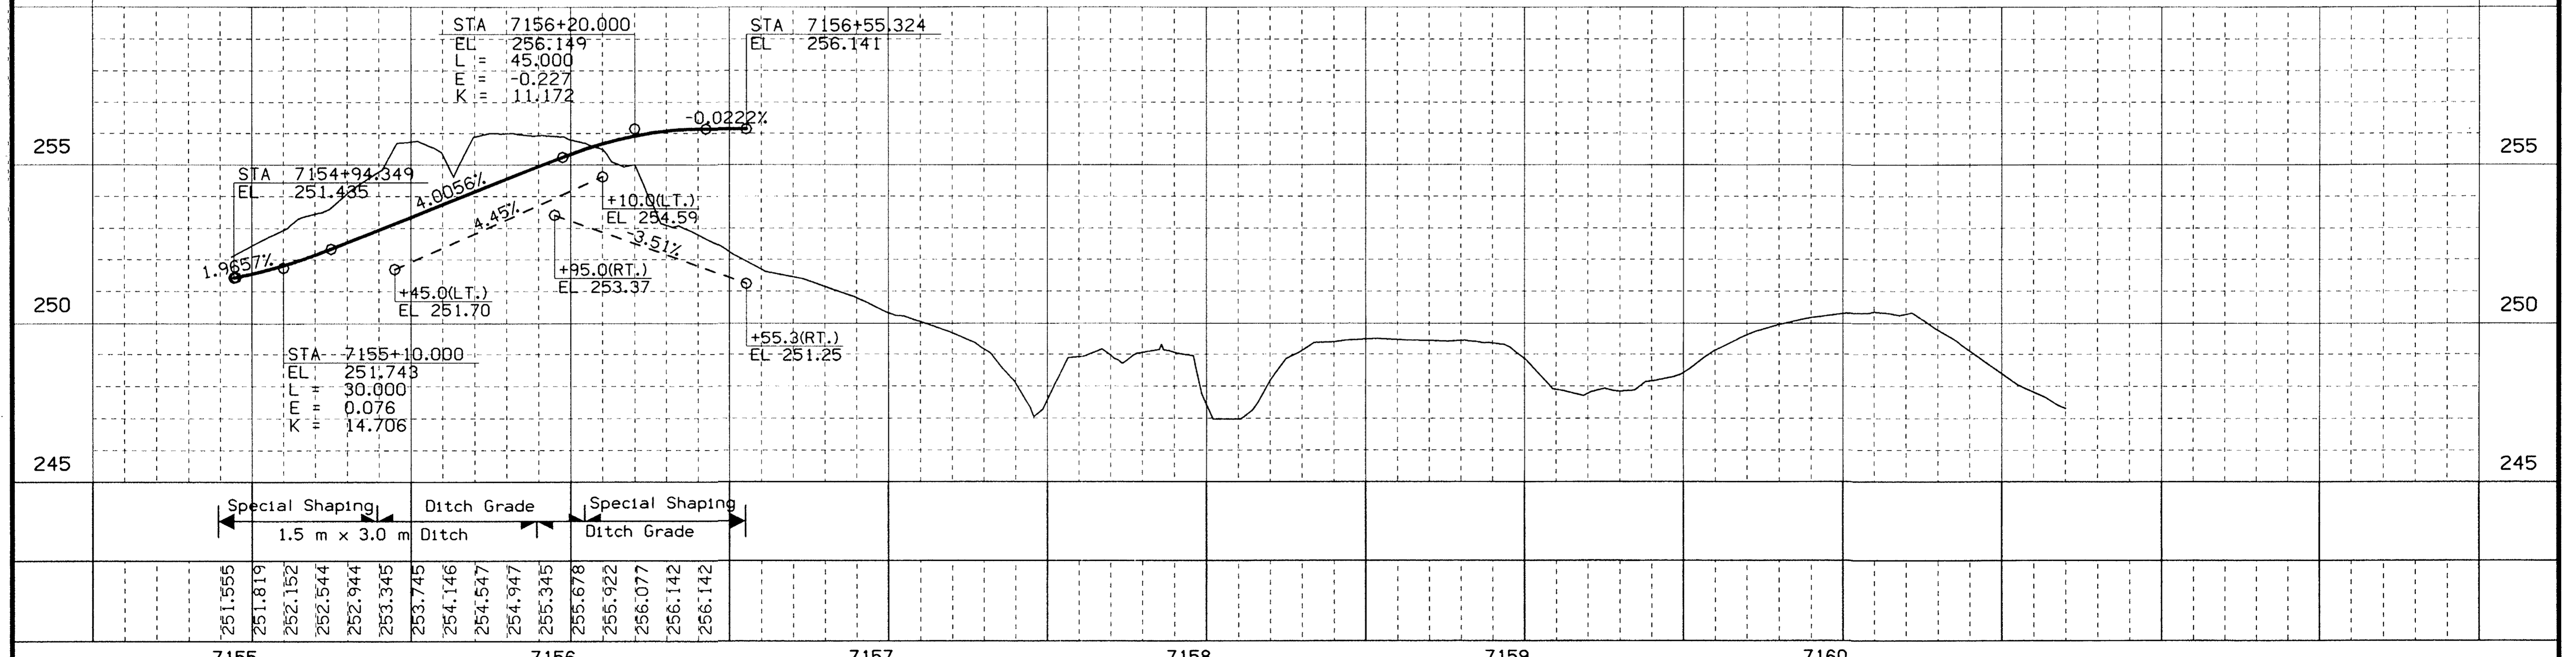

Special Shaping 1.5 m x 3.0 m Ditch
 Ditch Grade
 Special Shaping 1.5 m x 3.0 m Ditch


7155	7156	7157	7158	7159	7160
DESIGN TEAM	Skogerboe / EARTH TECH	METRIC	IOWA DOT * OFFICE OF ROAD DESIGN	Linn/Jones	COUNTY
PROJECT NUMBER				NHSX-151-3(112)--3H-57	
SHEET NUMBER				K.08	

CIRCULAR CURVE DATA

101-10C
09-27-94

NO.	Δ	R	T	L	E
B-1	12.100	75	7.949	15.839	0.420
B-2	51.197	25	11.977	22.339	2.721
B-3	14.069	120	14.807	29.466	0.910
B-4	80.363	20	16.890	28.052	6.178
B-5	16.738	120	17.653	35.055	1.292
B-6	16.683	60	8.797	17.470	0.641
B-7	55.359	20	10.491	19.324	2.585
B-8	7.161	100	6.257	12.498	0.196
B-9	89.420	15	14.849	23.410	6.107

STOP PAVING
Sta. 6157+20.00

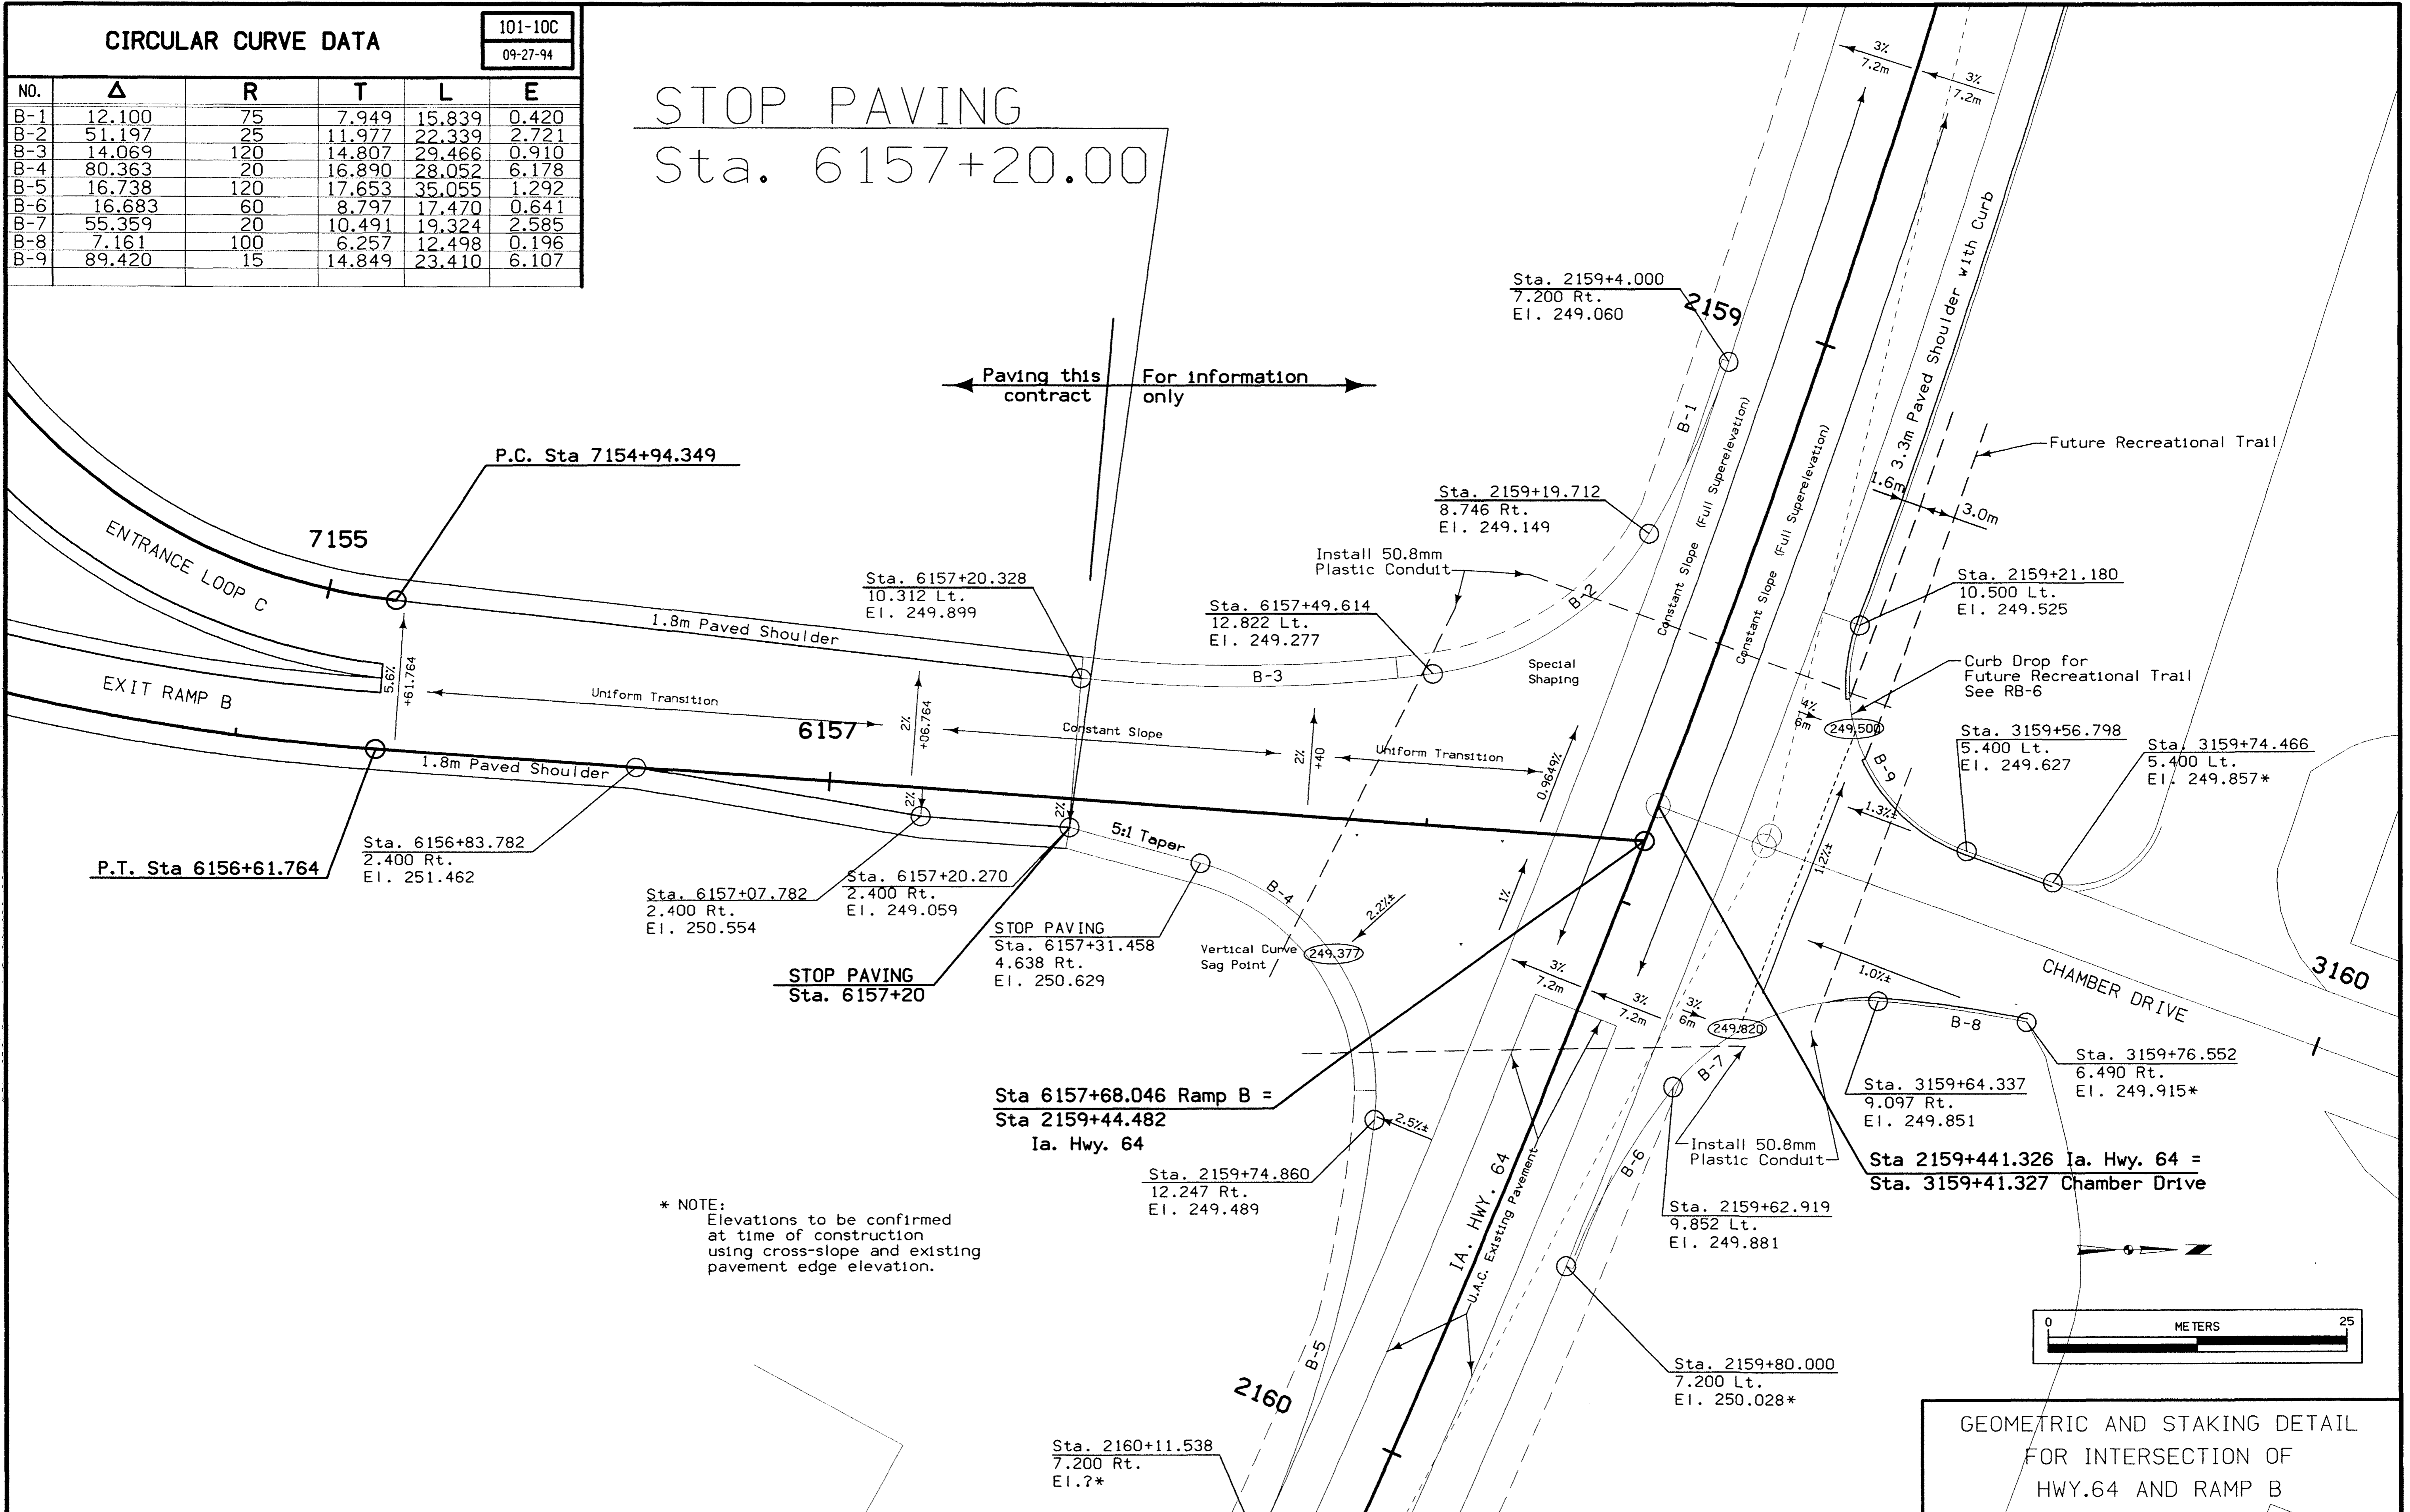

* NOTE:
Elevations to be confirmed
at time of construction
using cross-slope and existing
pavement edge elevation.



GEOMETRIC AND STAKING DETAIL
FOR INTERSECTION OF
HWY.64 AND RAMP B

STOP PAVING Sta. 6157+20.00

← Paving this contract For information only →



STOP PAVING
Sta. 6157+20

Sta 6157+68.046 Ramp B =
Sta 2159+44.482
Ia. Hwy. 64

Sta 2159+441.326 Ia. Hwy. 64 =
Sta. 3159+41.327 Chamber Drive

Match Existing
Transverse Joints




JOINTING LAYOUT
FOR INTERSECTION OF
HWY.64 AND RAMP B

CIRCULAR CURVE DATA

101-10C
09-27-94

NO.	Δ	R	T	L	E
C-1	70.560	8	5.660	9.852	1.800
C-2	92.903	15	15.780	24.322	6.772
C-3	13.633	150	17.930	35.690	1.068
C-4	51.927	24	11.687	21.751	2.694
C-5	112.357	13	19.403	25.493	10.356
C-6	15.700	45	6.204	12.331	0.426


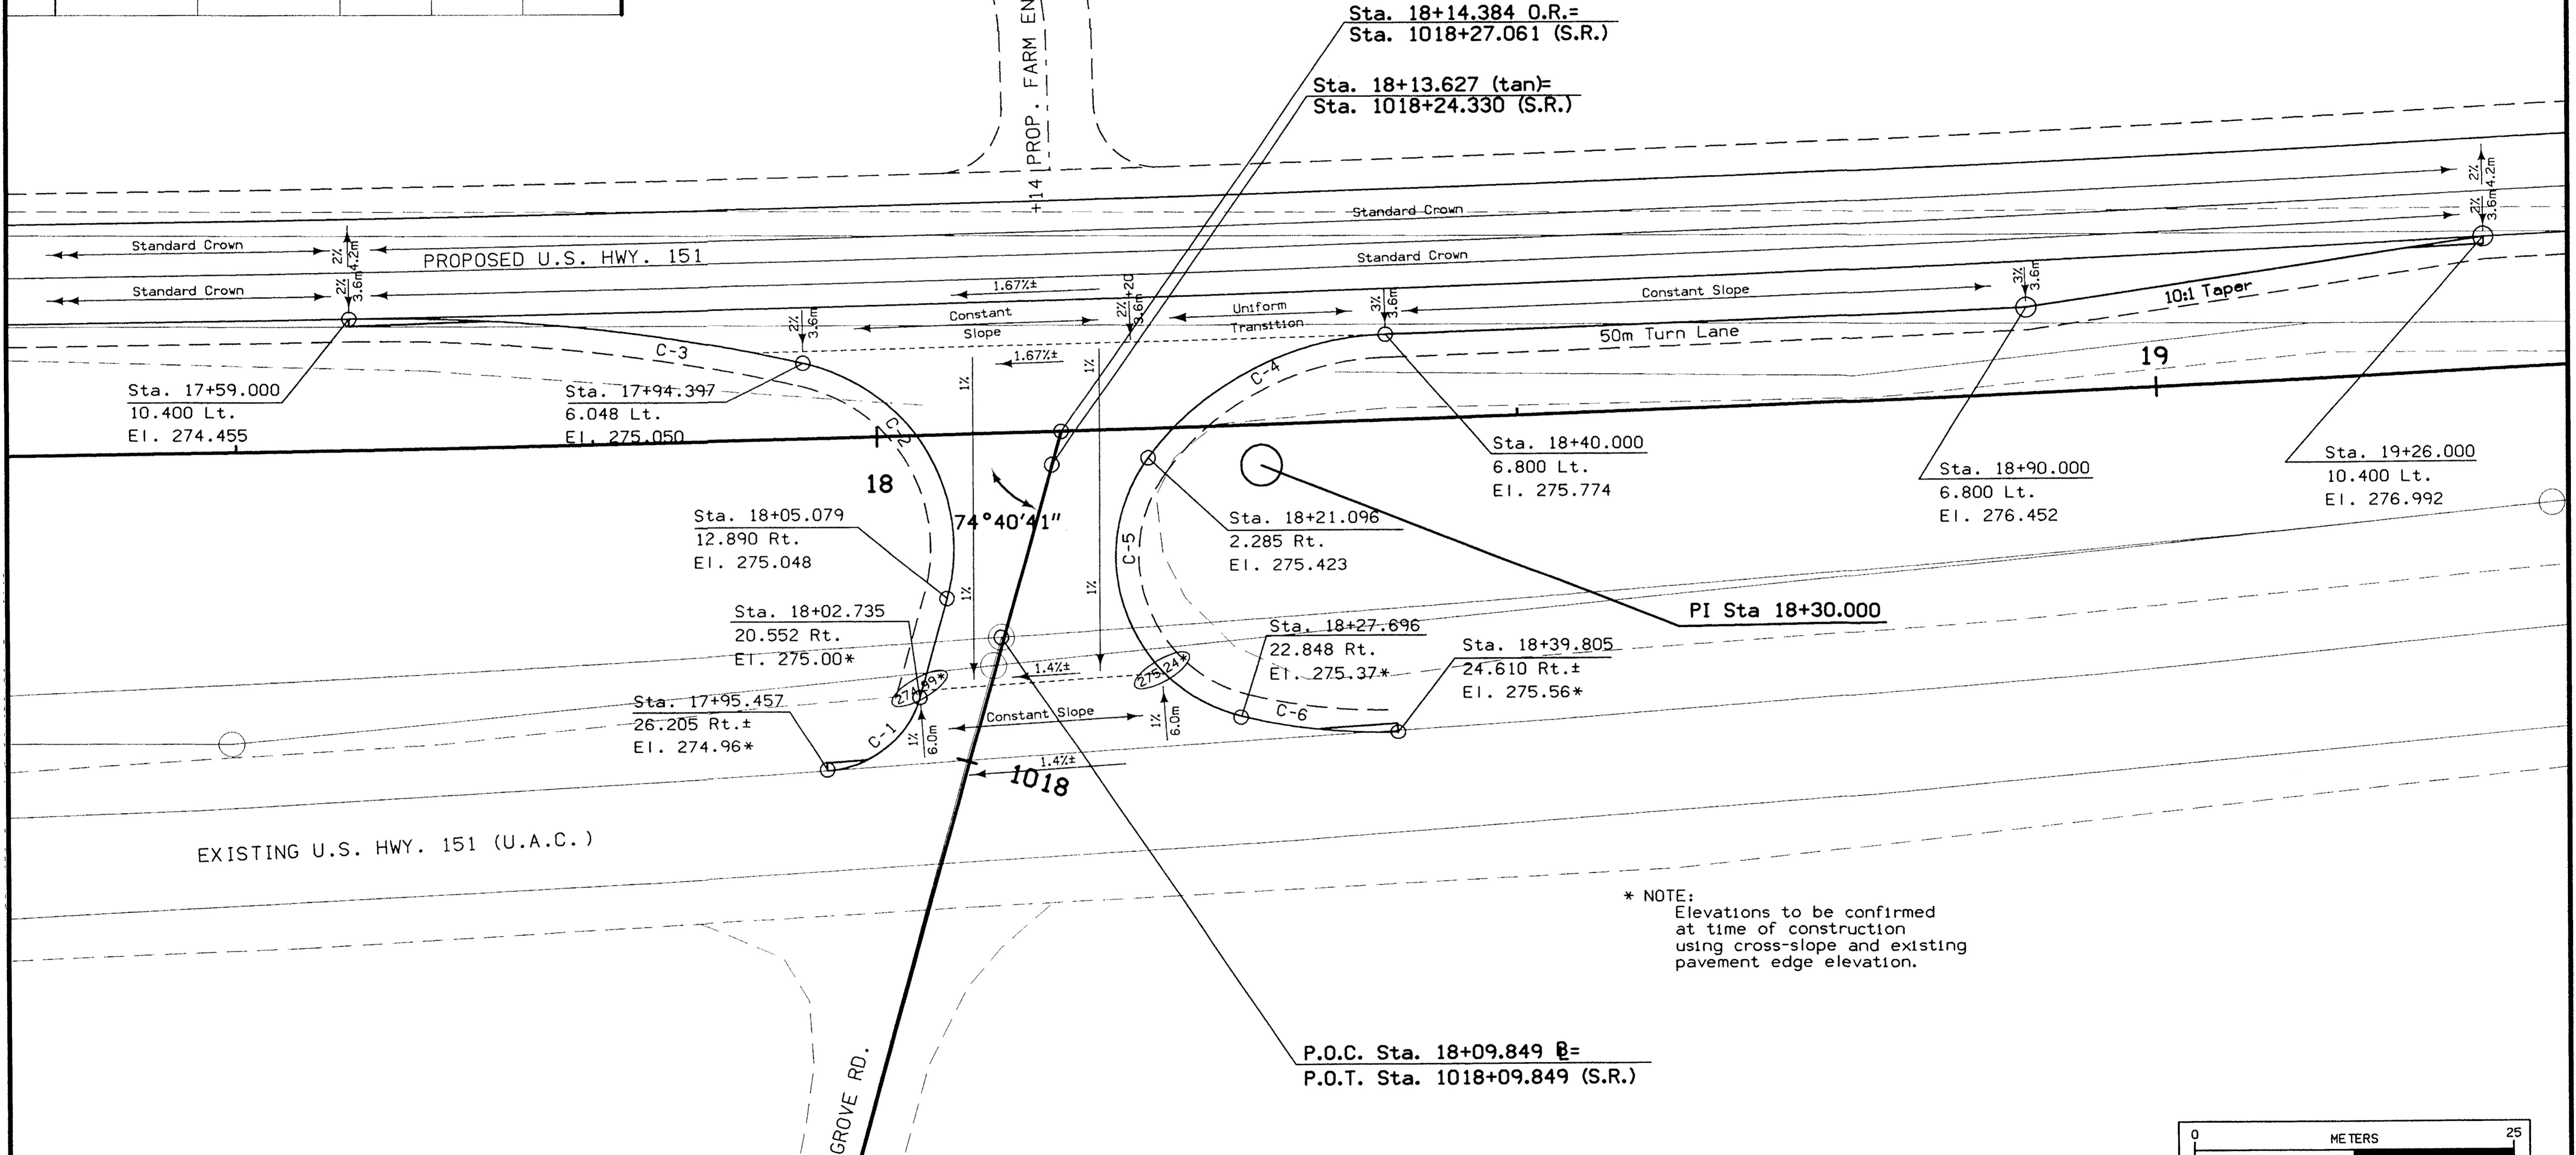


INTERSECTION PAVING REQUIREMENTS

101-12
09-27-94

TYPE	UNIT	AMOUNT	DESCRIPTION
Pavement	m ²	1115	Median Crossover
Island	m ²		
Curb	m		



GEOMETRIC AND STAKING DETAIL
FOR INTERSECTION OF
U.S. HWY. 151 WITH LINN GROVE RD.
AT STA. 18+14.384 O.R.

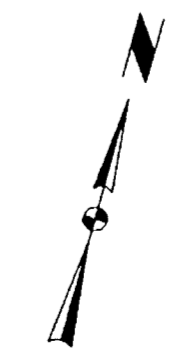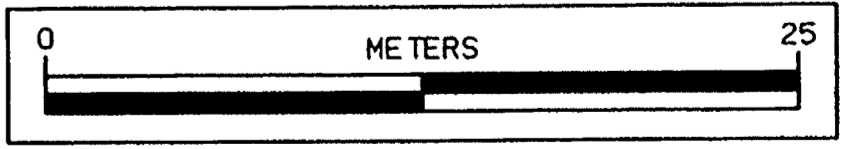

CIRCULAR CURVE DATA

101-10C
09-27-94

NO.	Δ	R	T	L	E
C-1	70.560	8	5.660	9.852	1.800
C-2	92.903	15	15.780	24.322	6.772
C-3	13.633	150	17.930	35.690	1.068
C-4	51.927	24	11.687	21.751	2.694
C-5	112.357	13	19.403	25.493	10.356
C-6	15.700	45	6.204	12.331	0.426

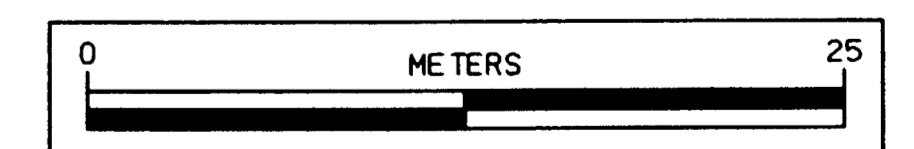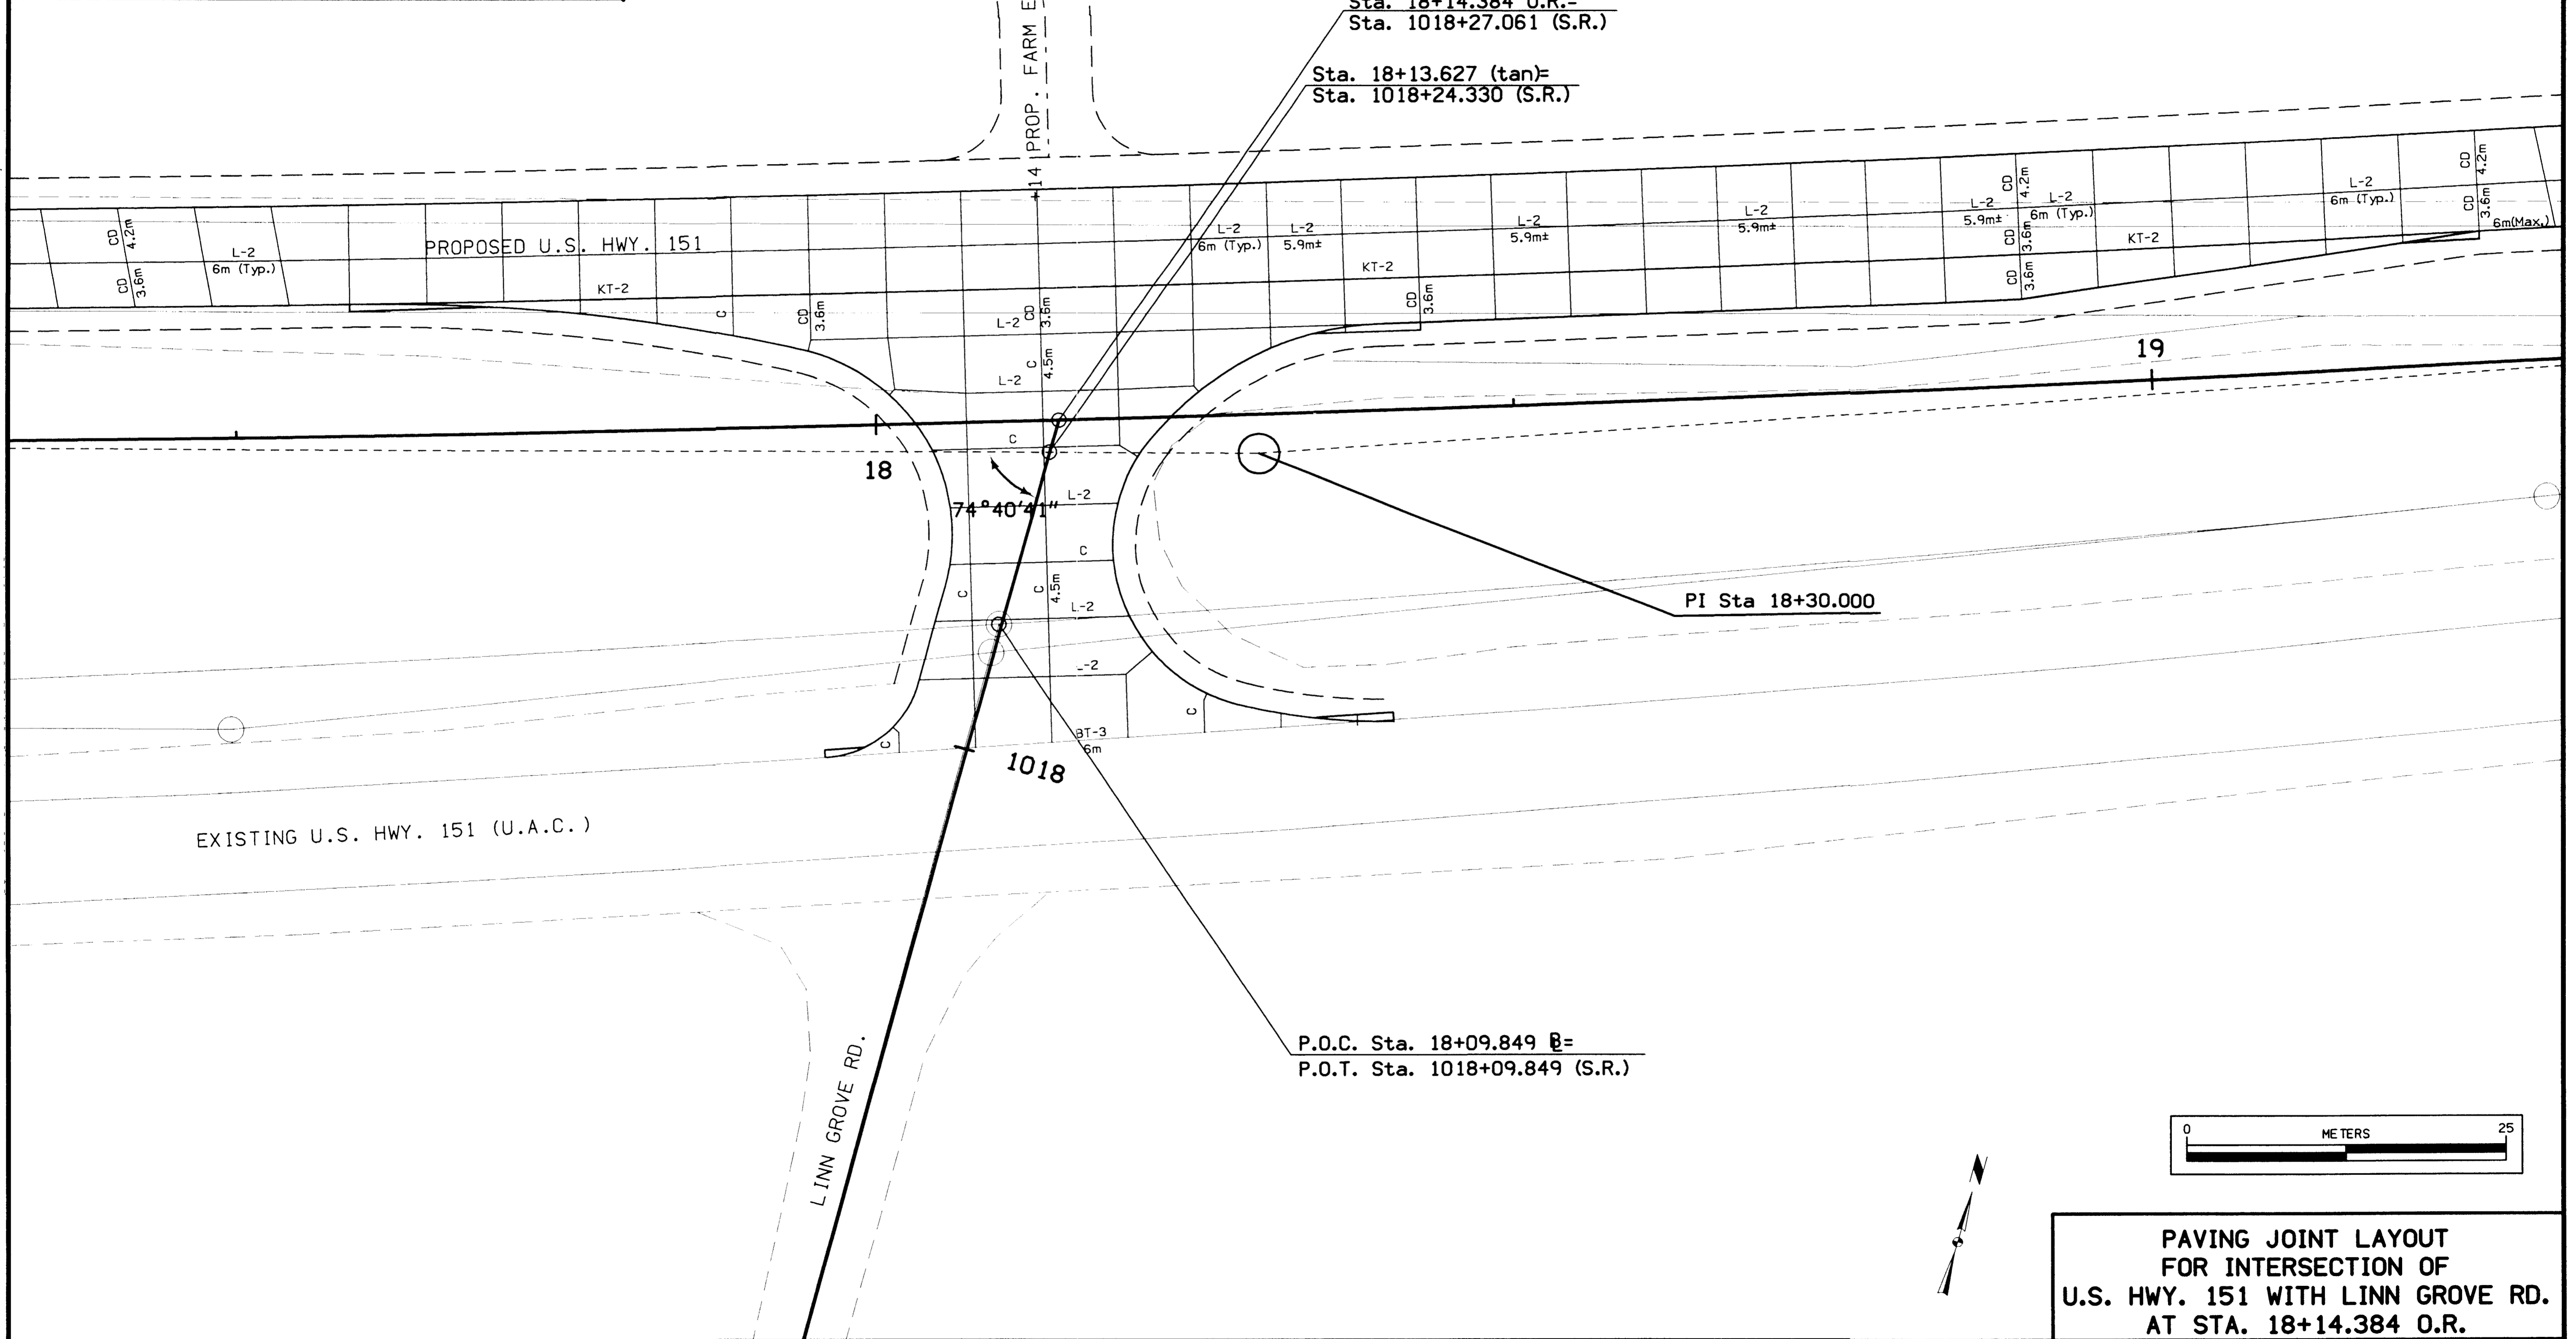


**PAVING JOINT LAYOUT
FOR INTERSECTION OF
U.S. HWY. 151 WITH LINN GROVE RD.
AT STA. 18+14.384 O.R.**

CIRCULAR CURVE DATA

101-10C
09-27-94

NO.	Δ	R	T	L	E
D-1	30.248	15	4.054	7.919	0.538
D-2	99.626	5	5.919	8.694	2.749
D-3	34.180	18	5.534	10.738	0.832
D-4	15.906	135	18.860	37.478	1.311
D-5	43.654	20	8.010	15.238	1.544
D-6	109.286	5	7.047	9.537	3.641
D-7	27.015	30	7.207	14.145	0.853

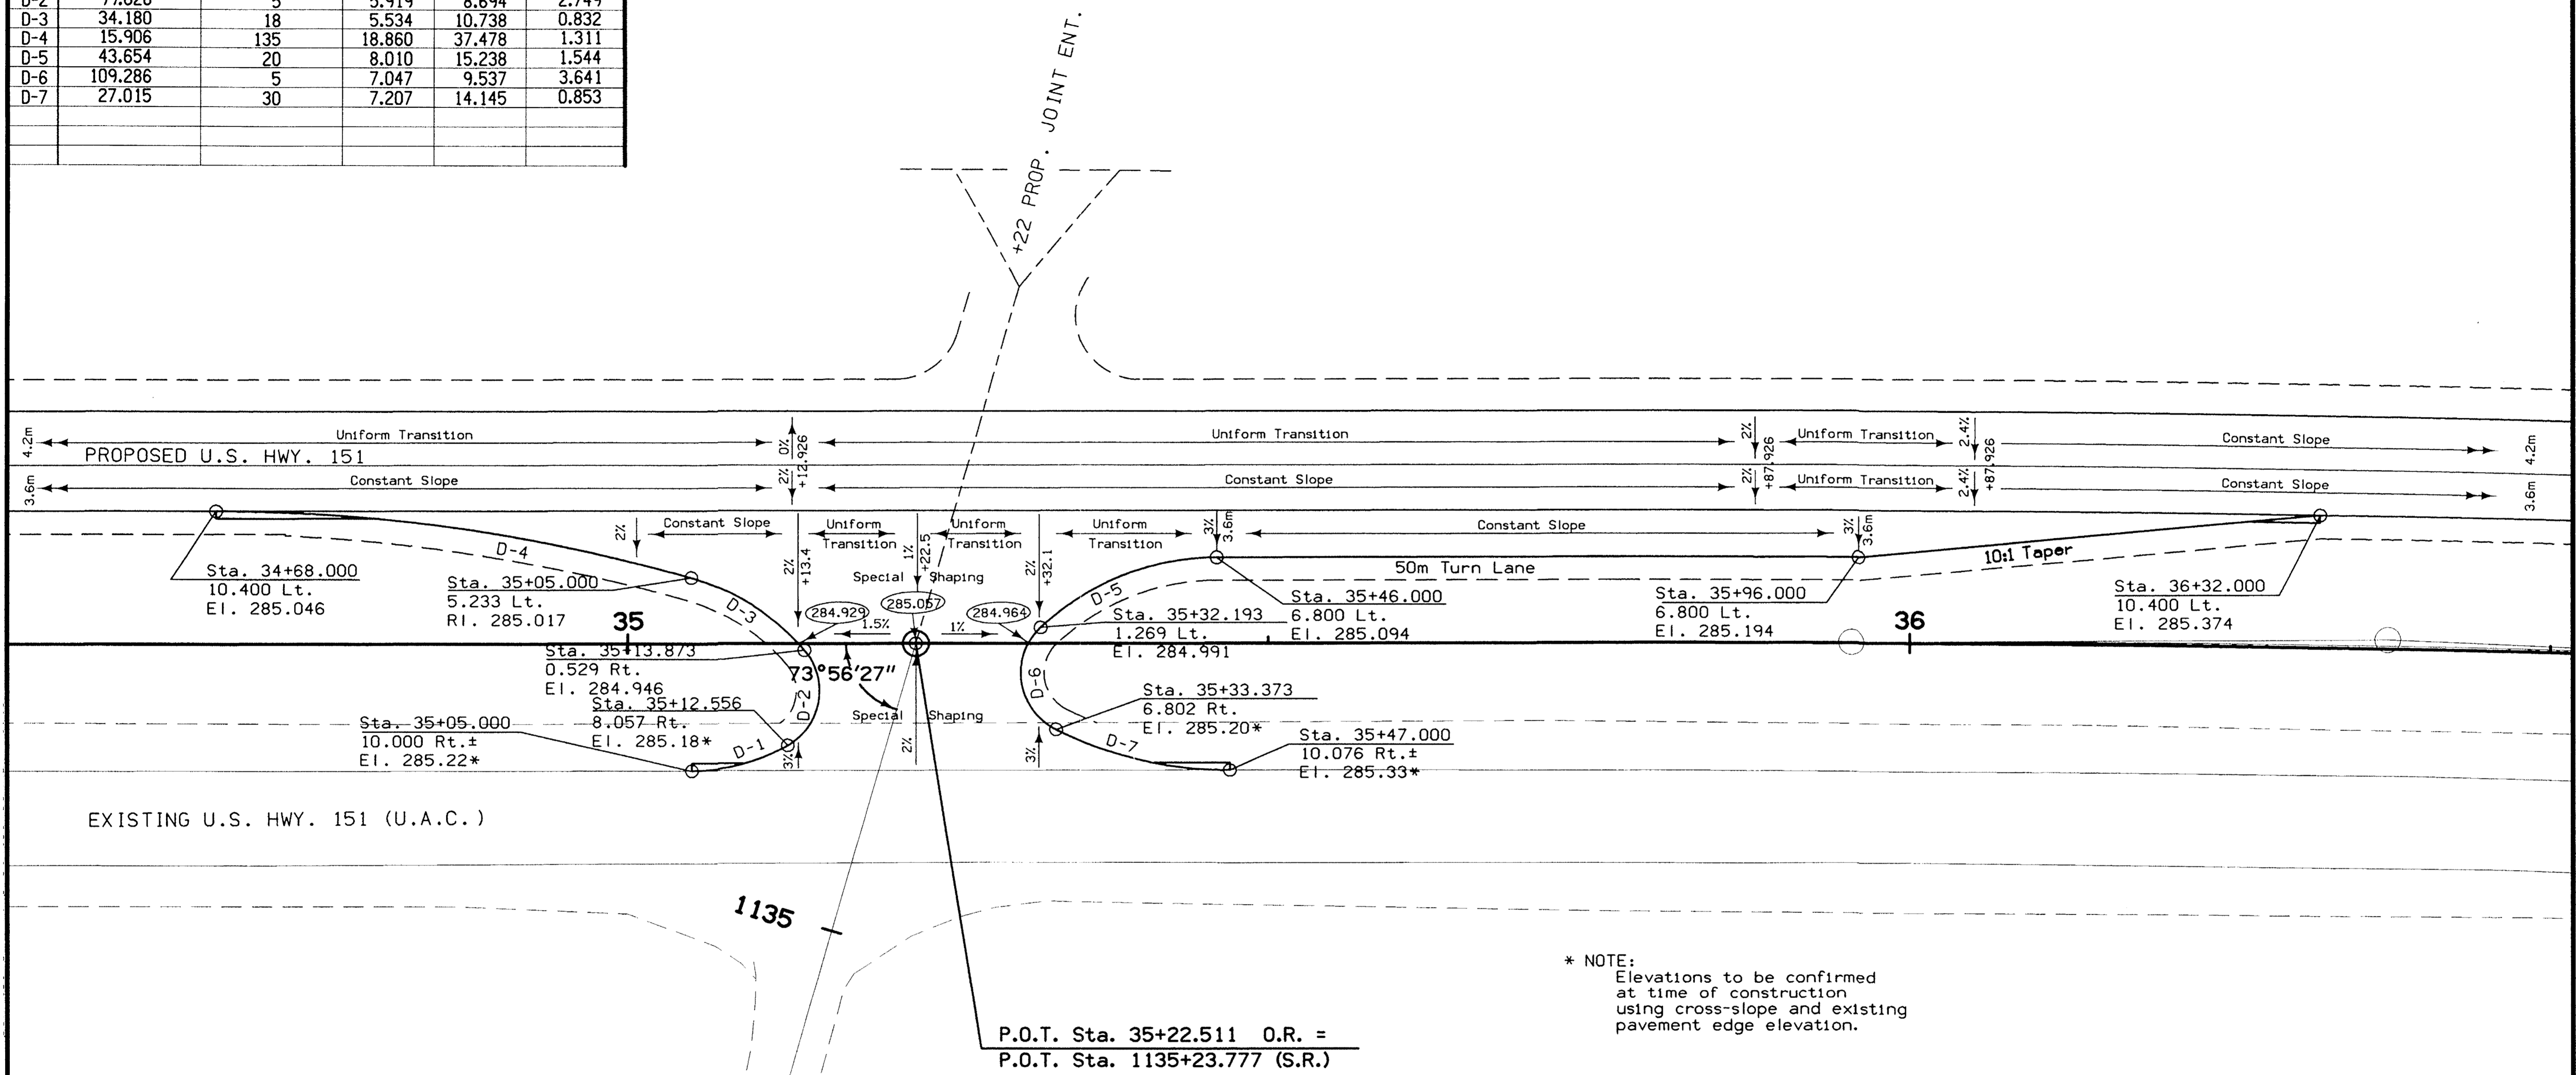


INTERSECTION PAVING REQUIREMENTS

101-12
09-27-94

TYPE	UNIT	AMOUNT	DESCRIPTION
Pavement	m ²	850	Median Crossover
Island	m ²		
Curb	m		


GEOMETRIC AND STAKING DETAIL
FOR INTERSECTION OF
U.S. HWY. 151 WITH TAYLOR RD.
AT STA. 35+22.511 O.R.

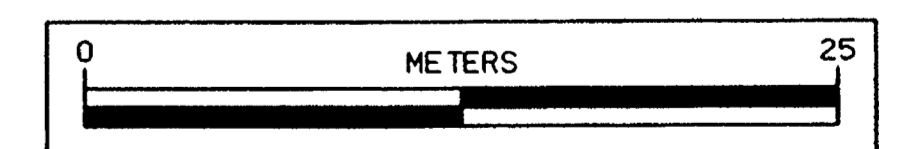


CIRCULAR CURVE DATA

101-10C
09-27-94

NO.	Δ	R	T	L	E
D-1	30.248	15	4.054	7.919	0.538
D-2	99.626	5	5.919	8.694	2.749
D-3	34.180	18	5.534	10.738	0.832
D-4	15.906	135	18.860	37.478	1.311
D-5	43.654	20	8.010	15.238	1.544
D-6	109.286	5	7.047	9.537	3.641
D-7	27.015	30	7.207	14.145	0.853

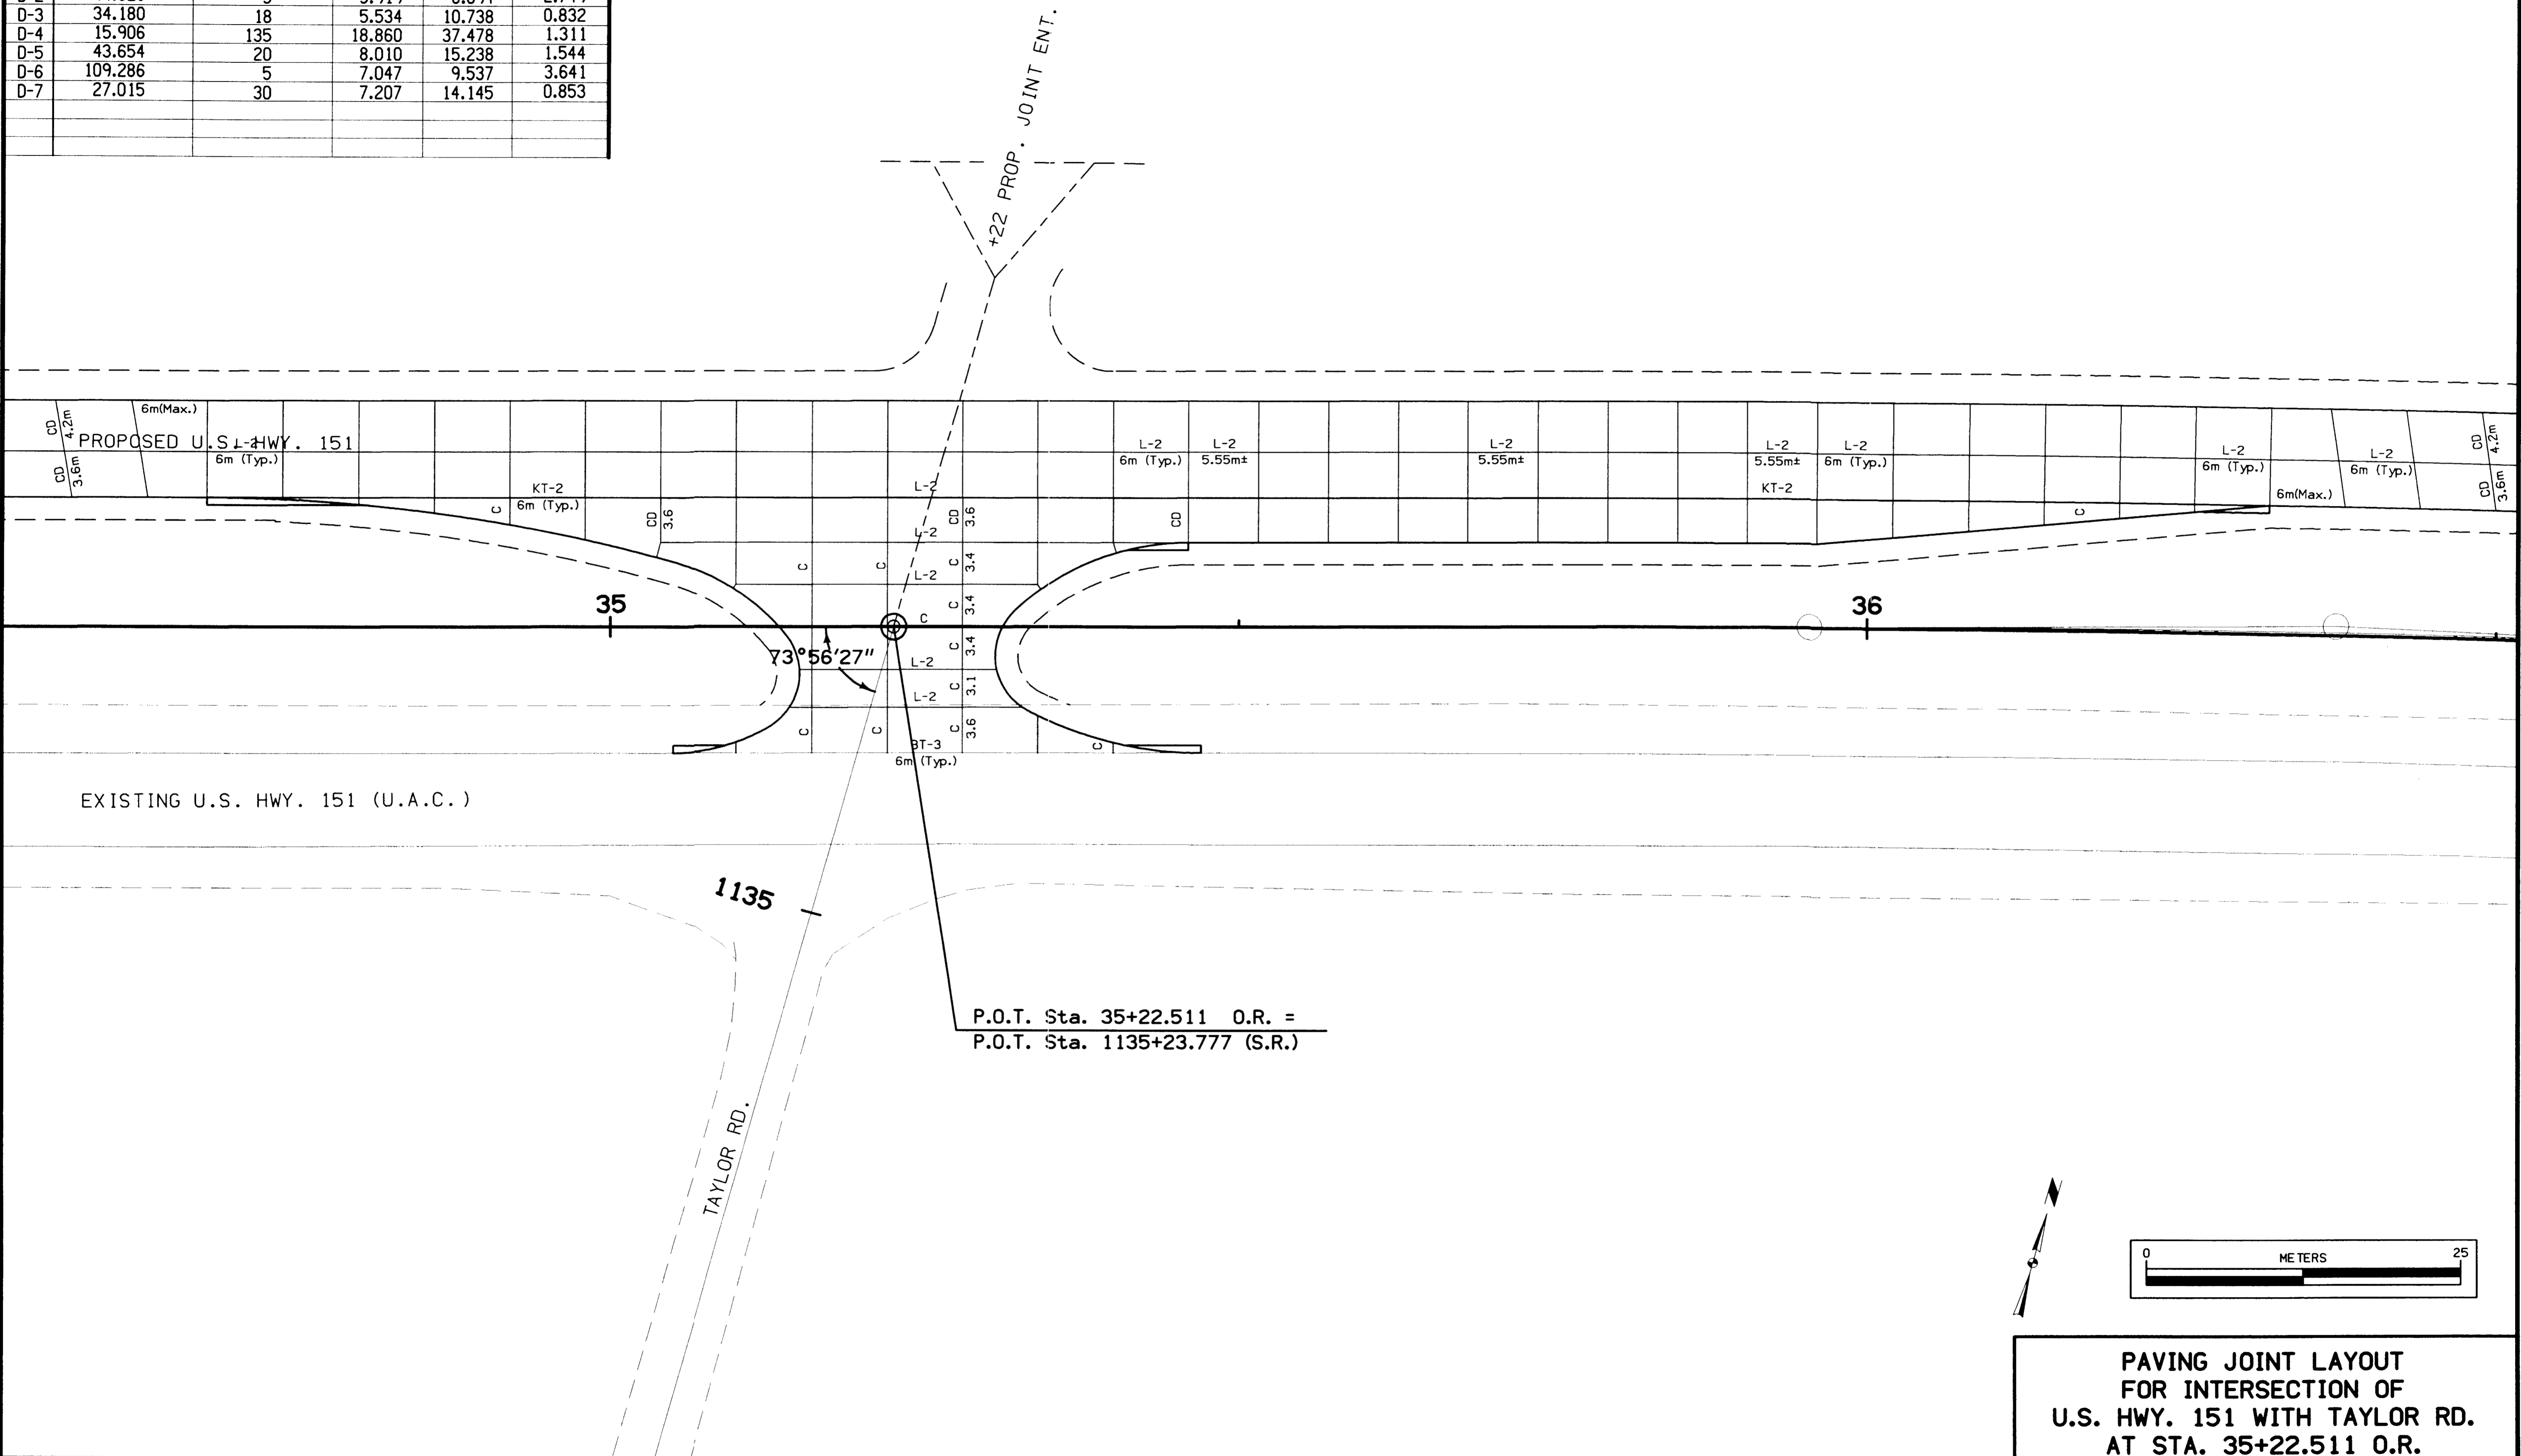

P.O.T. Sta. 35+22.511 O.R. =
P.O.T. Sta. 1135+23.777 (S.R.)

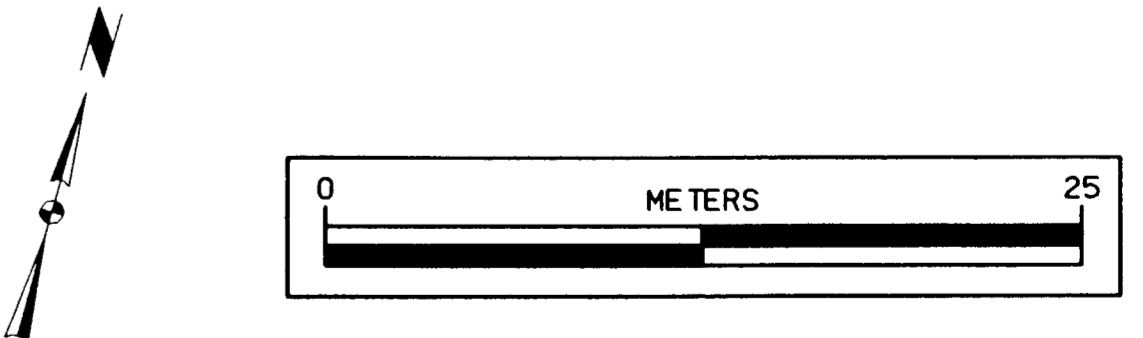


**PAVING JOINT LAYOUT
FOR INTERSECTION OF
U.S. HWY. 151 WITH TAYLOR RD.
AT STA. 35+22.511 O.R.**

CIRCULAR CURVE DATA

101-10C
09-27-94

NO.	Δ	R	T	L	E
E-1	39.300	22	7.855	15.090	1.360
E-2	120.207	5	8.696	10.490	5.031
E-3	20.527	50	9.054	17.913	0.813
E-4	34.174	20	6.148	11.929	0.924
E-5	110.764	5	7.243	9.666	3.801
E-6	31.208	40	11.171	21.787	1.531

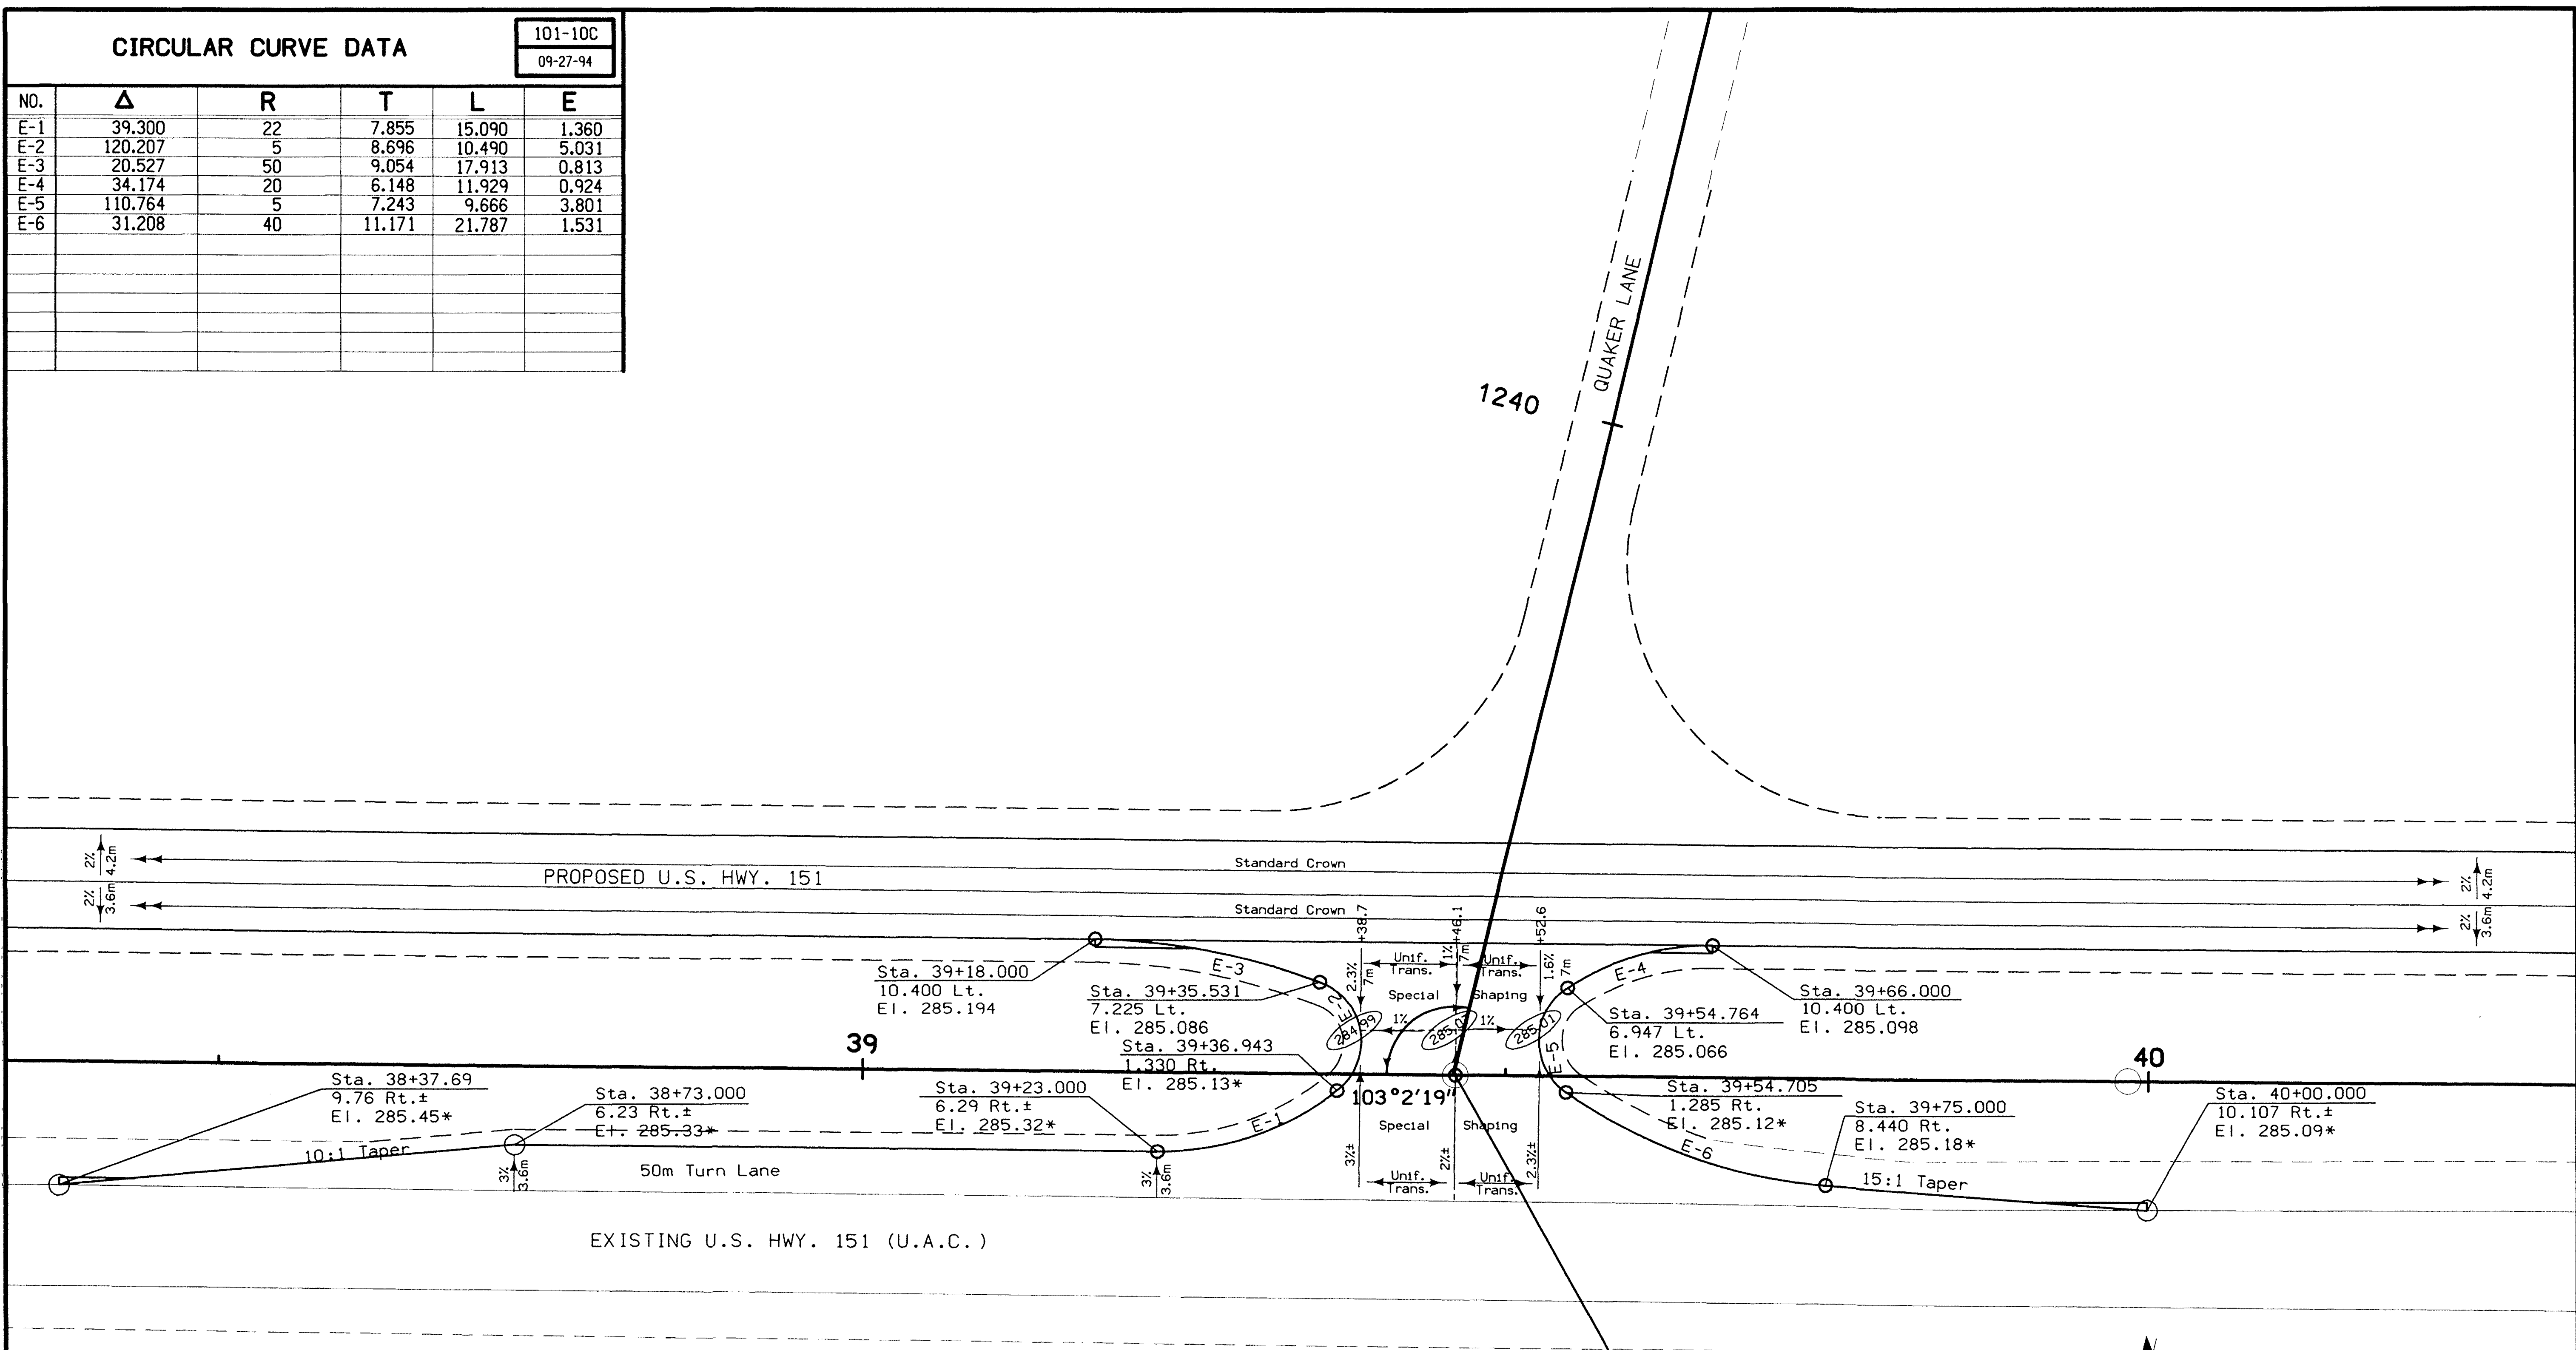

* NOTE:
Elevations to be confirmed
at time of construction
using cross-slope and existing
pavement edge elevation.

P.O.T. Sta. 39+46.115 O.R. =
P.O.T. Sta. 1239+47.387 (S.R.)

INTERSECTION PAVING REQUIREMENTS

101-12
09-27-94


TYPE	UNIT	AMOUNT	DESCRIPTION
Pavement	m ²	810	Median Crossover
Island	m ²		
Curb	m		

GEOMETRIC AND STAKING DETAIL
FOR INTERSECTION OF
U.S. HWY. 151 AND QUAKER LANE
AT STA. 39+46.115 O.R.

CIRCULAR CURVE DATA

101-10C
09-27-94

NO.	Δ	R	T	L	E
E-1	39.300	22	7.855	15.090	1.360
E-2	120.207	5	8.696	10.490	5.031
E-3	20.527	50	9.054	17.913	0.813
E-4	34.174	20	6.148	11.929	0.924
E-5	110.764	5	7.243	9.666	3.801
E-6	31.208	40	11.171	21.787	1.531

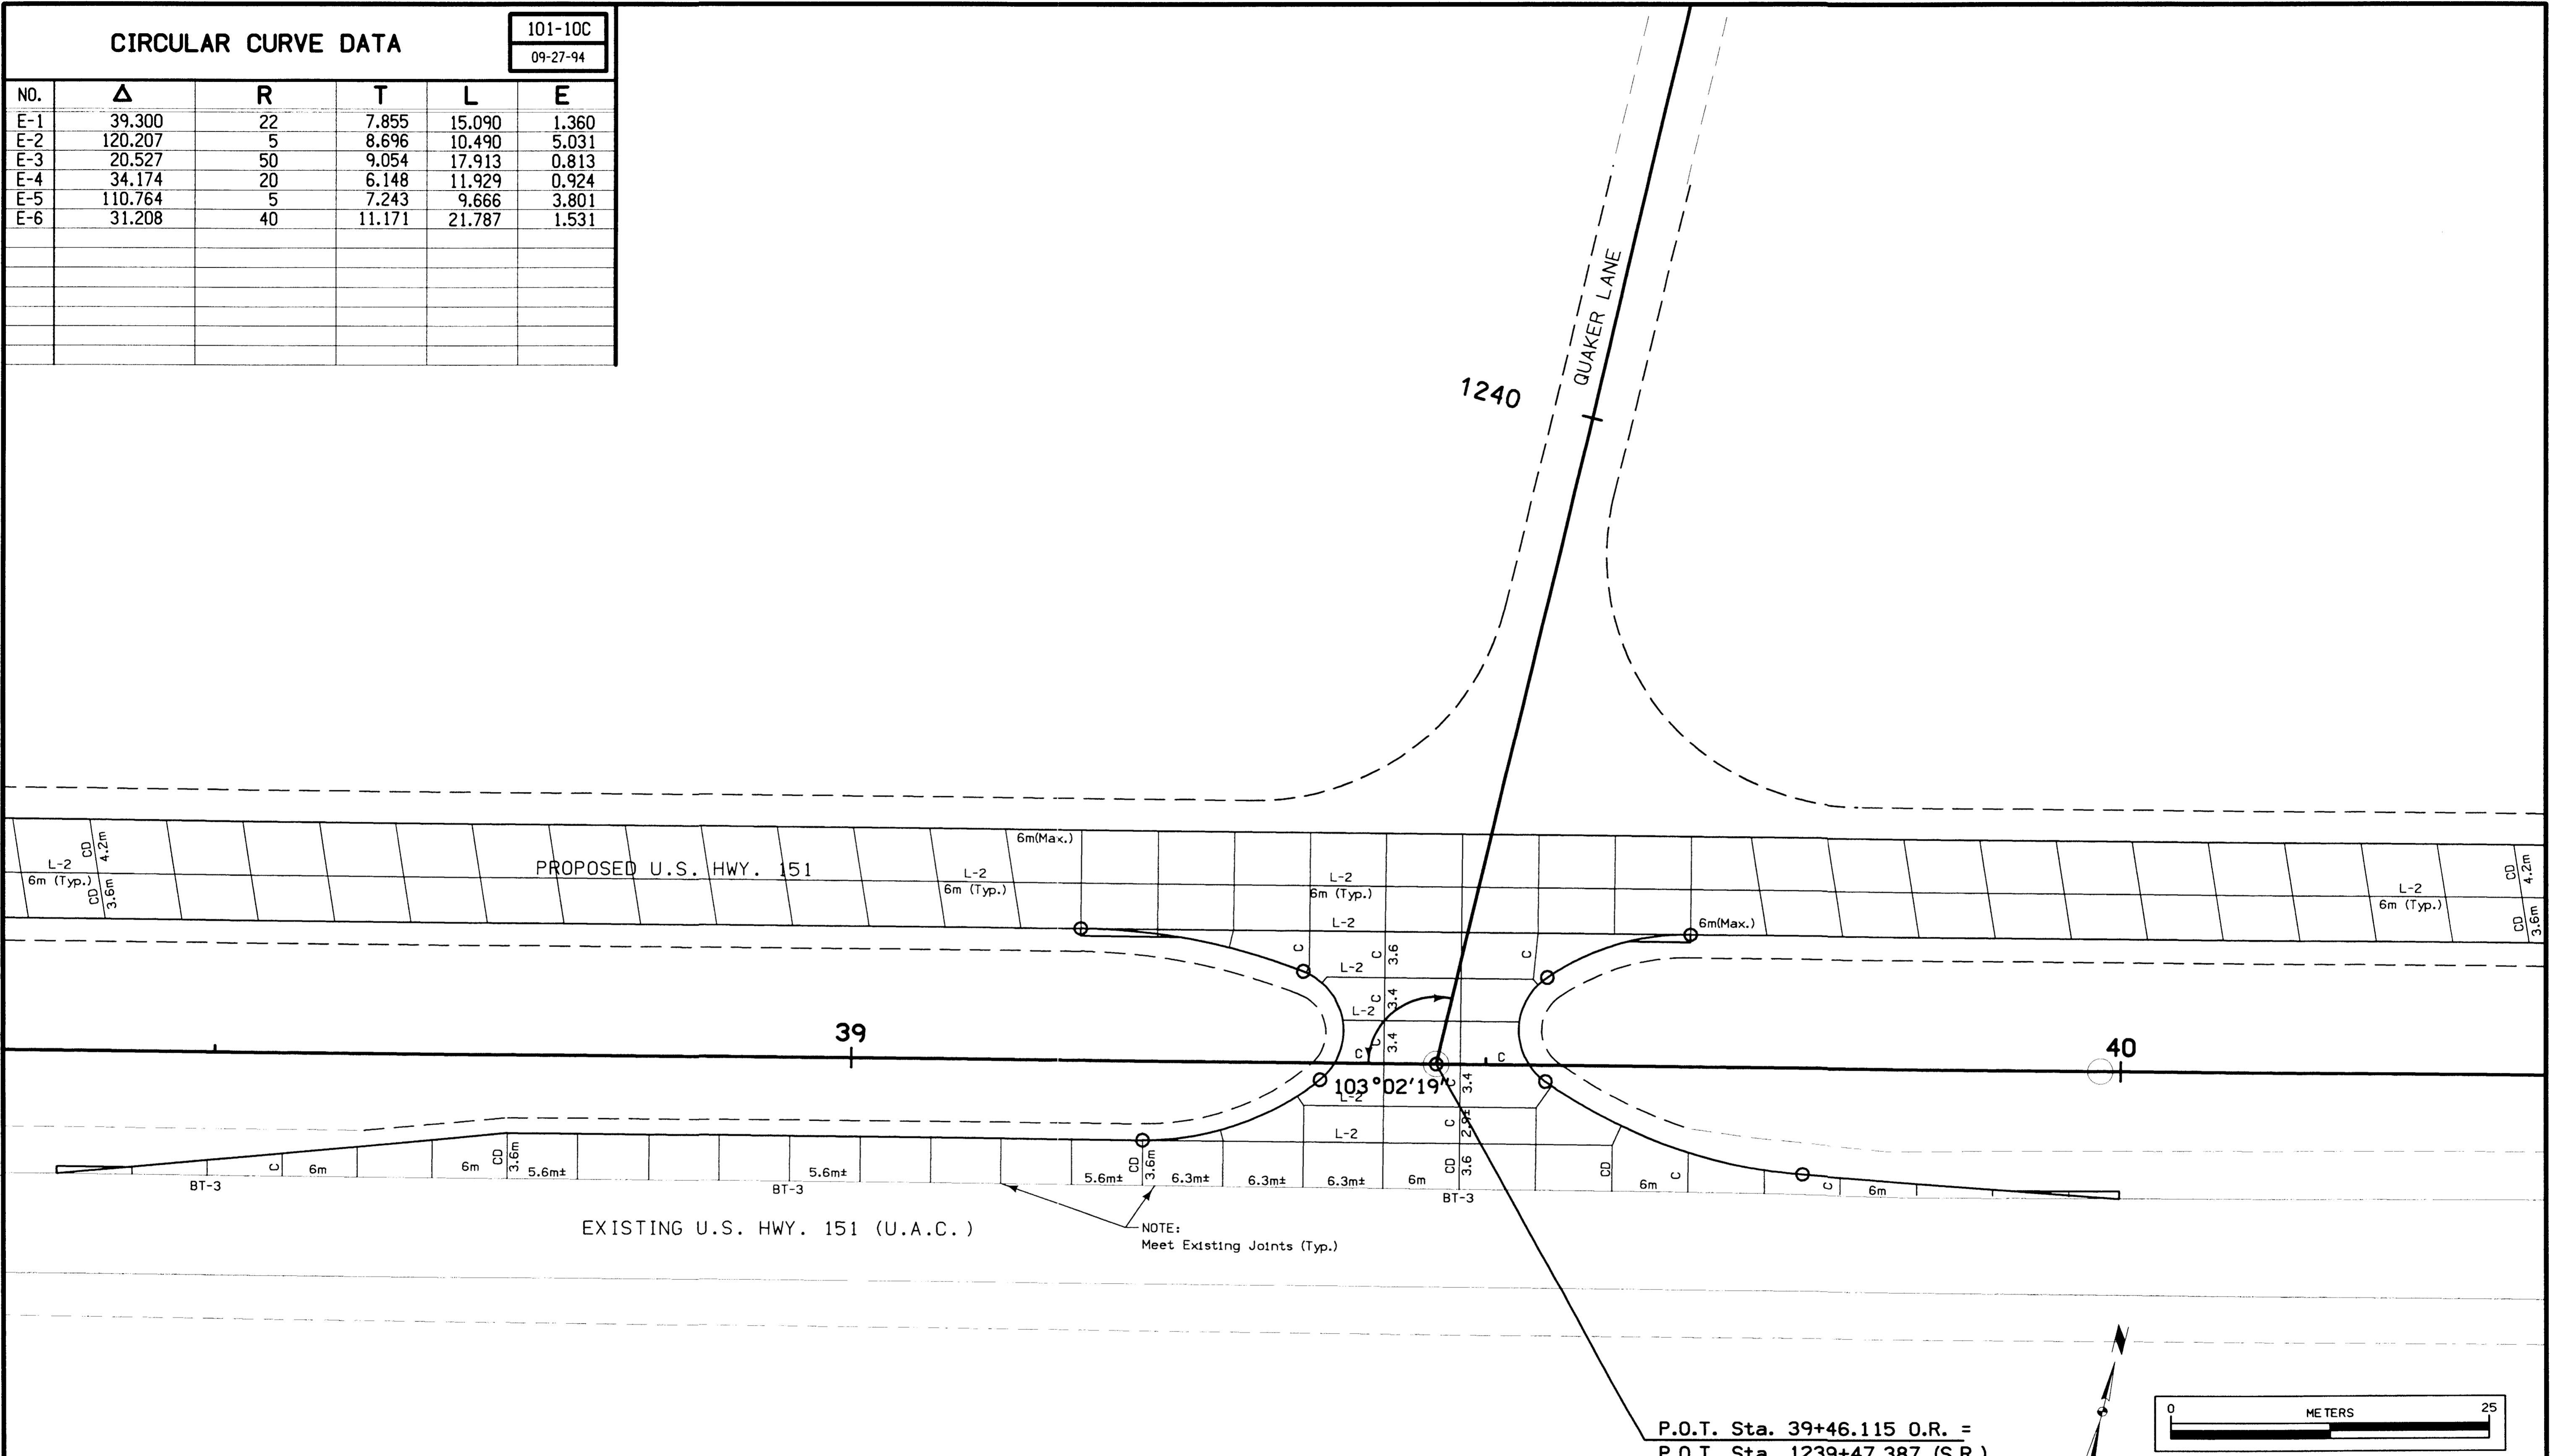

**PAVING JOINT LAYOUT
FOR INTERSECTION OF
U.S. HWY. 151 AND QUAKER LANE
AT STA. 39+46.115 O.R.**

CIRCULAR CURVE DATA


101-10C
09-27-94

NO.	Δ	R	T	L	E
0-1	74.457	18	14.695	24.648	5.237
0-2	79.068	8	6.603	11.040	2.373
0-3	20.683	50	9.124	18.049	0.826
0-4	76.146	18	14.100	23.922	4.865
0-5	77.051	10	7.962	13.488	2.782
0-6	20.110	45	7.979	15.794	0.702
0-7	88.467	23	22.393	35.513	9.100
0-8	14.010	140	17.202	34.233	1.053
0-9	16.707	70	10.279	20.412	0.751
0-10	47.419	40	17.567	33.105	3.687
0-11	12.720	120	13.375	26.460	0.743

ISLAND DATA

101-13
09-27-94

POINT NO.	STATION	ELEVATION
1	52+04.936, 21.500 LT	288.639
2	52+09.828, 21.500 LT	288.663
3	1452+50.188, 4.842 LT	288.613

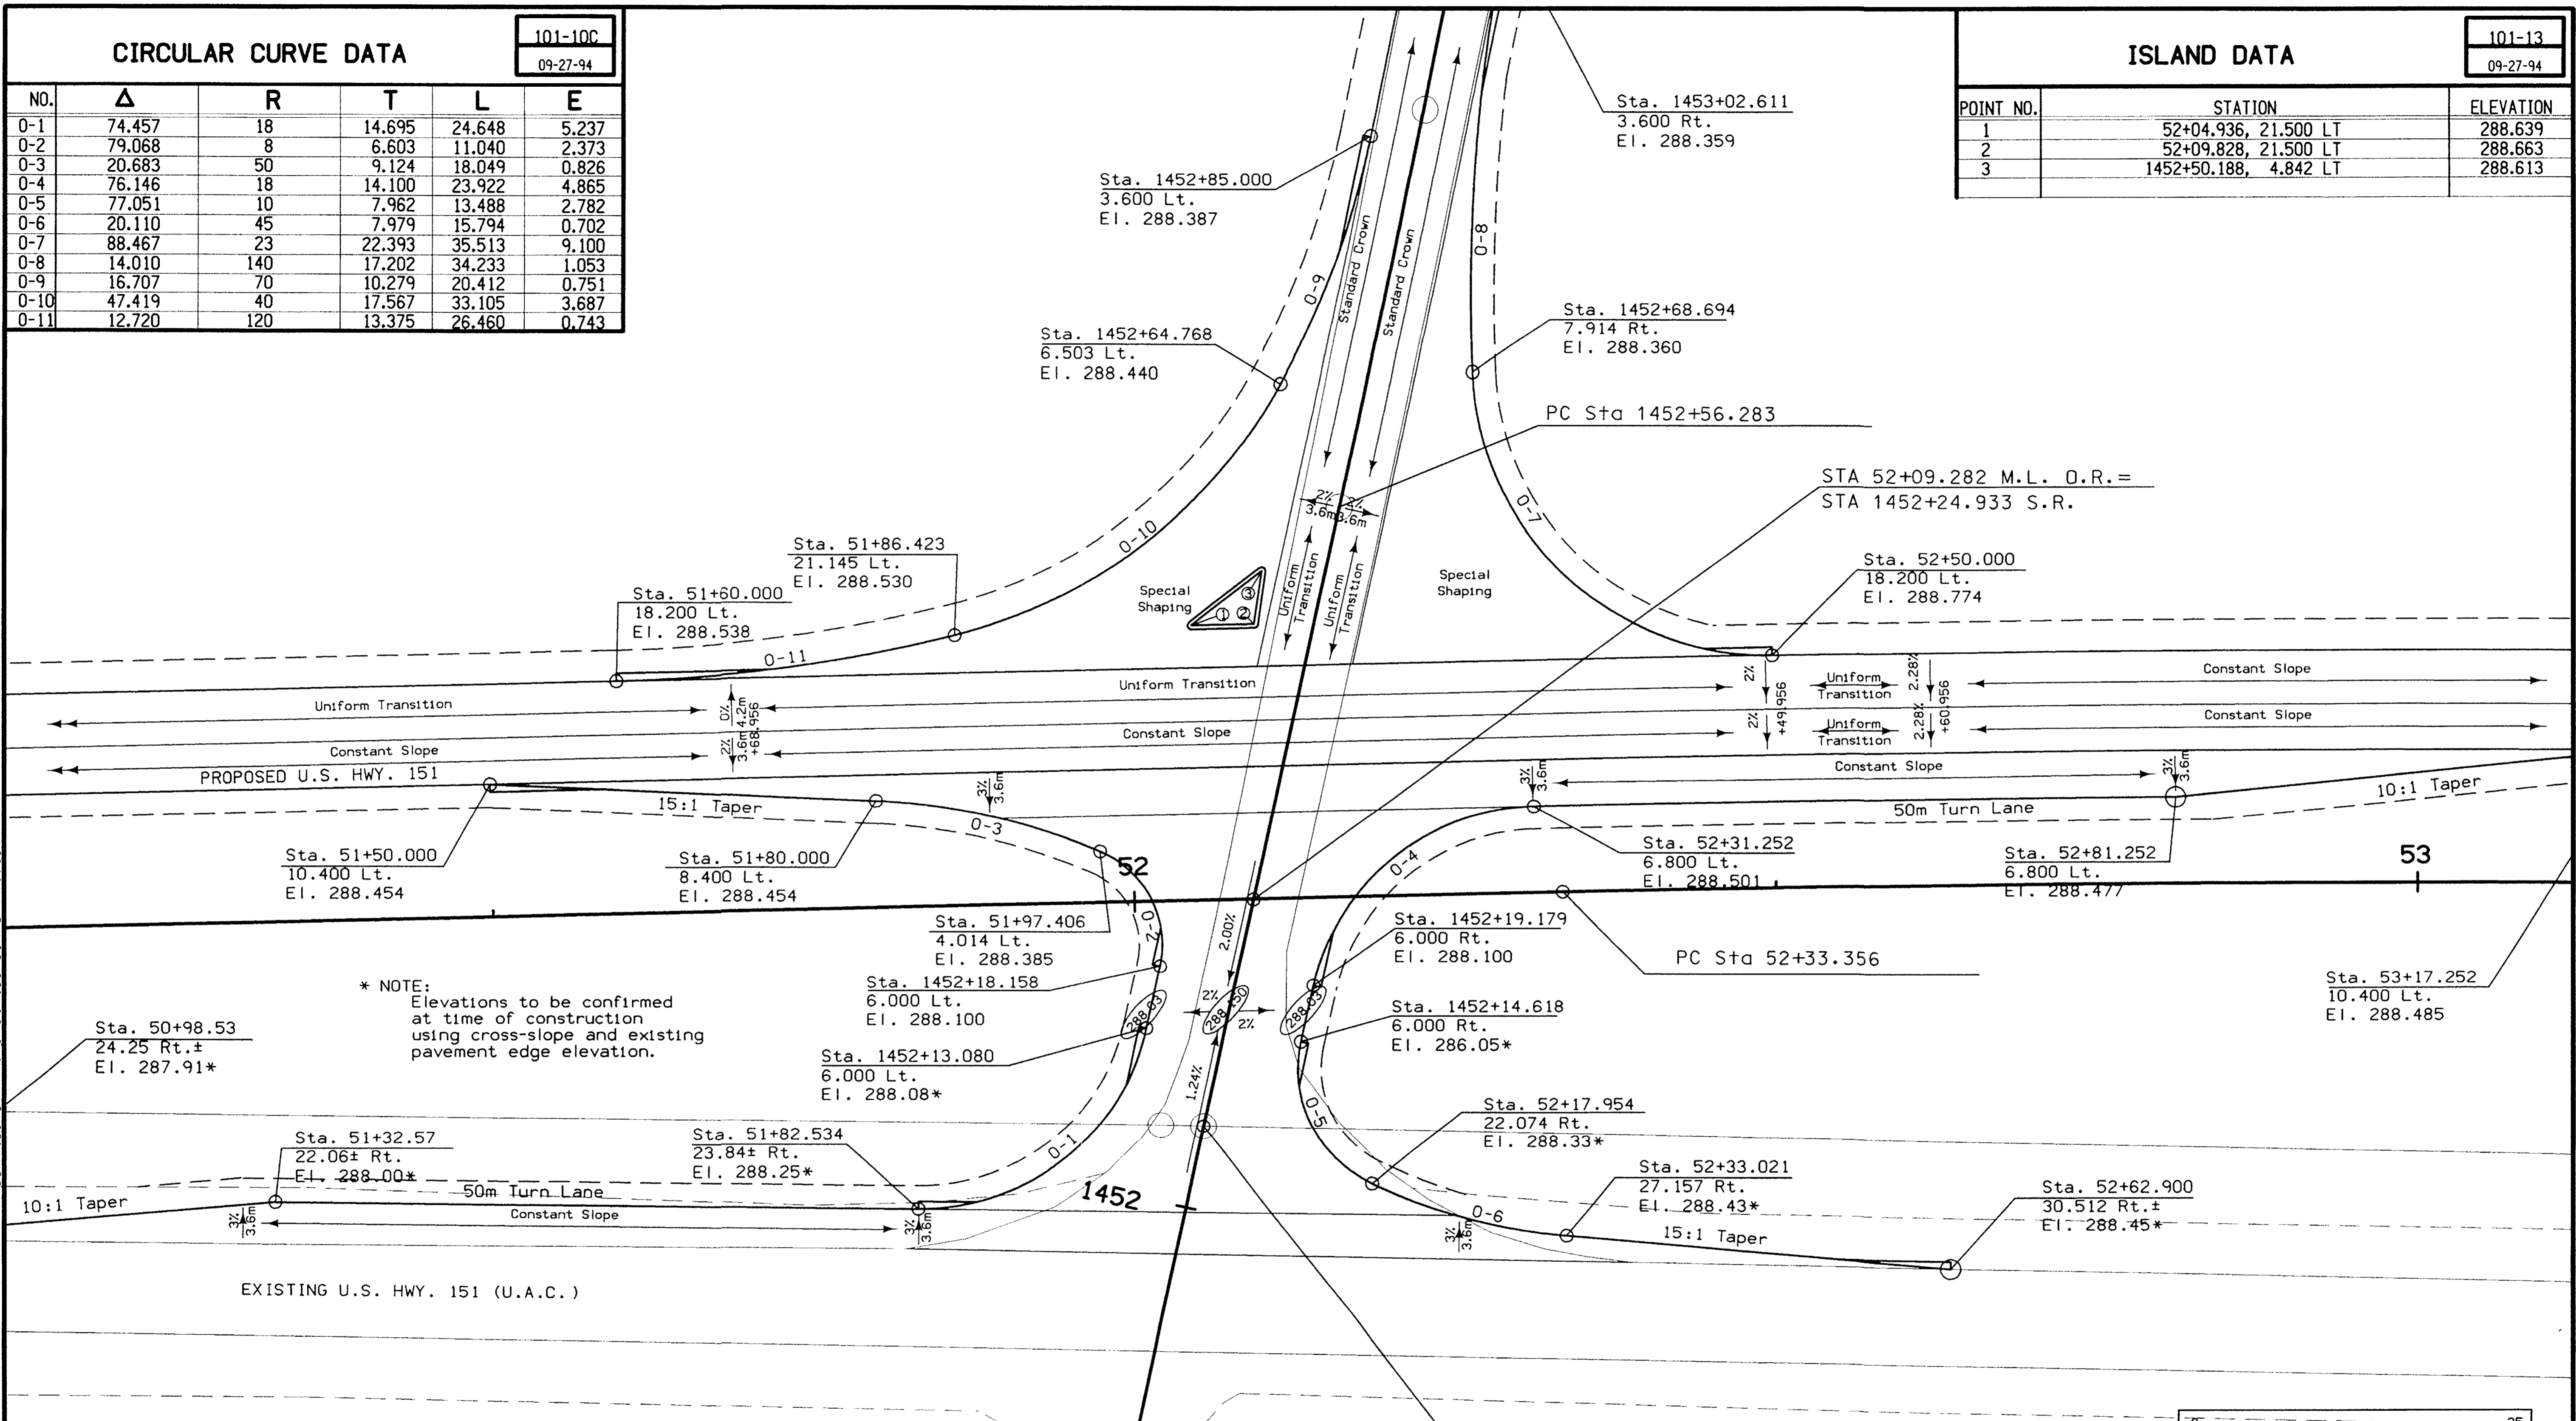


* NOTE:
Elevations to be confirmed
at time of construction
using cross-slope and existing
pavement edge elevation.


INTERSECTION PAVING REQUIREMENTS

101-12
09-27-94


TYPE	UNIT	AMOUNT	DESCRIPTION
Pavement	m ²	1470	Median Crossover
Pavement	m ²	302	West Return
Pavement	m ²	324	East Return
Island	m ²	10	150mm, Median PCC
Curb	m	16	100mm, Sloped Curb

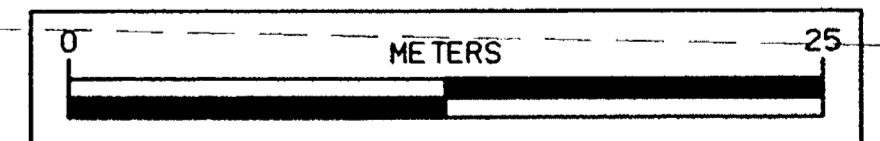

GEOMETRIC AND STAKING DETAIL
FOR INTERSECTION OF
U.S. HWY. 151 WITH LINN-JONES RD.
AT STA. 52+06.550

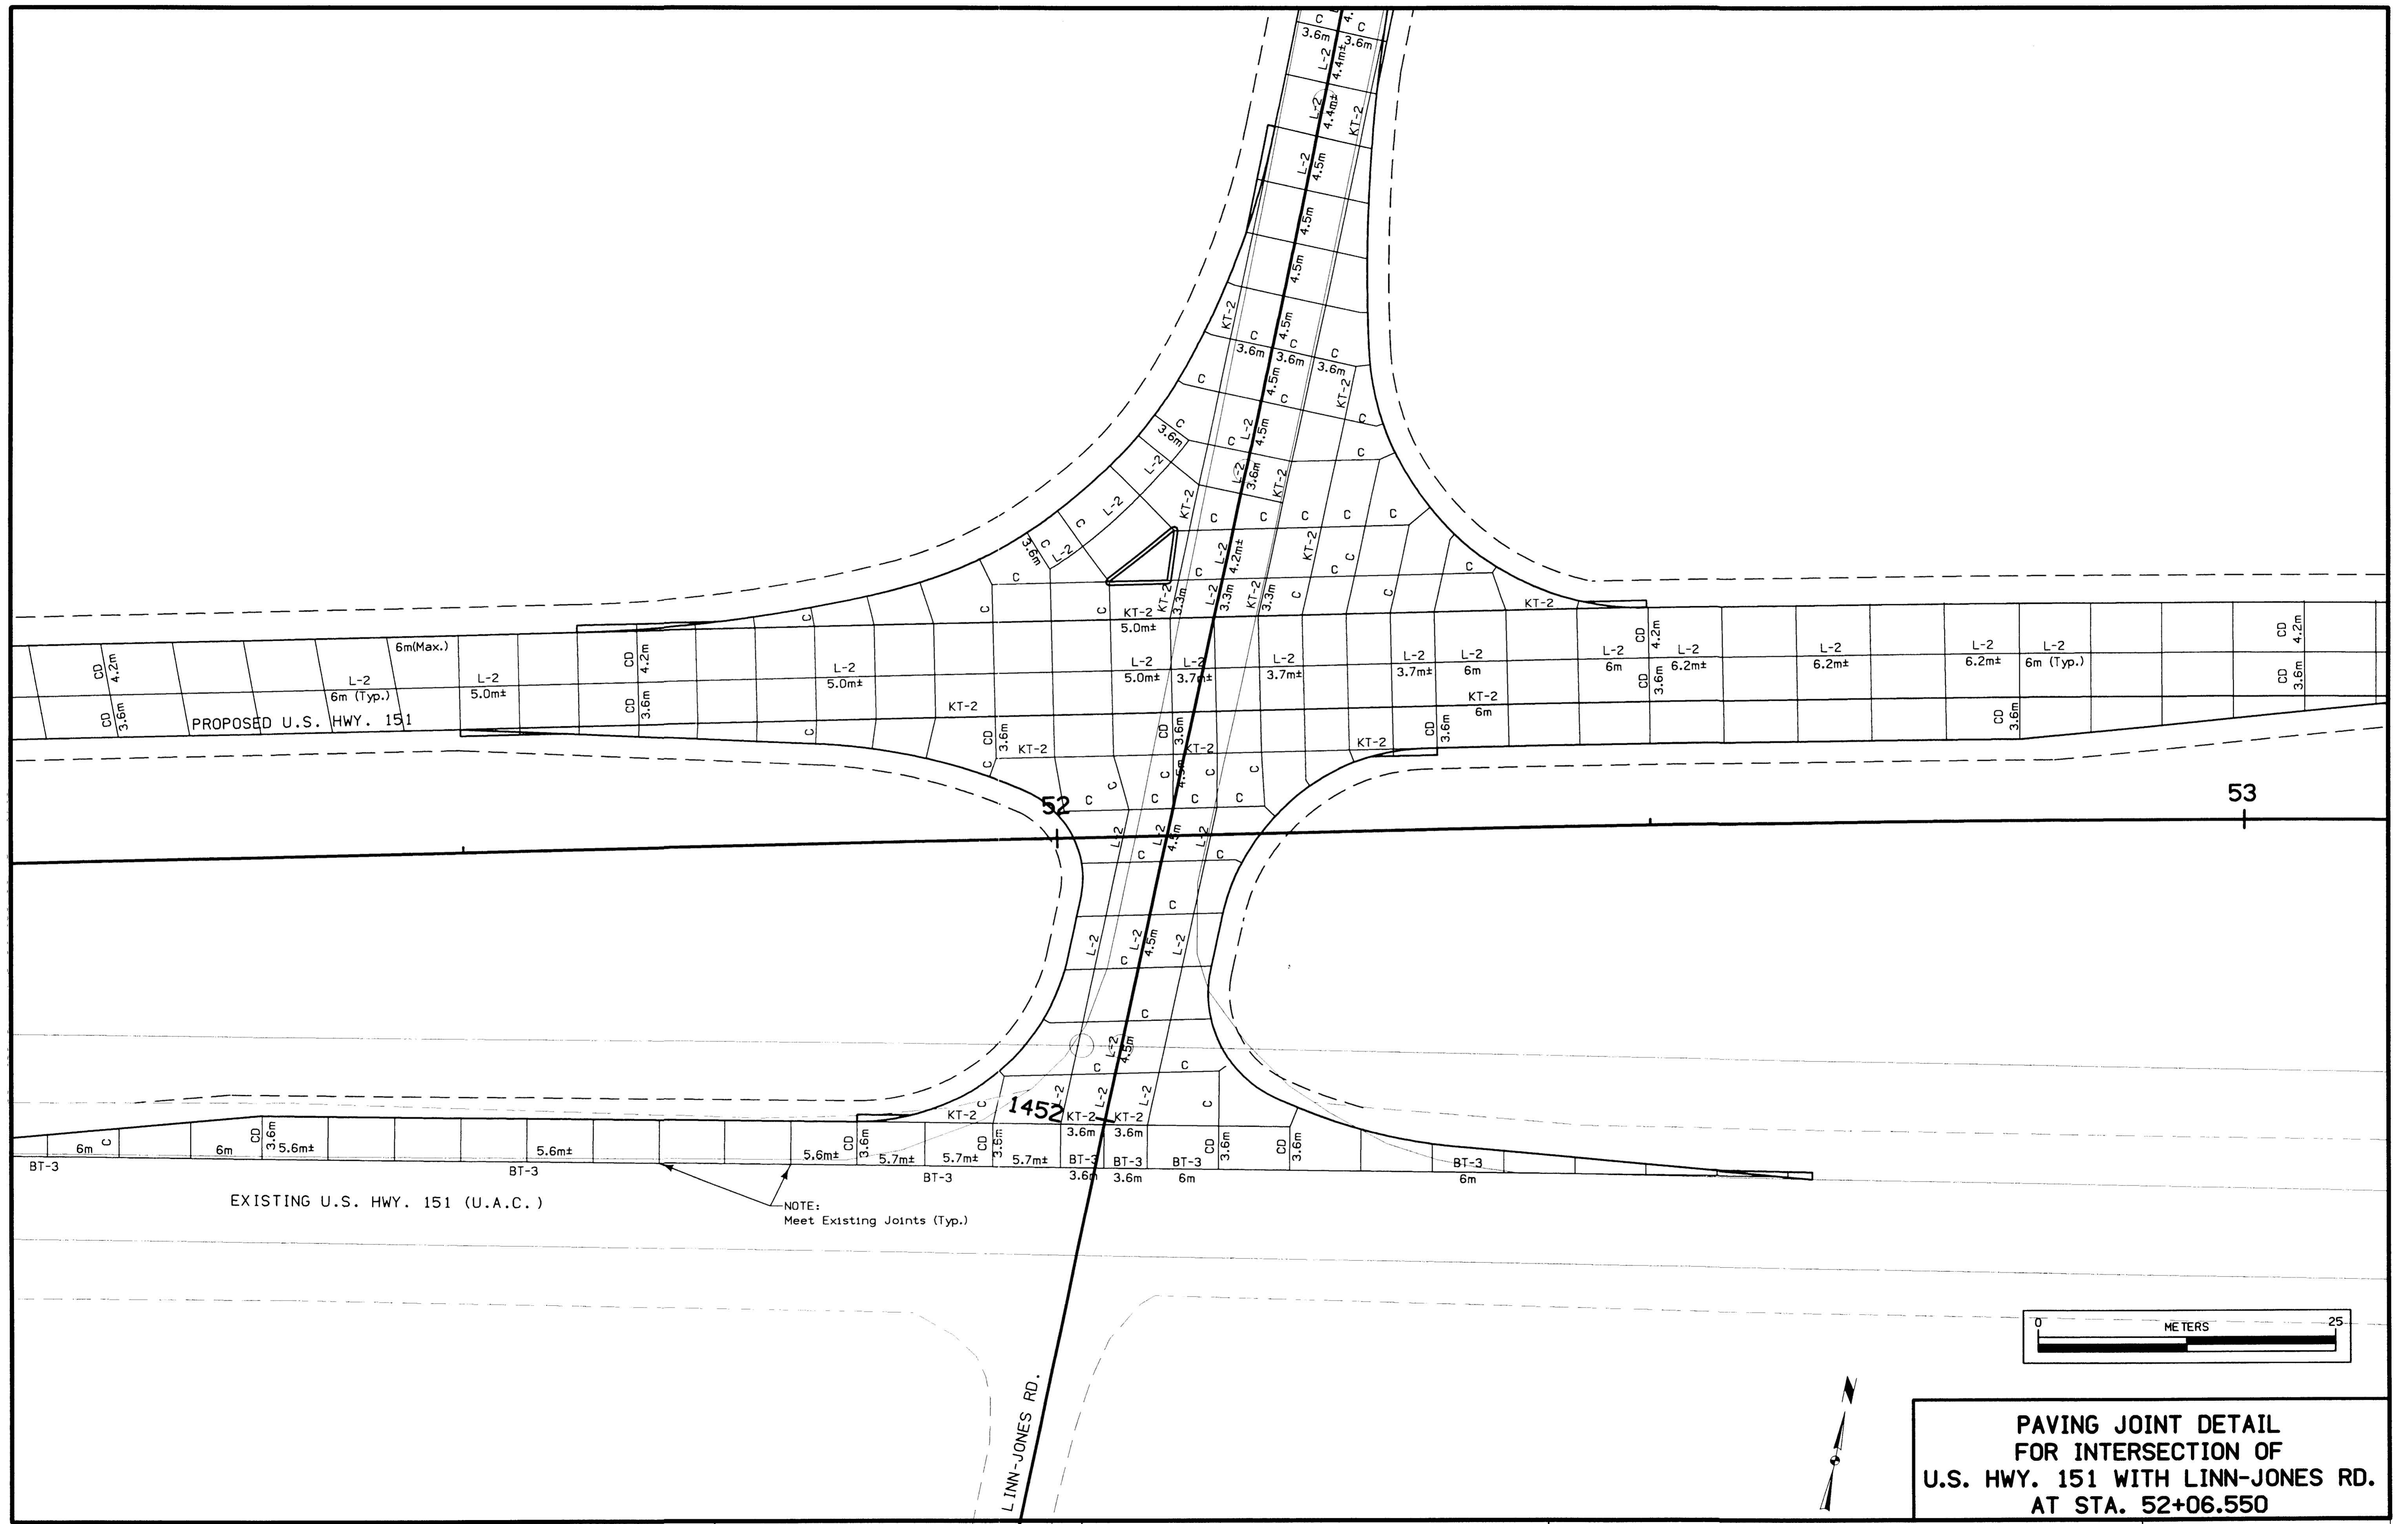

PAVING JOINT DETAIL
 FOR INTERSECTION OF
 U.S. HWY. 151 WITH LINN-JONES RD.
 AT STA. 52+06.550

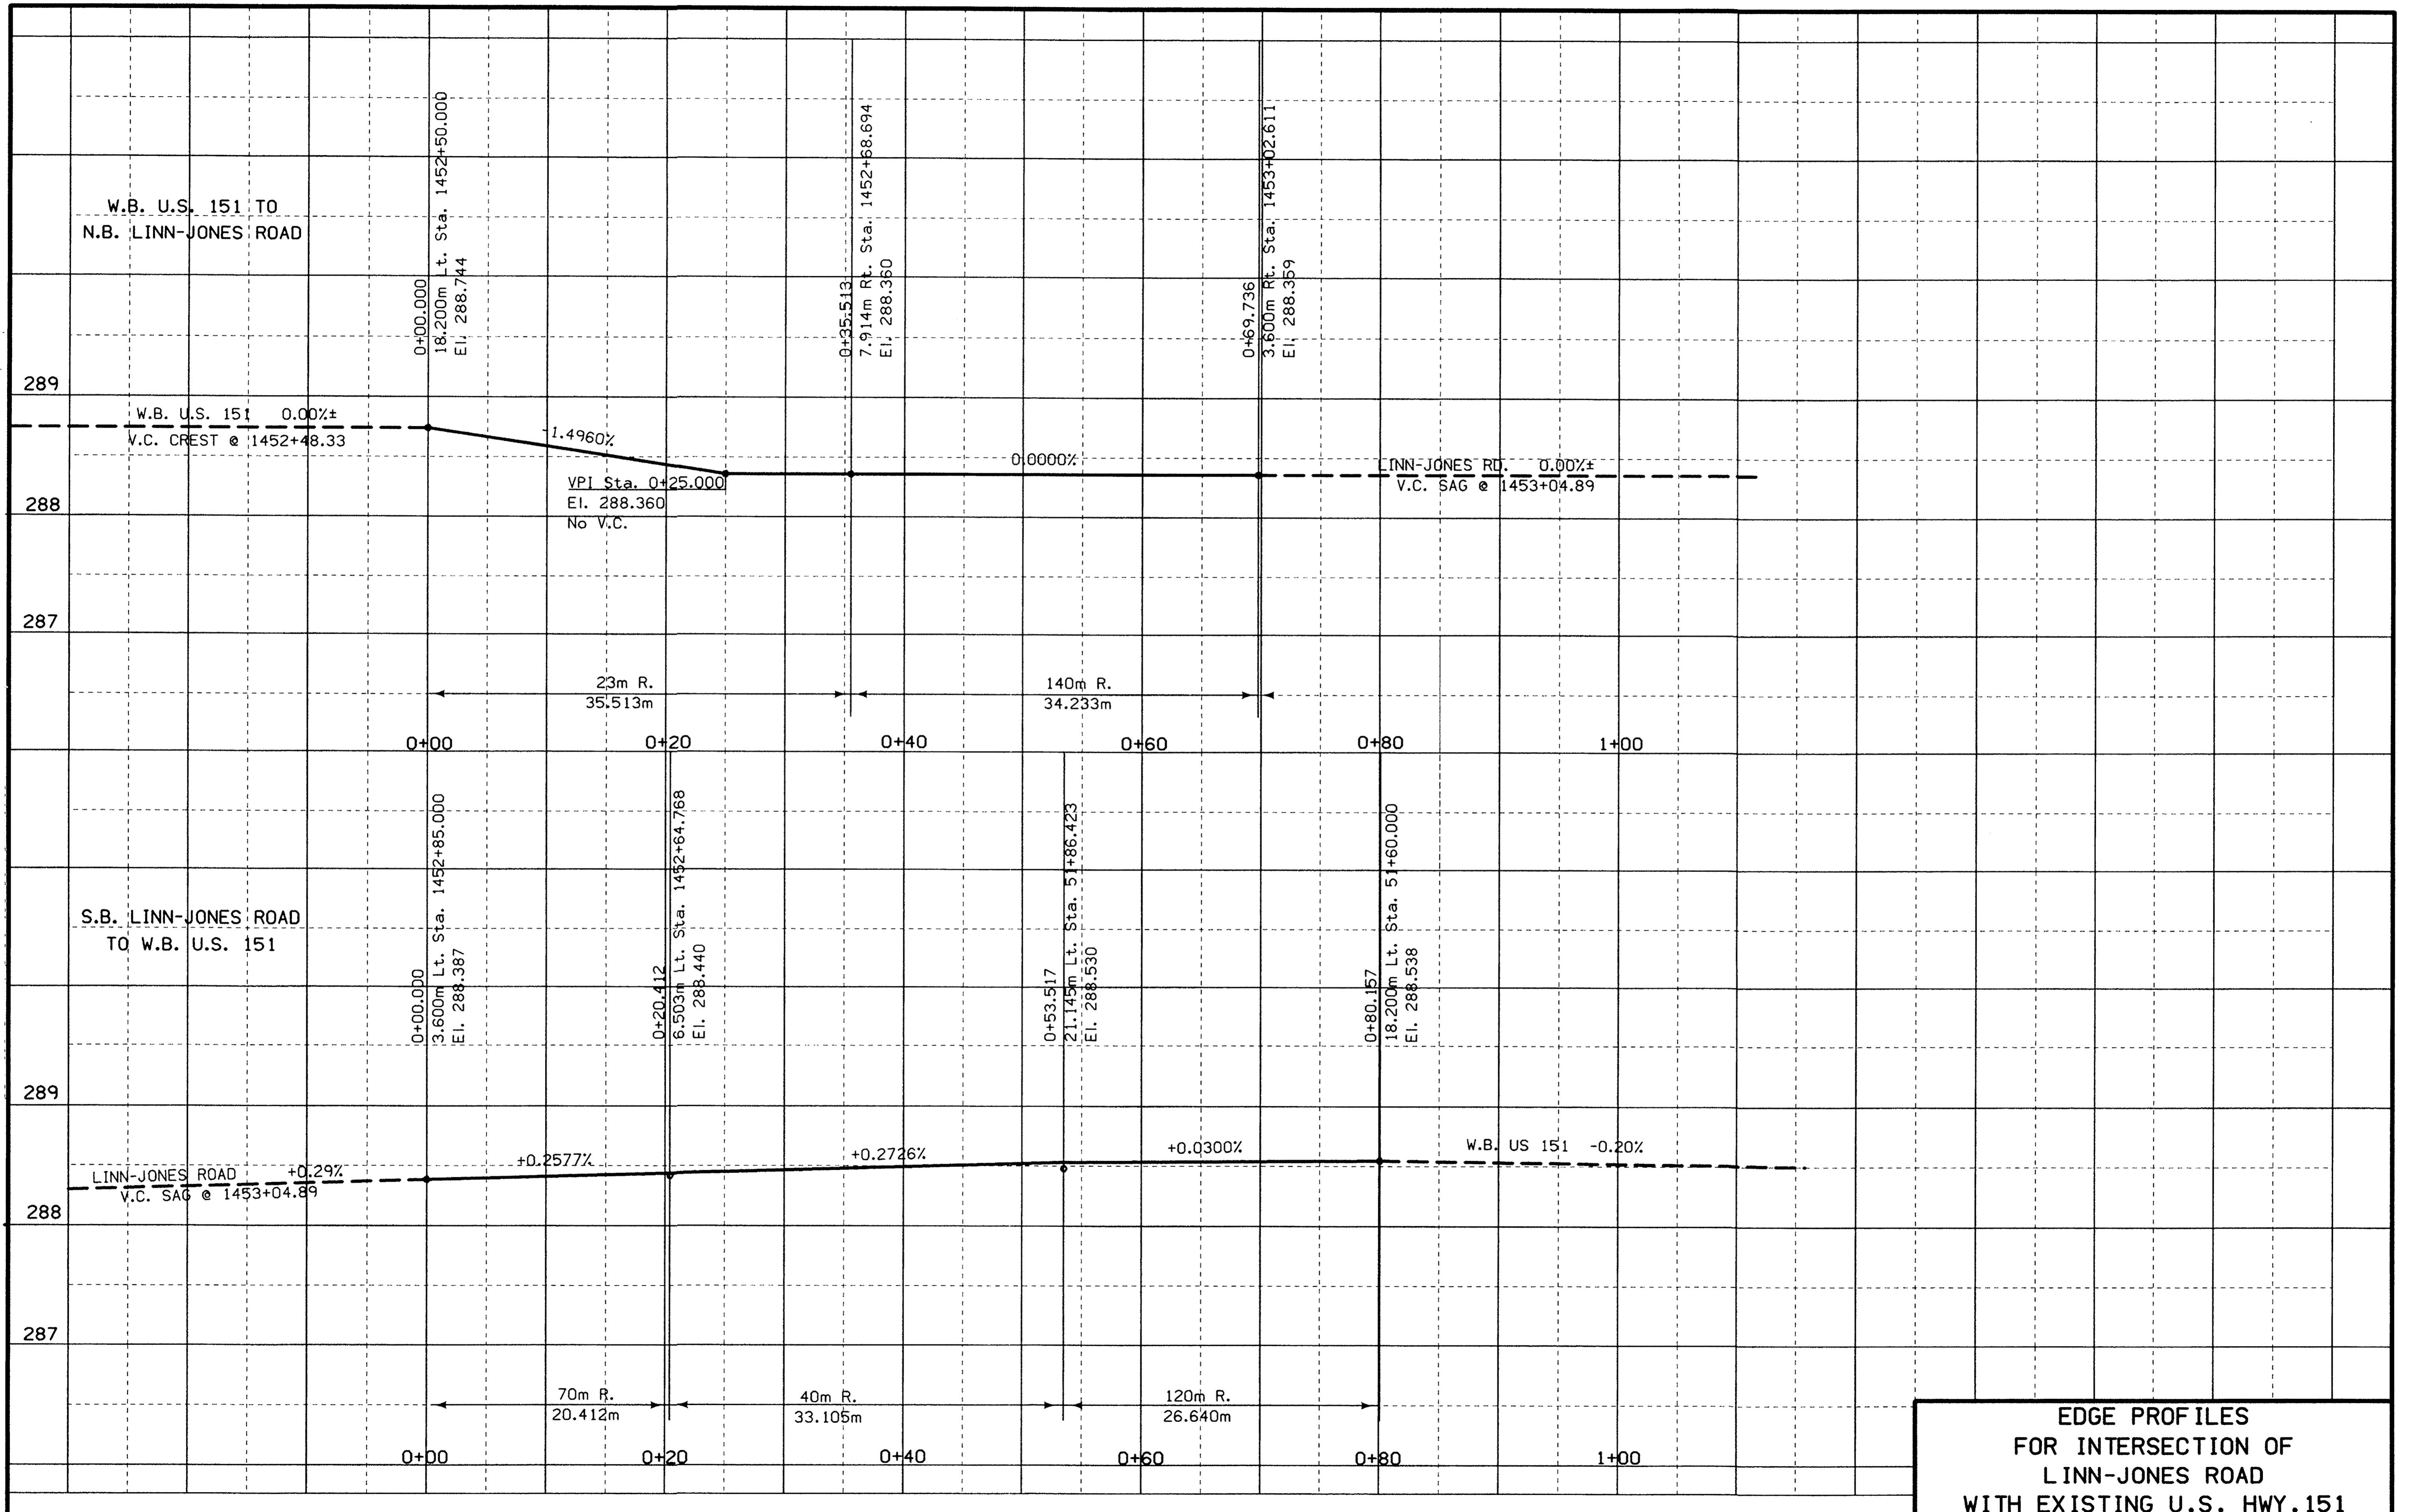


EDGE PROFILES
FOR INTERSECTION OF
LINN-JONES ROAD
WITH EXISTING U.S. HWY. 151


CIRCULAR CURVE DATA

101-10C
09-27-94

NO.	Δ	R	T	L	E
F-1	88.591	10	9.757	15.462	3.971
F-2	69.248	5	3.452	6.043	1.076
F-3	20.645	50	9.107	18.016	0.823
F-4	90.069	10	10.012	15.720	4.151
F-5	72.685	5	3.679	6.343	1.207
F-6	18.770	50	8.264	16.380	0.678

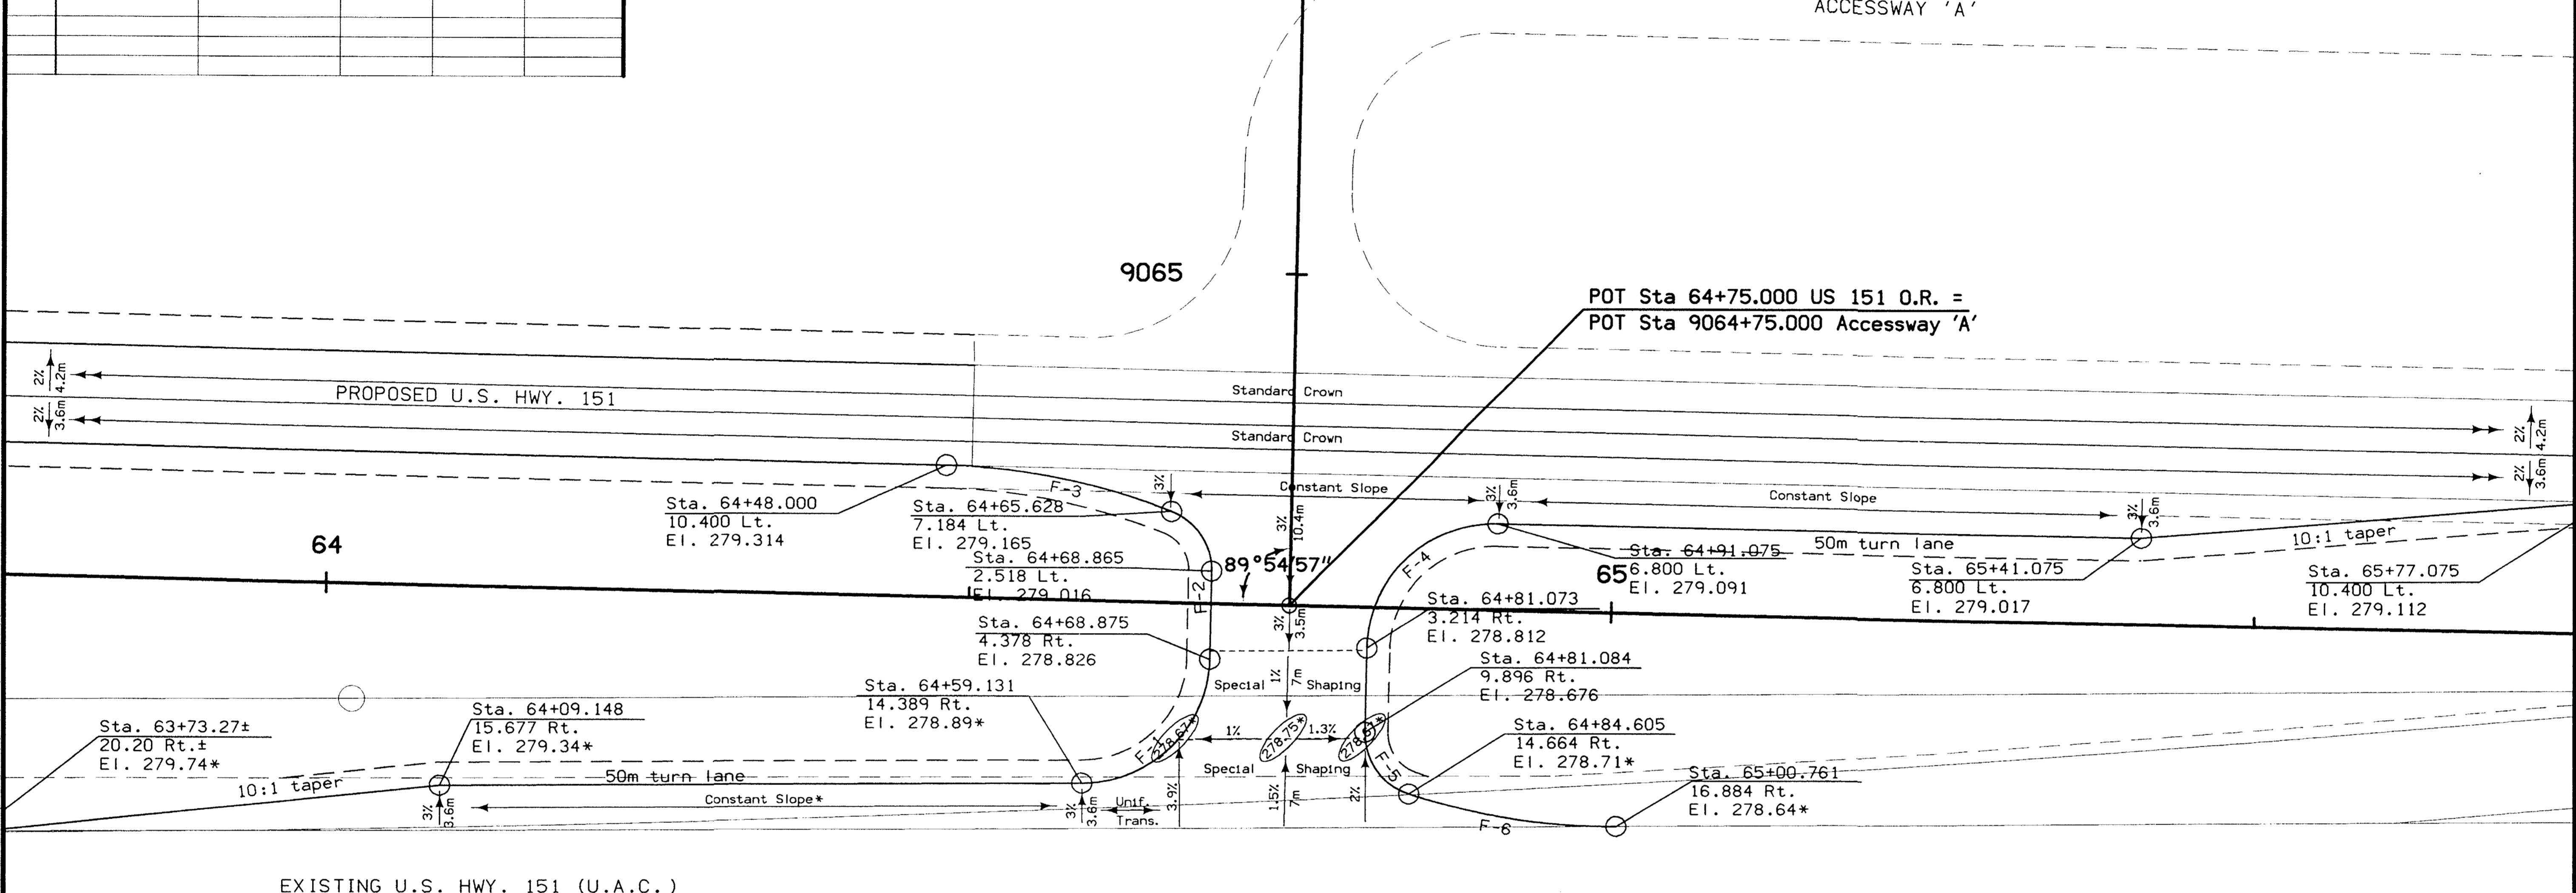

* NOTE:
Elevations to be confirmed
at time of construction
using cross-slope and existing
pavement edge elevation.

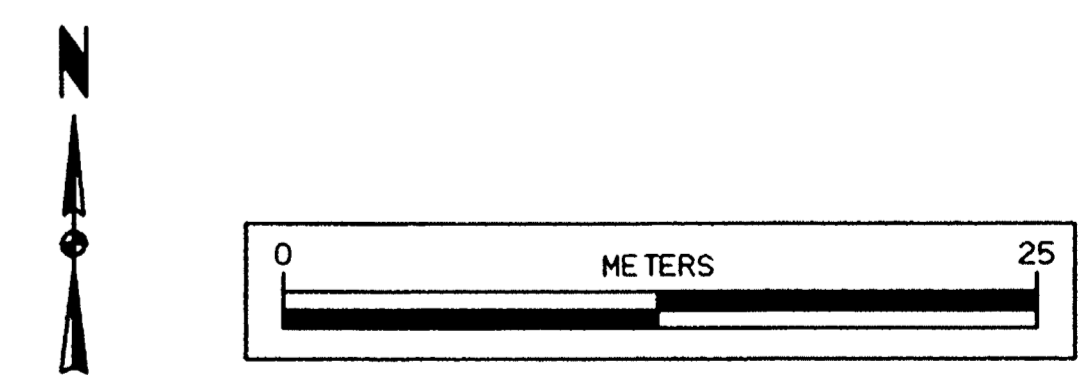


INTERSECTION PAVING REQUIREMENTS

101-12
09-27-94

TYPE	UNIT	AMOUNT	DESCRIPTION
Pavement	m ²	1000	Median Crossover
Island	m ²		
Curb	m		

GEOMETRIC AND STAKING DETAIL
FOR ACCESSWAY A
AT STA. 64+75.000 O.R.

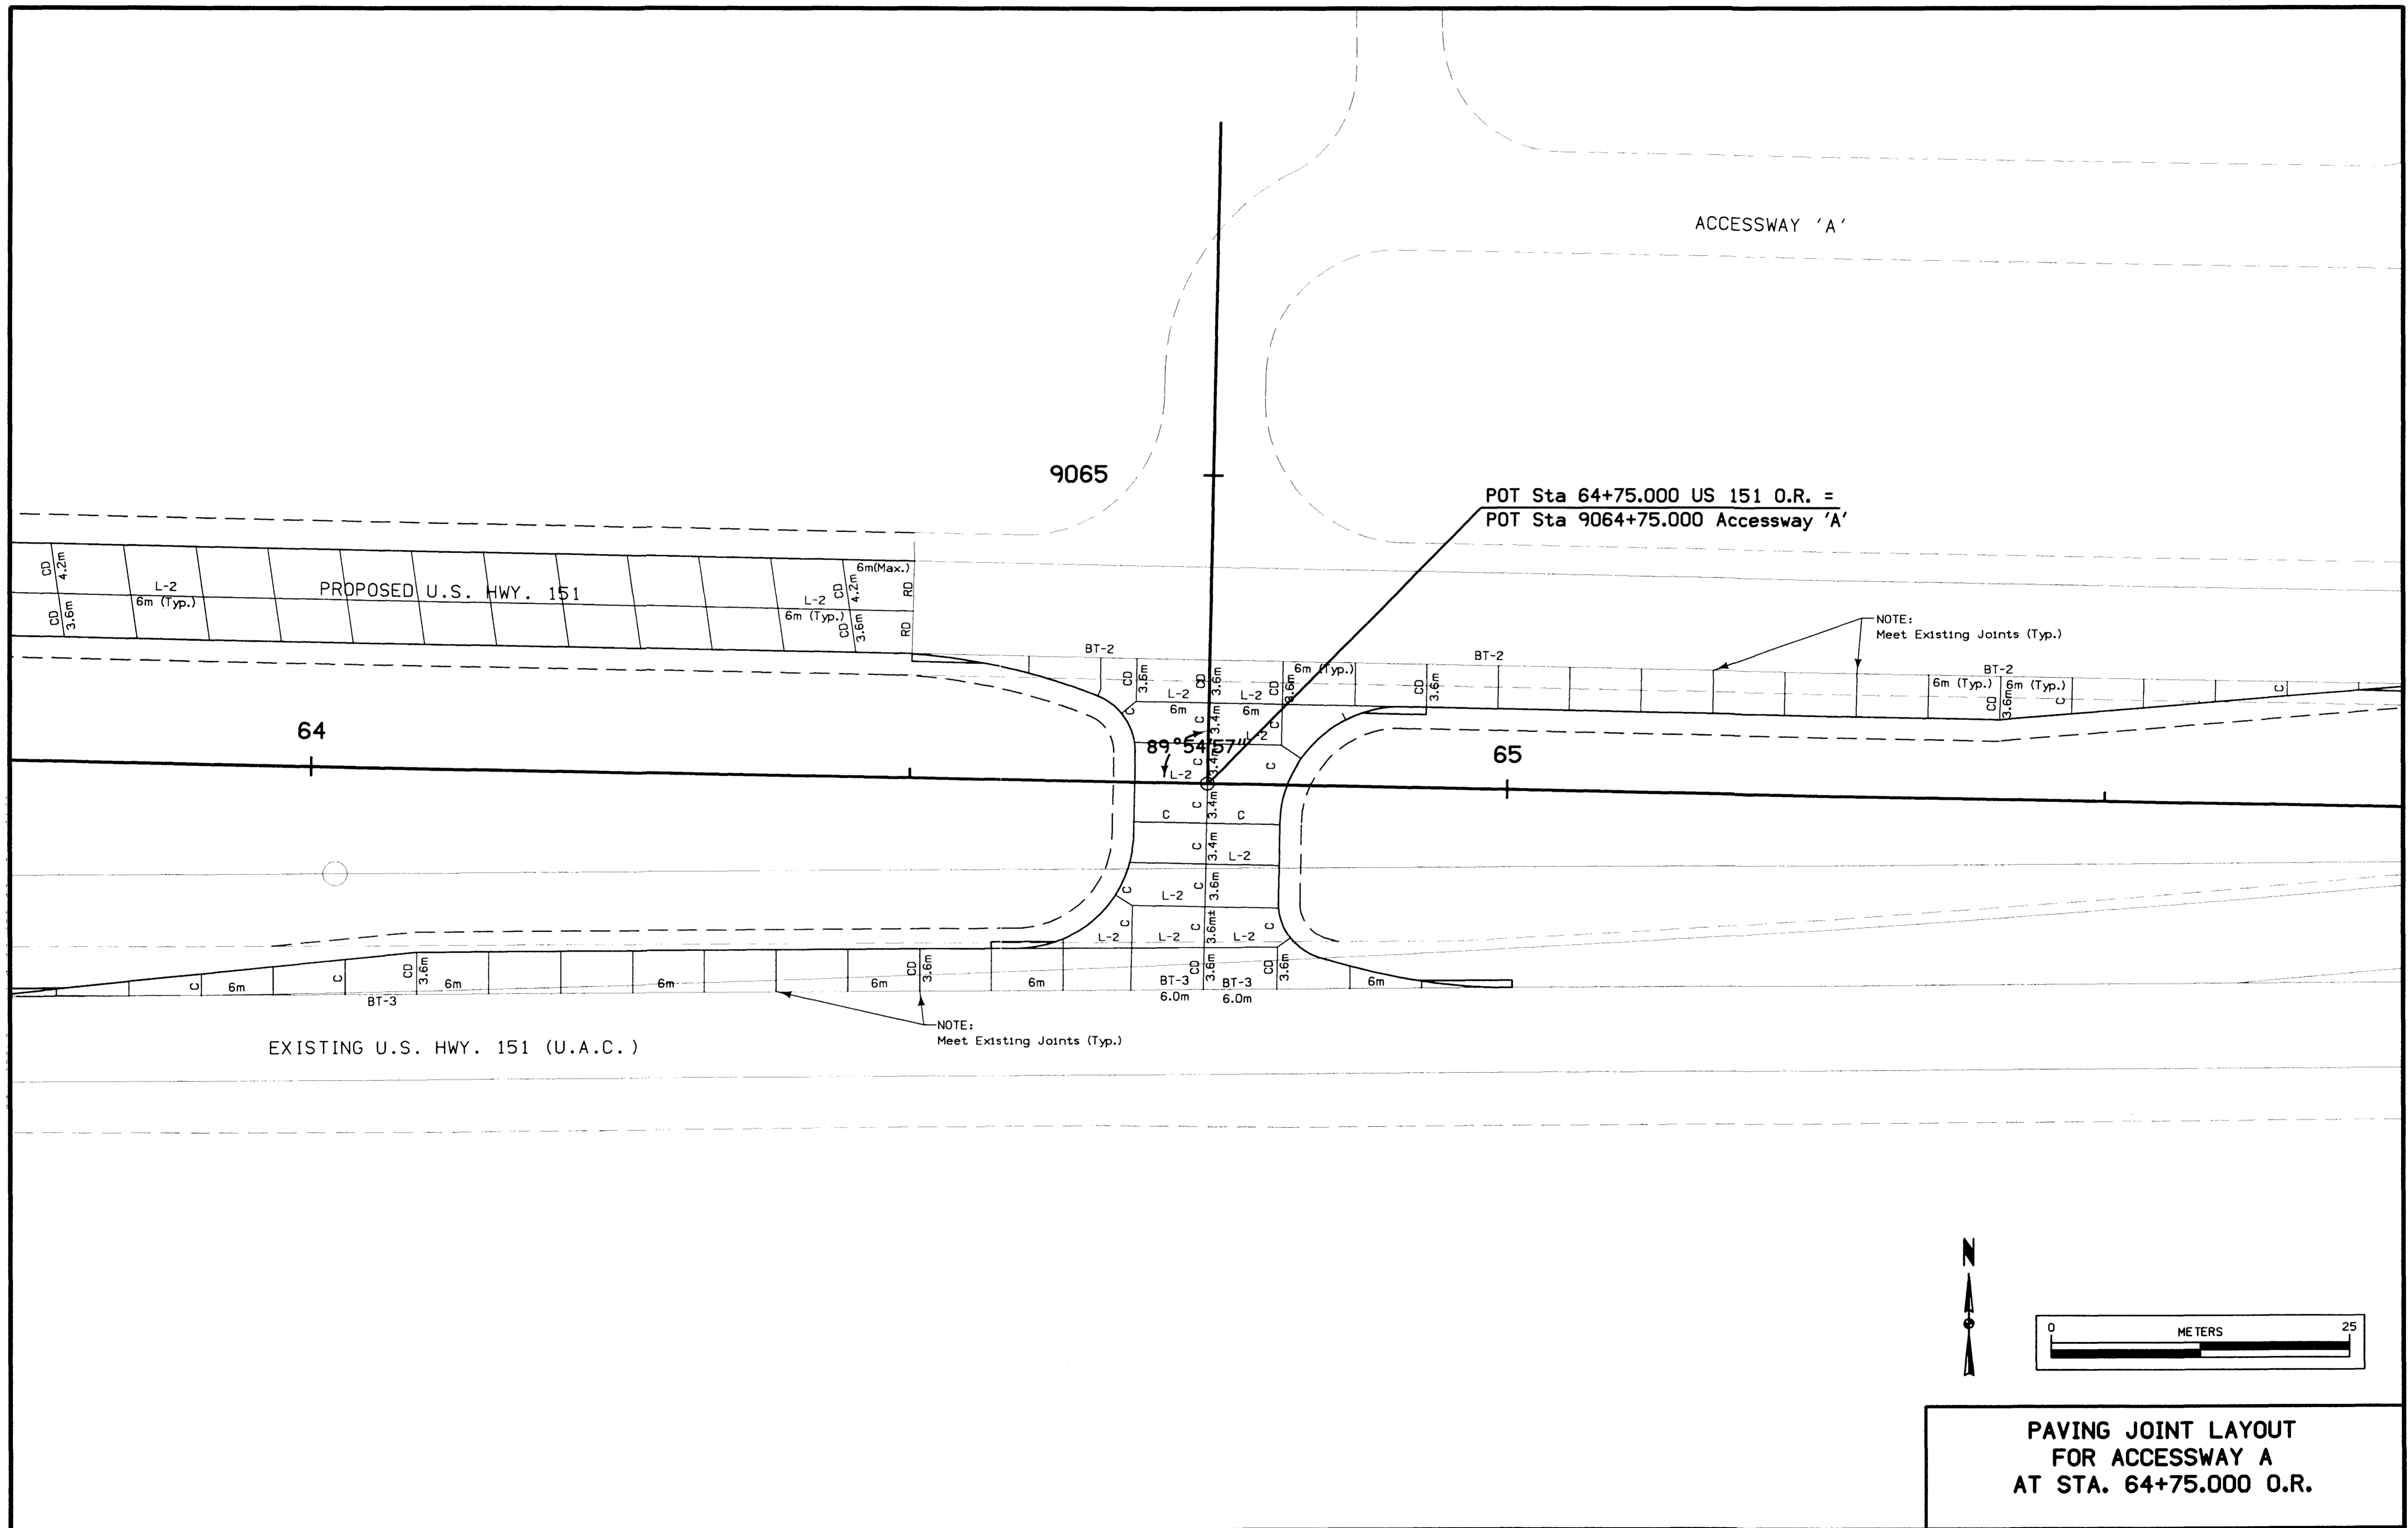

ACCESSWAY 'A'

9065


POT Sta 64+75.000 US 151 O.R. =
POT Sta 9064+75.000 Accessway 'A'

PROPOSED U.S. HWY. 151

EXISTING U.S. HWY. 151 (U.A.C.)

NOTE:
Meet Existing Joints (Typ.)

NOTE:
Meet Existing Joints (Typ.)

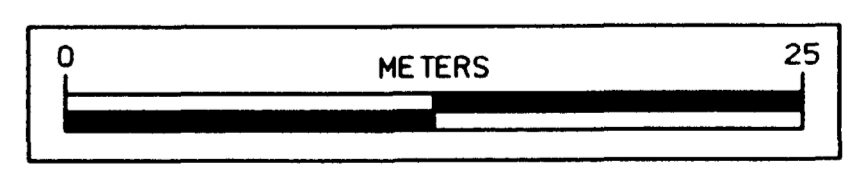


PAVING JOINT LAYOUT
FOR ACCESSWAY A
AT STA. 64+75.000 O.R.

CIRCULAR CURVE DATA

101-10C
09-27-94

NO.	Δ	R	T	L	E
G-1	26.580	20	4.724	9.278	0.550
G-2	131.127	5	11.004	11.443	7.087
G-3	18.433	50	8.113	16.086	0.654
G-4	43.856	21	8.454	16.074	1.638
G-5	115.898	5	7.986	10.114	4.422
G-6	20.200	40	7.125	14.102	0.630

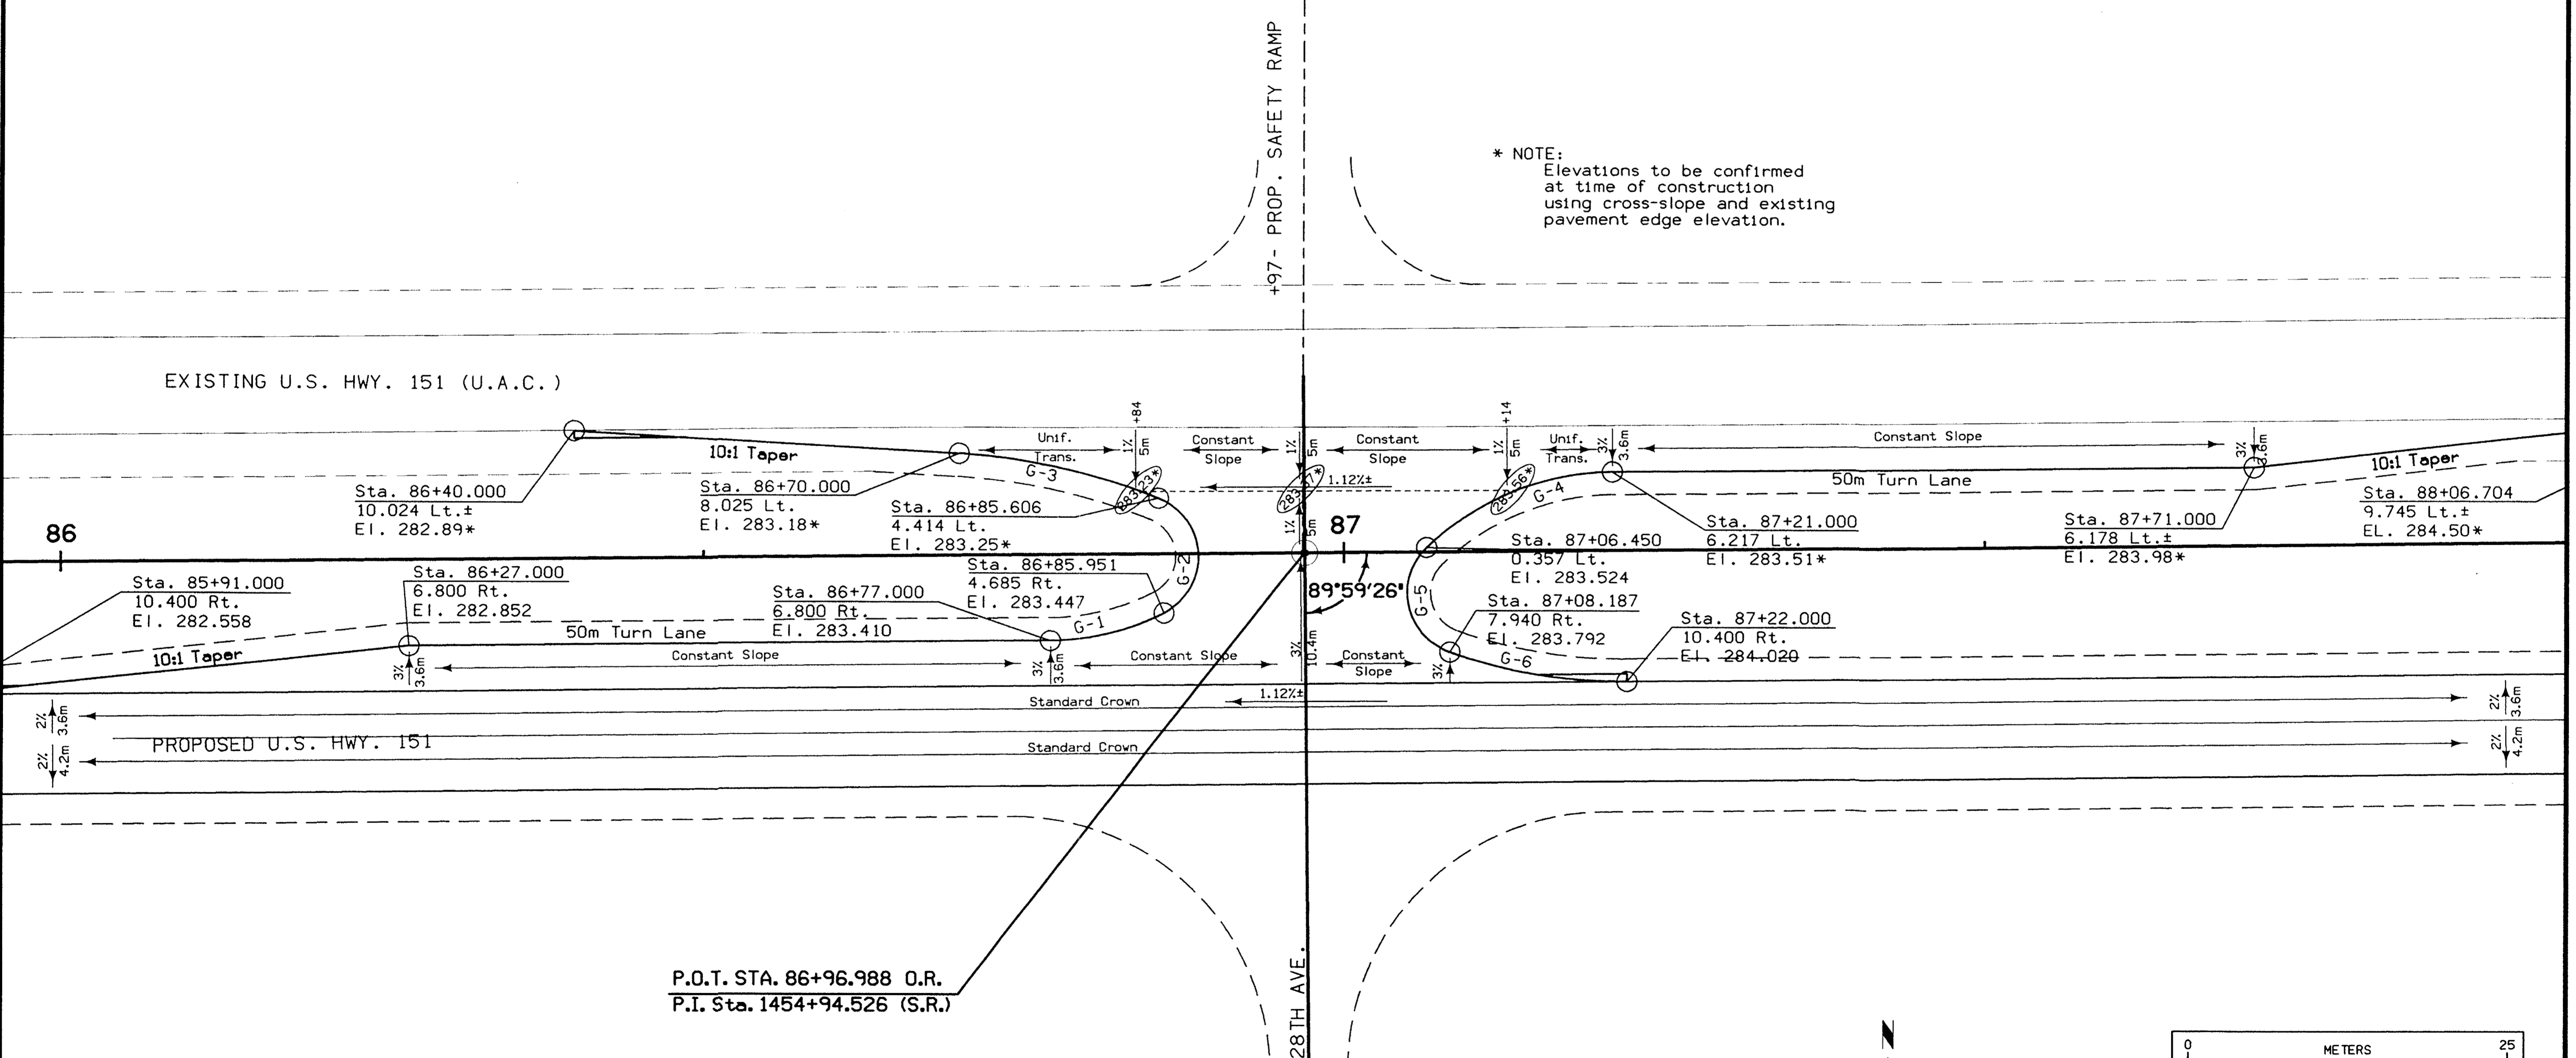


INTERSECTION PAVING REQUIREMENTS

101-12
09-27-94

TYPE	UNIT	AMOUNT	DESCRIPTION
Pavement	m ²	1110	Median Crossover
Island	m ²		
Curb	m		

GEOMETRIC AND STAKING DETAIL
FOR INTERSECTION OF U.S. HWY. 151
WITH 228TH AVE.
AT STA. 86+96.988 O.R.



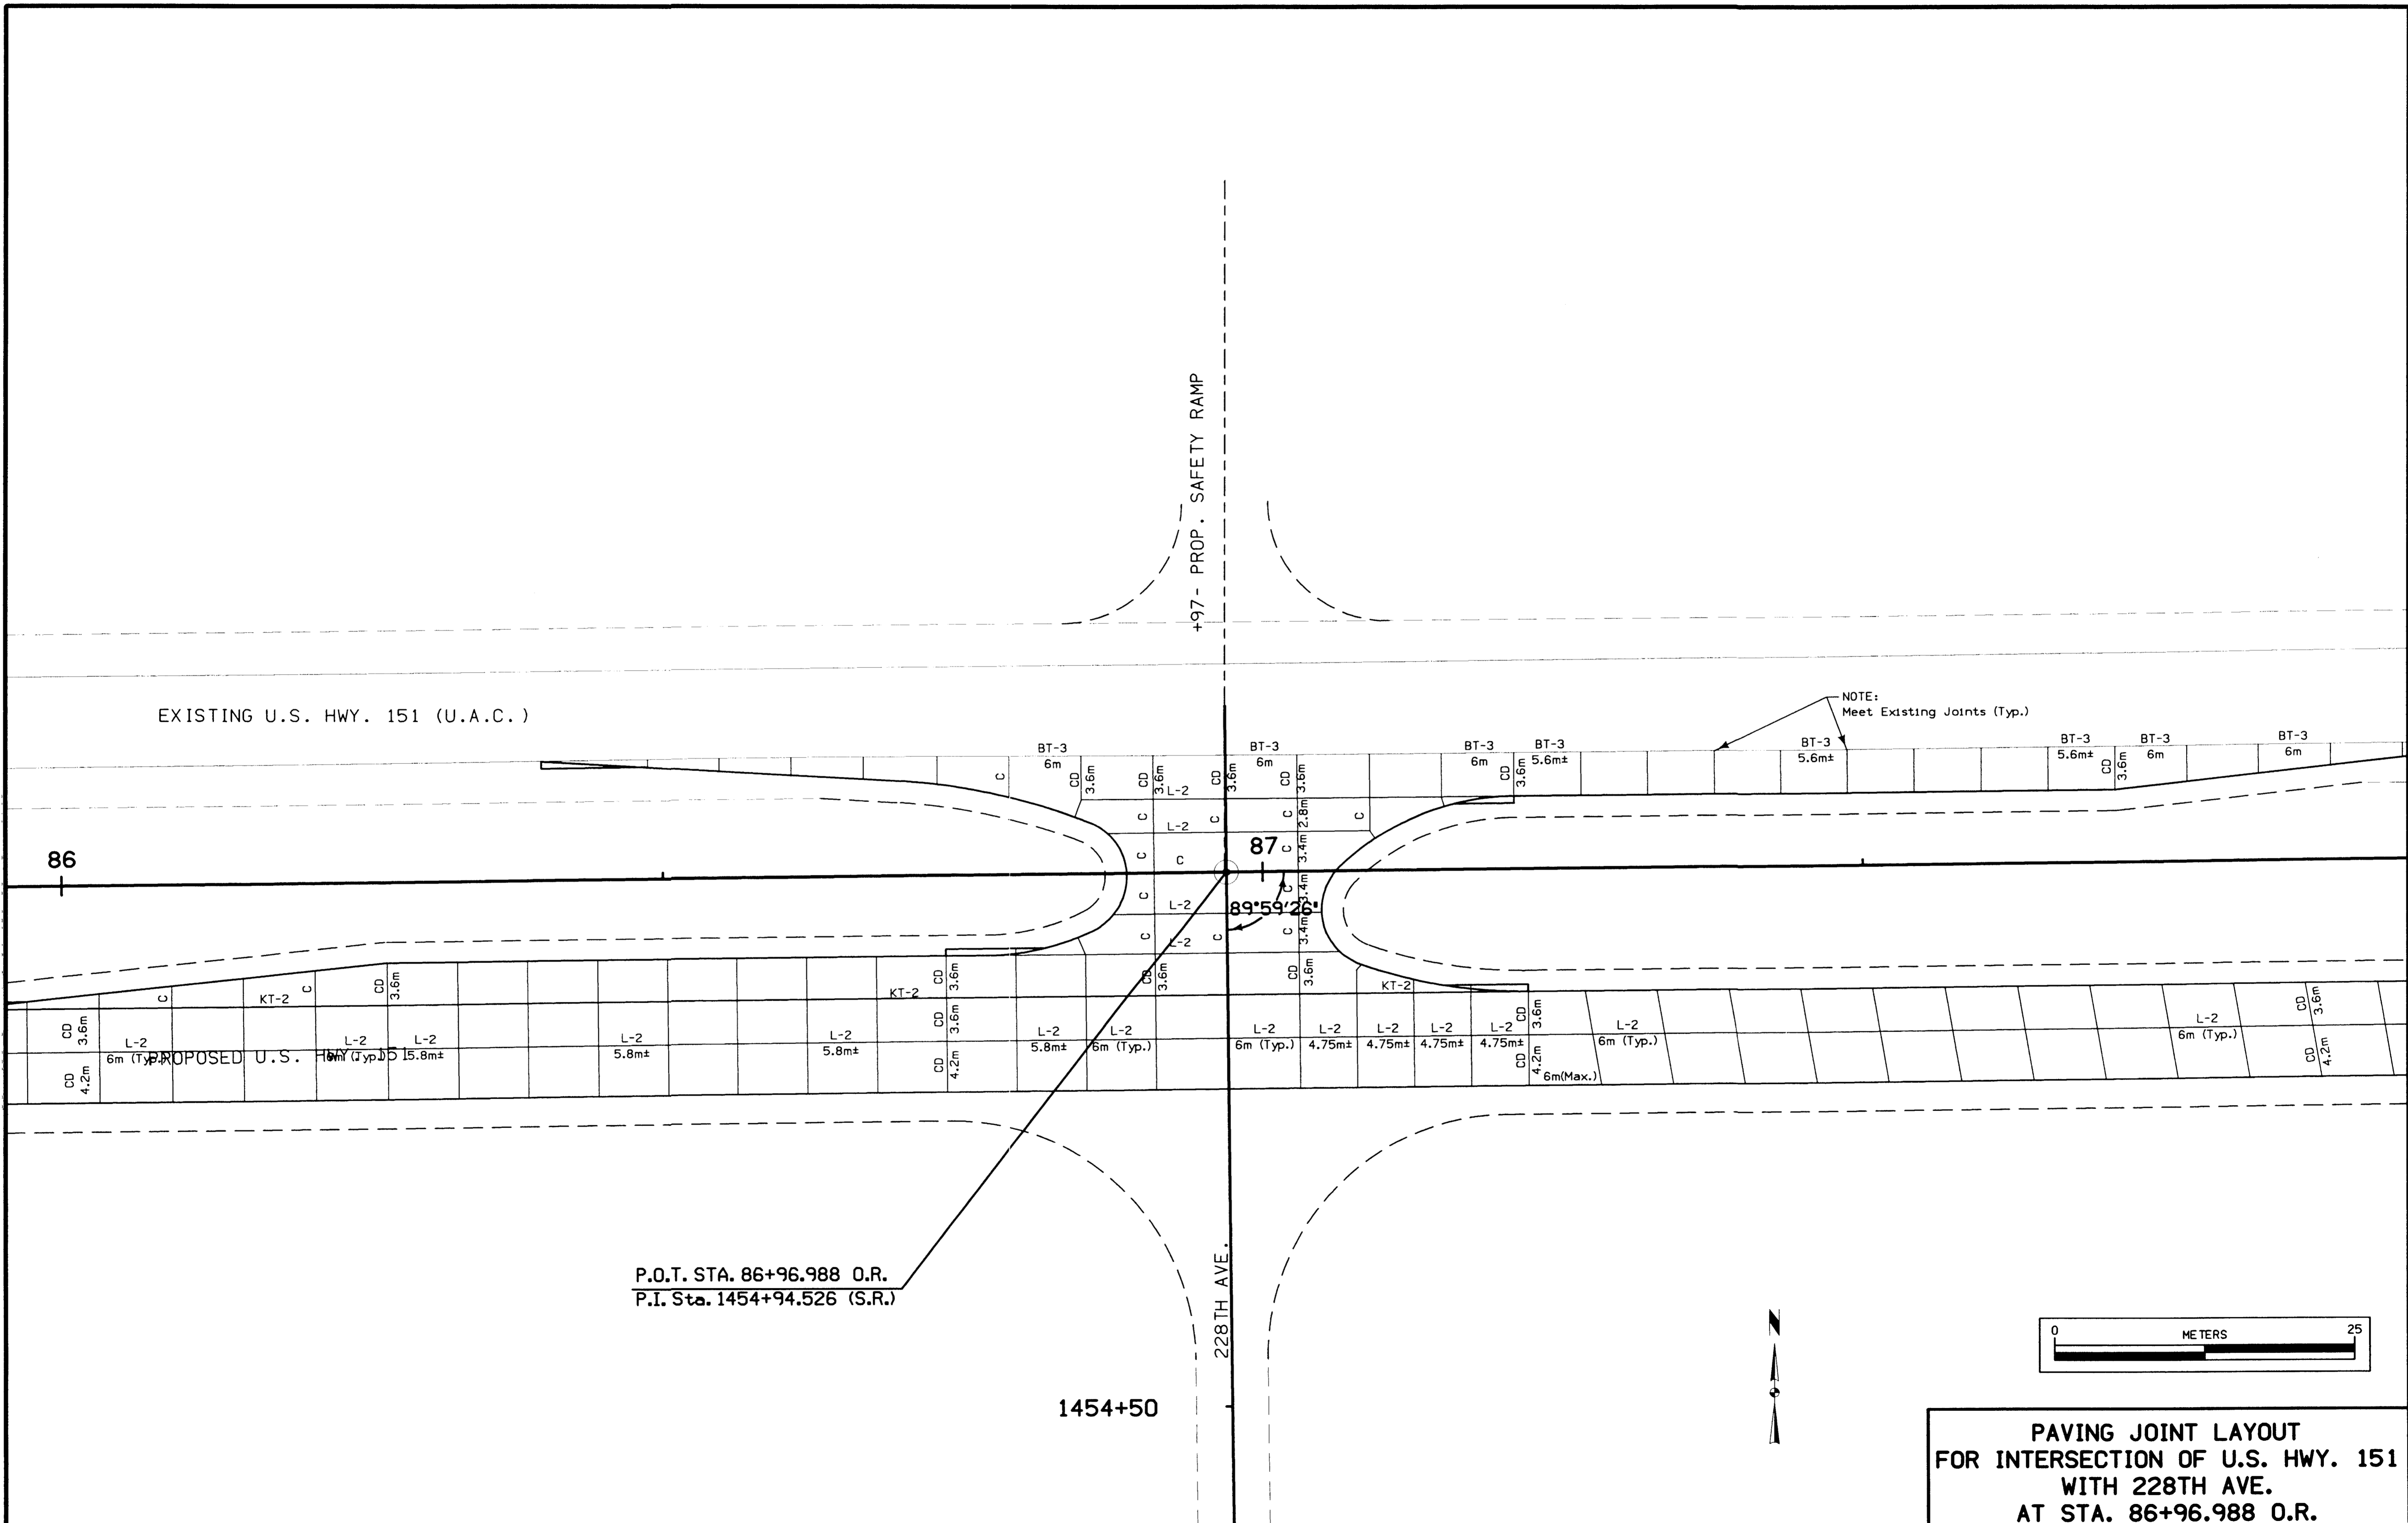

EXISTING U.S. HWY. 151 (U.A.C.)


86

87

NOTE:
Meet Existing Joints (Typ.)

P.O.T. STA. 86+96.988 O.R.
P.I. Sta. 1454+94.526 (S.R.)

1454+50

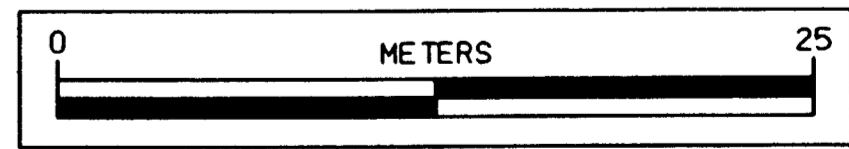


PAVING JOINT LAYOUT
FOR INTERSECTION OF U.S. HWY. 151
WITH 228TH AVE.
AT STA. 86+96.988 O.R.

CIRCULAR CURVE DATA

101-10C
09-27-94

NO.	Δ	R	T	L	E
H-1	41.033	18	6.736	12.891	1.219
H-2	109.951	5	7.134	9.595	3.712
H-3	28.979	35	9.045	17.702	1.150
H-4	57.475	15	8.225	15.047	2.107
H-5	65.157	5	3.195	5.686	0.934
H-6	51.528	15	7.240	13.490	1.656

* NOTE:
Elevations to be confirmed
at time of construction
using cross-slope and existing
pavement edge elevation.

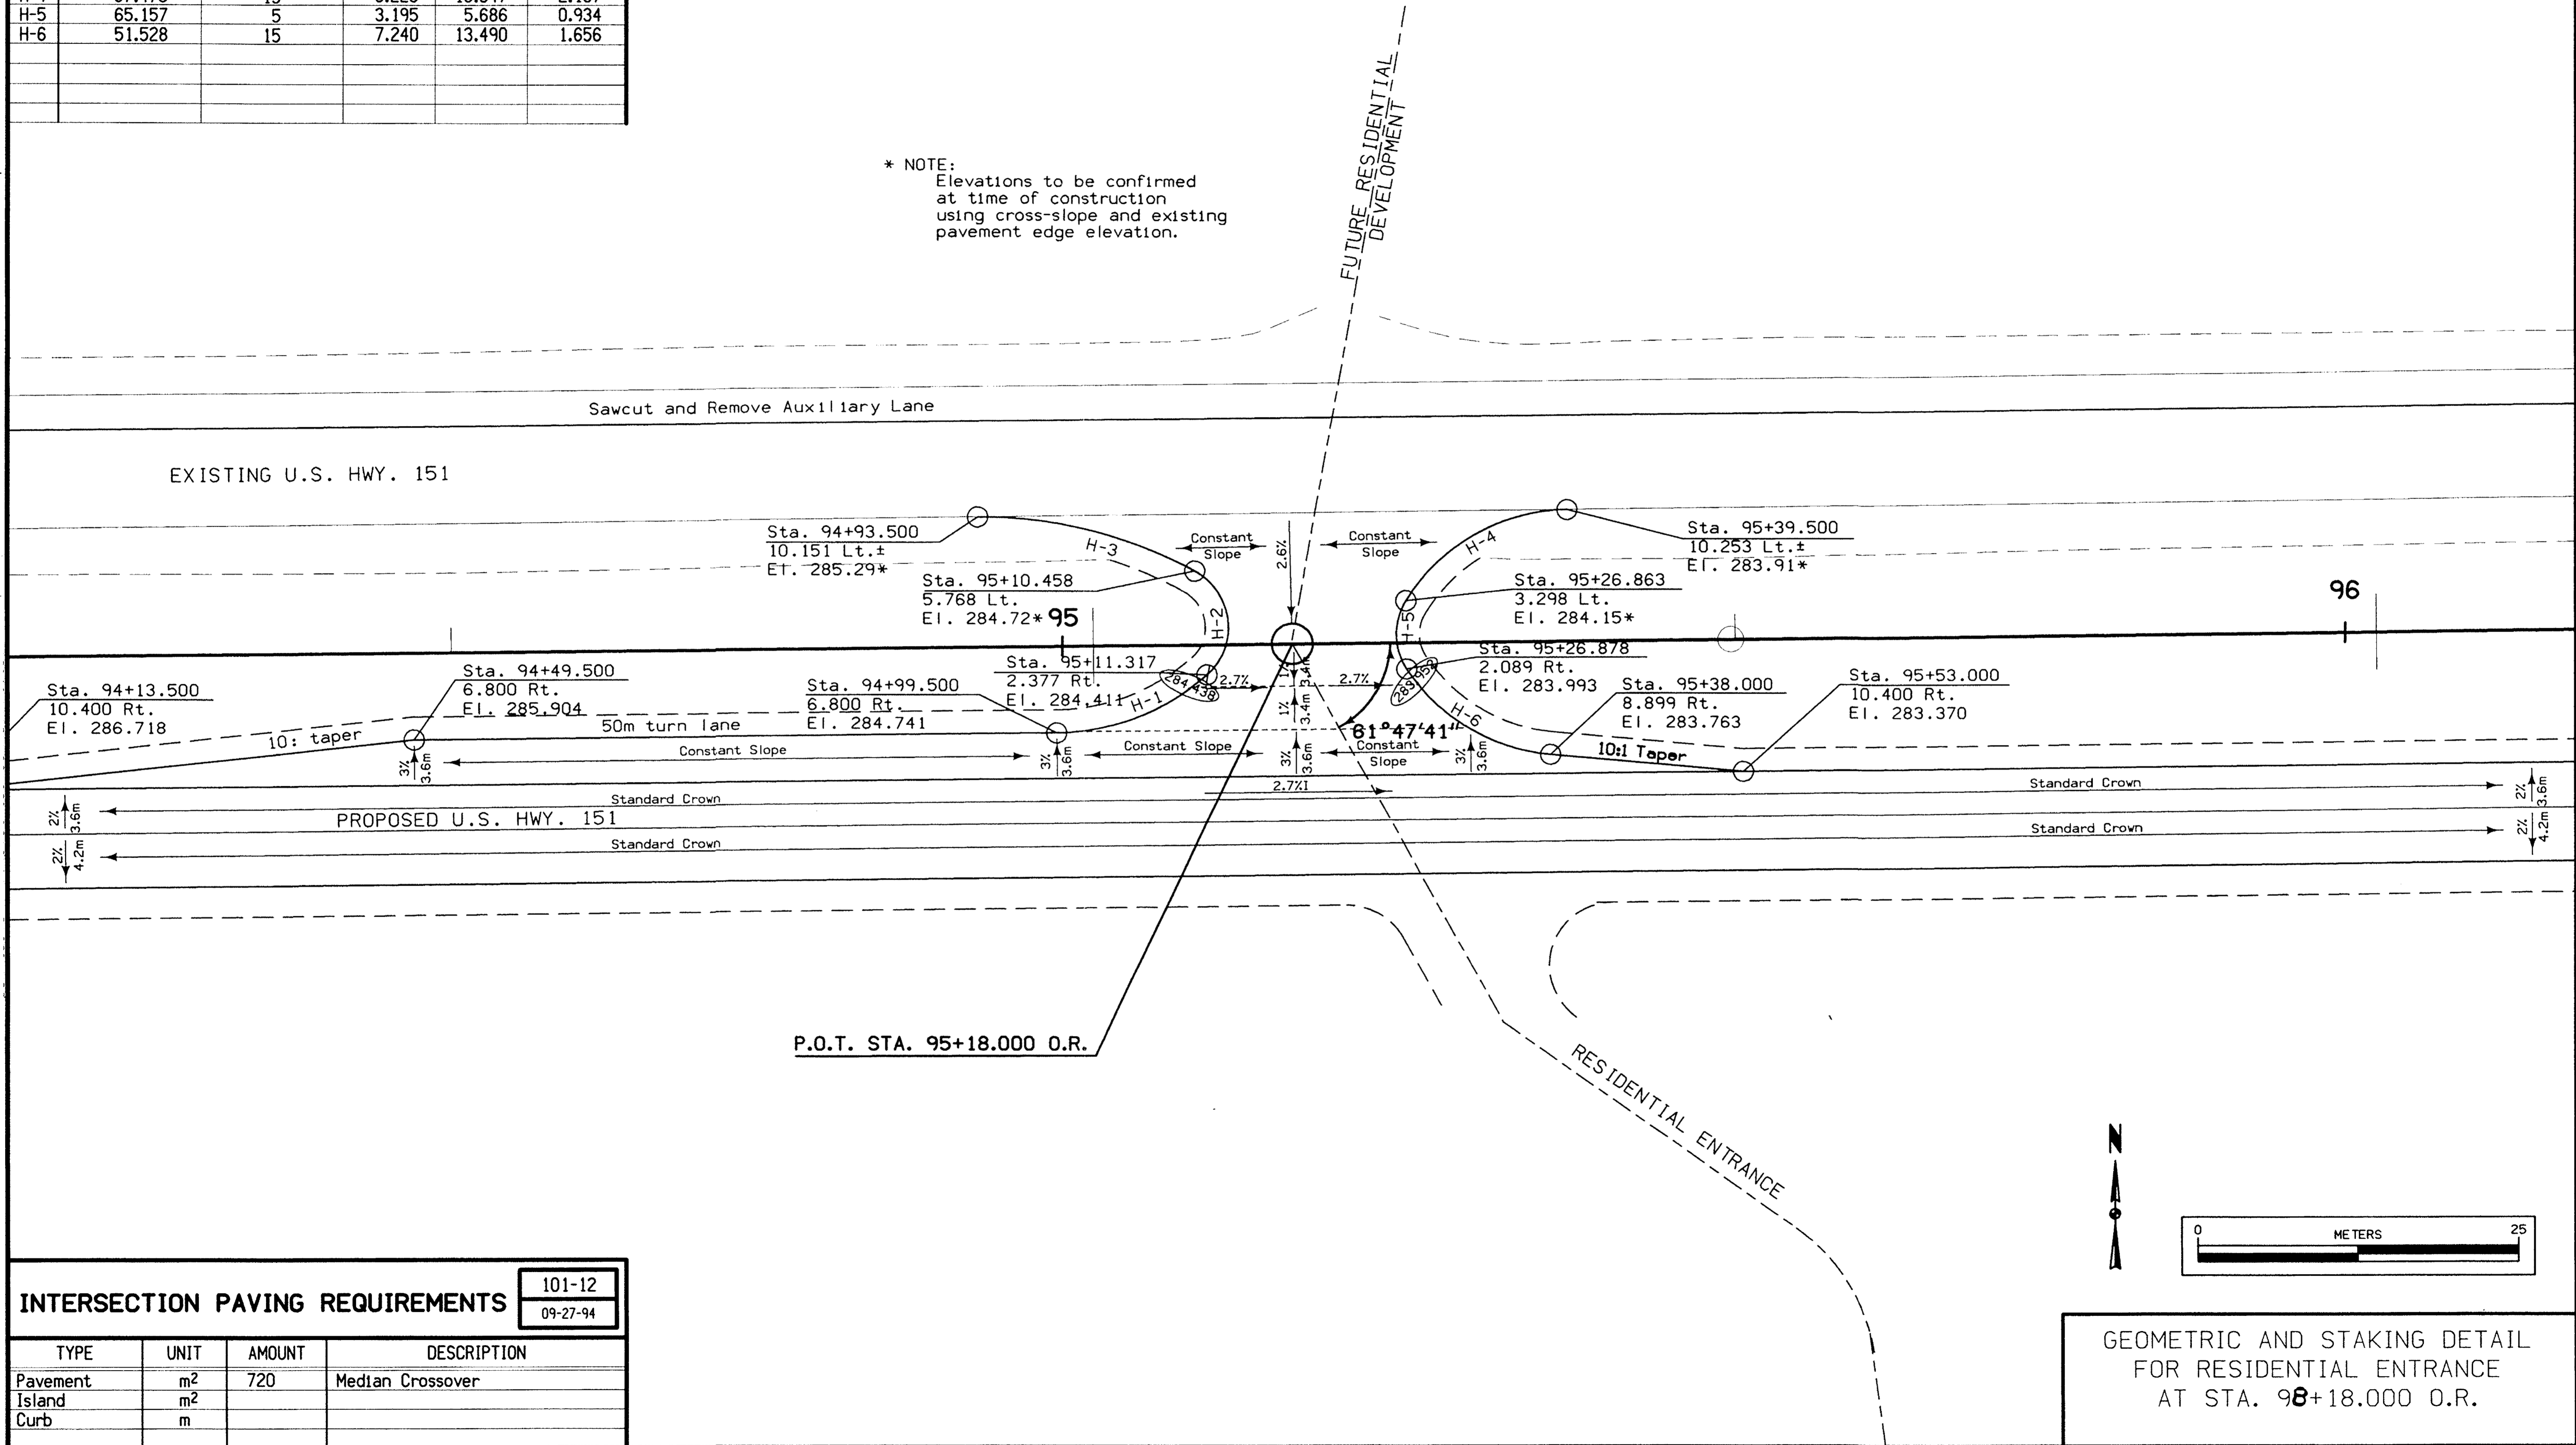


INTERSECTION PAVING REQUIREMENTS

101-12
09-27-94

TYPE	UNIT	AMOUNT	DESCRIPTION
Pavement	m ²	720	Median Crossover
Island	m ²		
Curb	m		

GEOMETRIC AND STAKING DETAIL
FOR RESIDENTIAL ENTRANCE
AT STA. 98+18.000 O.R.

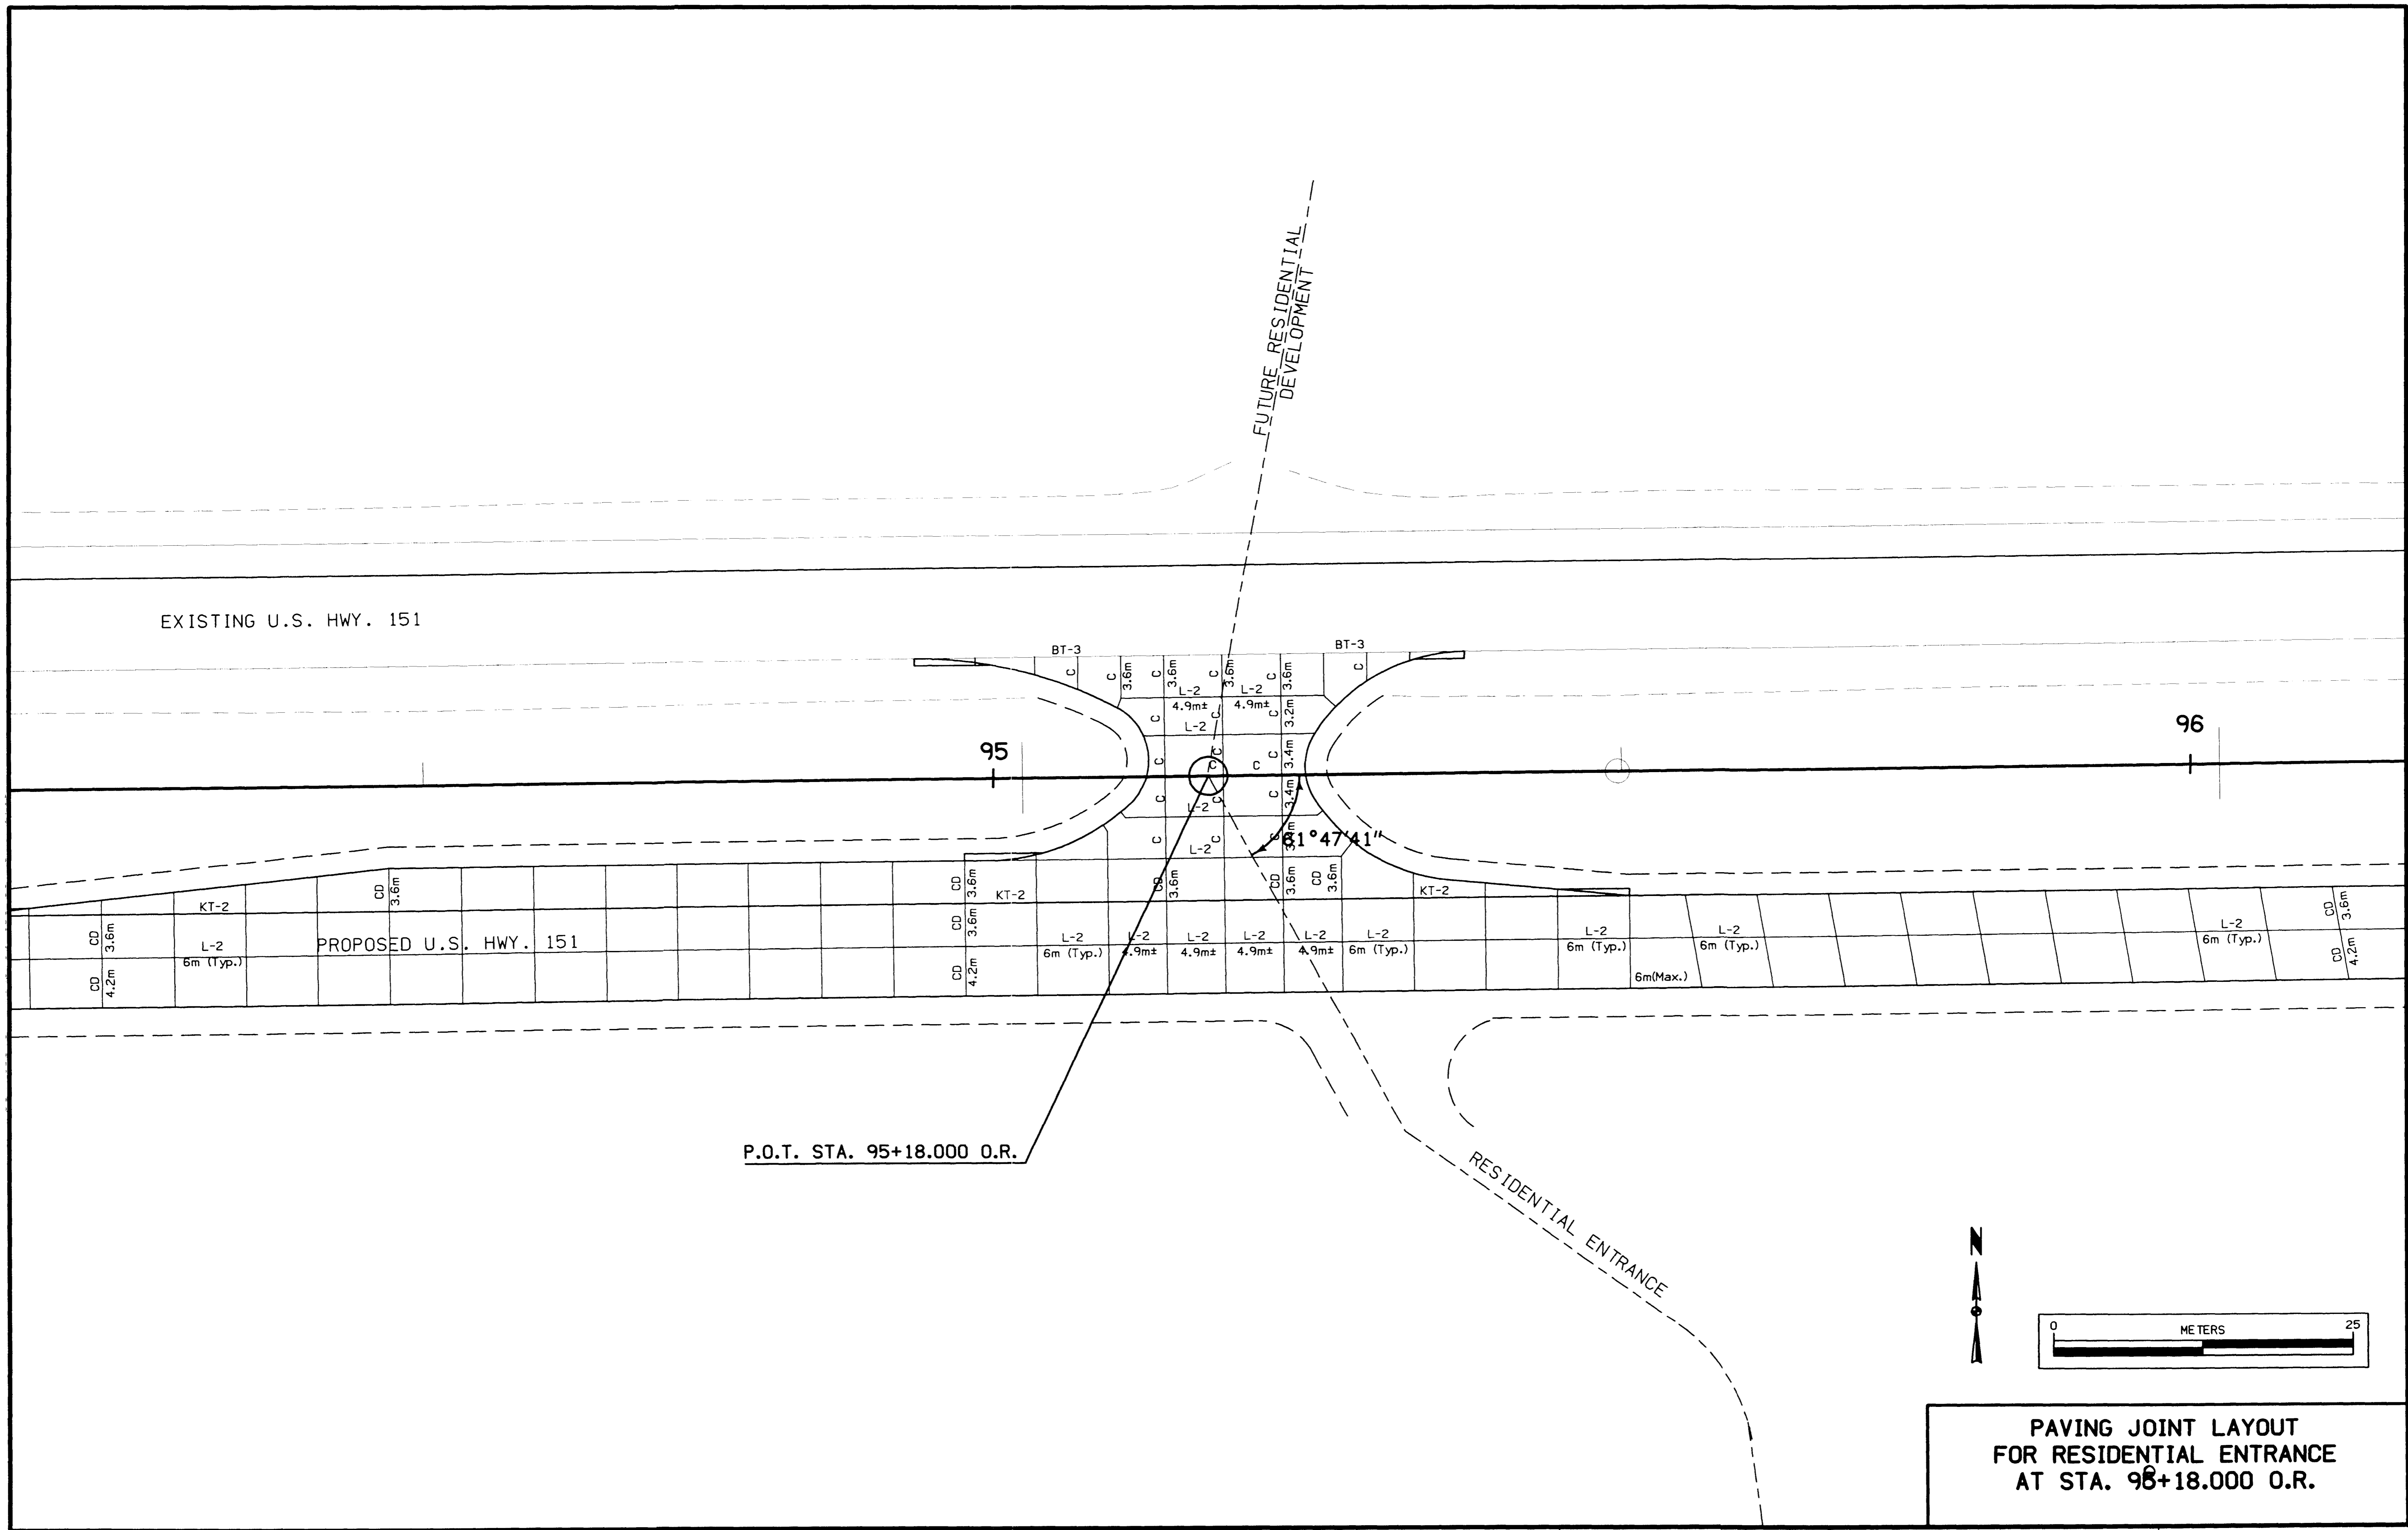

EXISTING U.S. HWY. 151

95

96


PROPOSED U.S. HWY. 151

P.O.T. STA. 95+18.000 O.R.

FUTURE RESIDENTIAL DEVELOPMENT

RESIDENTIAL ENTRANCE

81°47'41"

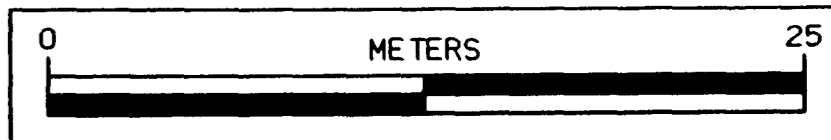


PAVING JOINT LAYOUT
FOR RESIDENTIAL ENTRANCE
AT STA. 98+18.000 O.R.

CIRCULAR CURVE DATA

101-10C
09-27-94

NO.	Δ	R	T	L	E
I-1	34.905	25	7.860	15.230	1.206
I-2	129.924	5	10.704	11.333	6.814
I-3	11.351	50	4.969	9.906	0.246
I-4	34.799	25	7.834	15.184	1.199
I-5	129.557	5	10.615	11.306	6.734
I-6	12.017	50	5.263	10.487	0.276

* NOTE:
Elevations to be confirmed
at time of construction
using cross-slope and existing
pavement edge elevation.

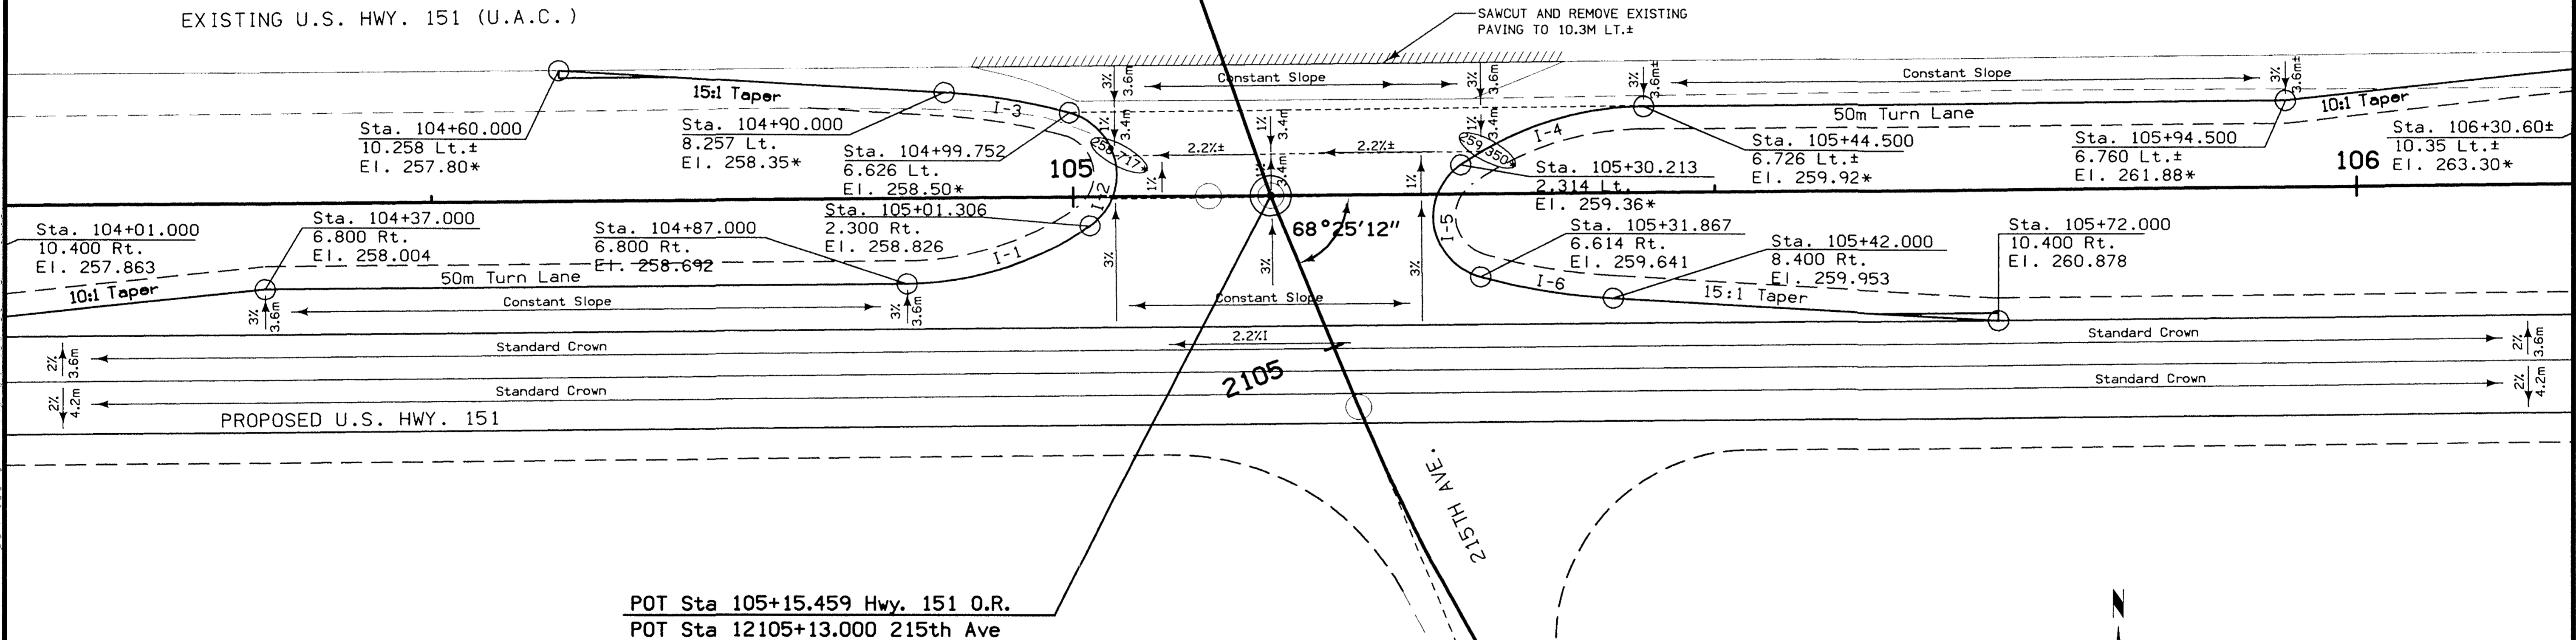


INTERSECTION PAVING REQUIREMENTS

101-12
09-27-94

TYPE	UNIT	AMOUNT	DESCRIPTION
Pavement	m ²	1340	Median Crossover
Island	m ²		
Curb	m		

GEOMETRIC AND STAKING DETAIL
INTERSECTION OF U.S. HWY. 151
WITH 215TH ST.
AT STA. 105+15.549 O.R.

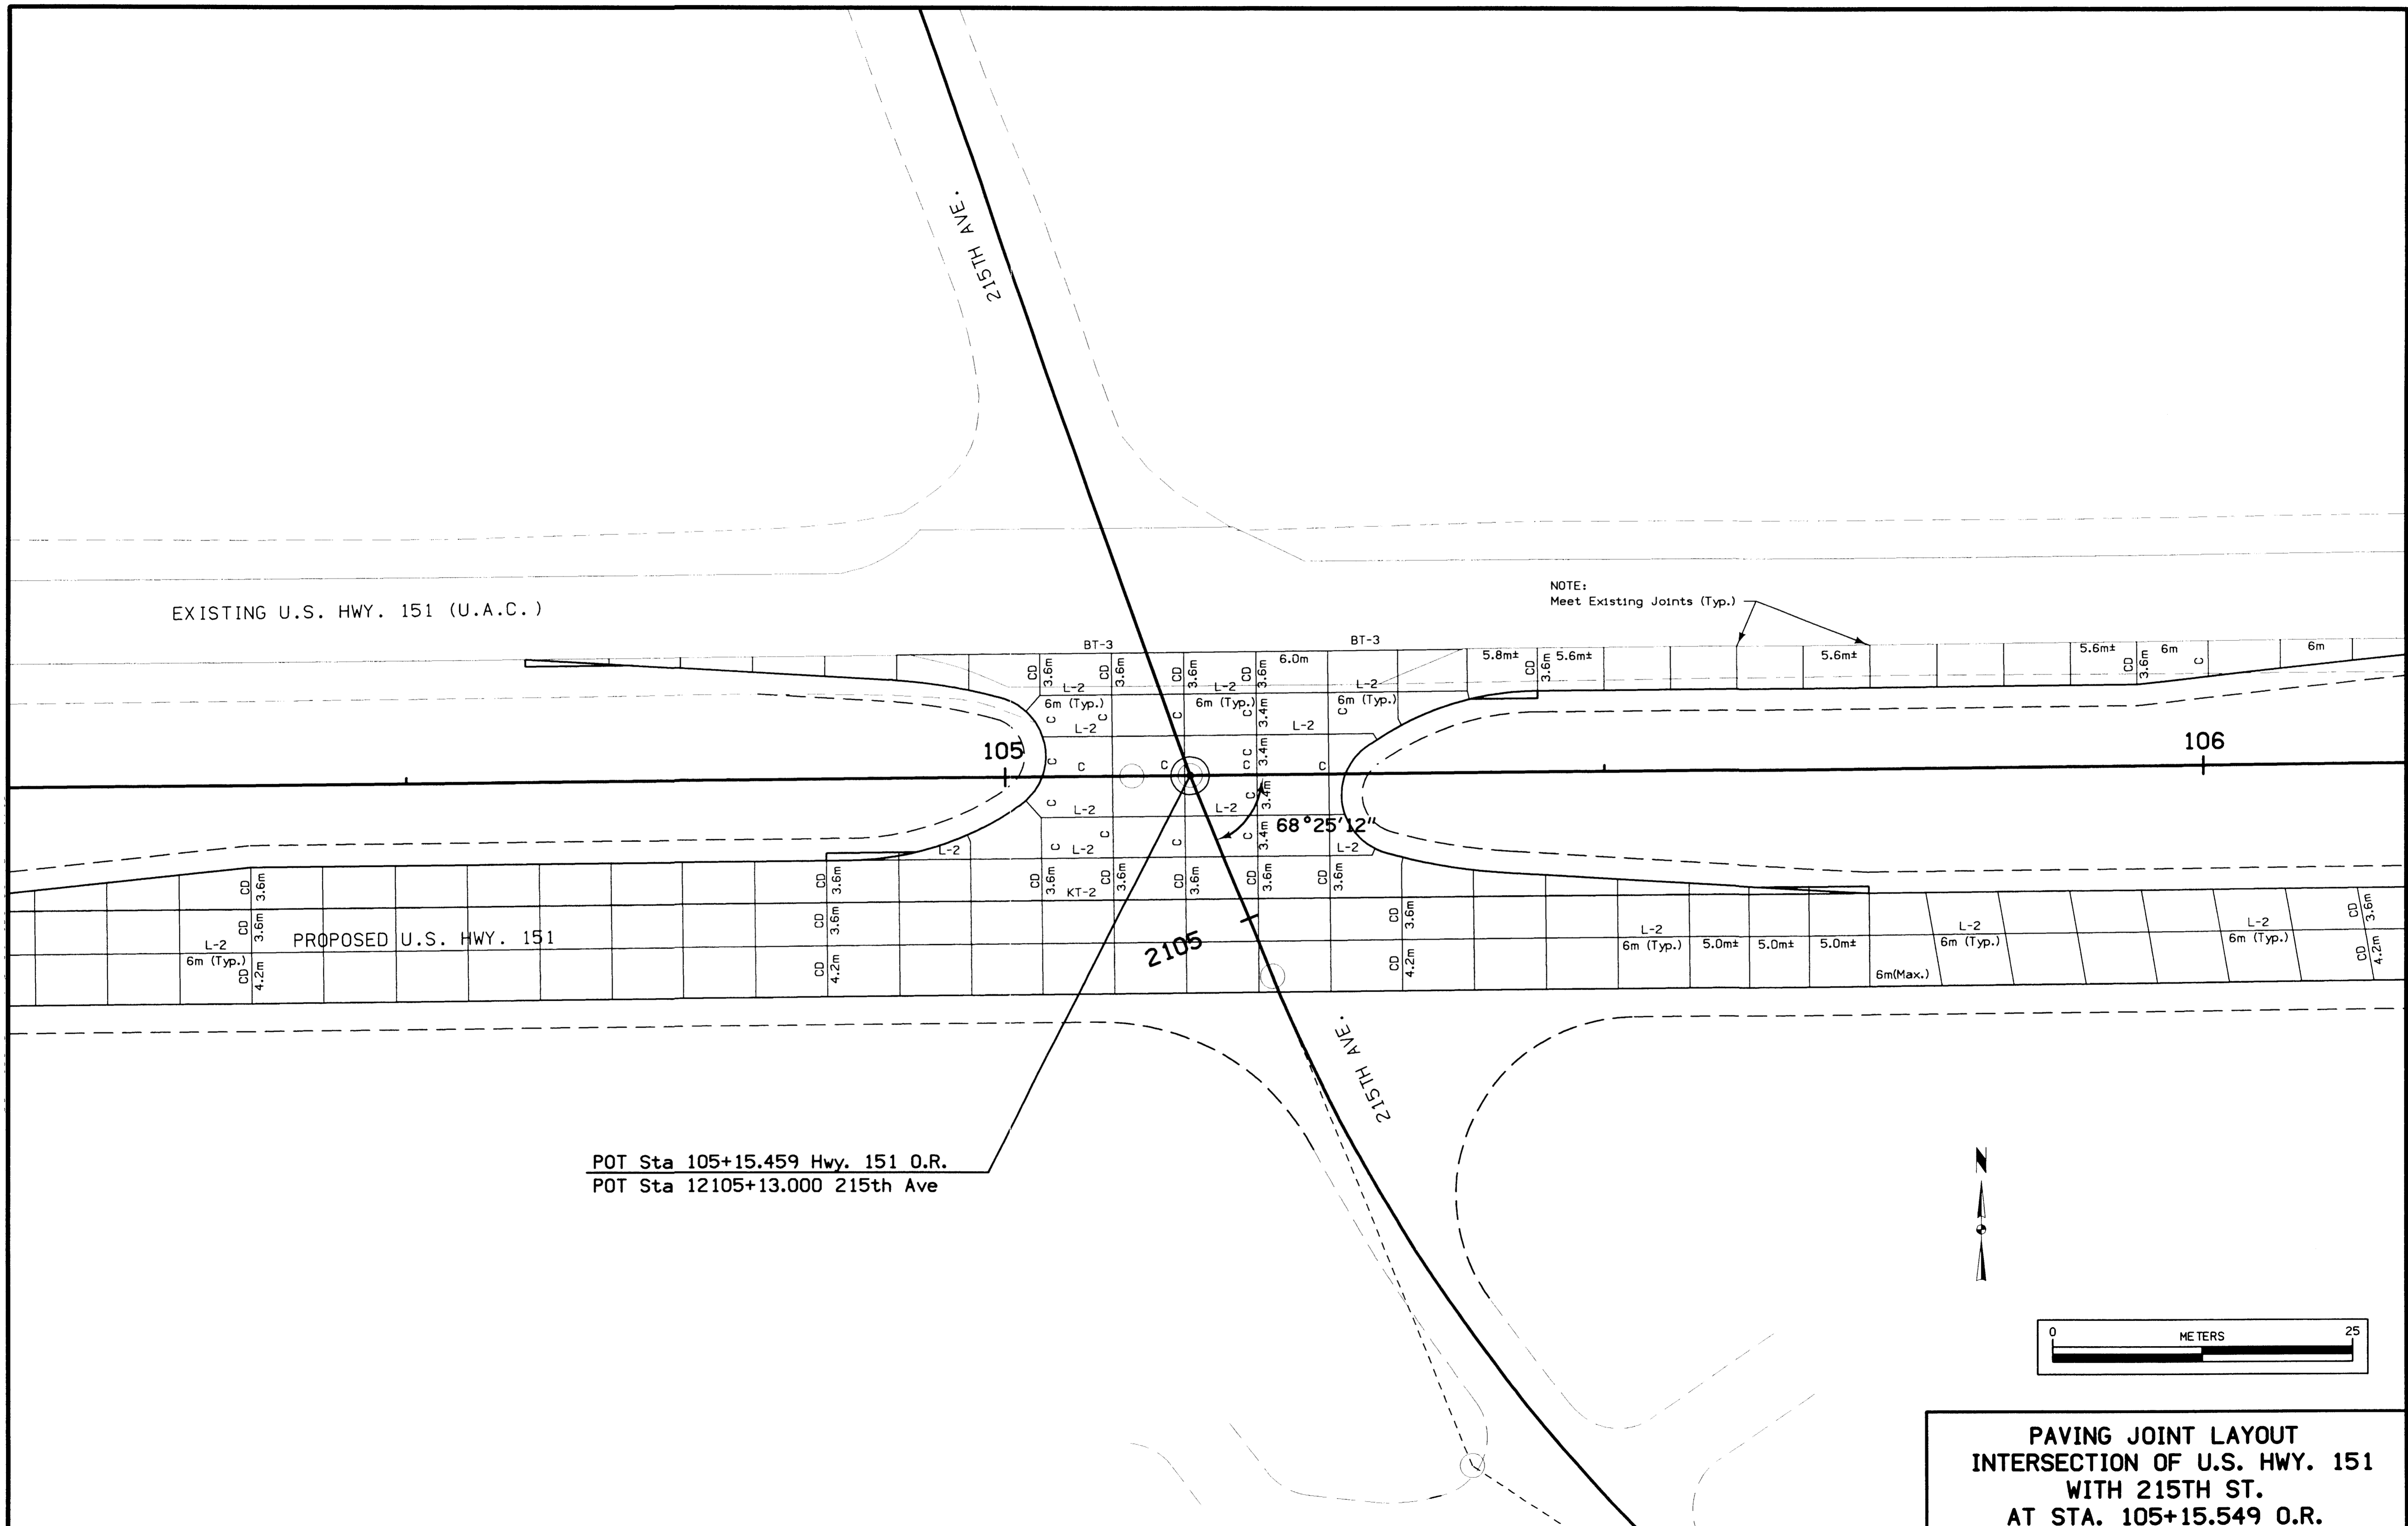

POT Sta 105+15.459 Hwy. 151 O.R.
 POT Sta 12105+13.000 215th Ave


PAVING JOINT LAYOUT
 INTERSECTION OF U.S. HWY. 151
 WITH 215TH ST.
 AT STA. 105+15.459 O.R.

CIRCULAR CURVE DATA

101-10C
09-27-94

NO.	Δ	R	T	L	E
J-1	22.566	20	3.990	7.877	0.394
J-2	142.495	7	20.618	17.409	14.774
J-3	14.902	75	9.809	19.507	0.639
J-4	49.494	18	8.297	15.549	1.820
J-5	124.762	8	15.290	17.420	9.257

* NOTE:
Elevations to be confirmed
at time of construction
using cross-slope and existing
pavement edge elevation.


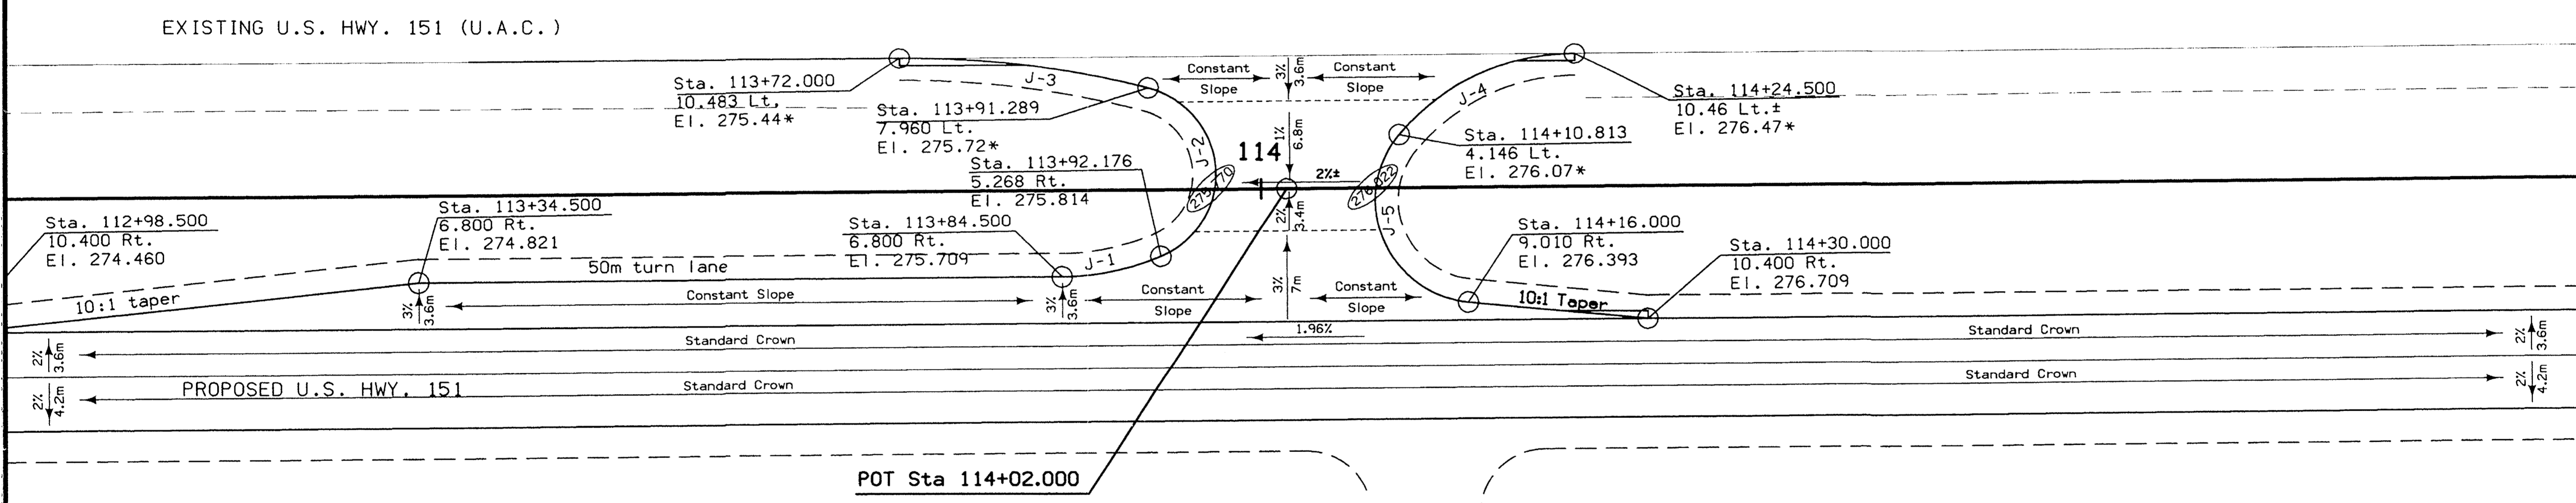





INTERSECTION PAVING REQUIREMENTS

101-12
09-27-94

TYPE	UNIT	AMOUNT	DESCRIPTION
Pavement	m ²	685	Median Crossover
Island	m ²		
Curb	m		

GEOMETRIC AND STAKING DETAIL
RESIDENTIAL ENTRANCE
AT STA. 114+02.000 O.R.

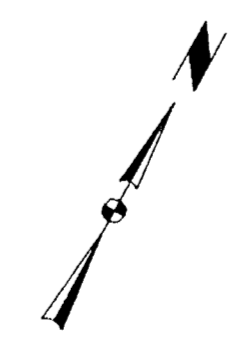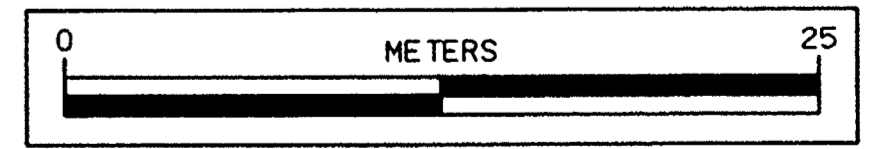

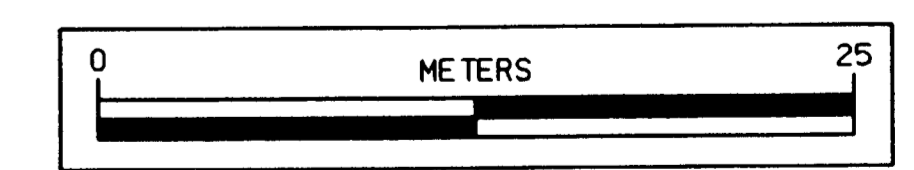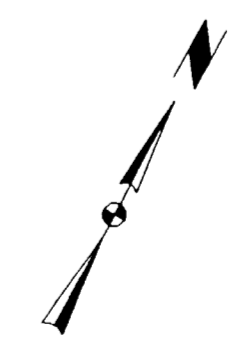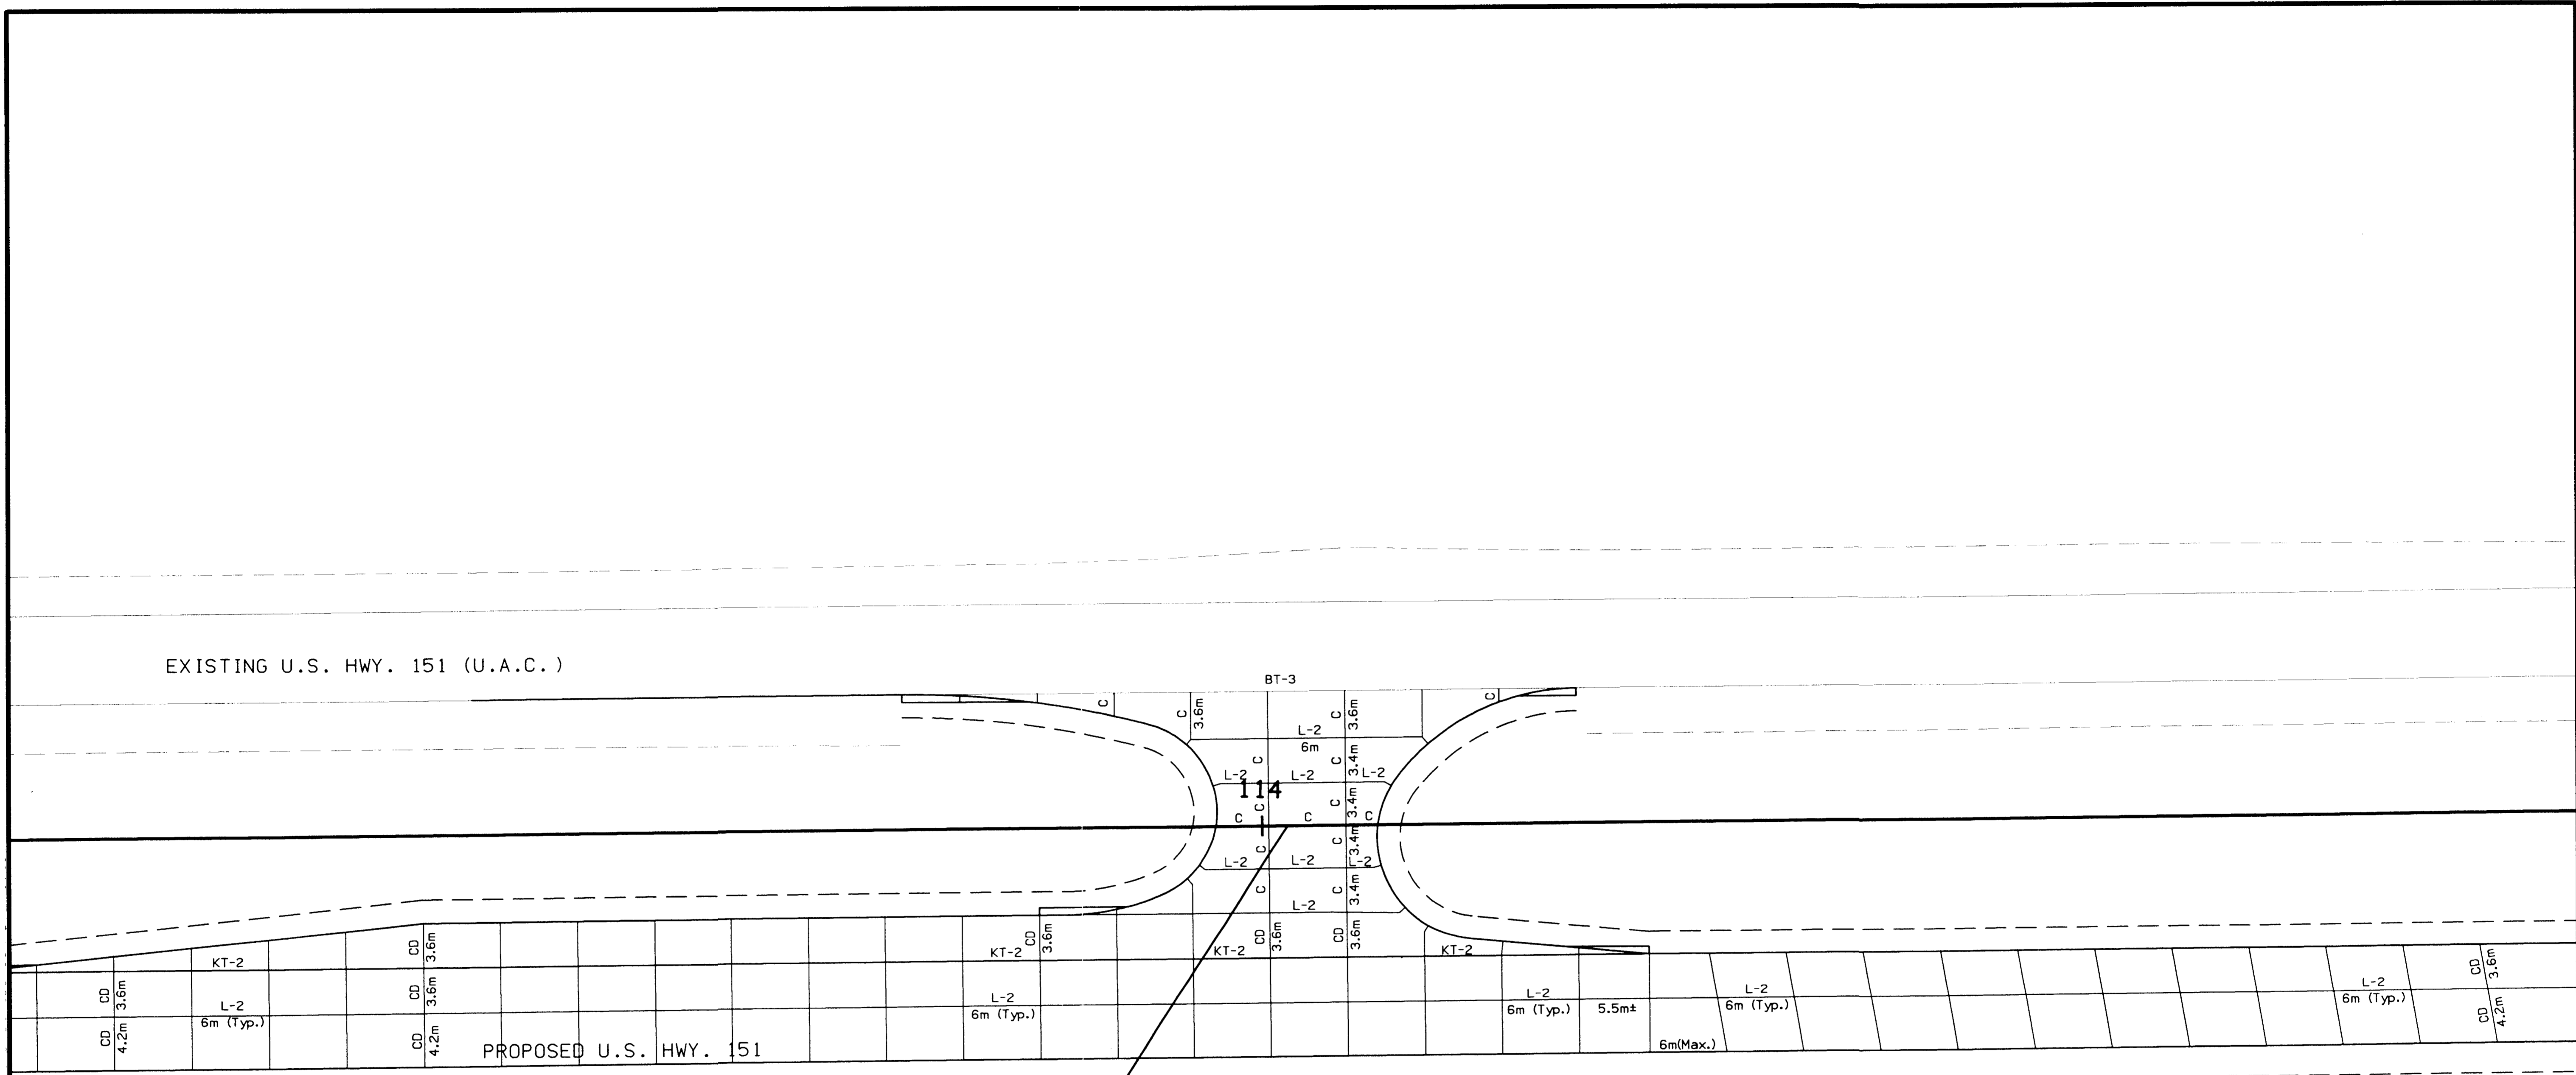


**PAVING JOINT LAYOUT
RESIDENTIAL ENTRANCE
AT STA. 114+02.000 O.R.**

CIRCULAR CURVE DATA

101-10C
09-27-94

NO.	Δ	R	T	L	E
J-1	22.437	20	3.967	7.832	0.390
J-2	136.731	5	12.606	11.932	8.562
J-3	20.793	100	18.347	36.291	1.669
J-4	20.572	20	3.630	7.181	0.327
J-5	138.816	5	13.308	12.114	9.216
J-6	20.495	100	18.079	35.771	1.621


* NOTE:
Elevations to be confirmed
at time of construction
using cross-slope and existing
pavement edge elevation.

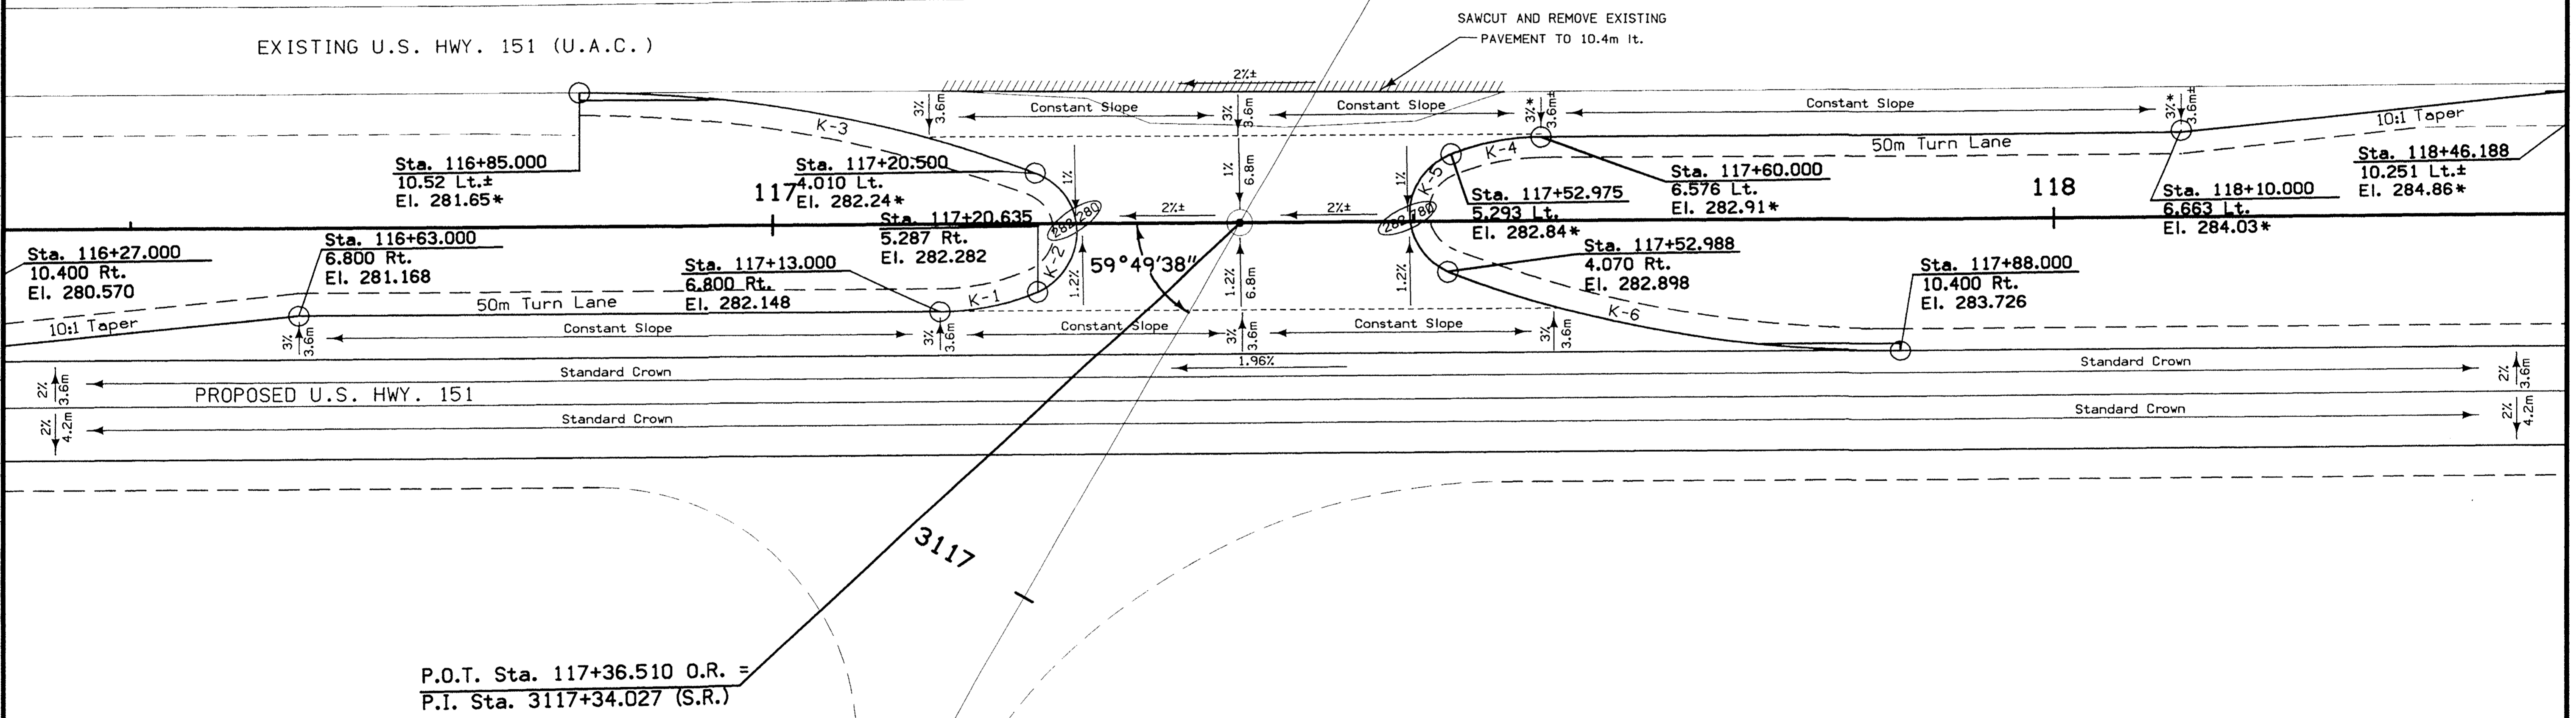


INTERSECTION PAVING REQUIREMENTS

101-12
09-27-94

TYPE	UNIT	AMOUNT	DESCRIPTION
Pavement	m ²	1350	Median Crossover
Island	m ²		
Curb	m		


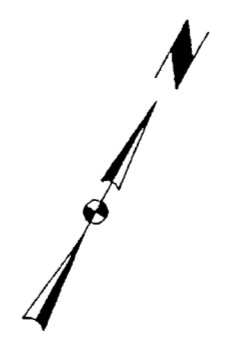


GEOMETRIC AND STAKING DETAIL
INTERSECTION OF U.S. HWY. 151
WITH FOREST CHAPEL RD.
AT STA. 117+36.510 O.R.

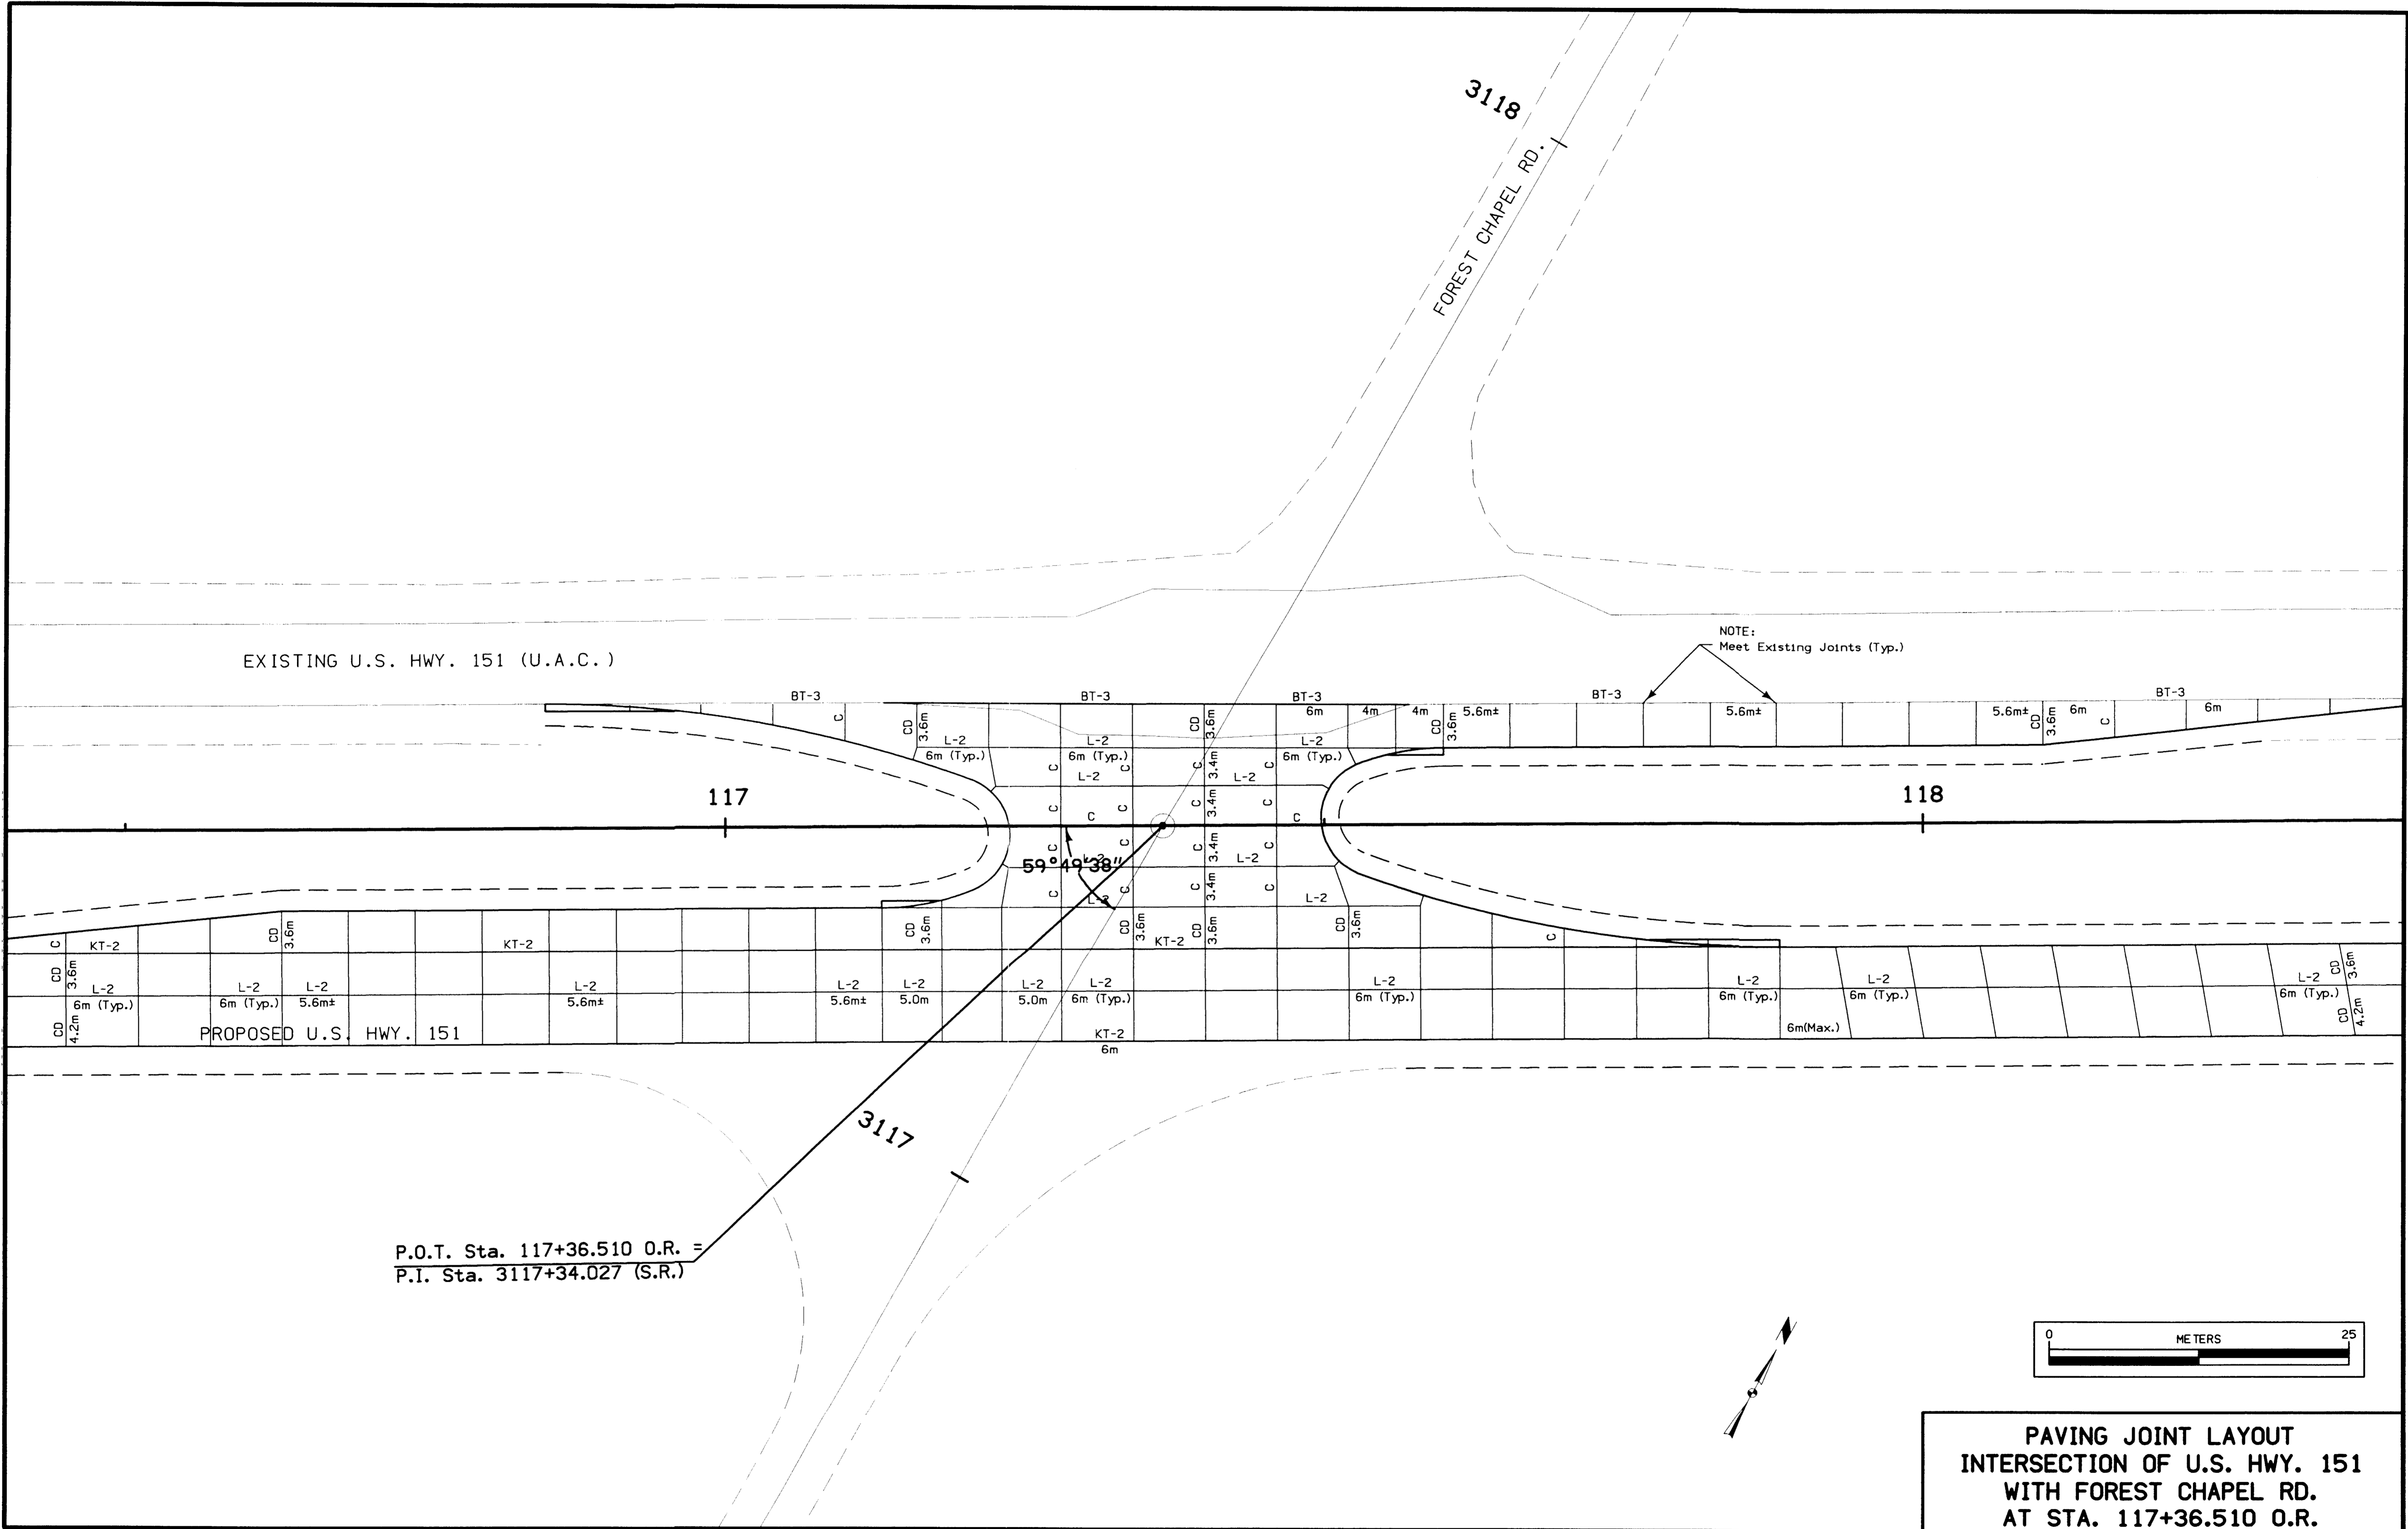

NOTE:
Meet Existing Joints (Typ.)

P.O.T. Sta. 117+36.510 O.R. =
P.I. Sta. 3117+34.027 (S.R.)

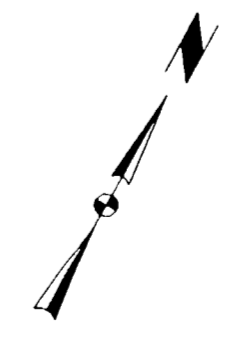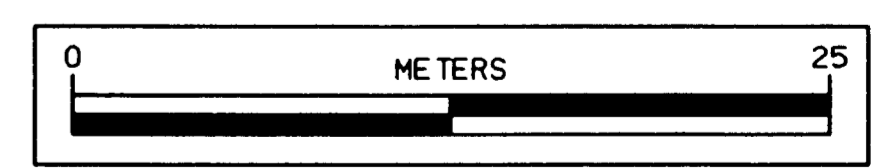

**PAVING JOINT LAYOUT
INTERSECTION OF U.S. HWY. 151
WITH FOREST CHAPEL RD.
AT STA. 117+36.510 O.R.**

CIRCULAR CURVE DATA

101-10C
09-27-94


NO.	Δ	R	T	L	E
P-1	34.071	20	6.128	11.893	0.918
P-2	122.178	5	9.053	10.662	5.342
P-3	21.932	100	19.377	38.279	1.860
P-4*	73.759	27	20.257	34.758	6.754
P-5	11.075	150	14.542	28.993	0.703
P-6	66.412	30	19.636	34.773	5.855
P-7	20.315	65	11.646	23.047	1.035
P-8	31.809	30	8.548	16.655	1.194
P-9	127.474	6	12.160	13.349	7.559
P-10	20.678	30	5.473	10.827	0.495

*Revised Curve P-4 to tie into previously constructed curve P-5, approx. 6.93m Rt. Sta. 2131+71.19.

ISLAND DATA

101-13
09-27-94

POINT NO.	STATION	ELEVATION
1	131+37.967, 21.600 RT	259.474
2	131+44.709, 21.600 RT	259.034
3	2131+58.735, 4.865 LT	259.459


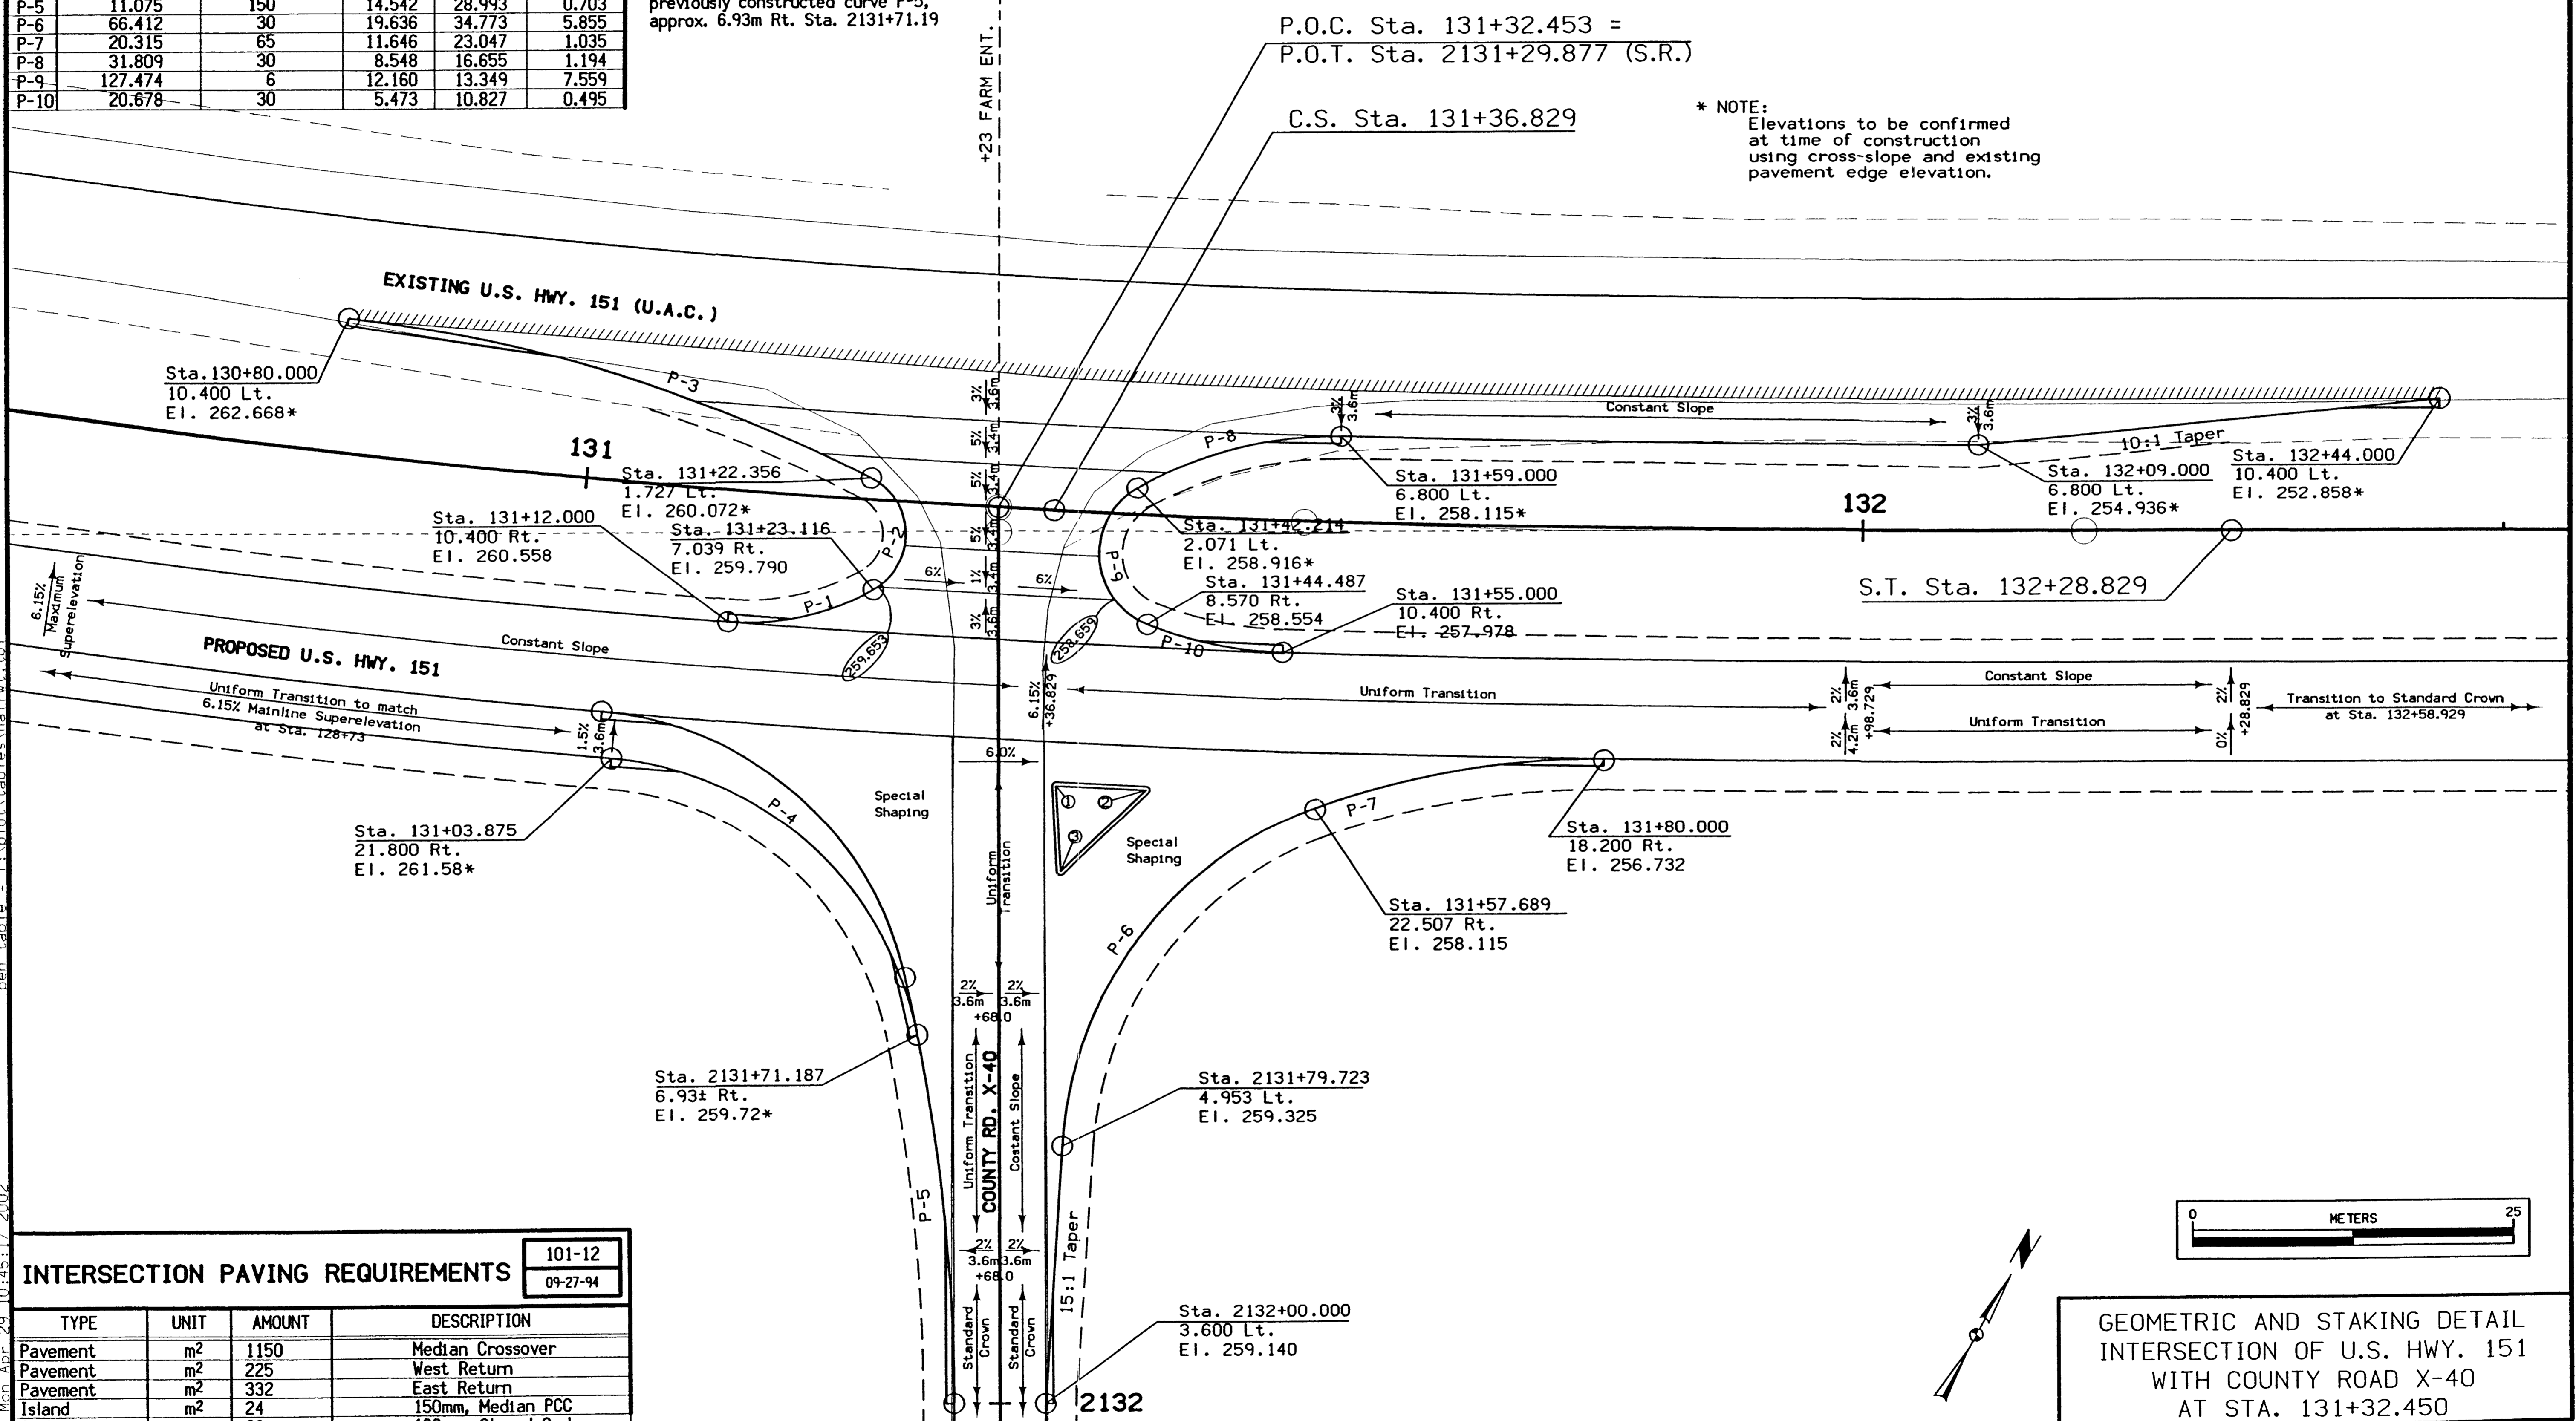


* NOTE:
Elevations to be confirmed at time of construction using cross-slope and existing pavement edge elevation.

INTERSECTION PAVING REQUIREMENTS

101-12
09-27-94


TYPE	UNIT	AMOUNT	DESCRIPTION
Pavement	m ²	1150	Median Crossover
Pavement	m ²	225	West Return
Pavement	m ²	332	East Return
Island	m ²	24	150mm, Median PCC
Curb	m	23	100mm, Sloped Curb

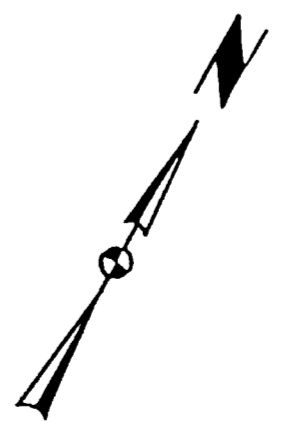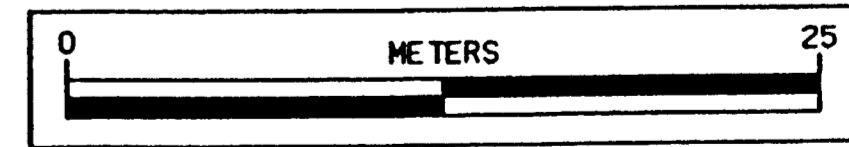

GEOMETRIC AND STAKING DETAIL
INTERSECTION OF U.S. HWY. 151
WITH COUNTY ROAD X-40
AT STA. 131+32.450


dgn = L:\WORK\PROJECT\39922\cadd\X40turn\X40L22.dgn
 prf = \\WAT501\DATA\PLT\COPY\EPV\X40L22.plt
 Date = Mon Apr 26 10:45:17 2002
 levels = 1-63
 pen table = I:\plot\tables\al.fwt.tb

dgn = L:\WORK\PROJECT\38922\cadd\40turn\40L23.dgn
 prf = \\WATSON\DATA\PLT\TYPER\40L23.prf
 date = Mon Apr 23 10:43:27 2002
 pen_table = I:\plot\tables\halfwt.tbl
 levels = 1-56,58-63

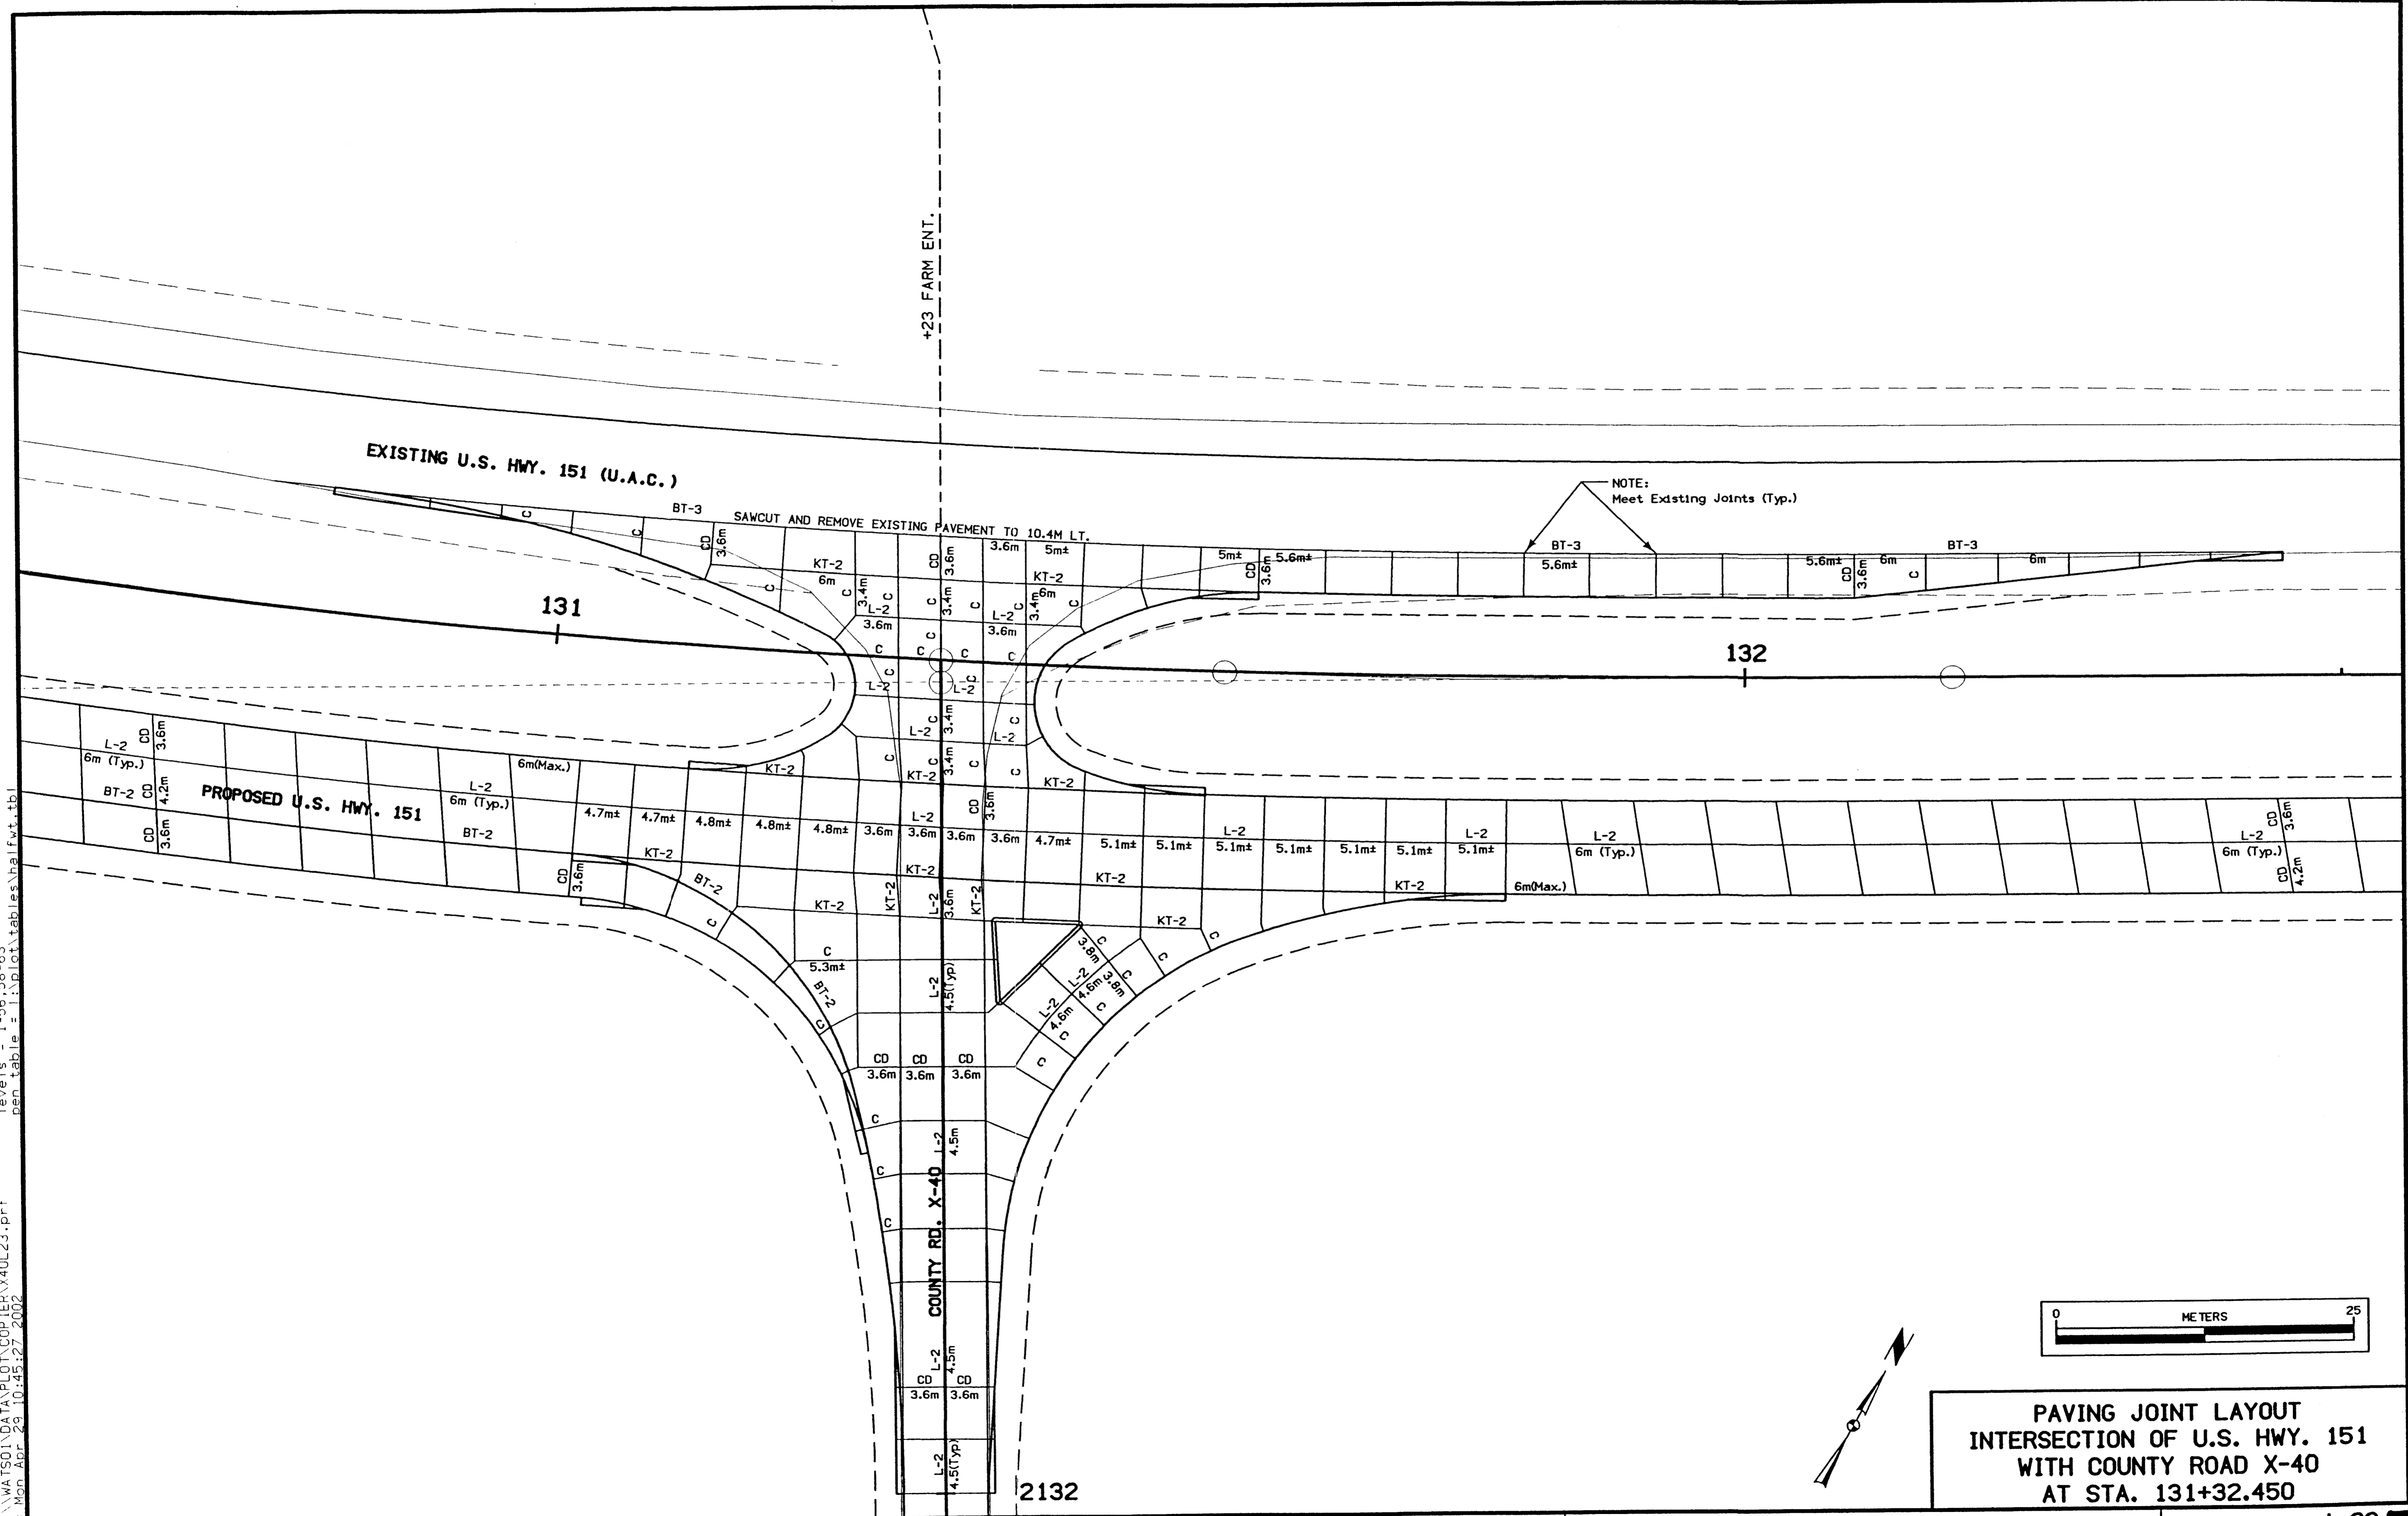

PAVING JOINT LAYOUT
 INTERSECTION OF U.S. HWY. 151
 WITH COUNTY ROAD X-40
 AT STA. 131+32.450

c:\work\PROJECT\39922\cadd\X40turn\X40L24.dgn levels = 1-20,22-63
 pcf = \\WATSO\DATA\DOT\COPYER\X40L24.prf pen table = 1\plot\tables\half.tbl
 Date = Mon Apr 29 10:45:35 2002

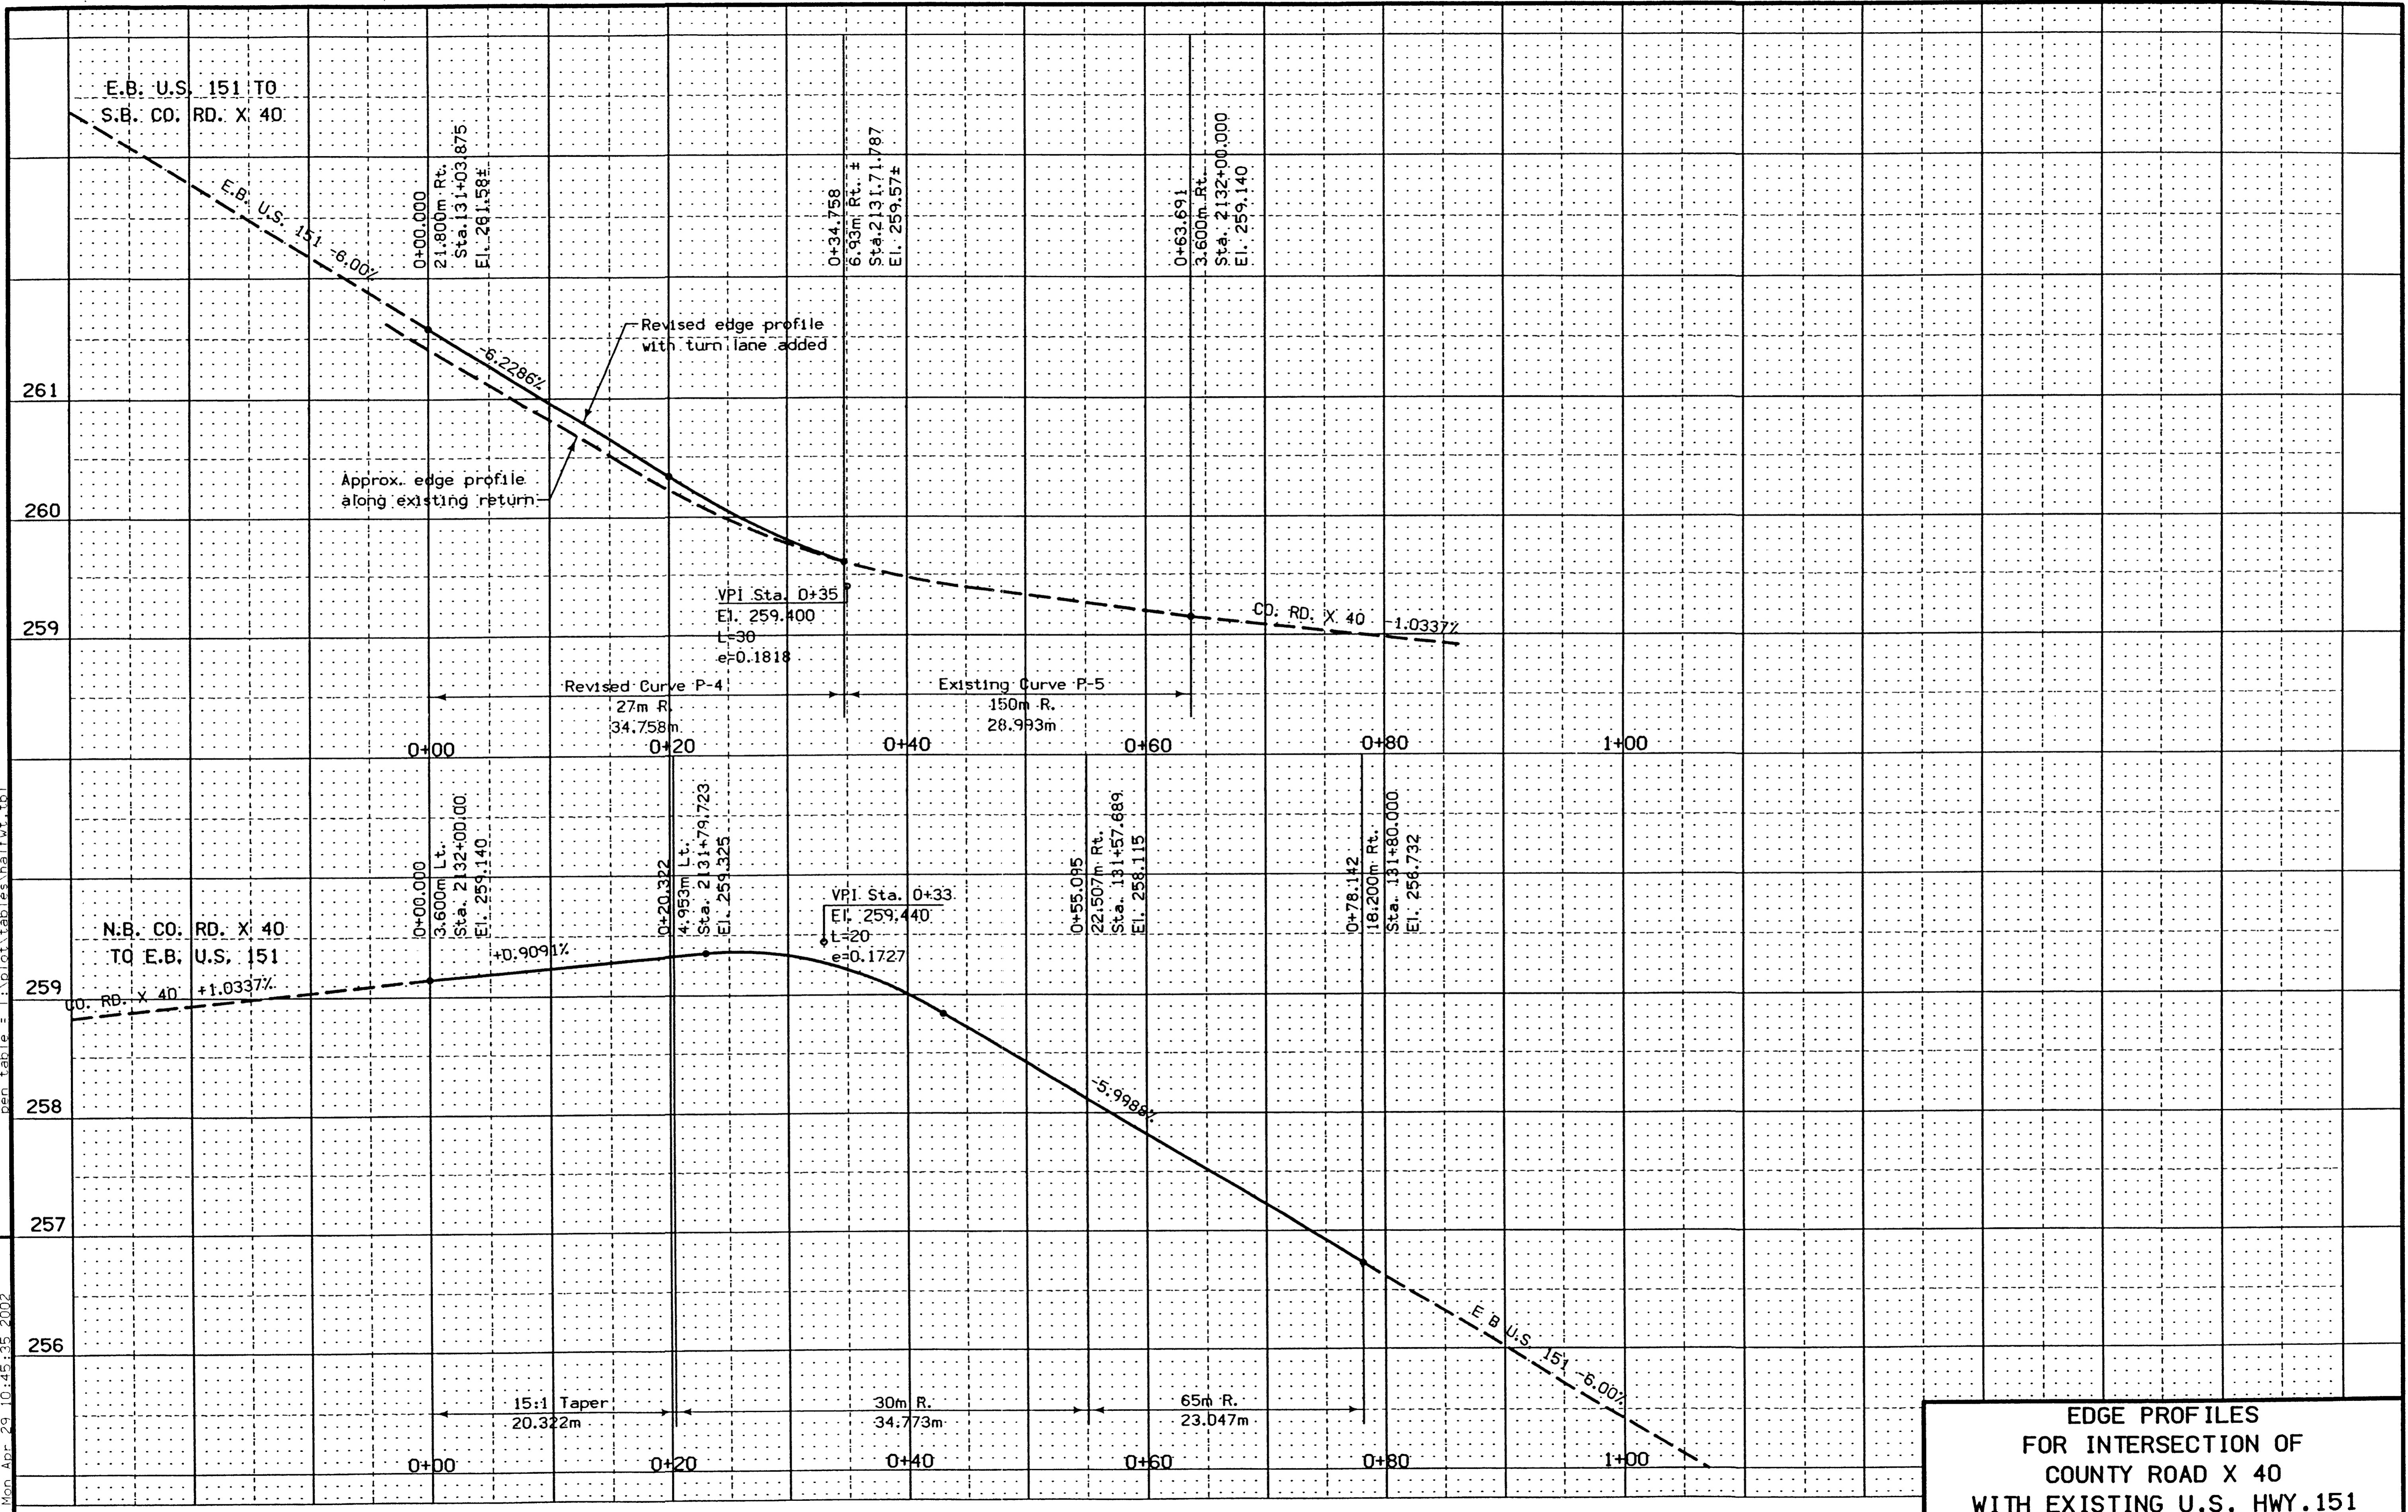


**EDGE PROFILES
 FOR INTERSECTION OF
 COUNTY ROAD X 40
 WITH EXISTING U.S. HWY. 151**

CIRCULAR CURVE DATA


101-10C
09-27-94

NO.	Δ	R	T	L	E
C-1	30.456	20	5.444	10.631	0.728
C-2	130.715	5	10.899	11.407	6.992
C-3	18.792	100	16.548	32.799	1.360
C-4	29.103	20	5.192	10.159	0.686
C-5	131.620	5	11.131	11.486	7.202
C-6	19.235	100	16.945	33.571	1.425

* NOTE:
Elevations to be confirmed
at time of construction
using cross-slope and existing
pavement edge elevation.

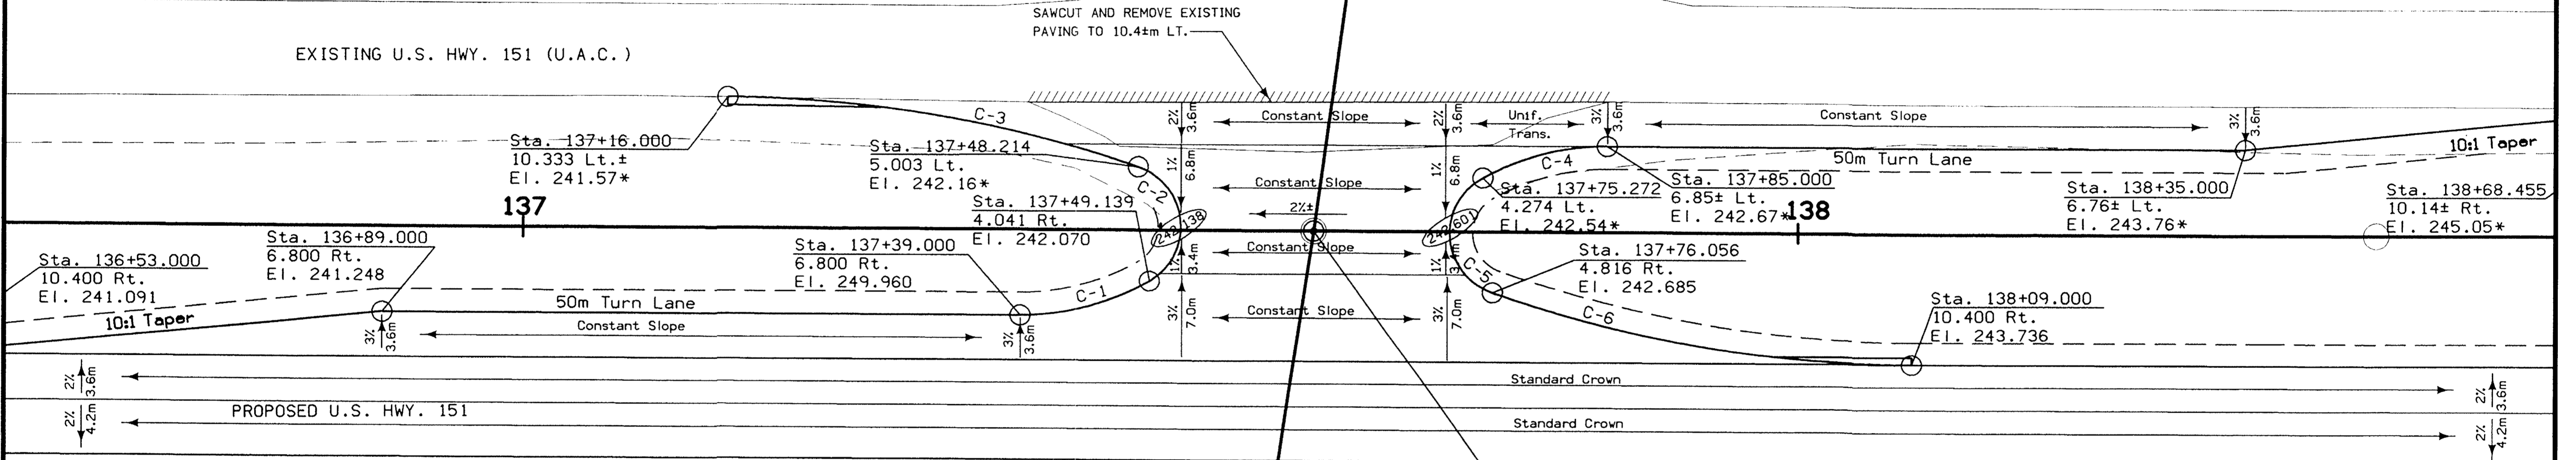

P.O.T. Sta. 137+59.527 O.R.
P.I. Sta. 3137+59.527 (S.R.)

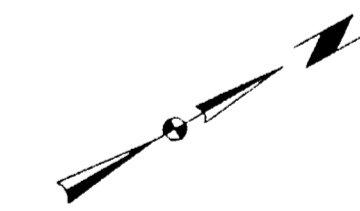


INTERSECTION PAVING REQUIREMENTS


101-12
09-27-94

TYPE	UNIT	AMOUNT	DESCRIPTION
Pavement	m ²	1210	Median Crossover
Island	m ²		
Curb	m		

GEOMETRIC AND STAKING DETAIL
FOR INTERSECTION OF
U.S. HWY. 151 WITH SHAW RD.

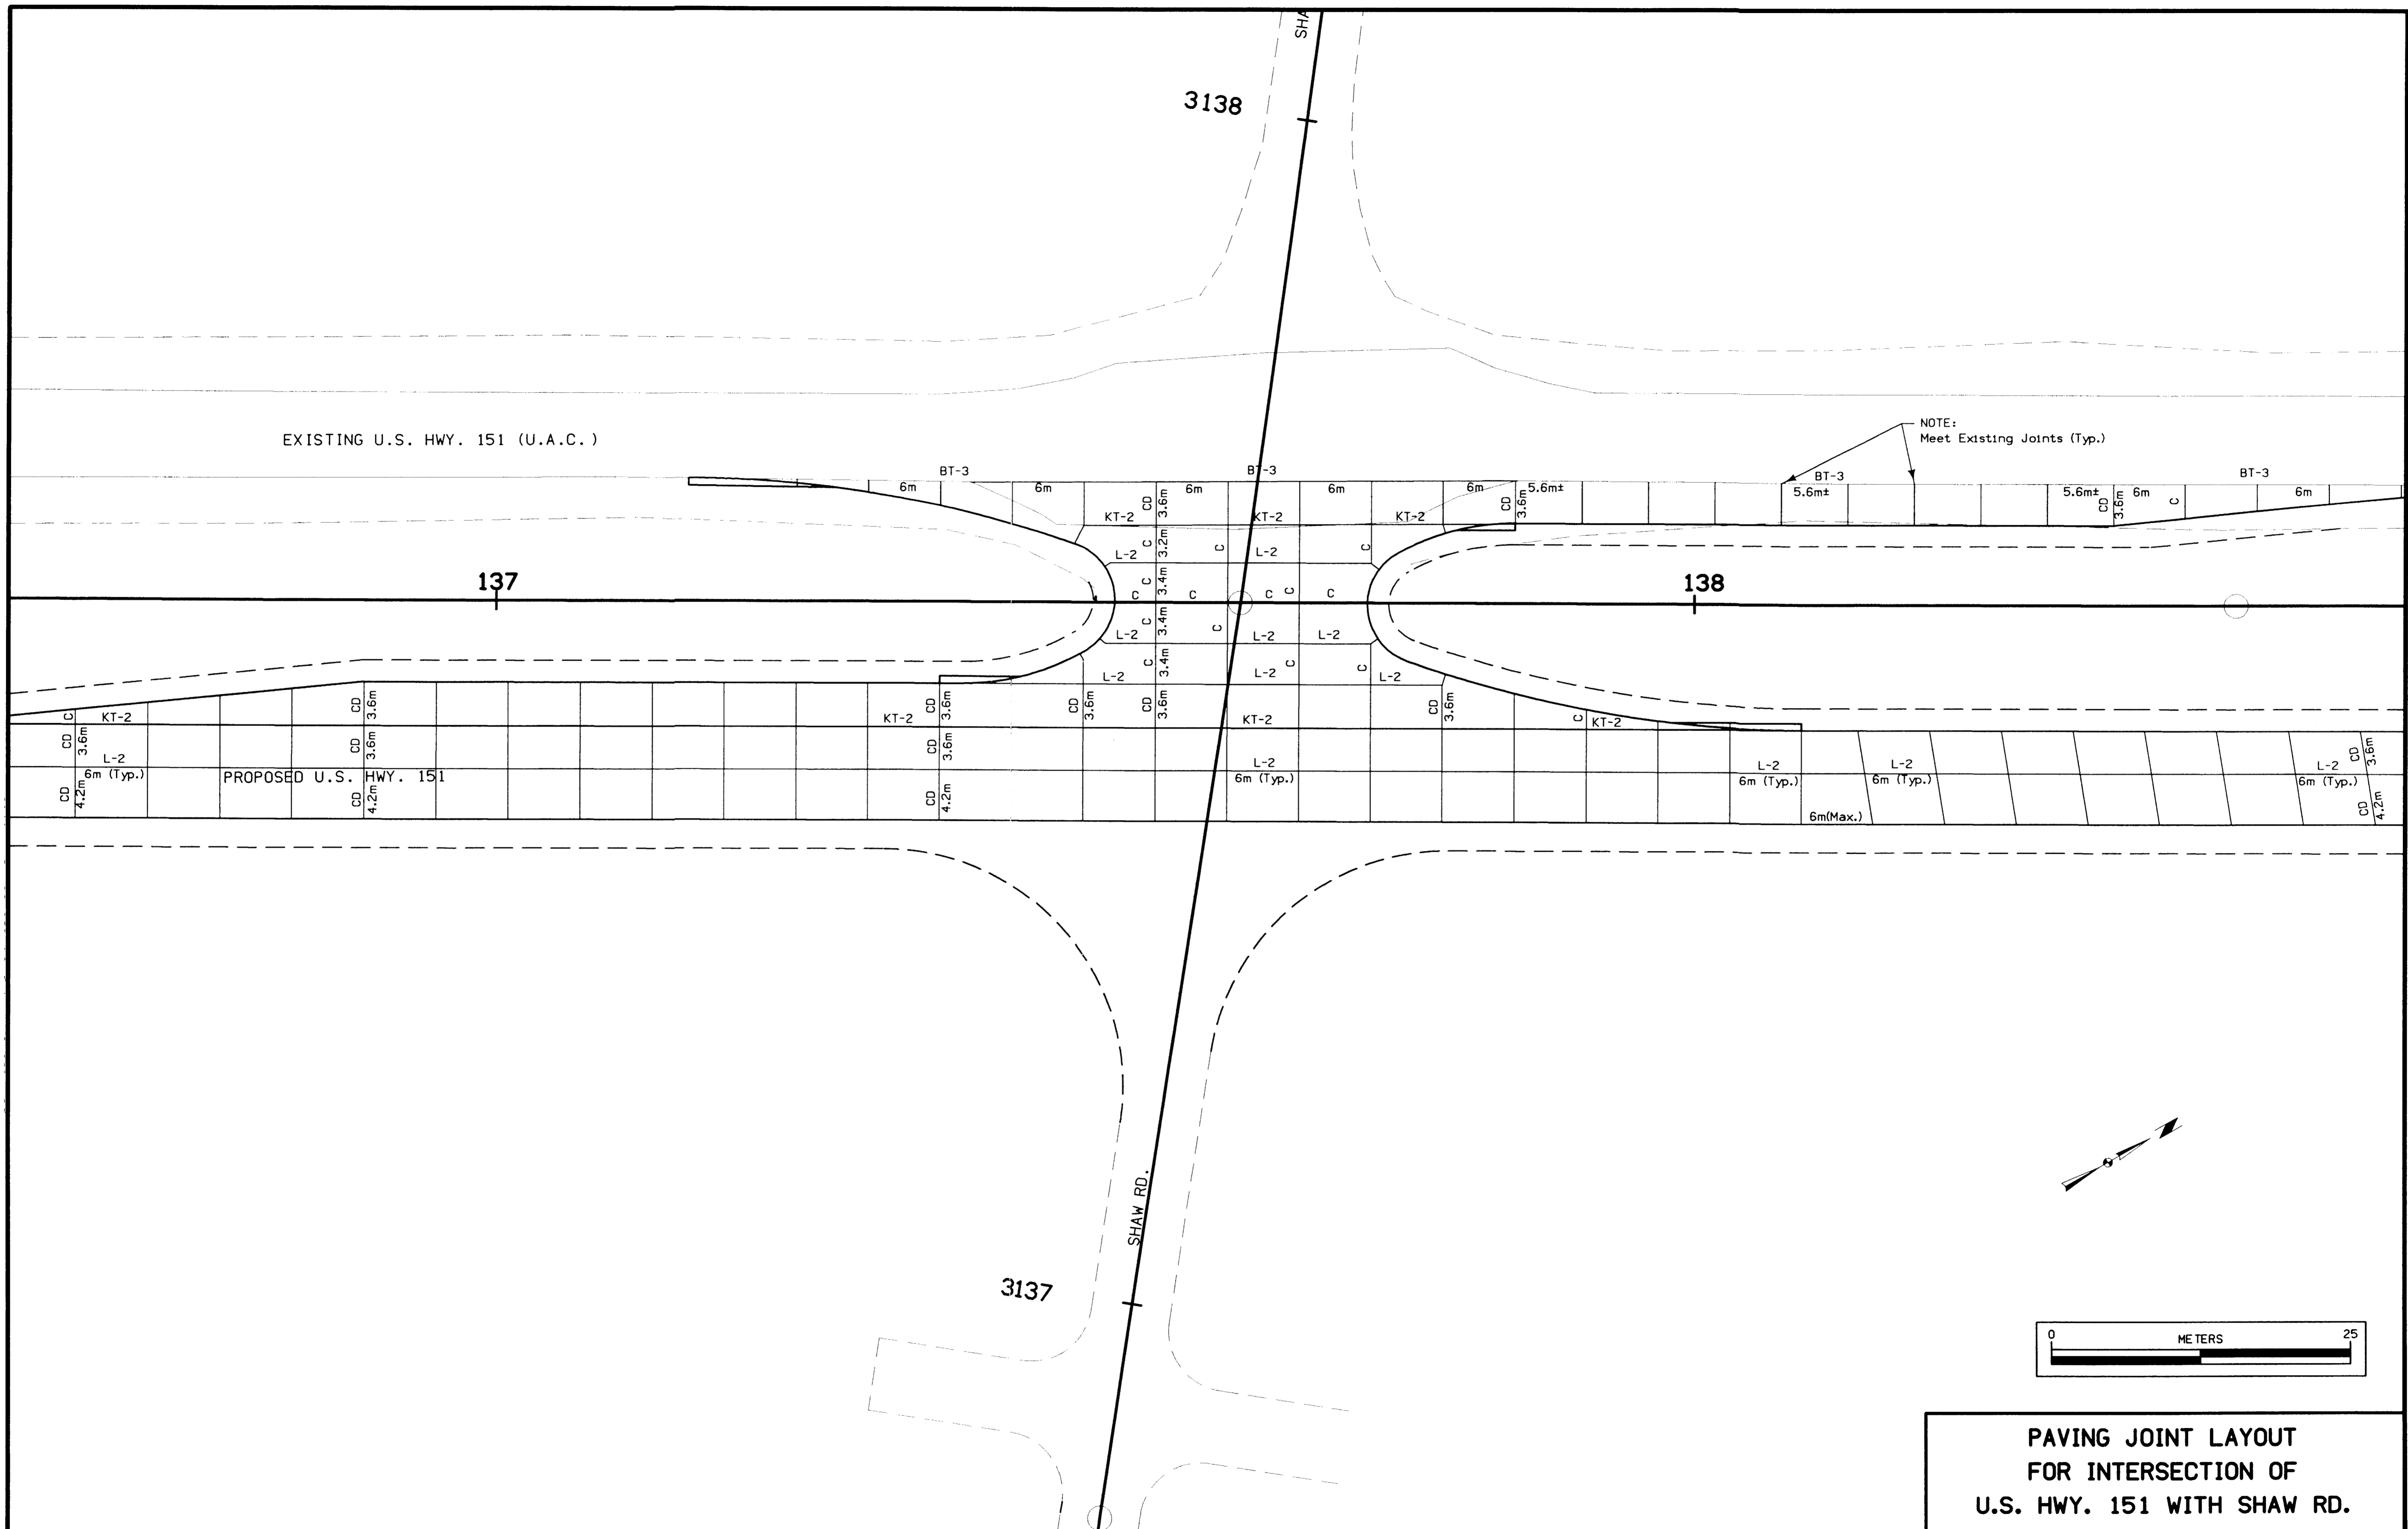

PAVING JOINT LAYOUT
FOR INTERSECTION OF
U.S. HWY. 151 WITH SHAW RD.

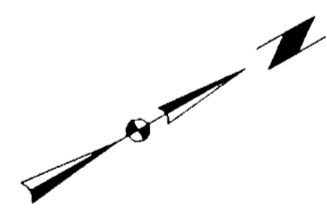

CIRCULAR CURVE DATA

101-10C
09-27-94


NO.	Δ	R	T	L	E
D-1	33.614	28	8.457	16.427	1.249
D-2	132.399	5	11.336	11.554	7.390
D-3	16.162	130	18.458	36.670	1.304
D-4	68.251	25	16.942	29.780	5.200
D-5	15.875	60	8.366	16.624	0.580
D-6	18.350	50	8.076	16.013	0.648
D-7	65.619	22	14.183	25.196	4.176
D-8	15.810	120	16.662	33.112	1.151
D-9	49.214	20	9.160	17.179	1.998
D-10	95.008	5	5.457	8.291	2.401
D-11	22.744	25	5.028	9.924	0.501

ISLAND DATA

101-13
09-27-94

POINT NO.	LOCATION	ELEVATION
1	1173+41.406, 4.530 Lt.	264.470
2	1173+45.101, 4.849 Lt.	264.580
3	1173+41.351, 8.739 Lt.	264.290

Refer to sheets L.32 through L.35 for geometric details of left and right turn lanes on Southbound U.S. Hwy. 151 at 130th Street.

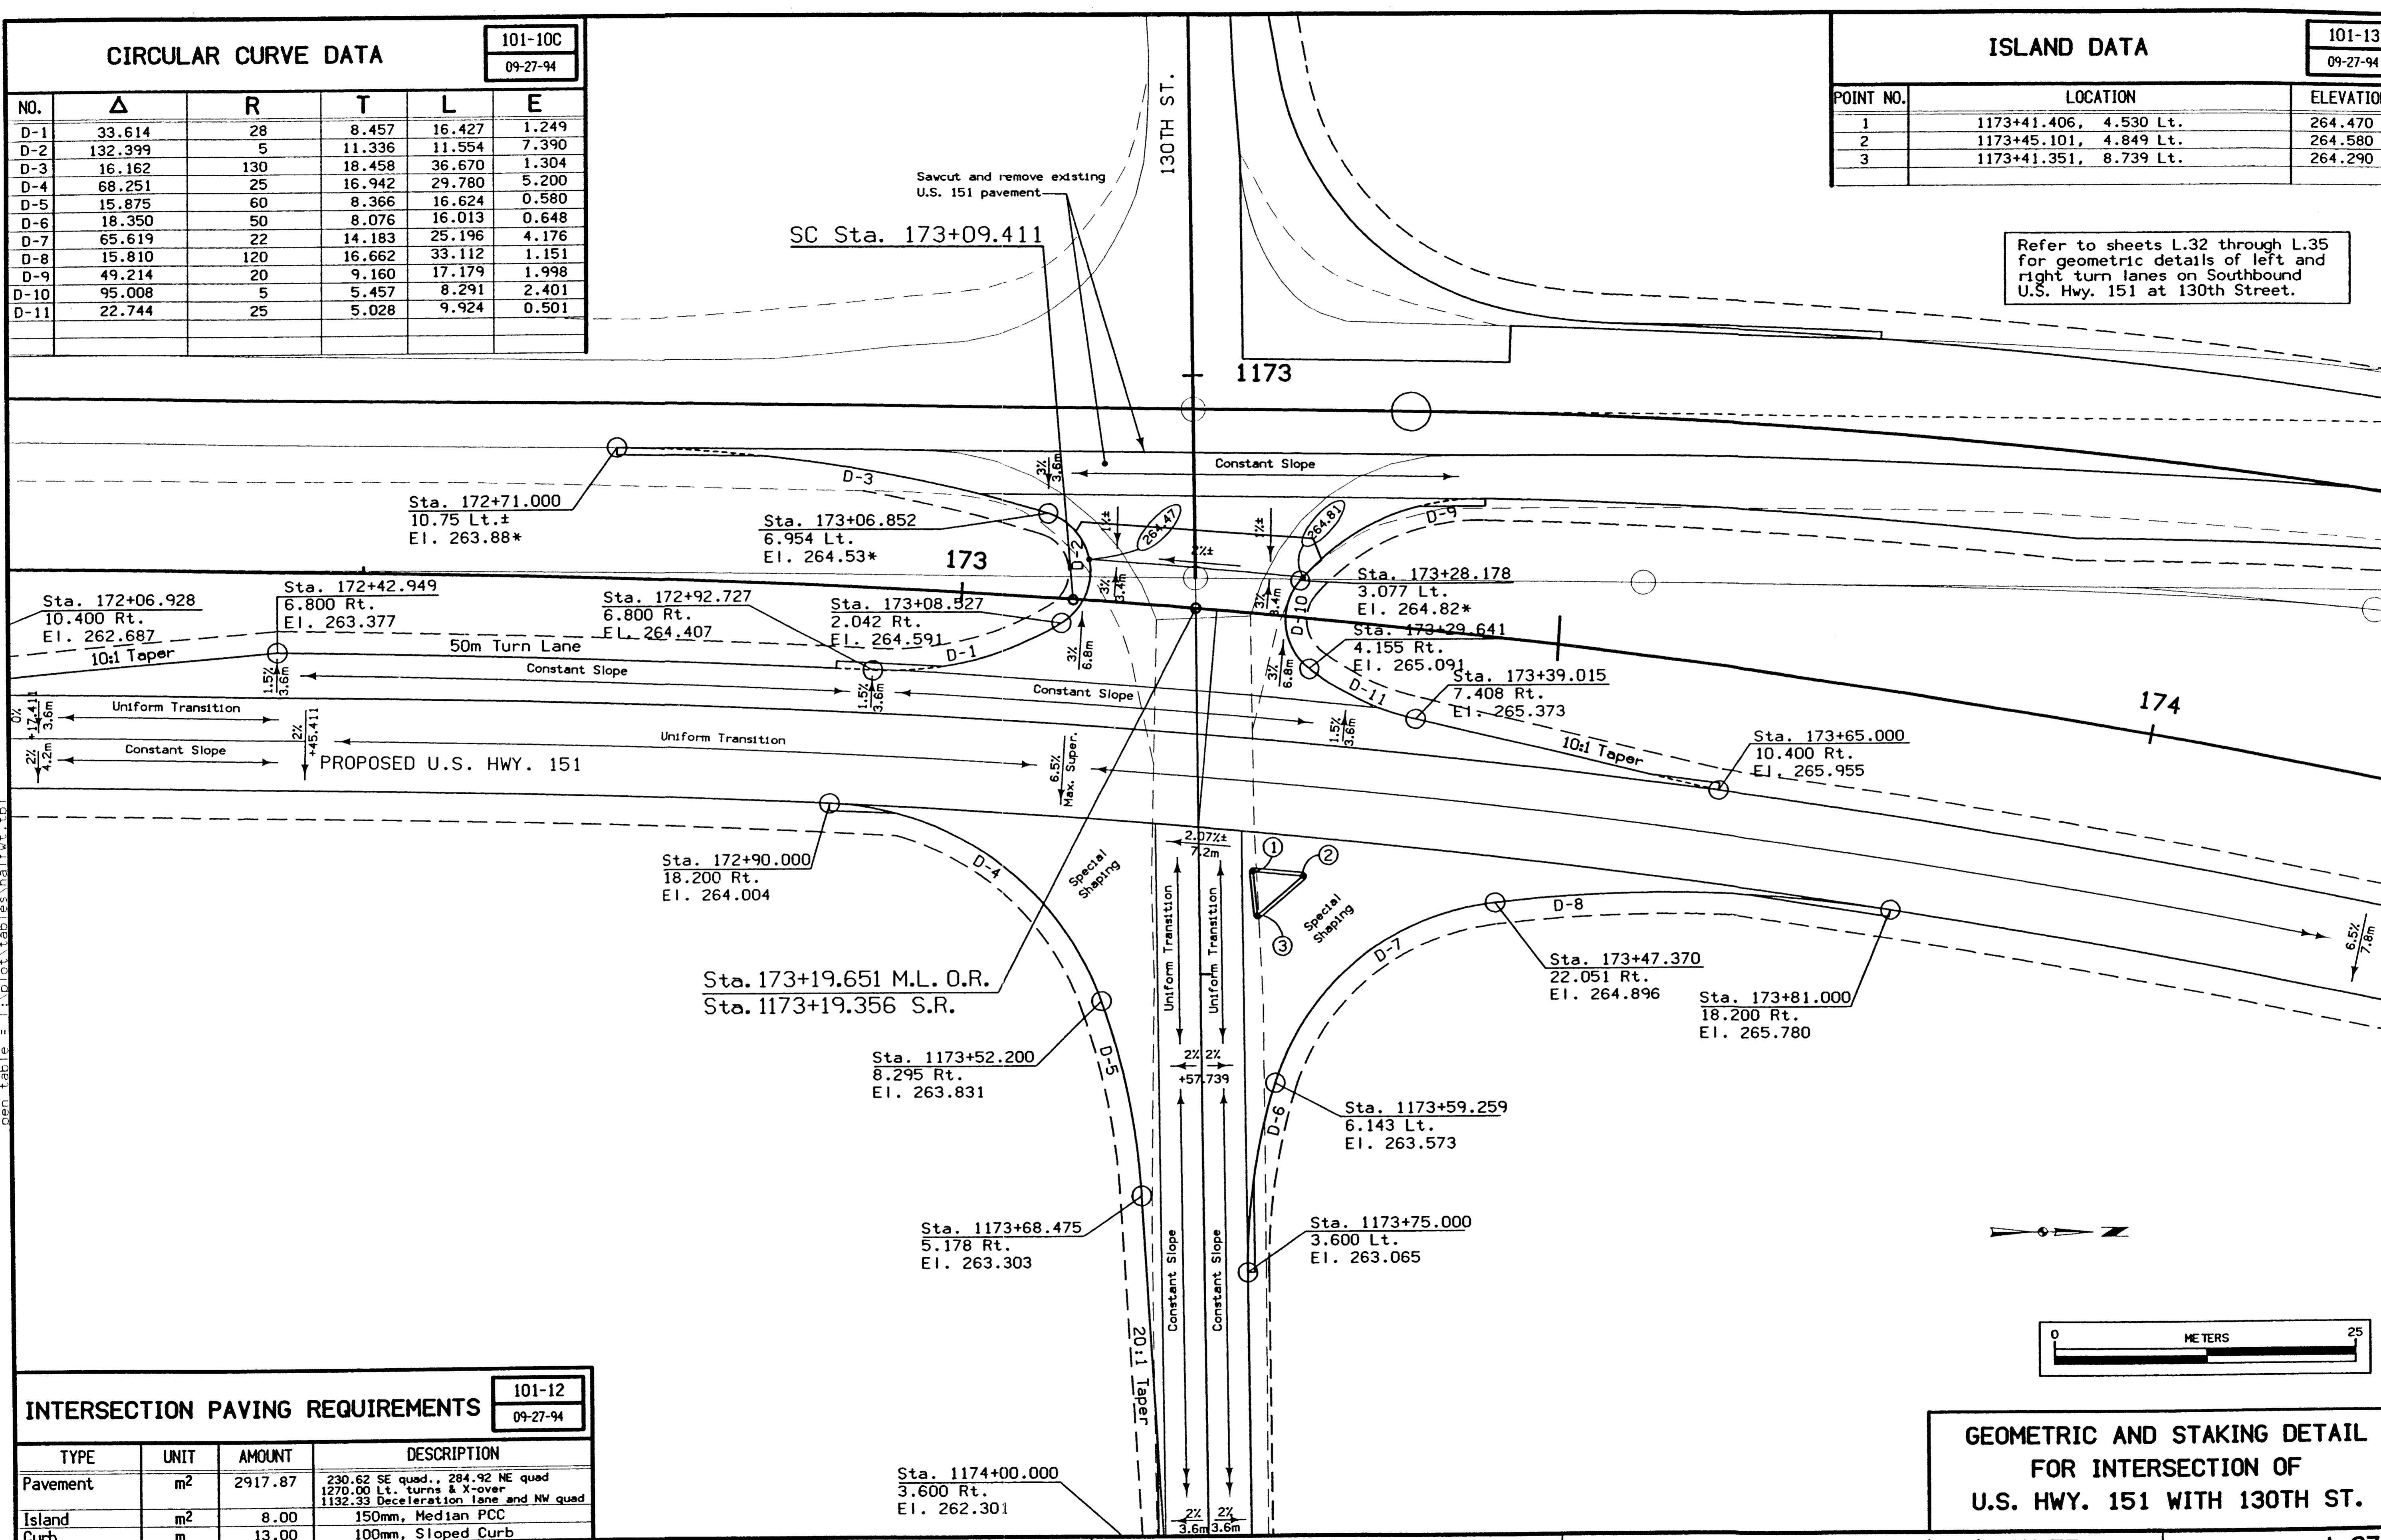

INTERSECTION PAVING REQUIREMENTS

101-12
09-27-94

TYPE	UNIT	AMOUNT	DESCRIPTION
Pavement	m ²	2917.87	230.62 SE quad., 284.92 NE quad 1270.00 Lt. turns & X-over 1132.33 Deceleration lane and NW quad
Island	m ²	8.00	150mm, Median PCC
Curb	m	13.00	100mm, Sloped Curb

**GEOMETRIC AND STAKING DETAIL
FOR INTERSECTION OF
U.S. HWY. 151 WITH 130TH ST.**

DESIGN TEAM **Skogerboe** / EARTH SYSTEMS

METRIC IOWA DOT * OFFICE OF ROAD DESIGN

Linn/Jones

COUNTY PROJECT NUMBER

NHSX-151-3(112)--3H-57

SHEET NUMBER **L.27**

Revised 04/08/02

133-198

dgn = I:\WORK\project\39922\cadd\anacurve\PAVE\57151112.i27
 levels = 1-63
 open table = I:\plot\tables\haffwt.tbl
 date = Mon Apr 8 13:06:44 2002 prf = \\WATS01\DATA\LOT\COPIER\L27.prf

SC Sta. 173+09.411

Refer to sheets L.32 through L.35 for geometric details of left and right turn lanes on Southbound U.S. Hwy. 151 at 130th Street.

130TH ST.



1173

173

174


PROPOSED U.S. HWY. 151

Sta. 173+19.651 M.L. O.R.
Sta. 1173+19.356 S.R.

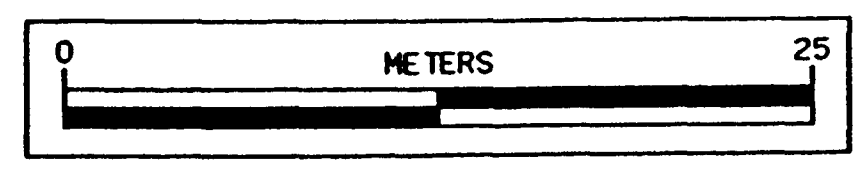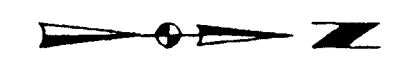

PAVING JOINT LAYOUT FOR INTERSECTION OF U.S. HWY. 151 WITH 130TH ST.

dgn = I:\WORK\project\39922\cadd\anacurve\PAVE\57151\12\128
level = 1-63
pen table = I:\plot\tables\halfwt.tbl

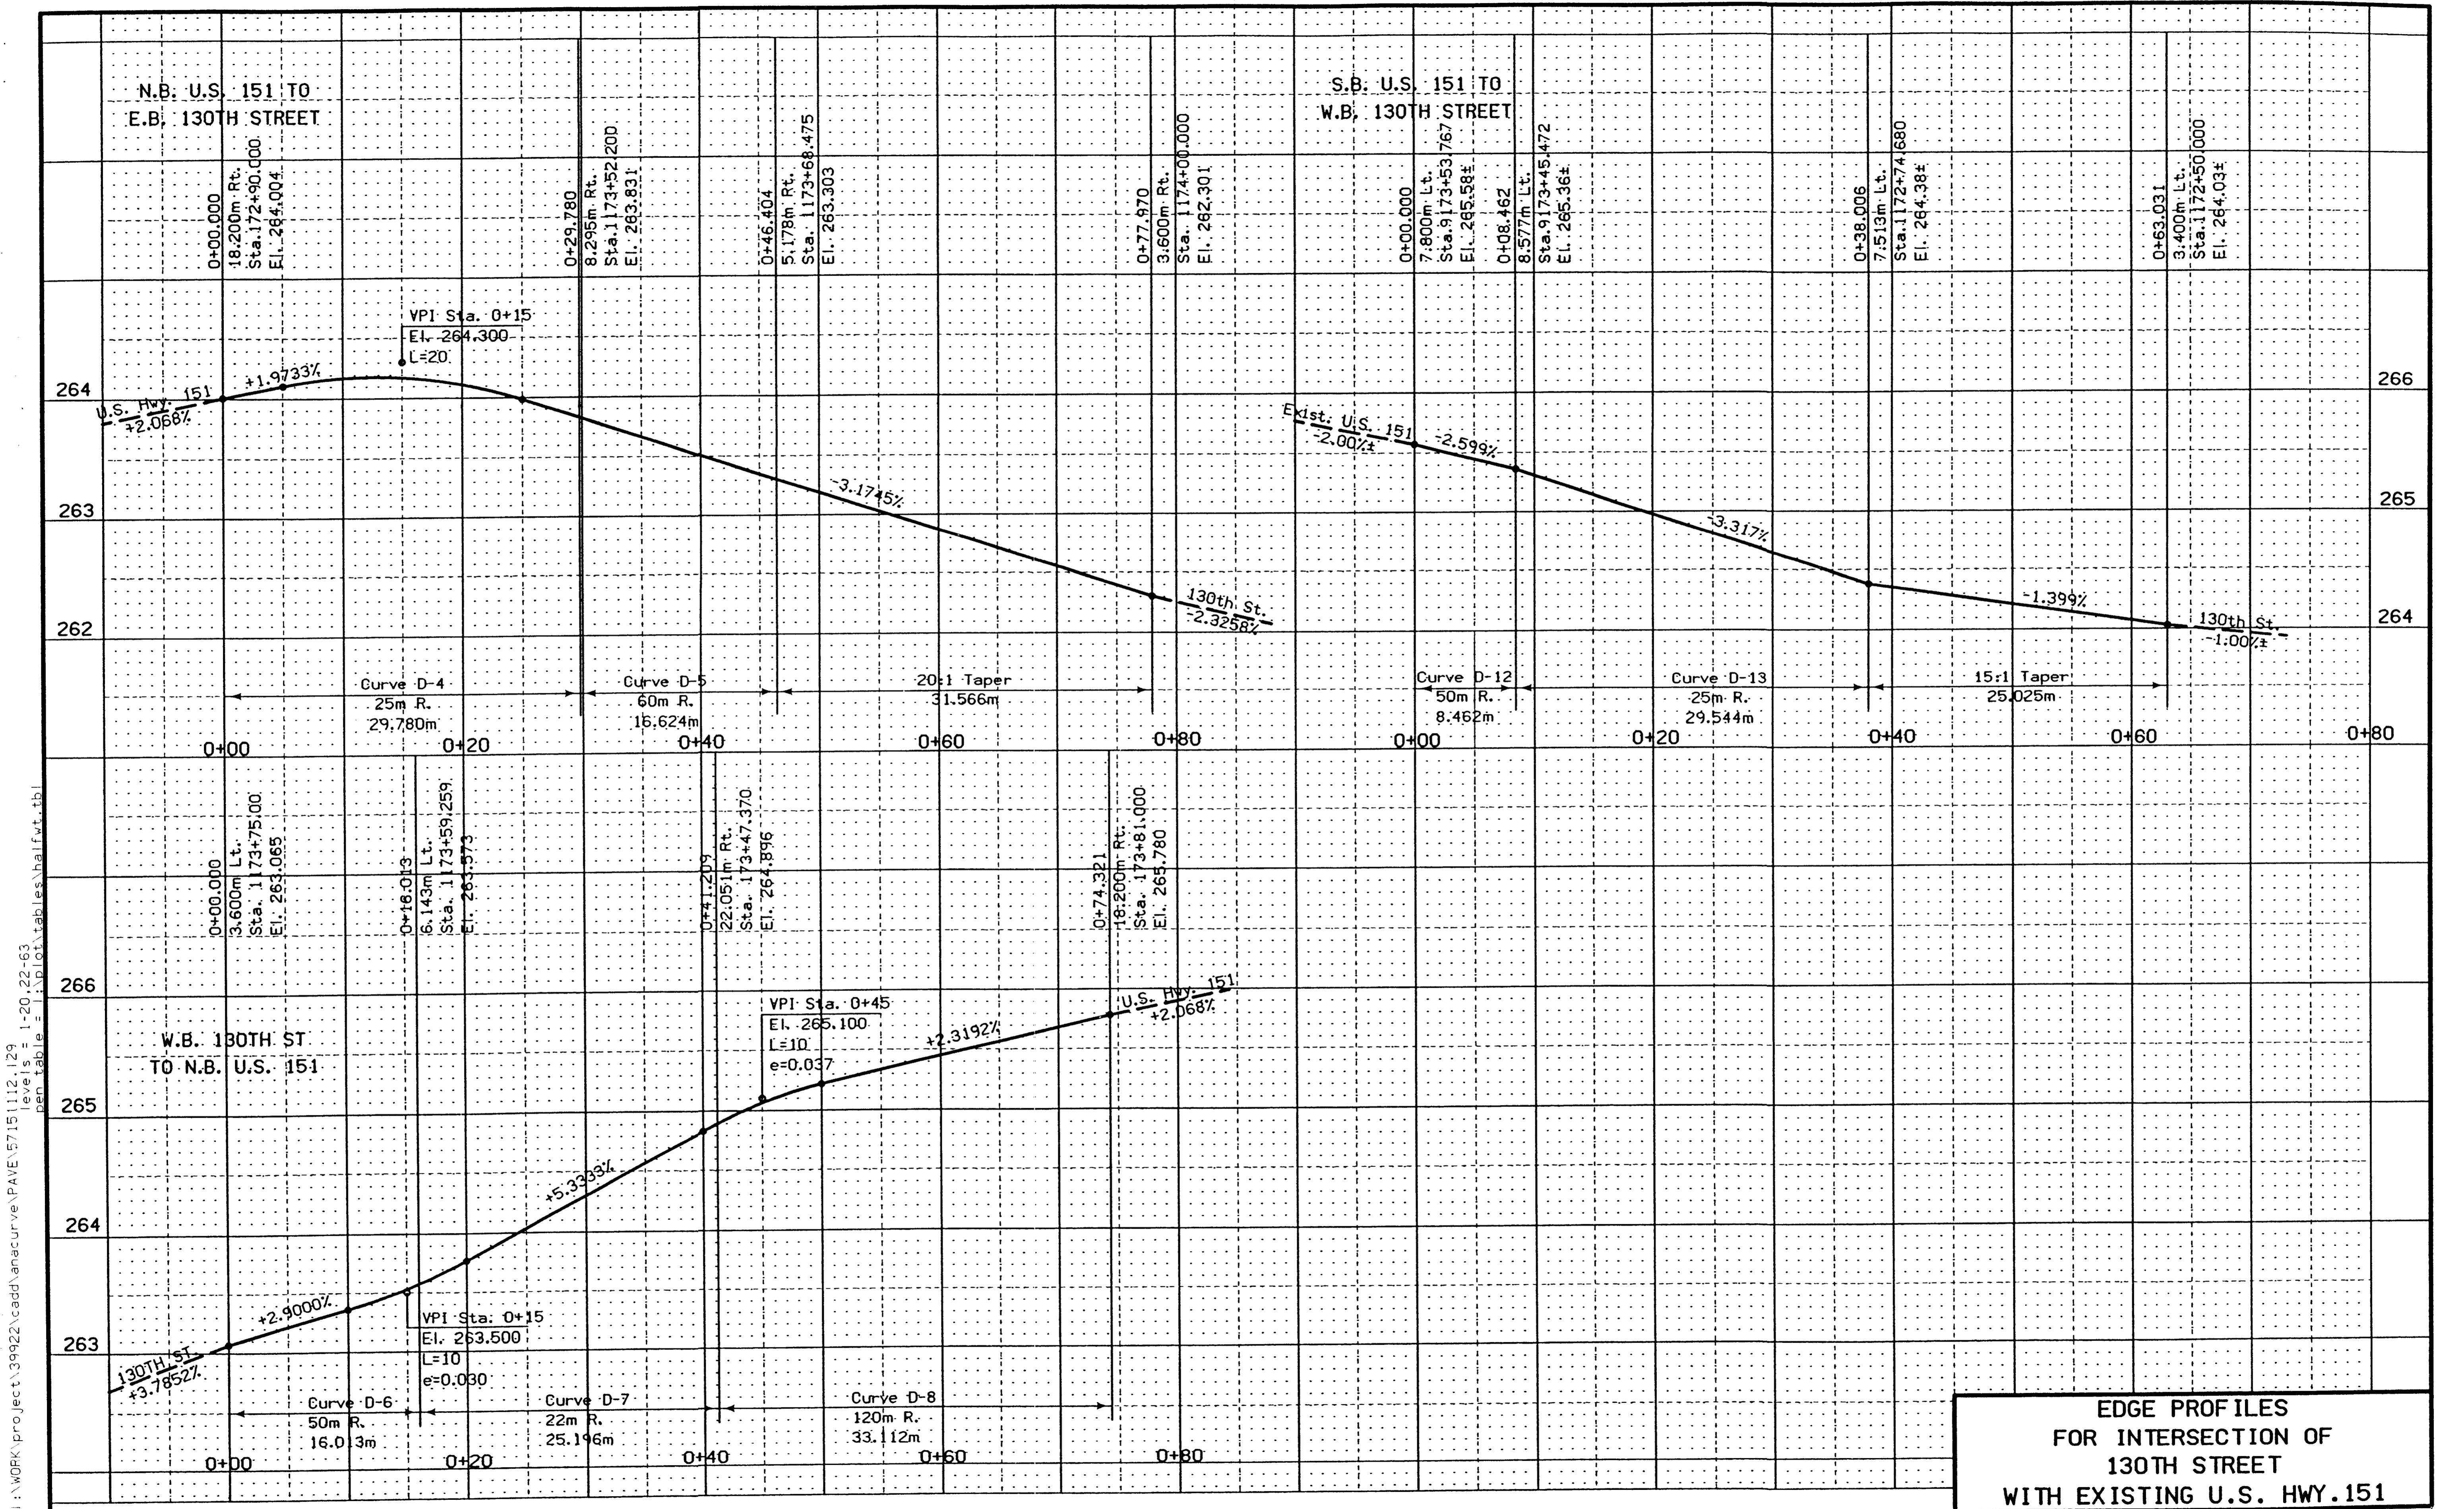


**EDGE PROFILES
FOR INTERSECTION OF
130TH STREET
WITH EXISTING U.S. HWY. 151**

dgn = I:\WORK\project\39922\cadd\anacurve\PAVE\5715\1112.129
 levels = 1-20,22-63
 pen table = I:\plot\tables\halfwt.tbl

CIRCULAR CURVE DATA

101-10C
09-27-94

NO.	Δ	R	T	L	E
E-1	45.925	20	8.474	16.031	1.721
E-2	114.190	5	7.727	9.965	4.204
E-3	19.846	50	8.747	17.319	0.759
E-4	43.530	20	7.985	15.195	1.535
E-5	101.093	5	6.075	8.822	2.868
E-6	29.631	25	6.613	12.929	0.860

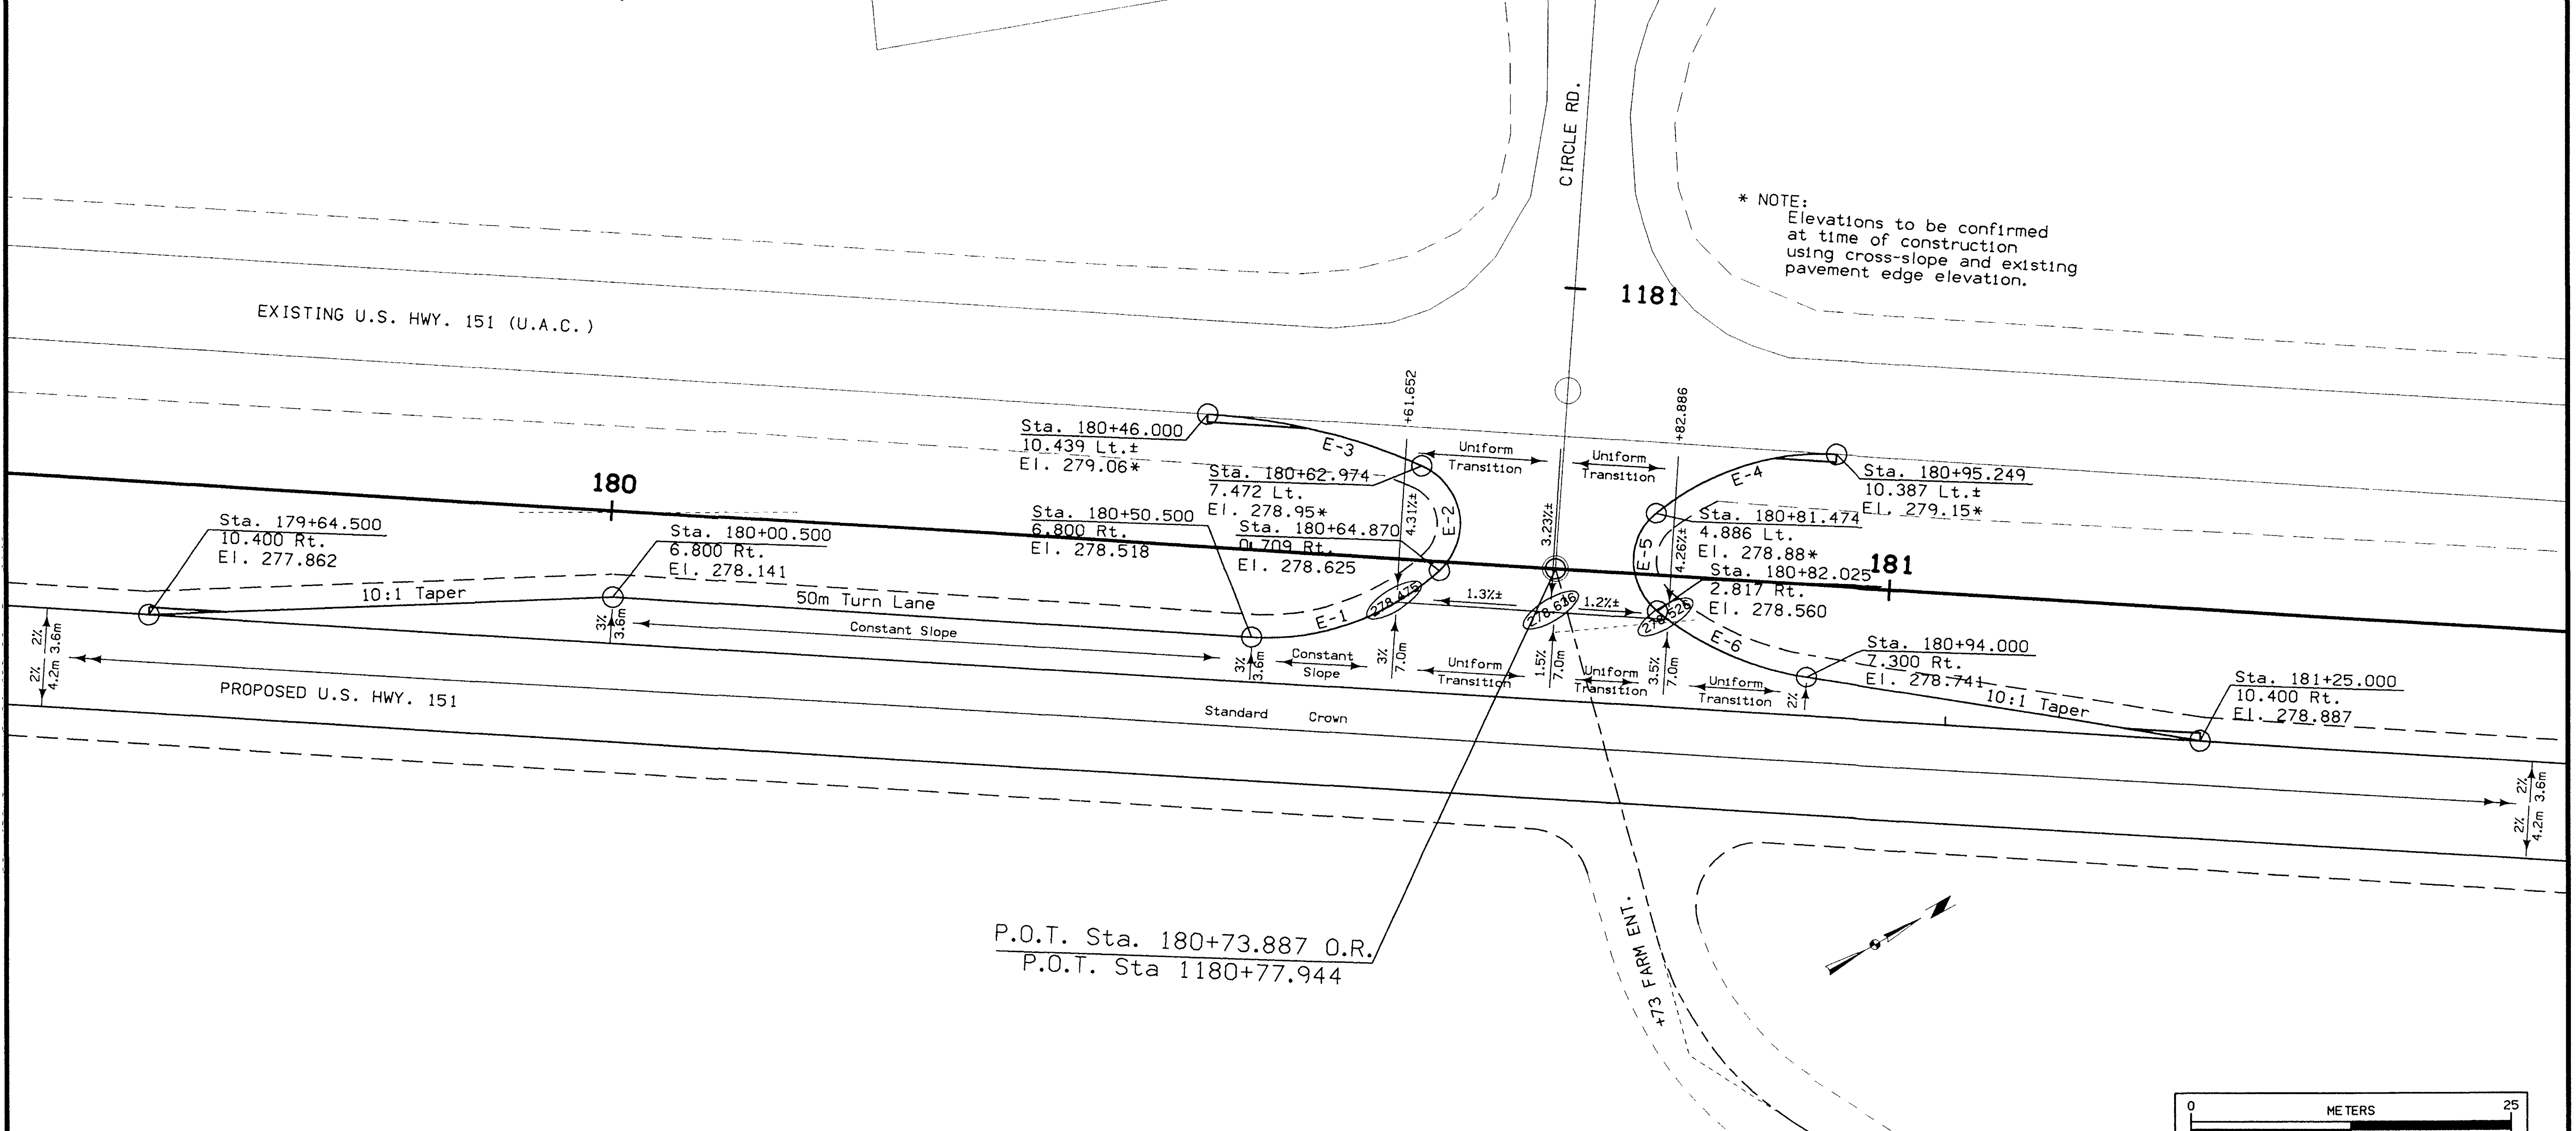


INTERSECTION PAVING REQUIREMENTS

101-12
09-27-94

TYPE	UNIT	AMOUNT	DESCRIPTION
Pavement	m ²	820	Median Crossover
Island	m ²		
Curb	m		

GEOMETRIC AND STAKING DETAIL
FOR INTERSECTION OF
U.S. HWY. 151 WITH CIRCLE RD.

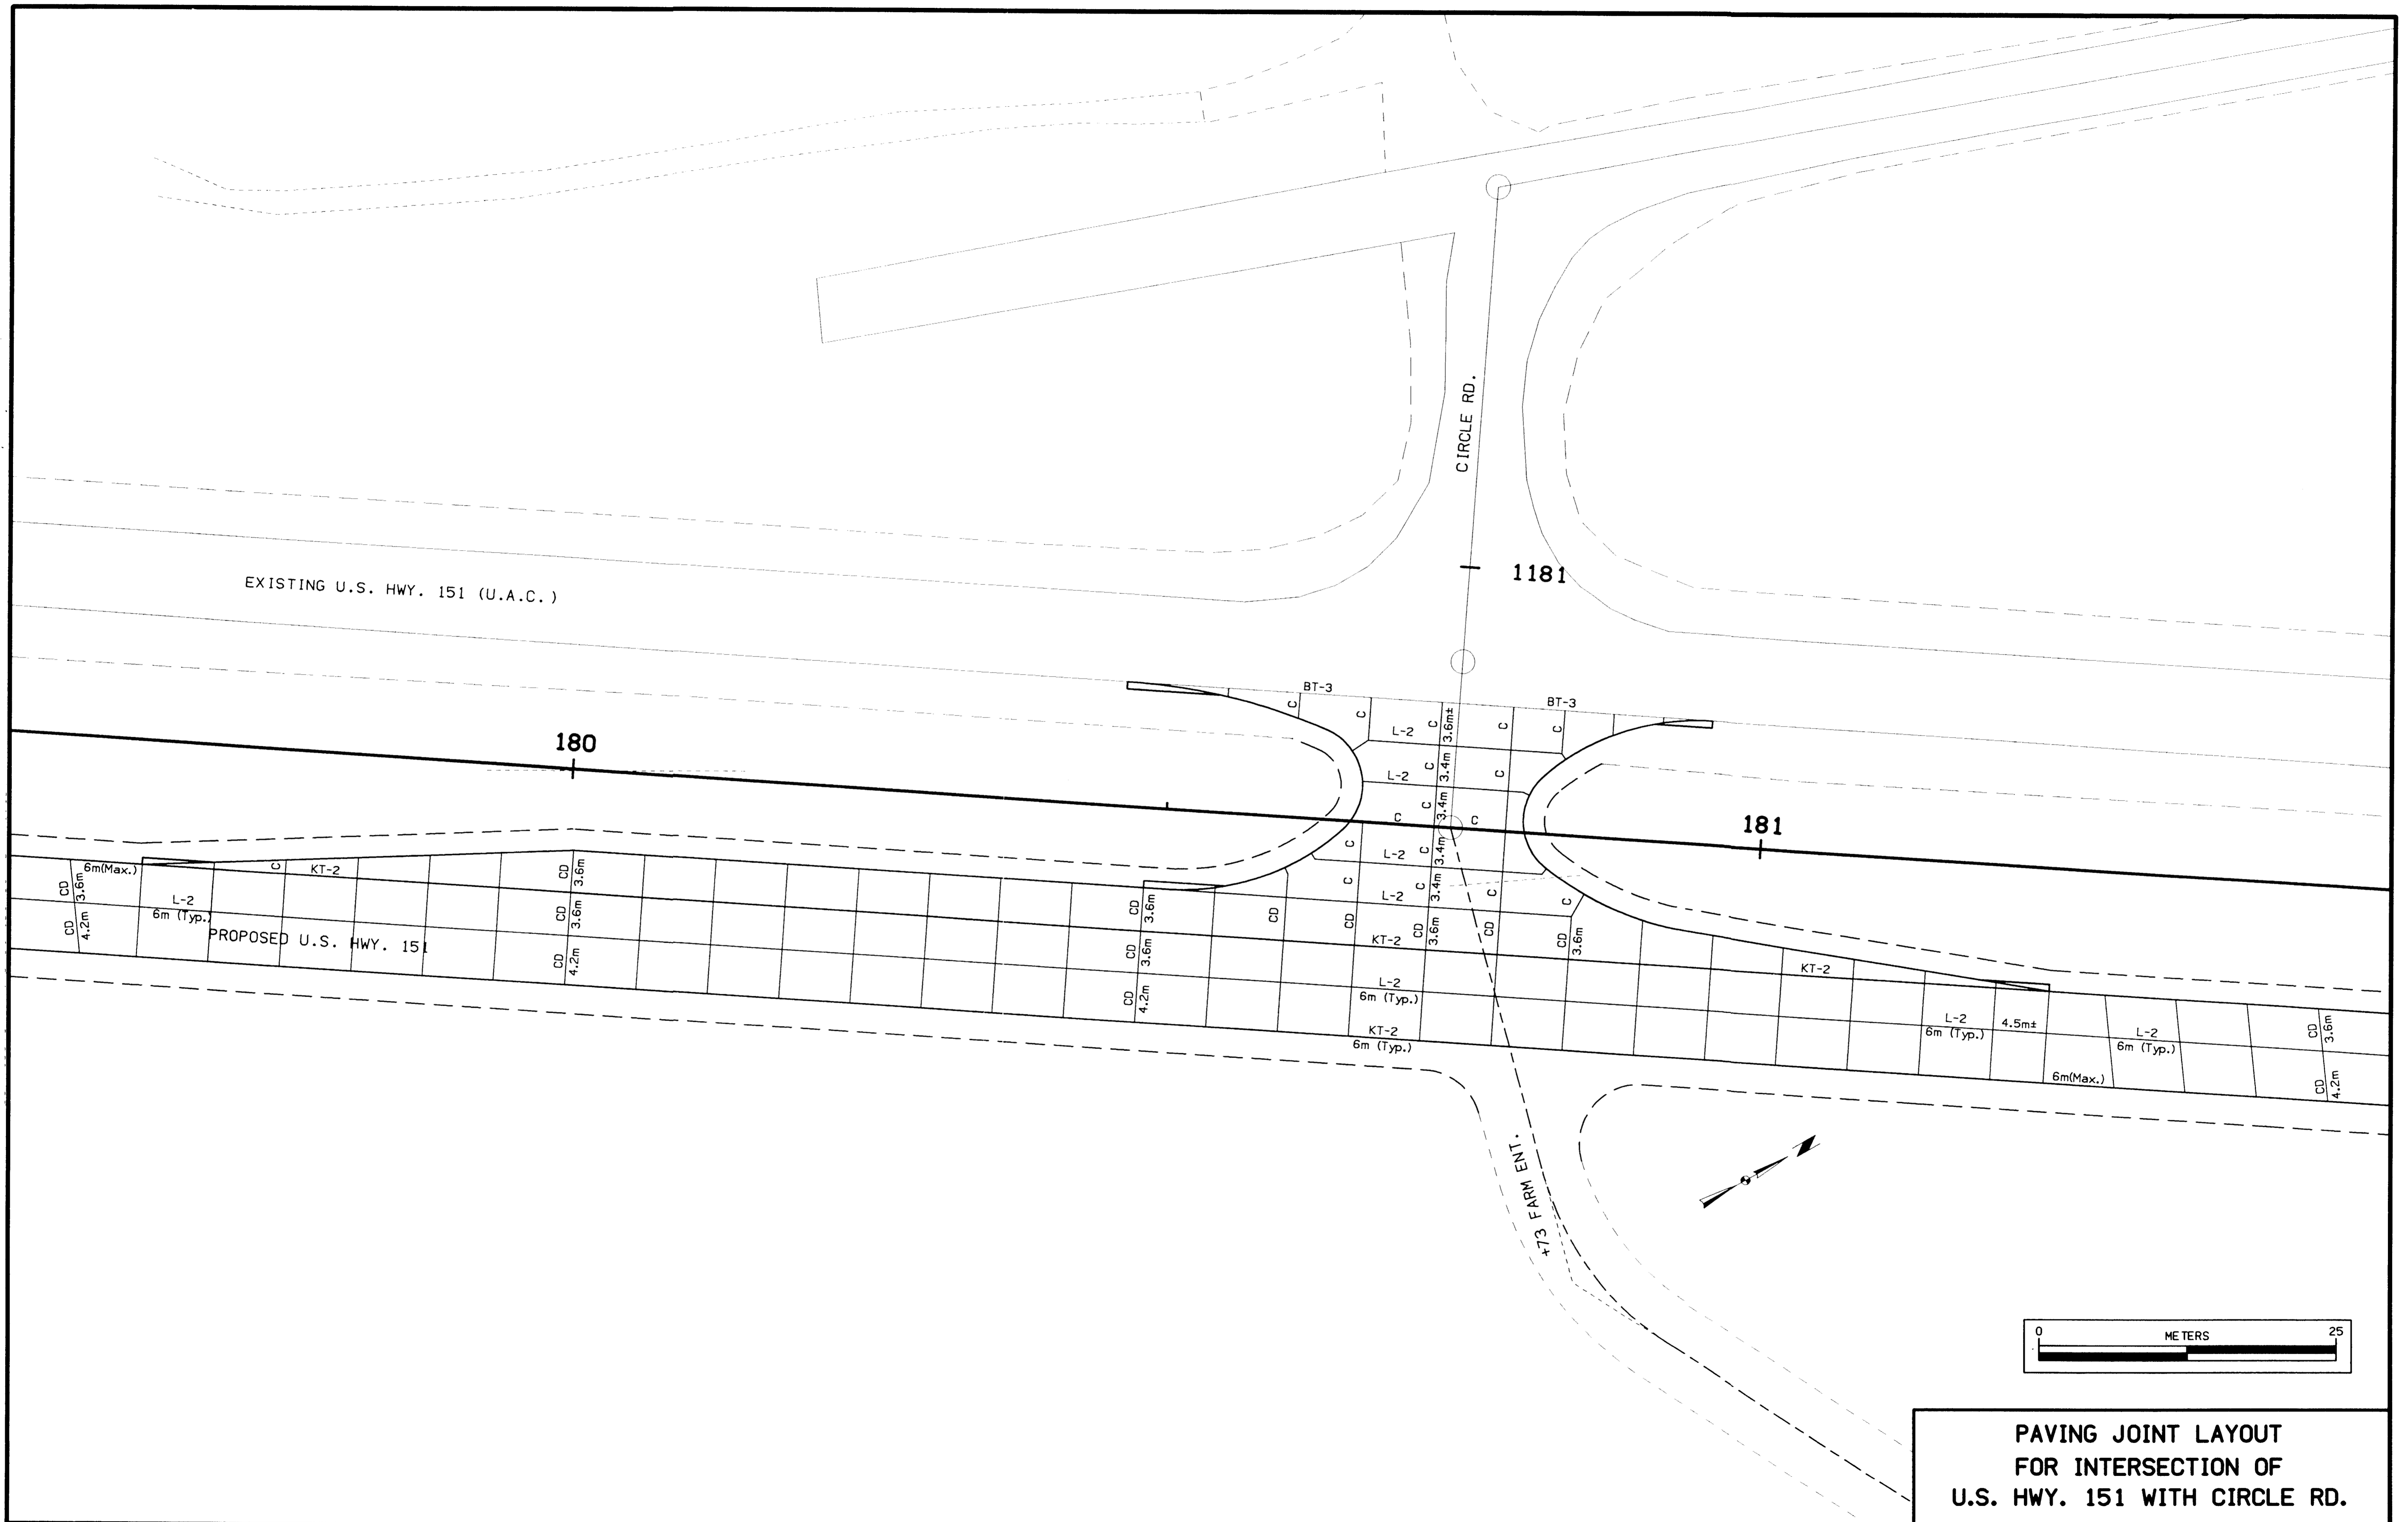

EXISTING U.S. HWY. 151 (U.A.C.)

CIRCLE RD.


1181

180

181

PROPOSED U.S. HWY. 151

473 FARM RD.

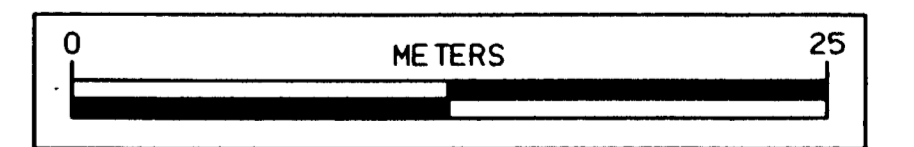

PAVING JOINT LAYOUT
FOR INTERSECTION OF
U.S. HWY. 151 WITH CIRCLE RD.

CIRCULAR CURVE DATA

101-10C
09-27-94

NO.	Δ	R	T	L	E
D-9	49.687	20	9.260	17.344	2.040
D-12	9.697	50	4.241	8.462	0.180
D-13	67.710	25	16.771	29.544	5.104

STAGING NOTES

108-26
09-27-94

Stage 1 - Construct Pavement Widening on US 151 SB lanes

Traffic Control as per RS-638
US 151 traffic to be maintained at all times.
Median crossover to be completed in halves, under traffic.

Grade pavement widening Sta 9173+44 to 9176+56
Remove existing median crossover pavement.
Grade median crossover at 130th Street

Mill 75mm of existing HMA Pavement right of relocation centerline from Sta 9173+44 to 9176+56

Pave PCC pavement for widening to match top of existing pavement.
Pave PCC pavement for median crossover to match existing pavement (without milling)

Pave 75mm HMA overlay right of relocation centerline from 9173+44 to 9176+56.
(Overlay both new and existing pavement)

Place granular shoulder, paint pavement markings

Stage 2 - Construct Right Turn Lane on US 151 SB Lanes

Traffic Control as per RS-63A
US 151 traffic to be maintained at all times.
Traffic on new pavement, right of relocation centerline.
130th Street North of US 151 shall remain open during construction.

Sawcut and remove pavement

Grade right turn lane from 9173+20 to 9173+45
Grade intersection return at 130th Street


Mill 75mm existing HMA pavement left of relocation centerline from Sta 9173+44 to 9176+56

Pave PCC pavement for widening and intersection return to match top of milled existing HMA pavement.

Pave variable depth HMA leveling course for right turn lane from 9173+45 to 9174+50.

Pave 75mm HMA overlay left of relocation centerline.
(Overlay both new and existing pavement)

Place granular shoulder, paint pavement markings

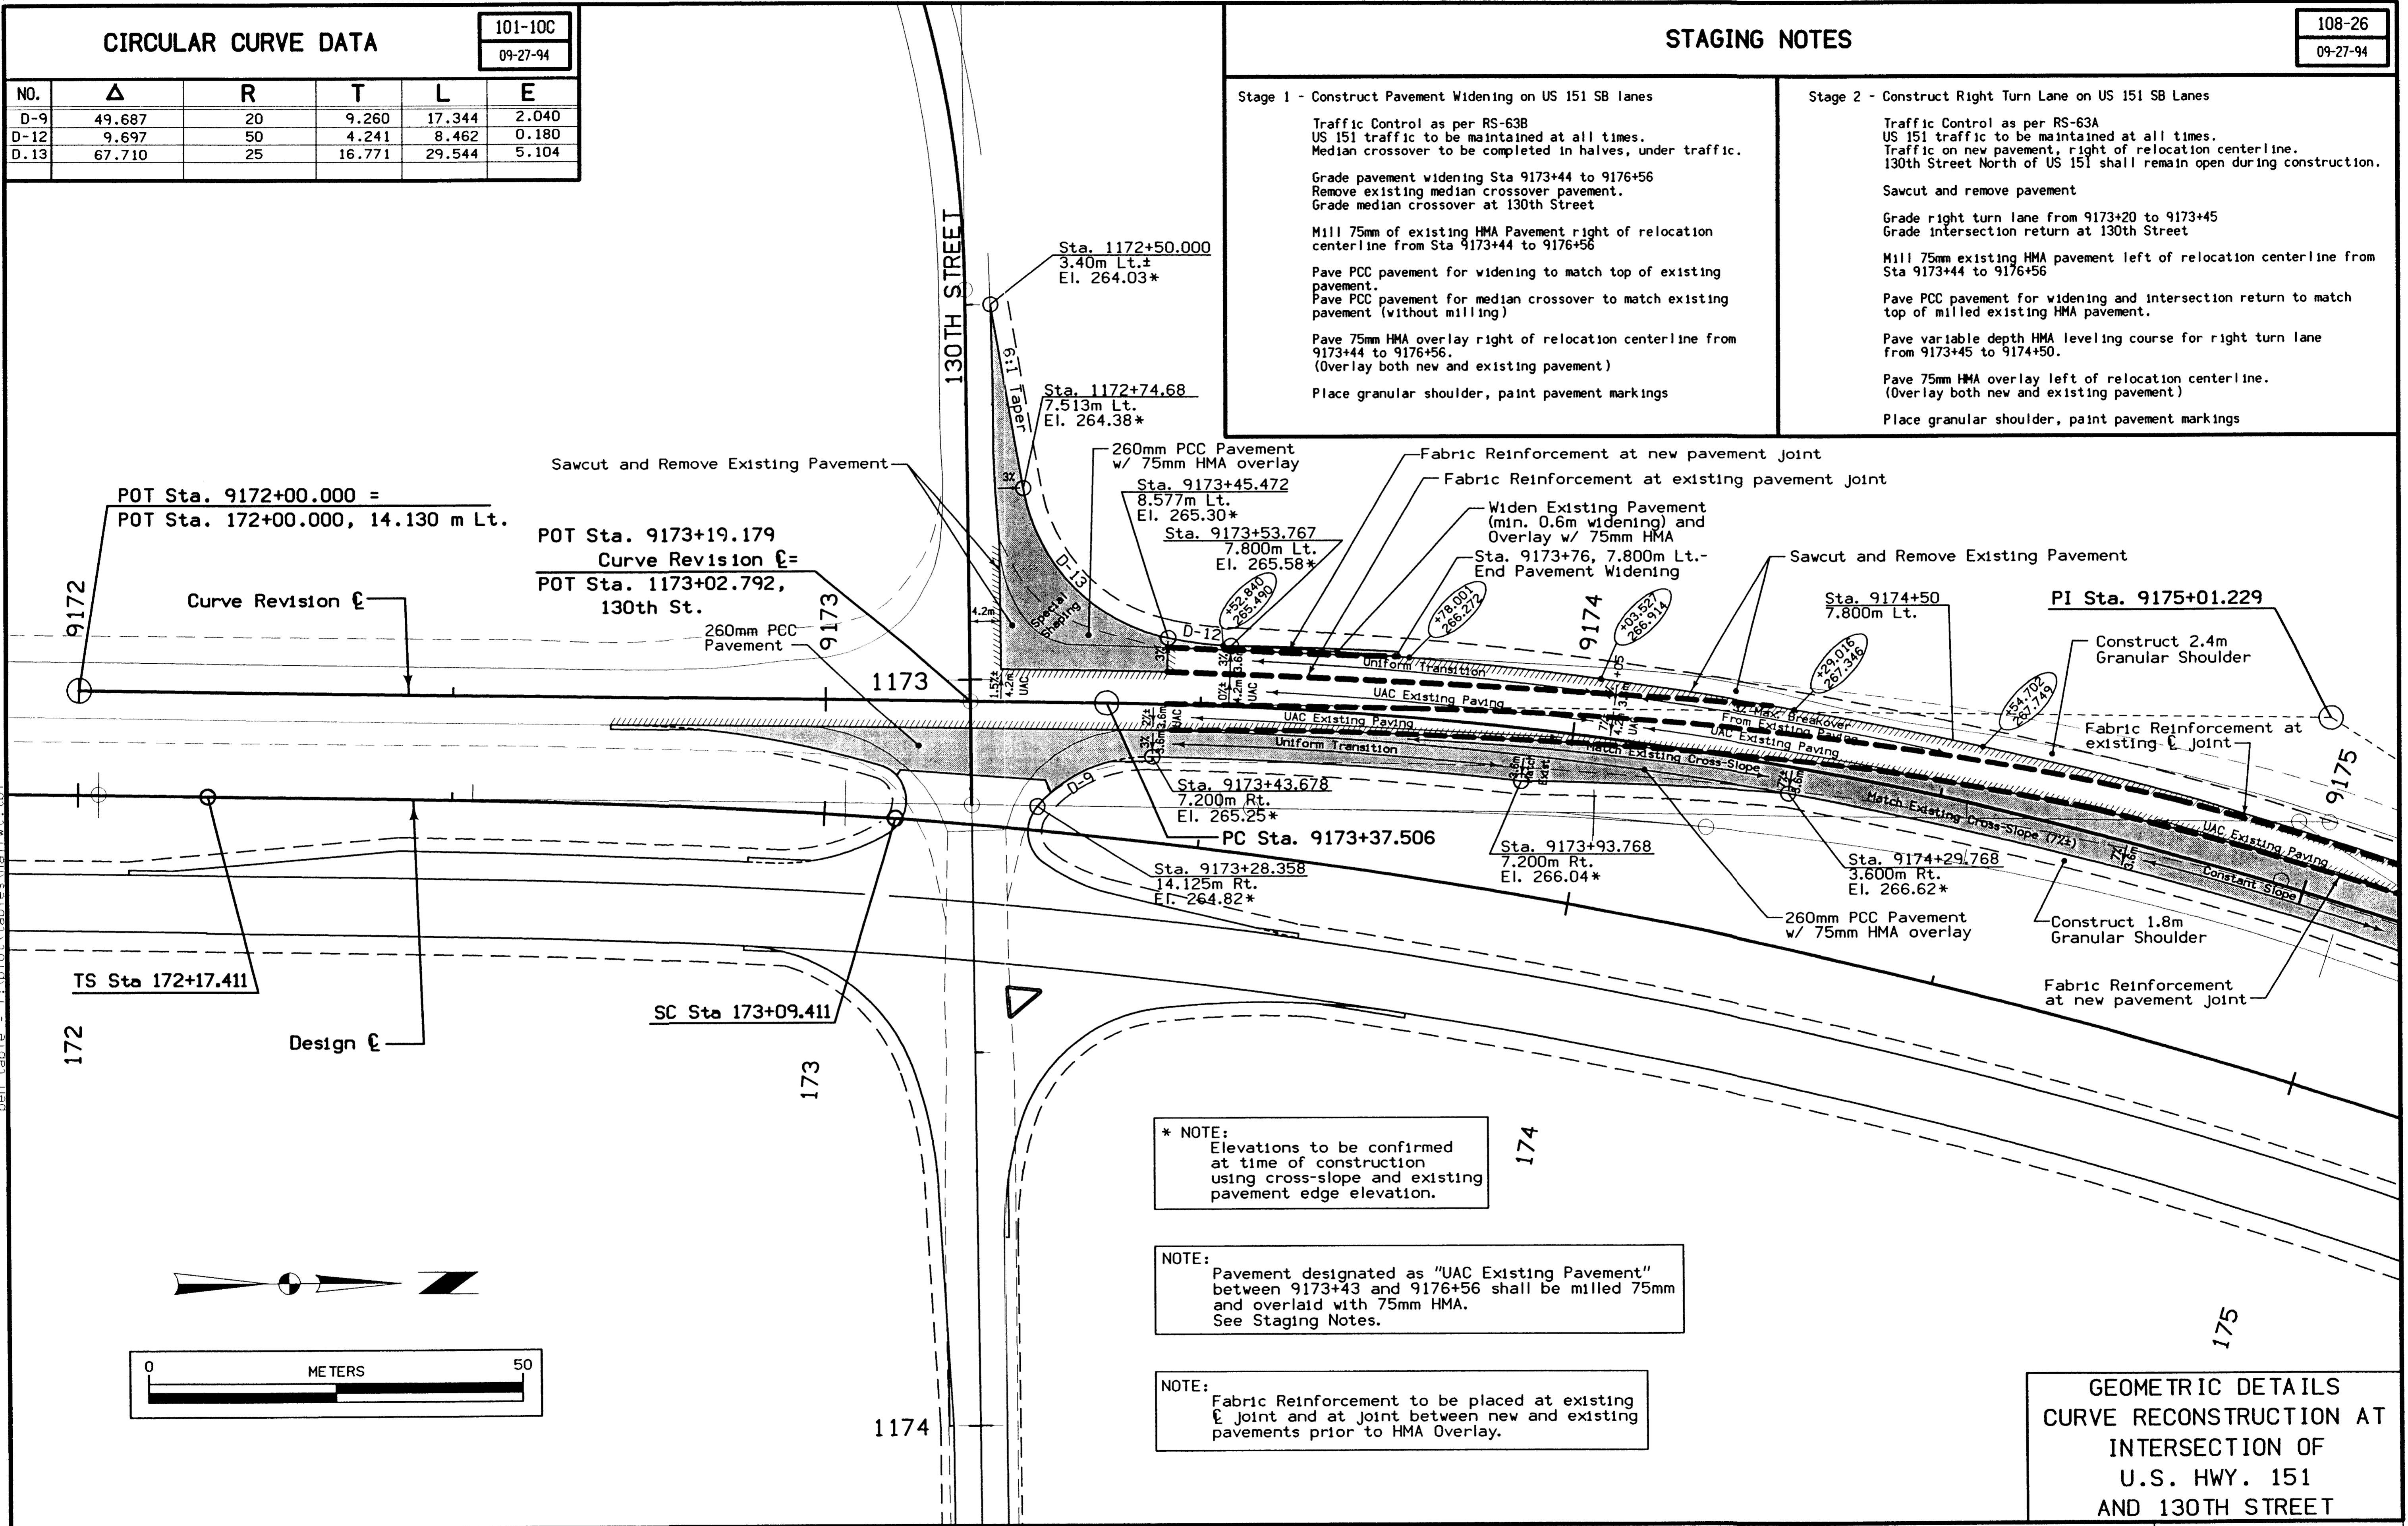

Sawcut and Remove Existing Pavement

POT Sta. 9172+00.000 =
POT Sta. 172+00.000, 14.130 m Lt.

Curve Revision ϵ

POT Sta. 9173+19.179
Curve Revision ϵ =
POT Sta. 1173+02.792,
130th St.


260mm PCC Pavement

* NOTE:
Elevations to be confirmed
at time of construction
using cross-slope and existing
pavement edge elevation.

NOTE:
Pavement designated as "UAC Existing Pavement"
between 9173+43 and 9176+56 shall be milled 75mm
and overlaid with 75mm HMA.
See Staging Notes.


NOTE:
Fabric Reinforcement to be placed at existing
 ϵ joint and at joint between new and existing
pavements prior to HMA Overlay.

GEOMETRIC DETAILS
CURVE RECONSTRUCTION AT
INTERSECTION OF
U.S. HWY. 151
AND 130TH STREET

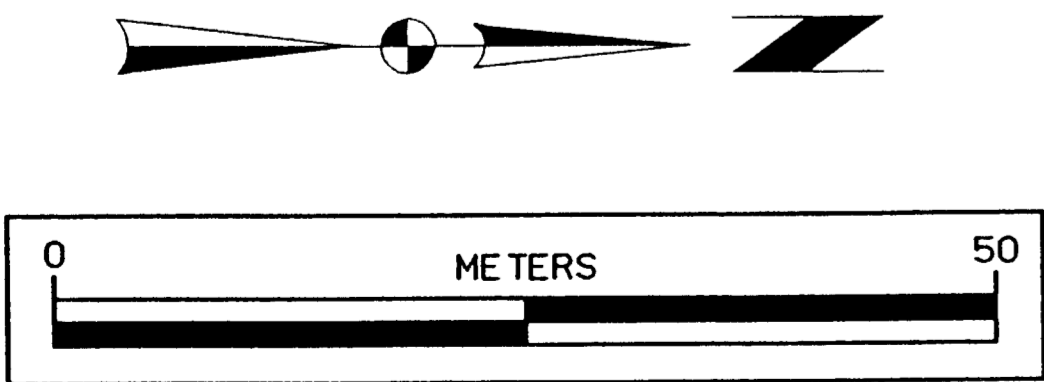


dgn = I:\work\project\39922\cadd\anacurve\pave\57151112_132
 leve\1-8,20-30
 pen\table = I:\plot\tables\halfwt.tbl
 date = Thu Apr 18 16:19:48 2002
 prf = \\WATSON1\DATA\PLOT\COPIER\132.prf

dgn = I:\WORK\proj\39922\cadd\anacurve\PAVE\57151112.133
levels = 1-4, 7, 8, 20, 21, 24, 30
open table = I:\pilot\tables\halfw.tbl

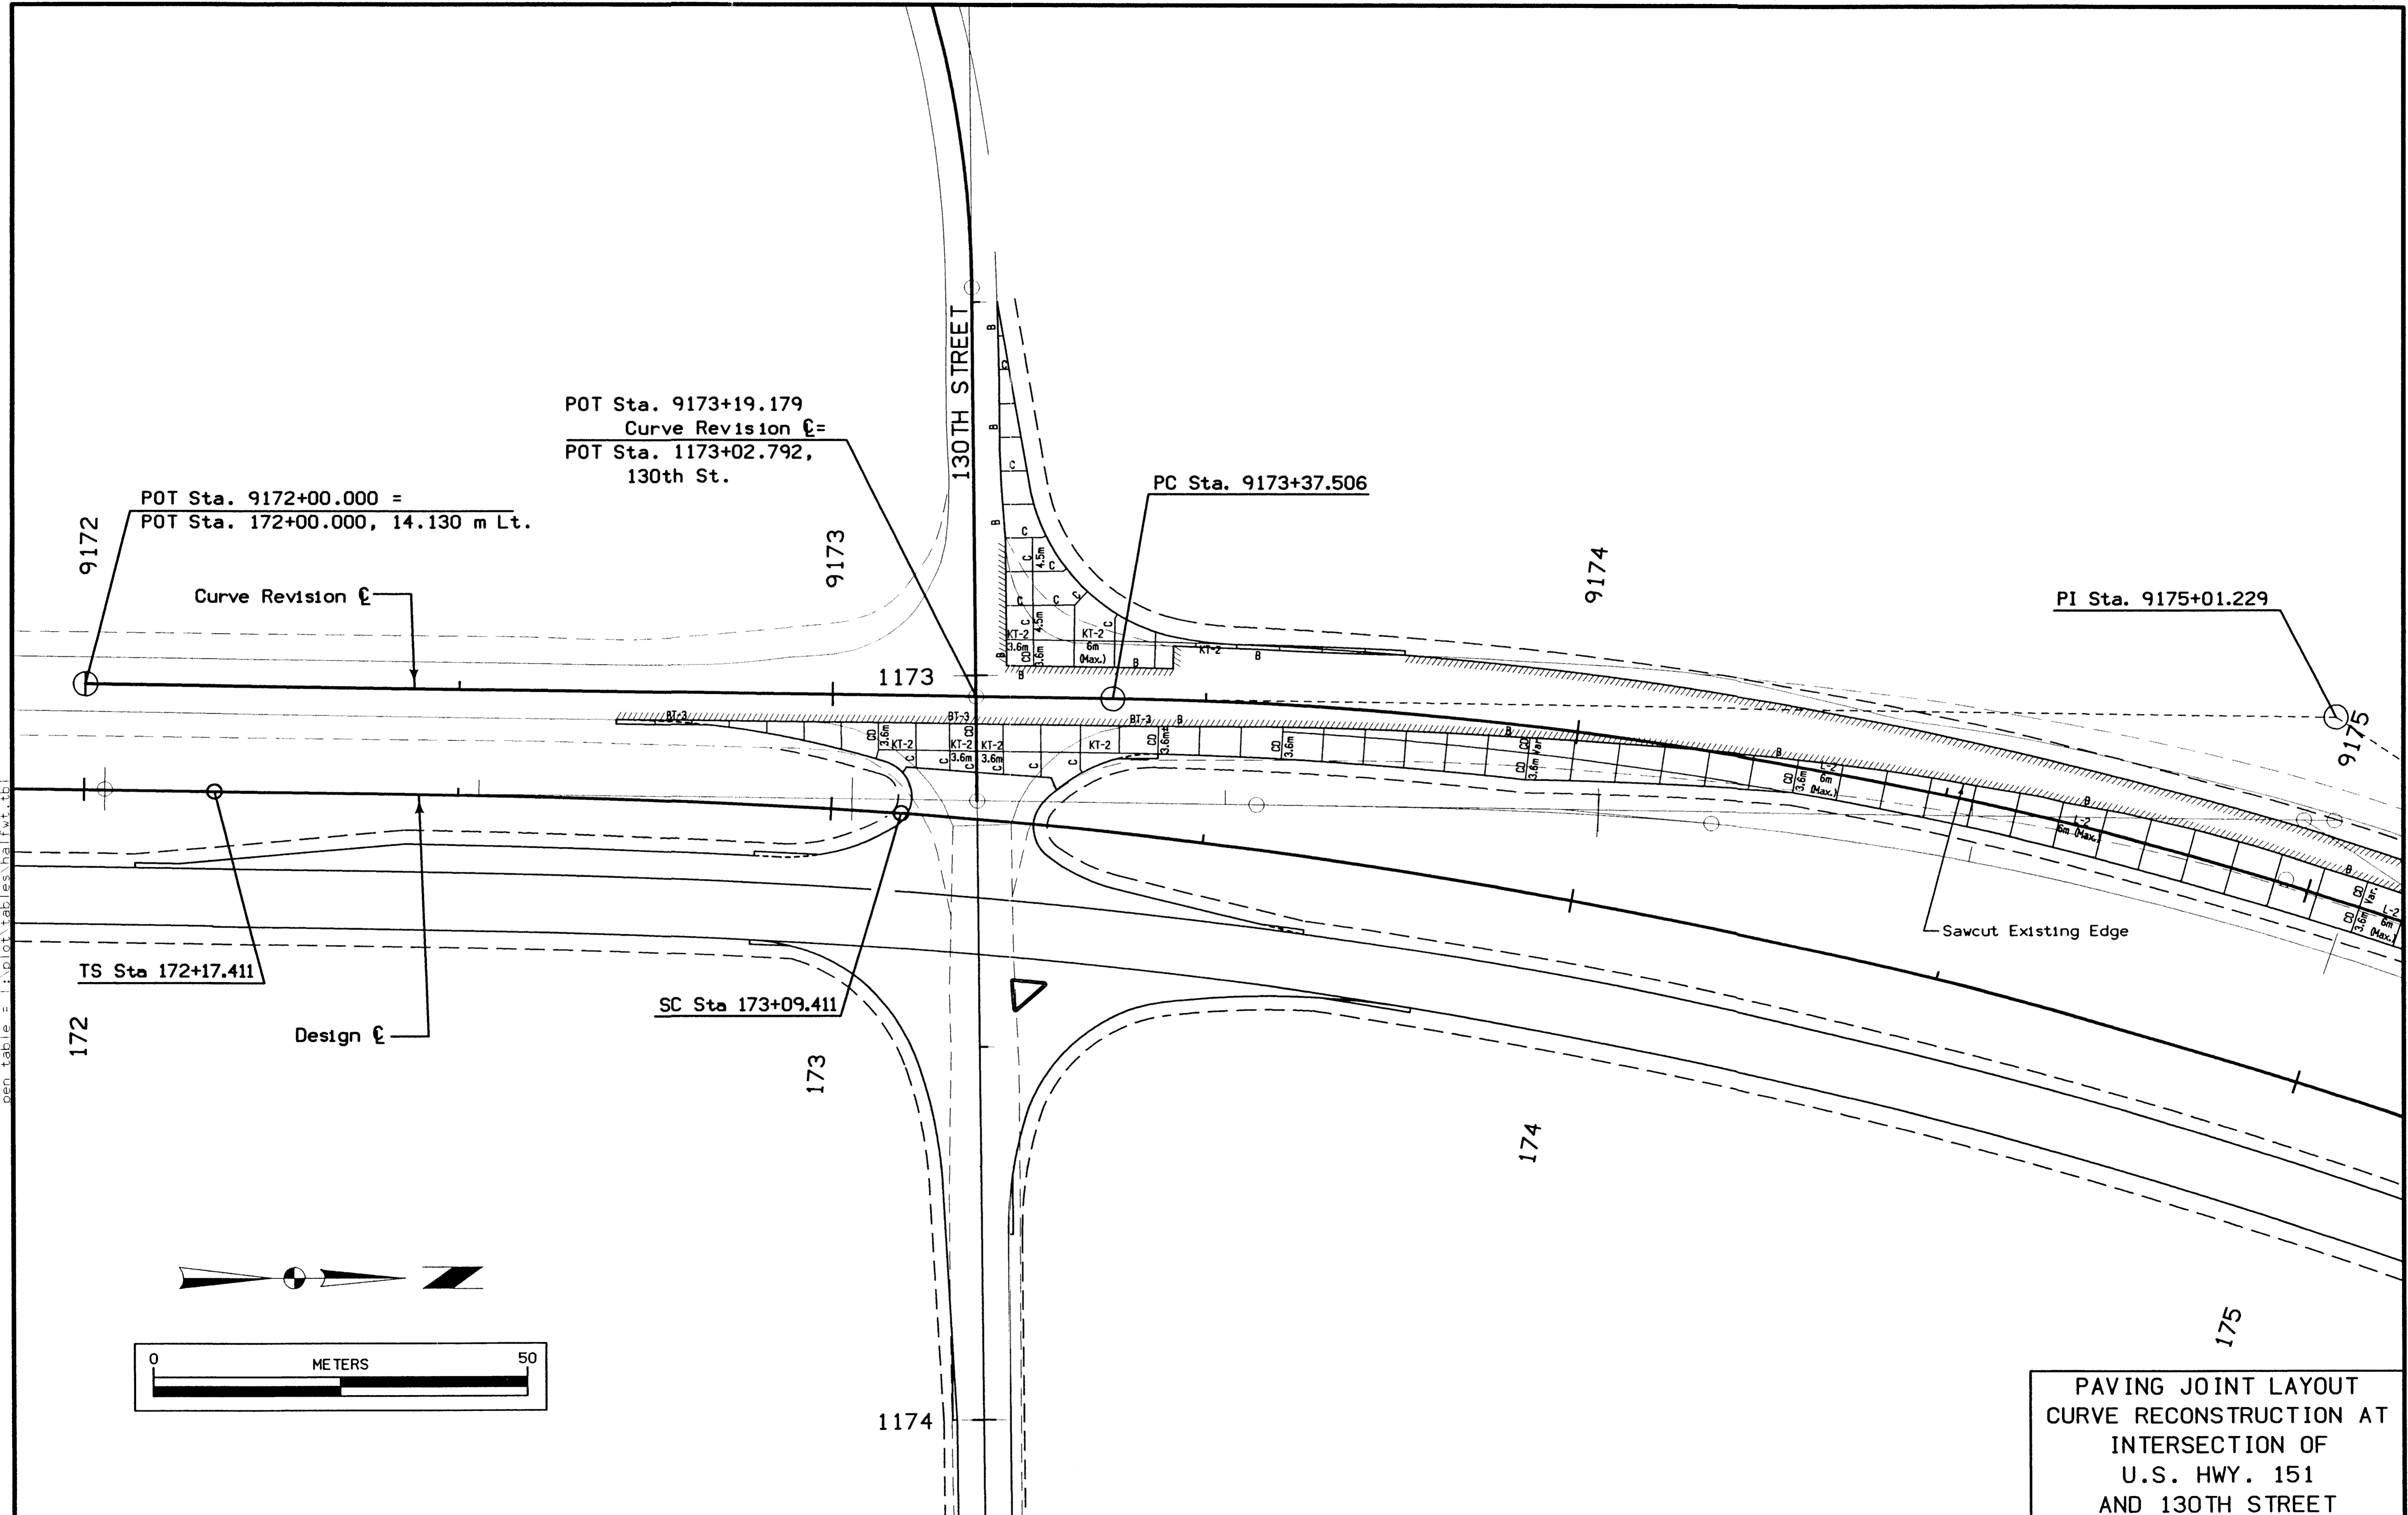


PAVING JOINT LAYOUT
CURVE RECONSTRUCTION AT
INTERSECTION OF
U.S. HWY. 151
AND 130TH STREET

GEOMETRIC DETAILS
 CURVE RECONSTRUCTION AT
 INTERSECTION OF
 U.S. HWY. 151
 AND 130TH STREET

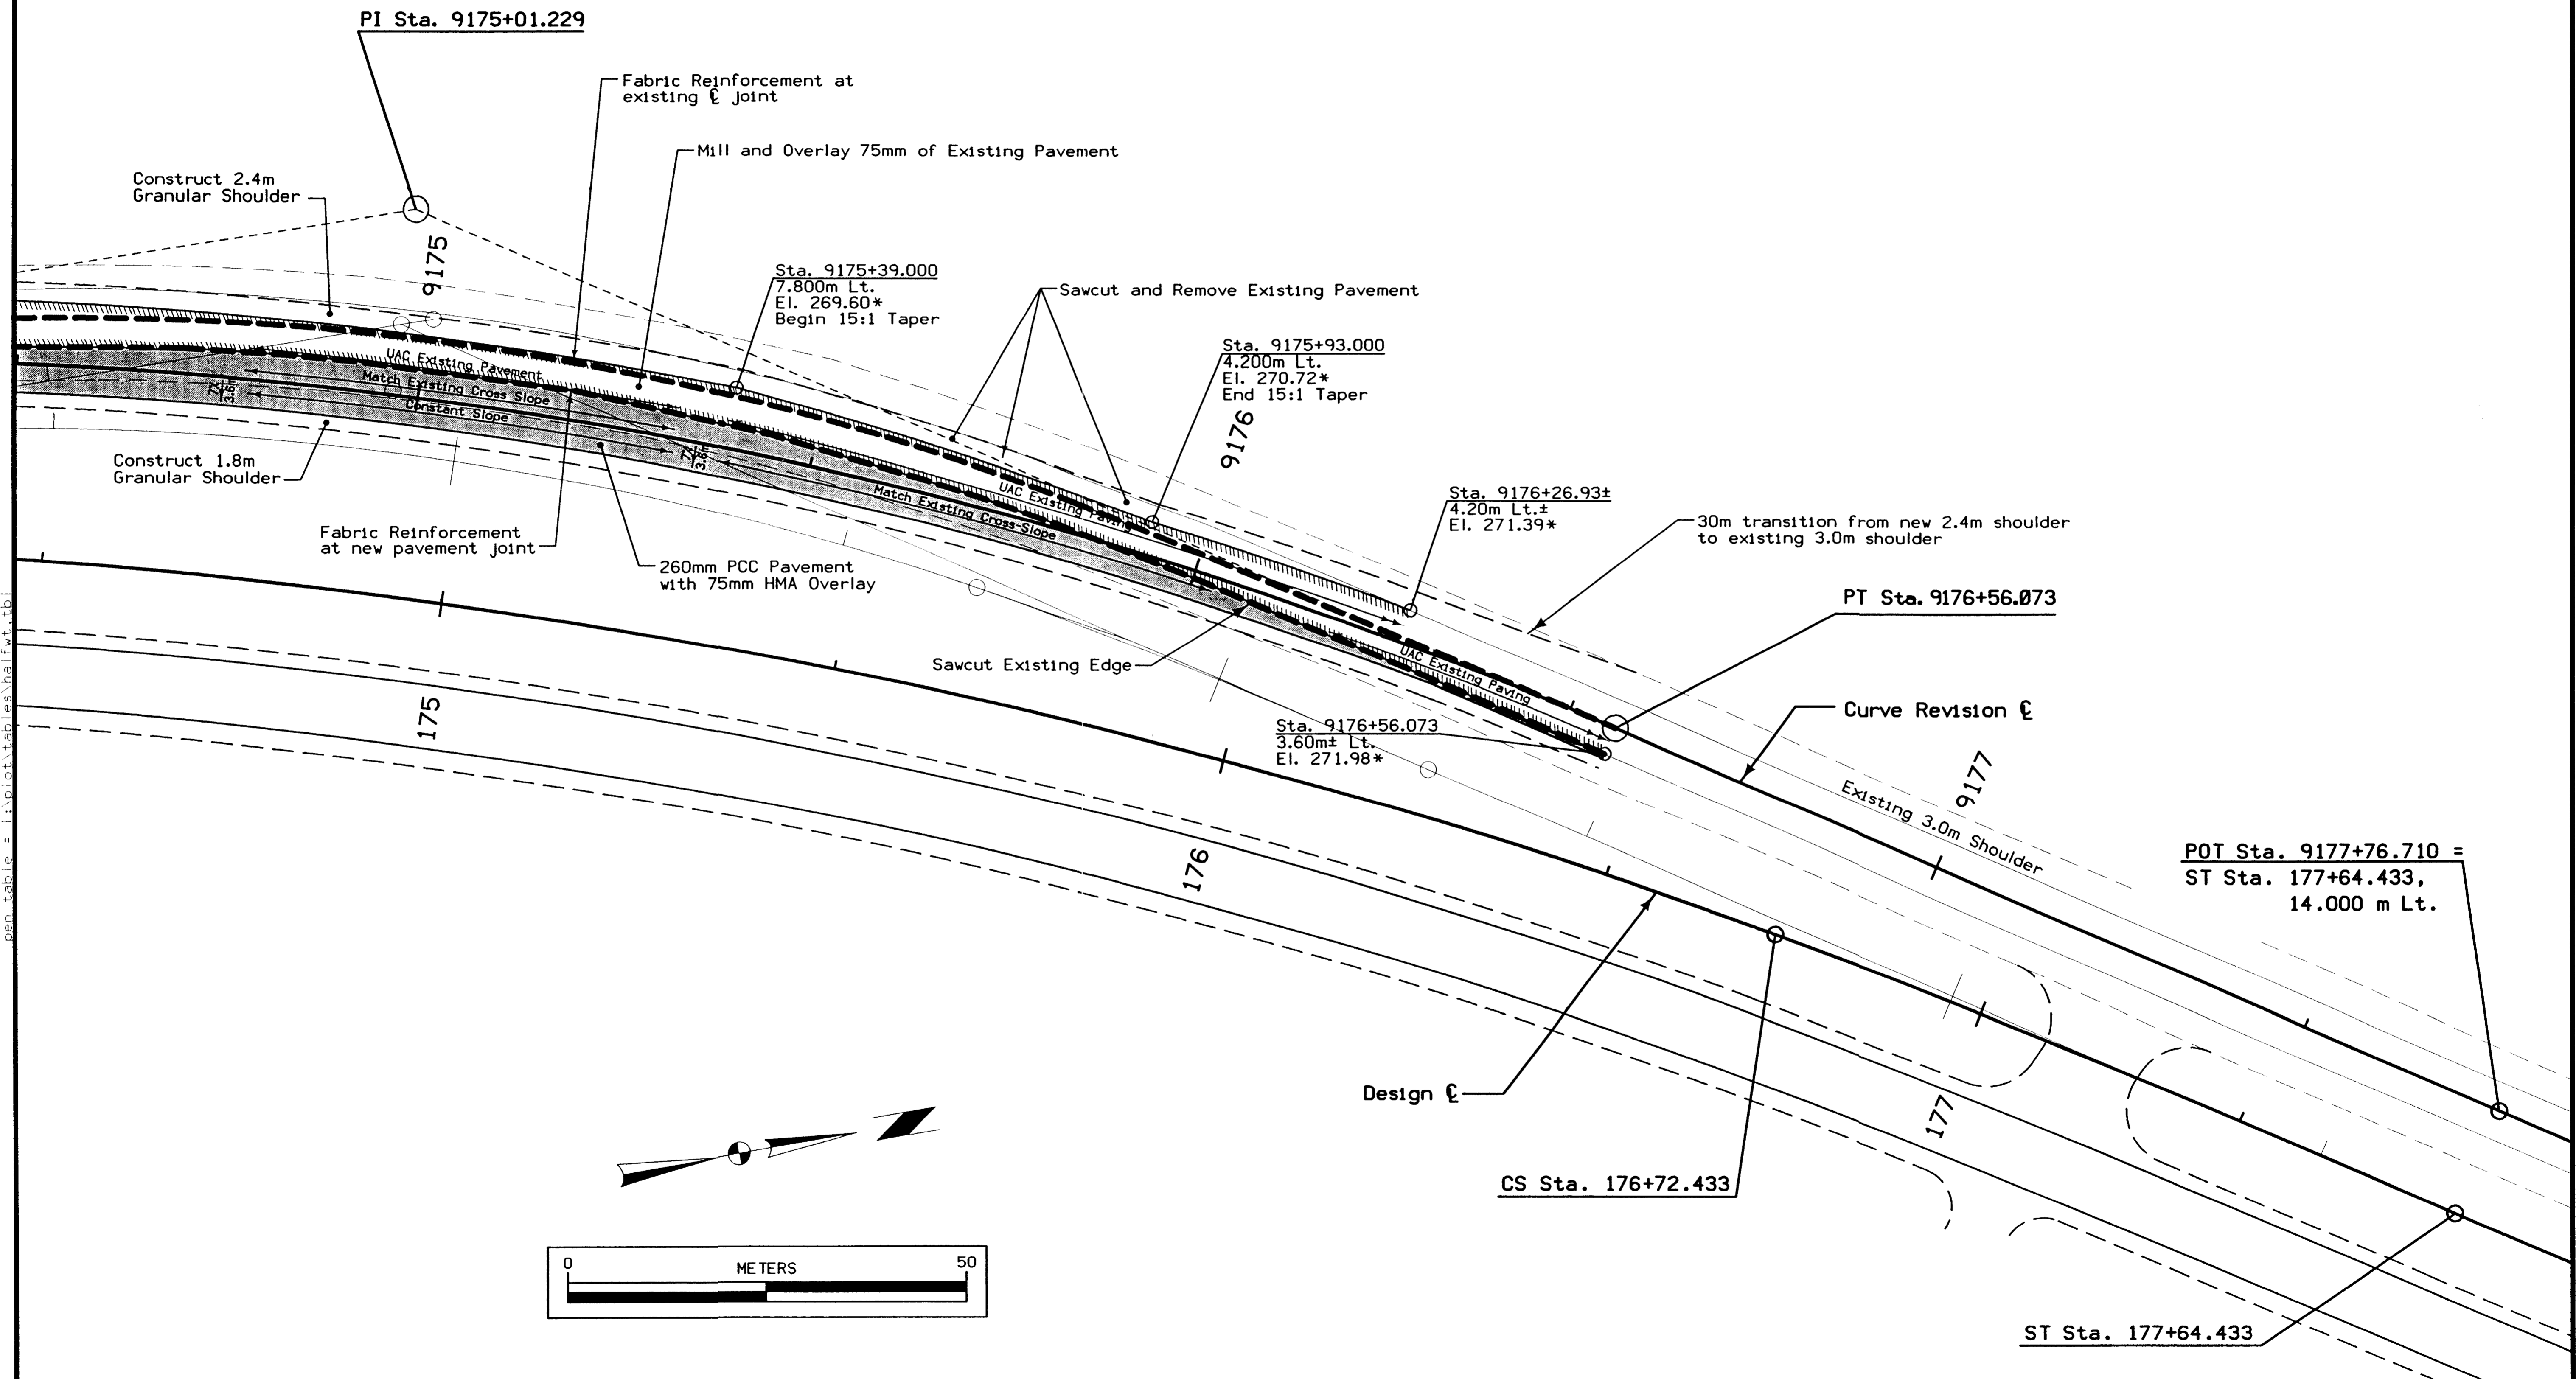

dgn = I:\work\project\39922\cadd\anacurve\pave\57151112.134
 levels = 1-63
 pen-table = I:\plot\tables\hal.fwt.tbl

PAVING JOINT LAYOUT
 CURVE RECONSTRUCTION AT
 INTERSECTION OF
 U.S. HWY. 151
 AND 130TH STREET

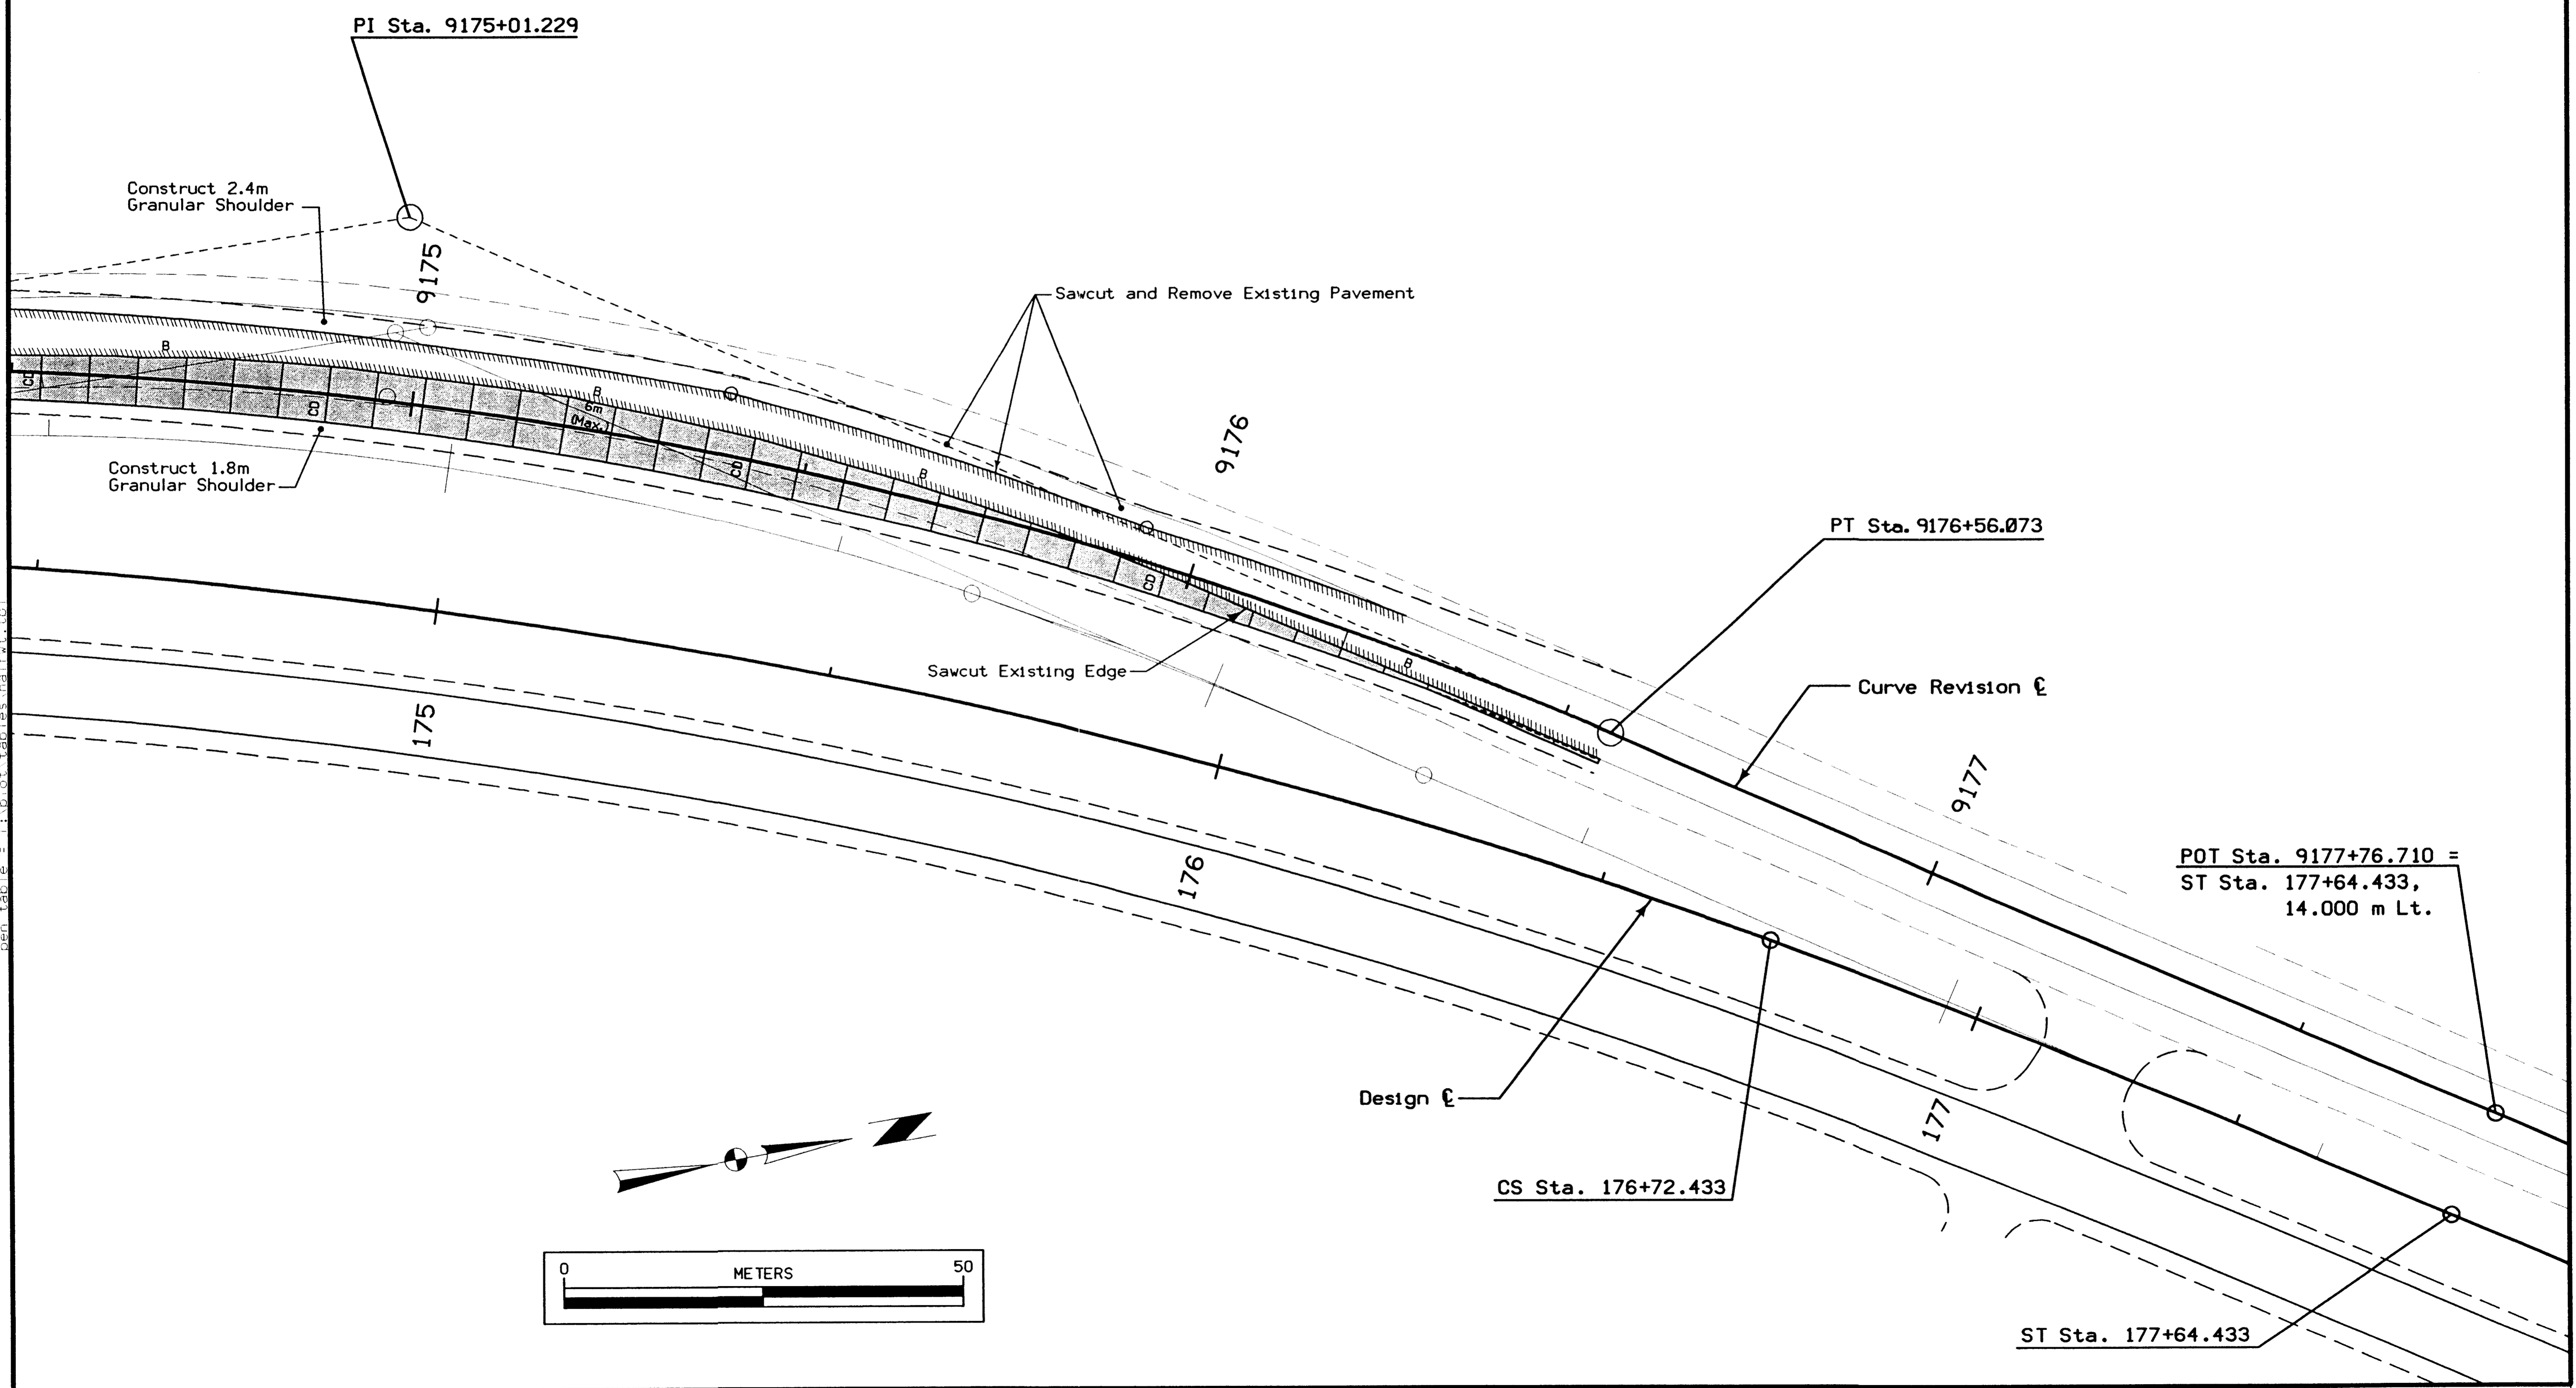

POT Sta. 9177+76.710 =
 ST Sta. 177+64.433,
 14.000 m Lt.


dgn = I:\WORK\project\39922\cadd\anacurve\PAVE\57151112_135
 levels = I-21_124-63
 open table = I:\plot\tables\half.tbl




SUMMARY OF QUANTITIES

Topsoil, Strip, Salvage, Stockpile = 9,000 m³
Topsoil Spread = 8,000 m³

From Sta. 15+40 to Sta. 134+00
Earth Shoulder Fill (Stage I + II) = 29,157m³
Borrow(stage I) = 2,594m³
Waste(stage II) = 4,483m³

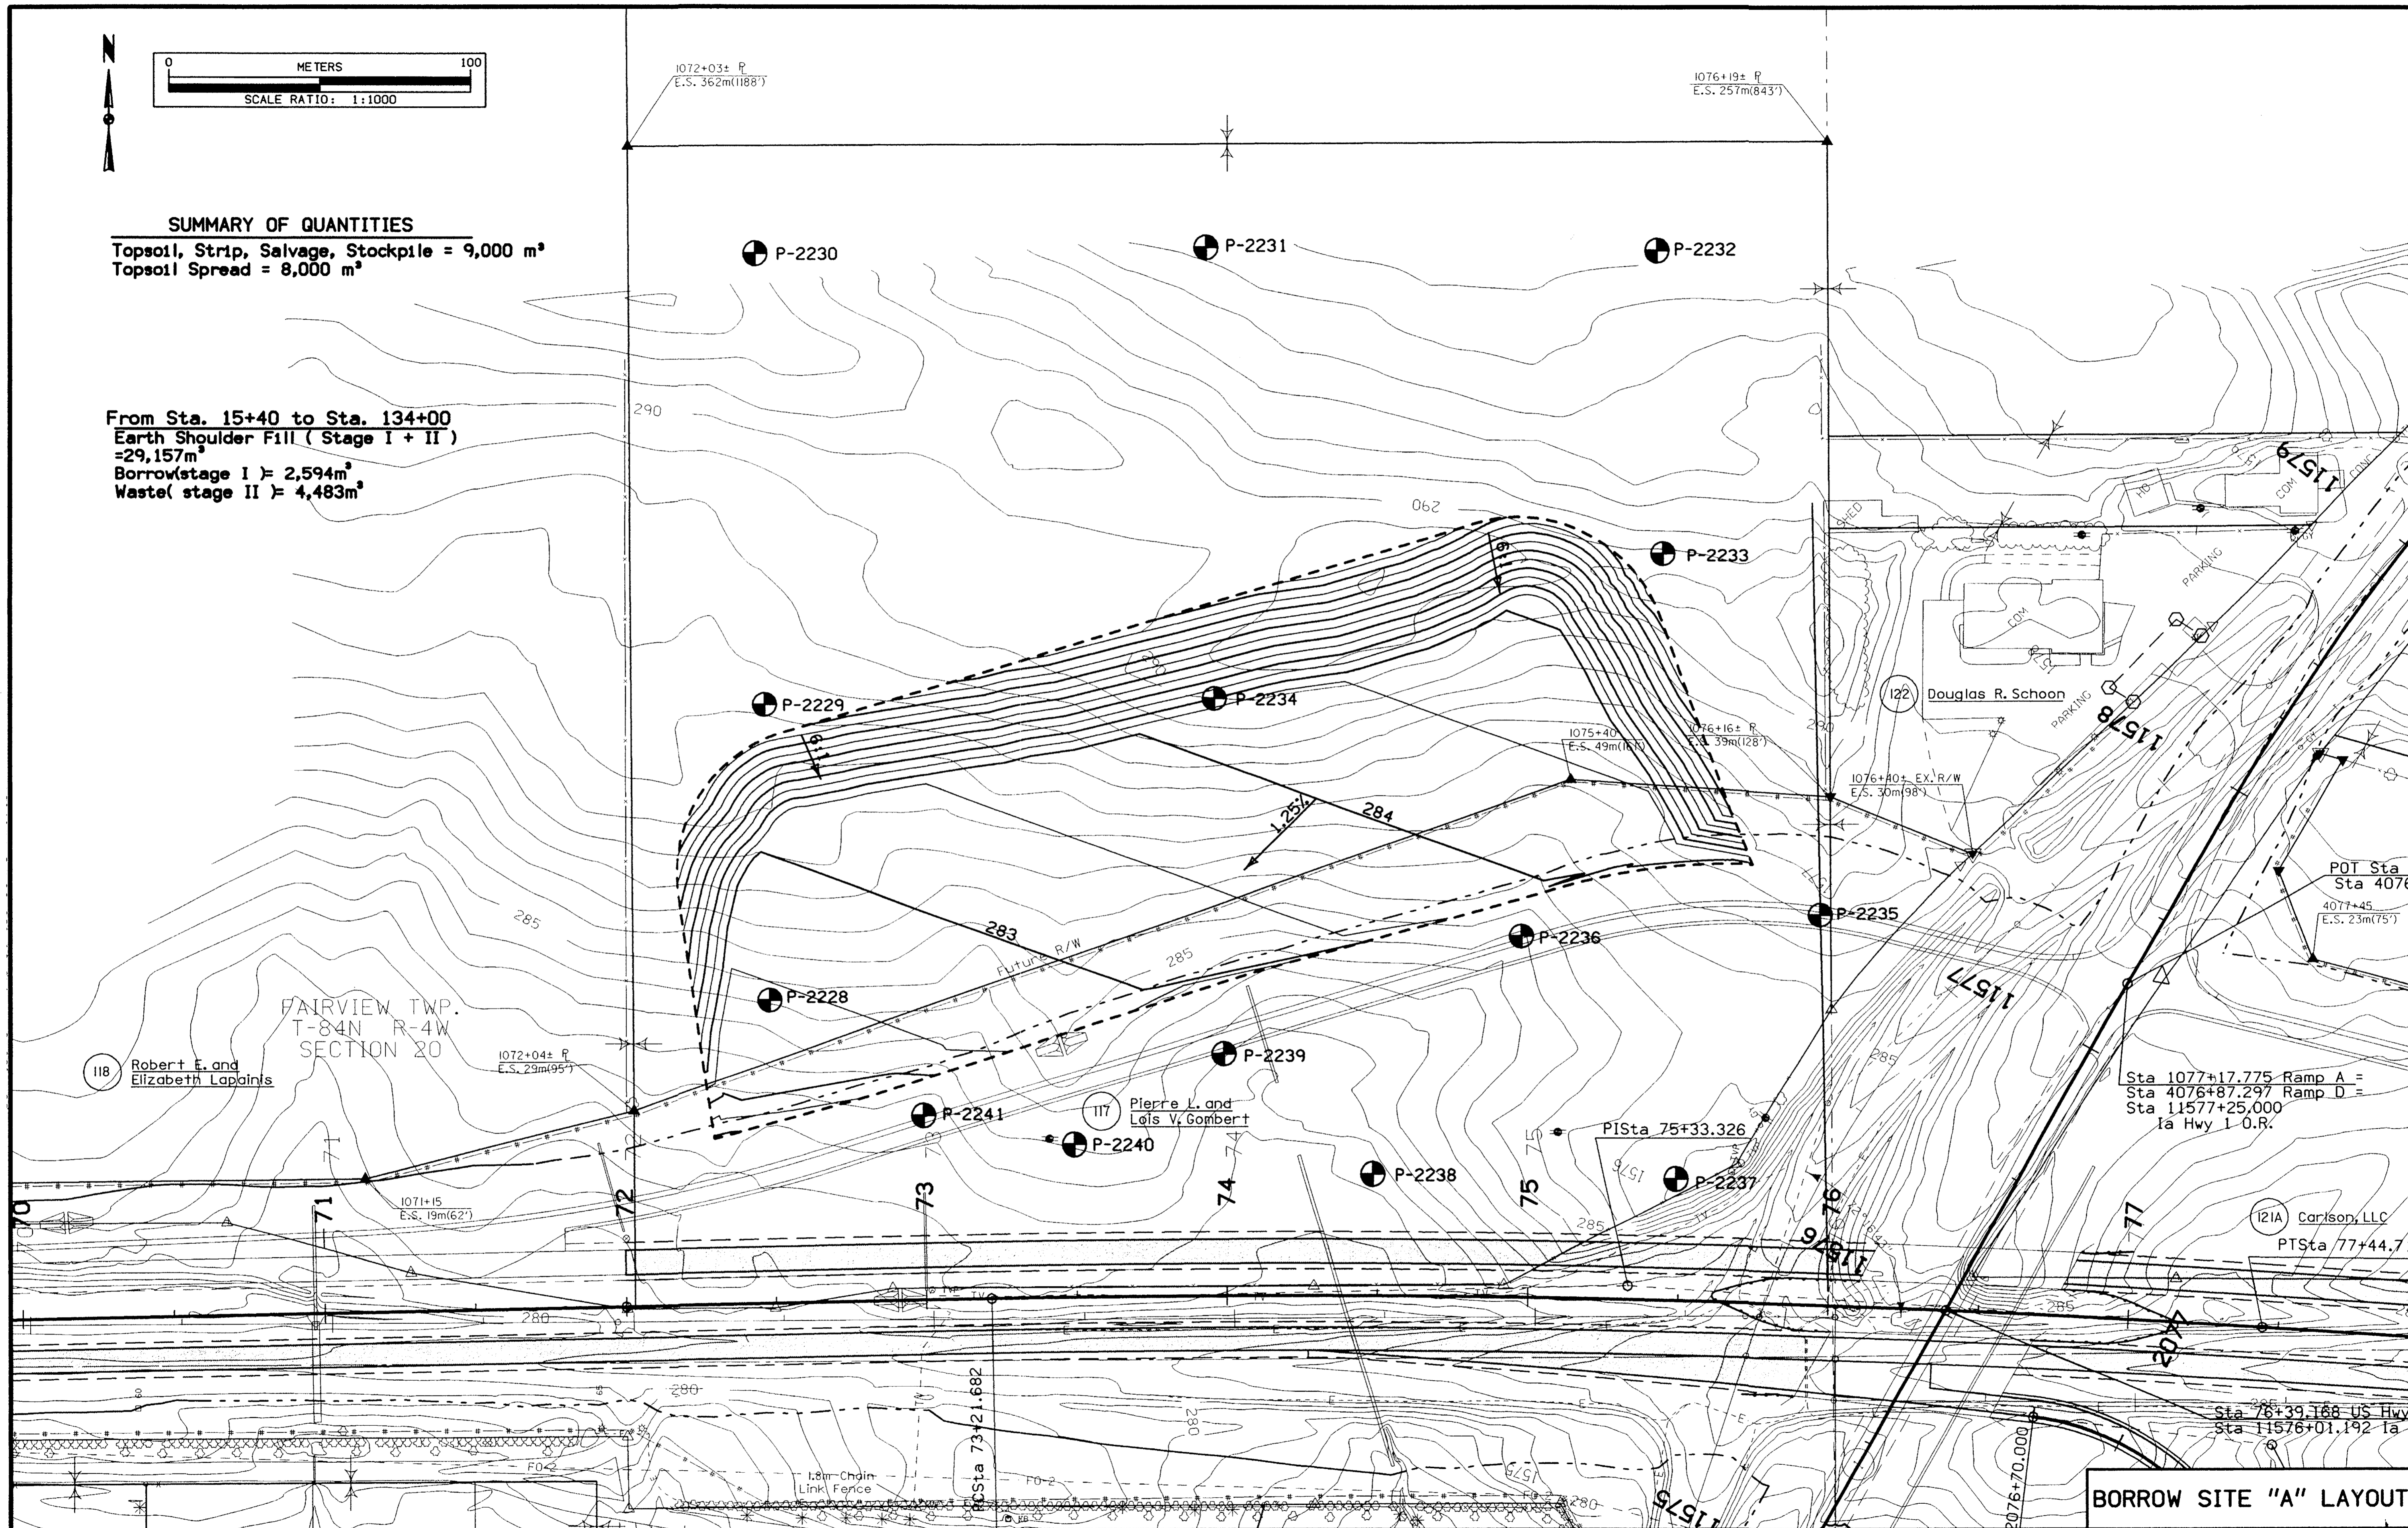

BORROW SITE "A" LAYOUT

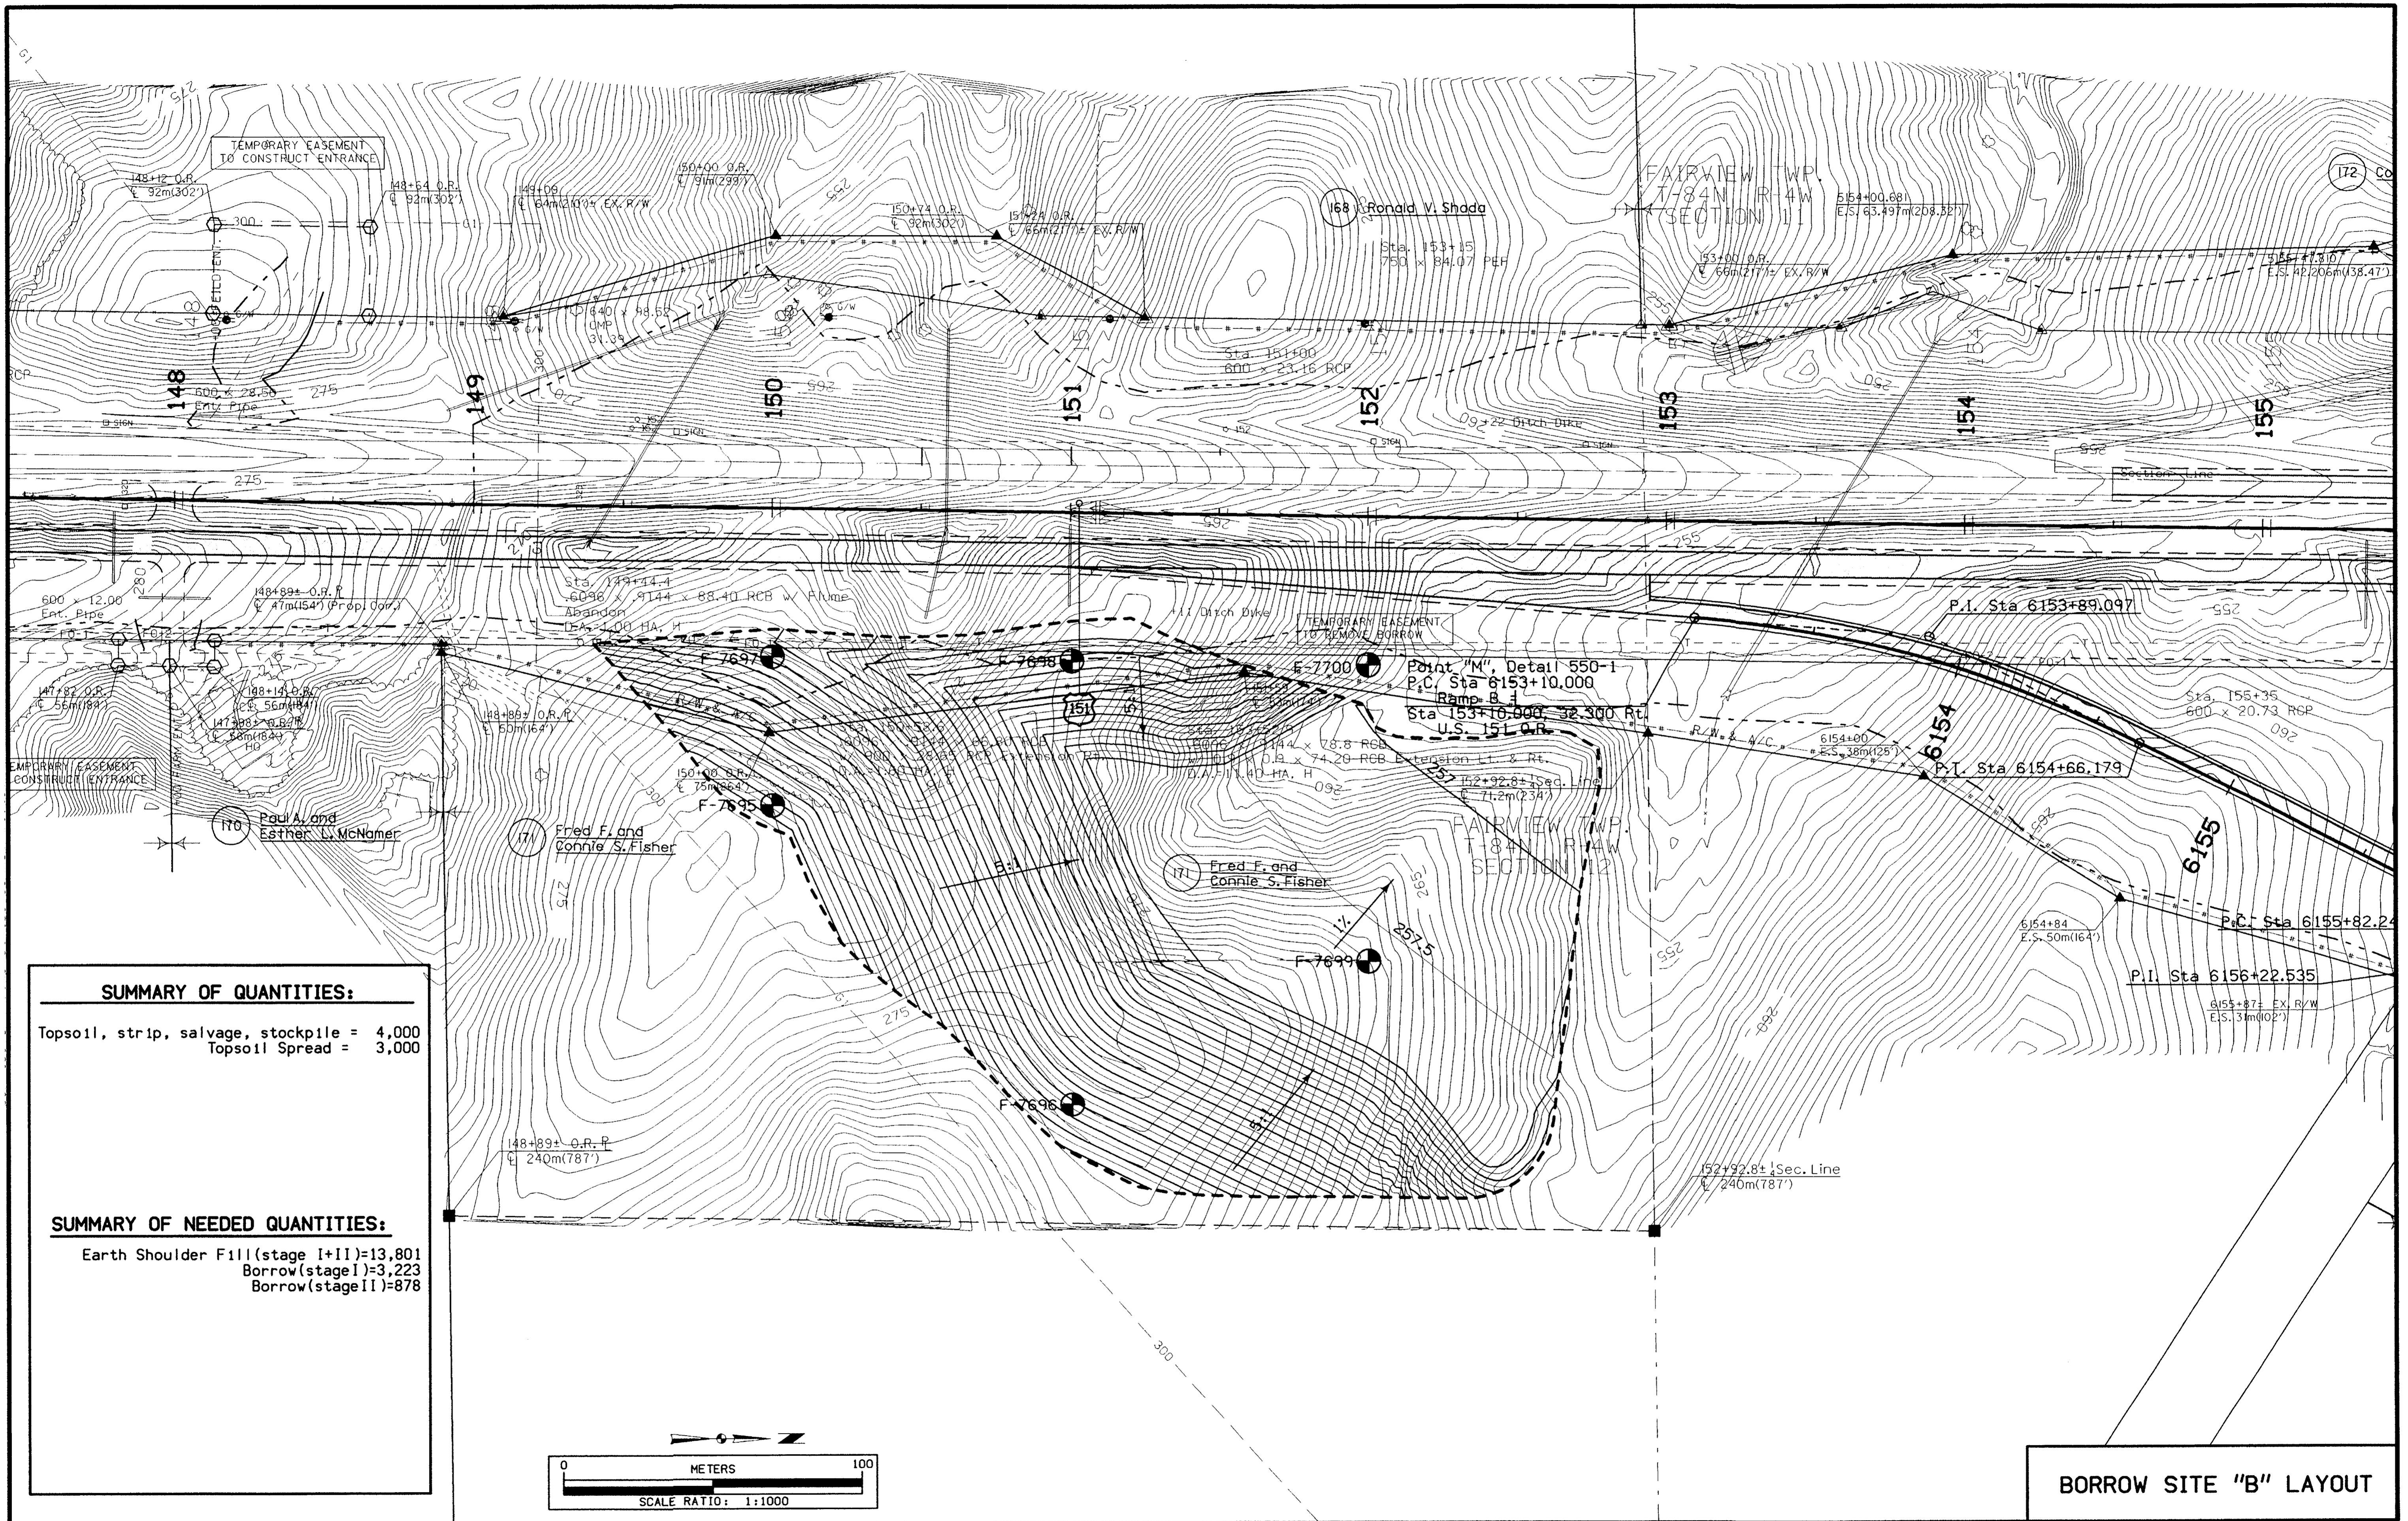


SUMMARY OF QUANTITIES:

Topsoil, strip, salvage, stockpile = 4,000
 Topsoil Spread = 3,000

SUMMARY OF NEEDED QUANTITIES:

Earth Shoulder Fill(stage I+II)=13,801
 Borrow(stage I)=3,223
 Borrow(stage II)=878

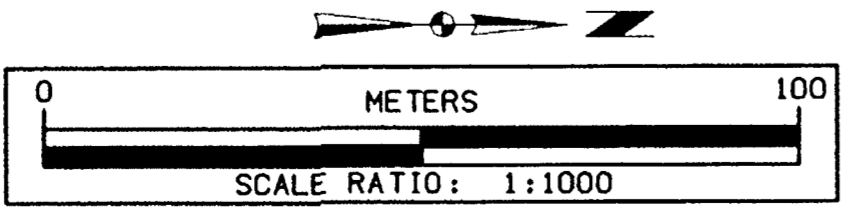

BORROW SITE "B" LAYOUT

TABULATION OF TEMPLATE QUANTITIES AND ADJUSTMENTS

Refer to Standard Road Plans RL-1A and RL-1B

107-28
03-26-96

STATION	TEMPLATE CUT	ADDITIONAL QUANTITY +C	SUBGRADE TREATMENT +C	MOISTURE AND DENSITY +C	TOPSOIL PLACEMENT +C	SELECT SOIL -C	PAYEMENT REMOVAL -C	ROCK -C	TOPSOIL REMOVAL -C	ADJUSTED EARTH CUT	UNSUIT-ABLE C - 3	UNSUIT-ABLE C - 5	ROCK CUT	ADDITIONAL ROCK CUT +C	PERCENT SWELL	ADJUSTED ROCK + SWELL	TEMPLATE FILL	ADDITIONAL QUANTITY +F	MOISTURE AND DENSITY +F	PAYEMENT REMOVAL +F	TOPSOIL PLACEMENT -F	SUBTRACT QUANTITY -F	SUBGRADE TREATMENT -F	ROCK FILL -F	ADJUSTED FILL	UNSUITABLE FILL	PERCENT SHRINK	ADJUSTED FILL + SHRINK	UNSUITABLE FILL + SHRINK	BALANCE AND OVERHAUL		
STAGE 1																																
X-Over e Sta. 4+50	0		0				0			0							2595			0					2595		30	3374				
X-Over e Sta. 182+80	0		0				0			0							1150			0					1150		30	1495				
Main line																																
51+85										115							54			0			20		34		30	44				
52+00	114		1				0			231							107			0			41		66		30	86				
52+30	229		2				0													0												
131+10	1000		46				0			1046							20			0			10		10		30	13				
131+50	250		12				0			262							5			0			3		2		30	3				
131+60																																
172+90	0		0				0			0							315			0			14		301		30	391				
173+00	0		0				0			0							1575			0			70		1505		30	1957				
173+50																																
Co. Rd. X-28																																
1452+44	9		17				13			13							6			0			0		6		30	8				
1452+50	198		140				110			228							60			0			0		60		30	78				
1453+00	270		140				110			300							33			0			0		33		30	43				
1453+50	238		140				110			268							70			0			0		70		30	91				
1454+00	158		140				110			188							98			0			0		98		30	127				
1454+00	103		140				110			133							133			0			0		133		30	173				
1455+00	35		140				110			65							85			0			0		85		30	111				
1455+50																																
Co. Rd. X-40																																
2131+48																																
2131+75	5413		70				55			5428							25			0			0		25		30	33				
2132+00	5463		70				55			5478							25			0			0		25		30	33				
2132+25																																
130th Street																																
1173+38	23		34				26			31							181			0			0		181		30	235				
1173+50	333		140				110			363							595			0			0		595		30	774				
1174+00	395		140				110			425							420			0			0		420		30	546				
1174+50	79		70				55			94							179			0			0		179		30	233				
1174+75																																
TOTALS	14310		1442				1084			14668							7731								7573			9848				
STAGE 1	2184		1244				974			2454							6506								6506			8271				


TABULATION OF TEMPLATE QUANTITIES AND ADJUSTMENTS

107-28
03-26-96


Refer to Standard Road Plans RL-1A and RL-1B

STATION	TEMPLATE CUT	ADDITIONAL QUANTITY +C	SUBGRADE TREATMENT +C	MOISTURE AND DENSITY +C	TOPSOIL PLACEMENT +C	SELECT SOIL -C	PAVEMENT REMOVAL -C	ROCK -C	TOPSOIL REMOVAL -C	ADJUSTED EARTH CUT	UNUSUITABLE C-3	UNUSUITABLE C-5	ROCK CUT	ADDITIONAL ROCK CUT +C	PERCENT SWELL	ADJUSTED ROCK + SWELL	TEMPLATE FILL	ADDITIONAL QUANTITY +F	MOISTURE AND DENSITY +F	PAVEMENT REMOVAL +F	TOPSOIL PLACEMENT -F	SUBTRACT QUANTITY -F	SUBGRADE TREATMENT -F	ROCK FILL -F	ADJUSTED FILL	UNUSUITABLE FILL	PERCENT SHRINK	ADJUSTED FILL + SHRINK	UNUSUITABLE FILL + SHRINK	BALANCE AND OVERHAUL	
STAGE II																															
Mainline																															
15+40	140		28				22			146						41			0				0		41		30	53			
15+50	775		140				110			805						171			0				0		171		30	222			
16+00	925		140				110			955						141			0				0		141		30	183			
16+50	1100		140				110			1130						176			0				0		176		30	229			
17+00	1300		140				110			1330						321			0				0		321		30	417			
17+50	1675		140				110			1705						256			0				0		256		30	333			
18+00	1425		128				110			1443						183			0				13		170		30	221			
18+50	800		78				85			793						437			25				63		399		30	519			
19+00	650		23				55			618						630			55				118		567		30	737			
19+50	450		3				55			398						761			35				138		658		30	855			
20+00	300		0				85			215						948			5				140		813		30	1057			
20+50	275		0				110			165						1038			0				140		898		30	1167			
21+00	375		23				110			288						703			0				118		585		30	761			
21+50	425		83				110			398						298			0				58		240		30	312			
22+00	650		130				110			670						115			0				10		105		30	137			
22+50	450		140				110			480						6			0				0		6		30	8			
23+00	0		140				55			85						0			0				0		0		30	0			
23+50	0		70				0			70						0			0				0		0		30	0			
24+00																															
173+00	88		0				0			88						75			0				0		75		30	98			
173+50	200		0				0			200						138			0				0		138		30	179			
174+00	289		0				0			289						148			0				0		148		30	192			
174+50	358		0				0			358						151			0				0		151		30	196			
175+00	276		0				0			276						128			0				0		128		30	166			
175+50	95		0				0			95						61			0				0		61		30	79			
176+00																															
TOTALS	13206		1546				1567			13185						8047			120			798		7369			9580				
STAGE III																															
X-Over 'B'																															
1150			0				0			1150						0			0				0		0		30	0			
Additional for Rt. Turn Lane from Sta. 128+19 to Sta. 131+31																															
128+19	0		0													57							10		47		30	61			
128+50	0		0													295							43		252		30	328			
129+00	0		0													418							54		364		30	473			
129+50	0		0													438							54		384		30	499			
130+00	0		0													445							54		391		30	508			
130+50	0		0													445							54		391		30	508			
131+00	0		0													138							17		121		30	157			
131+31	0		0																												
																									TOTALS			2534			


dgn = L:\WORK\PROJECT\39922\cadd\X40\turn\X40t01.dgn
 levels = 1-3,6-11,15-19,26-30,32-40,42-45,50-53,60-63
 pen table = plot\tables\halftone.tbl

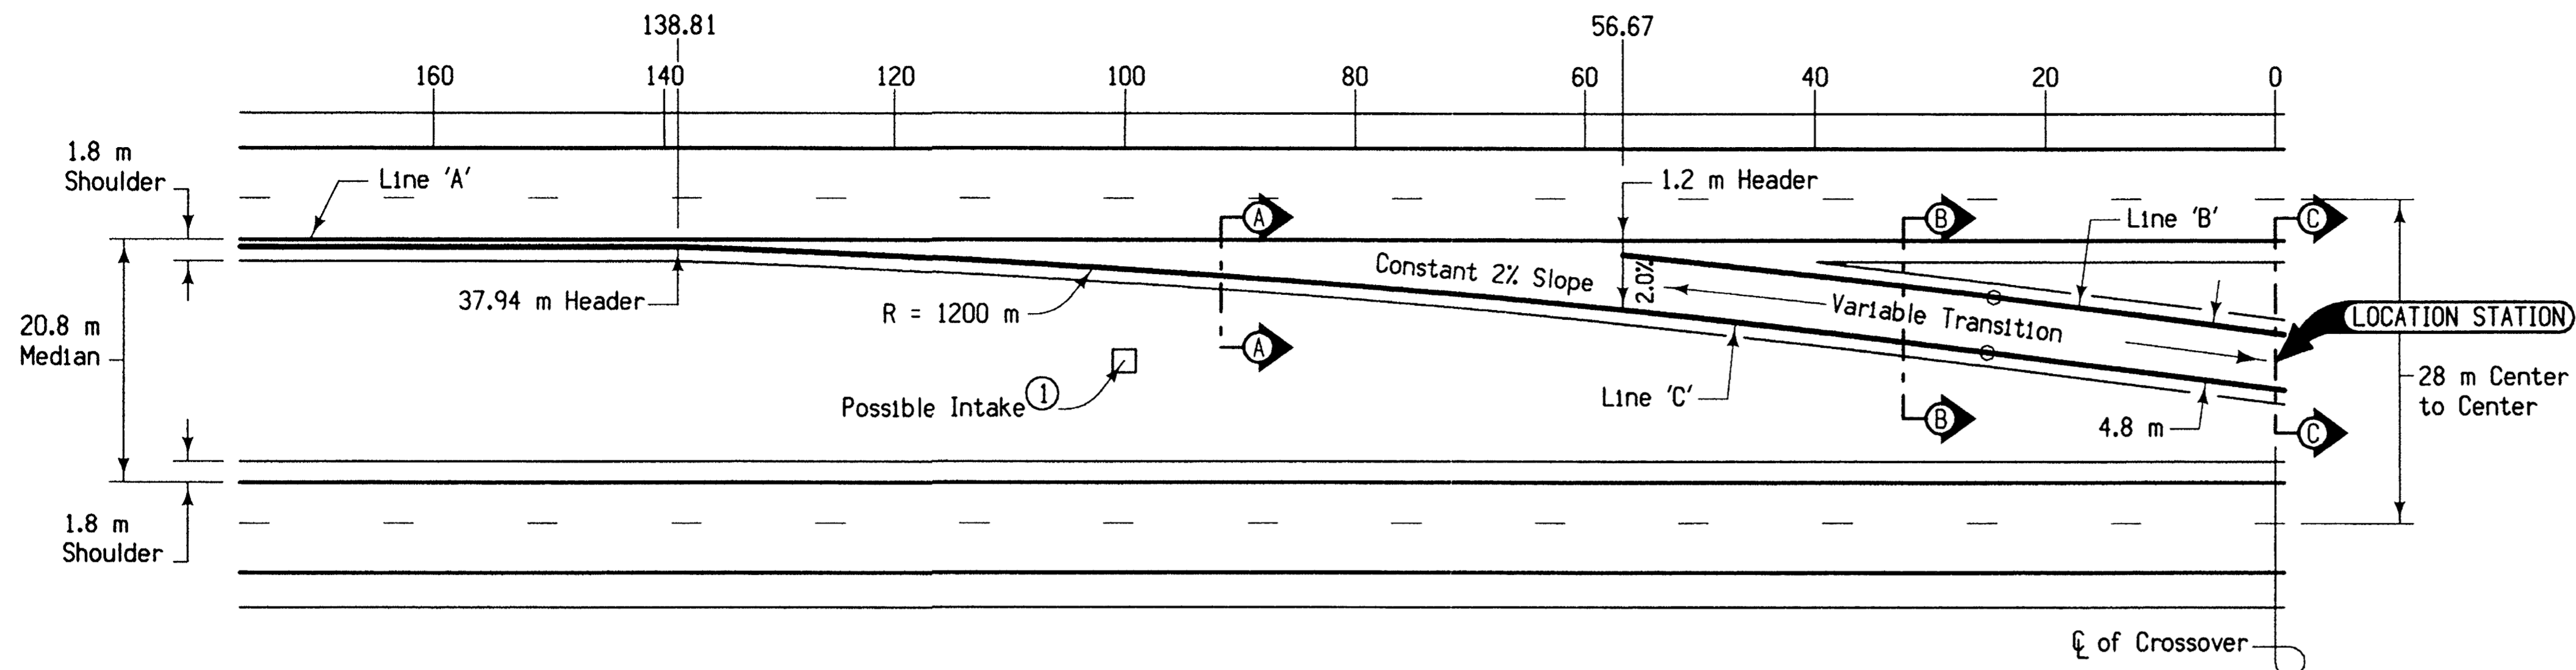


PLAN VIEW

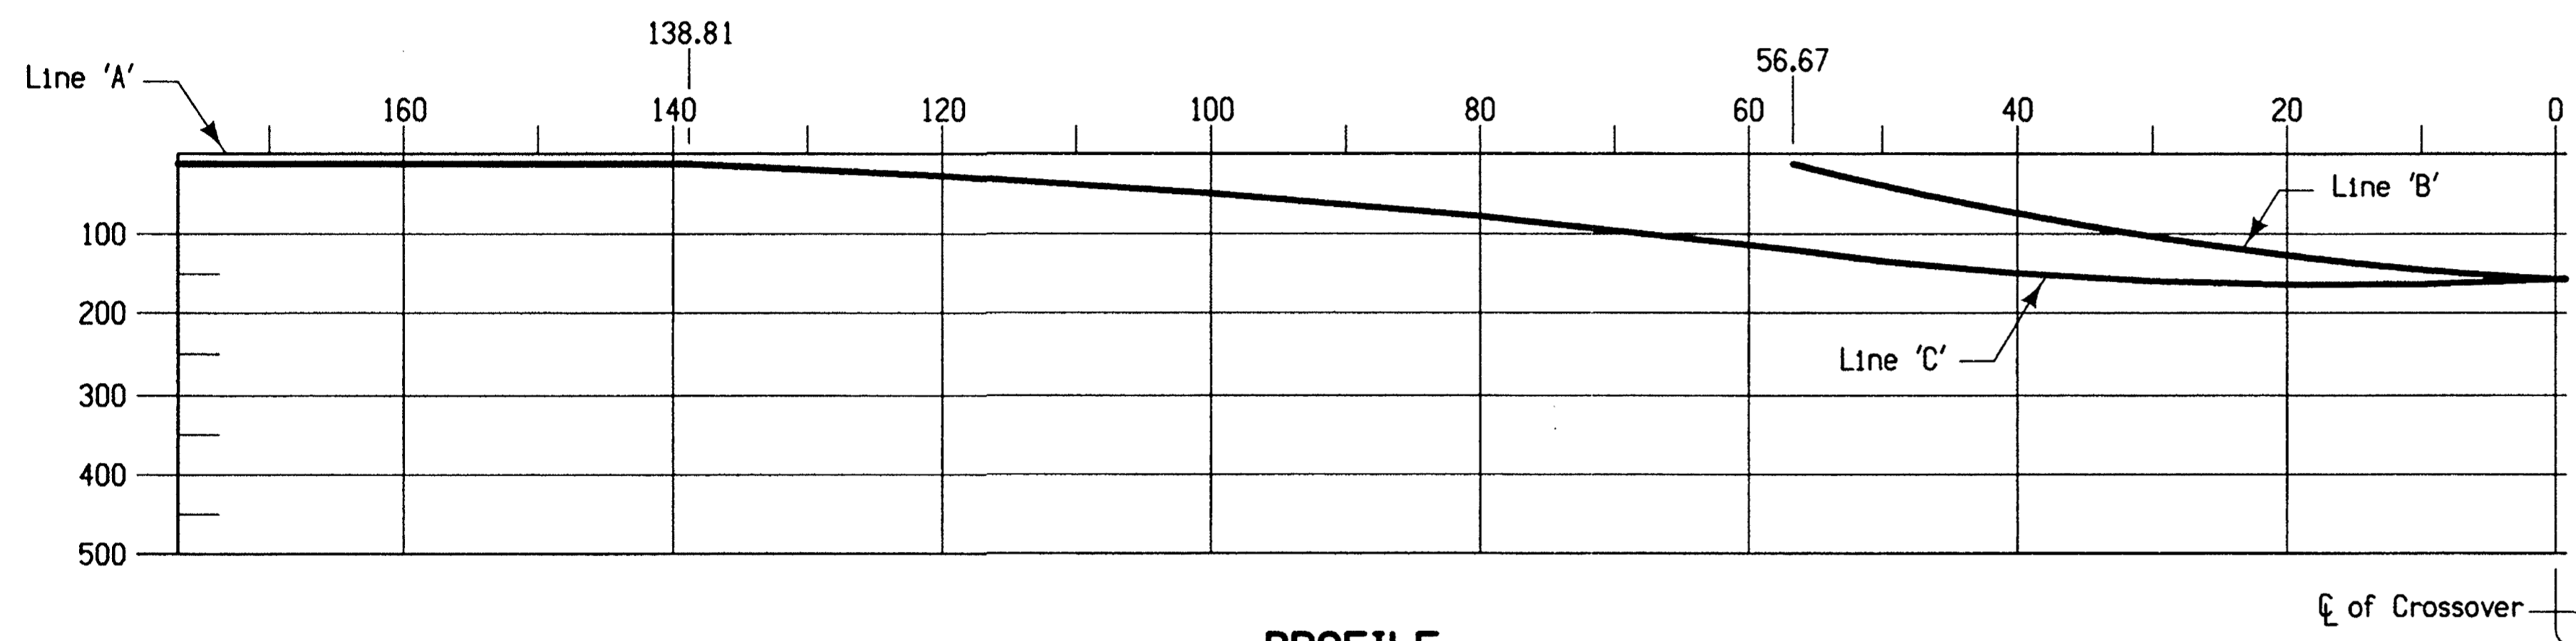


PROFILE

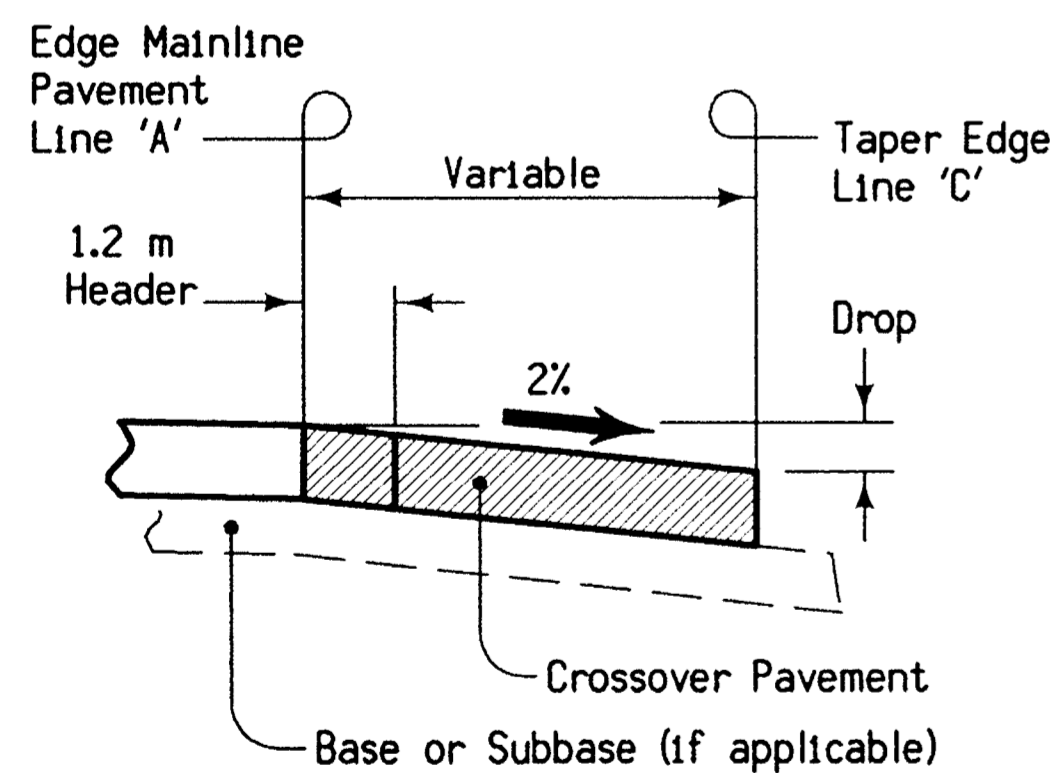

SECTION A-A

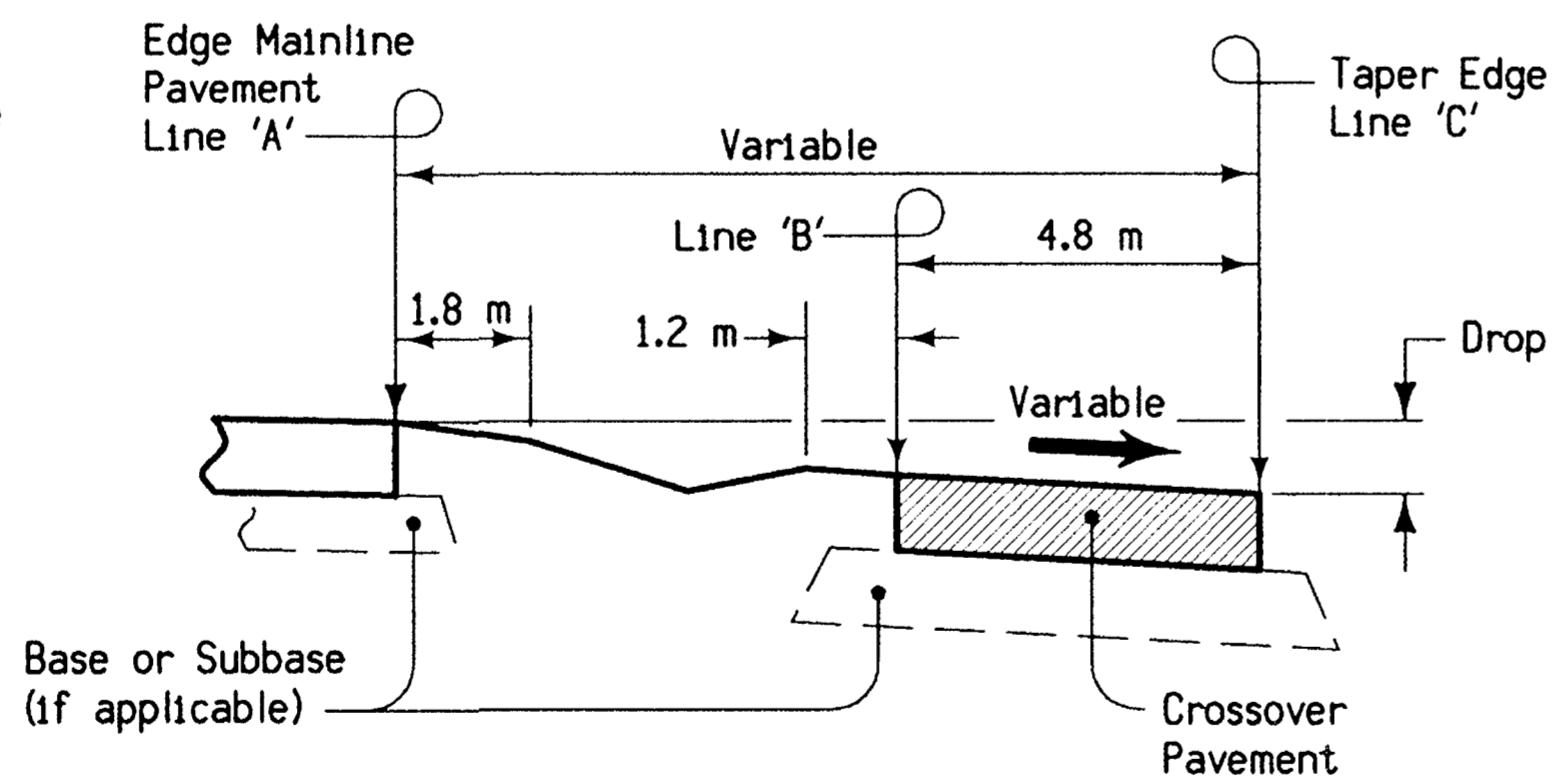

SECTION B-B

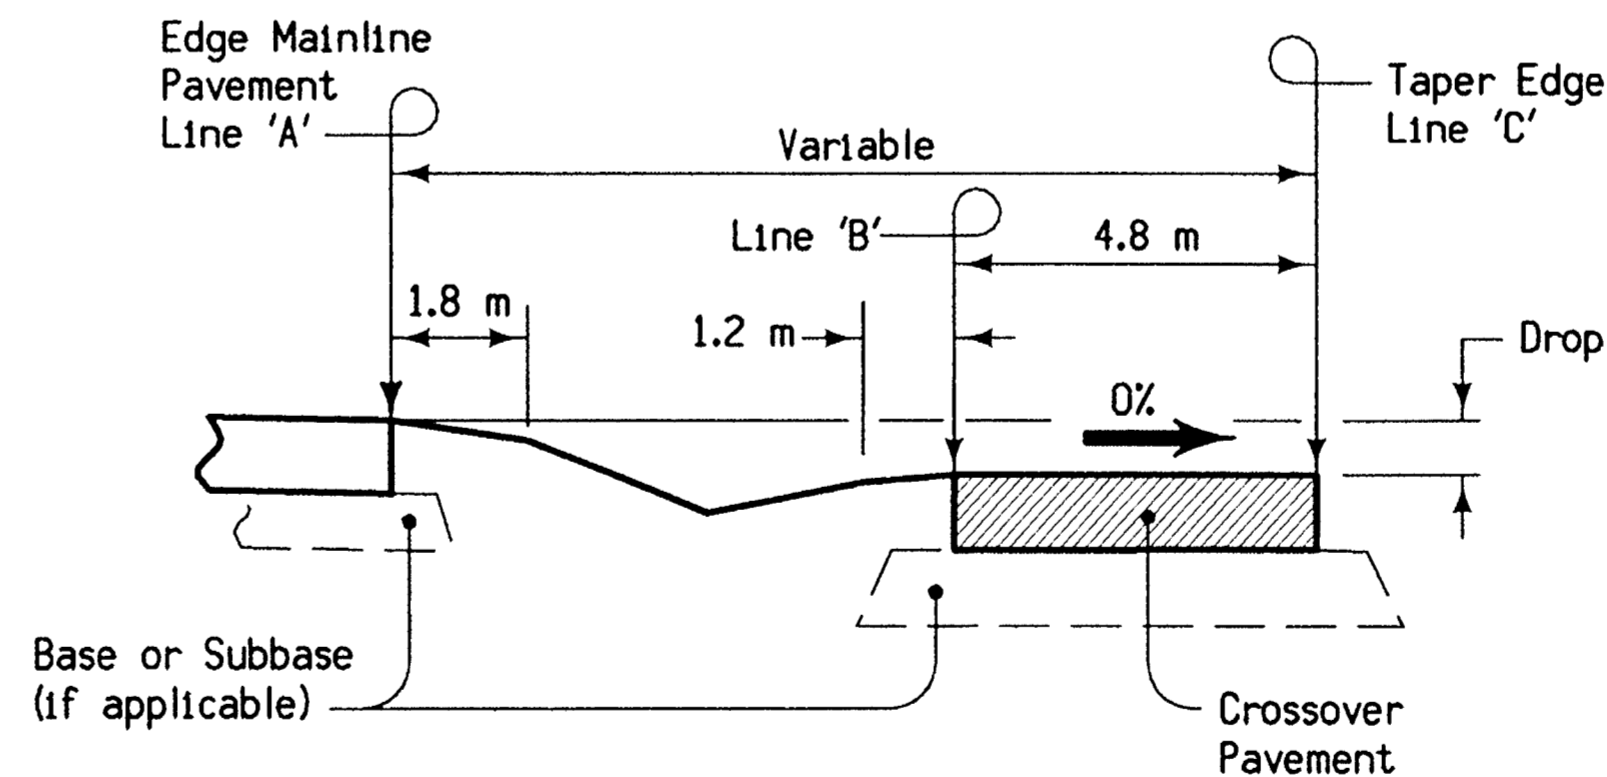

SECTION C-C

Distance	176.76	138.81	120	100	80	60	56.67	50	40	30	20	10	0.0
Offset 'A' to 'C'	0.6	0.6	1.34	2.46	3.91	5.69	6.02	6.71	7.82	9.01	10.27	11.55	12.82
Drop 'A' to 'B'			27	49	78	114	120	134	150	160	164	163	157
Drop 'A' to 'C'	12	12	27	49	78	114	120	134	150	160	164	163	157

GENERAL NOTES:

This detail sheet shows one end of a 4.8 meter crossover for a 20.8 meter wide median. Equivalent distances, dimensions and slopes apply to the opposite end of the crossover. Materials and methods of construction shall be in accordance with current Standard and Supplemental Specifications.

Crossover pavement shall be the same thickness as the mainline pavement. Crossover subbase for both A.C.C. and P.C.C. pavement shall be the same thickness as the mainline subbase.

In order to assure proper drainage, any special shaping of taper area surface between Lines 'A' and 'B' shall be accomplished by methods approved by the Engineer.


Refer to typical cross sections and appropriate Standard Road Plans for design details and requirements for shoulders.

① Refer to Tabulation 104-3.

All dimensions given in millimeters unless noted.

M METRIC VERSION	Project Development Division	
	DETAIL SHEET 531-3	
	REVISION: New	REVISION NO. New REVISION DATE 10-28-97
4.8 m CROSSOVER PAVEMENT TWO-LANE TO FOUR-LANE TRANSITION (20.8 m MEDIAN)		

dcn = I:\WORK\project\34120\cadd\PAVE\51151112.dwg
 pcf = \WATSON\DATA\PLT\PL463P\u01h.prf
 date = Thu Oct 5 15:45:15 2000
 pen table = I:\plot\tables\half.tbl
 levels = 1-19,21-45,47-52,60-63

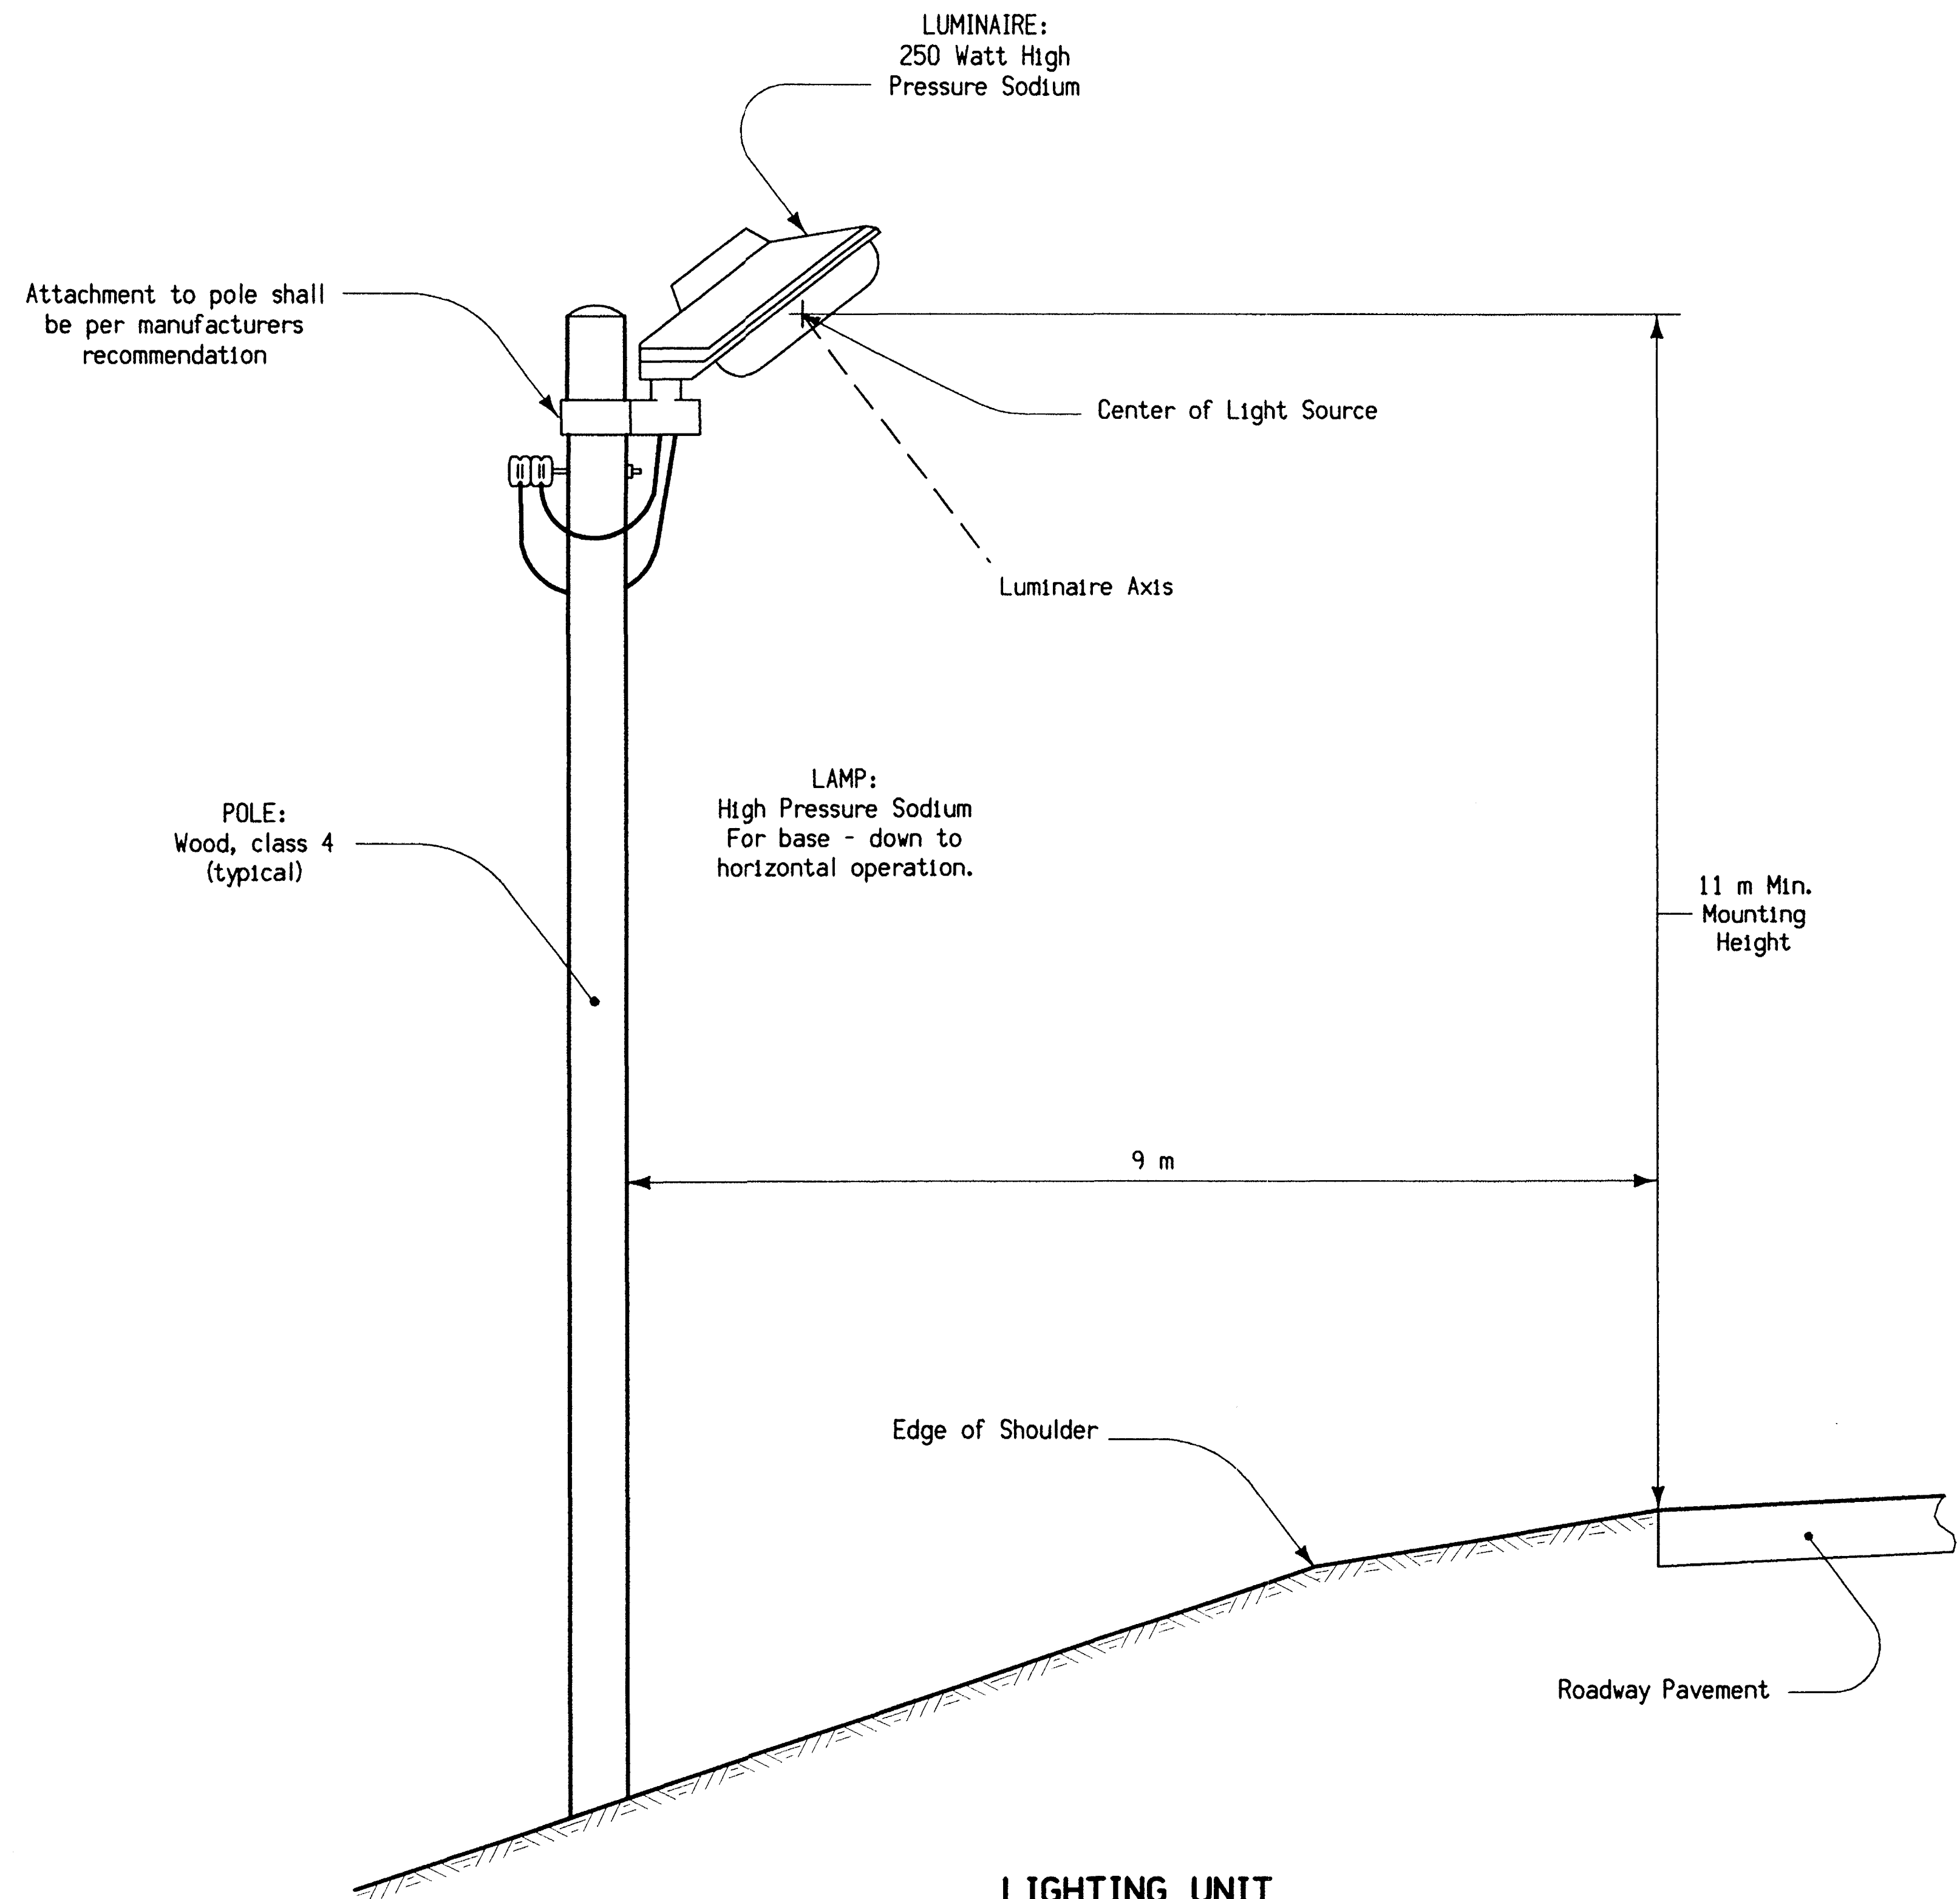

**LIGHTING UNIT
INSTALLATION DETAILS**

GENERAL NOTES:

Temporary floodlighting will be required on this project. The lighting shall conform to current Standard and Supplemental Specifications for floodlighting, Articles 2528.08 and 2528.12 paragraph A (5) except as modified hereon.

Temporary floodlighting shall consist of either a pole mounted luminaire as illustrated hereon or a luminaire mounted on portable type equipment. Location of the temporary floodlighting shall be as shown in the Traffic Control Plan or as determined by the Engineer. The contractor shall determine pole length by field measurement to obtain specified mounting height. Luminaire axis shall be directed to within the limits of the near traffic lane unless specified otherwise.

Proposals for alternatives to the class 4 wood pole used to mount luminaire may be submitted to the Engineer for approval.

The luminaire shall be designed to operate without a mastarm. The "Vector" and "Expressway" luminaire by the Holophane Company, Inc. or the "Interstate" luminaire by the Amerion Electric Division of I.T.T. are the approved luminaires.


Aerial lighting circuits shall be aluminum or A.C.S.R. triplex. Underground lighting circuits shall be type U.S.E. or U.F. All circuit design and materials shall be approved by the engineer before installation commences.

Price bid for "Temporary Floodlighting Luminaire" shall include all cost for furnishing, installing, maintaining and servicing the Temporary Floodlighting Units, all costs for electrical energy, and the cost of removing all lighting materials from the construction site.


All dimensions given in millimeters unless noted.

METRIC VERSION	M		
	Project Development Division		
	DETAIL SHEET		570-2
REVISION: Metric conversion of Detail Sheet 570-2 no. 8 (dated 6-15-93).		REVISION NO. 8	REVISION DATE 03-28-95
TEMPORARY FLOODLIGHTING (OFFSET)			

dgn = I:\WORK\project\34120\cadd\PAVE\57151112.u01
 prf = \WATS01\DA1A\PL01\PL463P.u02h.prf
 date = Thu Oct 5 15:45:24 2000
 pen_table = I:\plot\tables\helf.tbl
 levels = 1-19,21-45,47-52,60-63

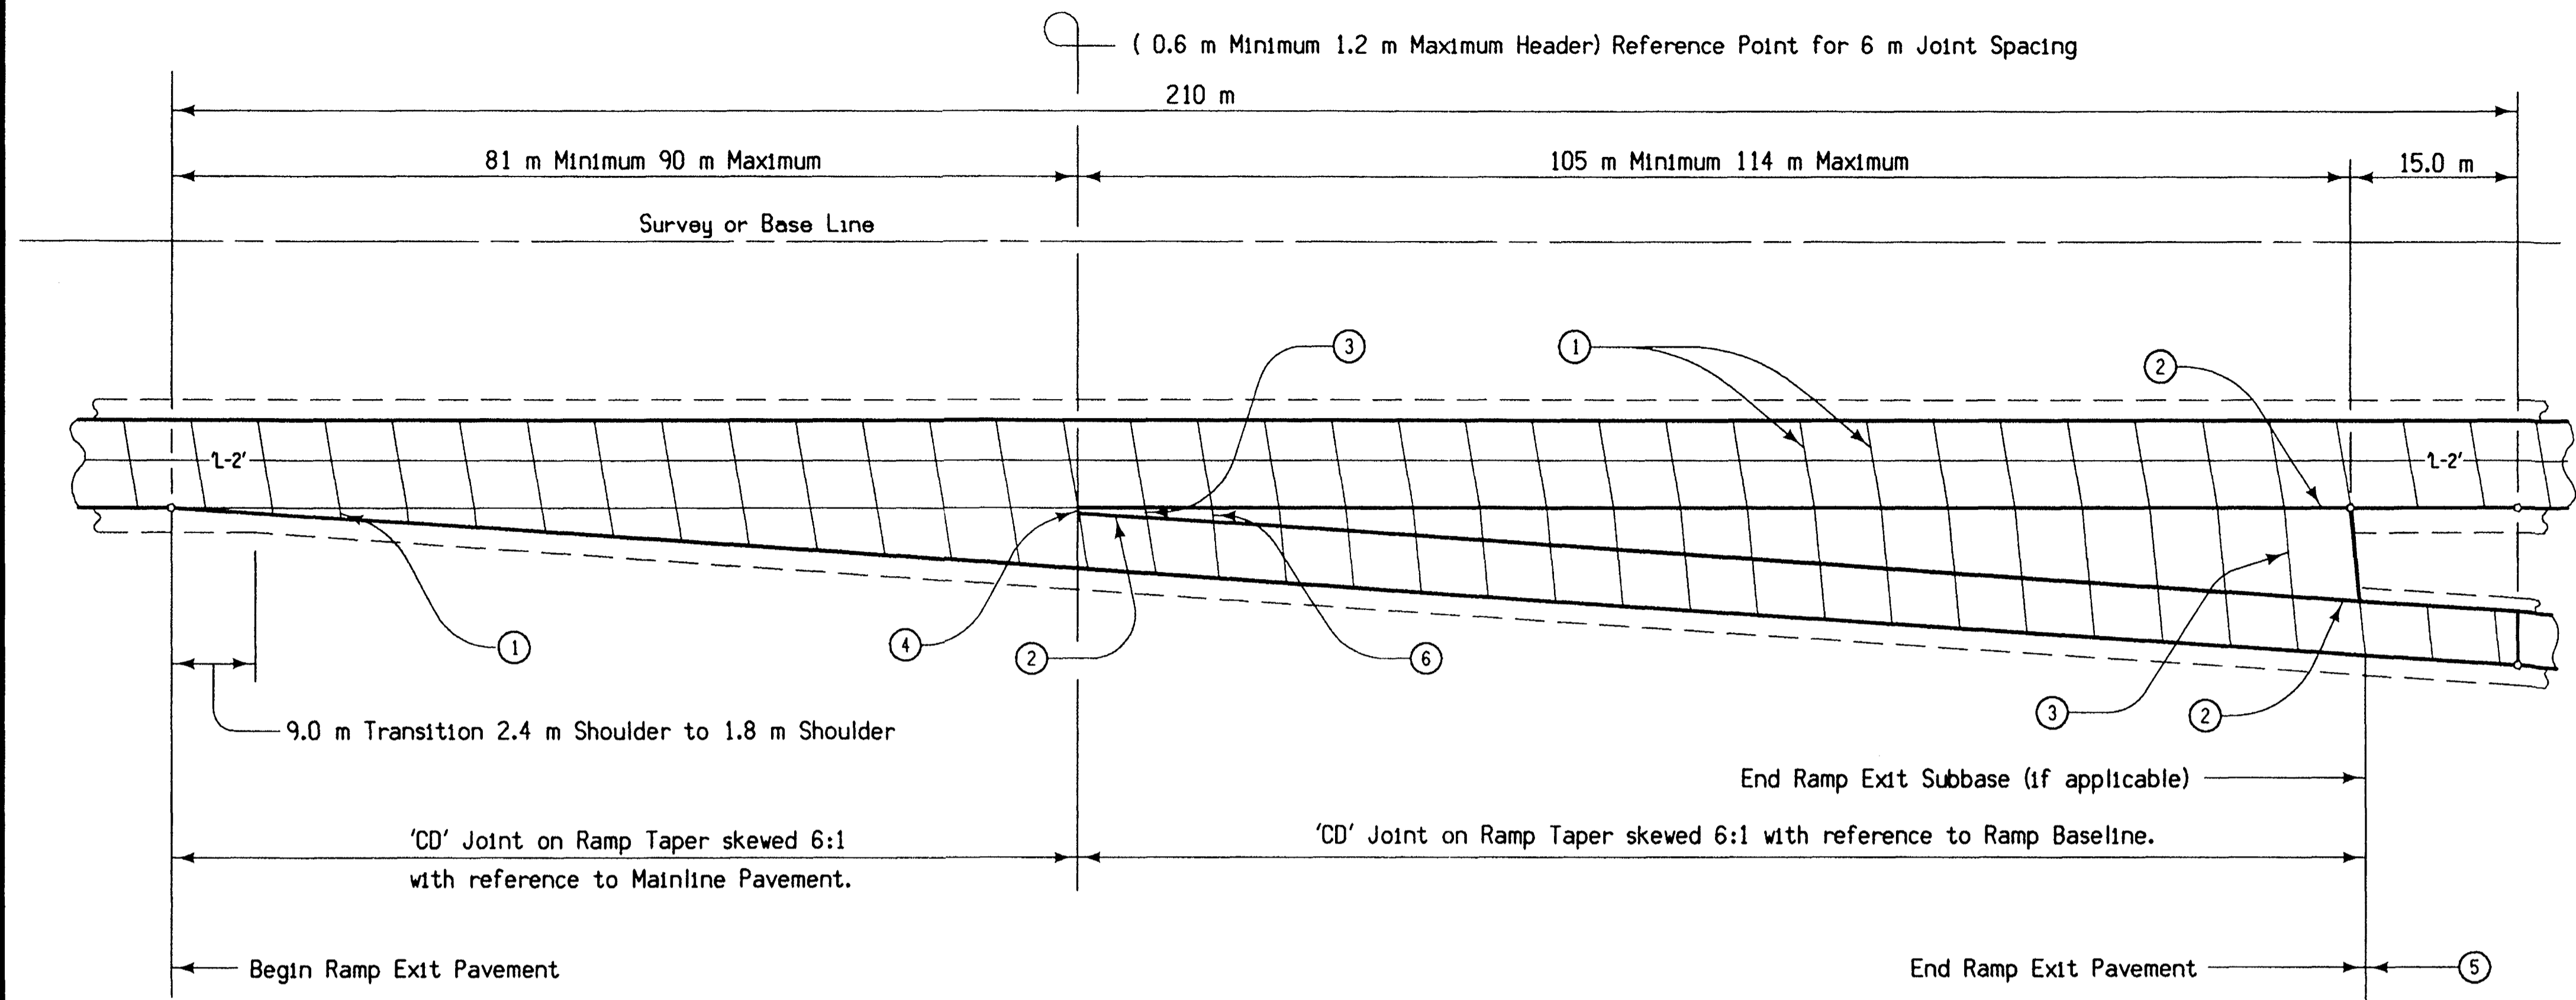

4.8 m EXIT RAMP

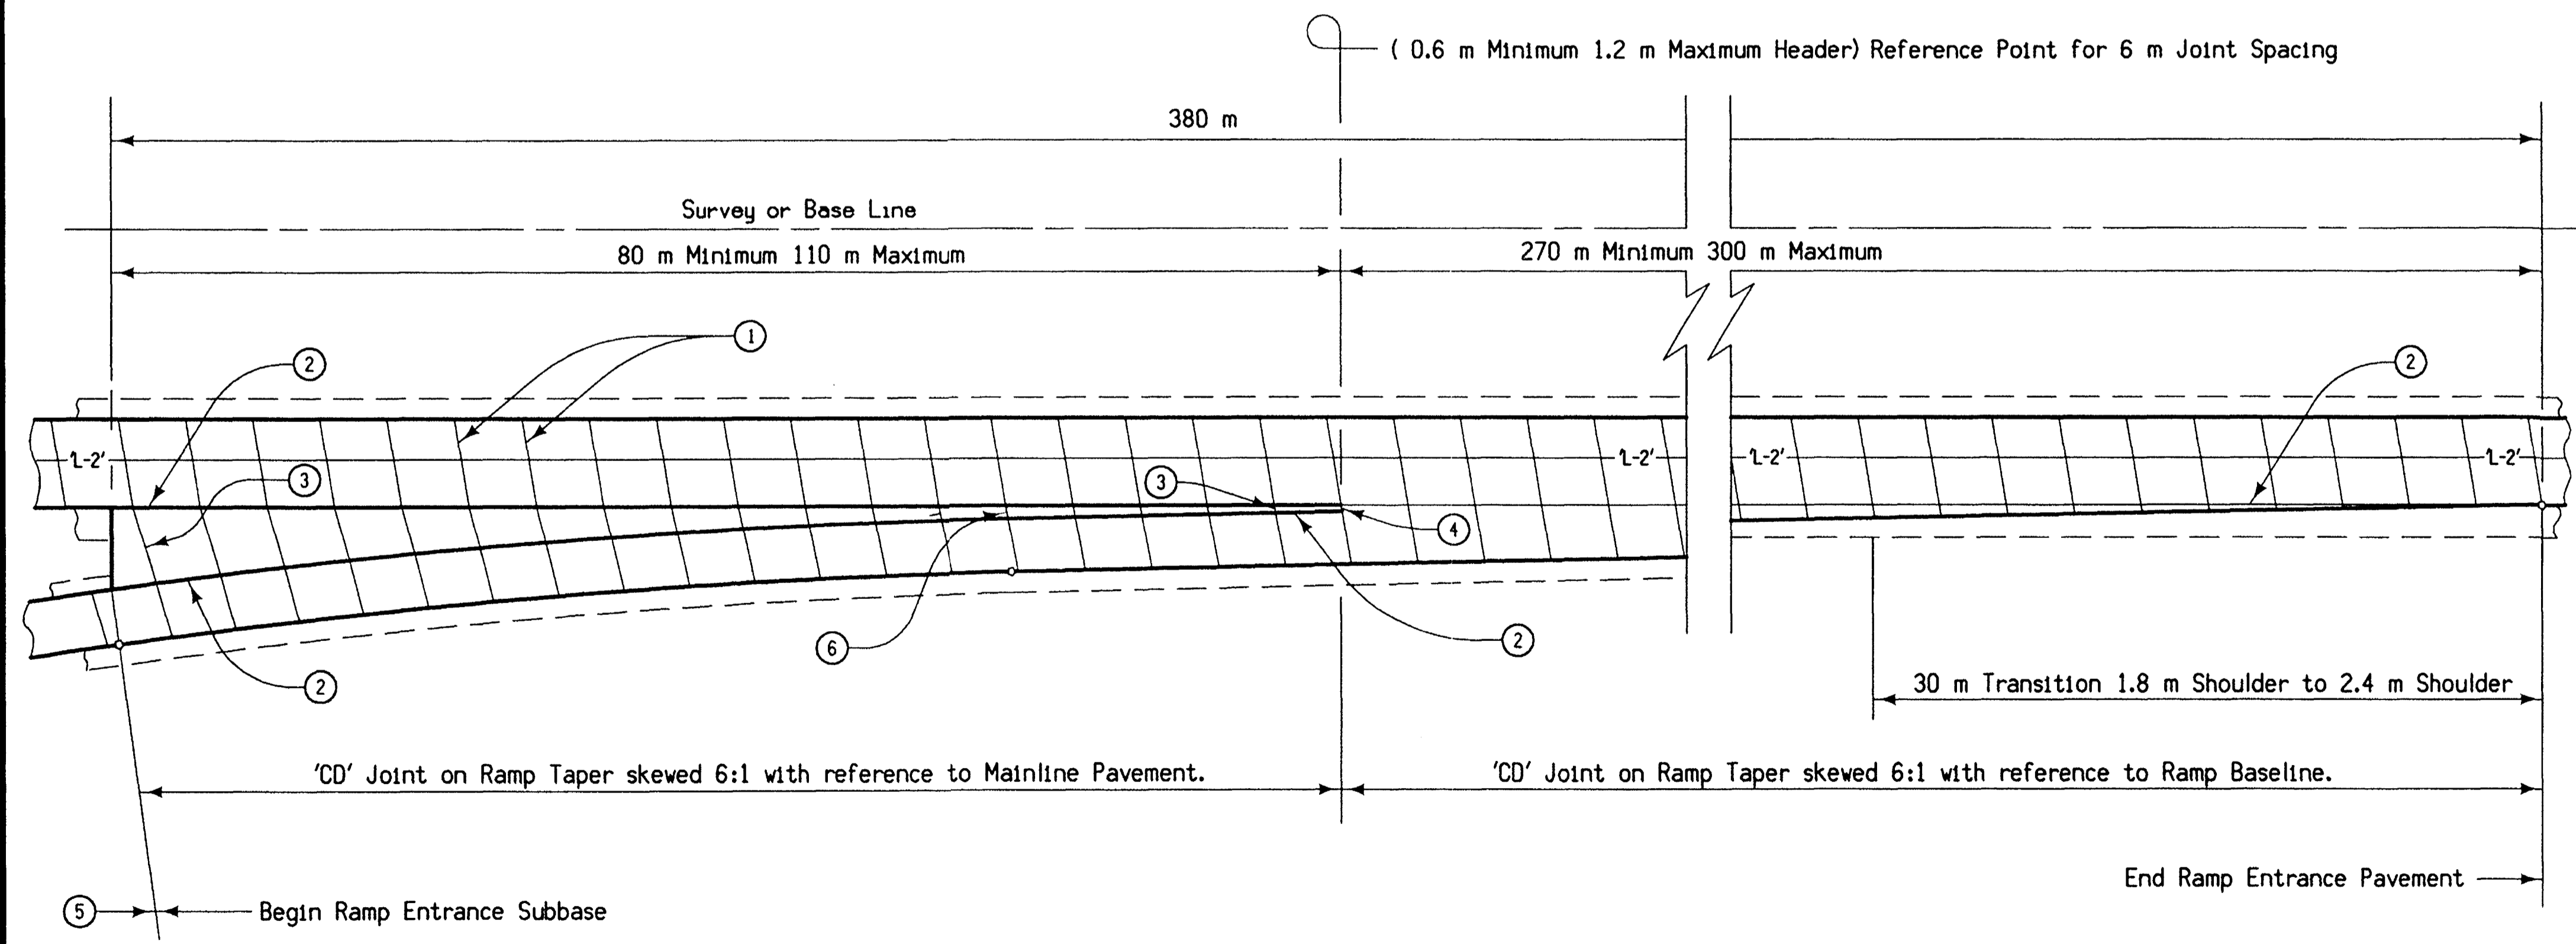

4.8 m ENTRANCE RAMP

GENERAL NOTES:

This plan sheet illustrates the jointing layouts for 4.8 meter exit and entrance ramps. Details are typical. Alternate methods of construction may be submitted to the Engineer for approval.

Materials and methods of construction shall be in accordance with current Standard and Supplemental Specifications.

Refer to Standard Road Plans RH-50, RH-51 and RH-52 for details of construction of pavement joints.

Refer to the appropriate Detail Sheets for the geometric layout and taper profile elevations.

No payment will be made for jointing as detailed on this sheet. The cost of jointing as indicated shall be considered incidental to "Standard or Slip Form Portland Cement Concrete Pavement".

- SUGGESTED CONSTRUCTION SEQUENCE**
1. Mainline Pavement
 2. Ramp Pavement
 3. Ramp Exit Pavement or Ramp Entrance Pavement


- SPECIAL NOTES:**
- ① All mainline transverse joints through the taper shall be 'CD' Joints skewed at 6:1 right ahead and shall be nominally spaced at 6 m intervals. See Standard Road Plan RH-50 for details of joint construction.
 - ② 'BT-2' or 'KT-2' Joint. Refer to Standard Road Plan RH-51 for details of joint construction.
 - ③ 'C' Joint, refer to Standard Road Plan RH-50 for details of joint construction.
 - ④ 'B' Joint, refer to Standard Road Plan RH-50 for details of joint construction.
 - ⑤ Refer to Detail Project Plans for ramp jointing.
 - ⑥ The transverse joints on the ramp shall be skewed 6:1 with reference to the ramp baseline where the gore area is 1.2 meters or greater.

All dimensions given in millimeters unless noted.


METRIC VERSION	M		<i>Project Development Division</i>	
	DETAIL SHEET		550-5	
	REVISION: Revise shoulder width from 2.3 m to 2.4 m.		REVISION NO. 3	REVISION DATE 04-25-00
TYPICAL JOINTING DETAILS FOR 4.8 m EXIT AND ENTRANCE RAMP				

dgn = I:\WORK\PROJECTS\34120\cadd\PAVE\5/151112.u01
 levels = 1-19,21-45,47-52,60-63
 prf = \\WATSON1\DATA\PLD\PL-463\U03h.prf
 date = Thu Oct 5 15:45:30 2000
 pen table = I:\plot\tables\harrfw.tbl

dgn = I:\WORK\project\3412\U\cead\PAVE\3/15/11\12.u01
 prf = \\WAT501\DATA\PLT\PL463P\u04h.prf
 date = Thu Oct 5 15:45:37 2000
 levels = 1-19,21-45,47-52,60-63
 plot table = I:\plot\tables\h1fwt.tbl

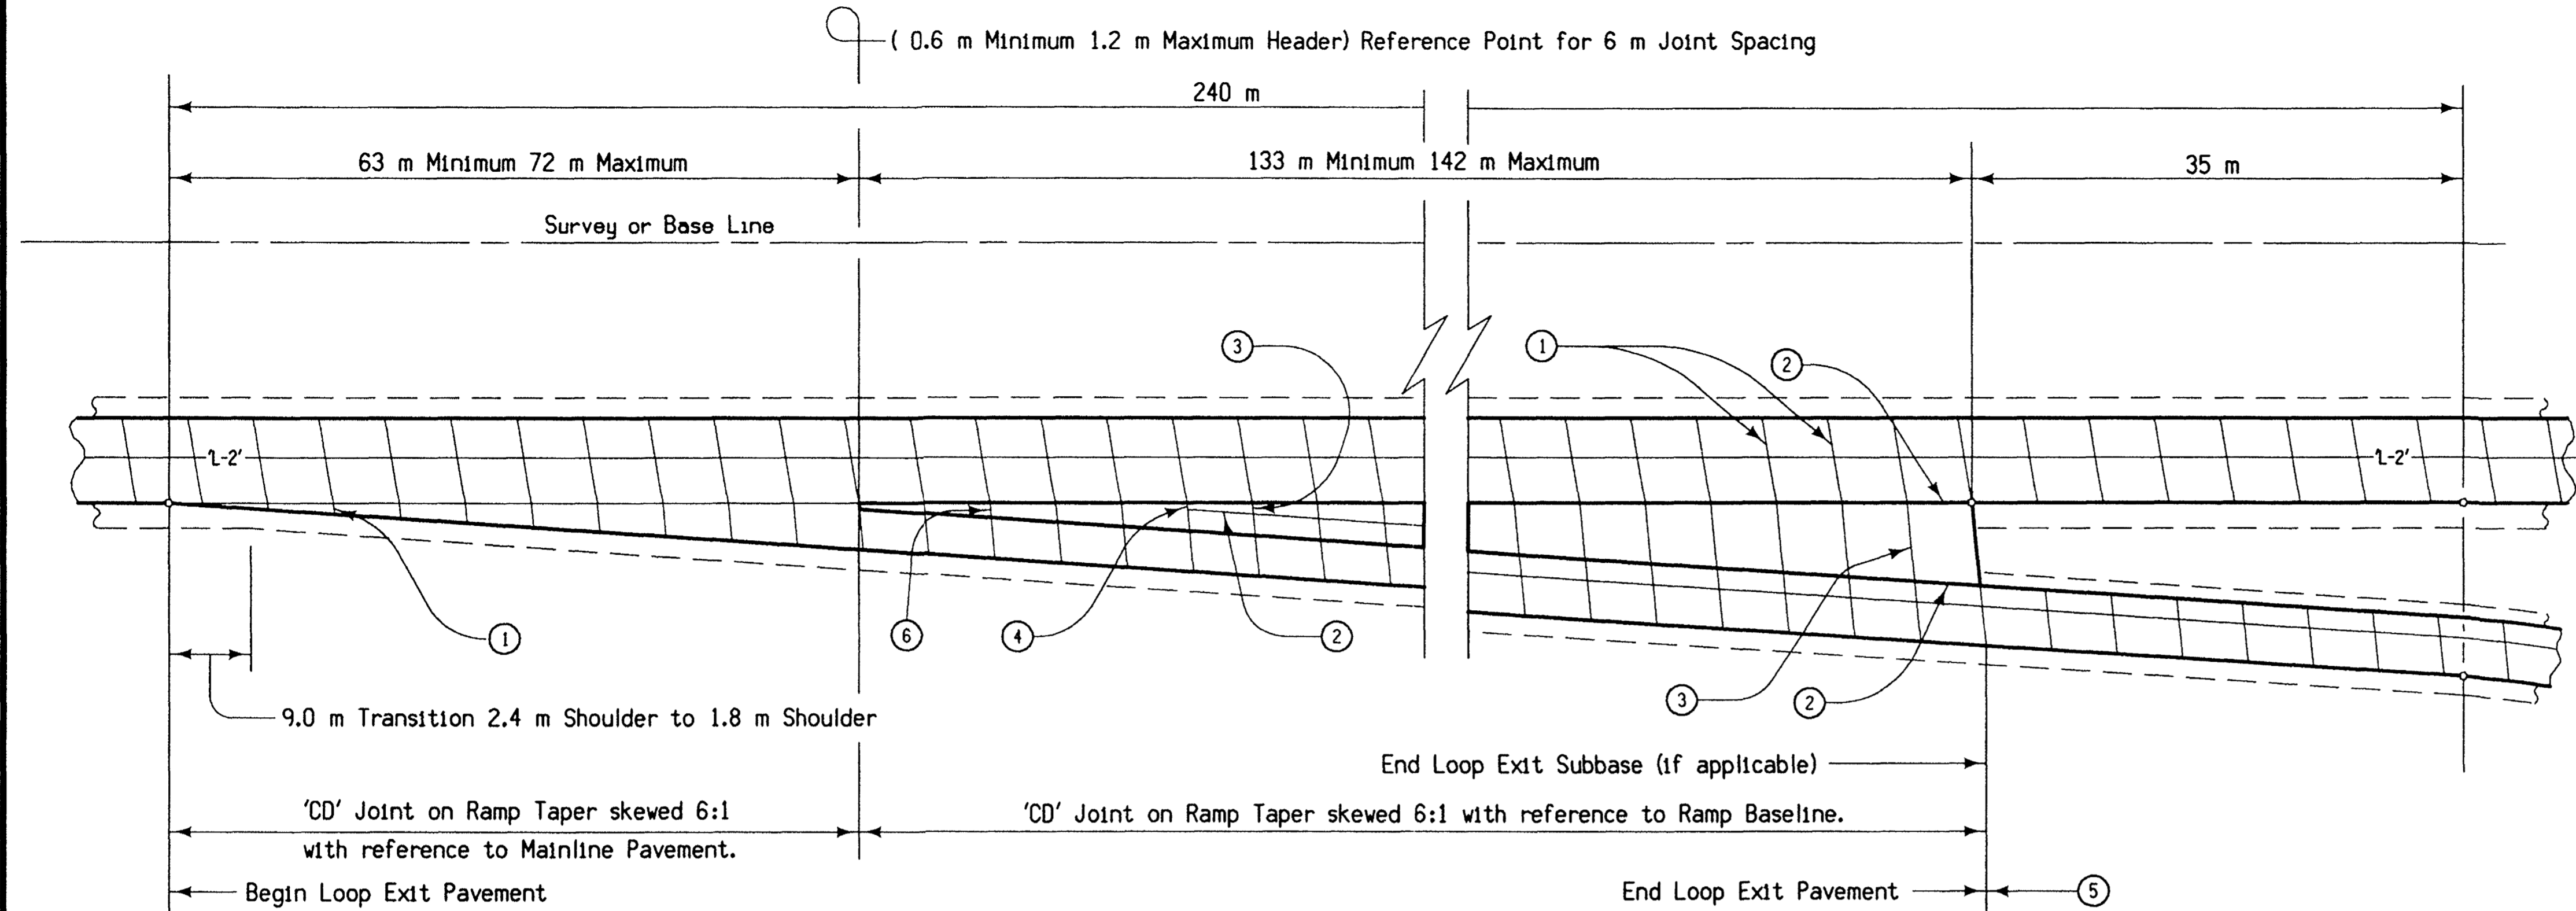

5.5 m EXIT LOOP

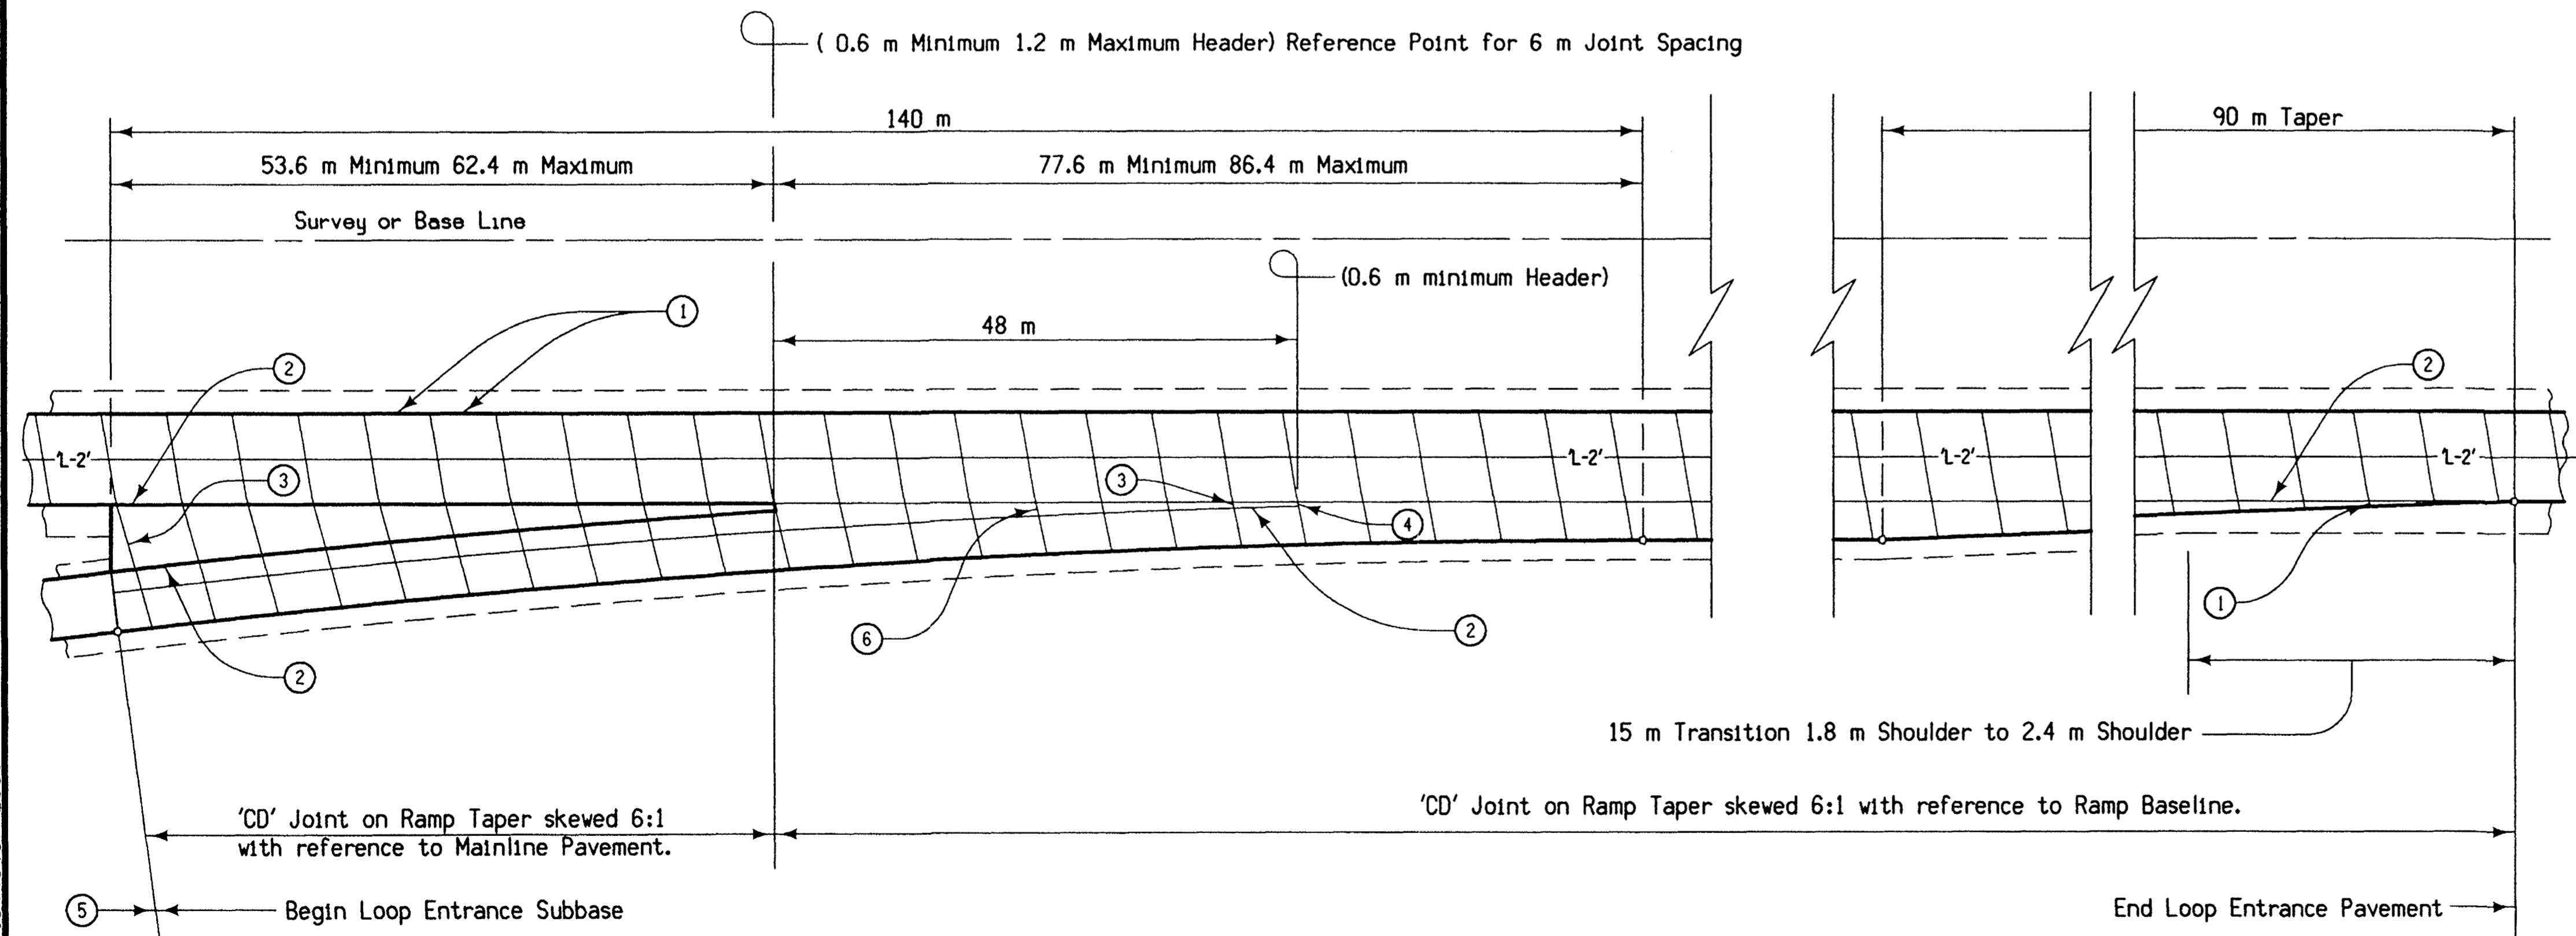

5.5 m ENTRANCE LOOP

GENERAL NOTES:

This plan sheet illustrates the jointing layouts for 5.5 meter exit and entrance loops. Details are typical. Alternate methods of construction may be submitted to the Engineer for approval.

Materials and methods of construction shall be in accordance with current Standard and Supplemental Specifications.

Refer to Standard Road Plans RH-50, RH-51 and RH-52 for details of construction of pavement joints.

Refer to the appropriate Detail Sheets for the geometric layout and taper profile elevations.

No payment will be made for jointing as detailed on this sheet. The cost of jointing as indicated shall be considered incidental to "Standard or Slip Form Portland Cement Concrete Pavement".

- SUGGESTED CONSTRUCTION SEQUENCE**
1. Mainline Pavement
 2. Loop Pavement
 3. Loop Exit Pavement or Loop Entrance Pavement


- SPECIAL NOTES:**
- 1 All mainline transverse joints through the taper shall be 'CD' Joints skewed at 6:1 right ahead and shall be nominally spaced at 6 m intervals. See Standard Road Plan RH-50 for details of joint construction.
 - 2 'BT-2' or 'KT-2' Joint. Refer to Standard Road Plan RH-51 for details of joint construction.
 - 3 'C' Joint, refer to Standard Road Plan RH-50 for details of joint construction.
 - 4 'B' Joint, refer to Standard Road Plan RH-50 for details of joint construction.
 - 5 Refer to Detail Project Plans for ramp jointing.
 - 6 The transverse joints on the ramp shall be skewed 6:1 with reference to the ramp baseline where the gore area is 1.2 meters or greater.

All dimensions given in millimeters unless noted.

M METRIC VERSION	Project Development Division	
	DETAIL SHEET 550-6	
	REVISION:	REVISION NO. REVISION DATE
	3	04-25-00
TYPICAL JOINTING DETAILS FOR 5.5 m EXIT AND ENTRANCE LOOP		

FRONT FACING SIGNS

Direction of Marking →

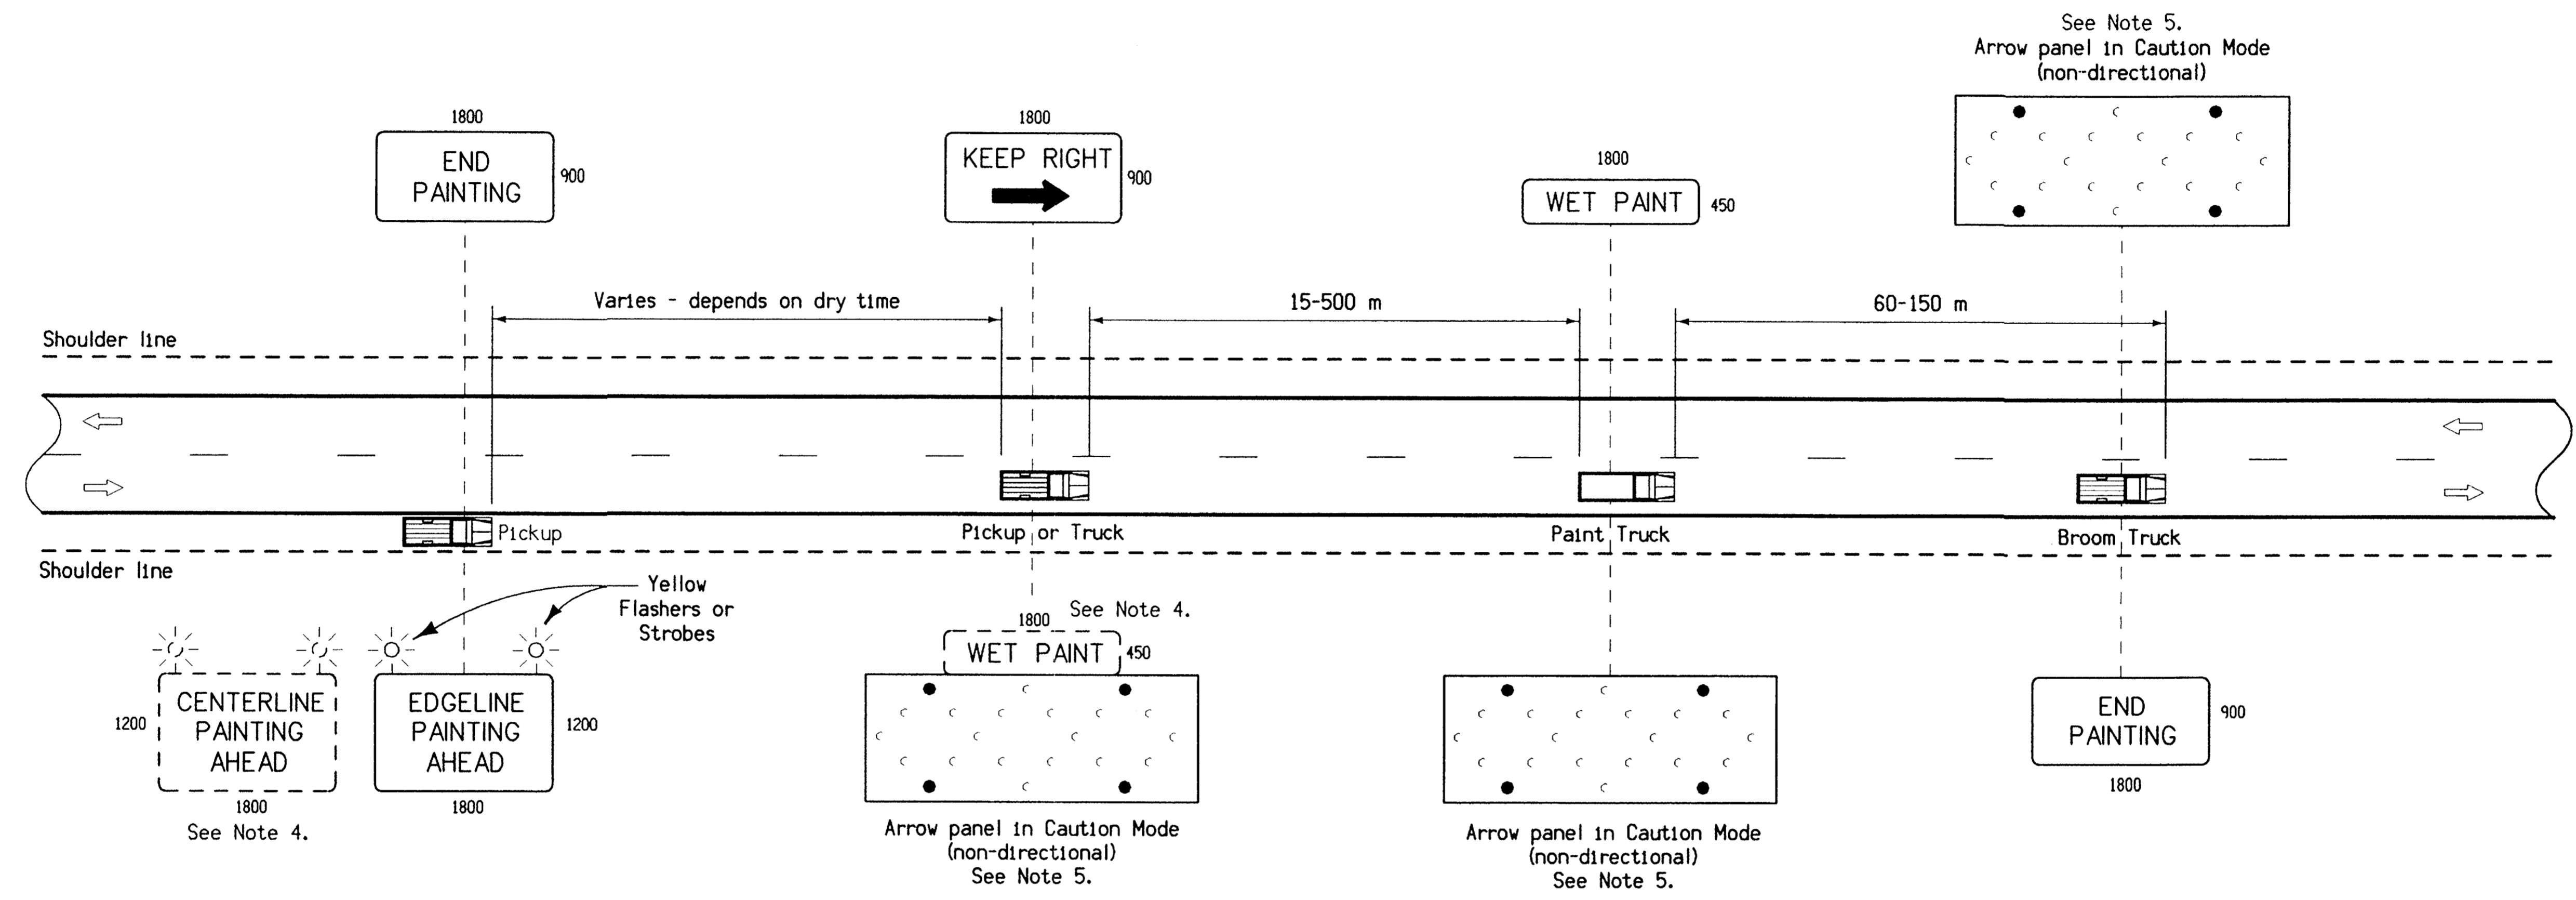

REAR FACING SIGNS

GENERAL NOTES:


1. All signs shall have an orange background with black legend.
2. Flagger(s) should be used at primary road junctions or as necessary to control traffic.
3. Arrow panels shall meet the requirements of a Type 'C' Arrow Display as specified in the MUTCD and current Standard and Supplemental Specifications.
4. This layout may be used to place centerline pavement markings. When used to paint centerline markings, the "EDGE LINE PAINTING AHEAD" sign shall be changed to a "CENTERLINE PAINTING AHEAD" sign. A "WET PAINT" sign shall be mounted on the vehicle behind the paint truck.
5. A yellow strobe or revolving light may be substituted for this arrow panel.

All dimensions given in millimeters unless noted.

M METRIC VERSION	<i>Project Development Division</i>	
	DETAIL SHEET	520-41
	REVISION: Add "CENTERLINE" to title block.....	REVISION NO. REVISION DATE 3 04-27-99
TRAFFIC CONTROL FOR EDGELINE AND CENTERLINE MARKINGS ON TWO-LANE ROADWAYS		

ALL SIGNS REAR FACING

Direction of Marking

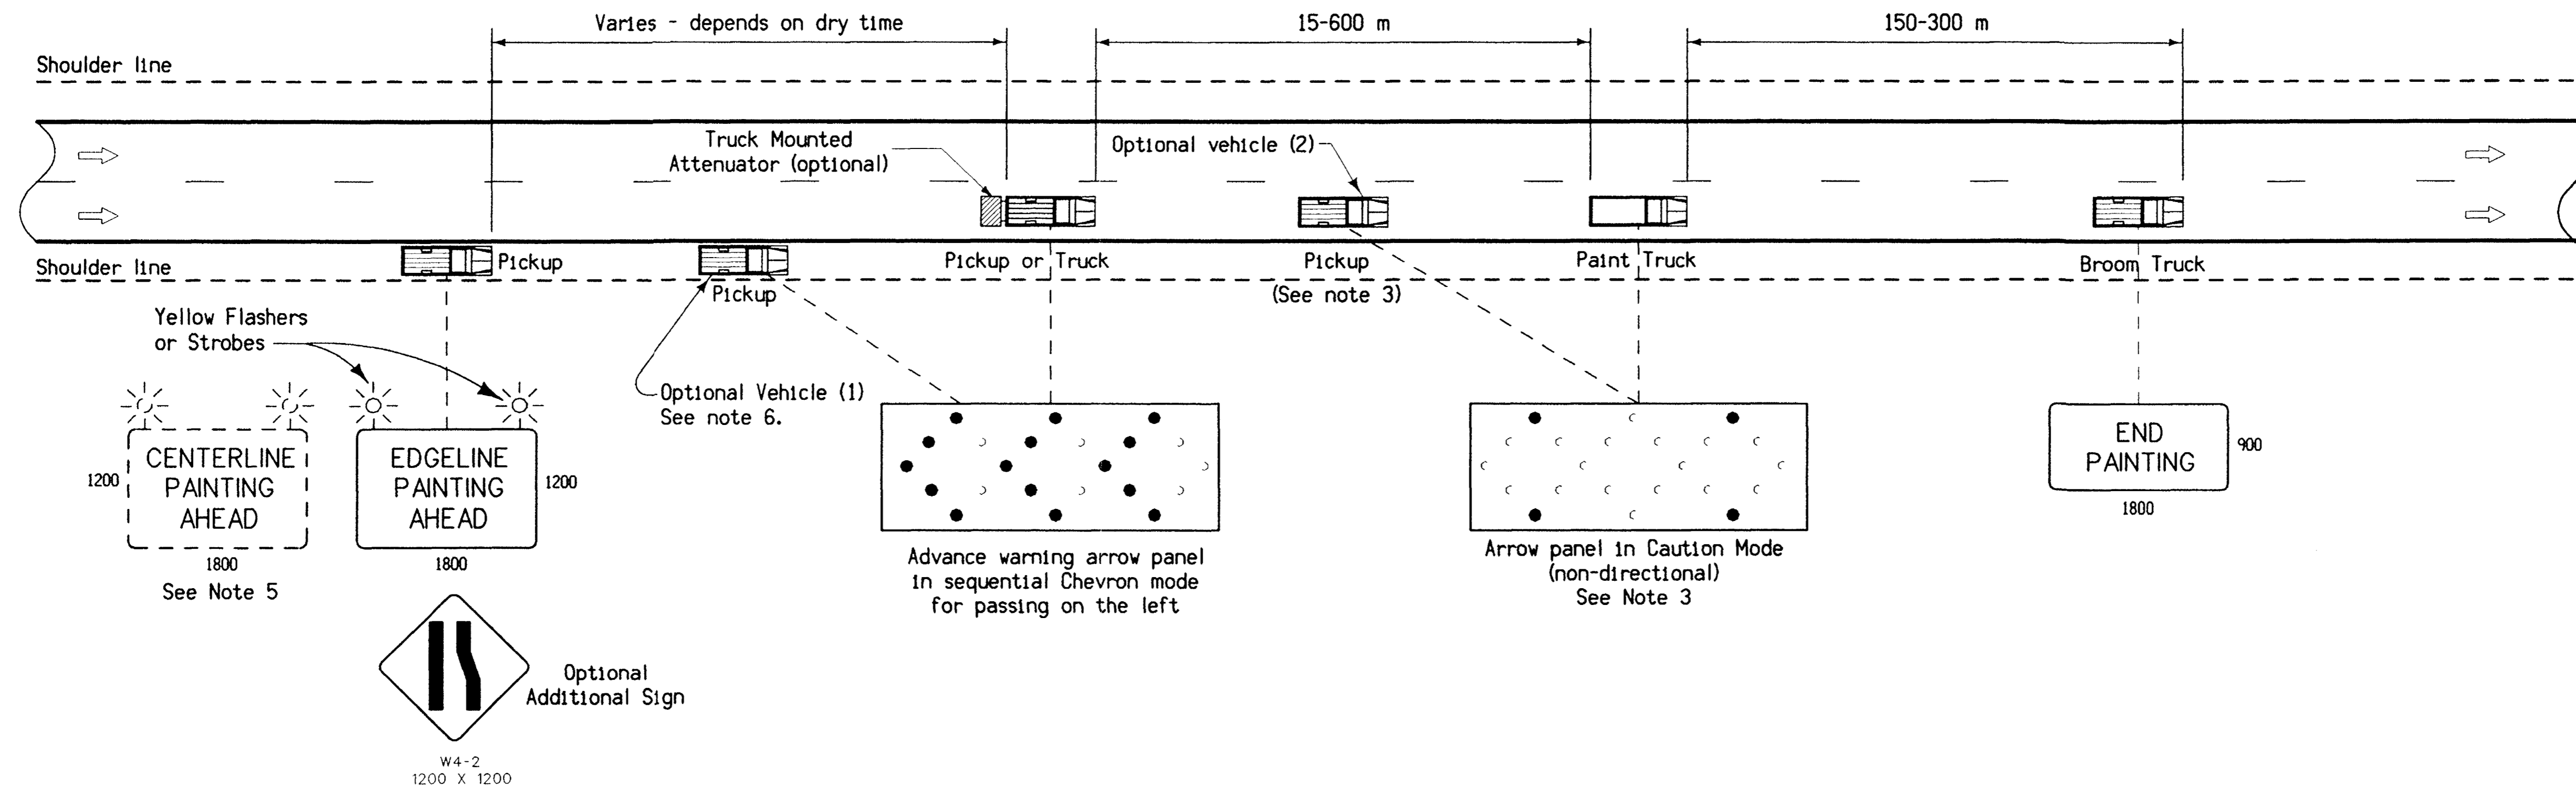

GENERAL NOTES:

1. All signs shall have an orange background with black legend.
2. Signs are illustrated for placing the right edgeline. When placing a left (median) edgeline, signs shall indicate passing on the right.
3. The arrow panel on the optional vehicle (2) may be used in the sequential chevron mode on divided roadways only. This arrow panel shall be operated in the caution mode when used on undivided roadways or when optional vehicle (1) is used. A yellow strobe or revolving light may be substituted for this arrow panel.
4. Arrow panels shall meet the requirements of a Type 'C' Arrow Display as specified in the MUTCD and current Standard and Supplemental Specifications.
5. This layout may be used to place lane line pavement markings. When used to paint lane line markings, the "EDGELINE PAINTING AHEAD" sign shall be changed to a "CENTERLINE PAINTING AHEAD" sign.
6. Optional vehicle (1) may be used on divided roadways only.

All dimensions given in millimeters unless noted.

M METRIC VERSION	<i>Project Development Division</i>	
	DETAIL SHEET	521-41
	REVISION: Add "CENTERLINE" to title block,.....	REVISION NO. REVISION DATE 4 04-27-99
TRAFFIC CONTROL FOR EDGELINE AND CENTERLINE MARKINGS ON MULTI-LANE DIVIDED OR UNDIVIDED ROADWAYS		

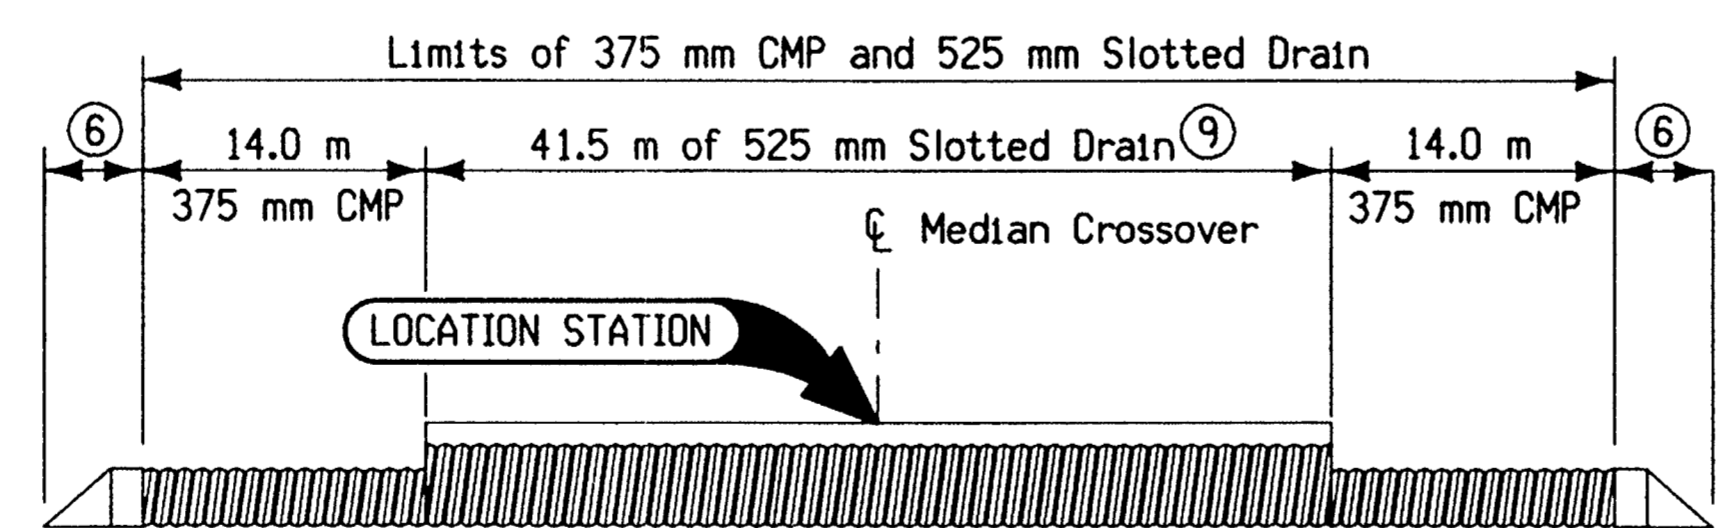
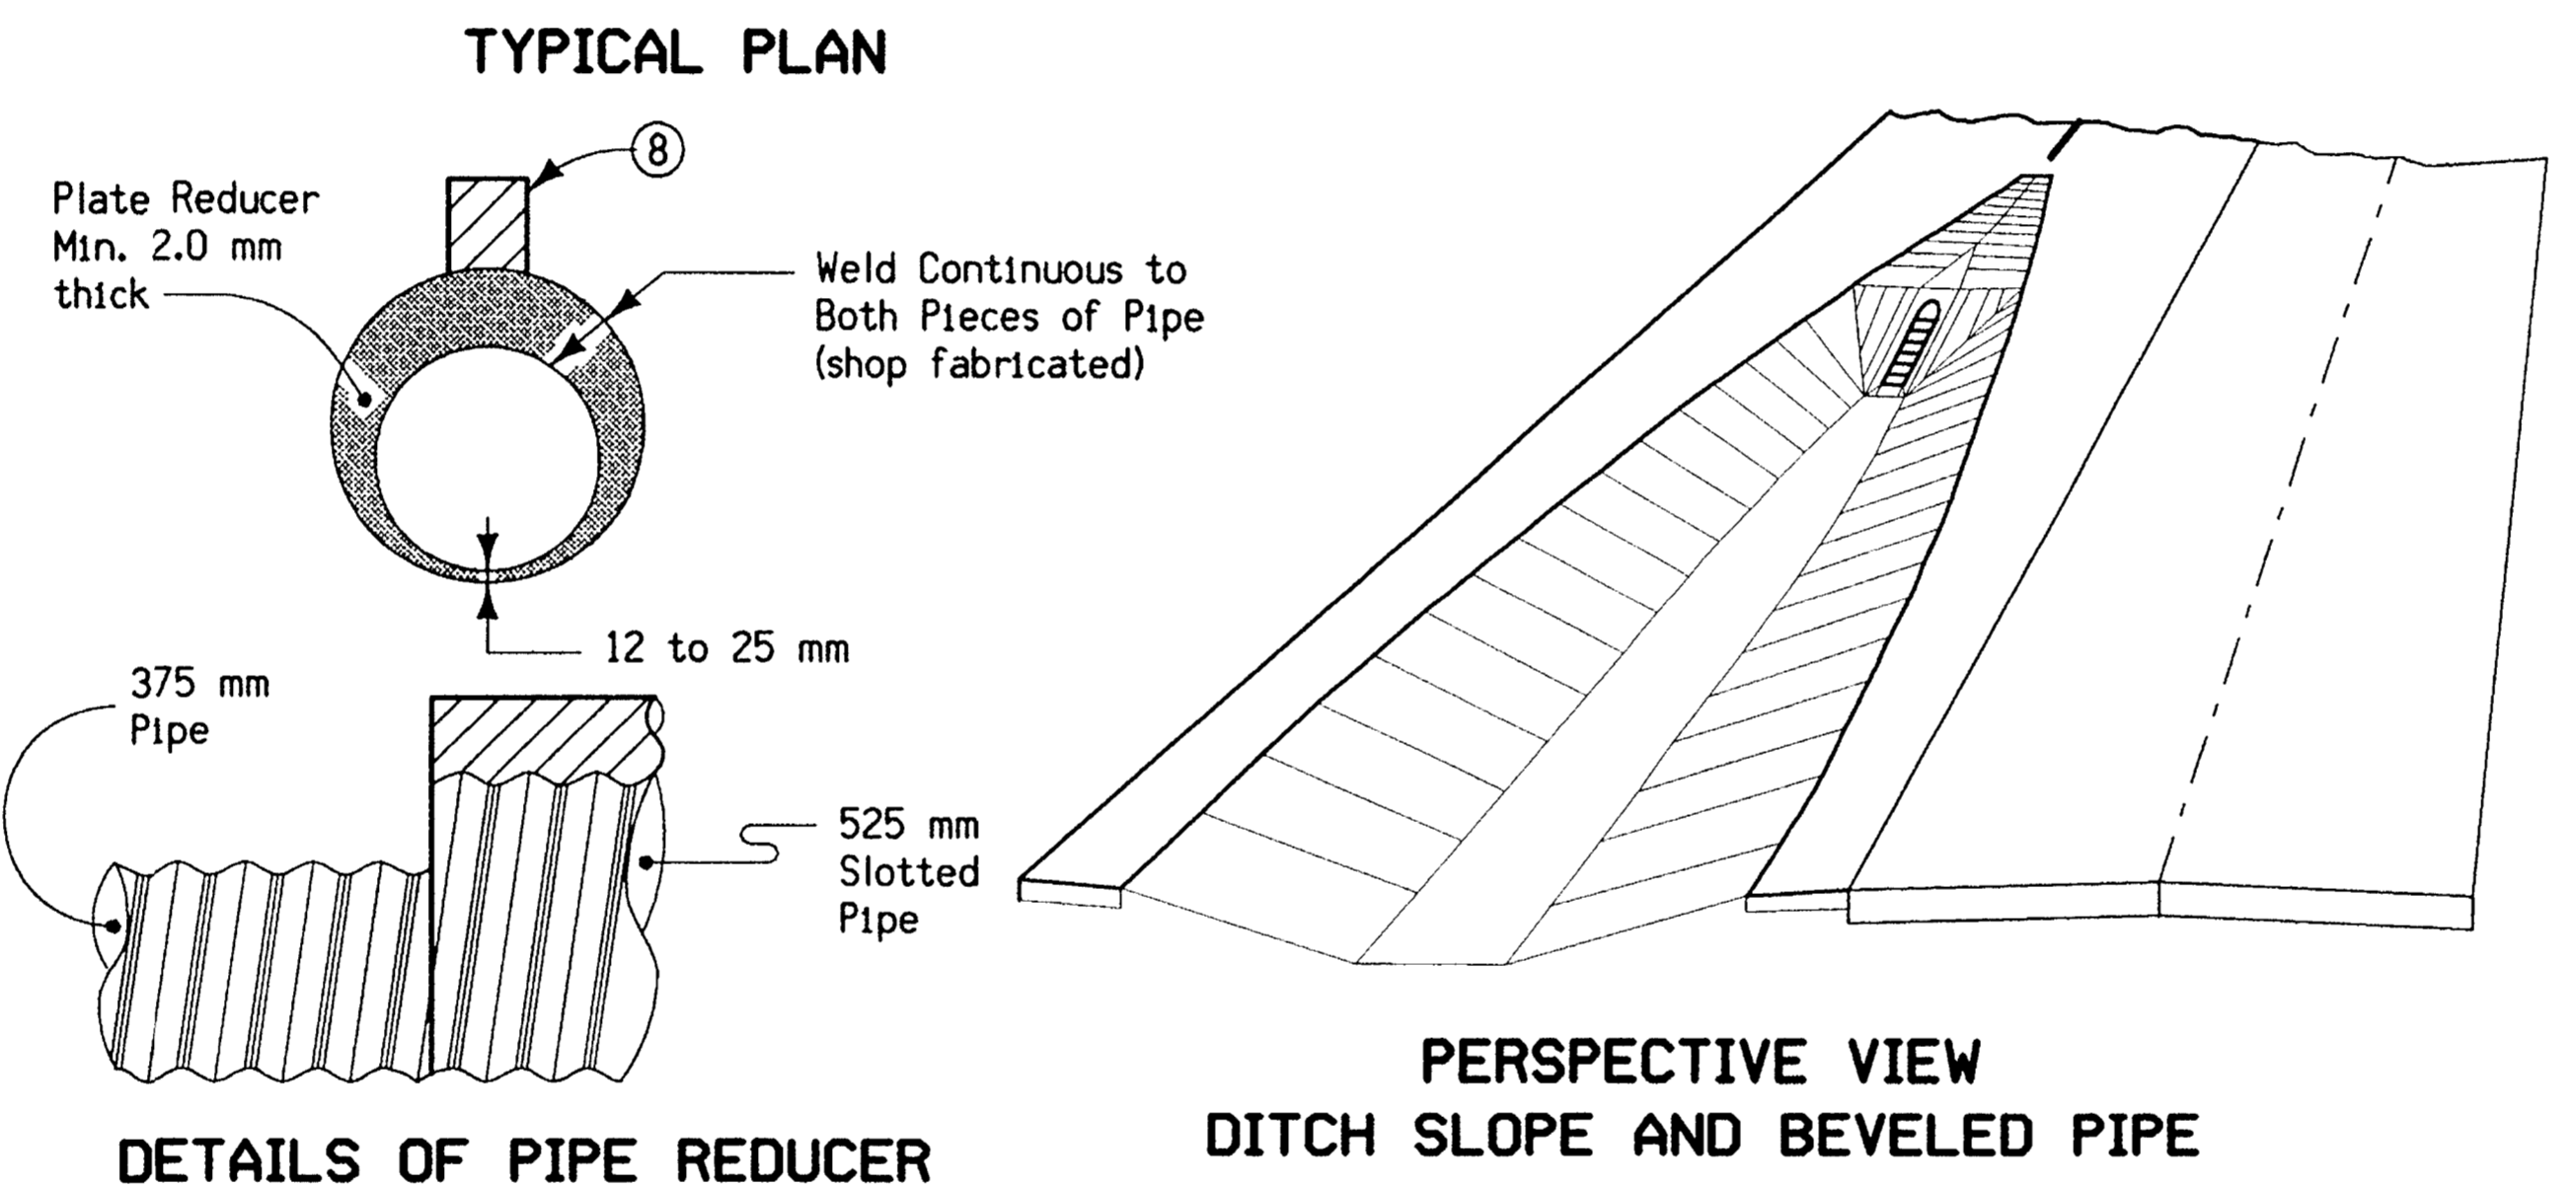
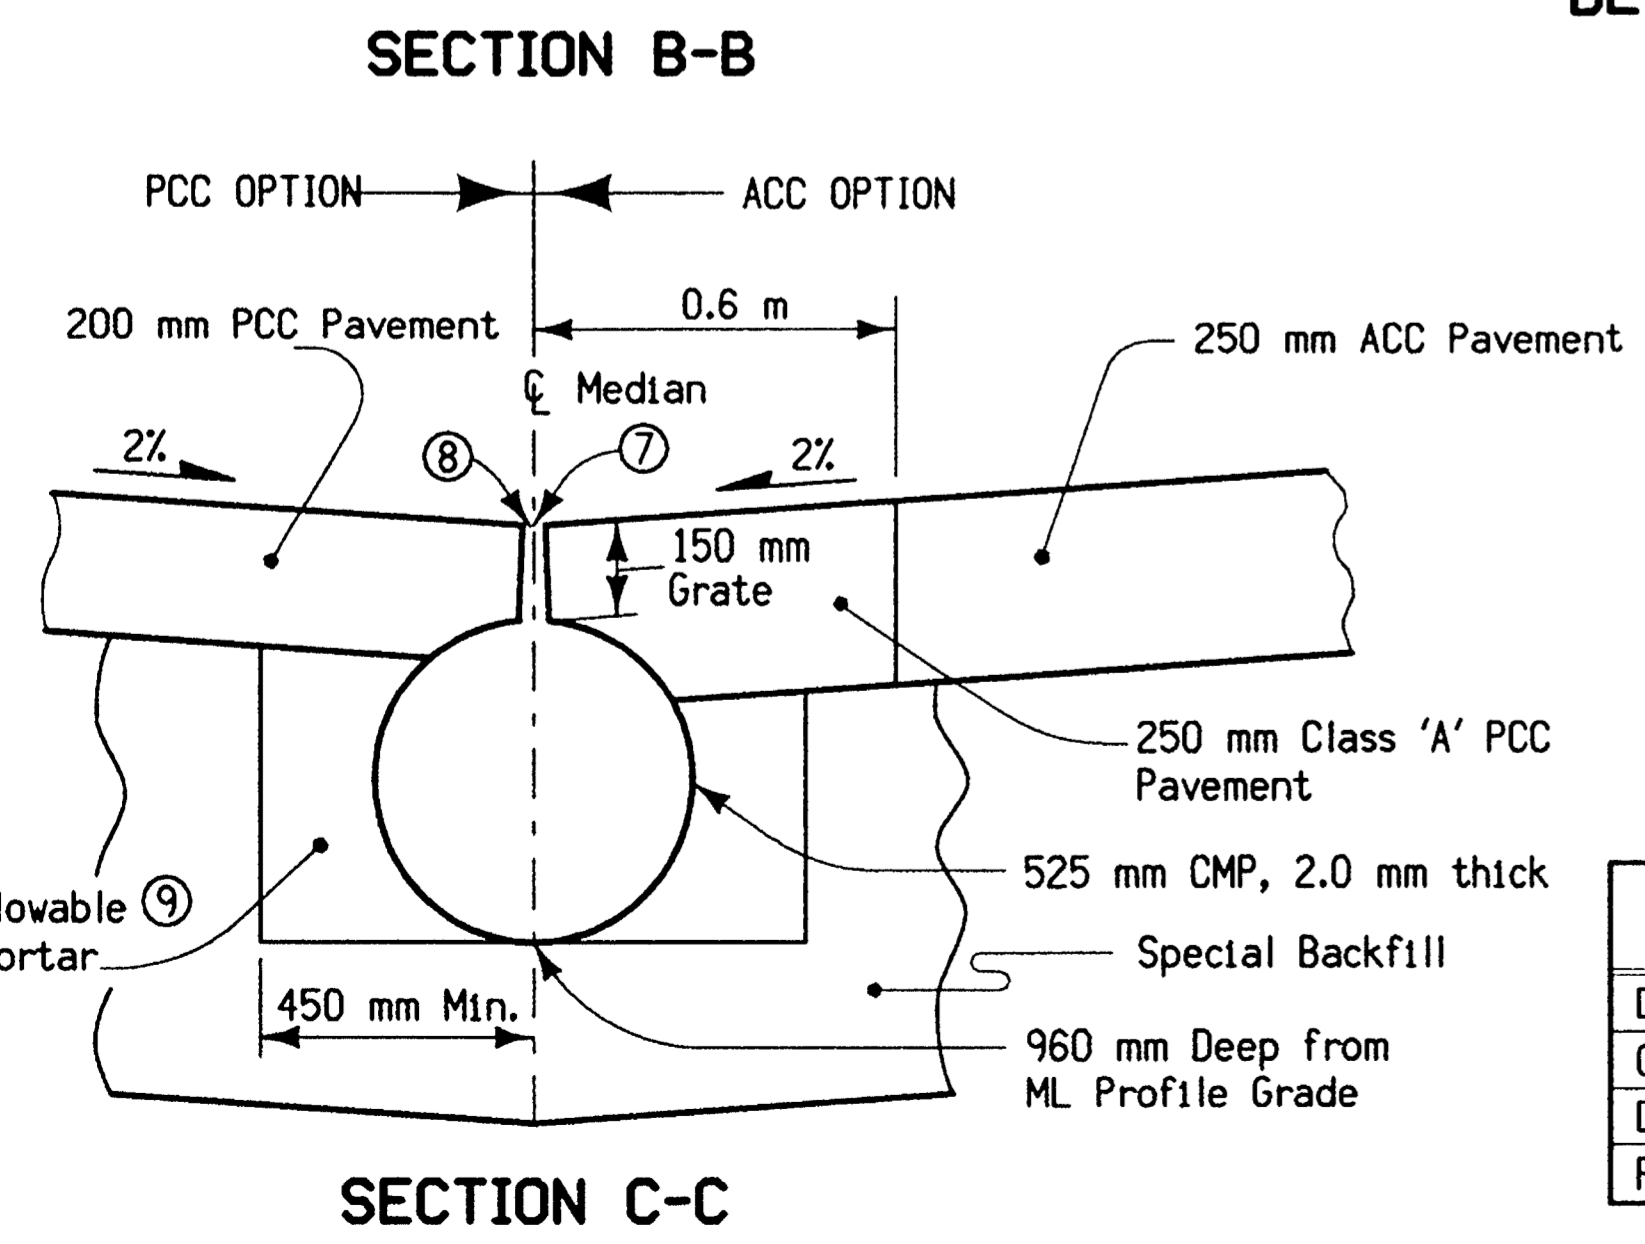
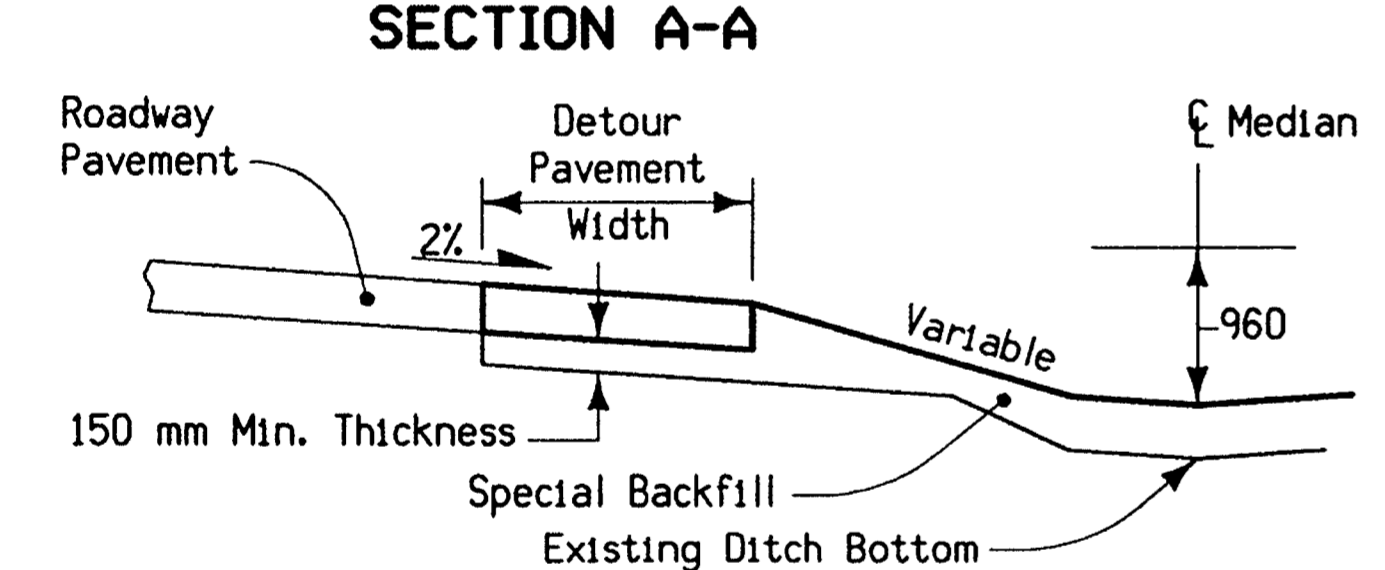
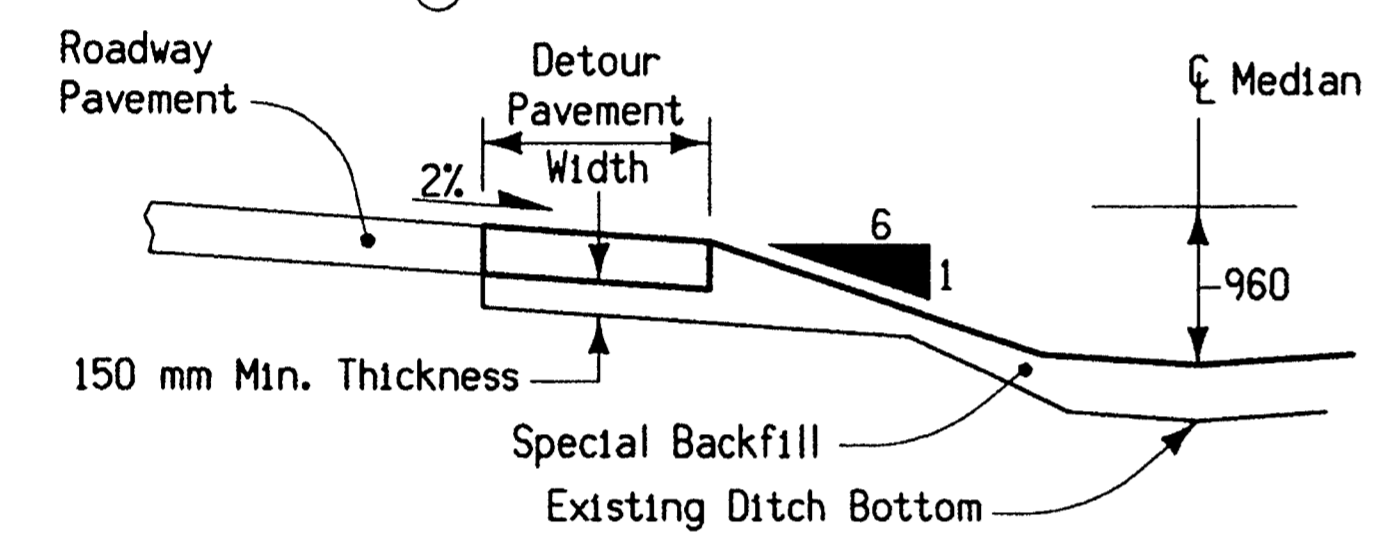
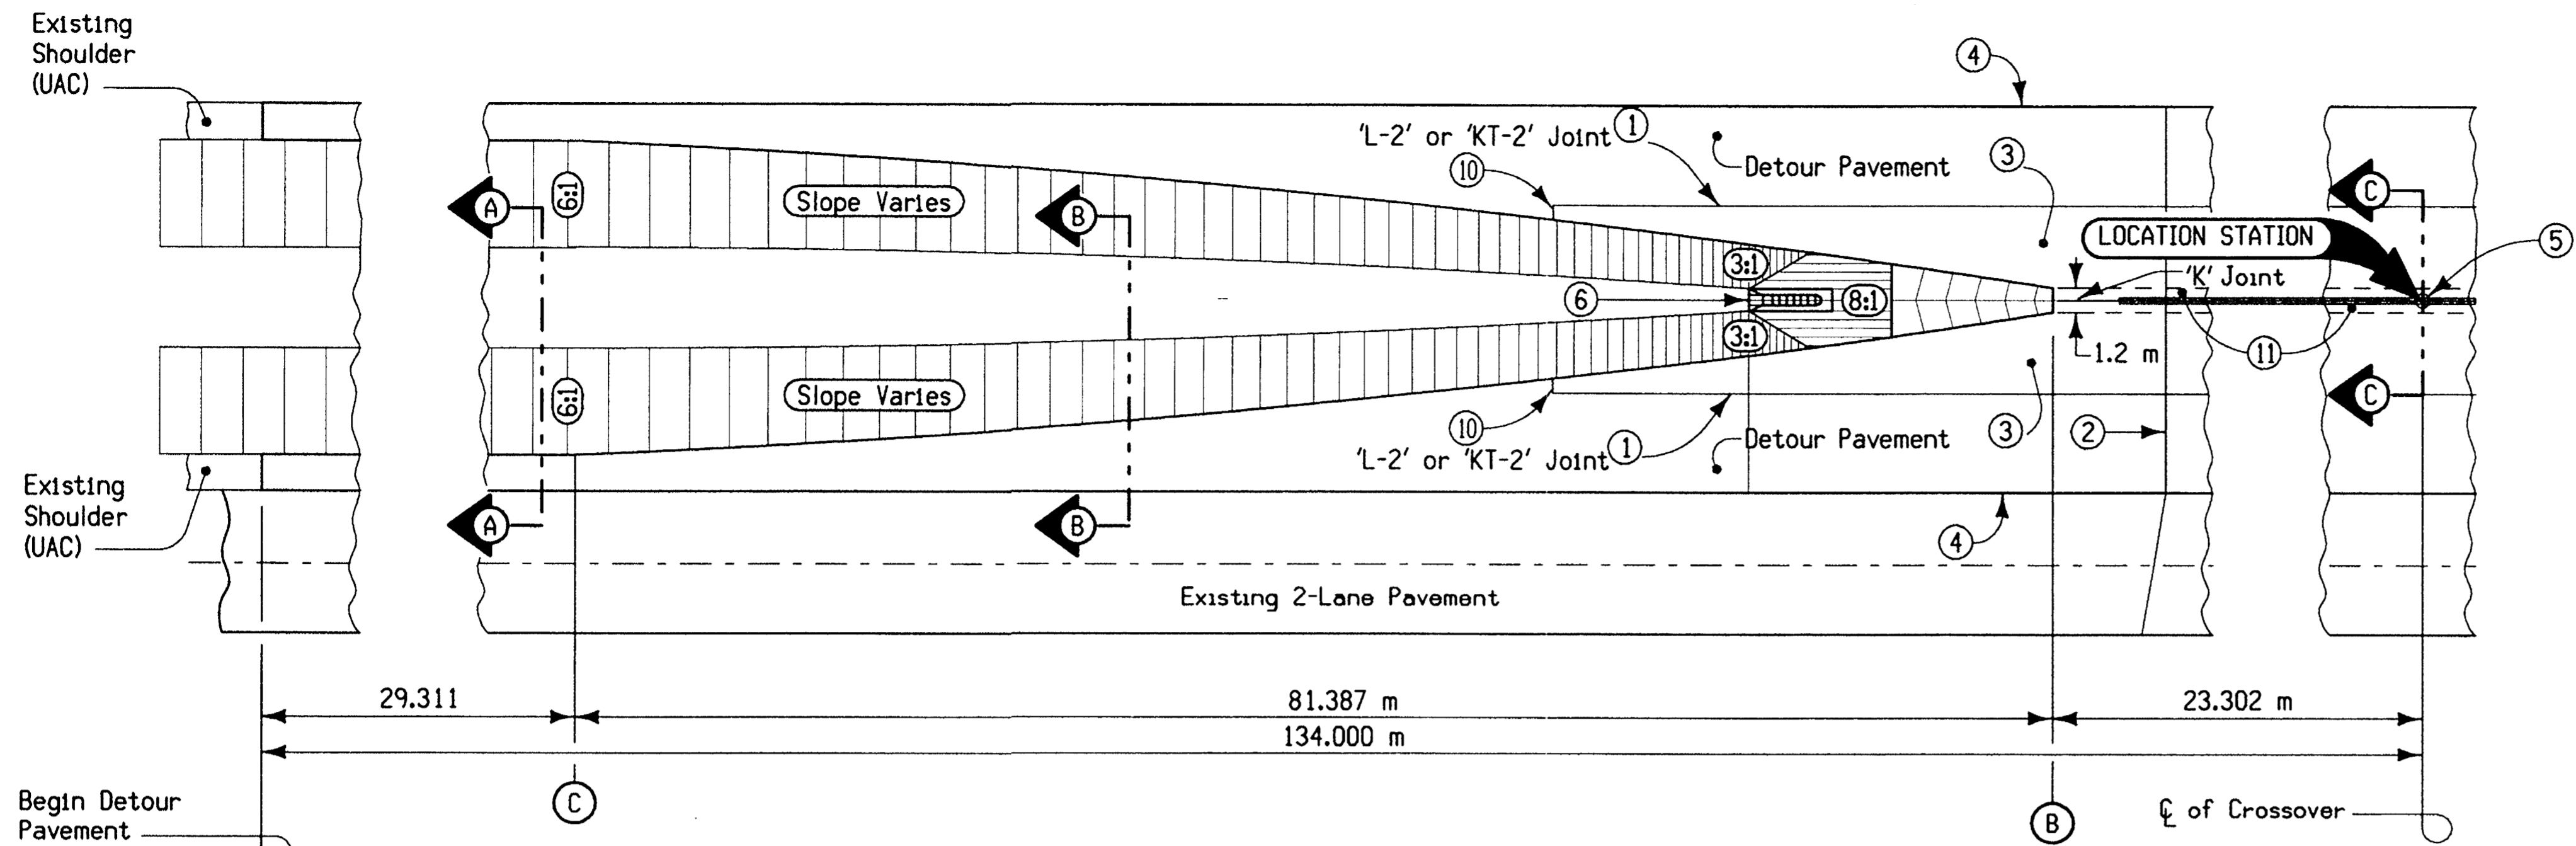


TABLE OF OFFSETS AND DROPS

Distance (m) from Location Station	134.000	104.689	96.553	88.414	80.275	72.136	63.997	55.858	47.719	39.580	31.441	23.302	0
Offset (m) from inside edge of Pavement	1.800	1.800	2.180	2.652	3.217	3.875	4.627	5.473	6.412	7.446	8.575	9.800	10.400
Drop (mm) from inside edge of Pavement	72	36	44	53	64	78	93	109	128	149	172	196	208
POINT LOCATION	-----	(C)	-----	-----	-----	-----	-----	-----	-----	-----	-----	(B)	-----

GENERAL NOTES:

This plan shows the construction details of a median crossover. The construction involves the removal of the existing paved shoulder, placement of special backfill to build the embankment for crossover, laying of corrugated metal pipes, placement of the median crossover pavement, and construction of the beveled pipe and guard as detailed on Detail Sheet 500-12.

Materials and construction methods used shall be in accordance with current Standard and Supplemental Specifications.

Any modification of the median crossover design shall be subject to the approval of the Engineer.

Price bid for contract items shall be considered full compensation for furnishing all necessary materials and labor to construct the median crossover as detailed.

Contract bid items are:

Item	Unit	Amount
Special Backfill	Mg	3852 **
Pavement, median crossover	m ²	2649
375 mm corrugated metal roadway pipe culvert	m	28
525 mm corrugated metal slotted drain /150 mm grate ***	m	41.5

* The removal of subbase material is considered incidental to the removal of pavement.


** Quantities are based on the assumption that the existing median ditch is 1.2 meters deep and foreslopes are 4:1.

*** Flowable mortar and pipe reducers shall be considered incidental to the 525 millimeter corrugated metal slotted drain.


- ① Spaced at one-quarter median width. See Standard Road Plan RH-51.
- ② Match crossover pavement joints with existing roadway joints. 'CD' joints are required. See Standard Road Plan RH-50.
- ③ Detour Pavement shall be as specified under these contract documents.
- ④ KT-2 Joint, bend bars out for new pavement only.
- ⑤ Median crossover is symmetrical at centerline.
- ⑥ Beveled pipe and guard. See Detail Sheet 500-12.
- ⑦ Duct tape or wood block shall be used to cover slotted drain during construction of crossover pavement.
- ⑧ Slotted grate 150 mm high x 45 mm opening width. The spacer and bearing bars (sides) shall be 4.76 mm material.
- ⑨ The entire length of slotted drain shall be encased in flowable mortar.
- ⑩ 0.6 m 'C' joint.
- ⑪ 250mm thick x 0.6 m wide PCC Pavement, Class 'A', for ACC Option of Detour Pavement

All dimensions given in millimeters unless noted.


METRIC VERSION	Project Development Division		
	DETAIL SHEET 531-1D		
	REVISION: Revise note 3 to include Superpave mix requirements.	REVISION NO. 6	REVISION DATE MOD.
DETAILS OF MEDIAN CROSSOVER (20.8 m MEDIAN) 65 MPH			

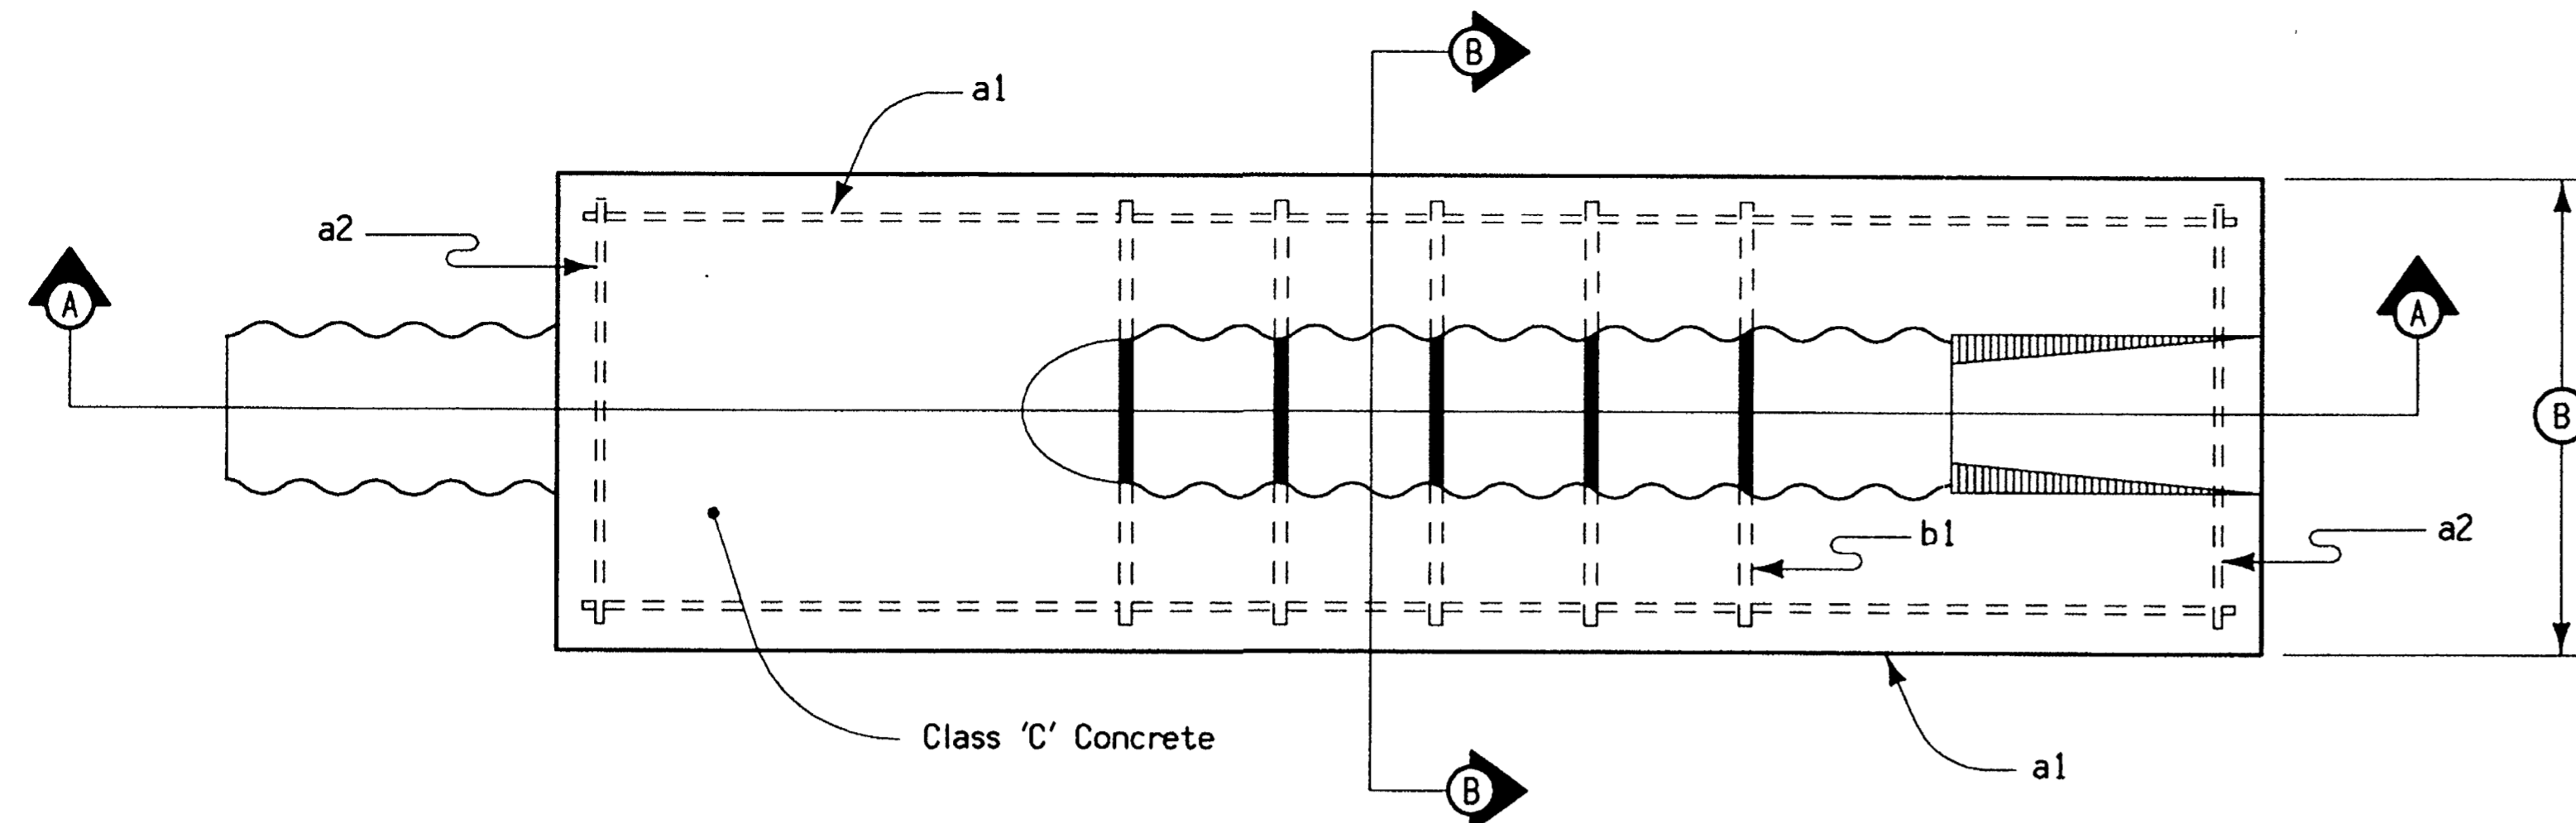

PLAN VIEW

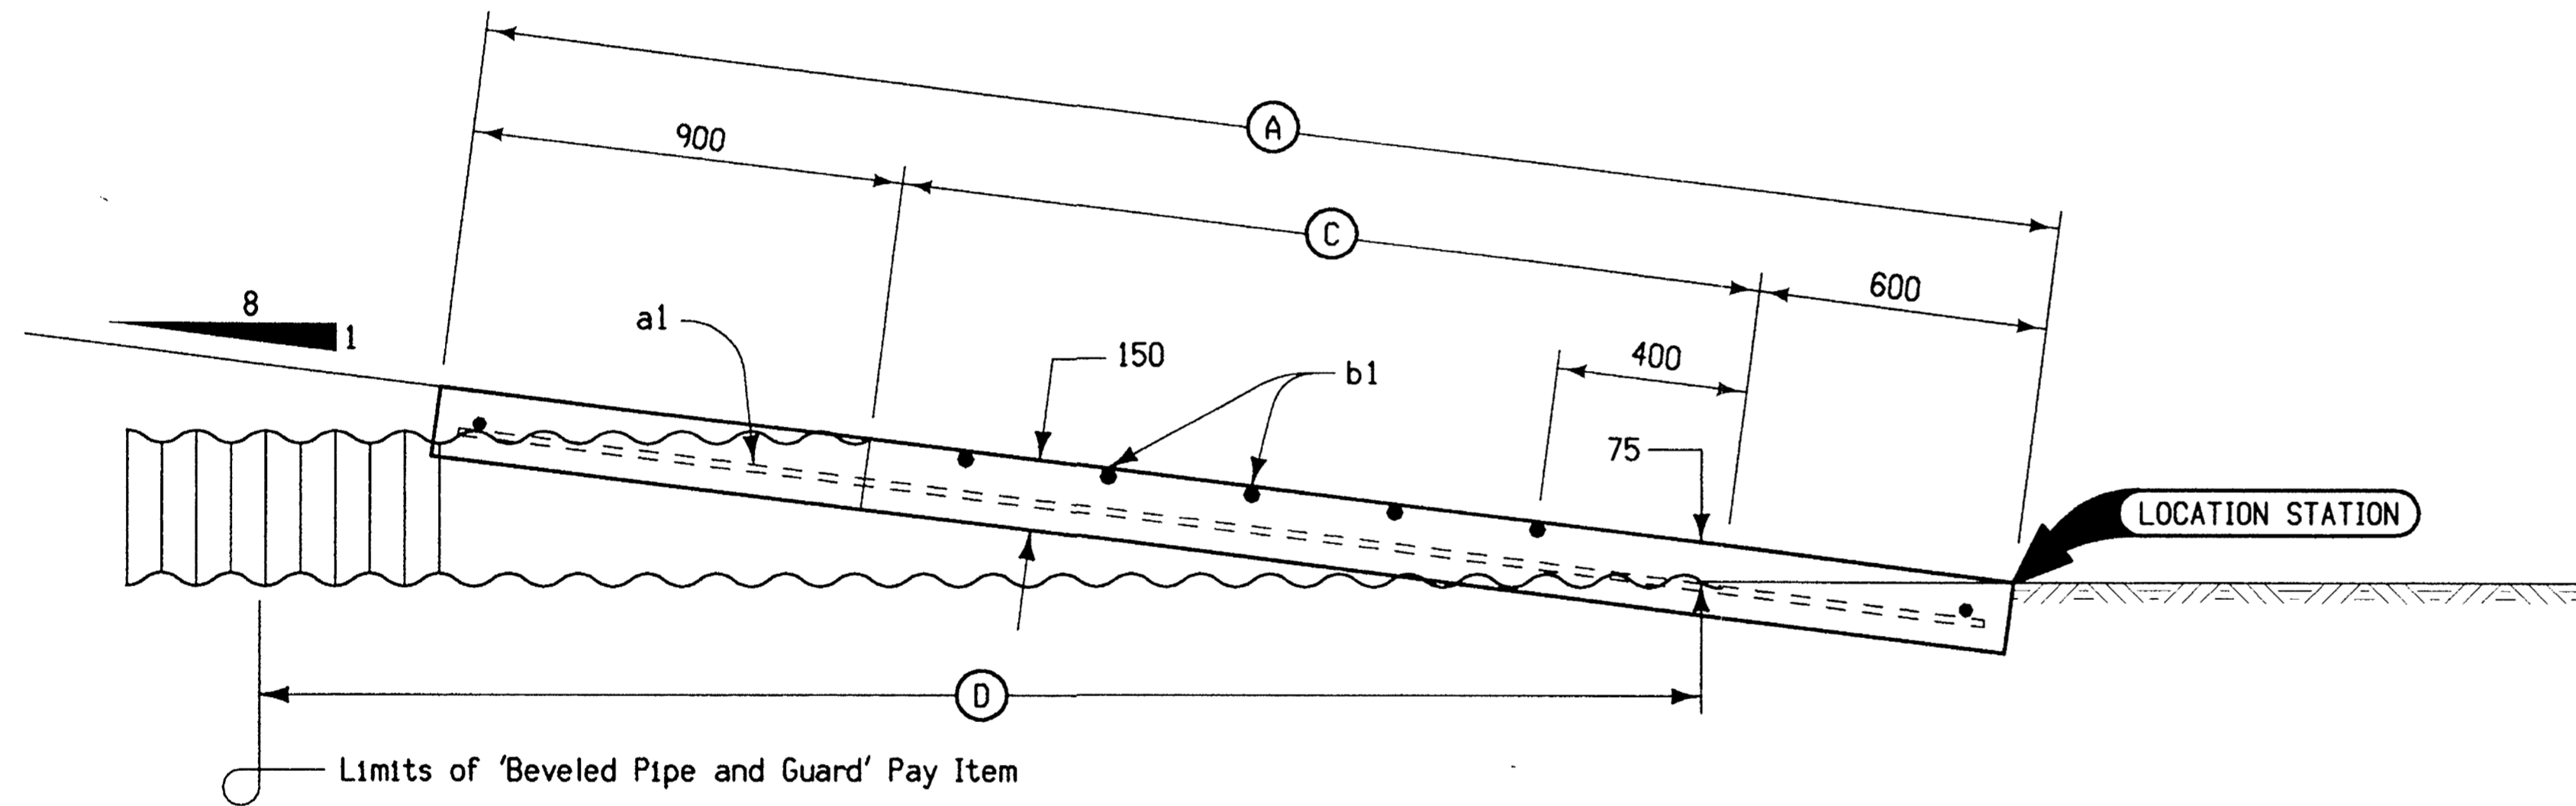

SECTION A-A

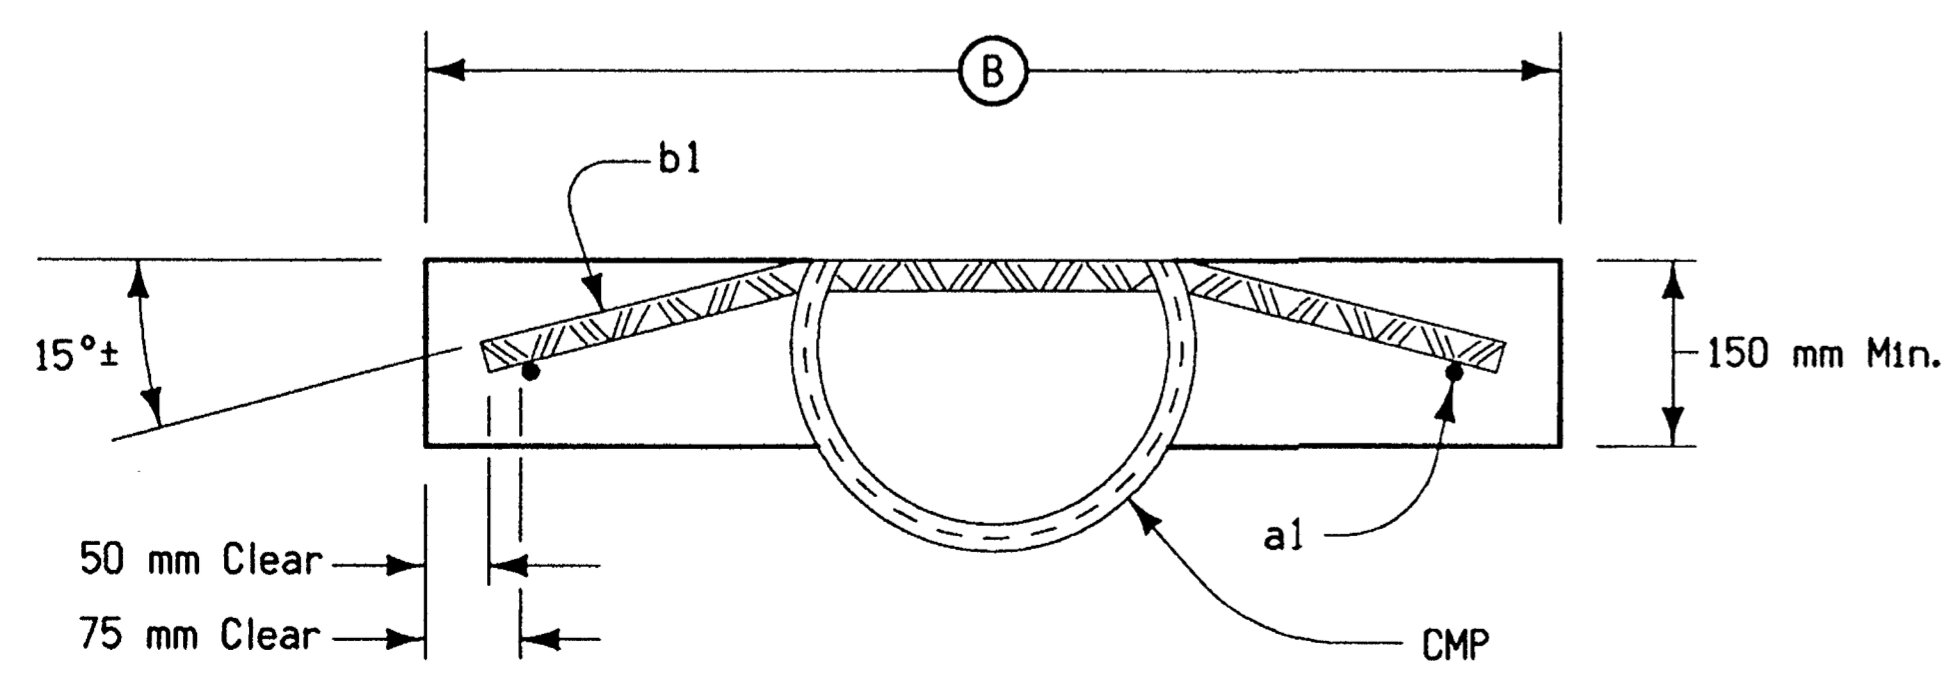

SECTION B-B

REINFORCING BAR LIST										
PIPE SIZE	BAR MARK	BAR SIZE	LOCATION	SHAPE	NO.	LENGTH mm	TOTAL LENGTH mm	MASS kg	TOTAL MASS kg	SPACING mm
300	a1	15	Base	—	2	3200	6400	10	19	See Detail
	a2	15	Base	—	2	800	1600	3		See Detail
	b1	25	Base	—	5	815	1630	6		300
375	a1	15	Base	—	2	3800	7600	12	22	See Detail
	a2	15	Base	—	2	875	1750	3		See Detail
	b1	25	Base	—	7	890	1780	7		300
450	a1	15	Base	—	2	4400	8800	14	25	See Detail
	a2	15	Base	—	2	950	1900	3		See Detail
	b1	25	Base	—	9	965	1930	8		300

TABLE OF DIMENSIONS				
PIPE SIZE	(A)	(B)	(C)	(D)
300	3300	900	1800	3000
375	3900	975	2400	3600
450	4500	1050	3000	4200

GENERAL NOTES:

This plan illustrates the details for the construction of a Beveled Pipe and Guard. Alternate designs, methods of construction or materials may be submitted to the Engineer for approval.

Materials and methods of construction shall be in accordance with current Standard and Supplemental Specifications.

Reinforcing steel used in construction of "Beveled Pipe and Guard" shall be deformed bars meeting the requirements of Article 4151.03. All steel bars shall be hot-dip galvanized in accordance with ASTM A 123 specifications.

Concrete used in the construction of Beveled Pipe and Guard shall be Class 'C' Concrete.

The Corrugated Metal Pipe shall be cut to fit the 8:1 foreslope. Slots shall be cut into the CMP for placement of the No. 25 bar. After the foreslope has been placed, the No. 25 bars shall be fitted into the slots cut in the CMP so they will be in proper position when the concrete collar is poured.


Price bid for "Beveled Pipe and Guard", each, shall be considered full compensation for the furnishing all the materials and constructing the Beveled Pipe and Guard as detailed hereon and as directed by the Engineer.

Special Note:

A silt fence ditch check will be required immediately upstream from the inlet of the culvert. Refer to Standard Road Plan RC-16 for construction details and basis of payment.

All dimensions given in millimeters unless noted.

M METRIC VERSION	Project Development Division	
	DETAIL SHEET	500-12
	REVISION: Metric conversion of Detail Sheet 500-12, no. 3, (dated 3-28-95)	REVISION NO. 3 REVISION DATE 03-28-95
DETAILS OF BEVELED PIPE AND GUARD		

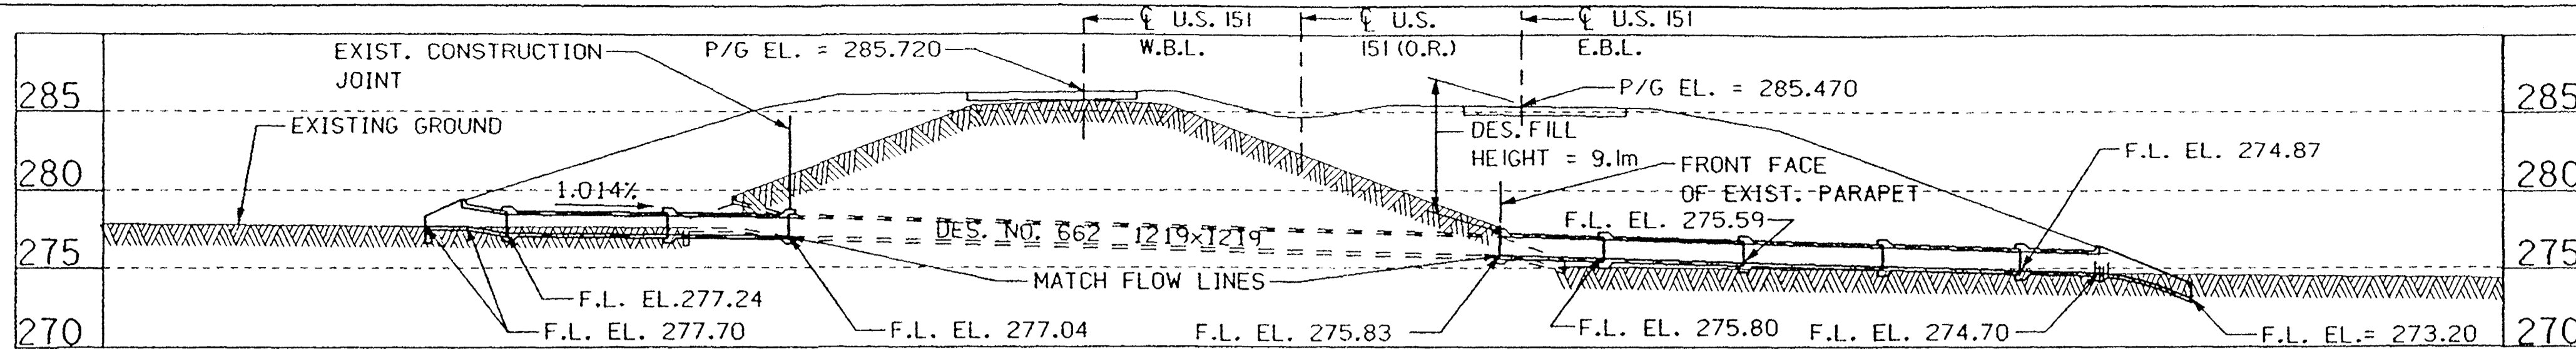


LONGITUDINAL SECTION - ALONG CULVERT

ESTIMATED SETTLEMENT = 0.20 m

BENCH MARK:

FOR NEW BENCH MARK INFORMATION, SEE PAGE G.18

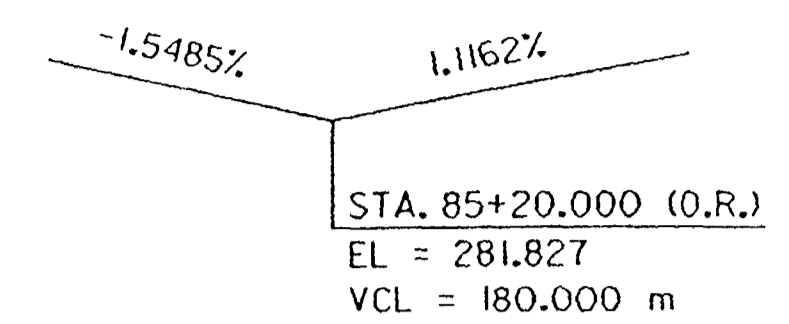

U.S. HWY. 151 PROFILE GRADE

HYDRAULIC DATA

FREQUENCY	DISCHARGE (cms)	HEADWATER ELEV.
10-YEAR	2.09	278.54
25-YEAR	2.39	278.61
50-YEAR	2.98	278.76
100-YEAR	3.58	278.89


DRAINAGE AREA = 25.90 ha, ROLLING
50 YEAR DESIGN FREQUENCY

LOCATION


U.S. 151
T84N - R4W
SECTION 20
FAIRVIEW TWP.
JONES COUNTY

TRAFFIC DATA


2001	ADT	7140
2021	ADT	8560
2021	DHV	920
2001	TRUCKS	10%
2021	TRUCKS	11%

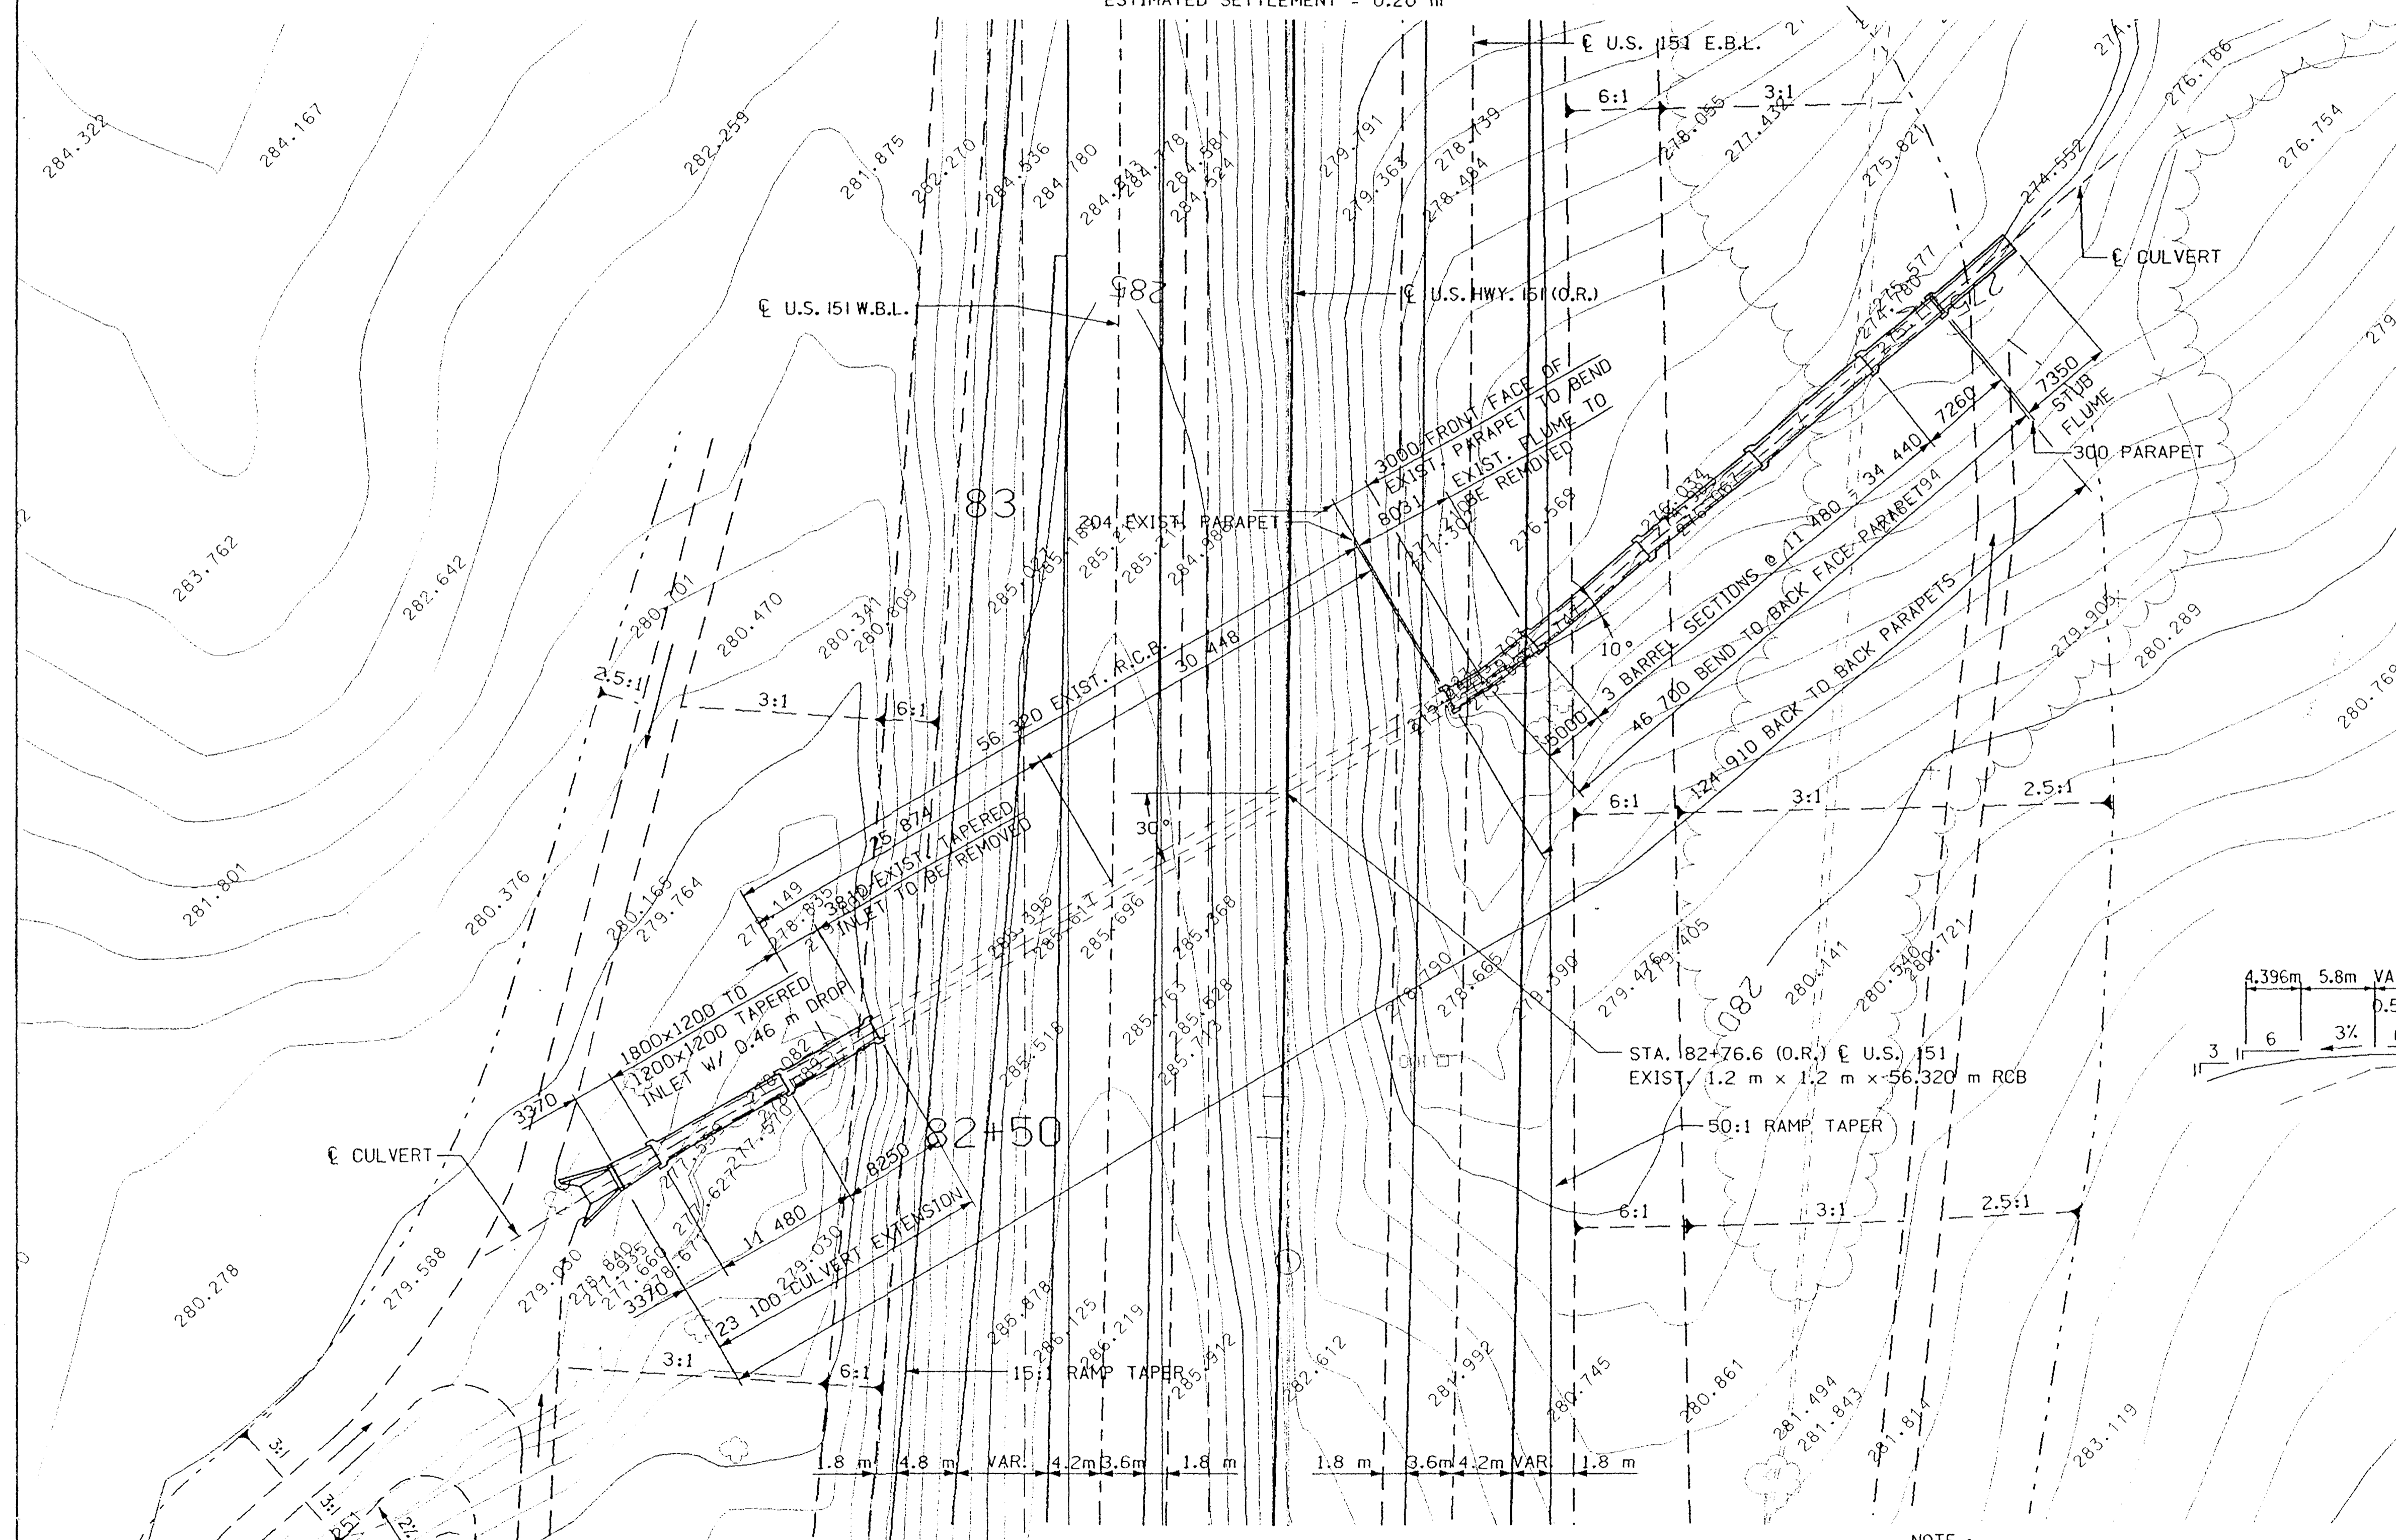

SITUATION PLAN

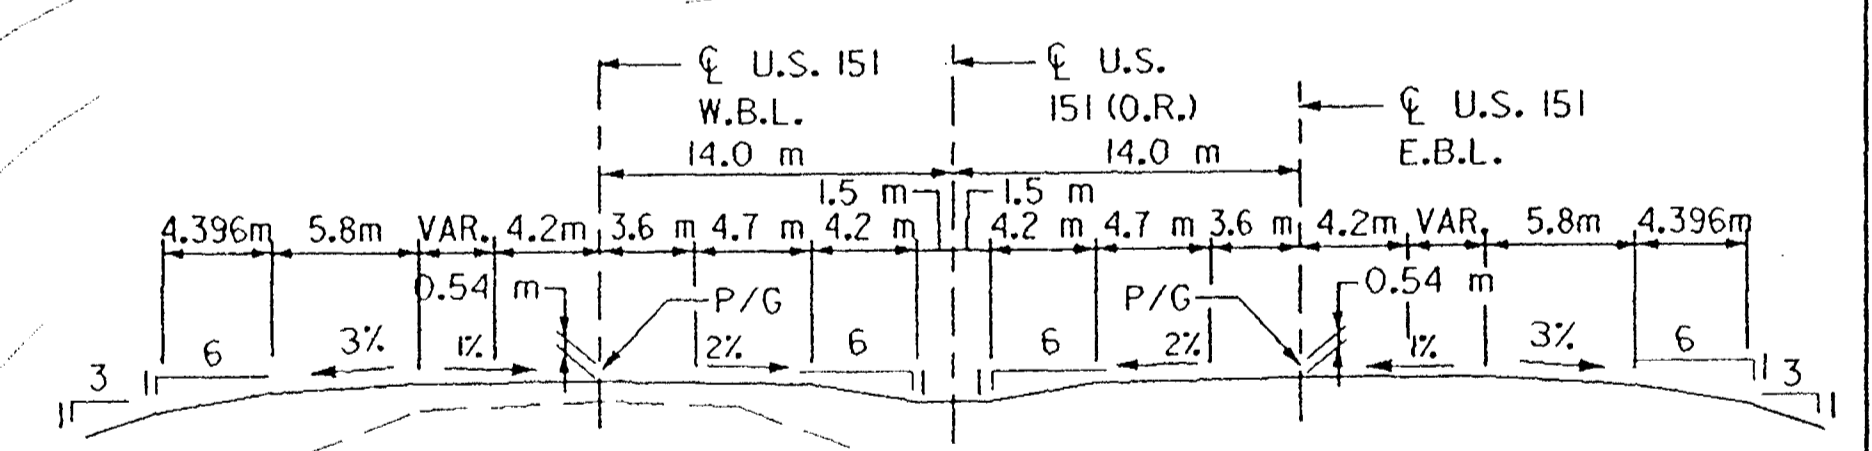

TYPICAL APPROACH SECTION

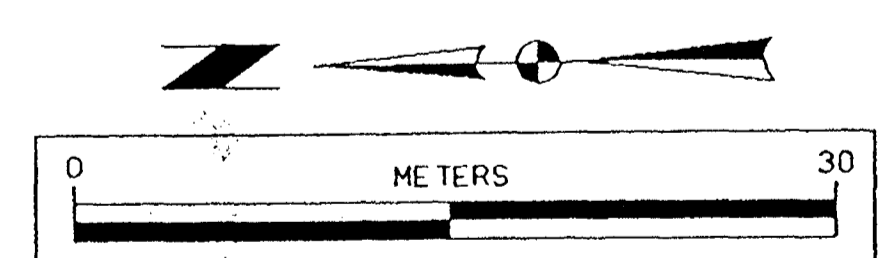

DESIGN FOR EXTENSION TO A 30° SKEW (R.A.)
1.2 m x 1.2 m REINFORCED CONCRETE BOX CULVERT SITUATION PLAN
 STA. 82+76.6 (O.R.) U.S. HIGHWAY 151
 JONES COUNTY
 FEBRUARY, 1999
 IOWA DEPARTMENT OF TRANSPORTATION - PROJECT DEVELOPMENT DIVISION
 DESIGN SHEET NO. 2 OF 11 FILE NO. 29164 DESIGN NO. 398

NOTE :
ALL DIMENSIONS SHOWN ARE IN MILLIMETERS (mm)
UNLESS OTHERWISE NOTED OR SHOWN.


DESIGNED BY DLN CHECKED BY RMJ
 DETAILED BY JAE CADD FILE h53398.s02

EARTH TECH

LINN/JONES COUNTY

PROJECT NUMBER NHSX-151-3(112)--3H-57

STATE	FHWA REGION	FISCAL YEAR	SHEET NO.	TOTAL SHEETS
IOWA	7		V.01	

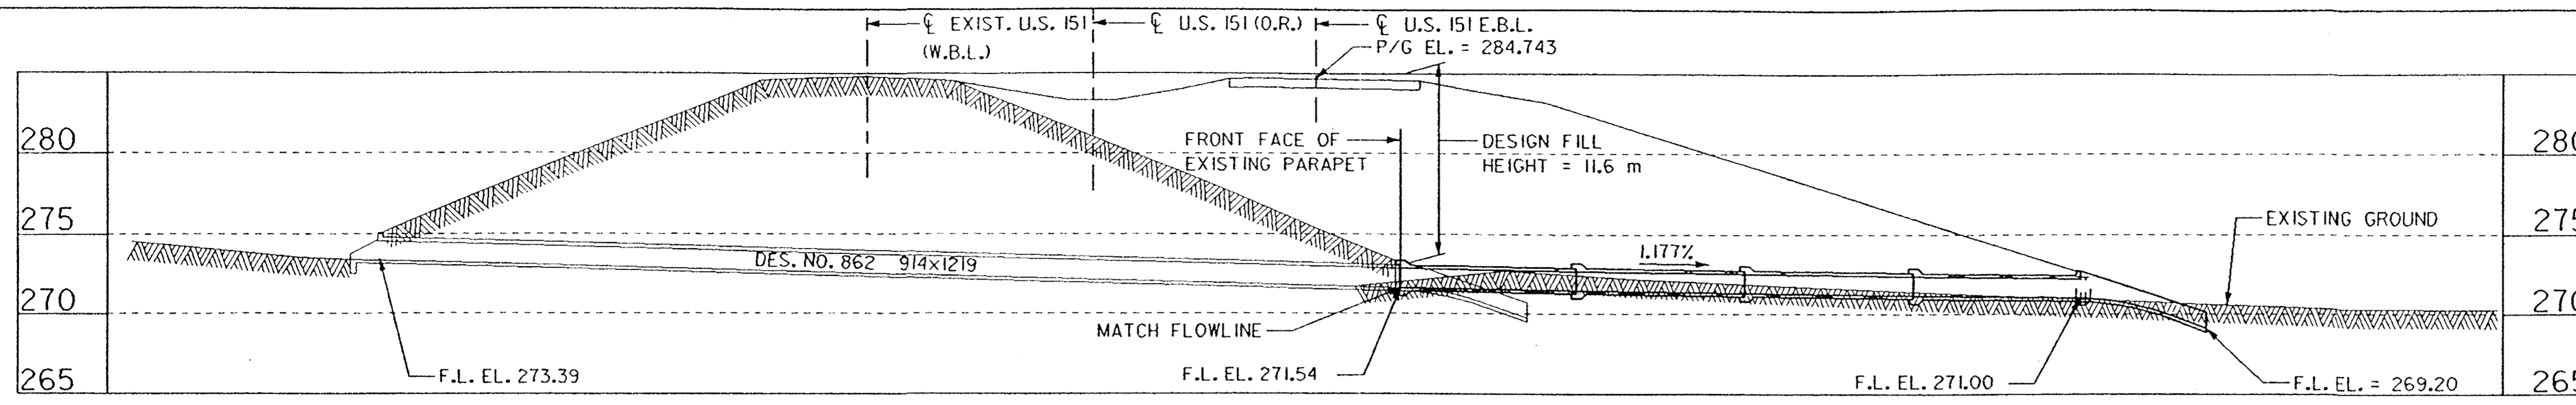

LONGITUDINAL SECTION - ALONG CULVERT
ESTIMATED SETTLEMENT = 0.12 m

BENCH MARK:
FOR NEW BENCH MARK INFORMATION, SEE PAGE G.18

U.S. HWY. 151 PROFILE GRADE



HYDRAULIC DATA		
FREQUENCY	DISCHARGE(CMS)	HEADWATER ELEV.
10-YEAR	1.35	274.40
25-YEAR	1.54	274.50
50-YEAR	1.93	274.69
100-YEAR	2.31	274.89

DRAINAGE AREA = 9.7 ha, HILLY
50 YEAR DESIGN FREQUENCY

LOCATION
U.S. 151
184N - R4W
SECTION 21
FAIRVIEW TWP.
JONES COUNTY


TRAFFIC DATA

2001	ADT	7140
2021	ADT	8560
2021	DHV	920
2001	TRUCKS	10%
2021	TRUCKS	11%

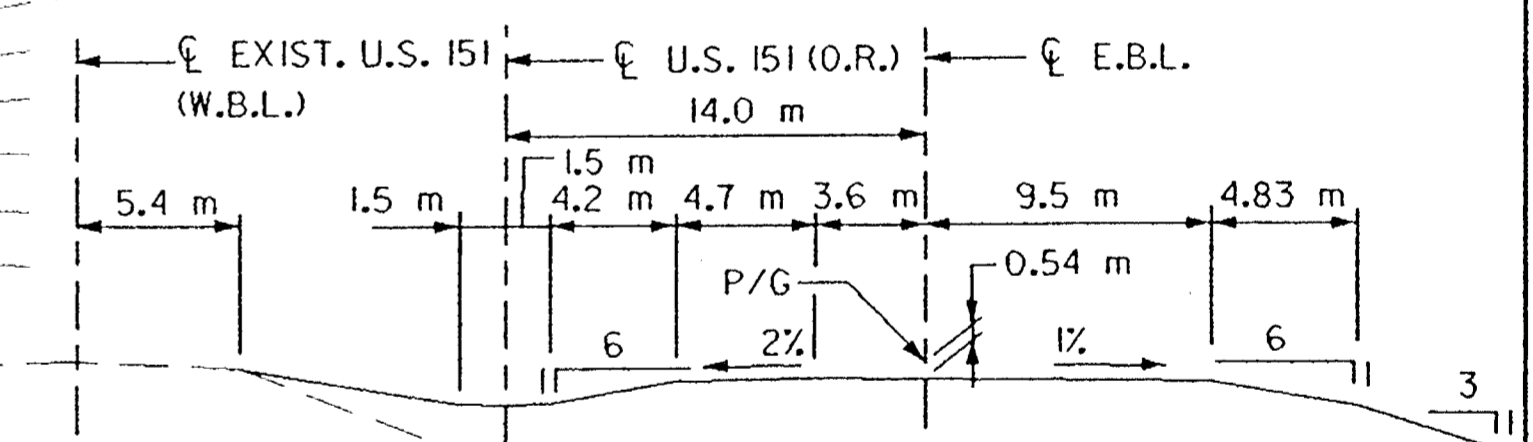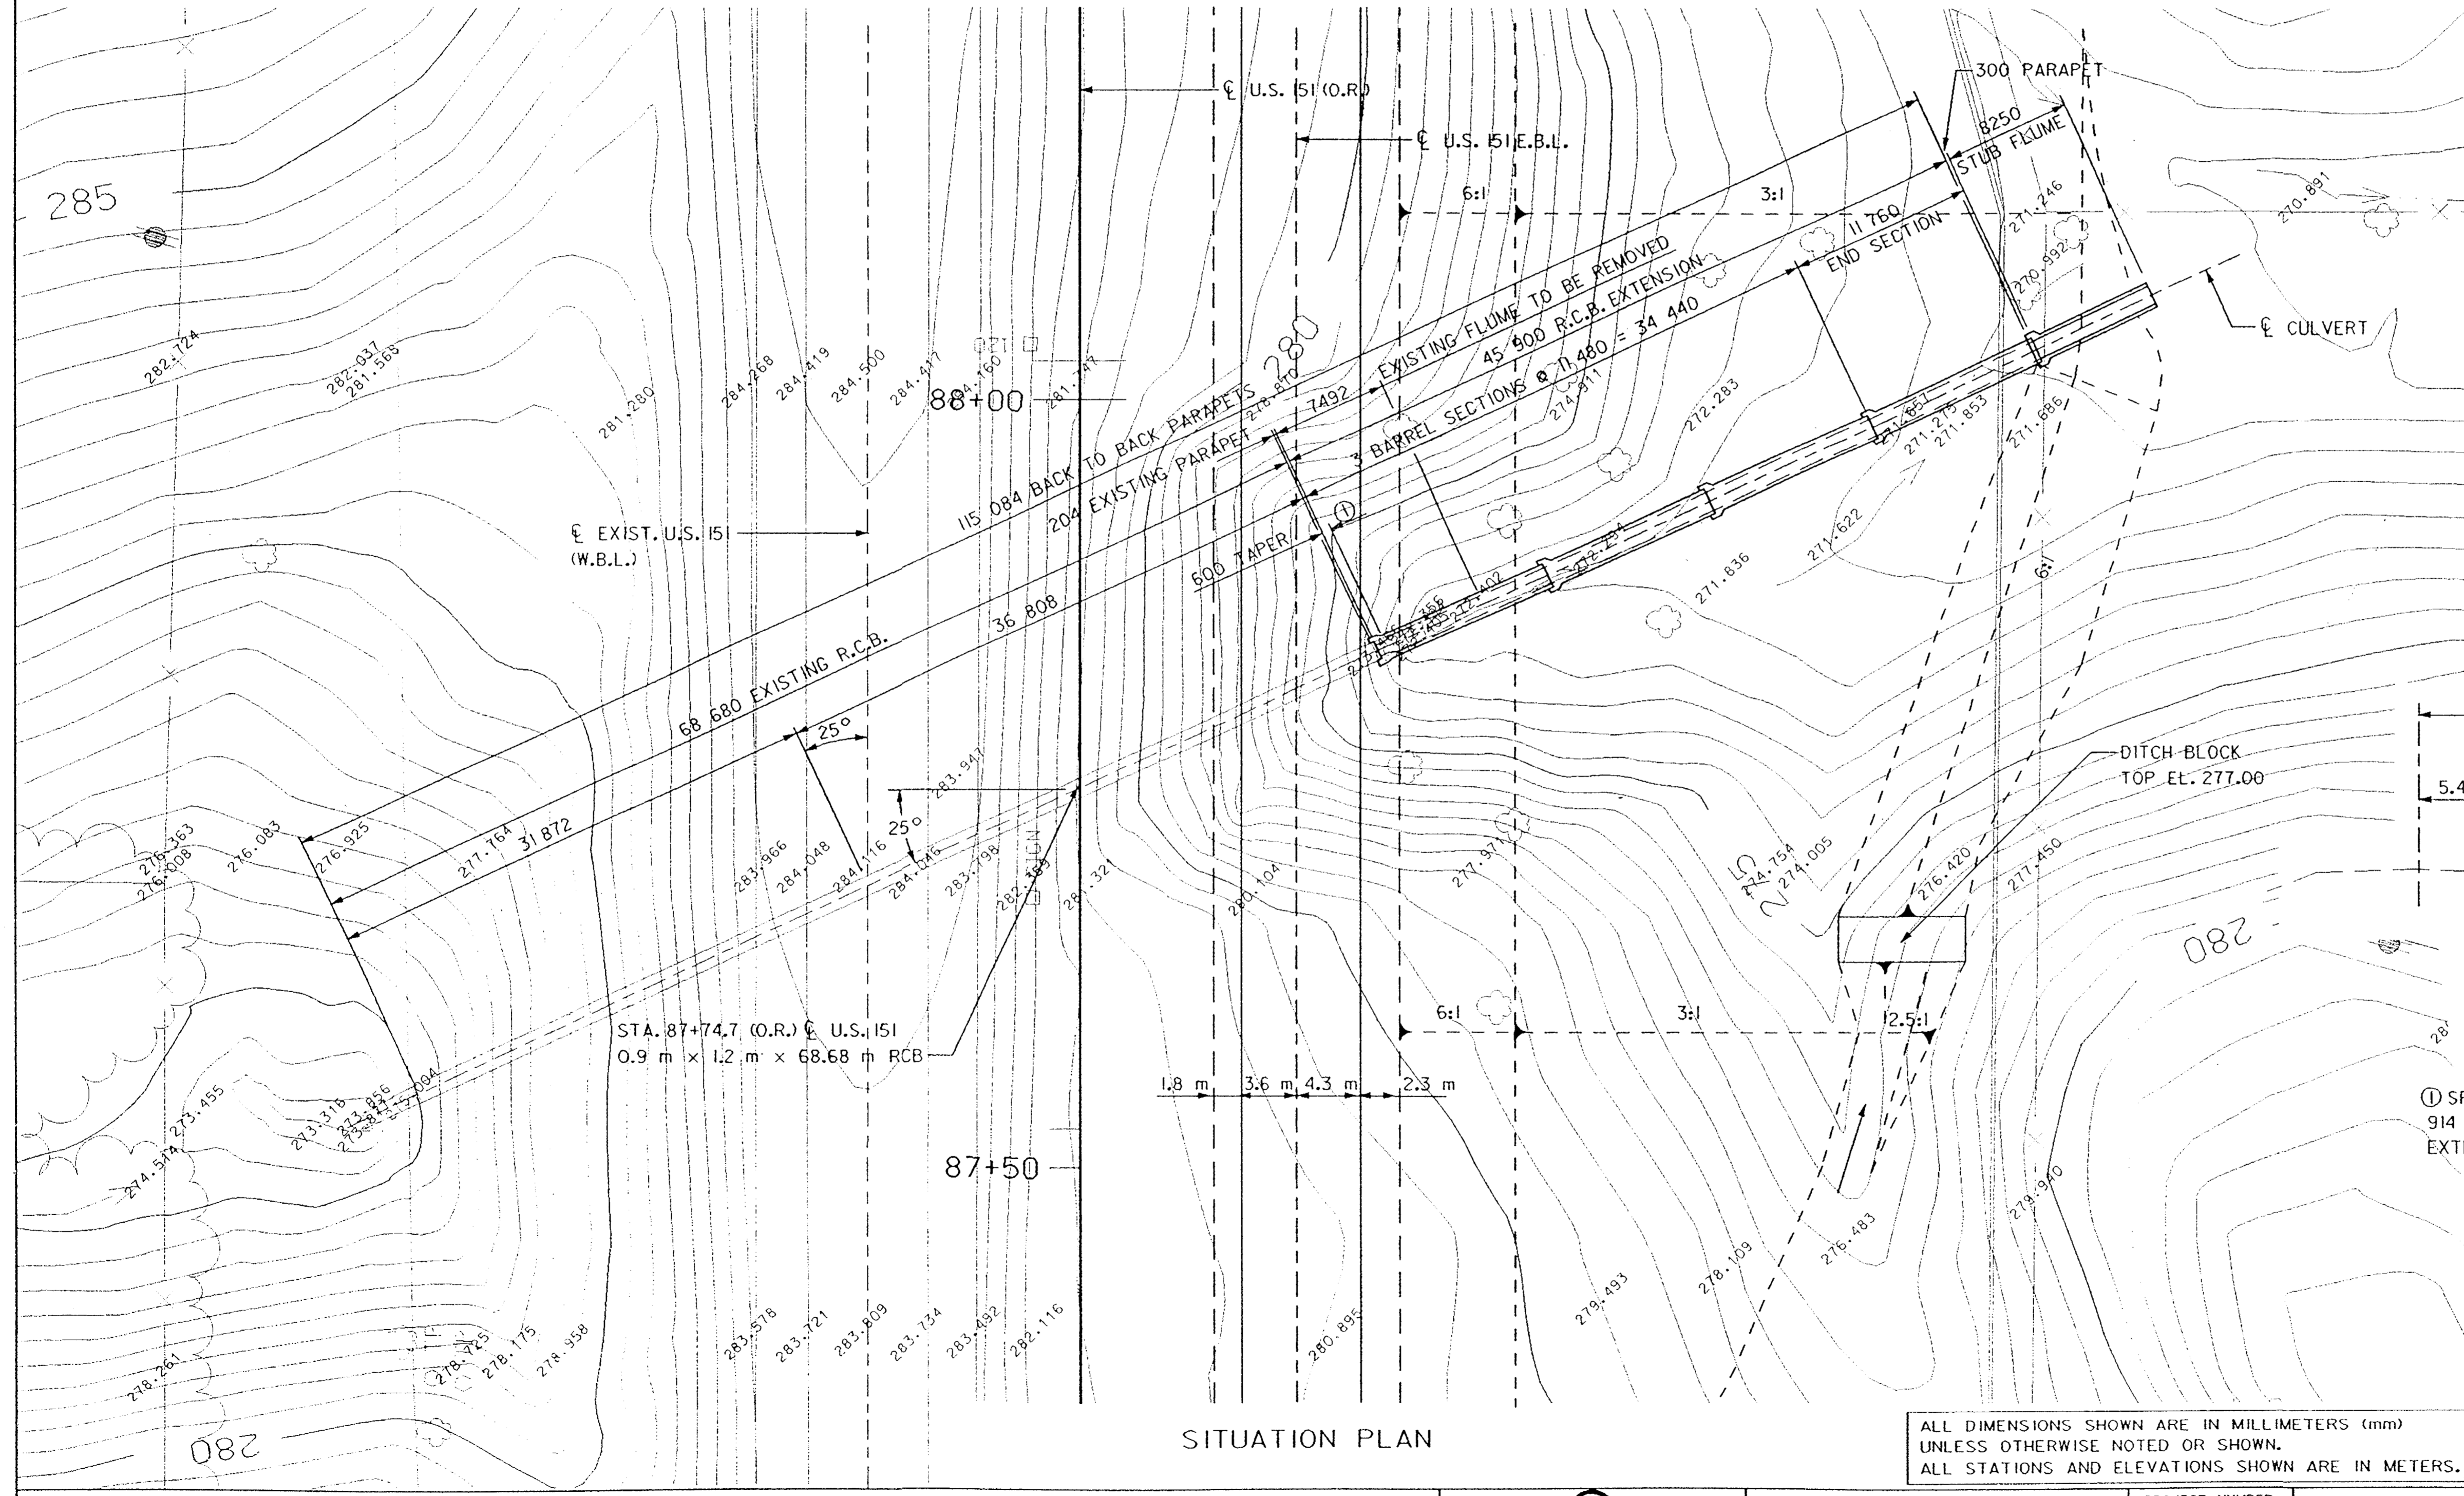

TYPICAL APPROACH SECTION

① SPAN TAPERS FROM 914 TO 1200 IN NEW EXTENSION.

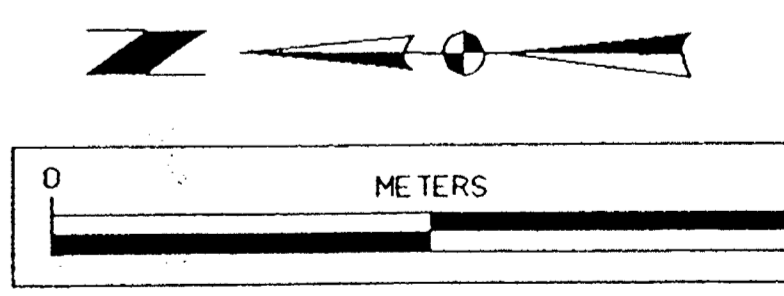

DESIGN FOR EXTENSION TO A 25° SKEW (R.A.)
**0.90 m x 1.2 m TO 1.2 m x 1.2 m
REINFORCED CONCRETE BOX CULVERT
SITUATION PLAN**

STA. 87+74.7 (O.R.) U.S. HIGHWAY 151 FEBRUARY, 1999
JONES COUNTY
IOWA DEPARTMENT OF TRANSPORTATION - PROJECT DEVELOPMENT DIVISION
DESIGN SHEET NO. 2 OF 6 FILE NO. 29164 DESIGN NO. 498

ALL DIMENSIONS SHOWN ARE IN MILLIMETERS (mm)
UNLESS OTHERWISE NOTED OR SHOWN.
ALL STATIONS AND ELEVATIONS SHOWN ARE IN METERS.





DESIGNED BY DLN CHECKED BY RMJ
DETAILED BY JAE CADD FILE H53498.S02



LINN/JONES COUNTY

PROJECT NUMBER NHSX-151-3(112)--3H-57

STATE	FHWA REGION	FISCAL YEAR	SHEET NO.	TOTAL SHEETS
IOWA	7		V.02	

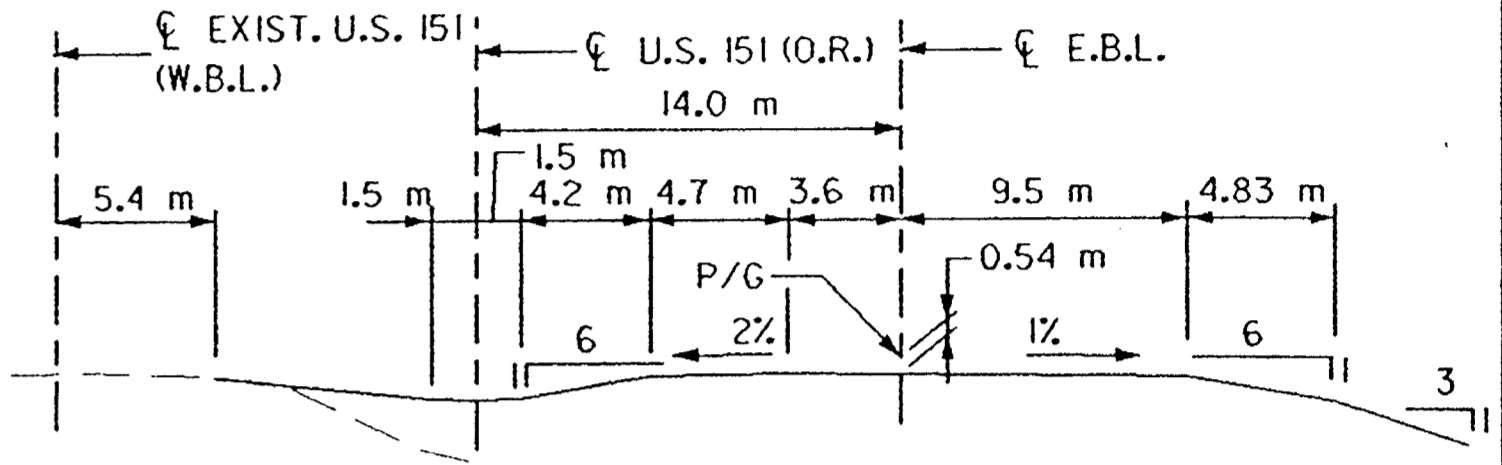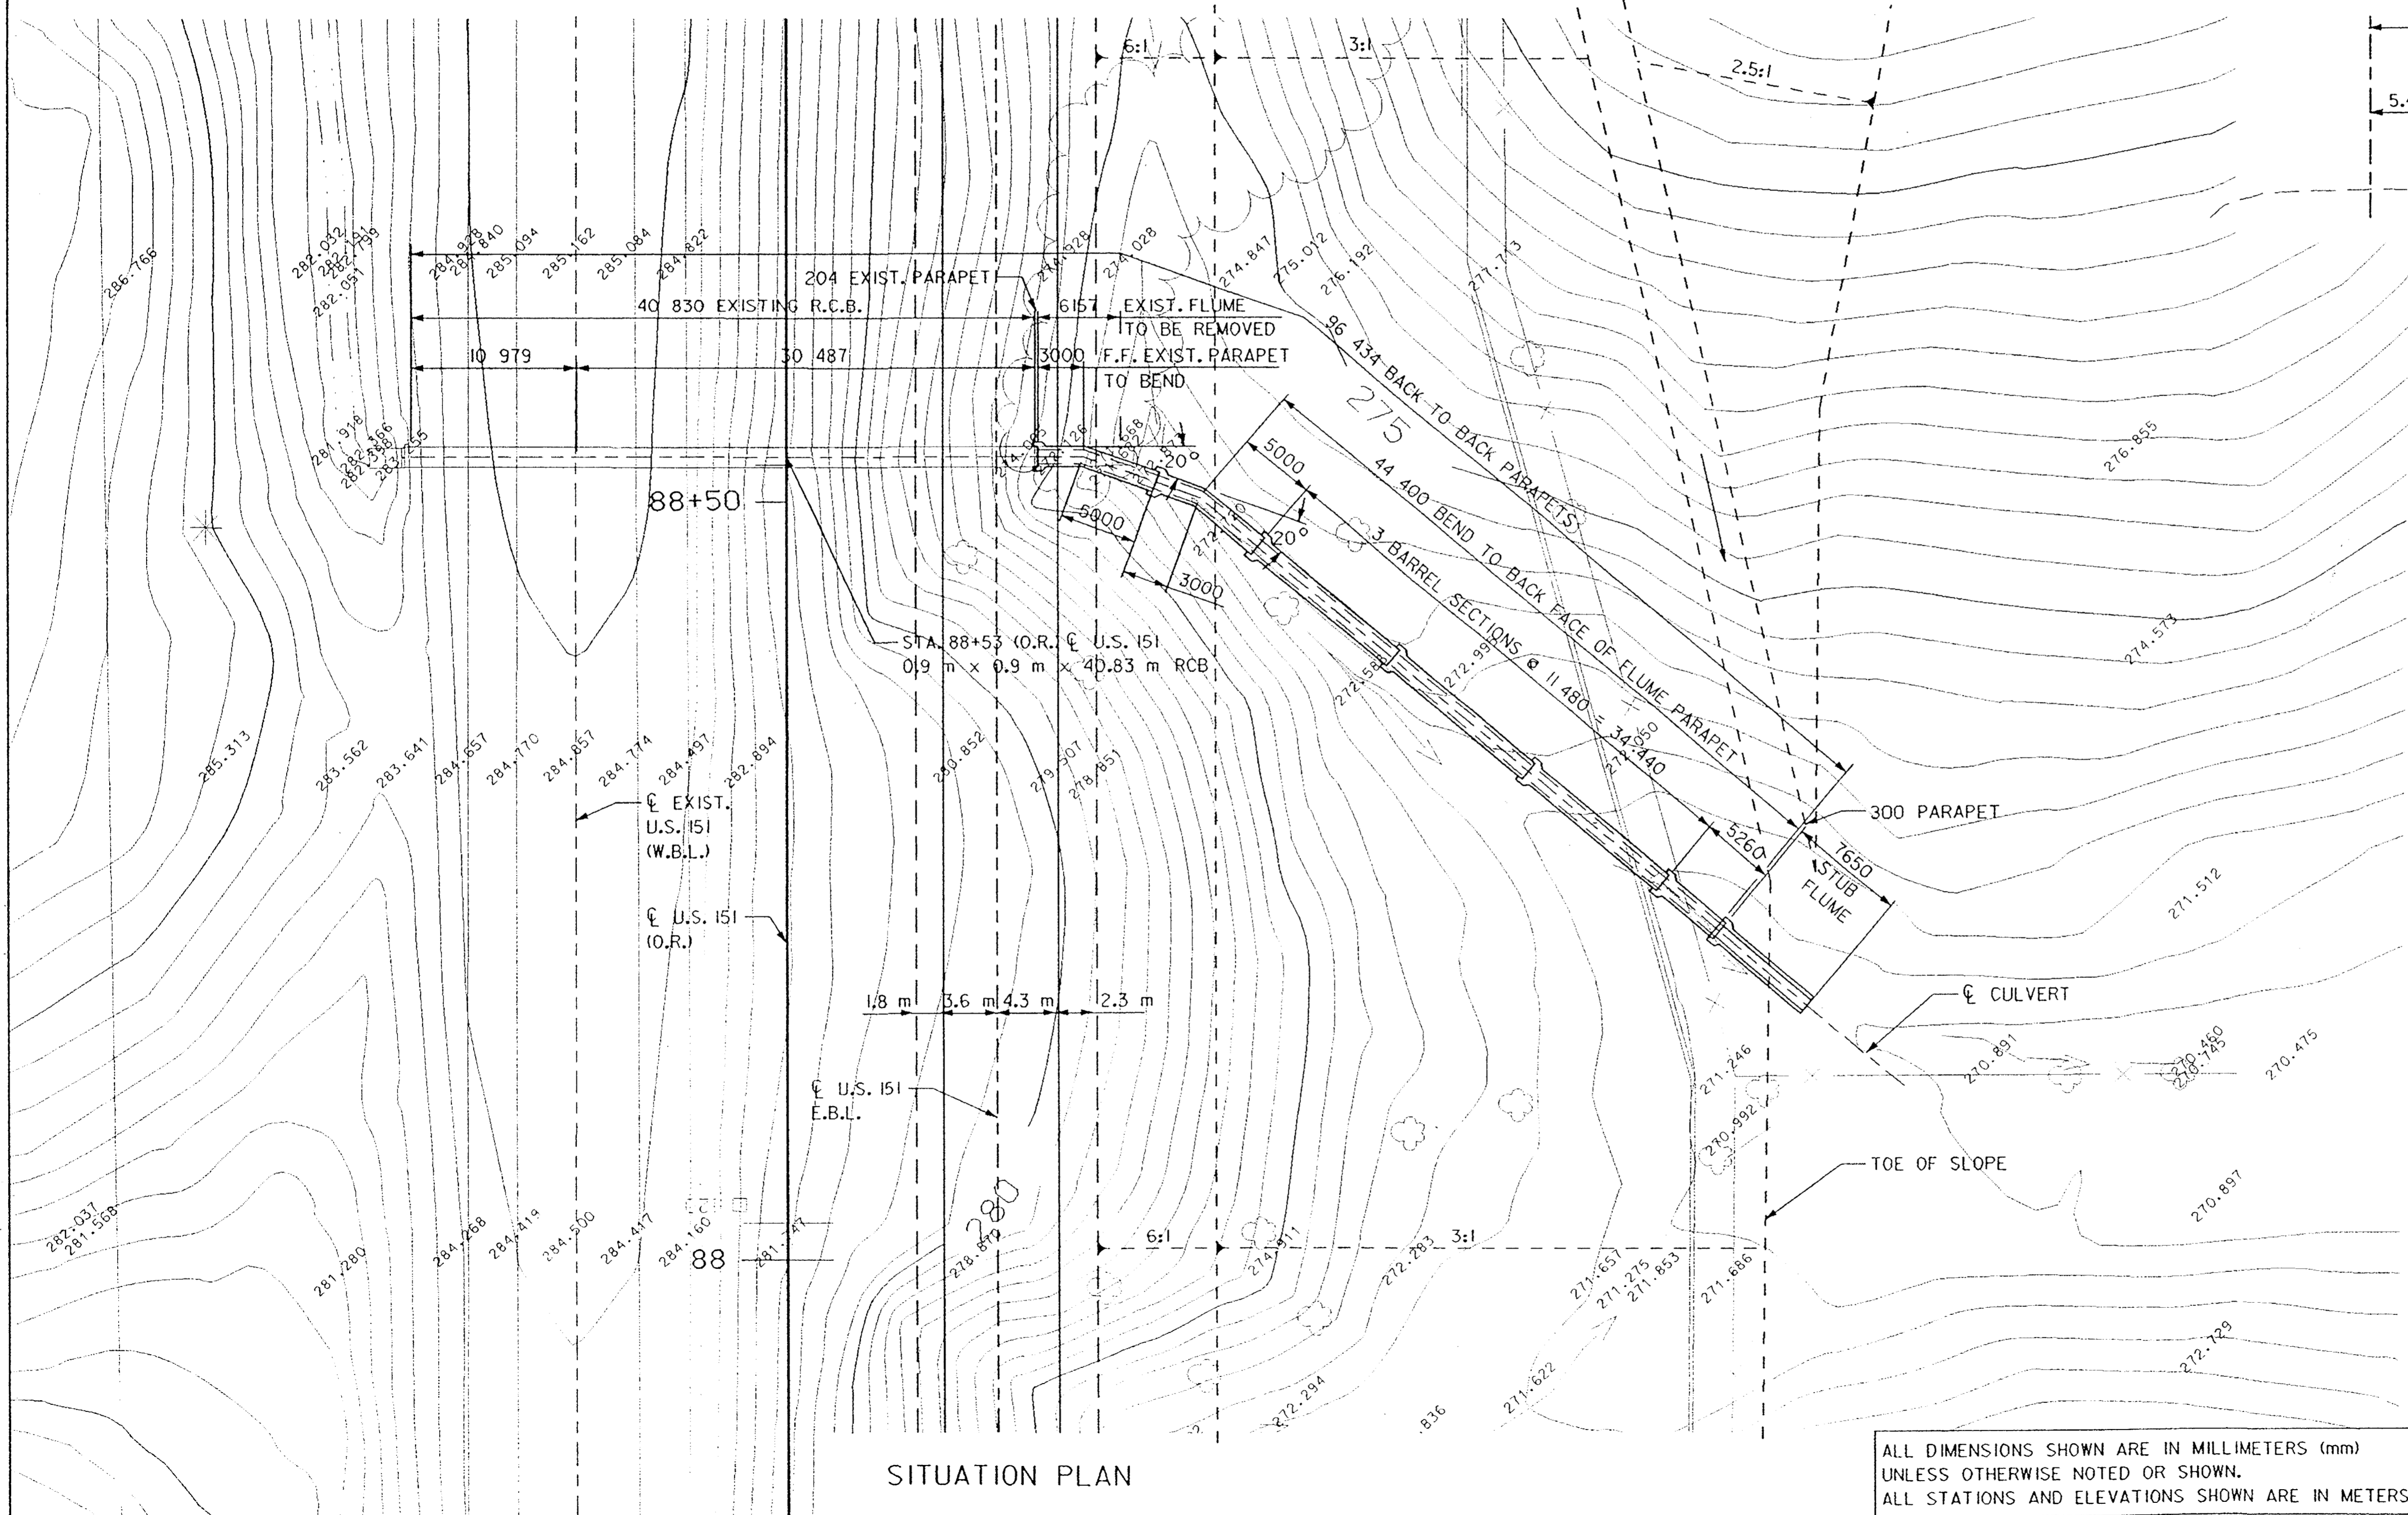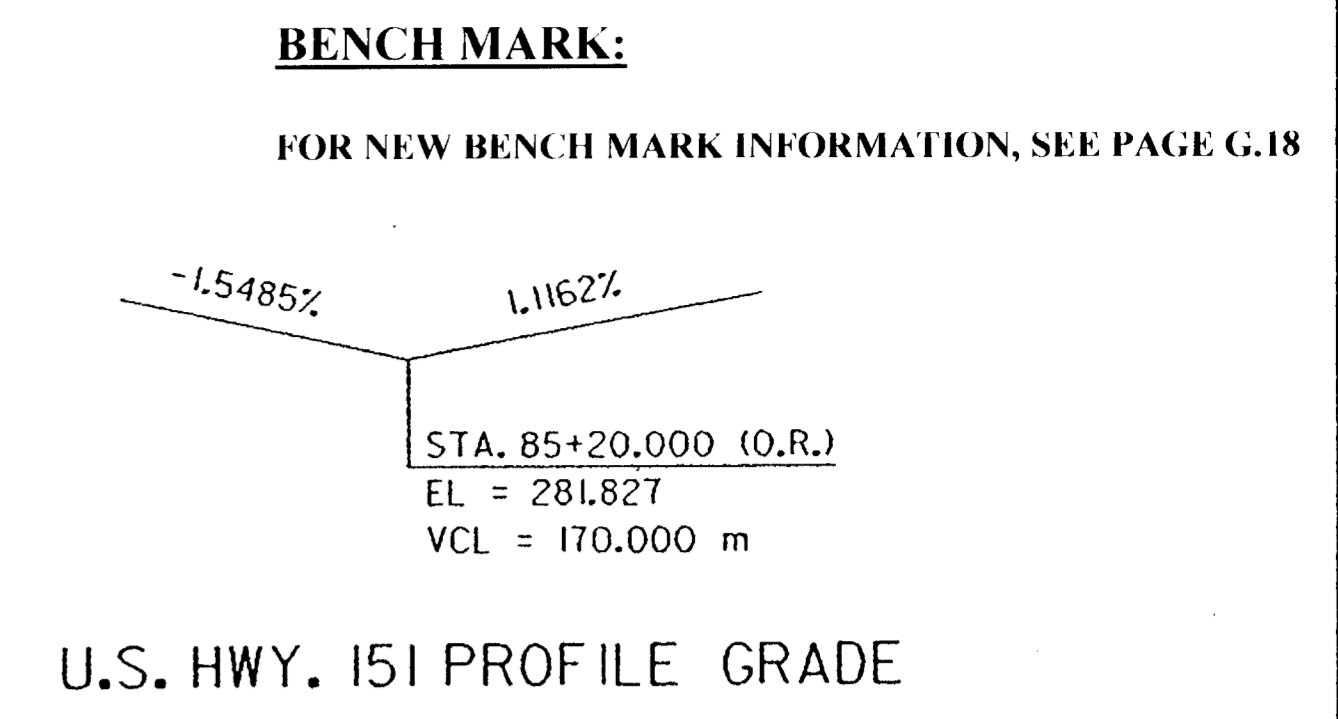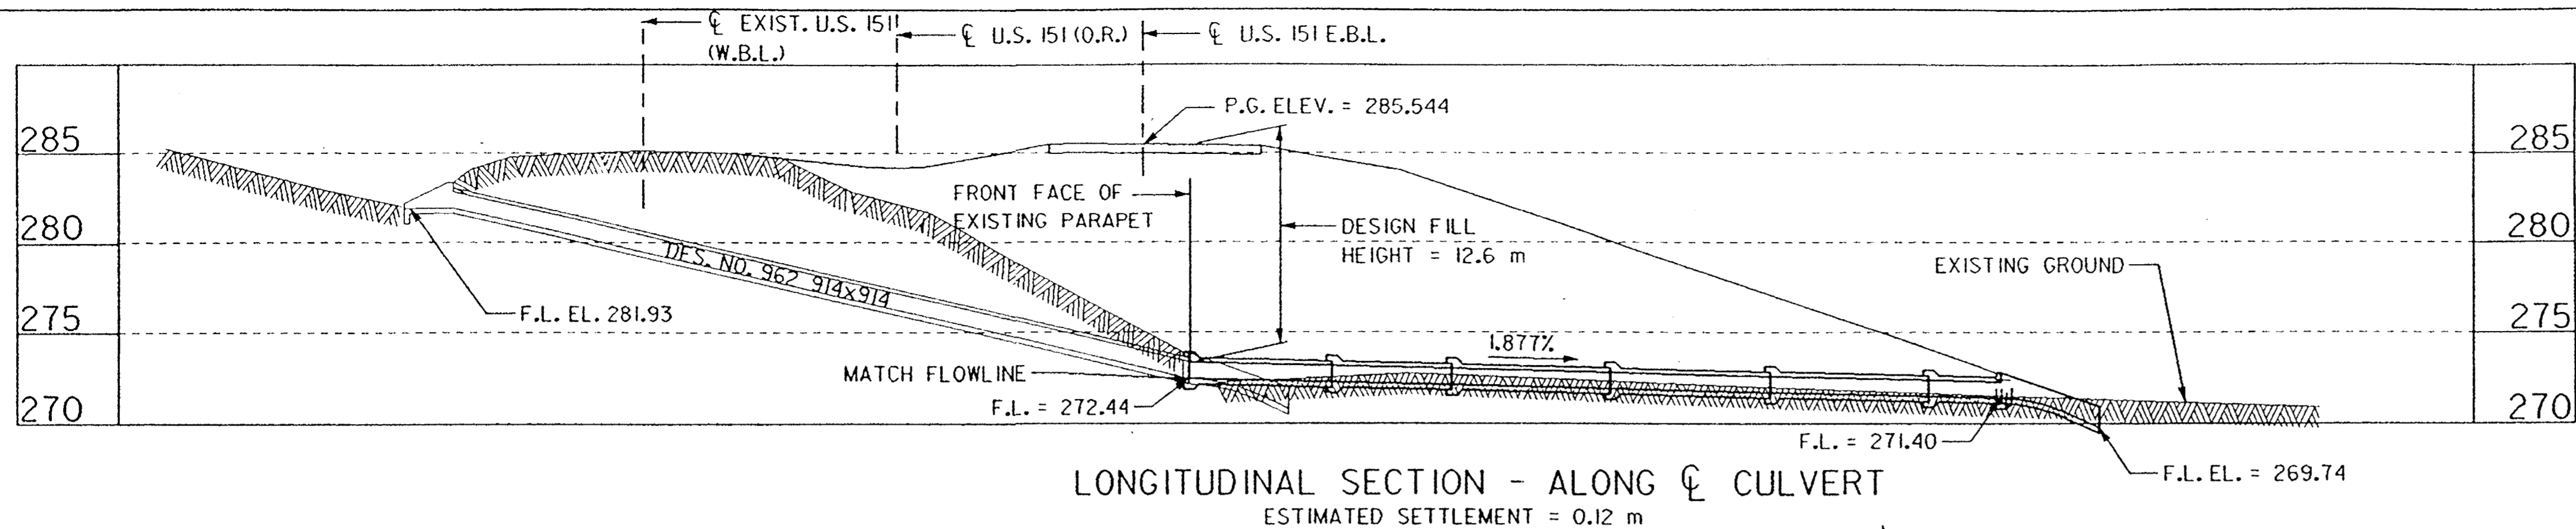

HYDRAULIC DATA


FREQUENCY	DISCHARGE(cms)	HEADWATER ELEV.
10-YEAR	0.65	282.52
25-YEAR	0.75	282.58
50-YEAR	0.93	282.69
100-YEAR	1.12	282.80

DRAINAGE AREA = 3.6 ha, HILLY
50 YEAR DESIGN FREQUENCY

LOCATION
U.S. 151
T84N - R4W
SECTION 21
FAIRVIEW TWP.
JONES COUNTY

TRAFFIC DATA

2001	ADT	7140
2021	ADT	8560
2021	DHV	920
2001	TRUCKS	10%
2021	TRUCKS	11%

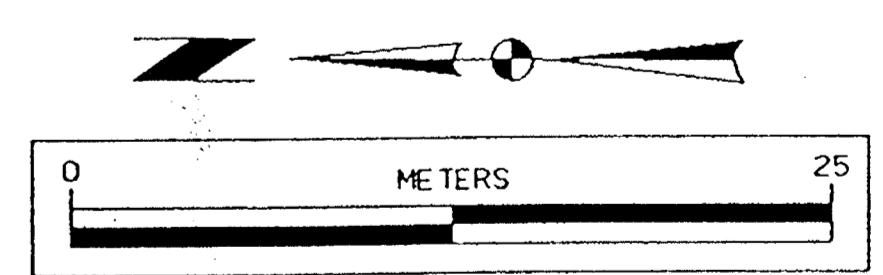

DESIGN FOR EXTENSION TO A 0° SKEW
0.9 m x 0.9 m REINFORCED CONCRETE BOX CULVERT SITUATION PLAN
STA. 88+53.0 (O.R.) U.S. HIGHWAY 151
FEBRUARY, 1999
JONES COUNTY
IOWA DEPARTMENT OF TRANSPORTATION - PROJECT DEVELOPMENT DIVISION
DESIGN SHEET NO. 2 OF 9 FILE NO. 29164 DESIGN NO. 598

ALL DIMENSIONS SHOWN ARE IN MILLIMETERS (mm)
UNLESS OTHERWISE NOTED OR SHOWN.
ALL STATIONS AND ELEVATIONS SHOWN ARE IN METERS.


DESIGNED BY DLN CHECKED BY RMJ
DETAILED BY JAE CADD FILE H53598.S02

EARTH TECH

LINN/JONES COUNTY

PROJECT NUMBER NHSX-151-3(112)--3H-57

STATE IOWA FHWY REGION 7 FISCAL YEAR SHEET NO. V.03 TOTAL SHEETS

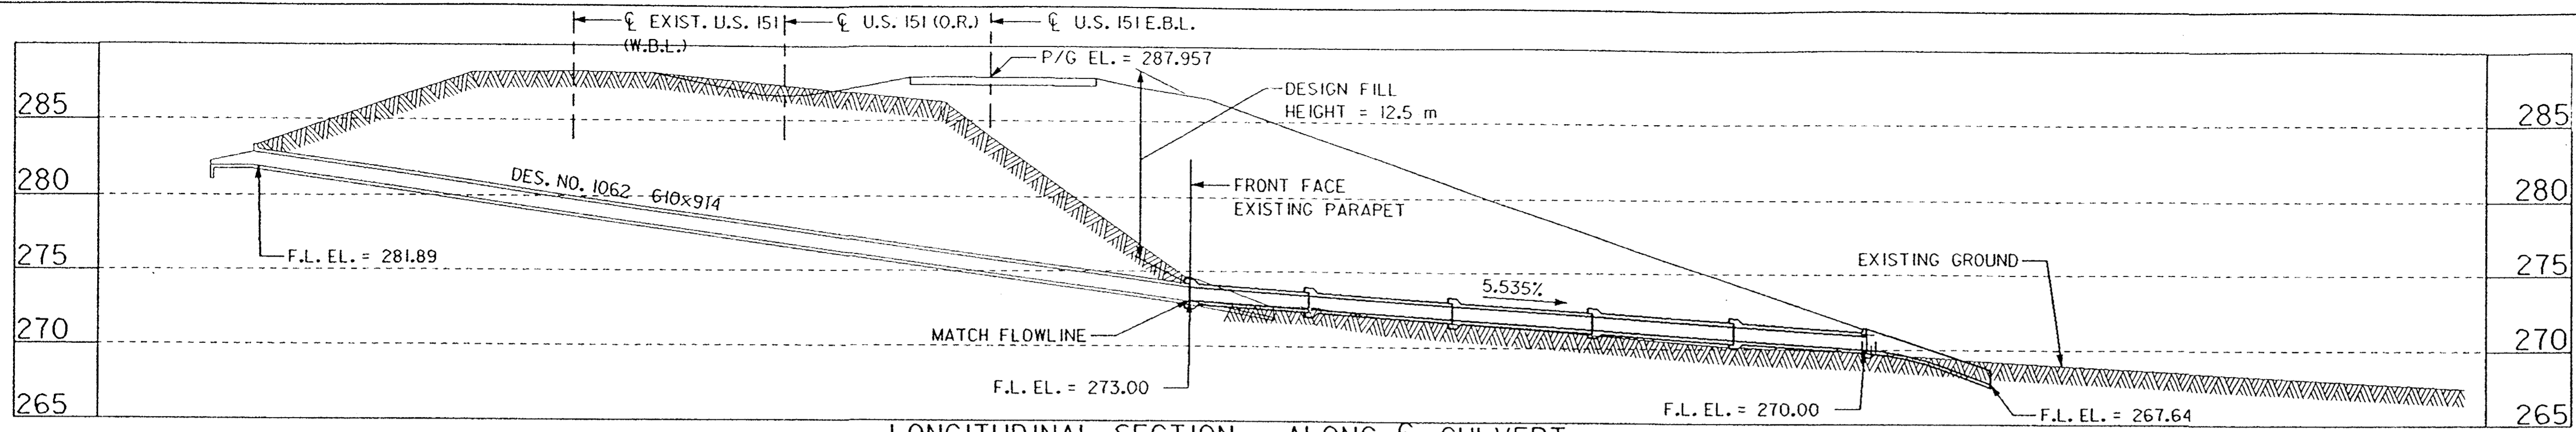


BENCH MARK:
 FOR NEW BENCH MARK INFORMATION,
 SEE PAGE G.18

STA. 93+50.000 (O.R.)
 EL. 291.102
 VCL=560.000 m

U.S. HWY. 151 PROFILE GRADE


LONGITUDINAL SECTION - ALONG CULVERT
 ESTIMATED SETTLEMENT = 0.13 m

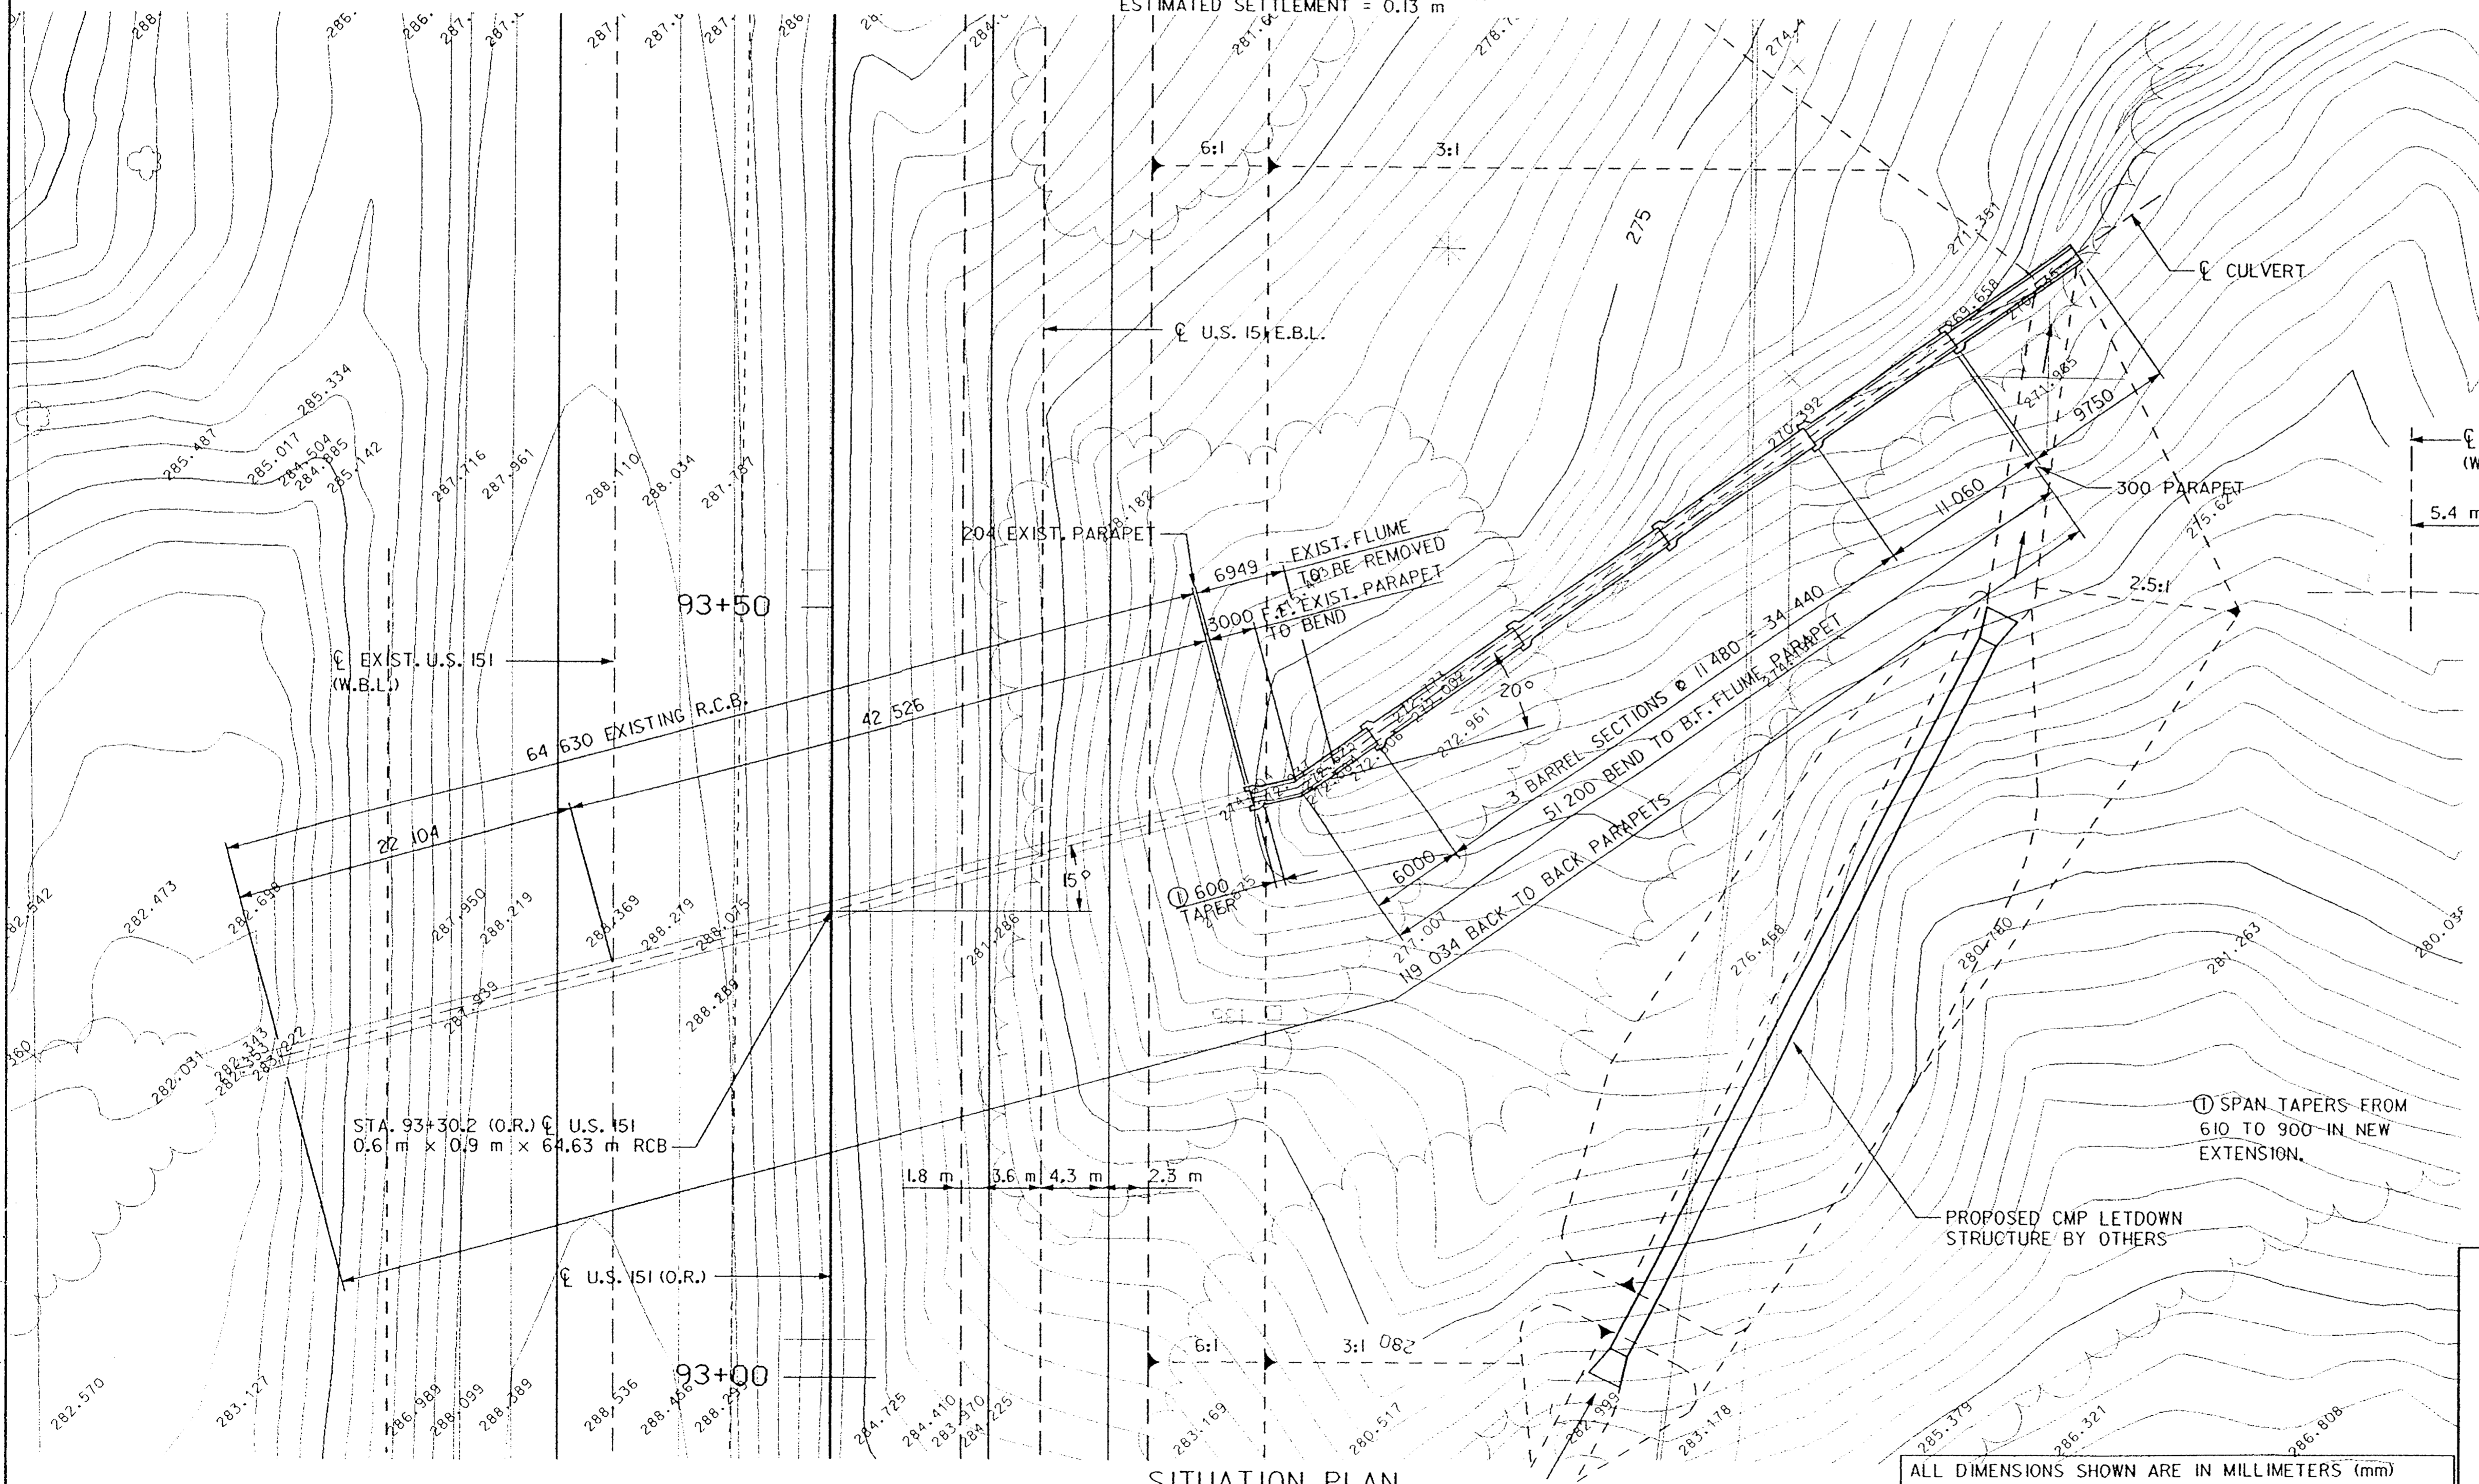

HYDRAULIC DATA

FREQUENCY	DISCHARGE (cms)	HEADWATER ELEV.
10-YEAR	0.71	282.72
25-YEAR	0.81	282.81
50-YEAR	1.01	282.99
100-YEAR	1.21	283.19

DRAINAGE AREA = 4.0 ha, HILLY
 50 YEAR DESIGN FREQUENCY

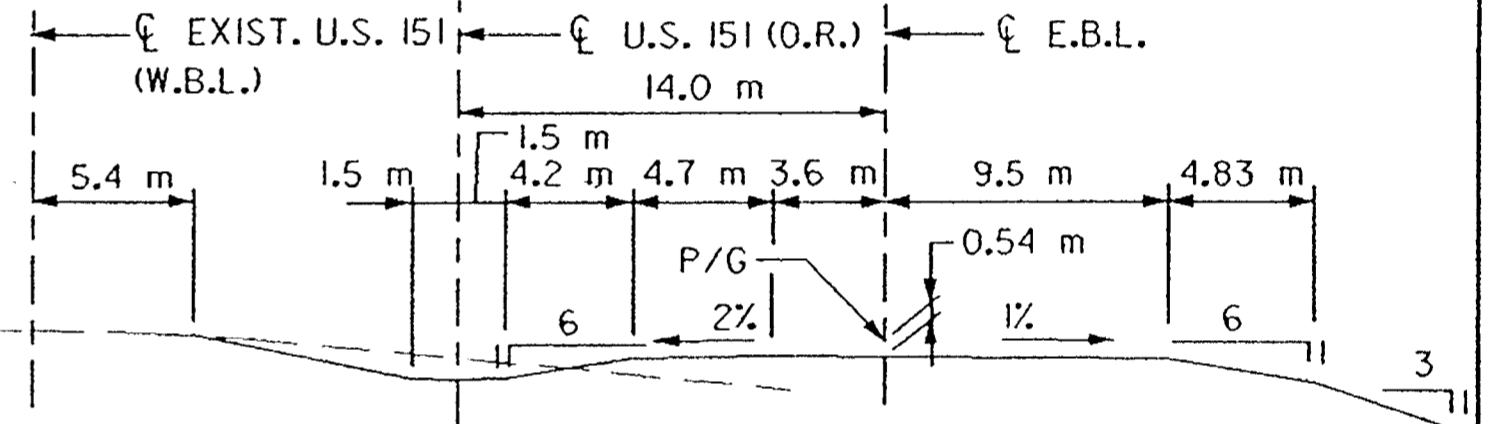


TRAFFIC DATA

Year	ADT	DHV	TRUCKS (%)
2001	7140	920	10%
2021	8560	920	11%

LOCATION

U.S. 151
 T84N - R4W
 SECTION 21
 FAIRVIEW TWP.
 JONES COUNTY

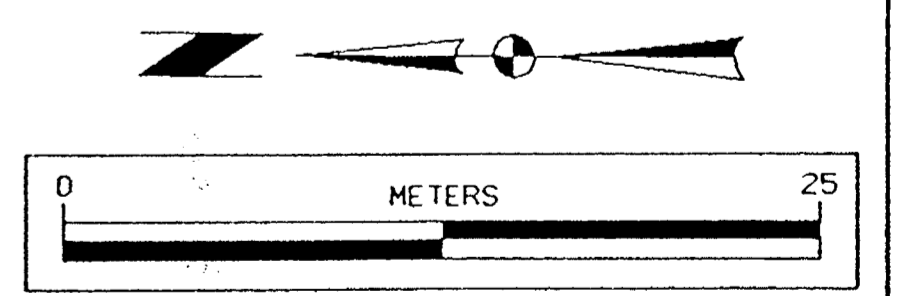

DESIGN FOR EXTENSION TO A 15° SKEW (R.A.)
0.6 m x 0.9 m TO 0.9 m x 0.9 m
REINFORCED CONCRETE BOX CULVERT
SITUATION PLAN


STA. 93+30.2 (O.R.) U.S. HIGHWAY 151

FEBRUARY, 1999


JONES COUNTY
 IOWA DEPARTMENT OF TRANSPORTATION - PROJECT DEVELOPMENT DIVISION
 DESIGN SHEET NO. 2 OF 7 FILE NO. 29164 DESIGN NO. 698

ALL DIMENSIONS SHOWN ARE IN MILLIMETERS (mm)
 UNLESS OTHERWISE NOTED OR SHOWN.
 ALL STATIONS AND ELEVATIONS SHOWN ARE IN METERS.


DESIGNED BY DLN CHECKED BY RMJ
 DETAILED BY JAE CADD FILE H53698.S02

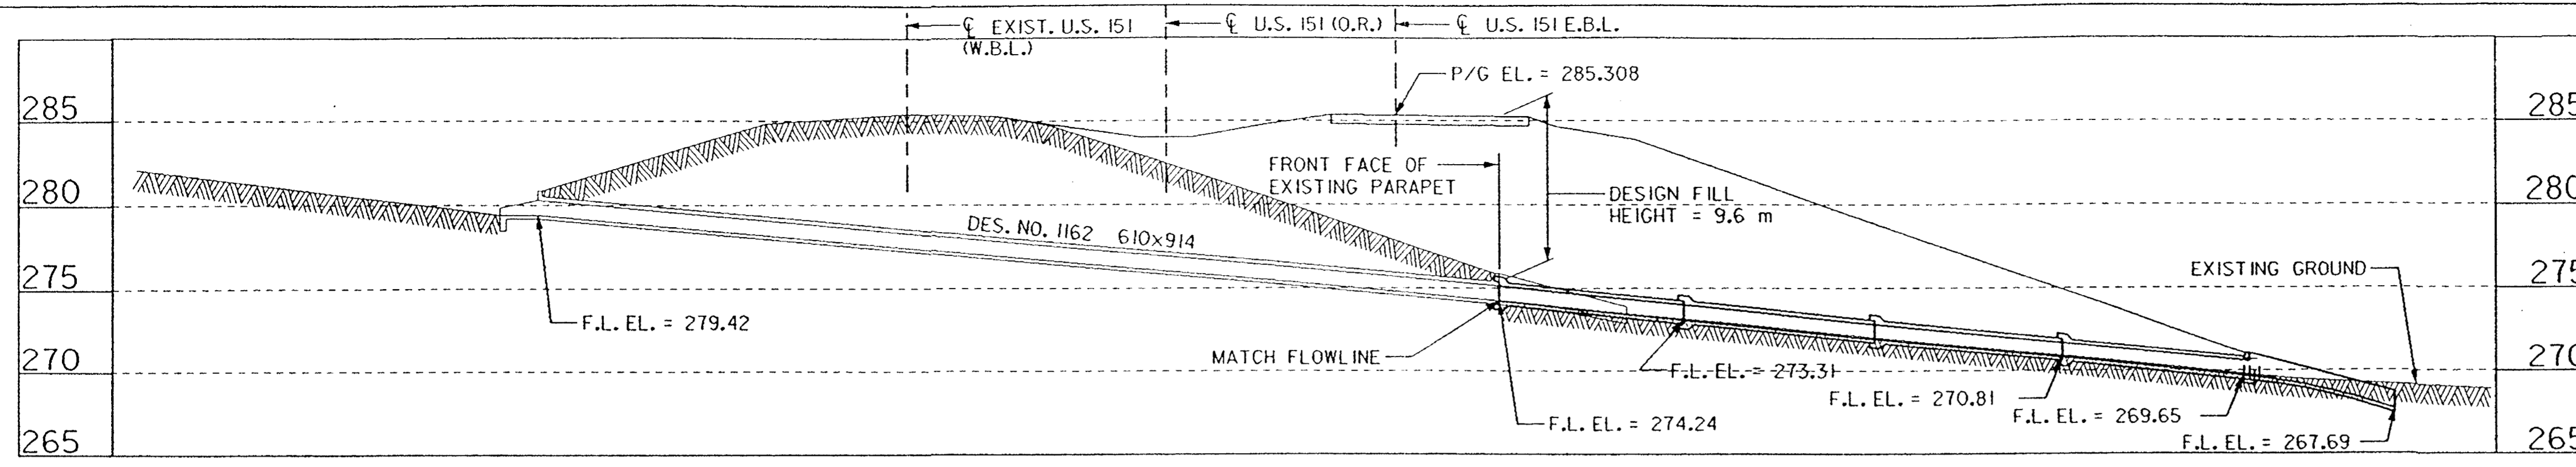

BENCH MARK:
FOR NEW BENCH MARK INFORMATION, SEE PAGE G.18

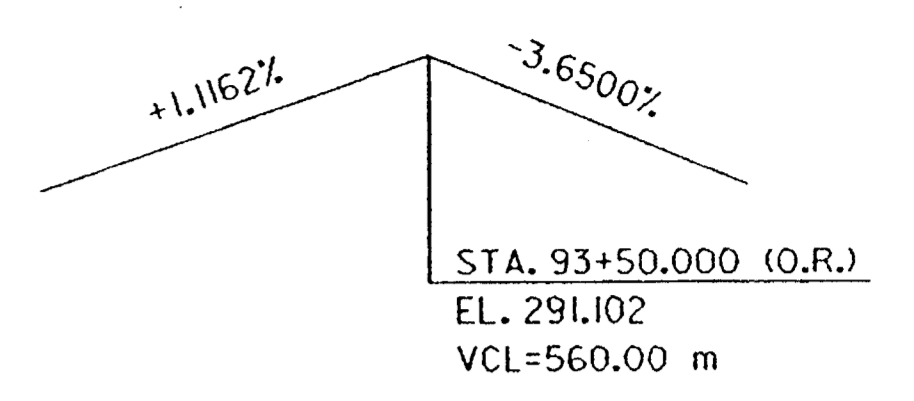

LONGITUDINAL SECTION - ALONG CULVERT
ESTIMATED SETTLEMENT = 0.18 m

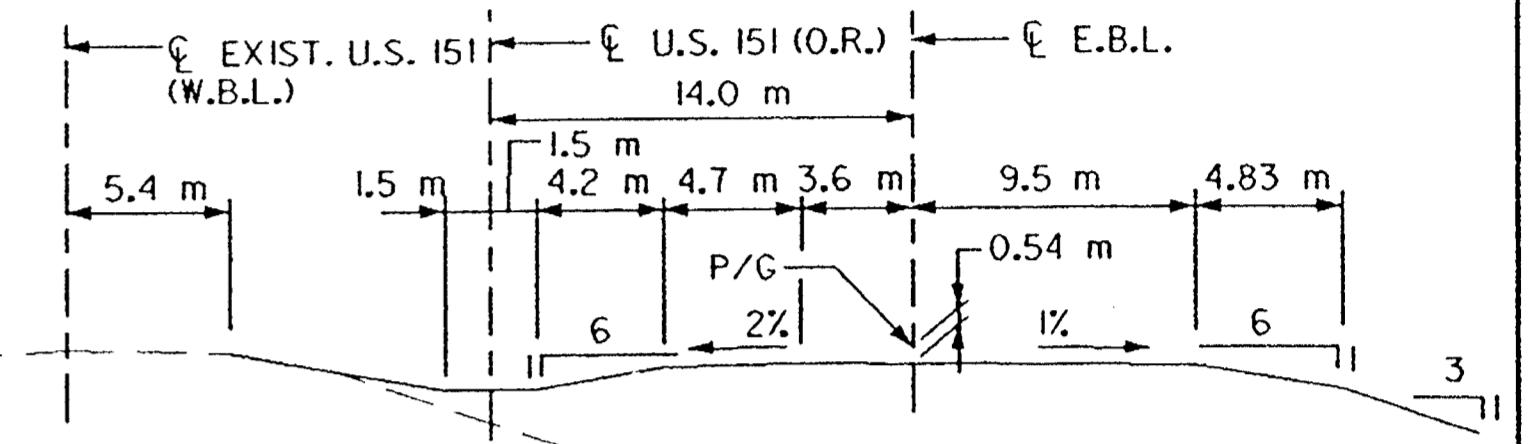



TYPICAL APPROACH SECTION

HYDRAULIC DATA		
FREQUENCY	DISCHARGE (cms)	HEADWATER ELEV.
10-YEAR	0.36	279.94
25-YEAR	0.41	279.99
50-YEAR	0.51	280.08
100-YEAR	0.62	280.18

DRAINAGE AREA = 1.6 ha, HILLY
50 YEAR DESIGN FREQUENCY

LOCATION
U.S. 151
T84N - R4W
SECTION 21
FAIRVIEW TWP.
JONES COUNTY

TRAFFIC DATA		
2001	ADT	7140
2021	ADT	8560
2021	DHV	920
2001	TRUCKS	10%
2021	TRUCKS	11%

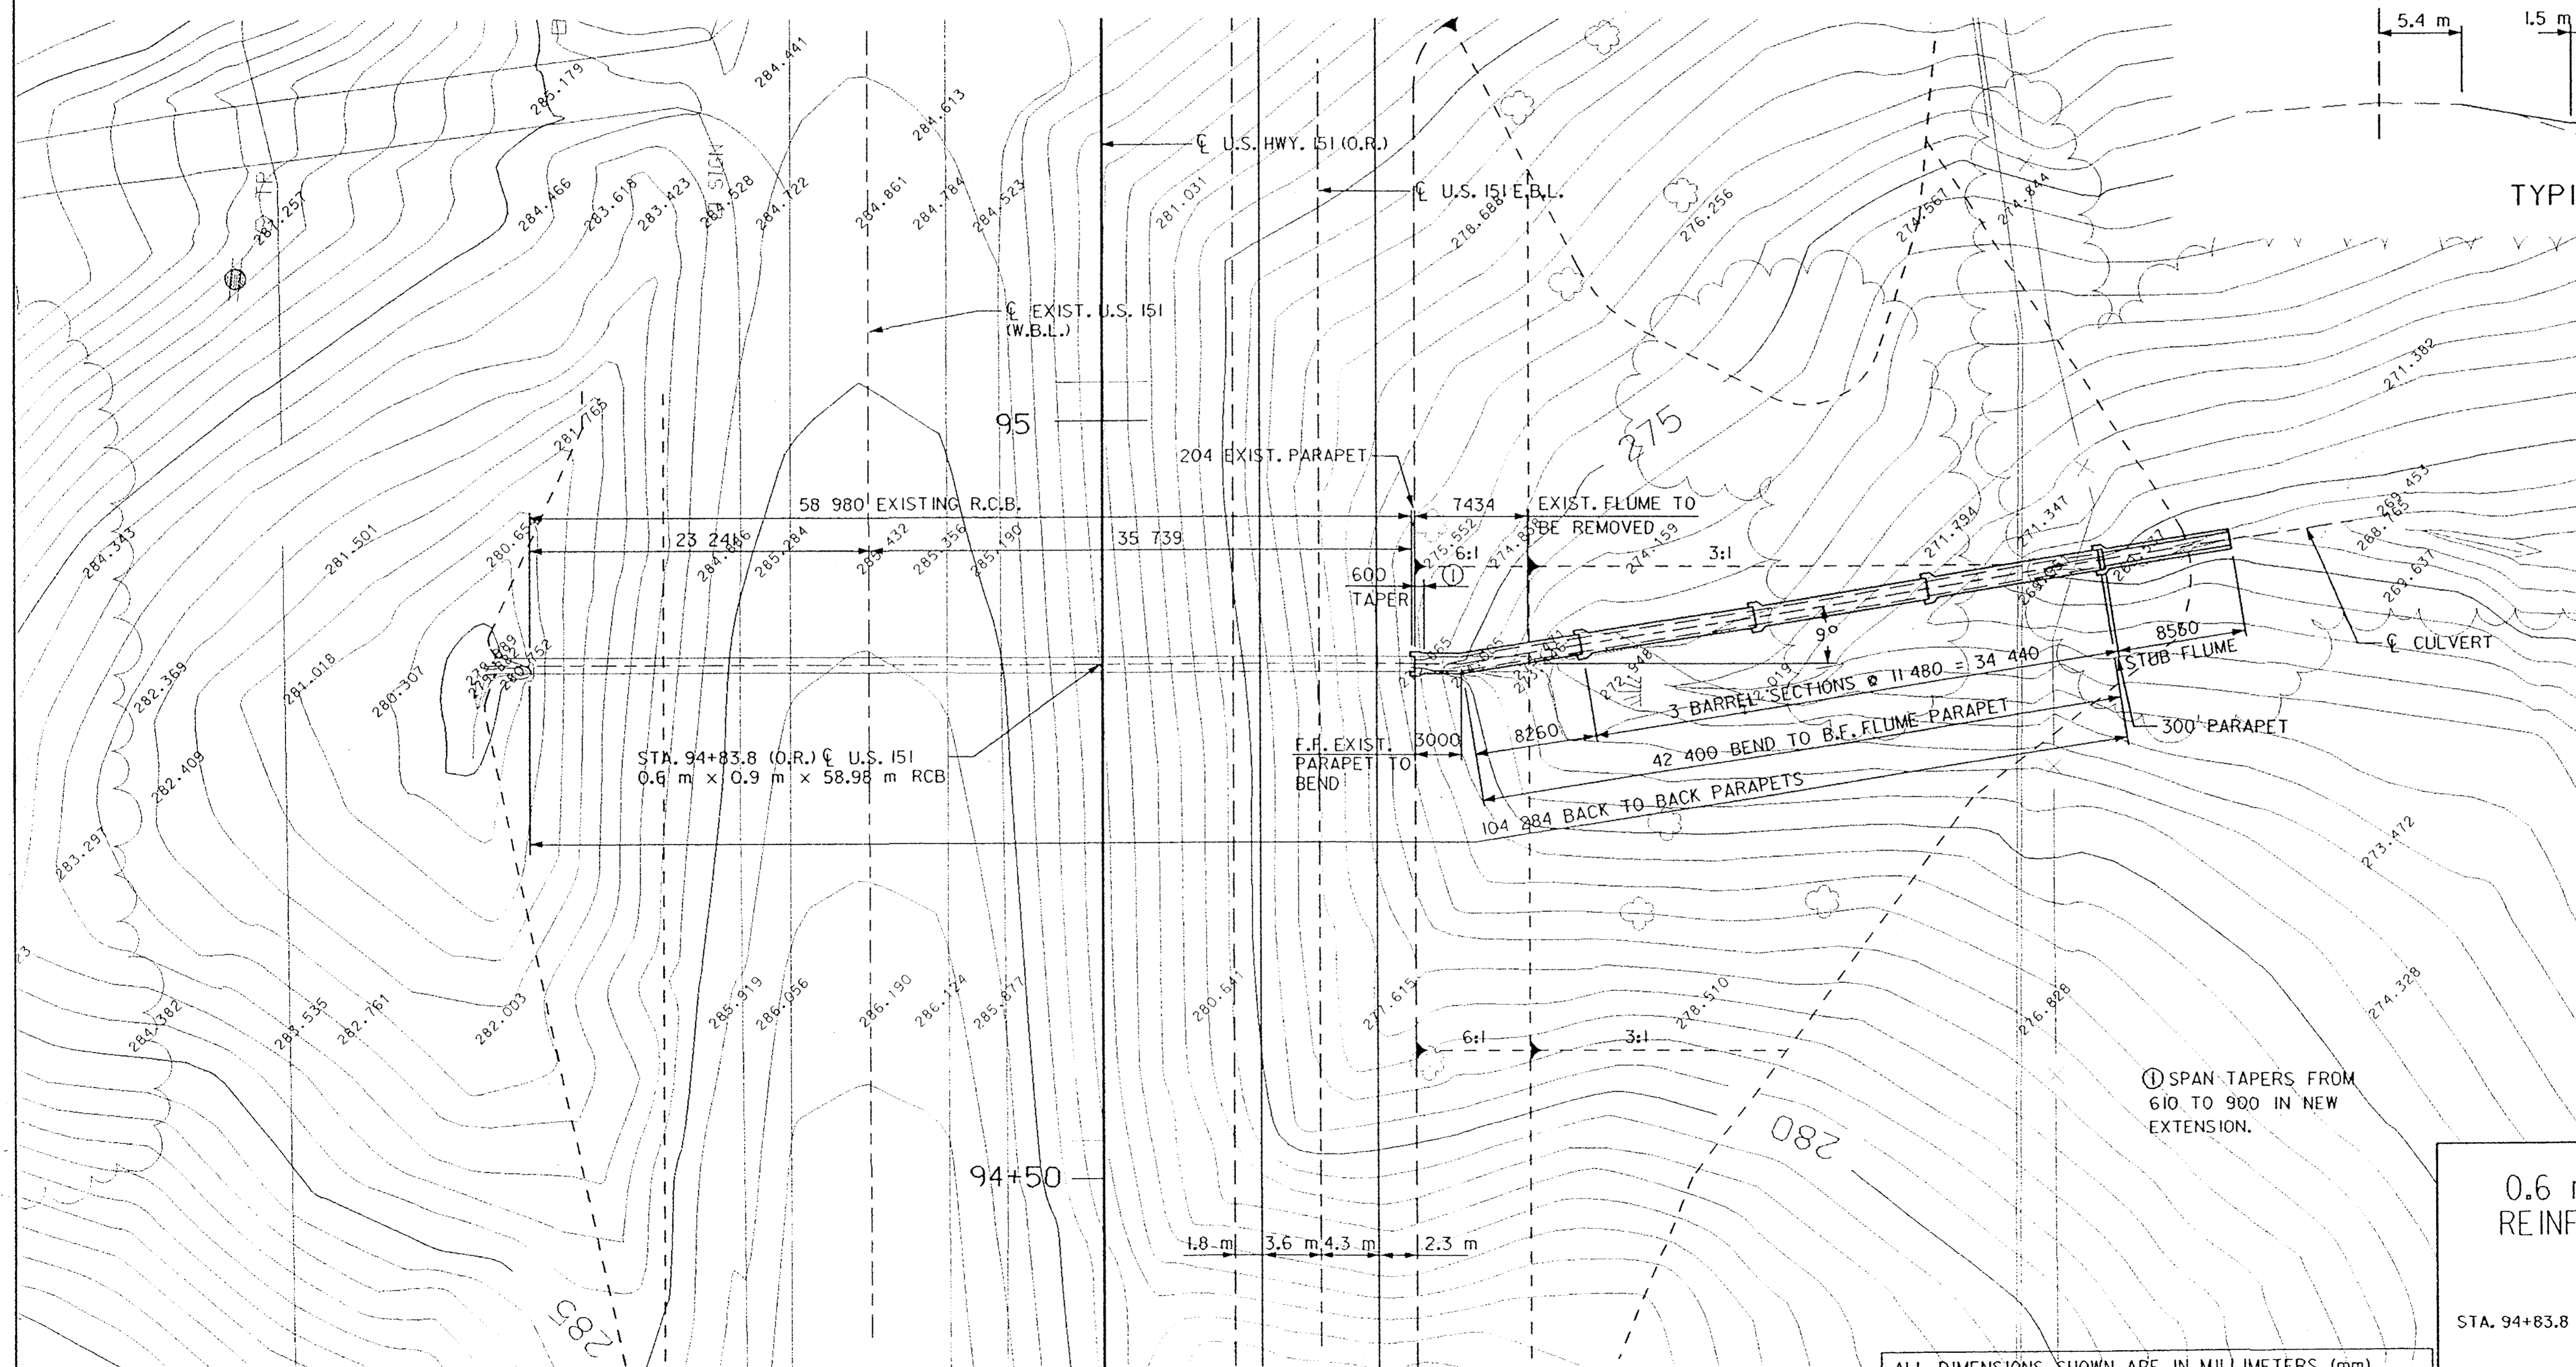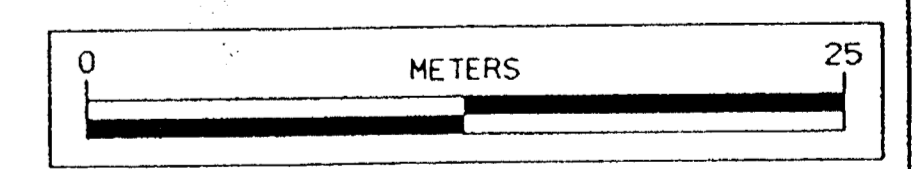

SITUATION PLAN
FILL HT. = 9.6 m

DESIGN FOR EXTENSION TO A 0° SKEW
0.6 m x 0.9 m TO 0.9 m x 0.9 m
REINFORCED CONCRETE BOX CULVERT
SITUATION PLAN
STA. 94+83.8 (O.R.) U.S. HIGHWAY 151
JONES COUNTY
IOWA DEPARTMENT OF TRANSPORTATION - PROJECT DEVELOPMENT DIVISION
DESIGN SHEET NO. 2 OF 7 FILE NO. 29164 DESIGN NO. 798
FEBRUARY, 1999

ALL DIMENSIONS SHOWN ARE IN MILLIMETERS (mm)
UNLESS OTHERWISE NOTED OR SHOWN.
ALL STATIONS AND ELEVATIONS SHOWN ARE IN METERS.


DESIGNED BY RMJ CHECKED BY DLN
DETAILED BY MAP CADD FILE H53798.S02

EARTH TECH

LINN/JONES COUNTY


PROJECT NUMBER NHX-151-3(112)-3H-57

STATE	FHWA REGION	FISCAL YEAR	SHEET NO.	TOTAL SHEETS
IOWA	7		V.05	

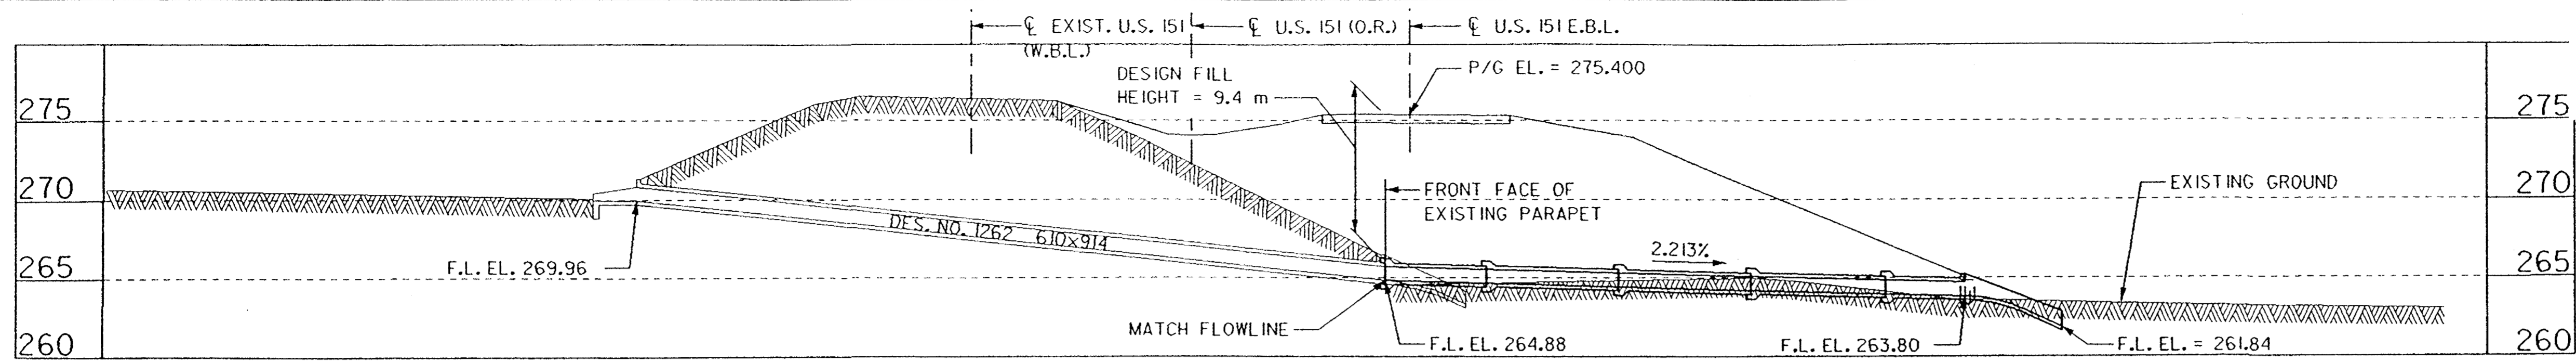

LONGITUDINAL SECTION - ALONG CULVERT
ESTIMATED SETTLEMENT = 0.06 m

BENCH MARK:
FOR NEW BENCH MARK INFORMATION, SEE PAGE G.18

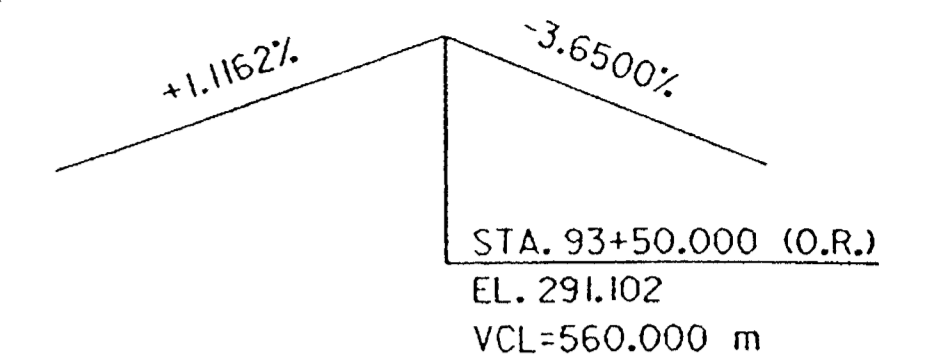

U.S. HWY. 151 PROFILE GRADE

HYDRAULIC DATA		
FREQUENCY	DISCHARGE(cms)	HEADWATER ELEV.
10-YEAR	0.76	270.85
25-YEAR	0.87	270.95
50-YEAR	1.08	271.14
100-YEAR	1.30	271.38


DRAINAGE AREA = 4.5 ha, HILLY
50 YEAR DESIGN FREQUENCY

LOCATION


U.S. 151
T84N - R4W
SECTION 21
FAIRVIEW TWP.
JONES COUNTY

TRAFFIC DATA

2001 ADT 7140
2021 ADT 8560
2021 DHV 920
2001 TRUCKS 10%
2021 TRUCKS 11%

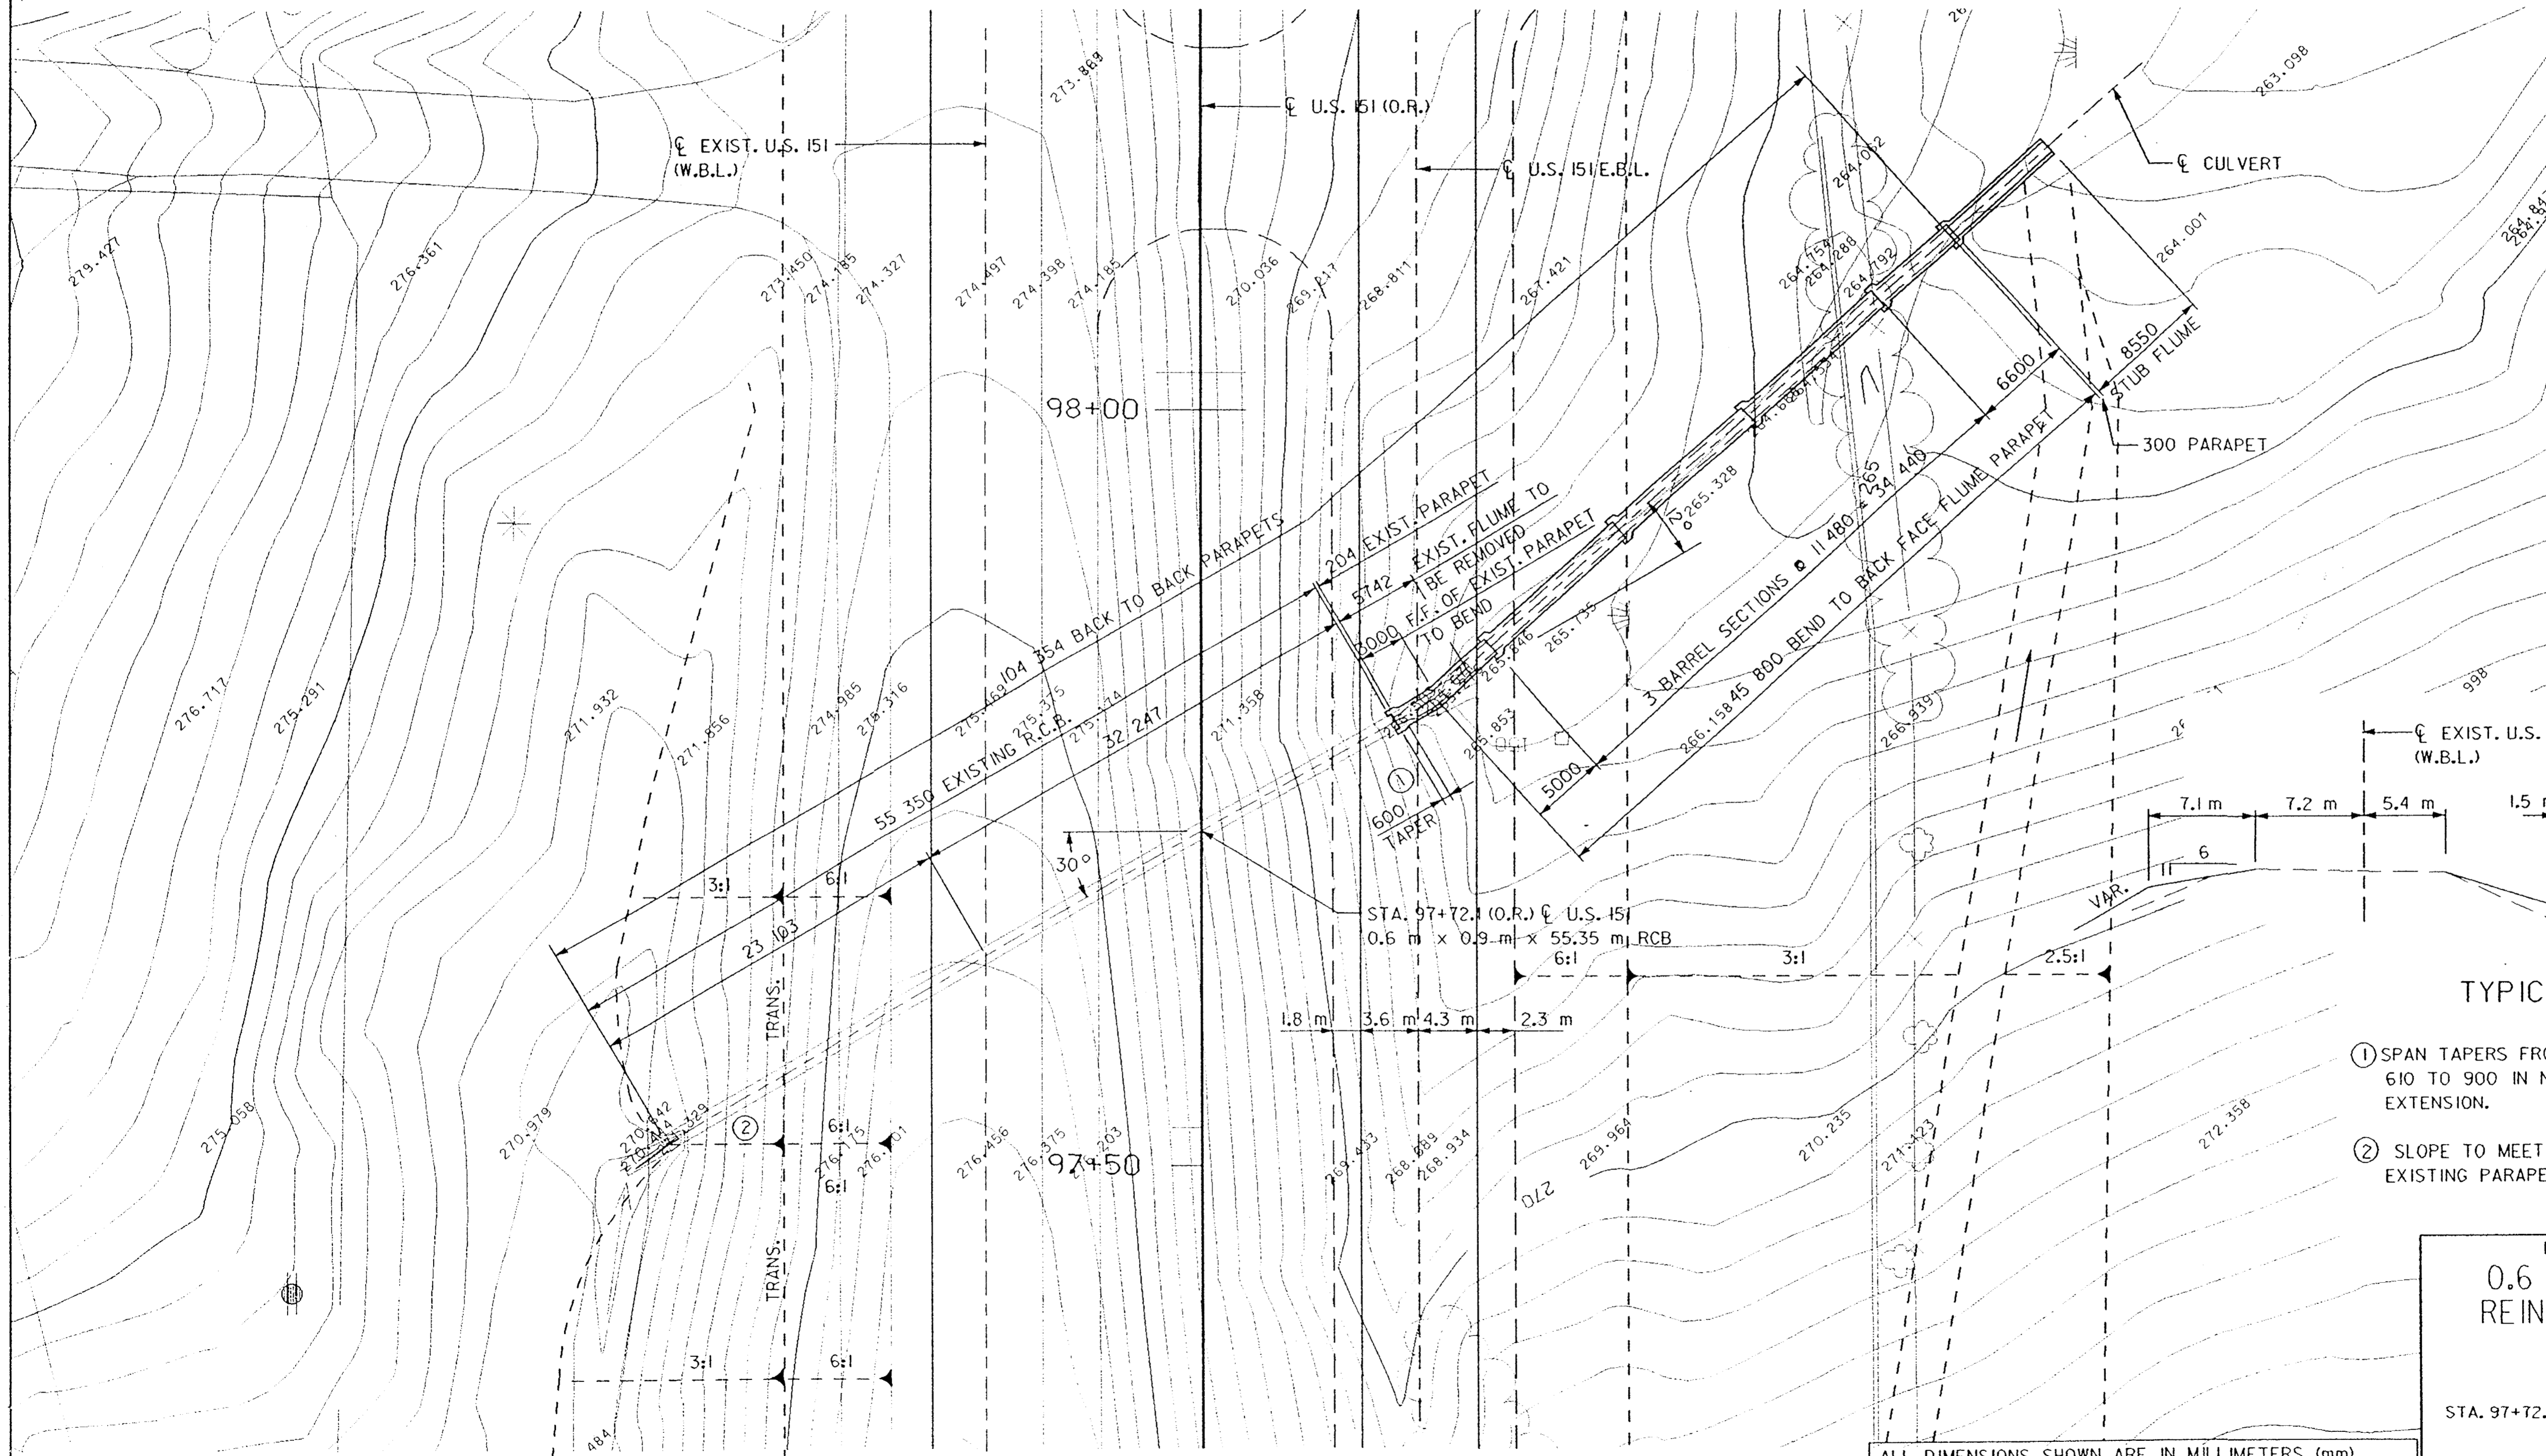


SITUATION PLAN

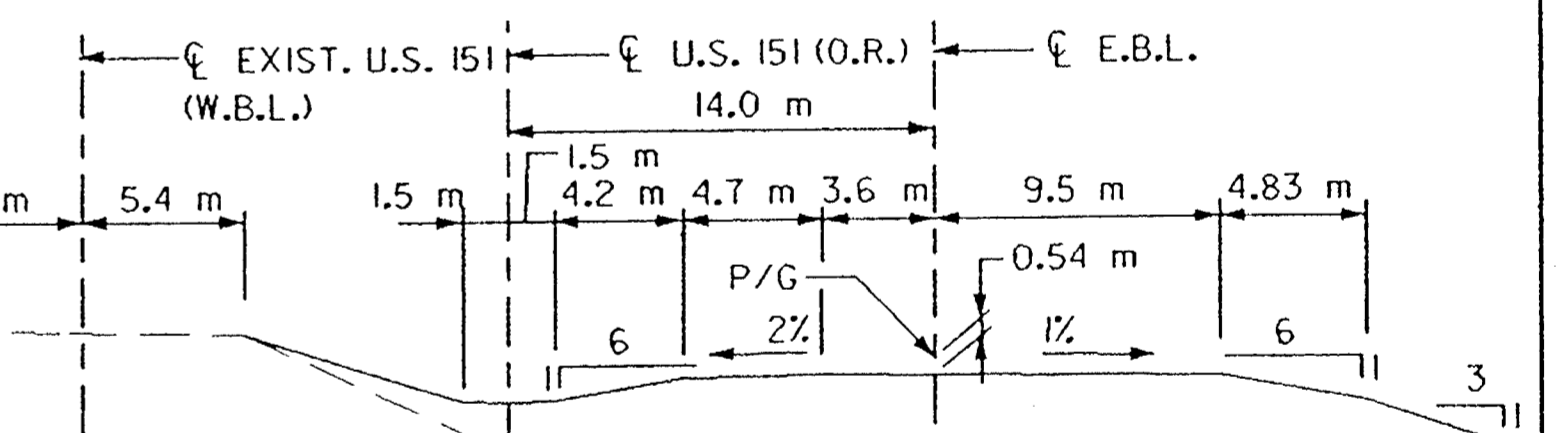


TYPICAL APPROACH SECTION

- ① SPAN TAPERS FROM 610 TO 900 IN NEW EXTENSION.
- ② SLOPE TO MEET EXISTING PARAPET

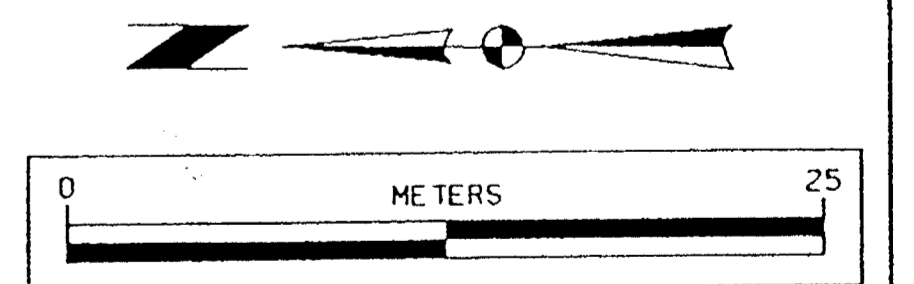


DESIGN FOR EXTENSION TO A 30° SKEW (I.A.)
**0.6 m x 0.9 m TO 0.9 m x 0.9 m
REINFORCED CONCRETE BOX CULVERT
SITUATION PLAN**
STA. 97+72.1 (O.R.) U.S. HIGHWAY 151
JONES COUNTY
IOWA DEPARTMENT OF TRANSPORTATION - PROJECT DEVELOPMENT DIVISION
DESIGN SHEET NO. 2 OF 7 FILE NO. 29164 DESIGN NO. 898
FEBRUARY, 1999

ALL DIMENSIONS SHOWN ARE IN MILLIMETERS (mm)
UNLESS OTHERWISE NOTED OR SHOWN.
ALL STATIONS AND ELEVATIONS SHOWN ARE IN METERS.

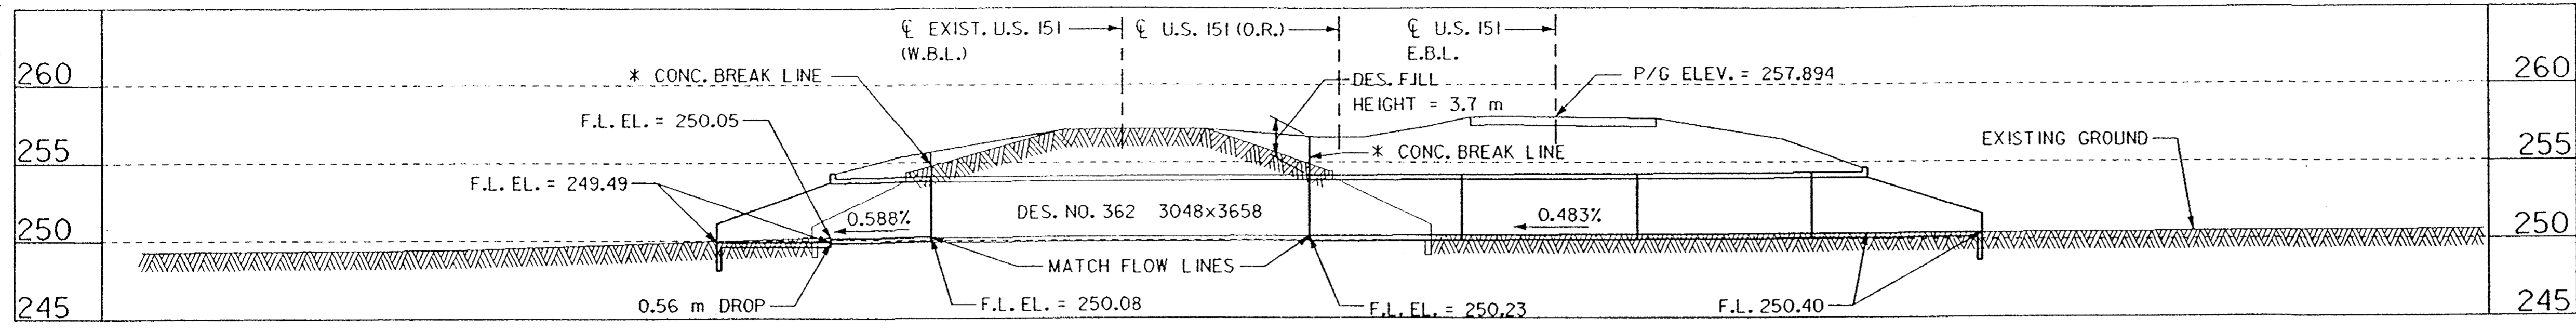


BENCH MARK:
FOR NEW BENCH MARK INFORMATION, SEE PAGE G.18

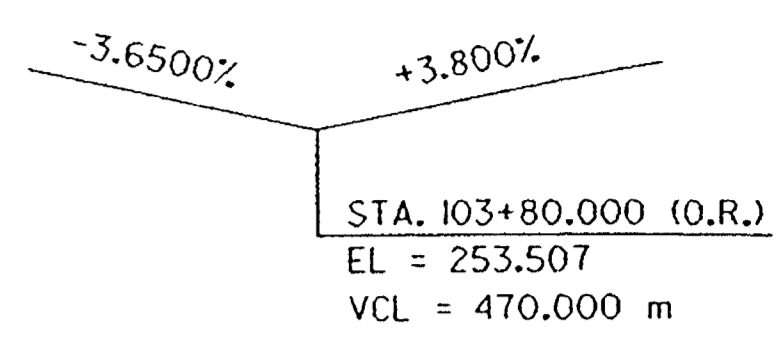


U.S. HWY. 151 PROFILE GRADE

* SEE PART REMOVAL PLANS ON DESIGN SHEETS 3 AND 5.

LONGITUDINAL SECTION - ALONG ϕ CULVERT
ESTIMATED SETTLEMENT = 0.05 m

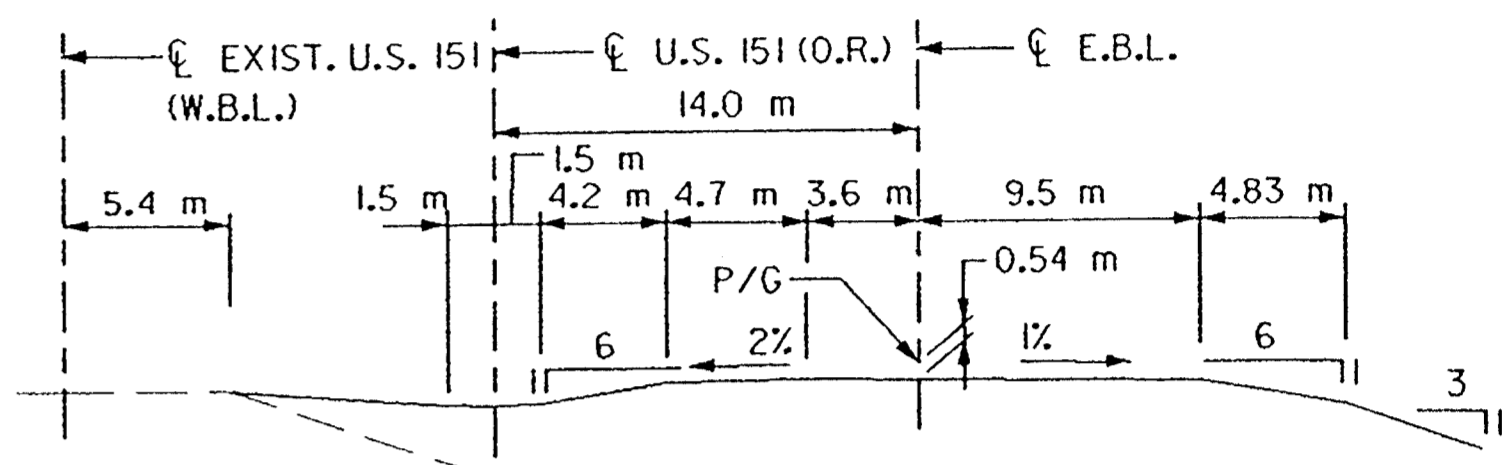

TYPICAL APPROACH SECTION

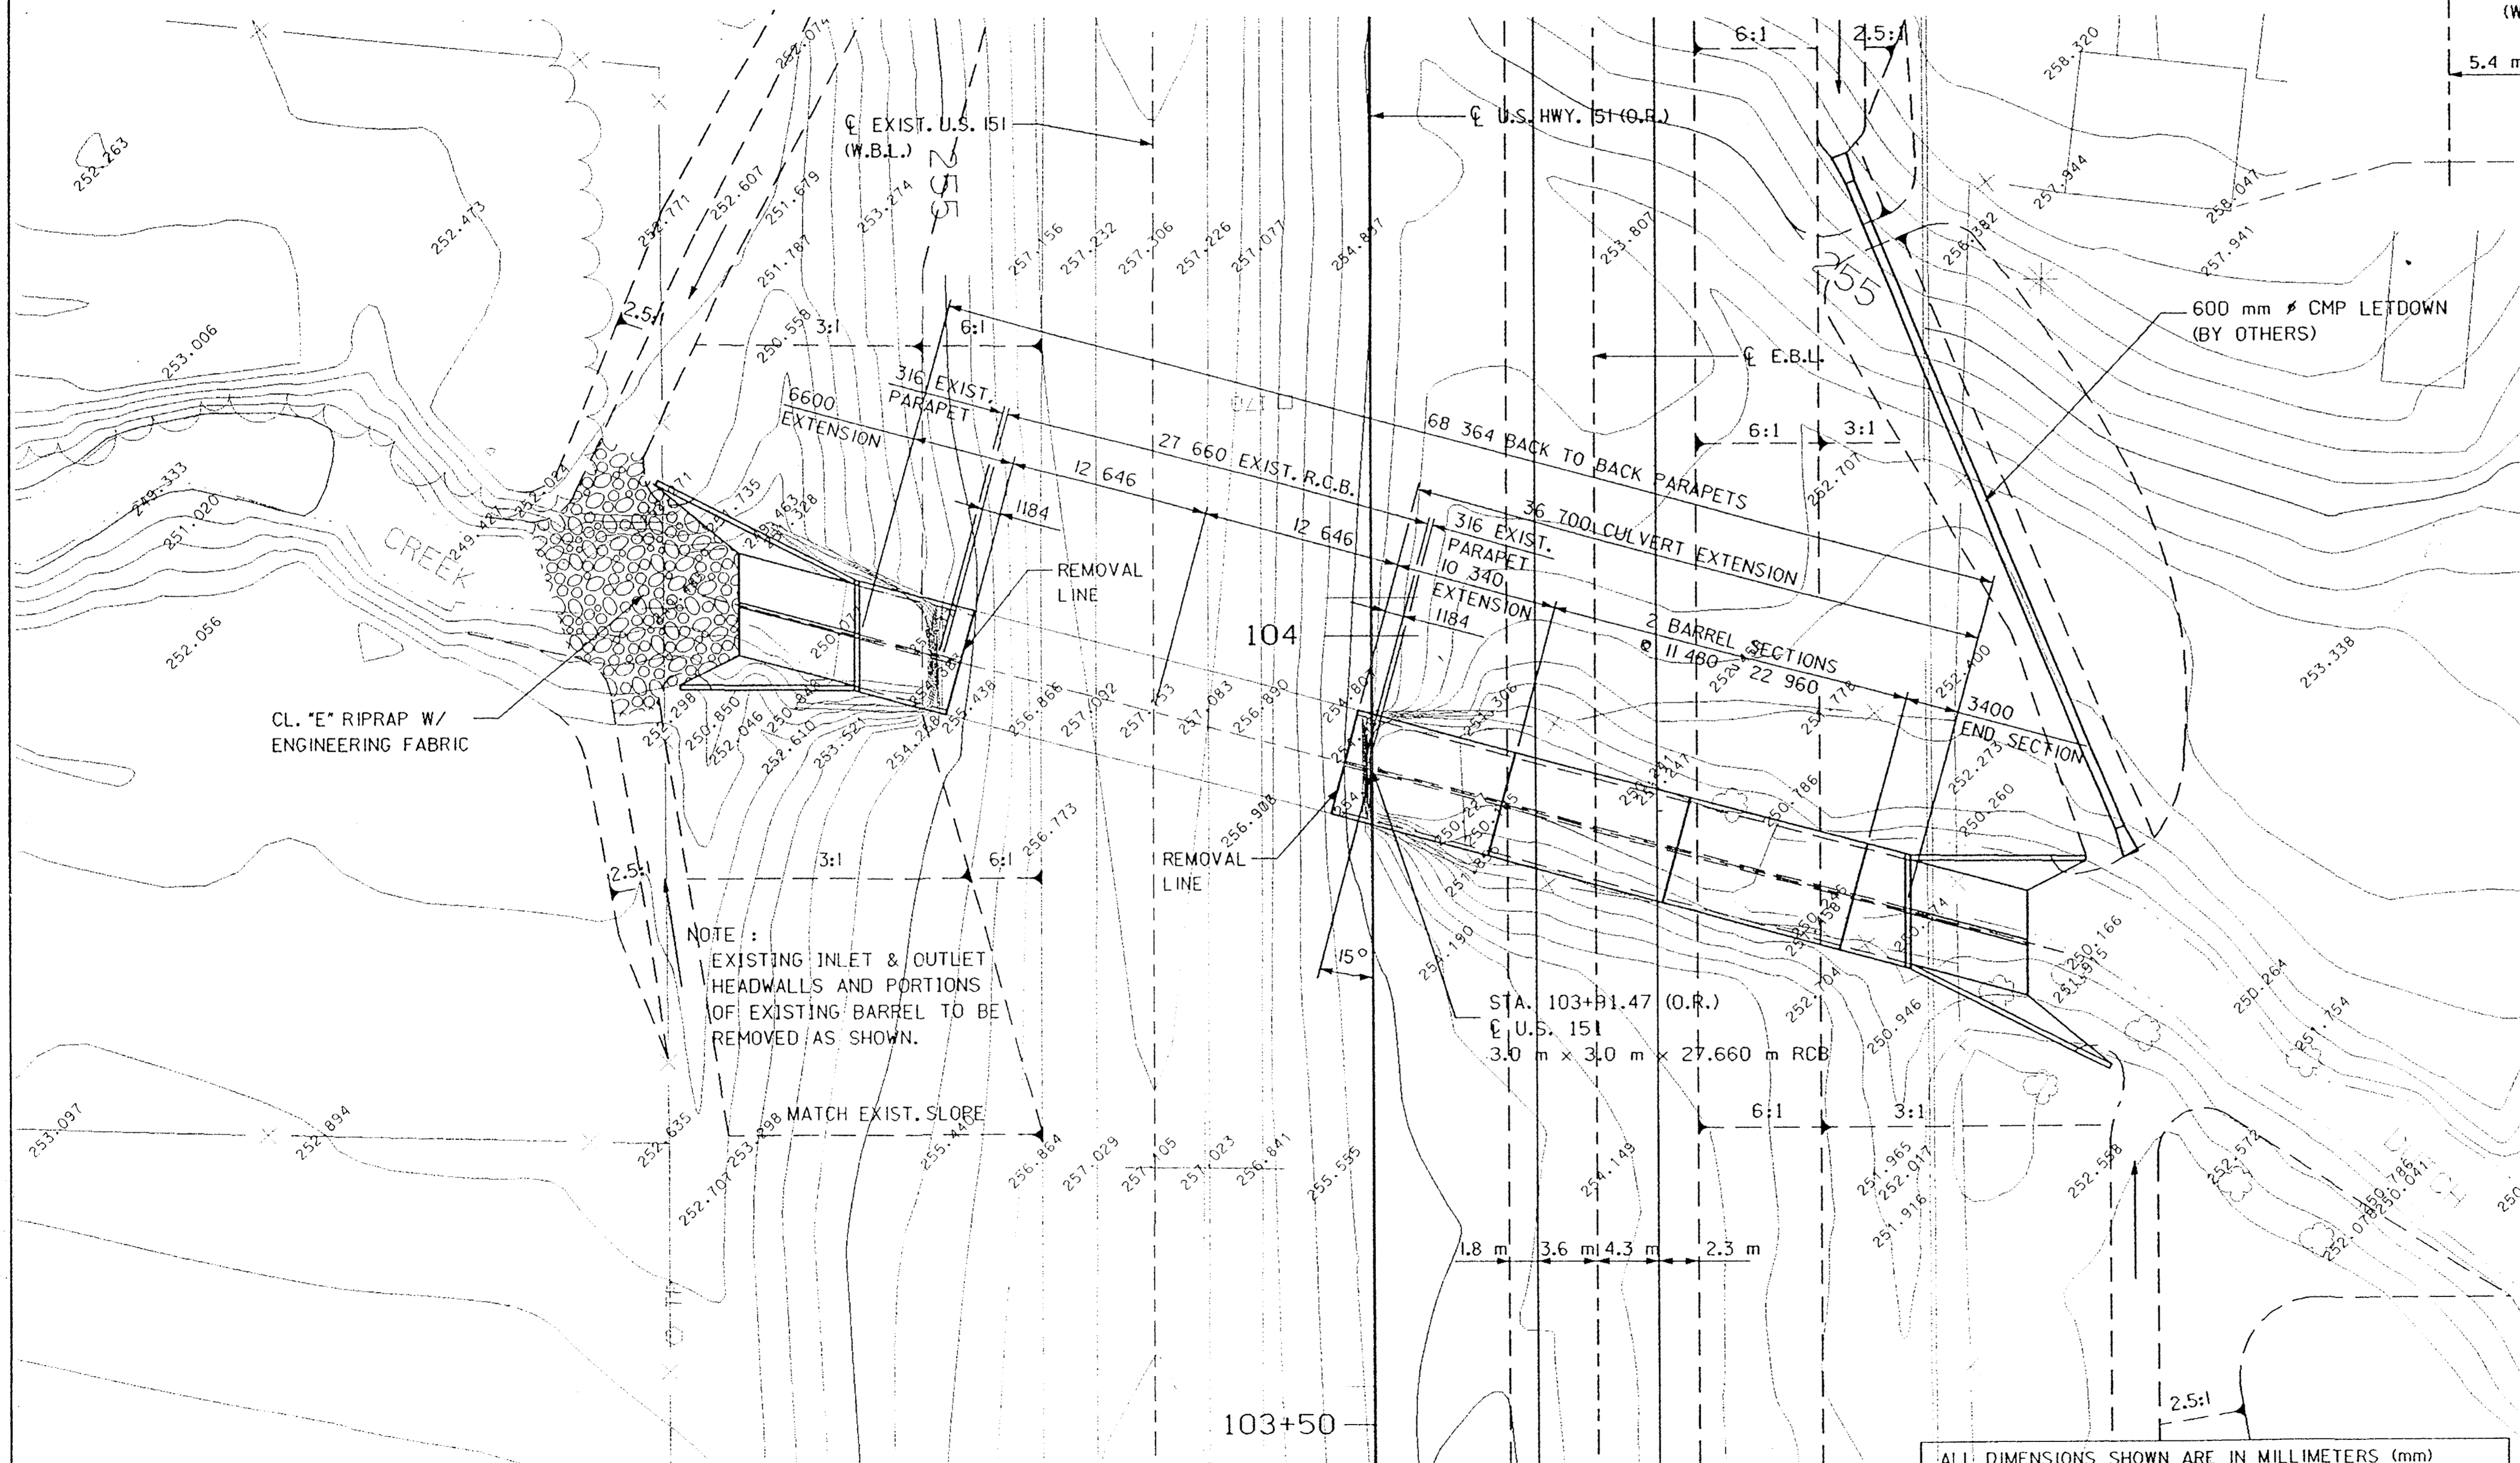

HYDRAULIC DATA

FREQUENCY	DISCHARGE(cms)	HEADWATER ELEV.
10-YEAR	23.81	252.55
25-YEAR	33.73	252.90
50-YEAR	41.66	253.27
100-YEAR	50.31	253.65
500-YEAR	67.70	254.42


DRAINAGE AREA = 1040.0 ha, ROLLING
50 YEAR DESIGN FREQUENCY

LOCATION

U.S. 151
T84N - R4W
SECTION 22
FAIRVIEW TWP.
JONES COUNTY

TRAFFIC DATA

2001 ADT 7140
2021 ADT 8560
2021 DHV 920
2001 TRUCKS 10%
2021 TRUCKS 11%

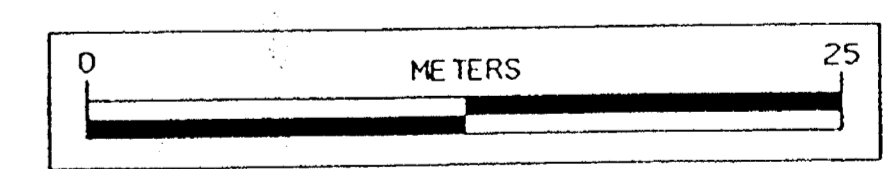

DESIGN FOR EXTENSION TO A 15° SKEW (L.A.)
**TWIN 3.0 m x 3.6 m
REINFORCED CONCRETE BOX CULVERT
SITUATION PLAN**
STA. 103+91.47 (O.R.) ϕ U.S. HIGHWAY 151
JONES COUNTY
IOWA DEPARTMENT OF TRANSPORTATION - PROJECT DEVELOPMENT DIVISION
DESIGN SHEET NO. 2 OF 10 FILE NO. 29164 DESIGN NO. 998
FEBRUARY, 1999

ALL DIMENSIONS SHOWN ARE IN MILLIMETERS (mm)
UNLESS OTHERWISE NOTED OR SHOWN.
ALL STATIONS AND ELEVATIONS SHOWN ARE IN METERS

DESIGNED BY RMJ CHECKED BY DLN
DETAILED BY JAE CADD FILE H53998.S02




LINN/JONES COUNTY


PROJECT NUMBER NHSX-151-3(112)--3H-57

STATE	FHWA REGION	FISCAL YEAR	SHEET NO.	TOTAL SHEETS
IOWA	7		V.07	

160-198

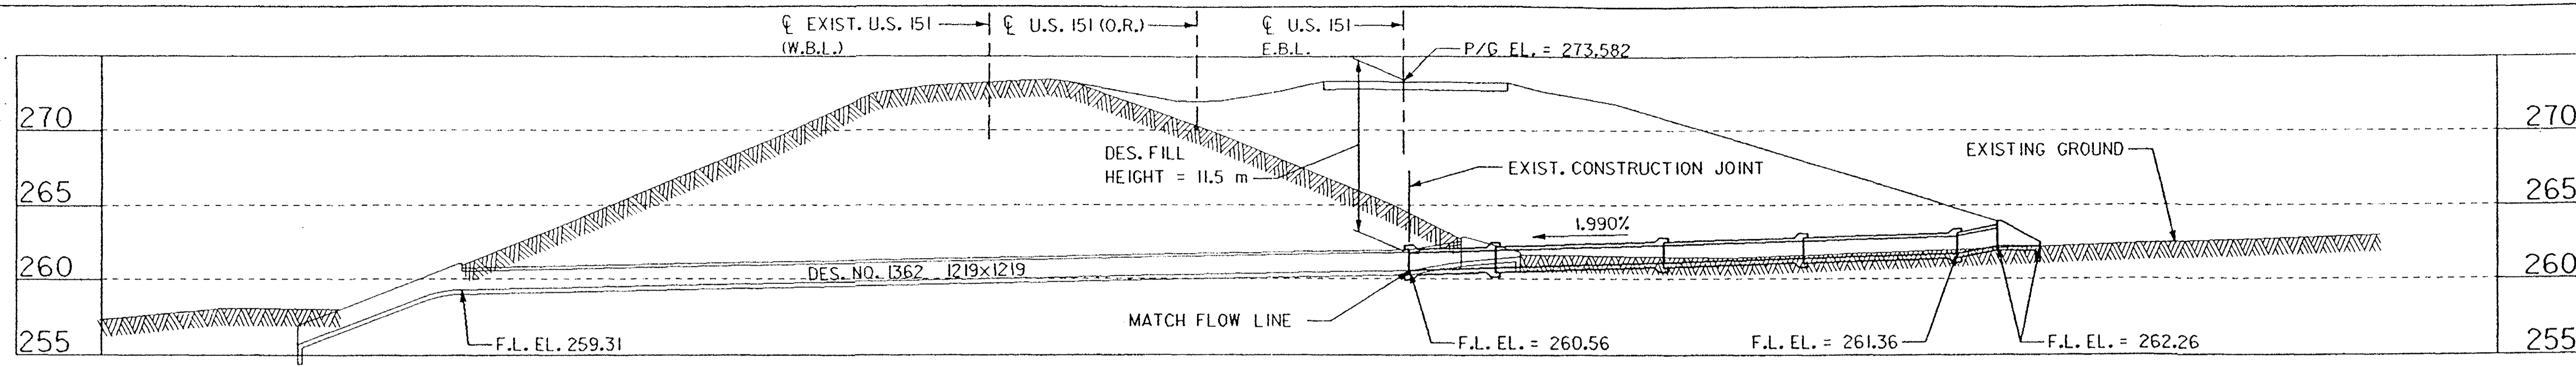


BENCH MARK:
FOR NEW BENCH MARK INFORMATION,
SEE PAGE G.18

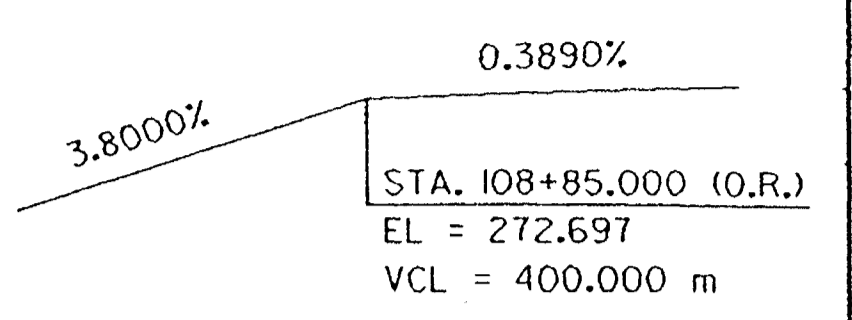

U.S. HWY. 151 PROFILE GRADE

LONGITUDINAL SECTION - ALONG CULVERT
ESTIMATED SETTLEMENT = 0.05 m

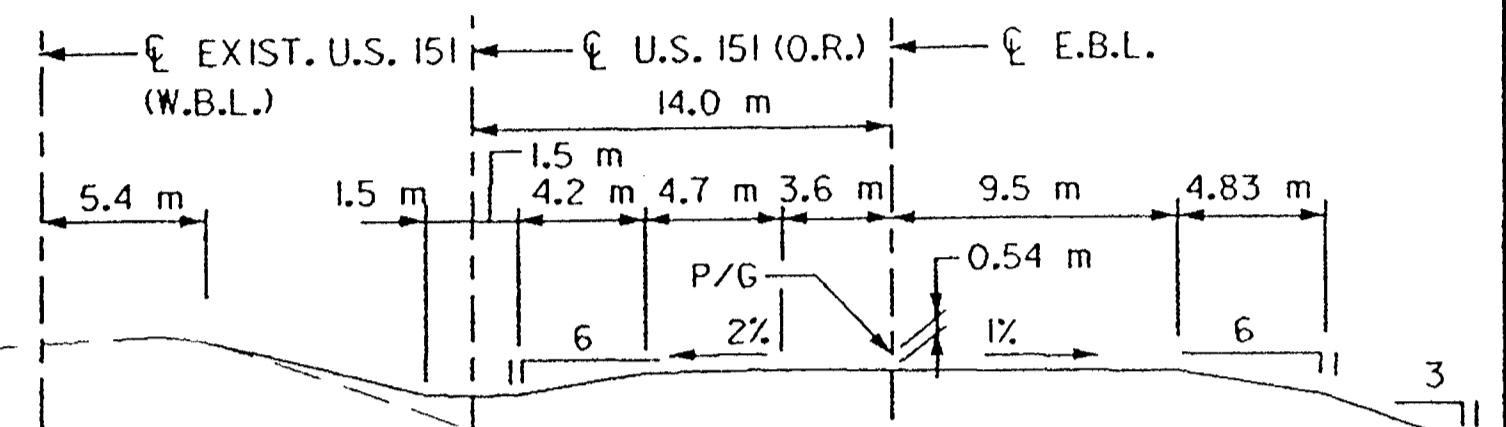

TYPICAL APPROACH SECTION

SUPERELEVATION DATA		SPIRAL DATA		CURVE DATA	
e = 0.0615	L = 92.000	Δ = 28°48'20.21"	PI STA. 109+81.905	Δ = 22°44' 48" LT.	T = 175.002
x = 29.900	Ls = 92.000	Es = 28.649	L = 345.395	E = 17.426	R = 870.000
		Xc = 91.989	LT = 61.342		
		Yc = 1.621	ST = 30.675		

HYDRAULIC DATA		
FREQUENCY	DISCHARGE(cms)	HEADWATER ELEV.
10-YEAR	3.64	263.47
25-YEAR	4.16	263.58
50-YEAR	5.20	263.79
100-YEAR	6.24	263.99

DRAINAGE AREA = 37.2 ha, HILLY
50 YEAR DESIGN FREQUENCY

LOCATION		TRAFFIC DATA	
U.S. 151	2001 ADT	7140	
T84N - R4W	2021 ADT	8560	
SECTION 22	2021 DHV	920	
FAIRVIEW TWP.	2001 TRUCKS	10%	
JONES COUNTY	2021 TRUCKS	11%	

DESIGN EXTENSION TO A FOR 0° SKEW
1.2 m x 1.2 m REINFORCED
CONCRETE BOX CULVERT
SITUATION PLAN

STA. 111+12.40 (O.R.) U.S. HIGHWAY 151 FEBRUARY, 1999

JONES COUNTY
IOWA DEPARTMENT OF TRANSPORTATION - PROJECT DEVELOPMENT DIVISION
DESIGN SHEET NO. 2 OF 10 FILE NO. 29164 DESIGN NO. 1098

ALL DIMENSIONS SHOWN ARE IN MILLIMETERS (mm)
UNLESS OTHERWISE NOTED OR SHOWN.
ALL STATIONS AND ELEVATIONS SHOWN ARE IN METERS.


DESIGNED BY RMJ CHECKED BY DLN
DETAILED BY JAE CADD FILE H531098.S02

EARTH TECH



LINN/JONES COUNTY

PROJECT NUMBER NHSX-151-3(112)--3H-57

STATE IOWA FPMR REGION 7 FISCAL YEAR V.08 SHEET NO. TOTAL SHEETS

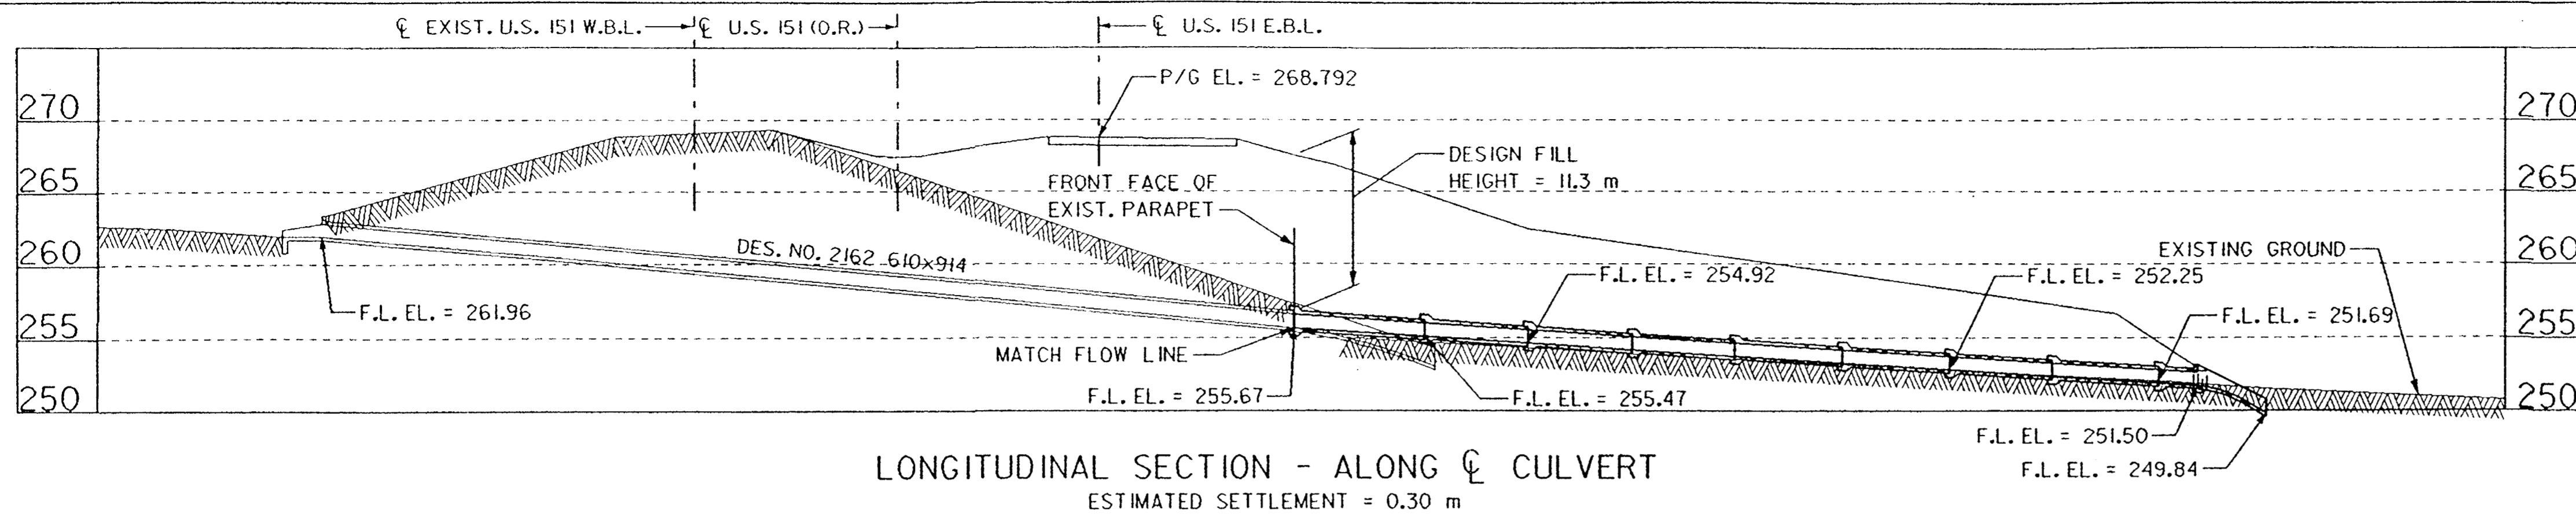

FOR NEW BENCH MARK INFORMATION, SEE PAGE G.18

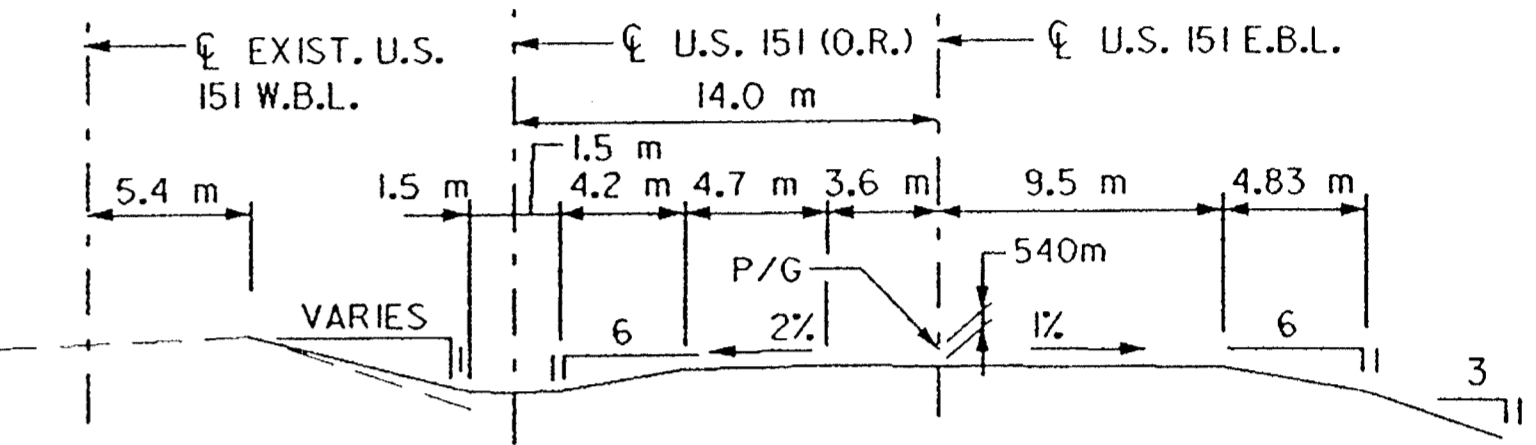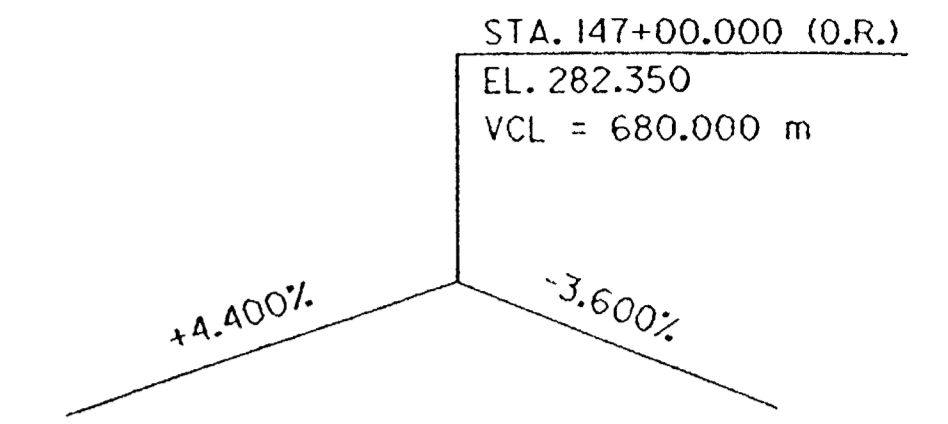

TYPICAL APPROACH SECTION

HYDRAULIC DATA

FREQUENCY	DISCHARGE (cms)	HEADWATER ELEV.
10-YEAR	0.71	262.81
25-YEAR	0.81	262.89
50-YEAR	1.01	263.07
100-YEAR	1.21	263.27

DRAINAGE AREA = 4.0 ha, HILLY
50 YEAR DESIGN FREQUENCY



LOCATION

US 151
T84N - R4W
SECTION 13 & 14
FAIRVIEW TWP.
JONES COUNTY

TRAFFIC DATA

2001	ADT	6590
2021	ADT	7910
2021	DHV	850
2001	TRUCKS	11%
2021	TRUCKS	12%

① SPAN TAPERS FROM 610 TO 900 IN NEW EXTENSION.

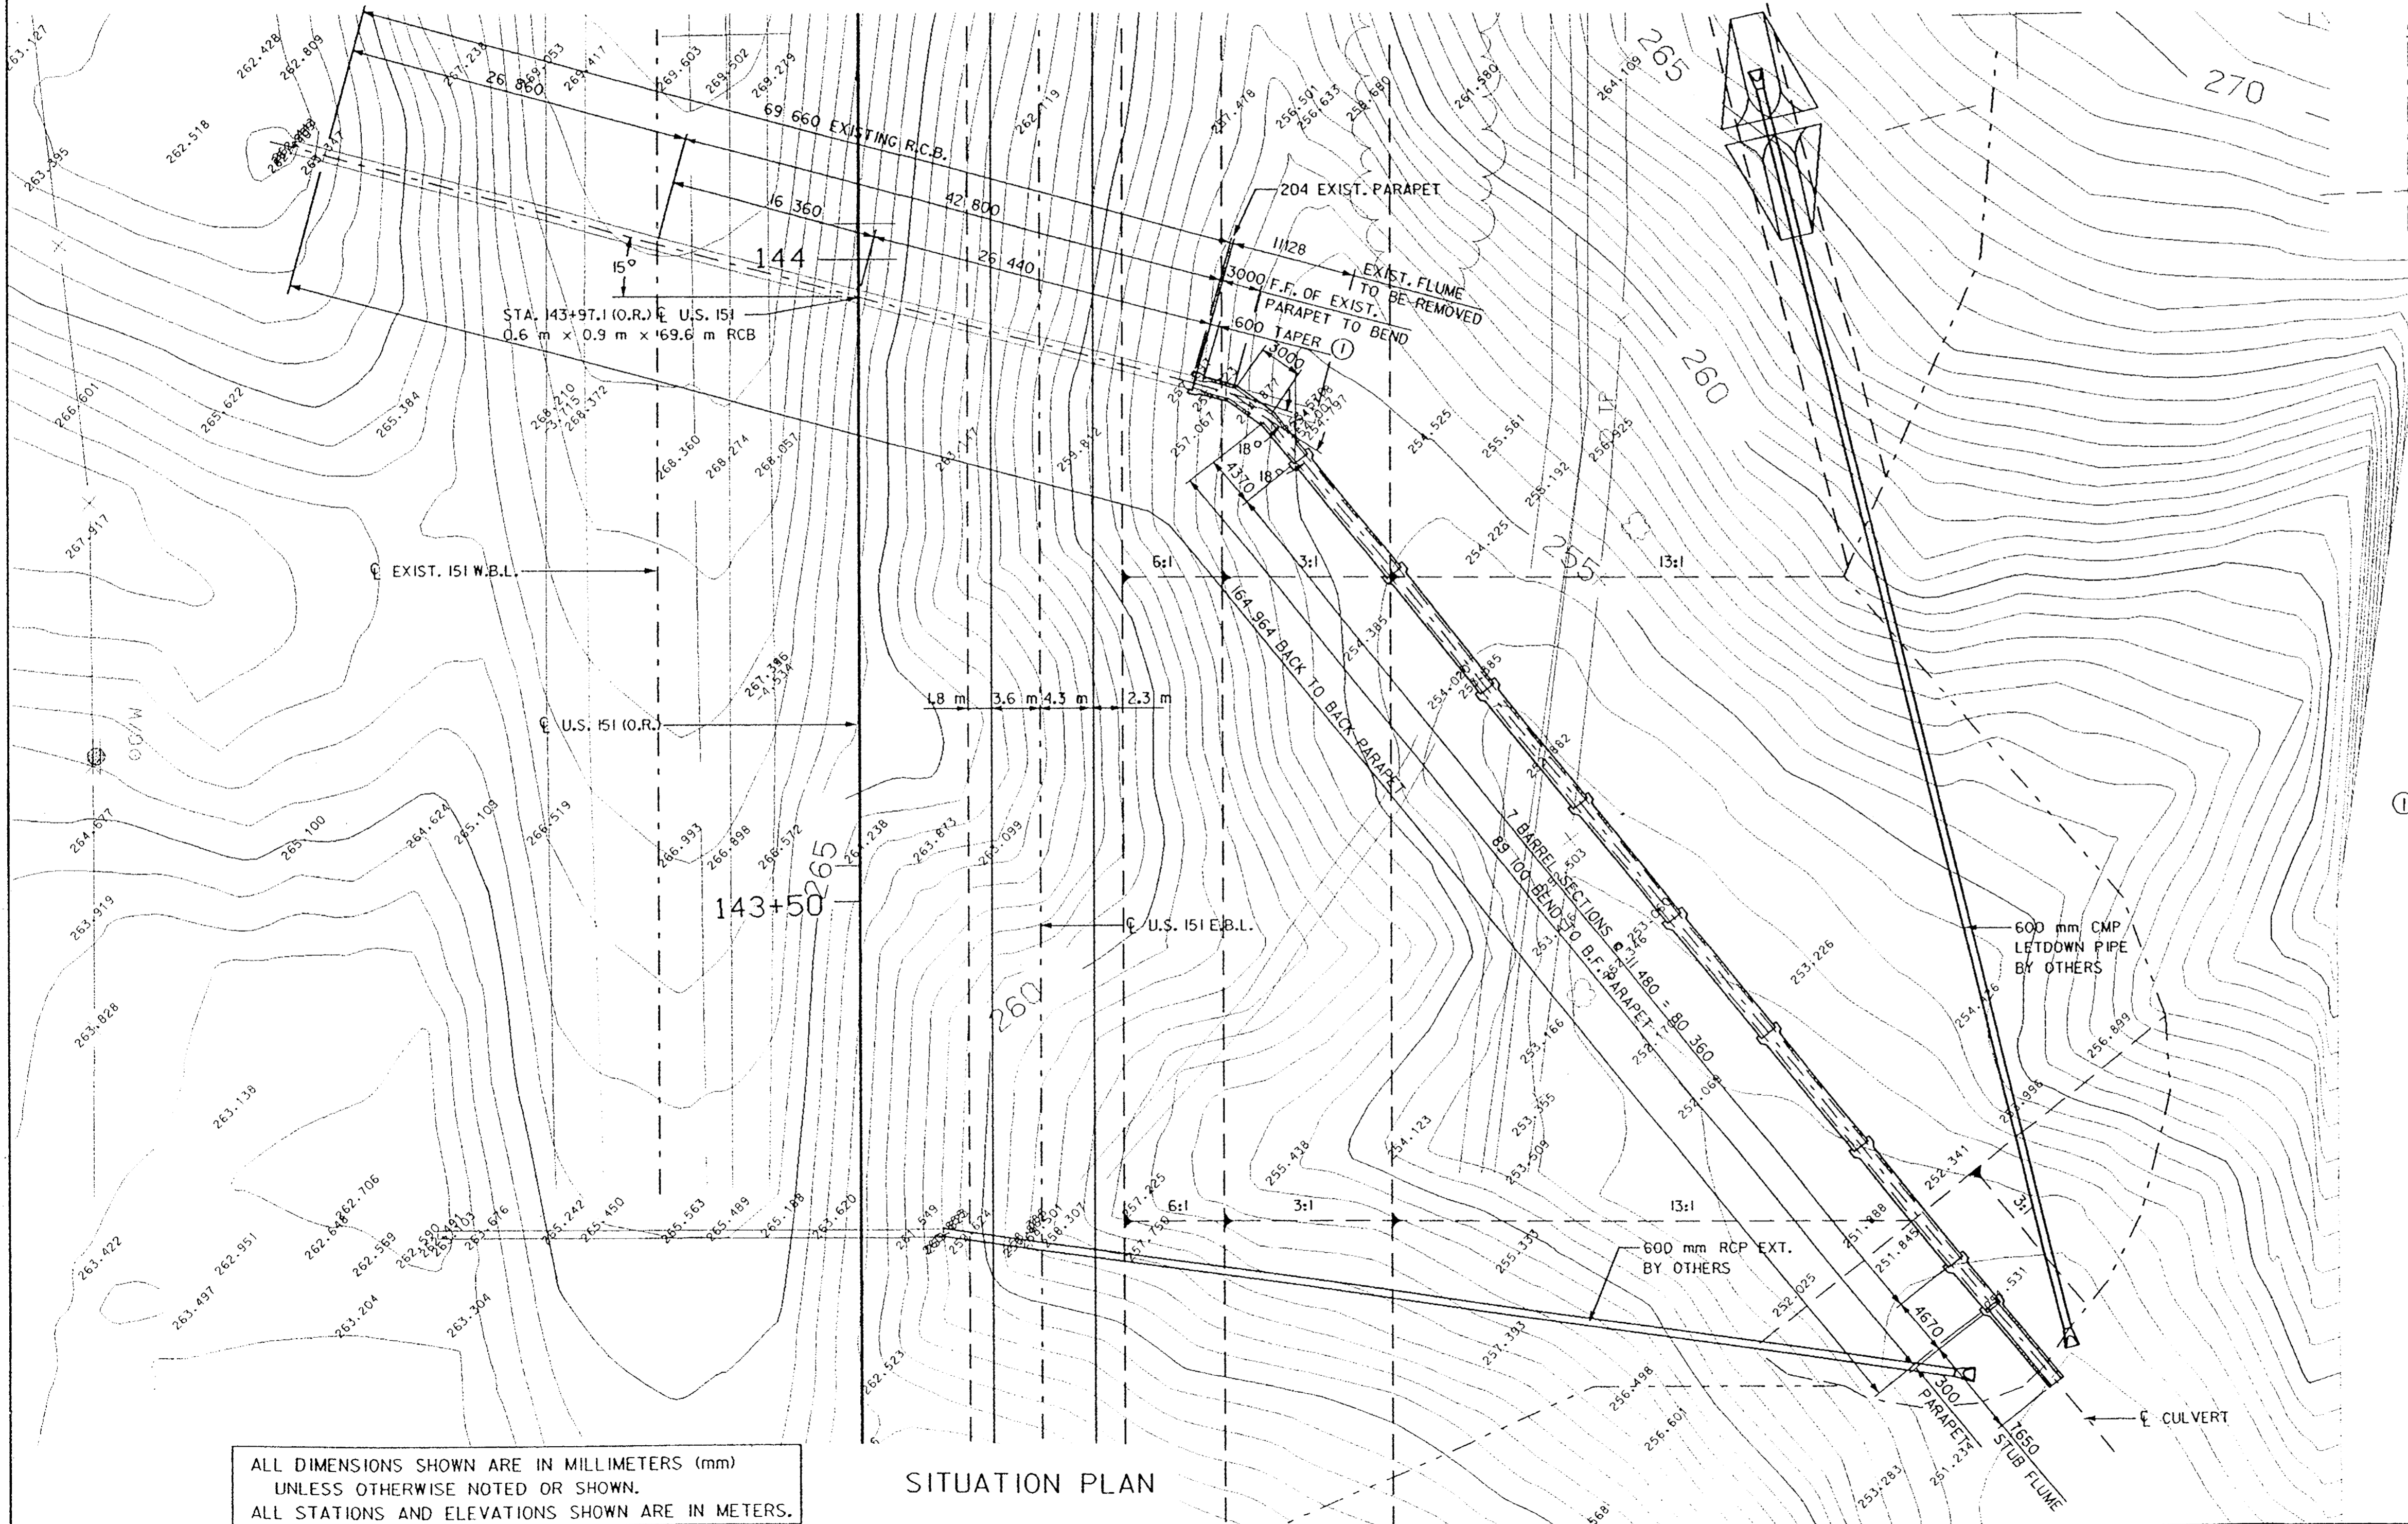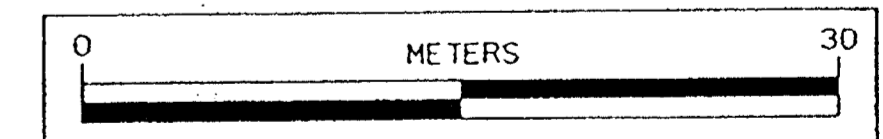

SITUATION PLAN

DESIGN FOR EXTENSION TO A 15° SKEW (L.A.)
0.6 m x 0.9 m TO 0.9 m x 0.9 m
REINFORCED CONCRETE BOX CULVERT
SITUATION PLAN
 STA. 143+97.1 (O.R.) U.S. HIGHWAY 151
 JONES COUNTY
 IOWA DEPARTMENT OF TRANSPORTATION - PROJECT DEVELOPMENT DIVISION
 DESIGN SHEET NO. 2 OF 7 FILE NO. 29164 DESIGN NO. 1198
 FEBRUARY, 1999






DESIGNED BY RMJ CHECKED BY DLN
 DETAILED BY JAE CADD FILE H531198.S02

EARTH TECH

JONES COUNTY

PROJECT NUMBER NHSX-151-3(112)--3H-57

STATE IOWA FHWA REGION 7 FISCAL YEAR SHEET NO. V.09 TOTAL SHEETS

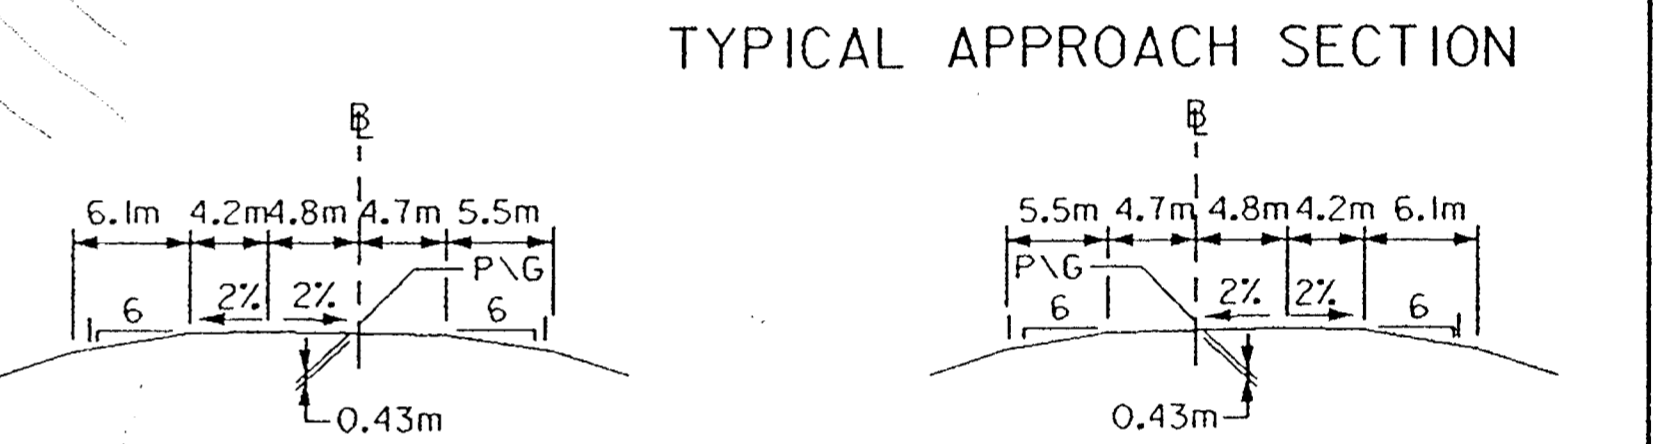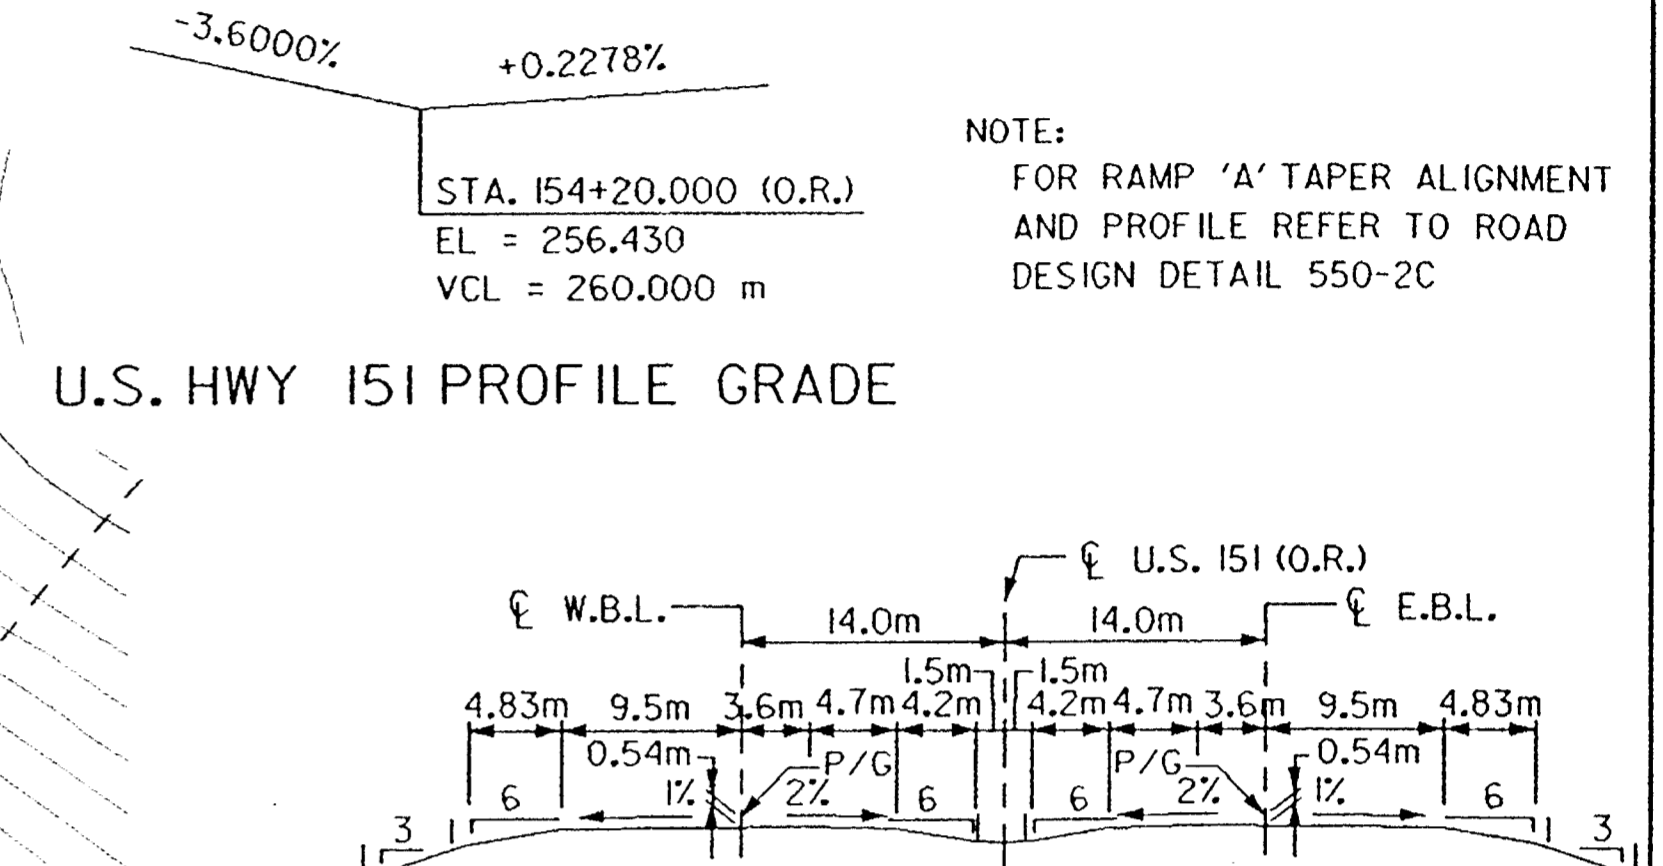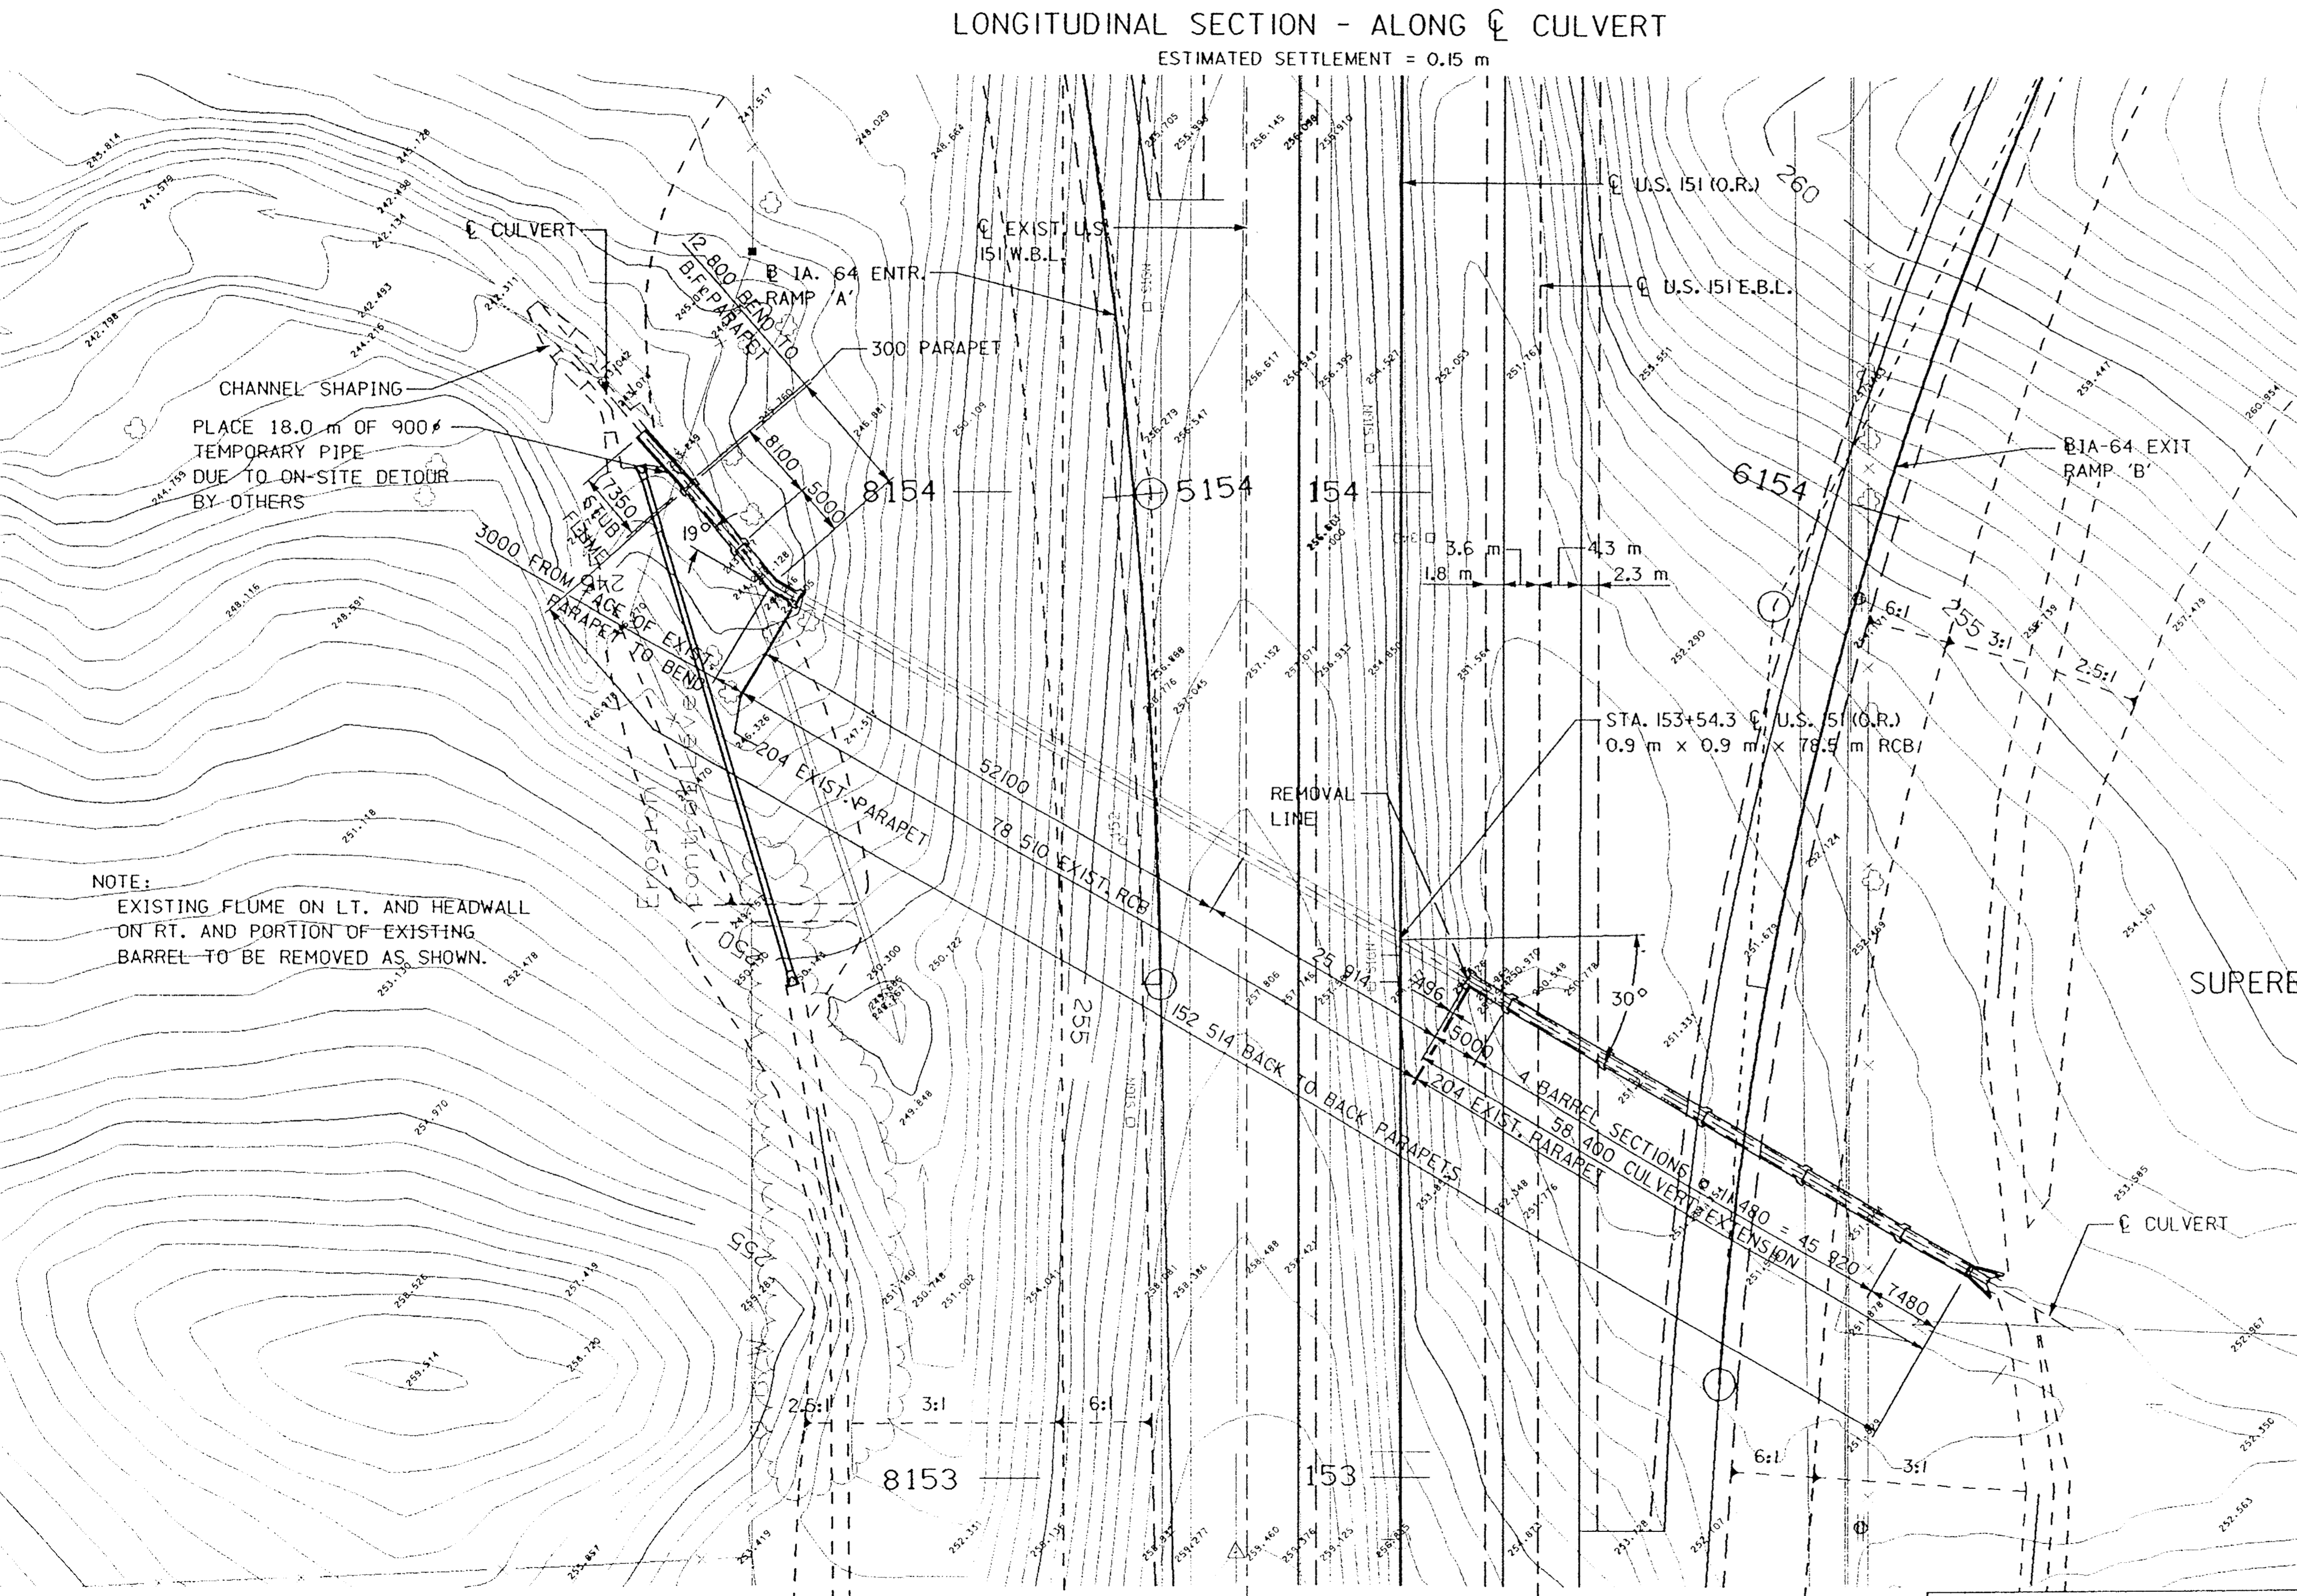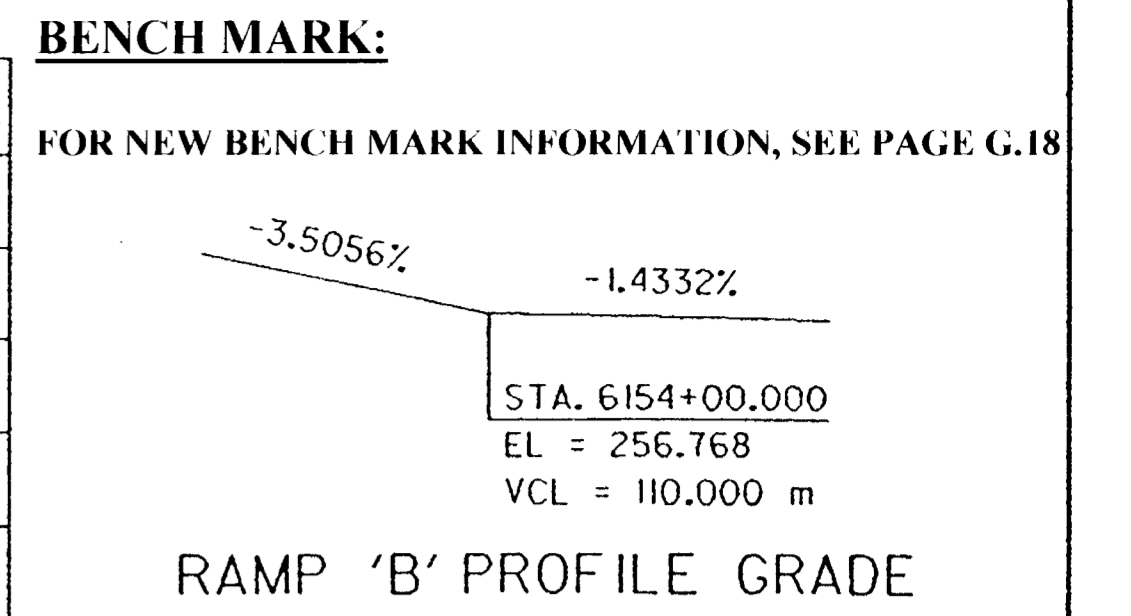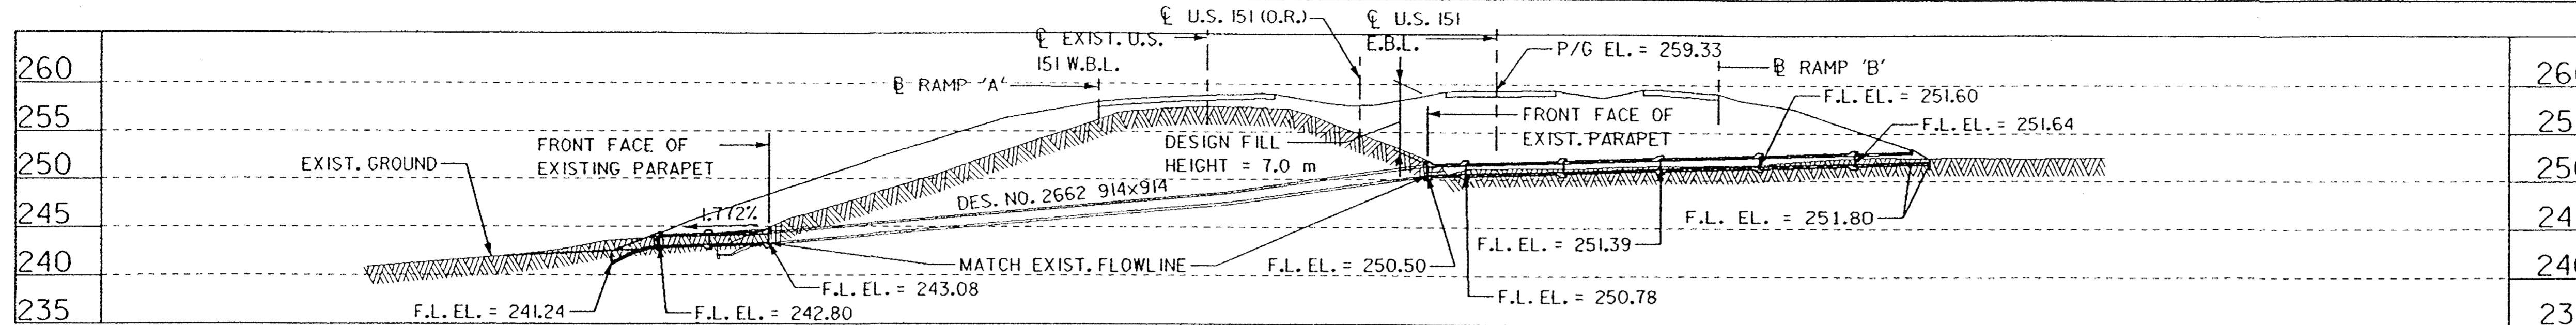

NOTE:
SEE SUPERELEVATION DATA FOR CHANGE IN TYPICAL CROSS SECTION

NOTE:
SEE ROAD DESIGN DETAIL 520-2C FOR SUPERELEVATION DATA

SUPERELEVATION DATA RAMP 'B'

L = 109.300
x = 27.300
e = 0.080
m = 32.860

HYDRAULIC DATA

FREQUENCY	DISCHARGE (cms)	HEADWATER ELEV.
10-YEAR	1.51	252.93
25-YEAR	1.73	253.08
50-YEAR	2.16	253.41
100-YEAR	2.59	253.83

DRAINAGE AREA = 11.3 ha, HILLY
50 YEAR DESIGN FREQUENCY

LOCATION **TRAFFIC DATA**

U.S. 151	2001 ADT	6590
T84N - R4W	2021 ADT	7910
SECTION 11 & 12	2021 DHV	850
FAIRVIEW TWP.	2001 TRUCKS	11%
JONES COUNTY	2021 TRUCKS	12%



DESIGN FOR EXTENSION TO A 30° SKEW (L.A.)
0.9 m x 0.9 m REINFORCED CONCRETE BOX CULVERT SITUATION PLAN

STA. 153+54.3 (O.R.) U.S. HIGHWAY 151 FEBRUARY, 1999

JONES COUNTY
IOWA DEPARTMENT OF TRANSPORTATION - PROJECT DEVELOPMENT DIVISION
DESIGN SHEET NO. 2 OF 7 FILE NO. 29164 DESIGN NO. 1398

ALL DIMENSIONS SHOWN ARE IN MILLIMETERS (mm)
UNLESS OTHERWISE NOTED OR SHOWN.
ALL STATIONS AND ELEVATIONS SHOWN ARE IN METERS.


DESIGNED BY RMJ CHECKED BY JAE DLM
DETAILED BY JAE CADD FILE H531398.S02

EARTH TECH


JONES COUNTY

PROJECT NUMBER NHX-151-3(12)--3H-57

STATE IOWA FHWA REGION 7 FISCAL YEAR SHEET NO. V.10 TOTAL SHEETS

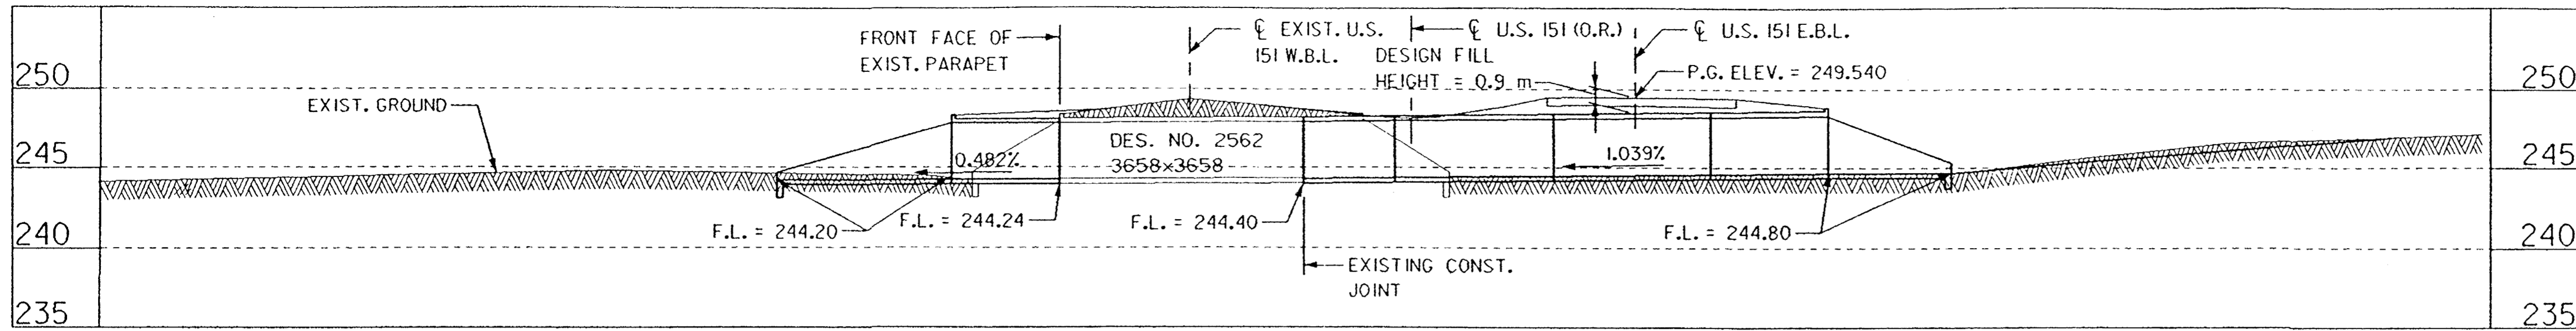

BENCH MARK:
FOR NEW BENCH MARK INFORMATION, SEE PAGE G.18

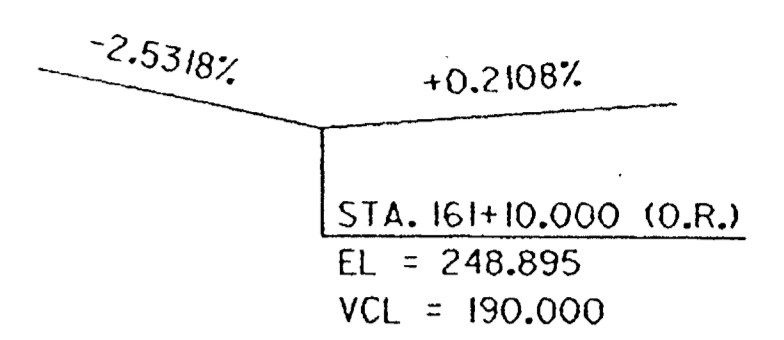

U.S. HWY. 151 PROFILE GRADE



HYDRAULIC DATA

FREQUENCY	DISCHARGE (cms)	HEADWATER ELEV.
10-YEAR	13.90	246.75
25-YEAR	20.07	247.28
50-YEAR	25.02	247.66
100-YEAR	30.50	248.07

DRAINAGE AREA = 404.7 ha, ROLLING
50 YEAR DESIGN FREQUENCY

LOCATION

U.S. 151
T84N - R4W
SECTION 1 & 2
FAIRVIEW TWP.
JONES COUNTY

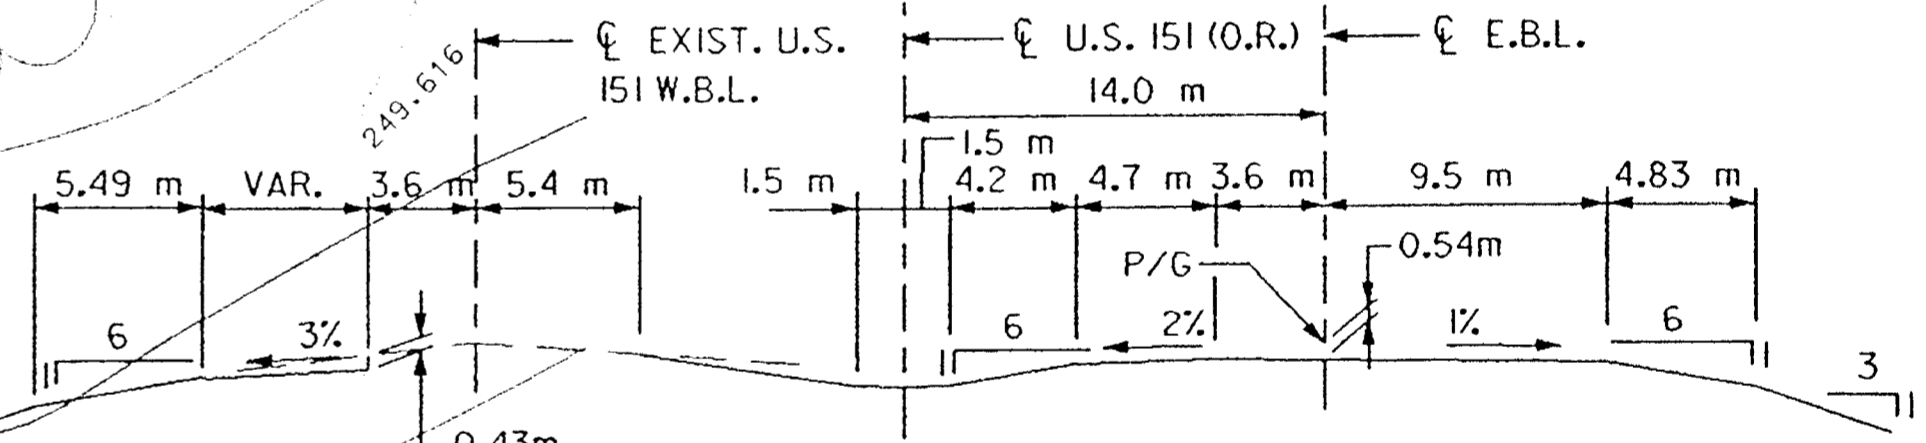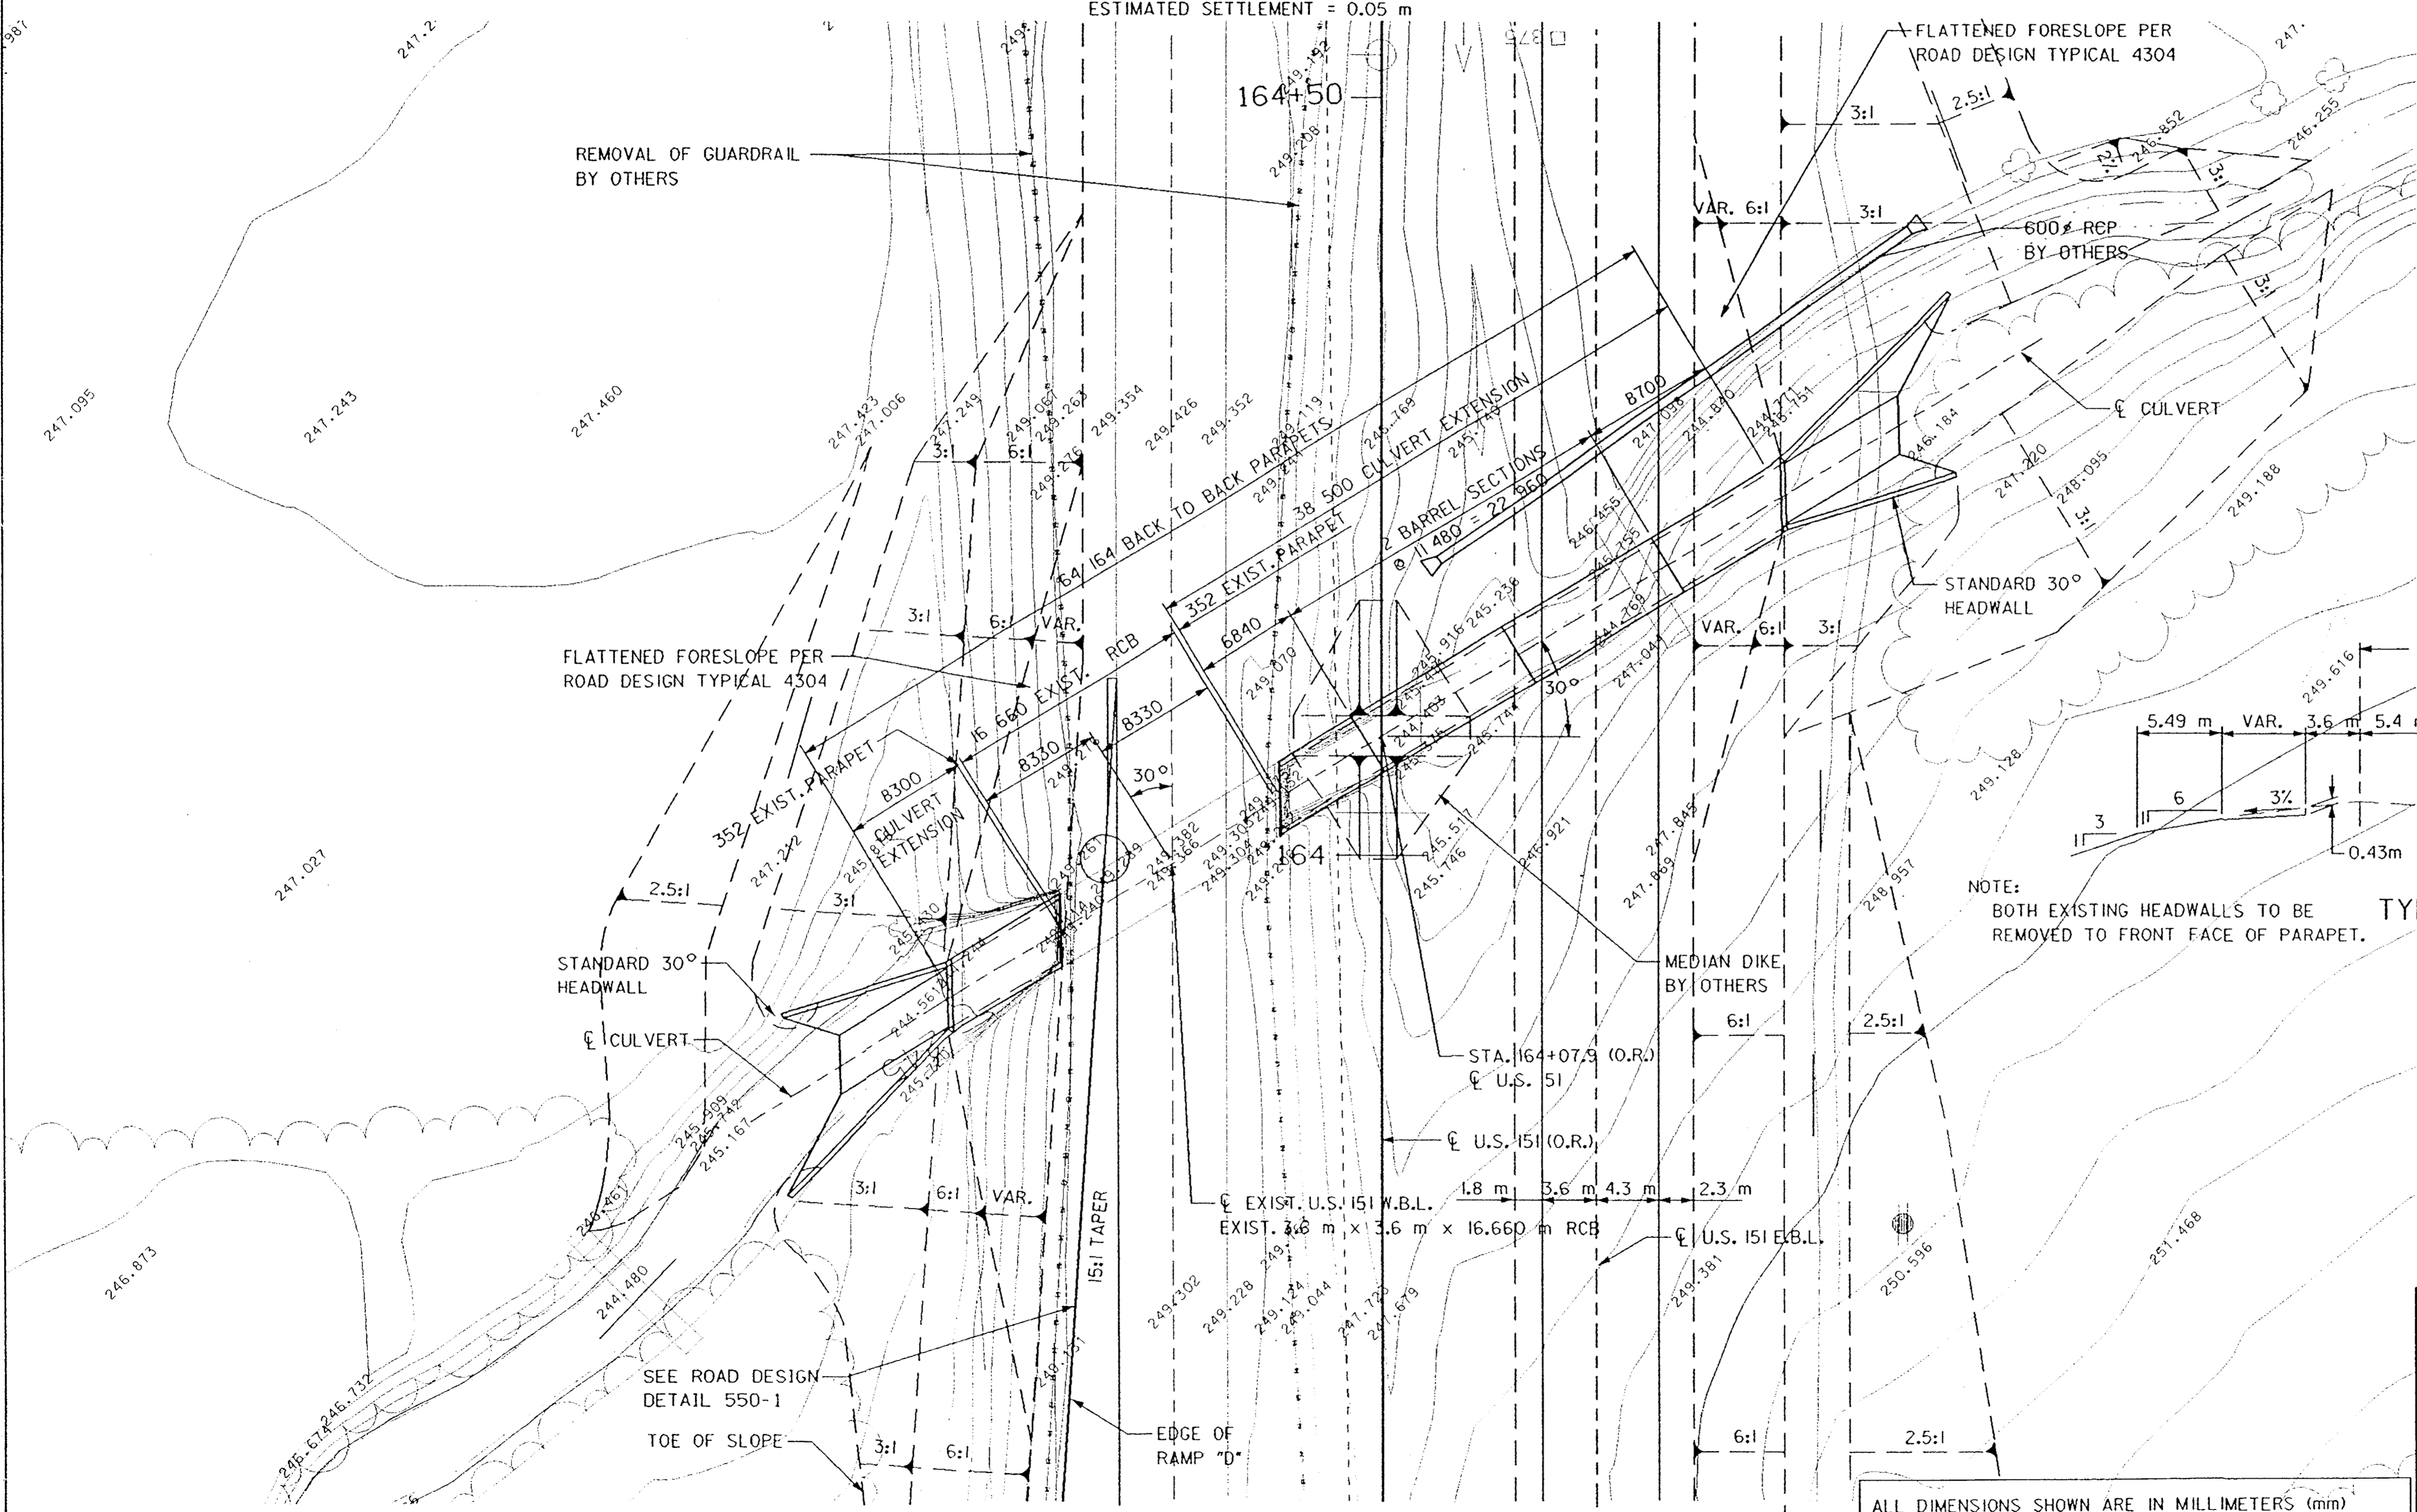


NOTE:
BOTH EXISTING HEADWALLS TO BE
REMOVED TO FRONT FACE OF PARAPET.

TYPICAL APPROACH SECTION

TRAFFIC DATA

2001	ADT	5530
2021	ADT	6630
2021	DHV	712
2001	TRUCKS	11%
2021	TRUCKS	13%

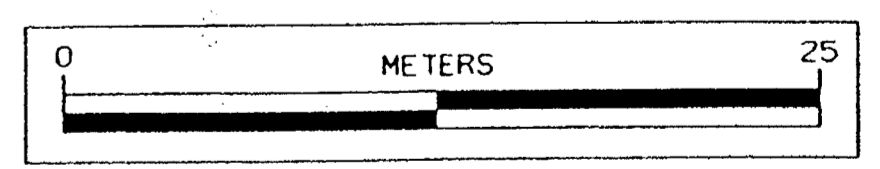

DESIGN FOR EXTENSION TO A 30° SKEW (R.A.)
**3.6 m x 3.6 m REINFORCED
CONCRETE BOX CULVERT
SITUATION PLAN**

STA. 164+07.9 (O.R.) U.S. HIGHWAY 151 FEBRUARY, 1999

JONES COUNTY

IOWA DEPARTMENT OF TRANSPORTATION - PROJECT DEVELOPMENT DIVISION
DESIGN SHEET NO. 2 OF 4 FILE NO. 29164 DESIGN NO. 1698

ALL DIMENSIONS SHOWN ARE IN MILLIMETERS (mm)
UNLESS OTHERWISE NOTED OR SHOWN.
ALL STATIONS AND ELEVATIONS SHOWN ARE IN METERS.

DESIGNED BY RMJ CHECKED BY DLN
DETAILED BY JAE CADD FILE H531698.S02

EARTH TECH

JONES COUNTY

PROJECT NUMBER

NHSX-151-3(12)-3H-57

STATE

IOWA

FHWA REGION

7


FISCAL YEAR

SHEET NO.

V.11


TOTAL SHEETS

164-198

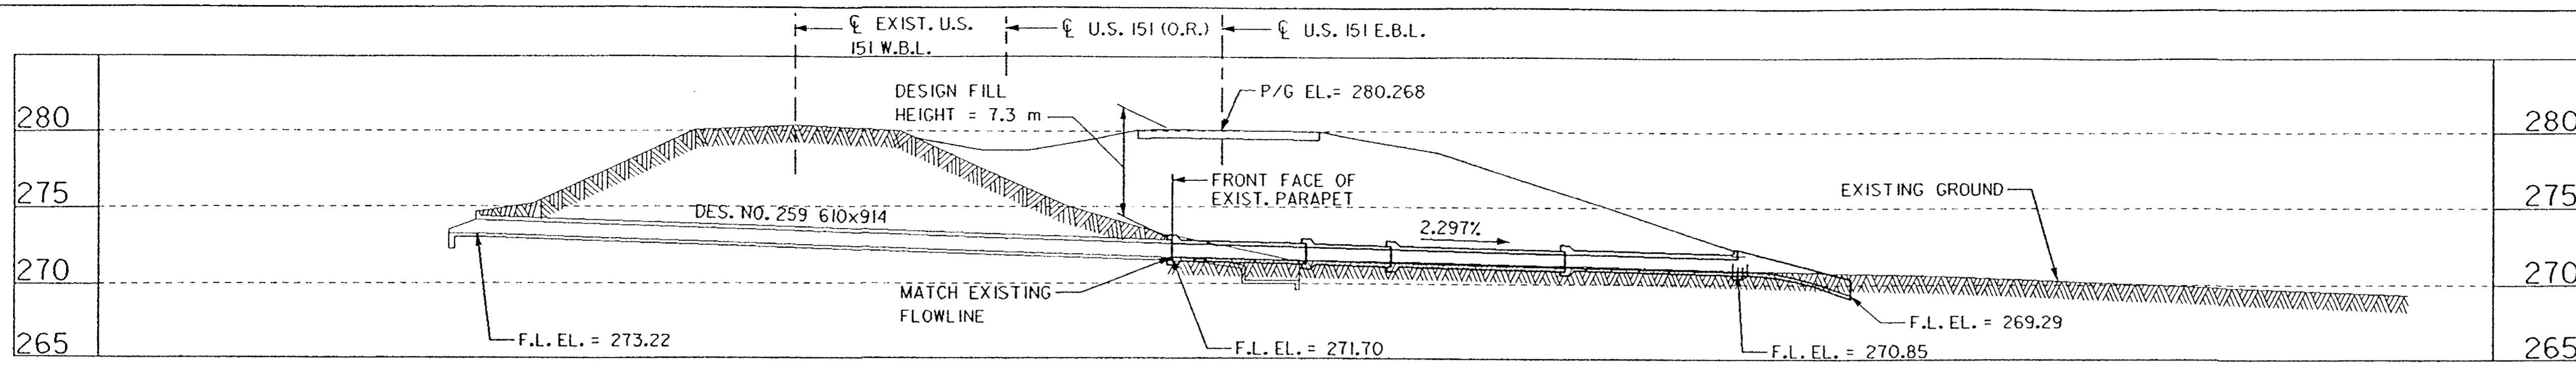

BENCH MARK:
 FOR NEW BENCH MARK INFORMATION,
 SEE PAGE G.18 STA. 179+70.000 (O.R.)
 EL. 278.538
 VCL = 240.000 m
 +2.0680% +0.2718%
**U.S. HWY. 151
 PROFILE GRADE**

LONGITUDINAL SECTION - ALONG CULVERT
 ESTIMATED SETTLEMENT = 0.05 m

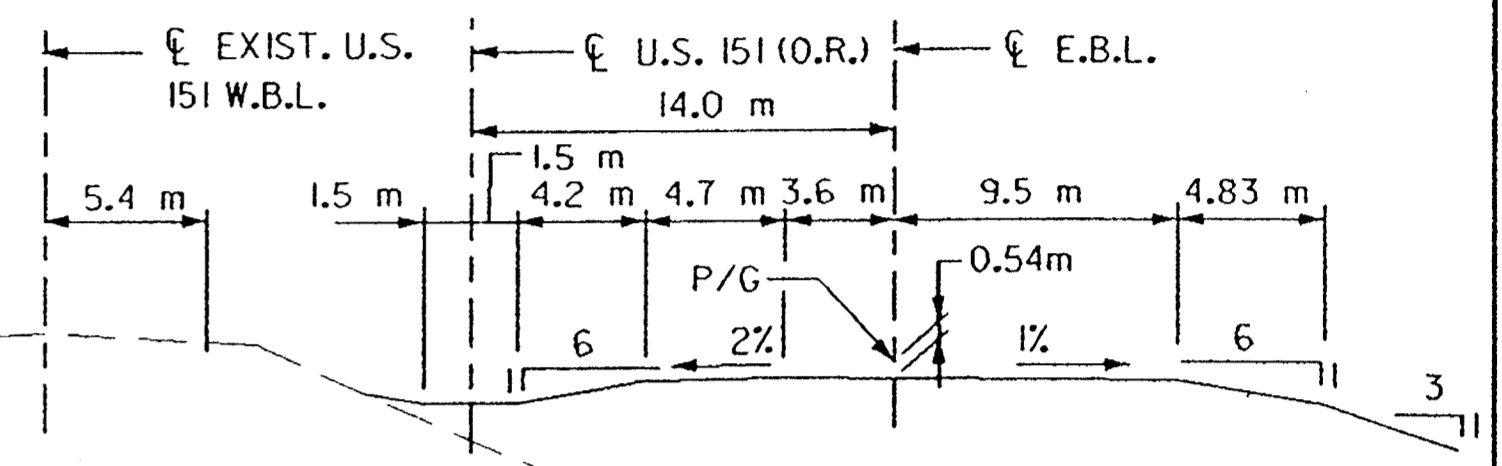

TYPICAL APPROACH SECTION



HYDRAULIC DATA


FREQUENCY	DISCHARGE(cms)	HEADWATER ELEV.
10-YEAR	0.64	274.02
25-YEAR	0.73	274.10
50-YEAR	0.92	274.27
100-YEAR	1.10	274.44

DRAINAGE AREA = 5.3 ha, ROLLING
 50 YEAR DESIGN FREQUENCY

LOCATION
 U.S. 151
 T85N - R4W
 SECTION 36
 CASS TWP.
 JONES COUNTY

TRAFFIC DATA


2001 ADT	7480
2021 ADT	8950
2021 DHV	960
2001 TRUCKS	10%
2021 TRUCKS	11%

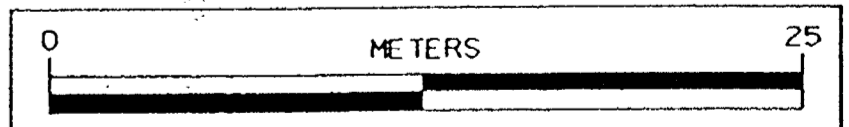

DESIGN FOR EXTENSION TO A 10° SKEW (R.A.)
**0.6 m x 0.9 m TO 0.9 m x 0.9 m
 REINFORCED CONCRETE BOX CULVERT
 SITUATION PLAN**

STA. 186+03.92 (O.R.) U.S. HIGHWAY 151 FEBRUARY, 1999
JONES COUNTY
 IOWA DEPARTMENT OF TRANSPORTATION - PROJECT DEVELOPMENT DIVISION
 DESIGN SHEET NO. 2 OF 6 FILE NO. 29164 DESIGN NO. 1798


ALL DIMENSIONS SHOWN ARE IN MILLIMETERS (mm)
 UNLESS OTHERWISE NOTED OR SHOWN.
 ALL STATIONS AND ELEVATIONS SHOWN ARE IN METERS.

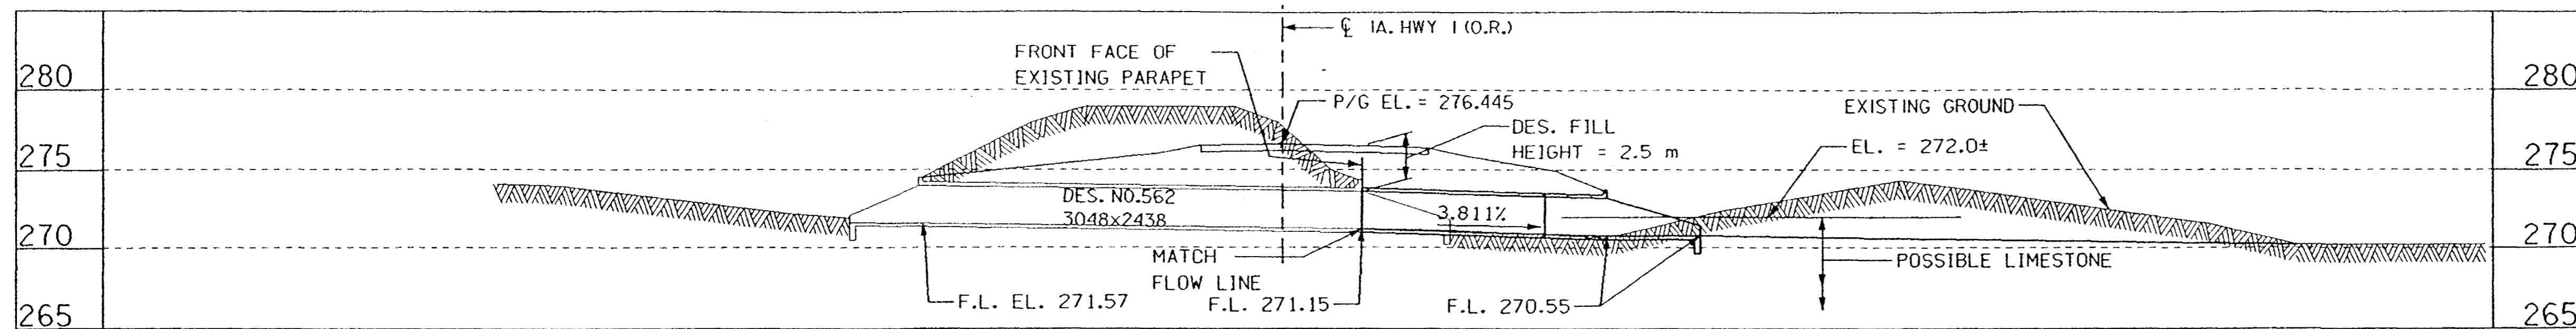


LONGITUDINAL SECTION - ALONG \bar{C} CULVERT
ESTIMATED SETTLEMENT = 0.00 m

BENCH MARK:

FOR NEW BENCH MARK INFORMATION, SEE PAGE G.18

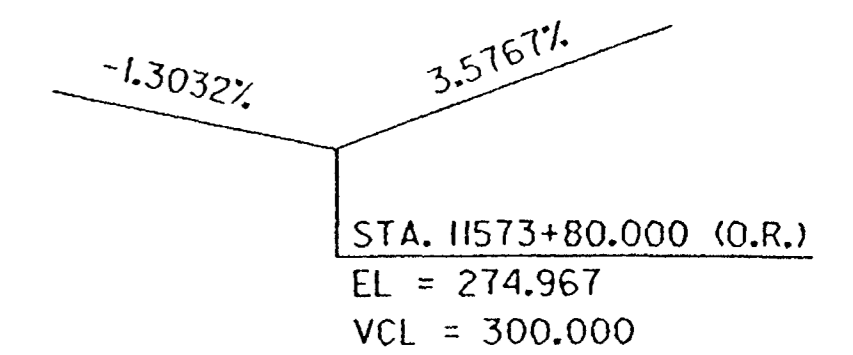

IA. HWY. NO. 1 PROFILE GRADE

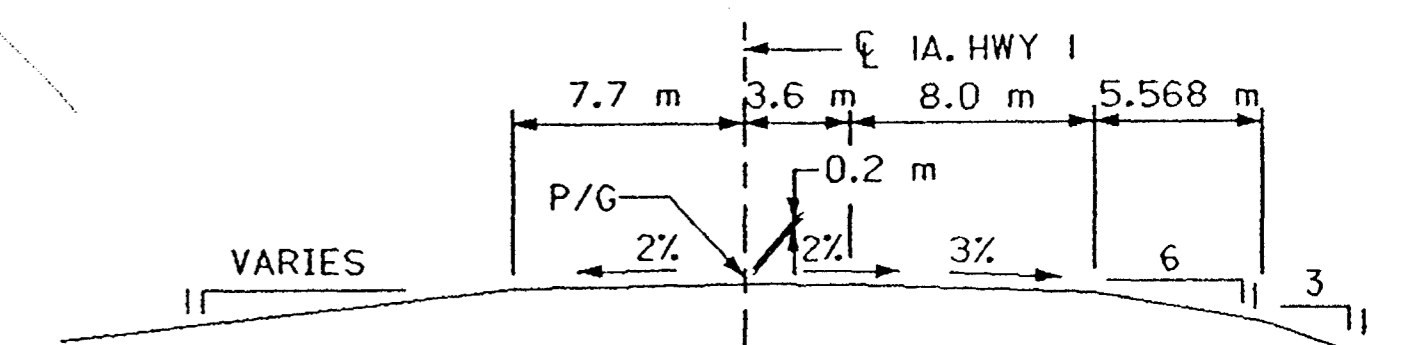

NOTE :
SEE SUPERELEVATION DATA FOR CHANGE
IN TYPICAL CROSS SECTION

TYPICAL APPROACH SECTION

HYDRAULIC DATA		
FREQUENCY	DISCHARGE (cms)	HEADWATER ELEV.
10-YEAR	12.73	273.61
25-YEAR	14.55	273.81
50-YEAR	18.19	274.20
100-YEAR	21.83	274.61


DRAINAGE AREA = 299 ha, ROLLING
50 YEAR DESIGN FREQUENCY

LOCATION

IA 1
T84N - R4W
SECTION 20
FAIRVIEW TWP.
JONES COUNTY

TRAFFIC DATA

2001	ADT	4420
2021	ADT	5300
2021	DHV	568
2001	TRUCKS	9%
2021	TRUCKS	10%

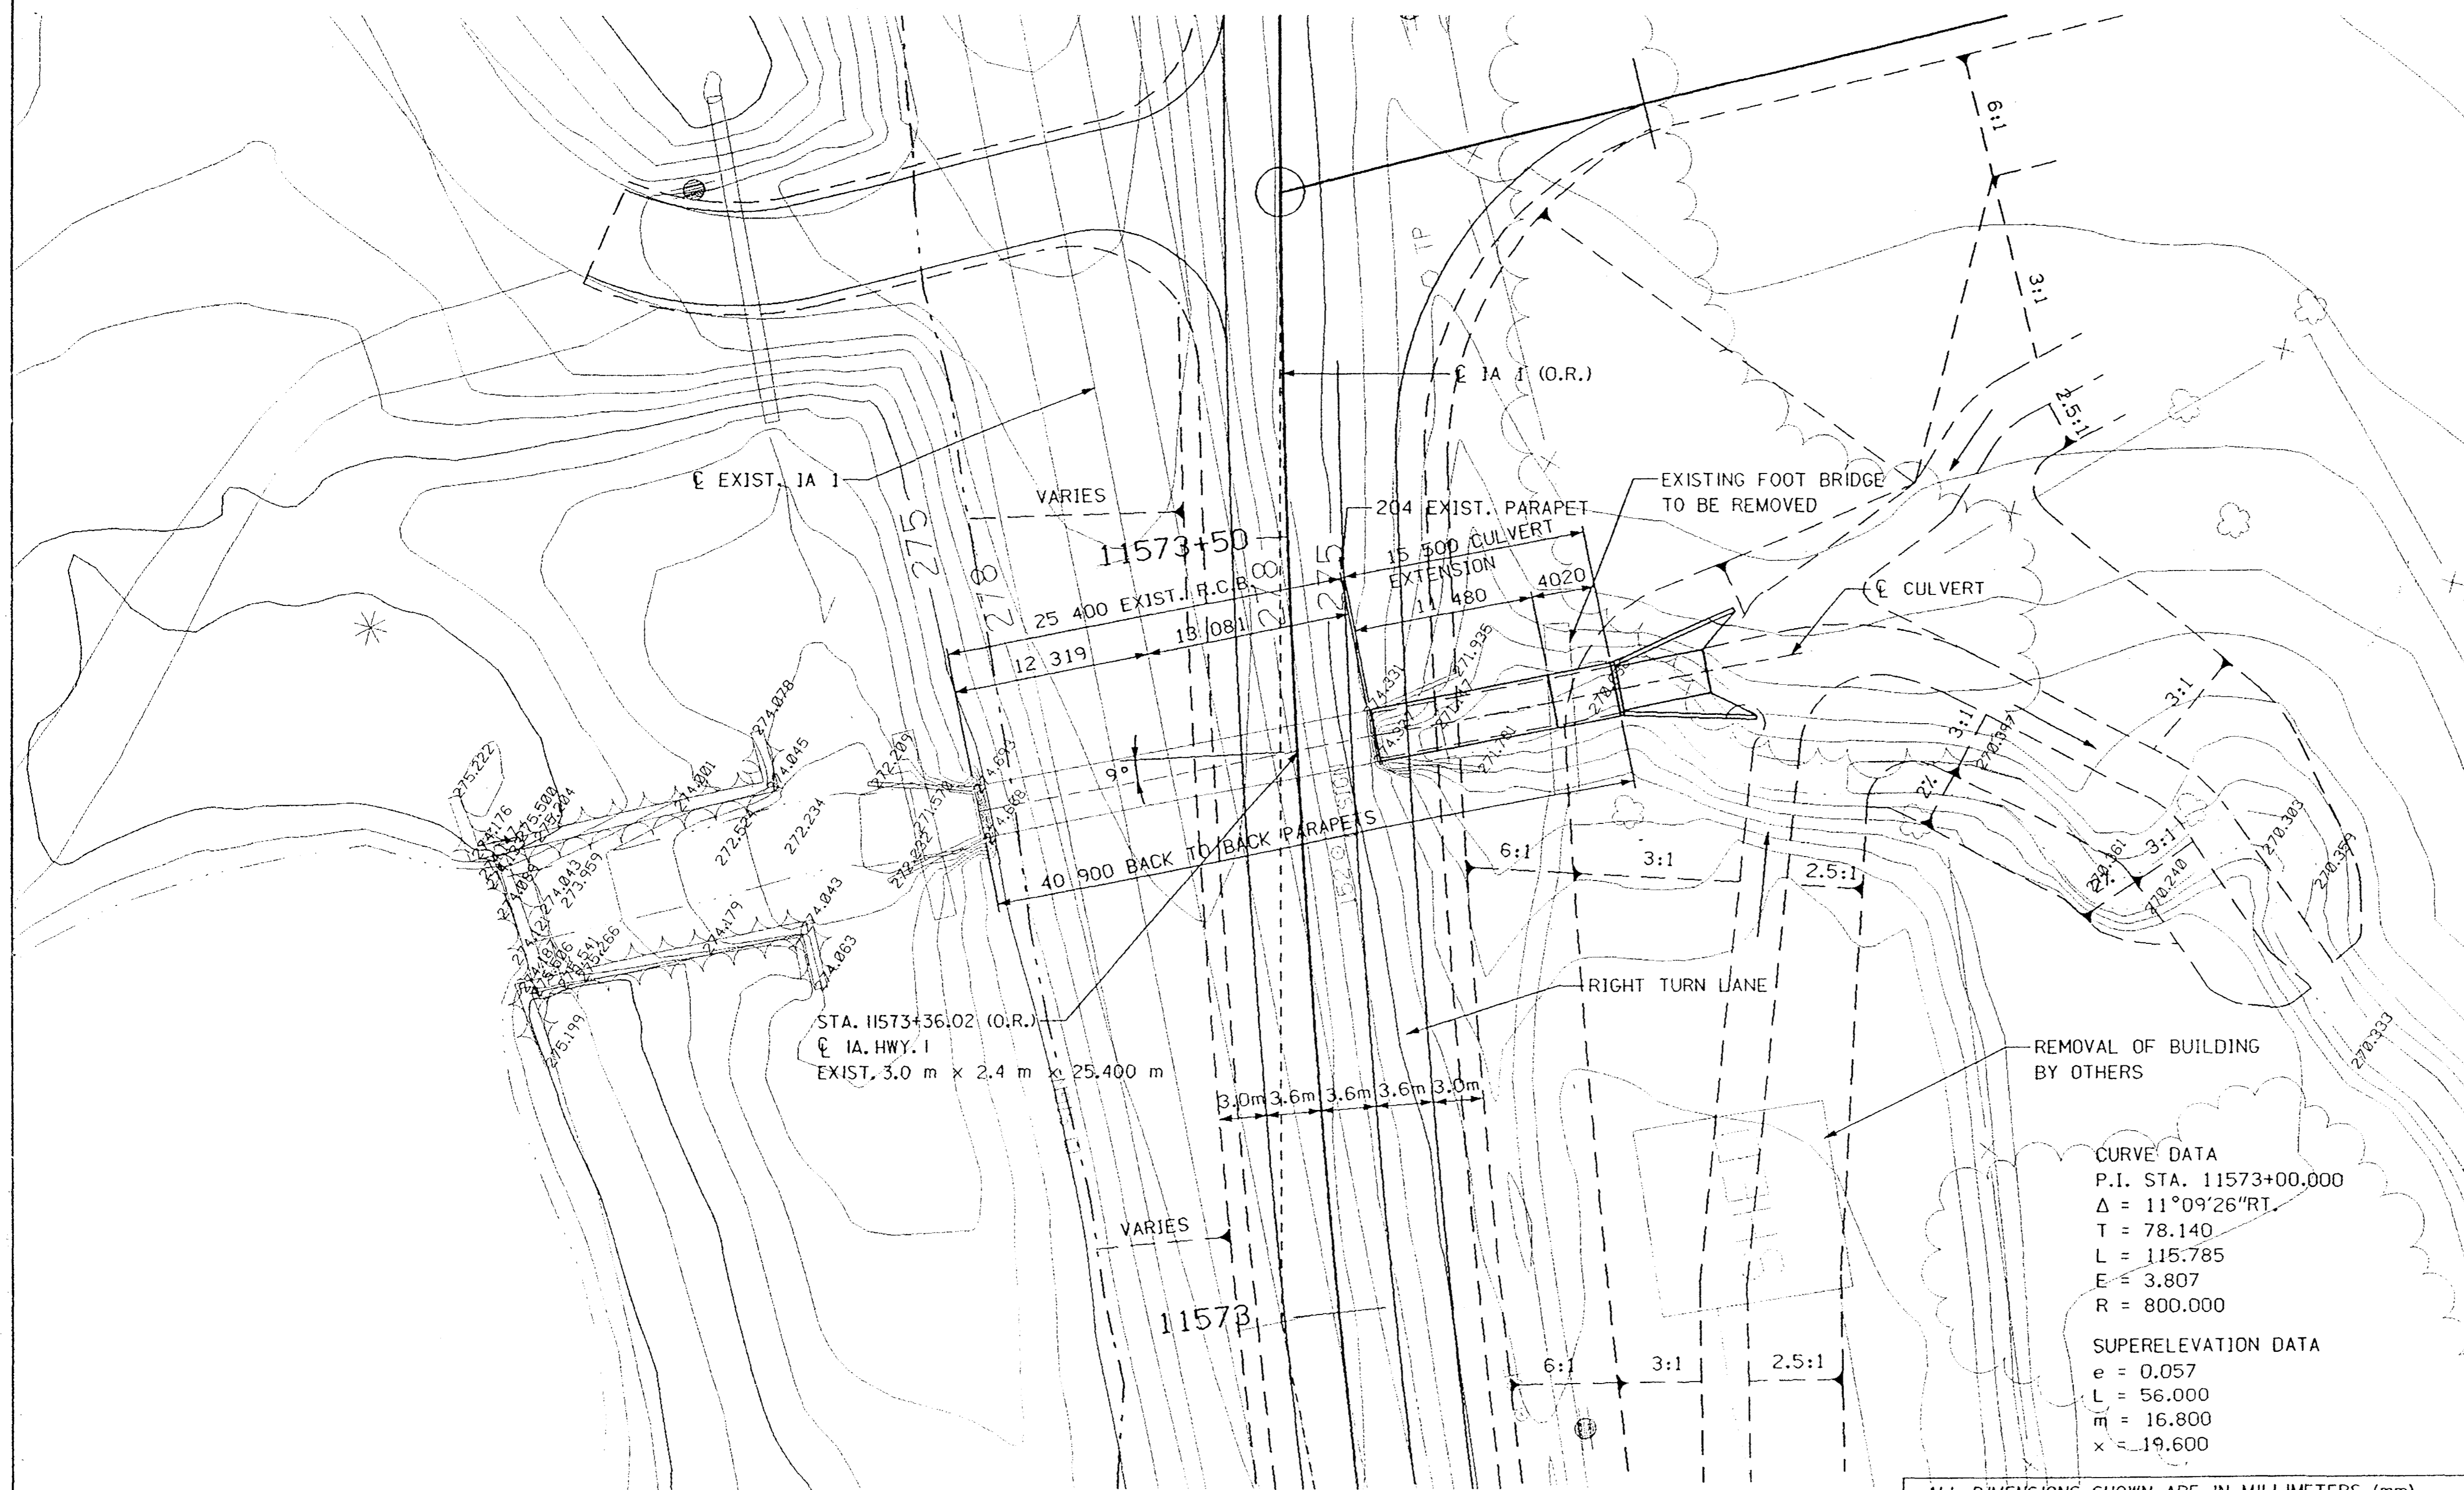

CURVE DATA
P.I. STA. 11573+00.000
 $\Delta = 11^{\circ}09'26''$ RT
T = 78.140
L = 115.785
E = 3.807
R = 800.000

SUPERELEVATION DATA
e = 0.057
L = 56.000
m = 16.800
x = 19.600

SITUATION PLAN

ALL DIMENSIONS SHOWN ARE IN MILLIMETERS (mm)
UNLESS OTHERWISE NOTED OR SHOWN.
ALL STATIONS AND ELEVATIONS SHOWN ARE IN METERS.

DESIGN EXTENSION TO A FOR 9° SKEW
3.0 m x 2.4 m REINFORCED
CONCRETE BOX CULVERT
SITUATION PLAN

STA. 11573+36.02 (O.R.) \bar{C} IOWA HIGHWAY 1 FEBRUARY, 1999

JONES COUNTY

IOWA DEPARTMENT OF TRANSPORTATION - PROJECT DEVELOPMENT DIVISION
DESIGN SHEET NO. 2 OF 3 FILE NO. 29164 SHEET NO. 1898

DESIGNED BY DLN CHECKED BY RMJ
DETAILED BY JAE CADD FILE H531898_S02


EARTH TECH

LINN/JONES COUNTY



PROJECT NUMBER NHSX-151-3(112)--3H-57

STATE IOWA REGION 7 FISCAL YEAR SHEET NO. V.13 TOTAL SHEETS

NOTE :
 MINIMUM CLEAR ZONE REQUIRED
 IS 9.0 m ON IA I. MEDIAN GUARD RAIL NOT
 SHOWN, TO BE DESIGNED.

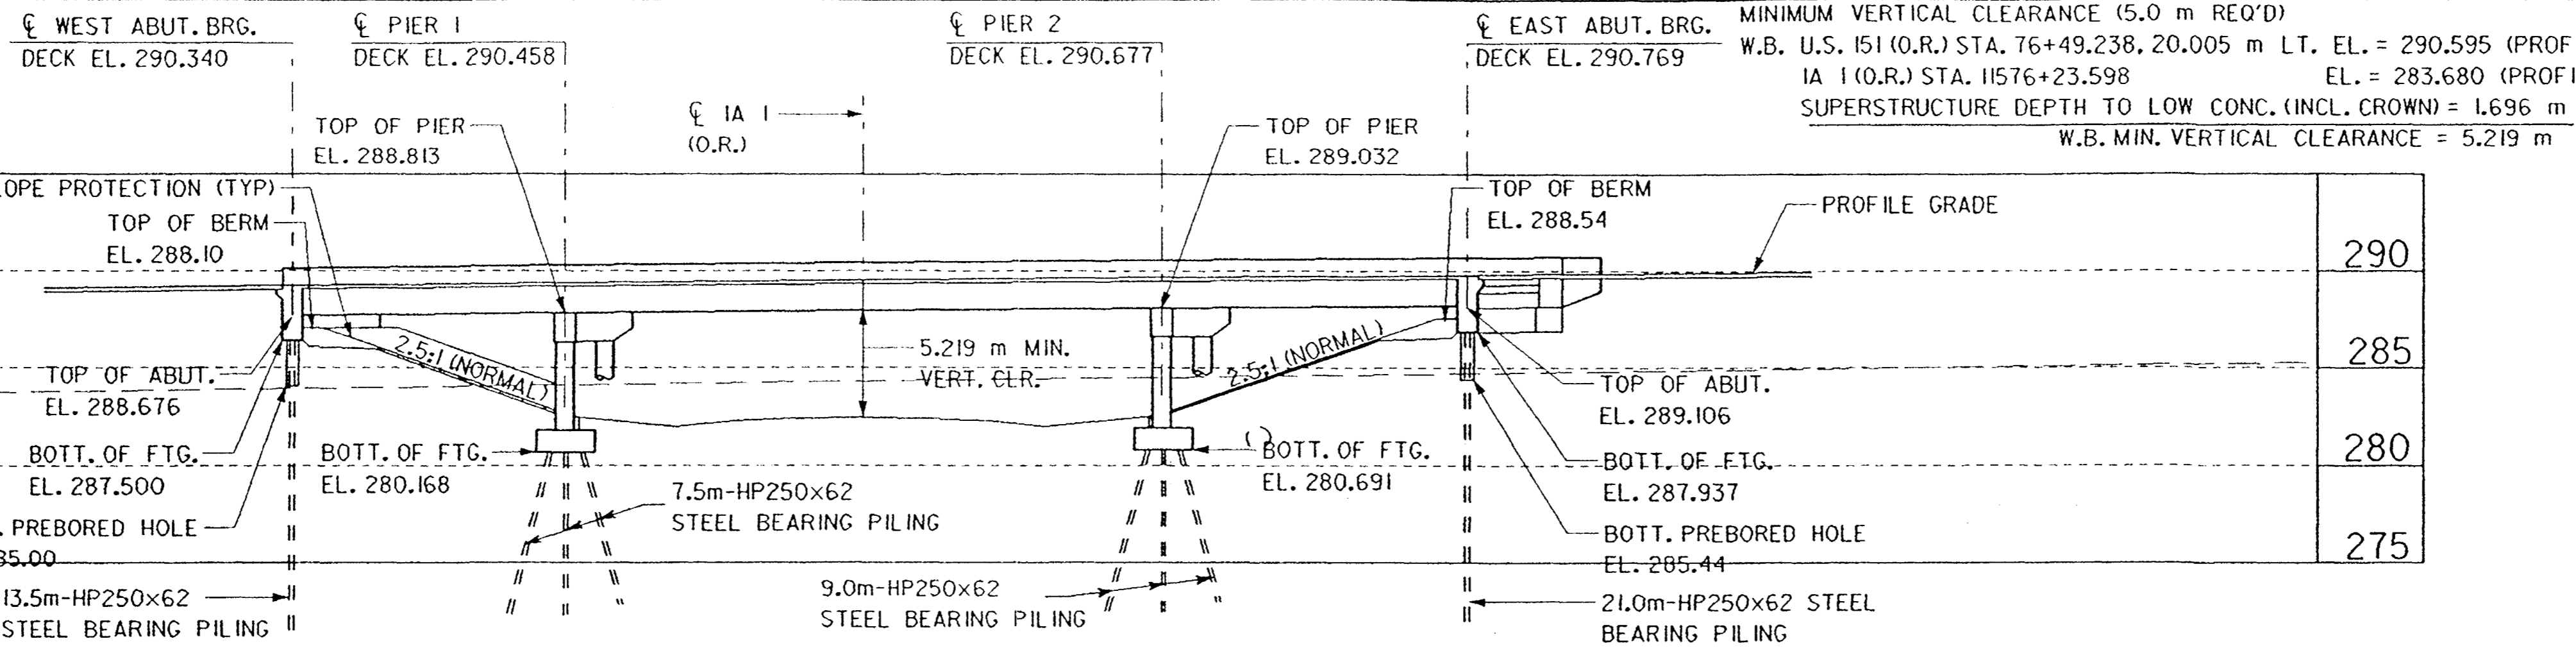

BENCH MARK:
 FOR NEW BENCH MARK INFORMATION,
 SEE PAGE G.18

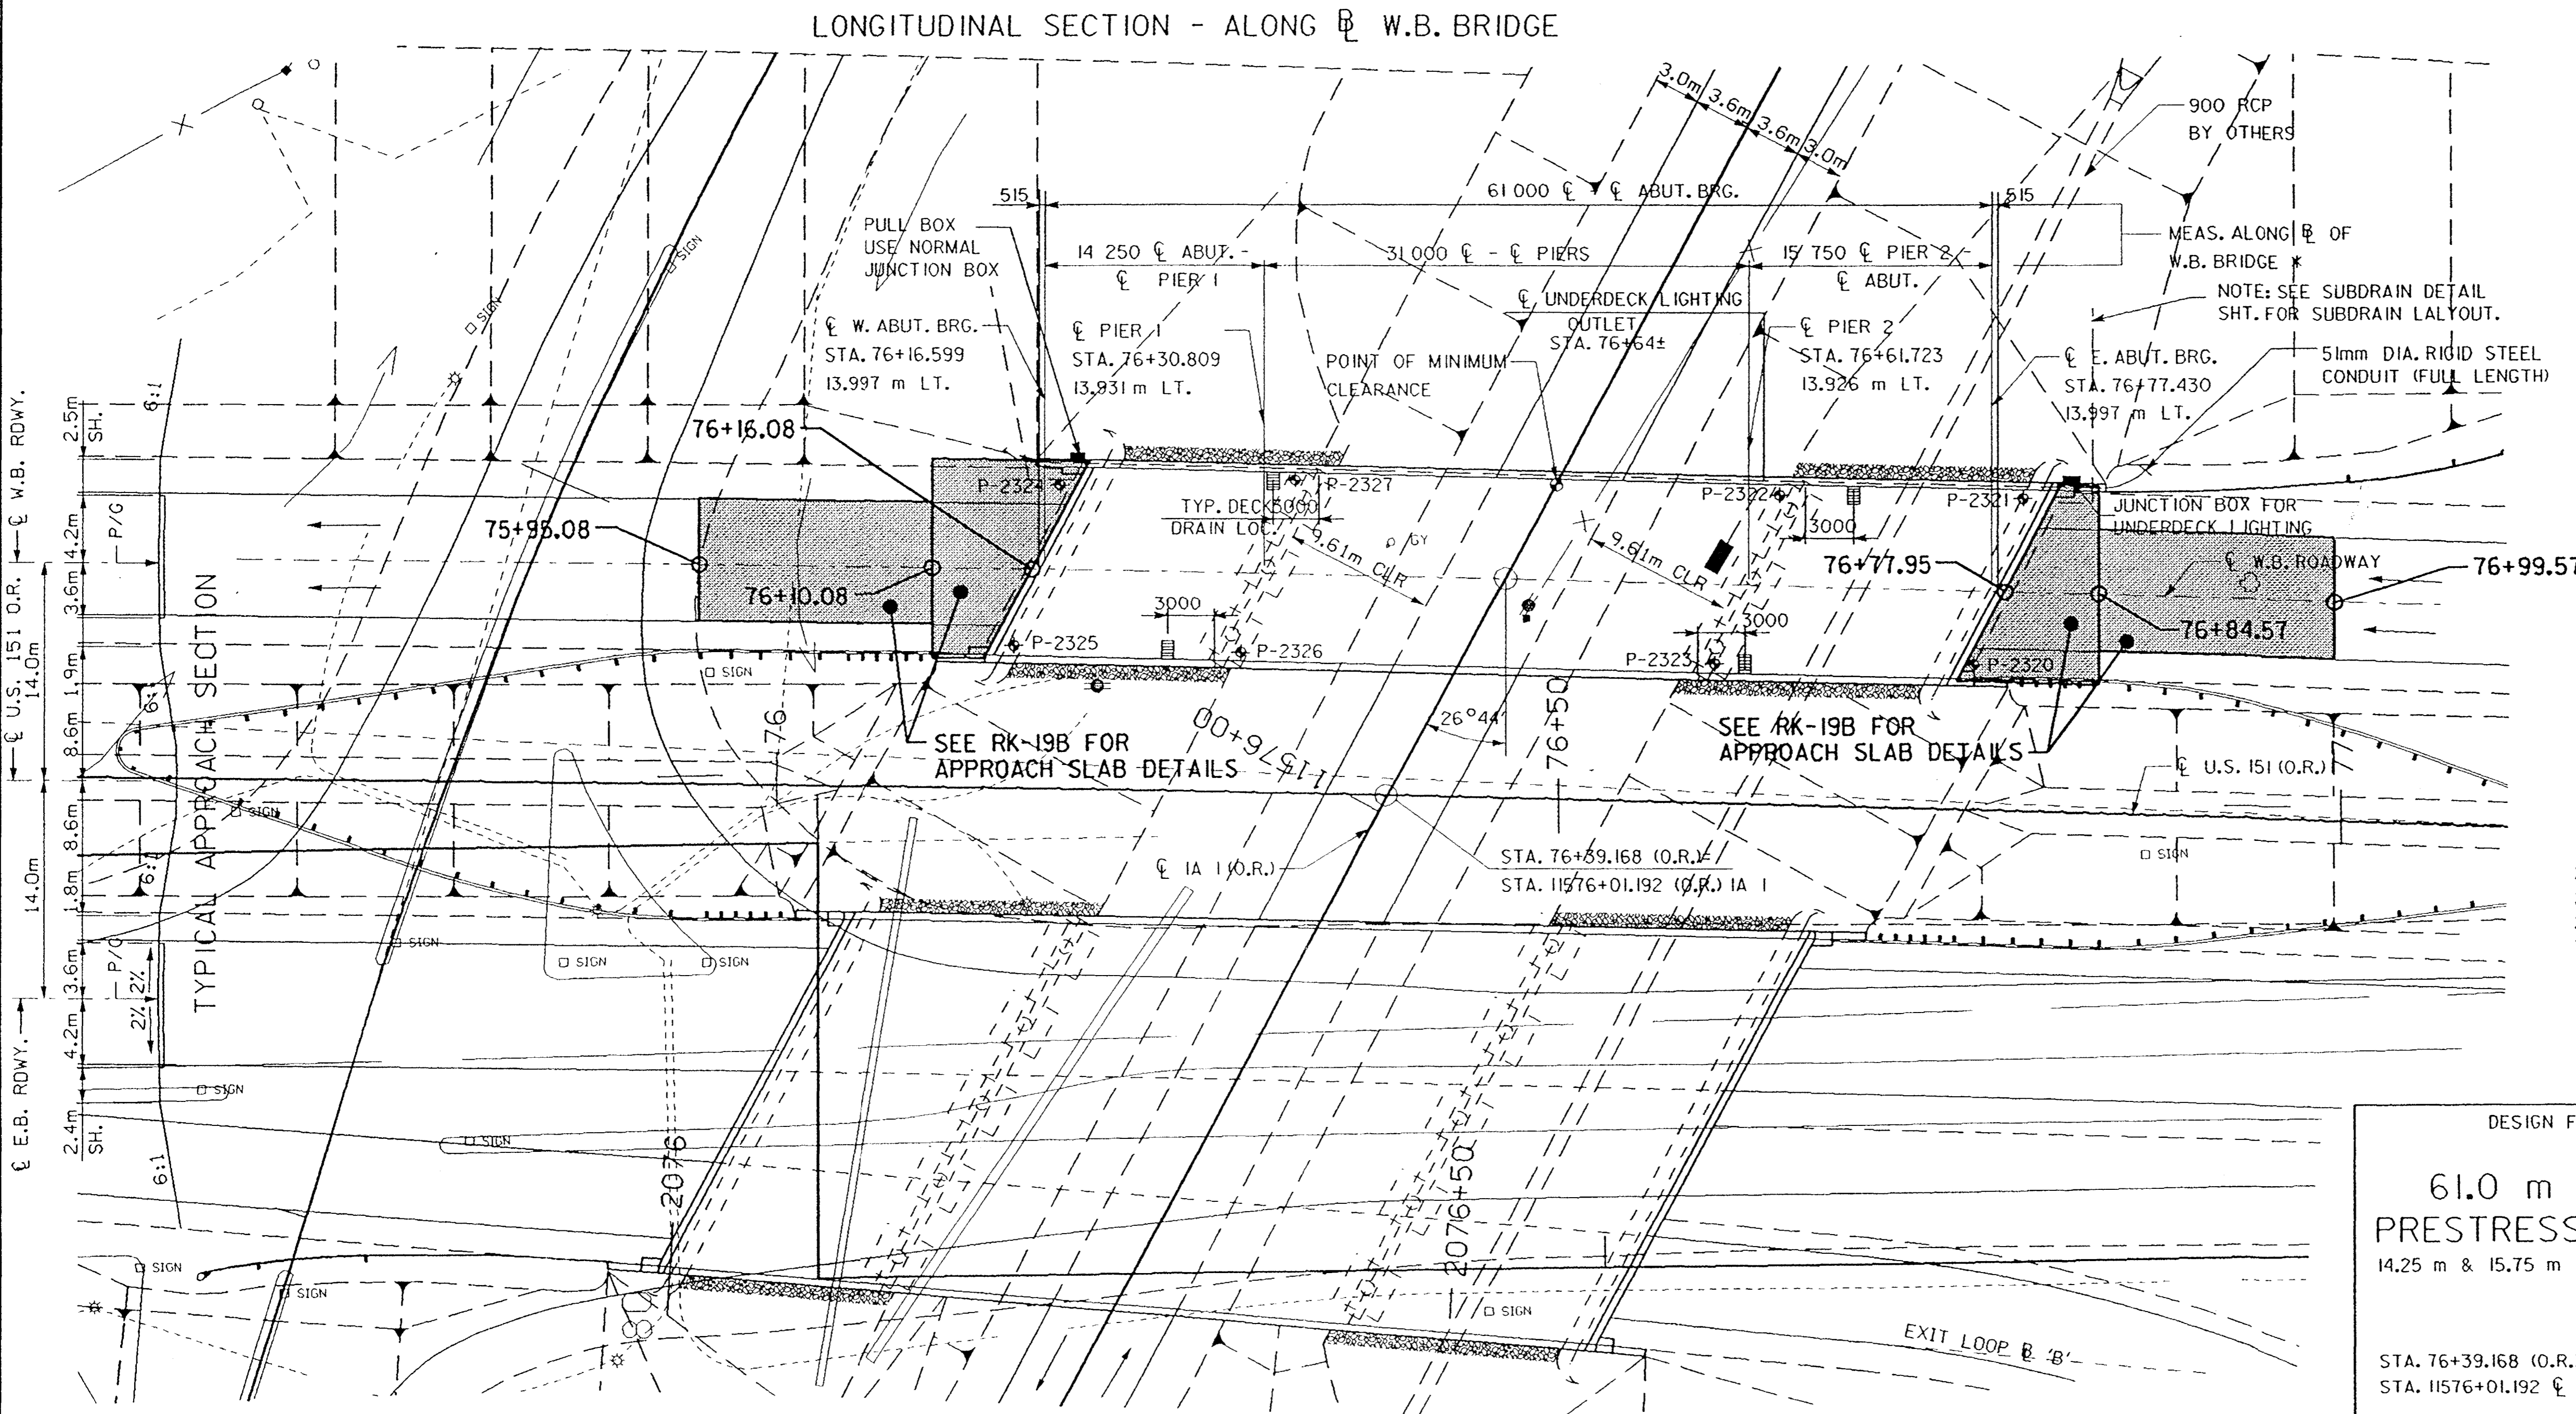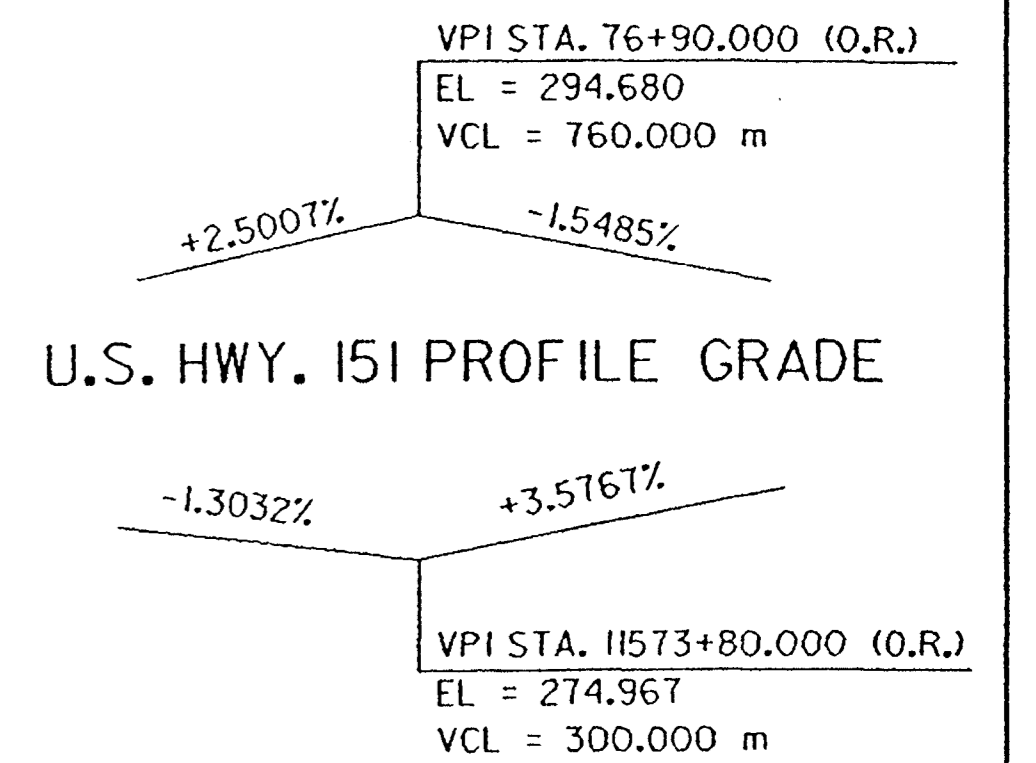

* BASELINE IS THE CHORD LINE DRAWN BETWEEN
 THE INTERSECTION POINTS OF ϕ APPROACH
 ROADWAY AND OUT TO OUT OF SLAB AT
 EACH ABUTMENT.

TRAFFIC DATA		LOCATION
2001 AADT	7230 VPD	U.S. 151 OVER IA I
2021 AADT	8660 VPD	T84N R4W
2021 DHV	930 VPH	SECTION 20
TRUCKS	11%	FAIRVIEW TWP. JONES COUNTY



DESIGN FOR 26°44' SKEW (L.A.) ON A 5000 m CURVE
WEST BOUND
61.0 m x 12.2 m PRETENSIONED
PRESTRESSED CONCRETE BEAM BRIDGE
 14.25 m & 15.75 m END SPANS 31.00 m CENTER SPAN
SITUATION PLAN (WB)
 STA. 76+39.168 (O.R.) ϕ U.S. HIGHWAY 151
 STA. 11576+01.192 ϕ IA I
 FEBRUARY 2000

JONES COUNTY
 IOWA DEPARTMENT OF TRANSPORTATION - PROJECT DEVELOPMENT DIVISION
 DESIGN SHEET NO. 2 OF 20 FILE NO. DESIGN NO. 198

FILE: [***] D:\17198C\H530198.S02
 TIME: WED AUG 30 10:15:56 2000

SITUATION PLAN - BRIDGE (W.B.L.)

S.B.I. NO. 17198C

EARTH TECH

JONES COUNTY

PROJECT NUMBER

NHSX-151-3(112)--3H-57

STATE

REGION

YEAR


SHEET

NO.


TOTAL

SHEETS


167-198

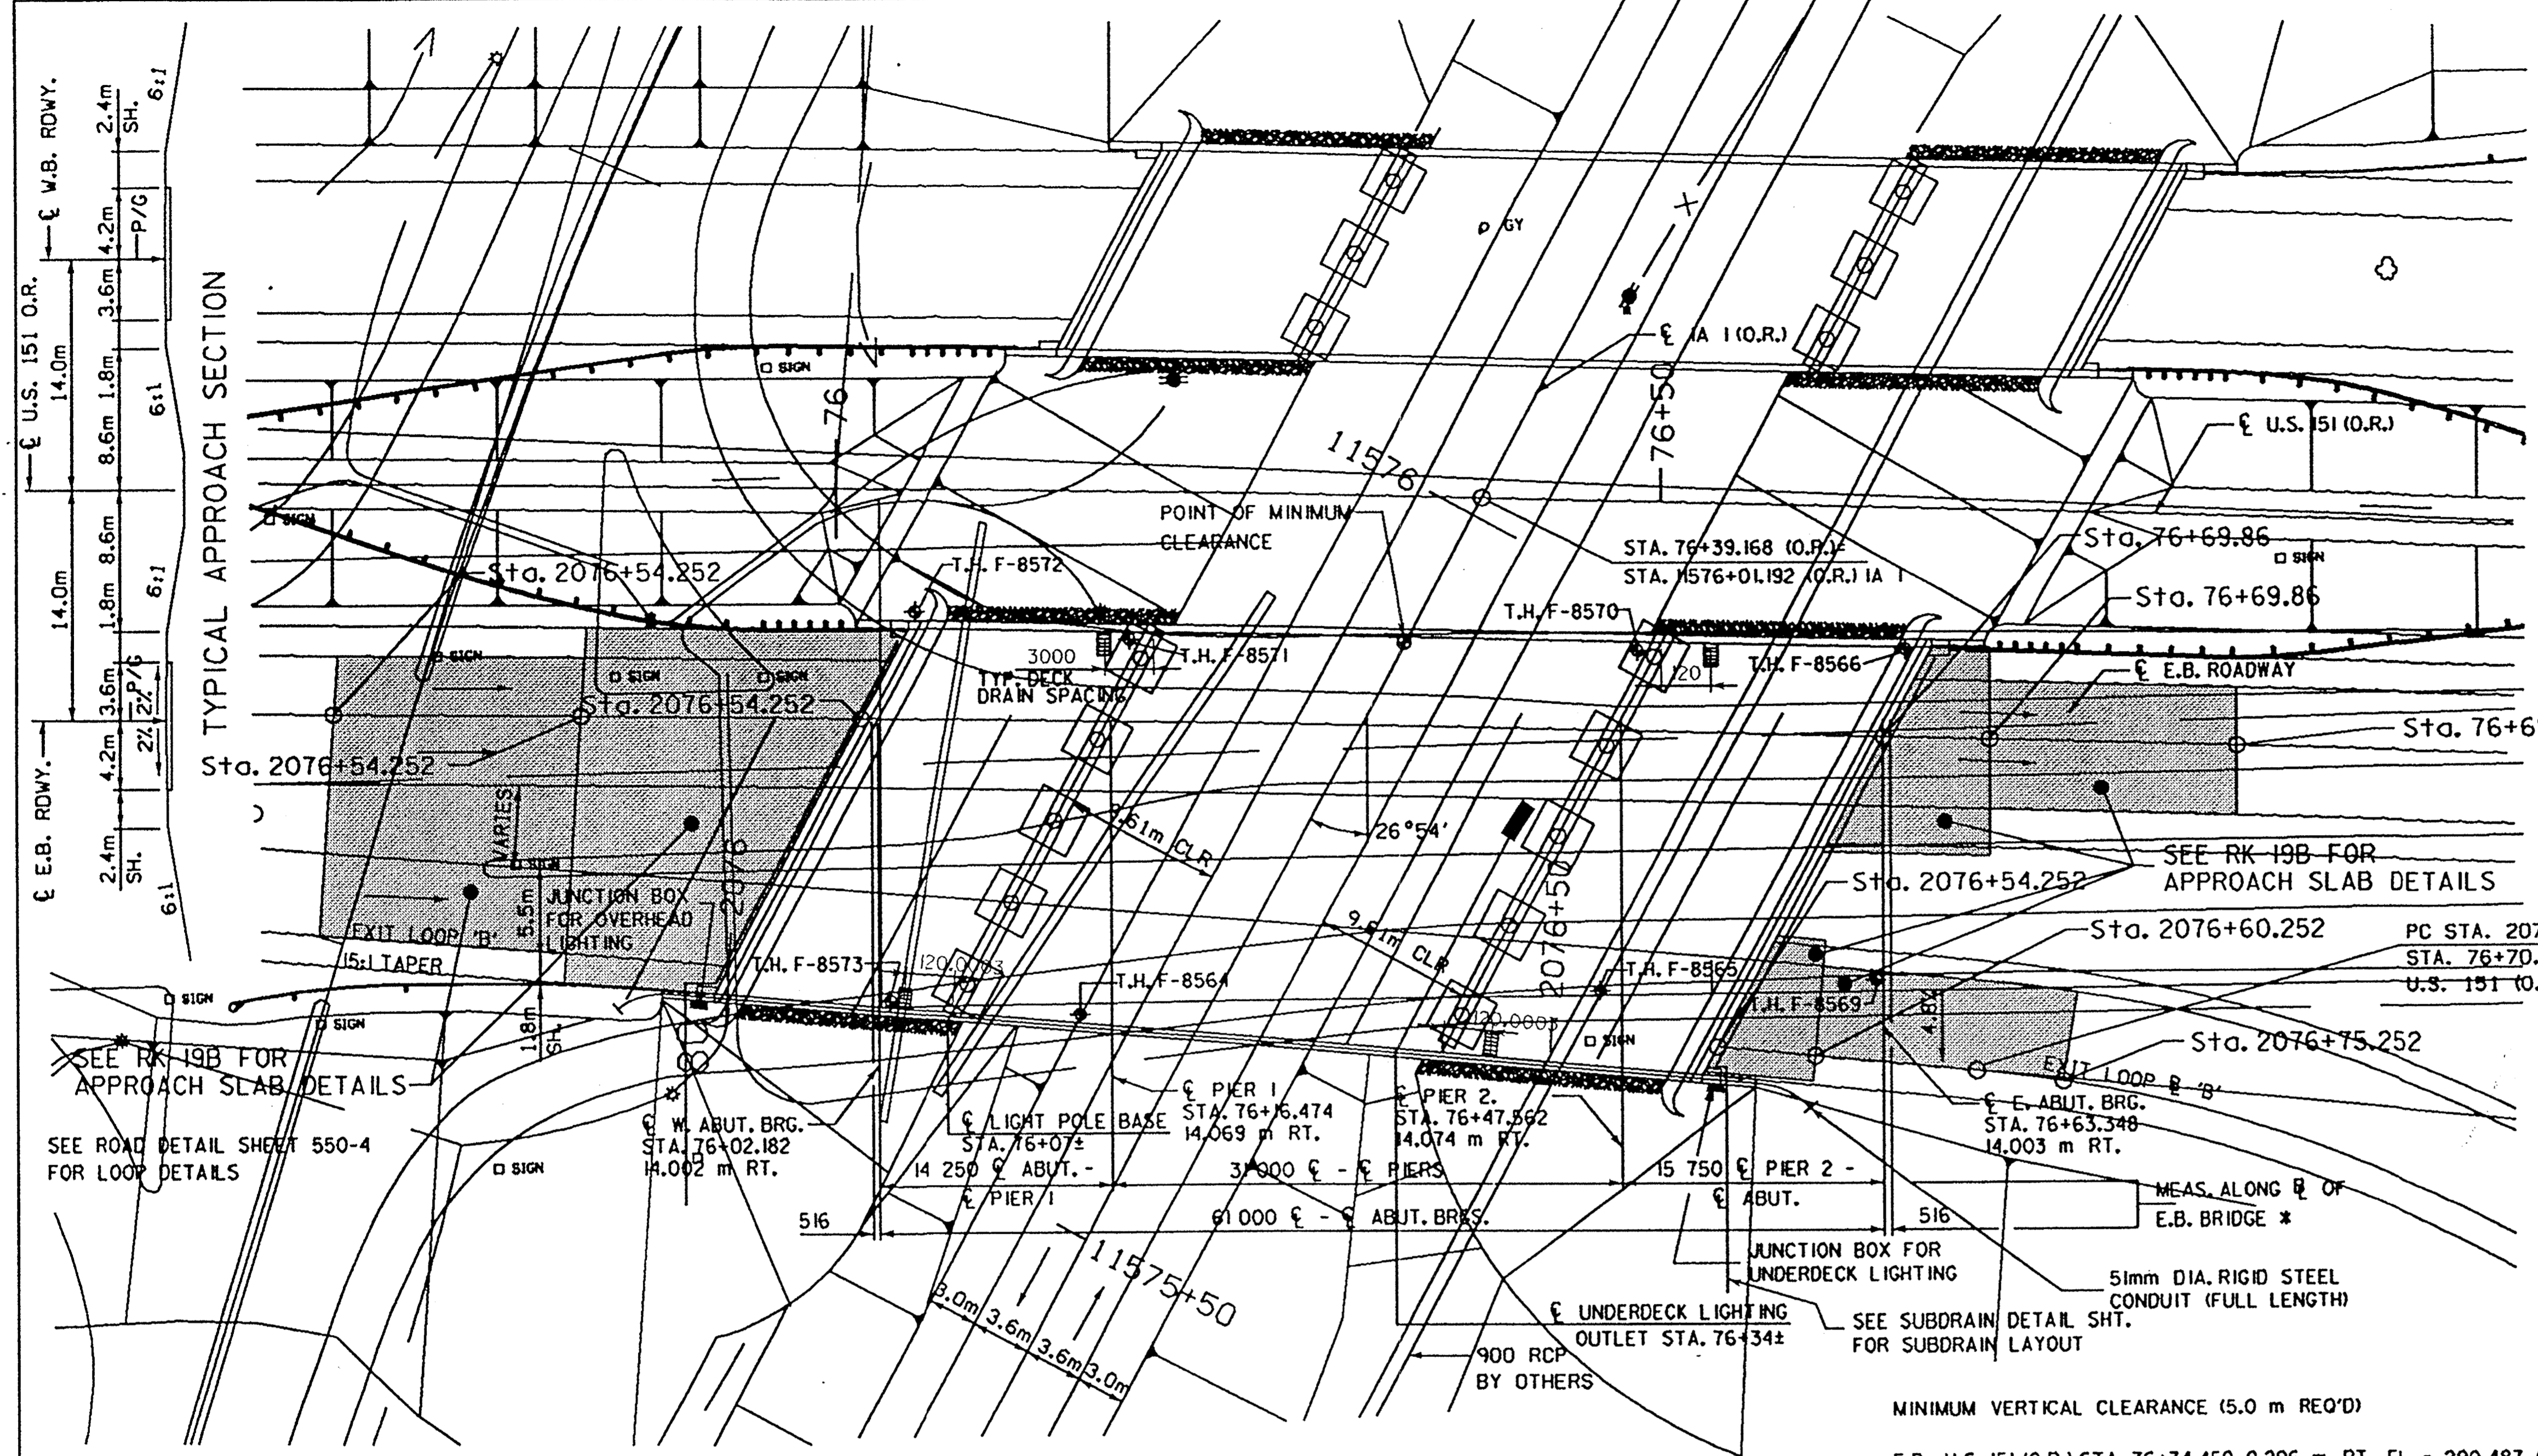

BENCH MARK:
 FOR NEW BENCH MARK INFORMATION, SEE PAGE G.18

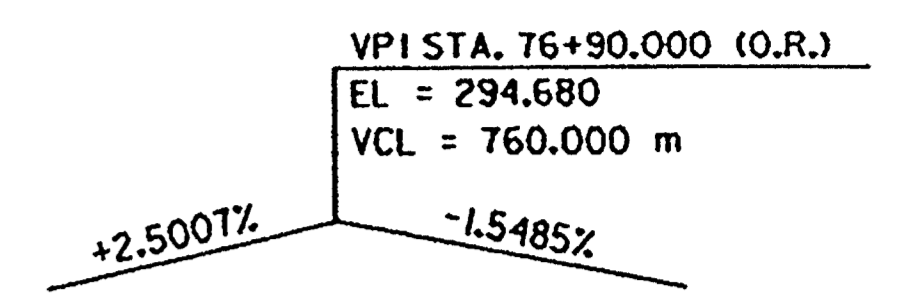

U.S. HWY. 151 PROFILE GRADE

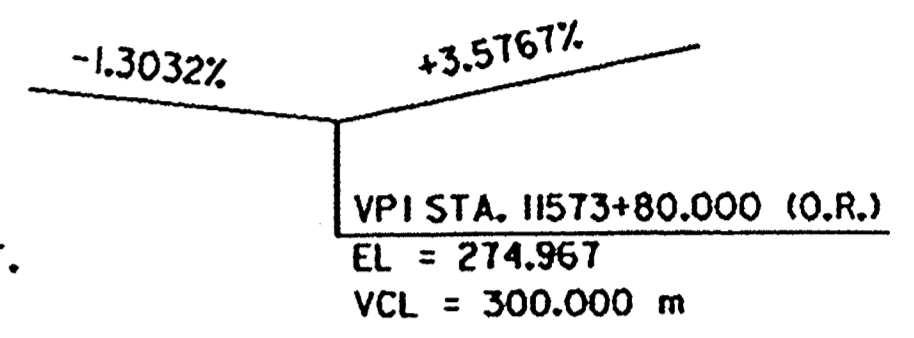


IA HWY 1 PROFILE GRADE

CURVE DATA
 P.I. STA. 75+33.327
 $\Delta = 4^{\circ}50'51.475''$ RT.
 T = 211.644
 L = 423.036
 E = 4.477
 R = 5000.000


* BASELINE IS THE CHORD LINE DRAWN BETWEEN THE INTERSECTION POINTS OF ϕ APPROACH ROADWAY AND OUT TO OUT OF SLAB AT EACH ABUTMENT.

TRAFFIC DATA		LOCATION
2001 AADT	7230 VPD	U.S. 151 OVER IA 1
2021 AADT	8660 VPH	T84N R4W
2021 DHV	930 VPH	SECTION 20
TRUCKS	11%	FAIRVIEW TWP.
		JONES COUNTY

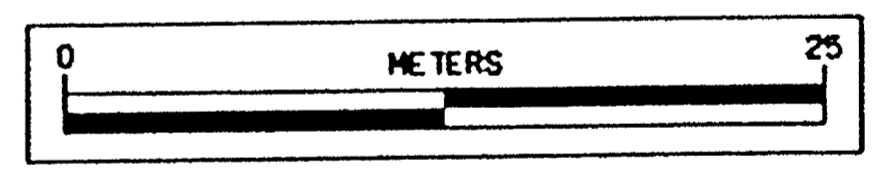

SITUATION PLAN - BRIDGE (E.B.L.)

NOTE:
 MINIMUM CLEAR ZONE REQUIRED IS 9.0 m ON IA 1.

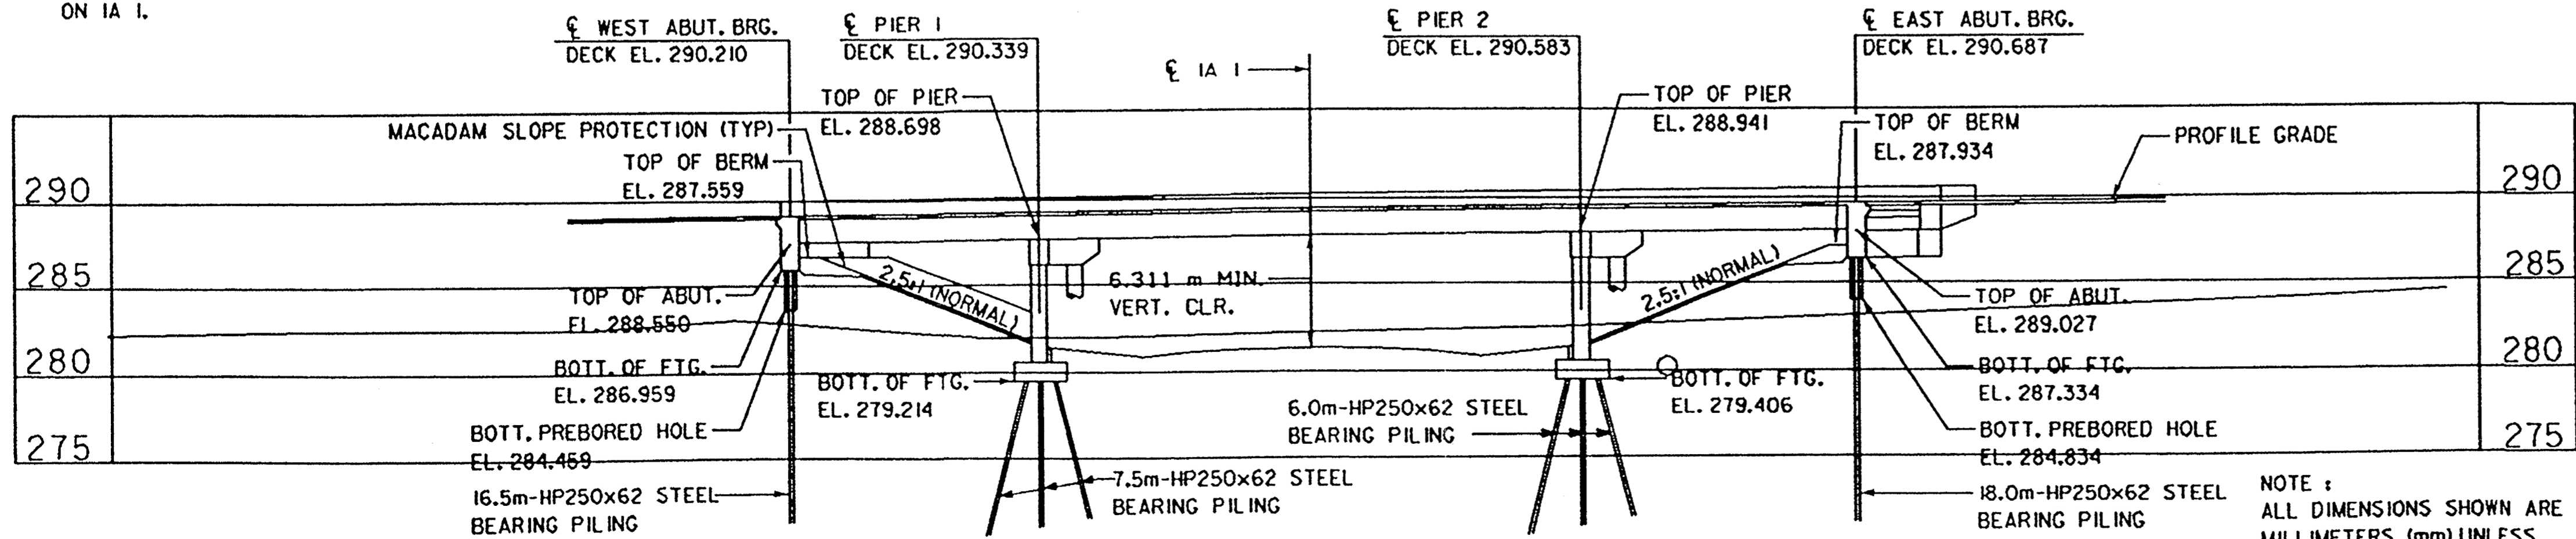

LONGITUDINAL SECTION - ALONG E.B. BRIDGE

DESIGN FOR 26°54' SKEW (L.A.) ON A 5000 m CURVE
EAST BOUND
 61.0 m x VAR. WIDTH PRETENSIONED
 PRESTRESSED CONCRETE BEAM BRIDGE
 14.25 m & 15.75 m END SPANS
 31.00 m CENTER SPAN

SITUATION PLAN

STA. 76+39.168 (O.R.) ϕ U.S. HIGHWAY 151
 STA. 11576+01.192 ϕ IA 1

JONES COUNTY

IOWA DEPARTMENT OF TRANSPORTATION - PROJECT DEVELOPMENT DIVISION
 DESIGN SHEET NO. 2 OF 29 FILE NO. _____ DESIGN NO. 298


FILE: [***] D:\17198C\H530298.S02
 TIME: THU MAR 23 14:24:50 2000

S.B.I. NO. 17198C




JONES COUNTY PROJECT NUMBER NHSX-151-3(112)--3H-57

STATE	FHWA REGION	FISCAL YEAR	SHEET NO.	TOTAL SHEETS
IOWA	7		V.15	

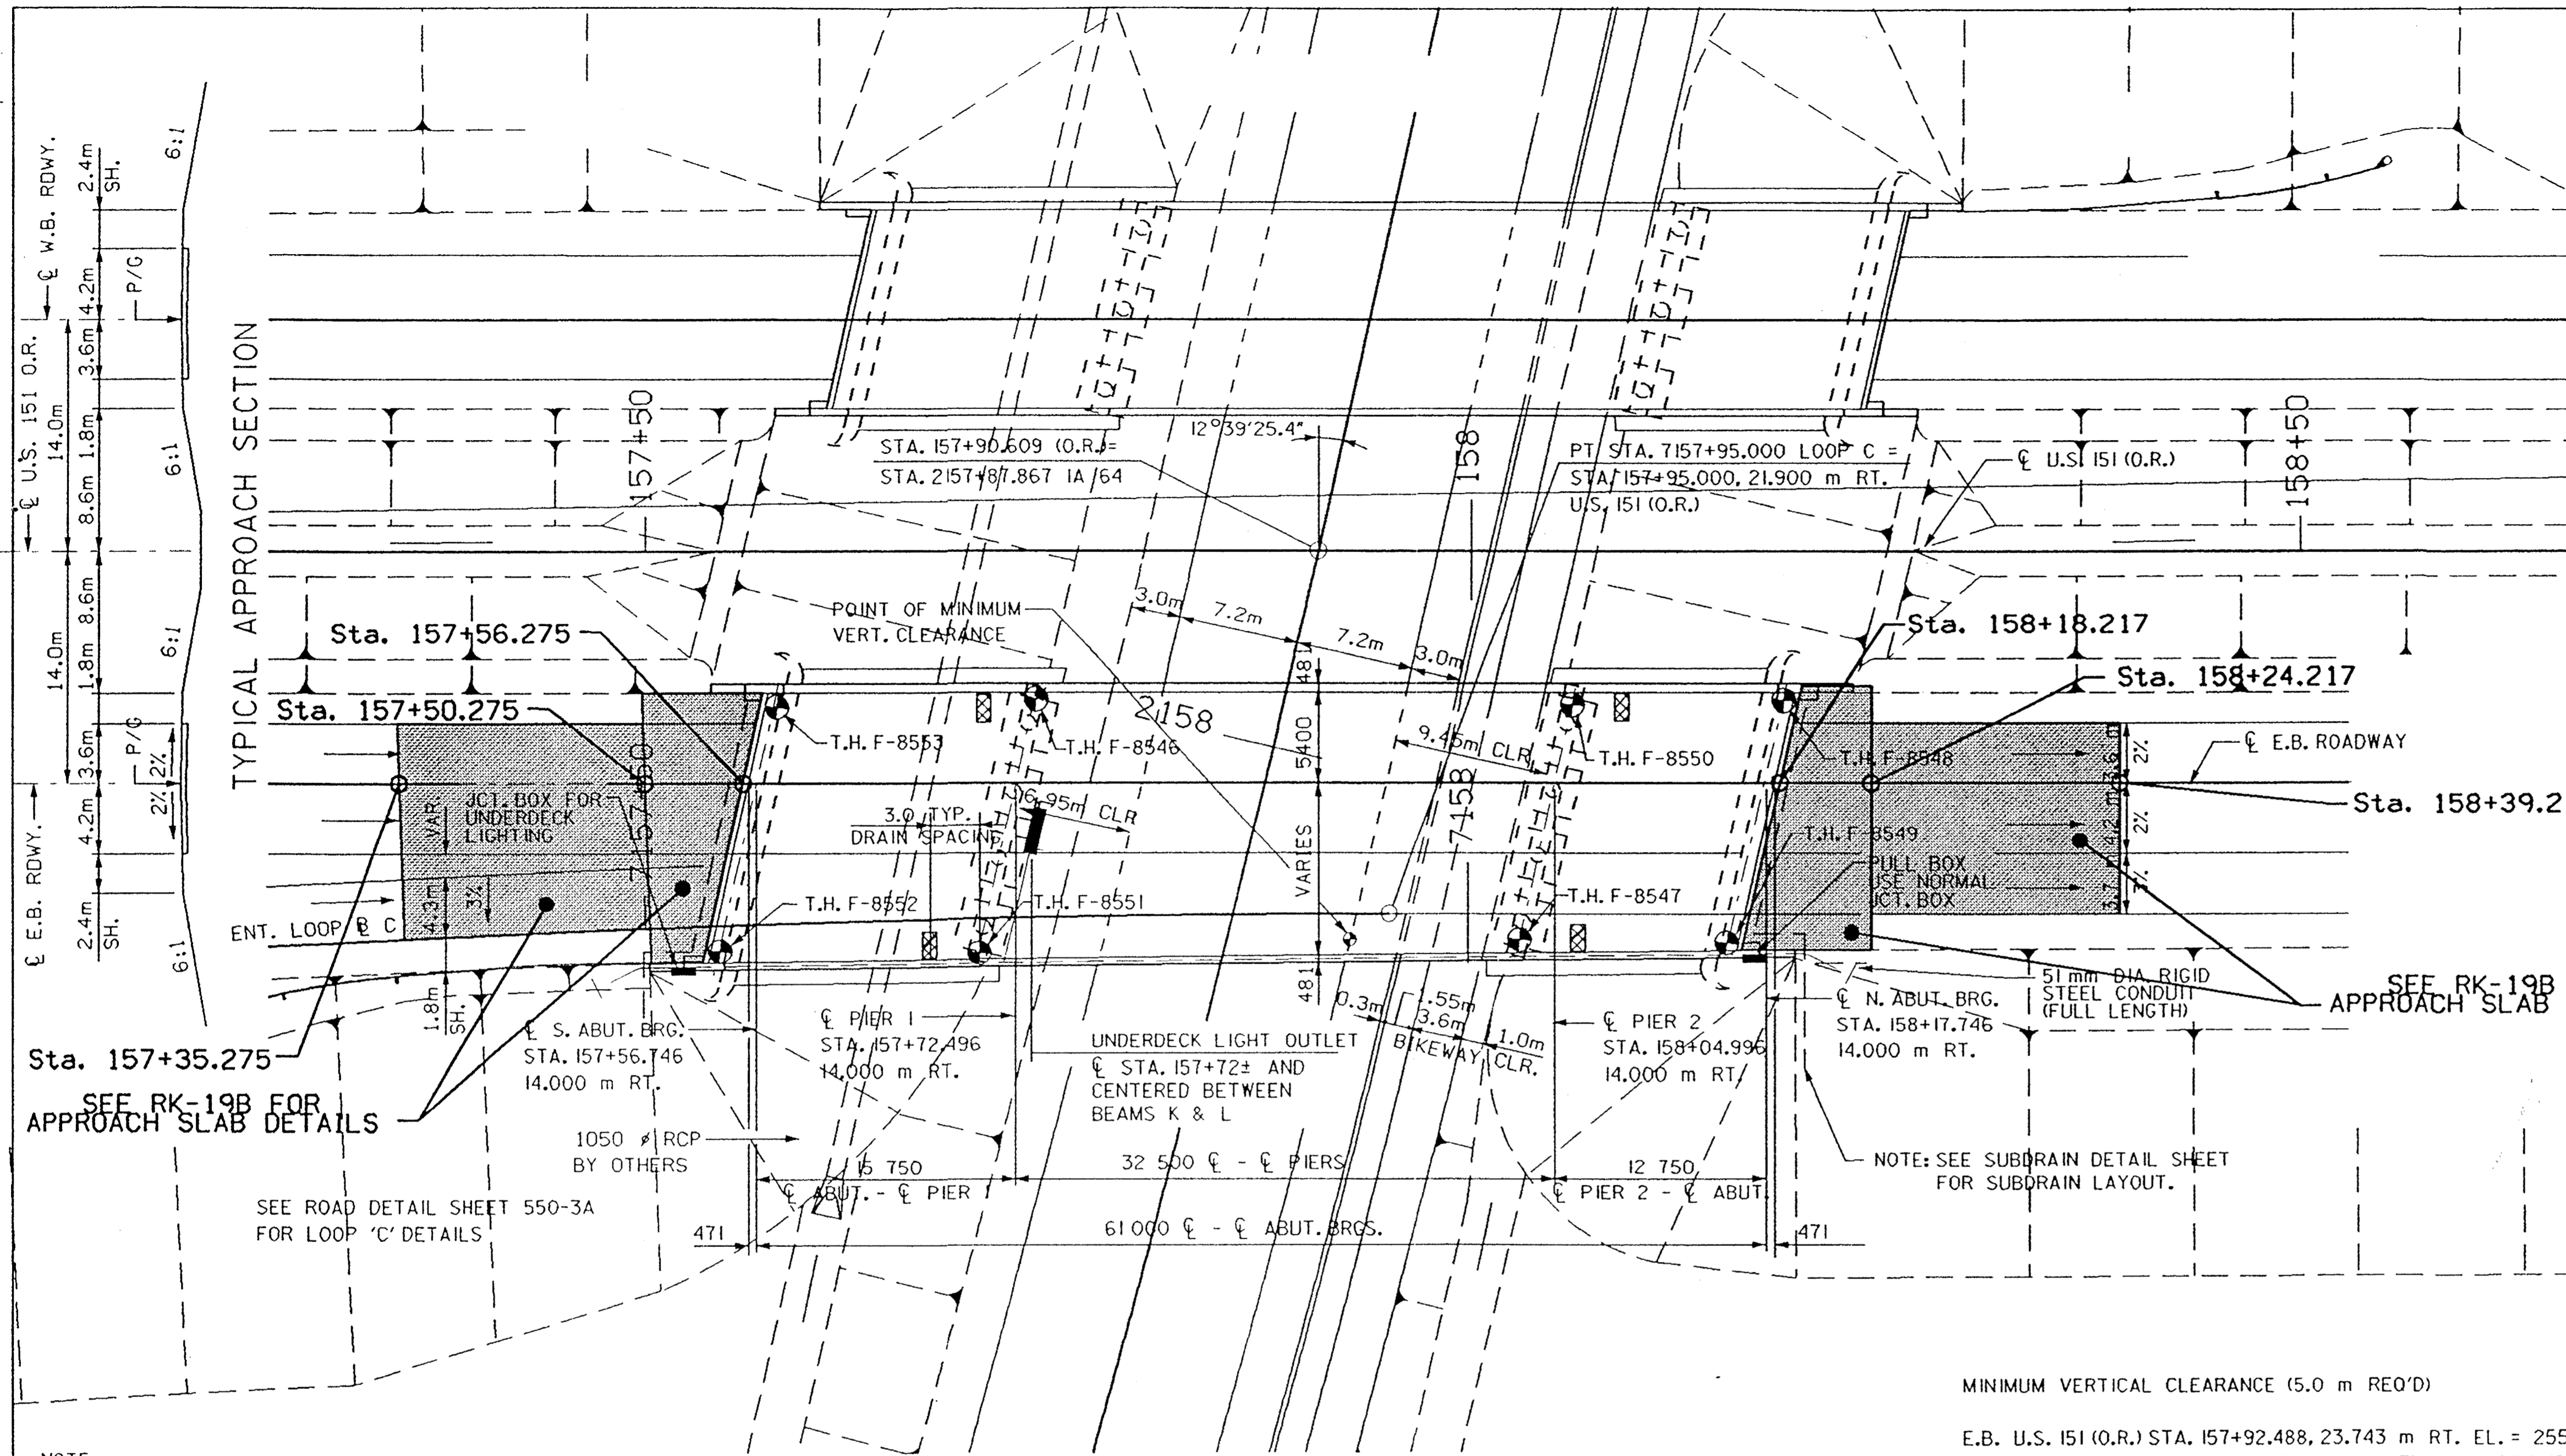

BENCH MARK:
FOR NEW BENCH MARK INFORMATION, SEE PAGE G.18

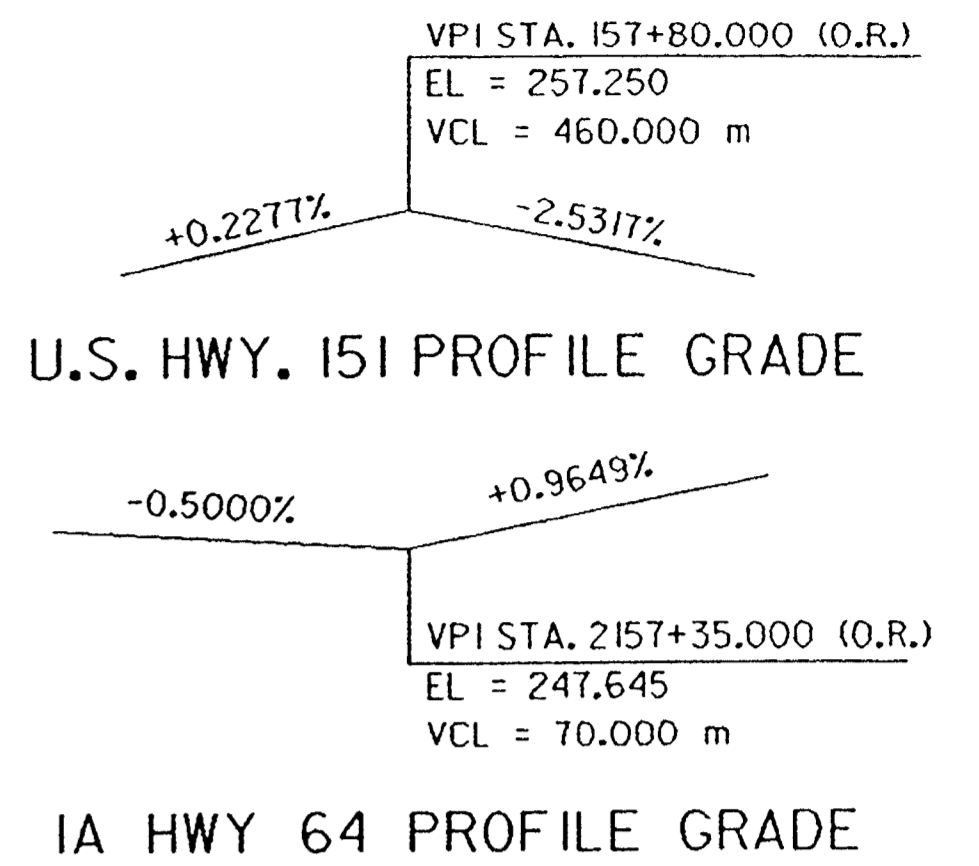

IA 64 CURVE DATA

P.I. STA. 2159+41.145
Δ = 14°41'19.56" RT.
R = 1165.011 m
T = 150.159 m
L = 298.671 m
E = 9.637 m
e = 3.0%
L = 44.0 m
x = 30.0 m


NOTE:
MINIMUM CLEAR ZONE REQUIRED IS
6.5 m ON IA 64, FUTURE BIKEWAY ON NORTH
SIDE OF IA 64.

MINIMUM VERTICAL CLEARANCE (5.0 m REQ'D)

E.B. U.S. 151 (O.R.) STA. 157+92.488, 23.743 m RT. EL. = 255.515 (PROFILE GRADE)
IA 64 (O.R.) STA. 2158+10.501 EL. = 248.374 (PROFILE GRADE)
SUPERSTRUCTURE DEPTH TO LOW CONC. (INCL. CROWN AND SUPERLEV.) = 2.032 m
E.B. MIN. VERTICAL CLEARANCE = 5.109 m

TRAFFIC DATA		LOCATION
2001 AADT	6590 VPD	U.S. 151 OVER IA 64
2021 AADT	7910 VPD	T84N R4W
2021 DHV	850 VPH	SECTION II
TRUCKS	12%	FAIRVIEW TWP. JONES COUNTY

SITUATION PLAN - BRIDGE (E.B.L.)

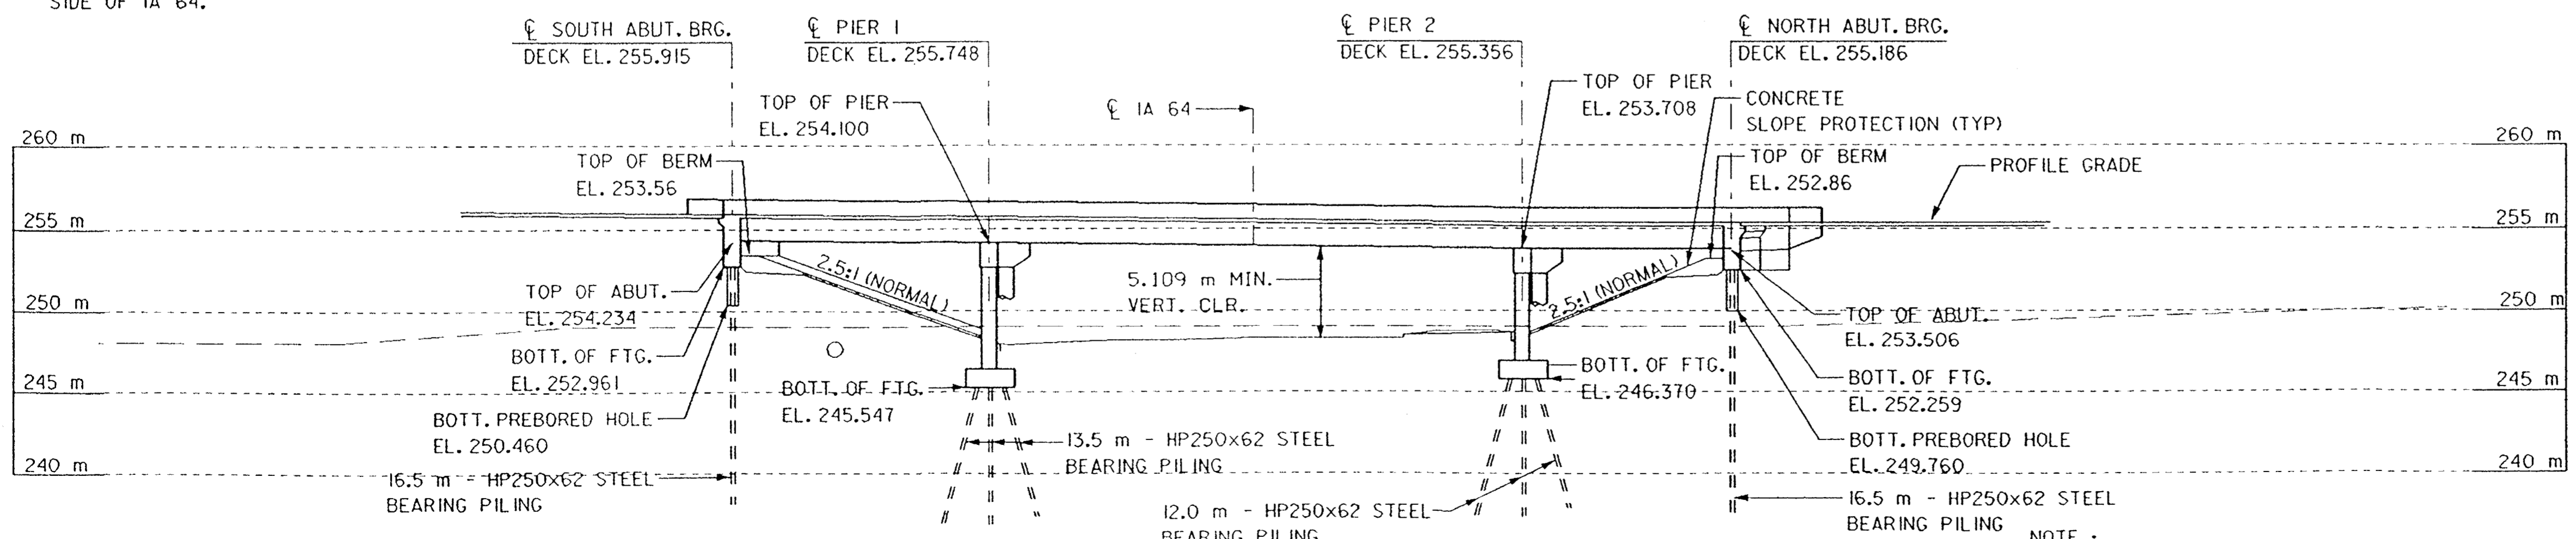

LONGITUDINAL SECTION - ALONG ROADWAY (E.B.L.)



NOTE:
ALL DIMENSIONS SHOWN ARE IN MILLIMETERS (mm)
UNLESS OTHERWISE NOTED OR SHOWN.

DESIGN FOR 12°39'25" SKEW (L.A.)
EAST BOUND
61.0 m x VARIABLE WIDTH PRETENSIONED
PRESTRESSED CONCRETE BEAM BRIDGE
15.75 m & 12.75 m END SPANS 32.50 m CENTER SPAN
SITUATION PLAN
STA. 157+90.609 (O.R.) U.S. HWY. 151
STA. 2157+87.867 (O.R.) IA 64
JONES COUNTY
NOVEMBER, 1999
IOWA DEPARTMENT OF TRANSPORTATION - PROJECT DEVELOPMENT DIVISION
DESIGN SHEET NO. 2 OF 22 FILE NO. 29164 DESIGN NO. 1498


NOTE :
 MINIMUM CLEAR ZONE REQUIRED IS
 6.5 m ON IA 64. FUTURE BIKEWAY ON NORTH
 SIDE OF IA 64.

MINIMUM VERTICAL CLEARANCE (5.0 m REQ'D)

BENCH MARK:
 FOR NEW BENCH MARK INFORMATION,
 SEE PAGE G.18

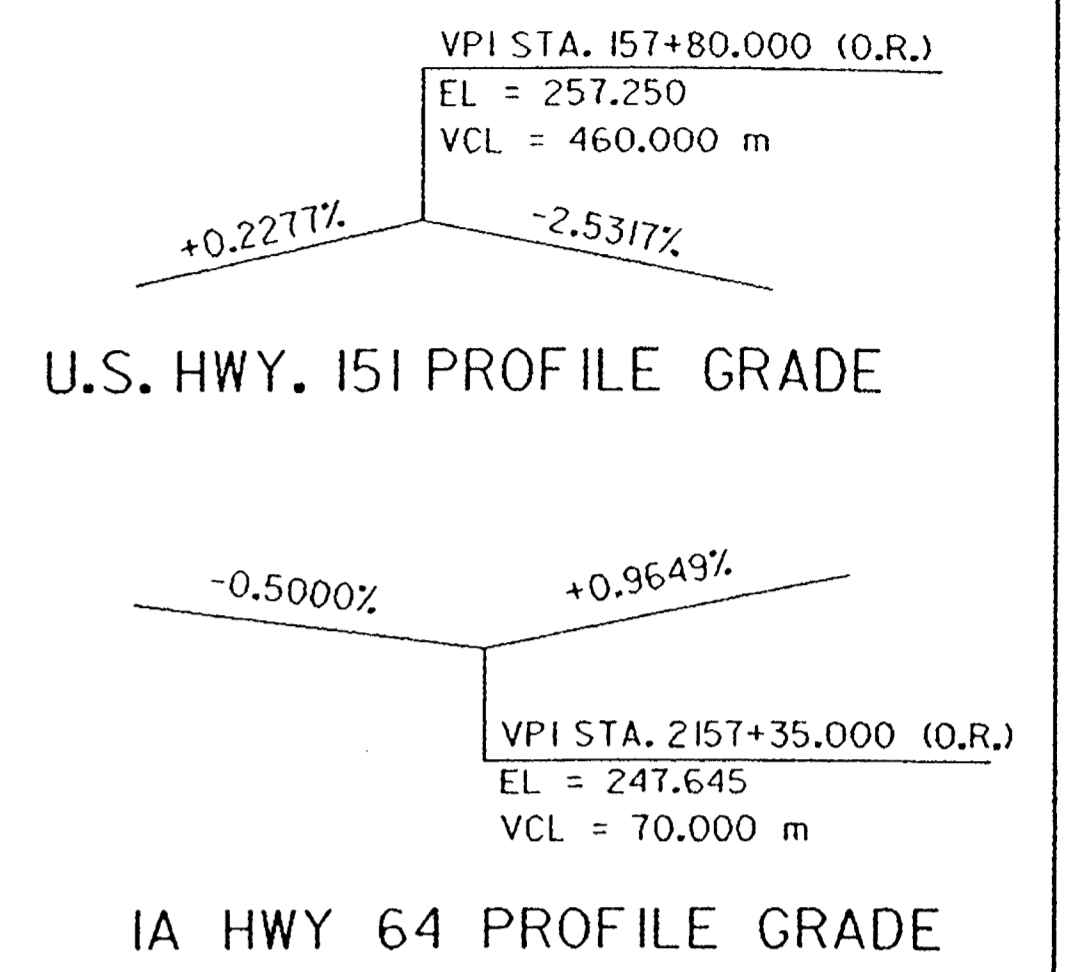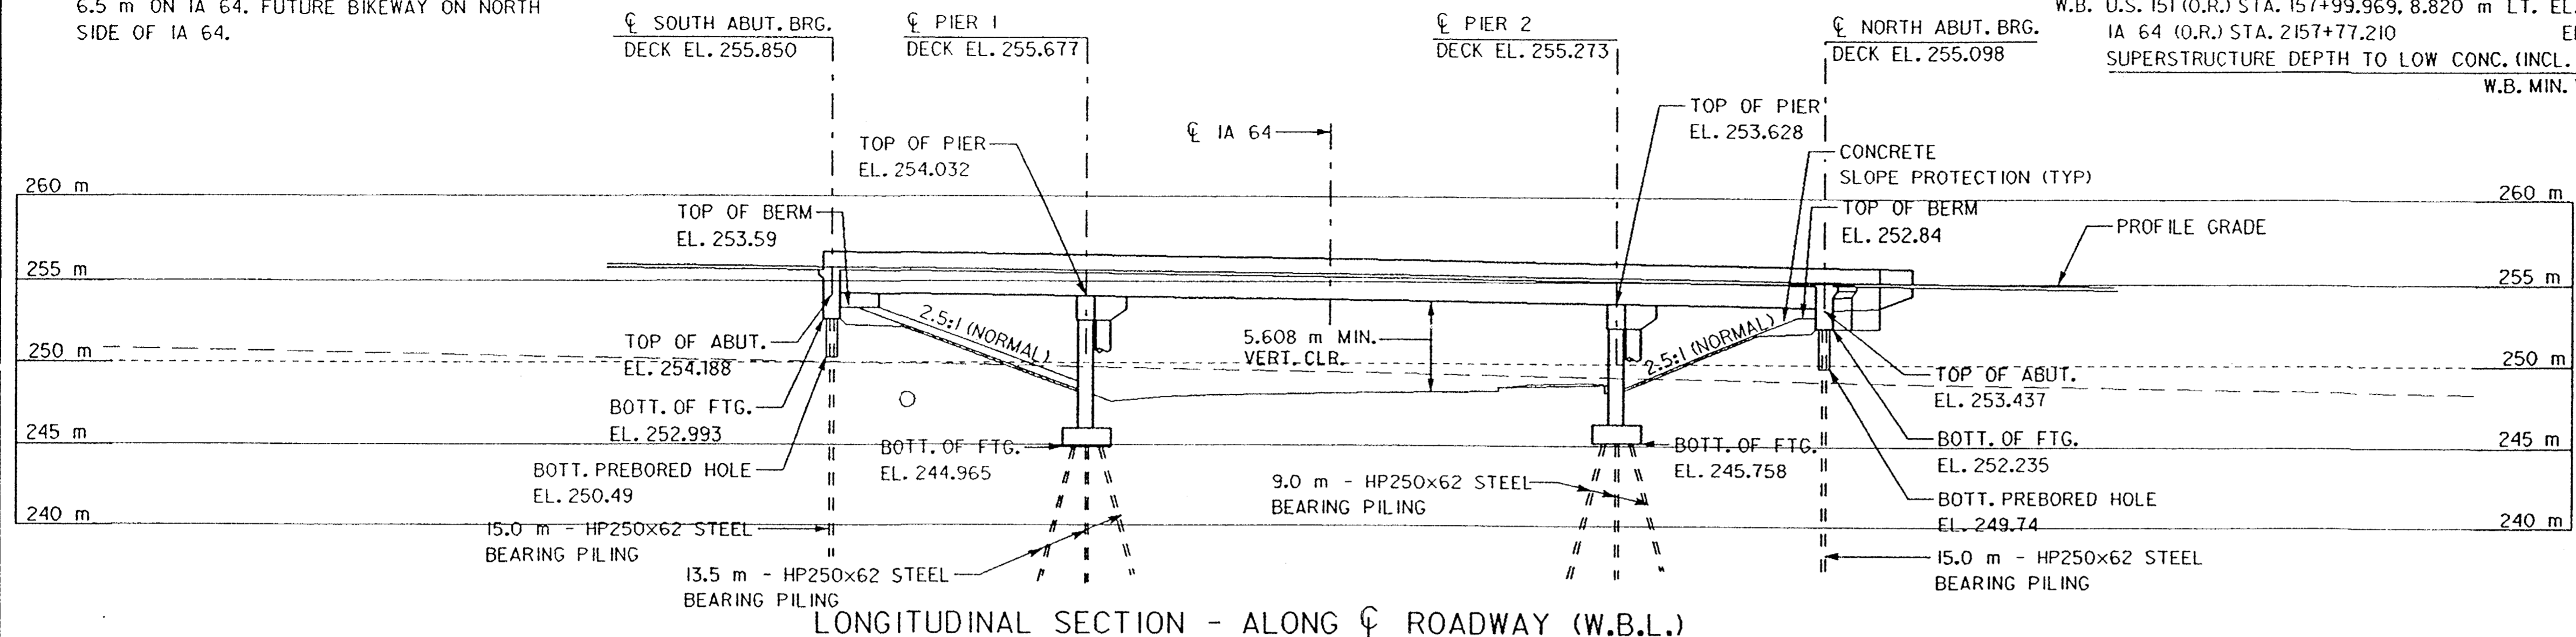


IA 64 CURVE DATA
 P.I. STA. 2159+41.145
 $\Delta = 14^\circ 41' 19.56''$ RT.
 R = 1165.011 m
 T = 150.159 m
 L = 298.671 m
 E = 9.637 m
 $e = 3.0\%$
 L = 44.0 m
 x = 30.0 m

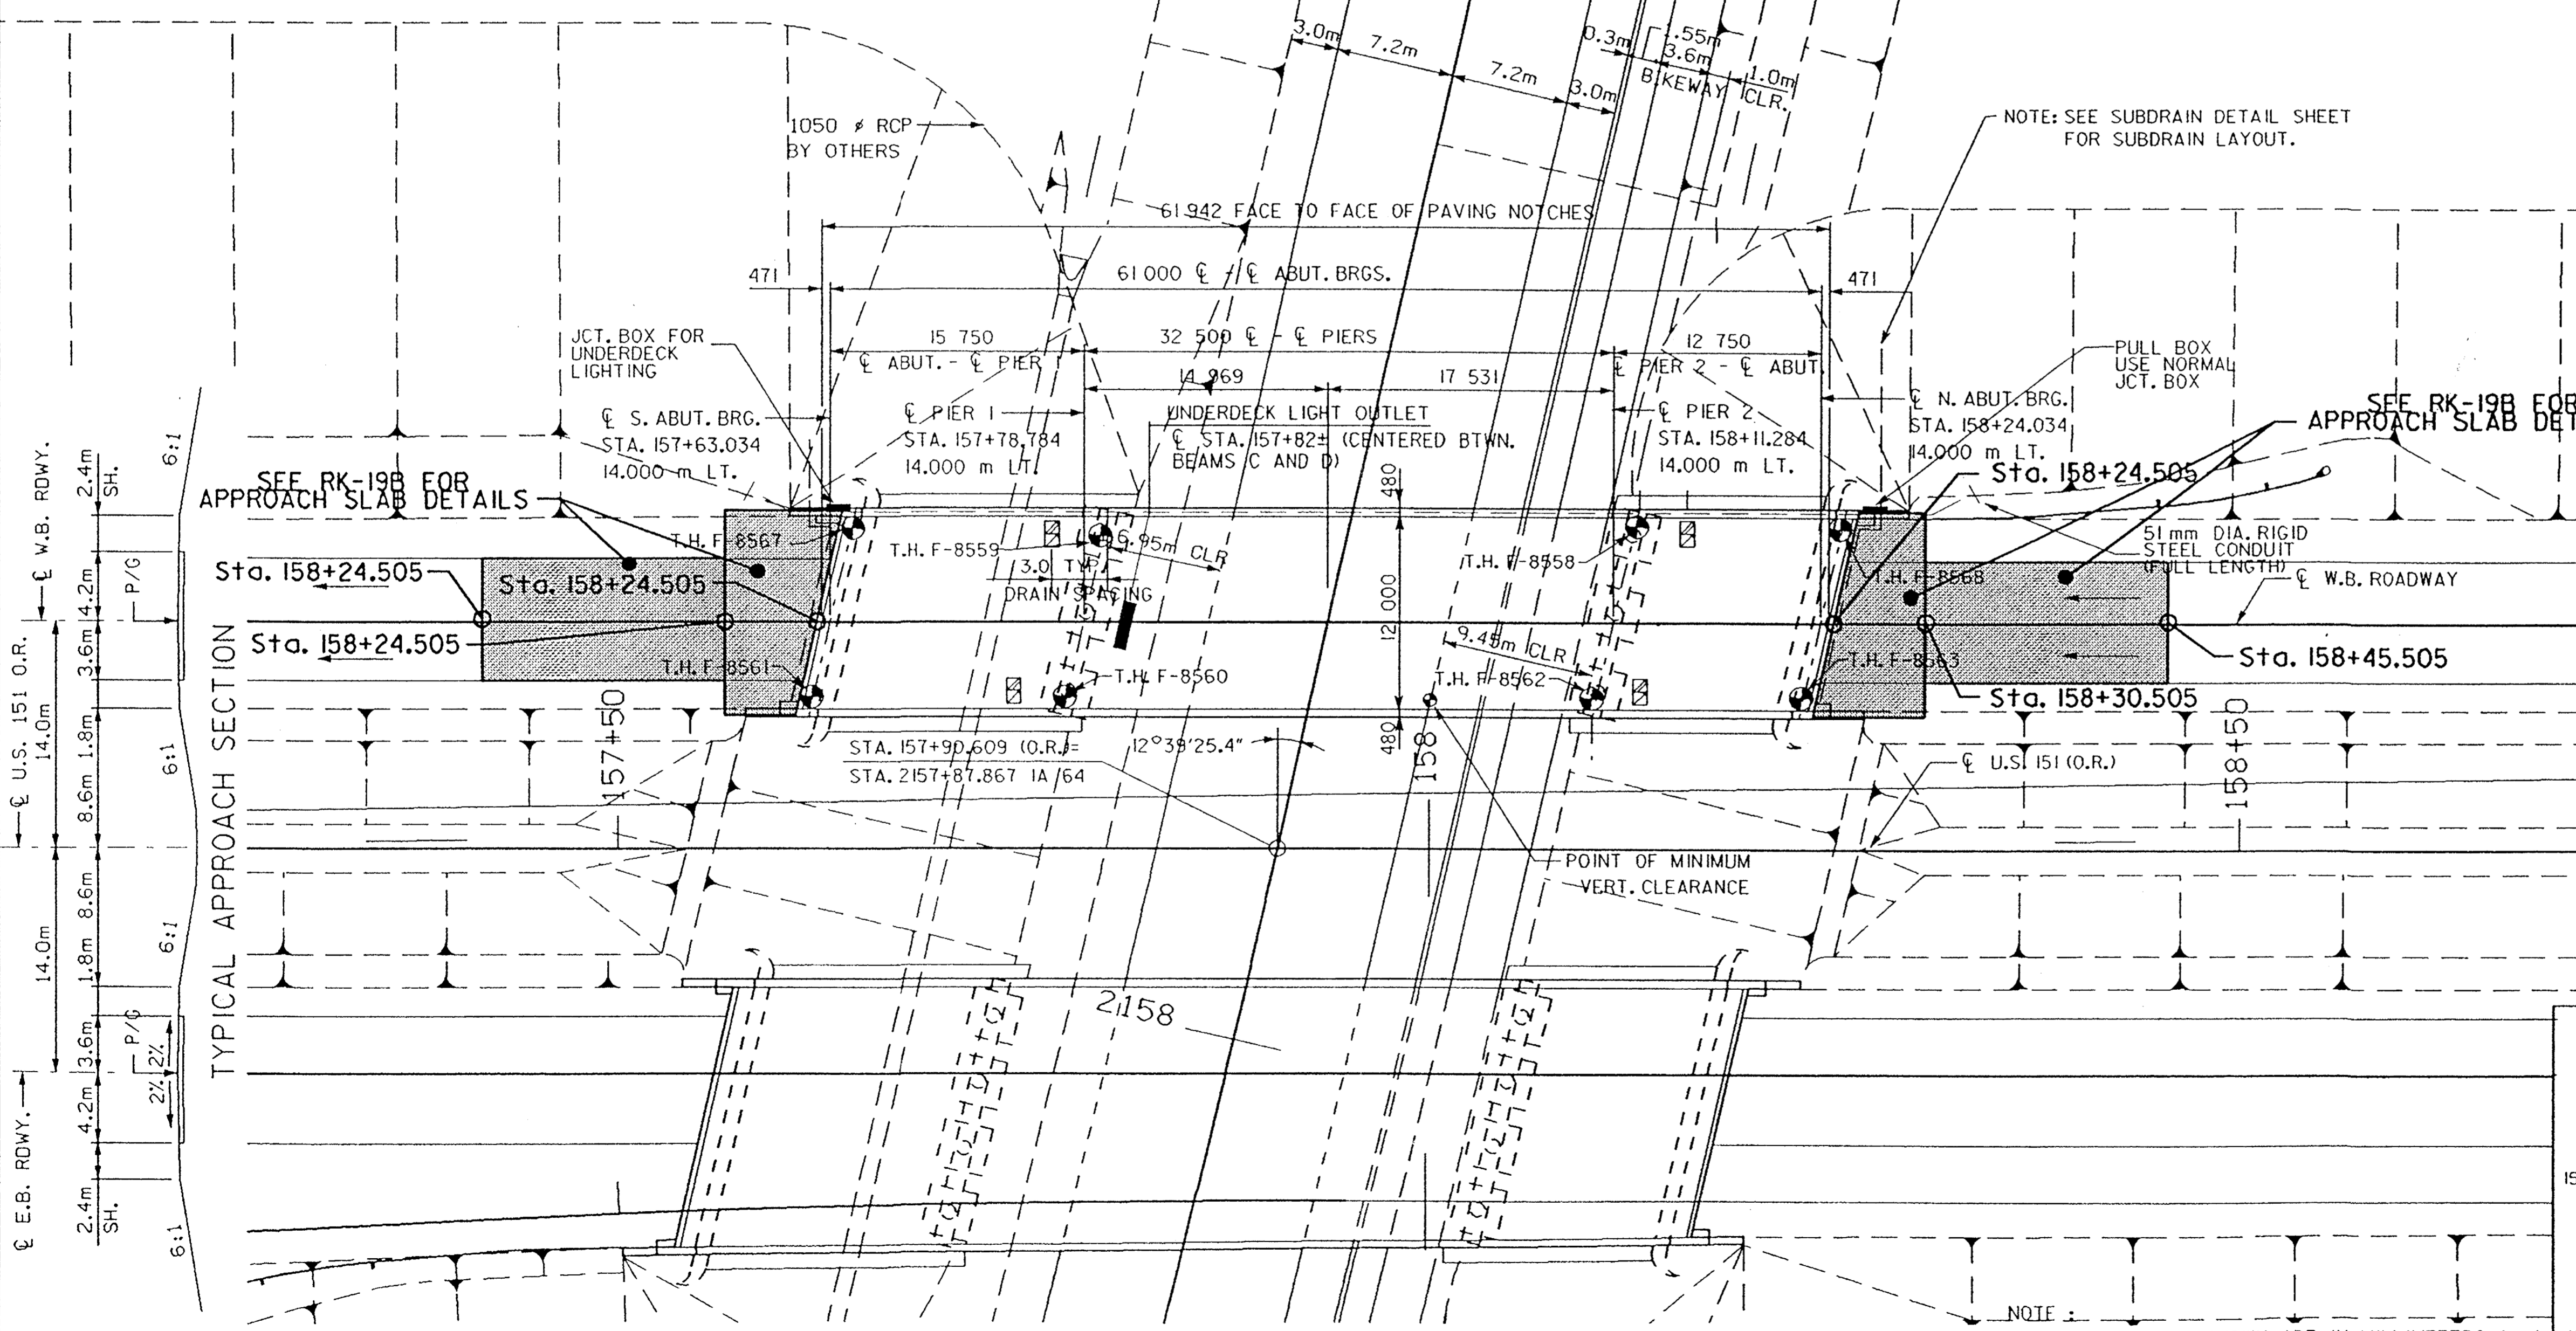


TRAFFIC DATA LOCATION

Year	ADT	VPD	Location
2001	6590	6590	U.S. 151 OVER IA 64
2021	7910	7910	T84N R4W
2021	850	850	SECTION II
TRUCKS	12%		FAIRVIEW TWP. JONES COUNTY

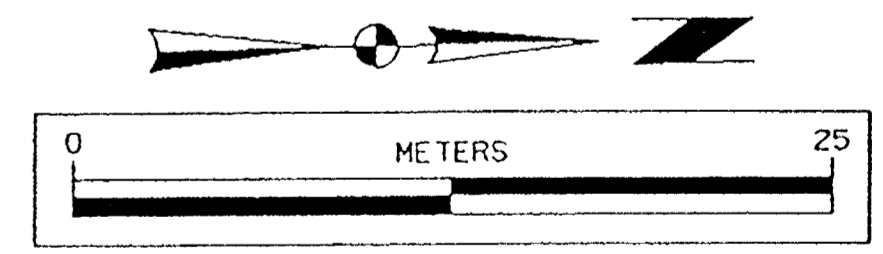

DESIGN FOR 12°39'25" SKEW (L.A.)
WEST BOUND
 61.0 m x 12.0 m PRETENSIONED
 PRESTRESSED CONCRETE BEAM BRIDGE
 15.75 m & 12.75 END SPANS 32.50 m CENTER SPAN
SITUATION PLAN
 STA. 157+90.609 (O.R.) U.S. HWY. 151
 STA. 2157+87.867 (O.R.) IA 64
 JONES COUNTY
 NOVEMBER, 1999
 IOWA DEPARTMENT OF TRANSPORTATION - PROJECT DEVELOPMENT DIVISION
 DESIGN SHEET NO. 2 OF 20 FILE NO. 29164 DESIGN NO. 1598

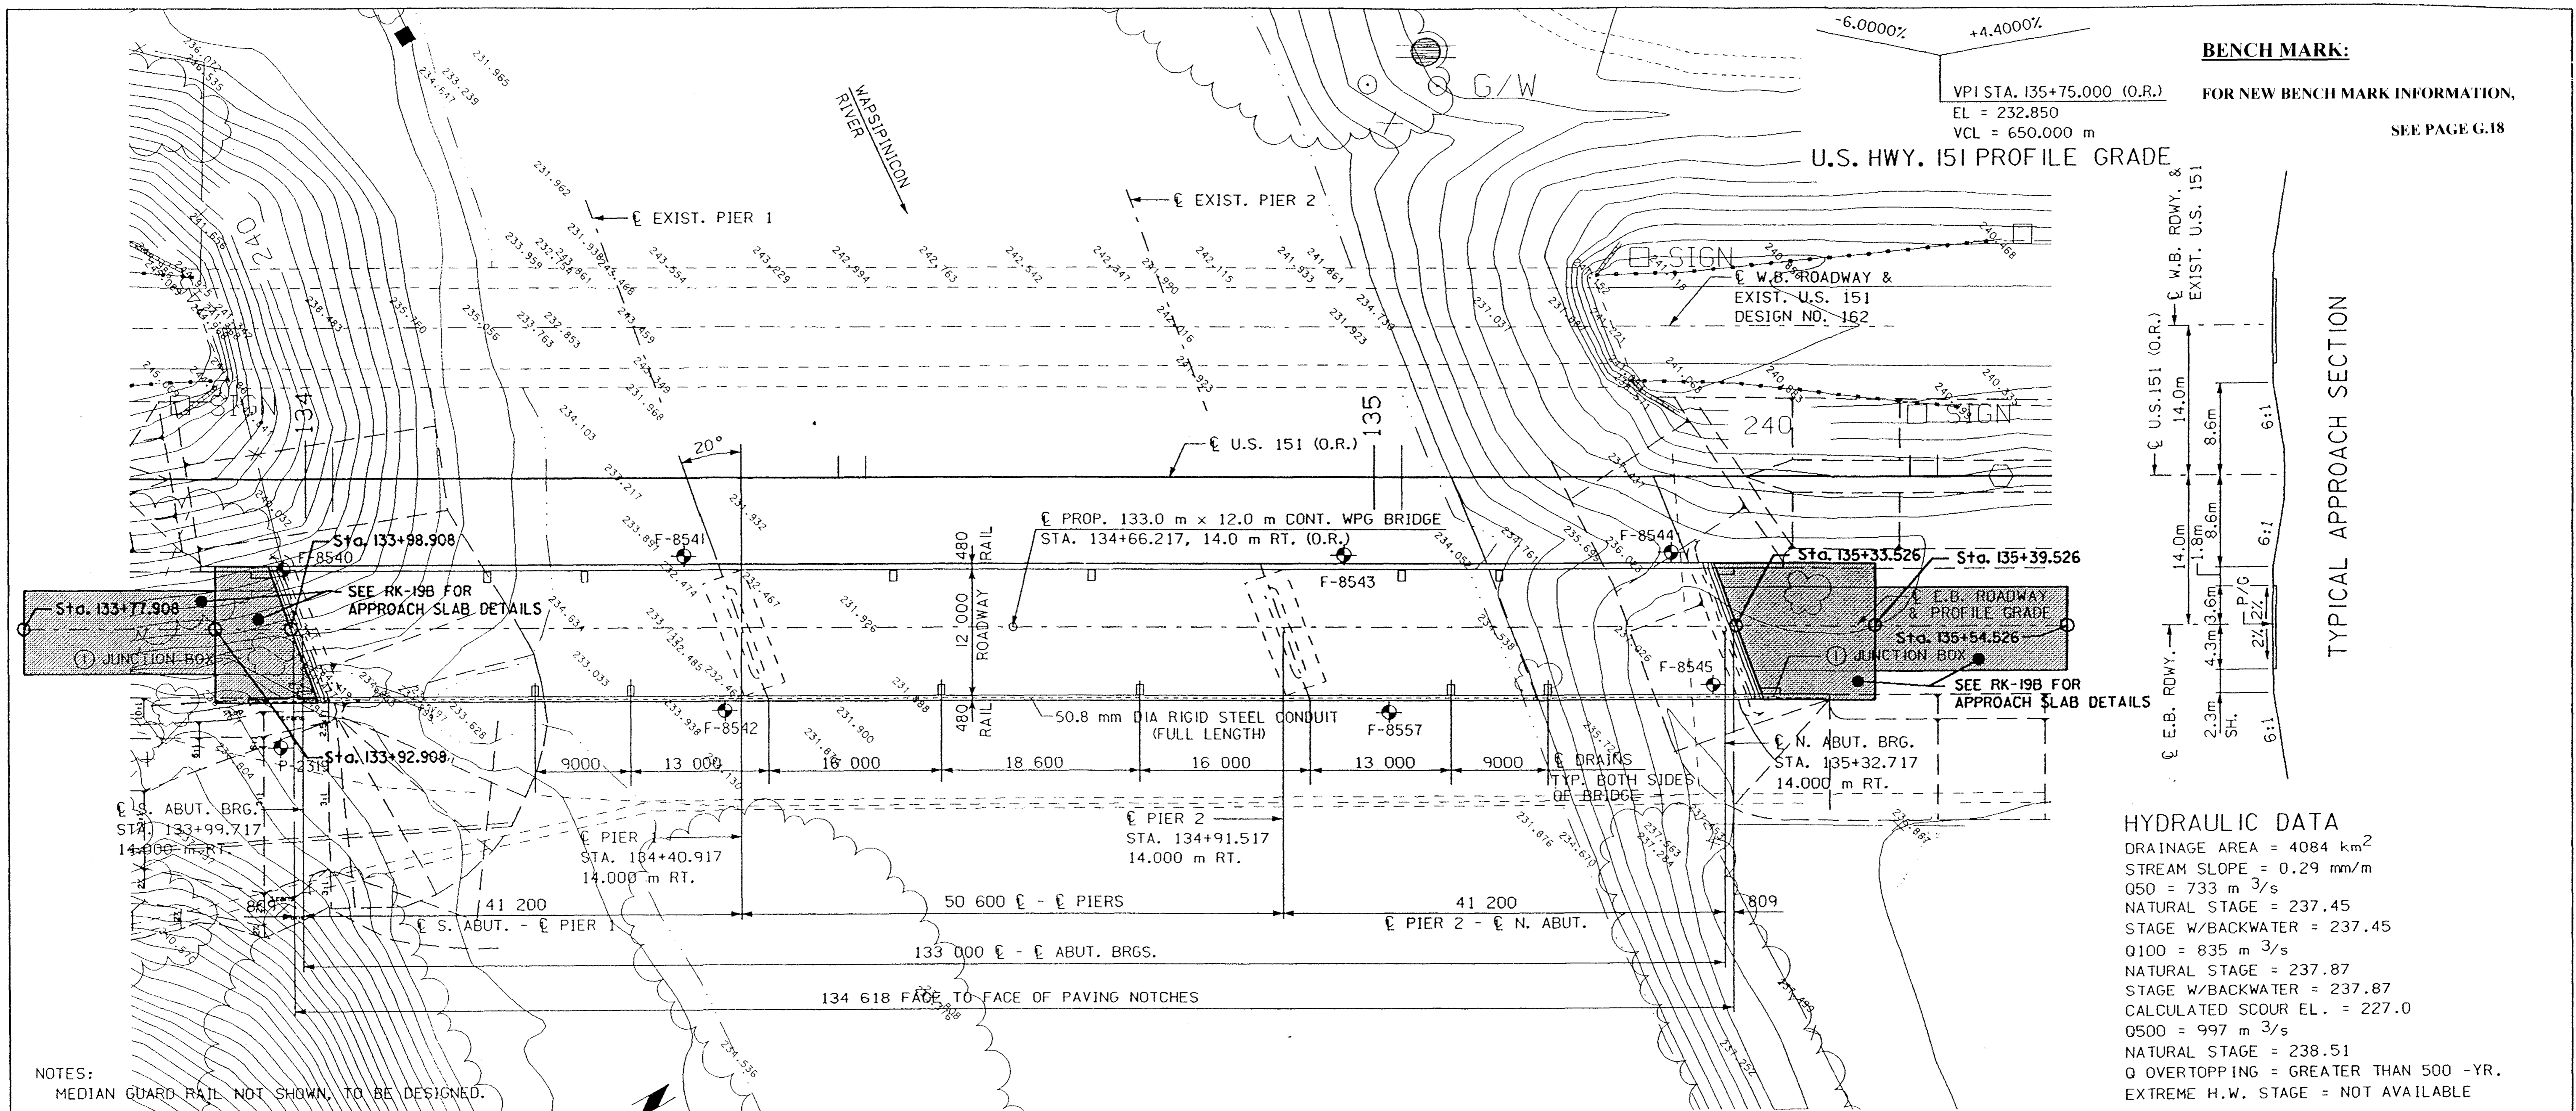

BENCH MARK:
 FOR NEW BENCH MARK INFORMATION,
 SEE PAGE G.18


HYDRAULIC DATA
 DRAINAGE AREA = 4084 km²
 STREAM SLOPE = 0.29 mm/m
 Q50 = 733 m³/s
 NATURAL STAGE = 237.45
 STAGE W/BACKWATER = 237.45
 Q100 = 835 m³/s
 NATURAL STAGE = 237.87
 STAGE W/BACKWATER = 237.87
 CALCULATED SCOUR EL. = 227.0
 Q500 = 997 m³/s
 NATURAL STAGE = 238.51
 Q OVERTOPPING = GREATER THAN 500 -YR.
 EXTREME H.W. STAGE = NOT AVAILABLE

TRAFFIC DATA
 2001 AADT 7820 VPD
 2021 AADT 9370 VPD
 2021 DHV 1006 VPH
 TRUCKS 11%

LOCATION
 U.S. 151 OVER THE
 WAPSIPINICON RIVER
 T84N - R4W
 SECTION 14
 FAIRVIEW TWP.
 JONES COUNTY

NOTES:
 MEDIAN GUARD RAIL NOT SHOWN, TO BE DESIGNED.
 ① JUNCTION BOX FOR CONDUIT. SEE LIGHTING DETAIL SHEET FOR DETAILS.

IOWA DEPARTMENT OF NATURAL RESOURCES FLOOD PLAIN DEVELOPMENT PERMIT NUMBER FP99-30
 THIS PROJECT IS COVERED BY THE CORPS OF ENGINEERS
 NATIONWIDE 404 PERMIT. ITEMS #14 AND #25

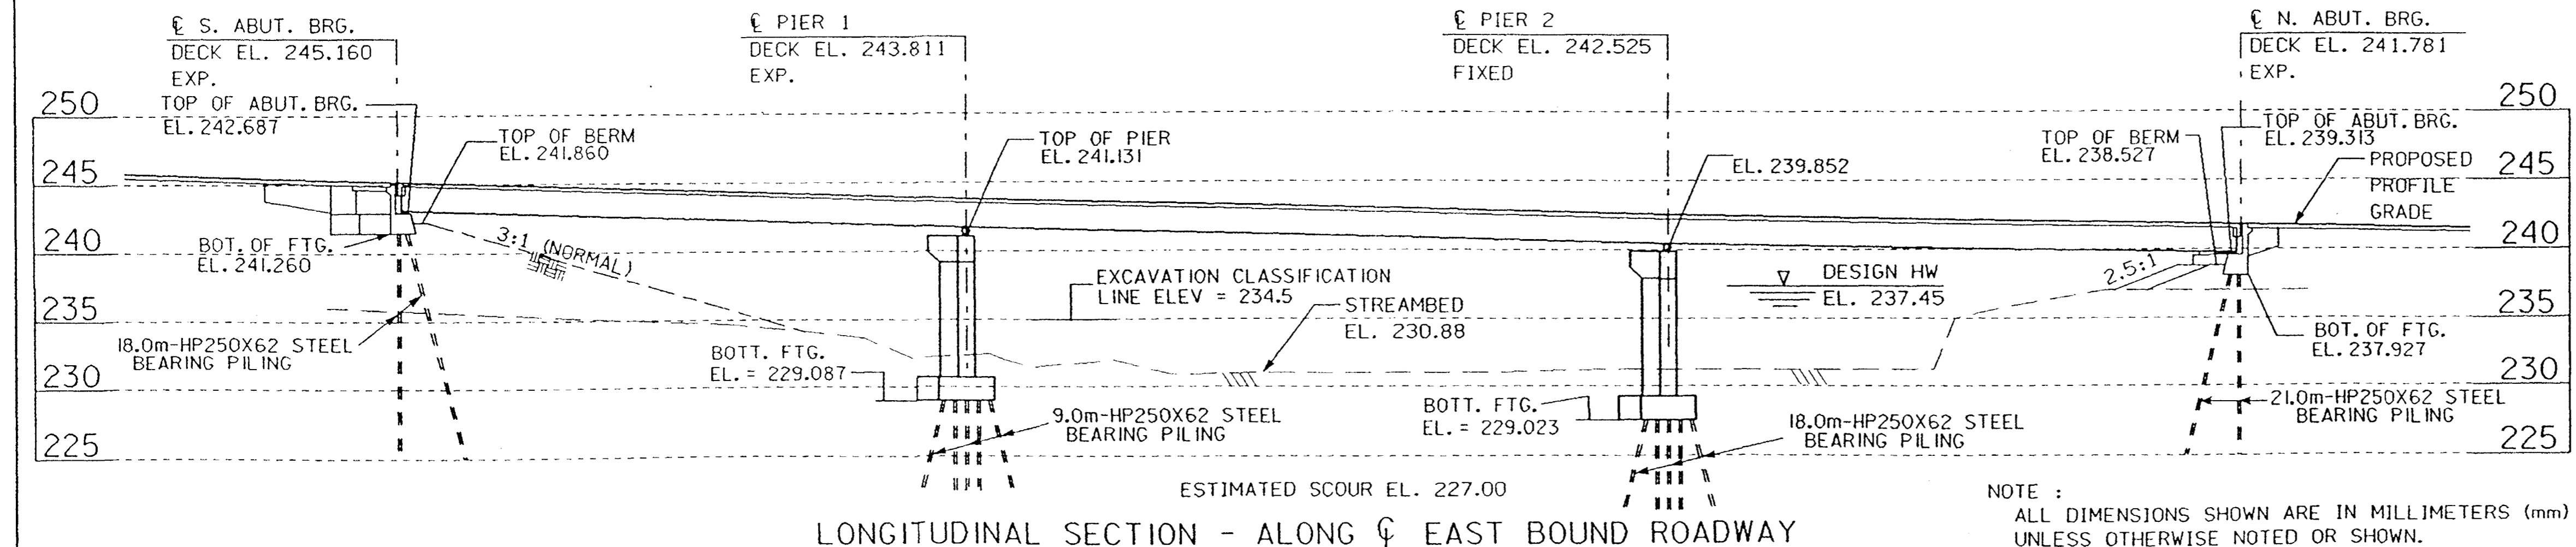

NOTE:
 ALL DIMENSIONS SHOWN ARE IN MILLIMETERS (mm)
 UNLESS OTHERWISE NOTED OR SHOWN.

DESIGN FOR 20° SKEW (R.A.)
133.0 m x 12.0 m CONTINUOUS WELDED PLATE GIRDER BRIDGE
 41.20 m END SPANS 50.60 m CENTER SPAN
SITUATION PLAN
 STA. 134+66.217, 14.000 m RT. (O.R.) U.S. HIGHWAY 151
 JONES COUNTY
 IOWA DEPARTMENT OF TRANSPORTATION - PROJECT DEVELOPMENT DIVISION
 DESIGN SHEET NO. 2 OF 27 FILE NO. 29164 DESIGN NO. 1298

LIVE PROJECT NO. NHSX-151-3(112)--3H-57
 ACCOUNTING: 02-21-23
 * SUBSTANTIAL NON-SUBSTANTIAL
 * PARTICIPATING NON-PARTICIPATING
 F.W.R. Concurrence 3-18-04

Contract Modification

Iowa Department of Transportation 5/5/2004 10:21 AM
 Field Manager 3.2a

Contract: 53-1514-085, PCC PAVEMENT - GRADE & REPLACE

Cont. Mod. Number	Revision Number	Cont. Mod. Date	Net Change	Awarded Contract Amount
33	3	5/5/2004	\$308,657.20	\$11,354,812.61

Route

HWY 151

Contract Location

ICONS COUNTY NHSX-151-4(85)-31F-53

Short Description

Curve Widening at US 151 and 130th Street

Description of Changes

The geometrics of a horizontal curve located within a use-as-constructed segment of the southbound lanes of US 151 near Anamosa at 130th Street from station 165+00 to 187+10 does not meet the 110 kph design standards. After evaluating several design alternatives from the design consultant, the Department decided to construct a widening unit on the inside of the existing curve, thereby flattening the curve to meet the requirements for a 110 kph design speed. Existing pavement that is in excess of what is needed for the widening unit would be removed and existing turn lanes would be reconstructed. Construction would be performed while maintaining traffic. In accordance with approvals on Staff Action Number 04-0719, dated March 18, 2004, the project limits will be extended to include widening of the curve at 130th Street as extra work on this contract. All signed unit and lump sum prices established for this work were considered fair and reasonable when compared to similar work on contracts in the US 151 corridor and the "Summary of Awarded Contract Unit Prices for English & Metric Items - 2003," considering the quantities and nature of the work involved.

New Items

Project: 53-1514-085, 020219 069 IJC

Category: 0002, WORK ON US 151 EAST OF ANAMOSA (FOR CONTRACT ADMINISTRATION)

Item Description	Item Code	Prop.Ln.	Item Type	Unit	Proposed Qty.	Unit Price	Dollar Value
(LUMP SUM ITEM) Mobilization	2599-999915	1457	SUPPLEMENT LS		1.000	19,500.00000	\$19,500.00

Reason: See Description of Changes

ASPH BINDER, PG 64-2R	2303-226478	1412	SUPPLEMENT MG		44.000	330.00000	\$13,200.00
-----------------------	-------------	------	---------------	--	--------	-----------	-------------

Reason: See Description of Changes

CL 10 EXCAVATION RDWY+BORROW	2102-100100	1372	SUPPLEMENT M3		2,132.000	6.50000	\$13,858.00
------------------------------	-------------	------	---------------	--	-----------	---------	-------------

Reason: See Description of Changes

CONC 1000 RDWY PIPE CULV 600 MM	2416-100600	1422	SUPPLEMENT M		4.300	180.00000	\$774.00
---------------------------------	-------------	------	--------------	--	-------	-----------	----------

Reason: See Description of Changes

New Items

Project: 53-1514-085, 020219 069 IJC

Category: 0002, WORK ON US 151 EAST OF ANAMOSA (FOR CONTRACT ADMINISTRATION)

Item Description	Item Code	Prop.Ln.	Item Type	Unit	Proposed Qty.	Unit Price	Dollar Value
EARTH SHLD CONSTRUCTION	2123-100200	1392	SUPPLEMENT M		621.000	5.00000	\$3,105.00

Reason: See Description of Changes

FABRIC REINFORCEMENT	2303-500000	1417	SUPPLEMENT M2		864.500	6.75000	\$5,820.00
----------------------	-------------	------	---------------	--	---------	---------	------------

Reason: See Description of Changes

FLAGGER	2528-107000	1462	SUPPLEMENT DAY		10.000	225.00000	\$2,250.00
---------	-------------	------	----------------	--	--------	-----------	------------

Reason: See Description of Changes

GRANULAR SHLD TYPE A	2121-100100	1477	SUPPLEMENT MG		423.000	15.00000	\$6,345.00
----------------------	-------------	------	---------------	--	---------	----------	------------

Reason: See description of Changes

GRANULAR SUBBASE	2111-100000	1382	SUPPLEMENT M2		2,601.000	9.00000	\$23,409.00
------------------	-------------	------	---------------	--	-----------	---------	-------------

Reason: See Description of Changes

HMA (3M ESAL) SURF, 12.5 MM, FRIC L3	2303-043123	1472	SUPPLEMENT MG		734.000	53.00000	\$38,902.00
--------------------------------------	-------------	------	---------------	--	---------	----------	-------------

Reason: See description of Changes

LONGITUDINAL SUBDRAIN (SHLD) 100 MM	2502-290100	1422	SUPPLEMENT M		400.000	18.75000	\$7,500.00
-------------------------------------	-------------	------	--------------	--	---------	----------	------------

Reason: See Description of Changes

PAINTED PAVT MARK WATERBORNE/SOLVENT	2527-101001	1447	SUPPLEMENT M		863.000	2.50000	\$2,157.50
--------------------------------------	-------------	------	--------------	--	---------	---------	------------

Reason: See Description of Changes

PAVT MARK RMVD	2527-108000	1452	SUPPLEMENT M		100.000	3.50000	\$350.00
----------------	-------------	------	--------------	--	---------	---------	----------

Reason: See Description of Changes

Contract: 53-1514-085

Cont. Mod.: 33, Rev. 3

Page 2 of 4

LISTING OF PROJECT REVISIONS

111-23

09-27-94

DATE	SHEET NO.	DESCRIPTION OF REVISIONS
04-03-01	A.03	Add Sheet for Listing of Project Revisions, 111-23.
	L.02	Revise Pavement Joint Layouts.
	L.04	
	L.06	
	L.08	
	L.11	
	L.13	
	L.15	
	L.17	
	L.19	
	L.21	
	L.23	
	L.26	
	L.28	
	L.31	
04-08-02	A.03	Revise 111-23 for 04-08-02 plan revision.
	B.03	Modify Typical X-29, revise Station Limits.
	B.06	Revise Station Limits, Typical 7/110.
	C.05	Add Subgrade Treatment #6, #7 to Tab. 103-3.
	C.13	Revise Station Limit and quantities, Sta. 173+20, Tab. 110-1.
	C.15	Revise Station Limits and quantities, Tab. X-50.
	C.20	Add Station Limits and quantities for Curve Reconstruction at 130th Street.
	D.23	Revise notes, add Curve Reconstruction centerline.
	D.24	Revise notes, add Curve Reconstruction centerline.
	E.08	Revise notes, add Curve Reconstruction centerline.
	G.05	Add Curve Reconstruction Centerline.
	G.06	Add Curve Reconstruction Centerline.
	L.27	Remove callouts at NW quadrant, add reference to L.32 - L.35.
	L.28	Remove joints at NW quadrant, add reference to L.32 - L.35.
	L.29	Revise edge profile, SB U.S. 151 to WB 130th St.
	L.32	Add sheet showing new intersection design.
	L.33	Add sheet showing new pavement jointing layout.
	L.34	Add sheet showing new intersection design.
	L.35	Add sheet showing new pavement jointing layout.
04-08-04	A.03	Revise 111-23 for 04-08-04 plan revision.
	B.03	Modify Typical X-29 for highside shoulder and backslopes
	B.06	Revise Station Limits and quantities, Typical 7/110.
	C.05	Add Culvert at Sta. 173+76.5 to Tab. 104-3.
	C.13	Revise Subgrade Treatment #6, #7, Tab. 103-3
	C.15	Revise Station Limit and quantities, Sta. 173+20, Tab. 110-1.
	C.20	Add Removal, Sta. 173+00 to 174+50, to Tab. 110-1
	D.23	Revise Station Limits and quantities at Sta. 173+20, Tab. X-50.
	D.24	No Change, Included for Contractor Information
	E.08	No Change, Included for Contractor Information
	G.05	No Change, Included for Contractor Information
	G.06	No Change, Included for Contractor Information
	L.27	Revise Intersection Paving Requirements Notes and Quantities, Tab. 101-2
	L.28	No Change, Included for Contractor Information
	L.29	Revise edge profile, SB U.S. 151 to WB 130th St.
	L.32	Revise Return Geometry for NW Quadrant U.S. 151 and 130th St.
	L.33	Revise Circular Curve 0.13, Tab. 101-10c
	L.34	No Change, Included for Contractor Information
	L.35	No Change, Included for Contractor Information
	XSC.01 - XSC.05	Revised Cross Sections, Sta. 9173+50 to 9176+50

HORIZONTAL CURVE RECONSTRUCTION - US 151

SB LANE ANAMOSA @ 130th STREET

FINAL PROJECT QUANTITIES SEE CONTRACT NO. 53-1514-085

Contract Modification

Iowa Department of Transportation 5/5/2004 10:21 AM
 Field Manager 3.2a

New Items

Project: 53-1514-085, 020219 069 IJC

Category: 0002, WORK ON US 151 EAST OF ANAMOSA (FOR CONTRACT ADMINISTRATION)

Item Description	Item Code	Prop.Ln.	Item Type	Unit	Proposed Qty.	Unit Price	Dollar Value
PAVT SCARIFICATION	2014-101200	1387	SUPPLEMENT M2		2,075.000	6.50000	\$13,487.50

Reason: See Description of Changes

RMV REINSTALL CONC APRON 4" TO 2416-261000	1427	SUPPLEMENT FACH		1.000	500.00000		\$500.00
--	------	-----------------	--	-------	-----------	--	----------

Reason: See Description of Changes

RMV OF PAVT	2510-001000	1442	SUPPLEMENT M2		634.000	35.20000	\$22,316.80
-------------	-------------	------	---------------	--	---------	----------	-------------

Reason: See Description of Changes

SPECIAL BACKFILL MAT1	2102-230100	1377	SUPPLEMENT MG		1,756.000	14.00000	\$24,584.00
-----------------------	-------------	------	---------------	--	-----------	----------	-------------

Reason: See Description of Changes

STDG-F PCC PAVT QM-C CL 31 260 MM	2301-104260	1482	SUPPLEMENT M2		2,136.000	49.90000	\$106,580.40
-----------------------------------	-------------	------	---------------	--	-----------	----------	--------------

Reason: See description


SUBDRAIN OUTLET RF-10F	2502-300195	1437	SUPPLEMENT FACH		4.000	150.00000	\$600.00
------------------------	-------------	------	-----------------	--	-------	-----------	----------

Reason: See Description of Changes

TRAFFIC CONTROL	2528-101000	1457	SUPPLEMENT LS		1.000	9,000.00000	\$9,000.00
-----------------	-------------	------	---------------	--	-------	-------------	------------

Reason: See Description of Changes

Subtotal for Category 0002: \$308,657.20
 Subtotal for Project 53-1514-085: \$308,657.20

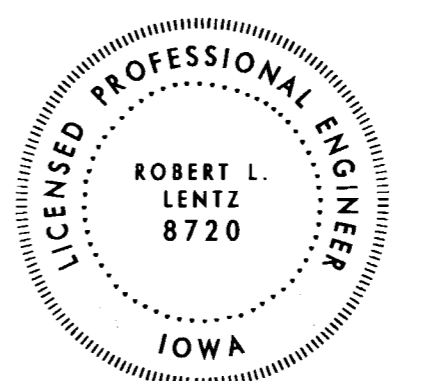


I hereby certify that this plan was prepared under my supervision and that engineering decisions with regard to the design were made by me or by other duly licensed Professional Engineers under the laws of the State of Iowa.

Signature: Robert L. Lentz Date: 16 Apr 04
 Printed or Typed Name: Robert L. Lentz
 My license renewal date is December 31, 2005.

Pages or sheets covered by this seal:
 04/03/01 Revision: A.03, L.02, L.04, L.06, L.08, L.11, L.13, L.15, L.17, L.19, L.21, L.23, L.26, L.28, L.31
 04/08/02 Revision: A.03, B.03, B.06, C.05, C.13, C.15, C.20, D.23, D.24, E.08, G.05, G.06, L.27, L.28, L.29, L.32, L.33, L.34, L.35
 04/08/04 Revision: A.03, B.03, B.06, C.05, C.13, C.15, C.20, C.23, D.24, E.08, G.05, G.06, L.27, L.28, L.29, L.32, L.33, L.34, L.35, XSC.01-XSC.05

004 Charges 167151112.ec3
 09-27-94
 doc file = I:\p\at\lab\esara f.x.t.d
 prf = XUSWAISOINDA IANPL D\NPL85/BWA03.prf
 date = Fri Apr 16 13:22:46 2004

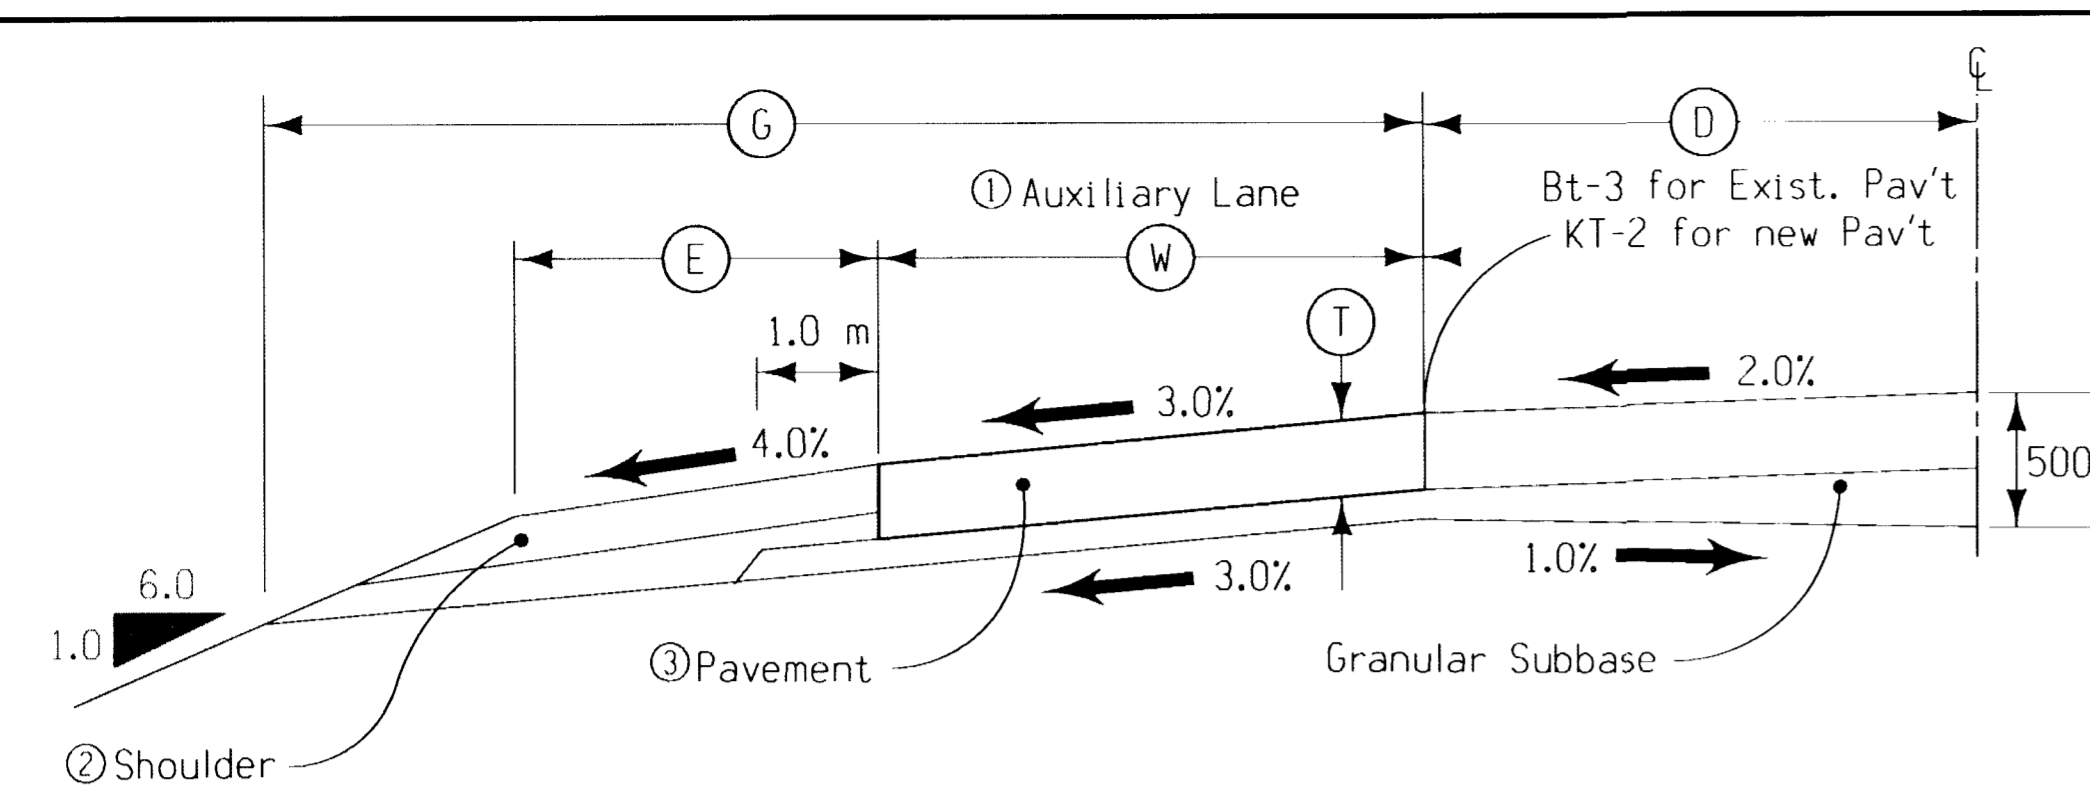

LOCATION		SIDE	D m	E m	W m	G m	T mm
ROAD IDENTIFICATION	STATION TO STATION						
Main line	18+40.00 18+90.00	WBL	3.6	1.8	3.6	8.8	260
Main line	35+46.00 35+96.00	WBL	3.6	1.8	3.6	8.8	260
Main line	38+73.00 39+23.00	EBL	3.6	1.8	3.6	8.8	260
Main line	51+30.03 51+80.00	EBL	3.6	1.8	3.6	8.8	260
Main line	52+34.00 52+84.00	WBL	3.6	1.8	3.6	8.8	260
Main line	64+08.70 64+58.70	EBL	3.6	1.8	3.6	8.8	260
Main line	86+27.00 86+77.00	EBL	3.6	1.8	3.6	8.8	260
Main line	87+21.00 87+71.00	WBL	3.6	1.8	3.6	8.8	260
Main line	94+49.50 94+99.50	EBL	3.6	1.8	3.6	8.8	260
Main line	104+37.00 104+87.00	EBL	3.6	1.8	3.6	8.8	260
Main line	105+43.00 105+96.22	WBL	3.6	1.8	3.6	8.8	260
Main line	113+34.50 113+84.50	EBL	3.6	1.8	3.6	8.8	260
Main line	117+63.01 117+13.00	EBL	3.6	1.8	3.6	8.8	260
Main line	117+60.00 118+10.00	WBL	3.6	1.8	3.6	8.8	260
Main line	131+58.43 132+08.97	WBL	3.6	1.8	3.6	8.8	260
Main line	136+89.00 137+39.00	EBL	3.6	1.8	3.6	8.8	260
Main line	137+88.00 138+38.00	WBL	3.6	1.8	3.6	8.8	260
Main line	172+42.95 172+92.73	EBL	3.6	1.8	3.6	8.8	260
Main line	173+43.08 173+93.00	WBL	3.6	1.8	3.6	8.8	*
Main line	180+00.50 180+50.50	EBL	3.6	1.8	3.6	8.8	260

Notes:

- Details shall be similar for construction on either side (by stationing) of roadway.
- Refer to other drawings for details of shoulder design and construction.
- Pavement for auxiliary lane shall be constructed according to requirements specified for through roadway pavement.

Normal section shown may be modified appropriately in areas of super-elevated curves or other locations specifically designated by the engineer.


See Typical Cross Section for details of ditches and backslopes.

Refer to Intersection Details (L sheets) for additional information.


Section view is in direction of traffic.

GRADING AND PAVING
TYPICAL HALF SECTION
PROPOSED LEFT TURN LANE

* 260mm PCC with 75mm HMA overlay on turn lane and adjacent mainline paving.

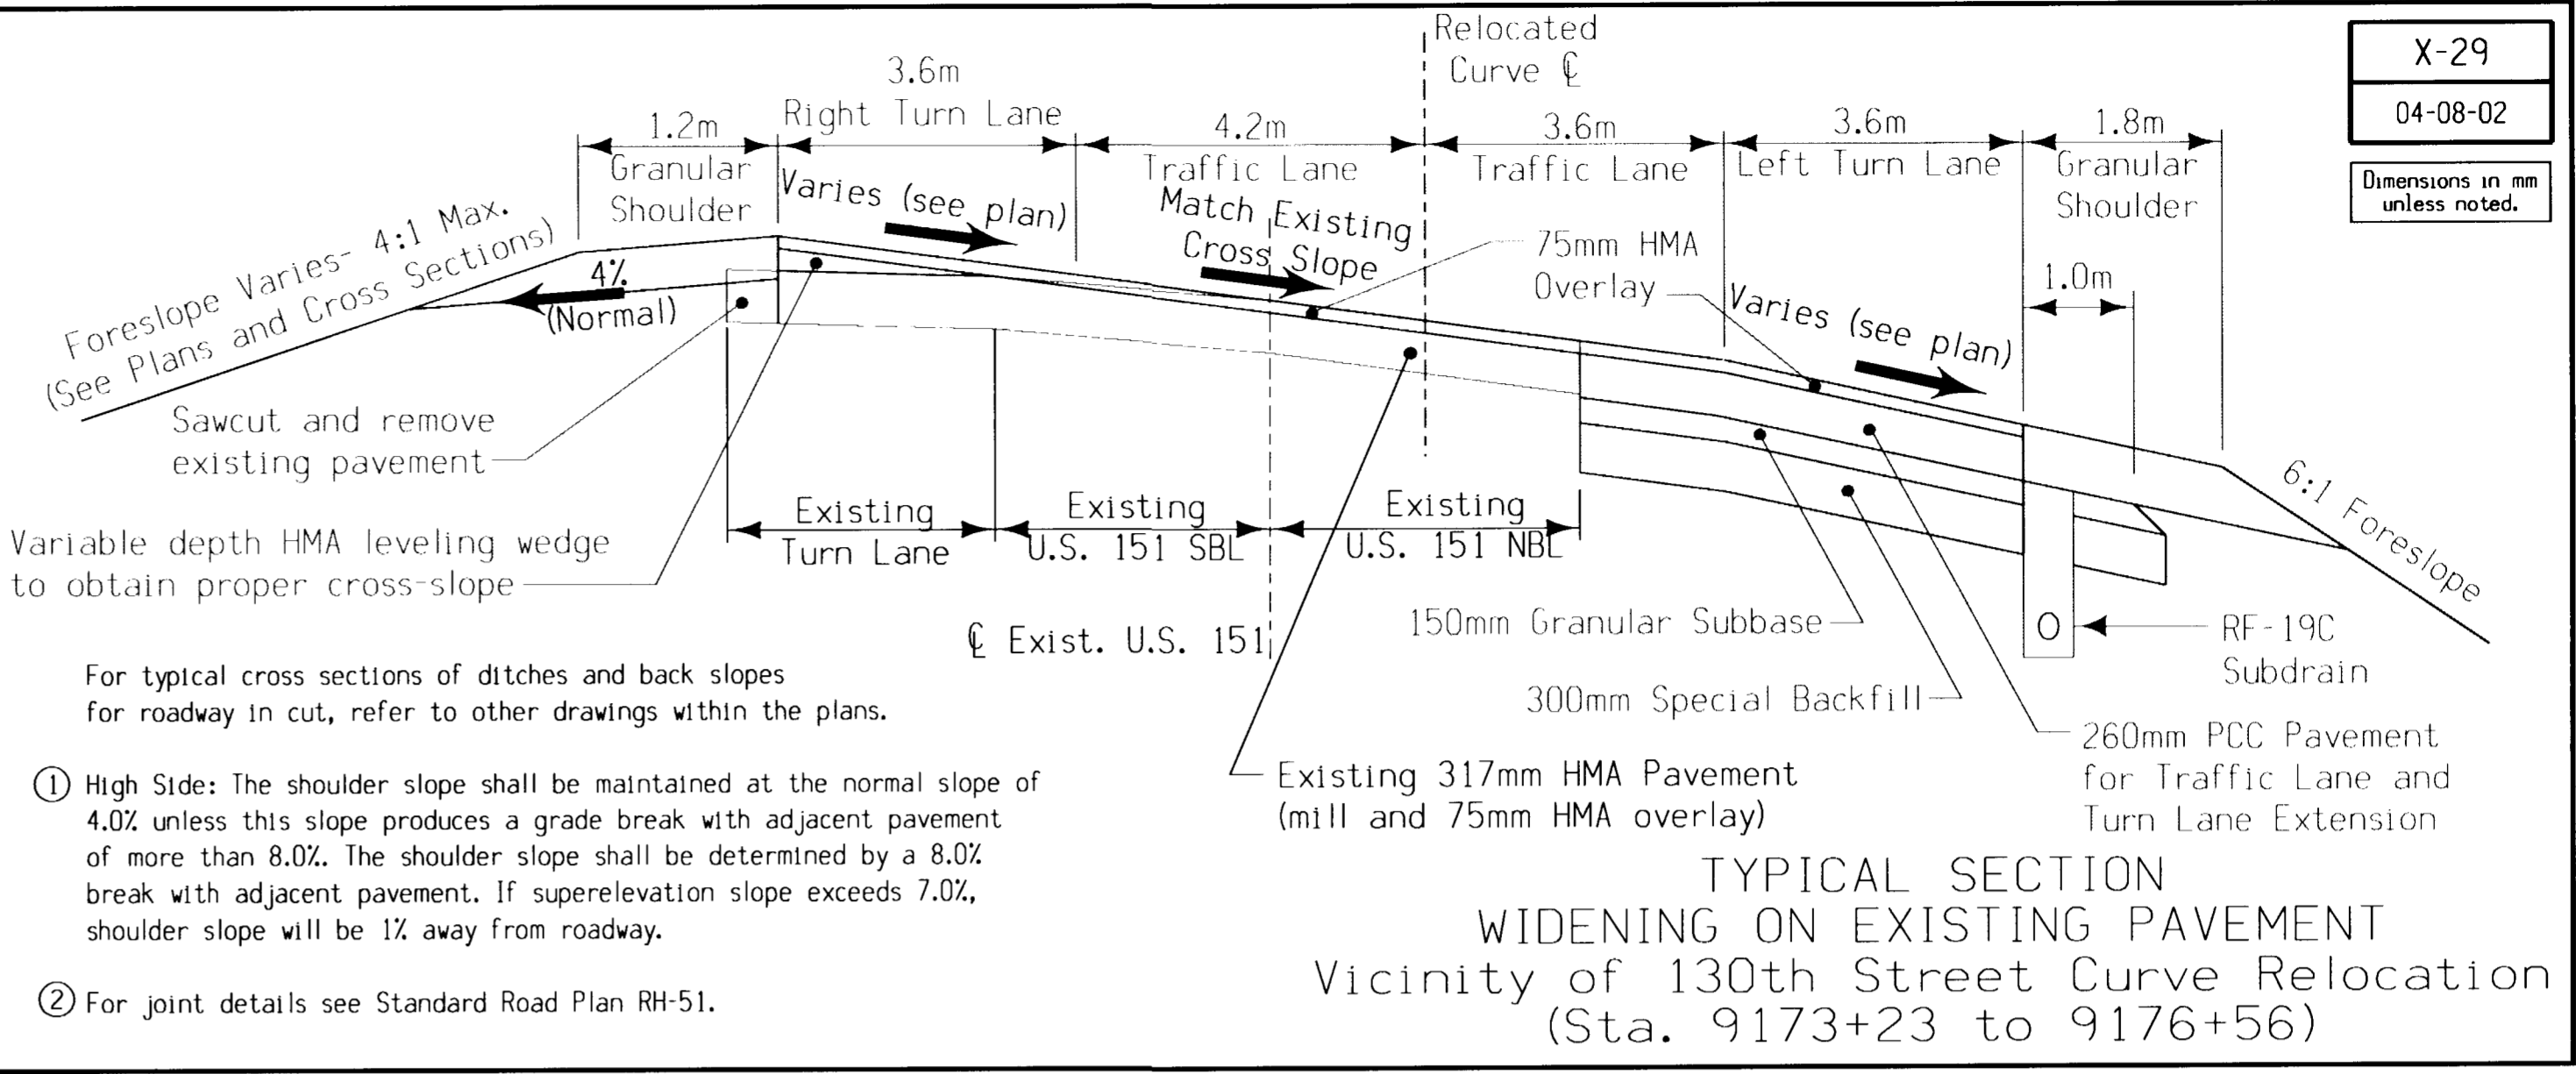

TYPICAL SECTION
WIDENING ON EXISTING PAVEMENT
Vicinity of 130th Street Curve Relocation
(Sta. 9173+23 to 9176+56)

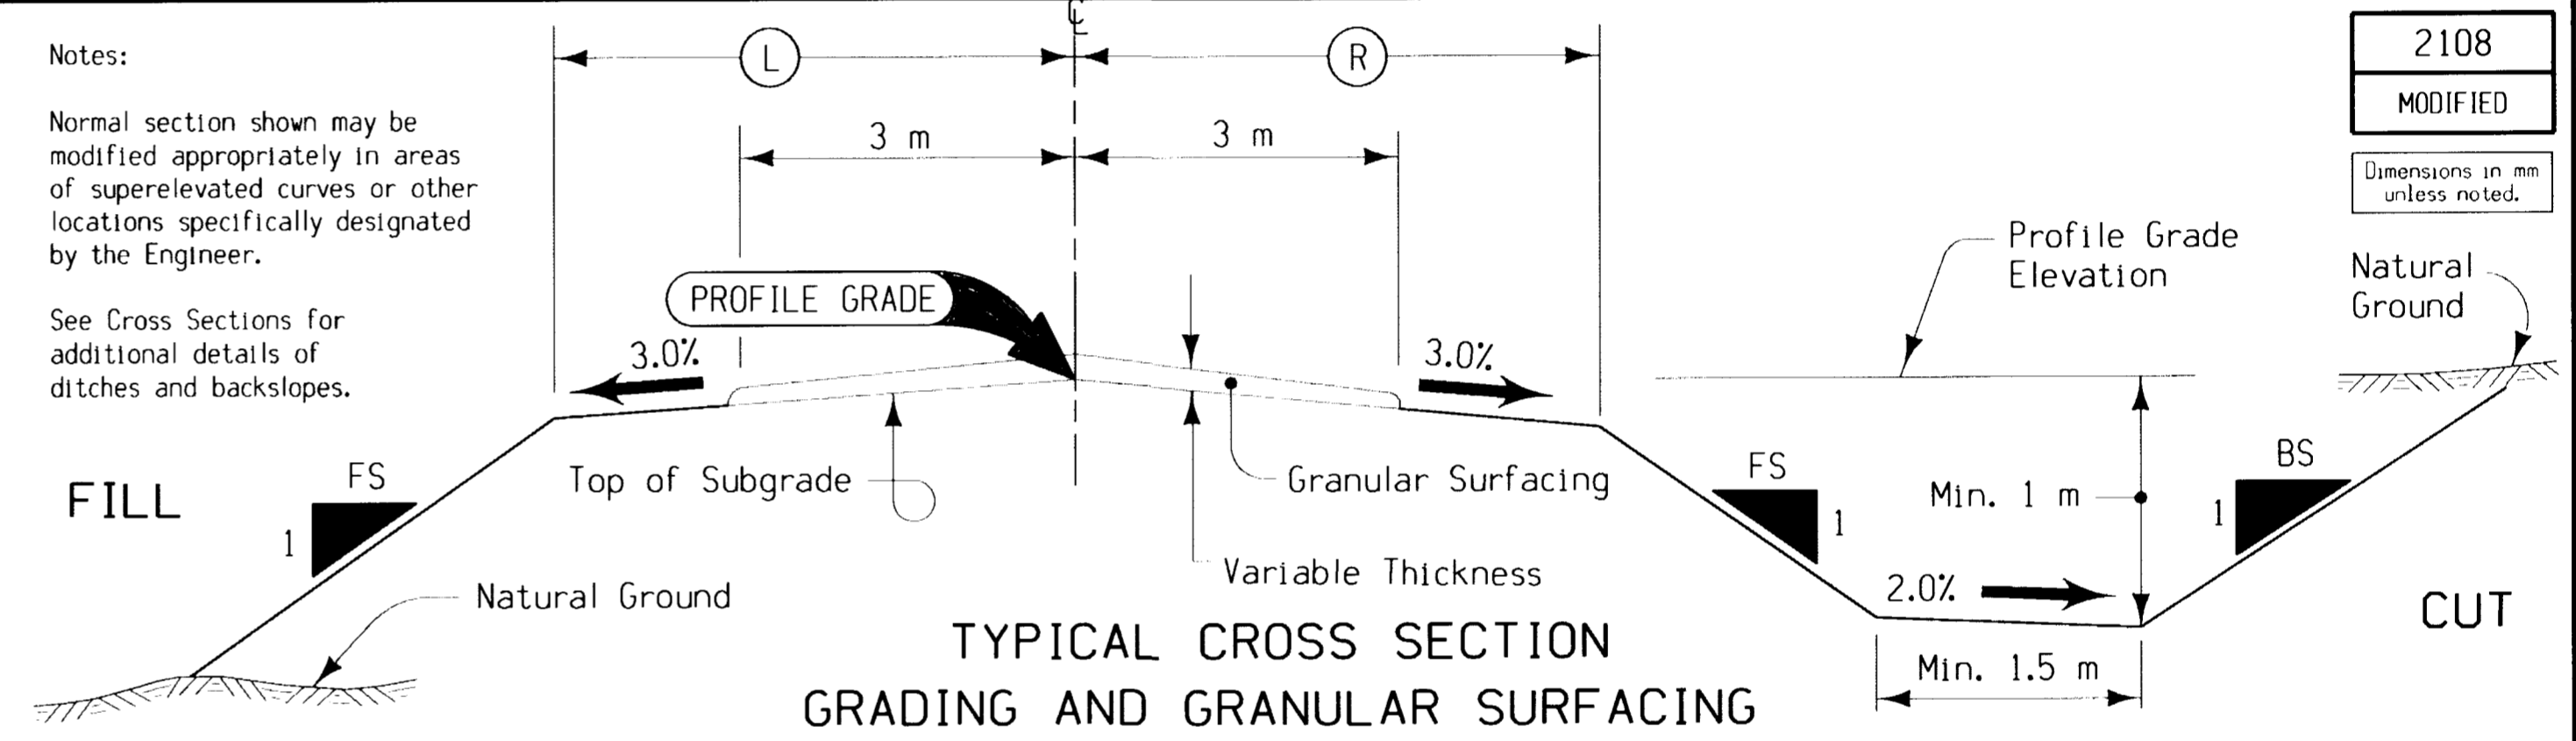

LOCATION		DIMENSIONS		SLOPES	
ROAD IDENTIFICATION	STATION TO STATION	L	R	FS	BS
Side Road		4.2	4.2	3.0	2.5

Notes:

Subbase may be constructed to a width greater than that indicated.


Any such extra width of subbase shall be considered incidental to other work and not be measured for payment.

Section view is in direction of traffic.

Normal section shown may be appropriately modified for areas specifically designated by the Engineer, such as intersections or super-elevated curves.


- Refer to other drawing for details of shoulder design and construction.
- Refer to Standard Road Plan RF-19C for details of subdrain installation.

LOCATION		DIMENSIONS				SHOULDER TYPE		
INTERCHANGE	RAMP	T mm	C m	E m	J m			
(L) Iowa Highway 1	B	2076+75.252	2079+40.00	260	5.5	1.2	1.8	Paved
(R) Iowa Highway 1	C	3075+30.00	3080+10.36	260	4.8	1.2	1.8	Paved
(R) Iowa Highway 64	B	6153+10.00	6157+20.00	260	4.8	1.2	1.8	Paved
(L) Iowa Highway 64	C	7154+94.349	7156+55.32	260	5.5	1.2	1.8	Paved

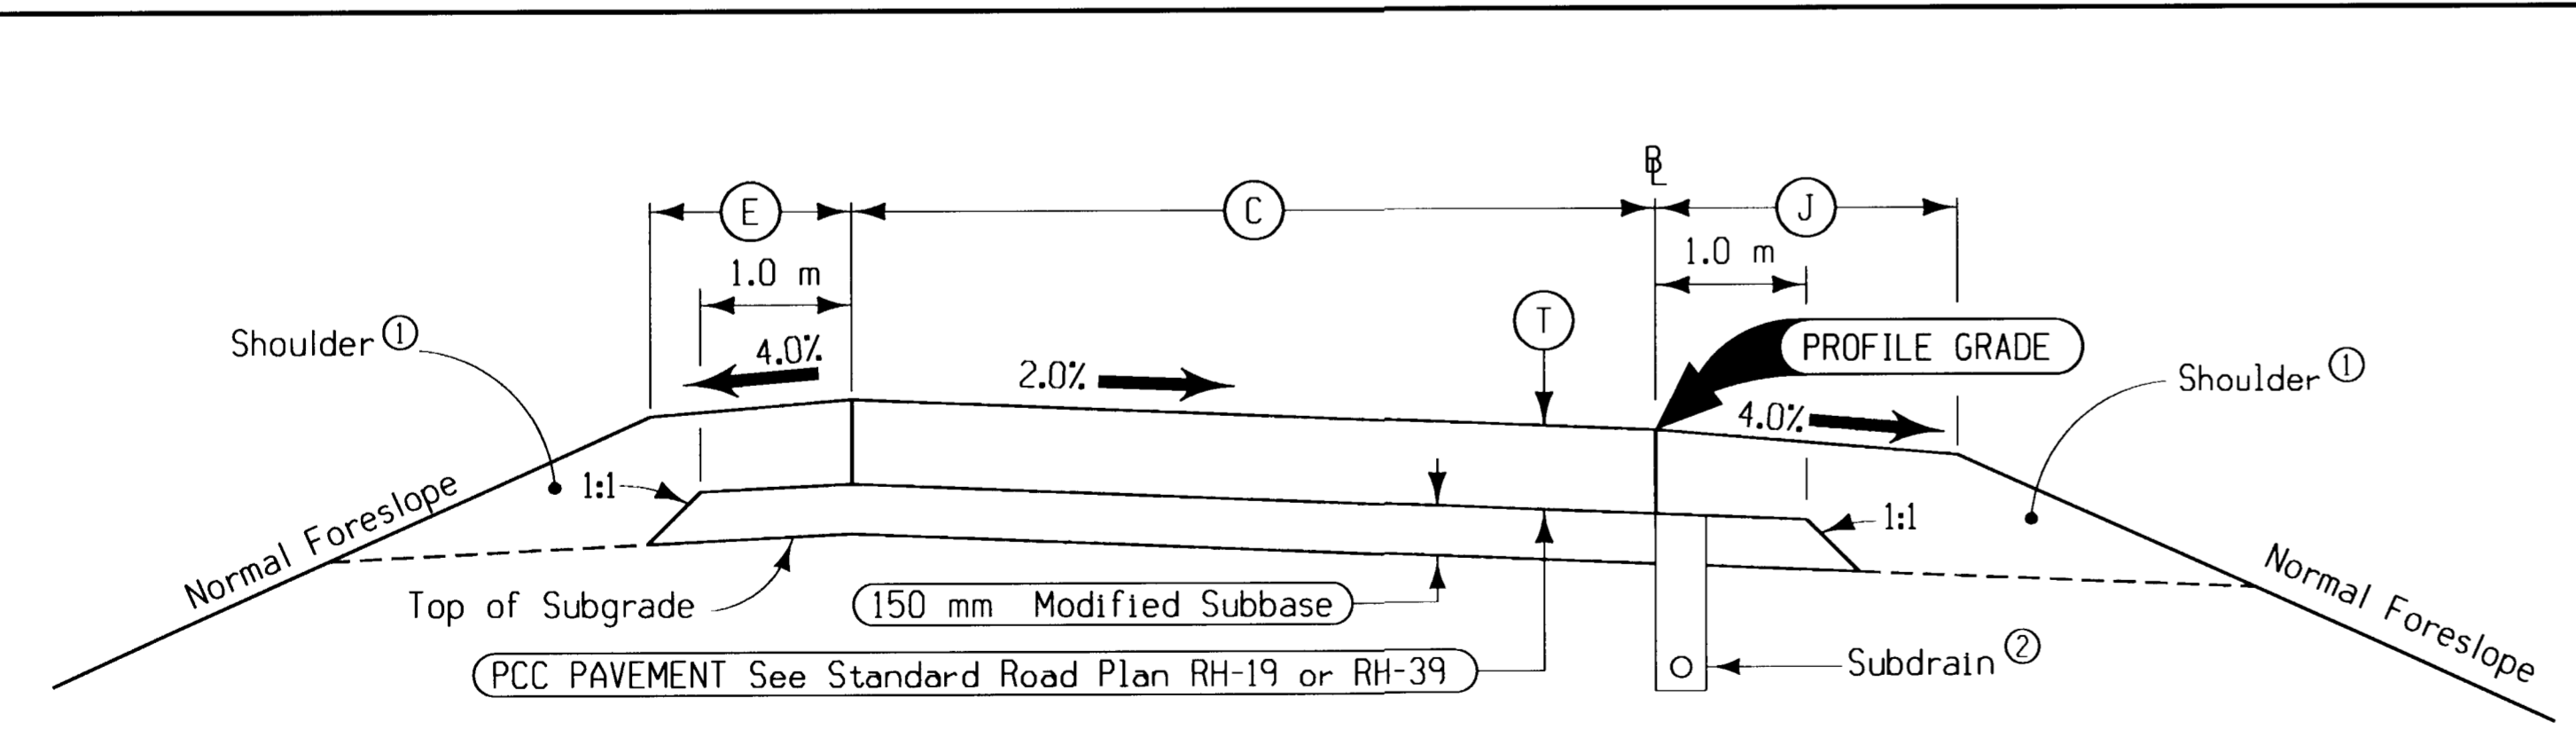

TYPICAL CROSS SECTION
PCC RAMP PAVING

sgr = I:\WORK\proj\2004 Changes\571511\216C1\levels\1463\plan\tablestra.fvw.tb
 date = Wed Apr 14 15:59:04 2004

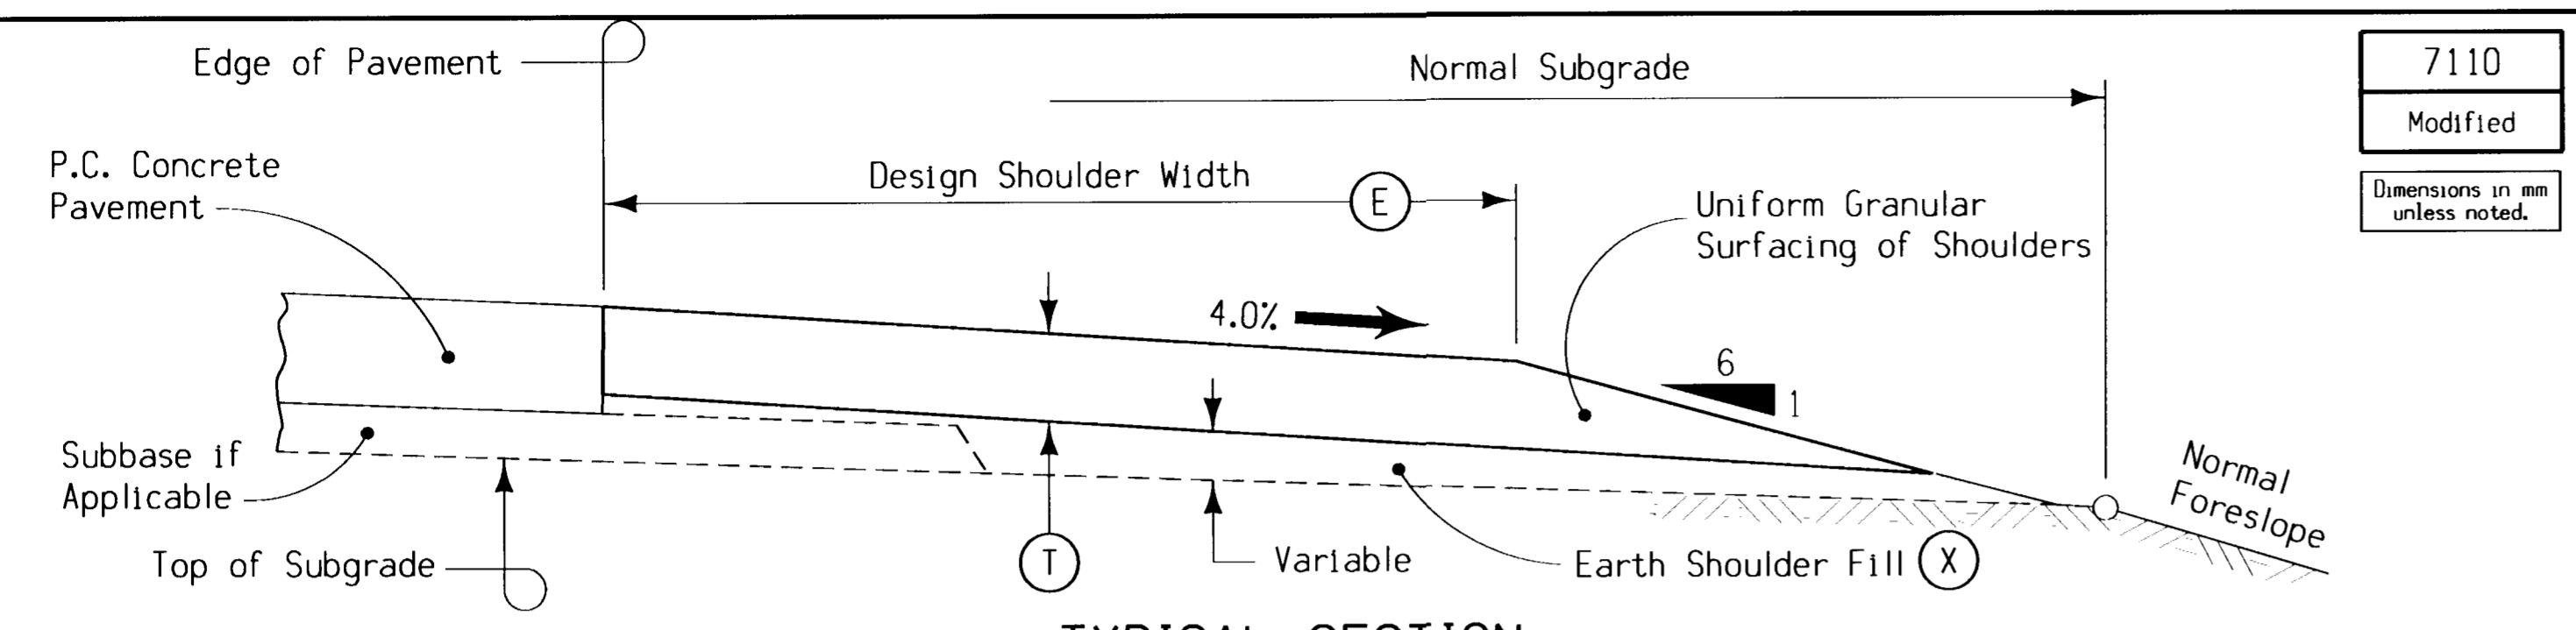


7110
Modified
Dimensions in mm unless noted.

TYPICAL SECTION
TYPE 'A' OR 'B' GRANULAR SHOULDER
Adjacent to PCC Pavement

Note:
Earth Shoulder fill requires approximately (X) cubic meters of excavation, including 40% for shrinkage, per station.
See Standard Road Plan RH-37D for construction requirements.

ROAD IDENTIFICATION	LOCATION		E m	T mm	SIDE	X m ³	
	STATION TO STATION						
Mainline Westbound	15+40	64+50	2.4	150	Lt.	125.3	
	15+40	65+75	1.8	150	Rt.	92.5	
	72+00	82+00	2.4	150	Lt.	125.3	
	72+00	84+00	1.8	150	Rt.	92.5	
	83+10	84+00	1.8	150	Lt.	92.5	
	154+50	164+00	1.8	150	Rt.	92.5	
	154+50	162+10	2.4	150	Lt.	125.3	
	163+10	164+00	1.8	150	Lt.	92.5	
	(Relocated Curve)	9173+50	9175+43	1.2	150	Rt.	68.3
	(Relocated Curve)	9175+43	9176+56	2.4	150	Rt.	125.3
	(Relocated Curve)	9173+40	9176+56	1.8	150	Lt.	92.5
	Mainline Eastbound	21+00	24+00	2.4	150	Rt.	125.3
		21+00	24+00	1.8	150	Lt.	92.5
		67+95	74+30	2.4	150	Rt.	125.3
74+30		75+78	1.8	150	Rt.	92.5	
76+85		80+10	2.4	150	Rt.	125.3	
80+90		83+50	1.8	150	Rt.	92.5	
83+50		151+07	2.4	150	Rt.	125.3	
151+07		153+10	1.8	150	Rt.	92.5	
152+95		156+55	2.4	150	Rt.	125.3	
158+30		161+50	1.8	150	Rt.	92.5	
161+50		187+10	2.4	150	Rt.	125.3	
67+95		187+10	1.8	150	Lt.	92.5	
X-28		1452+50	1455+00	2.4	150	Lt.	37.9
		1452+50	1455+00	2.4	150	Rt.	37.9
X-40	2131+46	2132+25	2.4	150	Lt.	37.9	
	2131+46	2132+25	2.4	150	Rt.	37.9	
130th Street	1173+35	1174+75	1.8	150	Lt.	34.7	
	1173+35	1174+75	1.8	150	Rt.	34.7	
X-Over @ Sta. 4+50	700+37	702+78	1.2	150	Rt.	0.0	
	701+95	704+16	1.2	150	Lt.	0.0	

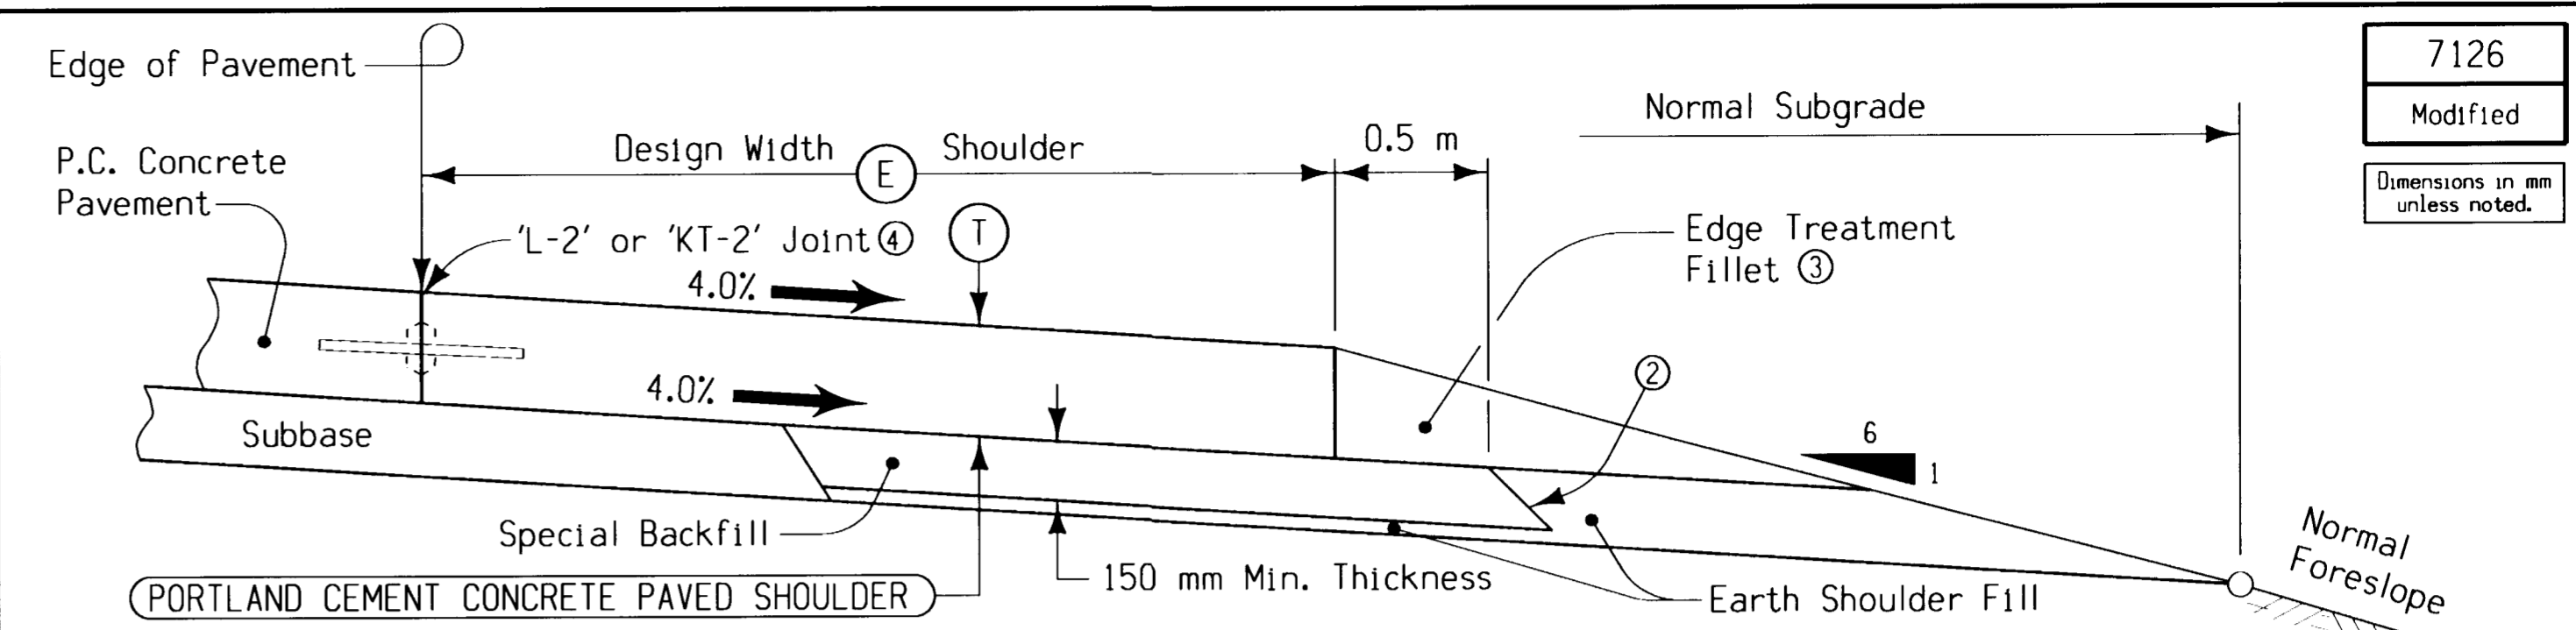


7126
Modified
Dimensions in mm unless noted.

TYPICAL SECTION
Full Depth PCC Paved Shoulder

- Per station per side. See Standard Road Plan RH-41B for basis of estimate.
- Approximately 1:1 Slope
- Refer to appropriate detail drawings.
- When (1) is less than 200 mm use 'BT-1' Joint. When (1) is equal to or more than 200 mm use 'L-2', 'KT-2' or modified 'BT-3'. Modified 'BT-3' requires a keyway. See Standard Road Plan RH-51 for joint details.
- Bid Items
- See Tab. 112-9
- Earth Shoulder fill requires approximately (X) cubic meters of excavation, including 40% for shrinkage, per station.
- Included with special backfill under ramps and tapers. See tab. X-50 on Sheet C.15 for details.
- Max breakover is 7%. When superelevation exceeds 7%, paved shoulders high side will have a 1% slope on to Ramp or Loop.

ROAD IDENTIFICATION	LOCATION		SIDE	DIMENSIONS		QUANTITIES (1)		
	STATION TO STATION			T mm	E m	SURFACE AREA m ² (2)	VOLUME m ³ (7)	SPECIAL BACKFILL Mg (8)
IA-1 Loop B	2076+60	2079+39	LT	260	1.2	(6)	21.4	(8)
	2076+60	2079+39	RT	260	1.8	(6)	21.4	(8)
IA-1 Ramp C	3075+08	3080+90	RT	260	1.8	(6)	21.4	(8)
	3075+00	3076+00	LT	260	1.8	(6)	21.4	(8)
IA-64 Ramp C	3076+00	3080+10	LT	260	1.2	(6)	21.4	(8)
	6153+10	6157+20	RT	260	1.8	(6)	21.4	(8)
	6153+00	6156+62	LT	260	1.2	(6)	21.4	(8)
	6156+62	6157+20	LT	260	1.8	(6)	21.4	(8)
IA-64 Loop C	7154+94	7157+50	RT	260	1.8	(6)	21.4	(8)
	7154+94	7156+55	LT	260	1.2	(6)	21.4	(8)

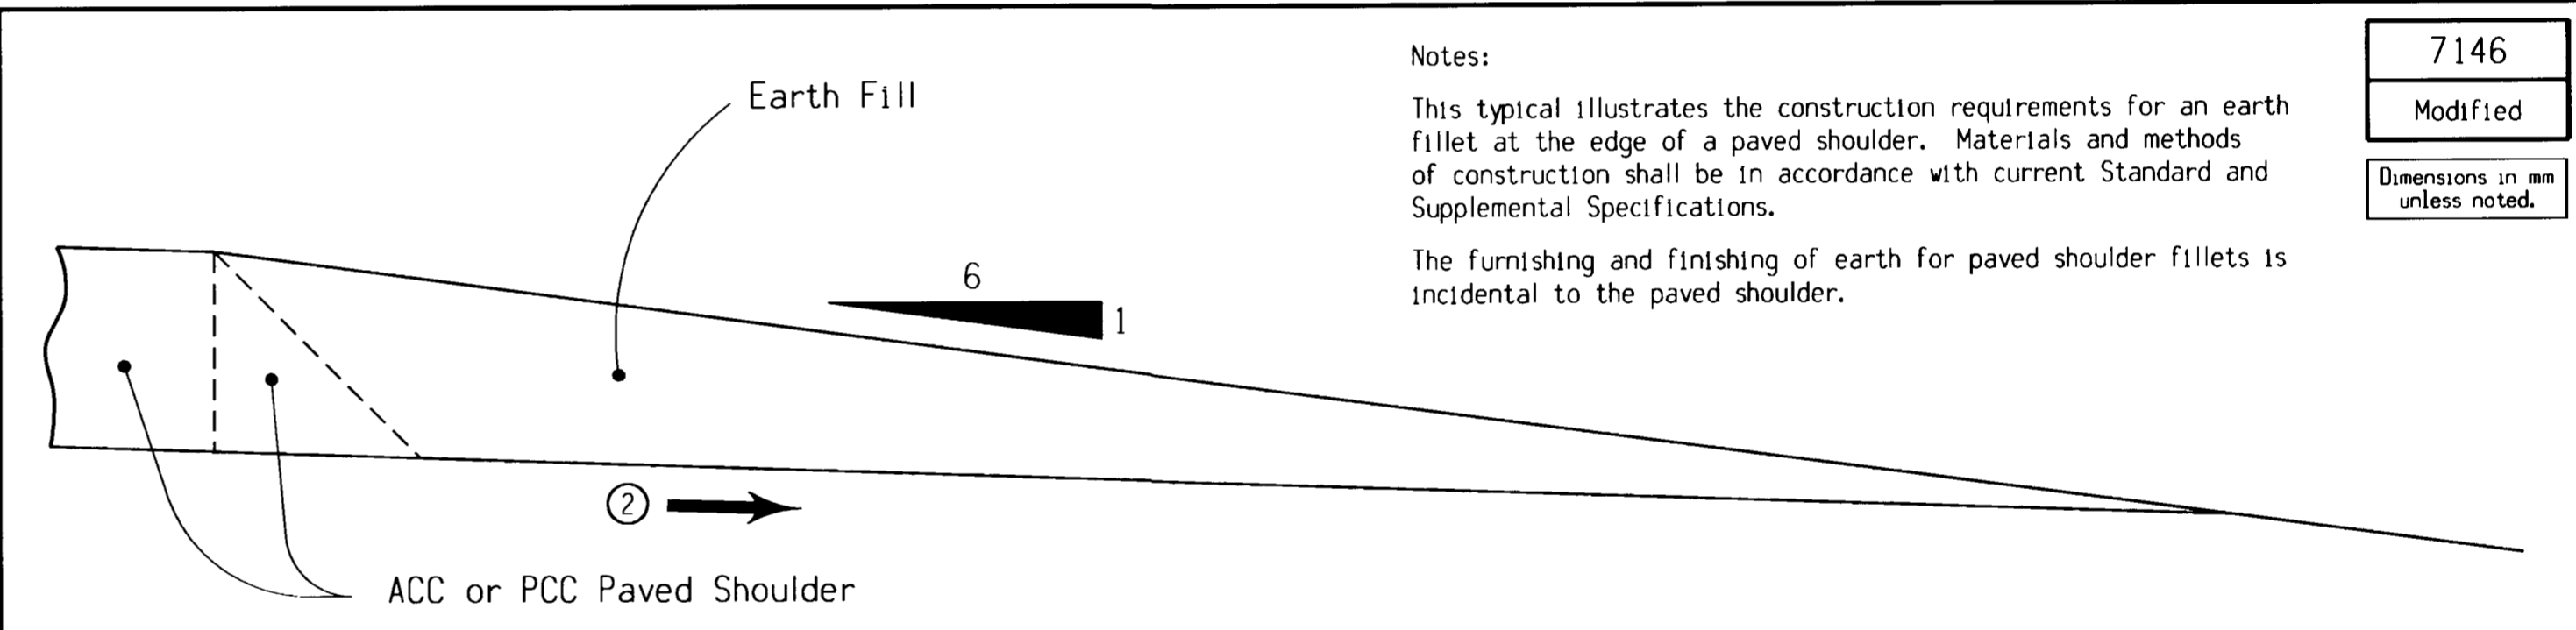

7146
Modified
Dimensions in mm unless noted.

Notes:
This typical illustrates the construction requirements for an earth fillet at the edge of a paved shoulder. Materials and methods of construction shall be in accordance with current Standard and Supplemental Specifications.
The furnishing and finishing of earth for paved shoulder fillets is incidental to the paved shoulder.

ROAD IDENTIFICATION	LOCATION		SIDE	QUANTITIES (1)
	STATION TO STATION			EARTH FILL m ³ 40% Shrink
IA-1 Loop B	2076+60	2079+39	LT	37.6
	2076+60	2079+39	RT	37.6
IA-1 Ramp C	3075+08	3080+90	RT	37.6
	3075+00	3076+00	LT	37.6
	3076+00	3080+10	LT	37.6
	6153+10	6157+20	RT	37.6
IA-64 Ramp C	6153+00	6156+62	LT	37.6
	6156+62	6157+20	LT	37.6
IA-64 Loop C	7154+94	7157+50	RT	37.6
	7154+94	7156+55	LT	37.6

- Not a bid item. Quantities are per station per side.
- Match slope of under side of shoulder pavement.

EARTH FOR
PAVED SHOULDER FILLET

pcr = I:\WORK\proj\sect\39922\cadd\anacurve\PAVE - 2004 Charges\87151112.dwg
 evels = 1-63
 per table = 1.p.ctab es\ra1.f.x.t.tio

PROPOSED SUBGRADE TREATMENT

103-3
MODIFIED

NO.	LOCATION	DESCRIPTION			TYPE	QUANTITY		POLYMER GRID m ²	AVAILABLE FROM		REMARKS
	Station to Station	Side	Depth	Width	Material + Shrink %	m ³	Mg		Quantity	Station to Station	
1	15+40 to 23+50		0.3	9.2	Special Backfill 4132		5495				Includes Cross Over & Storage Lanes @ Sta. 18+14 Includes Cross Over & Storage Lanes @ Sta. 52+09 Includes Cross Over & Storage Lanes
2	51+00 to 53+50		0.3	9.2	Special Backfill 4132		1863				
3	128+50 to 133+80		0.3	9.2	Special Backfill 4132		3761				
4	1452+45 to 1455+00 (X-28)		0.3	9.2	Special Backfill 4132		1579				
5	2131+48 to 2132+25 (X-40)		0.3	9.2	Special Backfill 4132		477				
					TOTALS		15010				
6	9173+25 to 9174+50		0.3	4.6	Special Backfill 4132		310				Right Turn Lane @ 130th St., Includes Return Curve Widening & Left Turn Lane @ 130th St., Includes Crossover
7	9172+75 to 9176+56		0.3	4.6	Special Backfill 4132		1445				

DRAINAGE STRUCTURE BY ROAD CONTRACTOR

104-3
10-03-00

* Not a bid item

LOCATION	TYPE	SIZE mm	KIND OF PIPE	LENGTH NEW CONST. m	BEDDING CLASS	DESIGN COVER (H)	CAMBER m	APRON NO.		ADAPTORS* RF-2	CONNECTED PIPE JOINT* RF-14	FLOW LINE ELEVATIONS			DIMENSIONS m				SKEW AHEAD Degrees		DIKE				CLASS 20 m ³	EMBANKMENT IN PLACE m ³	REMARKS				
								Inlet	Outlet			Lt.	Rt.	Other	Total		Extensions		Lt.	Rt.	Lt.	Rt.	Lt.	Rt.				Lt.	Rt.		
								Type	Type			Lt.	Rt.	Lt.	Rt.	Lt.	Rt.	Lt.	Rt.	Lt.	Rt.	Lt.	Rt.	Lt.				Rt.	Type		
131+10 EBL	1101 Med.	600	1000	21.34	C	0.8		1	1	3	6	259.317	259.200		9.56	15.51														Pipe Apron Guard	
183+20 EBL	1101 Med.	600	1000	20.12	C	0.8		1	1	3	6	278.190	277.990																	Pipe Apron Guard	
County Road X-40 2132+00.0	1101	600	1000	24.38	C	1.4		1	1	3	6	257.000	257.500		14.14	13.98															
130th Street 1173+82.4	1101	750	1000	15.85	C	2.6		1	1	3	6	259.310	259.290		11.19	8.41					29										
173+76.5	1301	600	1000	4.27	C	1.0				1	2	263.900	260.679	263.581	41.35	39.21	4.27	0												Remove and Relay Inlet Apron	
																															TOTAL

- ① Refer to Standard Road Plan RF-38
- ② Not a Bid Item

TABULATION OF BRIDGE END DRAIN

104-8
02-11-00

Bridge Station	Bridge Corner	LOCATION		SHOULDER ①		Polymer Grid m ² ②	INSTALLATION INFORMATION					SPECIAL BACKFILL Mg ②	REMARKS
		Distance DI-1 or DI-2 ①	Panels Required A B C or D	PCC m ²	Elevation			Length					
					Form Grade		(A)	(B)	(C)	(L1)	(L2)		
76+39													
WBL	NW	10.5	B	16.68	16.68	290.081	290.051	288.301	282.523	2.78	24.7	16.9	(1) Sta. 76+07.5 Lt.
EBL	SW	10.5	C/D	26.16	26.16	289.622	289.592	287.842	280.893	2.18	28.8	13.2	(1) Sta. 76+01.7 Rt.
134+66													
EBL	SE	6.6	C	16.68	16.68	241.409	241.379	239.629	235.098	2.78	21.1	33.8	(1) Sta. 135+43.9 Rt.
157+90													
WBL	NW	6.6	C	16.68	16.68	254.729	254.699	252.949	245.300	2.78	24.6	16.9	(1) Sta. 158+34.0 Lt.
EBL	NE	9.8	B	13.08	13.08	254.824	254.794	253.044	247.150	2.18	28.1	13.2	(1) Sta. 158+27.2 Rt.
TOTALS		5		89.28									

(1) Additional Polymer Grid and Granular Subbase Along Pavement Edges is Accounted for Under the Bridge Approach Tabulation.

gpr = I:\WORK\proj\sect\30022\add\ver\curve\FAVE - 2004 Charges\17151112.c01
 elevs\103.0+03
 per scale = 1:1000

DESIGN TEAM

METRIC

IOWA DOT * OFFICE OF ROAD DESIGN

COUNTY

PROJECT NUMBER

SHEET NUMBER

C.05

date = Wed Apr 14 16:15:05 2004

prf = \XUSWATSD\DATA\INPL0\NPL85\BW\CU5.prf

Revised 04/08/04

175-198

TABULATION OF SAFETY CLOSURES

108-13A
10-28-97

Refer to Section 2518 of the Standard Specifications

STATION	CLOSURE TYPE		REMARKS
	Road Qty.	Hazard Qty.	
163+80 WBL	1		
4+30 WBL	1		Traffic Control
18+14	2		Access Location
35+22	2		Access Location
39+46	2		Access Location
64+75	2		Access Location
66+50	1		Traffic Control
67+00	1		Traffic Control
72+00	1		Traffic Control
76+39		4	Bridge Approach
83+80	1		Traffic Control
86+97	2		Access Location
105+15	2		Access Location
117+37	2		Access Location
134+66		2	Bridge Approach
137+62	2		Access Location
157+90.6		4	Bridge Approach
163+80 WBL	1		Traffic Control
173+20		2	Access Location
IA-1 ENT. RAMP 'C'	1		Traffic Control
3075+20			
IA-64 EXIT RAMP 'B'			
6157+50	1		Traffic Control
TOTAL	37		

REMOVAL OF PAVEMENT

110-1
04-27-99

* Not a bid item.

STATION TO STATION		PAVEMENT TYPE	AREA m ²	SAW CUT m*	REMARKS
WBL					
15+40	24+00		6555	7.2	Stage II (WBL & X-Over)
81+90	84+60		384		Stage IV (see J.02)
82+00	83+00		372		Stage II (see J.02)
83+00	84+00		572	8.4	Stage III (see J.02)
84+00	85+20		145		Stage III (see J.02)
162+00	164+00		1530	7.2	Stage II (see J.03)
162+40	164+60		233		Stage IV (see J.03)
163+05	164+00		942	13.4	Stage III (see J.03)
164+00	165+20		140		Stage III (see J.03)
173+20	9176+27		621	638.0	Stage II (right turn lane)
EBL					
21+00 Lt. Lane	24+00 Lt. Lane		1210	7.2	Stage IV (see J.04)
21+00 Rt. Lane	24+00 Rt. Lane		1210	7.2	Stage V (see J.04)
20+40	24+60		400		Stage V (see J.04)
20+40	24+60		400		Stage VI (see J.04)
X-Overs					
63+70	69+40		2800		Stage III
Sideroads					
1452+00	1455+00		2385	7.2	X-28
2131+48	2132+25		965	7.2	X-40
1173+05	1173+20		245	7.2	130th Street
TOTALS			20522		
04/08/04 PLAN REVISION					
173+00	173+40		156.5	385.7	Stage I Curve Relocation
173+20	9176+27		634.1	325.0	Stage II Curve Relocation
CURVE RELOCATION TOTAL :			790.6	710.7	

TABULATION OF PAVED SHOULDERS

112-9
10-28-97

① Lane(s) to which the shoulder is adjacent.

No.	Direction of Traffic	LOCATION			L	STANDARD ROAD PLAN AND/OR DETAIL DRAWING	E or W WIDTH m	SHOULDER AREA m ²	REMARKS
		Station to Station	Side	m					
1	EB	2076+60	2079+39	LT	279	RH-41B	1.2	334.8	Exit Loop B
2	EB	2076+60	2079+39	RT	279	RH-41B	1.8	502.2	Exit Loop B
3	EB	3075+08	3080+90	RT	582	RH-41B	1.8	1047.6	Entrance Ramp C
4	EB	3075+00	3076+00	LT	100	RH-41B	1.8	180.0	Entrance Ramp C
5	EB	3076+00	3080+10	LT	410	RH-41B	1.2	492.0	Entrance Ramp C
6	EB	6153+10	6157+20	RT	410	RH-41B	1.8	738.0	Exit Ramp B
7	EB	6153+00	6156+62	LT	362	RH-41B	1.2	434.4	Exit Ramp B
8	EB	6156+62	6157+20	LT	58	RH-41B	1.8	104.4	Exit Ramp B
9	EB	7154+94	7157+50	RT	256	RH-41B	1.8	460.8	Entrance Loop C
10	EB	7154+94	7156+55	LT	161	RH-41B	1.2	193.2	Entrance Loop C
TOTAL								4487.4	

TABULATION OF DELINEATORS AND OBJECT MARKERS

108-17
04-28-98

Refer to Standard Plans RE-48A-B* and RE-29C

Station	Type*	OBJECT MARKER				REMARKS
		DELINEATOR	Type 3			
		Single White D-1W Number	Type 2 OM2-3YV Number	OM-3L Number	OM-3R Number	
WBL	3			1		
76+78.6	3				1	
76+85.1						
EBL	3				1	
2075+96	3			1		
76+01.2						
133+95.9	3			1		
134+00.5	3				1	
7157+50.1	3			1		
157+54	3				1	
WBL	3			1		
158+26.8	3				1	
158+29.5						
TOTAL				10		

REMOVE or REMOVE AND REINSTALL BEAM GUARDRAIL

110-7A
10-28-97

① Lane(s) to which the installation is adjacent.

No.	Direction of Traffic	LOCATION		STEEL BEAM GUARDRAIL			POST (mm)				END ANCHORAGE			REMARKS
		Station	Side	Remove m	Remove & Reinstall m	Remove No.	Remove & Reinstall				Remove No.	Remove & Reinstall No.	Type	
							200x200 No.	250x250 No.	150x200 No.	150x150 No.				
WBL		133+96	RT	38		22								
WBL		135+24	RT	33		19								
TOTAL				71		41								

TABULATION OF BRIDGE APPROACH SECTION

112-6
10-03-00

(Refer to Standard Road Plan RF-19E, RK-16, RK-19A, RK-19B, RK-19C, RK-19D, RK-19E, RK-19F, RK-19G, RK-19H, or RK-19J)

① Not a bid item

Bridge Station	End	LOCATION		APPROACH PAVEMENT				SUBDRAIN				APPROACH SUBGRADE		REMARKS
		Thickness	Pay Length	Non-Reinf. Pavement Area m ²	Reinforced Pavement Area m ²	Fixed or Movable Abutment F or M	Perforated Subdrain 100 mm	Subdrain Outlet		Class 'A' Crushed Stone Backfill m ³	Modified Subbase m ³	Polymer Grid m ²		
								Station	Side				m ³	
Mainline				117	78.8		11.5			99.59	221.31			
				117	77.1		11.5			98.91	219.80			
76+39 WBL	W	300		267.2	191.3	M	25.5	173.1	LT	3.8	0.5	220.97	491.04	
76+39 WBL	E	300		117	74.8	M	11.5	172.6	LT	1.7	0.5	97.76	217.24	
76+39 EBL	W	300		82.5	42.7	M	13.4	153.1	RT	2.0	0.5	67.17	149.27	
76+39 EBL	E	300				M		157.9	RT					mainline
76+39 EBL	E	300		117	81.5	M	11.5	2148.3	RT	1.7	0.5	101.06	224.58	loop B
				117	80.3		11.5			1.7	0.5	100.47	223.26	
134+66 EBL	W	300				F		213.9	RT					
134+66 EBL	E	300		117	116.1	F	11.5	186.5	RT	1.7	0.5	116.08	257.95	
				117	110.4		11.5			1.7	0.5	113.23	251.62	
157+91 WBL	W	300		191.5	147.7	M	19.4	201.6	LT	2.9	0.5	165.96	368.80	
157+91 WBL	E	300		171	150.3	M	11.5	200.5	LT	1.7	0.5	158.75	352.78	
157+91 EBL	W	300				M		195.3	RT					
157+91 EBL	E	300		1531.2	1151	M	150.3	194.2	RT	22.5	5.5	1339.94	2977.65	

TABULATION OF TEMPORARY FLOODLIGHTING LUMINAIRES

108-27
04-30-96

NO.	LOCATION STATION	TYPE	NUMBER LUMIN.	REMARKS
STAGE II				
	6+00	Offset	1	Traffic Control, Sheet J.07
	69+00	Offset	1	
	82+00	Offset	1	Traffic Control, Sheet J.08
	85+00	Offset	1	Traffic Control, Sheet J.05
	162+00	Offset	1	Traffic Control, Sheet J.05
	165+00	Offset	1	Traffic Control, Sheet J.05
STAGE IV				
	21+00	Offset	1	
	24+00	Offset	1	Traffic Control, Sheet J.06
				Traffic Control, Sheet J.06
	1073+50	Offset	2	Traffic Control, RS-15
(*)	184+75	Offset	1	Traffic Control, Sheet J.09
(*)	186+25	Offset	1	Traffic Control, Sheet J.09
TOTAL			12	

(*) ARE NOT TO BE REMOVED BY THIS PROJECT



TABULATION OF PAVEMENT MARKINGS

108-22
10-31-95



- ② Broken Center Line (Yellow)
- ③ Double Center Line (Yellow)
- ⑤ No-Passing Zone Line (Yellow)
- ⑥ Broken Lane Line (White)
- ⑦ Edge Line Right (White)
- ⑧ Edge Line Left (Yellow)
- ⑨ Dotted Line (White)
- ⑩ Solid Lane Line (White)
- ⑪ Channelizing Line (White)
- ⑫ Channelizing Line (Yellow)
- ⑬ Stop Line (White)
- ⑭ Crosswalk Line (White)
- ⑮ Yellow Curb
- ⑯ White Curb

ROAD IDENTIFICATION	LOCATION		SIDE		LENGTH (m)																REMARKS
	STATION TO	STATION FROM	L	R	②	③	⑤	⑥	⑦	⑧	⑨	⑩	⑪	⑫	⑬	⑭	⑮	⑯			
	82+05	85+00		WBL					295												
	162+00	165+00		WBL					300												
	162+00	163+39		WBL																	
	162+00	163+39		WBL																	
	162+00	165+00		WBL					300												
	162+00	165+00		WBL						300											
	163+39	164+12		WBL							73										
Stage IV																					
Main line	20+40	24+60		EBL					420												
	20+40	21+00		EBL						60									Removable Tape Marking		
	21+00	24+00		EBL						300											
	24+00	24+60		EBL						60									Removable Tape Marking		
Stage V																					
Main line	20+40	21+00		EBL						60									Remove Removable Tape Marking		
	24+00	24+60		EBL						60									Remove Removable Tape Marking		
	20+40	24+60		EBL						420											
	20+40	21+00		EBL						60									Removable Tape Marking		
	21+00	24+00		EBL						300											
	24+00	24+60		EBL						60									Removable Tape Marking		
Stage VI																					
Main line	20+40	21+00		EBL						60									Remove Removable Tape Marking		
	24+00	24+60		EBL						60									Remove Removable Tape Marking		
	21+00	24+00		EBL						300											
	21+00	24+00		EBL						300											
LENGTH SUBTOTALS																					
					0	1570	0	0	0	1305	0	0	1135	1165	0	0	0	0	0	Removable Tape Marking	
					0	2680	0	0	1605	1305	0	0	1135	1165	0	0	0	0	0	Remove Removable Tape Marking	
					0	463	285	28386	31053	33847	518	1639	2292	1153	130	0	0	0	0	Pavement Marking	
					0	4222	300	2230	7053	65	0	0	0	0	32	0	0	0	0	Pavement Marking Removed	
QUANTITY FACTORS																					
					0.25	2.00	1.00	0.25	1.00	1.00	0.33	1.00	2.00	2.00	6.00	1.50					
TOTALS																					
					0	3140	0	0	0	1305	0	0	2270	2330	0	0	0	0	0	Removable Tape Marking, TOTAL = 9,045	
					0	5360	0	0	1605	1305	0	0	2270	2330	0	0	0	0	0	Remove Removable Tape Marking, TOTAL = 12,870	
					0	926	285	7097	31053	33847	171	1639	4584	2306	780	0	0	0	0	Pavement Marking, TOTAL = 82,688	
					0	8444	300	558	7053	65	0	0	0	0	192	0	0	0	0	Pavement Marking Removed, TOTAL = 16,612	
ADDED FOR CURVE RECONSTRUCTION																					
S.B.L. @ 130TH STREET																					
	173+20	175+30		WBL																	
	173+55	176+55		WBL					300												
	173+40	176+50		CL				310													
	173+20	173+90		WBL																	
	174+25	176+50		WBL																	
LENGTH SUBTOTAL																					
									310	300											
QUANTITY FACTOR																					
									0.25	1.0											
TOTALS																					
									78	300											

g:\work\proj\30022\scs\scurve\pave - 2004\Drawings\7111112.c14
 Date Plotted: 04/08/04 16:15:29
 User: jonesl
 Plot File: \\USWA1S01\DATA\NPL01\NPL85\BWAC20.plt

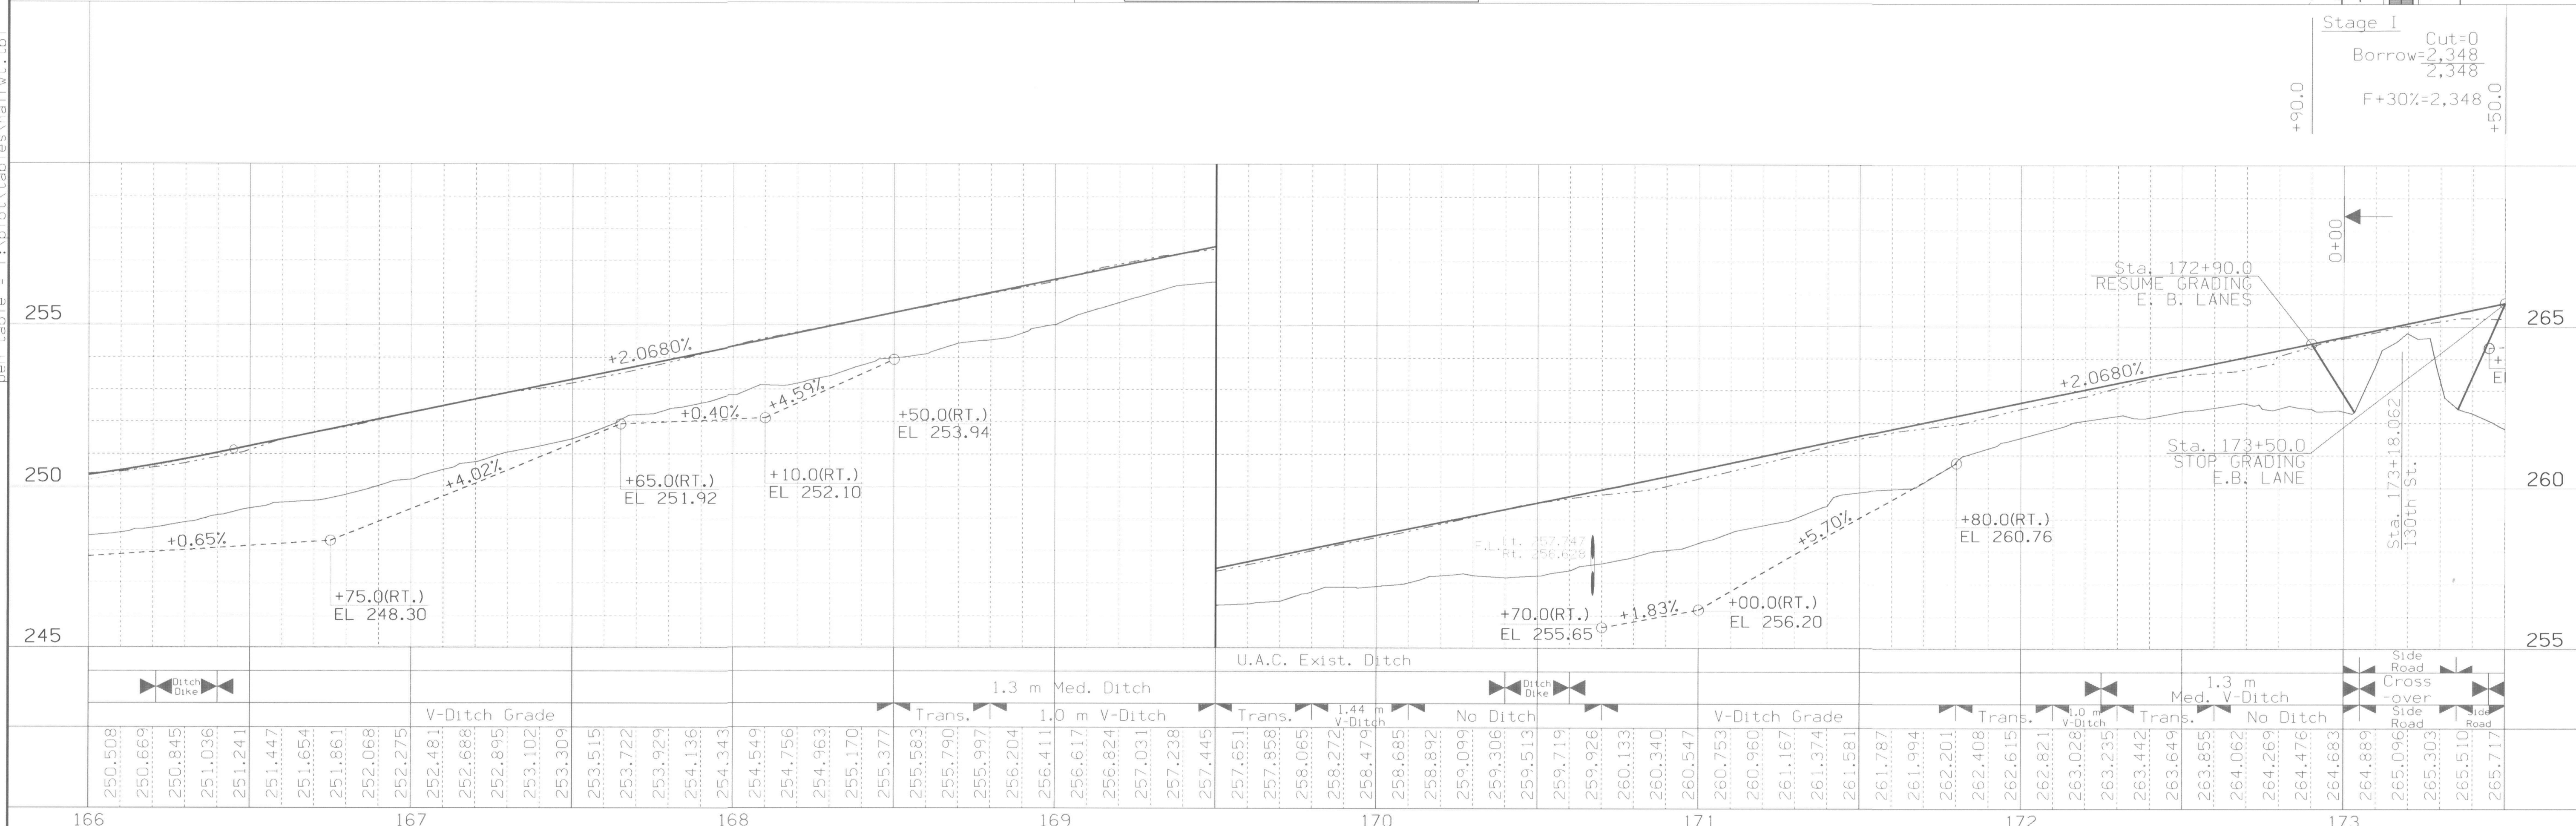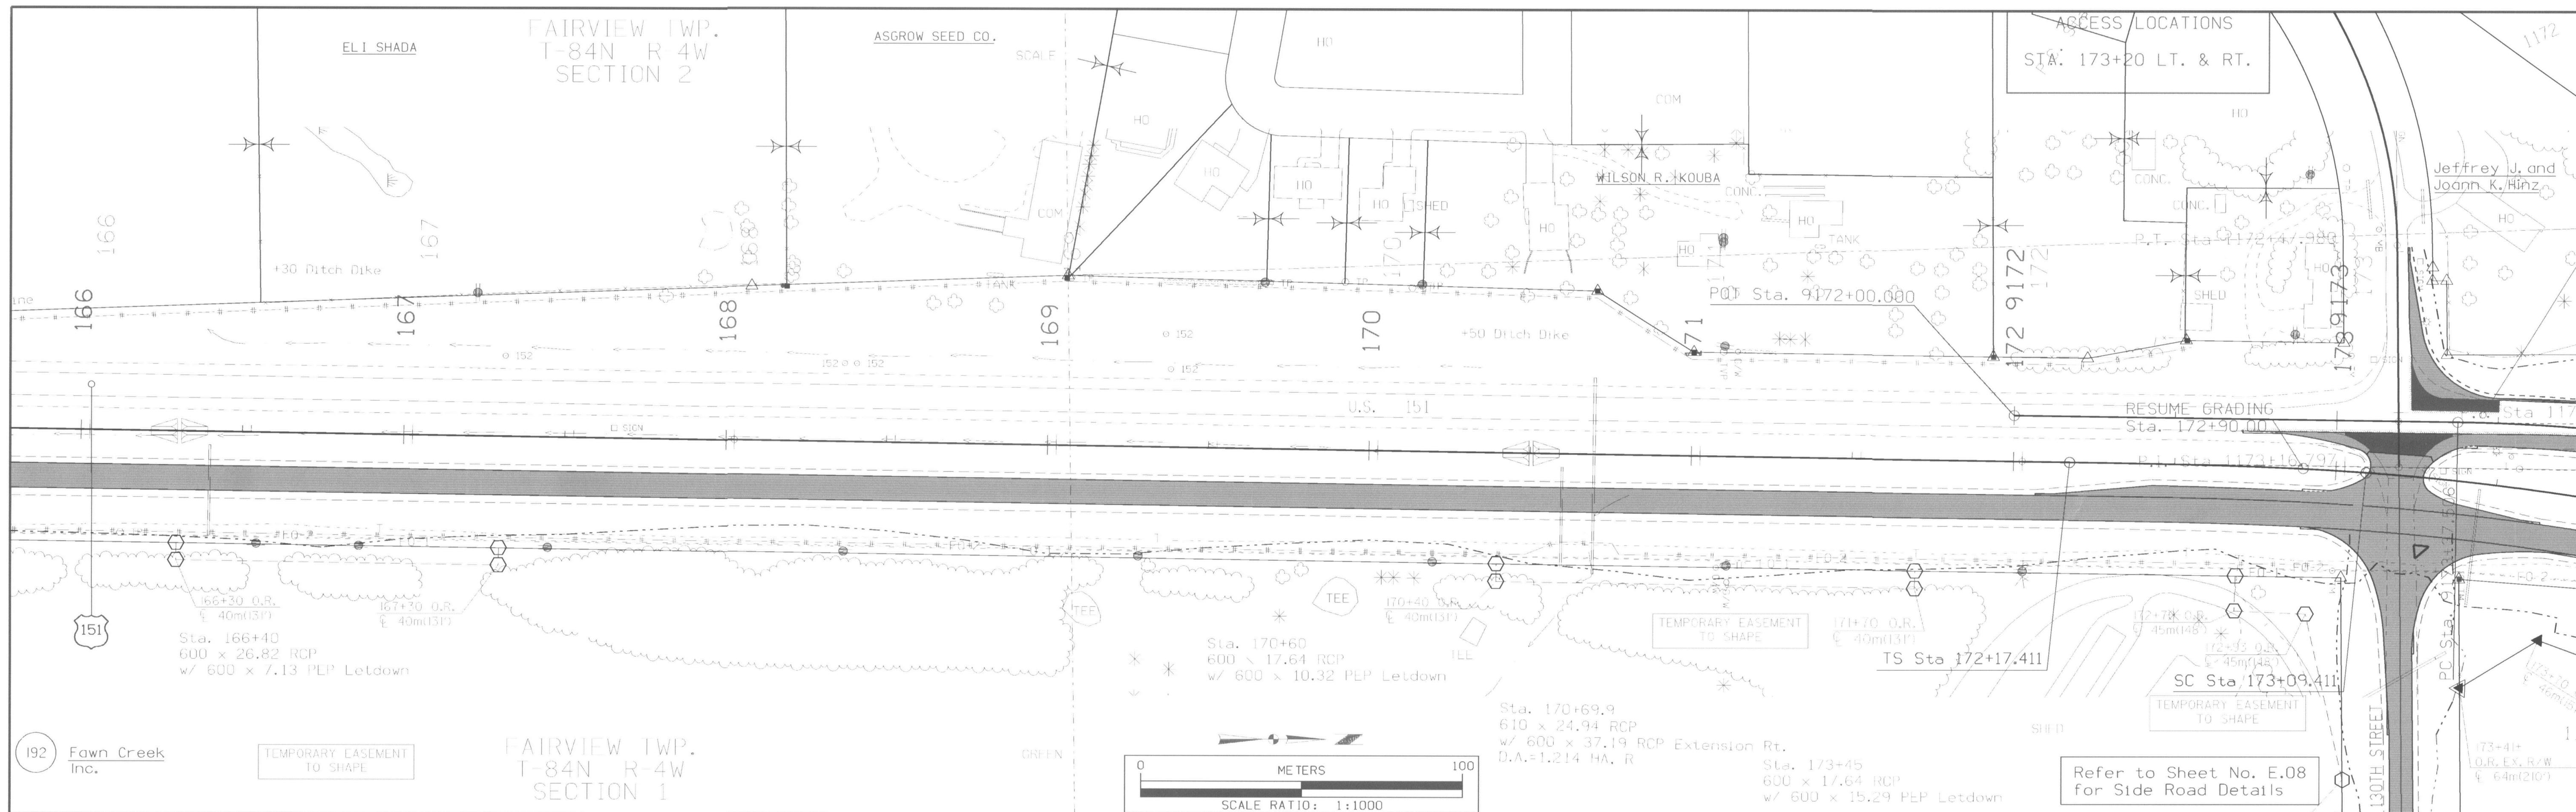

DESIGN TEAM	Skogerboe / EARTH T ECH	METRIC	IOWA DOT * OFFICE OF ROAD DESIGN	Linn/Jones	COUNTY	PROJECT NUMBER	NHSX-151-3(112)--3H-57	SHEET NUMBER	D.23
-------------	-------------------------	--------	----------------------------------	------------	--------	----------------	------------------------	--------------	------

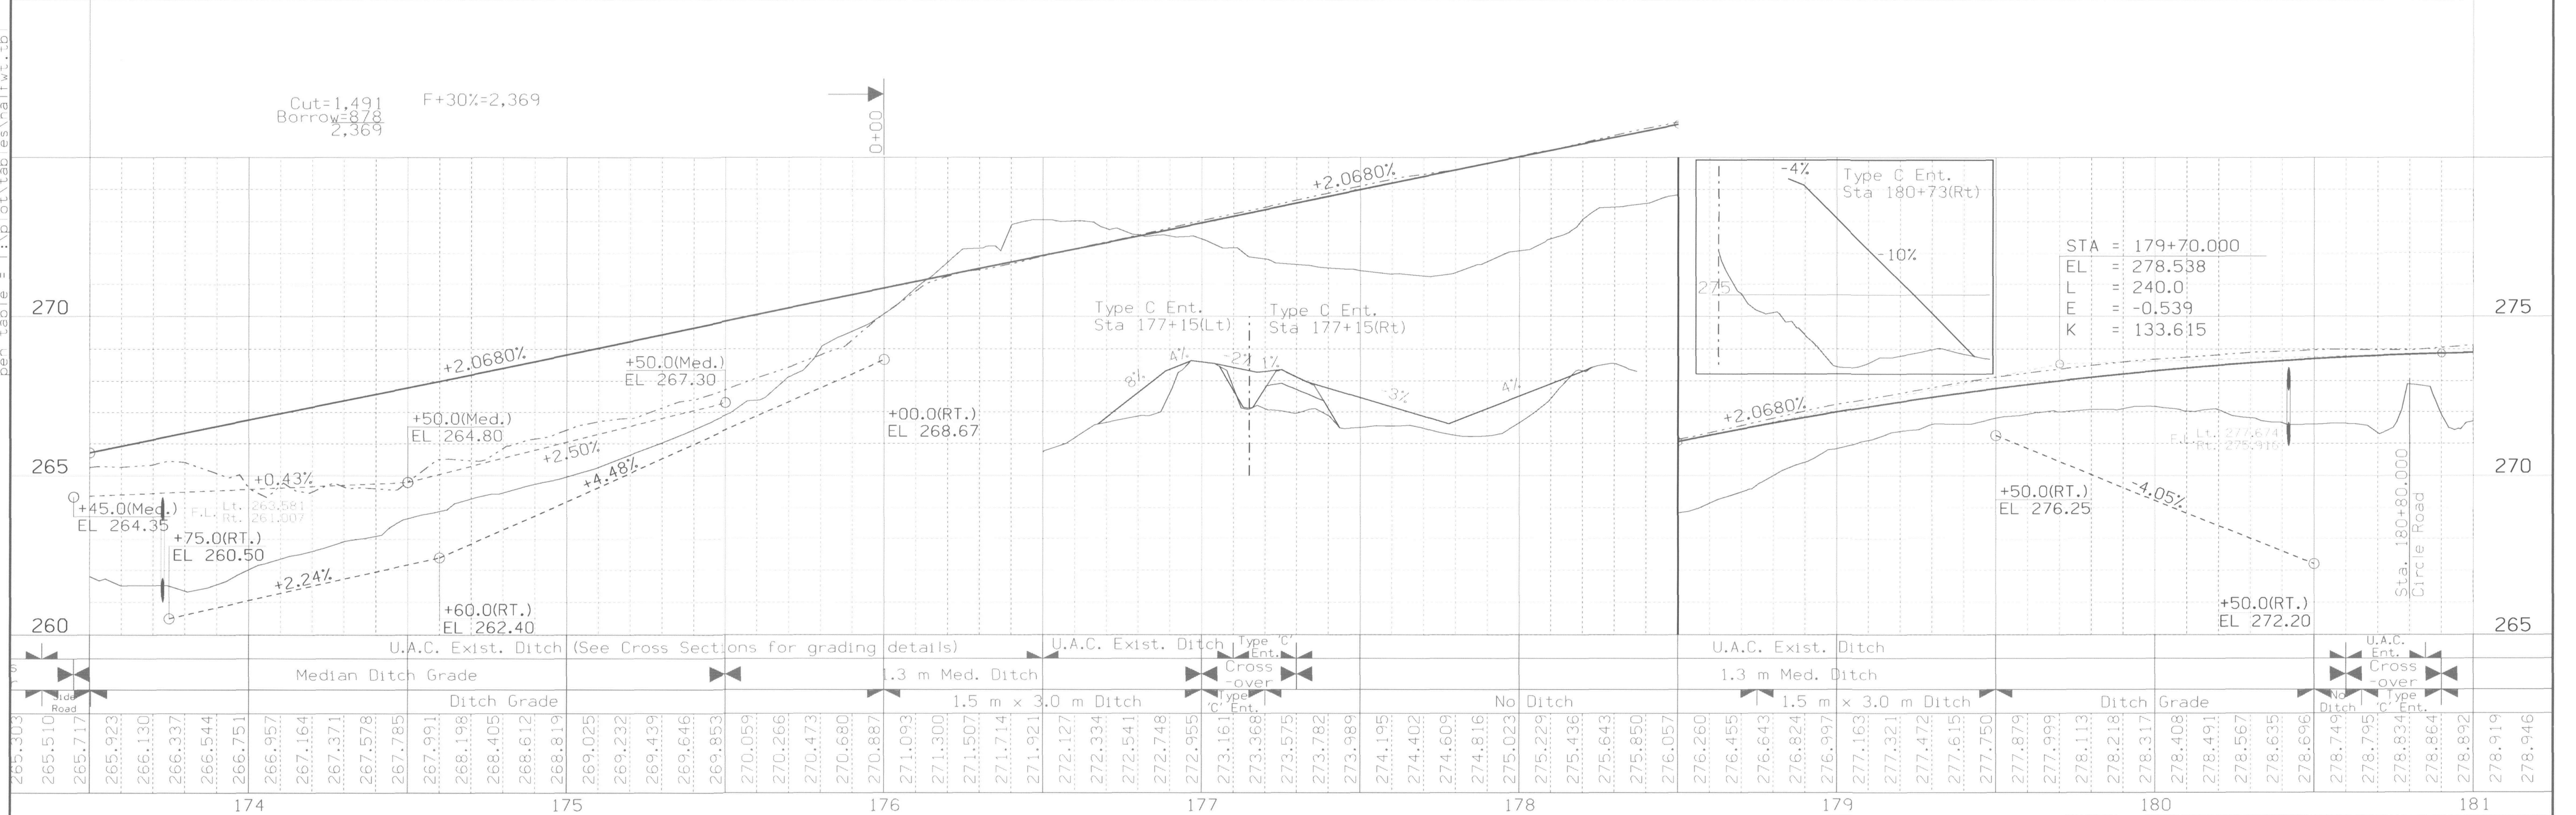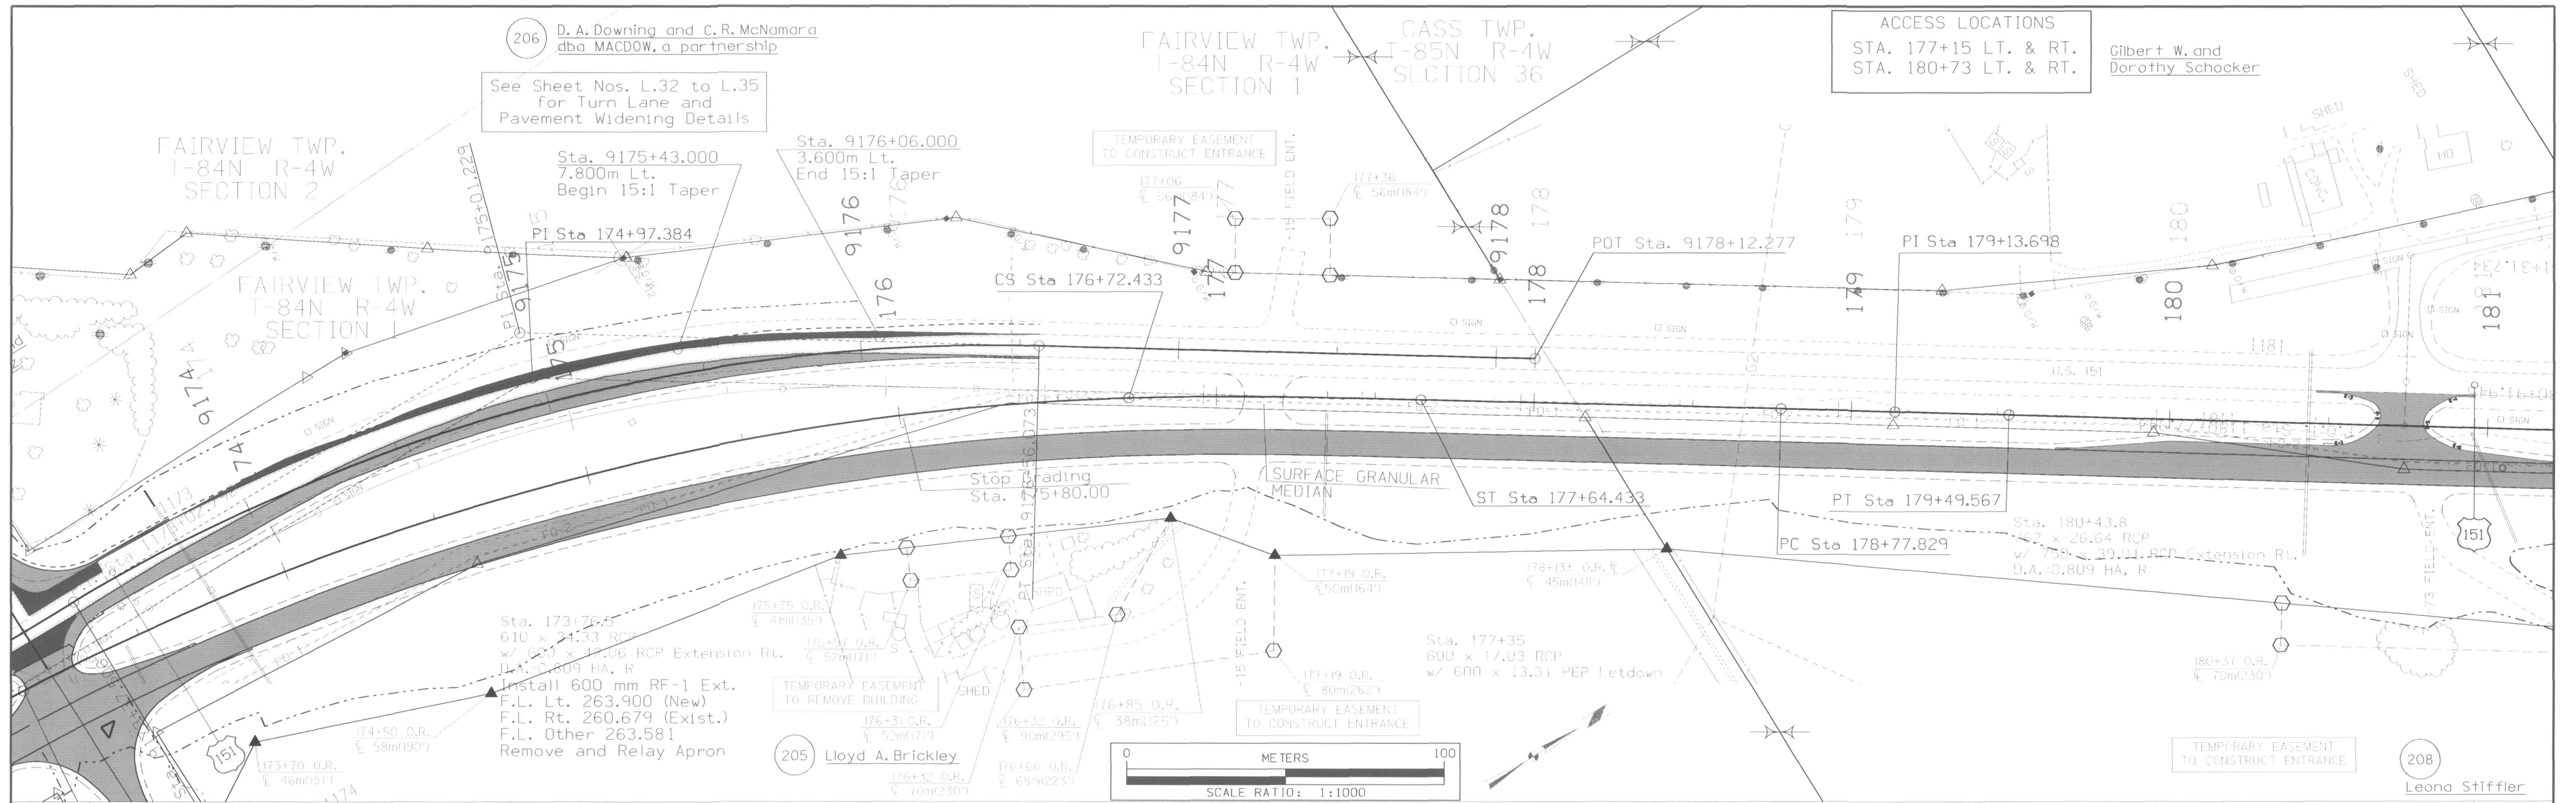

sgr = I:\MOR\proj\39922\cadd\anacurve\FAVE - 2004 Changes\57151112.d24
 levels = 1-4,7,8
 pen style = l:\p\ot\tables\ta\l\fw.t.td

206 D. A. Downing and C. R. McNamara
dba MACDOW, a partnership

205 Lloyd A. Brickley

FAIRVIEW TWP.
T-84N R 4W
SECTION 1


STA. 173+19.651 M.L. O.R.
STA. 1173+19.356 S.R.

STA. 1173+37.739
BEGIN CONSTRUCTION

STA. 1174+75.000
END CONSTRUCTION

ACQUIRE ACCESS CONTROL
FROM STA. 1173+38 TO STA. 1173+88


192 Fawn Creek, Inc.

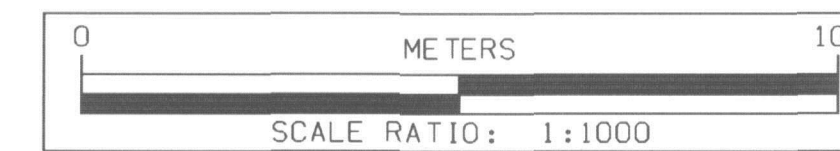

(FOR REFERENCE ONLY)
DUBUQUE - 130TH STREET



Stage I
Cut=913
Borrow=875
1,788

sgn = I:\WORK\project\39922\cadd\anacurve\PAVE - 2004 Changes\57151112.e08
 @level = 12.78
 per = 1:1000
 plot = I:\p\ot\lab\es\half\wt.tbl

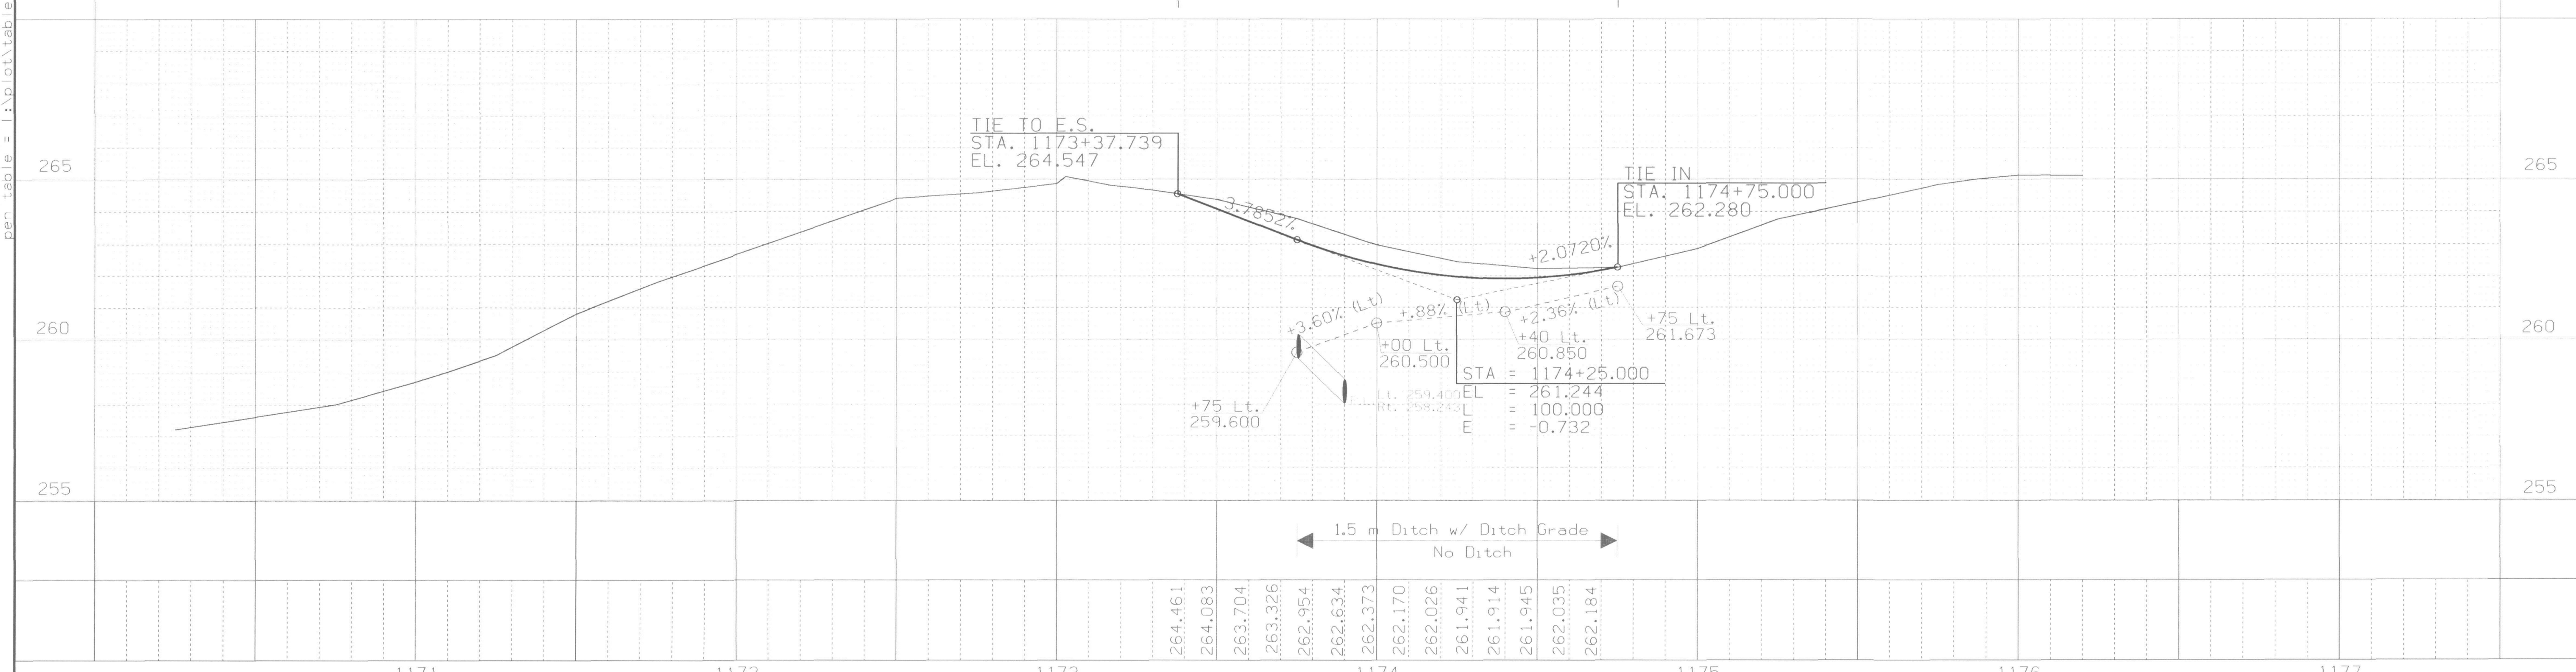

1171	1172	1173	1174	1175	1176	1177
DESIGN TEAM	Skogerboe / ROBINSON	METRIC	IOWA DOT * OFFICE OF ROAD DESIGN	COUNTY	PROJECT NUMBER	NHSX-151-3(112)--3H-57
					SHEET NUMBER	E.08

dgn = I:\WORK\project\39922\cadd\ansecurve\PAVE - 2004\Changes\57151112.g05
 leve.lis = 10
 pen.tbl = I:\plot\tables\mal.fwt.tbl

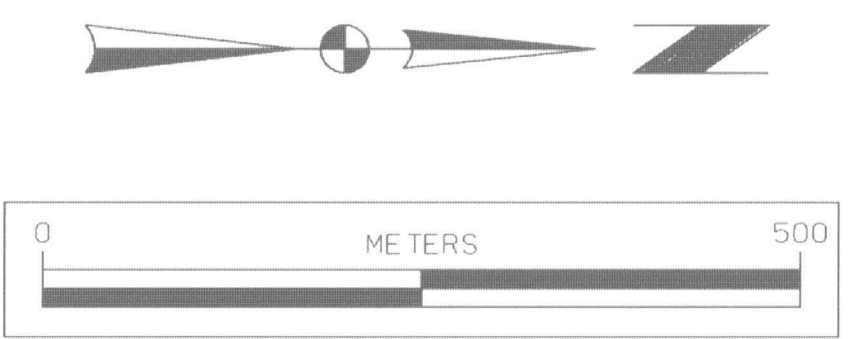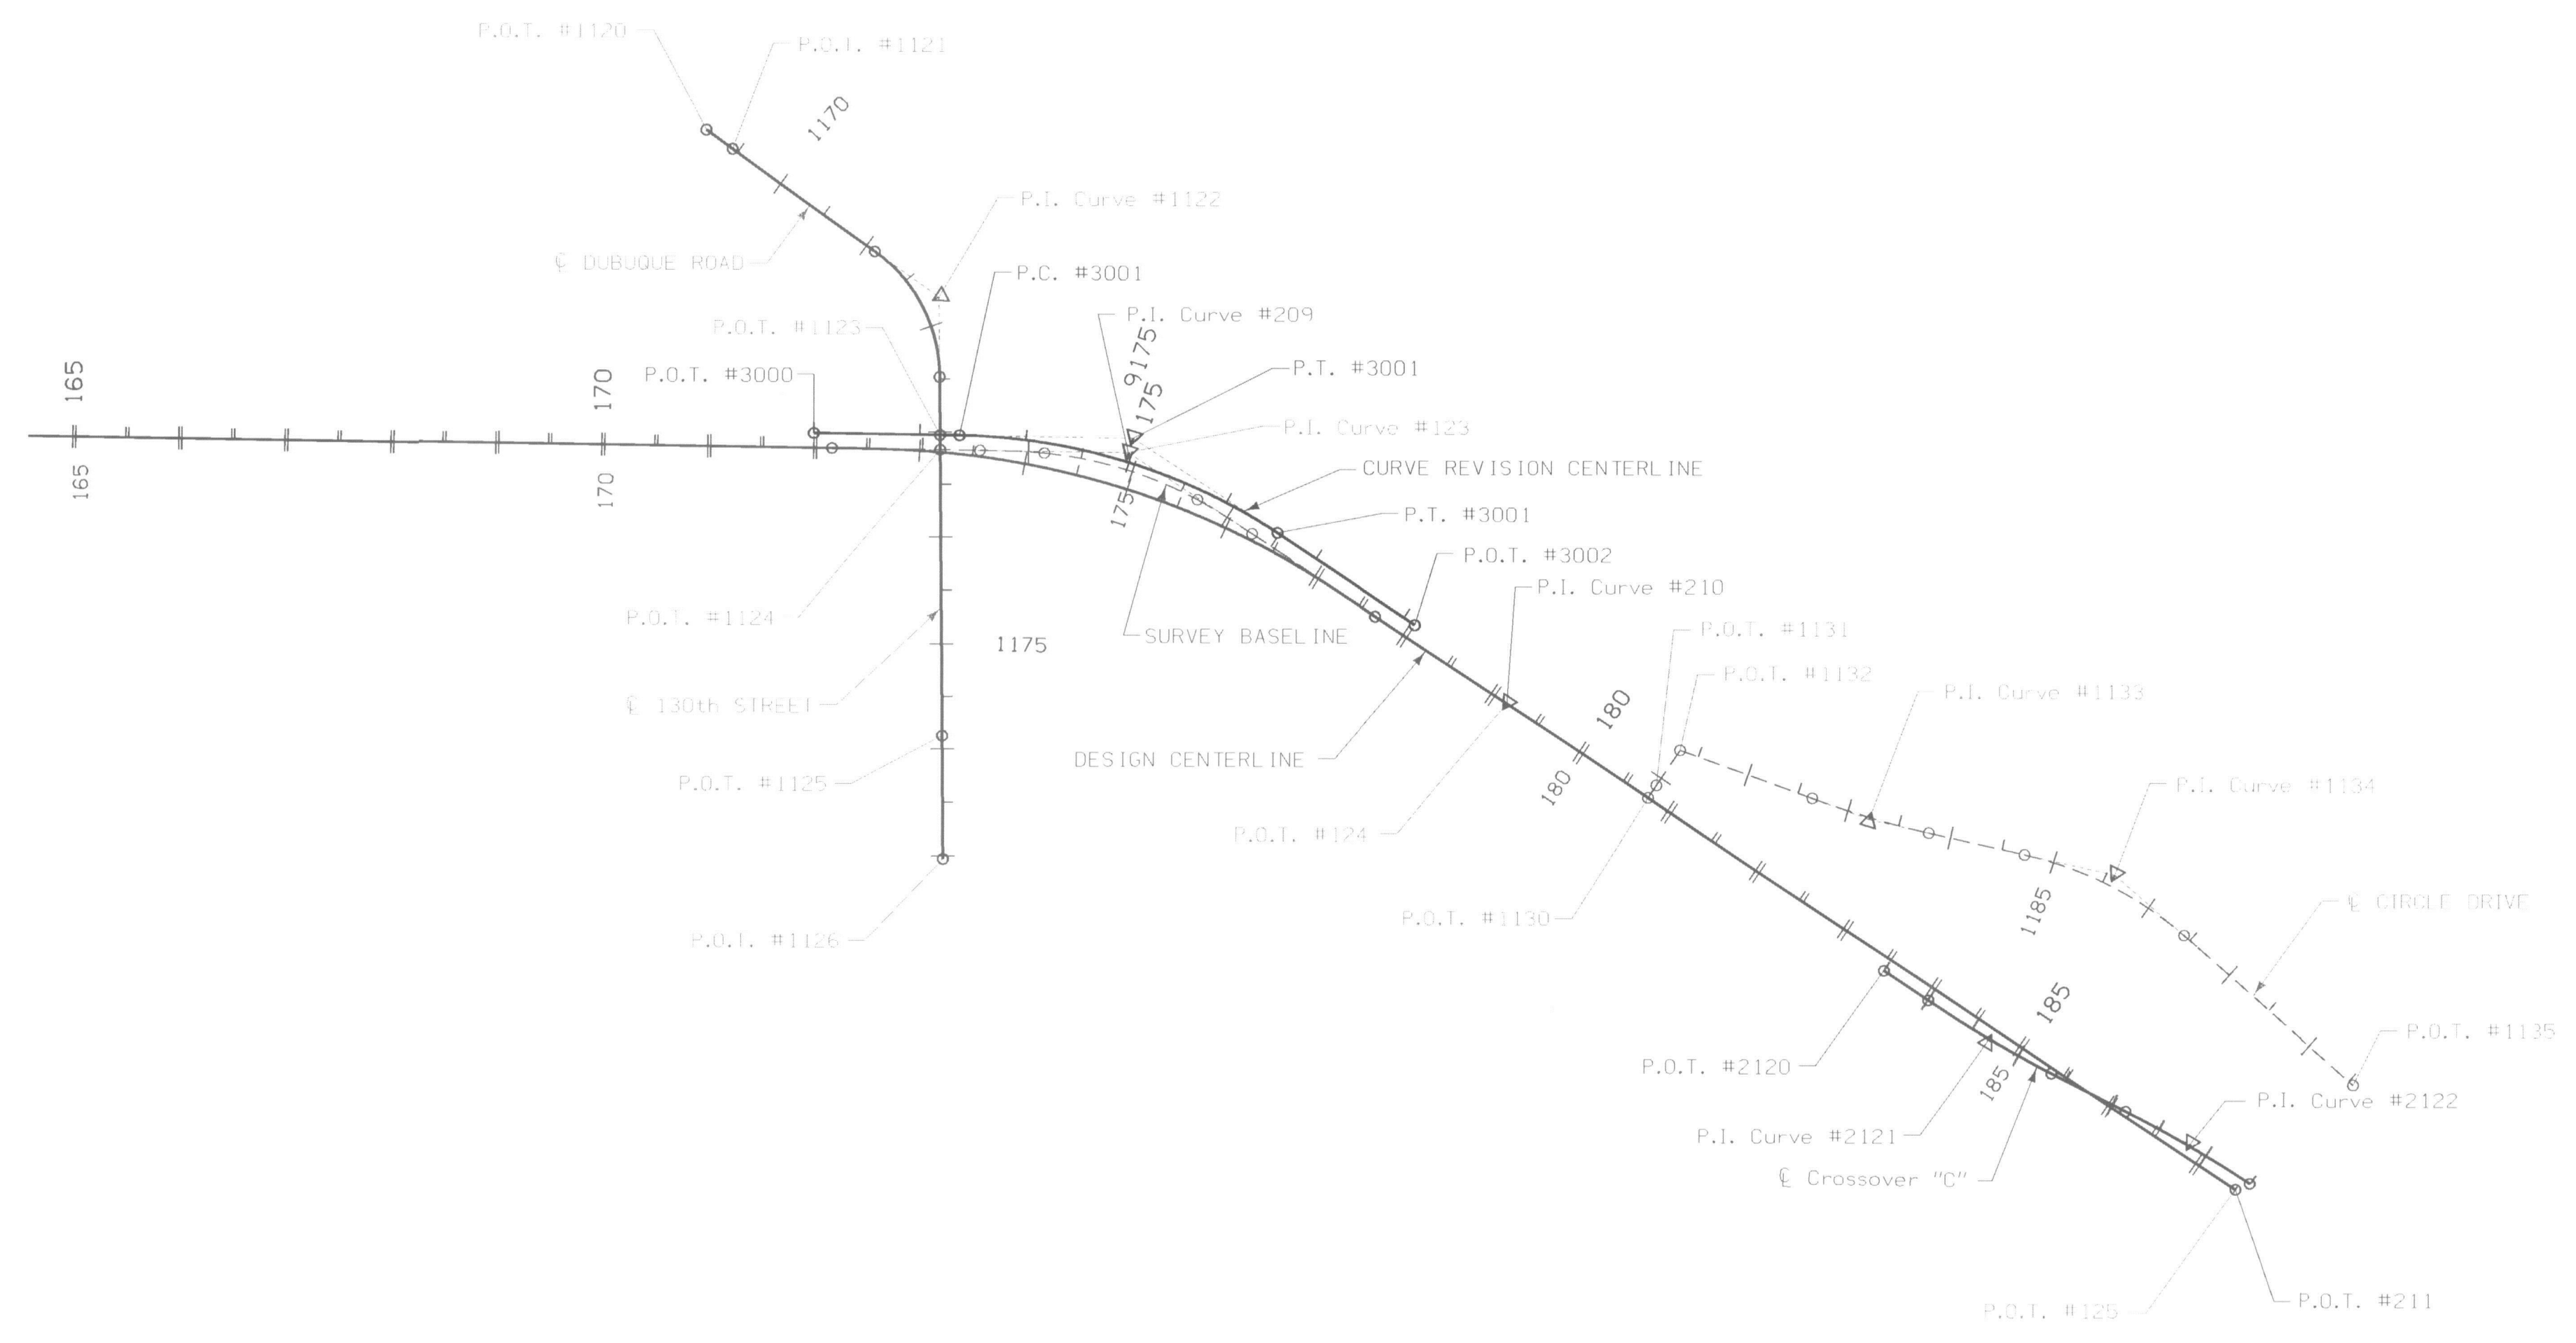

GEOMETRIC LAYOUT
 STA. 165+00 TO STA. 187+50

CIRCULAR CURVE DATA

101-10C
09-27-94


NO.	Δ	R	T	L	E
D-1	33.614	28	8.457	16.427	1.249
D-2	132.399	5	11.336	11.554	7.390
D-3	16.162	130	18.458	36.670	1.304
D-4	68.251	25	16.942	29.780	5.200
D-5	15.875	60	8.366	16.624	0.580
D-6	18.350	50	8.076	16.013	0.648
D-7	65.619	22	14.183	25.196	4.176
D-8	15.810	120	16.662	33.112	1.151
D-9	49.214	20	9.160	17.179	1.938
D-10	95.008	5	5.457	8.291	2.401
D-11	22.744	25	5.028	9.924	0.501

ISLAND DATA

101-13
09-27-94

POINT NO.	LOCATION	ELEVATION
1	1173+41.406, 4.530 Lt.	264.470
2	1173+45.101, 4.849 Lt.	264.580
3	1173+41.351, 8.739 Lt.	264.290

Refer to sheets L.32 through L.35 for geometric details of left and right turn lanes on Southbound U.S. Hwy. 151 at 130th Street.

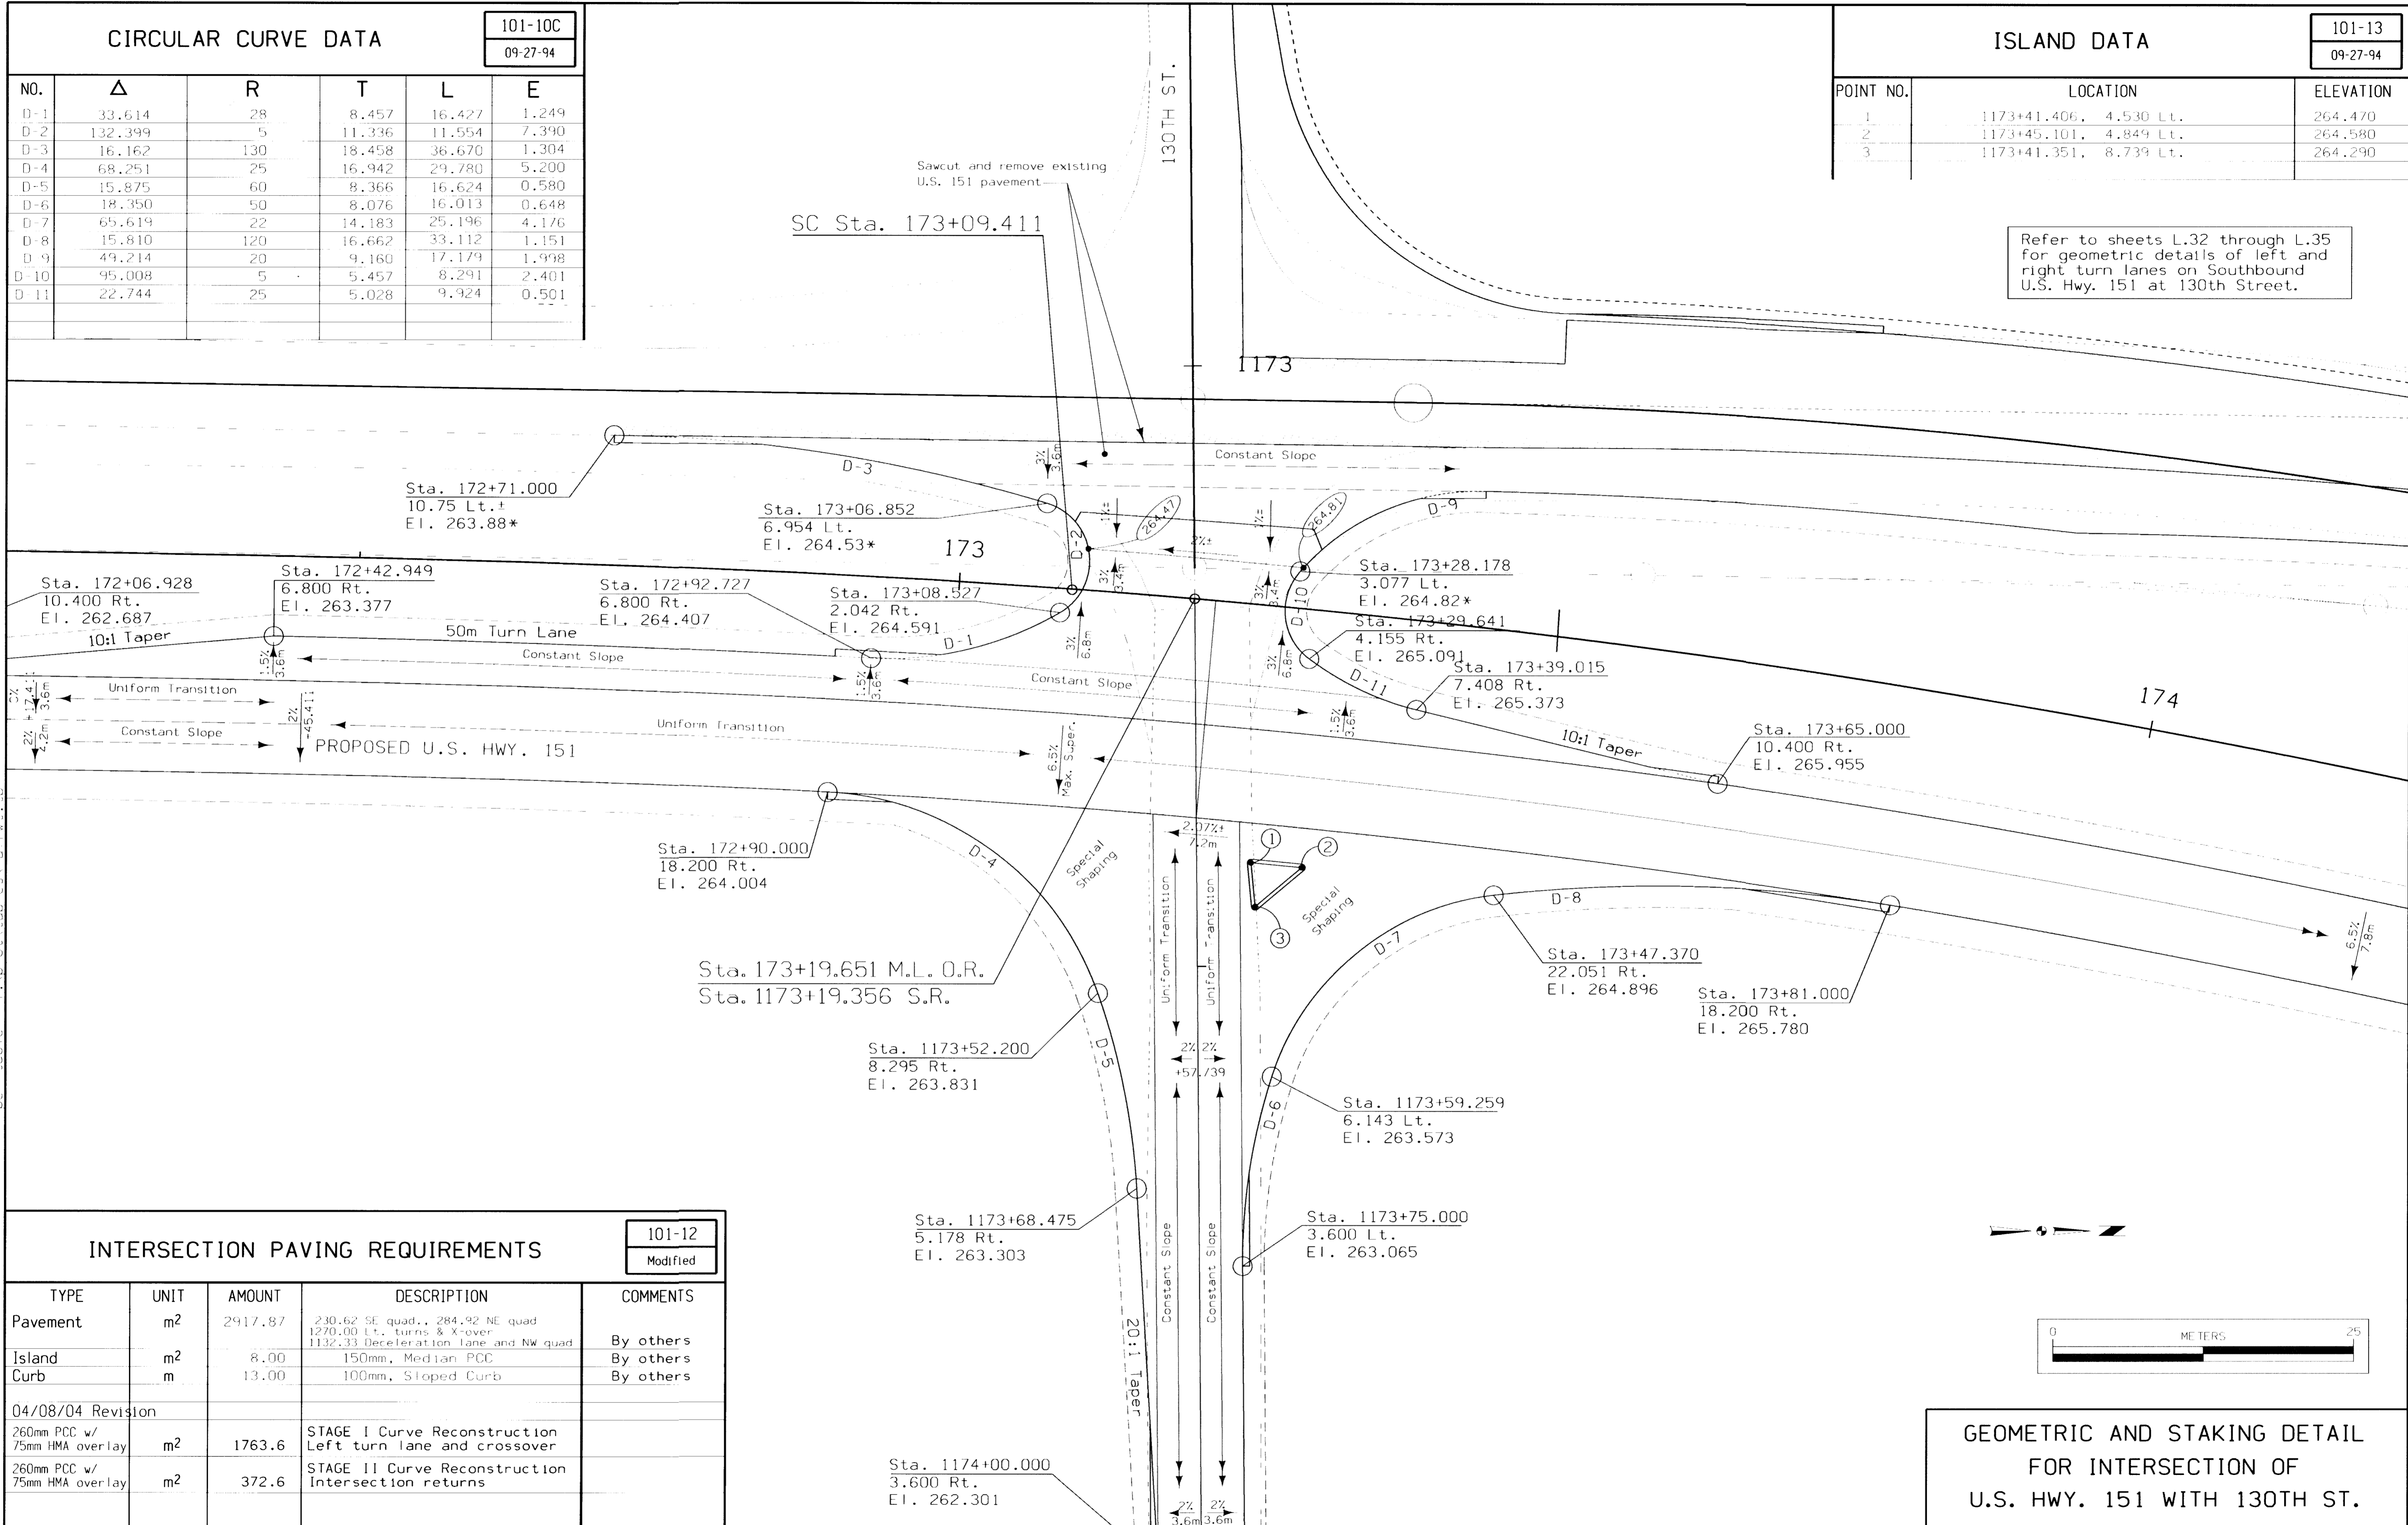


INTERSECTION PAVING REQUIREMENTS


101-12
Modified

TYPE	UNIT	AMOUNT	DESCRIPTION	COMMENTS
Pavement	m ²	2917.87	230.62 SE quad., 284.92 NE quad 1270.00 Lt. turns & X-over 1132.33 Deceleration lane and NW quad	By others
Island	m ²	8.00	150mm, Median PCC	By others
Curb	m	13.00	100mm, Sloped Curb	By others
04/08/04 Revision				
260mm PCC w/ 75mm HMA overlay	m ²	1763.6	STAGE I Curve Reconstruction Left turn lane and crossover	
260mm PCC w/ 75mm HMA overlay	m ²	372.6	STAGE II Curve Reconstruction Intersection returns	

GEOMETRIC AND STAKING DETAIL
FOR INTERSECTION OF
U.S. HWY. 151 WITH 130TH ST.

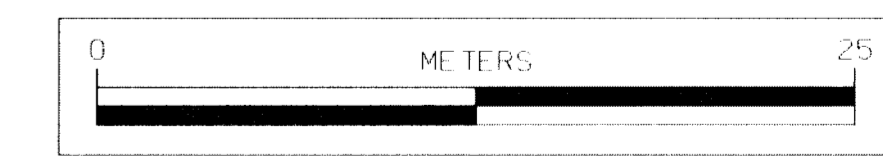

I:\WORK\PROJECT\39922\esdo\res\ave\AVE - 2004\Drawings\371511.2.27
 levels\103
 sep\scale = 1:10 of\15b esva f.w.t.r.b

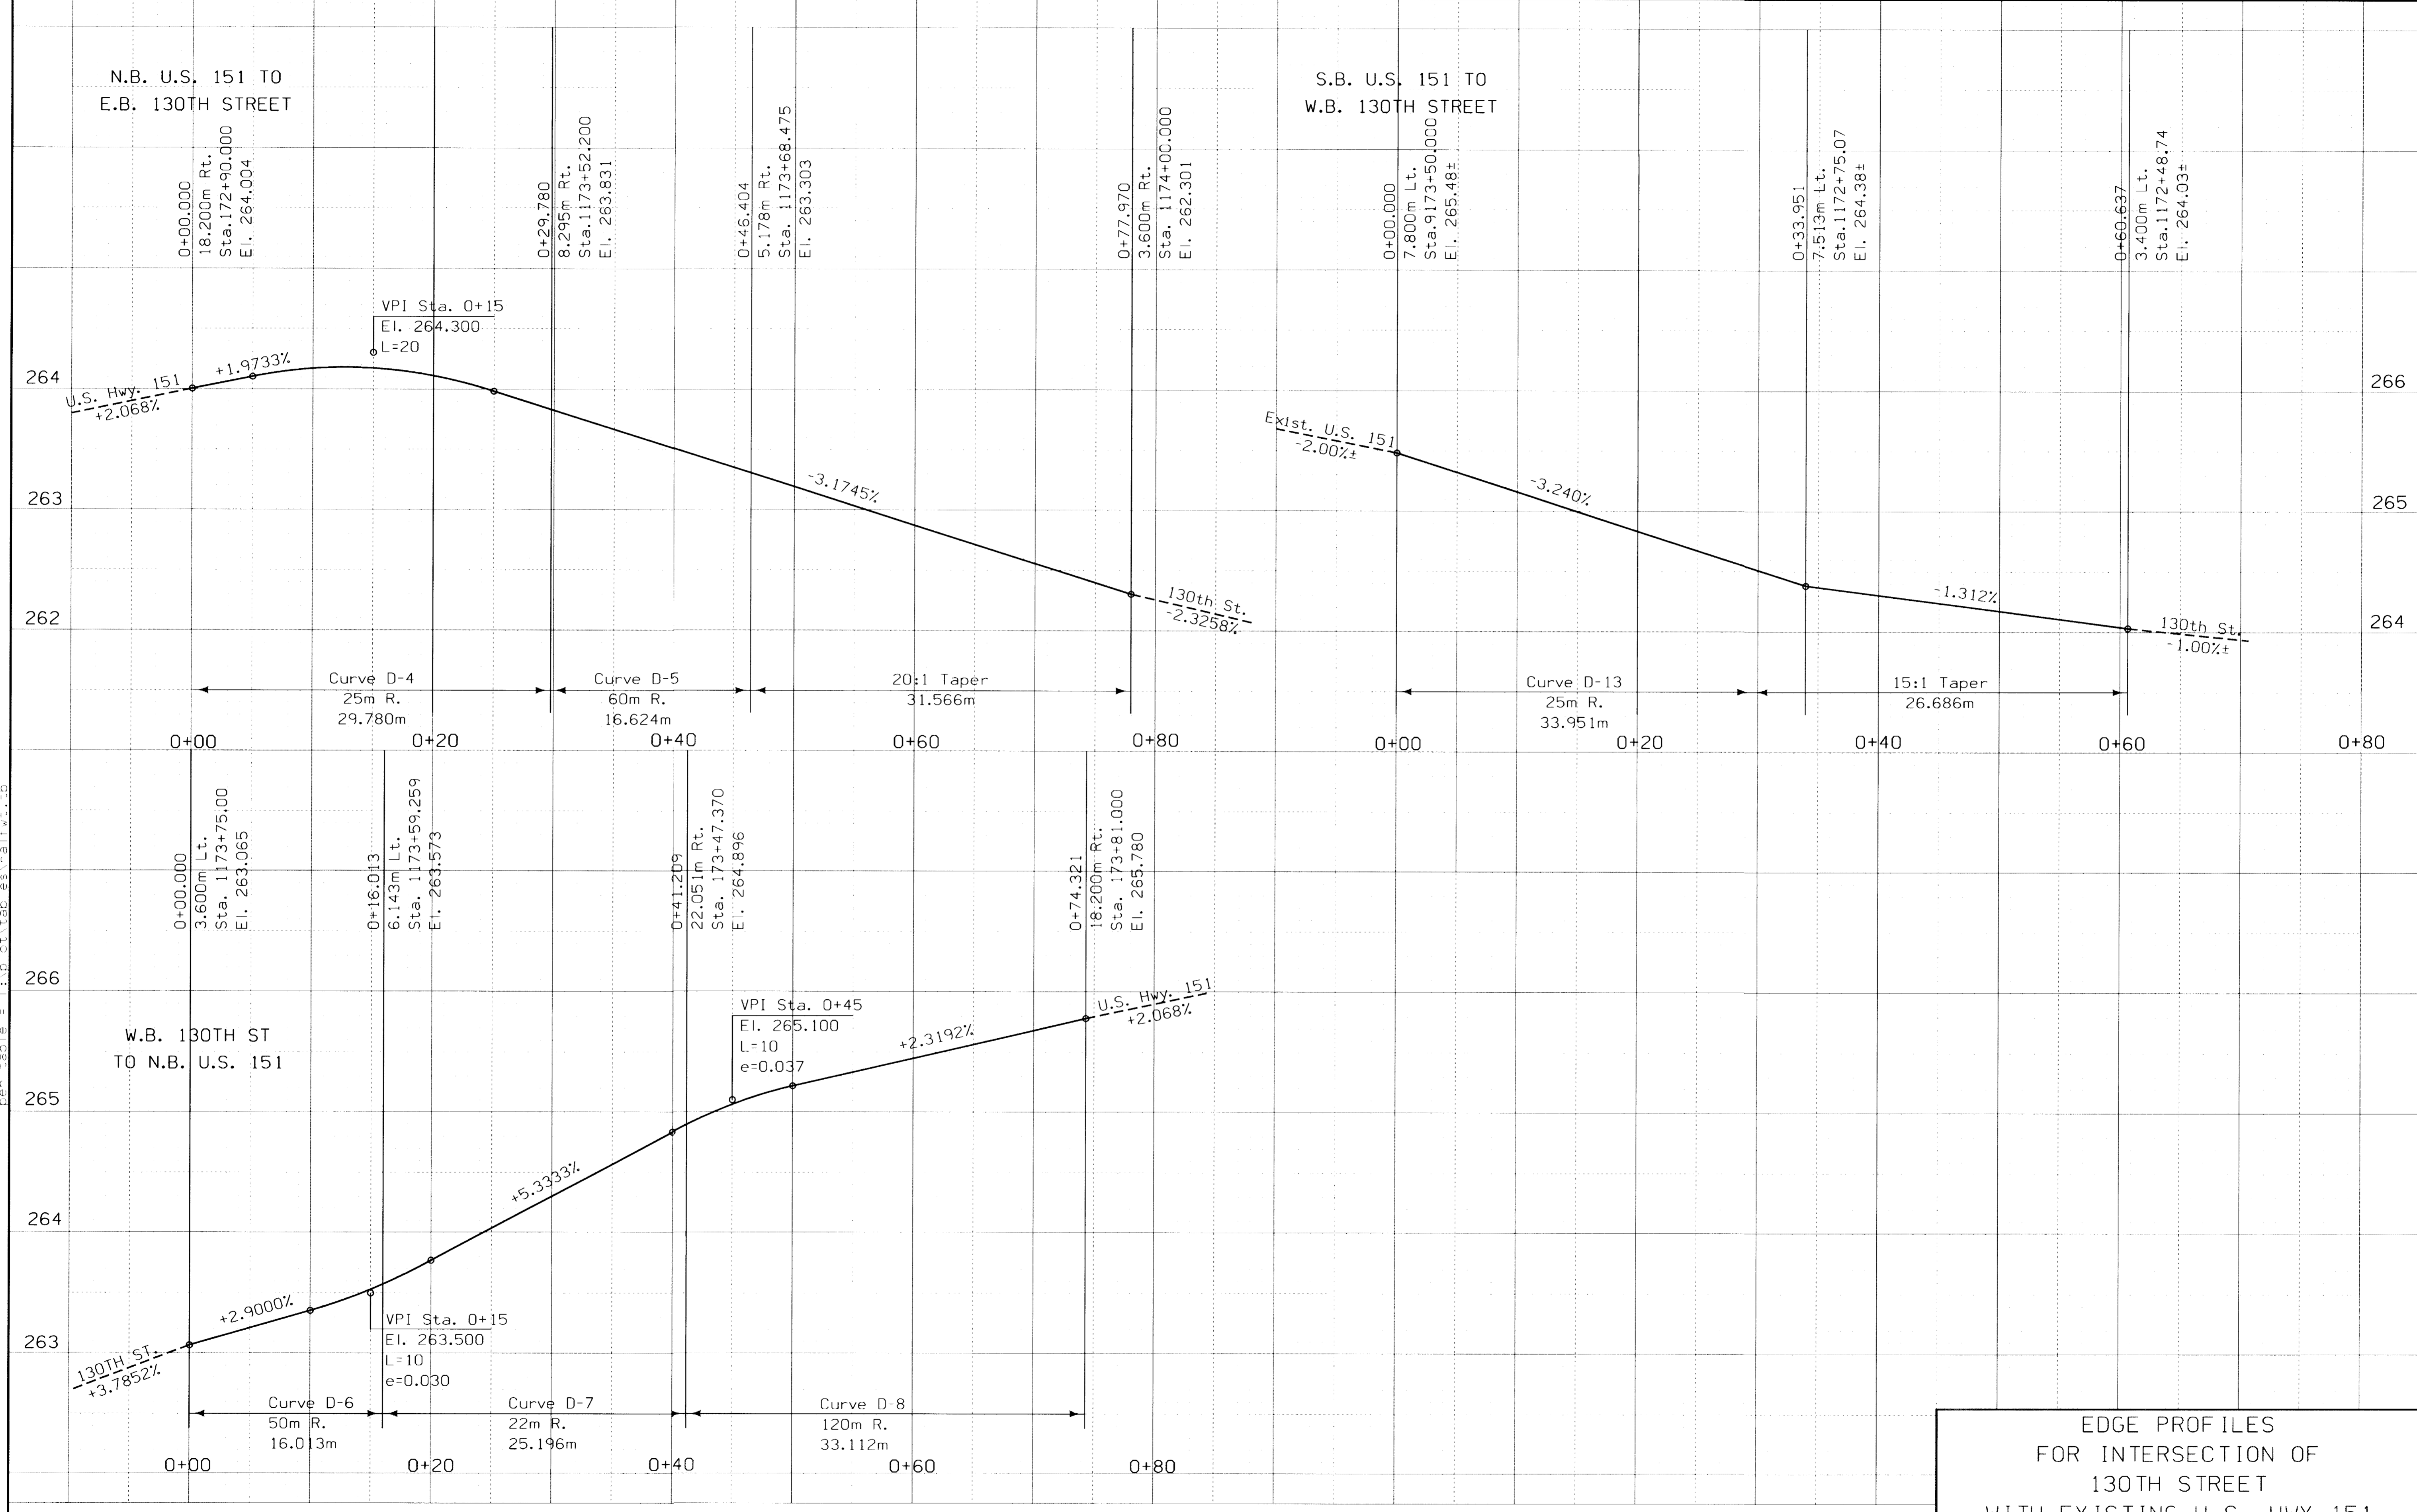

EDGE PROFILES
FOR INTERSECTION OF
130TH STREET
WITH EXISTING U.S. HWY. 151

CIRCULAR CURVE DATA

101-10C
09-27-94

NO.	Δ	R	T	L	E
D-9	49.687	20	9.260	17.344	2.040
D-12	9.697	50	4.241	8.462	0.180
D-13	77.810	25	20.176	33.951	7.126

STAGING NOTES

108-26
09-27-94

Stage 1 - Construct Pavement Widening on US 151 SB Lanes

Traffic Control as per RS-63B
US 151 traffic to be maintained at all times.
Median crossover to be completed in halves, under traffic.

Grade pavement widening Sta 9173+44 to 9176+56
Remove existing median crossover pavement.
Grade median crossover at 130th Street

Mill 75mm of existing HMA Pavement right of relocation centerline from Sta 9173+44 to 9176+56

Pave PCC pavement for widening to match top of existing pavement.
Pave PCC pavement for median crossover to match existing pavement (without milling)

Pave 75mm HMA overlay right of relocation centerline from 9172+71 to 9176+56.
(Overlay both new and existing pavement)

Place granular shoulder, paint pavement markings

Stage 2 - Construct Right Turn Lane on US 151 SB Lanes

Traffic Control as per RS-63A
US 151 traffic to be maintained at all times.
Traffic on new pavement, right of relocation centerline.
130th Street North of US 151 shall remain open during construction.

Sawcut and remove pavement

Grade right turn lane from 9173+20 to 9175+43
Grade intersection return at 130th Street


Mill 75mm existing HMA pavement left of relocation centerline from Sta 9173+44 to 9176+56

Pave PCC pavement for widening and intersection return to match top of milled existing HMA pavement.

Pave variable depth HMA leveling course for right turn lane from 9173+44 to 9174+50.

Pave 75mm HMA overlay left of relocation centerline.
(Overlay both new and existing pavement)

Place granular shoulder, paint pavement markings

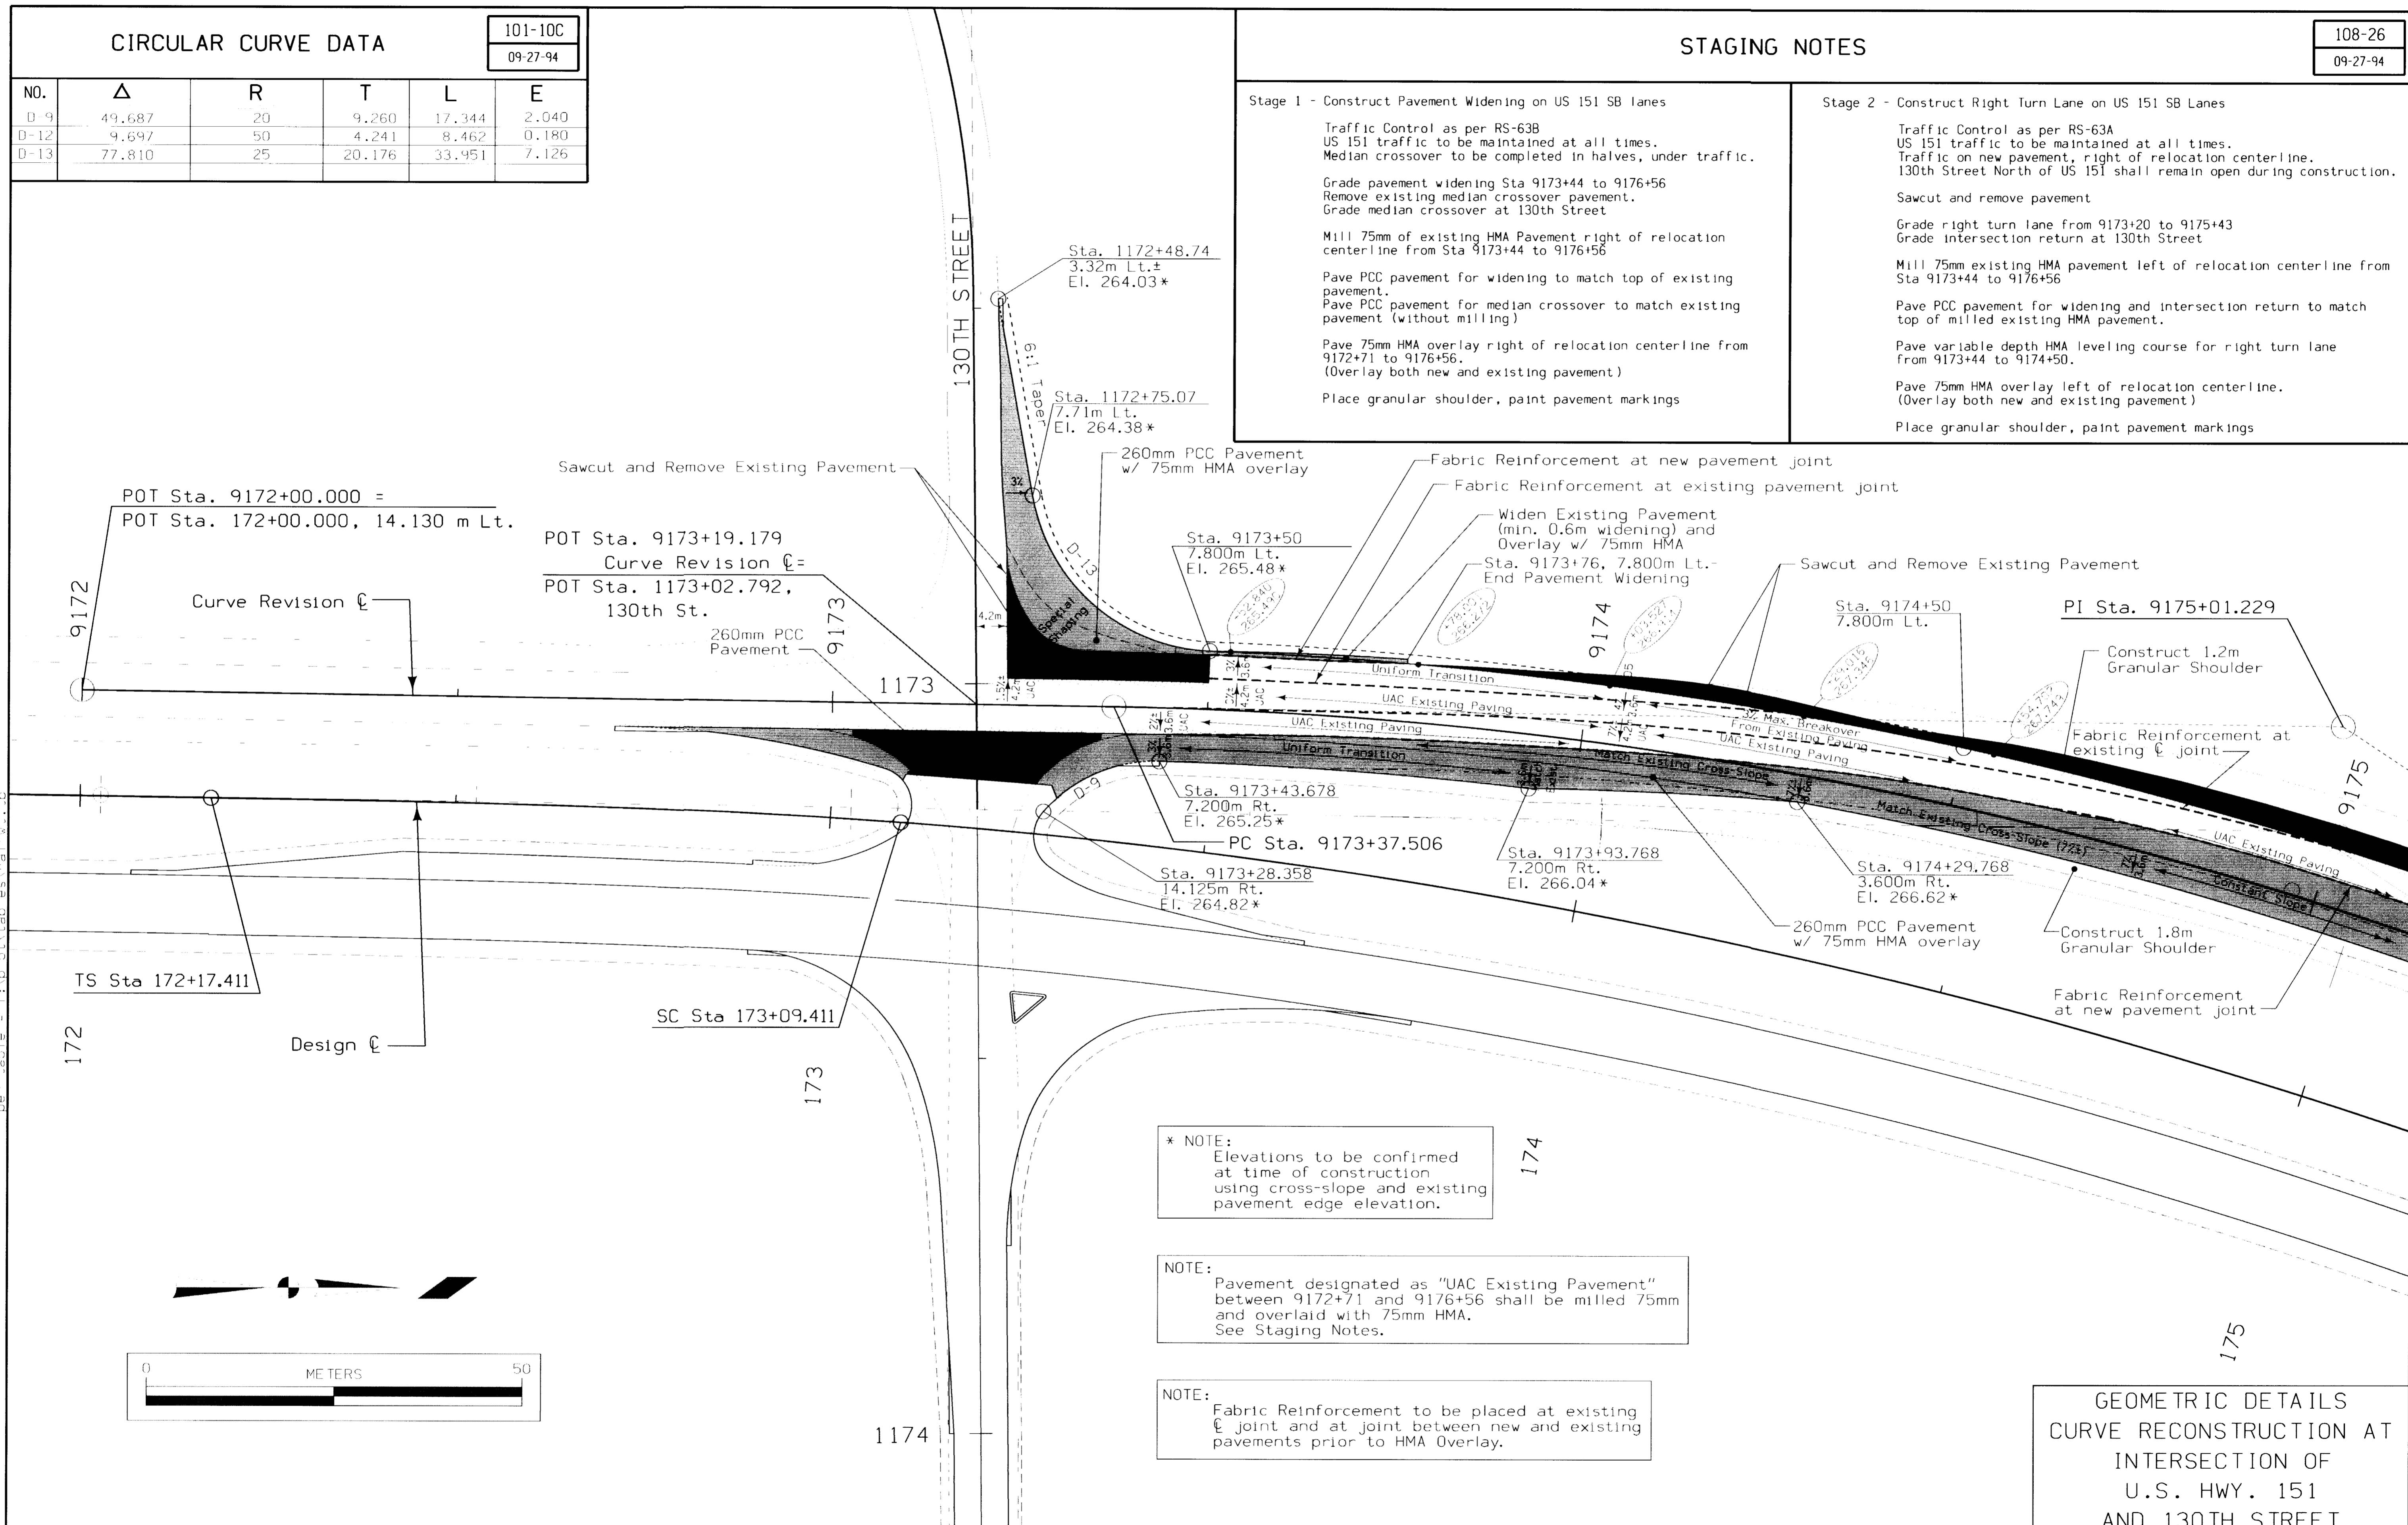

* NOTE:
Elevations to be confirmed at time of construction using cross-slope and existing pavement edge elevation.



NOTE:
Pavement designated as "UAC Existing Pavement" between 9172+71 and 9176+56 shall be milled 75mm and overlaid with 75mm HMA. See Staging Notes.

NOTE:
Fabric Reinforcement to be placed at existing ϵ joint and at joint between new and existing pavements prior to HMA Overlay.

GEOMETRIC DETAILS
CURVE RECONSTRUCTION AT
INTERSECTION OF
U.S. HWY. 151
AND 130TH STREET


I:\work\project\39922\cadd\curve\101-10C.dwg
 2004 Cranes\37151112.32
 levels = 101-10C-3C
 per table = 101-10C-3C

g:\work\project\39922\ceod\eracurve\FAVE - 2004 Changes\3715112.33
elevation 172.78, 20.2, 124.30
per scale 1:1 No of tabs es\af\w.cib

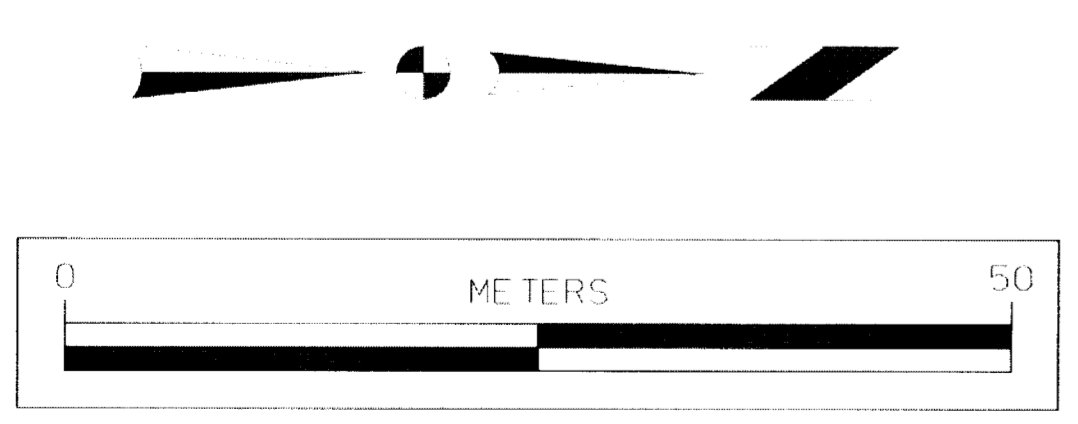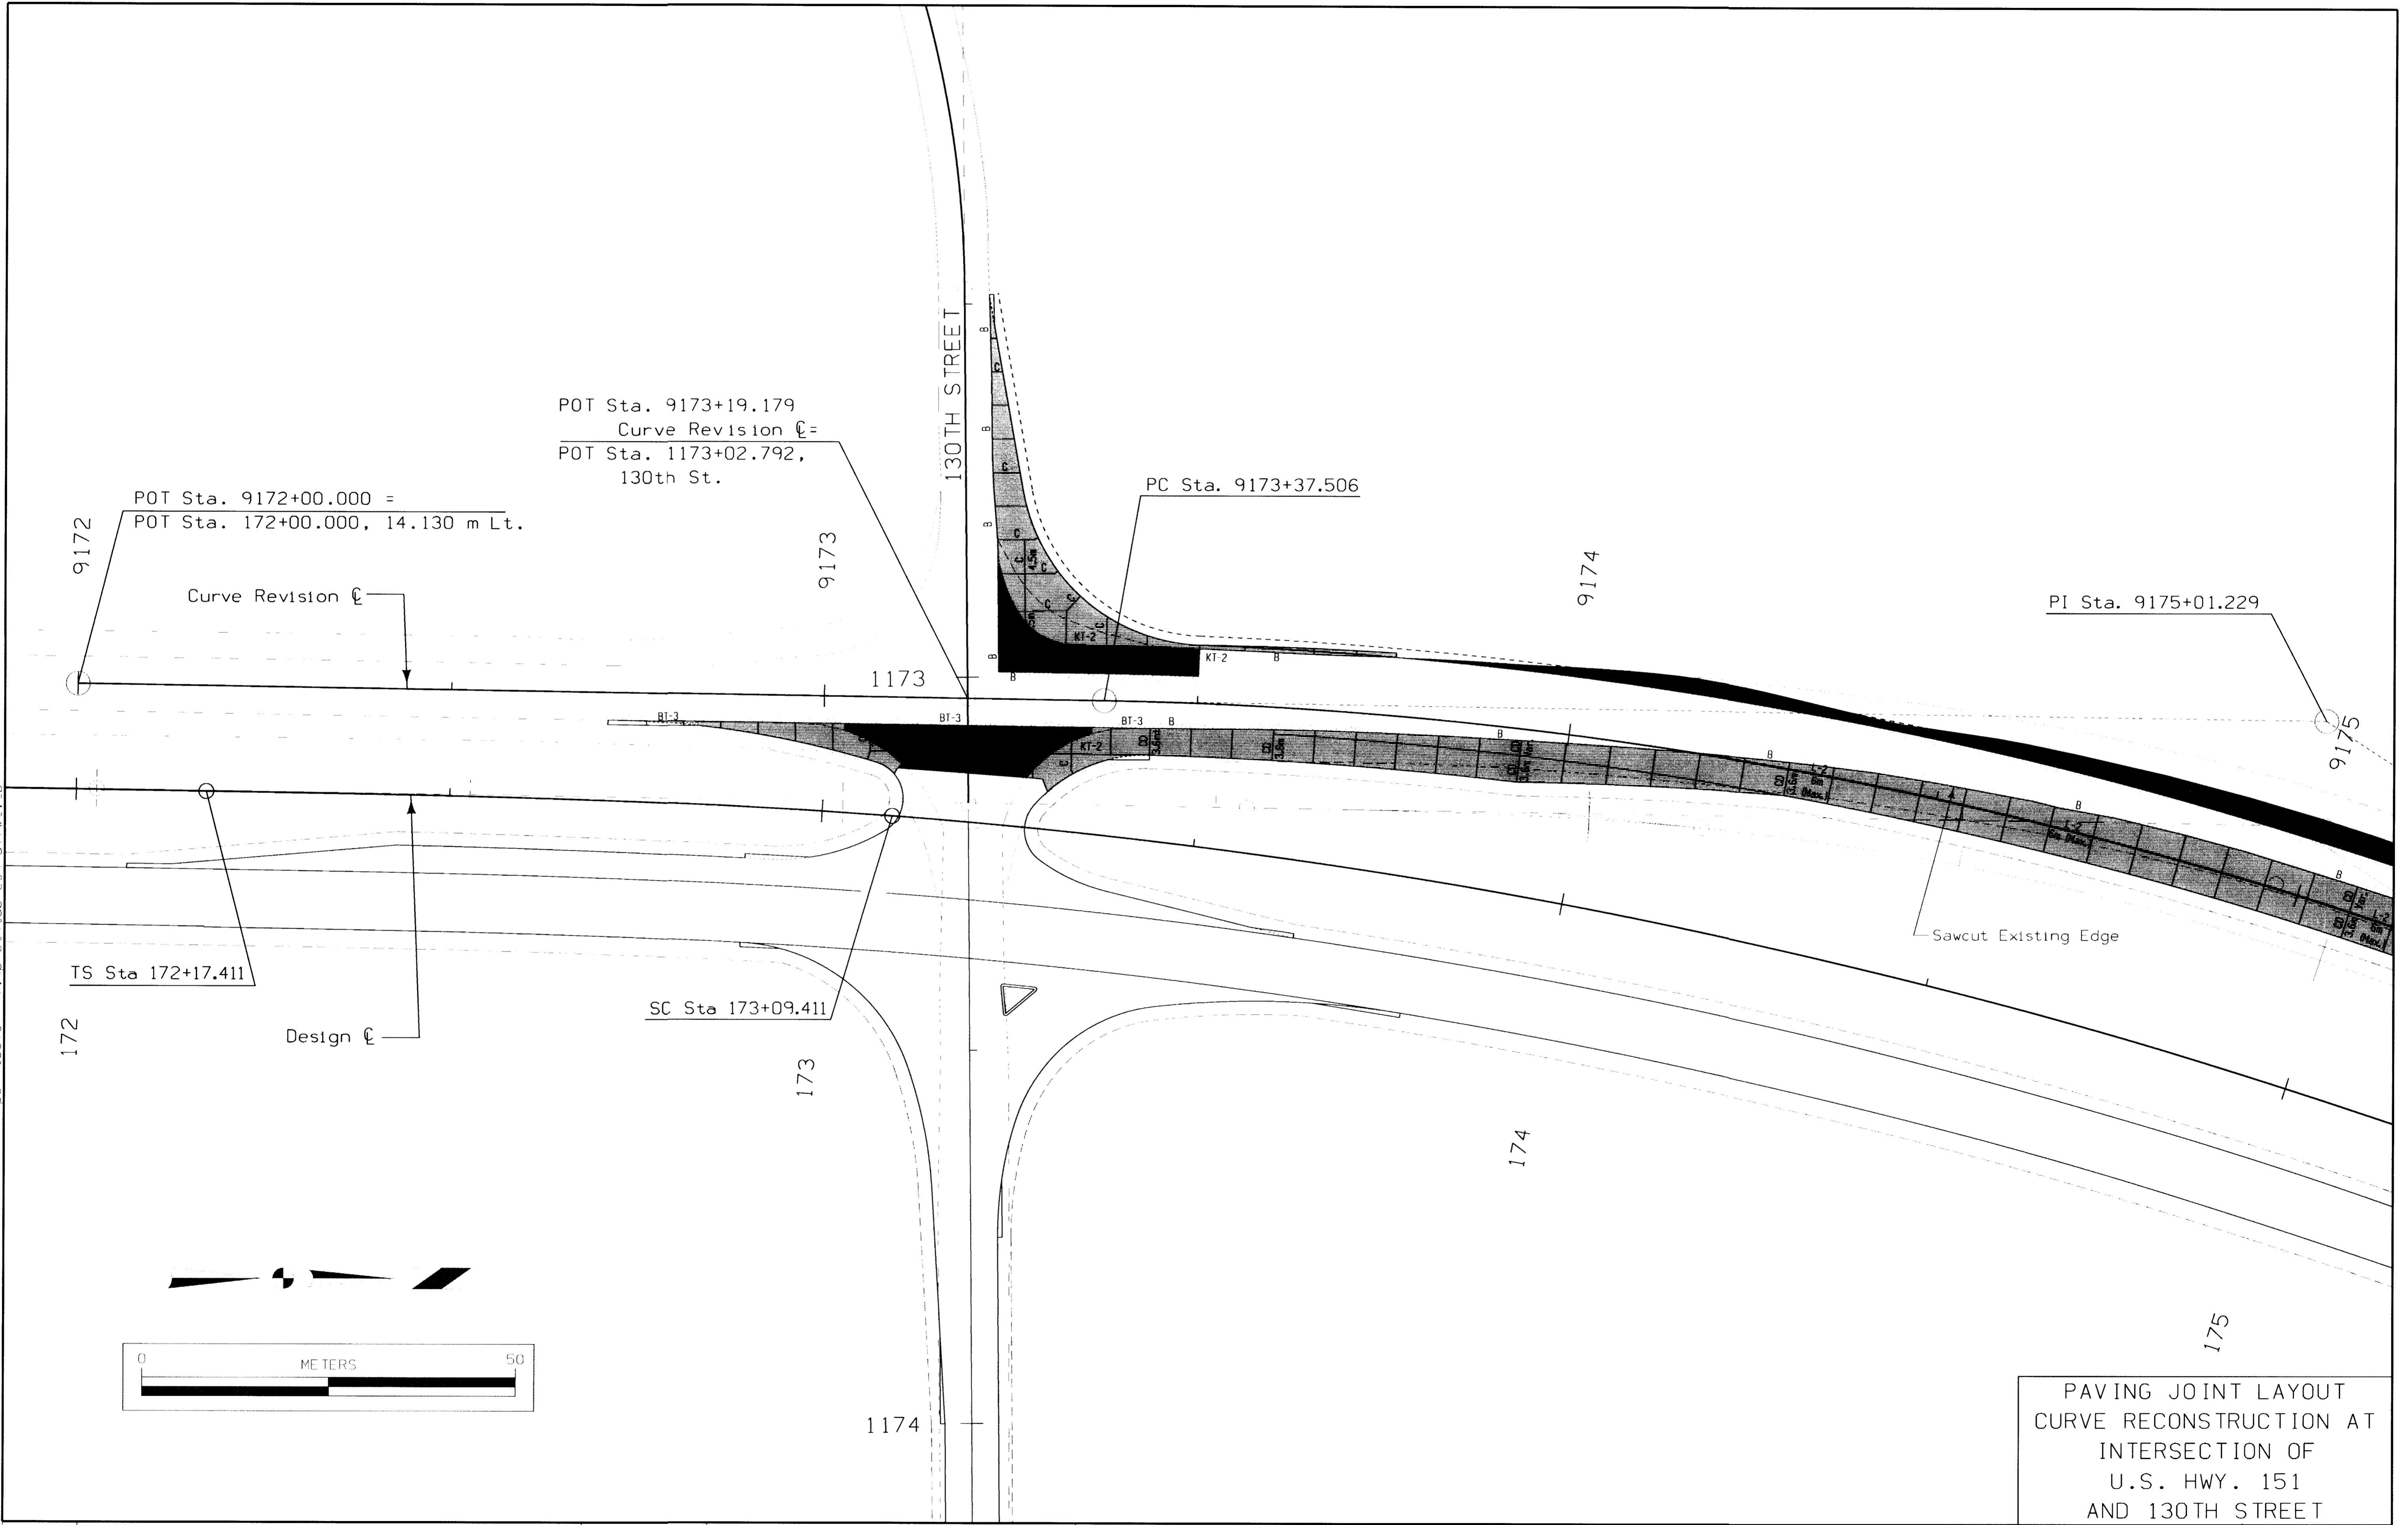


PAVING JOINT LAYOUT
CURVE RECONSTRUCTION AT
INTERSECTION OF
U.S. HWY. 151
AND 130TH STREET

GEOMETRIC DETAILS
CURVE RECONSTRUCTION AT
INTERSECTION OF
U.S. HWY. 151
AND 130TH STREET

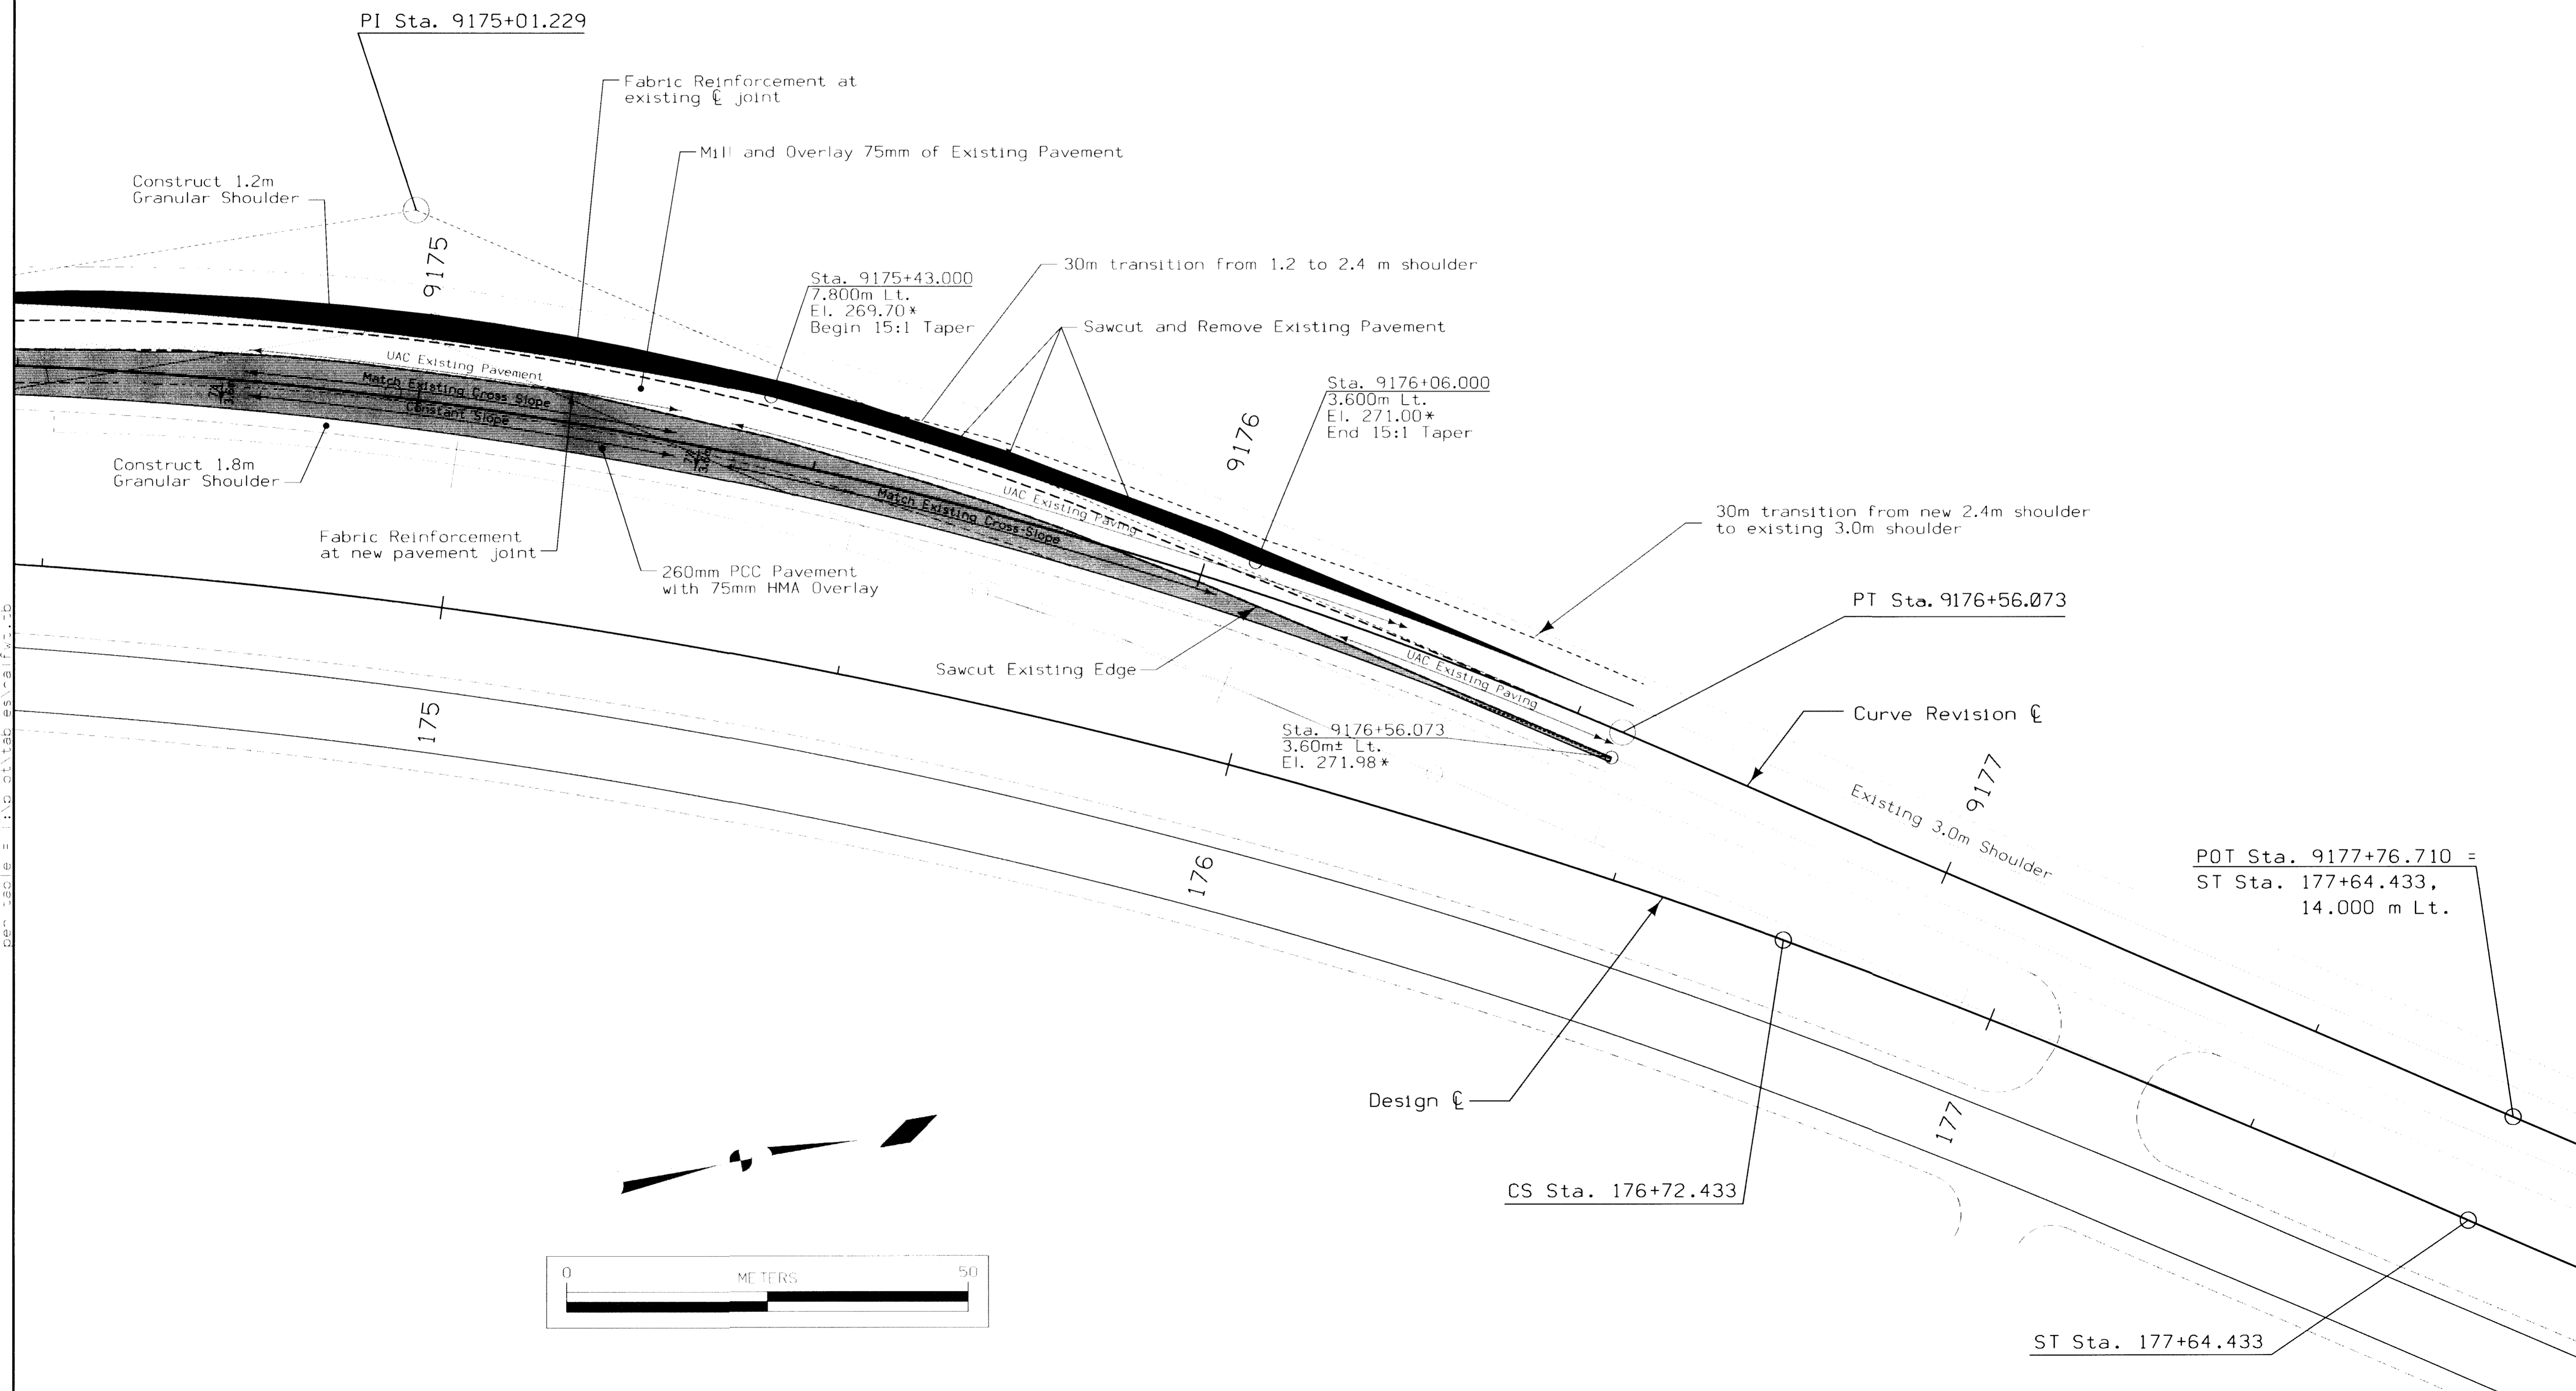



og = I:\WORK\proj\sect\39922\cadd\plan\curv\PAVE - 2004\Cargas\37:511:2.34
 elevs = 1-63
 per table = I:\B\01\tab\es\ref\vt.tbb

PAVING JOINT LAYOUT
 CURVE RECONSTRUCTION AT
 INTERSECTION OF
 U.S. HWY. 151
 AND 130TH STREET

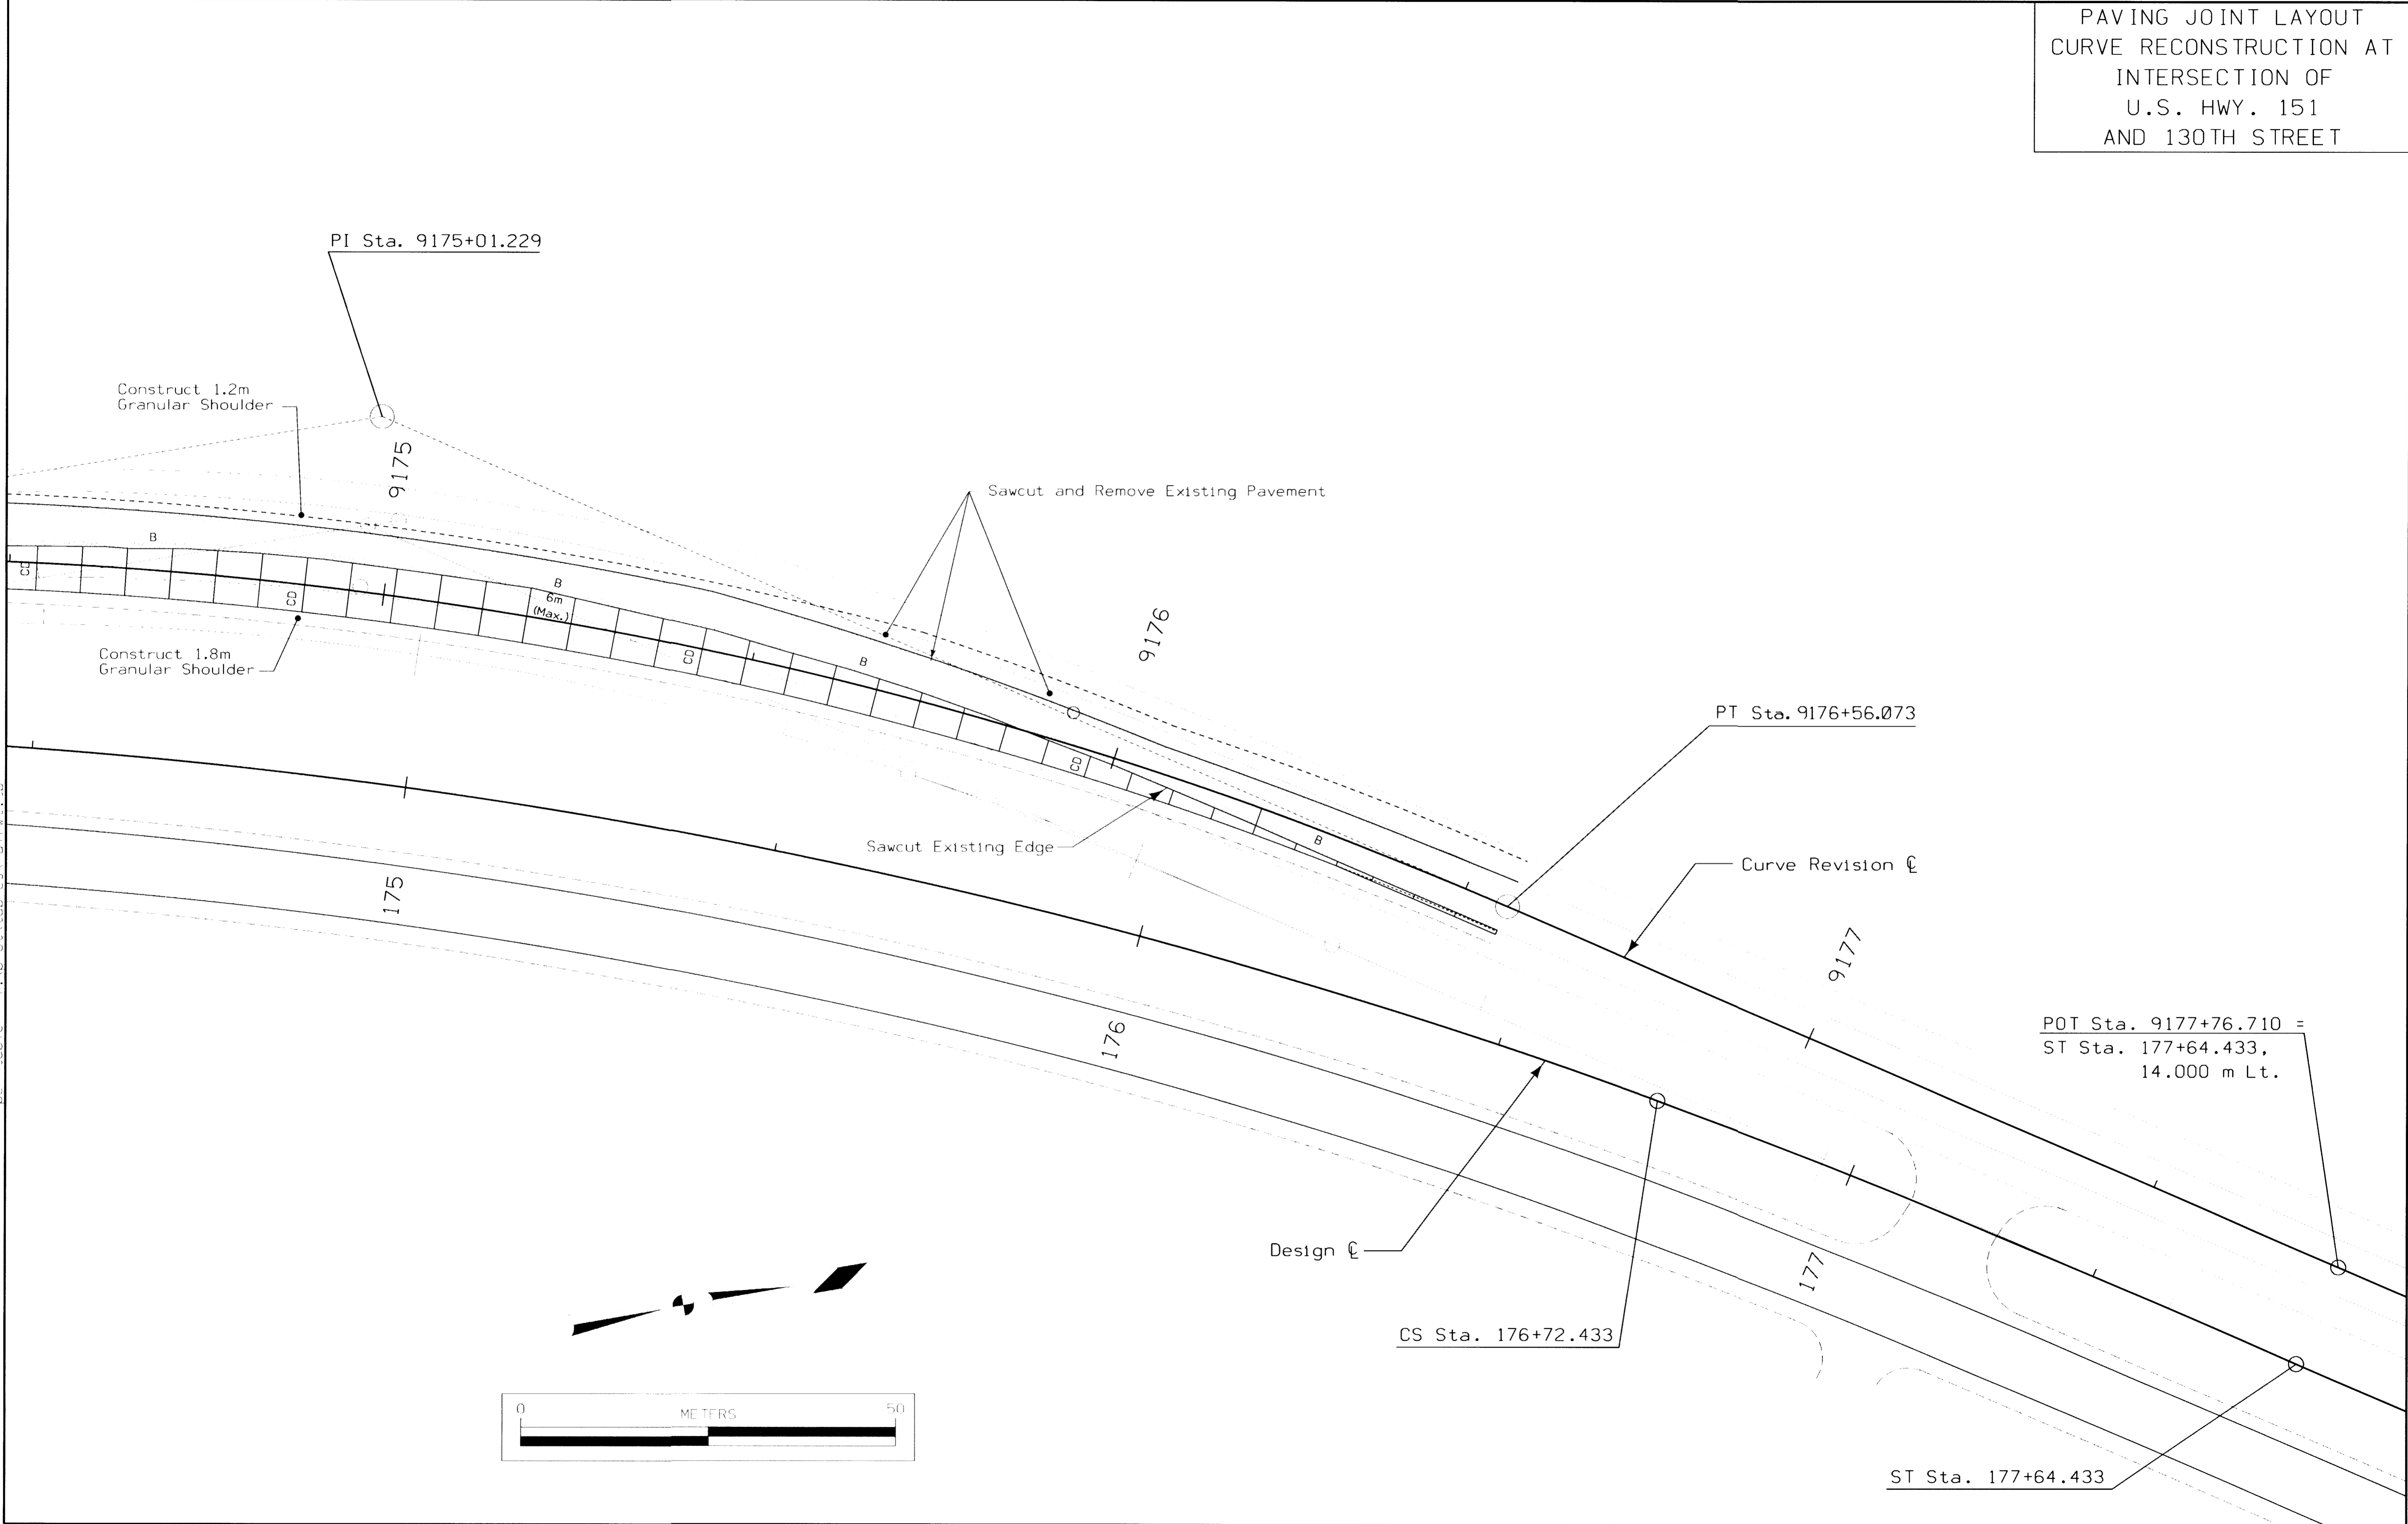

c:\wch\project\39922\asado\curve\PAVE - 2004 Changes\37151112.35
 elevs - 1-21-24-63
 per table = 1:10 of tables\ref\Fvt.10

POT Sta. 9177+76.710 =
 ST Sta. 177+64.433,
 14.000 m Lt.

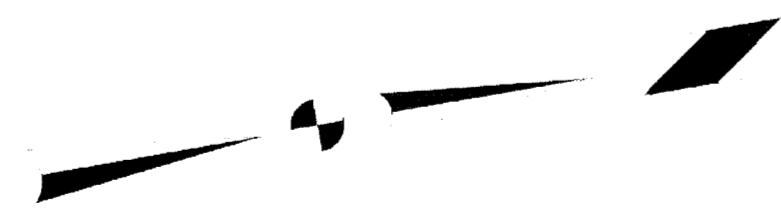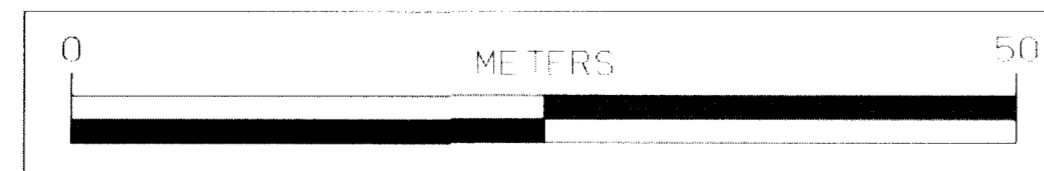

190-198

STALLION CREEK SANITARY SEWER & US 151 WATER MAIN EXTENSION


2004

CITY OF ANAMOSA, IOWA
MAYOR
JOHN HATCHER
CITY COUNCIL
BOB GEORGE, DENNIS HANSEN, BRIAN HARMON,
BERNE REICHT, HERB SPENCER & STEVE VACA
CITY ADMINISTRATOR
JOHN HALEMAN
CITY CLERK
PUBLIC WORKS DIRECTOR
LARRY BRISCOLL

UTILITY MARKING
THE UTILITIES SHOWN ON THIS PLAN HAVE BEEN LOCATED FROM FIELD SURVEY INFORMATION AND/OR
CONDUCTED IN ACCORDANCE WITH IOWA REGULATIONS AND THE IOWA DEPARTMENT OF
TRANSPORTATION. THE CITY OF ANAMOSA, IOWA, IS NOT RESPONSIBLE FOR THE ACCURACY OF THE
EXACT LOCATION INDICATED.


LEGEND

Symbol	Description
Circle with 'S'	Sanitary Sewer
Circle with 'W'	Water Main
Circle with 'E'	Electric
Circle with 'G'	Gas
Circle with 'T'	Telephone
Circle with 'C'	Cable
Circle with 'F'	Fire Hydrant
Circle with 'M'	Manhole
Circle with 'R'	Recessed Manhole
Circle with 'A'	Access Point
Circle with 'B'	Block
Circle with 'D'	Drain
Circle with 'H'	Hydrant
Circle with 'I'	Iron
Circle with 'L'	Lead
Circle with 'N'	Natural Gas
Circle with 'O'	Oil
Circle with 'P'	Propane
Circle with 'Q'	Other
Circle with 'R'	Recessed Manhole
Circle with 'S'	Sanitary Sewer
Circle with 'T'	Telephone
Circle with 'U'	Underground Utility
Circle with 'V'	Valve
Circle with 'W'	Water Main
Circle with 'X'	Other
Circle with 'Y'	Other
Circle with 'Z'	Other

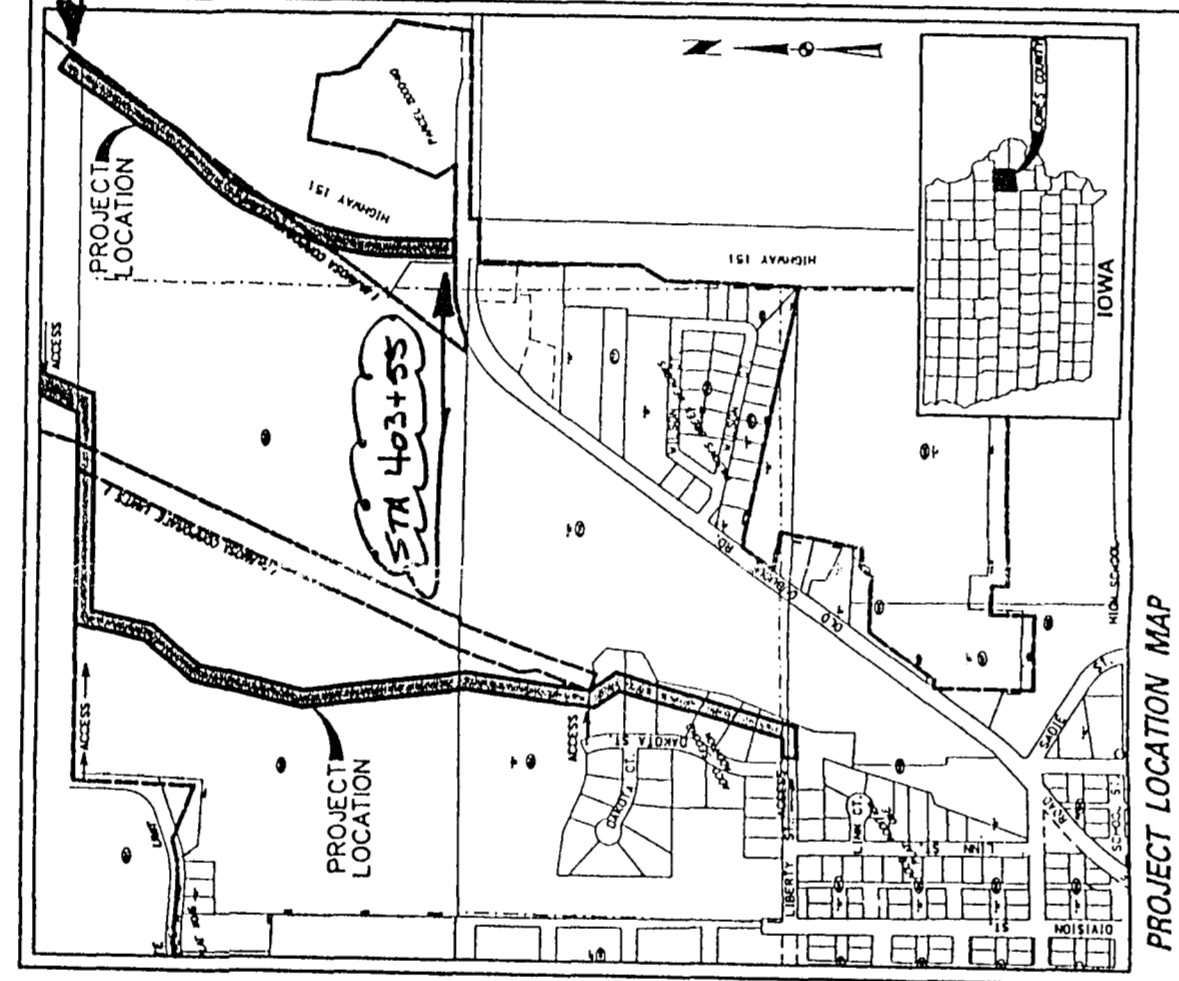

SHEET INDEX
1. GENERAL NOTES & DETAIL SHEET
2. 10" SANITARY SEWER PLAN & PROFILE
3. 10" WATER MAIN PLAN & PROFILE

3/1/04

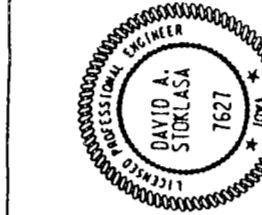


Snyder & Associates
1008 BOWLING GREEN BLVD
ANAMOSA, IOWA 50003
TEL: 562-2222 FAX: 562-2223
WWW.SNYSR.COM

**STATION CREEK SANITARY SEWER
& US 151 WATER MAIN EXTENSION**

Sheet 1 of 14
CRD-256

5311-8004-01 Permit #
State for about work
without 30th/Dubuque Road
is included in ASBUC
S/S

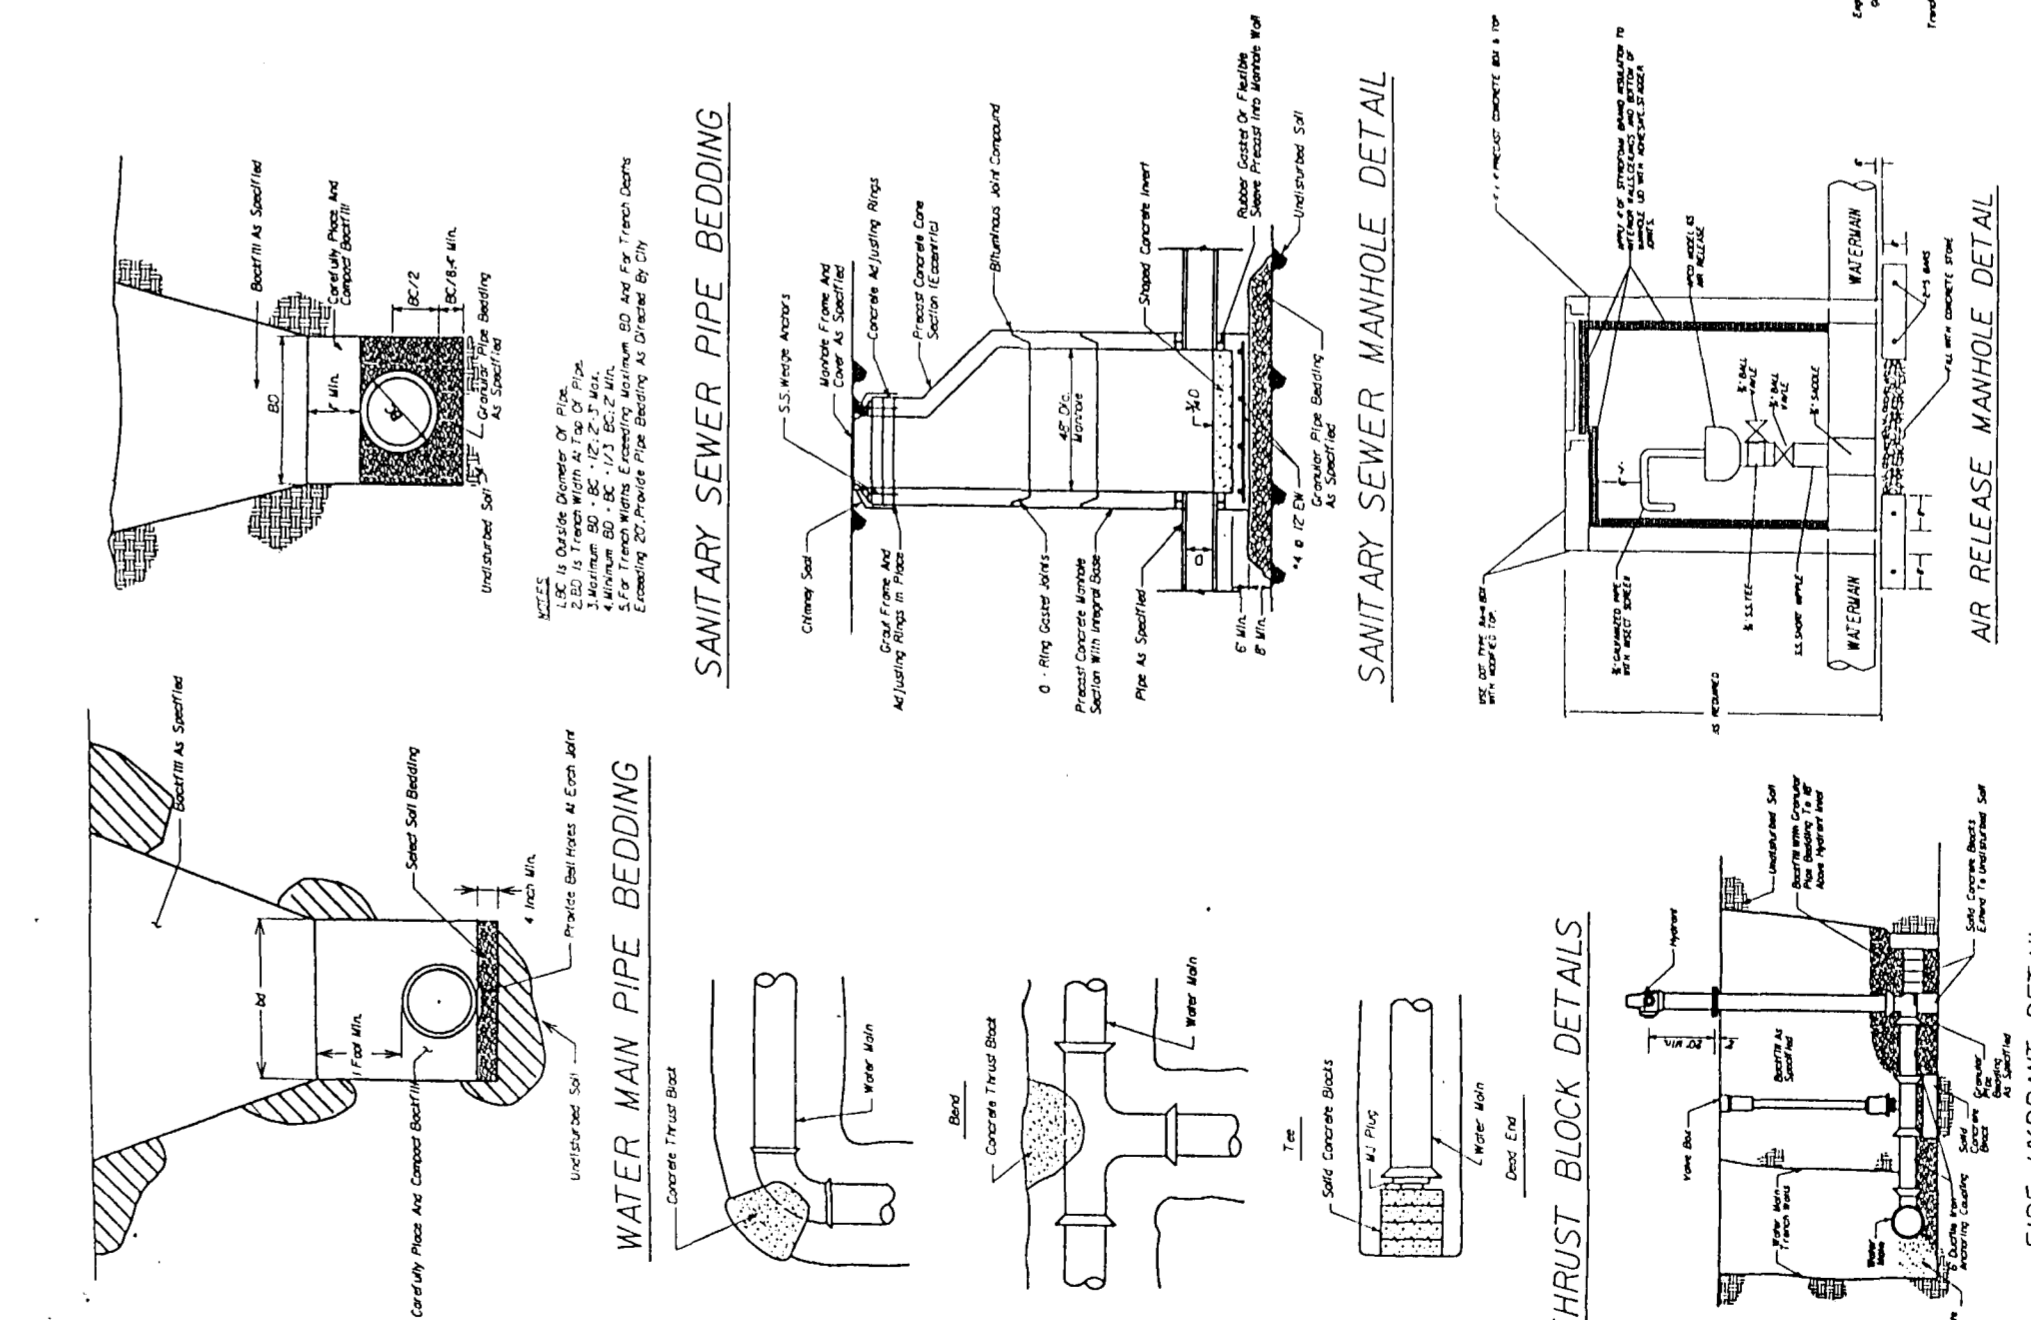

Snyder & Associates
1008 BOWLING GREEN BLVD
ANAMOSA, IOWA 50003
TEL: 562-2222 FAX: 562-2223
WWW.SNYSR.COM

**STATION CREEK SANITARY SEWER
& US 151 WATER MAIN EXTENSION**

Sheet 2 of 14
CRD-256

1. SITE DESCRIPTION
This project is for the installation of 10" S.D. Sanitary Sewer, 10" S.D. Water Main, and 10" S.D. Water Main. The project is located in the City of Anamosa, Iowa. The project area is approximately 7.5 acre. The project is located on the east side of the city, between 151st Street and 152nd Street. The project is located on the east side of the city, between 151st Street and 152nd Street. The project is located on the east side of the city, between 151st Street and 152nd Street.



2. CONVICTIONS
All locations where utility lines are located shall be marked and identified. The contractor shall be responsible for identifying and marking all utility lines. The contractor shall be responsible for identifying and marking all utility lines. The contractor shall be responsible for identifying and marking all utility lines.

3. OTHER COMMENTS
The contractor shall be responsible for obtaining all necessary permits. The contractor shall be responsible for obtaining all necessary permits. The contractor shall be responsible for obtaining all necessary permits.

4. MAINTENANCE
The contractor shall be responsible for maintaining all installed equipment. The contractor shall be responsible for maintaining all installed equipment. The contractor shall be responsible for maintaining all installed equipment.


5. INSPECTIONS
The contractor shall be responsible for scheduling all inspections. The contractor shall be responsible for scheduling all inspections. The contractor shall be responsible for scheduling all inspections.

6. UNUSUAL CONDITIONS
The contractor shall be responsible for identifying and reporting all unusual conditions. The contractor shall be responsible for identifying and reporting all unusual conditions. The contractor shall be responsible for identifying and reporting all unusual conditions.

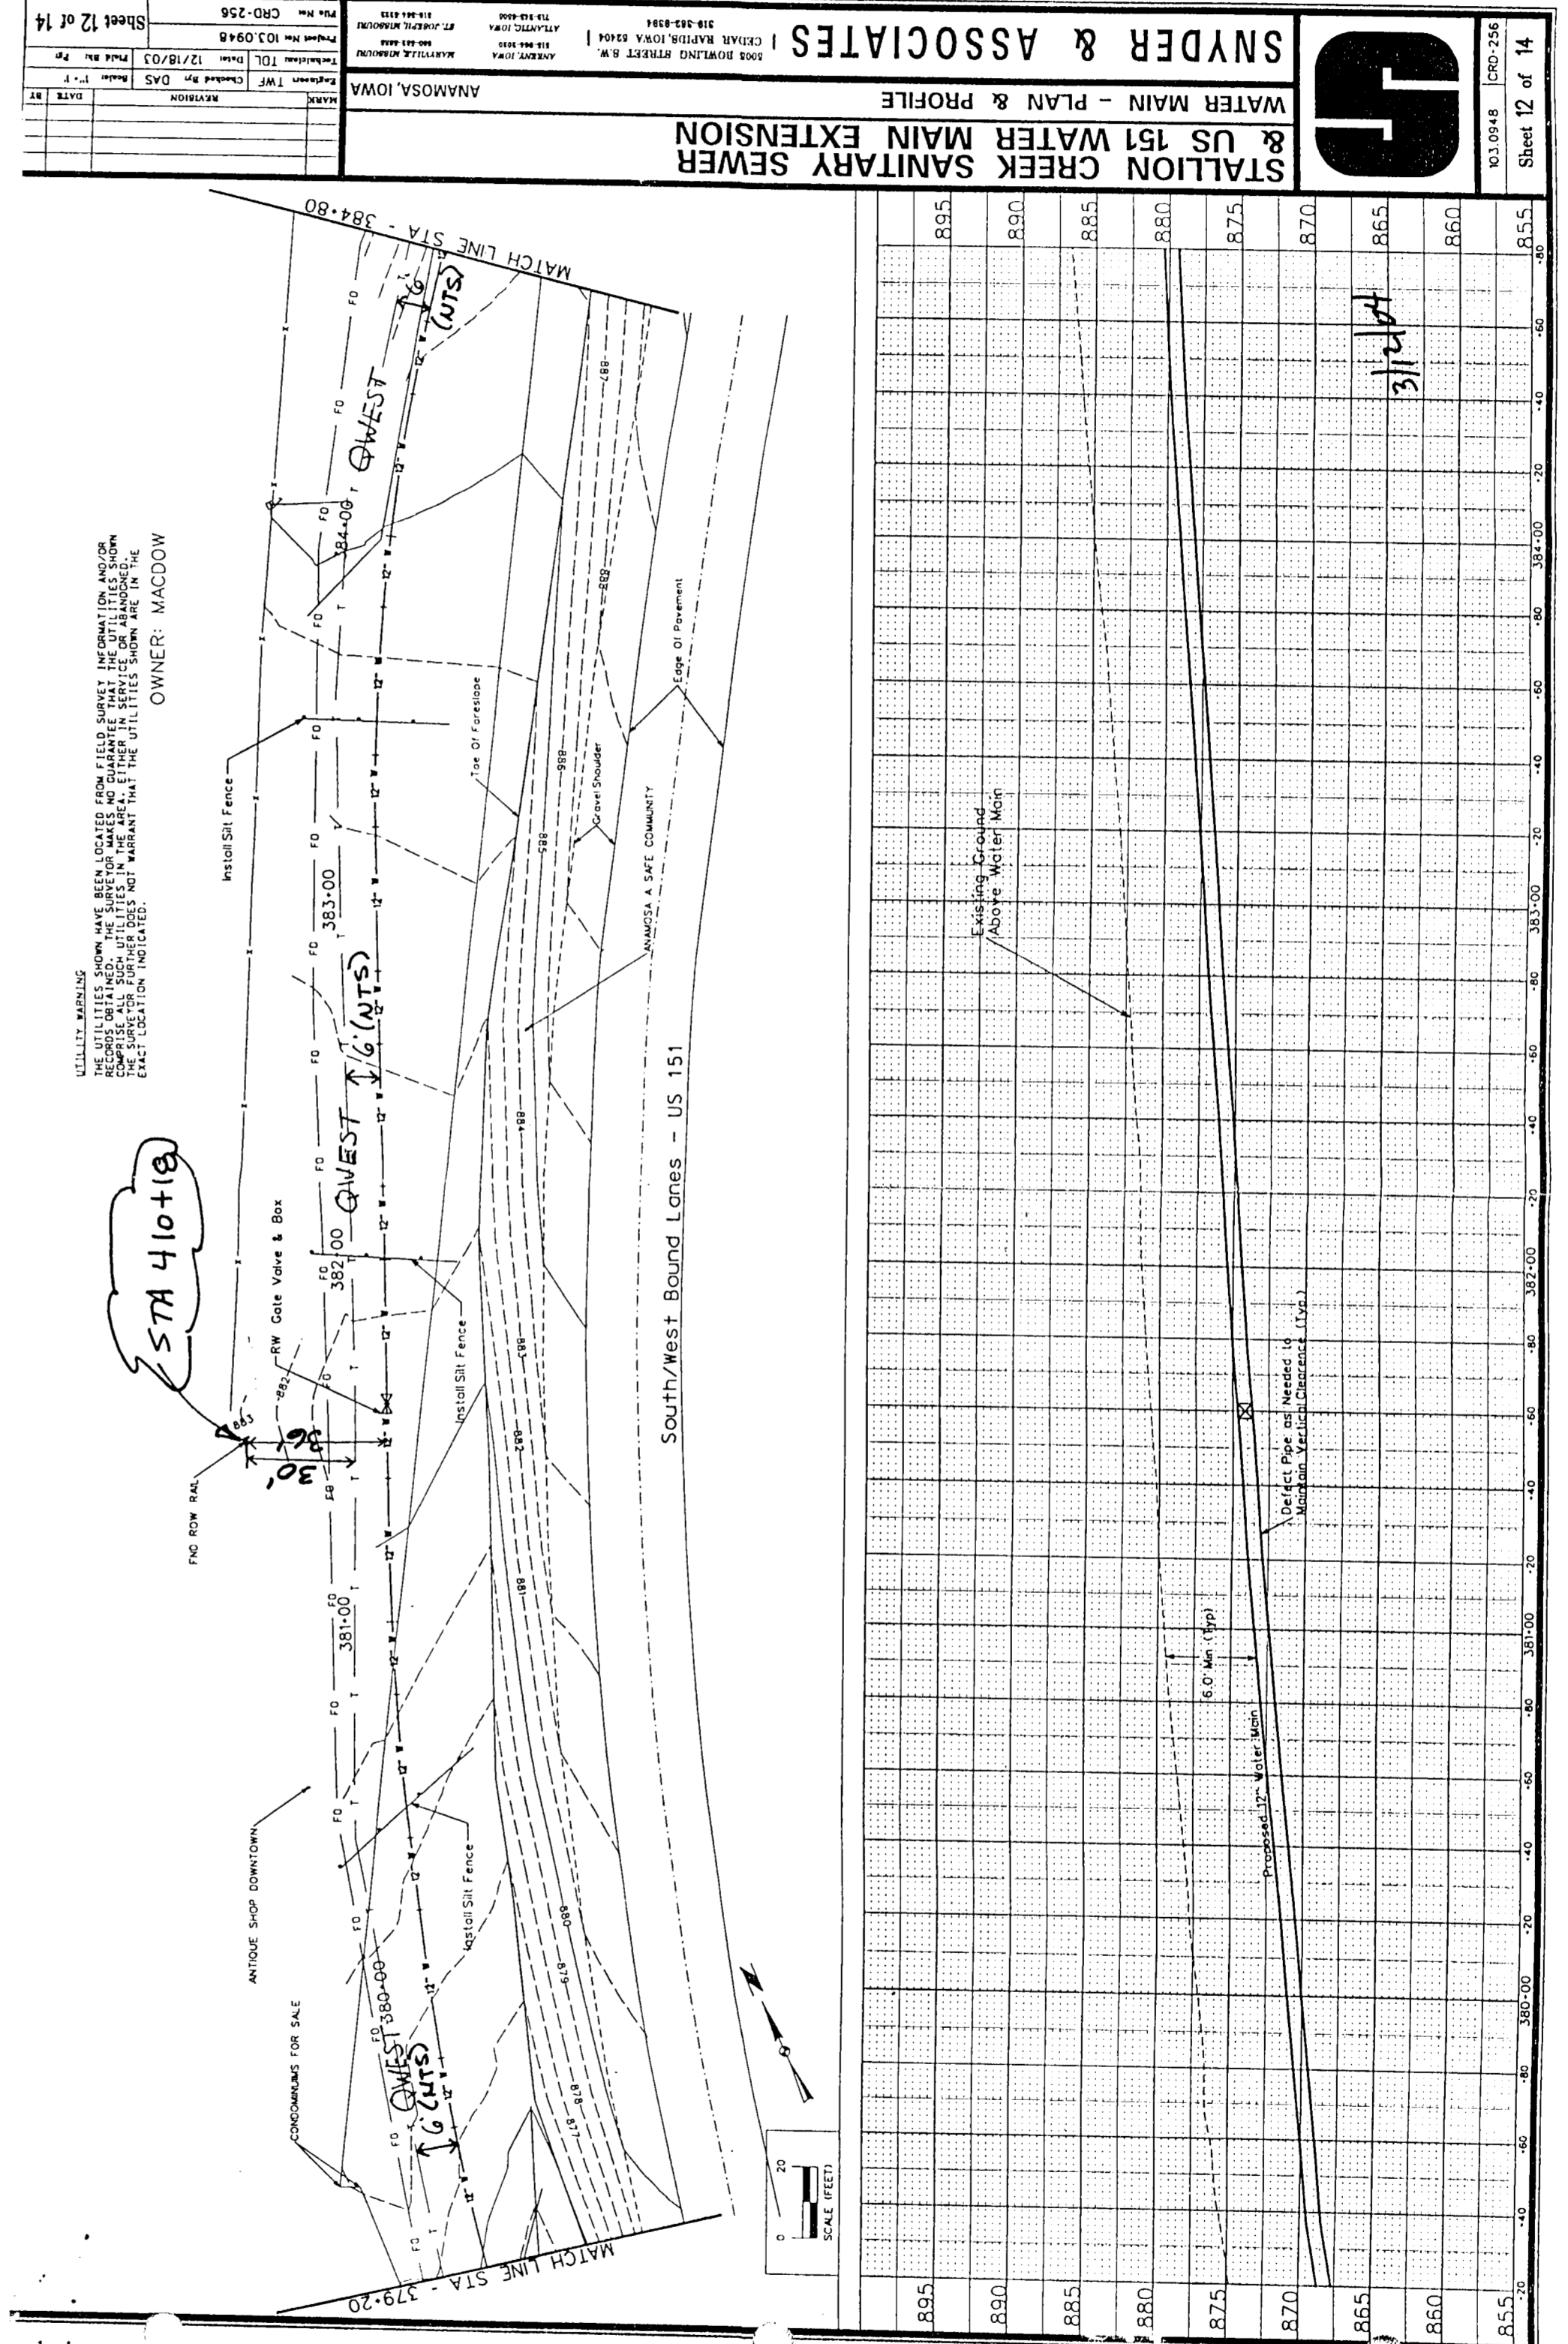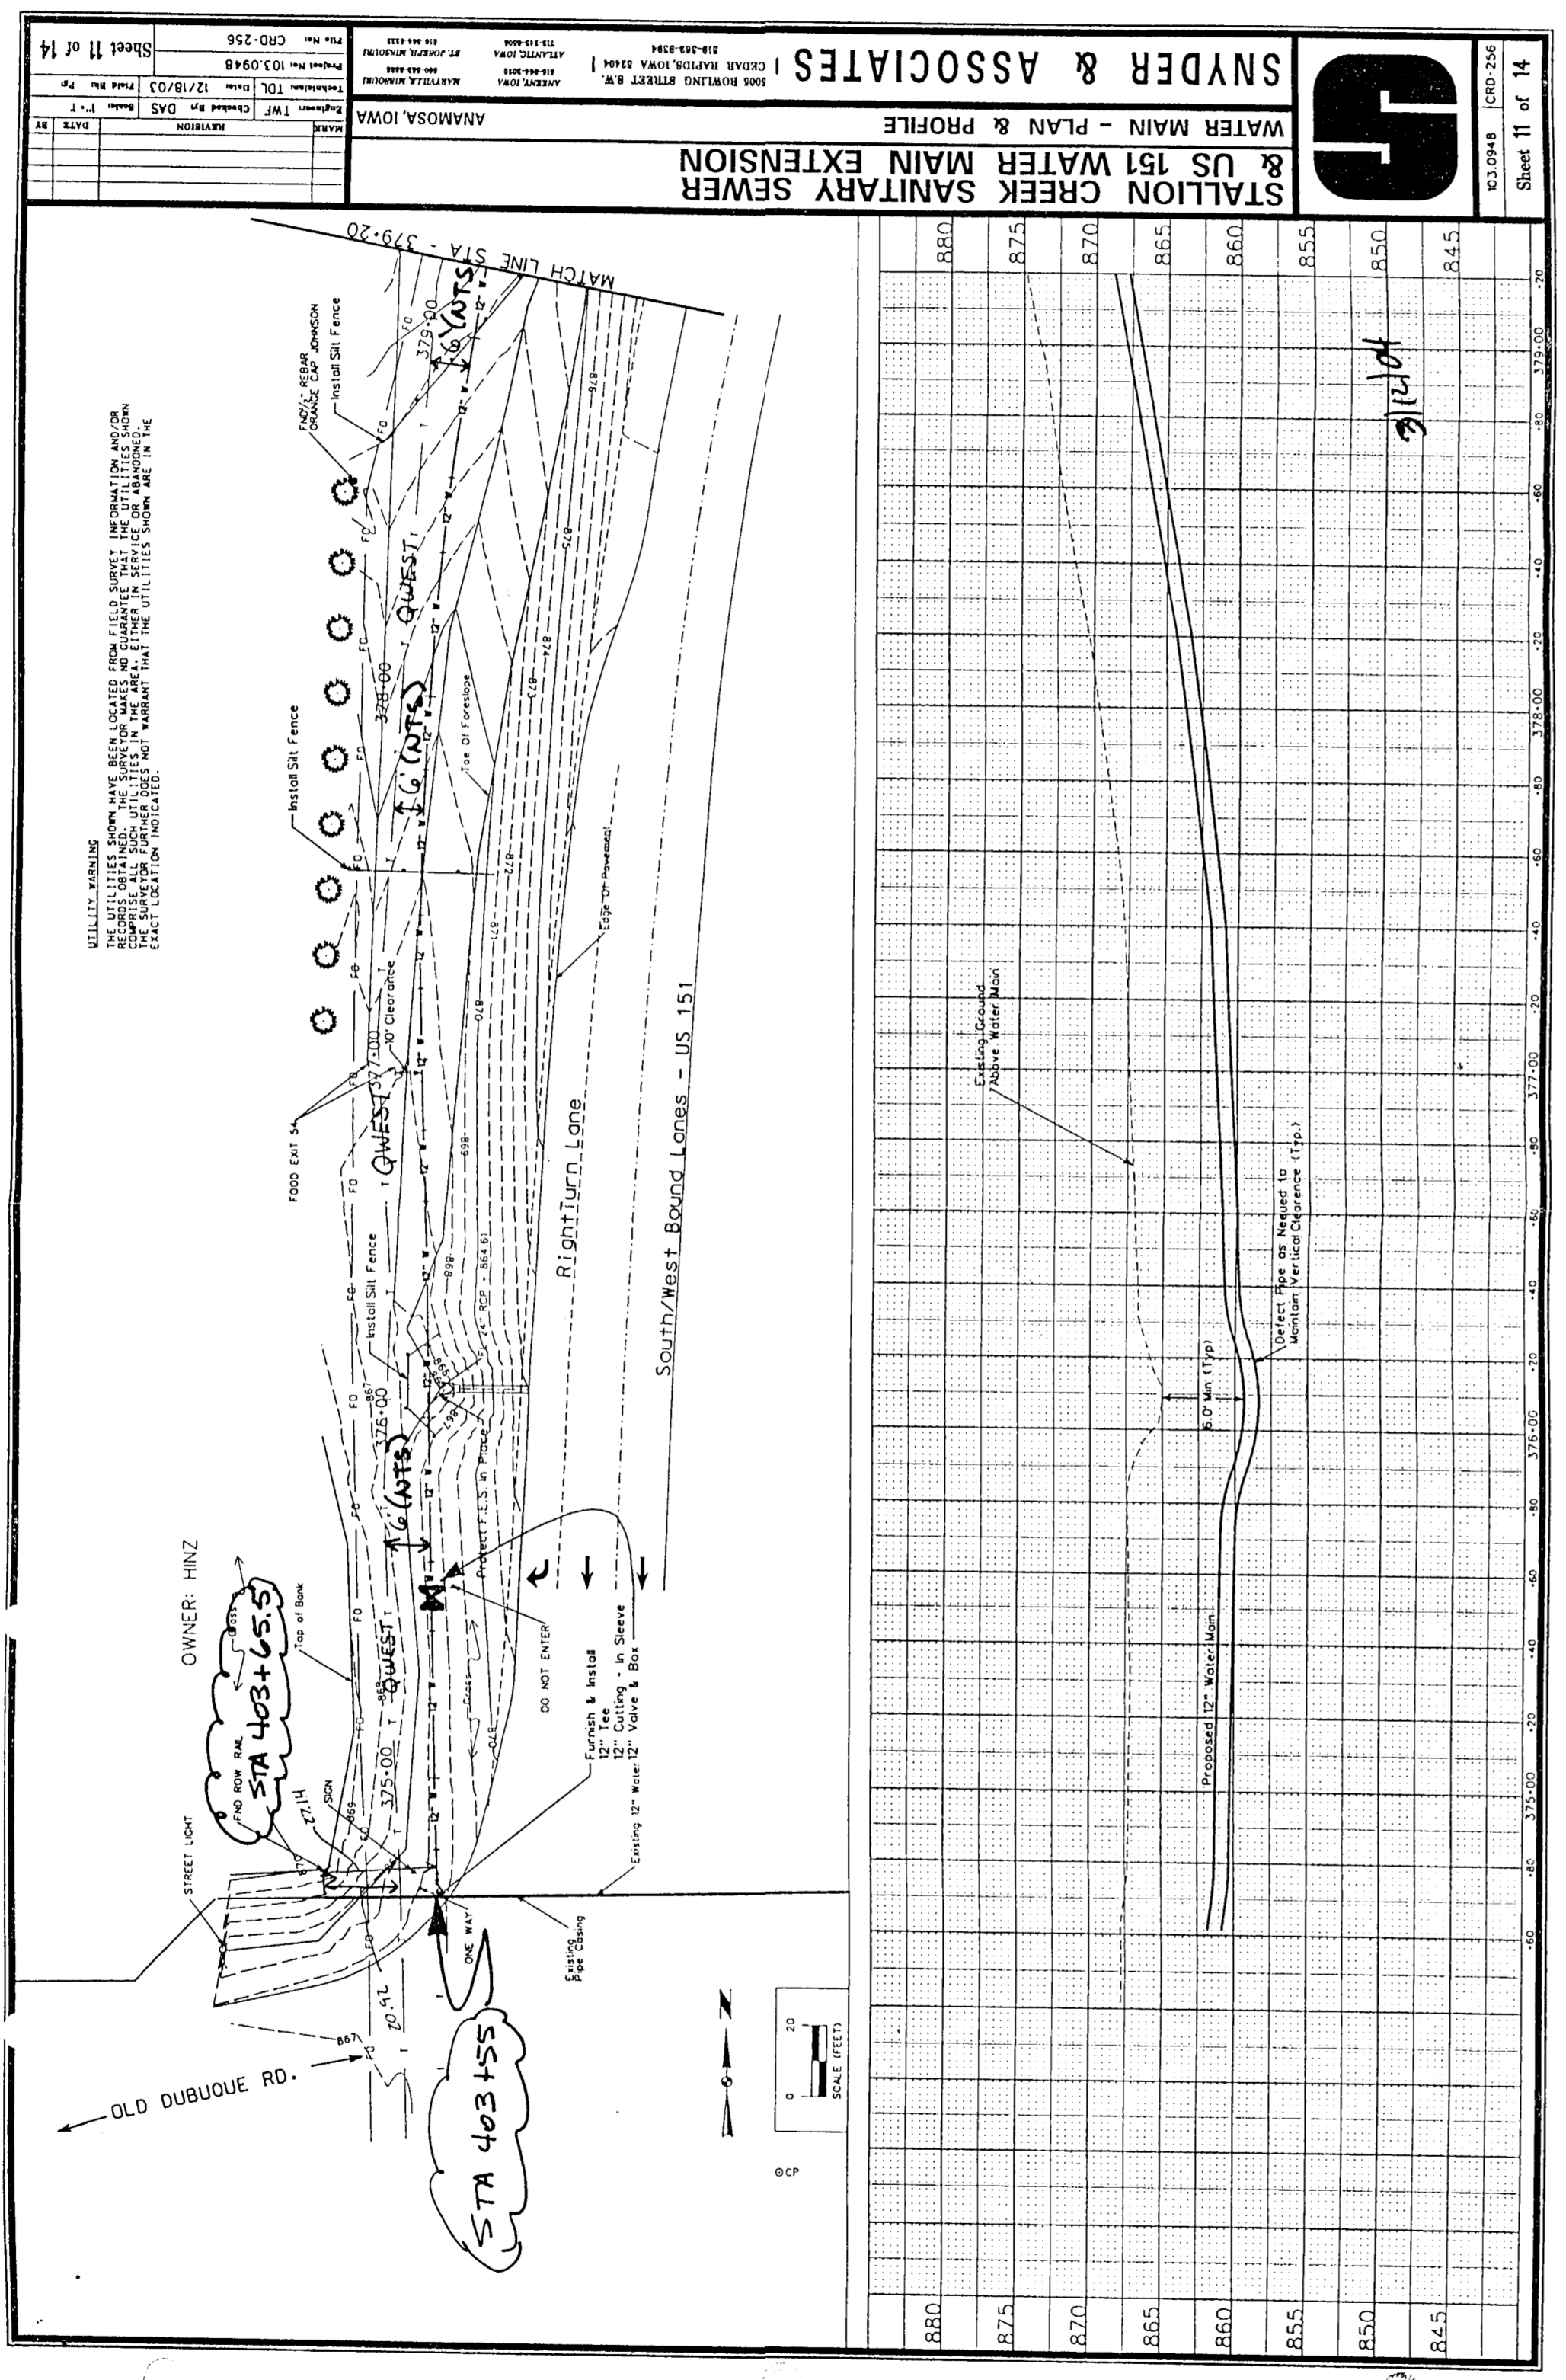


STALLION CREEK SANITARY SEWER & US 151 WATER MAIN EXTENSION
 WATER MAIN - PLAN & PROFILE
 SNYDER & ASSOCIATES
 ANAMOSA, IOWA
 SHEET 11 OF 14

STALLION CREEK SANITARY SEWER & US 151 WATER MAIN EXTENSION
 WATER MAIN - PLAN & PROFILE
 SNYDER & ASSOCIATES
 ANAMOSA, IOWA
 SHEET 12 OF 14

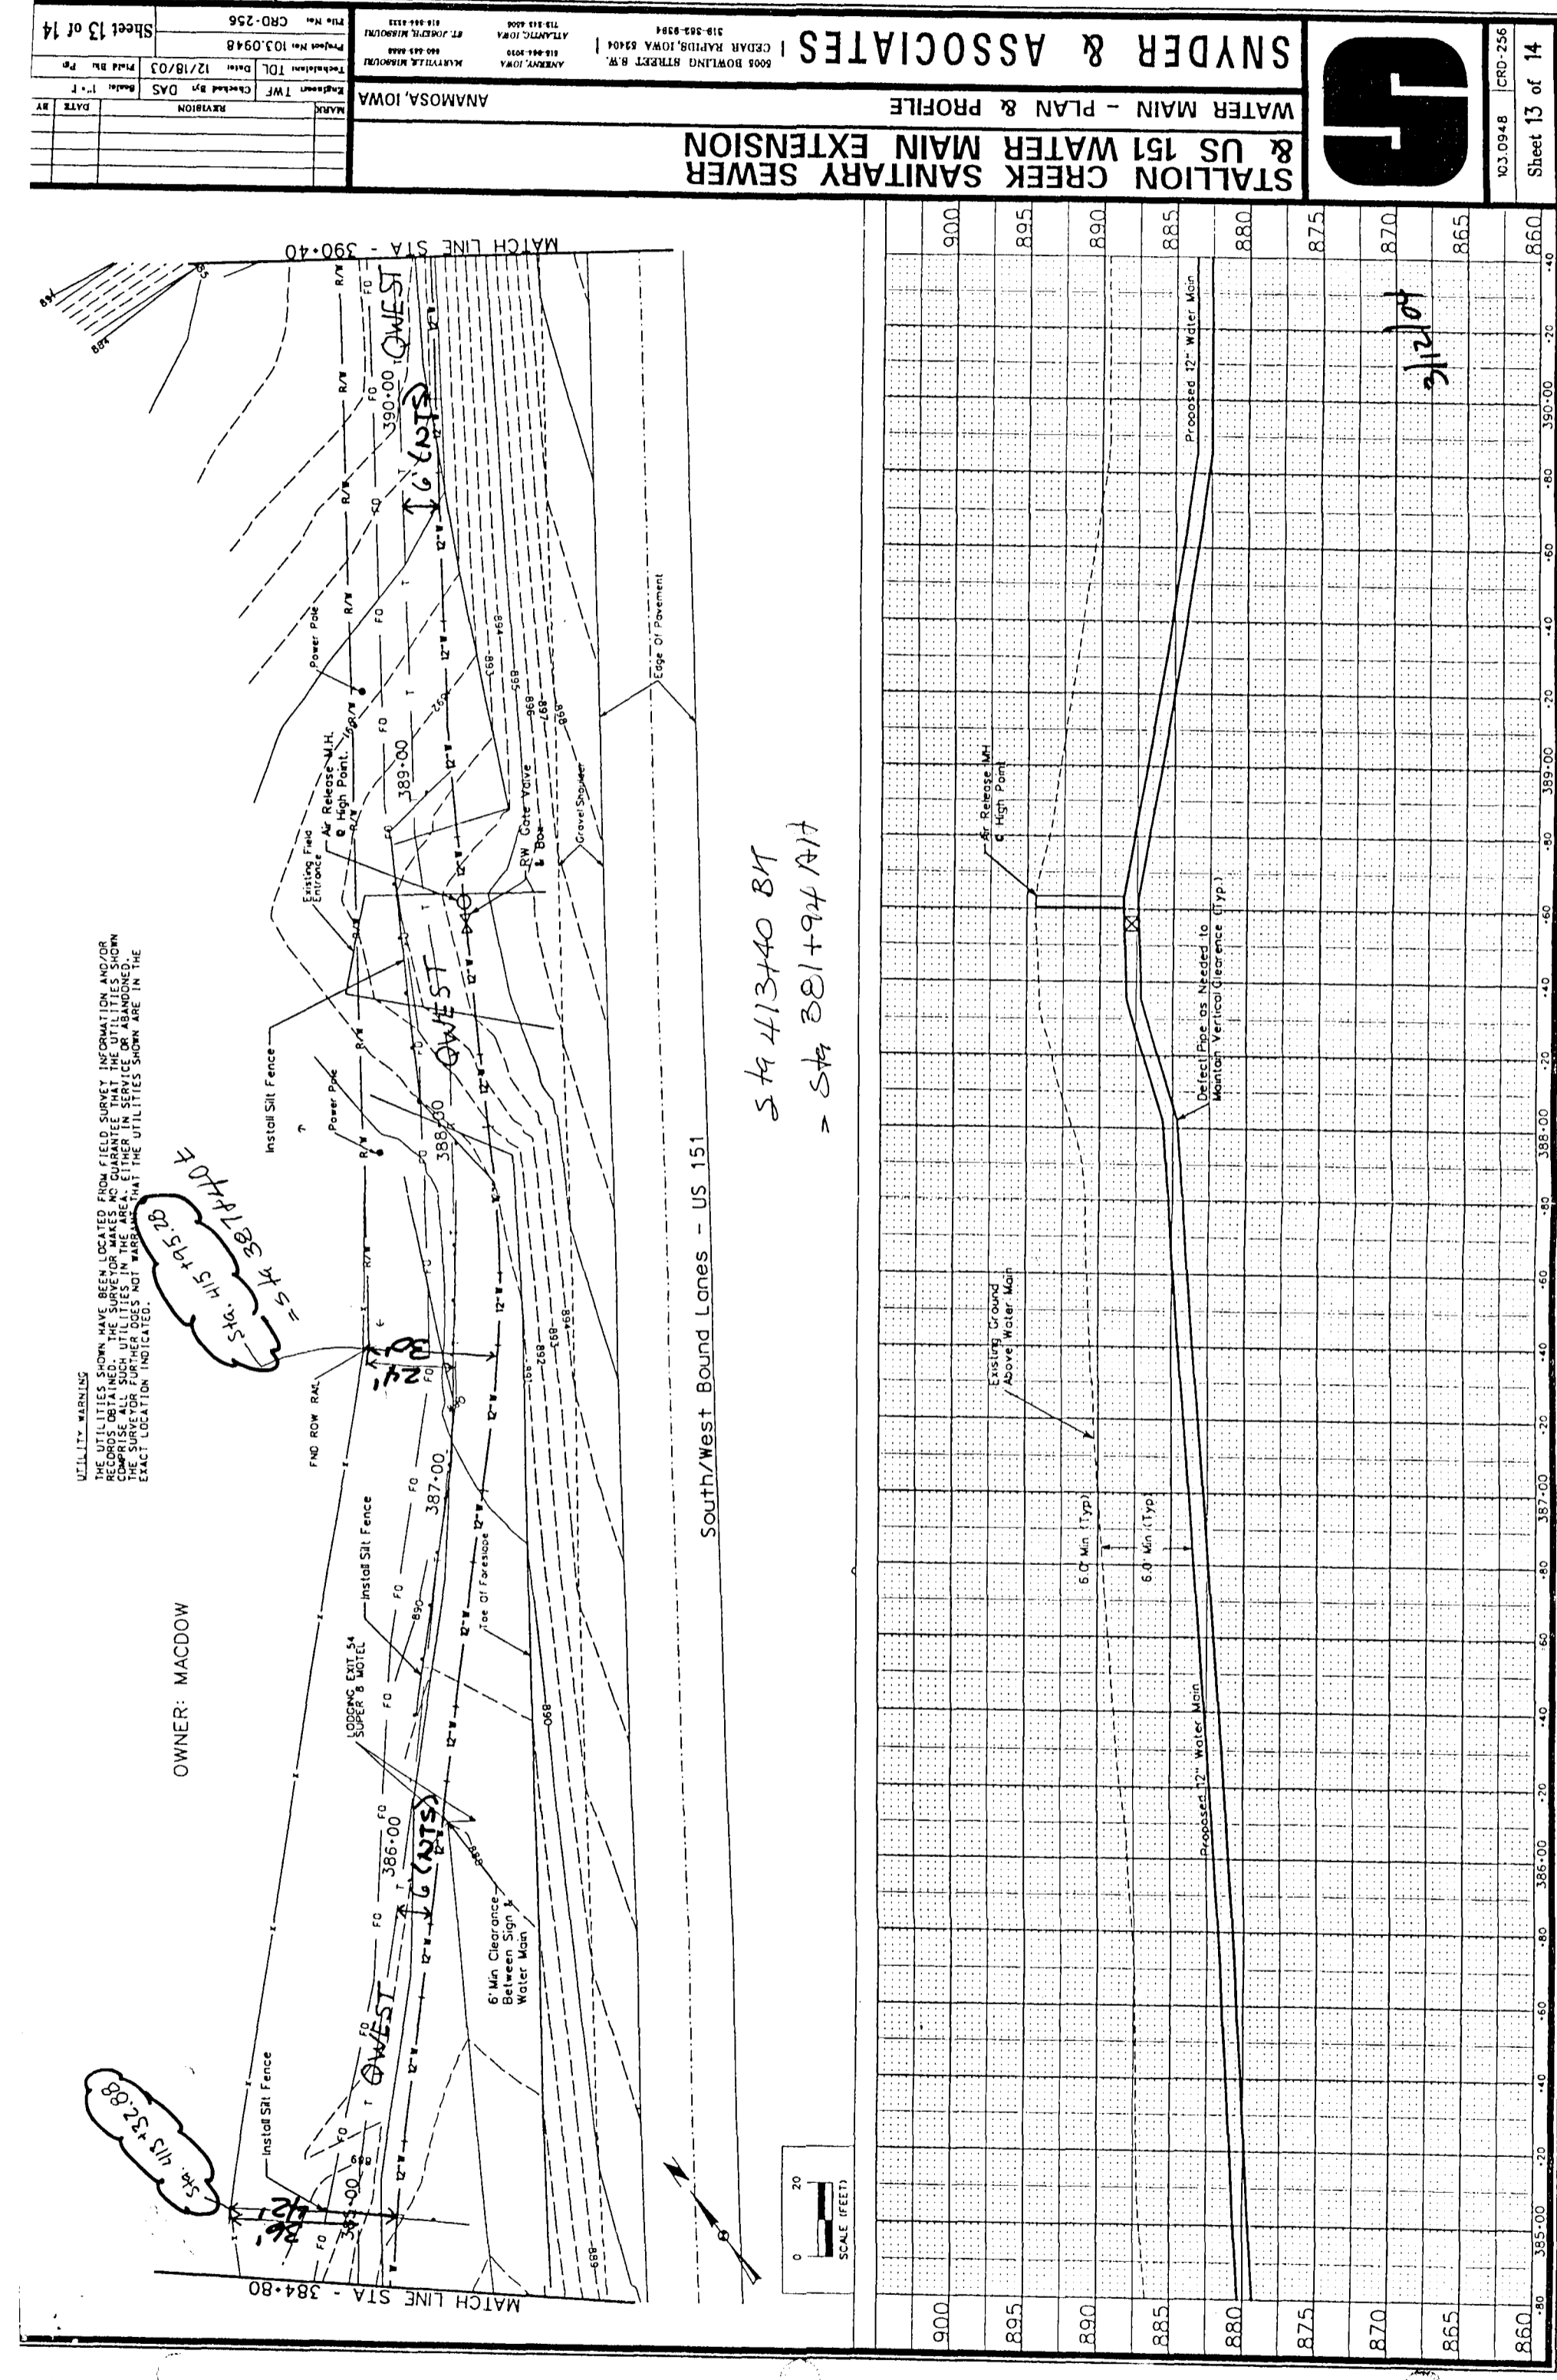

S SNYDER & ASSOCIATES
 808 BOWLING STREET SE
 CEDAR RAPIDS, IOWA 52401
 PHONE: 319.265.1111
 FAX: 319.265.1112
 PROJECT NO. 02.0948
 SHEET NO. 13 OF 14
 DATE: 12/18/03
 DRAWN BY: JAS
 CHECKED BY: TWF

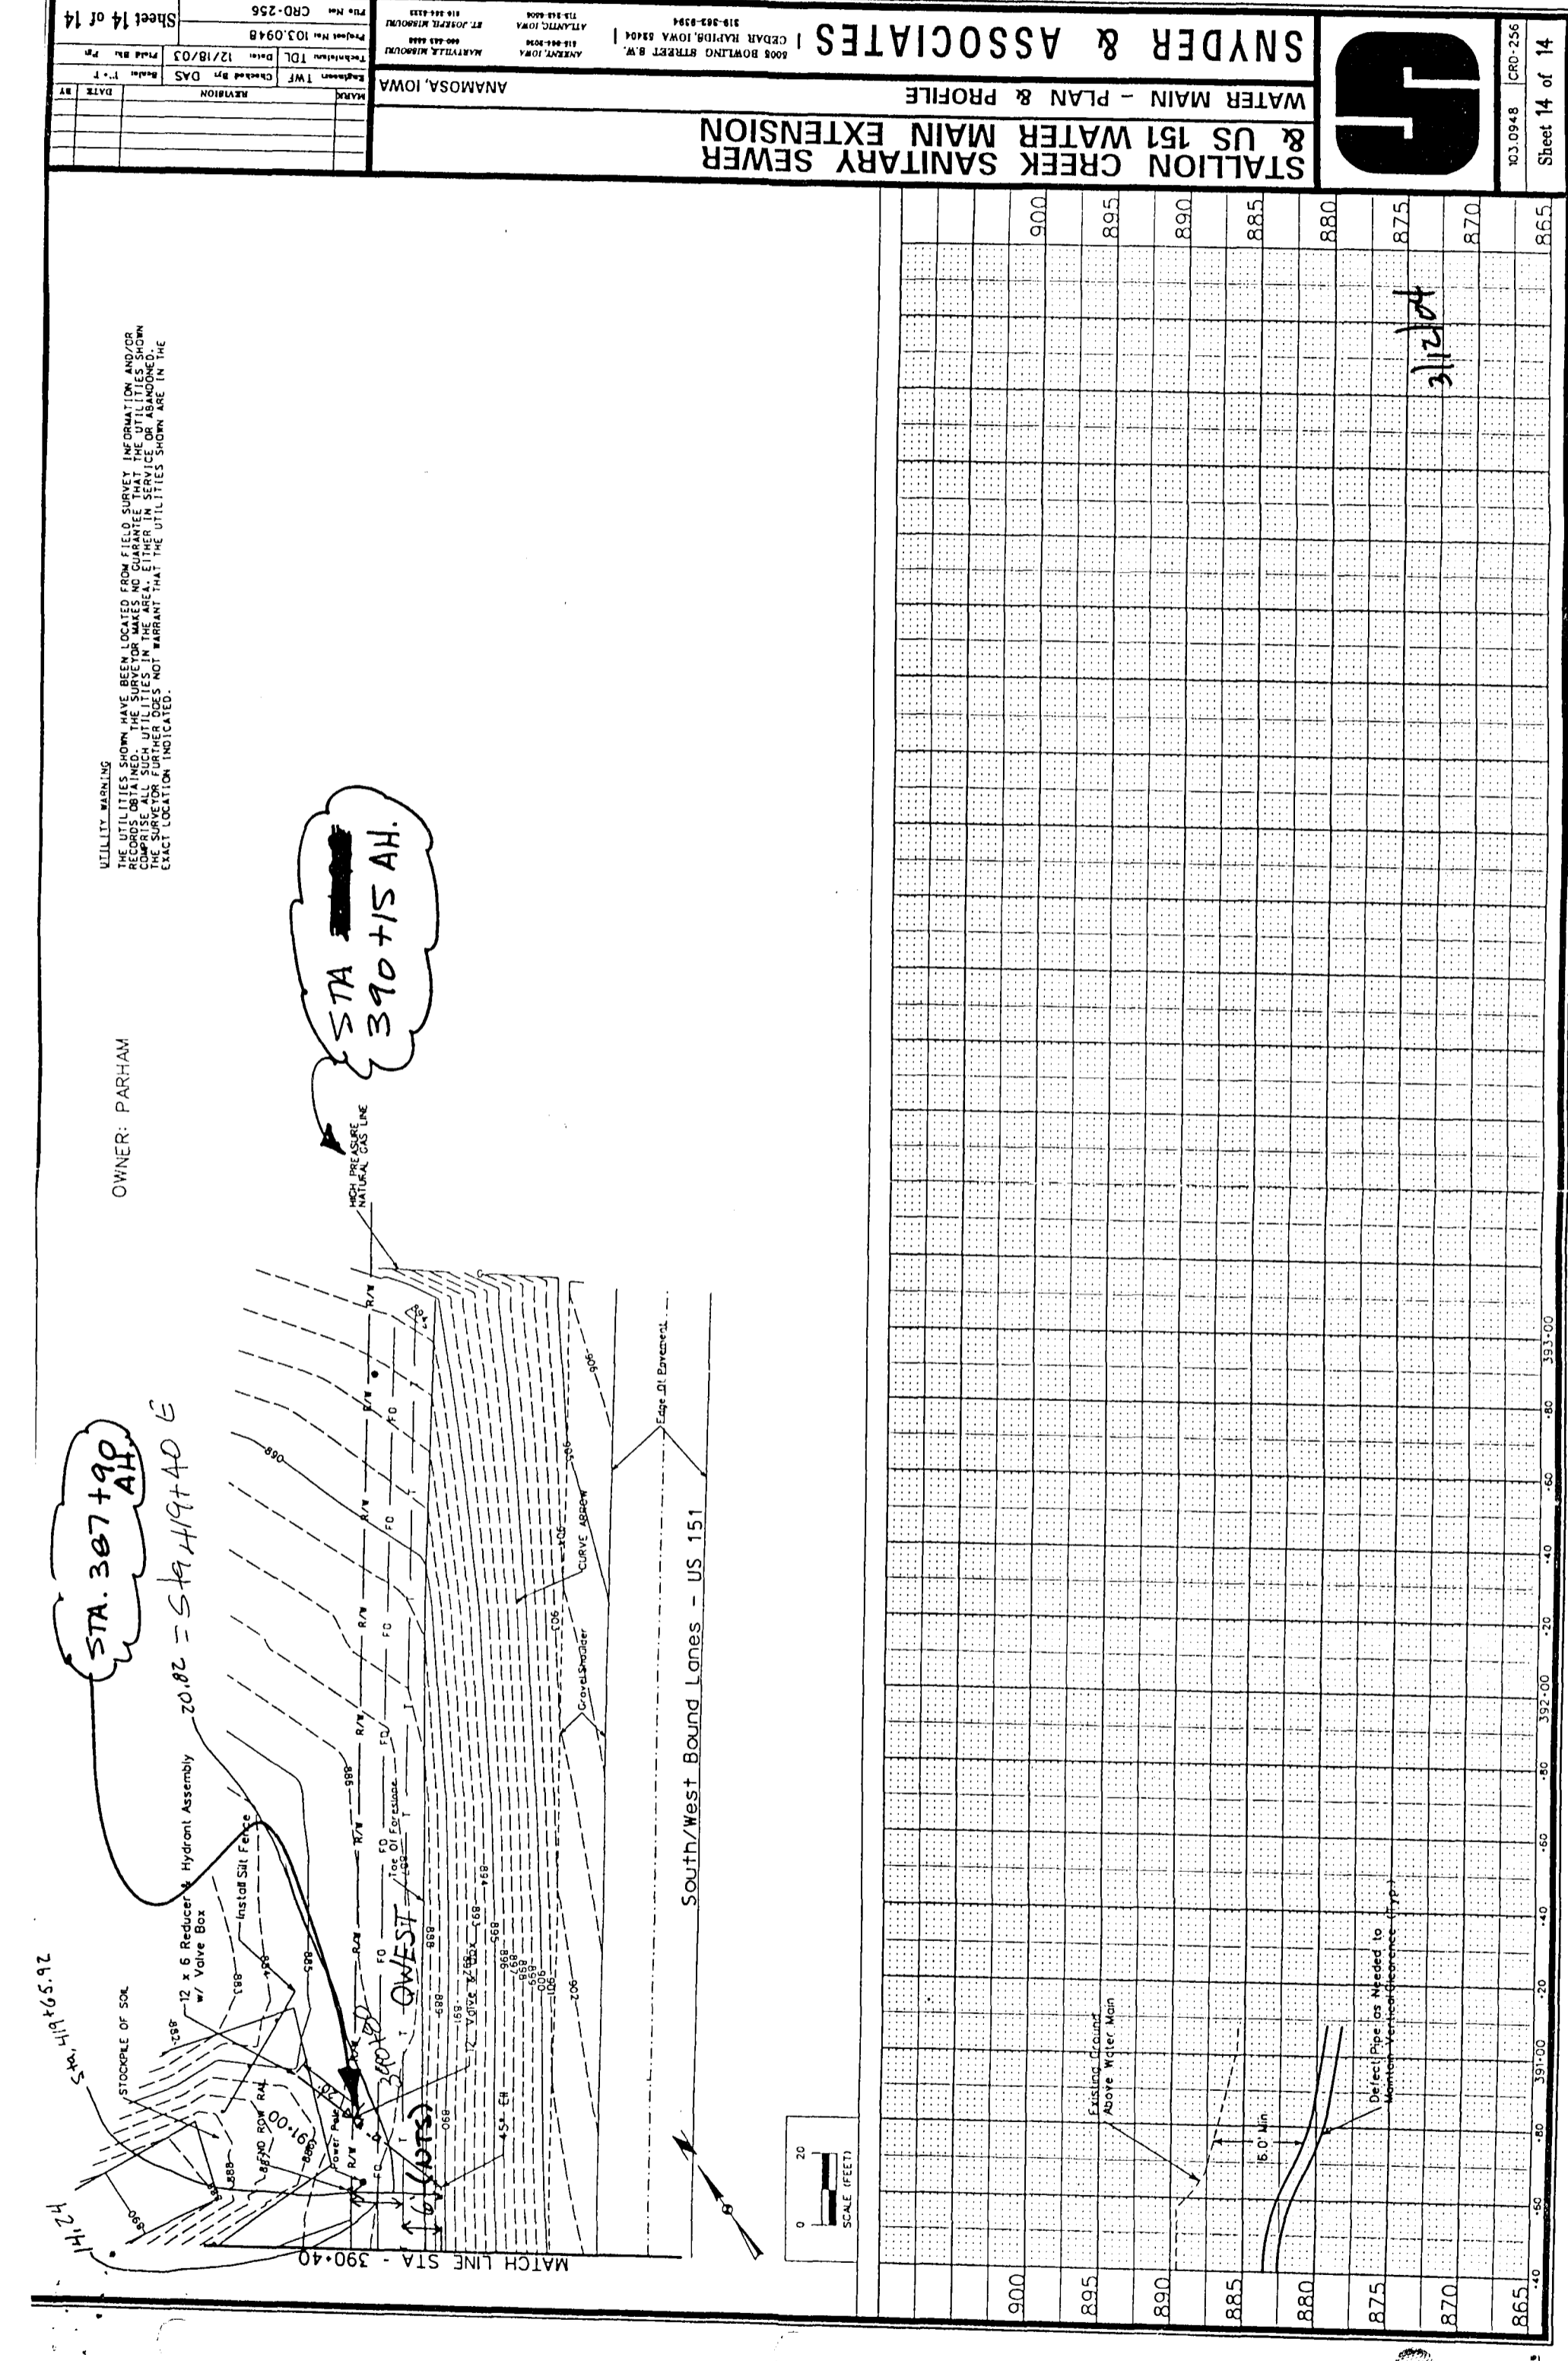



S SNYDER & ASSOCIATES
 808 BOWLING STREET SE
 CEDAR RAPIDS, IOWA 52401
 PHONE: 319.265.1111
 FAX: 319.265.1112
 PROJECT NO. 02.0948
 SHEET NO. 14 OF 14
 DATE: 12/18/03
 DRAWN BY: JAS
 CHECKED BY: TWF

① Refer to Standard Road Plan RF-19C.
 ② Refer to Soils Sheets



TABULATION OF LONGITUDINAL SUBDRAIN SHOULDER AND BACKSLOPE

104-9
 03-28-95
 *Not a bid item

Line No.	Road or Lane Ident.	LOCATION			Side	LONGITUDINAL SUBDRAIN				SUBDRAIN OUTLET RF-19E or RF-22		POROUS BACKFILL*	CLASS "A" CRUSHED STONE *	REMARKS	
		Station to Station		Depth (D) m		Shoulder ①		Backslope ②		Station	Type				Mg
						Dia. mm	Length m	Dia. mm	Length m						
145	US 151	176	64+50	65+67	RT	1.1	100	128			64+50	E	56.0	0.9	
146	US 151	177	65+67	67+25	RT	1.1	100	169			2 @ 65+57	E	68.6	0.9	AT STA. 66+75 BEGIN NEW CONSTRUCTION N.B. LANE
147	US 151	178	67+25	68+15	RT	1.1	100	99			2 @ 67+25	E	43.5	0.9	
148	US 151	135	68+20	69+50	RT	1.1	100	141			68+15	E	60.2	0.9	
149	US 151	134	69+50	71+00	RT	1.1	100	161			68+20	E	68.6	0.9	
150	US 151	133	71+00	72+50	RT	1.1	100	162			2 @ 69+50	E	68.6	0.9	
151	US 151	132	72+50	74+00	RT	1.1	100	163			2 @ 71+00	E	68.6	0.9	
152	US 151	131	74+00	75+50	RT	1.1	100	168			2 @ 72+50	E	83.2	0.9	
153	US 151	179	76+82	78+50	RT	1.1	100	177			74+00	E	72.7	0.9	
154	US 151	143	78+50	79+50	RT	1.1	100	113			75+50	E	72.7	0.9	
155	US 151	144	80+10	81+50	RT	1.1	100	150			2 @ 78+50	E	64.4	0.9	ALONG RAMP TAPER.
156	US 151	145	81+50	83+00	RT	1.1	100	170			79+50	E	68.6	0.9	ALONG RAMP TAPER.
157	US 151	146	83+00	84+50	RT	1.1	100	182			2 @ 81+50	E	68.6	0.9	
158	US 151	147	84+50	85+30	RT	1.1	100	94			2 @ 83+00	E	39.3	0.9	
159	US 151	71	85+30	86+80	RT	1.1	100	165			2 @ 84+50	E	68.6	0.9	
160	US 151	70	86+80	88+50	RT	1.1	100	181			85+30	E	76.9	0.9	
161	US 151	69	88+50	90+13	RT	1.1	100	175			2 @ 86+80	E	68.6	0.9	
162	US 151	68	90+18	91+50	RT	1.1	100	165			2 @ 88+50	E	68.6	0.9	
163	US 151	67	91+50	93+00	RT	1.1	100	163			90+13	E	68.6	0.9	
164	US 151	66	93+00	94+50	RT	1.1	100	164			90+18	E	68.6	0.9	
165	US 151	65	94+50	95+00	RT	1.1	100	64			2 @ 91+50	E	68.6	0.9	
165A	US 151	64	95+05	96+00	RT	1.1	100	106			2 @ 93+00	E	68.6	0.9	
166	US 151	63	96+00	97+50	RT	1.1	100	163			2 @ 94+50	E	68.6	0.9	
167	US 151	62	97+50	99+00	RT	1.1	100	162			2 @ 95+00	E	68.6	0.9	
168	US 151	61	99+00	100+50	RT	1.1	100	163			2 @ 96+00	E	68.6	0.9	
169	US 151	60	100+50	102+00	RT	1.1	100	165			2 @ 97+50	E	68.6	0.9	
170	US 151	59	102+00	103+50	RT	1.1	100	165			2 @ 99+00	E	68.6	0.9	
171	US 151	58	103+50	103+80	RT	1.1	100	43			2 @ 100+50	E	18.4	0.9	
172	US 151	57	103+80	105+50	RT	1.1	100	186			2 @ 102+00	E	76.9	0.9	
173	US 151	56	105+50	107+00	RT	1.1	100	158			2 @ 103+80	E	66.5	0.9	
174	US 151	55	107+00	107+50	RT	1.1	100	56			2 @ 105+50	E	25.5	0.9	
175	US 151	54	107+53	109+00	RT	1.1	100	142			2 @ 107+00	E	67.3	0.9	
176	US 151	53	109+00	109+50	RT	1.1	100	63			107+50	E	30.9	0.9	
177	US 151	52	109+50	111+00	RT	1.1	100	137			2 @ 107+53	E	63.1	0.9	
178	US 151	51	111+00	112+50	RT	1.1	100	147			2 @ 109+00	E	68.6	0.9	
179	US 151	50	112+25	113+50	RT	1.1	100	136			2 @ 109+50	E	58.1	0.9	
180	US 151	49	113+50	114+95	RT	1.1	100	151			2 @ 111+00	E	68.6	0.9	
											112+50	E			
											112+25	E			
											2 @ 113+50	E			
											114+95	E			

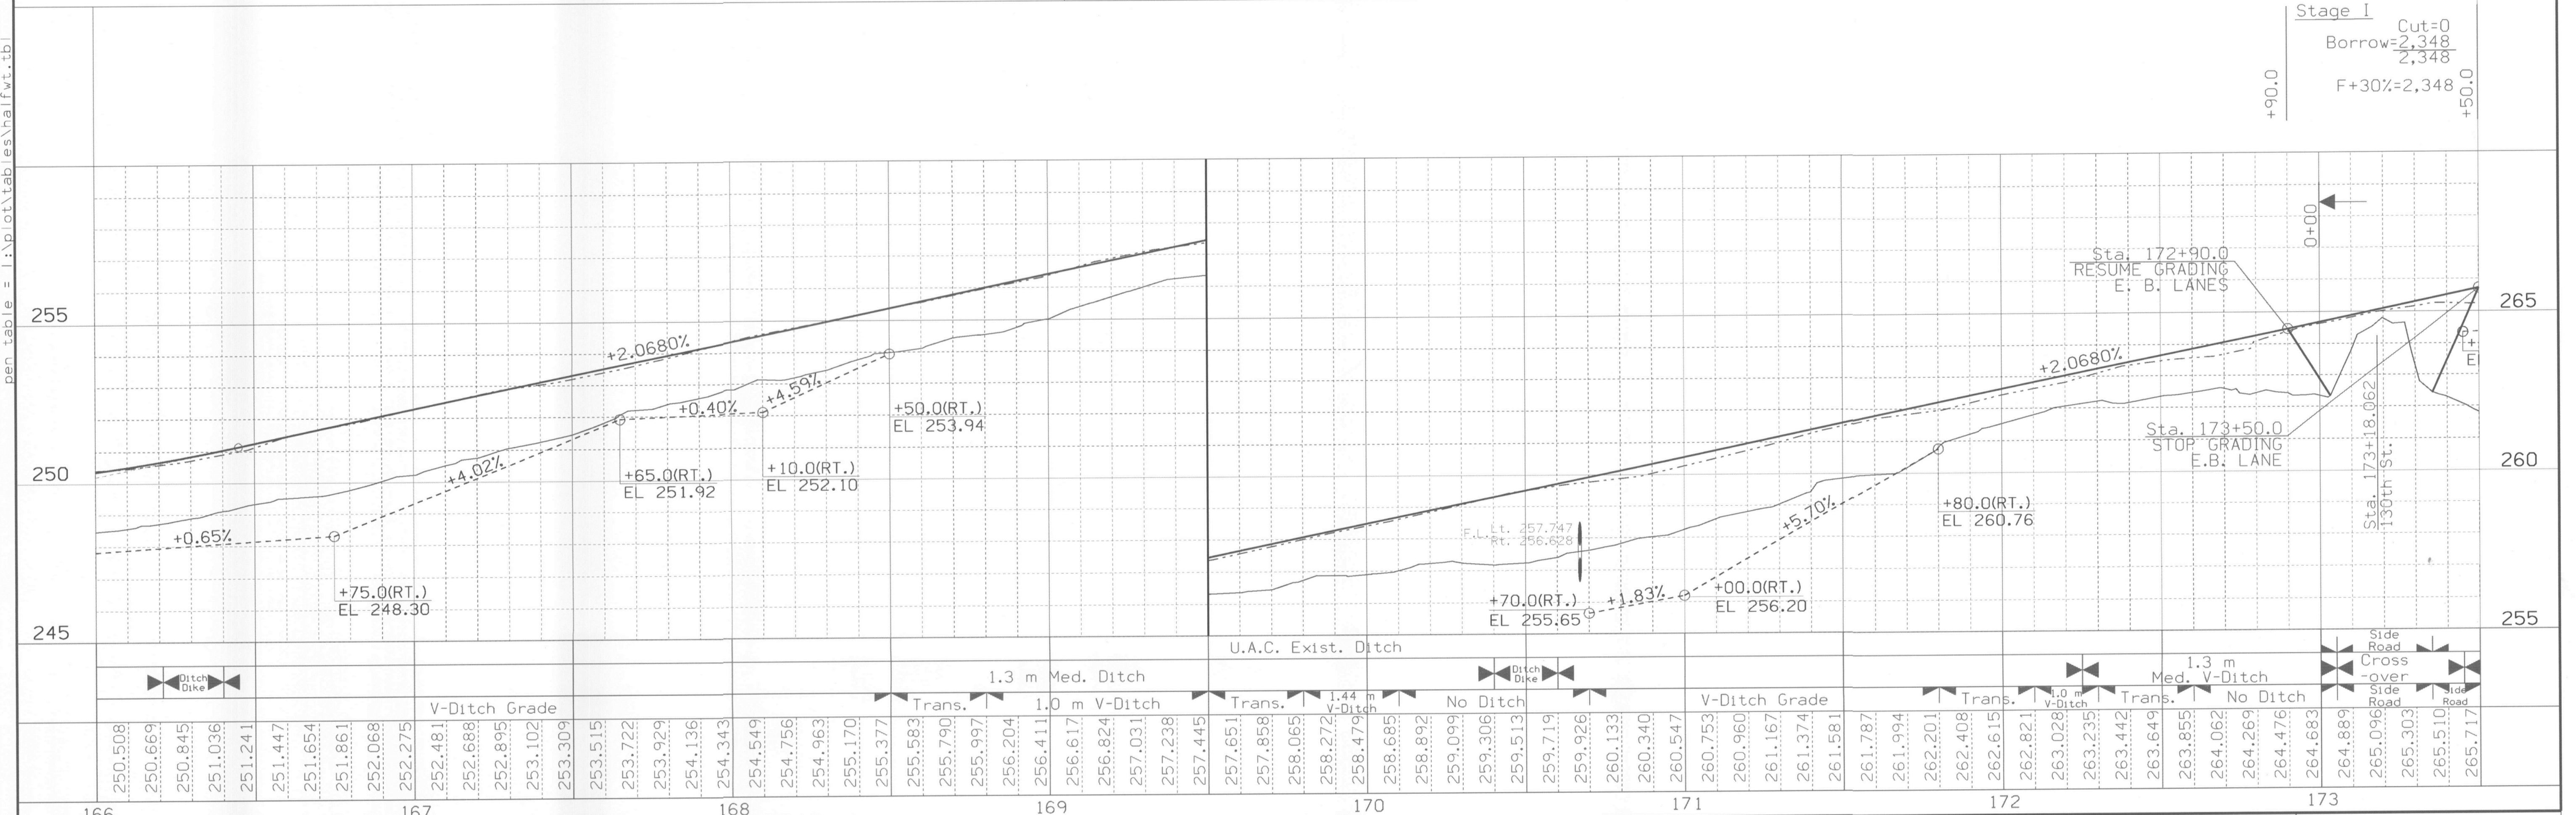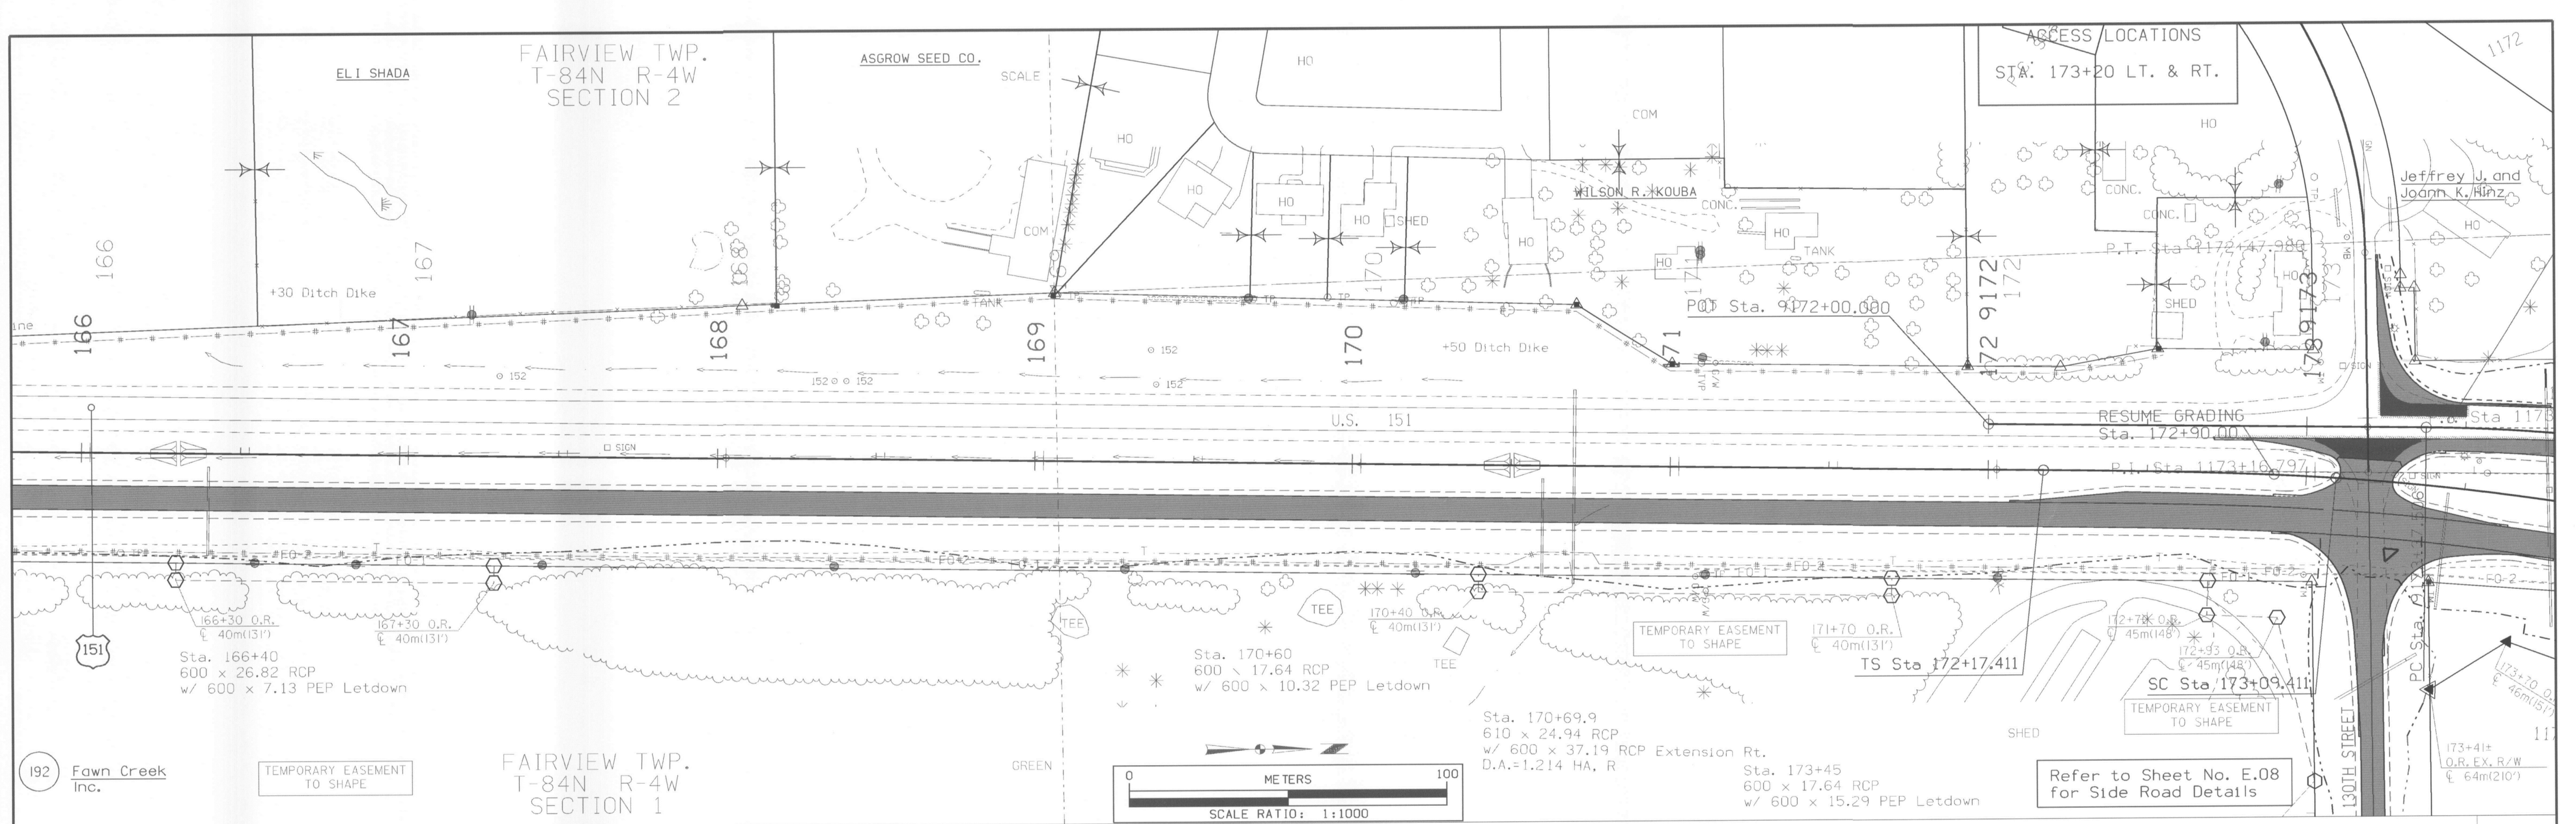

dgn = I:\MORR\project\39922\cadd\anacurve\PAVE - 2004 Changes\57151112.d24
 levels = 1-4,7,8
 plot table = I:\plot\tables\halfwt.tbl

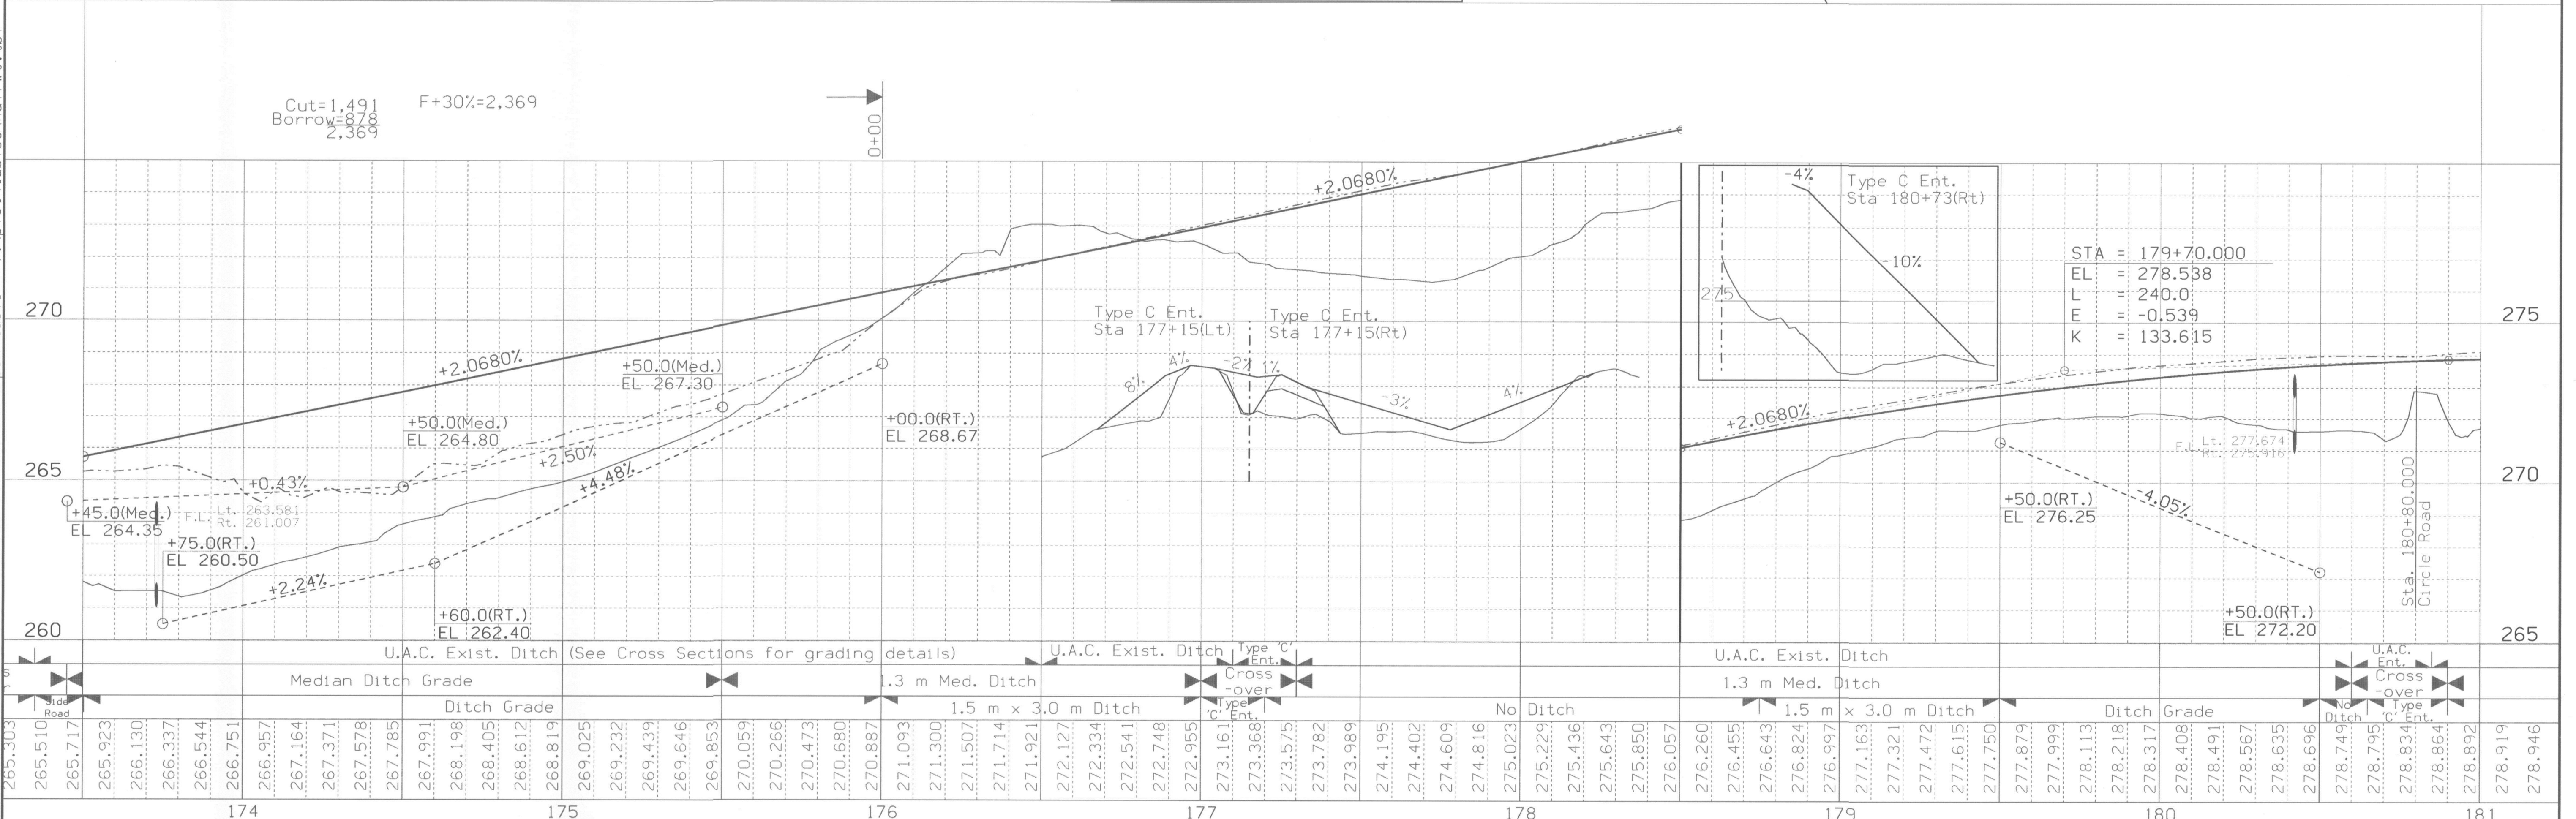
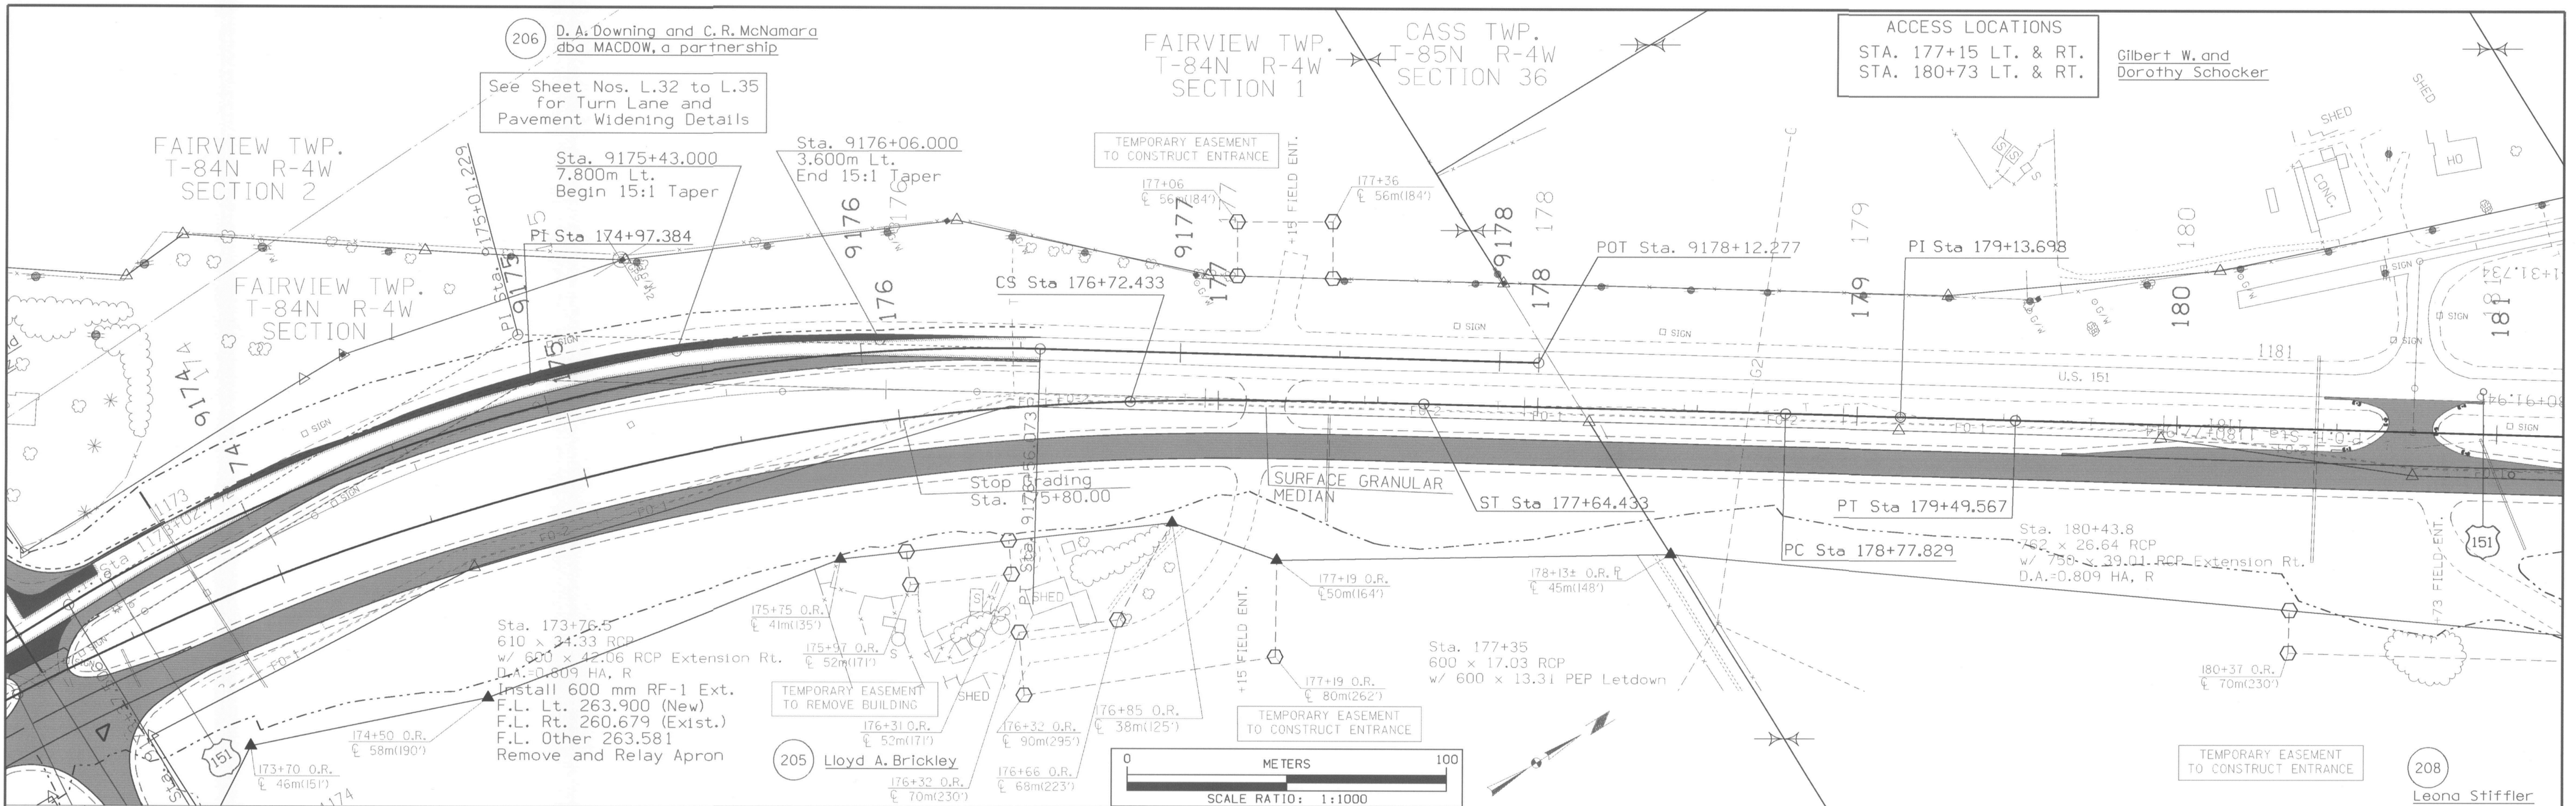


DESIGN TEAM	Skogerboe / EARTH SYSTEMS	METRIC	IOWA DOT * OFFICE OF ROAD DESIGN	Linn/Jones	COUNTY	PROJECT NUMBER	NHSX-151-3(112)--3H-57	SHEET NUMBER	D.24
-------------	---------------------------	--------	----------------------------------	------------	--------	----------------	------------------------	--------------	------

206 D. A. Downing and C. R. McNamara
dba MACDOW, a partnership


205 Lloyd A. Brickley

FAIRVIEW TWP.
T-84N R-4W
SECTION 1

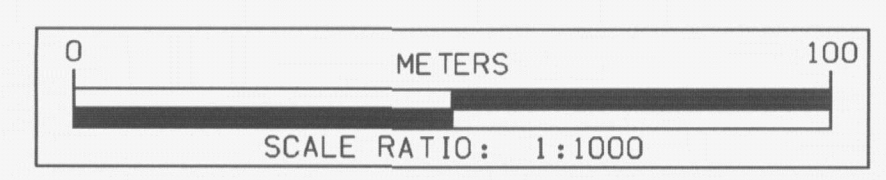
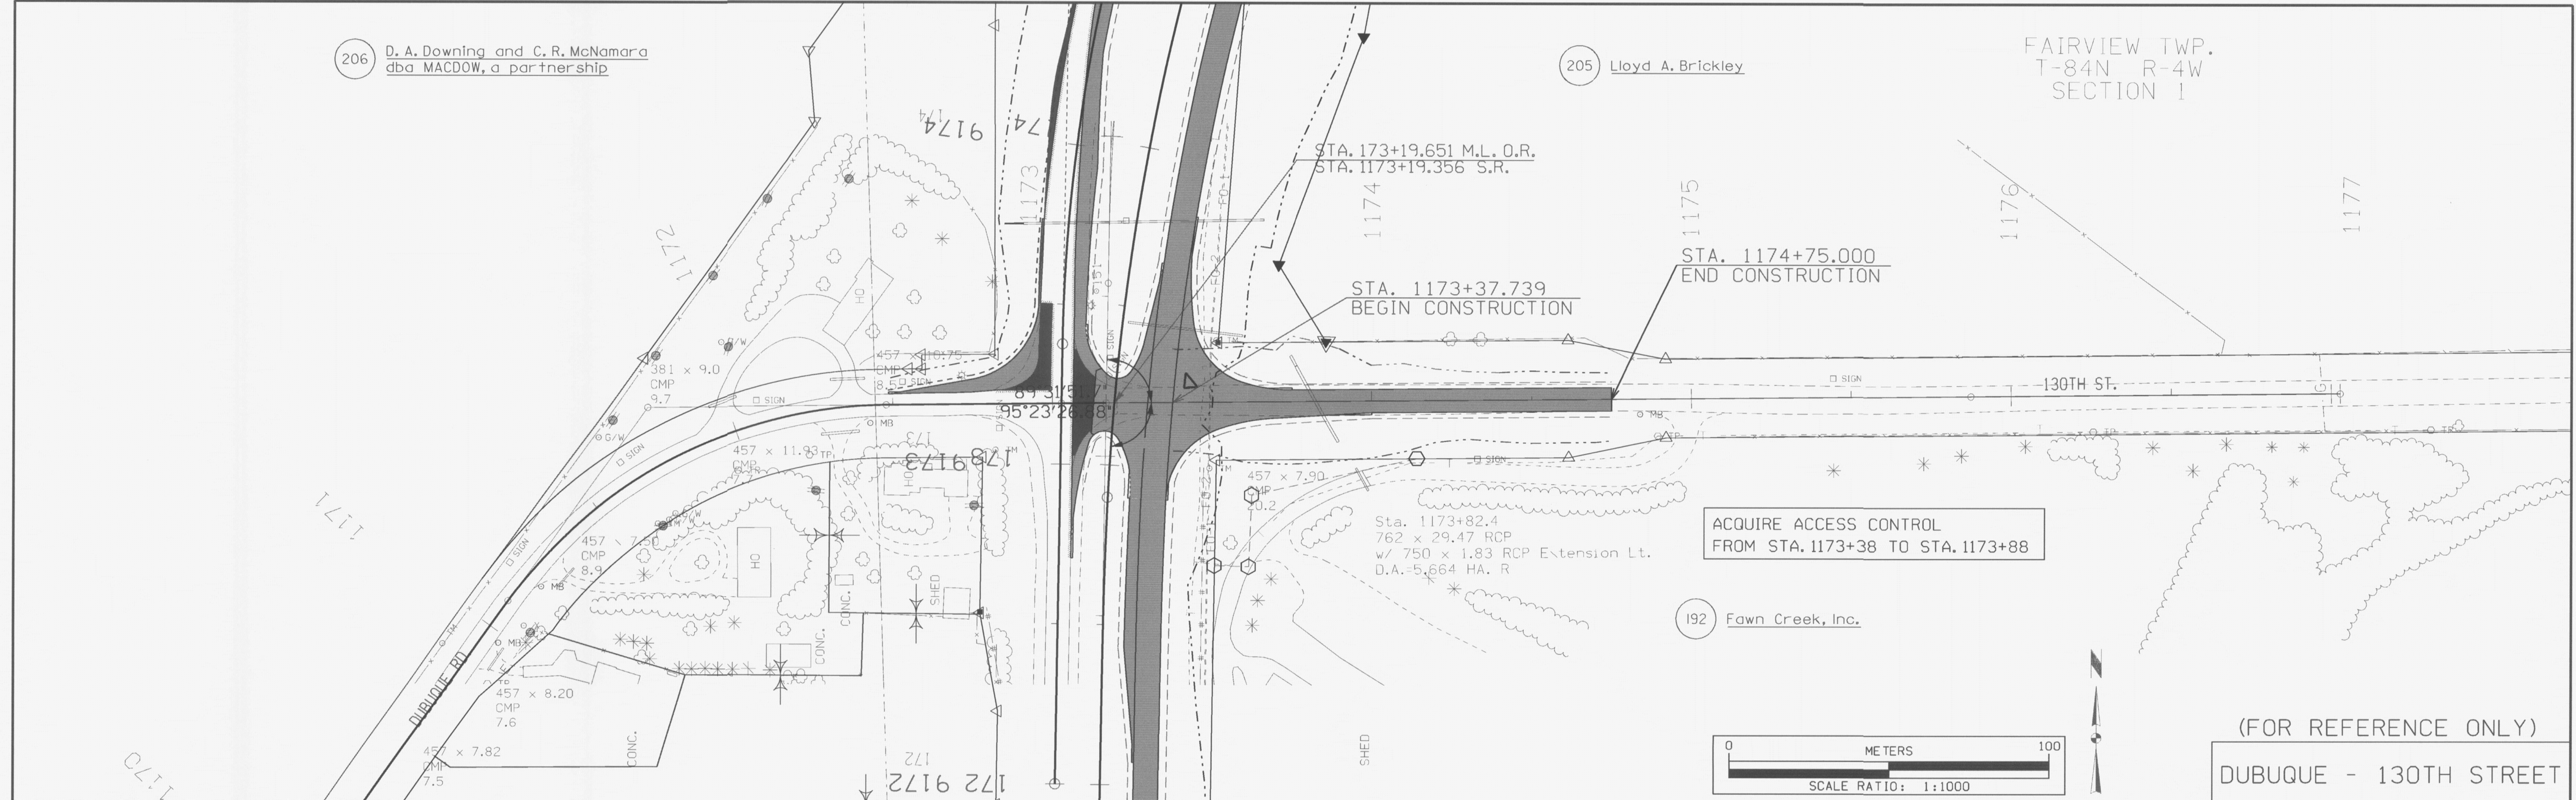


(FOR REFERENCE ONLY)
DUBUQUE - 130TH STREET

Stage I	
Cut=913	F+30%=1,788
Borrow=875	
1,788	

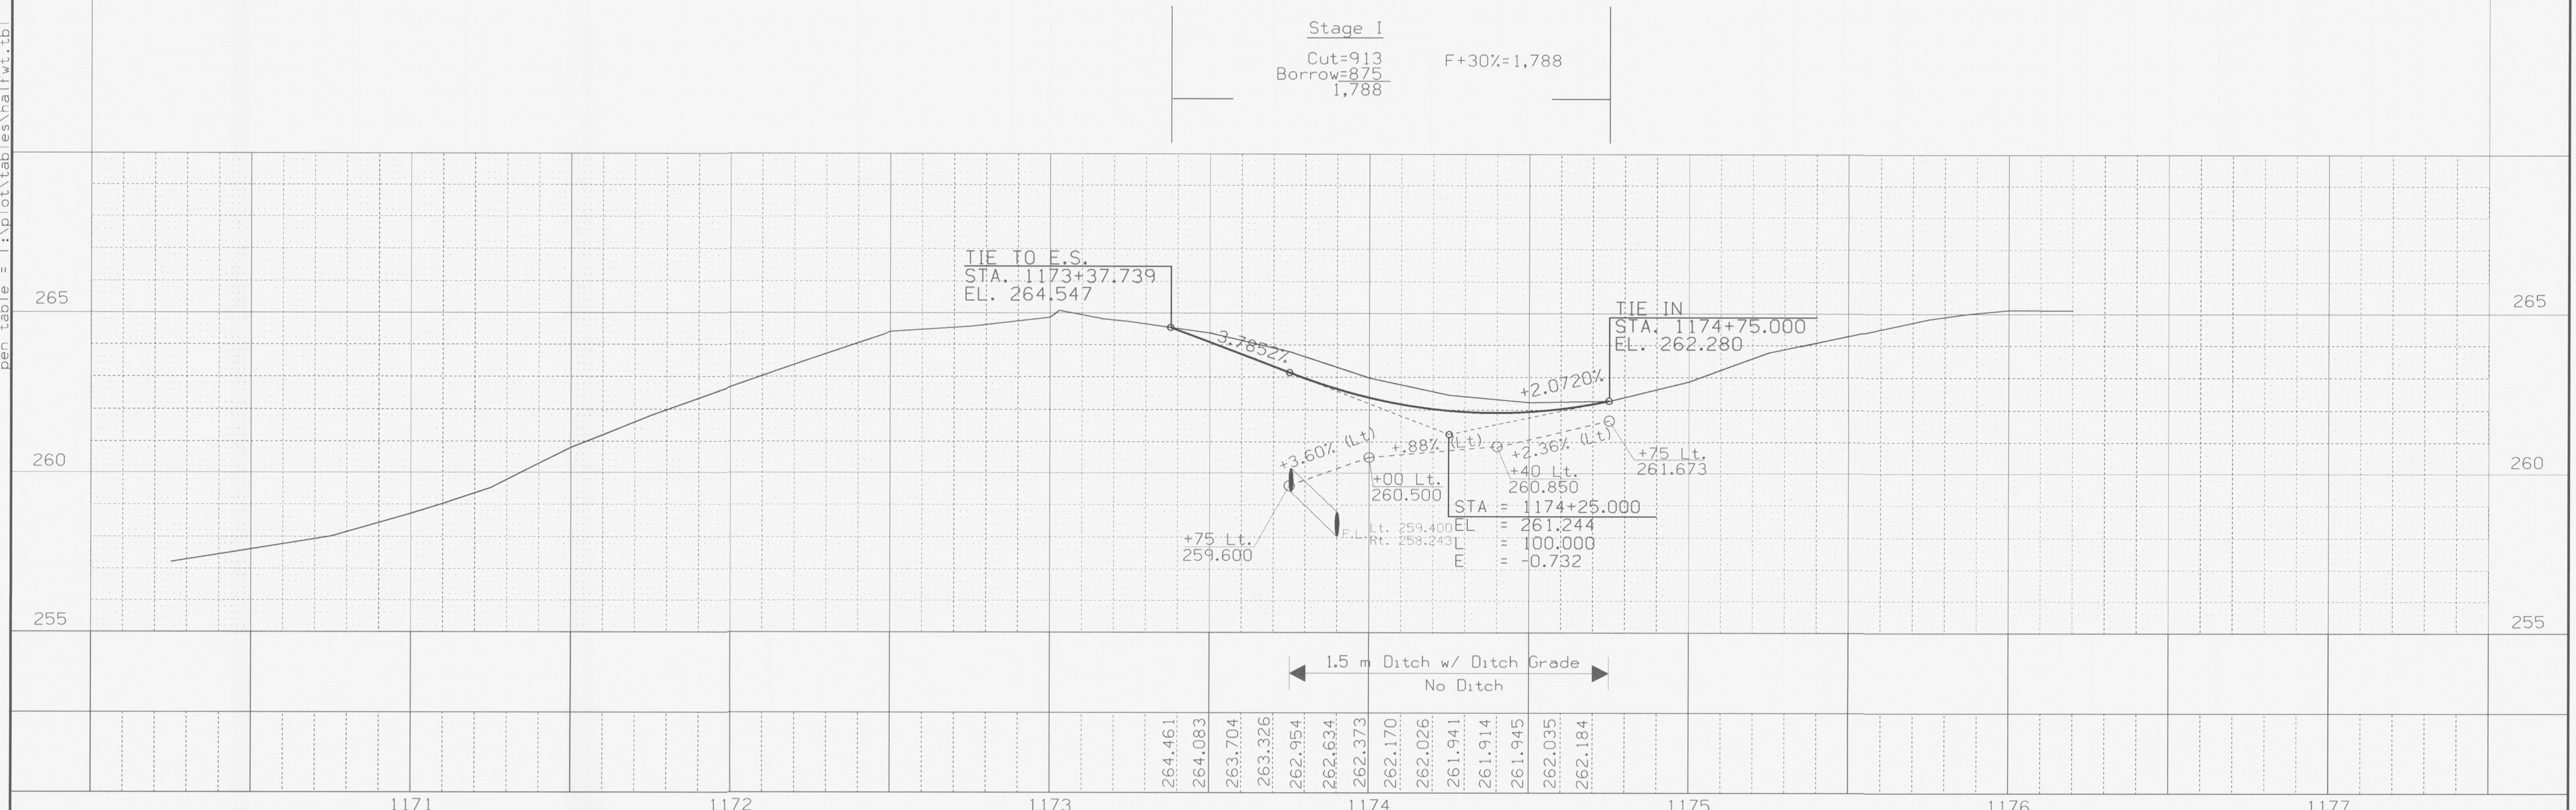

dgn = I:\WORK\project\39922\cadd\anacurve\PAVE - 2004.Changes\57151112.e08
 level = 4.178
 pen_table = I:\plot\tables\halfwt.tbl

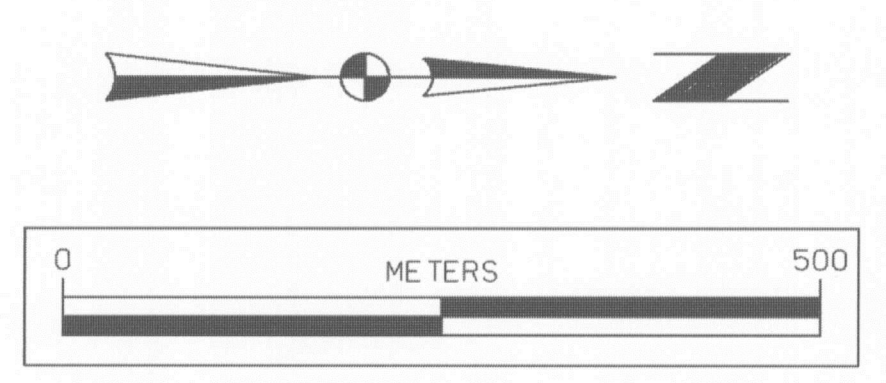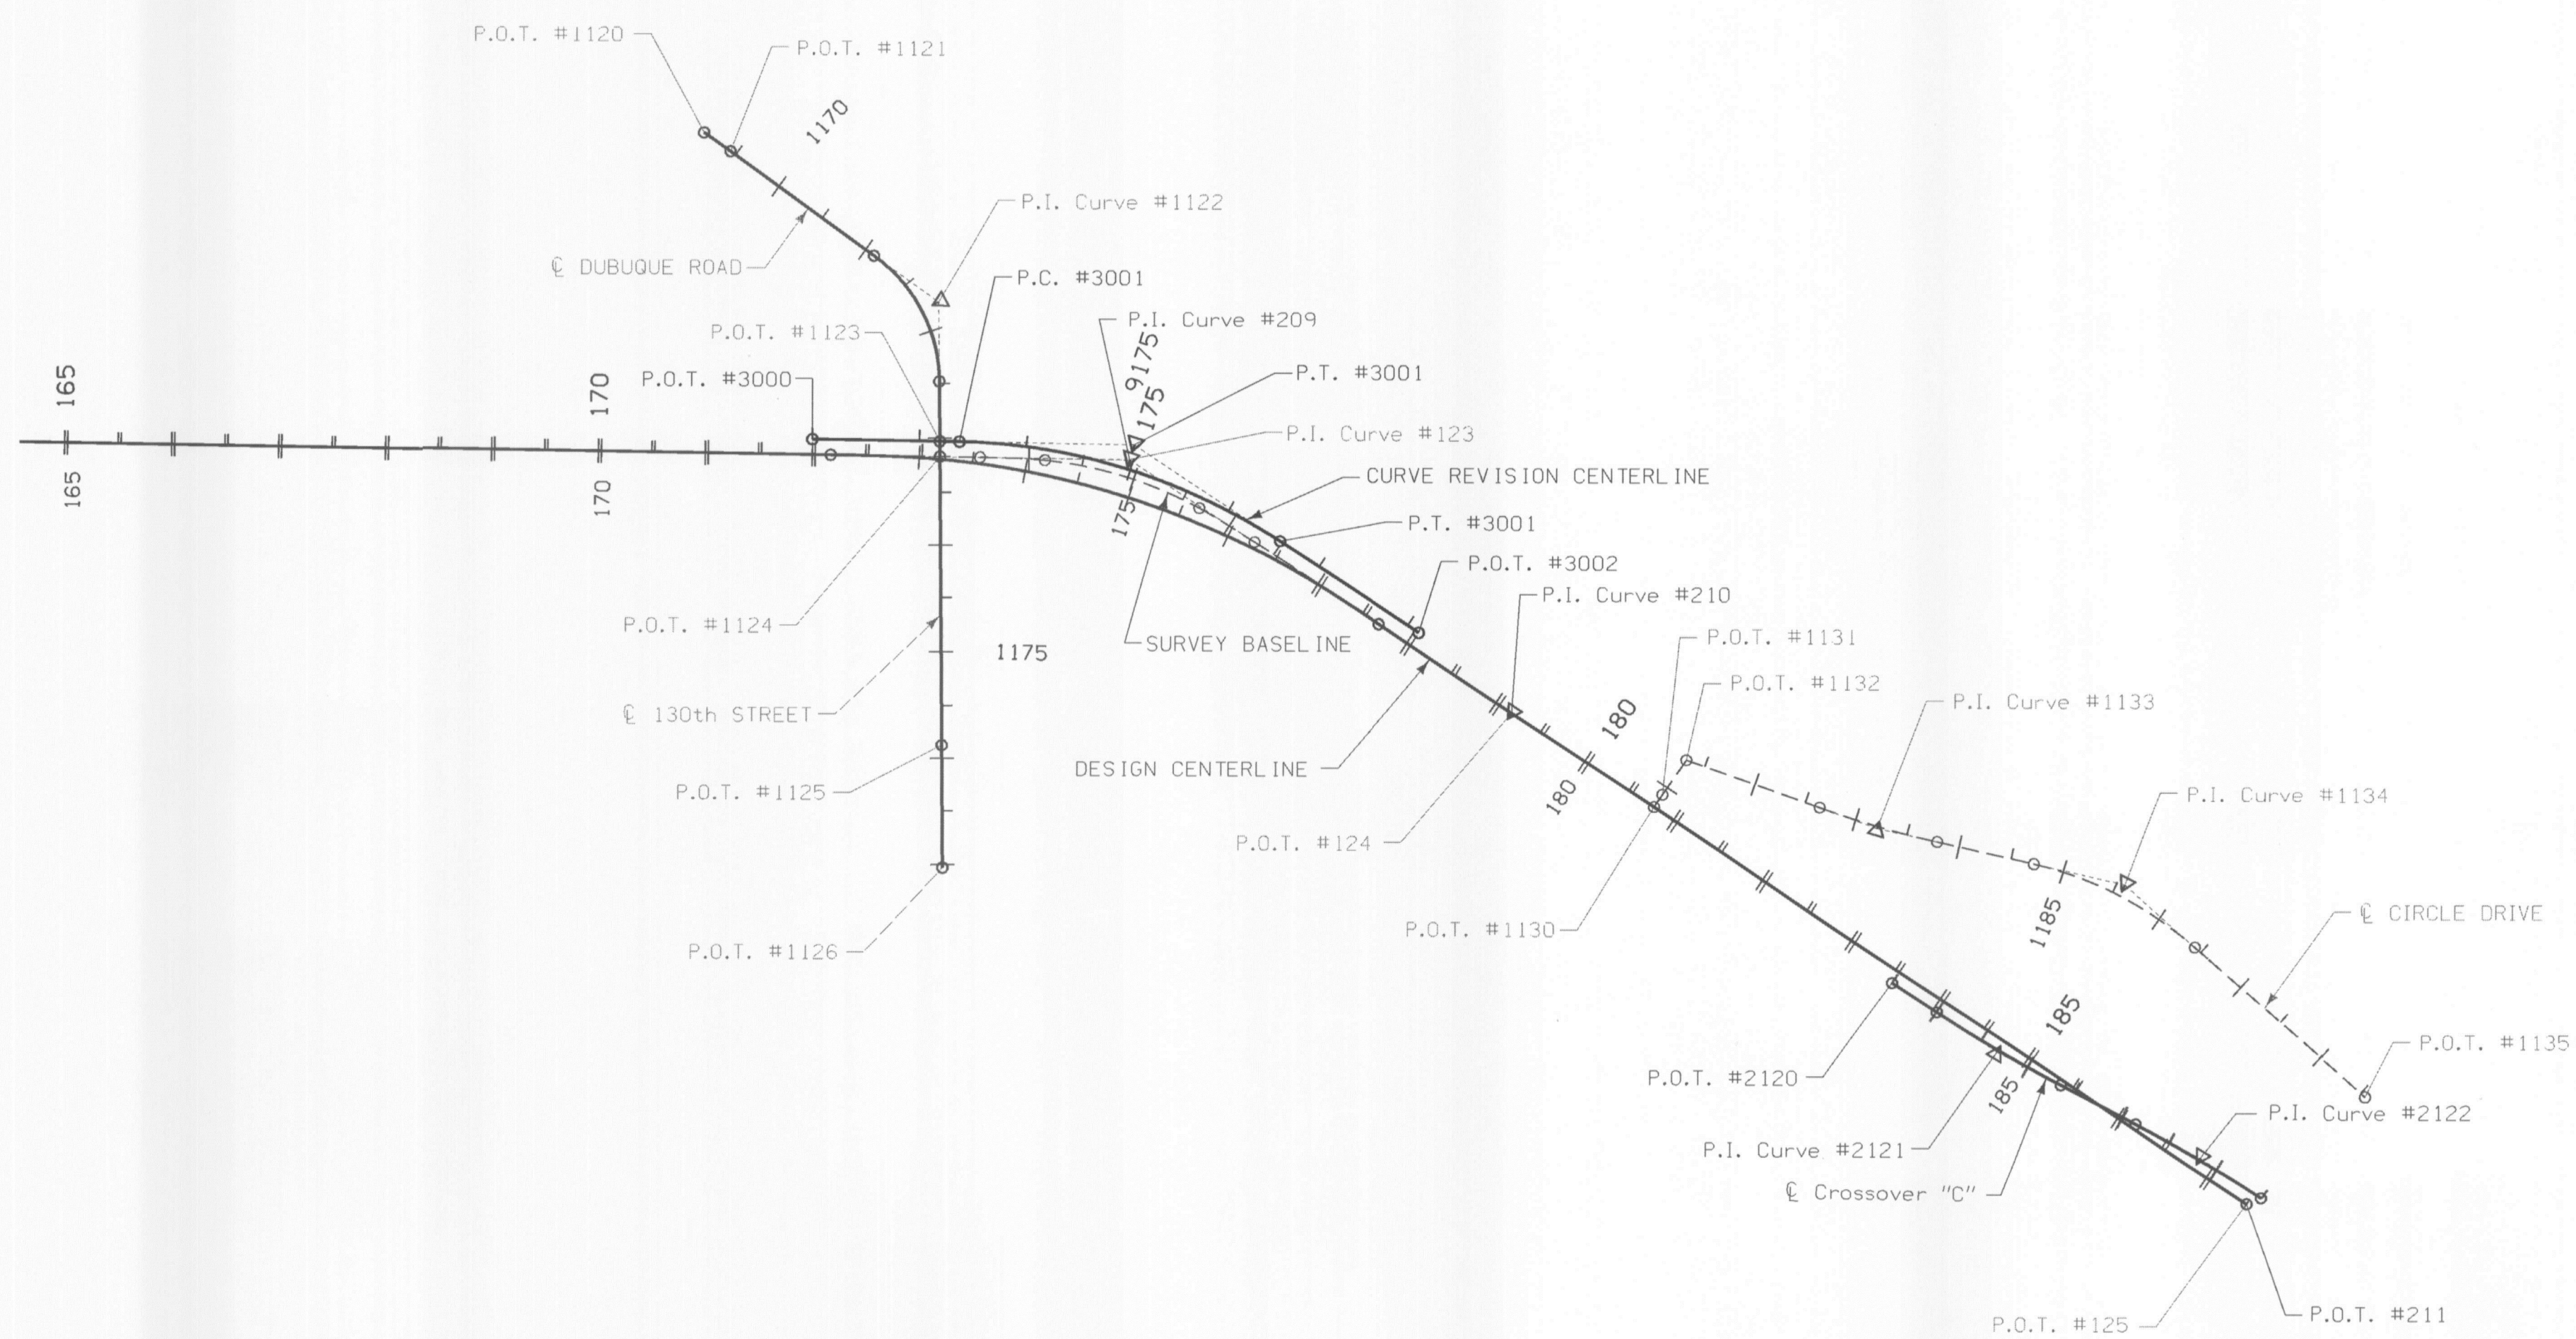

GEOMETRIC LAYOUT
 STA. 165+00 TO STA. 187+50

dgn = I:\WORK\project\39922\cadd\anacurve\PAVE - 2004 Changes\57151112.g05
 levels = 1-63
 pen.table = I:\plot\tables\halfwt.tbl

182-198

