


FAIRFAX
POP.
2123

151

R-8W

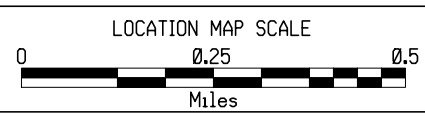


Note:
 ① Top 6" Modified Subbase Shall be of Virgin Material

Curbed Shoulder

Shoulder Jointing:
 Longitudinal joint not required when distance from back of curb to nearest joint is less than 15':

Single pour: L-2
 Staged : KT-2
 Transverse:C at 20' spacing

2_Curb_Modified			
BEGIN STATION	END STATION	(P) Feet	Curb Type See PV-102
845+05.45	848+30.33	3'	6" Sloped

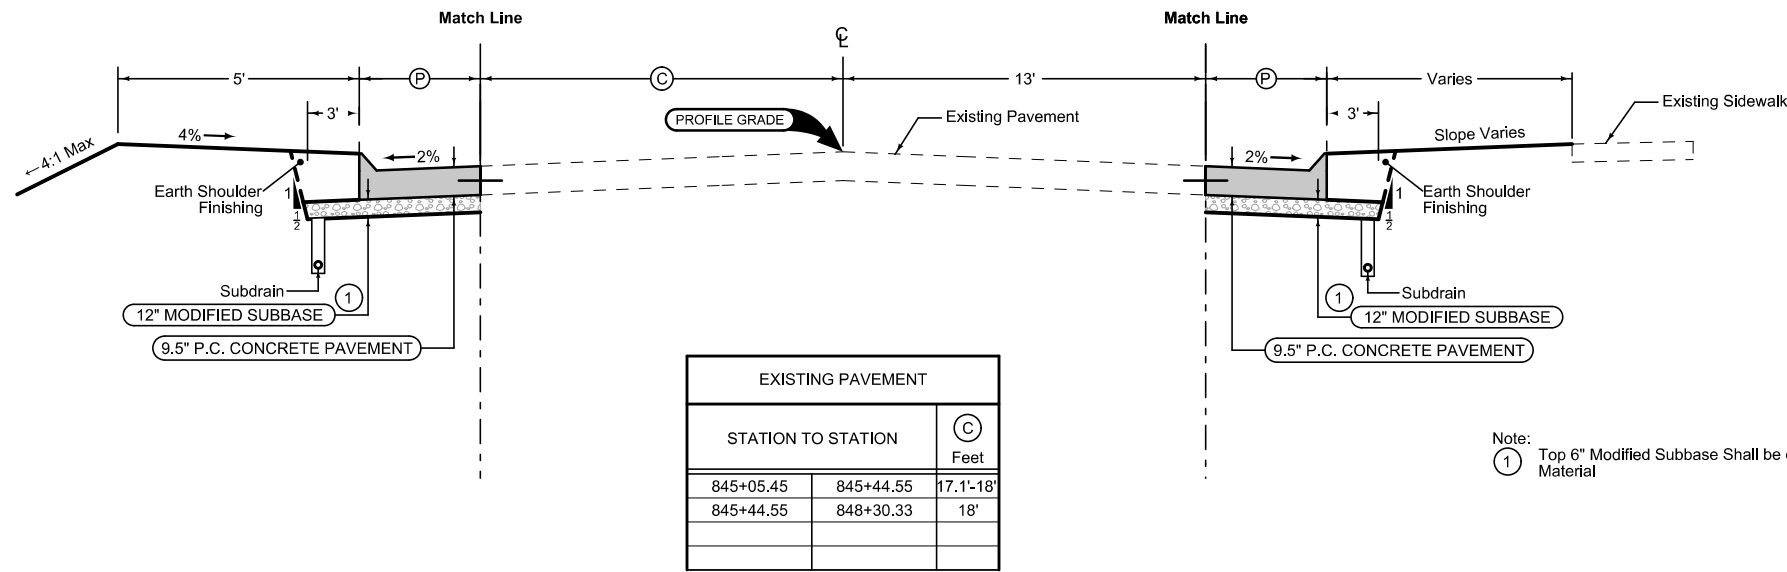

EXISTING PAVEMENT		
STATION TO STATION	(C) Feet	
845+05.45 845+44.55	17.1'-18'	
845+44.55 848+30.33	18'	

Note:
 ① Top 6" Modified Subbase Shall be of Virgin Material

Curbed Shoulder

Shoulder Jointing:
 Longitudinal joint not required when distance from back of curb to nearest joint is less than 15':

Single pour: L-2
 Staged : KT-2
 Transverse:C at 20' spacing


2_Curb_Modified			
BEGIN STATION	END STATION	(P) Feet	Curb Type See PV-102
843+88.58	845+60.00	2.9'-6.7'	6" Sloped

Curbed Shoulder

Shoulder Jointing:
 Longitudinal joint not required when distance from back of curb to nearest joint is less than 15':

Single pour: L-2
 Staged : KT-2
 Transverse:C at 20' spacing

2_Curb_Modified			
BEGIN STATION	END STATION	(P) Feet	Curb Type See PV-102
845+60.00	846+17.11	6.7'-8'	6" Sloped
846+17.11	847+90.50	8'	6" Sloped

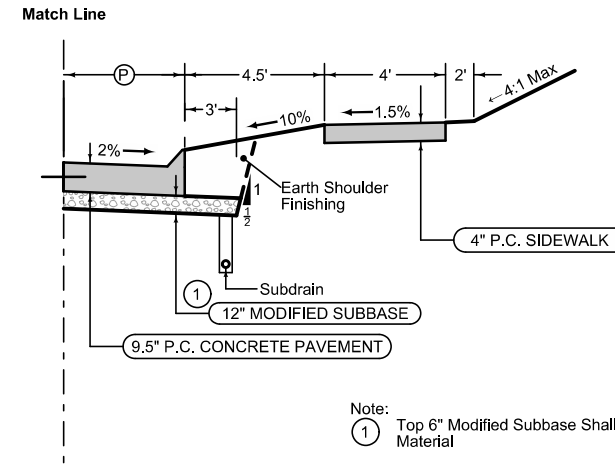

Note:
 ① Top 6" Modified Subbase Shall be of Virgin Material

Curbed Shoulder

Shoulder Jointing:
 Longitudinal joint not required when distance from back of curb to nearest joint is less than 15':

Single pour: L-2
 Staged : KT-2
 Transverse:C at 20' spacing

2_Curb_Modified			
BEGIN STATION	END STATION	(P) Feet	Curb Type See PV-102
847+90.50	848+30.33	8'	6" Sloped

See Tab 100-24 or 100-25 for pavement quantities.
 See Tab 112-9 for shoulder quantities.

Note:
 ① Top 6" Modified Subbase Shall be of Virgin Material


US HIGHWAY 151

Curbed Shoulder

Shoulder Jointing:
Longitudinal joint not required when distance from back of curb to nearest joint is less than 15':

Single pour: L-2
Staged: KT-2
Transverse: C at 20' spacing

2_Curb_Modified			
BEGIN STATION	END STATION	(P) Feet	Curb Type See PV-102
848+30.33	848+69.80	3'	6" Sloped

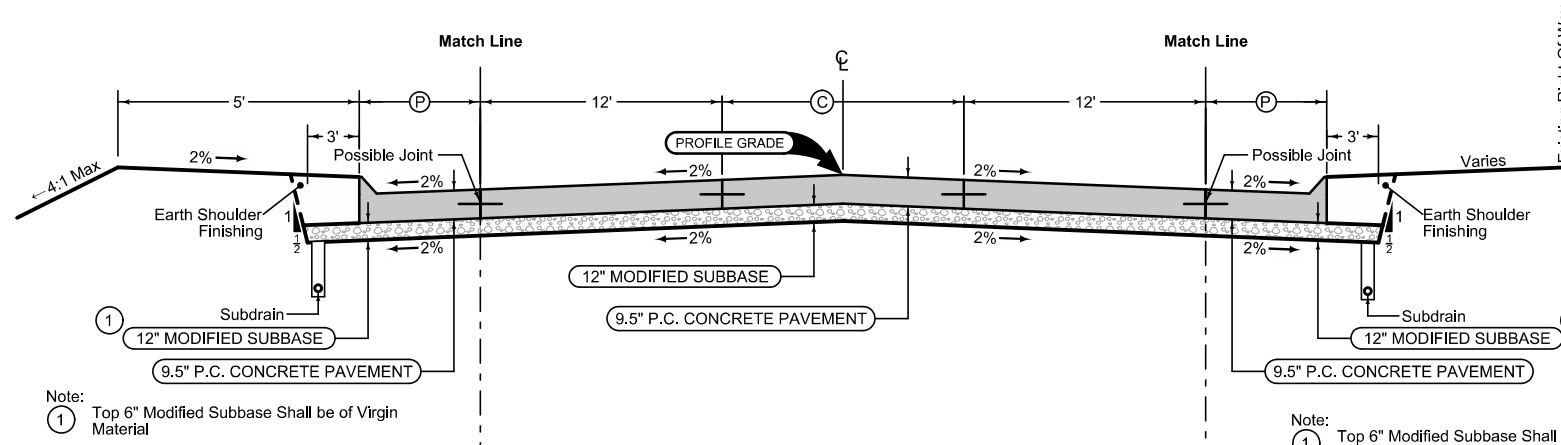

Note:
① Top 6" Modified Subbase Shall be of Virgin Material

Curbed Shoulder

Shoulder Jointing:
Longitudinal joint not required when distance from back of curb to nearest joint is less than 15':


Single pour: L-2
Staged: KT-2
Transverse: C at 20' spacing

2_Curb_Modified			
BEGIN STATION	END STATION	(P) Feet	Curb Type See PV-102
848+30.33	848+70.64	3'	6" Sloped

Note:
① Top 6" Modified Subbase Shall be of Virgin Material

Mainline Jointing:
Transverse joints: CD at 20' spacing
Longitudinal joint: L-2

2P_TWLTL_10-19-10		
STATION TO STATION	(C)	Feet
848+30.33	853+34.27	12'
853+34.27	855+59.10	12'-2.1'
859+06.10	861+73.36	0'-12'
861+73.36	863+59.72	12'
863+59.72	864+57.82	12'-14'
864+57.82	865+48.61	14'
869+26.20	879+38.00	14'
882+34.00	898+00.00	14'

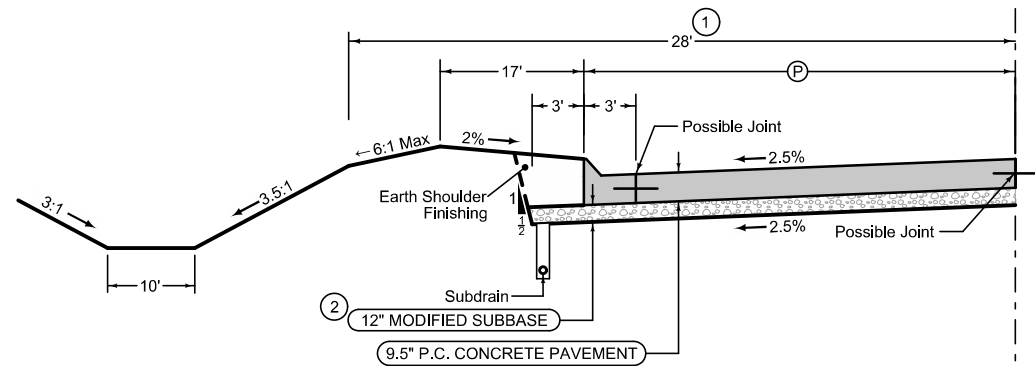

Curbed Shoulder

Shoulder Jointing:
Longitudinal joint not required when distance from back of curb to nearest joint is less than 15':

Single pour: L-2
Staged: KT-2
Transverse: C at 20' spacing

2_Curb_Modified			
BEGIN STATION	END STATION	(P) Feet	Curb Type See PV-102
850+01.96	853+34.27	15'	6" Sloped
853+34.27	855+14.27	15'-3'	6" Sloped

Note:
① Where "P" Plus 17' Exceeds 28' Clear Zone, Eliminate 6:1 Slope.
② Top 6" Modified Subbase Shall be of Virgin Material


Curbed Shoulder

Shoulder Jointing:
Longitudinal joint not required when distance from back of curb to nearest joint is less than 15':

Single pour: L-2
Staged: KT-2
Transverse: C at 20' spacing

2_Curb_Modified			
BEGIN STATION	END STATION	(P) Feet	Curb Type See PV-102
849+97.65	853+34.27	3'	Sloped ①
853+34.27	855+59.10	3'-8"	6" Sloped
859+06.10	859+93.36	9'	6" Sloped
864+74.60	865+48.61	3'	4" Sloped

NOTE:
① Refer to L-Sheets for Curb Type at Guardrail installations
② Top 6" Modified Subbase Shall be of Virgin Material

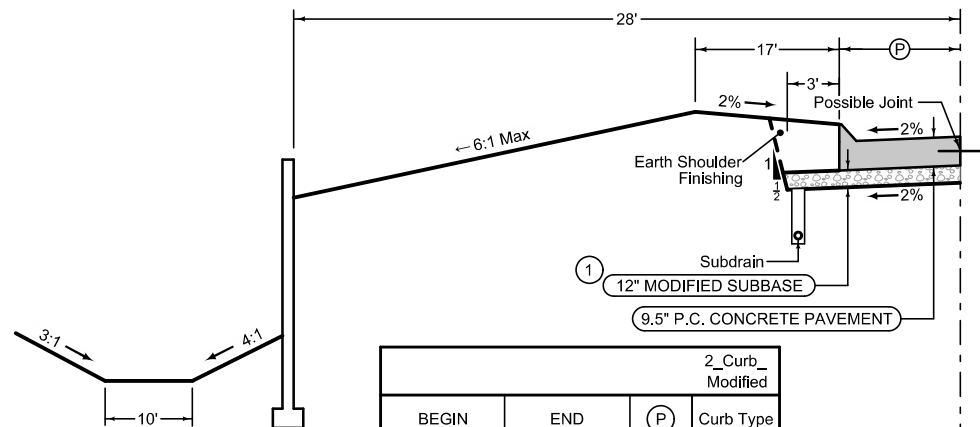

Curbed Shoulder

Shoulder Jointing:
Longitudinal joint not required when distance from back of curb to nearest joint is less than 15':

Single pour: L-2
Staged: KT-2
Transverse: C at 20' spacing


2_Curb_Modified			
BEGIN STATION	END STATION	(P) Feet	Curb Type See PV-102
855+14.27	855+59.10	3'-6"	6" Sloped
859+06.10	861+73.23	9'-3'	6" Sloped
861+73.23	863+87.58	3'	6" Sloped

Note:
① Top 6" Modified Subbase Shall be of Virgin Material

Curbed Shoulder

Shoulder Jointing:
Longitudinal joint not required when distance from back of curb to nearest joint is less than 15':

Single pour: L-2
Staged: KT-2
Transverse: C at 20' spacing

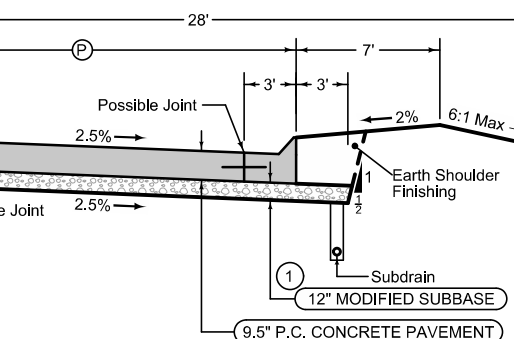


2_Curb_Modified			
BEGIN STATION	END STATION	(P) Feet	Curb Type See PV-102
859+93.36	861+73.36	3'-15"	6" Sloped
861+73.36	863+58.36	15'	6" Sloped

Note:
① Top 6" Modified Subbase Shall be of Virgin Material

See Tab 100-24 or 100-25 for pavement quantities.
See Tab 112-9 for shoulder quantities.

US HIGHWAY 151

- NOTE:
- ① Ditch width and backslope varies, see cross sections.
 - ② Top 6" Modified Subbase Shall be of Virgin Material.

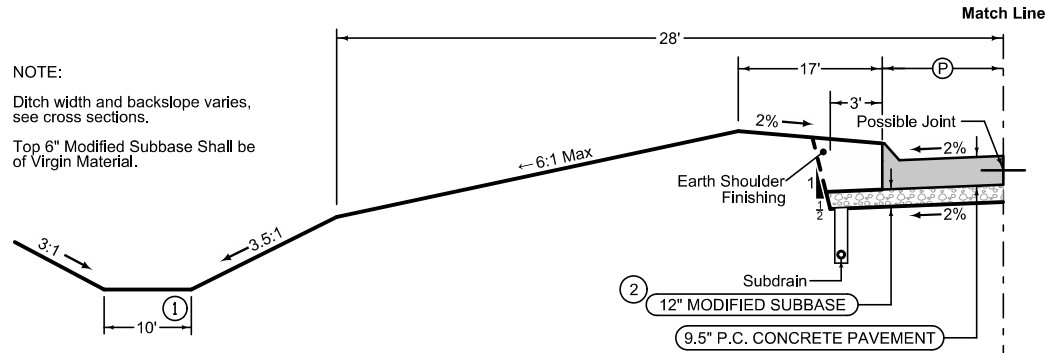


Curbed Shoulder

Shoulder Jointing:
Longitudinal joint not required when distance from back of curb to nearest joint is less than 15':

Single pour: L-2
Staged : KT-2
Transverse:C at 20' spacing

2_Curb_Modified			
BEGIN STATION	END STATION	(P) Feet	Curb Type See PV-102
864+64.13	865+48.61	3'	6" Sloped
869+26.20	870+00.00	3'	4" Sloped
870+00.00	870+70.00	3'-10'	4" Sloped

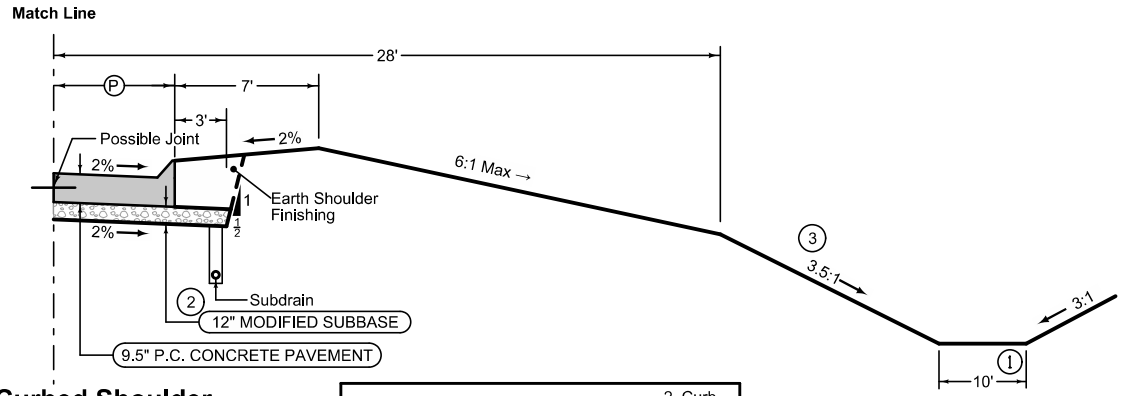

Curbed Shoulder

Shoulder Jointing:
Longitudinal joint not required when distance from back of curb to nearest joint is less than 15':

Single pour: L-2
Staged : KT-2
Transverse:C at 20' spacing


2_Curb_Modified			
BEGIN STATION	END STATION	(P) Feet	Curb Type See PV-102
869+26.20	870+00.00	3'	6" Sloped
870+00.00	870+70.00	3'-10'	6" Sloped

- NOTE:
- ① Ditch width and backslope varies, see cross sections.
 - ② Top 6" Modified Subbase Shall be of Virgin Material.
 - ③ Foreslope varies, see cross sections.

PCC Shoulder

PCC Shoulder Jointing:
Longitudinal joint: BT-1 or BT-5
Transverse joints: C at 20' spacing

2_P_PCC_Modified		
STATION TO STATION	(P) Feet	
870+70.00	875+41.91	10'
876+49.90	879+38.00	10'
882+34.00	883+19.86	10'
890+21.24	898+00.00	10'

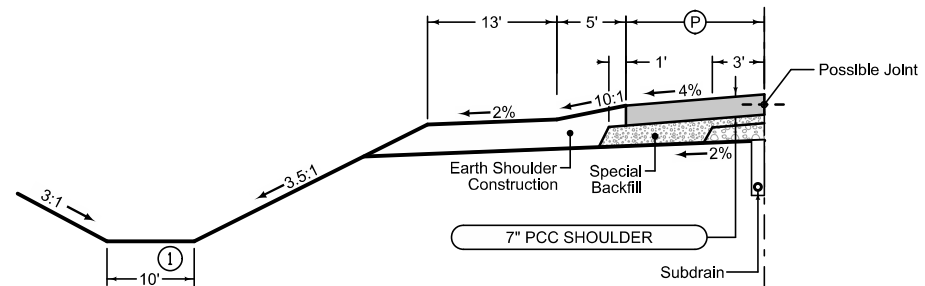


- NOTE:
- ① Ditch width varies, see cross sections

- NOTE:
- ① Ditch width varies, see cross sections

PCC Shoulder

PCC Shoulder Jointing:
Longitudinal joint: BT-1 or BT-5
Transverse joints: C at 20' spacing

2_P_PCC_Modified		
STATION TO STATION	(P) Feet	
870+70.00	879+38.00	10'
885+23.39	898+00.00	10'

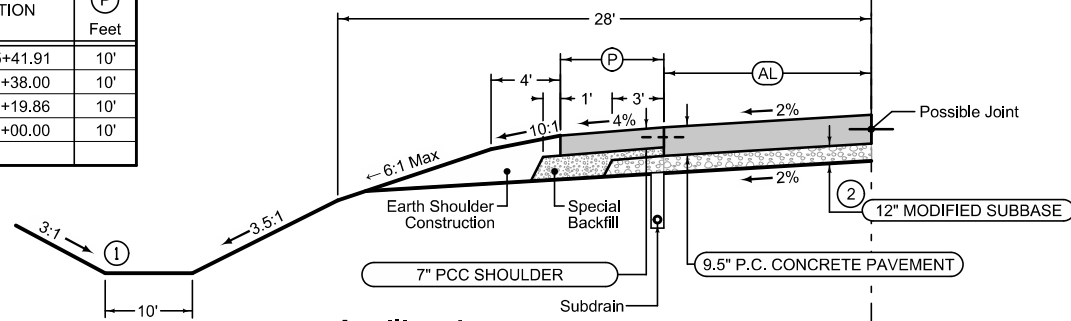

- NOTES:
- ① Ditch width and backslope varies, see cross sections.
 - ② Top 6" Modified Subbase Shall be of Virgin Material.


Auxiliary Lane

Longitudinal joint: L or KT
Transverse joint: Match Mainline

2_AuxLane_PCC_Modified		2_AL_Shldr_PCC_Modified	
STATION TO STATION	(AL) Feet	(P) Feet	
884+25.93	888+43.66	12'	6'
888+43.66	889+31.04	12'-4"	6'
889+31.04	890+21.24	4'-0"	6'-10'

Auxiliary Lane PCC Shoulder

PCC Shoulder Jointing:
Longitudinal joint: BT-1 or BT-5
Transverse joints: C at 20' spacing

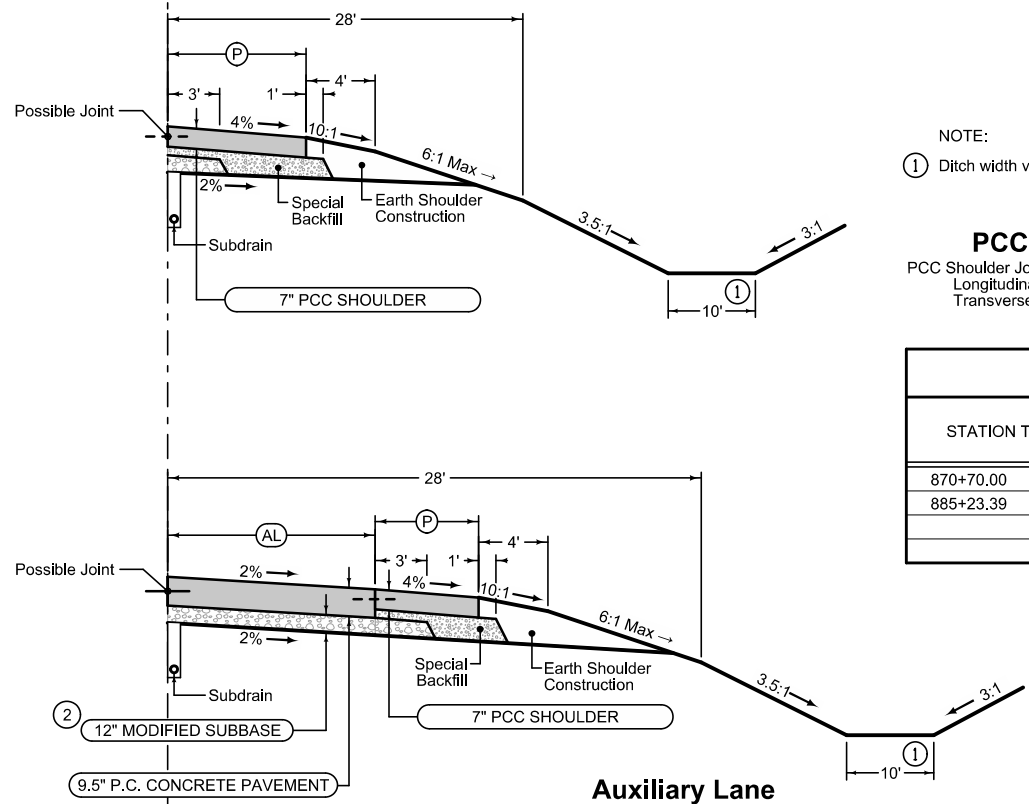

Auxiliary Lane

Longitudinal joint: L or KT
Transverse joint: Match Mainline

2_AuxLane_PCC_Modified		2_AL_Shldr_PCC_Modified	
STATION TO STATION	(AL) Feet	(P) Feet	
882+34.00	882+78.25	8.5'-12'	6'
882+78.25	883+76.66	12'	6'
883+76.66	883+95.73	12'	6'-8'


Auxiliary Lane PCC Shoulder

PCC Shoulder Jointing:
Longitudinal joint: BT-1 or BT-5
Transverse joints: C at 20' spacing

- NOTE:
- ① Ditch width and backslope varies, see cross sections.
 - ② Top 6" Modified Subbase Shall be of Virgin Material.

See Tab 100-24 or 100-25 for pavement quantities.
See Tab 112-9 for shoulder quantities.

US HIGHWAY 151

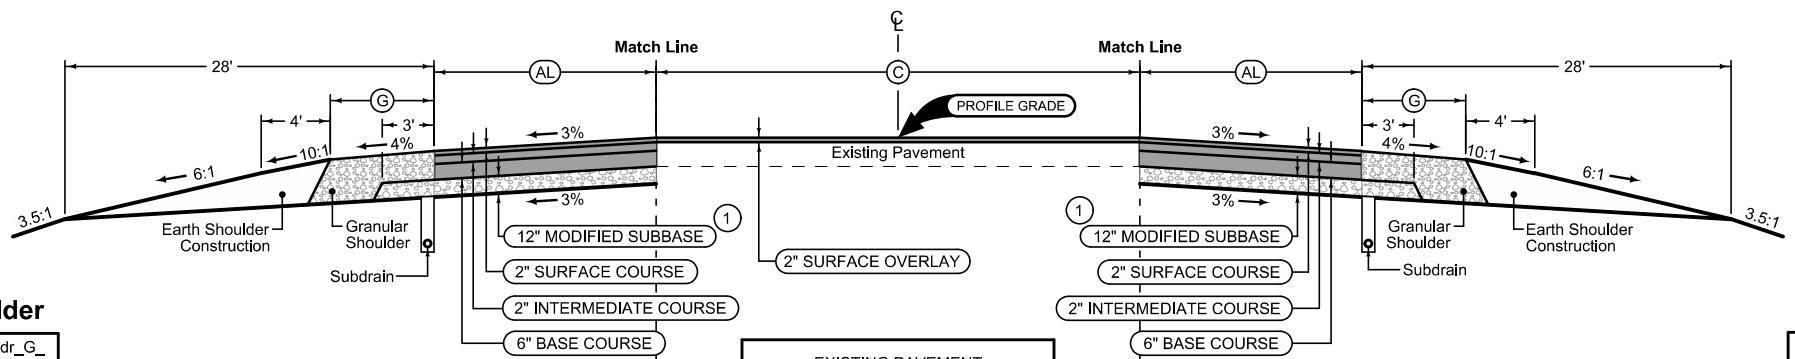

Auxiliary Lane Granular Shoulder
Longitudinal joint: B

2_AuxLane_HMA_10-18-16		2_AL_Shldr_G_Modified	
STATION TO STATION	AL Feet	G Feet	
898+00.00	900+09.70	5.2'-0"	6'
900+09.70	902+58.42	0'	6'

Note:
① Top 6" Modified Subbase Shall be of Virgin Material

EXISTING PAVEMENT

STATION TO STATION			C Feet
898+00.00	900+00.00	34'-38.3'	
900+00.00	902+58.42	38.3'-55.6'	


Note:
① Top 6" Modified Subbase Shall be of Virgin Material

Auxiliary Lane Granular Shoulder
Longitudinal joint: B

2_AuxLane_HMA_10-18-16		2_AL_Shldr_G_Modified	
STATION TO STATION	AL Feet	G Feet	
898+00.00	901+81.55	6.8'-1.7'	6'
901+81.55	902+58.42	1.7'-2"	6'

Combination Shoulder
Shoulder Jointing:
Longitudinal joint: B

2_C_Modified		P Feet	G Feet
974+22.81	974+69.65	0'-4"	6'
974+69.95	979+30.00	4'	6'
981+40.00	982+06.34	13.3'	0'
982+06.34	982+49.54	13.3'-15'	0'
982+49.54	982+76.24	15'	0'
982+76.24	984+83.16	4'	6'
984+83.16	985+76.45	0'	6'-0"

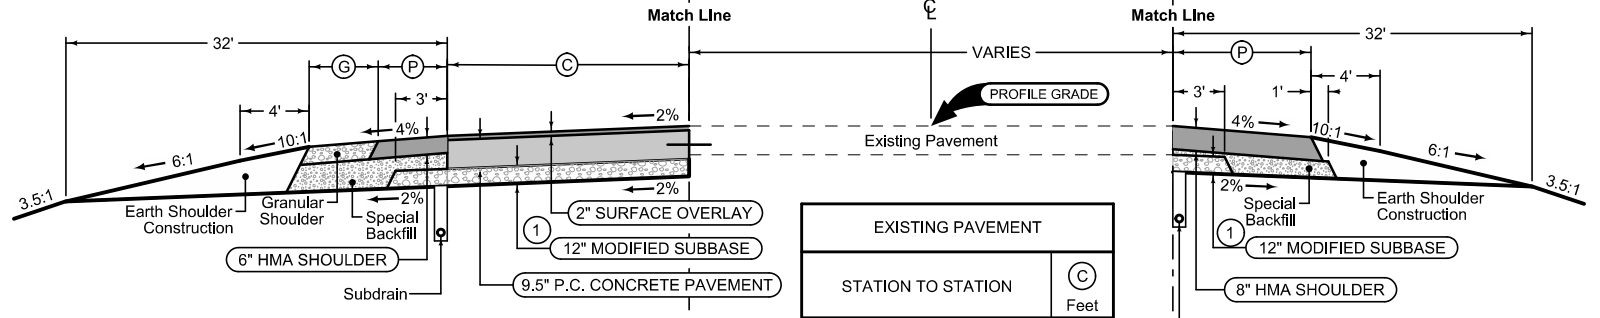

Note:
① Top 6" Modified Subbase Shall be of Virgin Material

EXISTING PAVEMENT

STATION TO STATION			C Feet
974+22.81	974+69.95	0'	
974+69.95	979+30.00	12'	
981+40.00	984+83.16	12'	
984+83.16	985+76.46	0'	


Note:
① Top 6" Modified Subbase Shall be of Virgin Material

HMA Shoulder
Shoulder Jointing:
Longitudinal joint: B

2_P_HMA_Modified		P Feet
977+55.34	977+81.50	0'
977+81.50	978+01.97	6.9'-5.2'
978+01.97	978+51.41	5.2'-3.2'
978+51.41	979+30.00	3.2'

Combination Shoulder
Shoulder Jointing:
Longitudinal joint: B

2_C_Modified		P Feet	G Feet
979+30.00	979+80.09	4'	6'
979+80.09	981+40.00	13.3'	0'

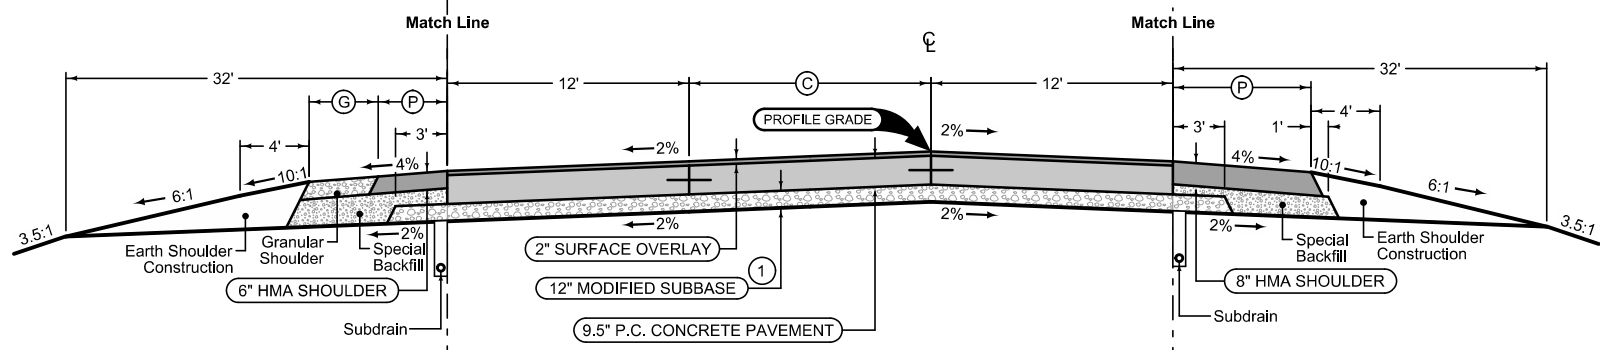

Note:
① Top 6" Modified Subbase Shall be of Virgin Material

Mainline Jointing:
Transverse joints: CD at 20' spacing
Longitudinal joint: L-2

2P_TWLT_Modified

STATION TO STATION			C Feet
979+30.00	981+40.00	16'	

HMA Shoulder
Shoulder Jointing:
Longitudinal joint: B

2_P_HMA_Modified		P Feet
979+30.00	980+65.15	13.3'
980+65.15	981+40.00	10'


See Tab 100-24 or 100-25 for pavement quantities.
See Tab 112-9 for shoulder quantities.

US HIGHWAY 151


Curbed Shoulder

Shoulder Jointing:
Longitudinal joint not required when distance from back of curb to nearest joint is less than 15':

Single pour: L-2
Staged: KT-2
Transverse: C at 15' spacing

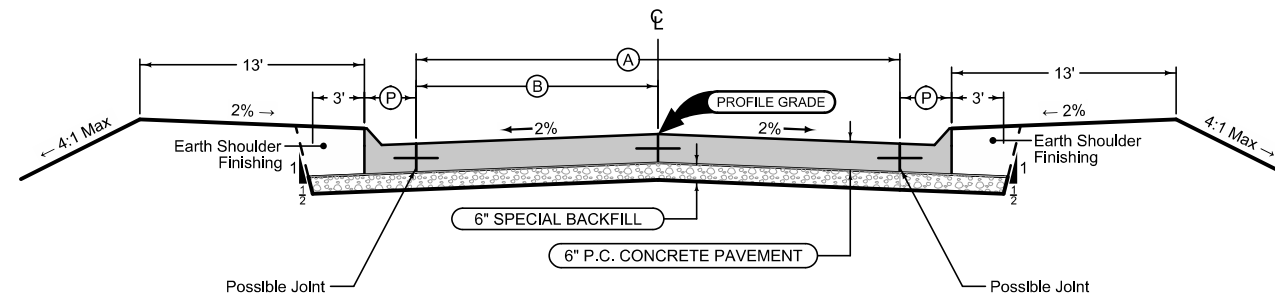

LOCATION		DIMENSIONS			2_Curb_Modified
ROAD IDENTIFICATION	STATION TO STATION	(A) Feet	(B) Feet	(P) Feet	Curb Type See PV-102
CHURCH STREET	1848+56.14 1849+04.97	36'	18'	3'	6" Std.
CHURCH STREET	1849+52.97 1850+11.77	31'	15.5'	3'	6" Std.
PRARIE AVENUE	2864+82.50 2865+30.81	23'	11.5'	2.5'	6" Std.

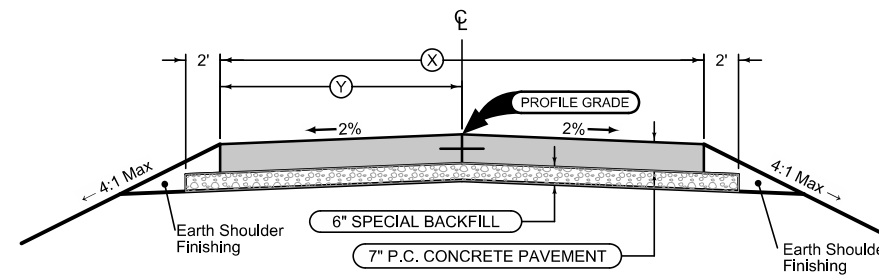


LOCATION		DIMENSIONS	
ROAD IDENTIFICATION	STATION TO STATION	(X) Feet	(Y) Feet
CHURCH STREET	1847+69.25 1848+56.14	36'	18'
CHURCH STREET	1850+11.77 1851+01.77	37'-25"	18.5'-12.5"
CHURCH STREET	1851+01.77 1851+25.00	25'	12.5'
PRAIRIE AVENUE	2865+30.81 2866+56.00	23'	11.5'
STALLMAN DRIVE	4874+25.00 4875+43.95	25'	12.5'
CEMETERY ROAD	5882+30.00 5883+60.60	25'	12.5'

Curbed Shoulder

Shoulder Jointing:
Longitudinal joint not required when distance from back of curb to nearest joint is less than 15':


Single pour: L-2
Staged: KT-2
Transverse: C at 15' spacing

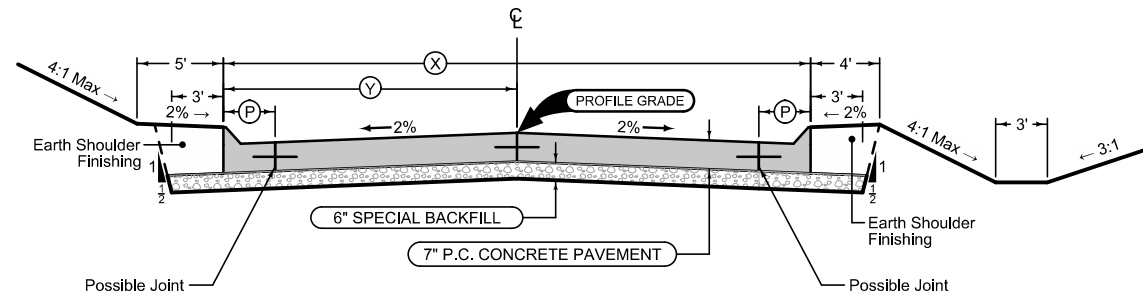

LOCATION		DIMENSIONS			2_Curb_Modified
ROAD IDENTIFICATION	STATION TO STATION	(X) Feet	(Y) Feet	(P) Feet	Curb Type See PV-102
LOSEY AVENUE	3862+86.45 3864+80.81	23'	11.5'	2.5'	6" Std.

Shoulder Jointing:
Longitudinal joint not required when distance from back of curb to nearest joint is less than 15':


Single pour: L-2
Staged: KT-2
Transverse: C at 15' spacing

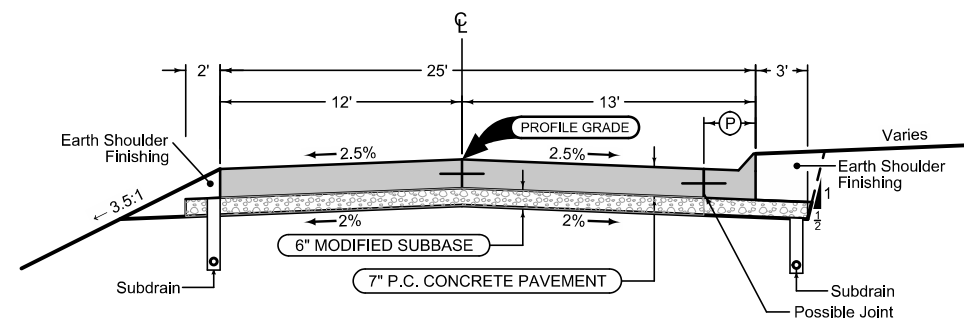

LOCATION		2_Curb_Modified	
ROAD IDENTIFICATION	STATION TO STATION	(P) Feet	Curb Type See PV-102
CEMETERY ROAD	5884+86.04 5885+42.00	2.5'	6" Std.


See Tab 100-24 for pavement quantities.

SIDERoads

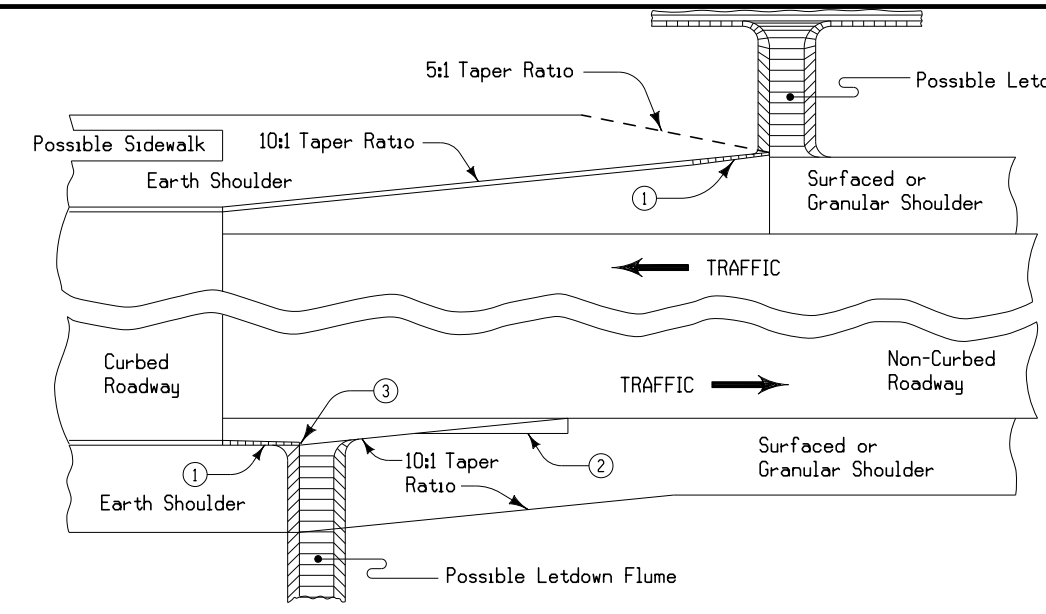


- ① Runout curb according to PV-102
- ② End of Taper Details see Typical Detail 7101
- ③ End earth shoulder at the end of the curb transition when no flume is needed.

**TRANSITION
BETWEEN CURBED AND
NON-CURBED ROADWAYS**

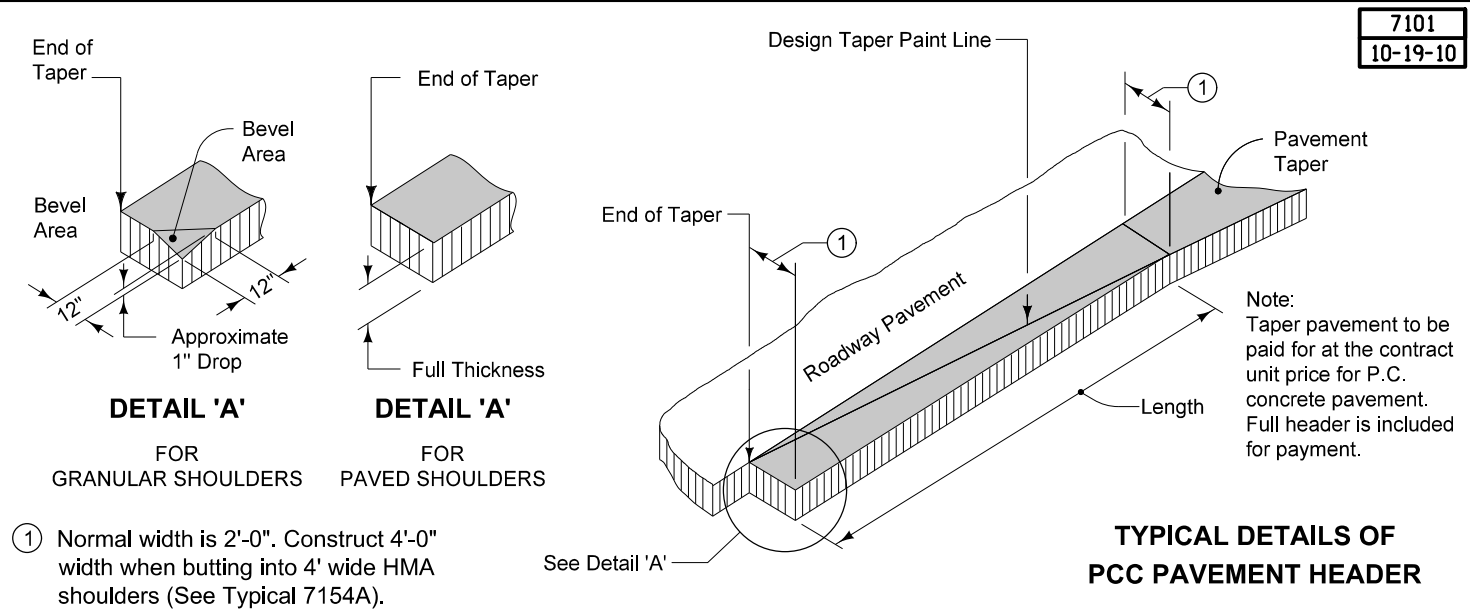

- ① Normal width is 2'-0". Construct 4'-0" width when butting into 4' wide HMA shoulders (See Typical 7154A).

**TYPICAL DETAILS OF
PCC PAVEMENT HEADER**

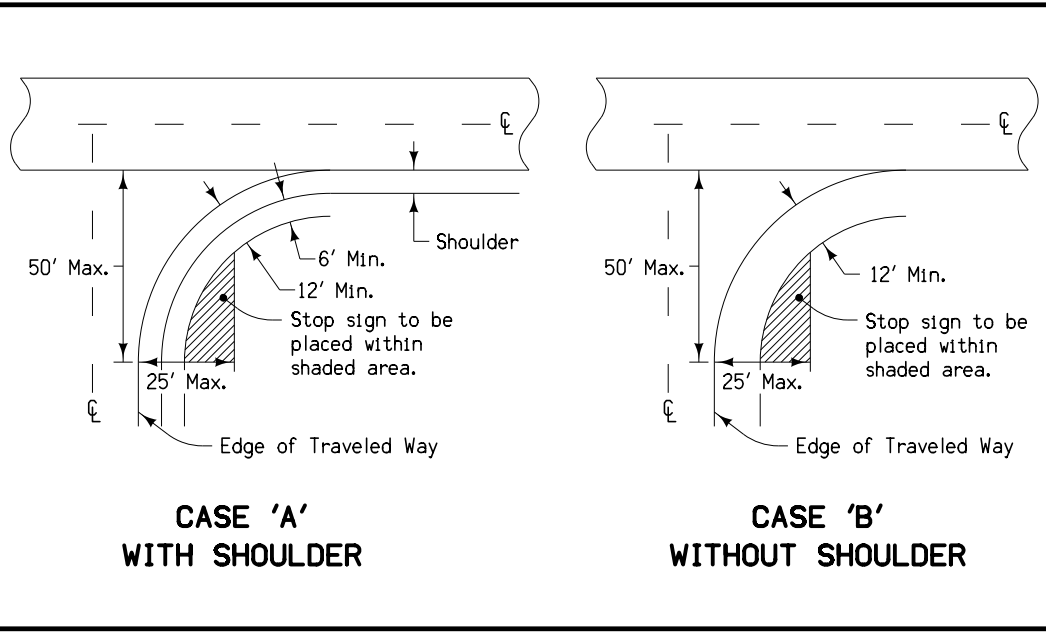

NOTES:

Stop signs should be confined to the shaded areas, but as close to the approach roadway as possible to provide the motorist with the best visual impact.

If possible, stop signs should be placed at the point where vehicles are to stop or as near as practical.


In rural areas, the lateral clearance should not be closer than 6' from the edge of a usable shoulder, or if none, 12' from edge of the traveled way.

In urban areas, stop signs should be placed a minimum of 6' from the near edge of the intersected street or a minimum of 4' in advance of the near edge of a marked crosswalk. Lateral clearance may be reduced to a minimum of 2' from the face of a curb.

Where the approach roadway consists of two lanes of traffic, a second stop sign should be placed where it is visible to traffic in the inner lane.

At channelized intersections, the additional stop sign may be placed on a channelized island or median.


STOP SIGN PLACEMENT

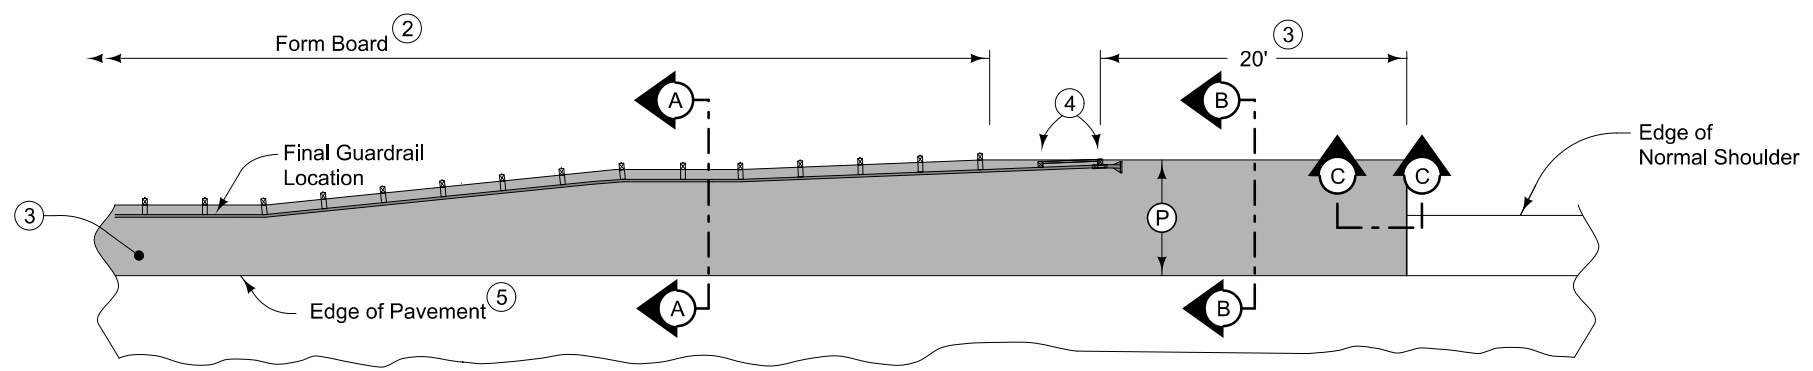


PLAN VIEW

Compaction of HMA is required to face of guardrail post. Hand compaction will be allowed under guardrail. Removal and reinstallation of guardrail will be allowed with no additional payment.
Refer to Tabulation 112-9 for shoulder quantities.

- ① For subgrade treatment, refer to other details in the plan.
- ② PCC: When guardrail posts are installed prior to construction of PCC paved shoulder, fasten form board to the face of guardrail posts for the length shown. Refer to note 4 for final 2 posts.
- ③ Continue paved shoulder to existing paved shoulder or 20 feet beyond the center of the first post.
- ④ Shoulder may be notched for final 2 posts or post sleeves may be installed through pavement. Do not drive posts through pavement.
- ⑤ 'KT-1 joint for PCC shoulder.
'B' joint for HMA shoulder.

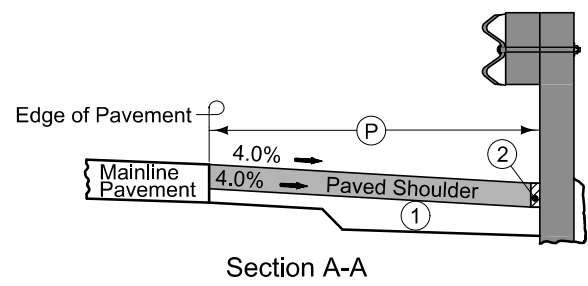


Section A-A

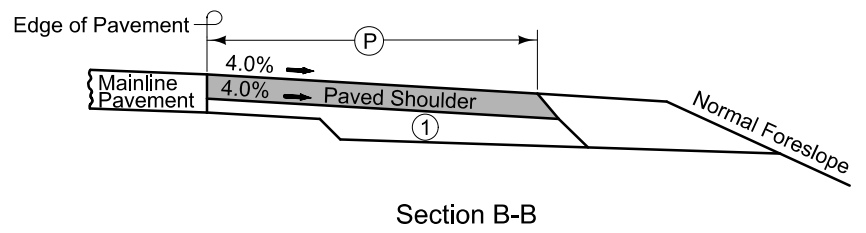


Section B-B

NEW CONSTRUCTION

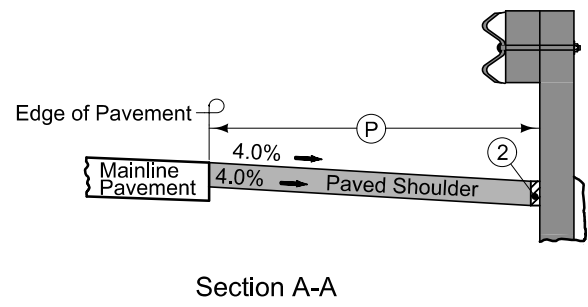


Section A-A

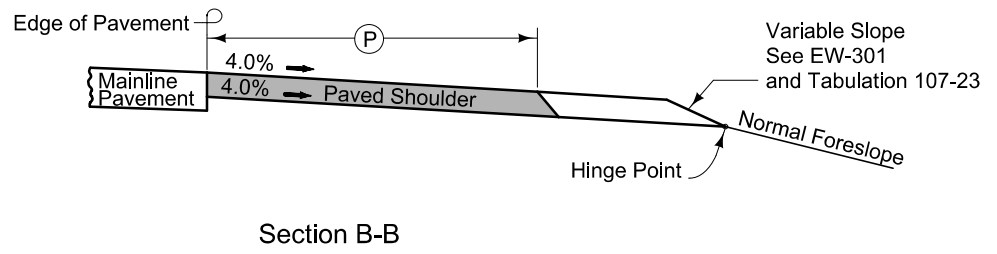

Section B-B

EXISTING SHOULDER

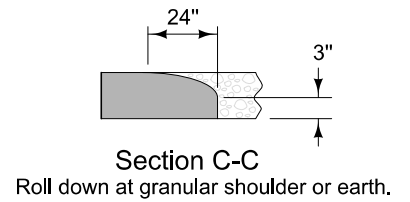

Section C-C

Roll down at granular shoulder or earth.


PAVED SHOULDER AT GUARDRAIL

LOCATION			DIMENSIONS						6" Special Backfill	Earth Shoulder Construction	Area
ROAD IDENTIFICATION	STATION TO STATION		HMA			PCC					
	PW Feet	T Inches	SGW Feet	PW Feet	T Inches	SGW Feet	6" Special Backfill	Earth Shoulder Construction			
Hwy 151 - Stage 1C	869+08.50	870+79.40	0-21	9	0-27.3	0-21	8	0-26.9	41	1.71	1,901.8
	870+79.40	877+08.33	21	9	27.3	21	8	26.9	455	6.29	
	877+08.33	877+82.62	21-15.5	9	27.3-21.8	21-15.5	8	26.9-21.4	47	0.74	
	877+82.62	878+58.49	15.5-7.5	9	21.8-13.8	15.5-7.5	8	21.4-13.4	31	0.76	
	878+58.49	879+14.71	7.5-6	9	13.8-12.3	7.5-6	8	13.4-11.9	14	0.56	
Hwy 151 - Stage 1C	882+63.44	883+85.91	0-7.4	9	0-13.7	0-7.4	8	0-13.3	15	1.22	46.6
	883+85.91	883+99.64	1.1-0	9	7.4-0	1.1-0	8	7-0	2	0.14	
Hwy 151 - Stage 1C	884+99.85	885+73.34	0-21	9	0-27.3	0-21	8	0-26.9	37	0.73	1,258.5
	885+73.34	890+52.10	21	9	27.3	21	8	26.9	346	4.79	
	890+52.10	890+92.18	12.1-0	9	18.4-0	12.1-0	8	18-0	16	0.40	
Hwy 151 - Stage 1C	891+27.79	891+39.51	0-12.5	9	0-18.8	0-12.5	8	0-18.4	3	0.12	593.1
	891+39.51	893+78.67	21	9	27.3	21	8	26.9	176	2.39	
	893+78.67	893+96.76	19-0	9	25.3-0	19-0	8	24.9-0	9	0.18	
Hwy 151 - Stage 1C	894+37.55	894+56.81	0-19	9	0-25.3	0-19	8	0-24.9	10	0.19	247.1
	894+56.81	895+38.01	21	9	25.3	21	8	24.9	60	0.81	
	895+38.01	895+56.49	19-0	9	25.3-0	19-0	8	24.9-0	10	0.18	
Hwy 151 - Stage 1C	895+98.24	896+18.20	0-18.5	9	0-24.8	0-18.5	8	0-4.4	10	0.20	1,110.3
	896+18.20	898+00.16	20.5	9	26.8	20.5	8	26.4	133	1.82	
	898+00.16	899+40.00	20.5-13.5	9	26.8-19.8	20.5-13.5	8	26.4-19.4	84	1.40	
	899+40.00	900+97.41	13.5	9	19.8	13.5	8	19.4	75	1.57	
	900+97.41	902+84.49	13.5-0	9	19.8-0	13.5-0	8	19.4-0	48	1.87	
Hwy 151 - Stage 2A	860+81.21	863+59.72	0-17.5	9	0-23.8	0-17.5	8	0-23.4	86	2.79	720.4
	863+59.72	864+64.09	17.5-16.5	9	23.8-22.8	17.5-16.5	8	23.4-22.4	63	1.04	
	864+64.09	865+98.61	16.5-17	9	22.8-23.3	16.5-17	8	22.4-22.9	80	1.35	
Hwy 151 - Stage 2A	868+76.20	870+70.00	18	9	24.3	18	8	23.9	123	1.94	439.2
	870+70.00	872+09.69	8-0	9	14.3-0	8-0	8	13.9-0	16	1.40	
Hwy 151 - Stage 2A	876+23.77	876+99.08	0-8	9	0-8.8	0-2.5	8	0-8.4	14	0.75	325.4
	876+99.08	878+42.11	8	9	14.3	8	8	13.9	41	1.43	
	878+42.11	879+40.54	8-13.2	9	14.3-19.5	8-13.2	8	13.9-19.1	36	0.98	
	879+40.54	879+68.00	13.2	9	19.5	13.2	8	19.1	13	0.27	
Hwy 151 - Stage 2A	882+04.00	882+45.25	13.2	9	19.5	13.2	8	19.1	20	0.41	176.0
	882+45.25	883+41.78	13.2-8	9	19.5-14.3	13.2-8.05	8	19.1-13.9	36	0.97	
	883+41.78	883+46.75	8-0	9	14.3-0	8-0	8	13.9-0	1	0.05	
Hwy 151 - Stage 2B	898+00.00	901+97.45	6-0	9	12.3-0	8-0	8	11.9-0	287	3.97	203.1
Total:									2,438	45.42	7,021.5

Quantity calculations based on vertical pavement edges.

Normal section shown may be modified appropriately in areas of superelevated curves or other locations specifically designated by the Engineer.

- ① Possible HMA 1:1 slope
- ② Match Existing Pavement Slope

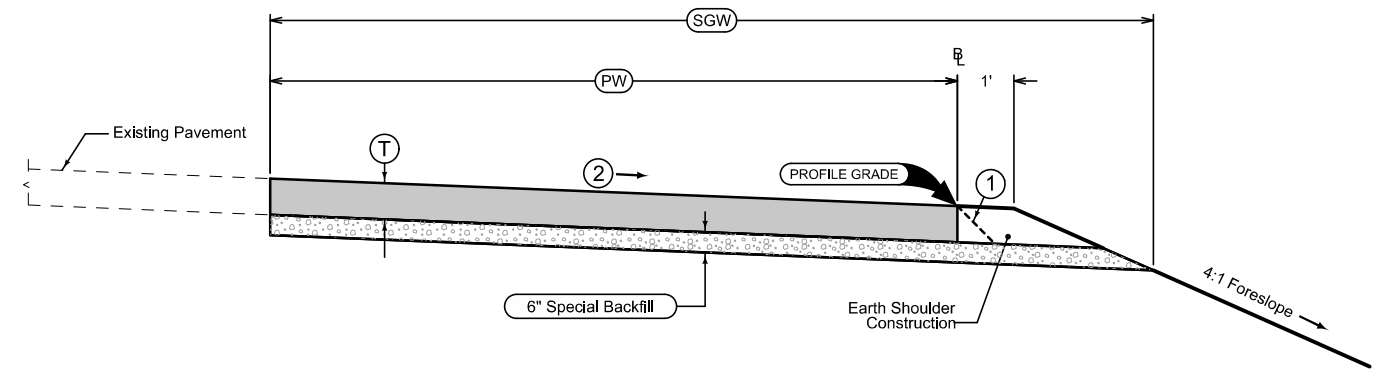

DETOUR PAVING AT STAGE 1C AND STAGE 2A


D_Detour A
Modified

LOCATION			DIMENSIONS						6" Special Backfill	Earth Shoulder Construction	Area
ROAD IDENTIFICATION	STATION TO STATION		HMA			PCC					
	PW Feet	T Inches	SGW Feet	PW Feet	T Inches	SGW Feet	6" Special Backfill	Earth Shoulder Construction			
Hwy 151 - DD No. 2	1978+22.02	1979+03.23	0-24	9	0-28	0-24	8	0-27.7	37	0.81	1,124.8
	1979+03.23	1980+76.44	24	9	28-32.7	24	8	27.7-32.1	146	3.46	
	1980+76.44	1982+12.34	24-0	9	28-0	24-0	8	27.7-0	60	1.36	
Total:									243	5.63	1,124.8

Quantity calculations based on vertical pavement edges.

Normal section shown may be modified appropriately in areas of superelevated curves or other locations specifically designated by the Engineer.


- ① Possible HMA 1:1 slope

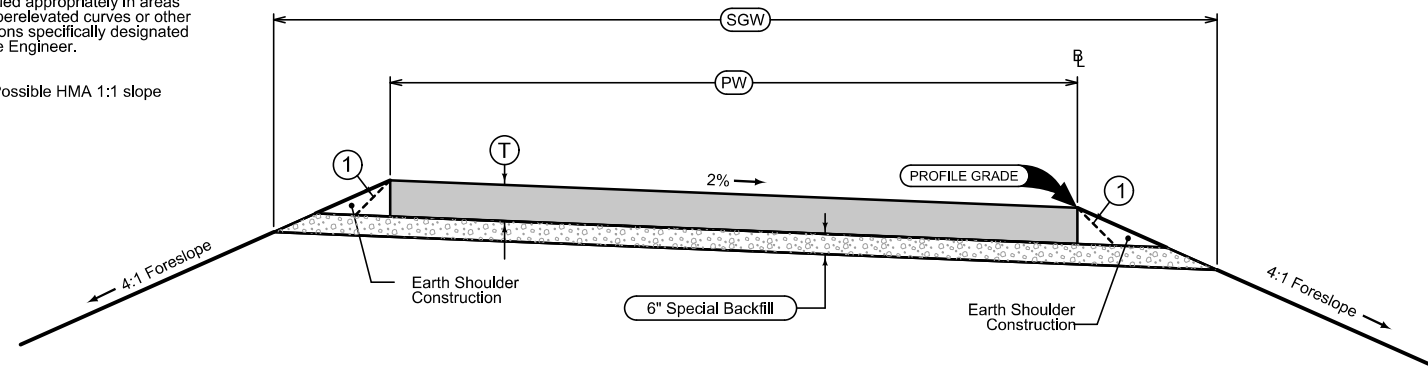

DETOUR PAVING AT DRAINAGE DITCH #2


D_Detour B
Modified

Flume

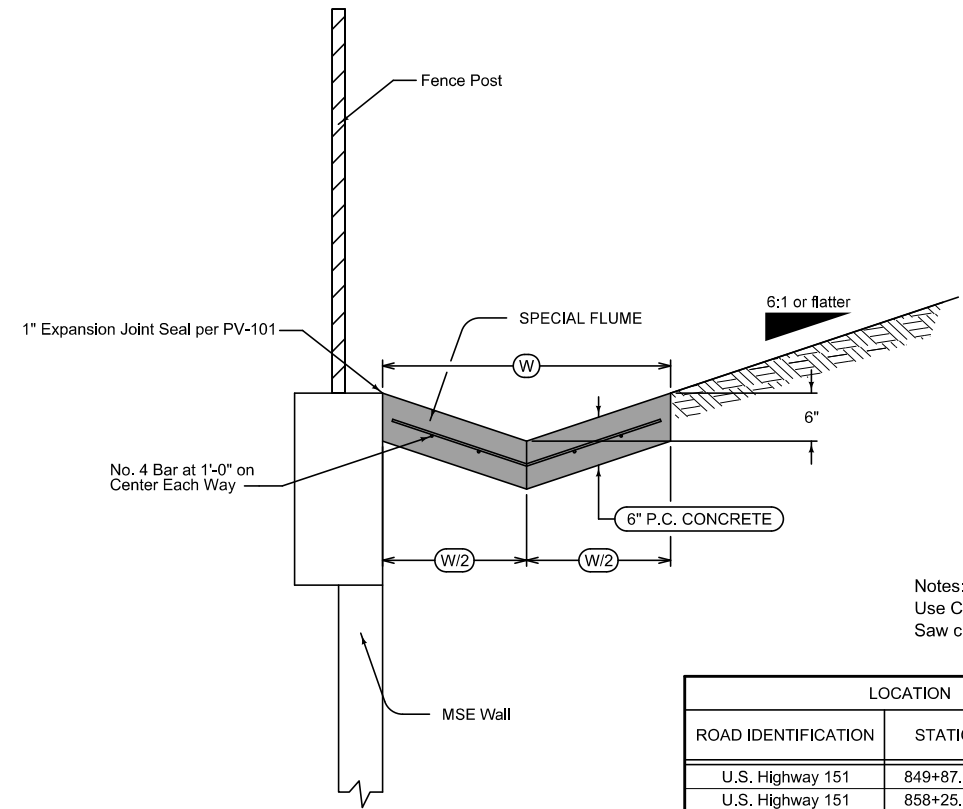

Notes:
Use Class C Concrete.
Saw cut Transverse Joints at 8'-0" on Center.


LOCATION				DIMENSIONS		REMARKS
ROAD IDENTIFICATION	STATION TO STATION		SIDE	LENGTH	WIDTH (W)	
U.S. Highway 151	849+87.80	856+66.00	RT	678.2'	4'	MSE Wall No. 1
U.S. Highway 151	858+25.00	863+52.00	RT	527.0'	4'	MSE Wall No. 2
U.S. Highway 151	858+56.40	863+42.00	LT	485.6'	4'	MSE Wall No. 3

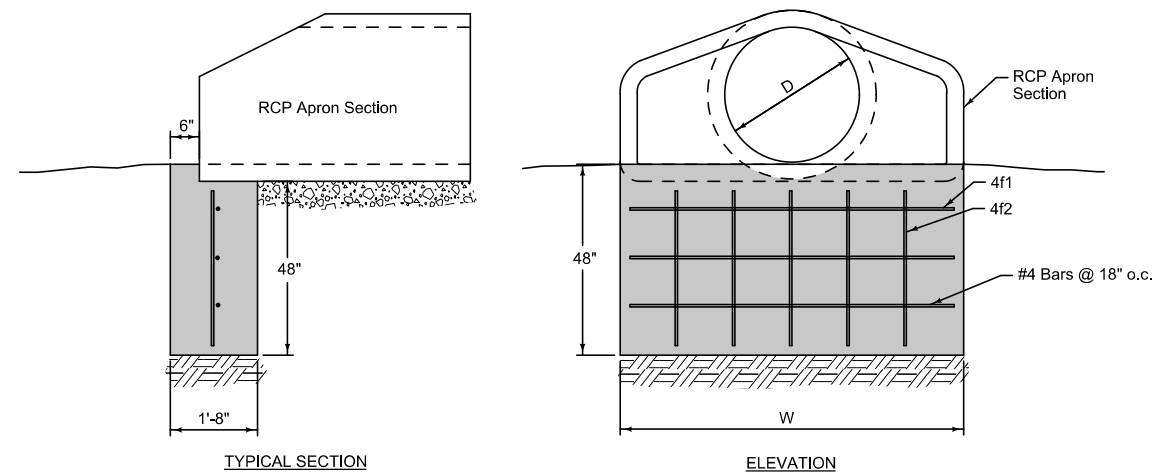

REINFORCING BAR LIST

D	W	Mark	Size	Length	Count	D	W	Mark	Size	Length	Count
12"	2'-4"	4f1	4	2'-0"	3	48"	7'-10"	4f1	4	7'-6"	3
		4f2	4	3'-8"	2			4f2	4	3'-8"	6
15"	2'-10 1/2"	4f1	4	2'-6 1/2"	3	54"	8'-5"	4f1	4	8'-1"	3
		4f2	4	3'-8"	2	4f2	4	3'-8"	6		
18"	3'-5"	4f1	4	3'-1"	3	60"	8'-11"	4f1	4	8'-7"	3
		4f2	4	3'-8"	3	4f2	4	3'-8"	6		
24"	4'-6"	4f1	4	4'-2"	3	66"	8'-11"	4f1	4	8'-7"	3
		4f2	4	3'-8"	3	4f2	4	3'-8"	6		
30"	5'-7"	4f1	4	5'-3"	3	72"	10'-0"	4f1	4	9'-8"	3
		4f2	4	3'-8"	4	4f2	4	3'-8"	7		
36"	6'-8"	4f1	4	6'-4"	3	78"	10'-7"	4f1	4	10'-3"	3
		4f2	4	3'-8"	5	4f2	4	3'-8"	7		
42"	7'-3"	4f1	4	6'-11"	3	84"	11'-1"	4f1	4	10'-9"	3
		4f2	4	3'-8"	5	4f2	4	3'-8"	8		

FIGURE 4030.221 SHEET 1 OF 1


SUDAS
 SUDAS Standard Specifications
 RCP APRON SECTION FOOTING

REVISION	1	10-21-14
4030.221		SHEET 1 of 1

**ESTIMATED PROJECT QUANTITIES
(UP TO A 5 DIVISION PROJECT)**

Division 1: State Funding
Division 2: City of Fairfax Funding
Division 3: State/City of Fairfax Shared Funding
Division 4: City of Cedar Rapids Funding
Division 5: Retaining Wall Design No. 918

Item No.	Item Code	Item	Unit	Estimated Quantities						As Built					
				Division 1	Division 2	Division 3	Division 4	Division 5	Total	Division 1	Division 2	Division 3	Division 4	Division 5	
				1	2101-0850001	CLEARING & GRUBBING	ACRE	2.8						2.8	
2	2101-0850002	CLEARING & GRUBBING	UNIT	131						131					
3	2102-0425070	SPECIAL BACKFILL	TON	6868.8	81.1					6949.9					
4	2102-2625001	EMBANKMENT-IN-PLACE, CONTRACTOR FURNISHED	CY	4778						4778					
5	2102-2710070	EXCAVATION CLASS 10, ROADWAY & BORROW	CY	79102	169					79271					
6	2102-2712015	EXCAVATION, CLASS 12, BOULDERS OR ROCK FRAGMENTS	CY	50						50					
7	2105-8425005	TOPSOIL, FURNISH AND SPREAD	CY	4099						4099					
8	2105-8425015	TOPSOIL, STRIP, SALVAGE AND SPREAD	CY	11492	47					11539					
9	2107-0875100	COMPACTION WITH MOISTURE CONTROL	CY	59691						59691					
10	2107-3825025	GRANULAR MATERIAL FOR BLANKET AND SUBDRAIN	CY	2361						2361					
11	2115-0100000	MODIFIED SUBBASE	CY	16116.2						16116.2					
12	2121-7425010	GRANULAR SHOULDERS, TYPE A	TON	846.7						846.7					
13	2122-5190007	PAVED SHOULDER, P.C. CONCRETE, 7 IN.	SY	4544.4						4544.4					
14	2122-5500060	PAVED SHOULDER, HOT MIX ASPHALT MIXTURE, 6 IN.	SY	776.1						776.1					
15	2122-5500080	PAVED SHOULDER, HOT MIX ASPHALT MIXTURE, 8 IN.	SY	347.4						347.4					
16	2123-7450000	SHOULDER CONSTRUCTION, EARTH	STA	120.85						120.85					
17	2123-7450020	SHOULDER FINISHING, EARTH	STA	120.85						120.85					
18	2213-7100400	RELOCATION OF MAIL BOXES	EACH	10						10					
19	2214-5145150	PAVEMENT SCARIFICATION	SY	576.1						576.1					
20	2301-0690203	BRIDGE APPROACH, BR-203	SY	1678.6						1678.6					
21	2301-0690205	BRIDGE APPROACH, BR-205	SY	1188.8						1188.8					
22	2301-1033070	STD OR SLIP FORM PCC PAVEMENT, CLASS C, CLASS 2 DURABILITY, 7 IN.	SY	4131.6	347.6					4479.2					
23	2301-1033095	STD OR SLIP FORM PCC PAVEMENT, CLASS C, CLASS 3 DURABILITY, 9.5 IN.	SY	21572.7						21572.7					
24	2301-6911722	PORTLAND CEMENT CONCRETE PAVEMENT SAMPLES	LS	1						1					
25	2303-1041500	HOT MIX ASPHALT HIGH TRAFFIC, BASE COURSE, 1/2 IN. MIX	TON	129.9						129.9					
26	2303-1042500	HOT MIX ASPHALT HIGH TRAFFIC, INTERMEDIATE COURSE, 1/2 IN. MIX	TON	43.3						43.3					
27	2303-1043502	HOT MIX ASPHALT HIGH TRAFFIC, SURFACE COURSE, 1/2 IN. MIX, FRICTION L-2	TON	546.1						546.1					
28	2303-1258284	ASPHALT BINDER, PG 58-28H, HIGH TRAFFIC	TON	43.2						43.2					
29	2304-0100000	DETOUR PAVEMENT	SY	8146.3						8146.3					
30	2315-8275025	SURFACING, DRIVEWAY, CLASS A CRUSHED STONE	TON	414						414					
31	2401-6750001	REMOVALS, AS PER PLAN	LS	1						1					
32	2402-0425030	GRANULAR BACKFILL	TON	54423.4						54423.4					
33	2402-0425040	FLOODED BACKFILL	CY	285.2						285.2					
34	2402-2720100	EXCAVATION, CLASS 20, FOR ROADWAY PIPE CULVERT	CY	975.5						975.5					
35	2403-0100000	STRUCTURAL CONCRETE (MISCELLANEOUS)	CY			1.4				1.4					
36	2404-7775000	REINFORCING STEEL	LB			21				21					
37	2412-0000100	LONGITUDINAL GROOVING IN CONCRETE	SY	5485						5485					
38	2416-0100012	APRONS, CONCRETE, 12 IN. DIA.	EACH		2					2					
39	2416-0100015	APRONS, CONCRETE, 15 IN. DIA.	EACH	1	1					2					
40	2416-0100018	APRONS, CONCRETE, 18 IN. DIA.	EACH	2		1				3					
41	2416-0100030	APRONS, CONCRETE, 30 IN. DIA.	EACH			1				1					
42	2416-0100042	APRONS, CONCRETE, 42 IN. DIA.	EACH	4						4					
43	2416-0101136	REMOVE AND REINSTALL CONCRETE PIPE APRONS GREATER THAT 36 IN.	EACH	1						1					
44	2416-1160030	CULVERT, CONCRETE ENTRANCE PIPE, 30 INCH	LF	56						56					
45	2416-1180042	CULVERT, CONCRETE ROADWAY PIPE, 42 INCH	LF	244						244					
46	2416-1180048	CULVERT, CONCRETE ROADWAY PIPE, 48 INCH	LF	2						2					
47	2417-0225012	APRONS, METAL, 12 IN. DIA.	EACH	2						2					
48	2417-0225018	APRONS, METAL, 18 IN. DIA.	EACH	6						6					
49	2417-1007000	CORRUGATED PIPE CULVERT, ENTRANCE PIPE, 12 IN. DIA.	LF	28						28					
50	2417-1040018	CULVERT, CORRUGATED METAL ENTRANCE PIPE, 18 IN. DIA.	LF	150						150					
51	2432-0000100	MECHANICALLY STABILIZED EARTH RETAINING WALL	SF	31998						31998					
52	2435-0130148	MANHOLE, SANITARY SEWER, SW-301, 48 IN.	EACH		1					1					
53	2435-0130160	MANHOLE, SANITARY SEWER, SW-301, 60 IN.	EACH				4			4					
54	2435-0140148	MANHOLE, STORM SEWER, SW-401, 48 IN.	EACH	1	1					2					
55	2435-0140172	MANHOLE, STORM SEWER, SW-401, 72 IN.	EACH			1				1					
56	2435-0250700	INTAKE, SW-507	EACH		1					1					
57	2435-0250900	INTAKE, SW-509	EACH	12		1				13					
58	2435-0251000	INTAKE, SW-510	EACH	3						3					
59	2435-0251230	INTAKE, SW-512, 30 IN.	EACH			1				1					
60	2435-0251300	INTAKE, SW-513	EACH	3	1					4					
61	2435-0600020	MANHOLE ADJUSTMENT, MAJOR	EACH		5					5					
62	2435-0700010	CONNECTION TO EXISTING MANHOLE	EACH		1		1			2					
63	2435-0700020	CONNECTION TO EXISTING INTAKE	EACH					1		1					
64	2499-3575000	SPECIAL FLUME	EACH	3						3					
65	2501-8400172	TEMPORARY SHORING	LS	1						1					
66	2502-8212034	SUBDRAIN, LONGITUDINAL, (SHOULDER), 4 IN. DIA.	LF	10826						10826					
67	2502-8221303	SUBDRAIN OUTLET, DR-303	EACH	32						32					
68	2502-8221305	SUBDRAIN OUTLET, DR-305	EACH	36						36					
69	2503-0114212	STORM SEWER GRAVITY MAIN, TRENCHED, RCP, 2000D (CLASS III), 12 IN.	LF		82					82					
70	2503-0114215	STORM SEWER GRAVITY MAIN, TRENCHED, RCP, 2000D (CLASS III), 15 IN.	LF	820	66	528				1414					
71	2503-0114218	STORM SEWER GRAVITY MAIN, TRENCHED, RCP, 2000D (CLASS III), 18 IN.	LF	200		262				462					
72	2503-0114224	STORM SEWER GRAVITY MAIN, TRENCHED, RCP, 2000D (CLASS III), 24 IN.	LF	62	106					168					
73	2503-0114230	STORM SEWER GRAVITY MAIN, TRENCHED, RCP, 2000D (CLASS III), 30 IN.	LF	46		362				408					
74	2503-0200036	REMOVE STORM SEWER PIPE LESS THAN OR EQUAL TO 36 IN.	LF	1331						1331					
75	2503-0500401	BRIDGE END DRAIN, DR-401	EACH	6						6					
76	2504-0114010	SANITARY SEWER GRAVITY MAIN, TRENCHED, POLYVINYL CHLORIDE PIPE (PVC), 10 IN.	LF		146					146					
77	2504-0116024	SANITARY SEWER GRAVITY MAIN, TRENCHED, DUCTILE IRON PIPE (DIP), 24 IN.	LF				277			277					
78	2504-0146024	SAN. SWR. GTY. MAIN WITH CASING PIPE, TRENCHLESS, DUCTILE IRON PIPE (DIP), 24 IN.	LF				155			155					
79	2504-0240036	REMOVE SANITARY SEWER PIPE LESS THAN OR EQUAL TO 36 IN.	LF				100			100					
80	2504-0240236	SANITARY SEWER ABANDONMENT, FILL AND PLUG, LESS THAN OR EQUAL TO 36 IN. DIA.	LF				246			246					

**ESTIMATED PROJECT QUANTITIES
(UP TO A 5 DIVISION PROJECT)**

Division 1: State Funding
Division 2: City of Fairfax Funding
Division 3: State/City of Fairfax Shared Funding
Division 4: City of Cedar Rapids Funding
Division 5: Retaining Wall Design No. 918

Item No.	Item Code	Item	Unit	Estimated Quantities						As Built					
				Division 1	Division 2	Division 3	Division 4	Division 5	Total	Division 1	Division 2	Division 3	Division 4	Division 5	
				81	2505-4008120	REMOVAL OF STEEL BEAM GUARDRAIL	LF	2596.4						2596.4	
82	2505-4008300	STEEL BEAM GUARDRAIL	LF	1562.5						1562.5					
83	2505-4008410	STEEL BEAM GUARDRAIL BARRIER TRANSITION SECTION, BA-201	EACH	8						8					
84	2505-4021010	STEEL BEAM GUARDRAIL END ANCHOR, BOLTED	EACH	8						8					
85	2505-4021020	STEEL BEAM GUARDRAIL END ANCHOR, W-BEAM	EACH	2						2					
86	2505-4021720	STEEL BEAM GUARDRAIL TANGENT END TERMINAL, BA-205	EACH	10						10					
87	2505-4502100	STEEL BEAM GUARDRAIL, POST ADAPTER UNIT, BA-210	EACH	22						22					
88	2507-3250005	ENGINEERING FABRIC	SY	409.6						409.6					
89	2507-6800061	REVTMENT, CLASS E	TON	399.5						399.5					
90	2510-6745850	REMOVAL OF PAVEMENT	SY	33775.8						33775.8					
91	2510-6750600	REMOVAL OF INTAKES AND UTILITY ACCESSES	EACH	13					3	16					
92	2511-6745900	REMOVAL OF SIDEWALK	SY	49.8						49.8					
93	2511-7526004	SIDEWALK, P.C. CONCRETE, 4 IN.	SY	60.3						60.3					
94	2515-2475006	DRIVEWAY, P.C. CONCRETE, 6 IN.	SY	2739.4						2739.4					
95	2515-6745600	REMOVAL OF PAVED DRIVEWAY	SY	1907.3						1907.3					
96	2518-6910000	SAFETY CLOSURE	EACH	47						47					
97	2519-1004072	FENCE, CHAIN LINK, 72 IN. HEIGHT, ON WALL	LF	1782.5						1782.5					
98	2519-4200190	REMOVAL OF FENCE, AS PER PLAN	LF	155.1						155.1					
99	2526-8285000	CONSTRUCTION SURVEY	LS	0.93	0.04		0.03			1					
100	2527-9263109	PAINTED PAVEMENT MARKING WATERBORNE OR SOLVENT-BASED	STA	312.1						312.1					
101	2527-9263131	WET RETROREFLECTIVE REMOVABLE TAPE MARKINGS	LF	548.93						548.93					
102	2527-9263137	PAINTED SYMBOLS AND LEGENDS, WATERBORNE OR SOLVENT-BASED	EACH	43						43					
103	2527-9263158	PAVEMENT MARKINGS REMOVED	STA	380.93						380.93					
104	2528-8400048	TEMPORARY BARRIER RAIL, CONCRETE	LF	11825						11825					
105	2528-8400157	TEMPORARY FLOODLIGHTING LUMINAIRE	EACH	2						2					
106	2528-8400256	TEMPORARY TRAFFIC SIGNALS	EACH	5						5					
107	2528-8445110	TRAFFIC CONTROL	LS	0.93	0.04		0.03			1					
108	2528-8445113	FLAGGERS	EACH												
109	2528-8445115	PILOT CARS	EACH												
110	2528-9109020	TEMPORARY LANE SEPARATOR SYSTEM	LF	1764						1764					
111	2529-5070110	PATCHES, FULL DEPTH FINISH, BY AREA	SY	80						80					
112	2529-5070120	PATCHES, FULL DEPTH FINISH, BY COUNT	EACH	2						2					
113	2533-4980005	MOBILIZATION	LS	0.93	0.04		0.03			1					
114	2551-0000110	TEMPORARY CRASH CUSHION	EACH	3						3					
115	2551-0000130	TEMPORARY CRASH CUSHION, SEVERE USE (SU)	EACH	31						31					
116	2552-0000230	SPECIAL PIPE EMBEDMENT OR ENCASEMENT	LF				95			95					
117	2552-0000300	TRENCH COMPACTION TESTING	LS				1			1					
118	2554-0114008	WATER MAIN, TRENCHED, POLYVINYL CHLORIDE PIPE (PVC), 8 IN.	LF		45					45					
119	2554-0114012	WATER MAIN, TRENCHED, POLYVINYL CHLORIDE PIPE (PVC), 12 IN.	LF		15					15					
120	2554-0134008	WATER MAIN WITH CASING PIPE, TRENCHED, POLYVINYL CHLORIDE PIPE (PVC), 8 IN.	LF		84					84					
121	2554-0134012	WATER MAIN WITH CASING PIPE, TRENCHED, POLYVINYL CHLORIDE PIPE (PVC), 12 IN.	LF		130					130					
122	2554-0207008	VALVE, GATE, DIP, 8 IN.	EACH		2					2					
123	2554-0207012	VALVE, GATE, DIP, 12 IN.	EACH		2					2					
124	2554-0210201	FIRE HYDRANT ASSEMBLY, WM-201	EACH		6					6					
125	2554-0214000	FIRE HYDRANT ADJUSTMENT	EACH		5					5					
126	2595-0005150	RAILROAD PROTECTIVE LIABILITY INSURANCE FOR UNION PACIFIC RAILROAD CO.	LS	1						1					
127	2599-9999010	INTERMEDIATE FOUNDATION IMPROVEMENTS	LS	1						1					
128	2599-9999010	INTERMEDIATE FOUNDATION IMPROVEMENTS VERIFICATION TESTING	LS	1						1					
129	2601-2634100	MULCHING	ACRE	12.6						12.6					
130	2601-2634105	MULCHING, BONDED FIBER MATRIX	ACRE	12.6						12.6					
131	2601-2636015	NATIVE GRASS SEEDING	ACRE	5.9						5.9					
132	2601-2636043	SEEDING AND FERTILIZING (RURAL)	ACRE	0.9						0.9					
133	2601-2636044	SEEDING AND FERTILIZING (URBAN)	ACRE	5.8						5.8					
134	2601-2638352	SLOPE PROTECTION, WOOD EXCELSIOR MAT	SQ	1539						1539					
135	2601-2642100	STABILIZE CROP - SEEDING AND FERTILIZING	ACRE	12.6						12.6					
136	2601-2643110	WATERING FOR SOD, SPECIAL DITCH CONTROL, OR SLOPE PROTECTION	MGAL	307.8						307.8					
137	2601-2643300	MOBILIZATION FOR WATERING	EACH	3						3					
138	2602-0000020	SILT FENCE	LF	7540						7540					
139	2602-0000030	SILT FENCE FOR DITCH CHECKS	LF	1880						1880					
140	2602-0000071	REMOVAL OF SILT FENCE OR SILT FENCE FOR DITCH CHECKS	LF	4519						4519					
141	2602-0000101	MAINTENANCE OF SILT FENCE OR SILT FENCE FOR DITCH CHECK	LF	910						910					
142	2602-0000150	STABILIZED CONSTRUCTION ENTRANCE	LF	1400						1400					
143	2602-0000320	PERIMETER AND SLOPE SEDIMENT CONTROL DEVICE, 20 IN. DIA.	LF	5799						5799					
144	2602-0000350	REMOVAL OF PERIMETER AND SLOPE SEDIMENT CONTROL DEVICE	LF	5799						5799					
145	2602-0000400	TEMPORARY INTAKE OR MANHOLE COVER ASSEMBLY	EACH	25						25					
146	2602-0000410	MAINTENANCE OF TEMPORARY INTAKE OR MANHOLE COVER ASSEMBLY	EACH	25						25					
147	2602-0000420	REMOVAL OF TEMPORARY INTAKE OR MANHOLE COVER ASSEMBLY	EACH	25						25					
148	2602-0000500	OPEN-THROAT CURB INTAKE SEDIMENT FILTER	LF	136						136					
149	2602-0000510	MAINTENANCE OF OPEN-THROAT CURB INTAKE SEDIMENT FILTER	EACH	18						18					
150	2602-0000520	REMOVAL OF OPEN-THROAT CURB INTAKE SEDIMENT FILTER	EACH	18						18					
151	2602-0010010	MOBILIZATIONS, EROSION CONTROL	EACH	5						5					
152	2602-0010020	MOBILIZATIONS, EMERGENCY EROSION CONTROL	EACH	5						5					
		Refer to Sheet V.1 for Reinforced Concrete Retaining Wall (Division 5) Quantities													

ESTIMATE REFERENCE INFORMATION

Item No.	Item Code	Description
1	2101-0850001	CLEARING & GRUBBING
2	2101-0850002	CLEARING & GRUBBING Refer to Tab. 110-17 and D Sheets for locations. Clearing and grubbing areas shall be approved by the Engineer prior to beginning of clearing operations. Take care to protect all trees and other plant material to remain.
3	2102-0425070	SPECIAL BACKFILL Refer to typical sections on B Sheets and Tab. 112-9 for locations. Includes material for construction of detour pavement.
4	2102-2625001	EMBANKMENT-IN-PLACE, CONTRACTOR FURNISHED
5	2102-2710070	EXCAVATION CLASS 10, ROADWAY & BORROW Refer to T Sheets. Quantity includes excavation needed for construction of MSE walls and detour pavement. Quantity includes 79,271 CY adjusted roadway cut and 84,049 adjusted fill +30% shrink for a net furnish of 4,778 CY. There will be no additional compensation for overhaul of excavated materials.
6	2102-2712015	EXCAVATION, CLASS 12, BOULDERS OR ROCK FRAGMENTS Refer to sheet CS.1 and Q Sheets.
7	2105-8425005	TOPSOIL, FURNISH AND SPREAD
8	2105-8425015	TOPSOIL, STRIP, SALVAGE AND SPREAD Refer to T Sheets. Quantity includes: 7,440 CY of strip and 11,539 CY of placement +40% shrink. Contractor to be responsible for a net furnish of 4,099 CY. There will be no additional compensation for overhaul of excess materials.
9	2107-0875100	COMPACTION WITH MOISTURE CONTROL
10	2107-3825025	GRANULAR MATERIAL FOR BLANKET AND SUBDRAIN Refer to Sheet CS.1 and Q Sheets.
11	2115-0100000	MODIFIED SUBBASE Refer to Tab 100-24 and B Sheets for locations. On mainline paving, top six inches of modified subbase shall be of virgin material.
12	2121-7425010	GRANULAR SHOULDERS, TYPE A
13	2122-5190007	PAVED SHOULDER, P.C. CONCRETE, 7 IN.
14	2122-5500060	PAVED SHOULDER, HOT MIX ASPHALT MIXTURE, 6 IN.
15	2122-5500080	PAVED SHOULDER, HOT MIX ASPHALT MIXTURE, 8 IN. Refer to Tab. 112-9, Tab. 100-25, and B Sheets for locations.
16	2123-7450000	SHOULDER CONSTRUCTION, EARTH
17	2123-7450020	SHOULDER FINISHING, EARTH Refer to B Sheets for locations. Includes backfill and finish grading behing all curbs. Includes locations of detour pavement.
18	2213-7100400	RELOCATION OF MAIL BOXES Relocated mailboxes at station 863+80, 877+10, 897+15, 899+40, 983+45, 2866+25 and 4874+75. Item includes removing, salvaging, and maintaining temporary mailboxes during construction. After project is completed, reinstall mailboxes per https://www.usps.com/manage/mailboxes.htm . Contact Clifford Brause, Postmaster - (319) 984-6230 to ascertain the requirements for maintenance of postal service to residents and businesses within the project area. Place and maintain mailboxes at temporary locations as designated by the postmaster. Reinstalled mailboxes to be approved by the postmaster following construction. Not less than 48 hours prior to removing any mailbox, notify each affected property owner in writing notifying them of the move and the location of the temporary mailbox. Temporary mailboxes shall be in a place so postal service is maintained at all times. Any permanent mailbox that must be removed shall be stored on the property to which it belongs and at a sufficient distance from the work area to ensure it will not be damaged during construction. Provide an accessible route to the temporary mailbox location for each property. Each mailbox relocated will be counted for payment. Payment will be at contract unit price for each and includes all material, labor, equipment, and coordination to maintain postal service to property owners and properly reinstall mailboxes.
19	2214-5145150	PAVEMENT SCARIFICATION Item includes milled wedge from Sta. 901+58 to Sta. 902+58 to transition HMA overlay to match existing pavement elevation. Refer to Tab. 102-16.
20	2301-0690203	BRIDGE APPROACH, BR-203
21	2301-0690205	BRIDGE APPROACH, BR-205 Refer to Tab. 112-6 for locations.
22	2301-1033070	STD OR SLIP FORM PCC PAVEMENT, CLASS C, CLASS 2 DURABILITY, 7 IN.
23	2301-1033095	STD OR SLIP FORM PCC PAVEMENT, CLASS C, CLASS 3 DURABILITY, 9.5 IN.
24	2301-6911722	PORTLAND CEMENT CONCRETE PAVEMENT SAMPLES Refer to Tab. 100-24 and B Sheets. Quantity includes curb and gutter area.
25	2303-1041500	HOT MIX ASPHALT HIGH TRAFFIC, BASE COURSE, 1/2 IN. MIX
26	2303-1042500	HOT MIX ASPHALT HIGH TRAFFIC, INTERMEDIATE COURSE, 1/2 IN. MIX
27	2303-1043502	HOT MIX ASPHALT HIGH TRAFFIC, SURFACE COURSE, 1/2 IN. MIX, FRICTION L-2
28	2303-1258284	ASPHALT BINDER, PG 58-28H, HIGH TRAFFIC Refer to Tab. 100-25 and B Sheets for locations. Binder quantity is based on 6.0% binder content. Items include 5% to account for overruns.
29	2304-0100000	DETOUR PAVEMENT Refer to details on Sheet B.8 and J Sheets.
30	2315-8275025	SURFACING, DRIVEWAY, CLASS A CRUSHED STONE Refer to Tab. 102-3.

ESTIMATE REFERENCE INFORMATION

Item No.	Item Code	Description
31	2401-6750001	REMOVALS, AS PER PLAN Refer to Tab. 110-2.
32	2402-0425030	GRANULAR BACKFILL For material placed as part of the MSE Wall construction. Material depth is assumed to be equal to the wall height. Actual material quantity will be determined based on wall design and delivery tickets.
33	2402-0425040	FLOODED BACKFILL
34	2402-2720100	EXCAVATION, CLASS 20, FOR ROADWAY PIPE CULVERT Refer to Tab. 104-3 for locations and quantities.
35	2403-0100000	STRUCTURAL CONCRETE (MISCELLANEOUS)
36	2404-7775000	REINFORCING STEEL For construction of apron footings, refer to detail on B Sheets. Refer to Sheet M.1 for location.
37	2412-0000100	LONGITUDINAL GROOVING IN CONCRETE Refer to Tab. 100-28.
38	2416-0100012	APRONS, CONCRETE, 12 IN. DIA.
39	2416-0100015	APRONS, CONCRETE, 15 IN. DIA.
40	2416-0100018	APRONS, CONCRETE, 18 IN. DIA.
41	2416-0100030	APRONS, CONCRETE, 30 IN. DIA.
42	2416-0100042	APRONS, CONCRETE, 42 IN. DIA. Refer to the M and V Sheets, Tab. 102-3, Tab 104-3 and Tab. 104-5B for locations. Install apron guards on all aprons. Apron guards are incidental to the contract unit price for each apron.
43	2416-0101136	REMOVE AND REINSTALL CONCRETE PIPE APRONS GREATER THAT 36 IN. Refer to Tab. 104-3 and Sheet V.21.
44	2416-1160030	CULVERT, CONCRETE ENTRANCE PIPE, 30 INCH Refer to Tab. 102-3.
45	2416-1180042	CULVERT, CONCRETE ROADWAY PIPE, 42 INCH
46	2416-1180048	CULVERT, CONCRETE ROADWAY PIPE, 48 INCH Refer to Tab. 104-3 and V Sheets.
47	2417-0225012	APRONS, METAL, 12 IN. DIA
48	2417-0225018	APRONS, METAL, 18 IN. DIA. Refer to Tab. 102-3.
49	2417-1007000	CORRUGATED PIPE CULVERT, ENTRANCE PIPE, 12 IN. DIA. Refer to Tab. 102-3. Materials, construction, method of measurement and basis of payment shall be per specification section 2417.
50	2417-1040018	CULVERT, CORRUGATED METAL ENTRANCE PIPE, 18 IN. DIA. Refer to Tab. 102-3.
51	2432-0000100	MECHANICALLY STABILIZED EARTH RETAINING WALL Refer to D Sheets for retaining wall locations and U Sheets for retaining wall situation plans.
52	2435-0130148	MANHOLE, SANITARY SEWER, SW-301, 48 IN. Refer to Tab. 104-5B and M Sheets.
53	2435-0130160	MANHOLE, SANITARY SEWER, SW-301, 60 IN. Refer to U Sheets. Manhole joints shall be tied per details on Sheet U.5. Manhole lids shll be bolt down type. Item includes external chimney seal, bold-down frame and lid, adjusting rings (pro-ring) and PVC liner. Sanitary sewer bypass pumping and dewatering are incidental to sanitay sewer construciton.
54	2435-0140148	MANHOLE, STORM SEWER, SW-401, 48 IN.
55	2435-0140172	MANHOLE, STORM SEWER, SW-401, 72 IN.
56	2435-0250700	INTAKE, SW-507
57	2435-0250900	INTAKE, SW-509
58	2435-0251000	INTAKE, SW-510
59	2435-0251230	INTAKE, SW-512, 30 IN.
60	2435-0251300	INTAKE, SW-513 Refer to Tab. 104-5B and M Sheets.
61	2435-0600020	MANHOLE ADJUSTMENT, MAJOR Refer to Tab. 104-10.
62	2435-0700010	CONNECTION TO EXISTING MANHOLE Refer to M Sheets and U Sheets.
63	2435-0700020	CONNECTION TO EXISTING INTAKE Refer to M Sheets.
64	2499-3575000	SPECIAL FLUME Construct flume at each MSE wall location, refer to flume detail on Sheet B.9. Concrete shall meet the requirements of specification section 2403. Reinforcing shall meet the requirements of specification section 2404. Compact sub-grade 6" below each flume per specification section 2109. Each flume properly installed will be counted for payment. Payment will be at the contract unit price of each and includes all materials, labor

ESTIMATE REFERENCE INFORMATION

Item No.	Item Code	Description
		and equipment needed to construct each flume per plans.
65	2501-8400172	TEMPORARY SHORING Install temporary shoring as needed for MSE wall construction. Temporary shoring will be measured and paid for at the contract unit price of lump sum.
66	2502-8212034	SUBDRAIN, LONGITUDINAL, (SHOULDER), 4 IN. DIA.
67	2502-8221303	SUBDRAIN OUTLET, DR-303
68	2502-8221305	SUBDRAIN OUTLET, DR-305 Refer to Tab. 104-9.
69	2503-0114212	STORM SEWER GRAVITY MAIN, TRENCHED, RCP, 2000D (CLASS III), 12 IN.
70	2503-0114215	STORM SEWER GRAVITY MAIN, TRENCHED, RCP, 2000D (CLASS III), 15 IN.
71	2503-0114218	STORM SEWER GRAVITY MAIN, TRENCHED, RCP, 2000D (CLASS III), 18 IN.
72	2503-0114224	STORM SEWER GRAVITY MAIN, TRENCHED, RCP, 2000D (CLASS III), 24 IN.
73	2503-0114230	STORM SEWER GRAVITY MAIN, TRENCHED, RCP, 2000D (CLASS III), 30 IN. Refer to Tab. 104-5B and M Sheets. Installed O-ring or profile gasketed joints where indicated.
74	2503-0200036	REMOVE STORM SEWER PIPE LESS THAN OR EQUAL TO 36 IN. Refer to Tab. 110-14 for locations. Item includes disposal of material offsite. Removal of aprons is included in this item.
75	2503-0500401	BRIDGE END DRAIN, DR-401 Refer to Tab.104-8A
76	2504-0114010	SANITARY SEWER GRAVITY MAIN, TRENCHED, POLYVINYL CLORIDE PIPE (PVC), 10 IN. Refer to Tab. 104-5B and M Sheets. Pipe shall be SDR-26.
77	2504-0116024	SANITARY SEWER GRAVITY MAIN, TRENCHED, DUCTILE IRON PIPE (DIP), 24 IN. Pipe shall be 24" DIP with ceramic epoxy lining, restrained joints and encased in polyethylene. Dewatering and any necessary temporary stream diversion is incidental. Pipe bedding to be Class F-3 per Standard Road Plan SW-103, modify where Special Pipe Embedment or Encasement is used. Pipe bedding material shall be granular backfill. Disposal of excess material from trench shall be incidental.
78	2504-0146024	SAN. SWR. GTY. MAIN WITH CASING PIPE, TRENCHLESS, DUCTILE IRON PIPE (DIP), 24 IN. Refer to U Sheets. Access for launching and receiving pits is limited to the temporary easements. Casing pipe shall be coal tar expoxied and incidental. Steel casing pipe shall be 48" diameter and minimum wall thickness shall be 0.344". Carrier pipe shall be 24" DIP with ceramic epoxy lining and restrained joints. Any necessary or temporary stream diversion is incidental.
79	2504-0240036	REMOVE SANITARY SEWER PIPE LESS THAN OR EQUAL TO 36 IN. Refer to U Sheets. Dispose of removed pipe.
80	2504-0240236	SANITARY SEWER ABANDONMENT, FILL AND PLUG, LESS THAN OR EQUAL TO 36 IN. DIA. Refer to U Sheets. Remove and dispose of existing manhole cone sections. Pipe and remaining manhole sections to be filled with flowable mortar. Plug upstream and downstream pipe ends.
81	2505-4008120	REMOVAL OF STEEL BEAM GUARDRAIL Refer to Tab. 110-7A.
82	2505-4008300	STEEL BEAM GUARDRAIL
83	2505-4008410	STEEL BEAM GUARDRAIL BARRIER TRANSITION SECTION, BA-201
84	2505-4021010	STEEL BEAM GUARDRAIL END ANCHOR, BOLTED
85	2505-4021020	STEEL BEAM GUARDRAIL END ANCHOR, W-BEAM
86	2505-4021720	STEEL BEAM GUARDRAIL TANGENT END TERMINAL, BA-205
87	2505-4502100	STEEL BEAM GUARDRAIL, POST ADAPTER UNIT, BA-210 Refer to Tab. 108-8A and Tab. 108-8C.
88	2507-3250005	ENGINEERING FABRIC
89	2507-6800061	REVTMENT, CLASS E Refer to Tab. 100-23.
90	2510-6745850	REMOVAL OF PAVEMENT Refer to Tab. 102-5 and Tab 110-1. If the removal limits are within 2-feet of an existing joint, extend removal to the joint. The Contractor is responsible for replacing any damaged pavement beyond the removal limits, no additional payment will be allowed for this work.
91	2510-6750600	REMOVAL OF INTAKES AND UTILITY ACCESSES Refer to Tab. 110-15 and M Sheets.
92	2511-6745900	REMOVAL OF SIDEWALK Refer to Tab. 110-5. Contractor is responsible for replacing any damaged pavement beyond the removal limits.
93	2511-7526004	SIDEWALK, P.C. CONCRETE, 4 IN. Refer to Tab. 113-1 and B Sheets. Refer to sheet L.1 for shaping information. Sidewalk through driveways shall be paid for as PCC Driveway. Use Class C concrete for all sidewalk construction.
94	2515-2475006	DRIVEWAY, P.C. CONCRETE, 6 IN. Refer to Tab. 102-3. Quantity includes sidewalk area within driveways.
95	2515-6745600	REMOVAL OF PAVED DRIVEWAY Refer to Tab. 110-8. Contractor is responsible for replacing any damaged pavement beyond the removal limits.

ESTIMATE REFERENCE INFORMATION

Item No.	Item Code	Description
96	2518-6910000	SAFETY CLOSURE Refer to Tab. 108-13A and J Sheets.
97	2519-1004072	FENCE, CHAIN LINK, 72 IN. HEIGHT, ON WALL Refer to Tab. 100-7. Install per wall manufacturer's recommendations.
98	2519-4200190	REMOVAL OF FENCE, AS PER PLAN Refer to Tab. 100-08.
99	2526-8285000	CONSTRUCTION SURVEY Includes construction survey for all project divisions.
100	2527-9263109	PAINTED PAVEMENT MARKING WATERBORNE OR SOLVENT-BASED
101	2527-9263131	WET RETROREFLECTIVE REMOVABLE TAPE MARKINGS
102	2527-9263137	PAINTED SYMBOLS AND LEGENDS, WATERBORNE OR SOLVENT-BASED
103	2527-9263158	PAVEMENT MARKINGS REMOVED Refer to Tab. 108-22 and Tab. 108-29. Refer to J Sheets for layout. Pavement cure shall be completely removed from pavement surface prior to application of pavement markings and symbols and legends.
104	2528-8400048	TEMPORARY BARRIER RAIL, CONCRETE Refer to Tab. 108-33 and J Sheets.
105	2528-8400157	TEMPORARY FLOODLIGHTING LUMINAIRE Refer to J Sheets.
106	2528-8400256	TEMPORARY TRAFFIC SIGNALS Refer to Tab. 108-28 and J Sheets.
107	2528-8445110	TRAFFIC CONTROL Refer to J Sheets.
110	2528-9109020	TEMPORARY LANE SEPARATOR SYSTEM Refer to Tab. 108-35 and J Sheets.
111	2529-5070110	PATCHES, FULL DEPTH FINISH, BY AREA
112	2529-5070120	PATCHES, FULL DEPTH FINISH, BY COUNT Refer to Tab. 102-6C.
114	2551-0000110	TEMPORARY CRASH CUSHION
115	2551-0000130	TEMPORARY CRASH CUSHION, SEVERE USE (SU) Refer to Tab. 108-30 and J Sheets.
116	2552-0000230	SPECIAL PIPE EMBEDMENT OR ENCASEMENT Refer to U Sheets and detail on sheet U.5. Applies to pipe P-3.
117	2552-0000300	TRENCH COMPACTION TESTING Includes testing for sanitary sewer shown on U Sheets, performed by an independent testing laboratory. Provide a minimum of 6 tests randomly spaced over sanitary sewer trench. No compensation will be made for re-testing failed tests.
118	2554-0114008	WATER MAIN, TRENCHED, POLYVINYL CLORIDE PIPE (PVC), 8 IN.
119	2554-0114012	WATER MAIN, TRENCHED, POLYVINYL CLORIDE PIPE (PVC), 12 IN.
120	2554-0134008	WATER MAIN WITH CASING PIPE, TRENCHED, POLYVINYL CLORIDE PIPE (PVC), 8 IN.
121	2554-0134012	WATER MAIN WITH CASING PIPE, TRENCHED, POLYVINYL CLORIDE PIPE (PVC), 12 IN.
122	2554-0207008	VALVE, GATE, DIP, 8 IN.
123	2554-0207012	VALVE, GATE, DIP, 12 IN.
124	2554-0210201	FIRE HYDRANT ASSEMBLY, WM-201 Refer to D Sheets and M Sheets. Steel casing pipe shall be 20" diameter for both 8" and 12" water main. Install tracer wire system for all water main per standard road plan WM-102. Provide restrained joint PVC pipe and stainless steel nuts and bolts for all water main fixtures and connections. Fire Hydrant Assembly shall be either Clow or Waterous with Storz connections.
125	2554-0214000	FIRE HYDRANT ADJUSTMENT Refer to Tab. 104-10.
127	2599-9999010	INTERMEDIATE FOUNDATION IMPROVEMENTS
128	2599-9999010	INTERMEDIATE FOUNDATION IMPROVEMENTS VERIFICATION TESTING Refer to special provisions for Intermediate Foundation Improvements for additional information, method of measurement and basis of payment.
129	2601-2634100	MULCHING
130	2601-2634105	MULCHING, BONDED FIBER MATRIX
131	2601-2636015	NATIVE GRASS SEEDING
132	2601-2636043	SEEDING AND FERTILIZING (RURAL)
133	2601-2636044	SEEDING AND FERTILIZING (URBAN) Seeding, fertilizing, and mulching are intended for use on all final restoration areas within the project limits. Mulching is intended to be used for temporary seeding needed to comply with the NPDES Permit. Use Mulching, Bonded Fiber Matrix for permanent seeding areas. Refer to Pollution Prevention Plan sheets for seeding areas.
134	2601-2638352	SLOPE PROTECTION, WOOD EXCELSIOR MAT

ESTIMATE REFERENCE INFORMATION			100-4A 10-29-02
Item No.	Item Code	Description	
		Item for slope protection of long steep slopes, generally near structures. Refer to Tab. 100-22.	
135	2601-2642100	STABILIZE CROP - SEEDING AND FERTILIZING Item intended to be used for temporary seeding needed to comply with NPDES Permit.	
136	2601-2643110	WATERING FOR SOD, SPECIAL DITCH CONTROL, OR SLOPE PROTECTION	
137	2601-2643300	MOBILIZATION FOR WATERING Items associated with installation of slope protection. Refer to Tab. 100-22.	
138	2602-0000020	SILT FENCE Refer to Tab. 100-17. The tabulation includes estimated locations for placement of silt fence to address possible erosion during construction. Verify the specific locations with the Engineer prior to placement. Bid item includes 25% additional quantity for field adjustments and replacements.	
139	2602-0000030	SILT FENCE FOR DITCH CHECKS Refer to Tab. 100-18. The tabulation includes estimated locations for placement of silt fence for ditch checks to address possible erosion during construction. Verify the specific locations with the Engineer prior to placement. Bid item includes 50% additional quantity for field adjustments and replacements.	
140	2602-0000071	REMOVAL OF SILT FENCE OR SILT FENCE FOR DITCH CHECKS This item is included for silt fence and silt fence for ditch check removal required for staging reasons, for replacement (replacement to be paid separately), or for areas that have achieved 70% permanent growth.	
141	2602-0000101	MAINTENANCE OF SILT FENCE OR SILT FENCE FOR DITCH CHECK This item is included for cleanout and repair of the silt fence and silt fence for ditch checks during the project.	
142	2602-0000150	STABILIZED CONSTRUCTION ENTRANCE Install as necessary for access to work areas during staged construction. Refer to Sheet C.28 - C.30.	
143	2602-0000320	PERIMETER AND SLOPE SEDIMENT CONTROL DEVICE, 20 IN. DIA.	
144	2602-0000350	REMOVAL OF PERIMETER AND SLOPE SEDIMENT CONTROL DEVICE Refer to Tab. 100-19.	
145	2602-0000400	TEMPORARY INTAKE OR MANHOLE COVER ASSEMBLY	
146	2602-0000410	MAINTENANCE OF TEMPORARY INTAKE OR MANHOLE COVER ASSEMBLY	
147	2602-0000420	REMOVAL OF TEMPORARY INTAKE OR MANHOLE COVER ASSEMBLY Refer to Tab. 100-11 and details on B Sheets.	
148	2602-0000500	OPEN-THROAT CURB INTAKE SEDIMENT FILTER	
149	2602-0000510	MAINTENANCE OF OPEN-THROAT CURB INTAKE SEDIMENT FILTER	
150	2602-0000520	REMOVAL OF OPEN-THROAT CURB INTAKE SEDIMENT FILTER Refer to Tab. 100-36 and details on B sheets.	
151	2602-0010010	MOBILIZATIONS, EROSION CONTROL	
152	2602-0010020	MOBILIZATIONS, EMERGENCY EROSION CONTROL Includes erosion control mobilizations for all project divisions.	

PROJECT DESCRIPTION		100-1D 10-18-05
This project includes grading and paving of a U.S. Highway 151, a two lane roadway with turn lanes and a two-way left turn lane from south of Church Street, north approximately 0.5 mile to west of the U.S. Highway 151 intersection with 80th Street SW in Fairfax.		
This project also includes pavement improvements associated with the structure replacement at Drainage Ditch No. 2, between Stoney Point Road and Dean Road.		
Associated projects include replacement of bridges at UPRR, Prairie Creek, Drainage Ditch No. 1 and Drainage Ditch No. 2 and project signing.		

INDEX OF TABULATIONS			111-25 10-18-11
Tabulation	Tabulation Title	Sheet No.	
C Sheets			
100-1C	ESTIMATED PROJECT QUANTITIES (UP TO A 5 DIVISION PROJECT)	C.1 - C.2	
100-1D	PROJECT DESCRIPTION	C.5	
100-4A	ESTIMATE REFERENCE INFORMATION	C.3 - C.5	
100-7	FENCING	C.7	
100-8	REMOVAL OF FENCE	C.7	
100-11	EROSION CONTROL FOR INTAKE OR MANHOLE WELL	C.25	
100-17	TABULATION OF SILT FENCES	C.23	
100-18	SILT FENCES FOR DITCH CHECKS	C.24 - C.24	
100-19	PERIMETER AND SLOPE SEDIMENT CONTROL DEVICE	C.25	
100-22	ROLLED EROSION CONTROL	C.27	
100-23	ROCK EROSION CONTROL	C.23	
100-24	PCC PAVEMENT	C.10 - C.11	
100-25	HMA PAVEMENT	C.12	
100-26	INCIDENTAL ITEMS	C.5	
100-27	PROPOSED POSTED SPEED LIMIT	C.13	
100-28	LONGITUDINAL GROOVING	C.13	
100-34	STORMWATER DRAINAGE BASIN AND STORAGE	C.23	
100-36	OPEN-THROAT CURB INTAKE SEDIMENT FILTER	C.25	
102-3	ACCESS POINTS AND SAFETY RAMPS	C.14	
102-5	EXISTING PAVEMENT	C.8	
102-6C	FULL-DEPTH PATCHES	C.13	
102-16	NOTCHES AND RUNOUTS FOR RESURFACING	C.12	
104-3	DRAINAGE STRUCTURE BY ROAD CONTRACTOR	C.9	
104-8A	SCOUR PROTECTION OR ROCK FLUME FOR BRIDGE END DRAIN	C.23	
104-9	LONGITUDINAL SUBDRAIN SHOULDER AND BACKSLOPE	C.15	
104-10	ADJUSTMENT OF FIXTURES	C.8	
105-4	STANDARD ROAD PLANS	C.6 - C.6	
107-23	GRADING FOR GUARDRAIL INSTALLATIONS	C.16	
108-8A	STEEL BEAM GUARDRAIL AT CONCRETE BARRIER OR BRIDGE RAIL END SECTION	C.16	
108-8C	STEEL BEAM GUARDRAIL FOR SIDE OBSTACLE (ONE-WAY PROTECTION)	C.16	
108-13A	SAFETY CLOSURES	C.17	
108-22	PAVEMENT MARKING LINE TYPES	C.19 - C.21	
108-28	TEMPORARY TRAFFIC SIGNALS	C.17	
108-29	PAVEMENT MARKING SYMBOLS AND LEGENDS	C.22	
108-30	CRASH CUSHIONS	C.18	
108-33	TEMPORARY BARRIER RAIL	C.17	
108-35	TEMPORARY LANE SEPARATOR SYSTEM	C.17	
110-1	REMOVAL OF PAVEMENT	C.8	
110-2	REMOVAL OF EXISTING STRUCTURES	C.9	
110-5	SIDEWALK REMOVAL	C.8	
110-7A	REMOVAL OF STEEL BEAM GUARDRAIL	C.16	
110-8	REMOVAL OF CONCRETE DRIVES	C.8	
110-12A	POLLUTION PREVENTION PLAN	C.26 - C.27	
110-14	SANITARY OR STORM SEWER ABANDONMENT OR REMOVAL	C.9	
110-15	REMOVAL OF INTAKES AND UTILITY ACCESSES	C.9	
110-17	CLEARING AND GRUBBING	C.7	
111-25	INDEX OF TABULATIONS	C.5	
112-6	BRIDGE APPROACH SECTION	C.11	
112-9	SHOULDERS	C.13	
113-1	SIDEWALKS	C.14	

INCIDENTAL ITEMS						100-26 10-15-13
Special or unique items where method of measurement / basis of payment is not indicated in the specifications or other contract documents.						
No.	Incidental Item	Unit	Quantity	Incidental To		Remarks
				Item Code	Item	
1	Maintenance of Postal Service	LS	1	2213-7100400	Relocation of Mail Boxes	
2	Maintenance of Garbage Service	LS	1	2528-8445110	Traffic Control	
3	Maintain Property Access and Parking	LS	1	2528-8445110	Traffic Control	

SECTION 404 PERMIT AND CONDITIONS		281-1 10-18-16
Construct this project according to the requirements of U.S. Army Corps of Engineers Nationwide, Permit No. 2018-458. A copy of this permit is available from the Iowa DOT website (http://www.envpermits.iowadot.gov/). The U.S. Army Corps of Engineers reserves the right to visit the site without prior notice.		

UTILITIES		262-6 10-18-05
(NOT A POINT 25 PROJECT)		
This is NOT a POINT 25 project and is not subject to the provisions of IAC 761-115.25.		

STANDARD ROAD PLANS

The following Standard Road Plans apply to construction work on this project.

Number	Date	Title
BA-200	10-18-16	Steel Beam Guardrail Components
BA-201	04-18-17	Steel Beam Guardrail Barrier Transition Section (MASH TL-3)
BA-202	10-20-15	Steel Beam Guardrail Bolted End Anchor
BA-203	10-18-11	Steel Beam Guardrail W-Beam End Anchor
BA-205	04-19-16	Steel Beam Guardrail Tangent End Terminal (MASH TL-3)
BA-210	04-19-16	Guardrail Post Adaptor Unit
BA-211	10-21-14	Steel Beam Guardrail Long - Span System for Post Conflicts
BA-250	10-18-16	Steel Beam Guardrail Installation at Concrete Barrier or Bridge End Post (MASH TL-3)
BA-252	04-19-16	Steel Beam Guardrail Installation at Side Obstacle (One-Way Protection)
BA-401	04-16-13	Temporary Barrier Rail (Precast Concrete)
BA-500	04-19-16	Temporary Crash Cushions Sand Barrel
BR-101	04-21-15	Bridge Approach Section (General Details)
BR-203	10-17-17	Double Reinforced 12" Approach
BR-205	10-16-18	Double Reinforced 12" Approach (Slab Bridge)
BR-211	10-17-17	Bridge Approach (Abutting PCC or Composite Pavement)
BR-231	10-17-17	Bridge Approach (Multi-Lane, Curbed Roadway)
DR-101	04-18-17	Pipe Culvert (Bedding and Backfill)
DR-102	04-21-15	Pipe Culvert (Cover and Camber)
DR-103	04-21-15	Pipe Culvert (Installation Details)
DR-104	04-19-16	Depth of Cover Tables for Concrete and Corrugated Pipe
DR-121	10-17-17	Connected Pipe Joints
DR-122	10-18-16	Construction of Type "C" Concrete Adaptors for Pipe Culvert Connections
DR-141	04-18-17	Pipe Bends and Half Pipe
DR-201	10-16-18	Concrete Aprons
DR-213	10-17-17	Pipe Apron Guard
DR-303	10-17-17	Subdrains (Longitudinal)
DR-305	04-17-18	Subdrain Outlets (Standard Subdrain, Pressure Release and Special)
DR-306	10-16-18	Precast Concrete Headwall for Subdrain Outlets
DR-401	04-17-18	Scour Protection for Bridge End Drain
DR-601	04-18-17	Reinforced Concrete Pipe Culvert
DR-621	04-18-17	Pipe Extension
EC-101	04-19-16	Wood Excelsior Mat for Ditch Protection
EC-103	04-21-15	Wood Excelsior Mat for Slope Protection
EC-104	04-17-18	Turf Reinforced Mat (TRM)
EC-105	04-17-18	Transition Mat
EC-201	10-16-18	Silt Fence
EC-204	04-18-17	Perimeter and Slope Sediment Control Devices
EC-301	10-18-16	Rock Erosion Control (REC)
EC-602	10-16-18	Open-Throat Curb Intake Sediment Filter
EW-101	10-17-17	Embankment and Rebuilding Embankments
EW-102	10-20-15	Allowable Placement of Unsuitable Soil in Embankments
EW-103	10-20-15	Embankment Subgrade Treatment, Moisture Density Control and Special Compaction
EW-201	04-19-16	Bridge Berm Grading without Recoverable Slope (Barnroof Section)
EW-301	10-20-15	Guardrail Grading
EW-401	10-20-15	Temporary Stream Crossing, Causeway, or Equipment Pad
EW-402	04-18-17	Temporary Stream Diversion
EW-501	10-20-15	Rural Entrance
EW-503	10-20-15	Side Road Grading
MI-101	10-20-15	Fencing Layout
MI-102	10-20-15	Chain Link Fence Construction
MI-103	10-20-15	Deer Fence and Field Fence Construction
MI-210	10-20-15	PCC Driveways and Alleys
MI-220	10-20-15	Detectable Warnings and Pedestrian Ramp
PM-110	10-16-18	Line Types
PM-111	04-21-15	Symbols and Legends
PM-120	10-21-14	Stop Lines and Islands
PM-210	10-18-11	Separation in Two-Lane Roadway
PM-521	04-19-11	Two-Lane Roadway with Right Turn Lanes
PM-522	10-16-12	Two-Lane Roadway with Left Turn Lanes
PM-550	04-19-11	Two-Lane Roadway with Two-Way Left Turn Lane
PR-103	10-21-14	Full Depth PCC Patch with Dowels
PR-202	10-21-14	Notches for Resurfacing (with or without Runout)
PV-101	10-16-18	Joints
PV-102	10-18-16	PCC Curb Details
PV-103	04-19-11	Manhole Boxouts in PCC Pavement
PV-105	10-21-14	PCC Pavement Widening
PV-121	04-21-15	Jointing PCC Pavement Widening
PV-203	10-15-13	HMA Base Widening
PV-301	04-19-11	Superelevation Details Two Lane Roadway
SI-101	04-19-16	Locations - Type 'A' Signs
SI-111	04-19-16	Support Structures - Wood Posts
SI-131	10-18-16	Installation - Type 'A' Signs
SI-171	04-18-17	Reference Location Sign Posts
SI-172	04-19-16	Delineators
SI-173	04-19-16	Object Markers
SI-211	10-18-16	Object Marker and Delineator Placement with Guardrail
SI-881	10-17-17	Special Signs for Workzones
SI-882	10-18-16	Special Signs for Restricted Width Traffic Control Zones
SW-101	04-17-18	Trench Bedding and Backfill Zones
SW-102	04-18-17	Rigid Gravity Pipe Trench Bedding
SW-301	04-17-18	Circular Sanitary Sewer Manhole
SW-401	04-17-18	Circular Storm Sewer Manhole
SW-507	04-17-18	Single Open-Throat Intake, Small Box
SW-509	04-17-18	Double Open-Throat Curb Intake, Small Box

STANDARD ROAD PLANS

The following Standard Road Plans apply to construction work on this project.

Number	Date	Title
SW-510	04-17-18	Double Open-Throat Curb Intake, Large Box
SW-511	04-17-18	Rectangular Area Intake
SW-512	04-17-18	Circular Area Intake
SW-513	04-17-18	Open-Sided Area Intake
SW-601	04-21-15	Castings for Sanitary Sewer Manholes
SW-602	04-21-15	Castings for Storm Sewer Manholes
SW-603	10-16-18	Castings for Grate Intakes
SW-604	04-17-18	Castings for Area Intakes
TC-1	04-16-13	Work Not Affecting Traffic (Two-Lane or Multi-Lane)
TC-81	04-20-10	Restricted Width Signing (Less Than 14.5 Feet)
TC-202	04-21-15	Work Within 15 ft of Traveled Way
TC-213	04-17-12	Lane Closure with Flaggers
TC-214	10-17-17	Lane Closure with Flaggers for use with Pilot Car
TC-216	10-18-16	Lane Closure with Signals
TC-217	10-18-16	Lane Closure with Signals and TBR
TC-252	04-19-16	Routes Closed to Traffic
TC-253	10-18-16	Paved On-Site Detour
WM-101	10-18-16	Thrust Blocks
WM-102	10-18-16	Tracer System
WM-201	04-18-17	Fire Hydrant Assembly

CLEARING AND GRUBBING

Location		Work and Material Type	Trees, Stumps, and Logs and Down Timber Material Diameters													All Other Materials		Estimated Quantities			Remarks
Station to Station or Ref. Loc. Sign to Ref. Loc. Sign or Description	Direction of Travel		3"-6"	>6"-9"	>9"-12"	>12"-15"	>15"-18"	>18"-24"	>24"-30"	>30"-36"	>36"-42"	>42"-48"	>48"-60"	>60"-72"	>72"	Length	Width	Units	Area	Herbicide Application	
			FT	FT	Units	Acres	Each														
Highway 151																					
864+11 to 866+82	SB	Trees - Clearing and Grubbing																0.5			
864+47 to 867+38	NB	Trees - Clearing and Grubbing																0.2			
867+50 to 871+88	SB	Trees - Clearing and Grubbing																0.4			
867+99 to 871+24	NB	Trees - Clearing and Grubbing																0.2			
877+85	SB	Trees - Clearing and Grubbing							1								29.0	0.1			
878+40 to 881+15	SB	Trees - Clearing and Grubbing																0.1			
881+33 to 881+60	SB	Trees - Clearing and Grubbing																0.1			
882+78	SB	Trees - Clearing and Grubbing						1									13.5	0.5			
882+78	SB	Trees - Clearing and Grubbing								1							22.0				
882+85	SB	Trees - Clearing and Grubbing				1											9.4				
882+89	SB	Trees - Clearing and Grubbing								1							22.0				
979+60 to 982+14	SB	Trees - Clearing and Grubbing																0.5			
Church Street																					
1847+74	EB	Trees - Clearing and Grubbing				1												9.4			
1848+12	WB	Trees - Clearing and Grubbing				1												9.4			
1848+28 to 1848+45	WB	Brush - Clearing													20.0	15.0	2.4				
Losey Avenue																					
3864+45	NB	Trees - Clearing and Grubbing						1										13.5			
Total:																	131.0	2.8			

100-08
04-17-18

REMOVAL OF FENCE

Removal of Field Fence is incidental to Clearing and Grubbing.

Location				Type	Length LF	Remarks
From		To				
Station	Offset	Station	Offset			
865+07.45	78.2' LT	866+06.64	77.4' LT	Chain Link	99.2	
870+54.67	89.6' LT	873+54.10	84.1' LT	Field	313.3	
880+48.18	72.7' LT	880+55.72	123.1' LT	Wood	55.9	Salvage to Property Owner
880+48.25	72.7' LT	881+31.85	127.3' LT	Field	110.1	Electric Wire Fence, Salvage to Property Owner
Total:					155.1	

232-10
04-18-17

EMERALD ASH BORER

Any living, dead, cut or fallen material of the ash (Fraxinus spp.) including trees, nursery stock, logs, firewood, stumps, roots, branches, and composted or uncomposted ash chips can be freely moved within the yellow areas of the most recent Federal EAB Quarantine & Authorized Transit.

https://www.aphis.usda.gov/plant_health/plant_pest_info/emerald_ash_b/downloads/eab_quarantine_map.pdf.

Obtain appropriate Compliance Agreements from USDA APHIS PPQ prior to moving any of the above listed ash articles to areas outside the yellow zone on the map.

For questions, concerns, and general assistance, contact:

USDA APHIS PPQ, Iowa office, 515-414-3295

Or

Iowa Department of Agriculture & Land Stewardship
515-725-1470
Entomology@IowaAgriculture.gov

100-7
10-16-12

FENCING

* Bid Item

Refer to MI-101, MI-102, MI-103, MI-104, 510-3, and 510-5

Location				Side	Chain Link				Deer				Field				Channel Crossing		Remarks
From		To			Fence		Gate		Fence		Brace Panels*		Gate		Fence		Brace Panels*		
Station	Offset	Station	Offset		Length*	Type	No.*	Type	Length*	Panel*	No.*	Type	Length*	Panel*	No.*	Type	Length*	Type	
				LF		EACH		LF	EACH	EACH		LF	EACH	EACH		LF			
849+79.84	46.5	856+74.00	40.5	RT	694.2	72 IN.												Install on MSE Wall No. 1	
858+17.00	40.5	863+60.00	46.5	RT	543.1	72 IN.												Install on MSE Wall No. 2	
858+05.00	37.1	863+50.00	46.5	LT	545.2	72 IN.												Install on MSE Wall No. 3	
Total:					1782.5														

EXISTING PAVEMENT

No.	Location					Year	Type	Project Number	Surface		Base		Subbase		Removal		Coarse Aggregate			Reinforcement	Remarks	
	County	Route	Dir. of Travel	Begin Ref. Loc. Sign	End Ref. Loc. Sign				Type	Depth	Type	Depth	Type	Depth	Type	Depth	Source	Type	Durability Class			Type
	Linn	US 151	Both	2156	2494	2007	HMA	STPN-151-3(120)--2J-57	HMA	2	HMA	2			HMA	2	BEVERLY		C.LST.		Surface Treatment	
						2007	HMA	STPN-151-3(120)--2J-51	HMA	4	HMA	7.5	Modified	12	HMA	3.5	BEVERLY		C.LST.		Widening Project	
						1995	PCC	NHS-151-2(3)--19-06	PCC	9											Grade and Replace	
						1985	PCC	FN-149-4(16)--21-57	PCC	12											Paved Shoulder Widening	
						1983	HMA	FR-151-1(3)--2G-48	RAC	1.5												
						1966	HMA	FN-255	AAC	1.5	AAC	1.5					CEDAR RAPIDS		C.LST.		Surfacing	
						1961	PCC	FN-255	PCC	10											Widening roadway from 18' to 24'	
						1952	HMA	P-10027	HMA	1.5	HMA	1.5					OTIS QRY.		C.LST.			
						1934	PCC	NRH-NRM-255	PCC	7							GLORY		C.LST.	1	C. Rapids St. = 1	

REMOVAL OF PAVEMENT

Refer to Tabulation 102-5

* Not a Bid Item

Begin Station	End Station	Side	Pavement Type	Area	Saw Cut*	Remarks
				SY	LF	
U.S. 151						
843+88.58	848+30.33	RT	PCC	147.8	444.7	Remove Per Staging Plans
845+05.45	848+30.33	LT	PCC	255.2	327.8	Remove Per Staging Plans
848+30.33	856+50.14	BOTH	PCC/HMA	3912.8	45.2	Includes C&G and Bridge Approach Pavement
857+96.21	866+58.37	BOTH	PCC/HMA	3528.2	253.9	Includes C&G and Brg. Apch. Pvmt. Remove Per Staging.
868+26.68	880+76.66	BOTH	PCC/HMA	4958.8	1310.9	Includes Bridge Approach Pvmt. Remove Per Staging.
881+03.15	898+00.00	BOTH	PCC/HMA	7108.4	1795.8	Includes Bridge Approach Pvmt. Remove Per Staging.
974+69.95	979+30.00	LT	HMA	394.4	472.1	Remove per Staging Plans
979+30.00	980+04.24	BOTH	PCC/HMA	309.5	44.7	Includes Bridge Approach Pvmt. Remove Per Staging.
908+33.64	981+40.00	BOTH	PCC/HMA	459.0	42.1	Includes Bridge Approach Pvmt. Remove Per Staging.
981+40.00	984+83.16	LT	HMA	316.9	355.2	Remove Per Staging Plans
CHURCH ST						
1849+50.70	1851+25.00	BOTH	HMA	681.7	25.5	Remove Per Staging Plans
PRAIRIE AVE						
2864+31.44	2866+56.00	BOTH	HMA	789.4	56.1	Remove Per Staging Plans
LOSEY AVE						
3862+86.45	3864+78.80	BOTH	HMA	552.1	107.6	Includes C&G Removal. Remove Per Staging Plans.
STALLMAN DR						
4874+25.00	4876+09.97	BOTH	HMA	1098.5	21.8	Remove Per Staging Plans
CEMETERY RD						
5882+30.00	5884+06.32	BOTH	HMA	526.5	24.4	Remove Per Staging Plans
5884+13.31	5885+42.00	BOTH	PCC	640.1	25.0	Remove Per Staging Plans
DETOUR PVMT.						
869+62.80	879+14.71	RT	TEMP. PVMT.	1859.8	0.0	Stage 1C Detour Pavement, Remove Per Staging.
882+63.44	883+99.64	RT	TEMP. PVMT.	46.6	0.0	Stage 1C Detour Pavement, Remove Per Staging.
884+99.85	890+92.91	RT	TEMP. PVMT.	1258.5	0.0	Stage 1C Detour Pavement, Remove Per Staging.
891+27.79	893+96.76	RT	TEMP. PVMT.	593.1	0.0	Stage 1C Detour Pavement, Remove Per Staging.
894+37.55	895+56.60	RT	TEMP. PVMT.	247.1	0.0	Stage 1C Detour Pavement, Remove Per Staging.
895+98.24	902+84.49	RT	TEMP. PVMT.	1102.8	0.0	Stage 1C Detour Pavement, Remove Per Staging.
860+76.91	865+98.61	LT	TEMP. PVMT.	720.4	0.0	Stage 2A Detour Pavement, Remove Per Staging.
868+76.20	872+09.69	LT	TEMP. PVMT.	439.2	0.0	Stage 2A Detour Pavement, Remove Per Staging.
876+23.77	879+68.00	LT	TEMP. PVMT.	325.4	0.0	Stage 2A Detour Pavement, Remove Per Staging.
882+04.00	883+46.75	LT	TEMP. PVMT.	175.7	0.0	Stage 2A Detour Pavement, Remove Per Staging.
898+00.00	901+97.45	LT	TEMP. PVMT.	203.1	0.0	Stage 2B Detour Pavement, Remove Per Staging.
977+97.82	982+28.46	LT	TEMP. PVMT.	1124.8	0.0	DD No. 2 Stage 1 Detour Pavement, Remove Per Staging.
			Total:	33775.8	5352.8	

ADJUSTMENT OF FIXTURES

No.	Location Station	Type of Fixture	Adjustment
1	844+66.07	Fire Hydrant	Minor Adjustment, Raise 0.06', Refer to Sheet D.2, Division 2
2	844+67.84	Water Valve	Minor Adjustment (Incidental), Raise 0.11', Refer to Sheet D.2
3	875+18.26	Gas Valve	Minor Adjustment (By Others), Raise 0.39', Refer to Sheet D.4, Contact Utility Company
4	877+81.86	Water Valve	Minor Adjustment, Adjust to Proposed Grade, Refer to Sheet D.3
5	877+82.08	Fire Hydrant	Minor Adjustment, Adjust to Proposed Grade, Refer to Sheet D.3, Division 2
6	879+46.82	Gas Valve	Minor Adjustment (By Others), Raise 1.86', Refer to Sheet D.4, Contact Utility Company
7	882+66.49	Sanitary Sewer Manhole	Major Adjustment, Raise 0.41', Refer to Sheet D.5, Division 2
8	885+38.91	Water Valve	Major Adjustment (Incidental), Lower 1.49', Refer to Sheet D.5
9	887+15.05	Gas Valve	Minor Adjustment (By Others), Raise 1.43', Refer to Sheet D.5, Contact Utility Company
10	888+23.42	Water Valve	Major Adjustment (Incidental), Lower 1.58', Refer to Sheet D.5
11	888+23.46	Fire Hydrant	Minor Adjustment (Incidental), Lower 0.74', Refer to Sheet D.5, Division 2
12	888+85.61	Gas Valve	Minor Adjustment (By Others), Raise 1.48', Refer to Sheet D.5, Contact Utility Company
13	890+58.90	Gas Valve	Minor Adjustment (By Others), Lower 0.04', Refer to Sheet D.5, Contact Utility Company
14	893+91.45	Gas Valve	Minor Adjustment (By Others), Adj. to Grade, Refer to Sheet D.5, Contact Utility Company
15	897+07.51	Water Valve	Minor Adjustment (Incidental), Raise 0.70', Refer to Sheet D.6
16	897+07.66	Fire Hydrant	Major Adjustment, Raise 1.48', Refer to Sheet D.6, Division 2
17	897+12.00	Water Valve	Minor Adjustment (Incidental), Raise 0.65', Refer to Sheet D.6
18	899+40.71	Gas Valve	Minor Adjustment (By Others), Raise 0.56', Refer to Sheet D.6, Contact Utility Company
19	1848+95.23	Sanitary Sewer Manhole	Major Adjustment, Raise 0.80', Refer to Sheet D.2, E.1, M.1 and M.8, Division 2
20	1850+41.44	Sanitary Sewer Manhole	Major Adjustment, Lower 0.40', Refer to Sheet E.1, Division 2
21	2865+79.64	Sanitary Sewer Manhole	Major Adjustment, Raise 0.98', Refer to Sheet E.2 Division 2
22	2864+84.91	Water Valve	Major Adjustment (Incidental), Raise 2.93' to Proposed Grade, Refer to Sheet E.2
23	2864+87.18	Water Valve	Major Adjustment (Incidental), Raise 2.47' to Proposed Grade, Refer to Sheet E.2
24	5884+86.59	Water Valve	Minor Adjustment (Incidental), Raise 0.32', Refer to Sheet E.5
25	5884+92.92	Water Valve	Minor Adjustment (Incidental), Raise 0.32', Refer to Sheet E.5
26	5885+20.44	Water Valve	Minor Adjustment (Incidental), Raise 0.51', Refer to Sheet E.5
27	5885+19.57	Fire Hydrant	Minor Adjustment, Raise 0.49', Refer to Sheet E.5, Division 2
28	5885+28.77	Storm Sewer Manhole	Major Adjustment, Lower 0.19', Refer to Sheet E.5, Division 2
	Totals:	5	MANHOLE ADJUSTMENT, MAJOR
		5	FIRE HYDRANT ADJUSTMENT

SIDEWALK REMOVAL

* Not a bid item

Begin Station	End Station	Area	Saw Cut*	Remarks
		SY	LF	
845+60.00	845+80.00	9.4	24.0	
846+24.70	847+08.40	33.4	0.0	
1850+41.51	1850+57.84	7.0	3.8	
	Total:	49.8	27.8	

REMOVAL OF CONCRETE DRIVES

* Not a Bid Item

Location Station	Side	Area	Saw Cut*	Remarks
		SY	LF	
846+44.00	RT	69.1	41.6	
846+93.00	LT	60.3	37.7	
847+60.50	RT	96.9	0.0	
849+21.00	LT	161.2	41.3	Includes Asphalt Removal
877+50.00	RT	239.5	34.2	
890+96.75	LT	195.8	36.7	
891+10.00	RT	298.7	23.9	
894+18.50	RT	241.8	47.8	Includes C&G Removal
894+21.00	LT	316.6	49.4	
895+76.54	RT	223.5	43.3	Includes C&G Removal
2866+42.33	LT	3.9	15.6	
	Total:	1907.3	371.5	

SANITARY OR STORM SEWER ABANDONMENT OR REMOVAL

* Not a bid item

Location/Description	Sanitary or Storm Sewer	Abandonment, Plug Only or Abandonment, Plug and Fill or Removal	Length of Pipe		Fill Material*	Remarks
			≤ 36 inch diameter	> 36 inch diameter	Flowable Mortar or CLSM	
			LF	LF	CY	
845+05 to 848+34, LT	Storm Sewer	Removal	329			
845+68 to 848+35, RT	Storm Sewer	Removal	266			
848+38.75, 29.2' LT to 15.8' RT	Storm Sewer	Removal	45			
848+41 to 849+64, LT	Storm Sewer	Removal	129			
849+82, 16.8' RT to 31.7' LT	Storm Sewer	Removal	49			
849+82, 35.7' LT to 59.9' LT	Storm Sewer	Removal	25			
852+52, 17.2' RT to 26.3' LT	Storm Sewer	Removal	44			
852+55, 29.7' LT to 104.1' LT	Storm Sewer	Removal	77			
863+54 to 865+24, RT	Storm Sewer	Removal	175			
863+81 to 864+64, LT	Storm Sewer	Removal	88			
866+39, 13.2' RT to 14.5' LT	Storm Sewer	Removal	28			
866+39, 18.5' LT to 60.7' LT	Storm Sewer	Removal	43			
3863+08, 11.2' LT to 18.8' RT	Storm Sewer	Removal	33			
979+67.8, 152.7' RT to 979+91.9, 107.5' RT	Sanitary Sewer	Removal	50			Losey Avenue
980+70.6, 98.9' LT to 980+71.2, 148.9' LT	Sanitary Sewer	Removal	50			Refer to U Sheets
980+71.2, 148.9' RT to 979+67.8, 152.7' RT	Sanitary Sewer	Abandonment, Plug and Fill	246		28.6 CY Flowable Mortar	Refer to U Sheets
Totals:	Storm Sewer	Removal	1331			
	Sanitary Sewer	Removal	100			
	Sanitary Sewer	Abandonment, Plug and Fill	246			

REMOVAL OF EXISTING STRUCTURES

Location	Description	Remarks
850+66 to 856+73, RT	Existing Block Retaining Wall	Refer to Sheet D.3
859+87 to 861+89, LT	Existing Block Retaining Wall	Refer to Sheet D.3
1850+18, 22' LT	Existing Block Retaining Wall	Refer to Sheet E.1
2865+65.30, 19.9' LT	Water Meter Pit	Existing Pit is Abandoned. Refer to Sheet E.2

REMOVAL OF INTAKES AND UTILITY ACCESSES

No.	Location/Description	Type	Remarks
1	845+63, 17.2' RT	Intakes	
2	848+39, 17.5' RT	Intakes	
3	848+38, 31.2' LT	Intakes	
4	849+82, 33.6' LT	Intakes	
5	849+82, 18.8' RT	Intakes	
6	851+14, 32' LT	Utilities	Utility Handhole, Coordinate with Utility Company
7	852+52, 19.2' RT	Intakes	
8	852+52, 28.1' LT	Intakes	
9	863+49, 18.9' RT	Intakes	
10	863+76, 27.3' LT	Intakes	
11	866+39, 15.2' RT	Intakes	
12	866+39, 16.5' LT	Intakes	
13	979+91.50, 107.9' RT	Utilities	Sanitary Sewer Manhole, Refer to U Sheets
14	980+67.30, 44.3' RT	Utilities	Sanitary Sewer Manhole, Refer to U Sheets
15	980+70.60, 62.0' LT	Utilities	Sanitary Sewer Manhole, Refer to U Sheets
16	3863+00, 13.2' LT	Intakes	
Total:		16	

DRAINAGE STRUCTURE BY ROAD CONTRACTOR

Length of unclassified pipe calculated is based on using Reinforced Concrete Pipe.


* Not a bid item

① Diameter or equivalent diameter

② UNCL = Unclassified Pipe CMP = Corrugated Metal Pipe RCP = Reinforced Concrete Pipe LCP = Arch or Elliptical Low Clearance Pipe SARC = Steel Arch Pipe

Drainage Area ACRE	Location	Type	Size ① IN	Kind Of Pipe ②	Length New Const. LF	Bedding Class	Design Cover (H) FT	Camber* (DR-102) FT	Apron No.	Apron Guard* (DR-213) No.	Elbow* (DR-141) No.	Diaphragm* (DR-501) No.	Tee Section* (DR-142) No.	"D" Section* (DR-141) No.	Reducer*	Type 'C' Connections* (DR-122) Type No.	Connected Pipe Joint* (DR-121) Type	4" Perforated Subdrain*	Flow Line Elevations Lt. Rt. Other	Dimensions Lin. Ft.				Skew Ahead Degrees Lt. Rt.	Dike			Class 20 CY	Flowable Mortar CY	Floodable* Backfill CY	Porous* Backfill CY	Flooded Backfill CY	Remarks			
																				Total		Extensions			Rt. Lt.	Location Station	Top Elevation							Type		
																				Lt.	Rt.	Lt.	Rt.												(A)	(B)
12.0	852+26.00	3000D	42	RCP	170	B	18.9	0.33	1	1	2						Type 2		752.04	754.30															Sheet V.20	
67.0	900+60.27	2000D	48	RCP	2	B	0.5										Type 2			753.22	753.30	753.30														Sheet V.21
40.3	6957+40.00	2000D	42	RCP	74	B	5.3	0.08	1	1	2						Type 2		772.40	773.30																Sheet V.22
Totals:									4	42"																										

PCC PAVEMENT

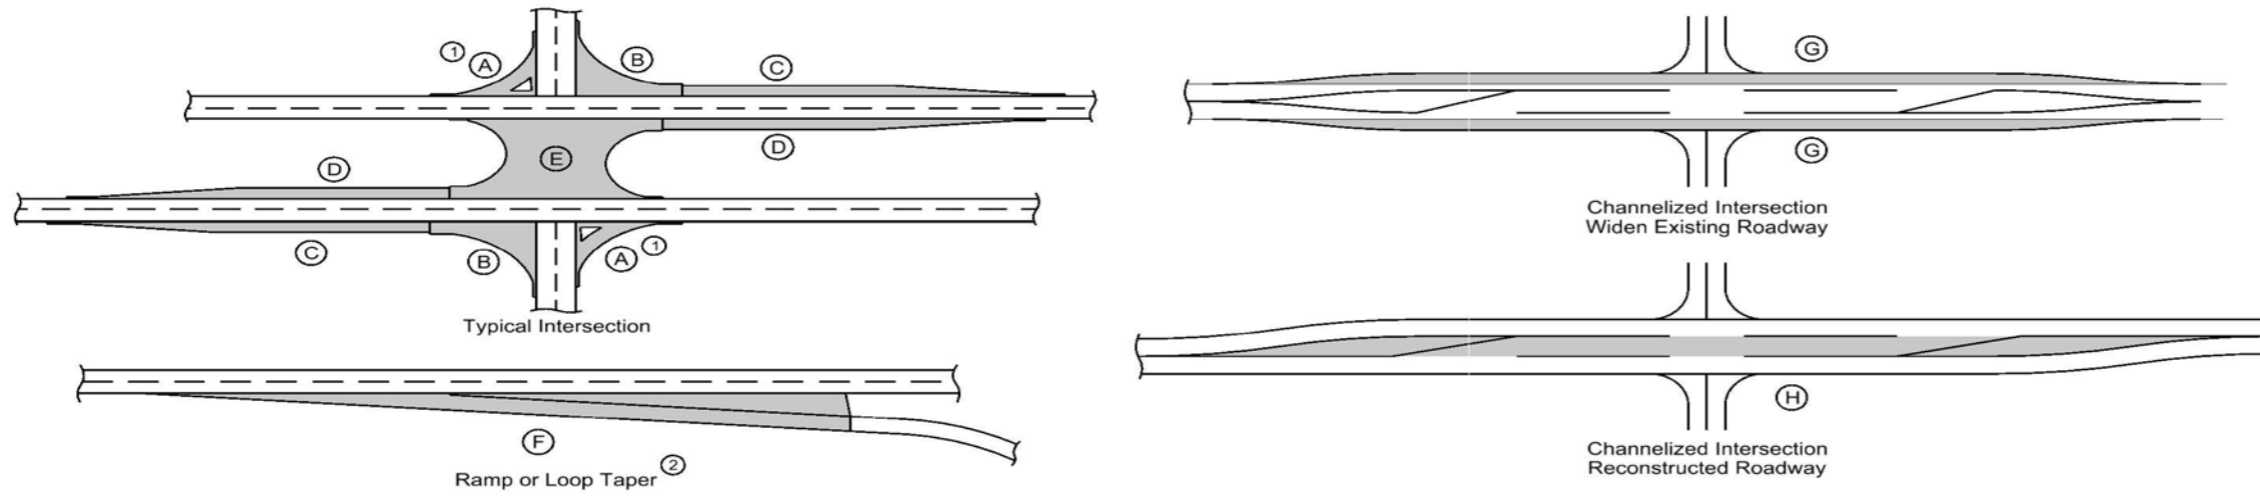

- ① Does not include raised island area or curb. Refer to tabulation 112-4 for quantities.
- ② Refer to PV-410, PV-411, PV-412, and PV-414.
- ③ Quantity includes Pavement Header.

Road Identification	Location		Mainline			Area ③								Total Area By Pavement Thickness		Special Backfill	Modified Subbase	Granular Subbase	Remarks		
	Direction of Travel	Station to Station		Width	Length	Area	A ①	B	C	D	E	F ②	G	H	SY						
		FT	FT	SY	SY	SY	SY	SY	SY	SY	SY	SY	SY	SY	9.5 IN					7 IN	TONS
Losey Avenue	NB/SB	3862+86.45	3864+56.28	23.0	169.8	434.1										434.1	115.0				
Losey Avenue	NB/SB	3864+56.28	3864+83.31	17.0	27.0	51.1										51.1	10.8				
Losey Avenue	NB	3864+56.28	3864+83.31	VARIES	27.0								30.4			30.4	9.0				
Stallman Drive	NB/SB	4874+25.00	4875+07.57	25.0	82.6	229.4										229.4	55.9				
Stallman Drive	NB/SB	4875+07.57	4875+43.95	22.0	36.4	89.0										89.0	21.3				
Stallman Drive	NB	4875+07.57	4875+81.00	VARIES	73.4								68.6			68.6	18.1				
Stallman Drive	NB/SB	4875+43.95	4875+81.00	19.0	37.0	78.3										78.3	16.5				
Stallman Drive	SB	4875+43.95	4875+81.00	VARIES	37.0								62.0			62.0	16.1				
Cemetery Road	EB/WB	5882+30.00	5883+88.70	25.0	158.7	440.9										440.9	102.7				
Cemetery Road	EB	5883+15.59	5883+88.70	VARIES	73.1											96.8	23.4				
Cemetery Road	WB	5883+60.60	5883+88.70	VARIES	28.1								33.3			33.3	9.0				
Cemetery Road	EB/WB	5884+37.80	5885+42.00	25.0	104.2	289.5										289.5		98.3			
Cemetery Road	EB	5884+37.80	5884+86.04	VARIES	48.2											46.8		21.1			
Cemetery Road	WB	5884+37.80	5885+27.53	VARIES	89.7								161.9			161.9		57.2			
Total:																21572.7	4479.2	959.5	15692.9		


BRIDGE APPROACH SECTION

Refer to the BR Series.

* Not a bid item

Bridge Station	End	Location		Skew Ahead Degrees	Approach Pavement				Standard Road Plans BR Series			Subdrain							Remarks	
		Thickness Inches	Pay Length FT		Non-Reinf. Pavement Area SY	Single-Reinf. Pavement Area SY	Double-Reinf. Pavement Area SY	Approach	Fixed or Movable Abutment	Abutting Pavement	Perforated Subdrain 4" LF	Subdrain Outlet		Porous Backfill CY	Class 'A' Crushed Stone Backfill CY	Modified Subbase TON	Polymer Grid SY	Special Backfill TON		
												LEFT	RIGHT							STA
857+32.60	S	4	12.0	70.0	140.9	94.5	122.5	BR-203	Movable	BR-211	74.0	855+69.10	LT	2.3		344.500	398.2		UPRR Bridge (BRF-151-3(141)--38-57)	
	N	4	12.0	70.0	140.9	94.4	129.2	BR-203	Movable	BR-211	54.0	858+96.10	LT	1.7		352.200	404.8		Connect Subdrain to Longitudinal Subdrain, Avoid GR Post	
867+41.69	S	30	12.0	86.8	146.7	102.8	228.3	BR-203	Movable	BR-211	78.0	865+58.61	LT	2.4		460.800	523.7		Prairie Creek Bridge (BRF-151-3(142)--38-57)	
	N	30	12.0	78.3	146.7	102.8	228.9	BR-203	Movable	BR-211	78.0	869+16.20	RT	2.4		461.500	521.4		Prairie Creek Bridge (BRF-151-3(142)--38-57)	
880+85.25	S	15	12.0	76.9	126.7	169.6	296.8	BR-205	Movable	BR-211	80.0	879+48.00	RT	2.5		601.500	635.7		Drainage Ditch No. 1 Bridge (BRF-151-3(152)--38-57)	
	N	15	12.0	78.3	149.8		445.9	BR-205	Movable	BR-211	82.0	882+24.00	RT	2.5		590.900	638.7		Ext. Dbl. Reinf. Section to End of Sep. Rail. Sheet L.17	
Total:							1678.6	1188.8	BR-203											

HMA PAVEMENT

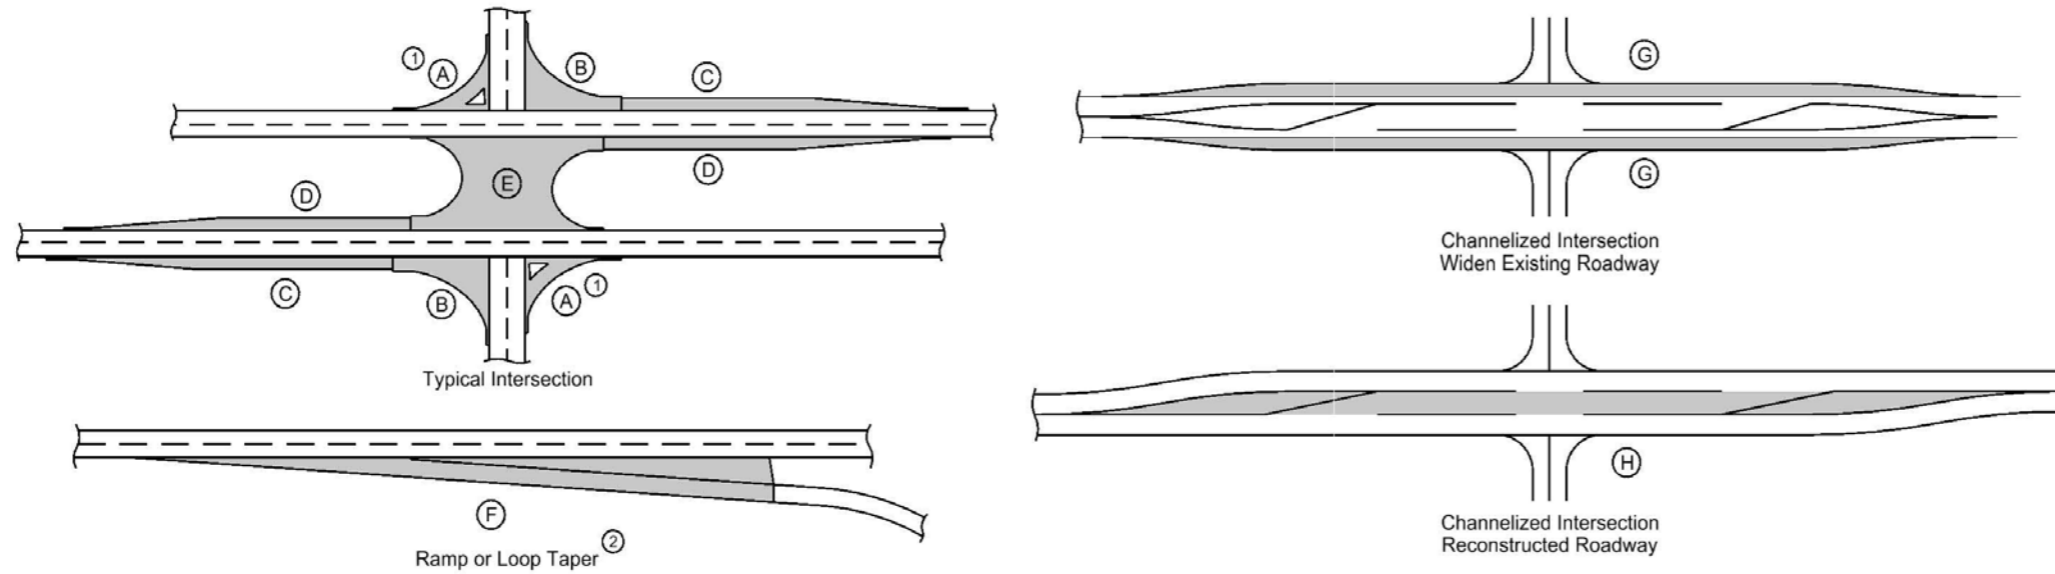

- ① Does not include raised island area or curb. Refer to tabulation 112-4 for quantities.
- ② Refer to PV-410, PV-411, PV-412, and PV-414.
- ③ Quantity includes Pavement Header.

Calculations assume a surface course unit weight (lbs/cf) of 155, an intermediate course unit weight (lbs/cf) of 150, a base course unit weight (lbs/cf) of 150, and a special backfill unit weight (lbs/cf) of 140.

Location				Mainline			Area ③								Bid Items										Remarks		
Road Identification	Direction of Travel	Station to Station		Width	Length	Area	A ①	B	C	D	E	F ②	G	H	Hot Mix Asphalt Pavement						Binder						
															Surface		Intermediate		Base		Surface	Intermediate	Base	Special Backfill		Modified Subbase	Granular Subbase
		FT	FT	SY	SY	SY	SY	SY	SY	SY	SY	SY	SY	SY	TONS	SY	TONS	SY	TONS	SY	TONS	TONS	TONS	SY		SY	
U.S. Highway 151	NB	898+00.00	902+58.42	Varies	458.4								298.3				33.6	298.3	100.7	298.3		2.0	6.0		284.1		
U.S. Highway 151	SB	898+00.00	900+09.70	Varies	209.7								68.2				7.7	68.2	23.0	68.2		0.5	1.4		139.2		
U.S. Highway 151	NB/SB	898+00.00	902+58.42	Varies	458.4	2469.0									287.0	2469.0											
U.S. Highway 151	SB	974+69.95	979+30.00	12.0	460.1	613.5									71.3	613.5											
U.S. Highway 151	NB/SB	979+30.00	981+40.00	40.0	210.0	933.4									108.5	933.4											
U.S. Highway 151	SB	981+40.00	984+83.16	12.0	343.2	457.6									53.2	457.6											
Total:														546.1	4473.5	43.3	366.5	129.9	366.5	32.8	2.6	7.8				423.3	

NOTCHES AND RUNOUTS FOR RESURFACING

Refer to PR-201 and PR-202.

① Bid item. Applies only to Types 'N1' and 'N3' on PR-202. Refer to 100-25 for remaining values.

Location Station	Type of Notch or Runout	S	I	DI	L	M	Pavement Scarification ①	Remarks
		IN	IN	IN	FT	IN	SY	
902+58.42	Type 'N1'	2.0			100.0	2.0	576.1	
Total:							576.1	

ACCESS POINTS AND SAFETY RAMPS

Refer to Cross-Sections

Length of unclassified pipe calculated is based on using Corrugated Metal Pipe.

- ① Refer to MI-210
- ② Refer to EW-501.
- ③ Refer to EW-501 or EW-502.

*Predetermined for access point not constructed with this project.

Station	Side	Type A, B, C, Safety Ramp, or Predetermined*	Length of Opening ①			Pipe Culvert ③							Aprons No.	Driveway Surface Area		Driveway Surfacing Material TON	Remarks		
			Case 1 or 2	1 1/2" Dropped Curb LF	3" Dropped Curb LF	W FT	PR FT	SR FT	H FT	Size IN	Pipe Length LF	Lt. LF		Rt. LF	HMA			PCC	
															SY			SY	
U.S. Hwy 151																			
844+91.50	R	C	2	26.8		20.0											28.8		
845+34.00	L	C	2	30.0		20.0											28.3		
845+97.50	R	B	2	40.0		35.0											36.2		
846+44.00	R	C	2	24.5		20.0											31.2		
846+93.00	L	B	2	44.0		34.0											81.2		
847+60.50	R	B	2	64.5		60.0											57.8	Ex. Entrance 65' wide	
864+19.80	L	C	1	71.2		25.0	VAR										493.6	Refer to L Sheets	
864+19.80	L	C				15.0												126.700	Refer to L Sheets
873+00.00	L	B	1			30.0	30.0	15.0									142.7		
877+50.00	R	B	1			34.2	30.0	15.0									202.2		
878+31.00	L	C				20.0		15.0										51.000	Refer to M Sheets
890+96.75	L	B	1			37.0	30.0		1.2	18	56.0	29.7	31.7	2			181.0	CMP Pipe	
891+10.00	R	B	1			24.0	30.0		1.5	18	44.0	24.9	23.8	2			238.5	CMP Pipe	
894+18.50	R	B	1			40.0	30.0										241.9		
894+21.00	L	B	1			30.0	30.0										230.8		
895+76.54	R	B	1			43.0	30.0										233.4	Includes Curb	
897+64.90	R	C				26.0		15.0										35.100	Incl. Curb, UAC Ex. Pipe
983+85.00	L	C				15.0		15.0	2.4	18	50.0	33.7	28.5	2				69.100	UAC Existing Pipe
Church St.																			
1847+85.30	R	B	2			24.0												169.9	
1850+17.23	R	B	2			30.0												83.2	
1850+31.75	L	C	2			12.0												21.2	
1850+68.00	R	C	2			12.0			1.0	12	28.0	15.4	13.6	2				35.7	CMP Pipe
1851+11.39	R	C	2			16.0												32.8	
Prairie Ave.																			
2865+51.90	L	C	2			10.0												75.4	
2866+00.00	R	C	2			16.0												23.9	
2866+42.33	L	C	2			16.0												23.4	
Losey Ave.																			
3863+77.60	R	C	2	34.4		24.0												46.3	
80th St. SW																			
7910+00.00	L	C						20.0	1.2	30	56.0	31.6	36.0	2				132.100	RCP Pipe
Totals:										12	28.0	CMP	Apron:	2					
										18	150.0	CMP	Apron:	6					
										30	56.0	RCP	Apron:	2					

SIDEWALK CONSTRAINTS


290-01
04-15-14

1. Widths:
Widths listed in the S sheets are minimums.
2. Cross Slopes:
Construct all sidewalks, curb ramps, and landings/turning spaces at a target cross slope of 1.5%. Cross slopes exceeding 2.0% will not be allowed, except for areas tying into existing pavement. In these areas, transition from existing pavement cross slope to a cross slope of less than 2.0% within one panel at a rate not to exceed 1.0% per foot.
3. Longitudinal Slopes:
 - a. Sidewalk:
 - i. Roadway slope exceeds 5.0%: Sidewalk longitudinal slope exceeding the roadway slope by more than 2.0% will not be allowed.
 - ii. Roadway slope 5.0% or less: Sidewalk longitudinal slope exceeding 5.0% will not be allowed.
 - b. Ramps:
 - i. Ramps 15.0' in length or less: Longitudinal slope exceeding 8.3% will not be allowed.
 - ii. Ramps greater than 15.0' in length: Construct with the longitudinal slope necessary to conform to the design.
4. Landing/Turning Spaces:
Longitudinal slopes exceeding 2.0% will not be allowed.

SIDEWALKS

113-1
10-16-18

See MI-220 and S Sheets

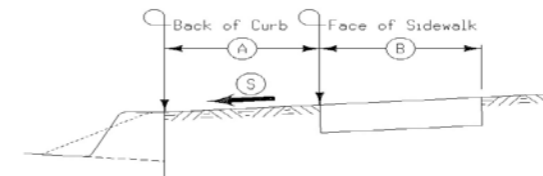

Intersection	Quadrant	Length	A	B	S	4" PCC Sidewalk	6" PCC Sidewalk	8" PCC Sidewalk	10" PCC Sidewalk	Detectable Warnings	Remarks
			FT	FT	%	SY	SY	SY	SY		
845+60.00 - 845+80.00		20	5.30	4.00		8.9					U.S. Highway 151
846+15.00 - 846+34.00		19	4.50	4.00		8.5					U.S. Highway 151
846+54.00 - 847+30.50		76.5	4.50	4.00		34.0					U.S. Highway 151
1850+37.75 - 1850+57.84		20	8.50	4.00		8.9					Church Street
Total:						60.3					

LONGITUDINAL SUBDRAIN SHOULDER AND BACKSLOPE

Refer to Soils Sheets

* Not a bid item. Bridge berm quantities assume a trench depth of 24 inches.

Line No.	Road or Lane Identification	Location Station to Station		Side	Longitudinal Subdrain (DR-303)						Subdrain Outlet		Porous* Backfill CY	Class "A"* Crushed Stone CY	Remarks		
					Depth D	Shoulder		Backslope		Bridge Berm (EW-203 or EW-204)		DR-303, DR-305 or DR-306					
						Size	Length	Size	Length	Standard Road Plan and Type	Size	Length				Station	Standard Road Plan and Type
						IN	FT	IN	FT		IN	FT					
1	US 151	843+88.65	845+64.97	RT	45.0	4.0	180.3					843+88.65	DR-303	18.1	Type 12, Cap End		
2	US 151	845+64.97	847+21.58	RT	45.0	4.0	158.1					845+64.97	DR-303	15.9	Type 12, Outlet into Intake ST-03		
3	US 151	847+21.58	848+39.00	RT	45.0	4.0	119.0					847+21.58	DR-303	11.9	Type 12, Outlet into Intake ST-05		
4	US 151	848+39.00	849+89.38	RT	45.0	4.0	152.4					848+39.00	DR-303	15.3	Type 12, Outlet into Intake ST-06		
5	US 151	849+89.38	851+50.00	RT	45.0	4.0	162.3					849+89.38	DR-303	16.3	Type 12, Outlet into Intake ST-11		
6	US 151	851+50.00	853+25.60	RT	45.0	4.0	176.4					851+50.00	DR-303	17.7	Type 12, Outlet into Intake ST-12		
7	US 151	853+25.60	855+69.10	RT	45.0	4.0	316.3					853+25.60	DR-303	31.7	Type 12, Outlet into Intake ST-18		
8	US 151	858+96.10	861+82.03	RT	45.0	4.0	305.1					855+69.10	DR-305, Type A	30.6	Type 7A, Outlet to Left		
9	US 151	861+82.03	863+51.70	RT	45.0	4.0	170.4					858+96.10	DR-303	17.1	Connect to Approach Pavement Subdrain		
10	US 151	863+51.70	865+66.60	RT	45.0	4.0	239.3					861+82.03	DR-303	24.0	Type 12, Outlet into Intake ST-22		
11	US 151	869+26.20	870+70.00	RT	45.0	4.0	195.8					863+51.70	DR-303	19.6	Type 12, Outlet into Intake ST-24		
12	US 151	870+70.00	875+24.64	RT	45.0	4.0	507.1					865+66.60	DR-305, Type A	50.9	Type 7A, Outlet to Left		
13	US 151	875+24.64	879+37.99	RT	45.0	4.0	464.9					869+26.20	DR-305, Type A	46.6	Type 7A		
14	US 151	882+29.22	885+23.39	RT	45.0	4.0	330.2					870+70.00	DR-305, Type A	33.1	Type 12		
15	US 151	885+23.39	888+50.00	RT	45.0	4.0	371.6					875+24.64	DR-305, Type A	37.3	Type 7A		
16	US 151	888+50.00	893+00.00	RT	30.0	4.0	486.2					879+37.99	DR-305, Type A	30.0	Type 7A		
17	US 151	893+00.00	898+00.00	RT	45.0	4.0	546.6					882+29.22	DR-305, Type A	54.8	Type 7A		
18	US 151	898+00.00	902+58.42	RT	45.0	4.0	507.8					885+23.39	DR-305, Type A	50.9	Type 7A		
19	US 151	845+05.46	846+64.33	LT	45.0	4.0	162.7					888+50.00	DR-305, Type A	16.3	Type 7A		
20	US 151	846+64.33	848+39.00	LT	45.0	4.0	176.3					893+00.00	DR-305, Type A	17.7	Type 12, Outlet into Intake ST-02		
21	US 151	848+39.00	849+89.28	LT	45.0	4.0	151.2					898+00.00	DR-305, Type A	15.2	Type 12, Outlet into Intake ST-04		
22	US 151	849+89.28	851+50.00	LT	45.0	4.0	162.3					898+00.00	DR-305, Type A	16.3	Type 12, Outlet into Intake ST-07		
23	US 151	851+50.00	853+25.60	LT	45.0	4.0	176.2					898+00.00	DR-303	17.7	Type 12, Outlet into Intake ST-14		
24	US 151	853+25.60	855+69.10	LT	45.0	4.0	278.2					849+89.28	DR-303	27.9	Type 12, Outlet into Intake ST-13		
25	US 151	858+96.10	861+82.03	LT	45.0	4.0	304.8					851+50.00	DR-303	30.6	Type 12, Outlet into Intake ST-18		
26	US 151	861+82.03	863+51.69	LT	45.0	4.0	170.4					853+25.60	DR-303	17.1	Connect to Approach Pavement Subdrain		
27	US 151	863+51.69	865+66.60	LT	45.0	4.0	255.8					855+69.10	DR-305, Type A	25.7	Type 7A		
28	US 151	869+16.20	870+70.00	LT	45.0	4.0	218.9					861+82.03	DR-303	22.0	Type 12, Outlet into Intake ST-21		
29	US 151	870+70.00	875+24.64	LT	45.0	4.0	565.9					863+51.69	DR-303	56.8	Type 12, Outlet into Intake ST-23		
30	US 151	875+24.64	879+37.99	LT	30.0	4.0	511.0					865+66.60	DR-305, Type A	31.5	Type 7A		
31	US 151	882+29.22	883+19.86	LT	45.0	4.0	164.1					869+16.20	DR-305, Type A	16.5	Type 12		
32	US 151	883+19.86	888+11.75	LT	45.0	4.0	553.4					870+70.00	DR-305, Type A	55.5	Type 7A		
33	US 151	888+11.75	893+07.78	LT	24.0	4.0	538.0					875+24.64	DR-305, Type A	24.9	Type 7A		
34	US 151	893+07.78	898+00.00	LT	24.0	4.0	541.7					879+37.99	DR-305, Type A	25.1	Type 7A		
35	US 151	898+00.00	902+58.42	LT	45.0	4.0	504.5					882+29.22	DR-305, Type A	50.6	Type 7A		
Totals:							10826.0					DR-303	32	989.2			
												DR-305	36				

GRADING FOR GUARDRAIL INSTALLATIONS

① Lane(s) to which the installation is adjacent.

Refer to EW-301

Location				Dimensions (Feet)									Earthwork		Remarks	
No.	Direction of Traffic	Station	Side	Foreslope at Guardrail	X1	Y1	X2	Y2	X3	Y3	X4	Y4	Z	Excavation Class 10		Embankment In Place
														CY		CY
1	NB	880+00.67	R	6:1					78.6	5.0	129.5	7.0	47.1			Earthwork Included in Template Quantities Earthwork Included in Template Quantities Approach Side, Ewrk. Included in Template Qtys Departure Side, Ewrk. Included in Template Qtys Approach Side, Ewrk. Included in Template Qtys Departure Side, Ewrk. Included in Template Qtys
2	SB	882+04.00	L	6:1					36.3	5.0	88.4	7.1	49.9			
3	NB	979+26.40	R	6:1					74.9	5.0	124.4	7.0	46.7			
4	NB	979+26.40	R	6:1							118.8	4.0	46.1			
5	SB	981+18.84	L	6:1				87.4	5.0	130.7	6.7	59.3				
6	SB	981+18.84	L	6:1							118.8	4.0	46.1			

REMOVAL OF STEEL BEAM GUARDRAIL

① Lane(s) to which the installation is adjacent.
② Includes length of End Terminals and End Anchors.

Location				Removal of Guardrail	
No.	Direction of Traffic	Station to Station	Side		
1	NB	849+74.84	856+50.00	RT	675.5
2	SB	855+61.06	856+51.59	LT	90.9
3	NB	857+94.75	858+84.84	RT	90.4
4	SB	857+94.97	862+96.35	LT	502.1
5	NB	865+77.61	866+60.69	RT	83.3
6	SB	865+78.29	866+61.42	LT	83.6
7	NB	868+27.45	869+48.28	RT	121.4
8	SB	868+27.61	869+48.29	LT	121.3
9	NB	879+15.90	880+63.70	RT	146.3
10	SB	880+03.84	880+61.94	LT	59.1
11	NB	881+15.77	881+75.06	RT	58.9
12	SB	881+17.73	882+62.14	LT	146.4
13	NB	978+35.42	979+83.13	RT	148.0
14	SB	979+46.38	980+06.71	LT	60.5
15	NB	980+31.32	980+91.56	RT	60.5
16	SB	980+54.10	982+02.06	LT	148.2
				Total:	2596.4

STEEL BEAM GUARDRAIL AT CONCRETE BARRIER OR BRIDGE RAIL END SECTION

Possible Standards: BA-200, BA-201, BA-202, BA-205, BA-206, BA-210, BA-211, BA-221, BA-225, BA-250, BA-260, LS-625, LS-626, LS-630, LS-635, SI-172, SI-173 and SI-211.

① Lane(s) to which the obstacle is adjacent.
② Not a bid item. Incidental to guardrail installation.

No.	Direction of Traffic	Side O = Outside M = Median	Location				Layout Lengths				Delineators and Object Markers				Bid Items								Remarks						
			Station	Offset	BA-250, BA-260, LS-630, or LS-635				Long-Span System	SI-211	Delineator SI-172	Object Marker SI-173			Bolted End Anchor	Post Adapter	Steel Beam Guardrail	Barrier Transition Section	BA-250 or LS-630					BA-260 or LS-635					
					VF	VT2	ET	STATION				TYPE	TYPE	Type 1					Type 2	Type 3	BA-202	BA-210		BA-200	BA-201	End Terminal		Barrier Transition Section	End Terminal
																										Tangent	Flared		
FT	LF	LF	LF	LF	STATION	TYPE	TYPE	White	OM2-2	OM3-L	OM3-R	BA-202	BA-210	BA-200	BA-201	BA-205	BA-206	LS-625	LS-626	BA-221	BA-225								
1	SB	O	856+09.10	20.0	40.625				47.7			2				B	1		0.0		1	1							
2	NB	O	856+23.50	20.8	578.125				47.7	851+39.73	2	2		24		A	1		537.5		1	1					Span Intake		
3	NB	O	858+44.50	20.8	165.625				47.7	853+14.73	2	2		7		A	1		125.0		1	1					Span Intake		
4	SB	O	858+56.11	20.0	365.625	62.50	25.00		47.7	861+71.12	2	2		19		B	1		412.5		1	1							
5	NB	O	866+41.74	23.6	78.125				47.7			2		4		A	1		37.5		1	1							
6	SB	O	868+76.20	23.0	65.625				47.7			2		3		B	1		25.0		1	1							
7	NB	O	880+00.67	29.6	78.125				47.7			3		1		A	1		37.5		1	1							
8	SB	O	882+04.00	29.0	40.625				47.7			3		1		A	1		0.0		1	1							
															Total:		8		1175.0		8		8						

STEEL BEAM GUARDRAIL FOR SIDE OBSTACLE (ONE-WAY PROTECTION)

Possible Standards: BA-200, BA-203, BA-205, BA-206, BA-210, BA-211, BA-252, LS-625, LS 626, LS-632, SI-172, SI-173, and SI-211.

① Lane(s) to which the obstacle is adjacent.

No.	Direction of Traffic	Side O = Outside M = Median	Location		Layout Lengths					Delineators and Object Markers				Bid Items				Remarks							
			Station	Offset	BA-252 or LS-632					Long-Span System	SI-211	Delineator SI-172	Object Marker SI-173			Steel Beam Guardrail	W-Beam End Anchor		End Terminal		Post Adapter				
					O _L	D ₀	Approach Side (A)		Trailing Side (T)				Type 1	Type 2	Type 3				Standard	Count					
							ET	VT2 _A	VF _A													VT1 _A	VT1 _T	EA	BA-200
FT	FT	LF	LF	LF	LF	LF	LF	STATION	TYPE	TYPE	White	OM2-2	OM3-L	OM3-R	BA-200	BA-203	BA-210								
1	NB	O	979+26.40	99.63	12.00				47.7										187.5		1	BA-205	1	11	
2	SB	O	981+18.84	99.63	12.00				47.7	75.00	118.75	9.375							200.0		1	BA-205	1	11	
															Total:			387.5		2		2	22		

TEMPORARY BARRIER RAIL

Possible Standards: BA-400, BA-401

* Not a bid item. Anchorage requirements are based on TBR locations shown in the plans. TBR alignments that vary from what is shown in the plans may result in additional TBR sections requiring anchorage.

No.	Station to Station		Length LF	(Select One)		Anchored* (Y/N)	Modular Glare Screen System (Y/N)	Remarks
				Steel BA-400	Concrete BA-401			
1	865+04.00	865+68.00	62.5		X	No	No	Stage 2A
2	865+68.00	868+88.00	325.0		X	Yes	No	Prairie Creek Bridge, Stage 2A/2B
3	868+88.00	873+37.00	450.0		X	No	No	Stage 2A
4	875+69.00	880+06.00	437.5		X	No	No	Stage 2A
5	880+06.00	881+97.00	187.5		X	Yes	No	Drainage Ditch No. 1, Stage 2A/2B
6	881+97.00	890+08.00	812.5		X	No	No	Stage 2A
7	891+88.00	903+13.00	1125.0		X	No	No	Stage 2A
8	864+14.00	865+04.00	87.5		X	No	No	Additional for Stage 2B
9	873+37.00	875+69.00	237.5		X	No	No	Relocate from Stage 2A for Stage 2B
10	890+08.00	891+58.00	150.0		X	No	No	Relocate from Stage 2A for Stage 2B
11	891+58.00	891+88.00	25.0		X	No	No	Additional for Stage 2B
12	863+42.00	865+58.00	212.5		X	No	No	Stage 3A
13	865+58.00	869+04.00	350.0		X	Yes	No	Prairie Creek Bridge Stage 3A/3B
14	865+42.00	866+06.00	62.5		X	Yes	No	Prairie Creek Bridge Stage 3A/3B
15	866+06.00	868+61.00	250.0		X	Yes	No	Prairie Creek Bridge Stage 3A/3B
16	848+61.00	869+12.00	2050.0		X	No	No	Prairie Creek Bridge Stage 3A/3B
17	868+69.00	869+33.00	62.5		X	Yes	No	Prairie Creek Bridge Stage 3A/3B
18	869+04.00	876+57.00	750.0		X	No	No	Stage 3A
19	878+35.00	879+49.00	112.5		X	No	No	Stage 3A
20	879+49.00	882+29.00	275.0		X	Yes	No	Drainage Ditch No. 1 Stage 3A/3B
21	879+34.00	879+97.00	62.5		X	Yes	No	Drainage Ditch No. 1 Stage 3A/3B
22	881+97.00	882+60.00	62.5		X	Yes	No	Drainage Ditch No. 1 Stage 3A/3B
23	880+22.00	882+10.00	187.5		X	Yes	No	Drainage Ditch No. 1 Stage 3A/3B
24	882+10.00	882+59.00	50.0		X	Yes	No	Drainage Ditch No. 1 Stage 3A/3B
25	882+29.00	893+37.00	1112.5		X	No	No	Stage 3A
26	895+05.00	903+23.00	812.5		X	No	No	Stage 3A
27	865+08.00	865+59.00	50.0		X	No	No	Relocate from Stage 3A for Stage 3B
28	882+29.00	883+39.00	112.5		X	No	No	Relocate from Stage 3A for Stage 3B
29	885+49.00	886+48.00	100.0		X	No	No	Relocate from Stage 3A for Stage 3B
30	892+10.00	894+77.00	262.5		X	No	No	Relocate from Stage 3A for Stage 3B
31	896+72.00	897+09.00	37.5		X	No	No	Relocate from Stage 3A for Stage 3B
32	978+79.00	981+69.00	287.5		X	Yes	No	Drainage Ditch No. 2 Stage 1
33	978+96.00	981+47.00	250.0		X	Yes	No	Drainage Ditch No. 2 Stage 2
34	978+53.00	982+59.00	412.5		X	Yes	No	Drainage Ditch No. 2 Stage 2
Total:			11825.0					

SAFETY CLOSURES

Refer to Section 2518 of the Standard Specifications

Station	Closure Type		Remarks
	Road Qty.	Hazard Qty.	
848+09.00	1		Hwy 151 Stage 1A
1848+00.00	1		Church Street Stage 1A
1850+07.00	1		Church Street Stage 1A
846+97.00	1		Hwy 151 Stage 1B
849+81.00	1		Hwy 151 Stage 1B/1C/2A/2B
1849+76.00	1		Church Street Stage 1B
1851+36.00	1		Church Street Stage 1B
863+67.00	1		Hwy 151 Stage 1C/2A/2B
864+54.00	1		Hwy 151 Stage 2A
873+76.00	1		Hwy 151 Stage 2A
875+29.00	1		Hwy 151 Stage 2A
5882+10.00	1		Cemetery Road Stage 2A
894+17.00	1		Driveway Stage 2A
890+43.00	1		Hwy 151 Stage 2A
981+51.00	1		Hwy 151 Stage 2A
902+74.00	1		Hwy 151 Stage 2A/2B
864+94.00	1		Hwy 151 Stage 2B
4874+17.00	1		Stallman Dr. Stage 2B
883+06.00	1		Hwy 151 Stage 2B
884+57.00	1		Hwy 151 Stage 2B
890+96.00	1		Driveway Stage 2B
893+81.00	1		Hwy 151 Stage 2B
894+54.00	1		Hwy 151 Stage 2B
3862+80.00	1		Losey Ave. Stage 3A
863+44.00	1		Hwy 151 Stage 3A
876+94.00	1		Hwy 151 Stage 3A
878+14.00	1		Hwy 151 Stage 3A
5885+53.00	1		Cemetery Road Stage 3A
891+20.00	1		Driveway Stage 3A
893+83.00	1		Hwy 151 Stage 3A
894+53.00	1		Hwy 151 Stage 3A
895+75.00	1		Hwy 151 Stage 3A
902+66.00	1		Hwy 151 Stage 3A/3B
865+24.00	1		Hwy 151 Stage 3B
876+66.00	1		Hwy 151 Stage 3B
876+35.00	1		Hwy 151 Stage 3B
883+14.00	1		Hwy 151 Stage 3B
885+83.00	1		Hwy 151 Stage 3B
890+55.00	1		Hwy 151 Stage 3B
891+62.00	1		Hwy 151 Stage 3B
894+15.00	1		Driveway Stage 3B
894+81.00	1		Hwy 151 Stage 3B
896+70.00	1		Hwy 151 Stage 3B
6956+19.00	1		Beverly Road
6958+18.00	1		Beverly Road
978+90.00	1		Hwy 151 At DD No. 1 Stage 2
981+55.00	1		Hwy 151 At DD No. 1 Stage 3
Total:			47

TEMPORARY LANE SEPARATOR SYSTEM

Station to Station	Length LF	Remarks	
			870+96.50
904+14.50	907+40.00	326	Stage 2A/2B
972+95.00	976+10.00	315	DD No. 2, Stage 1
984+93.00	987+24.00	231	DD No. 2, Stage 1
864+40.00	865+13.50	74	Prairie Creek, Stage 3A/3B
869+60.50	870+34.00	74	Prairie Creek, Stage 3A/3B
878+34.00	879+07.50	74	DD No. 1, Stage 3A/3B
882+85.00	883+41.00	56	DD No. 1, Stage 3A/3B
890+21.00	893+71.00	350	Stage 4
Total:		1764	

TEMPORARY TRAFFIC SIGNALS

No.	Location Station	Type			Remarks
		One Lane Traffic	Haul Road	Intersection	
1	864+26.00	YES	NO	US 151/Driveway	Stage 2A/2B
2	864+32.00	YES	NO	US 151/Prairie Ave.	Stage 2A/2B
3	870+26.00	YES	NO	Prairie Creek Bridge	Stage 2A/2B
4	976+80.00	YES	NO	Drain. Ditch No. 2	Stage 1
5	984+20.00	YES	NO	Drain. Ditch No. 2	Stage 1

TEMPORARY CROSSINGS AND DETOURS

Blading, shaping, and other work in preparation for maintaining temporary crossings or detours is incidental to other work. Furnish and spread additional granular surfacing needed for temporary crossings or detours during construction at the contract price.

CRASH CUSHIONS

* Bid Item
 ① Lane(s) to which the installation is adjacent.
 ② Complete this section when using the Temporary Crash Cushion bid item and Earthwork is needed for Sand Barrel placement. Refer to BA-500

No.	Direction of Traffic	Location Station	Side	Obstacle Width FT	Crash Cushion (Select One)*					Sand Barrel Details ②					Earthwork*		Spare Parts Kit (Select One)*		Obstacle Description	Remarks
					Temporary	Temporary Redirective	Temporary Severe Use	Permanent	Permanent Severe Use	V	W	X	Y	Z	Excavation Class 10 CY	Embankment in Place CY	Permanent EACH	Permanent Severe Use EACH		
										Length FT	Length FT	Length FT	Length FT	Length FT						
1	SB	865+04.00	RT	1.88			1												Temporary Barrier Rail	Stage 2A
2	SB	873+37.00	RT	1.88			1												Temporary Barrier Rail	Stage 2A
3	SB	875+69.00	RT	1.88			1												Temporary Barrier Rail	Stage 2A
4	SB	890+08.00	RT	1.88			1												Temporary Barrier Rail	Stage 2A
5	SB	891+88.00	RT	1.88			1												Temporary Barrier Rail	Stage 2A
6	SB	903+13.00	RT	1.88	1														Temporary Barrier Rail	Stg 2A/2B
7	SB	882+74.00	RT	1.88			1												Temporary Barrier Rail	Stage 2B
8	SB	884+92.00	RT	1.88			1												Temporary Barrier Rail	Stage 2B
9	SB	893+41.00	RT	1.88			1												Temporary Barrier Rail	Stage 2B
10	SB	893+95.00	RT	1.88			1												Temporary Barrier Rail	Stage 2B
11	NB	863+42.00	RT	1.88			1												Temporary Barrier Rail	Stage 3A
12	NB	865+42.00	LT	1.88			1												Temporary Barrier Rail	Stg 3A/3B
13	SB	869+12.00	RT	1.88			1												Temporary Barrier Rail	Stg 3A/3B
14	SB	869+33.00	LT	1.88			1												Temporary Barrier Rail	Stg 3A/3B
15	NB	876+57.00	RT	1.88			1												Temporary Barrier Rail	Stg 3A/3B
16	NB	878+35.00	RT	1.88			1												Temporary Barrier Rail	Stg 3A/3B
17	NB	879+34.00	LT	1.88			1												Temporary Barrier Rail	Stg 3A/3B
18	SB	882+59.00	RT	1.88			1												Temporary Barrier Rail	Stg 3A/3B
19	SB	882+60.00	LT	1.88			1												Temporary Barrier Rail	Stg 3A/3B
20	NB	893+37.00	RT	1.88			1												Temporary Barrier Rail	Stage 3A
21	NB	895+05.00	RT	1.88			1												Temporary Barrier Rail	Stage 3A
22	NB	903+22.00	RT	1.88			1												Temporary Barrier Rail	Stg 3A/3B
23	NB	883+39.00	RT	1.88			1												Temporary Barrier Rail	Stage 3B
24	NB	885+49.44	RT	1.88			1												Temporary Barrier Rail	Stage 3B
25	NB	890+05.00	RT	1.88			1												Temporary Barrier Rail	Stage 3B
26	NB	892+10.00	RT	1.88			1												Temporary Barrier Rail	Stage 3B
27	NB	894+77.00	RT	1.88			1												Temporary Barrier Rail	Stage 3B
28	NB	896+72.00	RT	1.88			1												Temporary Barrier Rail	Stage 3B
29	SB	978+79.00	RT	1.88	1														Temporary Barrier Rail	DD2 Stg. 1
30	SB	981+69.00	RT	1.88	1														Temporary Barrier Rail	DD2 Stg. 2
31	SB	978+53.00	RT	1.88			1												Temporary Barrier Rail	DD2 Stg. 2
32	NB	978+96.00	RT	1.88			1												Temporary Barrier Rail	DD2 Stg. 2
33	NB	981+47.00	RT	1.88			1												Temporary Barrier Rail	DD2 Stg. 2
34	SB	982+58.00	RT	1.88			1												Temporary Barrier Rail	DD2 Stg. 2
Total:					3		31													

PAVEMENT MARKING LINE TYPES

See PM-110

***MNY4 - Factor of 1.00 as value includes number of 4-inch passes to cover median nose area.

*BCY4 - Place on the same side of the roadway to match existing markings near the project.

**NPY4 - For estimating purposes only. No Passing Zone Lines will be located in the field.

BCY4: Broken Centerline (Yellow) @ 0.25

DCY4: Double Centerline (Yellow) @ 2.00

NPY4: No Passing Zone Line (Yellow) @ 1.25

BLW4: Broken Lane Line (White) @ 0.25

ELW4: Edge Line Right (White) @ 1.00

ELY4: Edge Line Left (Yellow) @ 1.00

SLW4: Solid Lane Line (White) @ 1.00

DLW4: Dotted Line (White) @ 0.33

CHY8: Channelizing Line (Yellow) @ 2.00

SLW2: Stop Line (White) @ 6.00

CHW8: Channelizing Line (White) @ 2.00

Road ID	Station to Station	Dir. of Travel	Location	Marking Type	Side			Length by Line Type (Unfactored)																Remarks
					L	C	R	BCY4*	DCY4	NPY4**	BLW4	ELW4	ELY4	SLW4	DLW4	CHY8	SLW2	CHW8	STA	STA	STA	STA		
					STA	STA	STA	STA	STA	STA	STA	STA	STA	STA	STA	STA	STA	STA	STA	STA	STA	STA		
STAGE 1A																								
US 151	843+05.21	848+61.10	NB	Removal of Paint			X							5.56										
	844+44.63	849+06.02	SB	Removal of Paint			X							4.61										
	843+15.27	843+63.64	BOTH	Removal of Paint			X		0.48															
	843+63.64	848+89.13	BOTH	Removal of Paint			X								5.25									
	863+43.03	863+86.67	NB	Removal of Paint			X							0.44										
	863+43.03	883+61.30	BOTH	Removal of Paint			X		20.18															
	863+43.03	866+23.80	SB	Removal of Paint			X													2.81				
	864+73.88	883+85.71	NB	Removal of Paint			X							19.12										
	866+23.80	872+81.22	SB	Removal of Paint			X							6.57										
	872+81.22	875+06.67	SB	Removal of Paint			X													2.25				
	875+06.67	883+15.10	SB	Removal of Paint			X							8.08										
	882+57.57	884+07.82	NB	Removal of Paint			X													1.50				
	883+15.10	884+35.77	SB	Removal of Paint			X													1.21				
	884+07.82	885+34.50	NB	Removal of Paint			X													1.27				
	884+35.77	886+69.70	SB	Removal of Paint			X													2.34				
	884+35.77	902+58.42	SB	Removal of Paint			X							18.23										
	884+95.42	897+41.17	BOTH	Removal of Paint			X		12.46															
	885+34.50	903+67.56	NB	Removal of Paint			X							18.33										
	897+41.17	903+67.54	BOTH	Removal of Paint			X													6.26				
	902+97.41	903+67.55	NB	Removal of Paint		X									0.70									
	972+69.70	987+40.69	SB	Removal of Paint			X							14.71										
	973+03.60	978+73.23	BOTH	Removal of Paint			X													5.70				
	974+66.78	978+83.75	NB	Removal of Paint			X							4.17										
	978+73.23	979+88.23	BOTH	Removal of Paint			X		1.15															
	979+88.23	987+40.50	BOTH	Removal of Paint			X													7.52				
	843+15.27	846+73.01	BOTH	Wet Retroreflective Removable Tape			X		3.58															
	864+26.66	900+33.77	BOTH	Wet Retroreflective Removable Tape			X		36.07															
	900+33.77	903+67.54	BOTH	Wet Retroreflective Removable Tape			X													3.34				
	900+33.77	903+67.56	NB	Wet Retroreflective Removable Tape			X							3.34										
	902+97.41	903+67.55	NB	Wet Retroreflective Removable Tape		X														0.70				
	967+48.23	974+69.74	BOTH	Wet Retroreflective Removable Tape			X													7.22				
	972+69.66	987+40.69	SB	Wet Retroreflective Removable Tape			X							14.71										
	974+66.78	987+83.75	NB	Wet Retroreflective Removable Tape			X							13.17										
	974+69.74	976+10.00	BOTH	Wet Retroreflective Removable Tape			X		1.40															
	976+10.00		NB	Wet Retroreflective Removable Tape			X													0.11				
	984+92.67		SB	Wet Retroreflective Removable Tape			X													0.11				
	984+93.06	987+83.75	BOTH	Wet Retroreflective Removable Tape			X													2.91				
STAGE 1B																								
US 151	843+15.27	846+73.01	BOTH	Removal of Removable Tape			X		3.58															
	843+15.27	848+85.83	BOTH	Wet Retroreflective Removable Tape			X		5.71															
STAGE 2A																								
US 151	843+15.27	848+85.83	BOTH	Removal of Removable Tape			X		5.71															
	864+26.66	900+33.77	BOTH	Removal of Removable Tape			X		36.07															
	900+33.77	903+67.54	BOTH	Removal of Removable Tape			X													3.34				
	900+33.77	903+67.56	NB	Removal of Removable Tape			X							3.34										
	902+58.42	907+90.11	SB	Removal of Paint			X							5.32										
	902+97.41	903+67.55	BOTH	Removal of Removable Tape		X														0.70				
	903+67.55	907+88.37	BOTH	Removal of Paint			X													4.21				
	903+67.55	908+46.42	NB	Removal of Paint			X													4.79				
	903+67.56	908+46.42	NB	Removal of Paint			X							4.79										
	972+85.46	974+69.74	BOTH	Removal of Removable Tape			X													1.84				
	974+69.74	976+10.00	BOTH	Removal of Removable Tape			X		1.40															
	976+10.00		NB	Removal of Removable Tape			X													0.11				
	976+10.19	987+40.69	SB	Removal of Removable Tape			X							11.31										
	976+78.36	984+07.88	NB	Removal of Removable Tape			X							7.30										
	984+92.67		SB	Removal of Removable Tape			X													0.11				
	984+92.67	987+83.75	BOTH	Removal of Removable Tape			X													2.91				
	987+40.66	988+78.46	SB	Removal of Paint			X							1.38										
	987+83.75	922+16.81	BOTH	Removal of Paint			X													65.67				
	870+96.50		SB	Wet Retroreflective Removable Tape			X													0.11				
	870+96.50	904+14.47	BOTH	Wet Retroreflective Removable Tape			X																	
	902+58.05	907+90.11	SB	Wet Retroreflective Removable Tape			X		33.18					5.32										
	902+58.71	905+63.73	NB	Wet Retroreflective Removable Tape			X							3.05										
	904+14.47	905+34.13	BOTH	Wet Retroreflective Removable Tape			X													1.20				
	905+34.13	907+88.75	BOTH	Wet Retroreflective Removable Tape			X													2.55				
	905+88.42	908+46.42	NB	Wet Retroreflective Removable Tape			X																	
	905+89.66	908+46.42	NB	Wet Retroreflective Removable Tape			X													2.58				
	972+85.46	986+49.80	BOTH	Wet Retroreflective Removable Tape			X		13.82					2.57										
	976+78.38	984+07.88	NB	Wet Retroreflective Removable Tape			X							7.41										
	976+78.38	988+78.48	SB	Wet Retroreflective Removable Tape			X							12.72										
	986+49.80	992+10.80	BOTH	Wet Retroreflective Removable Tape			X													5.61				
Praire Ave	286+63.88		WB	Wet Retroreflective Removable Tape			X													0.11				


PAVEMENT MARKING SYMBOLS AND LEGENDS

Refer to PM-111

Road Identification	Location		↑ STAW	↶ RTAW	↷ LTAW	↶↷ CSRW	↷↶ CSLW	↶↷↶ CSTW	↷↶↷ CRLW	↑ FERW	↗ LLRW	↖ RLRW	ⓧ RRCW	🚲 BLSW	♿ WCSW	♿ WPSB	SCHOOL	XING	STOP	AHEAD	ONLY	BIKE	LANE	EXIT	Groove Cuts EACH	Remarks
	Station	Side																								
US 151	847+87.00	RT			1																					
US 151	848+25.00	RT																				1				
US 151	848+62.00	RT			1																					
US 151	850+08.00	LT		1	1																					
US 151	850+45.00	LT																				1				
US 151	851+58.00	LT		1	1																					
US 151	853+08.00	LT		1	1																					
US 151	862+60.00	RT		1	1																					
US 151	862+97.00	RT																				1				
US 151	863+35.00	RT		1	1																					
US 151	864+83.00	LT			1																					
US 151	865+20.00	LT																				1				
US 151	865+58.00	LT				1																				
US 151	870+10.00					1																				TWLT
US 151	870+25.00					1																				TWLT
US 151	874+52.00	RT				1																				
US 151	874+89.00	RT																				1				
US 151	875+27.00	RT				1																				
US 151	878+61.00					1																				TWLT
US 151	878+77.00					1																				TWLT
US 151	882+41.00	RT				1																				
US 151	882+78.00	RT																				1				
US 151	882+97.00	RT		1																						
US 151	883+16.00	RT				1																				
US 151	883+55.00	RT		1																						
US 151	884+81.00	LT		1	1																					
US 151	885+19.00	LT																				1				
US 151	885+56.00	LT		1	1																					
US 151	888+34.00					1																				TWLT
US 151	888+50.00					1																				TWLT
US 151	894+28.00					1																				TWLT
US 151	894+44.00					1																				TWLT
US 151	897+73.00					1																				TWLT
US 151	897+89.00					1																				TWLT
Church St	1848+95.00					1																				
Church St	1849+68.00					1																				
	Total:			9	27																	7				

SILT FENCES FOR DITCH CHECKS

Possible Standard: EC-201

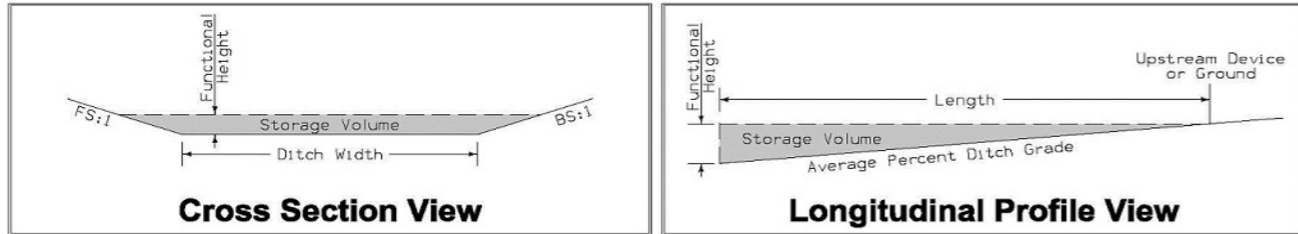


* The functional height used in the volume equation is 85% of effective height. Effective height is 1.58 feet as shown on EC-201.
* Volume equation: $[0.5 * Spacing * (0.5 * H^2 * FS + DW * H + 0.5 * H^2 * BS)]$

Basin No.	Type	Location		Bid Items			Stormwater Storage Volume Summary					Remarks
		Station	Side	Installation LF	Maintenance LF	Removal LF	Foreslope FS:1	Backslope BS:1	Ditch Width FT	Avg. % Slope Ditch Grade	Volume* CF	
1	1	851+00.88	L	23.0	2.3	11.5	3.5	3.0	10.0	0.3%	3038.5	
1	1	854+10.82	L	23.0	2.3	11.5	3.5	3.0	10.0	0.3%	3038.5	
1	1	856+47.43	L	44.0	4.4	22.0	3.5	3.0	28.0	0.3%	6845.9	
1	1	852+00.00	R	24.0	2.4	12.0	4.0	3.0	10.0	1.2%	987.1	
1	1	852+50.00	R	24.0	2.4	12.0	4.0	3.0	10.0	1.1%	1530.1	
1	1	854+00.00	R	24.0	2.4	12.0	4.0	3.0	10.0	1.1%	1530.1	
1	1	855+50.00	R	24.0	2.4	12.0	4.0	3.0	10.0	1.1%	1530.1	
2	1	857+60.88	L	23.0	2.3	11.5	4.0	3.0	10.0	0.3%	3109.5	
2	1	858+31.97	L	26.0	2.6	13.0	4.0	3.0	10.0	0.3%	3109.5	
2	1	860+01.80	L	21.0	2.1	10.5	4.0	3.0	7.0	3.0%	392.8	
2	1	860+35.00	L	21.0	2.1	10.5	4.0	3.0	5.0	3.0%	325.7	
2	1	860+73.46	L	19.0	1.9	9.5	4.0	3.0	5.0	3.0%	325.7	
2	1	861+73.46	L	19.0	1.9	9.5	4.0	3.0	5.0	1.2%	651.4	
2	1	862+73.46	L	19.0	1.9	9.5	4.0	3.0	5.0	1.2%	651.4	
3	1	865+55.00	R	23.0	2.3	11.5	4.0	3.0	10.0	3.3%	444.2	
3	1	866+00.00	R	23.0	2.3	11.5	4.0	3.0	10.0	3.3%	444.2	
3	1	866+75.00	R	23.0	2.3	11.5	4.0	3.0	10.0	1.9%	740.4	
5	1	871+00.00	R	24.0	2.4	12.0	4.0	3.0	10.0	0.8%	1530.1	
5	1	872+50.00	R	30.0	3.0	15.0	4.0	3.0	10.0	0.8%	1530.1	
5	1	874+00.00	R	30.0	3.0	15.0	4.0	3.0	10.0	0.8%	1530.1	
5	1	875+50.00	R	30.0	3.0	15.0	4.0	3.0	10.0	0.8%	1530.1	
6	1	864+95.00	L	24.0	2.4	12.0	3.5	3.0	10.0	3.5%	434.1	
6	1	865+40.00	L	24.0	2.4	12.0	3.5	3.0	10.0	3.5%	434.1	
6	1	865+85.00	L	24.0	2.4	12.0	3.5	3.0	10.0	3.5%	434.1	
6	1	866+30.00	L	24.0	2.4	12.0	3.5	3.0	10.0	3.5%	434.1	
7	1	868+50.00	L	24.0	2.4	12.0	3.5	3.0	10.0	0.3%	3038.5	
7	1	871+50.00	L	24.0	2.4	12.0	3.5	3.0	10.0	0.3%	3038.5	
7	1	874+50.00	L	24.0	2.4	12.0	3.5	3.0	10.0	0.3%	3038.5	
8	1	877+90.00	L	19.0	1.9	9.5	3.5	3.0	6.0	0.2%	2192.4	
8	1	879+50.00	L	24.0	2.4	12.0	3.5	3.0	10.0	0.2%	3038.5	
9	1	878+00.00	R	24.0	2.4	12.0	3.5	3.0	10.0	0.2%	3038.5	
9	1	879+50.00	R	24.0	2.4	12.0	3.5	3.0	10.0	0.2%	3038.5	
10	1	881+64.00	R	24.0	2.4	12.0	3.5	3.0	10.0	1.0%	1495.1	
10	1	882+50.00	R	24.0	2.4	12.0	3.5	3.0	10.0	1.0%	1495.1	
10	1	883+50.00	R	24.0	2.4	12.0	3.5	3.0	10.0	1.0%	1495.1	
10	1	885+35.00	R	24.0	2.4	12.0	3.5	3.0	10.0	1.6%	723.4	
10	1	886+10.00	R	24.0	2.4	12.0	3.5	3.0	10.0	1.6%	723.4	
10	1	886+85.00	R	24.0	2.4	12.0	3.5	3.0	10.0	1.6%	723.4	
10	1	890+00.00	R	24.0	2.4	12.0	3.5	3.0	10.0	0.4%	3038.5	
10	1	891+50.00	R	24.0	2.4	12.0	3.5	3.0	10.0	0.3%	3038.5	
12	1	883+68.00	L	18.0	1.8	9.0	3.5	3.0	10.0	0.6%	1495.1	
12	1	884+22.00	L	28.0	2.8	14.0	3.5	3.0	10.0	0.6%	1495.1	
12	1	885+00.00	L	24.0	2.4	12.0	3.5	3.0	10.0	0.6%	3038.5	
12	1	886+50.00	L	19.0	1.9	9.5	3.5	3.0	10.0	0.3%	3038.5	
12	1	889+50.00	L	18.0	1.8	9.0	3.5	3.0	10.0	0.3%	3038.5	
12	1	891+50.00	L	18.0	1.8	9.0	3.5	3.0	10.0	0.3%	3038.5	
13	1	895+40.00	R	18.0	1.8	9.0	3.5	3.0	5.0	1.5%	628.8	
13	1	895+50.00	L	24.0	2.4	12.0	3.5	3.0	10.0	0.3%	3038.5	
13	1	897+30.00	R	19.0	1.9	9.5	3.5	3.0	5.0	1.9%	471.6	
13	1	898+00.00	L	24.0	2.4	12.0	3.5	3.0	10.0	0.3%	3038.5	
15	1	975+50.00	L	22.0	2.2	11.0	6.0	3.0	4.0	1.1%	674.4	
15	1	976+00.00	L	24.0	2.4	12.0	6.0	3.0	6.0	2.0%	606.5	
15	1	976+50.00	L	24.0	2.4	12.0	6.0	3.0	6.0	2.0%	606.5	
15	1	977+00.00	L	6.0	0.6	3.0	6.0	3.0	6.0	3.0%	404.4	
15	1	977+50.00	L	24.0	2.4	12.0	6.0	3.0	6.0	3.0%	404.4	
15	1	978+00.00	L	24.0	2.4	12.0	6.0	3.0	6.0	2.0%	606.5	

SILT FENCES FOR DITCH CHECKS

Possible Standard: EC-201

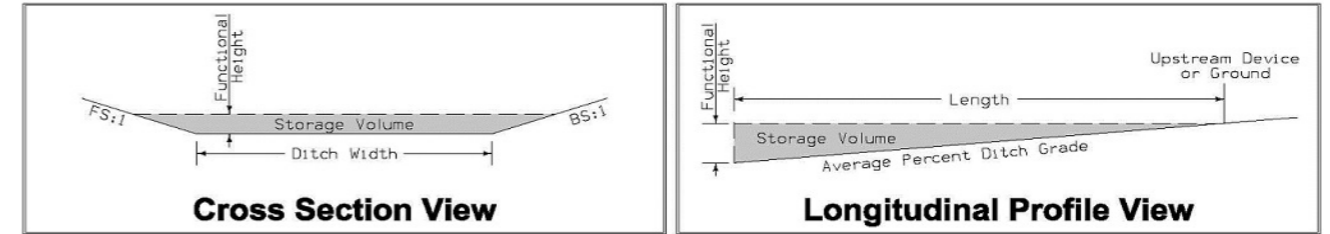

* The functional height used in the volume equation is 85% of effective height. Effective height is 1.58 feet as shown on EC-201.
* Volume equation: $[0.5 * Spacing * (0.5 * H^2 * FS + DW * H + 0.5 * H^2 * BS)]$

Basin No.	Type	Location		Bid Items			Stormwater Storage Volume Summary					Remarks
		Station	Side	Installation LF	Maintenance LF	Removal LF	Foreslope FS:1	Backslope BS:1	Ditch Width FT	Avg. % Slope Ditch Grade	Volume* CF	
15	1	978+50.00	L	19.0	1.9	9.5	3.5	3.0	6.0	2.0%	522.0	
15	1	979+58.00	L	19.0	1.9	9.5	3.5	3.0	6.0	1.0%	1078.8	
15	1	980+35.62	L	19.0	1.9	9.5	3.5	3.0	6.0	1.6%	522.0	
17	1	980+05.18	R	16.0	1.6	8.0	3.5	3.0	3.0	5.9%	123.6	
17	1	980+23.67	R	16.0	1.6	8.0	3.5	3.0	3.0	5.9%	123.6	
17	1	980+44.66	R	16.0	1.6	8.0	3.5	3.0	3.0	2.8%	247.3	
17	1	980+81.26	R	19.0	1.9	9.5	3.5	3.0	6.0	2.8%	348.0	
18	1	981+75.00	L	24.0	2.4	12.0	6.0	3.0	6.0	0.7%	1253.5	
18	1	983+25.00	L	24.0	2.4	12.0	6.0	3.0	6.0	0.7%	1253.5	
18	1	984+55.00	L	24.0	2.4	12.0	6.0	3.0	6.0	0.7%	1253.5	
Totals:				1880.0	150.0	749.0						

232-3A
10-20-15

EROSION CONTROL (RURAL SEEDING)

Following the completion of work in a disturbed area, place seed, fertilizer, and mulch on the disturbed area lying 8 feet adjacent to shoulder and median as follows:

Use seed mix and fertilizer meeting the requirements of Article 2601.03,C,3 and Section 4169 of the Standard Specifications.

Use mulch meeting the requirements of Articles 2601.03,E,2,a and 4169.07,A of the Standard Specifications.

Preparing the seedbed and furnishing and applying seed, fertilizer, and mulch is incidental to mobilization and will not be paid for separately.

232-3B
10-20-15

EROSION CONTROL (URBAN SEEDING)

Following the completion of work in a disturbed area, place seed, fertilizer, and mulch on the disturbed area as follows:

Use seed mix and fertilizer meeting the requirements of Article 2601.03,C,4 and Section 4169 of the Standard Specifications.

Use mulch meeting the requirements of Articles 2601.03,E,2,a and 4169.07,A of the Standard Specifications.

Preparing the seedbed and furnishing and applying seed, fertilizer, and mulch is incidental to mobilization and will not be paid for separately.

232-11
10-20-15

EROSION CONTROL (STABILIZING CROP SEEDING)

Following the completion of work in a disturbed area, place stabilizing crop, fertilizer, and mulch on the disturbed area as follows:

Use seed mix and fertilizer meeting the requirements of Article 2601.03,C,1 and Section 4169 of the Standard Specifications.

Use mulch meeting the requirements of Articles 2601.03,E,2,a and 4169.07,A of the Standard Specifications.

Preparing the seedbed and furnishing and applying seed, fertilizer, and mulch is incidental to mobilization and will not be paid for separately.

100-11
04-18-17

EROSION CONTROL FOR INTAKE OR MANHOLE WELL

Possible Detail: 570-5

Location Station	Side	Cover Assembly			Remarks
		Installation EACH	Maintenance EACH	Removal EACH	
845+64.97	R	1	1	1	
846+64.33	L	1	1	1	
847+21.58	R	1	1	1	
848+39.00	R	1	1	1	
848+39.00	L	1	1	1	
849+89.12	R	1	1	1	
849+89.35	L	1	1	1	
851+48.00	R	1	1	1	
851+50.00	R	1	1	1	
851+50.00	L	1	1	1	
853+25.60	R	1	1	1	
853+25.60	L	1	1	1	
861+82.03	R	1	1	1	
861+82.03	L	1	1	1	
861+84.00	L	1	1	1	
861+84.00	R	1	1	1	
863+51.69	L	1	1	1	
863+51.70	R	1	1	1	
1848+52.82	R	1	1	1	
1848+59.16	L	1	1	1	
1849+85.00	L	1	1	1	
1850+50.00	L	1	1	1	
2864+80.06	L	1	1	1	
3864+00.00	R	1	1	1	
3864+00.00	L	1	1	1	
Totals:		25	25	25	

100-36
10-16-18

OPEN-THROAT CURB INTAKE SEDIMENT FILTER

Possible Standard: EC-602

Location Station	Side	Installation	Maintenance	Removal	Remarks
		LF	EACH	EACH	
845+65.00	R	8.0	1	1	
846+64.33	L	8.0	1	1	
847+21.58	R	8.0	1	1	
848+39.00	R	8.0	1	1	
848+39.00	L	8.0	1	1	
849+89.12	R	8.0	1	1	
849+89.35	L	8.0	1	1	
851+50.00	R	8.0	1	1	
851+50.00	L	8.0	1	1	
853+25.60	R	8.0	1	1	
853+25.60	L	8.0	1	1	
861+82.03	R	8.0	1	1	
861+82.03	L	8.0	1	1	
863+51.70	R	8.0	1	1	
863+51.70	L	8.0	1	1	
2864+80.06	L	8.0	1	1	
3864+00.00	R	4.0	1	1	
3864+00.00	L	4.0	1	1	
Totals:		136.0	18	18	

100-19
04-19-16

PERIMETER AND SLOPE SEDIMENT CONTROL DEVICE

Possible Standards: EC-204

Location			Length of Installation			Remarks
Begin Station	End Station	Side	9 inch Dia	12 inch Dia	20 inch Dia	
			LF	LF	LF	
843+82.80	844+80.61	R			105.0	
845+02.39	845+60.29	R			62.0	
845+53.50	845+74.49	R			23.0	PLACE DEVICE AROUND ST-03
845+70.14	845+78.87	R			12.0	
846+16.12	847+16.92	R			103.0	
847+08.92	847+32.25	R			27.0	PLACE DEVICE AROUND ST-05
847+26.64	847+29.38	R			5.0	
847+91.50	848+34.33	R			49.0	
848+26.33	848+51.67	R			29.0	PLACE DEVICE AROUND ST-06
848+43.67	849+14.43	R			115.0	
849+52.80	849+85.25	R			89.0	
849+78.87	850+01.85	R			27.0	PLACE DEVICE AROUND ST-11
849+93.65	851+45.33	R			154.0	
851+39.33	851+62.67	R			27.0	PLACE DEVICE AROUND ST-12
851+54.67	853+20.93	R			168.0	
853+14.93	853+38.27	R			27.0	PLACE DEVICE AROUND ST-18
853+30.27	856+27.50	R			299.0	
858+40.50	861+77.30	R			338.0	
861+69.36	861+92.70	R			27.0	PLACE DEVICE AROUND ST-22
861+86.70	863+47.03	R			162.0	
863+39.03	863+62.37	R			27.0	PLACE DEVICE AROUND ST-24
863+56.36	863+94.37	R			235.0	
864+38.58	866+45.74	R			227.0	
868+68.20	870+69.91	R			202.0	
891+34.27		R			20.0	PLACE DEVICE AROUND FLARED END SECTION INLET
845+01.31	845+23.11	L			29.0	
845+44.89	846+59.66	L			121.0	
846+51.66	846+75.00	L			27.0	PLACE DEVICE AROUND ST-04
846+70.10	846+75.00	L			21.0	
847+11.00	848+34.33	L			140.0	
848+26.33	848+51.67	L			29.0	PLACE DEVICE AROUND ST-07
848+43.67	849+13.96	L			110.0	
849+57.96	849+86.40	L			54.0	
849+79.55	850+01.91	L			27.0	PLACE DEVICE AROUND ST-14
849+95.31	851+45.33	L			152.0	
851+39.33	851+62.67	L			27.0	PLACE DEVICE AROUND ST-13
851+54.67	853+20.93	L			168.0	
852+26.00		R			50.0	PLACE DEVICE AROUND FLARED END SECTION INLET
853+14.93	853+38.27	L			27.0	PLACE DEVICE AROUND ST-19
853+30.30	856+09.10	L			280.0	
858+56.11	861+77.36	L			322.0	
861+69.36	861+92.70	L			27.0	PLACE DEVICE AROUND ST-21
861+86.70	863+47.02	L			162.0	
863+39.03	863+62.37	L			27.0	PLACE DEVICE AROUND ST-23
863+56.36	864+01.57	L			187.0	
864+64.13	866+19.58	L			156.0	
868+34.07	870+70.00	L			237.0	
878+00.00		L			20.0	PLACE DEVICE AROUND FLARED END SECTION INLET
891+26.45		L			20.0	PLACE DEVICE AROUND FLARED END SECTION INLET
1847+58.76	1847+69.25	R			12.0	
1847+99.25	1848+04.15	R			45.0	
1848+03.25	1848+56.14	R			53.0	
1848+52.82		R			20.0	PLACE DEVICE AROUND ST-16
1850+50.00		R			20.0	PLACE DEVICE AROUND ST-08
1850+75.00	1850+79.96	R			24.0	
1850+83.37		R			20.0	PLACE DEVICE AROUND FLARED END SECTION INLET
1851+20.06	1851+25.17	R			16.0	
1850+38.75	1851+20.00	L			90.0	
2865+30.81	2865+91.27	R			67.0	
2866+07.73	2866+50.00	R			48.0	
2863+13.40	2863+35.85	L			102.0	
2863+47.68	2863+97.37	L			78.0	
2864+69.49	2864+90.74	L			26.0	PLACE DEVICE AROUND ST-24
2864+84.75	2865+30.81	L			47.0	
2865+30.81	2865+46.05	L			18.0	
2865+57.76	2866+49.96	L			94.0	
3863+35.85		R			20.0	PLACE DEVICE AROUND FLARED END SECTION INLET
3864+20.00		R			20.0	PLACE DEVICE AROUND FLARED END SECTION INLET
Total:					5799.0	

LIST OF SUBDRAIN WORK

Possible Standards: DR-121, DR-201, DR-203, DR-301, DR-302, DR-303, DR-305 and DR-306. Possible Detail: 500-10.

* Not a bid item

No.	Location		Pipe			Aprons			Outlets			Connected Pipe Joints*		Trench Drain	Granular Material	Porous Backfill*	Class "A" Crushed Stone*	Remarks
	Station to Station	Type of Installation	Concrete, C.M.P., or Plastic	Dia.	Length	DR-201	DR-203	500-10	DR-305	DR-306	DR-121							
											Type	No.	Type					
US 151		DR-301, DR-302, DR-303		IN	LF	No.	No.	No.	Type	No.	No.	Type	No.	LF	Blanket CY	CY	CY	
1	850+00.00	856+06.00													708.0			Working blanket in the left existing ditch
2	864+35.00	866+76.00													320.0			Working blanket in the left existing ditch
3	868+93.00	873+00.00													975.0			Working blanket in the left existing ditch
4	868+80.00	873+30.00													358.0			Working blanket in the right existing ditch
														Total	2361.0			

Note:
1. The Working Blankets shown on the Q sheets and Tab 104-5C may be deleted if determined not to be necessary at the time of construction.
2. The Working Blanket design thickness is 1 foot.

103-6
10-17-17

EMBANKMENT WITH MOISTURE CONTROL

Moisture Control is required for all Class 10 fill placed in all locations and depths. Stability berms placed outside the normal foreslope template and topsoil will not require Moisture Control.

103-10
04-18-17

TOPSOIL STRIPPING AND PLACEMENT

Location				Topsoil Stripping Thickness	Topsoil Placement Thickness	Remarks
Road Identification	Dir. of Traffic	Begin Station	End Station			
US 151	NB/SB	850+00.00	856+00.00	4.0		
US 151	NB/SB	858+50.00	866+50.00	4.0		
US 151	NB/SB	869+00.00	879+50.00	4.0		
US 151	NB/SB	882+00.00	903+00.00	4.0		

107-31
04-19-11

PLOWING AND SHAPING
Refer to Standard Road Plan EW-101


Station to Station		D	Remarks
		FT	
US 151			
861+00.00	863+50.00	5.0	Refer to W Sheets
980+00.00	981+00.00	5.0	Refer to W Sheets

103-7
08-01-08

SHRINKAGE DATA

Material	%	Remarks
Barrow & Template Cut	30%	
Topsoil	40%	
Estimated Boulder Quantity		50 CY

GEOTECHNICAL DESIGN



MATTHEW D. CUSHMAN
20478

I hereby certify that this engineering document was prepared under my supervision and that engineering decisions with regard to the design were made by me or by other duly licensed Professional Engineers under the laws of the State of Iowa.

Matthew D. Cushman 08/21/18
Signature Date

MATTHEW D. CUSHMAN
Printed or Typed Name

My license renewal date is December 31, 2018

Pages or sheets covered by this seal: CS.1 & Q.1-Q.24

Survey Information

General Information

Measurement units for this survey are US survey feet. This survey was performed for multiple projects as listed above for improvements along the Iowa 151 corridor near Fairfax in Linn County. Project datum and control information matches the coordinate system and vertical datum used for BRFN-151-3(134)--39-57 (SAP 0623). This project is a complete field survey for the digital terrain model.

Vertical Control

Vertical datum for this survey is relative to NAVD88.

A Digital level loop was run from BM #589 (established from SAP 0623) through the project benchmarks and returned to BM # 589. The loop error was allowable and the error was distributed proportionately among the project marks.

Vertical equations are as follows:

Datum Benchmark	Elevation = 791.713
BM #589 (SAP 0623)	Elevation = 791.713
= BM #589 (This Survey)	

Horizontal Control

The horizontal control matches the coordinate system used for SAP 0623.

Even though Linn County is in Iowa North Zone the major portion of this project control network is in the Iowa South Zone. As a result this bridge project is also in the Iowa South Zone modified to Ground using the parameters below.

STATE PLANE COORDINATE ZONE 1402 (IOWA SOUTH LAMBERT)

STATE PLANE COORDINATES HELD AT POINT g030

G030 N= 686745.854 E= 2084369.752 (U.S. Ft.)

AVERAGE PROJECT LATITUDE = 41 51 40.20597

RESULTING RADIUS = 6363875.949

MEAN PROJECT ELEVATION = 235.000 meters

SEA LEVEL FACTOR = 0.999963074

AVERAGE PROJECT SCALE FACTOR = 1.000015404

COMBINED FACTOR (GRID) = 0.999978478

1 / GRID = 1.000021523

HORIZONTAL DATUM = NAD 83(HARN)

Alignment Information

The horizontal alignment for this survey was created for SAP 0623 (originally from SAP 159), Project BRFN-151-3(134)--39-57.

ML1
(from SAP 159)

THE ALIGNMENT FOR THIS SURVEY IS A RETRACE OF THE EXISTING ALIGNMENT ON US # 151 FROM HOMESTEAD NORTH EAST TO NEW US # 30/218.

PI STA 101+08.45 THIS SURVEY=
PI STA 1267+96.48 PLANS PROJECT # FR-6-6(23)

PI STA 165+48.10 THIS SURVEY (DATUM STATIONING) =
PI STA 65+48.10 PLANS PROJECT # FN-149-2(13)

PI STA 242+02.93 THIS SURVEY=
PI STA 138+19.1 PLANS PROJECT # FN-194

POT STA 276+83.37 THIS SURVEY=
POT STA 120+78.52 PLANS PROJECT # FN-151-1(5)

PI STA 580+67.72 THIS SURVEY=
PI STA 426+85.76 PLANS PROJECT # NHS-151-2(3)


VERTICAL CONTROL

Point	North	East	Elevation	Station	Offset	Feature	Description
BM100	702680.804	2107578.854	780.530	841+08.15	23.119	BM	ARROW ON HYDRANT, EAST SIDE OF HWY 151, SOUTH END
BM1	703233.002	2107556.082	763.600	846+60.81	23.069	BM	GIN SPIKE IN POWER POLE, EAST SIDE HWY 151, ACROSS FROM "PIT STOP"
BM2	705704.166	2107504.303	750.420	871+35.96	70.098	BM	RR SPIKE IN POWER POLE, EAST SIDE HWY 151, 200' +/- NORTH OF NORTH END OF RIVER BRIDGE AT BEGINNING OF CLEARING
BM3	706904.792	2107804.979	760.370	883+94.08	-58.416	BM	RR SPIKE IN POWER POLE, NW QUADRANT OF CEMETARY ROAD AND HWY 151
BM4	708415.446	2109892.014	767.940	909+53.51	-171.787	BM	RR SPIKE IN POWER POLE, SOUTH SIDE OF 80TH ST SW, 70' +/- WEST OF STOP SIGN ON HWY 151
BM5	710868.765	2114183.819	781.810	958+96.64	-109.701	BM	GIN SPIKE IN LIGHT POLE, NW QUADRANT OF BEVERLY DRIVE WEST AND HWY 151
BM587	711354.287	2115052.646	791.920	968+91.68	-87.544	BM	RR SPIKE IN POWER POLE, NW QUADRANT HWY 151 AND STUNEY POINT, 80' +/- NW OF TRAFFIC LIGHT
BM588	711811.381	2116047.826	781.700	979+81.20	23.191	BM	CUT TRIANGLE ON BASE WALL OF REINFORCED CONCRETE BOX CULVERT
BM589	712237.496	2116803.443	791.710	988+48.54	39.136	BM	IDOT DISK IN HIGHWAY, EAST SIDE HWY 151, 50' +/- SOUTH OF TURNOOUT FOR DEAN ROAD


CP STA 837+45.84, 38.77 FT RT
 CP 118, SET REBAR W/ RED PLASTIC SNYDER CONTROL CAP
 N=702310.552, E=2107568.859, ELEV. 790.030

MONUMENT MAY BE LOCATED BY
 STAKING OUT COORDINATE


CP STA 846+36.12, 28.47 FT LT
 CP 100, SET REBAR W/ RED PLASTIC SNYDER CONTROL CAP
 N=703206.207, E=2107505.596, ELEV. 763.43

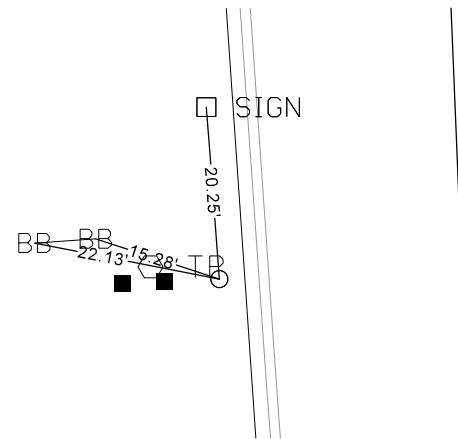


CP STA 854+30.14, 27.69 FT LT
 CP 101, SET REBAR W/ RED PLASTIC SNYDER CONTROL CAP
 N=703999.594, E=2107473.736, ELEV. 786.630

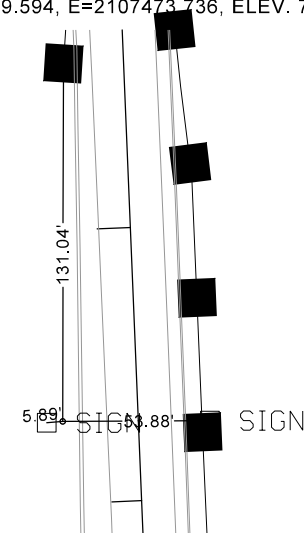


CP STA 856+78.46, 127.36 FT LT
 CP 201, SET REBAR W/ RED PLASTIC SNYDER CONTROL CAP
 N=704243.606, E=2107363.943, ELEV. 758.070

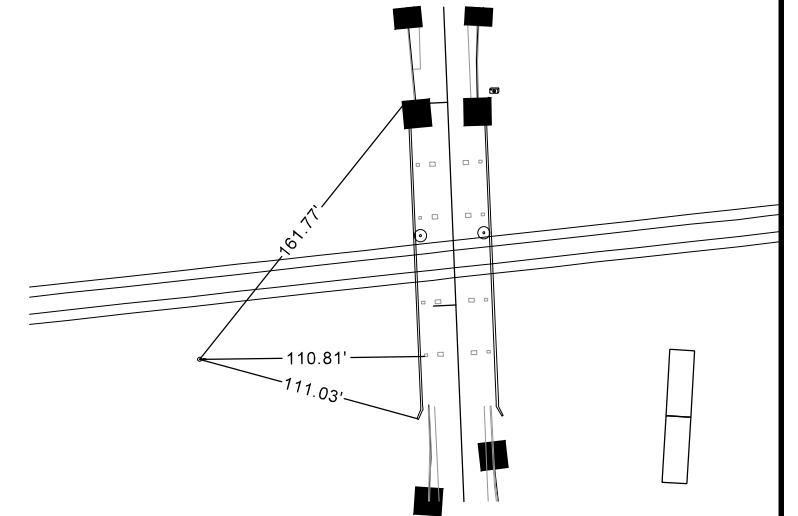


CP STA 857+71.20, 166.58 FT RT
 CP 200, SET REBAR W/ RED PLASTIC SNYDER CONTROL CAP
 N=704348.351, E=2107653.822, ELEV. 763.240

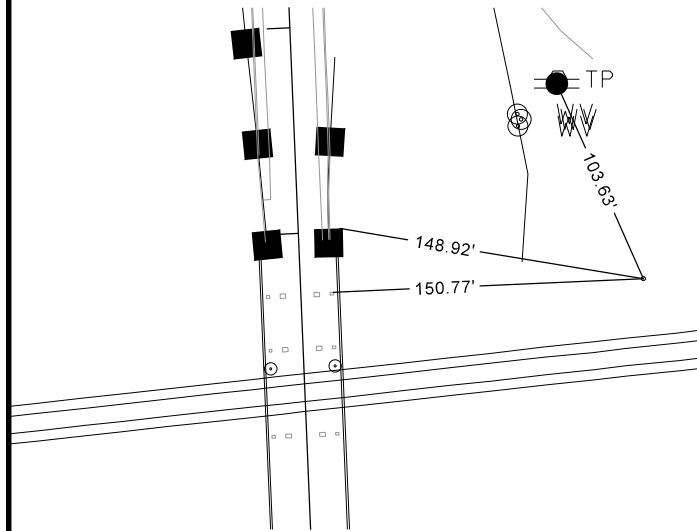


CP STA 872+09.67, 31.26 FT LT
 CP 102, SET REBAR W/ RED PLASTIC SNYDER CONTROL CAP
 N=705780.492, E=2107405.482, ELEV. 757.250

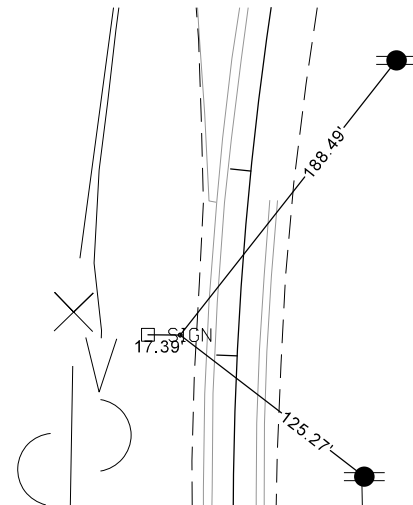

CP STA 884+01.50, 54.56 FT LT
 CP 104, SET REBAR W/ RED PLASTIC SNYDER CONTROL CAP
 N=706908.345, E=2107812.761, ELEV. 759.410

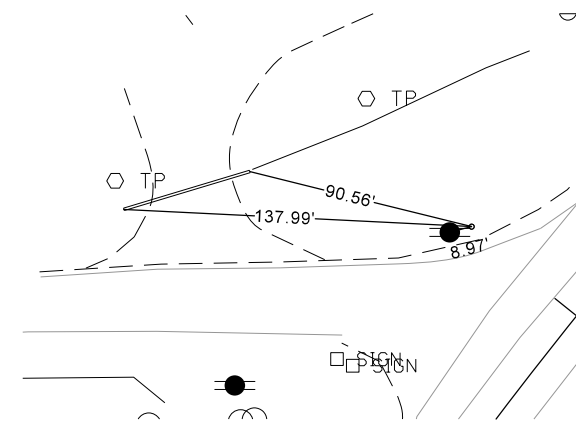

CP STA 894+61.29, 36.19 FT RT
 CP 105, SET REBAR W/ RED PLASTIC SNYDER CONTROL CAP
 N=707479.442, E=2108711.388, ELEV. 757.700

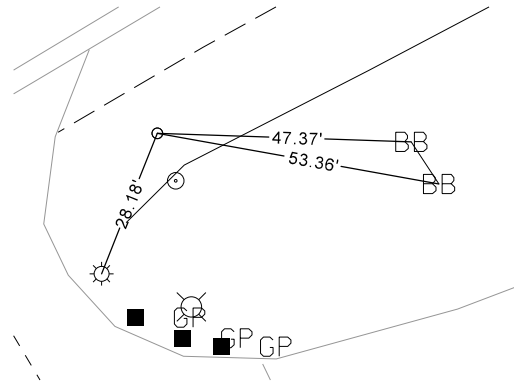

CP STA 901+36.51, 40.43 FT RT
 CP 106, SET REBAR W/ RED PLASTIC SNYDER CONTROL CAP
 N=707817.955, E=2109295.639, ELEV. 757.510

MONUMENT MAY BE LOCATED BY
 STAKING OUT COORDINATE

CP STA 908+95.75, 56.20 FT LT
 CP 107, SET REBAR W/ RED PLASTIC SNYDER CONTROL CAP
 N=708286.528, E=2109900.851, ELEV. 767.350

MONUMENT MAY BE LOCATED BY
 STAKING OUT COORDINATE

CP STA 917+25.17, 29.59 FT RT
 CP 108, SET REBAR W/ RED PLASTIC SNYDER CONTROL CAP
 N=708633.222, E=2110659.204, ELEV. 789.030

MONUMENT MAY BE LOCATED BY
 STAKING OUT COORDINATE

CP STA 926+88.32, 36.90 FT RT
 CP 109, SET REBAR W/ RED PLASTIC SNYDER CONTROL CAP
 N=709115.364, E=2111493.021, ELEV. 808.330

MONUMENT MAY BE LOCATED BY
 STAKING OUT COORDINATE

CP STA 937+41.40, 38.08 FT RT
 CP 110, SET REBAR W/ RED PLASTIC SNYDER CONTROL CAP
 N=709648.405, E=2112401.235, ELEV. 828.150

MONUMENT MAY BE LOCATED BY
 STAKING OUT COORDINATE


CP STA 948+82.87, 40.35 FT RT
 CP 111, SET REBAR W/ RED PLASTIC SNYDER CONTROL CAP
 N=710225.327, E=2113386.176, ELEV. 800.680

MONUMENT MAY BE LOCATED BY
 STAKING OUT COORDINATE

CP STA 953+99.85, 42.76 FT RT
 CP 112, SET REBAR W/ RED PLASTIC SNYDER CONTROL CAP
 N=710485.430, E=2113832.974, ELEV. 783.030

MONUMENT MAY BE LOCATED BY
 STAKING OUT COORDINATE


CP STA 958+91.52, 106.92 FT LT
 CP 113, SET REBAR W/ RED PLASTIC SNYDER CONTROL CAP
 N=710863.774, E=2114180.813, ELEV. 781.940

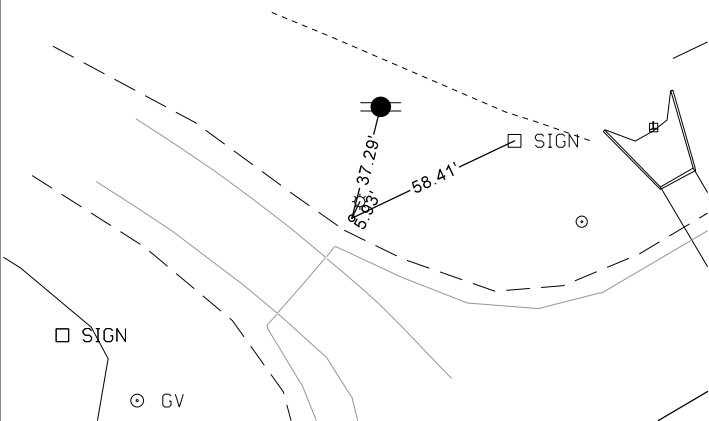


CP STA 968+92.74, 78.50 FT LT
 CP 114, SET REBAR W/ RED PLASTIC SNYDER CONTROL CAP
 N=711347.028, E=2115058.146, ELEV. 790.110

MONUMENT MAY BE LOCATED BY
 STAKING OUT COORDINATE


CP STA 973+96.87, 24.64 FT RT
 CP 115, SET REBAR W/ RED PLASTIC SNYDER CONTROL CAP
 N=711513.799, E=2115544.949, ELEV. 785.140

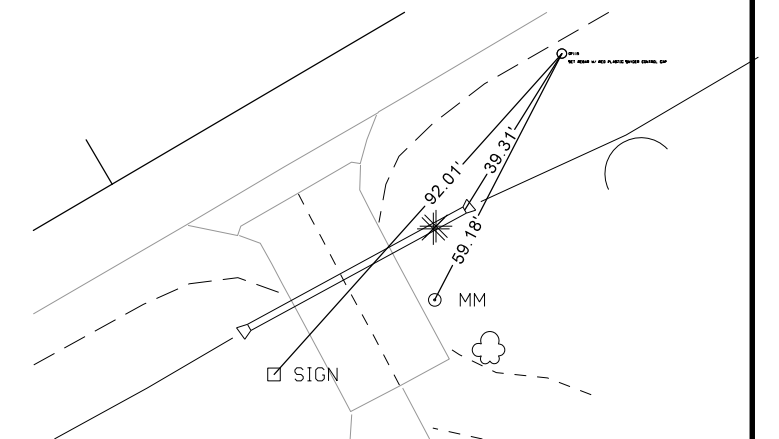


CP STA 981+16.48, 27.08 FT RT
 CP 116, SET REBAR W/ RED PLASTIC SNYDER CONTROL CAP
 N=711876.636, E=2116166.395, ELEV. 778.680

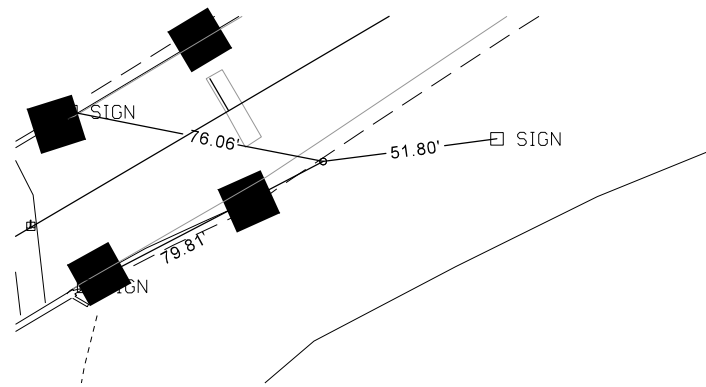

CP STA 991+86.29, 26.37 FT RT
 CP 373, SET HINGE NAIL IN ACC
 N=712419.779, E=2117088.065, ELEV. 799.640

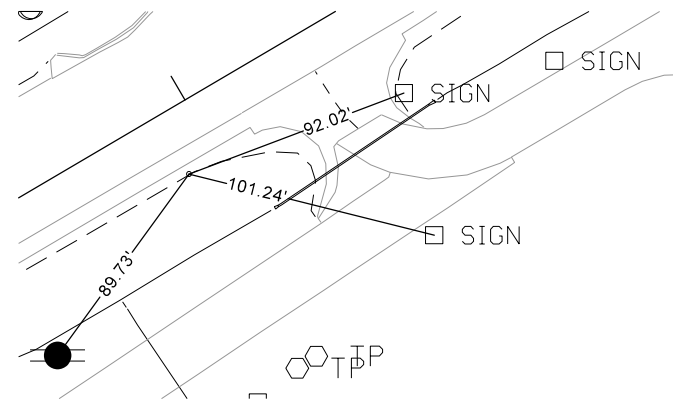

CP STA 992+95.16, 33.05 FT RT
 CP 117, SET REBAR W/ RED PLASTIC SNYDER CONTROL CAP
 N=712469.239, E=2117185.291, ELEV. 801.310

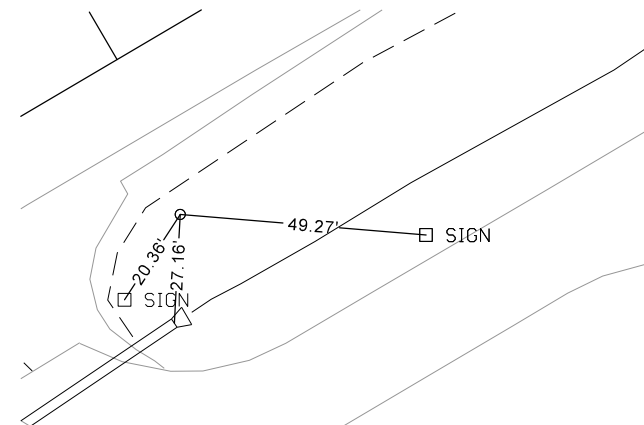

DESCRIBE CHAIN ML151 (US HIGHWAY 151)

Chain ML151 contains:
 1 2 CUR CUR1 CUR2 CUR3 CUR4 CUR5 CUR6 CUR7 CUR8 CUR9 CUR10 33
 CUR8 CUR9 CUR10 33

Beginning chain ML151 description
 =====

Point 1 N 687,471.81 E 2,084,954.51 Sta 550+54.72
 Course from 1 to 2 N 83° 13' 17.03" E Dist 2,968.75

Point 2 N 687,822.22 E 2,087,902.50 Sta 580+23.47
 Course from 2 to PC CUR1 N 89° 05' 00.94" E Dist 1,078.93

Curve CUR1

 P.I. Station = 596+55.40 N 687,848.32 E 2,089,534.22
 Delta = 1° 06' 21.45" (LT)
 Degree = 0° 06' 00.00"
 Tangent = 553.00
 Length = 1,105.96
 Radius = 57,295.78
 External = 2.67
 Long Chord = 1,105.94
 Mid. Ord. = 2.67
 P.C. Station = 591+02.40 N 687,839.48 E 2,088,981.30
 P.T. Station = 602+08.36 N 687,867.84 E 2,090,086.87
 C.C. = N 745,127.93 E 2,088,064.89
 Back = N 89° 05' 00.80" E
 Ahead = N 87° 58' 39.35" E
 Chord Bear = N 88° 31' 50.08" E

Course from PT CUR1 to PC CUR2 N 87° 58' 39.41" E Dist 2,643.13

Curve CUR2

 P.I. Station = 632+35.31 N 687,974.66 E 2,093,111.94
 Delta = 30° 00' 04.08" (LT)
 Degree = 3° 59' 59.94"
 Tangent = 383.83
 Length = 750.03
 Radius = 1,432.40
 External = 50.53
 Long Chord = 741.49
 Mid. Ord. = 48.81
 P.C. Station = 628+51.49 N 687,961.11 E 2,092,728.36
 P.T. Station = 636+01.52 N 688,178.19 E 2,093,437.36
 C.C. = N 689,392.62 E 2,092,677.80
 Back = N 87° 58' 39.30" E
 Ahead = N 57° 58' 35.22" E
 Chord Bear = N 72° 58' 37.26" E

Course from PT CUR2 to PC CUR3 N 57° 58' 34.93" E Dist 456.06

Curve CUR3

 P.I. Station = 645+17.23 N 688,663.76 E 2,094,213.73
 Delta = 13° 43' 25.46" (LT)
 Degree = 1° 30' 00.00"
 Tangent = 459.66
 Length = 914.92
 Radius = 3,819.72
 External = 27.56
 Long Chord = 912.73
 Mid. Ord. = 27.36
 P.C. Station = 640+57.57 N 688,420.02 E 2,093,824.02
 P.T. Station = 649+72.49 N 688,993.00 E 2,094,534.49
 C.C. = N 691,658.50 E 2,091,798.55
 Back = N 57° 58' 35.60" E
 Ahead = N 44° 15' 10.14" E
 Chord Bear = N 51° 06' 52.87" E

Course from PT CUR3 to PC CUR4 N 44° 15' 09.36" E Dist 440.29

Curve CUR4

 P.I. Station = 656+91.27 N 689,507.84 E 2,095,036.07
 Delta = 1° 17' 58.31" (RT)
 Degree = 0° 14' 00.00"
 Tangent = 278.48
 Length = 556.94
 Radius = 24,555.33
 External = 1.58
 Long Chord = 556.93
 Mid. Ord. = 1.58
 P.C. Station = 654+12.78 N 689,308.37 E 2,094,841.74
 P.T. Station = 659+69.72 N 689,702.85 E 2,095,234.88
 C.C. = N 672,173.05 E 2,112,429.95
 Back = N 44° 15' 09.90" E
 Ahead = N 45° 33' 08.21" E
 Chord Bear = N 44° 54' 09.05" E

Course from PT CUR4 to PC CUR5 N 45° 33' 08.19" E Dist 1,496.18

Curve Data

Curve CUR5
 P.I. Station = 677+66.26 N 690,960.89 E 2,096,517.41
 Delta = 2° 48' 09.95" (LT)
 Degree = 0° 28' 00.00"
 Tangent = 300.36
 Length = 600.59
 Radius = 12,277.67
 External = 3.67
 Long Chord = 600.53
 Mid. Ord. = 3.67
 P.C. Station = 674+65.91 N 690,750.56 E 2,096,302.98
 P.T. Station = 680+66.50 N 691,181.45 E 2,096,721.29
 C.C. = N 699,515.46 E 2,087,705.44
 Back = N 45° 33' 08.10" E
 Ahead = N 42° 44' 58.15" E
 Chord Bear = N 44° 09' 03.12" E

Course from PT CUR5 to PC CUR6 N 42° 44' 58.22" E Dist 4,614.96

Curve CUR6

 P.I. Station = 729+84.38 N 694,792.79 E 2,100,059.52
 Delta = 3° 01' 42.98" (RT)
 Degree = 0° 30' 00.02"
 Tangent = 302.93
 Length = 605.71
 Radius = 11,459.00
 External = 4.00
 Long Chord = 605.64
 Mid. Ord. = 4.00
 P.C. Station = 726+81.46 N 694,570.34 E 2,099,853.89
 P.T. Station = 732+87.17 N 695,004.06 E 2,100,276.61
 C.C. = N 686,792.04 E 2,108,268.56
 Back = N 42° 44' 58.20" E
 Ahead = N 45° 46' 41.18" E
 Chord Bear = N 44° 15' 49.69" E

Course from PT CUR6 to PC CUR7 N 45° 46' 41.21" E Dist 3,685.12

Curve CUR7

 P.I. Station = 775+07.55 N 697,947.52 E 2,103,301.12
 Delta = 10° 40' 27.65" (LT)
 Degree = 1° 00' 00.00"
 Tangent = 535.27
 Length = 1,067.44
 Radius = 5,729.58
 External = 24.95
 Long Chord = 1,065.89
 Mid. Ord. = 24.84
 P.C. Station = 769+72.29 N 697,574.21 E 2,102,917.53
 P.T. Station = 780+39.72 N 698,385.43 E 2,103,608.93
 C.C. = N 701,680.28 E 2,098,921.49
 Back = N 45° 46' 41.10" E
 Ahead = N 35° 06' 13.45" E
 Chord Bear = N 40° 26' 27.27" E

Course from PT CUR7 to PC CUR8 N 35° 06' 13.54" E Dist 2,462.06

Curve CUR8

 P.I. Station = 810+89.91 N 700,880.82 E 2,105,362.97
 Delta = 28° 47' 05.99" (RT)
 Degree = 2° 30' 00.00"
 Tangent = 588.12
 Length = 1,151.40
 Radius = 2,291.83
 External = 74.26
 Long Chord = 1,139.33
 Mid. Ord. = 71.93
 P.C. Station = 805+01.79 N 700,399.68 E 2,105,024.76
 P.T. Station = 816+53.18 N 701,139.67 E 2,105,891.07
 C.C. = N 699,081.74 E 2,106,899.74
 Back = N 35° 06' 13.40" E
 Ahead = N 63° 53' 19.39" E
 Chord Bear = N 49° 29' 46.39" E

Course from PT CUR8 to PC CUR9 N 63° 53' 19.54" E Dist 1,263.38

Curve Data

Curve CUR9
 P.I. Station = 835+39.61 N 701,969.91 E 2,107,584.97
 Delta = 66° 14' 42.26" (LT)
 Degree = 5° 59' 59.99"
 Tangent = 623.05
 Length = 1,104.08
 Radius = 954.93
 External = 185.28
 Long Chord = 1,043.61
 Mid. Ord. = 155.17
 P.C. Station = 829+16.57 N 701,695.70 E 2,107,025.51
 P.T. Station = 840+20.65 N 702,592.43 E 2,107,559.35
 C.C. = N 702,553.17 E 2,106,605.23
 Back = N 63° 53' 19.50" E
 Ahead = N 2° 21' 22.76" W
 Chord Bear = N 30° 45' 58.37" E

Course from PT CUR9 to PC CUR10 N 2° 21' 22.88" W Dist 3,009.23

Curve CUR10

 P.I. Station = 881+74.79 N 706,743.06 E 2,107,388.56
 Delta = 61° 52' 59.64" (RT)
 Degree = 3° 00' 00.00"
 Tangent = 1,144.91
 Length = 2,062.78
 Radius = 1,909.86
 External = 316.88
 Long Chord = 1,963.96
 Mid. Ord. = 271.79
 P.C. Station = 870+29.88 N 705,599.11 E 2,107,435.63
 P.T. Station = 890+92.65 N 707,323.68 E 2,108,375.32
 C.C. = N 705,677.64 E 2,109,343.87
 Back = N 2° 21' 22.90" W
 Ahead = N 59° 31' 36.74" E
 Chord Bear = N 28° 35' 06.92" E

Course from PT CUR10 to 33 N 59° 31' 36.72" E Dist 12,137.87

Point 33 N 713,479.21 E 2,118,836.55 Sta 1012+30.52
 =====

Ending chain ML151 description

DESCRIBE CHAIN SRCHURCH (CHURCH STREET)	DESCRIBE CHAIN SRSTALLMAN (STALLMAN DRIVE)	DESCRIBE CHAIN SRBEVERLY (BEVERLY ROAD)
Chain SRCHURCH contains: SRCHURCH102 SRCHURCH103 Beginning chain SRCHURCH description ===== Point SRCHURCH102 N 703,497.26 E 2,107,216.91 Sta 1846+30.00 Course from SRCHURCH102 to SRCHURCH103 N 88° 21' 40.74" E Dist 670.00 Point SRCHURCH103 N 703,516.42 E 2,107,886.64 Sta 1853+00.00 ===== Ending chain SRCHURCH description	Chain SRSTALLMAN contains: 4873 CUR SRSTALLMAN-1 4874 Beginning chain SRSTALLMAN description ===== Point 4873 N 706,409.81 E 2,107,401.91 Sta 4873+00.00 Course from 4873 to PC SRSTALLMAN-1 S 2° 22' 51.16" E Dist 179.34 ===== Curve Data *-----* Curve SRSTALLMAN-1 P.I. Station 4875+23.63 N 706,186.37 E 2,107,411.20 Delta = 72° 52' 18.32" (LT) Degree = 95° 29' 34.68" Tangent = 44.29 Length = 76.31 Radius = 60.00 External = 14.58 Long Chord = 71.27 Mid. Ord. = 11.73 P.C. Station 4874+79.34 N 706,230.63 E 2,107,409.36 P.T. Station 4875+55.65 N 706,175.10 E 2,107,454.04 C.C. = 706,233.12 E 2,107,469.31 Back = S 2° 22' 51.16" E Ahead = S 75° 15' 09.49" E Chord Bear = S 38° 49' 00.32" E ===== Course from PT SRSTALLMAN-1 to 4874 S 75° 15' 09.49" E Dist 144.35 Point 4874 N 706,138.35 E 2,107,593.64 Sta 4877+00.00 ===== Ending chain SRSTALLMAN description	Chain SRBEVERLY contains: 6952 CUR SRBEVERLY-1 6953 Beginning chain SRBEVERLY description ===== Point 6952 N 710,953.98 E 2,113,601.63 Sta 6952+00.00 Course from 6952 to PC SRBEVERLY-1 N 89° 33' 06.71" E Dist 249.20 ===== Curve Data *-----* Curve SRBEVERLY-1 P.I. Station 6956+71.71 N 710,957.67 E 2,114,073.33 Delta = 49° 58' 30.00" (RT) Degree = 12° 00' 00.44" Tangent = 222.52 Length = 416.45 Radius = 477.46 External = 49.31 Long Chord = 403.38 Mid. Ord. = 44.69 P.C. Station 6954+49.20 N 710,955.93 E 2,113,850.82 P.T. Station 6958+65.65 N 710,788.40 E 2,114,217.76 C.C. = 710,478.48 E 2,113,854.55 Back = N 89° 33' 06.71" E Ahead = S 40° 28' 23.29" E Chord Bear = S 65° 27' 38.29" E ===== Course from PT SRBEVERLY-1 to 6953 S 40° 28' 23.29" E Dist 23.58 Point 6953 N 710,770.46 E 2,114,233.07 Sta 6958+89.23 ===== Ending chain SRBEVERLY description
DESCRIBE CHAIN SRPRAIRIE (PRAIRIE AVENUE) Chain SRPRAIRIE contains: 2863 2864 2865 Beginning chain SRPRAIRIE description ===== Point 2863 N 704,983.08 E 2,107,341.09 Sta 2863+00.00 Course from 2863 to 2864 N 86° 54' 11.73" E Dist 300.00 Point 2864 N 704,999.28 E 2,107,640.65 Sta 2866+00.00 Course from 2864 to 2865 N 83° 28' 37.57" E Dist 200.00 Point 2865 N 705,022.00 E 2,107,839.35 Sta 2868+00.00 ===== Ending chain SRPRAIRIE description	Chain SRCEMETERY contains: 5880 5881 CUR SRCEMETERY-1 5882 5883 Beginning chain SRCEMETERY description ===== Point 5880 N 706,872.56 E 2,107,449.44 Sta 5880+00.00 Course from 5880 to 5881 N 88° 28' 15.30" E Dist 432.27 Point 5881 N 706,884.09 E 2,107,881.55 Sta 5884+32.27 Course from 5881 to PC SRCEMETERY-1 S 83° 10' 44.90" E Dist 45.02 ===== Curve Data *-----* Curve SRCEMETERY-1 P.I. Station 5885+27.68 N 706,872.76 E 2,107,976.29 Delta = 9° 36' 05.14" (LT) Degree = 9° 32' 57.47" Tangent = 50.39 Length = 100.55 Radius = 600.00 External = 2.11 Long Chord = 100.43 Mid. Ord. = 2.10 P.C. Station 5884+77.29 N 706,878.75 E 2,107,926.26 P.T. Station 5885+77.84 N 706,875.21 E 2,108,026.62 C.C. = 707,474.50 E 2,107,997.52 Back = S 83° 10' 44.90" E Ahead = N 87° 13' 09.96" E Chord Bear = S 87° 58' 47.47" E ===== Course from PT SRCEMETERY-1 to 5882 N 87° 13' 09.96" E Dist 61.46 Point 5882 N 706,878.19 E 2,108,088.01 Sta 5886+39.30 Course from 5882 to 5883 N 88° 27' 55.32" E Dist 361.76 Point 5883 N 706,887.88 E 2,108,449.64 Sta 5890+01.06 ===== Ending chain SRCEMETERY description	DESCRIBE CHAIN DD2 (DRAINAGE DITCH #2) Chain DD2 contains: DD2-9 CUR DD2-10 8974 Beginning chain DD2 description ===== Curve Data *-----* Curve DD2-9 P.I. Station 8977+51.45 N 712,093.14 E 2,115,952.05 Delta = 101° 12' 47.17" (LT) Degree = 88° 08' 50.47" Tangent = 79.15 Length = 114.82 Radius = 65.00 External = 37.42 Long Chord = 100.46 Mid. Ord. = 23.75 P.C. Station 8976+72.30 N 712,159.56 E 2,115,995.10 P.T. Station 8977+87.13 N 712,063.83 E 2,116,025.58 C.C. = 712,124.21 E 2,116,049.65 Back = S 32° 56' 36.72" W Ahead = S 68° 16' 10.44" E Chord Bear = S 17° 39' 46.86" E ===== Curve Data *-----* Curve DD2-10 P.I. Station 8978+30.80 N 712,047.66 E 2,116,066.15 Delta = 67° 47' 47.16" (RT) Degree = 88° 08' 50.47" Tangent = 43.68 Length = 76.91 Radius = 65.00 External = 13.31 Long Chord = 72.50 Mid. Ord. = 11.05 P.C. Station 8977+87.13 N 712,063.83 E 2,116,025.58 P.T. Station 8978+64.04 N 712,003.99 E 2,116,066.51 C.C. = 712,003.45 E 2,116,001.51 Back = S 68° 16' 10.44" E Ahead = S 0° 28' 23.28" E Chord Bear = S 34° 22' 16.86" E ===== Course from PT DD2-10 to 8974 S 0° 28' 23.28" E Dist 424.42 Point 8974 N 711,579.58 E 2,116,070.02 Sta 8982+88.46 ===== Ending chain DD2 description
DESCRIBE CHAIN SRLOSEY (LOSEY AVENUE) Chain SRLOSEY contains: 3862 CUR SRLOSEY-1 CUR SRLOSEY-2 3863 Beginning chain SRLOSEY description ===== Point 3862 N 704,699.51 E 2,107,551.37 Sta 3862+00.00 Course from 3862 to PC SRLOSEY-1 N 6° 16' 07.27" W Dist 86.45 ===== Curve Data *-----* Curve SRLOSEY-1 P.I. Station 3863+17.99 N 704,816.79 E 2,107,538.49 Delta = 9° 00' 55.63" (RT) Degree = 14° 19' 26.20" Tangent = 31.53 Length = 62.94 Radius = 400.00 External = 1.24 Long Chord = 62.87 Mid. Ord. = 1.24 P.C. Station 3862+86.45 N 704,785.44 E 2,107,541.93 P.T. Station 3863+49.39 N 704,848.29 E 2,107,540.00 C.C. = 704,829.12 E 2,107,939.54 Back = N 6° 16' 07.27" W Ahead = N 2° 44' 48.36" E Chord Bear = N 1° 45' 39.45" W ===== Curve Data *-----* Curve SRLOSEY-2 P.I. Station 3863+67.22 N 704,866.09 E 2,107,540.86 Delta = 5° 06' 11.25" (LT) Degree = 14° 19' 26.20" Tangent = 17.83 Length = 35.63 Radius = 400.00 External = 0.40 Long Chord = 35.61 Mid. Ord. = 0.40 P.C. Station 3863+49.39 N 704,848.29 E 2,107,540.00 P.T. Station 3863+85.02 N 704,883.90 E 2,107,540.12 C.C. = 704,867.46 E 2,107,140.46 Back = N 2° 44' 48.36" E Ahead = N 2° 21' 22.88" W Chord Bear = N 0° 11' 42.74" E ===== Course from PT SRLOSEY-2 to 3863 N 2° 21' 22.88" W Dist 214.98 Point 3863 N 705,098.70 E 2,107,531.28 Sta 3866+00.00 ===== Ending chain SRLOSEY description	DESCRIBE CHAIN SR80TH (80TH STREET) Chain SR80TH contains: SR801 SR802 SR803 Beginning chain SR80TH description ===== Point SR801 N 707,360.26 E 2,109,980.58 Sta 7897+74.35 Course from SR801 to SR802 N 2° 29' 54.80" W Dist 131.69 Point SR802 N 707,491.82 E 2,109,974.84 Sta 7899+06.04 Course from SR802 to SR803 N 2° 29' 54.80" W Dist 1,413.05 Point SR803 N 708,903.53 E 2,109,913.24 Sta 7913+19.08 ===== Ending chain SR80TH description	Chain DD2 contains: DD2-9 CUR DD2-10 8974 Beginning chain DD2 description ===== Curve Data *-----* Curve DD2-9 P.I. Station 8977+51.45 N 712,093.14 E 2,115,952.05 Delta = 101° 12' 47.17" (LT) Degree = 88° 08' 50.47" Tangent = 79.15 Length = 114.82 Radius = 65.00 External = 37.42 Long Chord = 100.46 Mid. Ord. = 23.75 P.C. Station 8976+72.30 N 712,159.56 E 2,115,995.10 P.T. Station 8977+87.13 N 712,063.83 E 2,116,025.58 C.C. = 712,124.21 E 2,116,049.65 Back = S 32° 56' 36.72" W Ahead = S 68° 16' 10.44" E Chord Bear = S 17° 39' 46.86" E ===== Curve Data *-----* Curve DD2-10 P.I. Station 8978+30.80 N 712,047.66 E 2,116,066.15 Delta = 67° 47' 47.16" (RT) Degree = 88° 08' 50.47" Tangent = 43.68 Length = 76.91 Radius = 65.00 External = 13.31 Long Chord = 72.50 Mid. Ord. = 11.05 P.C. Station 8977+87.13 N 712,063.83 E 2,116,025.58 P.T. Station 8978+64.04 N 712,003.99 E 2,116,066.51 C.C. = 712,003.45 E 2,116,001.51 Back = S 68° 16' 10.44" E Ahead = S 0° 28' 23.28" E Chord Bear = S 34° 22' 16.86" E ===== Course from PT DD2-10 to 8974 S 0° 28' 23.28" E Dist 424.42 Point 8974 N 711,579.58 E 2,116,070.02 Sta 8982+88.46 ===== Ending chain DD2 description

SUPERELEVATION DATA

See PV-300 Series

Road Identification	Circular Curve or Spiral Curve Name	Radius	Superelevation Data			Standard Road Plan	Section A-A	Section B-B	Section C-C	Section D-D	Section E-E	Section F-F	Case A	Case B	Case C	Case S	Case T	Case U	Remarks
			e %	L FT	x FT														
U.S. Hwy. 151	CUR10	1910	4.2	120	57	PV-301	868+88.88 892+33.65	869+45.88 891+76.65	870+02.88 891+19.65	870+65.88 890+56.65			870+29.88 890+92.65			870+60.17 890+62.36	870+60.17 890+62.36		
U.S. Hwy. 151	CUR10	1910	4.2	120	57		885+98.30	886+55.30	887+12.30	887+75.30									SB Rt. Turn Lane Transition

TRAFFIC CONTROL PLAN

U.S. 151 will be closed to through traffic throughout the project area for the duration of the project. Through traffic will use the detour route details on Sheets J.3-J.7. The road will remain open to local traffic throughout construction, with the exception of the UPRR Bridge, which will be closed. Refer to Staging Notes for additional information. All conflicting route markers along detour route shall be covered or removed. Detour signing and traffic control devices shall be in place prior to start of work. At the direction of the Engineer, remove, cover relocate or adjust existing signs for temporary traffic control, this shall be considered incidental to the project.

Church Street

Access to Church Street from U.S. 151 must be maintained between May 1st and August 15th. Church Street may be closed at U.S. 151 during intersection reconstruction. Road closure per Standard Road Plan TC-252.

Prairie Avenue

Access to Prairie Avenue from U.S. 151 shall be maintained through Stage 2. Following completion and opening of U.S. Highway 151 bridge at UPRR, access will be closed to complete intersection reconstruction.

Stallman Drive

Stallman Drive will be closed at U.S. 151 during intersection construction. Access to Stallman Drive via West Cemetery Road and access to West Cemetery Road intersection at U.S. 151 shall be maintained during Stallman Drive intersection closure.

Cemetery Road

Cemetery Road will be closed at U.S. 151 during intersection reconstruction. West Cemetery Road and East Cemetery Road intesections shall not be closed at the same time. West Cemetery Road and Stallman Drive intersetions with U.S. 151 shall not be closed at the same time.

Beverly Road

Beverly Road will be closed at U.S. 151 during culvert installation. Road closure par Standard Road Plan TC-252.

Access to properties within the project area shall be maintained at all times. Provide access to emergency vehicles at all times during construction. Maintain garbage and mail service to properties as necessary throughout construciton, this shall be considered incidental to other project items.

COORDINATED OPERATIONS

Other work in progress during the same period of time will include the construction of the projects listed. Coordinate operations with those of other contractors working within the same area.

Project	Type of Work
BRF-151-3(141)--38-57	UPRR Bridge
BRF-151-3(142)--38-57	Prairie Creek Bridge
BRF-151-3(152)--38-57	Drainage Ditch No. 1 Bridge
NHSX-151-3(134)--3H-57	Drainage Ditch No. 2 Structure
NHSX-151-3(169)--3H-57	Traffic Signs

STAGING NOTES

Staging designations may not match designations shown in structural plans.

U.S. HIGHWAY 151, SOUTH OF CHURCH STREET

Stage 1A:

Close U.S. 151 from north of Church Street to south of Prairie Avenue for bridge and wall construction. Traffic utilizes existing pavement, U.S. 151 south of Church Street shall remain open to maintain access to properties located adjacent to construction area. Shift traffic to western half of existing pavement. Construct U.S. 151 improvements on east side. Construct Church Street intersection from western limit to eastern end of radius. Sub-stage driveway replacement to maintain property access.

Stage 1B:

U.S. 151 remains closed from north of Church Street to south of Prairie Avenue. Shift traffic to east half of existing pavement utilizing previously constructed pavement. Construct U.S. Highway 151 improvements on west side. Construct remaining portion of Church Street east of U.S. Highway 151. Sub-stage driveway replacement as much as practical to maintain property access. Upon completion, open Church Street intersection to local traffic.

U.S. HIGHWAY 151, CHURCH STREET TO PRAIRIE AVENUE (UPRR BRIDGE CONSTRUCTION)

Stage 1A-2B:

U.S. 151 remains closed from north of Church Street to south of Prairie Avenue. Construct walls, bridge, pavement and temporary pavement. Perform longitudinal grooving on the bridge deck and approach pavement prior to opening to traffic.

U.S. HIGHWAY 151, UPRR TO 80TH STREET

Stage 1C:

Traffic utilizes existing roadway. Construct temporary pavement along east side of U.S. 151 between Prairie Creek and STA 902+85.

Stage 2A:

Shift traffic to east side of U.S. Highway 151. Install temporary traffic signal at Prairie Avenue and north of Prairie Creek Bridge, install per these plans and TC-216. Traffic will utilize a single lane across the existing Prairie Creek Bridge. North of Prairie Creek Bridge, two lanes of traffic will utilize existing pavement and previously constructed temporary pavement. Maintain access to Stallman Drive, close West Cemetery Road at U.S. Highway 151 to complete intersection improvements. Construct proposed improvements on west half of U.S. Highway 151 and install temporary pavement at the Prairie Creek and Drainage Ditch #1 Bridge. Close and reconstruct entrance at STA 894+21 (LT), maintain access to entrance at STA 890+96.75 (LT).

Stage 2B:

Maintain traffic as described in Stage 2A. Reopen U.S. Highway 151 intersection at West Cemetery Road. Close and reconstruct Stallman Drive intersection. Reopen driveway at STA 894+21 (LT), close and reconstruct entrance at STA 890+96.75 (LT). Construct improvements on west half of U.S. Highway 151 from STA 898+00 to STA 903+15. Construct temporary pavement to maintain a minimum of 29' from centerline. Perform longitudinal grooving on the bridge deck and approach pavement prior to opening to traffic.

Stage 3A:

Open U.S. Highway 151 bridge at UPRR. Shift traffic to the west side of U.S. Highway 151. Two lanes of traffic will utilize previously constructed pavement and temporary pavement. Close access to U.S. Highway 151 at Prairie Avenue intersection, construct Prairie Avenue and Losey Avenue. Construct proposed improvements on east half of U.S. Highway 151. Maintain access at STA 877+50 (RT). Close East Cemetery Road intersection at U.S. Highway 151. Close and reconstruct entrance at STA 891+10 (RT) and STA 895+76.54, maintain access to entrance at STA 894+18.50 (Casey's General Store). Close and reconstruct entrance at STA 897+94.90 (RT).

Stage 3B:

Maintain traffic as described in Stage 3A. Reopen U.S. Highway 151 access to East Cemetery Road and driveways constructed in Stage 3A. Reconstruct entrance at STA 877+50 (RT), sub-stage to maintain access. Close and reconstruct entrance at STA. 894+18.50 (RT). Construct improvements on east half of U.S. Highway 151 from STA 898+00 to STA 903+15. Perform longitudinal grooving on the bridge deck and approach pavement prior to opening to traffic.

Stage 4:

Shift traffic to east side of previously constructed pavement. Remove temporary pavement and construct remaining improvements on west side.

BEVERLY ROAD

Stage 1: Close Beverly Road at U.S. Highway 151 intersection, utilize Standard Road Plan TC-252. Complete proposed improvements.

U.S. HIGHWAY 151, DRAINAGE DITCH #2

Stage 1:



Traffic utilizes existing roadway. Traffic will utilize a single lane across the existing Drainage Ditch #2 Bridge. Install temporary signals on east and west side of bridge per these plans and TC-216. Construct portion of structure and U.S. highway 151 improvements left of centerline and construct temporary detour pavement to accommodate two-way traffic in Stage 2.

Stage 2:

Shift traffic to temporary detour pavement constructed in previous stage. Construct remaining portion of structure and U.S. Highway 151 improvements right of centerline.


Stage 3:

Shift traffic to previously constructed pavement. Remove temporary pavement. Construct shoulder and grade foreslope left of centerline.

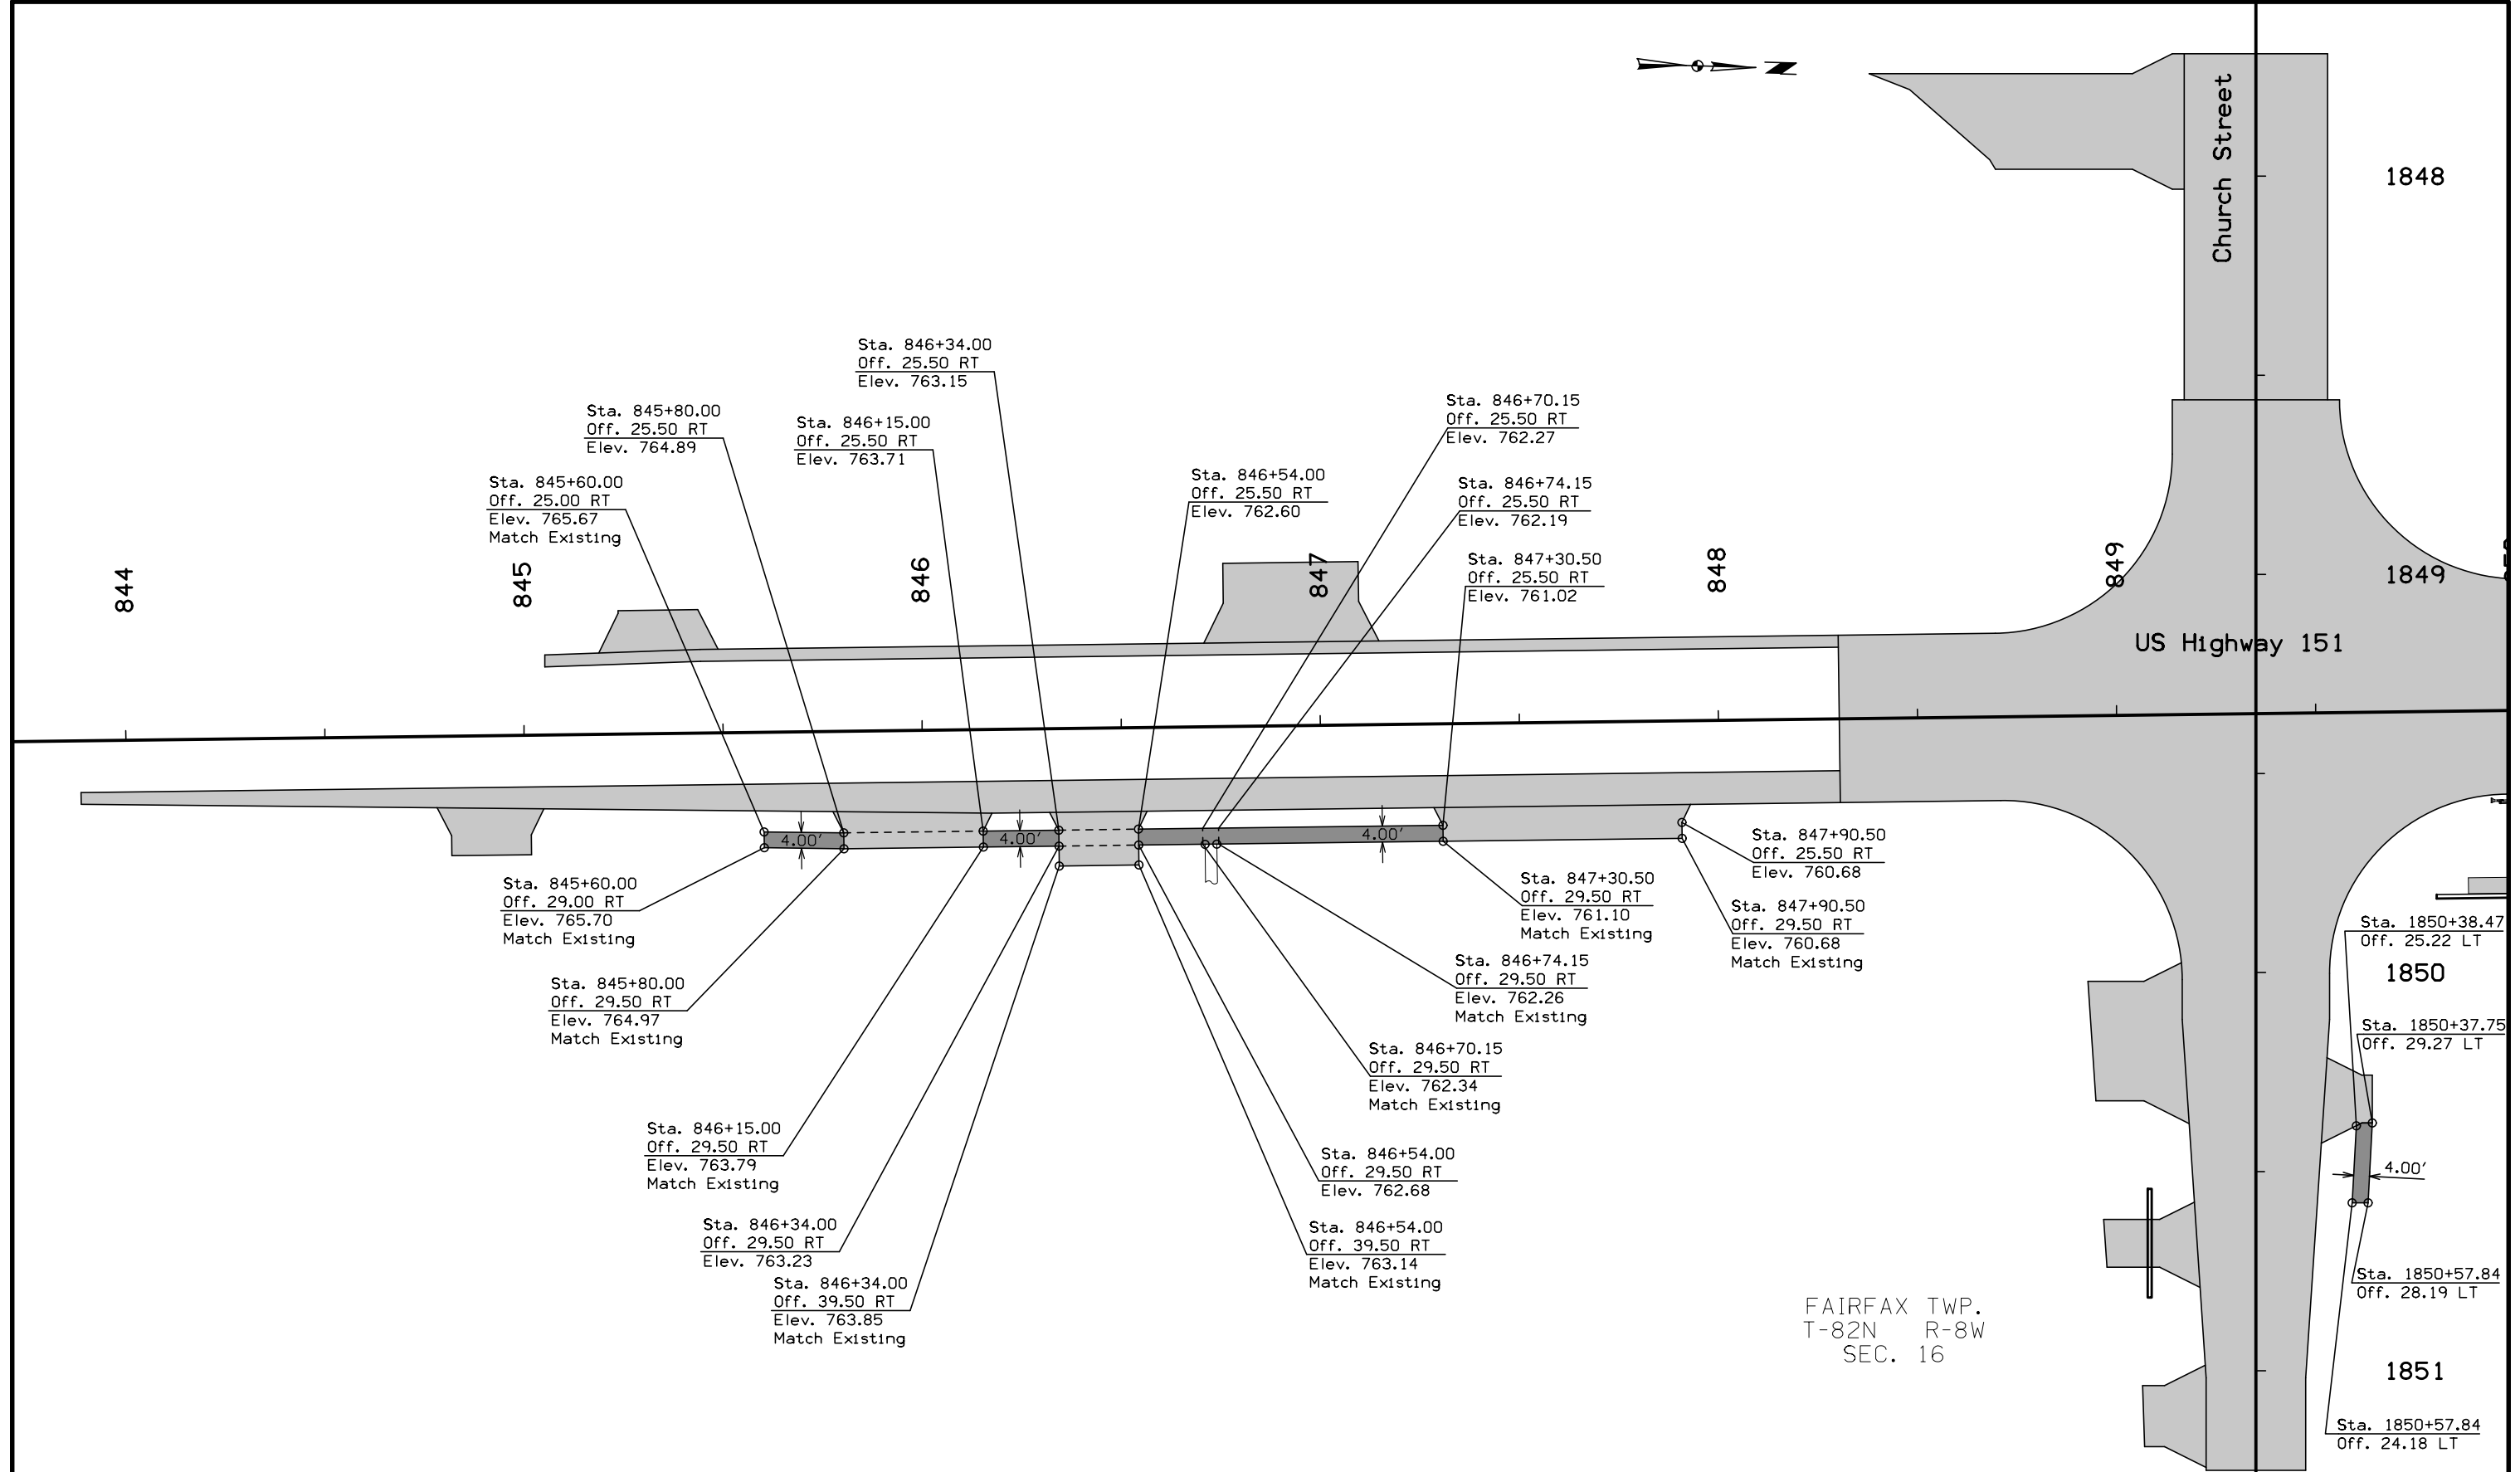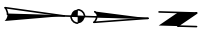

NOTES:

Refer to G sheets for horizontal alignment information.
Refer to appropriate Standard Road Plans for additional information.

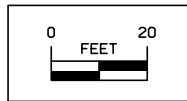


**Geometric Details
Sidewalk Southeast of Intersection
US Highway 151 and Church Street**

FILE NO.	ENGLISH	DESIGN TEAM	SNYDER & ASSOCIATES, INC.	LINN COUNTY	PROJECT NUMBER	NHSX-151-3(158)--3H-57	SHEET NUMBER	L.1
----------	---------	-------------	--------------------------------------	-------------	----------------	-------------------------------	--------------	------------

CIRCULAR CURVE DATA

Name	Δ	D	T	L	E	R
CURVE SRCHRCH_RET_1-2	90° 43' 03.62"	127° 19' 26.24"	45.57'	71.25'	19.04'	45'
CURVE SRCHRCH_RET_2-1	89° 16' 56.38"	127° 19' 26.24"	44.44'	70.12'	18.24'	45'
CURVE SRCHRCH_RET_3-1	90° 43' 03.62"	127° 19' 26.24"	45.57'	71.25'	19.04'	45'
CURVE SRCHRCH_RET_4-1	89° 16' 56.38"	127° 19' 26.24"	44.44'	70.12'	18.24'	45'

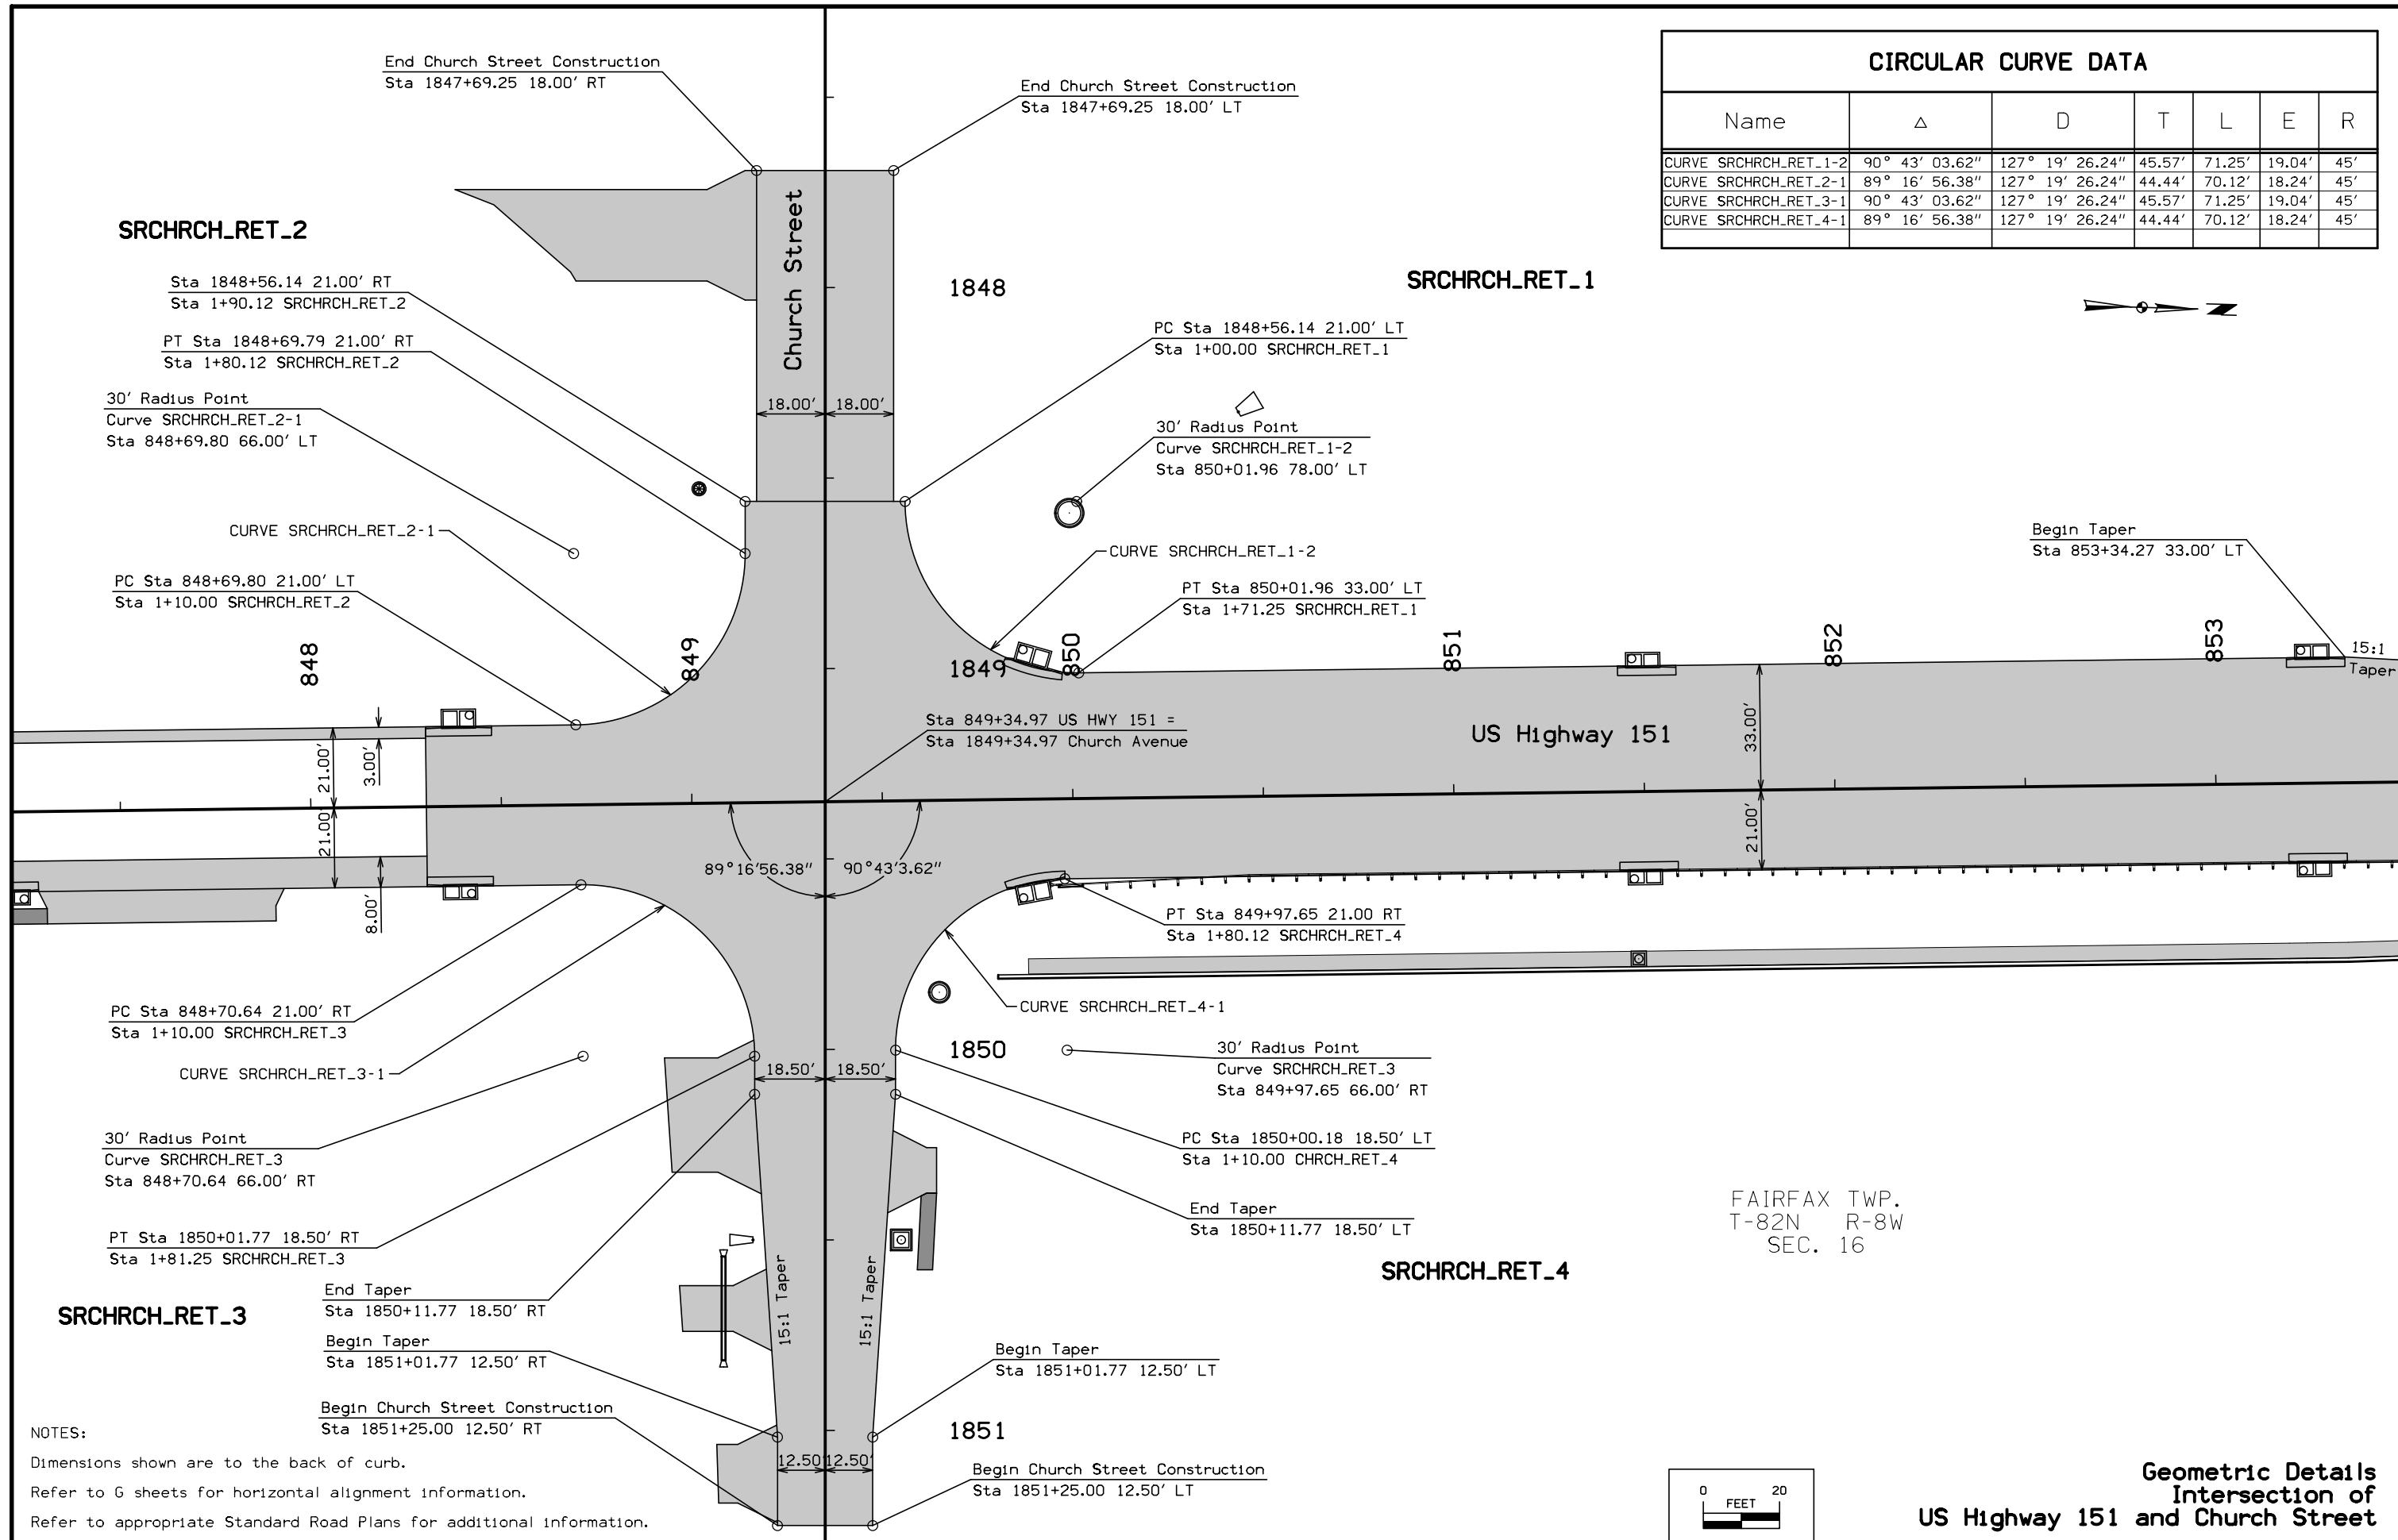

SRCHRCH_RET_2

Sta 1848+56.14 21.00' RT
Sta 1+90.12 SRCHRCH_RET_2
PT Sta 1848+69.79 21.00' RT
Sta 1+80.12 SRCHRCH_RET_2

30' Radius Point
Curve SRCHRCH_RET_2-1
Sta 848+69.80 66.00' LT

PC Sta 848+69.80 21.00' LT
Sta 1+10.00 SRCHRCH_RET_2

CURVE SRCHRCH_RET_2-1

848

849

1848

SRCHRCH_RET_1

PC Sta 1848+56.14 21.00' LT
Sta 1+00.00 SRCHRCH_RET_1

30' Radius Point
Curve SRCHRCH_RET_1-2
Sta 850+01.96 78.00' LT

CURVE SRCHRCH_RET_1-2

PT Sta 850+01.96 33.00' LT
Sta 1+71.25 SRCHRCH_RET_1

Begin Taper
Sta 853+34.27 33.00' LT

Sta 849+34.97 US HWY 151 =
Sta 1849+34.97 Church Avenue

US Highway 151

89° 16' 56.38"

90° 43' 3.62"

PT Sta 849+97.65 21.00 RT
Sta 1+80.12 SRCHRCH_RET_4

CURVE SRCHRCH_RET_4-1

PC Sta 848+70.64 21.00' RT
Sta 1+10.00 SRCHRCH_RET_3

CURVE SRCHRCH_RET_3-1

30' Radius Point
Curve SRCHRCH_RET_3
Sta 848+70.64 66.00' RT

PT Sta 1850+01.77 18.50' RT
Sta 1+81.25 SRCHRCH_RET_3

SRCHRCH_RET_3

End Taper
Sta 1850+11.77 18.50' RT

Begin Taper
Sta 1851+01.77 12.50' RT

Begin Church Street Construction
Sta 1851+25.00 12.50' RT

15:1 Taper

15:1 Taper

1850

30' Radius Point
Curve SRCHRCH_RET_3
Sta 849+97.65 66.00' RT

PC Sta 1850+00.18 18.50' LT
Sta 1+10.00 CHRCH_RET_4

End Taper
Sta 1850+11.77 18.50' LT

SRCHRCH_RET_4


1851

Begin Church Street Construction
Sta 1851+25.00 12.50' LT



NOTES:

Dimensions shown are to the back of curb.
Refer to G sheets for horizontal alignment information.
Refer to appropriate Standard Road Plans for additional information.


FAIRFAX TWP.
T-82N R-8W
SEC. 16

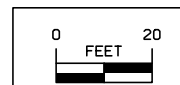

**Geometric Details
Intersection of
US Highway 151 and Church Street**

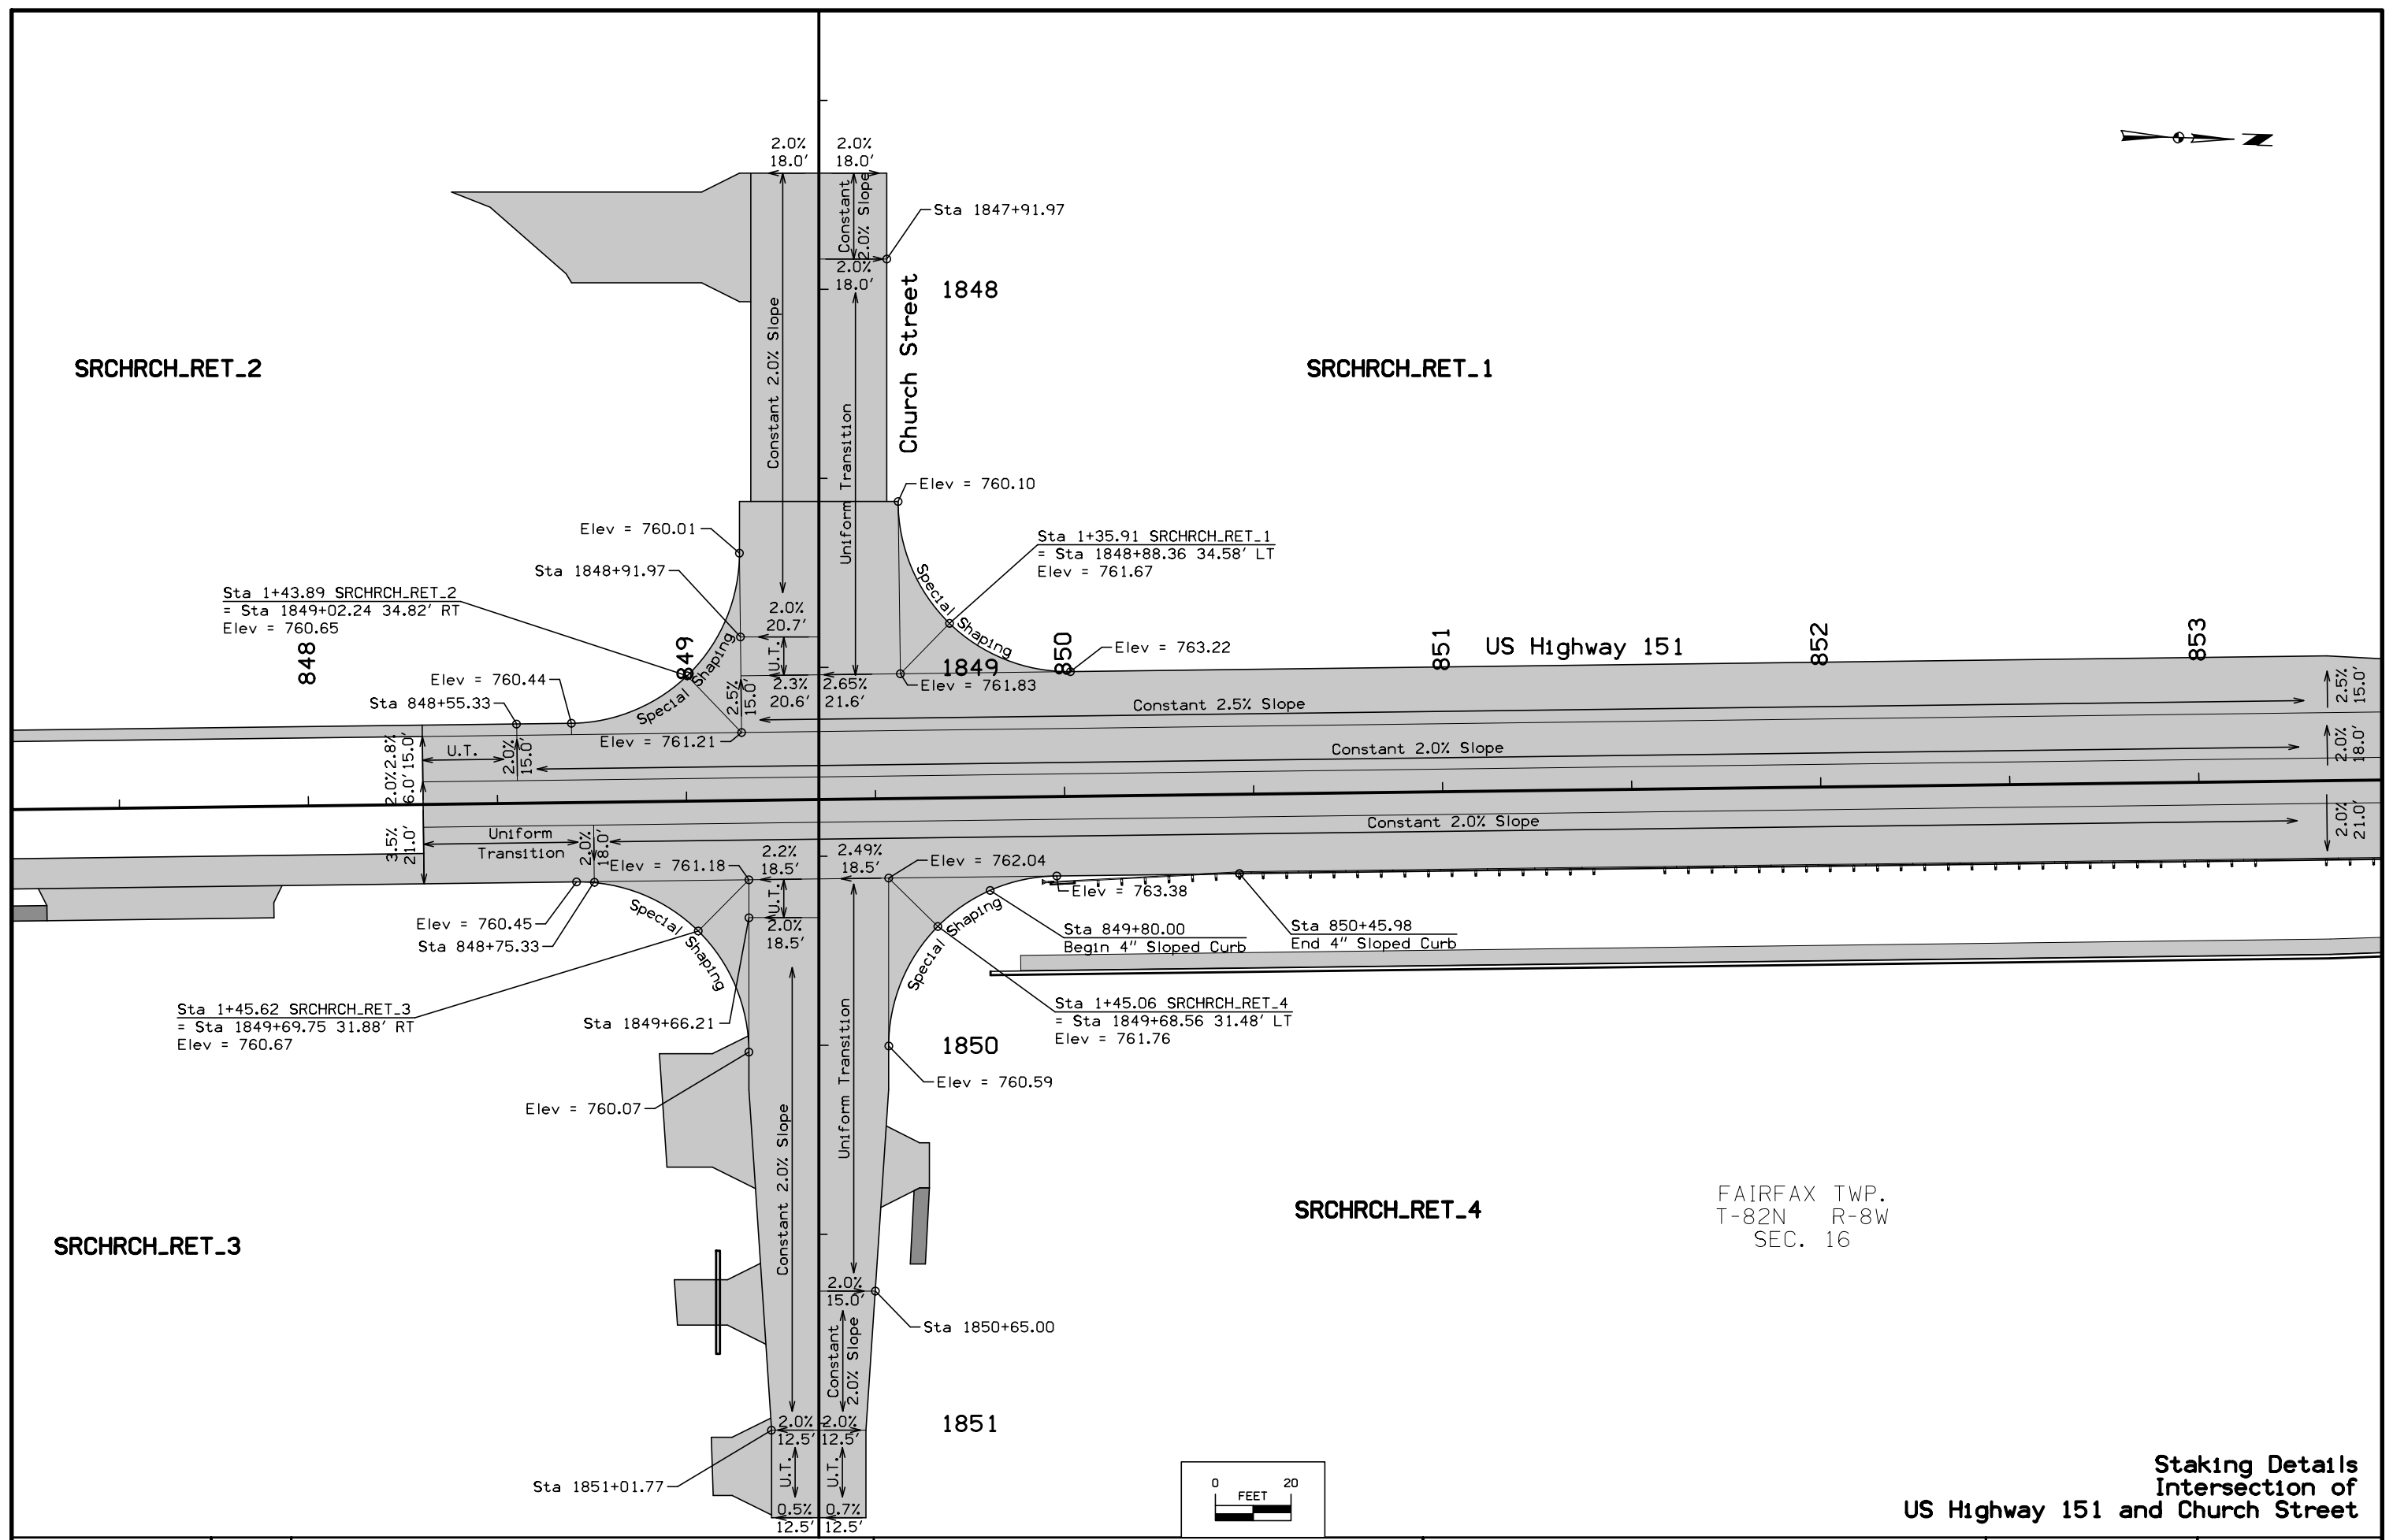
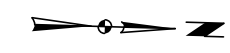


FAIRFAX TWP.
T-82N R-8W
SEC. 16


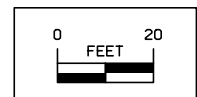


**Staking Details
Intersection of
US Highway 151 and Church Street**

FILE NO.	ENGLISH	DESIGN TEAM	SNYDER & ASSOCIATES, INC.	LINN COUNTY	PROJECT NUMBER	NHSX-151-3(158)--3H-57	SHEET NUMBER	L.3
----------	---------	-------------	--------------------------------------	-------------	----------------	-------------------------------	--------------	------------

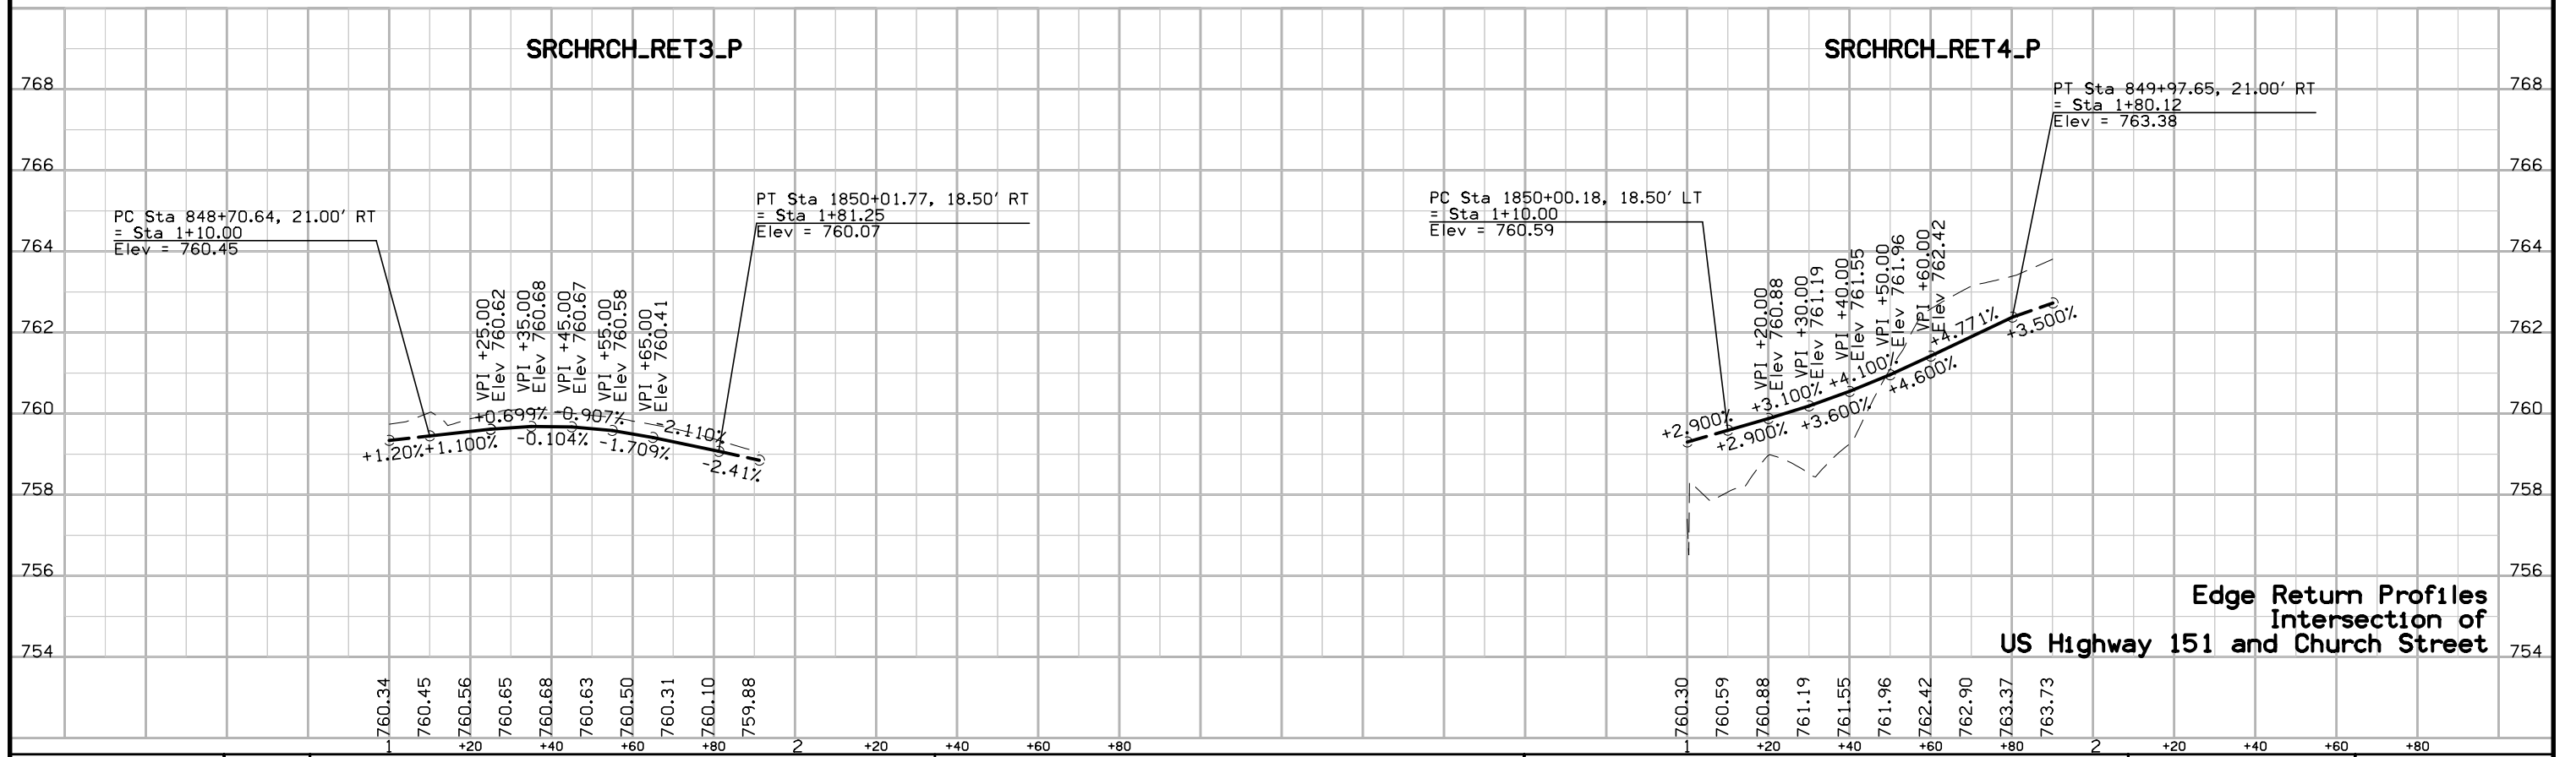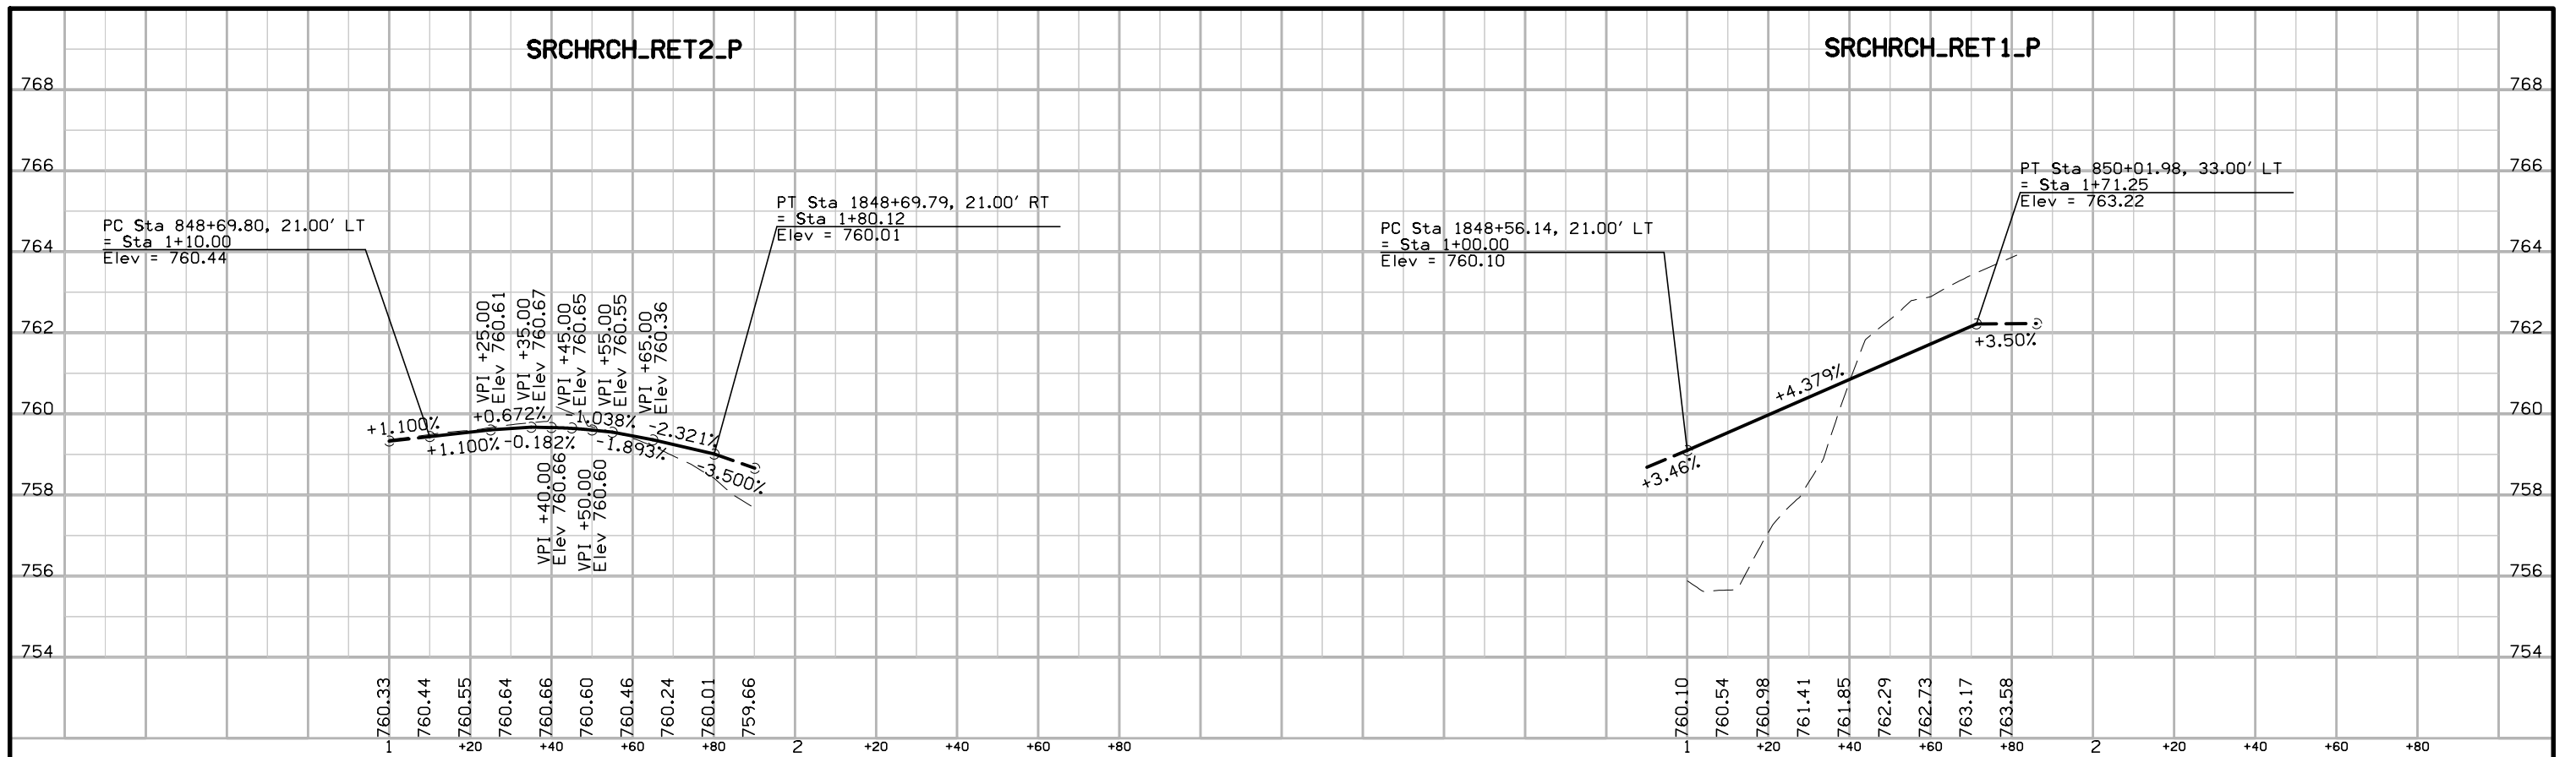

Edge Return Profiles
Intersection of
US Highway 151 and Church Street

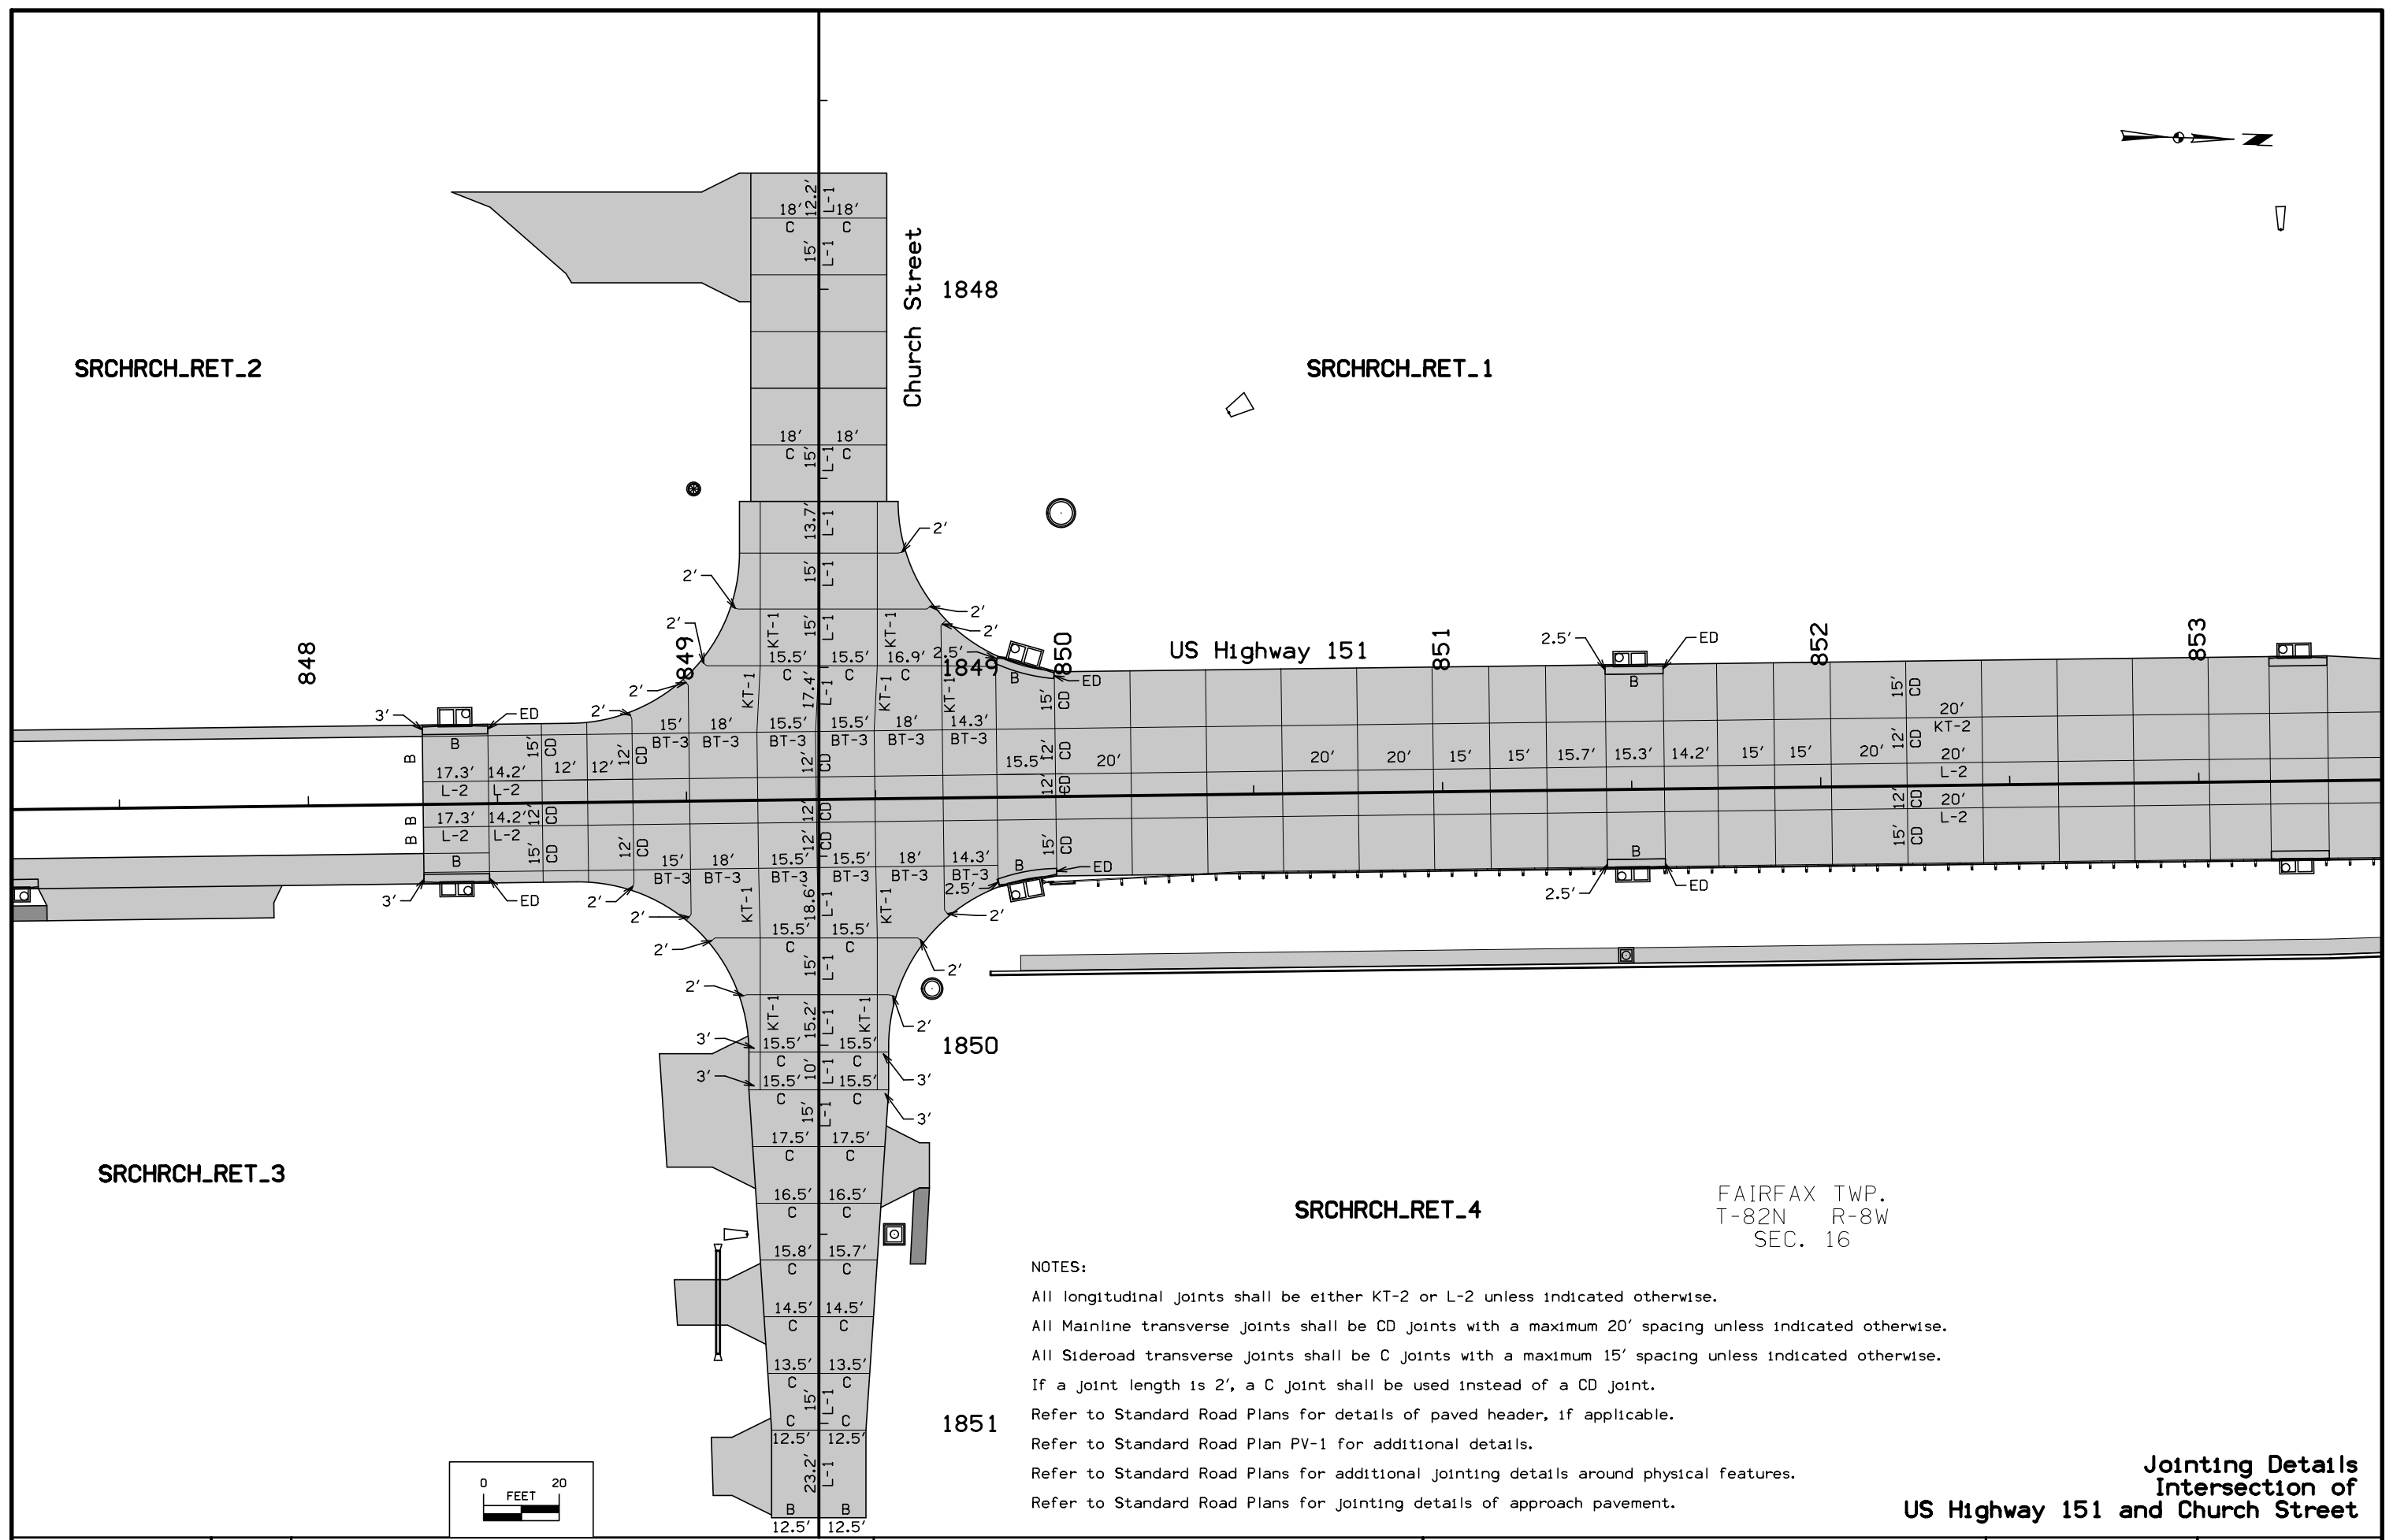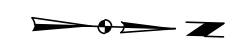

SRCHRCH_RET_2

SRCHRCH_RET_1

SRCHRCH_RET_3


SRCHRCH_RET_4

FAIRFAX TWP.
T-82N R-8W
SEC. 16

NOTES:


- All longitudinal joints shall be either KT-2 or L-2 unless indicated otherwise.
- All Mainline transverse joints shall be CD joints with a maximum 20' spacing unless indicated otherwise.
- All Sideroad transverse joints shall be C joints with a maximum 15' spacing unless indicated otherwise.
- If a joint length is 2', a C joint shall be used instead of a CD joint.
- Refer to Standard Road Plans for details of paved header, if applicable.
- Refer to Standard Road Plan PV-1 for additional details.
- Refer to Standard Road Plans for additional jointing details around physical features.
- Refer to Standard Road Plans for jointing details of approach pavement.

Jointing Details
Intersection of
US Highway 151 and Church Street

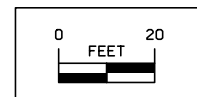


FAIRFAX TWP.
T-82N R-8W
SEC. 16

FAIRFAX TWP.
T-82N R-8W
SEC. 9

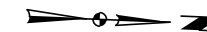


Union Pacific Railroad

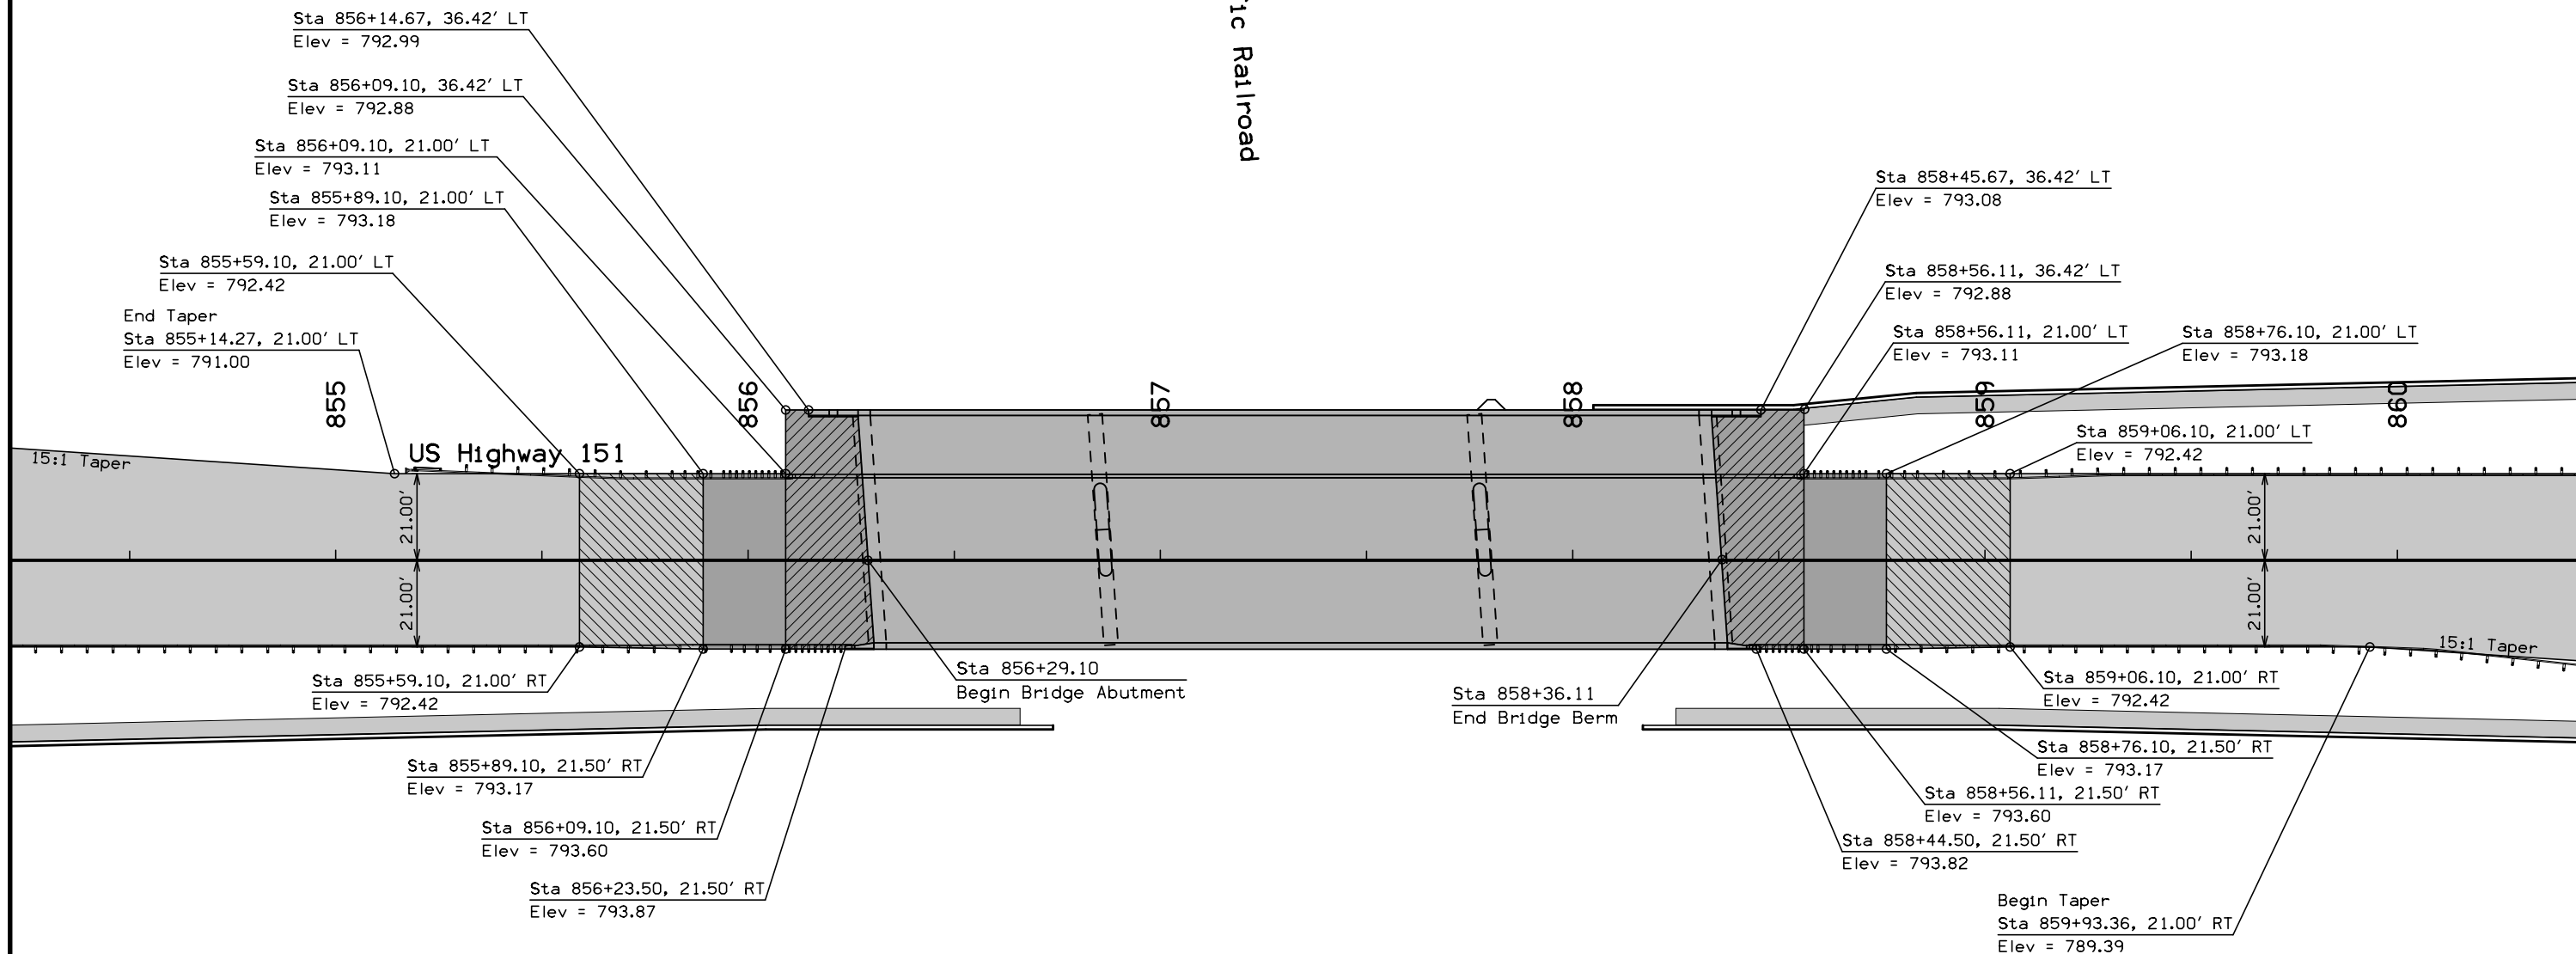

Notes:
Follow Standard Road Plan BR-203 For
Bridge Approach Pavement


Refer to G sheets for horizontal alignment
information.

- Legend
- Unreinforced Section
 - Single Reinforced Section
 - Double Reinforced Section

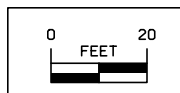


**Geometric Details
Union Pacific Railroad Bridge**

CIRCULAR CURVE DATA						
Name	Δ	D	T	L	E	R
CURVE SRPRAIR_RET_1-1	67° 24' 00.13"	91° 40' 23.69"	41.68'	73.68'	12.62'	62.5'
CURVE SRPRAIR_RET_1-2	67° 24' 00.13"	143° 14' 22.02"	26.68'	47.05'	8.08'	40'
CURVE SRPRAIR_RET_2-1	105° 28' 54.30"	21° 58' 18.71"	19.72'	27.62'	9.78'	15'
CURVE SRPRAIR_RET_2-2	53° 28' 43.61"	152° 47' 19.48"	18.89'	35.00'	4.49'	37.5'
CURVE SRPRAIR_RET_4-1	90° 44' 25.39"	143° 14' 22.02"	40.52'	63.35'	16.94'	40'
CURVE SRLOSEY_RET_3-1	137° 31' 07.99"	212° 57' 29.06"	25.73'	24.00'	17.60'	10'
CURVE SRLOSEY_RET_3-2	42° 28' 52.01"	114° 35' 29.61"	19.43'	37.07'	3.64'	50'
CURVE SRLOSEY_RET_4-1	89° 15' 34.61"	229° 10' 59.22"	24.68'	38.95'	10.13'	25'
CURVE 1	72° 25' 14.37"	1145° 54' 56.12"	3.661'	6.319'	1.19'	5'
CURVE 2	88° 16' 07.09"	381° 58' 18.71"	14.55'	23.11'	5.89'	15'
CURVE 3	88° 16' 07.09"	1145° 54' 56.12"	4.85'	7.70'	1.96'	5'
CURVE 4	72° 25' 14.37"	381° 58' 18.71"	10.98'	18.96'	3.59'	15'



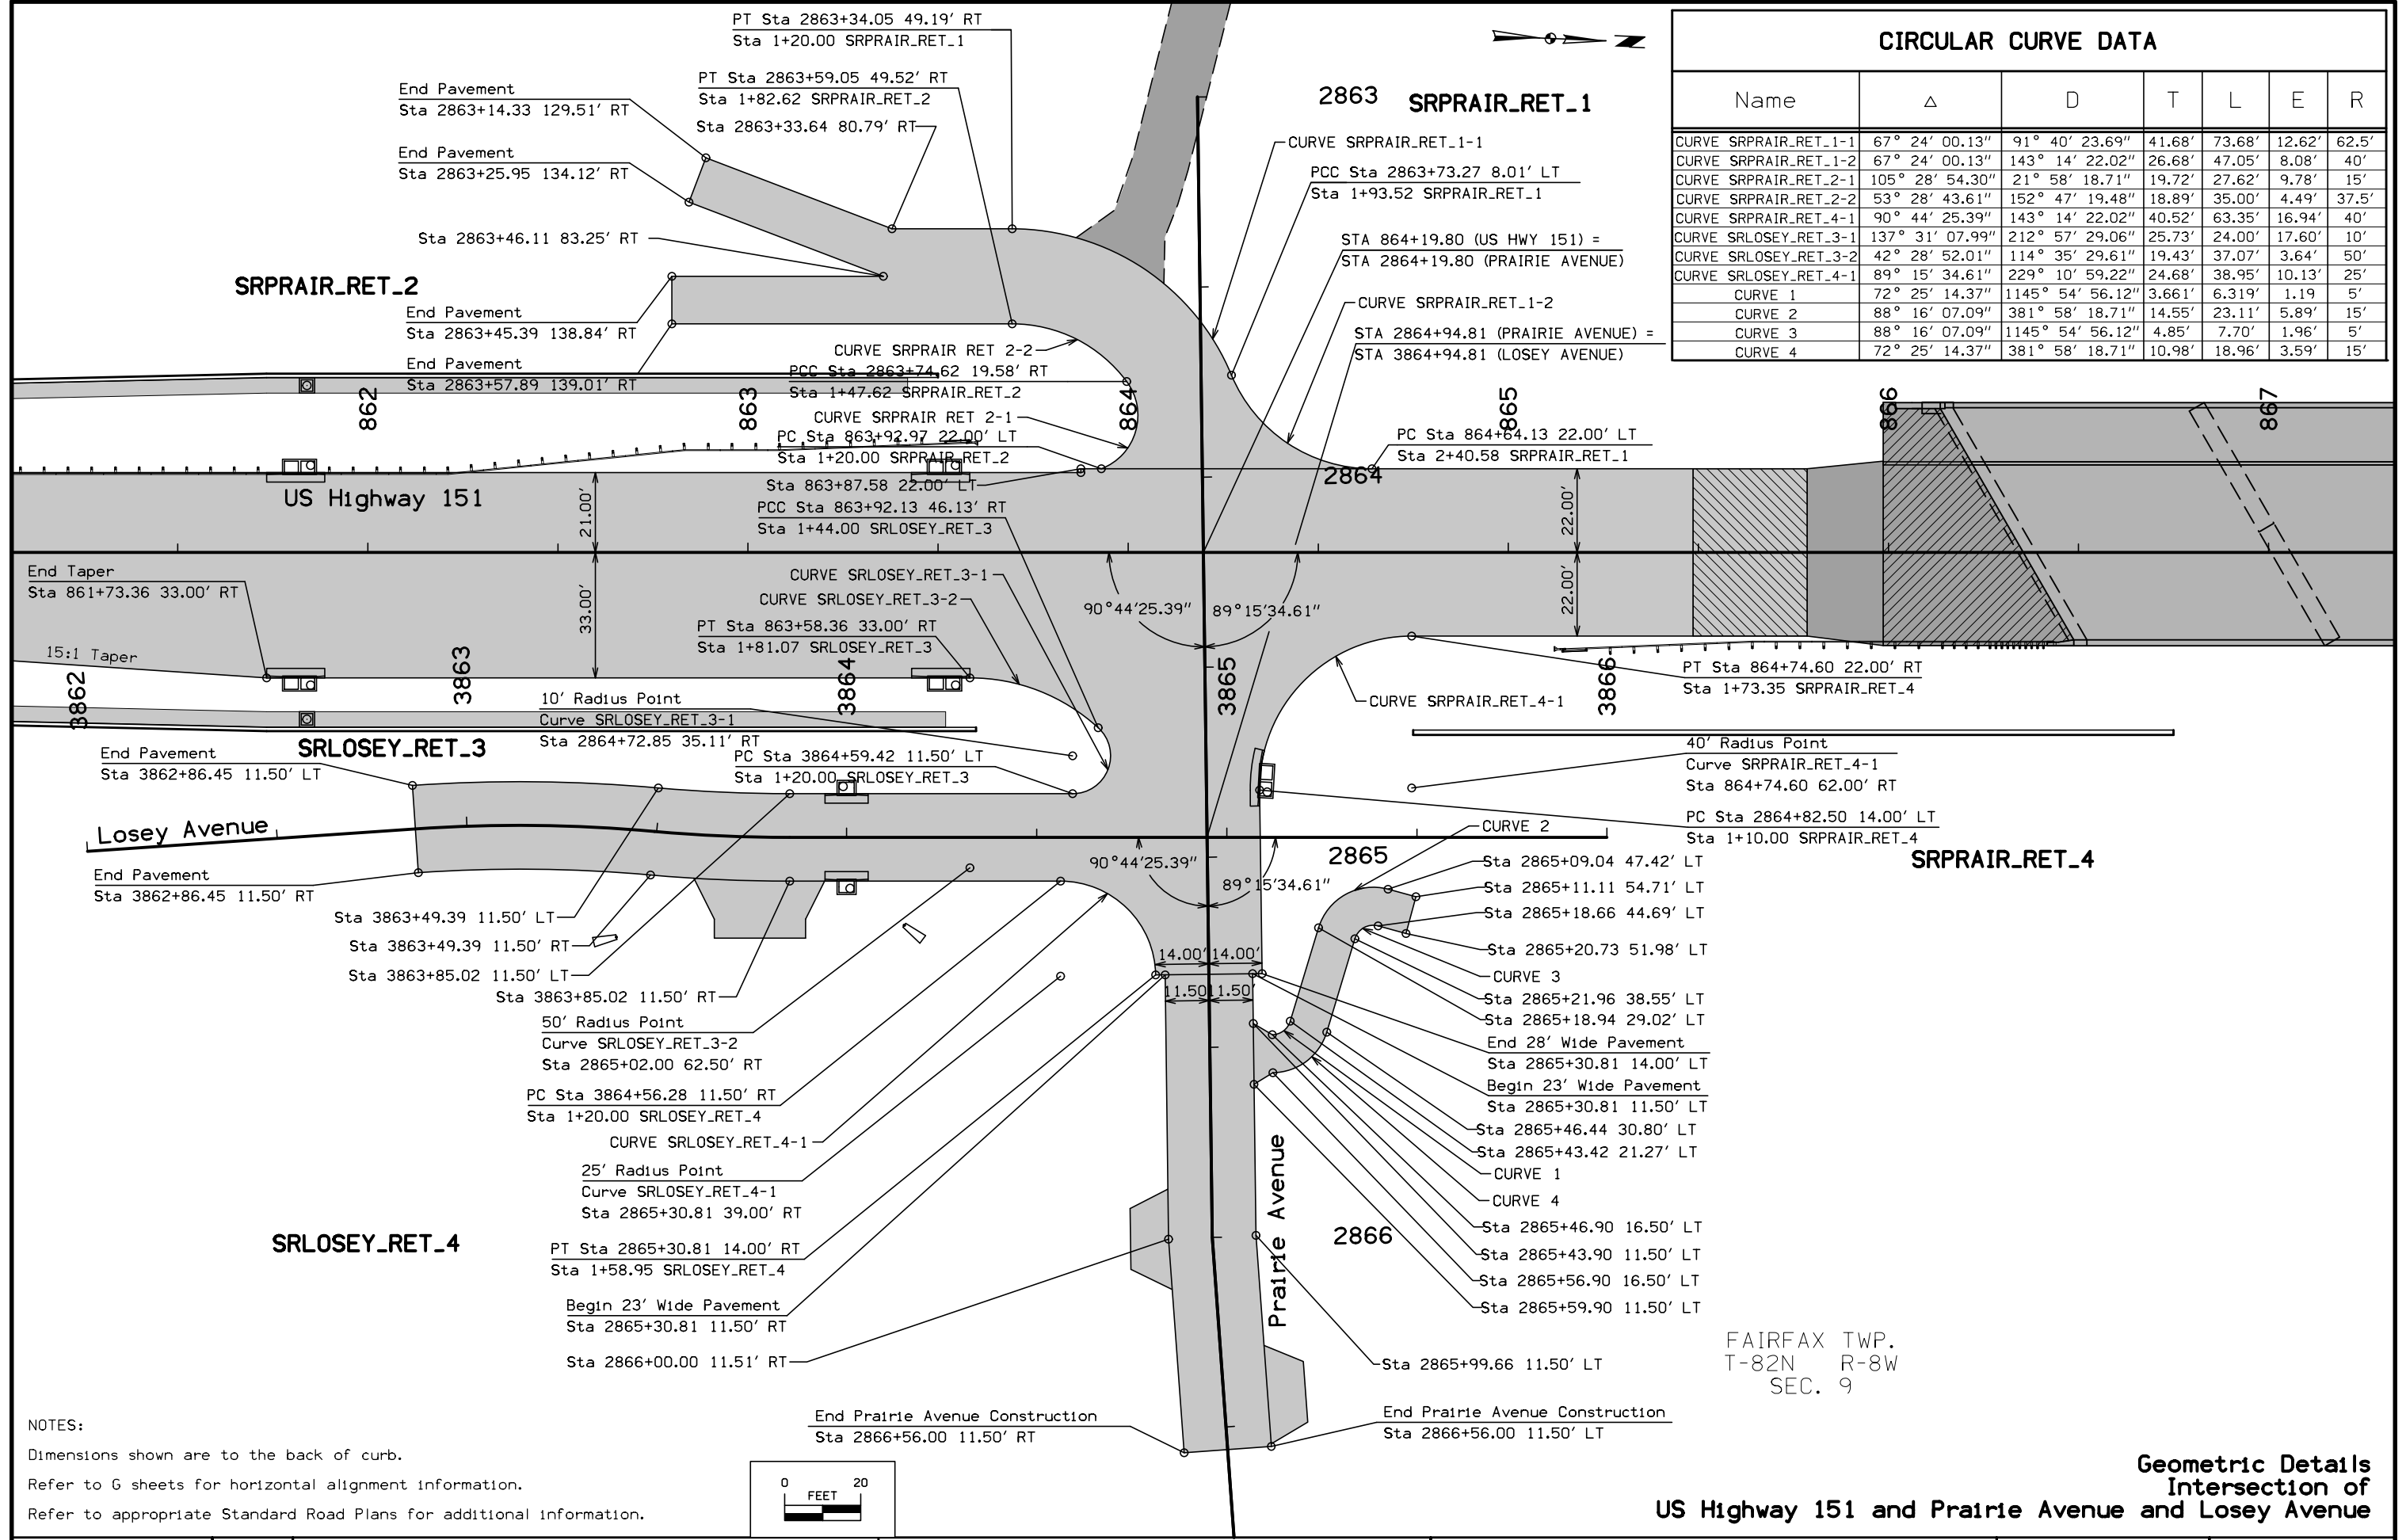


FAIRFAX TWP.
T-82N R-8W
SEC. 9

NOTES:
Dimensions shown are to the back of curb.
Refer to G sheets for horizontal alignment information.
Refer to appropriate Standard Road Plans for additional information.


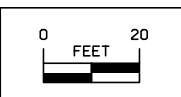


**Geometric Details
Intersection of
US Highway 151 and Prairie Avenue and Losey Avenue**

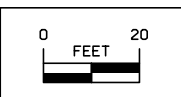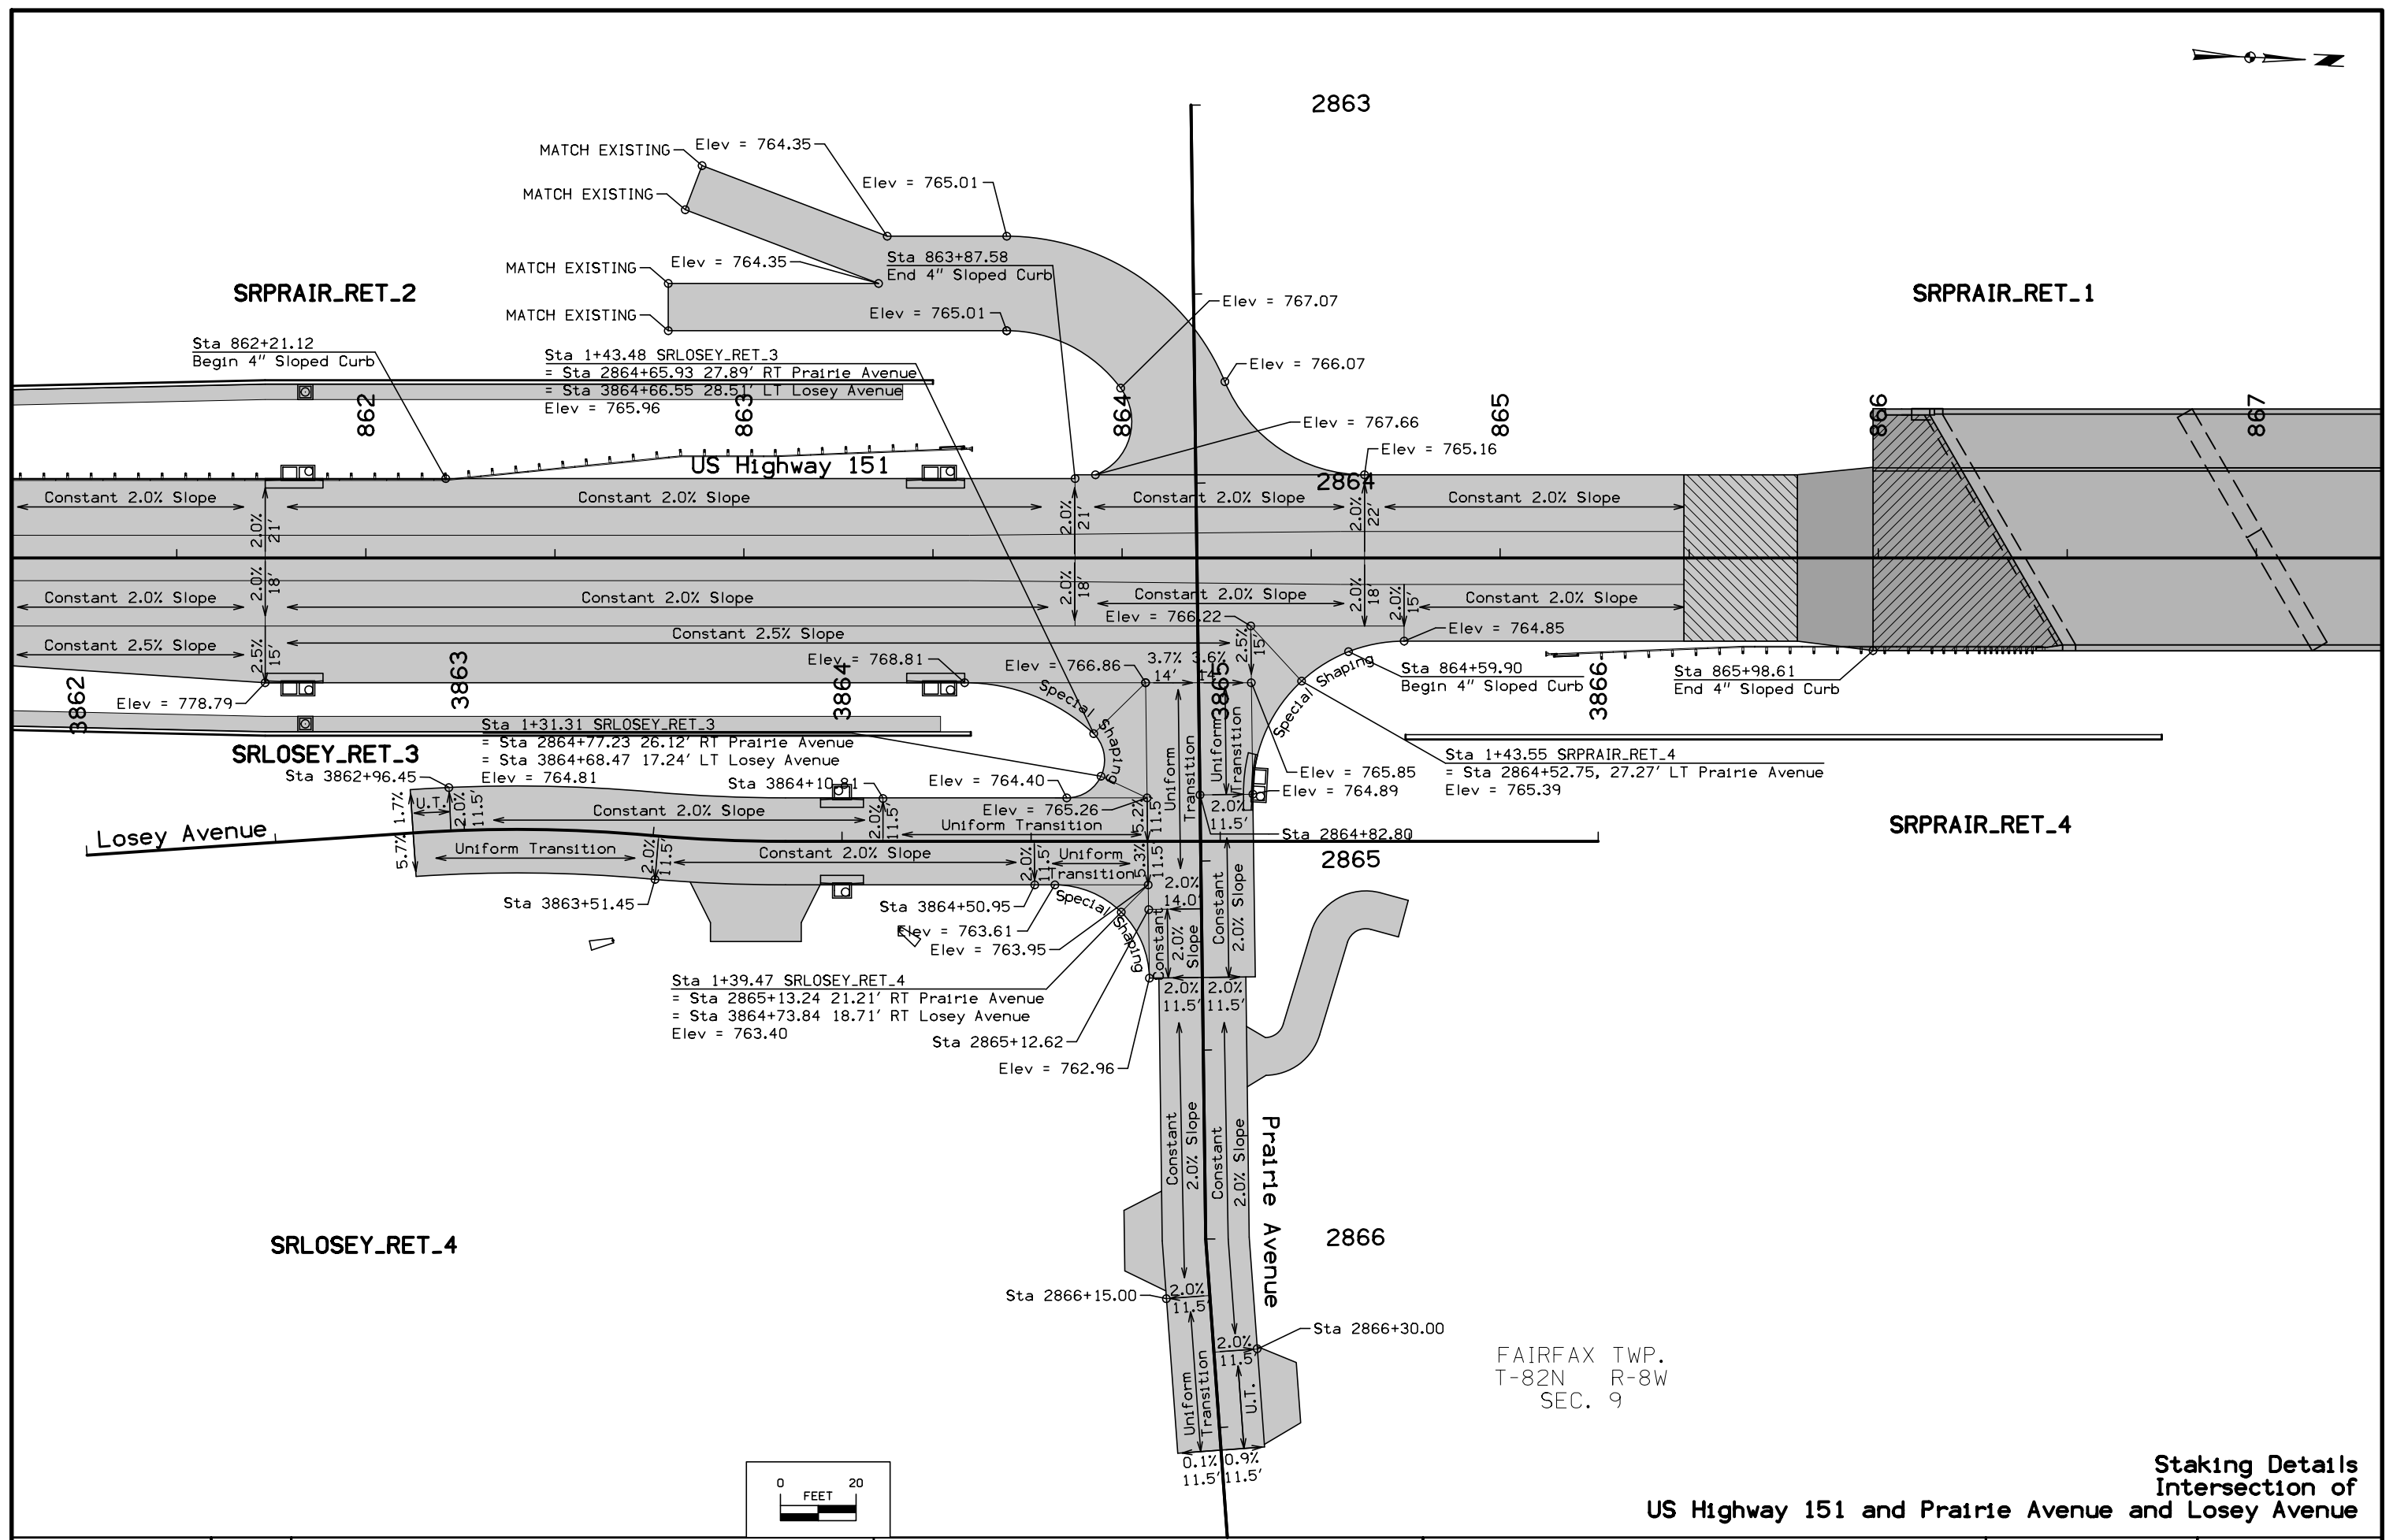
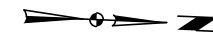


FAIRFAX TWP.
T-82N R-8W
SEC. 9



**Staking Details
Intersection of
US Highway 151 and Prairie Avenue and Losey Avenue**

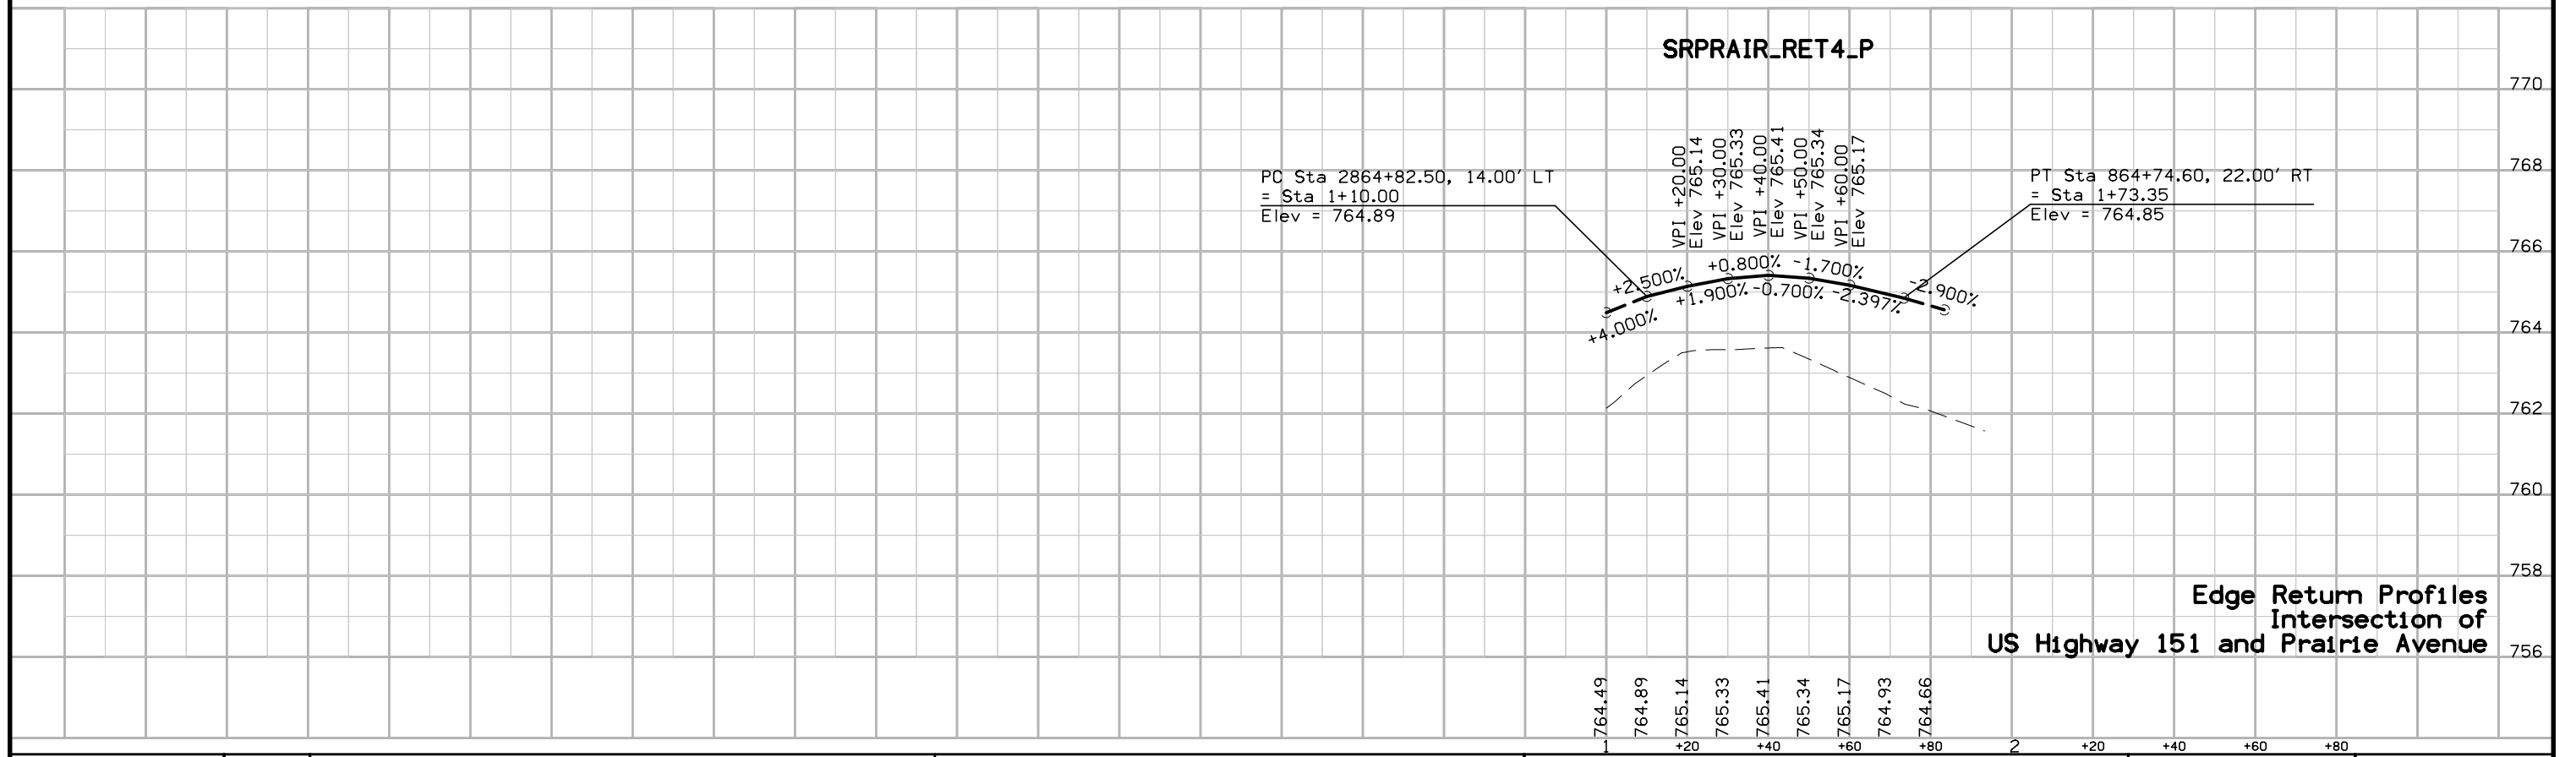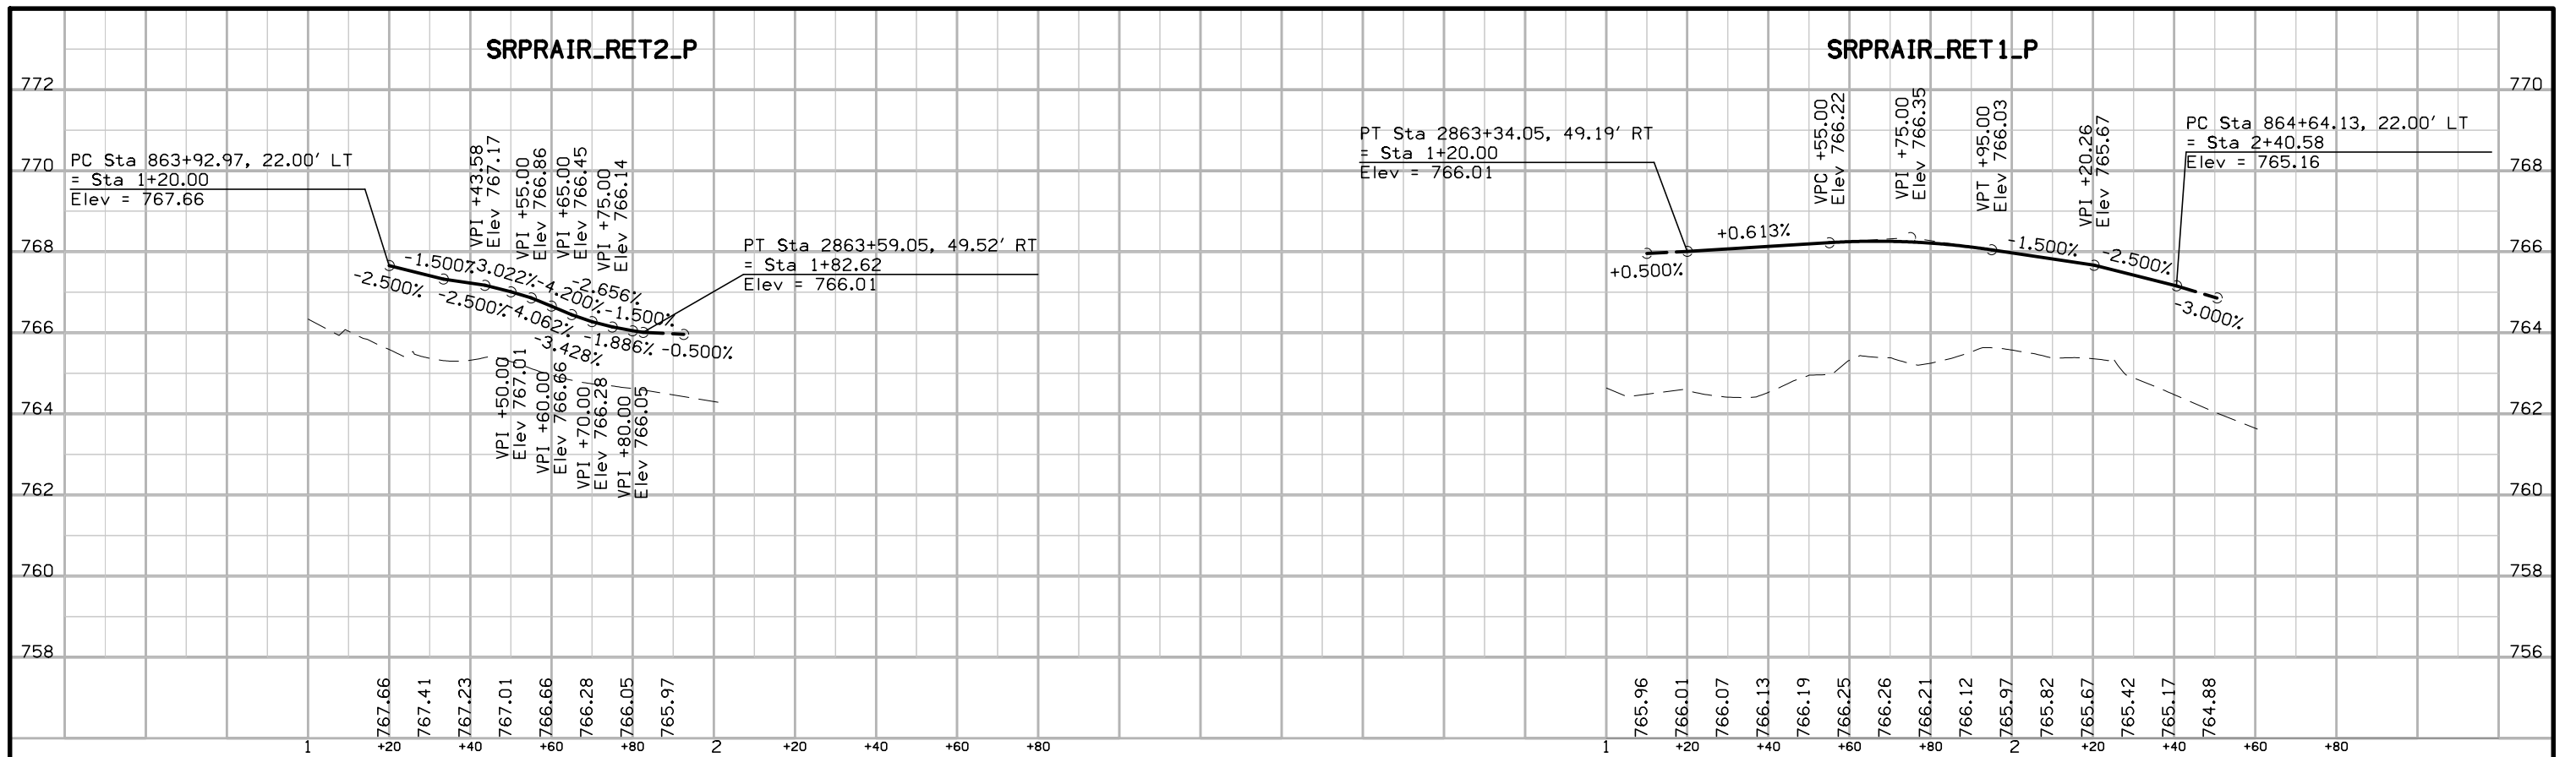

Edge Return Profiles
Intersection of
US Highway 151 and Prairie Avenue

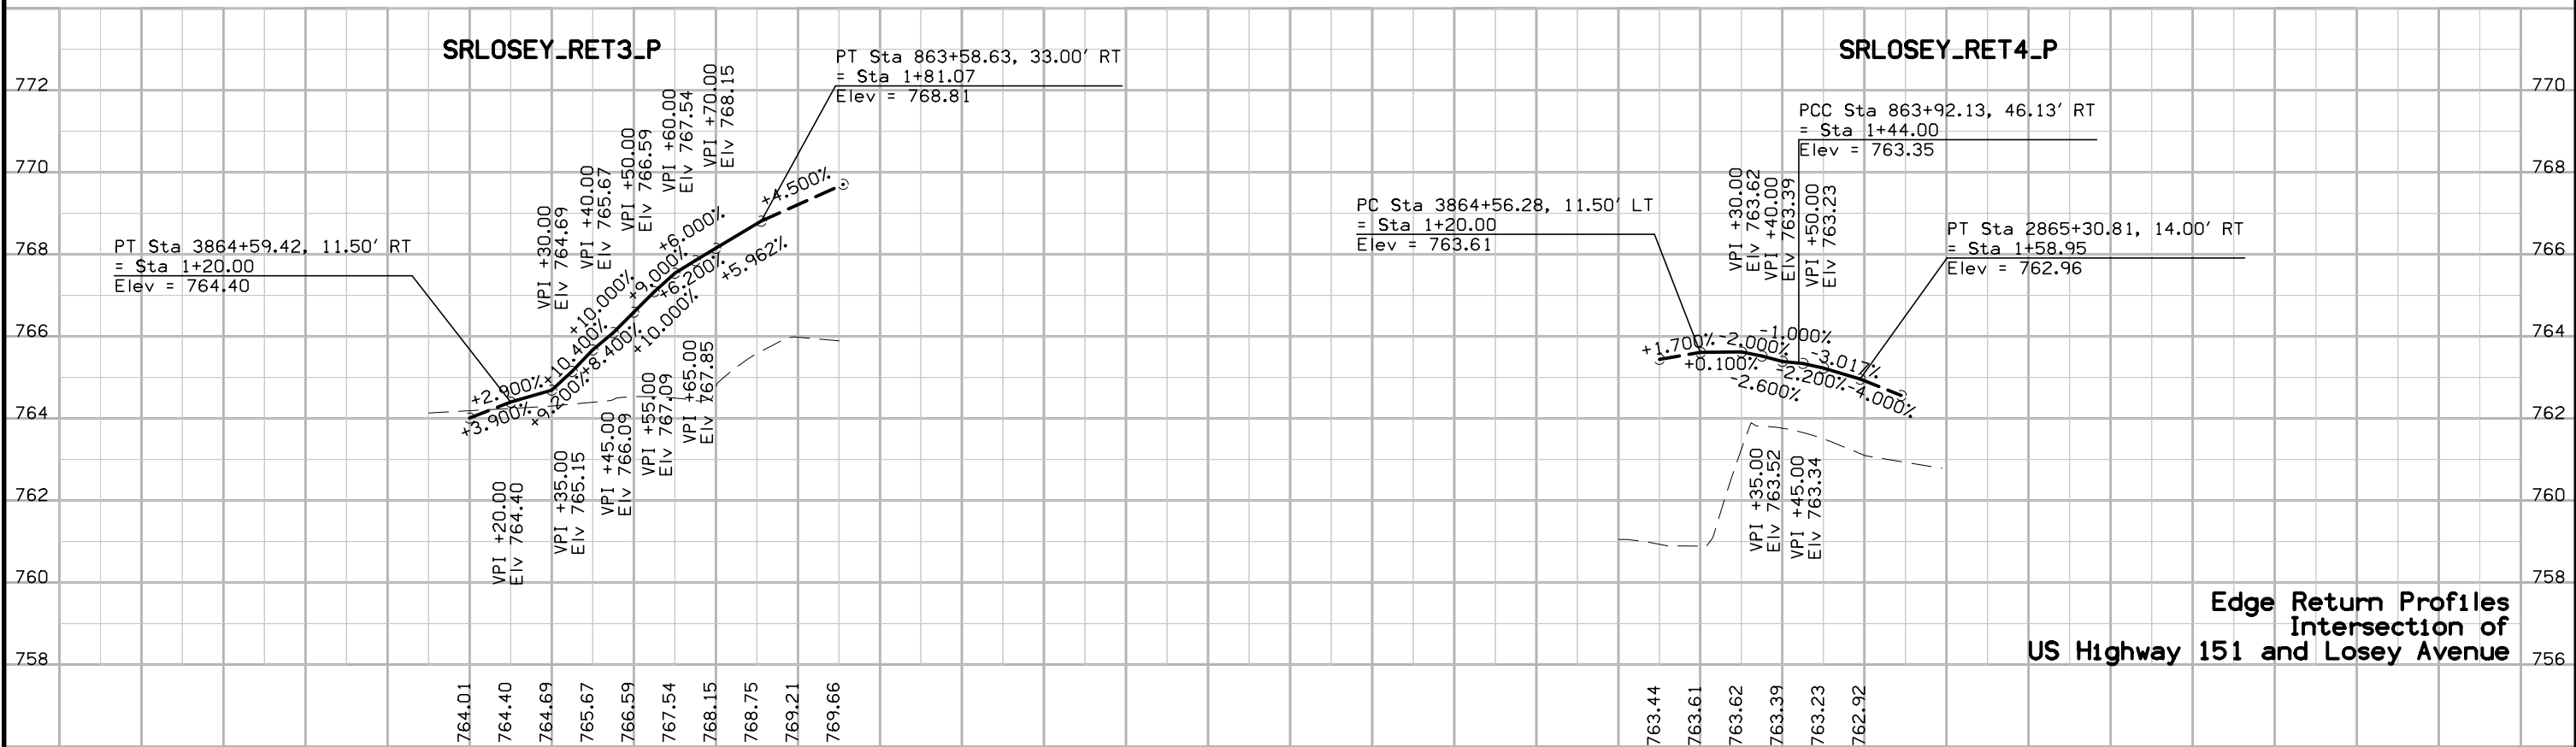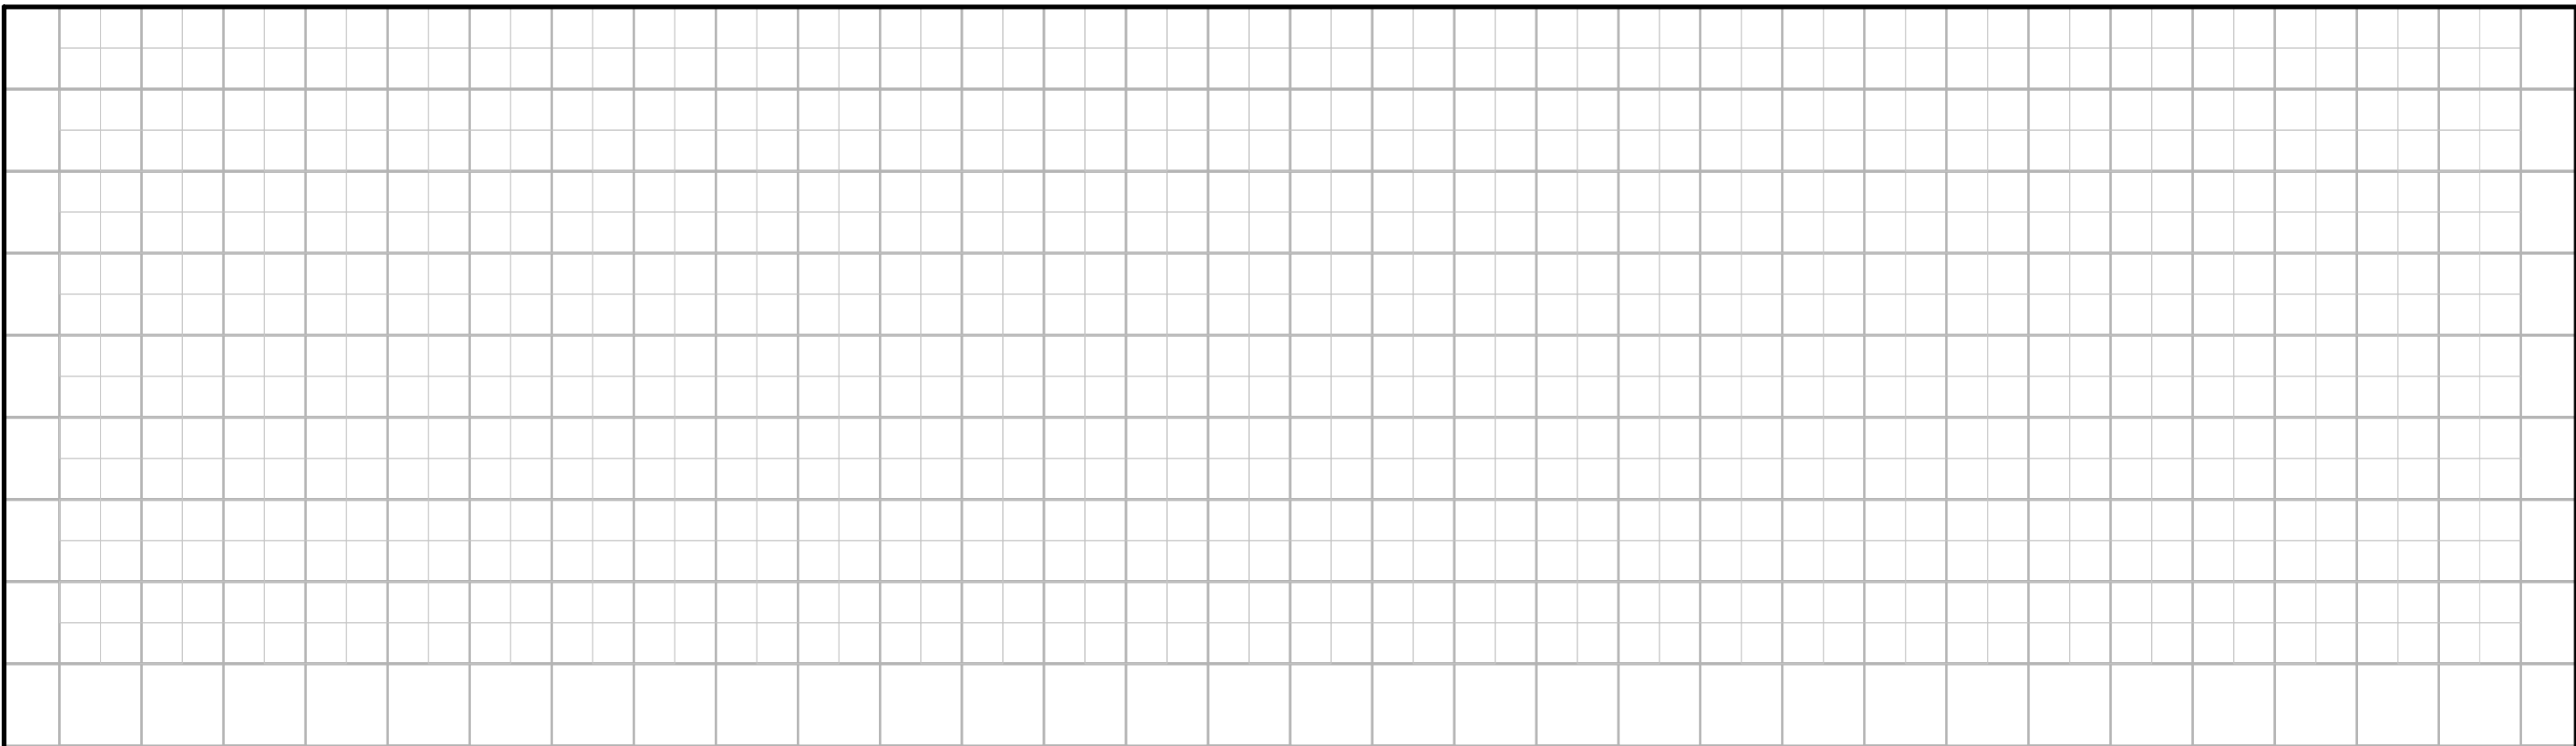

Edge Return Profiles
Intersection of
US Highway 151 and Losey Avenue

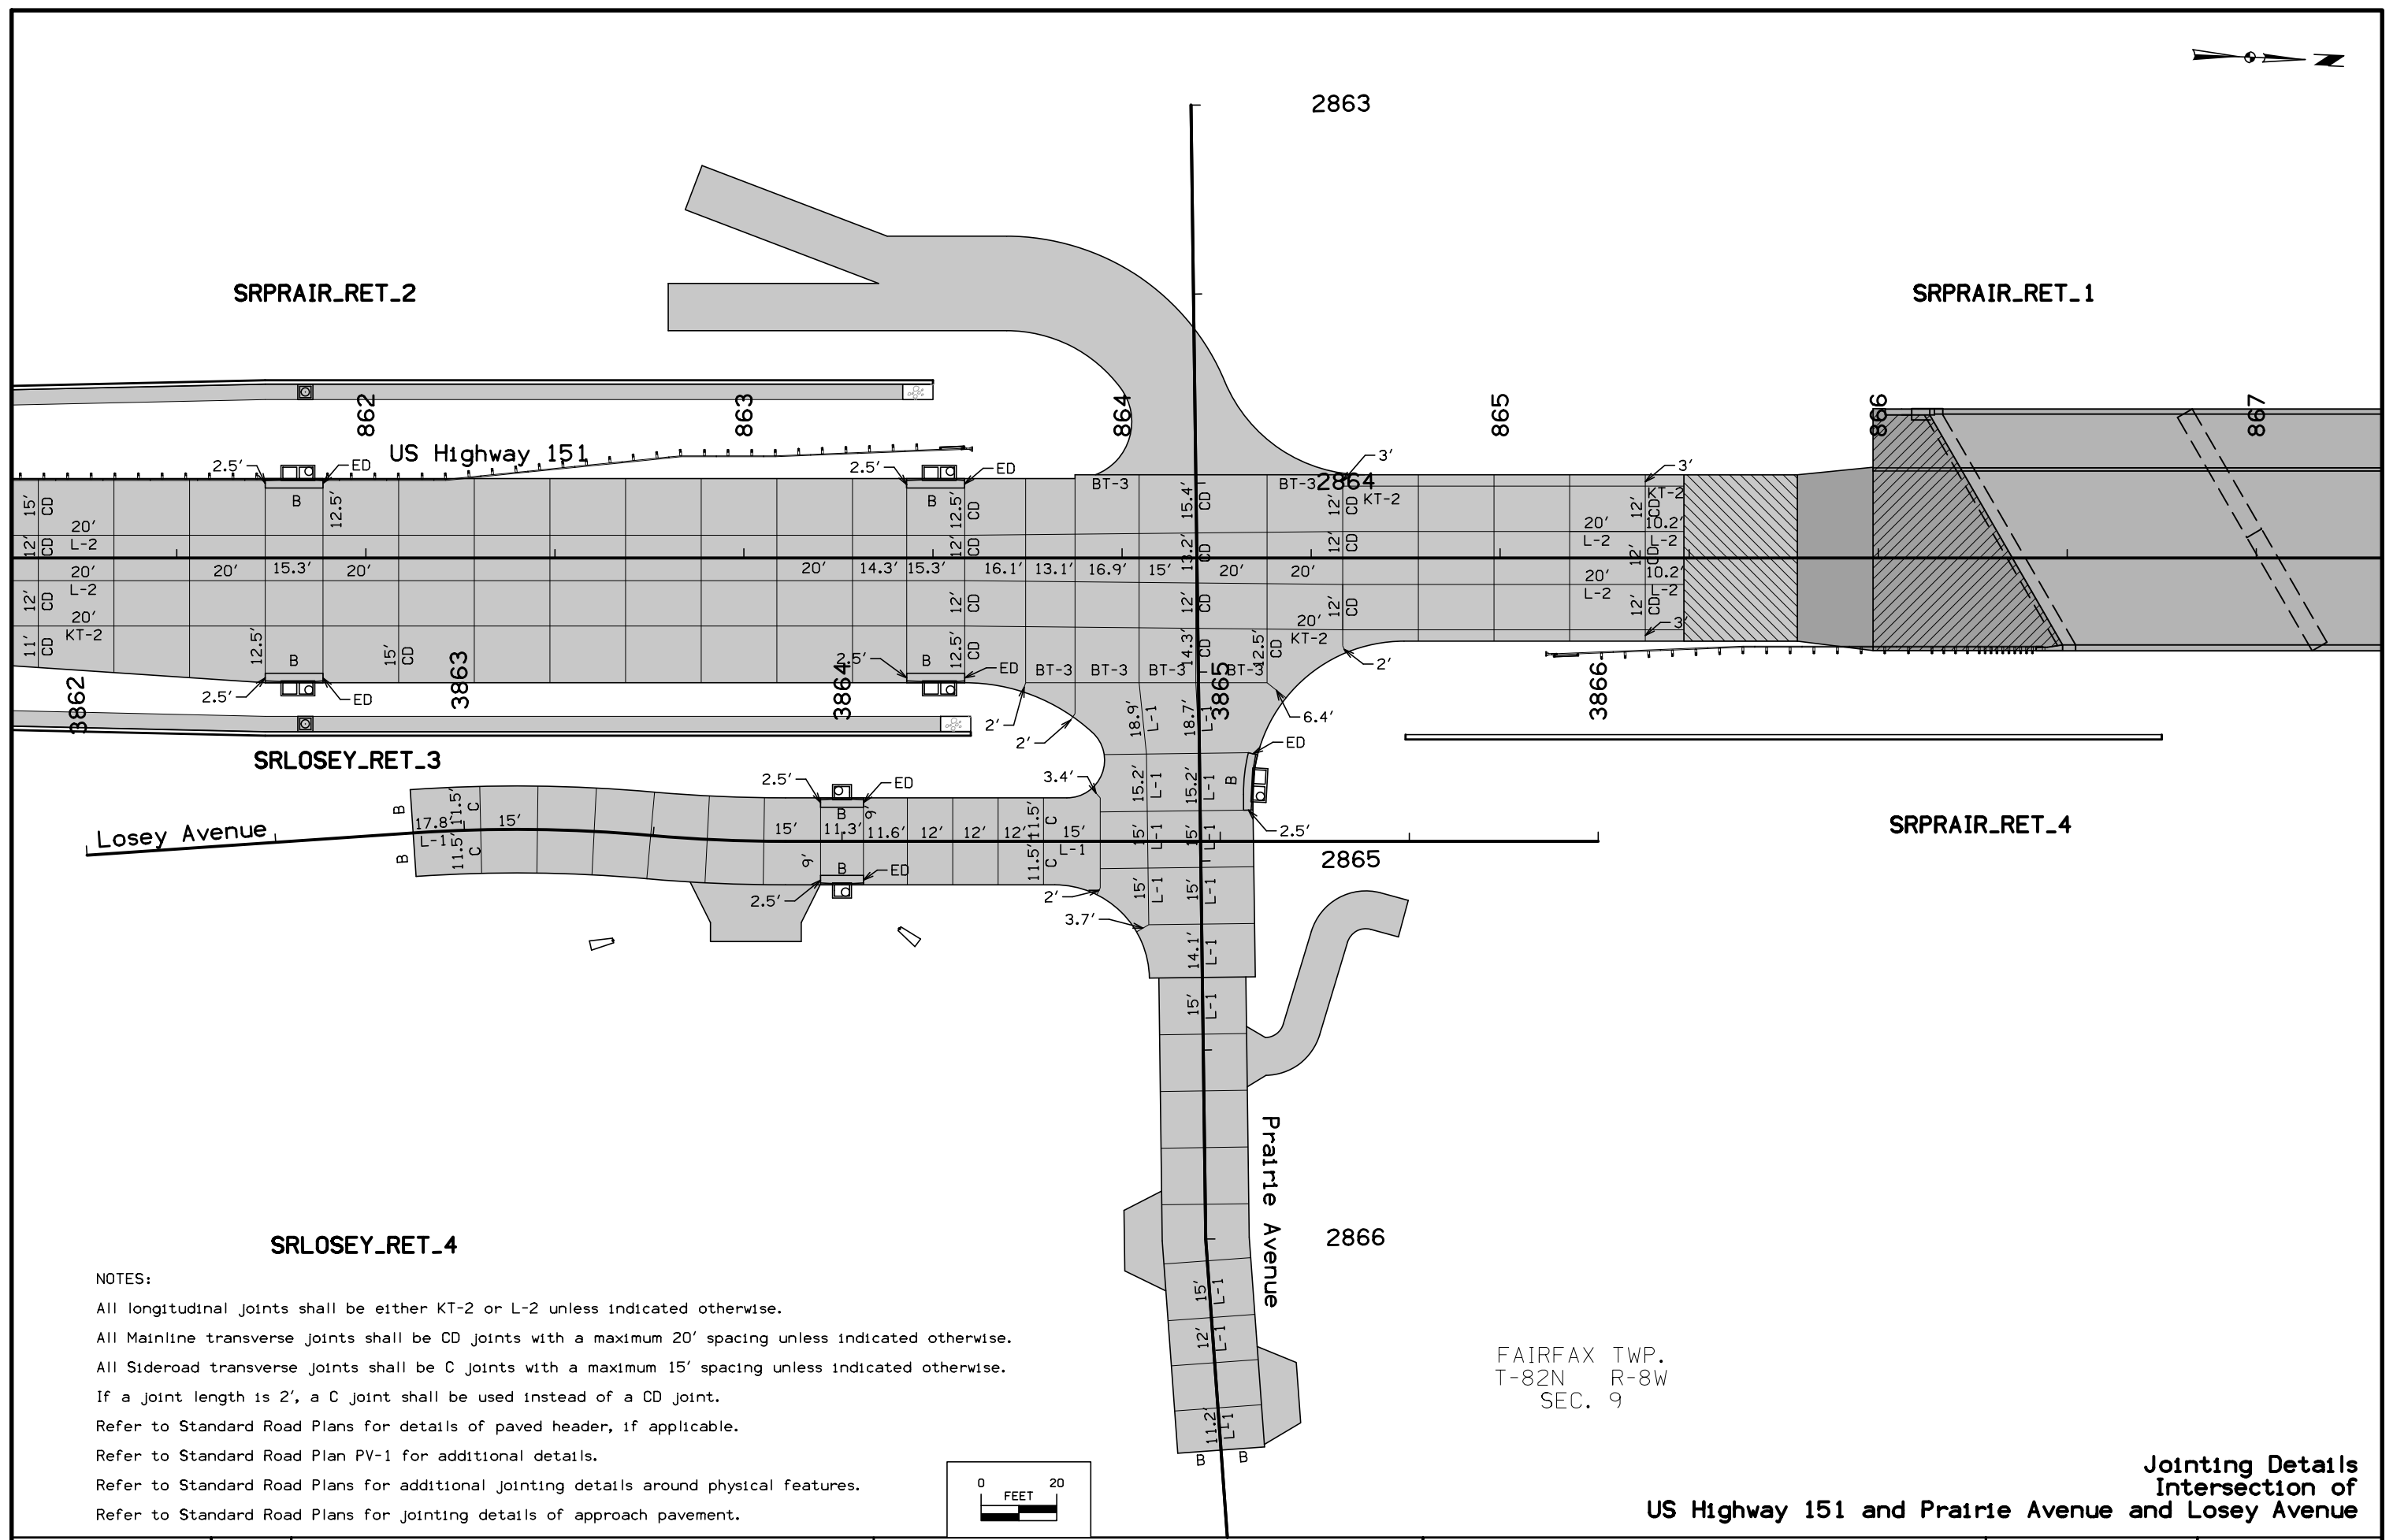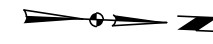

SRPRAIR_RET_2


SRPRAIR_RET_1

SRLOSEY_RET_3

SRPRAIR_RET_4


SRLOSEY_RET_4

- NOTES:
- All longitudinal joints shall be either KT-2 or L-2 unless indicated otherwise.
 - All Mainline transverse joints shall be CD joints with a maximum 20' spacing unless indicated otherwise.
 - All Sideroad transverse joints shall be C joints with a maximum 15' spacing unless indicated otherwise.
 - If a joint length is 2', a C joint shall be used instead of a CD joint.
 - Refer to Standard Road Plans for details of paved header, if applicable.
 - Refer to Standard Road Plan PV-1 for additional details.
 - Refer to Standard Road Plans for additional jointing details around physical features.
 - Refer to Standard Road Plans for jointing details of approach pavement.

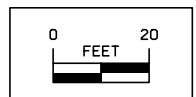


FAIRFAX TWP.
T-82N R-8W
SEC. 9

**Jointing Details
Intersection of
US Highway 151 and Prairie Avenue and Losey Avenue**

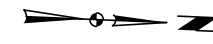


Prairie Creek

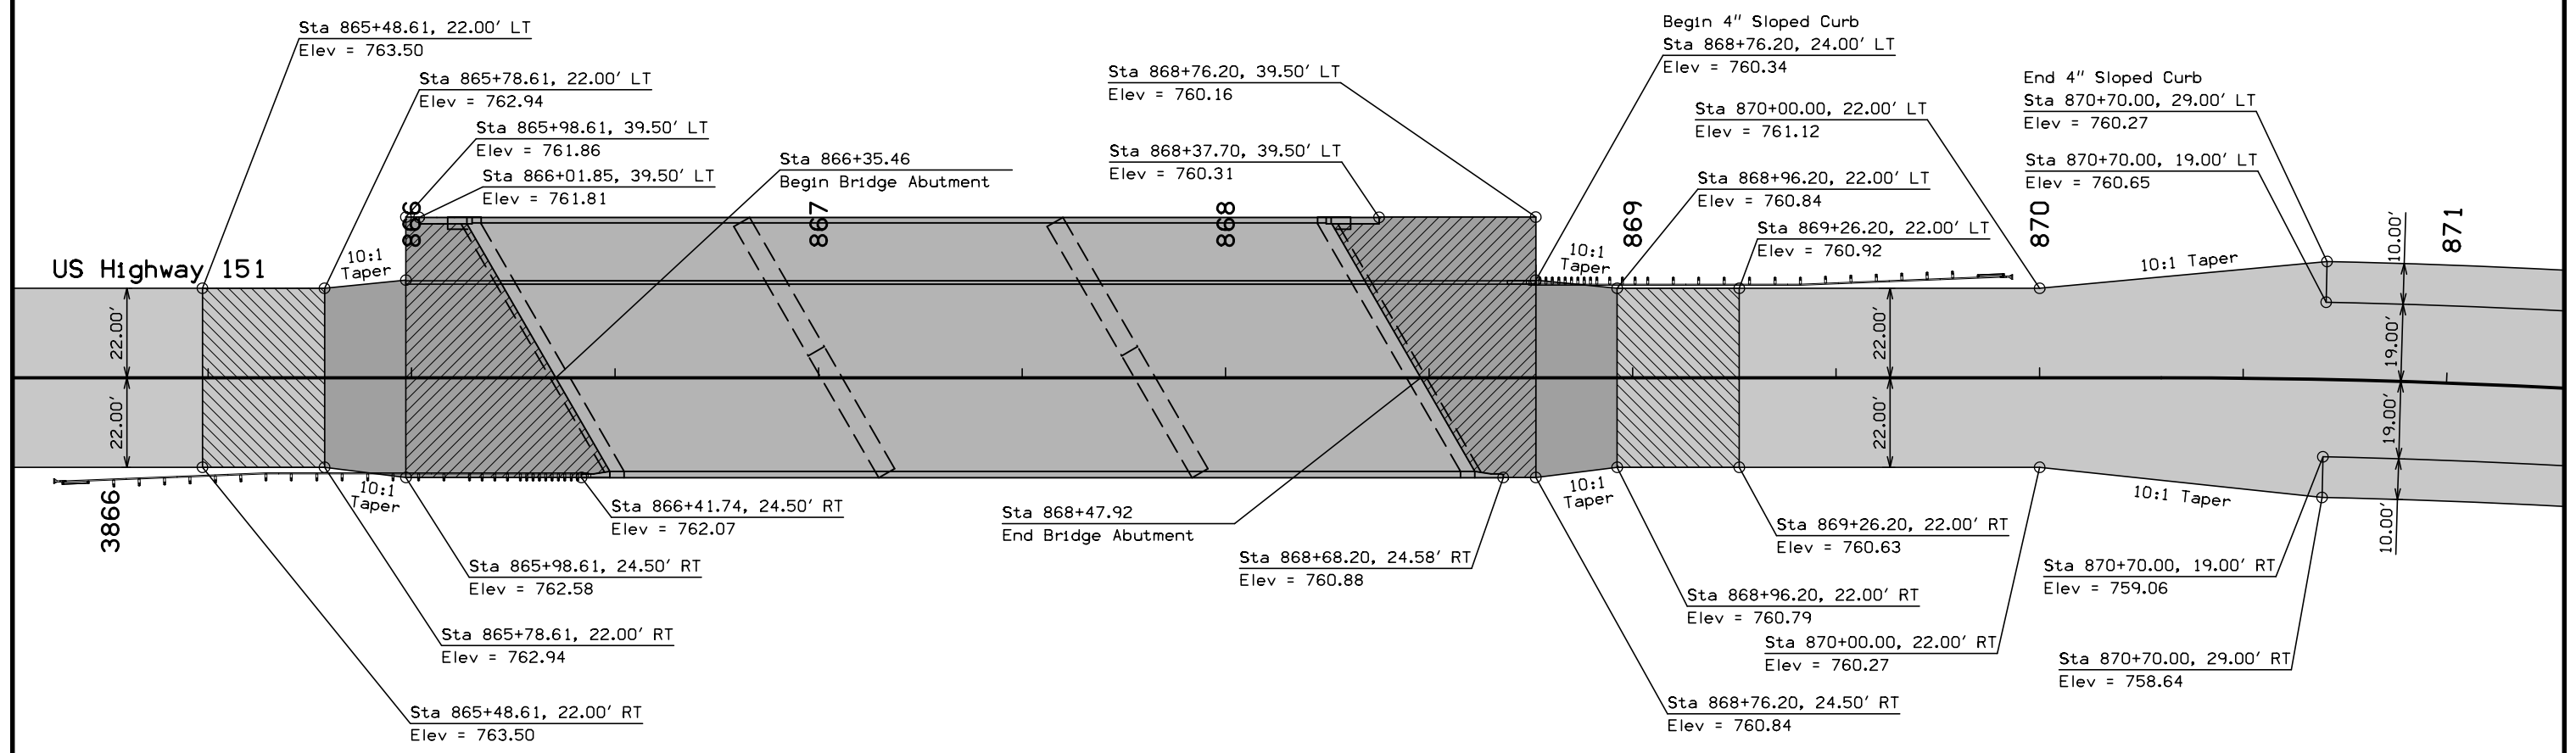

Notes:
 Follow Standard Road Plan BR-203 For Bridge Approach Pavement.
 Refer to G sheets for horizontal alignment information.


- Legend
- Unreinforced Section
 - Single Reinforced Section
 - Double Reinforced Section

FAIRFAX TWP.
 T-82N R-8W
 SEC. 9

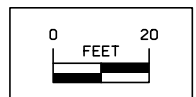


**Geometric Details
 Prairie Creek Bridge**

CIRCULAR CURVE DATA						
Name	Δ	D	T	L	E	R
CURVE SRSTLL_RET_1-1	26° 57' 38.81"	120° 37' 21.70"	11.39'	22.35'	1.35'	47.50'
CURVE SRSTLL_RET_1-2	134° 24' 50.55"	163° 42' 08.02"	83.29'	82.11'	55.35'	35.00'
CURVE SRSTLL_RET_2-3	77° 05' 10.18"	114° 35' 29.61"	39.83'	67.27'	13.93'	50.00'
CURVE SRSTLL_RET_2-4	61° 42' 02.18"	79° 01' 43.18"	43.31'	78.07'	11.95'	72.50'

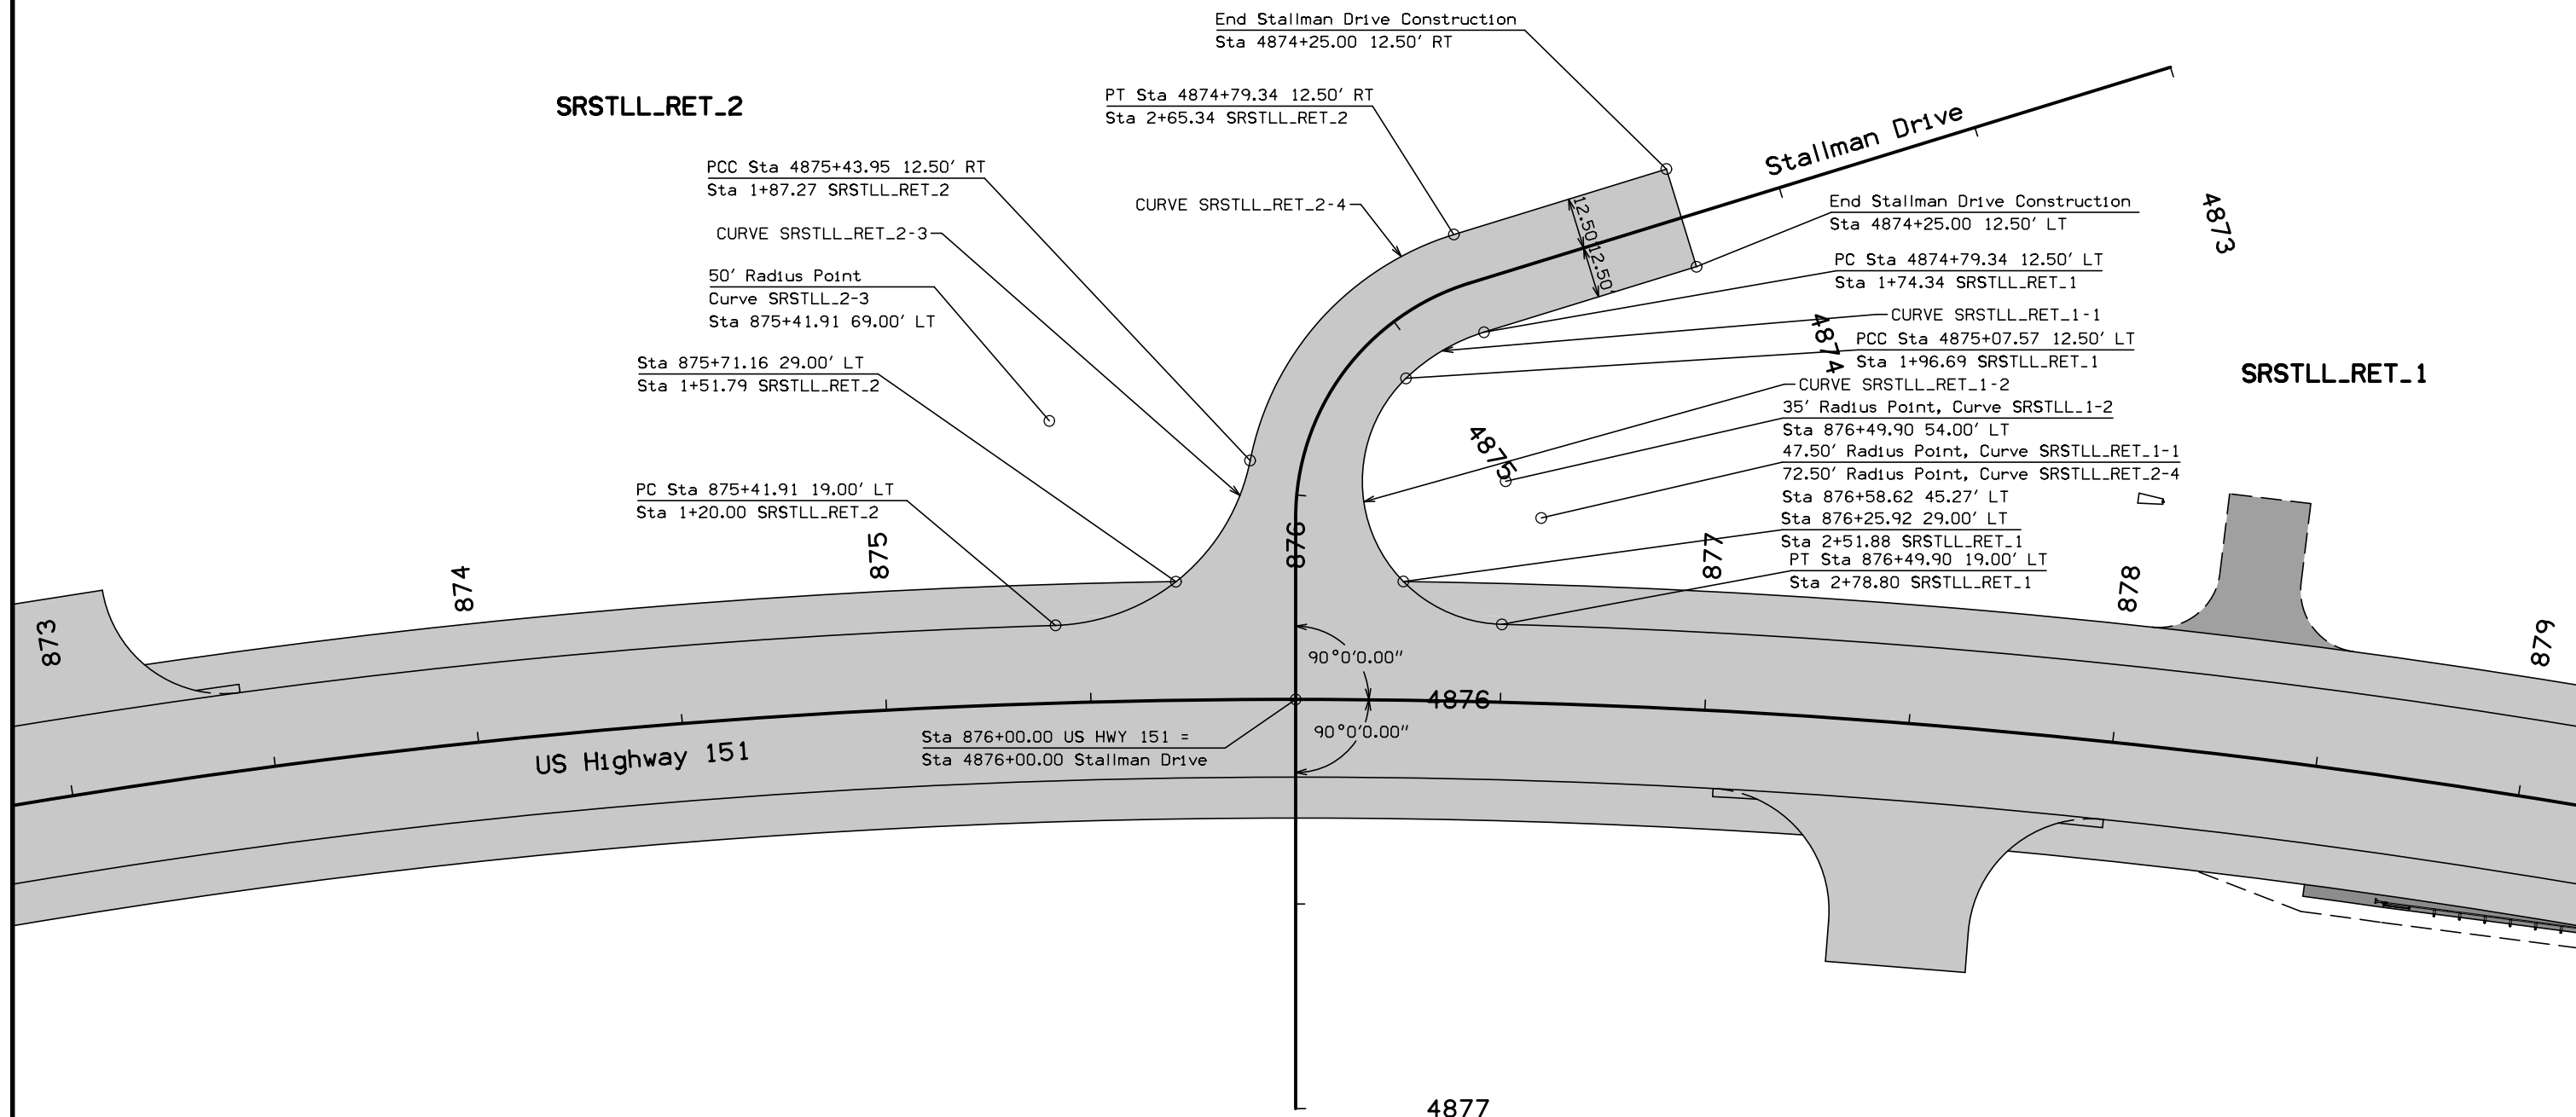

NOTES:
 Refer to G sheets for horizontal alignment information.
 Refer to appropriate Standard Road Plans for additional information.

FAIRFAX TWP.
 T-82N R-8W
 SEC. 9

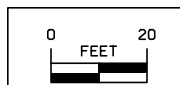

Geometric Details
 Intersection of
 US Highway 151 and Stallman Drive



SRSTLL_RET_2

Stallman Drive

4873

4874

SRSTLL_RET_1

Sta 1+57.00 SRSTLL_RET_2
= Sta 4875+67.79 25.36' RT Stallman Drive
Elev = 758.72

Sta 4875+46.00
Elev = 758.89

Sta 2+50.11 SRSTLL_RET_1
= Sta 4875+69.88 25.10' LT Stallman Drive
Elev = 759.09

873

874

US Highway 151

875

876

877


878

879

4876

4877


FAIRFAX TWP.
T-82N R-8W
SEC. 9

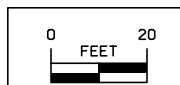


Staking Details
Intersection of
US Highway 151 and Stallman Drive

SRSTLL_RET2_P

SRSTLL_RET1_P

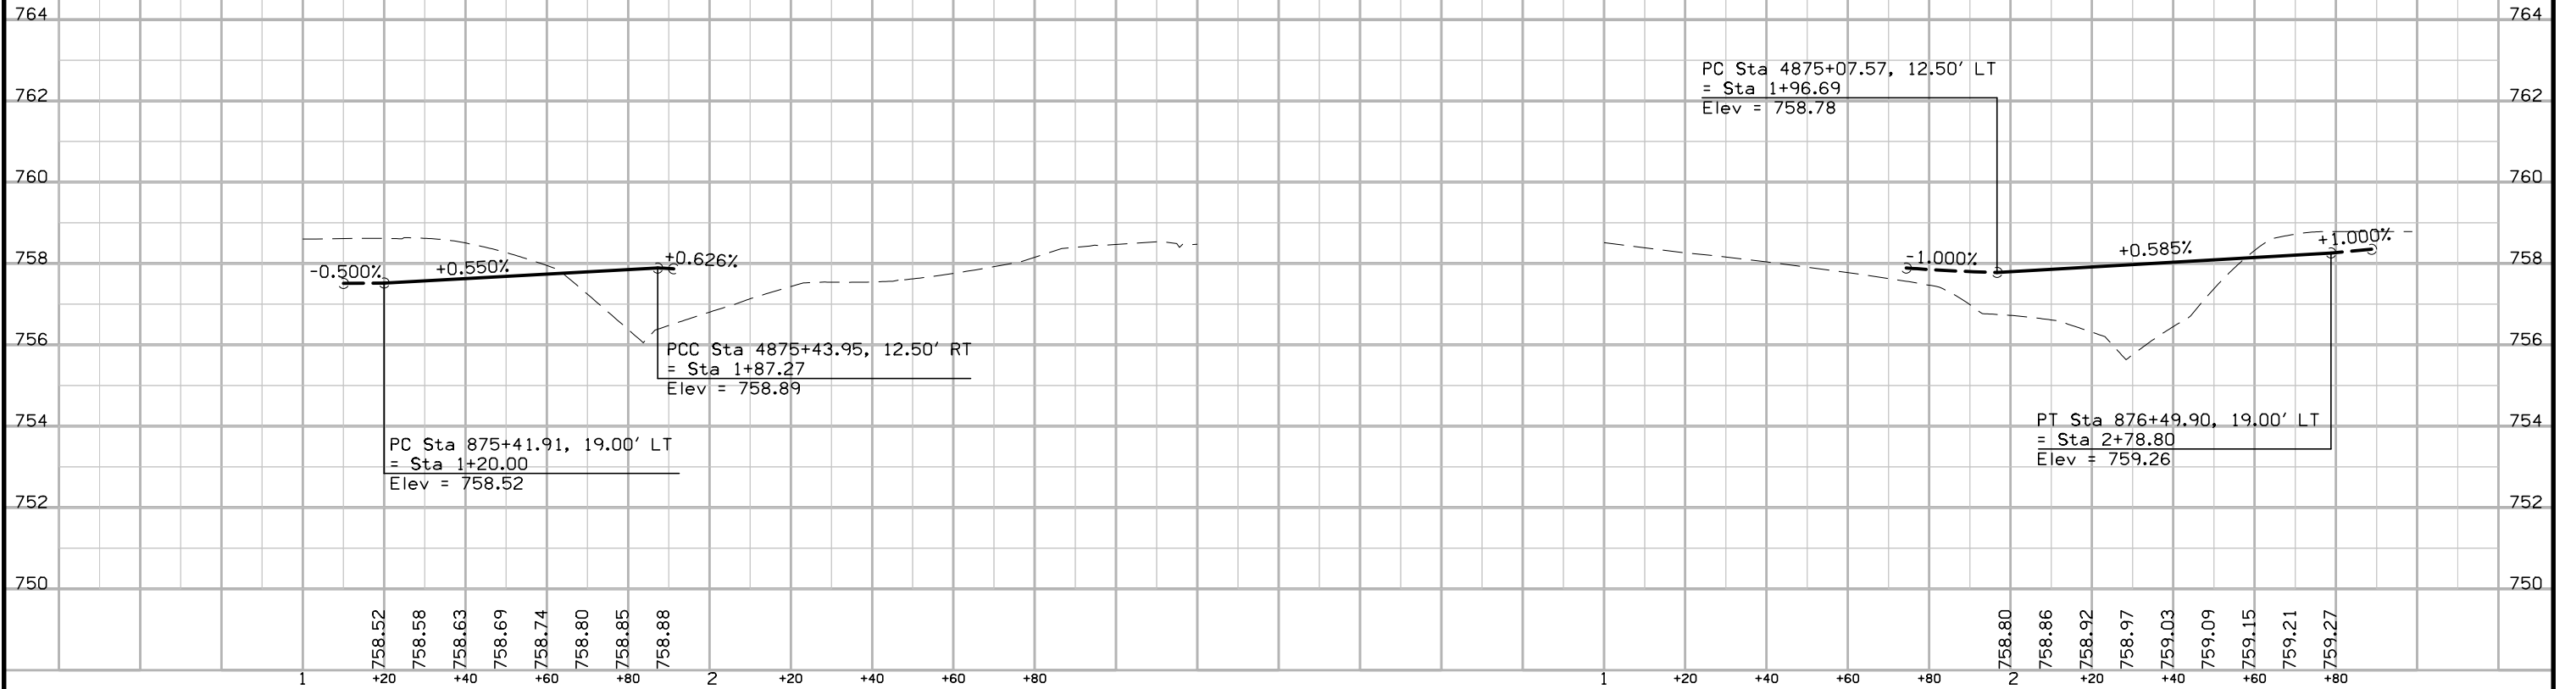


Edge Return Profiles
Intersection of
US Highway 151 and Stallman Drive

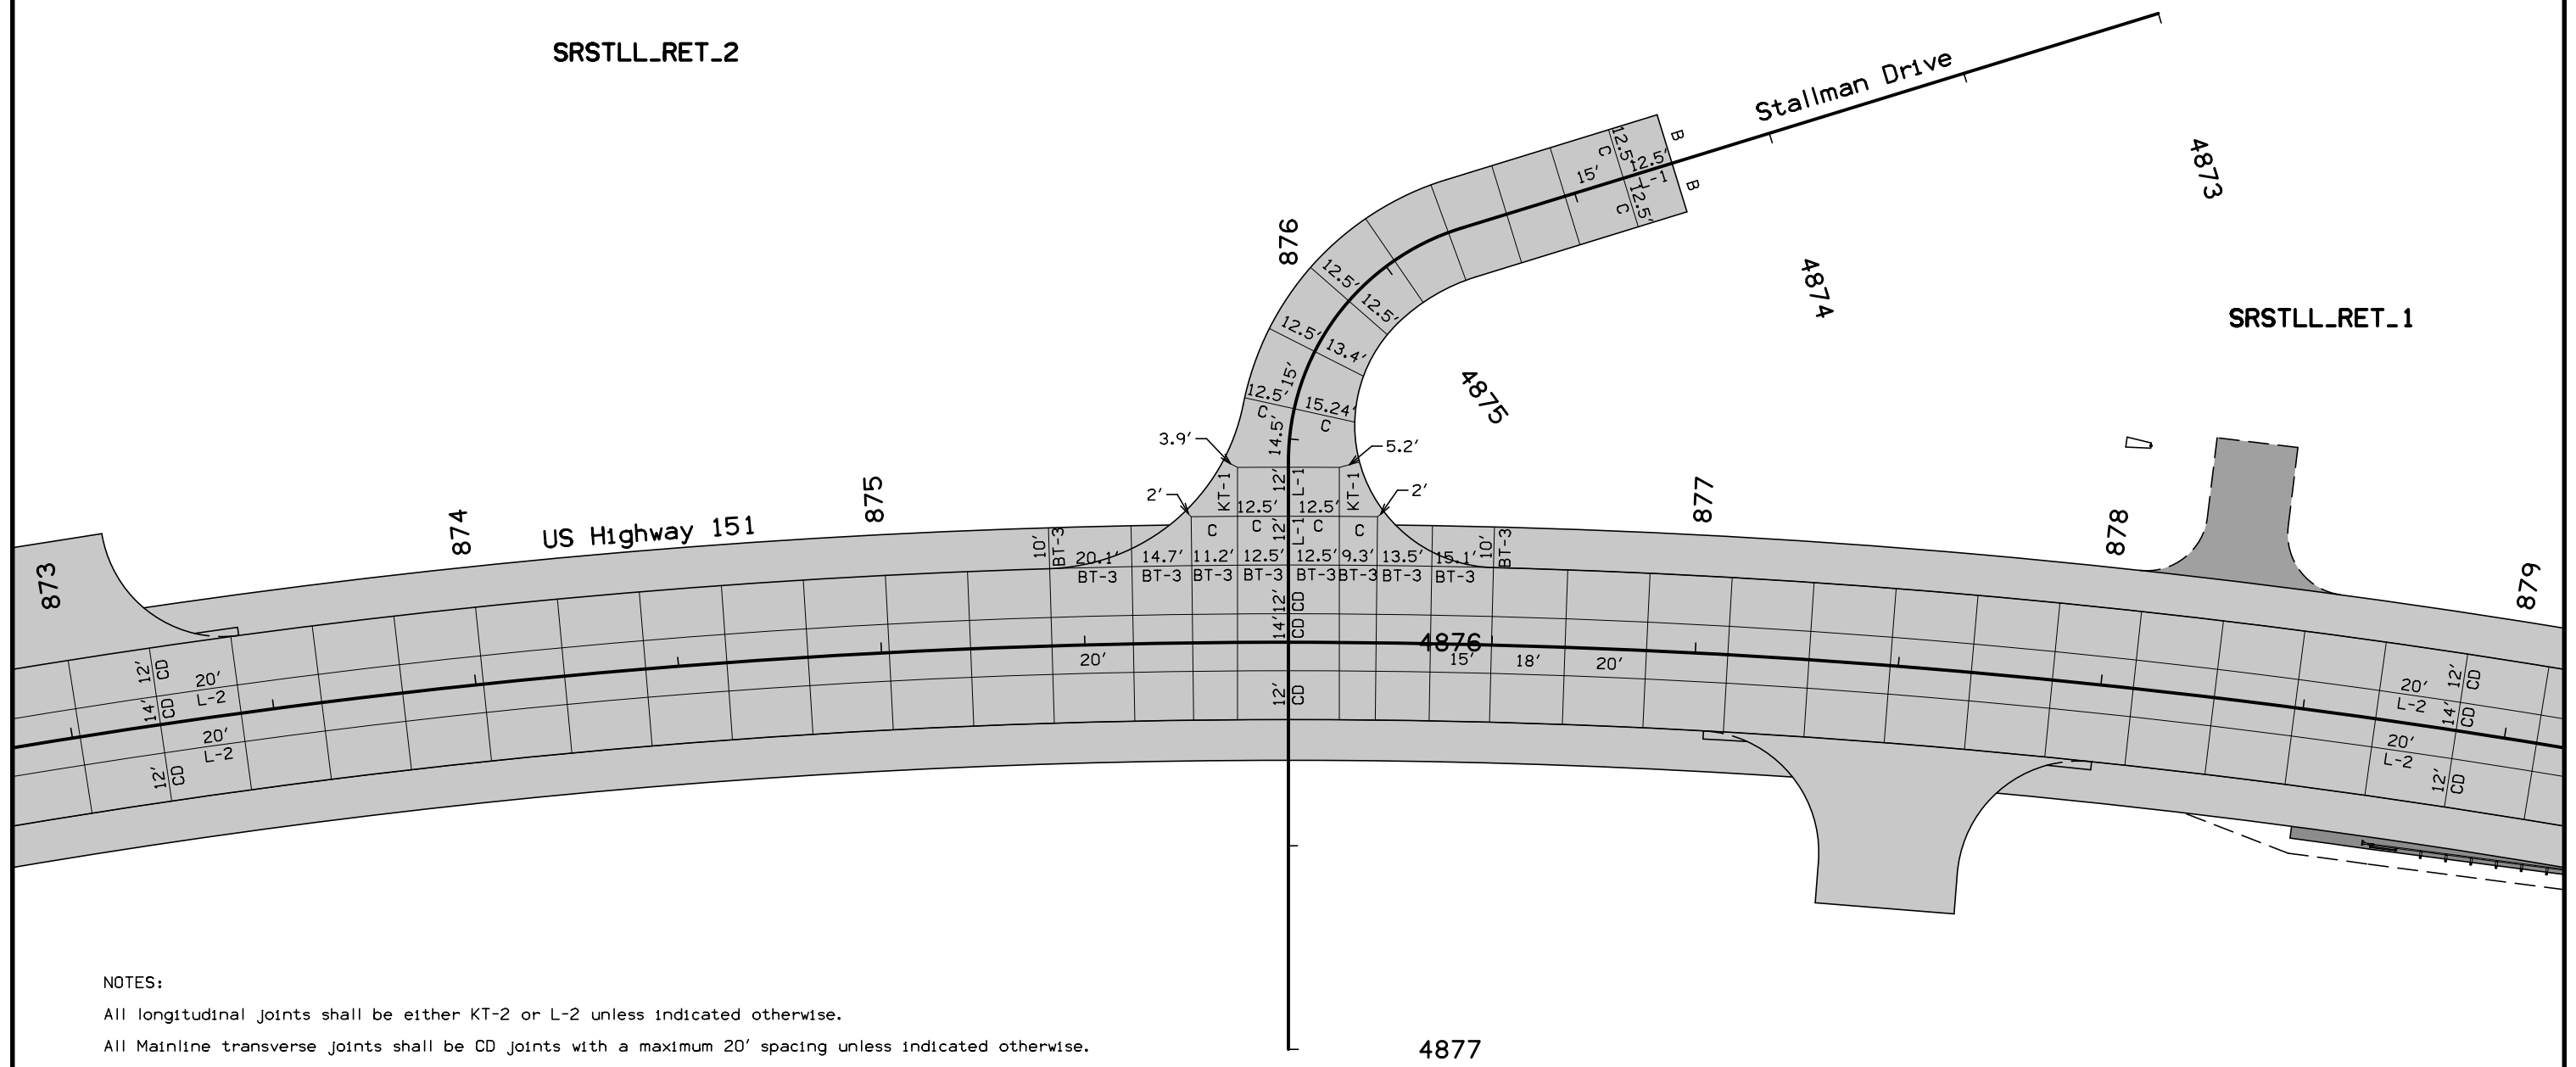


NOTES:

- All longitudinal joints shall be either KT-2 or L-2 unless indicated otherwise.
- All Mainline transverse joints shall be CD joints with a maximum 20' spacing unless indicated otherwise.
- All Sideroad transverse joints shall be C joints with a maximum 15' spacing unless indicated otherwise.
- If a joint length is 2', a C joint shall be used instead of a CD joint.
- Refer to Standard Road Plans for details of paved header, if applicable.
- Refer to Standard Road Plan PV-1 for additional details.
- Refer to Standard Road Plans for additional jointing details around physical features.
- Refer to Standard Road Plans for jointing details of approach pavement.

FAIRFAX TWP.
T-82N R-8W
SEC. 9

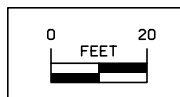


**Jointing Details
Intersection of
US Highway 151 and Stallman Drive**

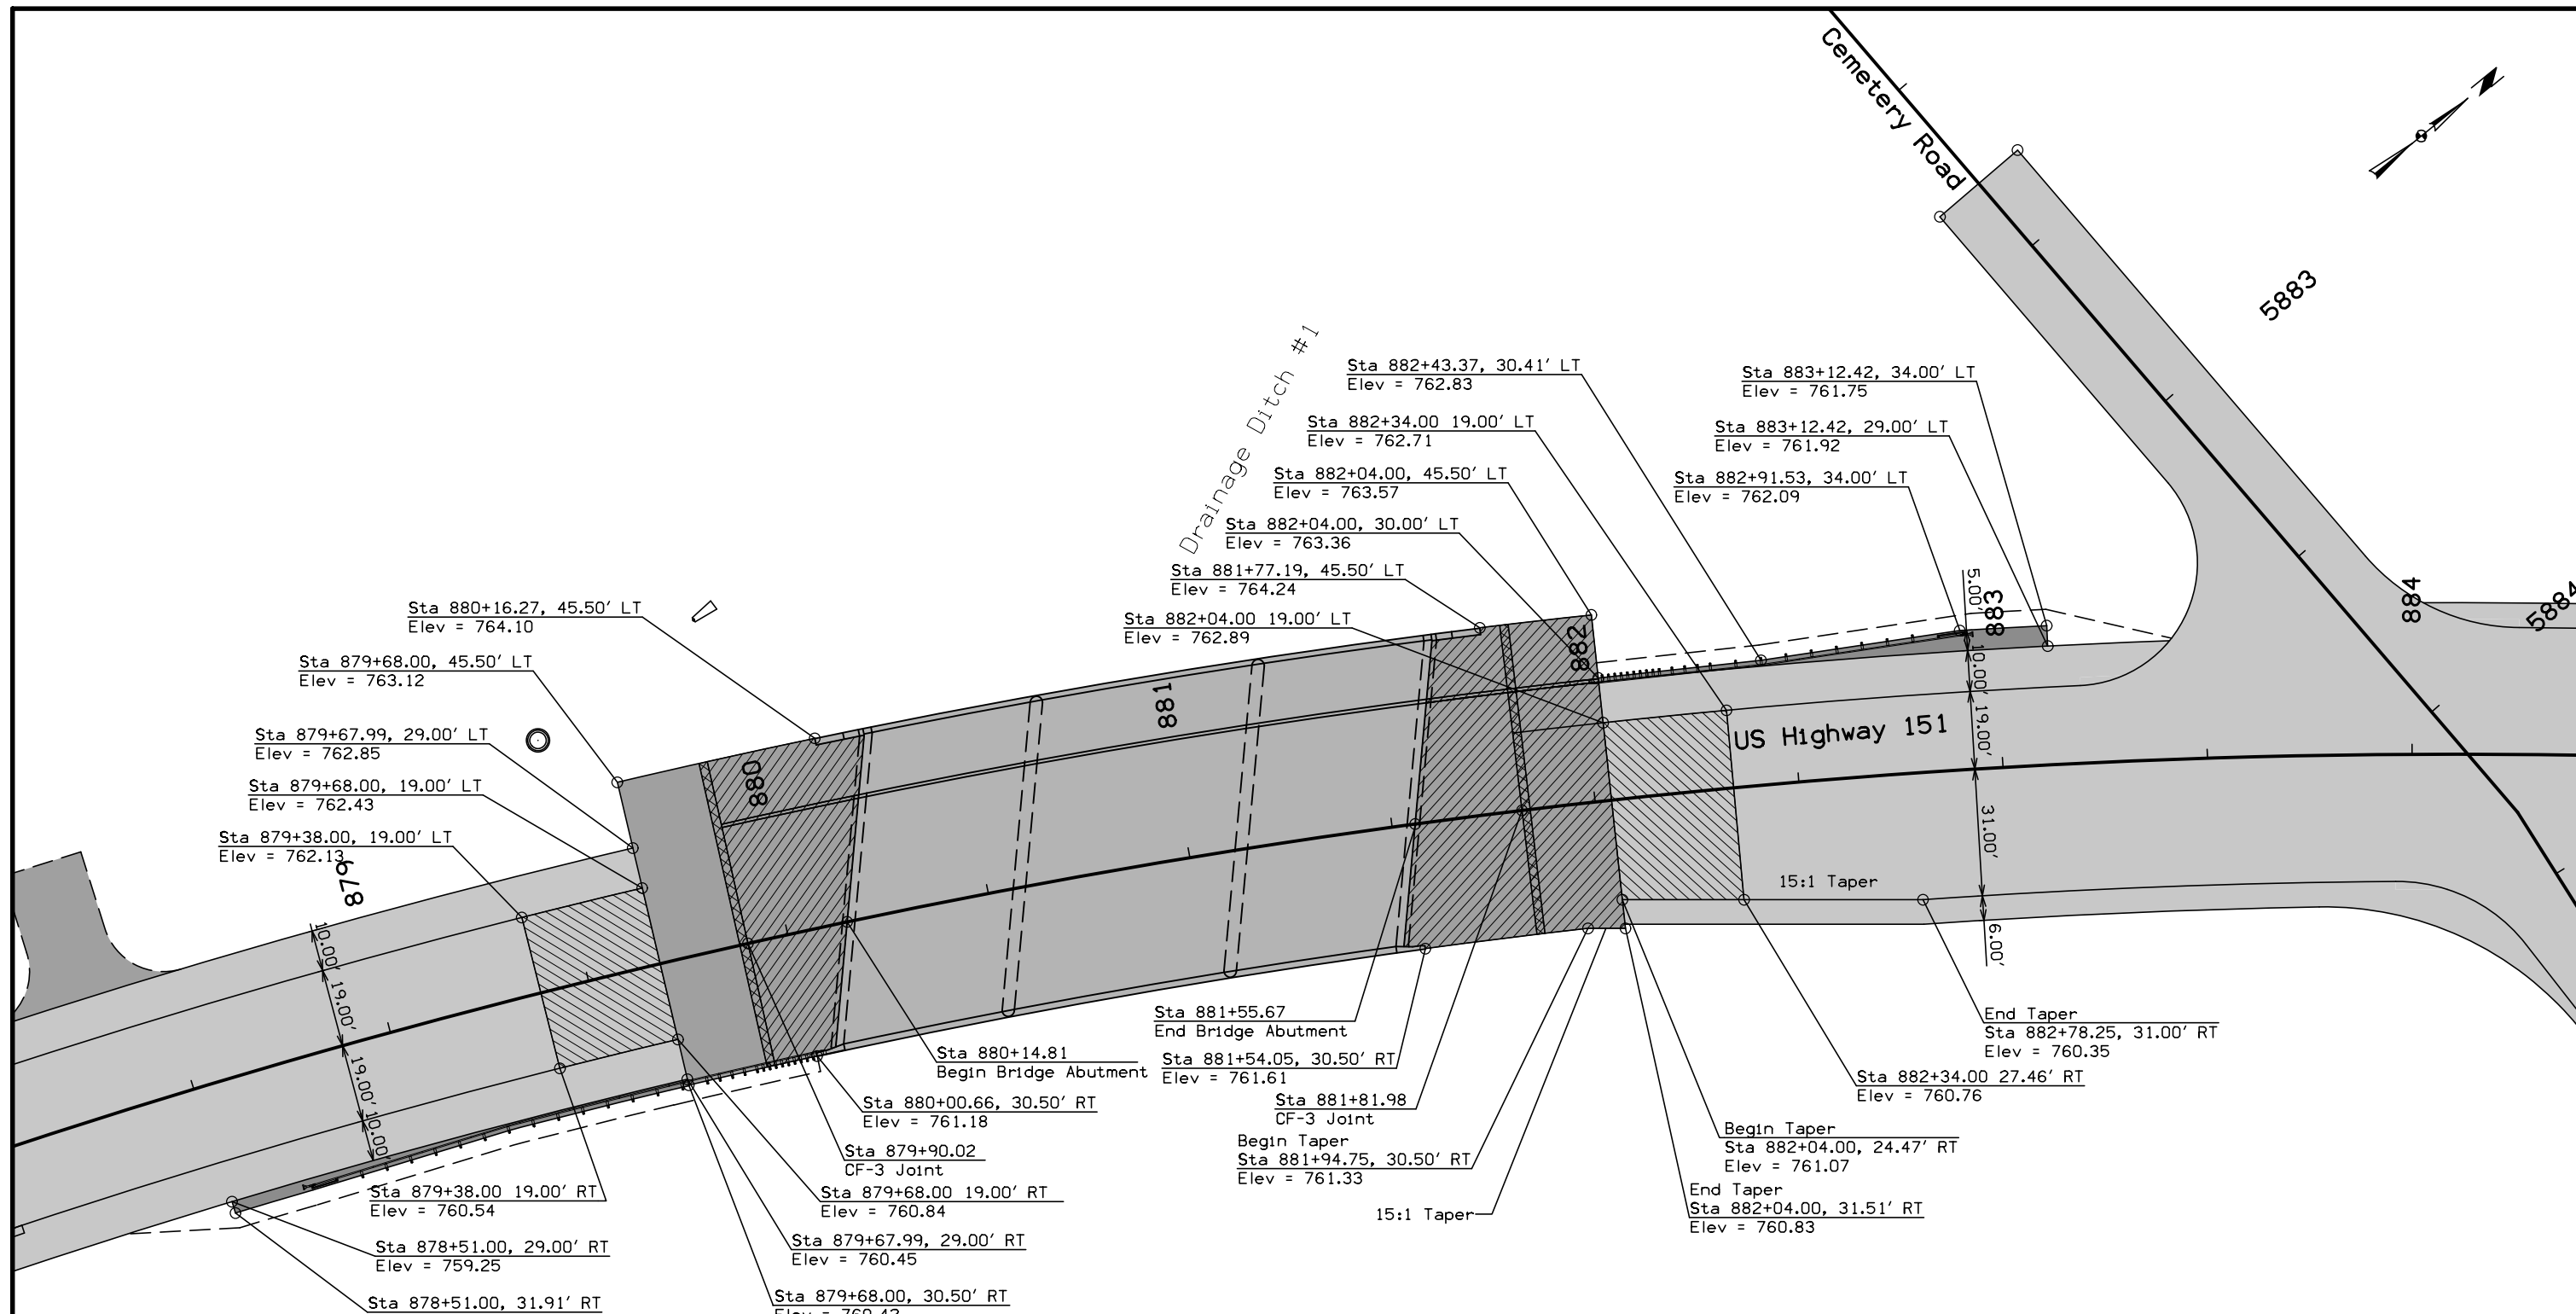

Note:
 Follow Standard Road Plan BR-205 for Bridge Approach Pavement. For North Abutment Extend Double Reinforced Section to End of Separation Rail, No Single Reinforced Section.


- Legend
- Unreinforced Section
 - Single Reinforced Section
 - Double Reinforced Section

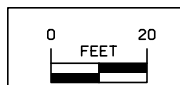


FAIRFAX TWP.
 T-82N R-8W
 SEC. 9

**Geometric Details
 Drainage Ditch #1 Bridge**

CIRCULAR CURVE DATA						
Name	Δ	D	T	L	E	R
SRCEMET_RET_1-1	48° 56' 43.89"	114° 35' 29.61"	22.76'	42.71'	4.95'	50'
SRCEMET_RET_2-2	127° 52' 20.06"	190° 59' 09.35"	61.33'	66.95'	38.28'	30'
SRCEMET_RET_3-2	52° 29' 27.50"	143° 14' 22.02"	19.72'	36.65'	4.59'	40'
SRCEMET_RET_4-2	130° 25' 29.97"	143° 14' 22.02"	86.62'	91.05'	55.41'	40'

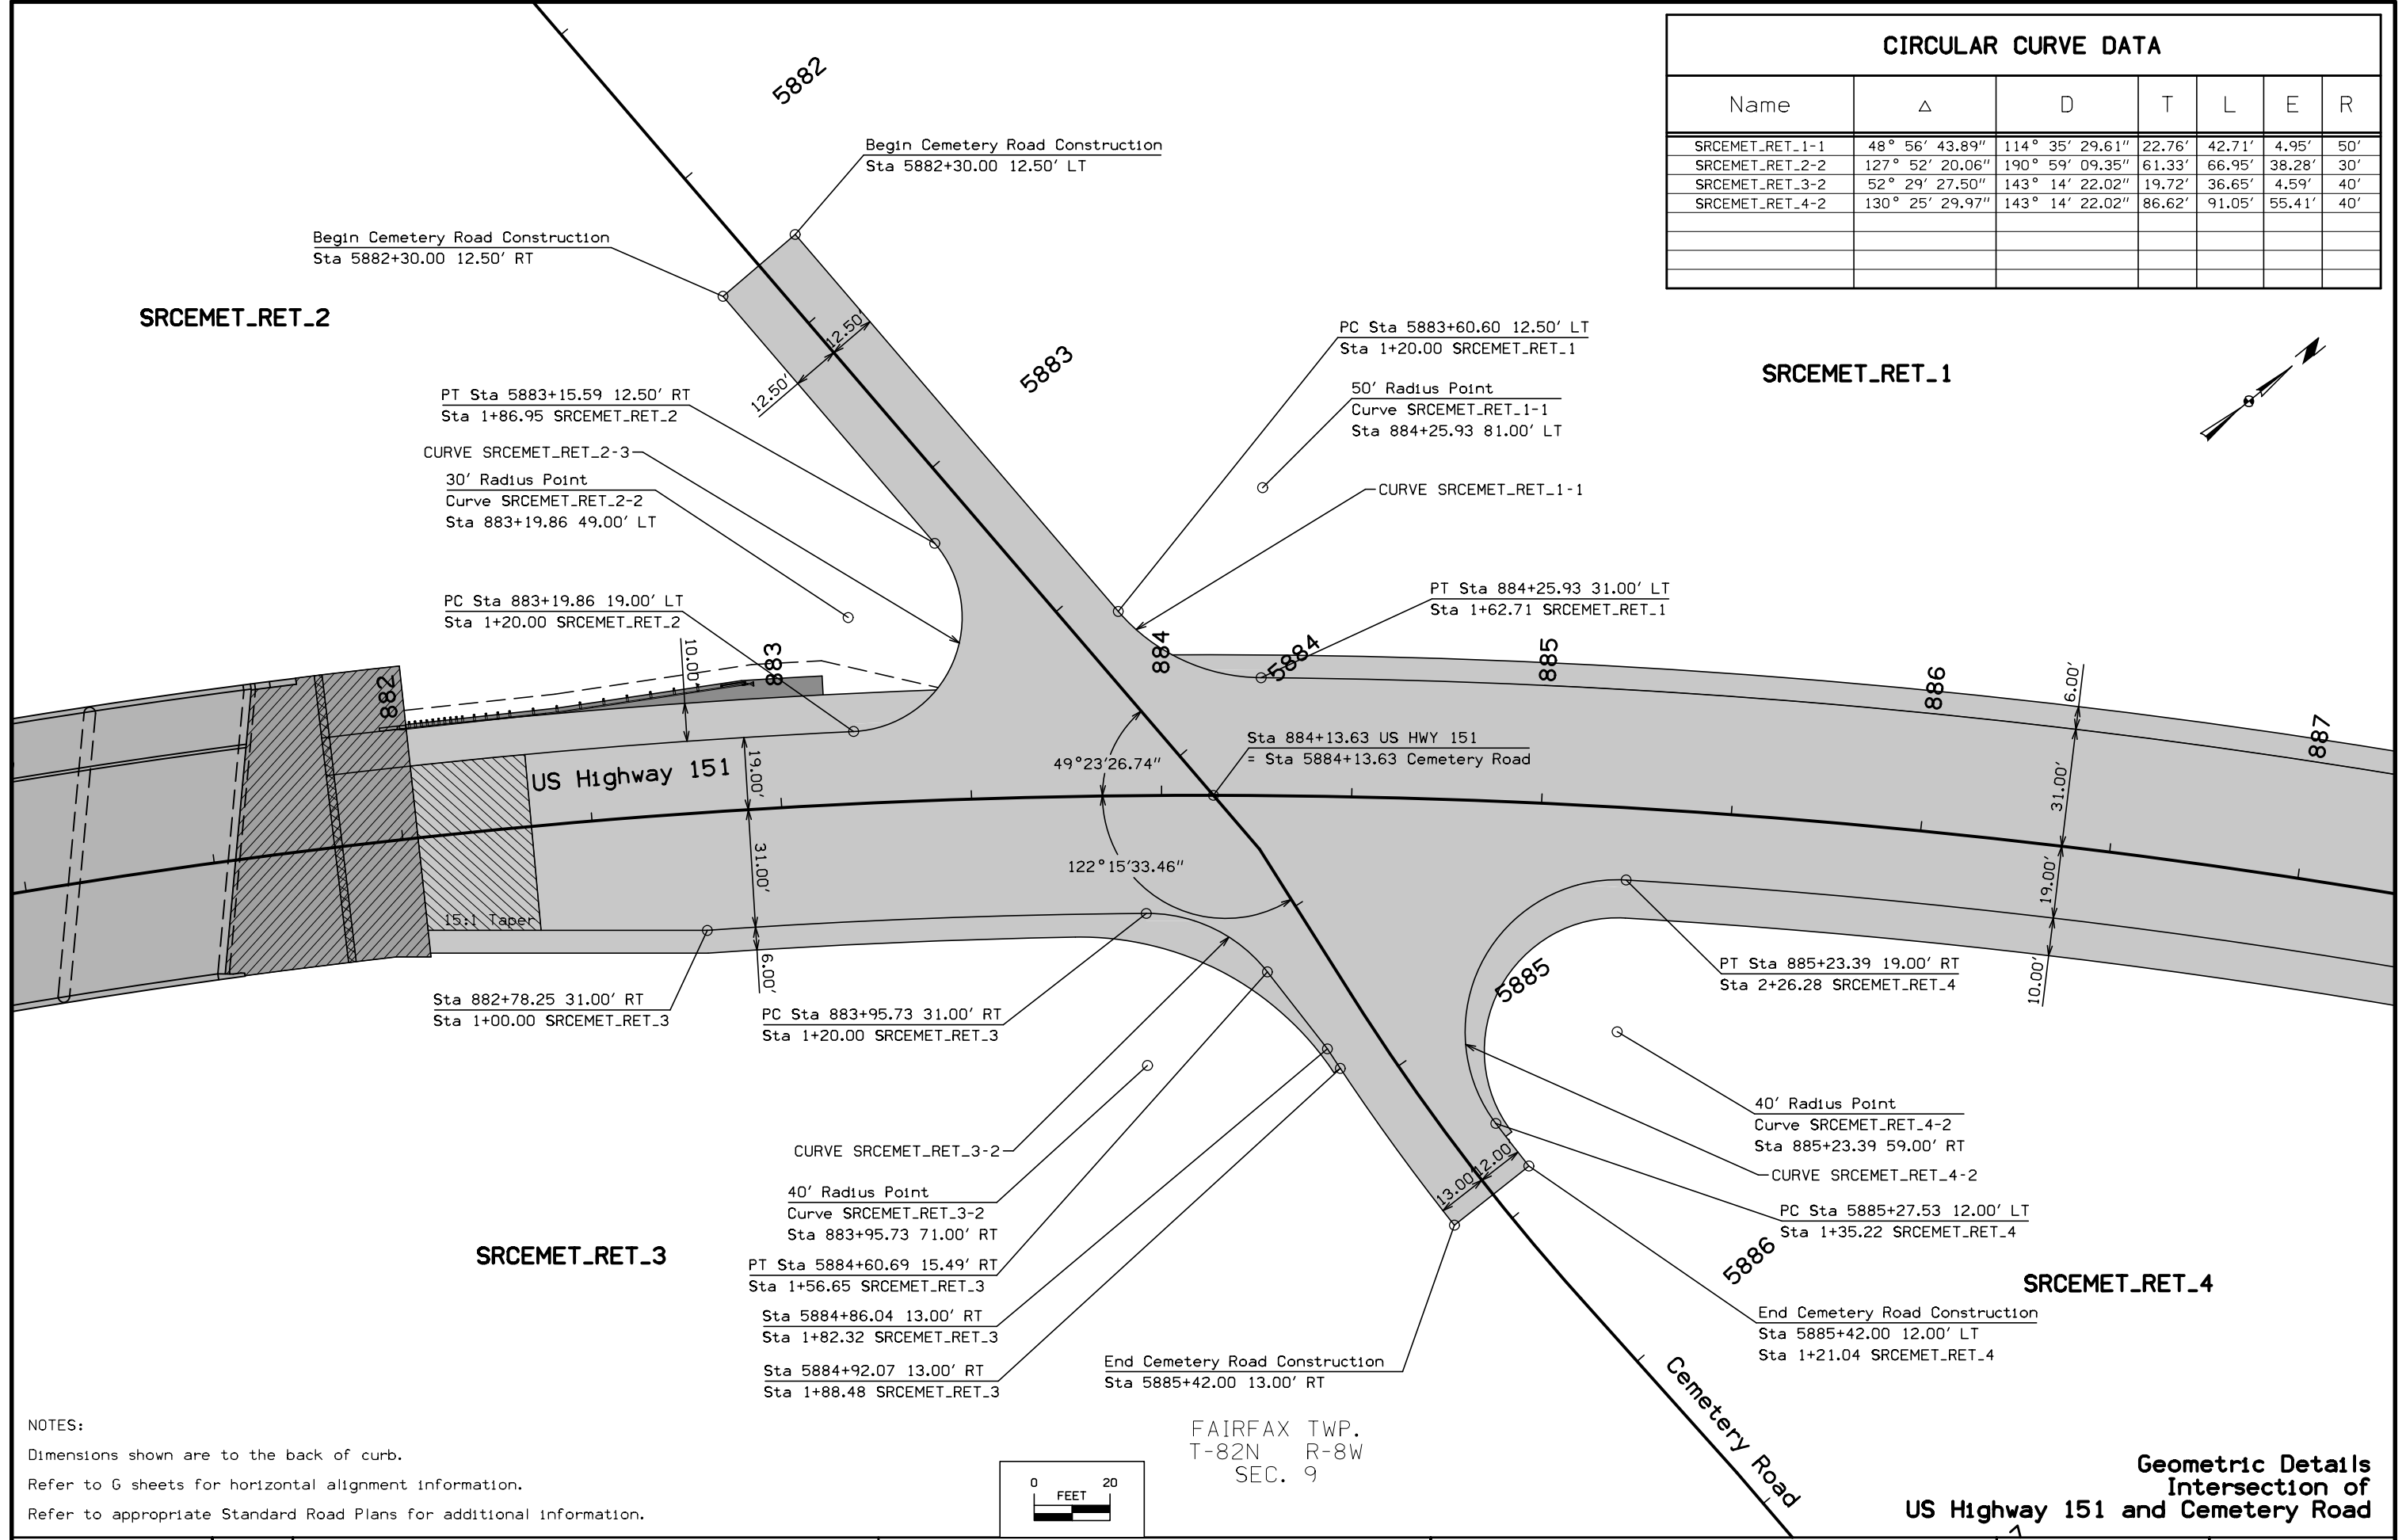


NOTES:
 Dimensions shown are to the back of curb.
 Refer to G sheets for horizontal alignment information.
 Refer to appropriate Standard Road Plans for additional information.

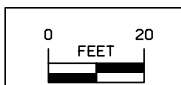

FAIRFAX TWP.
 T-82N R-8W
 SEC. 9

**Geometric Details
 Intersection of
 US Highway 151 and Cemetery Road**

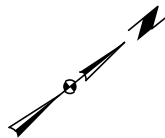


SRCEMET_RET_2

SRCEMET_RET_1


SRCEMET_RET_3



SRCEMET_RET_4

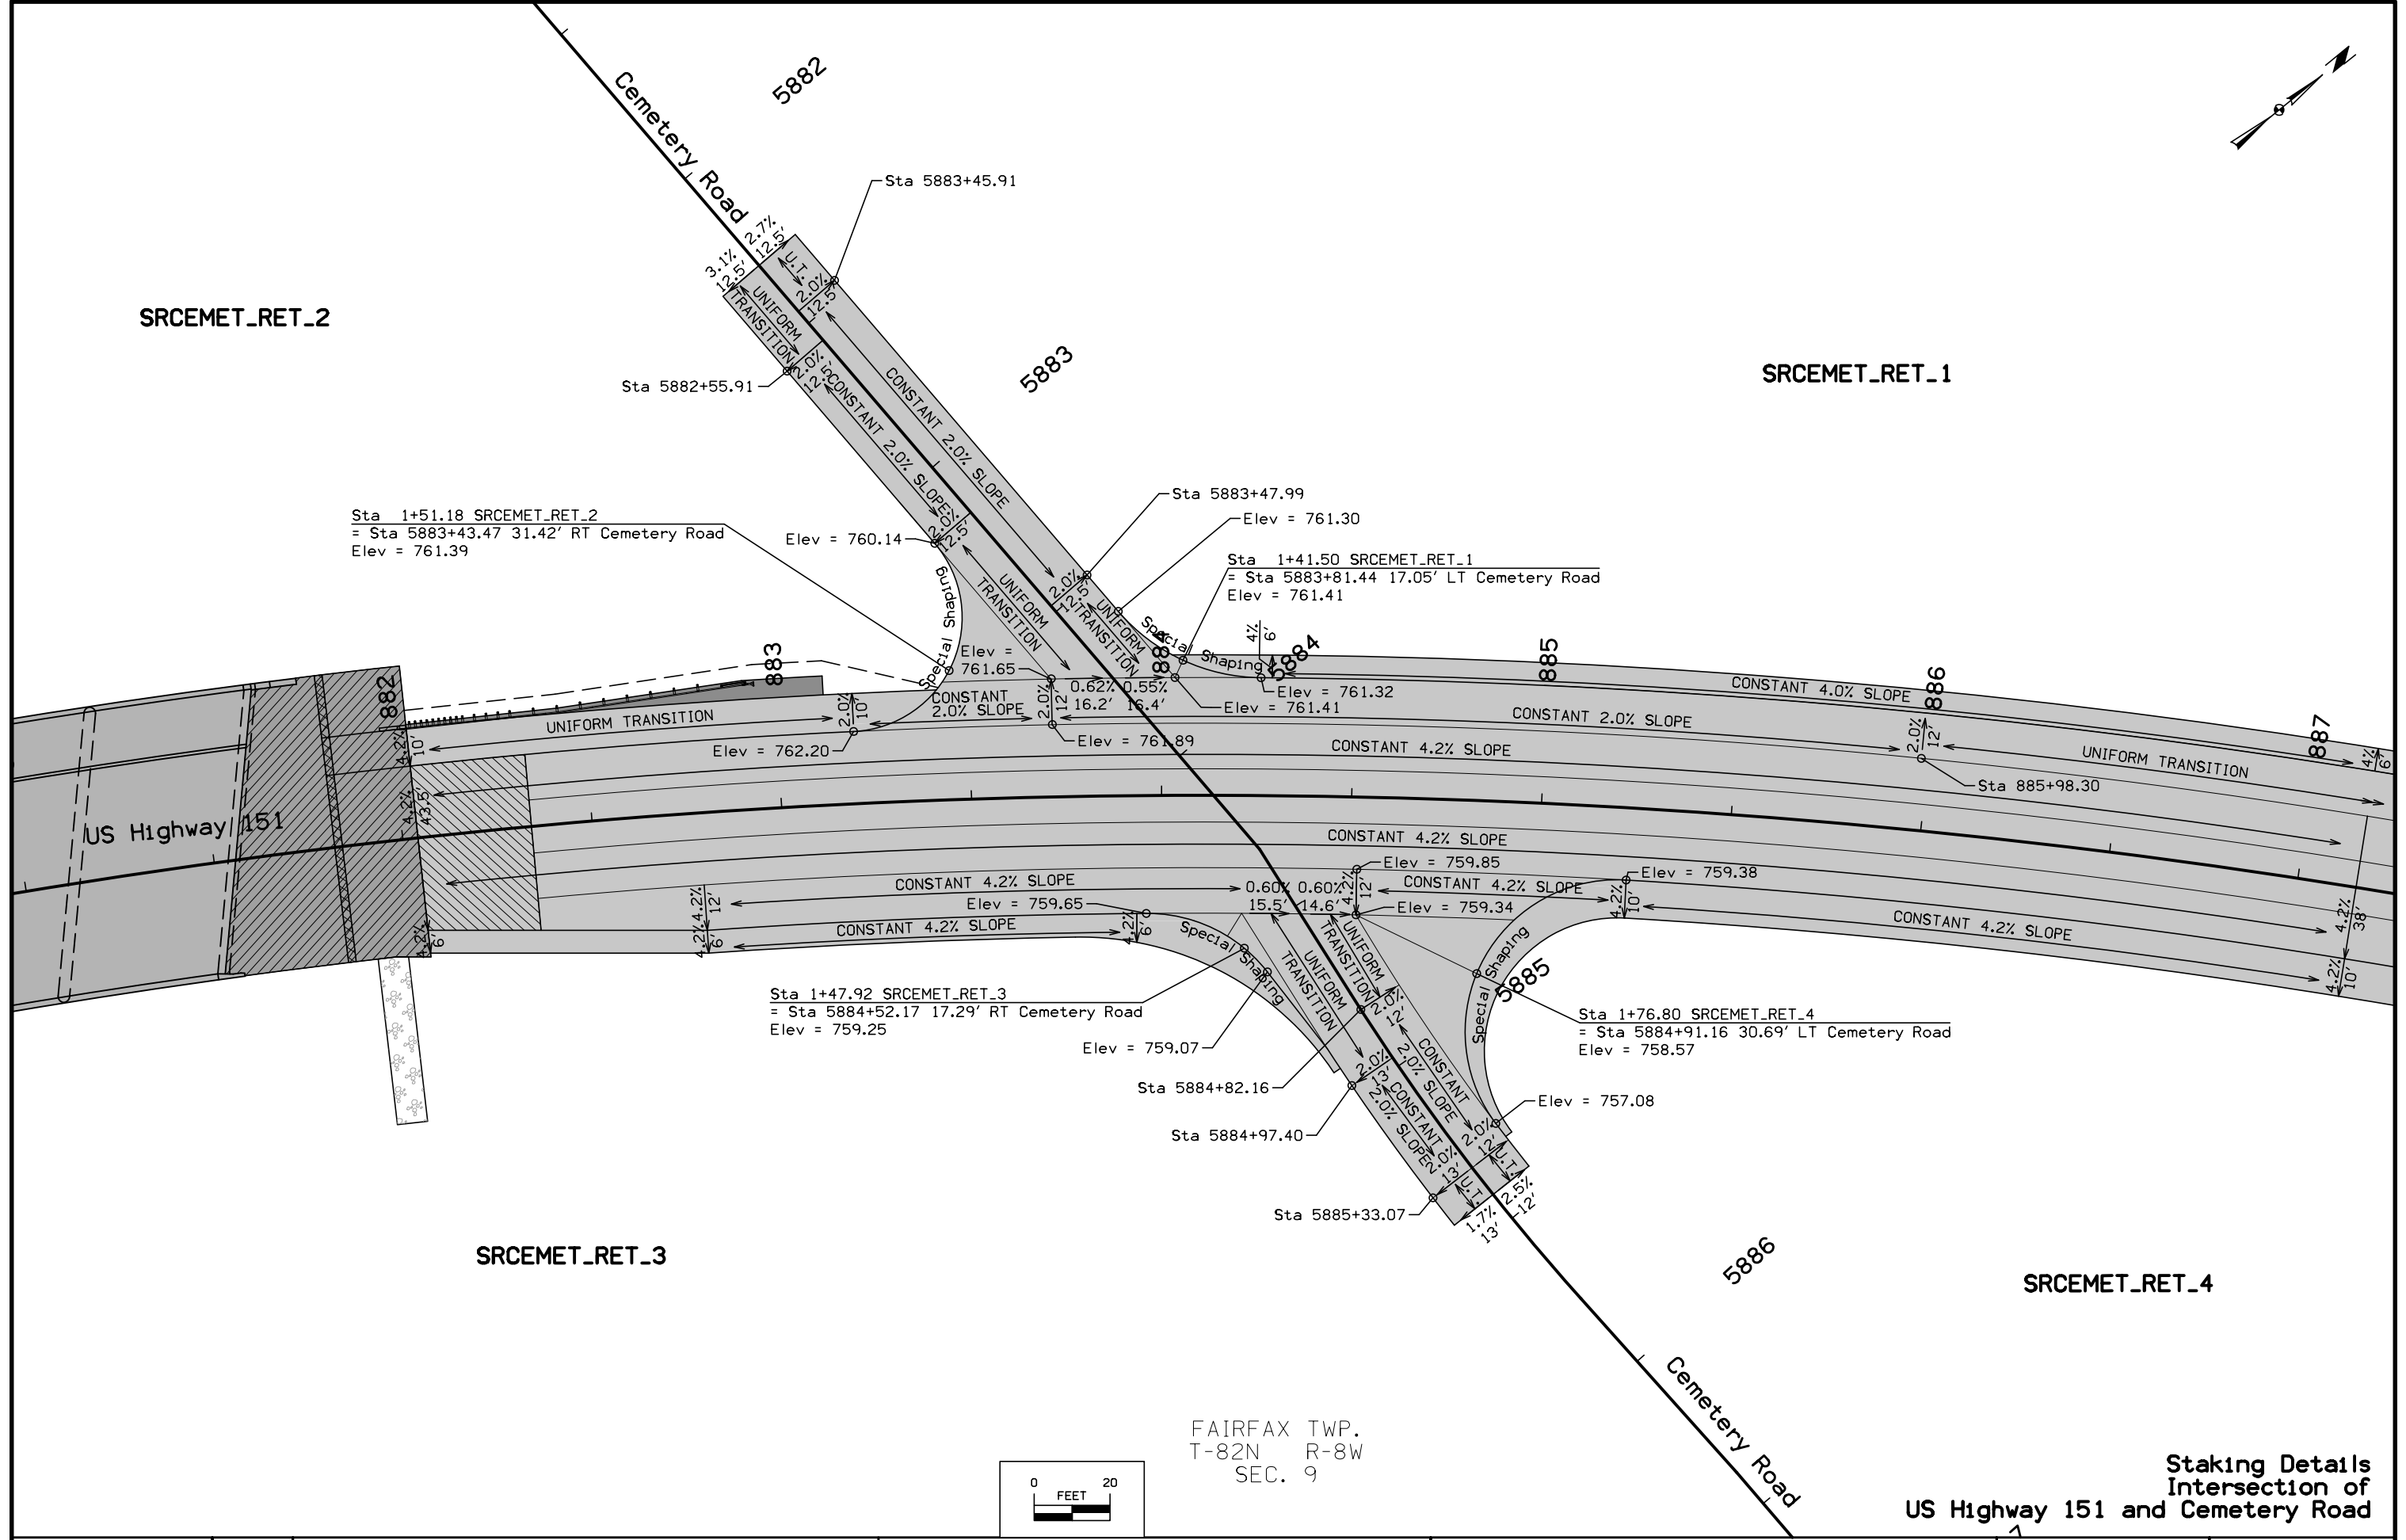


FAIRFAX TWP.
T-82N R-8W
SEC. 9

Staking Details
Intersection of
US Highway 151 and Cemetery Road

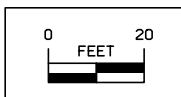

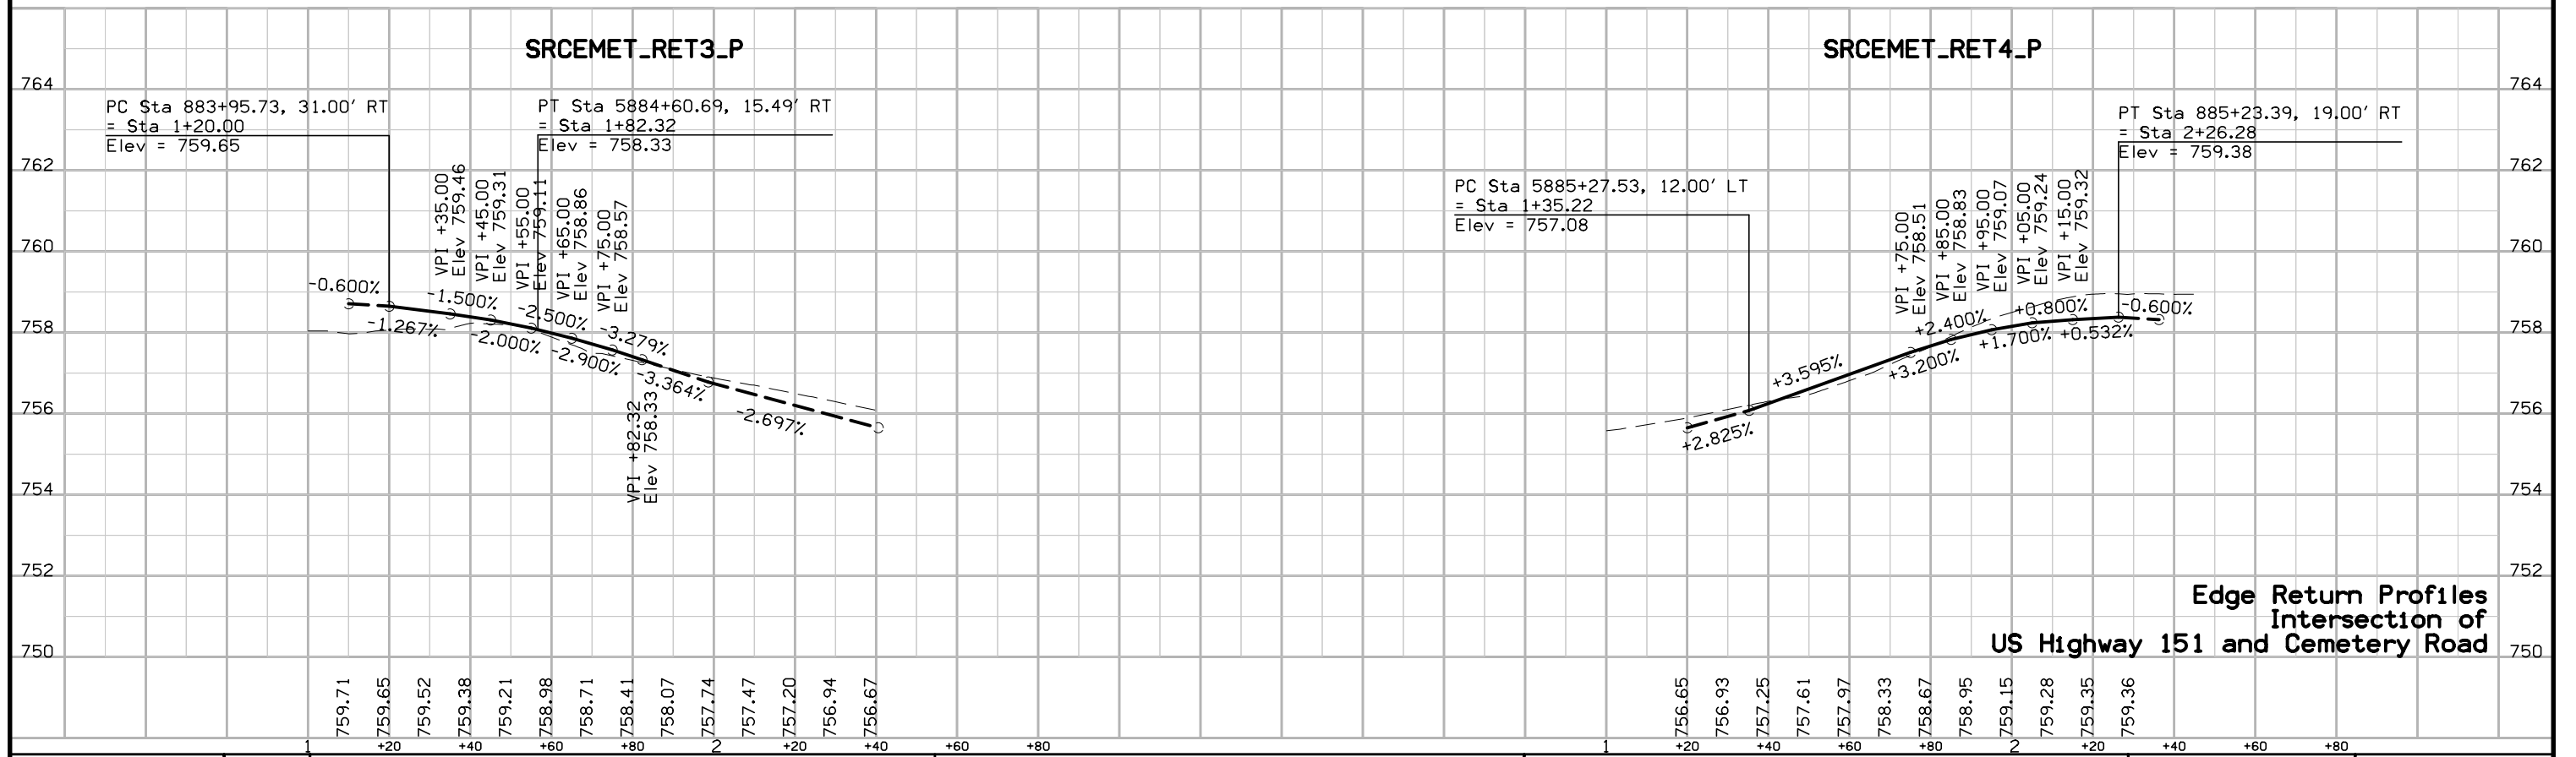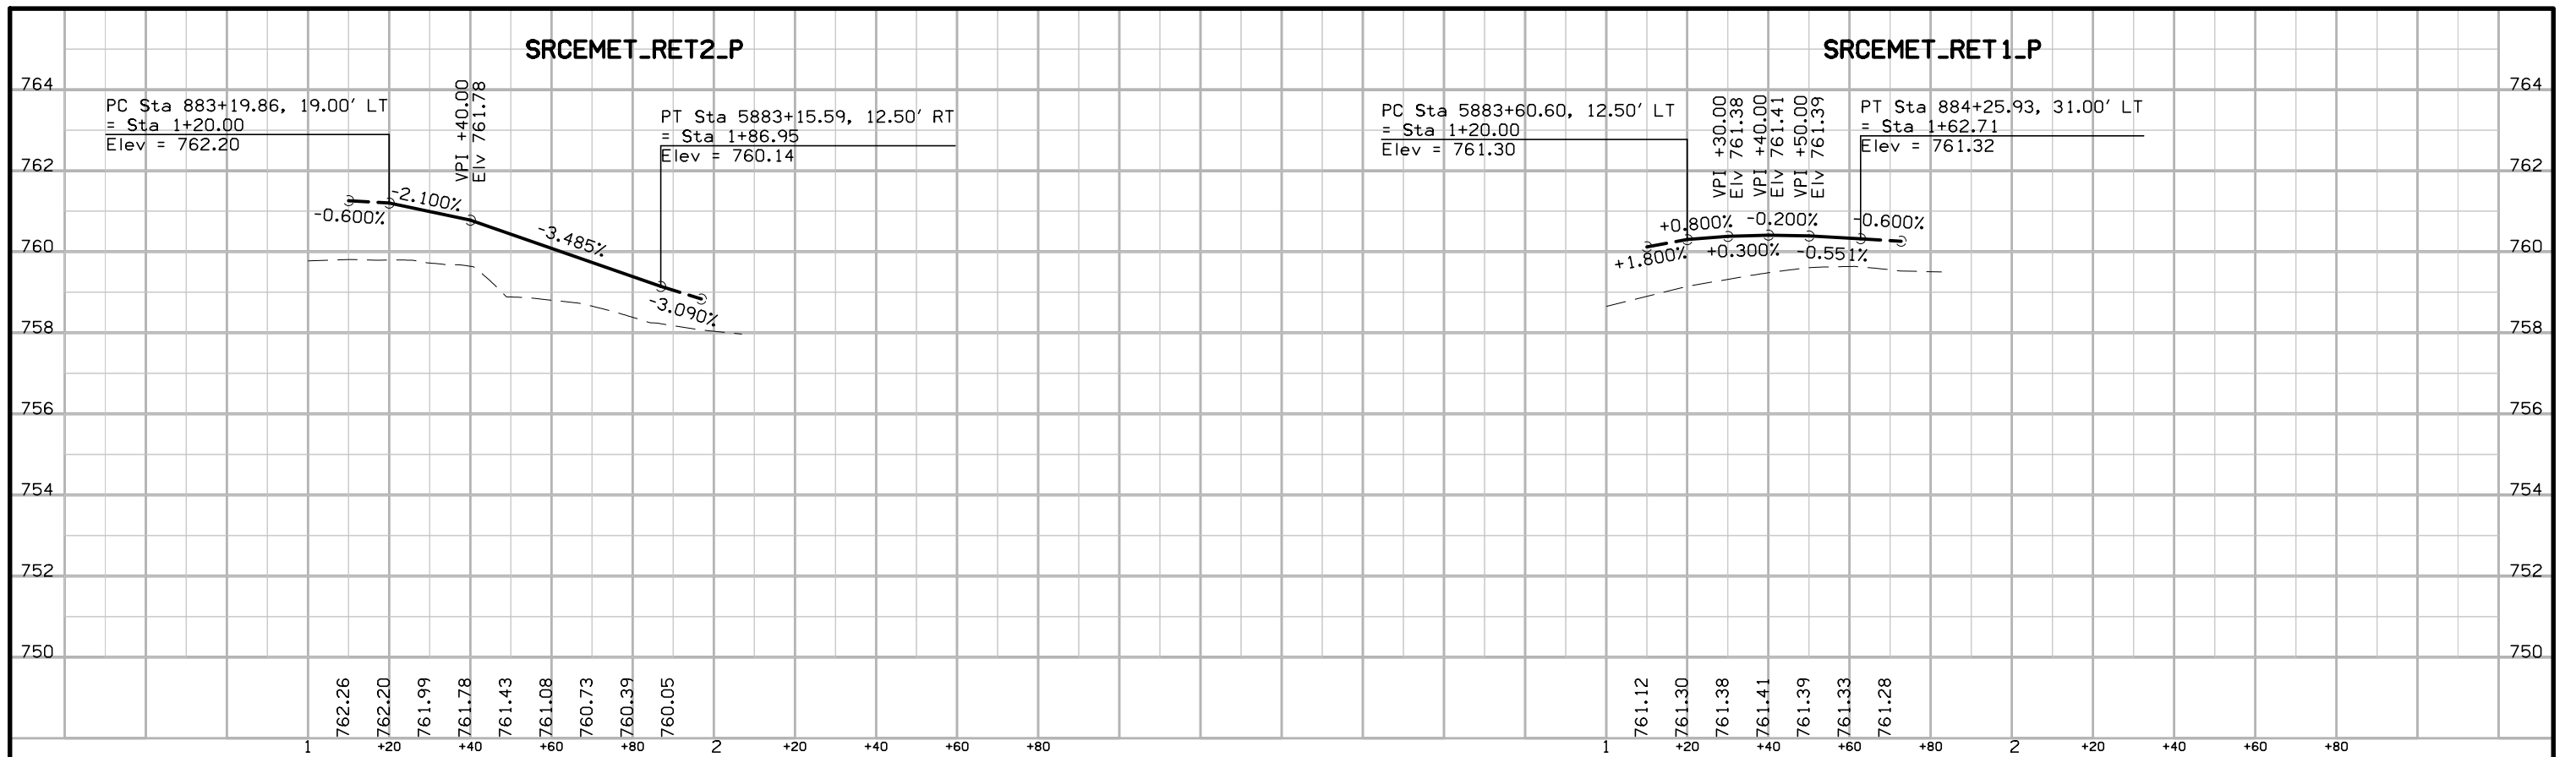


Edge Return Profiles
Intersection of
US Highway 151 and Cemetery Road

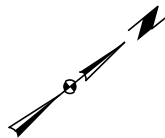

SRCEMET_RET_2


SRCEMET_RET_1

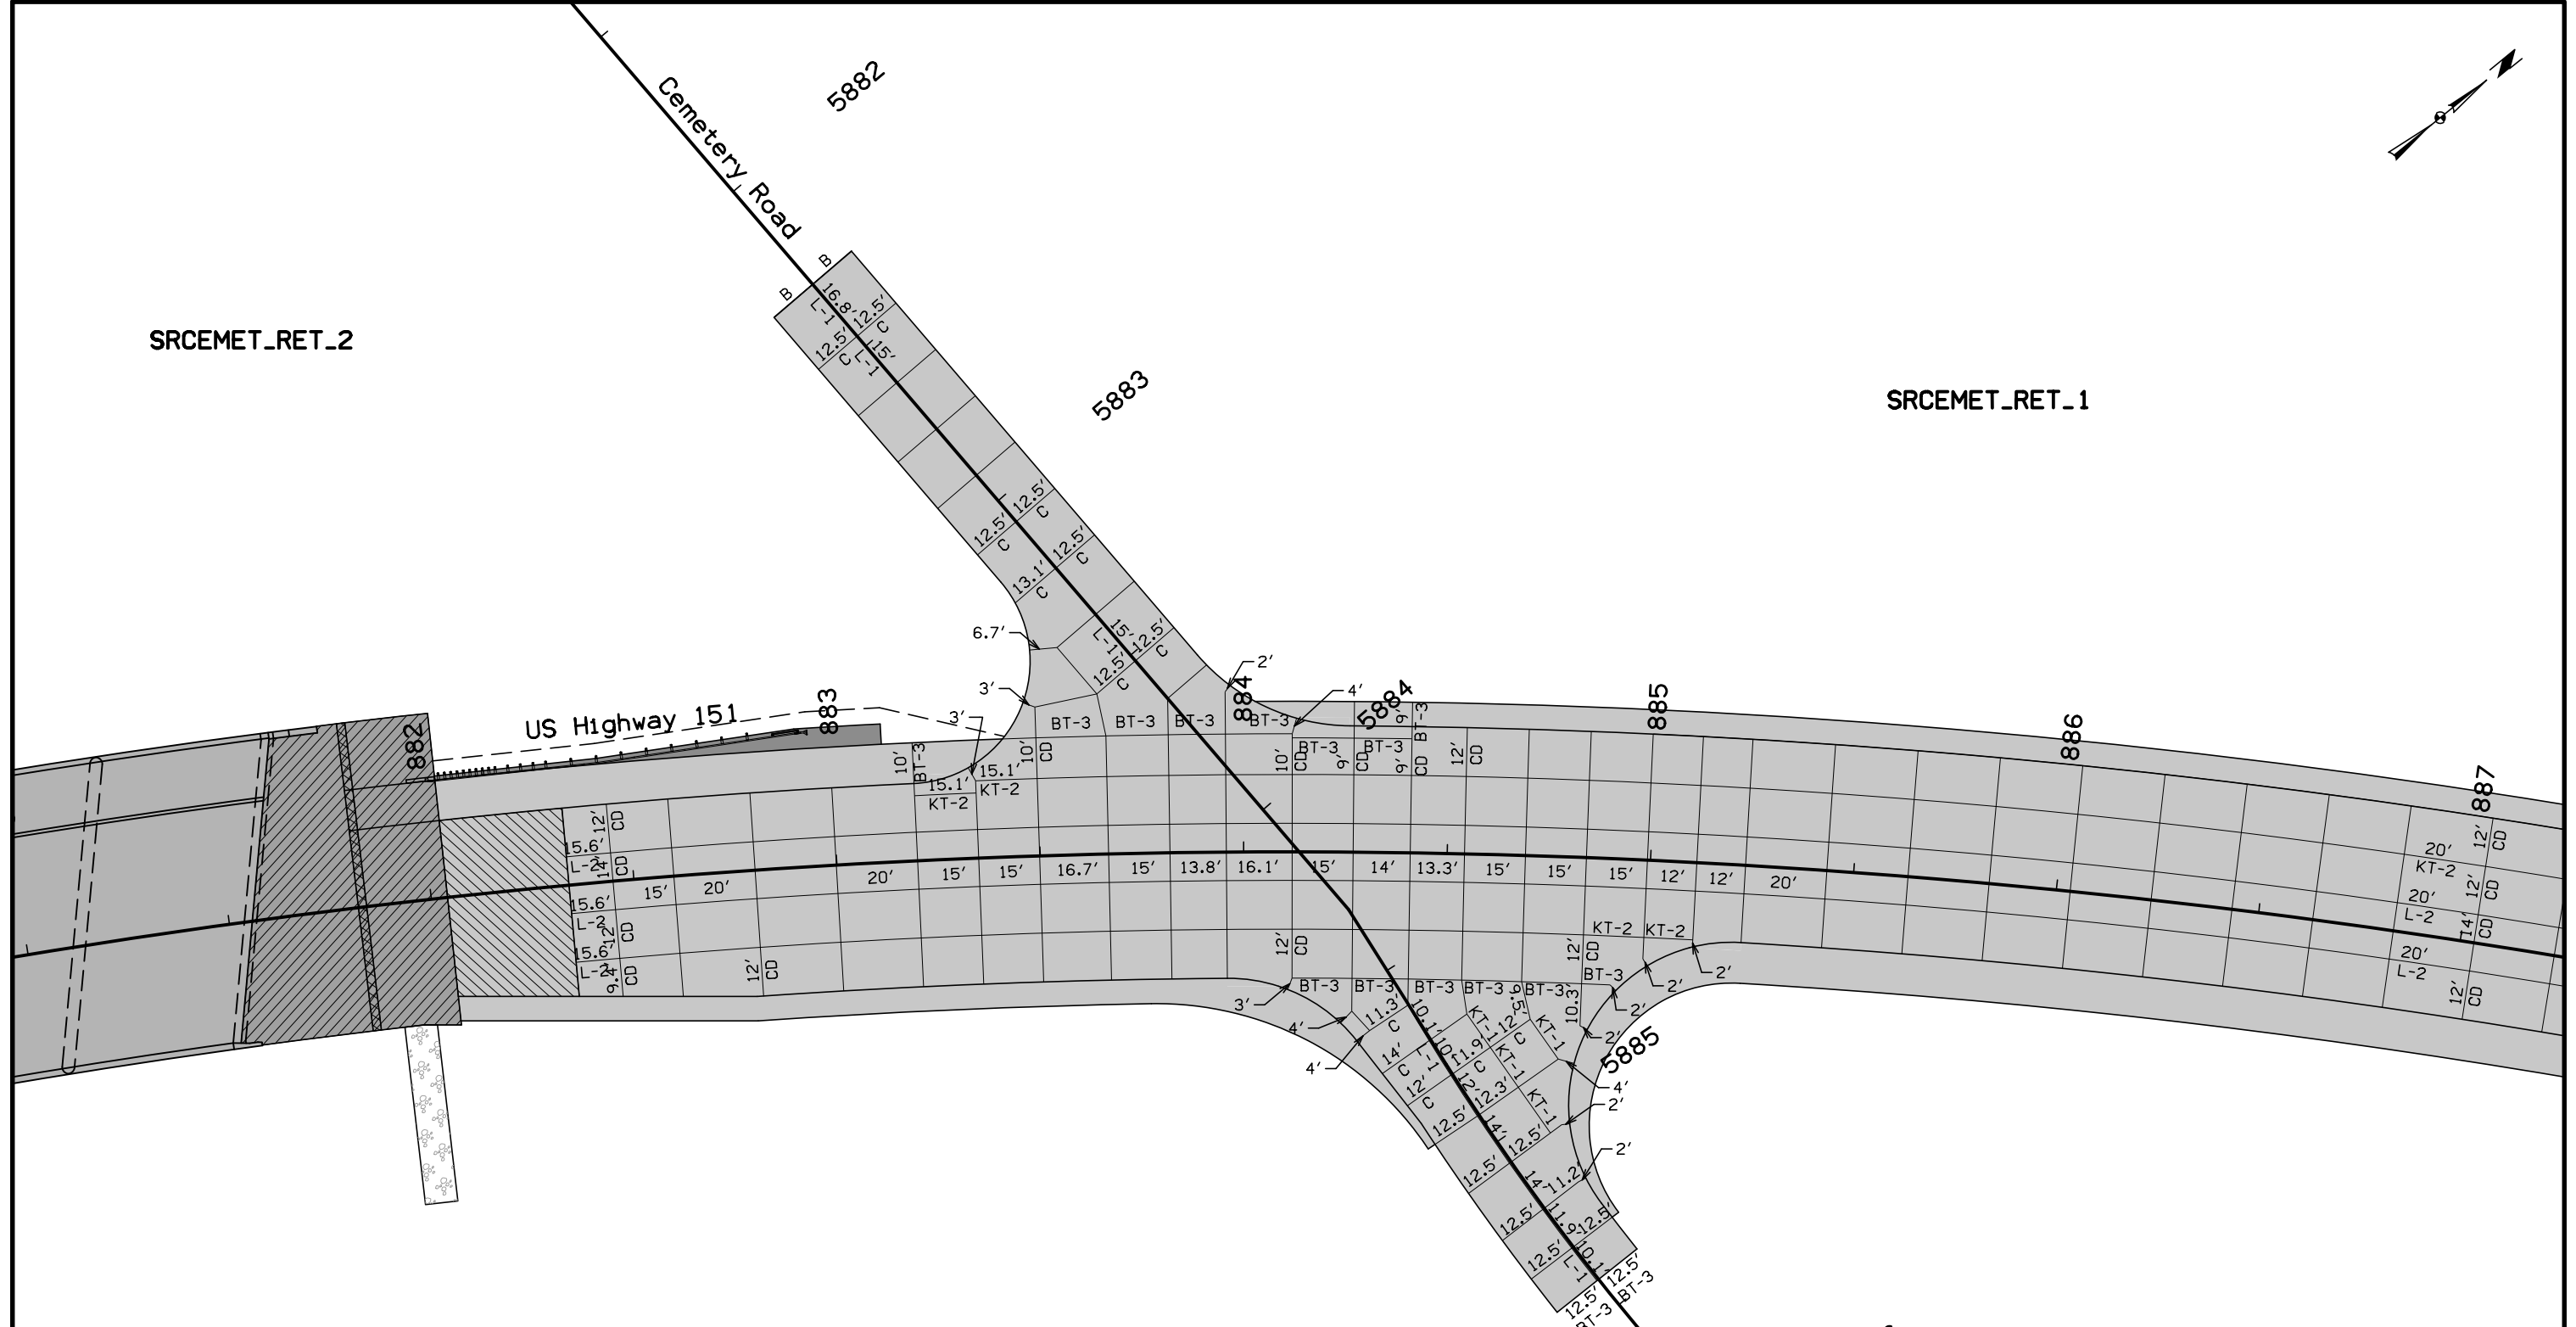

SRCEMET_RET_3



SRCEMET_RET_4

- NOTES:
- All longitudinal joints shall be either KT-2 or L-2 unless indicated otherwise.
 - All Mainline transverse joints shall be CD joints with a maximum 20' spacing unless indicated otherwise.
 - All Sideroad transverse joints shall be C joints with a maximum 15' spacing unless indicated otherwise.
 - If a joint length is 2', a C joint shall be used instead of a CD joint.
 - Refer to Standard Road Plans for details of paved header, if applicable.
 - Refer to Standard Road Plan PV-1 for additional details.
 - Refer to Standard Road Plans for additional jointing details around physical features.
 - Refer to Standard Road Plans for jointing details of approach pavement.

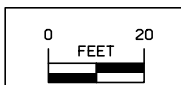


FAIRFAX TWP.
T-82N R-8W
SEC. 9

Jointing Details
Intersection of
US Highway 151 and Cemetery Road

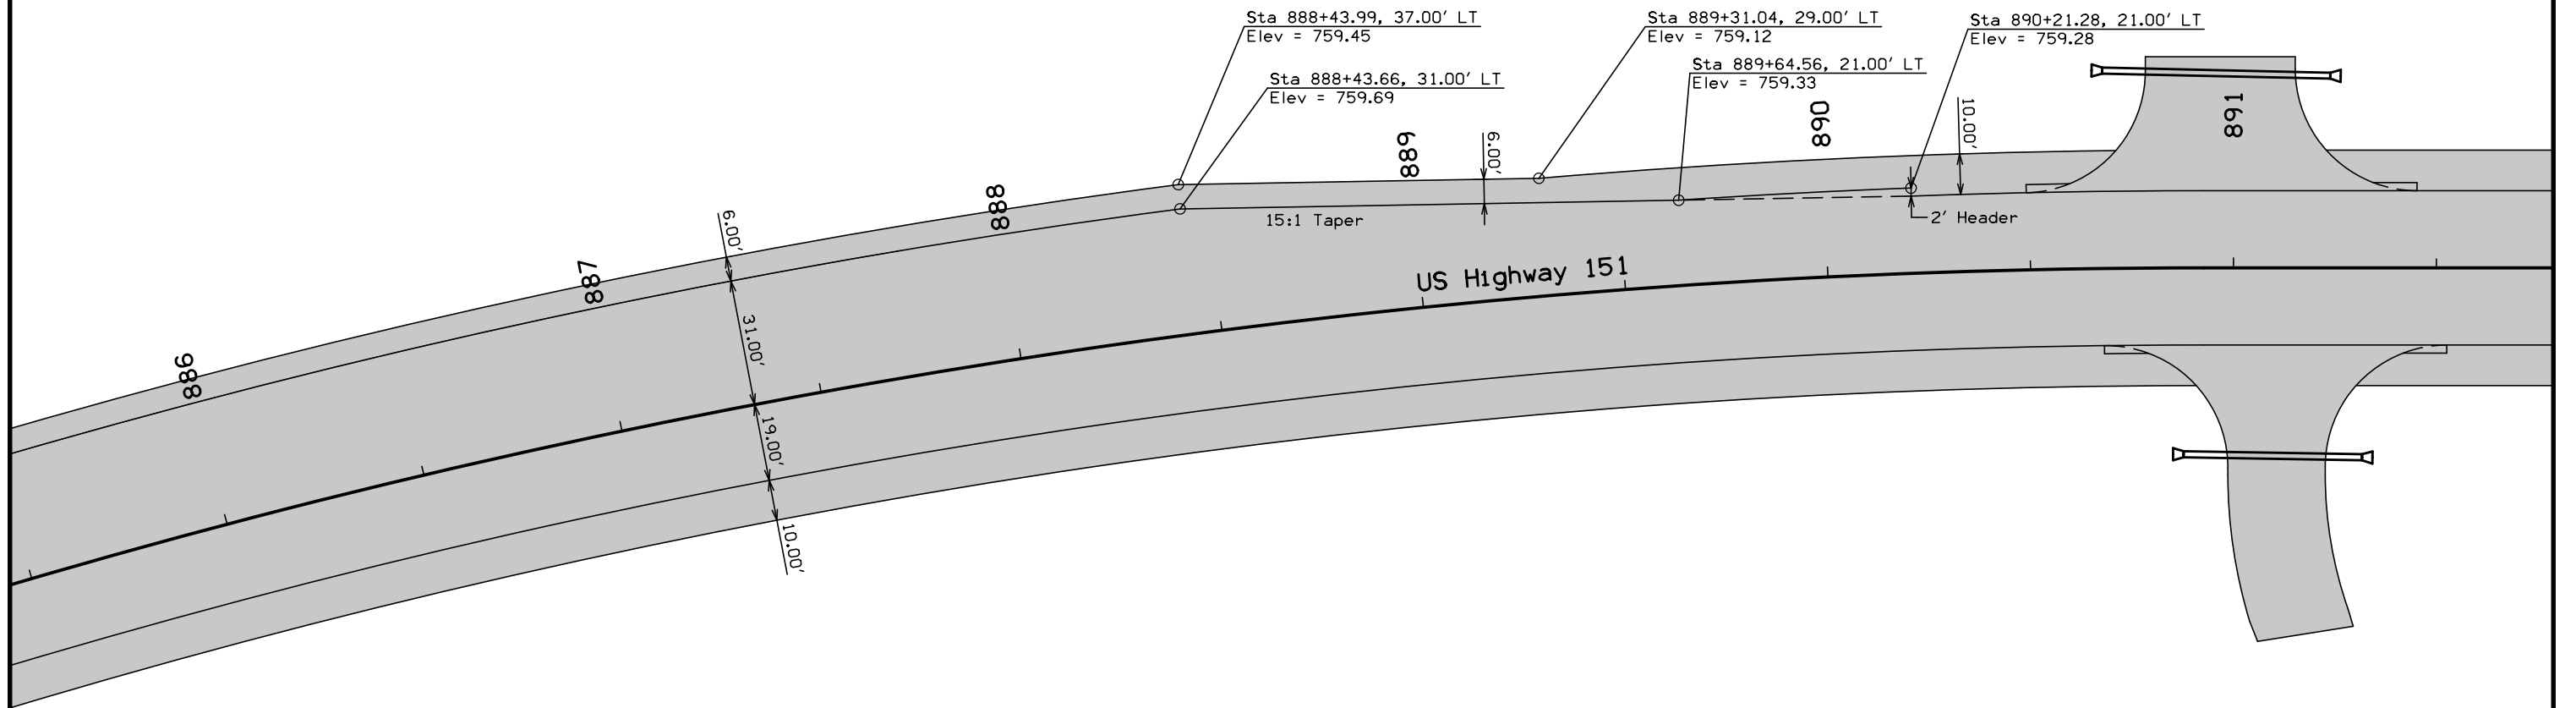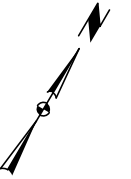

NOTES:
 Refer to G sheets for horizontal alignment information.
 Refer to appropriate Standard Road Plans for additional information.

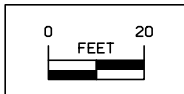

FAIRFAX TWP.
 T-82N R-8W
 SEC. 9

**Geometric Details
 Right Turn Lane**

STORM AND SANITARY SEWER

① Diameter or equivalent diameter

* Bid Item

** For SW-545

INTAKES AND UTILITY ACCESSES							PIPES															
No.	Location Station and Offset	*Type or Standard Road Plan	Form Grade	Bottom Well	Extension Length**	Notes	Line Number	Intake/Utility Access No.		Class 'D'	Pipe Size		Bid* Length	Design Length	Slope %	Connected Pipe Joint (DR-121)	Flow Lines			Pipe Profile Sheet No.	Notes	
			Elev.	Elev.	FT			From	To		IN	FT					FT	Inlet Elevation	Outlet Elevation			Other Elevation
								Type														
ST-01	841+87.00, 16.00 LT					Existing Intake	P-01	ST-01	ST-02	2000	12						771.69	762.18		M.3	Existing Pipe	
ST-02	845+01.00, 20.00 LT					Existing Intake	P-02	ST-02	ST-04	2000	15	164	155.4	2.64			761.98	757.88		M.3	Division 3	
ST-03	845+65.00, 19.84 RT	SW-509	764.25	760.00			P-03	ST-03	ST-05	2000	15	158	148.6	2.42			760.50	756.90		M.3	Division 3	
ST-04	846+64.33, 21.00 LT	SW-509	761.61	757.18			P-04	ST-04	ST-07	2000	18	176	166.7	1.13			757.68	755.80		M.3	Division 3	
ST-05	847+21.58, 21.00 RT	SW-509	760.54	755.14			P-05	ST-05	ST-06	2000	30	118	109.4	0.40			755.64	755.20		M.3	Division 3	
ST-06	848+39.00, 21.00 RT	SW-509	759.85	754.60			P-06	ST-06	ST-07	2000	30	46	42.0	0.50			755.10	754.89		M.3	Division 3	
ST-07	848+39.00, 21.00 LT	SW-510	760.12	754.30			P-07	ST-07	ST-15	2000	30	152	143.9	0.49			754.80	754.10		M.3	Gasket Pipe, Div. 3	
ST-08	1850+50.00, 25.00 RT	DR-201 (15-Inch)	756.56			Division 2	P-08	ST-08	ST-09	2000	15	40	36.9	2.05			756.44	755.58	756.56	M.5	Apron Inlet, Div. 2	
ST-09	1850+50.00, 20.00 LT	SW-513 (4'x 4')	758.23	754.48		Note 1 & Div.2	P-09	ST-09	ST-10	2000	24	68	62.8	0.45			754.98	754.70		M.5	Division 2	
ST-10	1849+85.00, 30.00 LT	SW-401 (48-Inch)	761.83	754.10		Division 2	P-10	ST-10	ST-11	2000	24	38	30.9	0.97			754.60	754.30		M.5	Division 2	
ST-11	849+89.12, 22.51 RT	SW-510	762.96	753.70			P-11	ST-11	ST-15	2000	24	62	57.2	0.88			754.20	753.70		M.5		
ST-12	851+48.00, 43.90 RT	SW-513 (3'x 3')	768.83	765.88		Note 2	P-12	ST-12	ST-13	2000	15	22	18.4	1.00			766.38	766.20		M.4		
ST-13	851+50.00, 21.00 RT	SW-509	770.62	765.60			P-13	ST-13	ST-14	2000	15	58	54.0	1.50			766.10	765.29		M.4		
ST-14	851+50.00, 33.00 LT	SW-509	770.31	764.69			P-14	ST-14	ST-15	2000	15	160	152.3	6.46			765.19	755.35		M.4		
ST-15	849+89.35, 35.68 LT	SW-510	762.65	753.00			P-15	ST-15	ST-17	2000	30	40	33.9	1.03			753.50	753.15		M.5	Division 3	
ST-16	1848+30.00, 30.00 RT	SW-512 (30-Inch)	758.75	754.26		Type 5 Cstg, Div. 3	P-16	ST-16	ST-17	2000	15	98	93.1	0.76			754.76	754.05		M.4	Division 3	
ST-17	850+00.00, 75.00 LT	SW-401 (72-Inch)	758.25	752.55		Division 3	P-17	ST-17	ST-18	2000	30	52	48.7	1.00	Type 3		753.05	752.56	752.50	M.5	Aprn Outlet, Div. 3	
ST-18	850+50.00, 104.06 LT	DR-201 (30-Inch)	752.50			Apron Ftg, Div. 3																
ST-19	853+25.60, 21.00 RT	SW-509	781.16	776.45			P-19	ST-19	ST-20	2000	15	58	54.0	1.50			776.95	776.14		M.4		
ST-20	853+25.60, 33.00 LT	SW-509	780.85	775.64			P-20	ST-20	ST-21	2000	15	114	109.9	Var.	Type 3		776.04	751.85	751.79	M.4	Let Down Pipe	
ST-21	853+23.50, 152.00 LT	DR-201 (15-Inch)	751.79																			
ST-22	861+84.00, 43.90 LT	SW-513 (3'x 3')	778.50	775.50		Note 2	P-22	ST-22	ST-24	2000	15	22	18.4	5.50			776.00	774.96		M.6		
ST-23	861+84.00, 43.90 RT	SW-513 (3'x 3')	778.20	775.20		Note 2	P-23	ST-23	ST-25	2000	15	10	6.4	15.20			775.70	774.65		M.6		
ST-24	861+82.03, 21.00 LT	SW-509	778.61	773.61			P-24	ST-24	ST-25	2000	15	58	54.0	1.50			774.11	773.30		M.6		
ST-25	861+82.03, 33.00 RT	SW-509	778.30	772.70			P-25	ST-25	ST-27	2000	15	170	161.7	5.66			773.20	764.05		M.6		
ST-26	863+51.70, 21.00 LT	SW-509	769.42	764.35			P-26	ST-26	ST-27	2000	15	58	54.0	1.50			764.85	764.04		M.6		
ST-27	863+51.70, 33.00 RT	SW-509	769.10	759.10			P-27	ST-27	ST-32	2000	15	90	82.2	4.38			759.60	756.00		M.6		
ST-28	3863+35.00, 30.20 RT	DR-201 (12-Inch)	760.40			Division 2	P-28	ST-28	ST-30	2000	12	64	60.1	2.71			760.25	758.7	760.4	M.6	Apron Inlet, Div. 2	
ST-29	3864+20.00, 26.80 RT	DR-201 (12-Inch)	761.15			Division 2	P-29	ST-29	ST-30	2000	12	18	16.6	12.24			760.55	758.7	761.15	M.6	Apron Inlet, Div. 2	
ST-30	3864+00.00, 11.50 RT	SW-507	762.92	758.00		Division 2	P-30	ST-30	ST-31	2000	15	26	23.0	1.00			758.5	758.27		M.6	Division 2	
ST-31	3864+00.00, 11.50 LT	SW-507	762.92	757.67		Division 3	P-31	ST-31	ST-32	2000	15	108	104.6	2.07			758.17	756		M.6	Division 3	
ST-32	2864+80.00, 14.00 LT	SW-509	764.95	754.95		Division 3	P-32	ST-32	ST-33	2000	18	86	81.4	Var.	Type 3		755.45	750.78	750.66	M.6	Aprn Outlet, Div. 3	
ST-33	865+25.00, 60.00 RT	DR-201 (18-Inch)	750.66			Division 3																
ST-34	878+00.00, 60.00 LT	DR-201 (18-Inch)	756.30				P-34	ST-34	ST-35	2000	18	152	148.7	1.24			756.23	754.38	756.3	M.7	Apron Inlet	
ST-35	879+52.00, 60.00 LT	SW-401 (48-Inch)	758.38	753.78			P-35	ST-35	ST-36	2000	18	48	46.1	0.54			754.28	754.03	754	M.7	Apron Outlet	
ST-36	879+99.50, 81.36 LT	DR-201 (18-Inch)	754.00																			
SN-01	1848+95.23, 40.95 RT	Existing Sanitary Manhole	761.33			Adjust +0.80'	P-S01		SN-02	PVC	10	14	12.0	0.30			752.42	752.38		M.8	Stub Pipe, Div. 2	
SN-02	1847+73.25	SW-301	757.98			Division 2	P-S02	SN-02	SN-01	PVC	10	132	126.7	0.30			752.38	752		M.8	Division 2	
Note 1: Form Grade Elev. = Inlet Elev. Note 2: Provide Precast Base, Form Grade Elev. = Inlet Elev.																						

SURVEY SYMBOLS

- CP Control Point
- ▲ BM Bench Mark
- PPA Power Pole Co. 1
- PLG Location of General Photo
- ☒ IN Storm Sewer Intake
- ☐ SIGN SI Sign
- LC Lot Corner
- BB Billboard
- WV Water Valve
- WH WHD Water Hydrant
- TP TPD Telephone Pedestal
- TDC Tree Deciduous
- * TEV Evergreen Tree
- ☒ SHR Shrub
- PR Electric Riser Pole
- ☐ SIGN SL Speed Limit Sign
- ⊕ MH Utility Access (Manhole)
- MIS Miscellaneous
- MM Mile Marker Post
- ⊗ WEL Well
- LUM Luminaire
- GP GP Guard Post (Less Than 4 Posts)
- GV Gas Valve
- ☐ EB EB Electrical Box
- ☐ UB UB Utility Box
- Fig FLG Flag Poles
- ▼ FHD Fire Hydrants
- ♣ STP Stump
- OUT Tile Outlet
- ⊗ INB Storm Sewer Beehive Intake
- ☐ S Soil Sampling Site (Wetlands)
- TVP TV Pedestal
- SP Stream Profile
- TW Top of Water
- BLD Building or Foundation
- LIN Miscellaneous Line
- ST Spiral Point
- RET Retaining Walls
- BRG Bridge
- TLNR Tree Line Right
- TLNL Tree Line Left
- CON Concrete or A/C Slab
- CUL Culvert
- FCL Chain Link and Security Fence
- GDL Guard Rail Steel
- BL Topo Breakline
- FWD Wood Fence
- D Centerline Draw or Stream (Down)
- DU Centerline Draw or Stream (Up)
- FW Wire Fence
- PIP Pipe Culvert
- RRR Railroad Rail
- CU Back of Curb
- ENU Edge Unpaved Entrance & Parking
- ENP Edge Paved Entrance & Park Lot
- EP Edge of Paved Roads (ML or SR)
- GU Gutter In Front of Curb
- SNP Unpaved Shoulder
- BNK Stream Bank
- EG Edge of Gravel Road
- EW Edge of Water
- ENT Centerline BL of Entrance
- SH Paved Shoulder
- RIP Rip-Rap
- TRL Trail
- SWK Sidewalk
- TV Satellite TV Dish
- TR Telephone Riser Pole
- ☐ TSB Telephone Switch Box
- UV Underground Utility Vault
- VS Channel Cross Section
- BLS Bridge Low Steel

- G(C) — GL1C Gas Line Co. 1 - Quality C
- GL1D Gas Line Co. 1 - Quality D
- Default_Chain Default Chain Feature
- WL3D Water Line Co. 3 - Quality D
- SA1D Sanitary Sewer Co. 1- Quality D
- T(C) — TL1C Telephone Line Co. 1 - Quality C
- St.S.(C) ST1C Storm Sewer Co. 1 - Quality C
- ST Spiral Point
- San.(C) SA1C Sanitary Sewer Co. 1- Quality C
- SA2D Sanitary Sewer Co. 2 - Quality D

UTILITY LEGEND

- PPA Alliant Energy
- TP TPD Telephone Pedestal
- WV Water Valve
- WH WHD Water Hydrant
- PR Electric Riser Pole
- GV Gas Valve
- ☐ EB EB Electrical Box
- ☐ UB UB Utility Box
- ▼ FHD Fire Hydrants
- TVP TV Pedestal
- GLA MidAmerican Energy
- ELB Linn County Rural Electric Cooperative
- FOA South Slope Phone Internet Television
- FOB Mediacom
- F03(C) — FOC Sprint/Nextel
- San.(C) SA1C City of Fairfax
- SA1D City of Fairfax
- SA2D City of Cedar Rapids
- TLA South Slope Phone Internet Television
- TLB Centurylink
- TVA Underground TV Cable Co. 1
- Water Line City of Cedar
- Water Line City of Cedar Rapids
- Water Line City of Fairfax

PLAN VIEW COLOR LEGEND OF STORM SEWER SHEETS

LINEWORK	Design Color No.	Description
Gray, Dark	(112)	Existing Topographic Features, Utilities, and Labels
Black	(17)	Proposed Storm Sewer Details, Alignment, Stationing, Tic Marks, and Alignment Annotation
SHADING	Design Color No.	Description
Gray, Light	(48)	Proposed Pavement Shading

PROFILE VIEW COLOR LEGEND OF STORM SEWER SHEETS

LINEWORK	Design Color No.	Description
Gray, Dark	(112)	Existing Ground Line Profile and Existing Utilities Information
Black	(17)	Proposed Pipes and Intakes

PLAN VIEW LINE STYLE LEGEND OF STORM SEWER SHEETS

- Plug and Abandon Existing Pipe or Structure
- Removal of Existing Pipe or Structure
- Previously Constructed Pipe or Structure
- Direction of Pipe Flow

PROFILE VIEW LINE STYLE LEGEND OF STORM SEWER SHEETS



- Existing Ground
- Proposed Ground
- Previously Constructed Pipe or Structure
- Proposed Pipe or Structure



RIGHT-OF-WAY LEGEND


- Reference Point
- Station
- ▲ Section Corner
- Ground Line Intercept
- //// Saw Cut
- Guardrail
- ▨ Clearing & Grubbing Area
- ▨ Pavement Removal
- ▲ Proposed Right-of-Way
- ▲ Existing and Proposed Right-of-Way
- ▲ Easement and Existing Right-of-Way
- Borrow
- Easement (Temporary)
- Easement
- X Excess
- A/C Access Control

STORM SEWER LEGEND AND SYMBOL INFORMATION SHEET


(COVERS SHEET SERIES M)

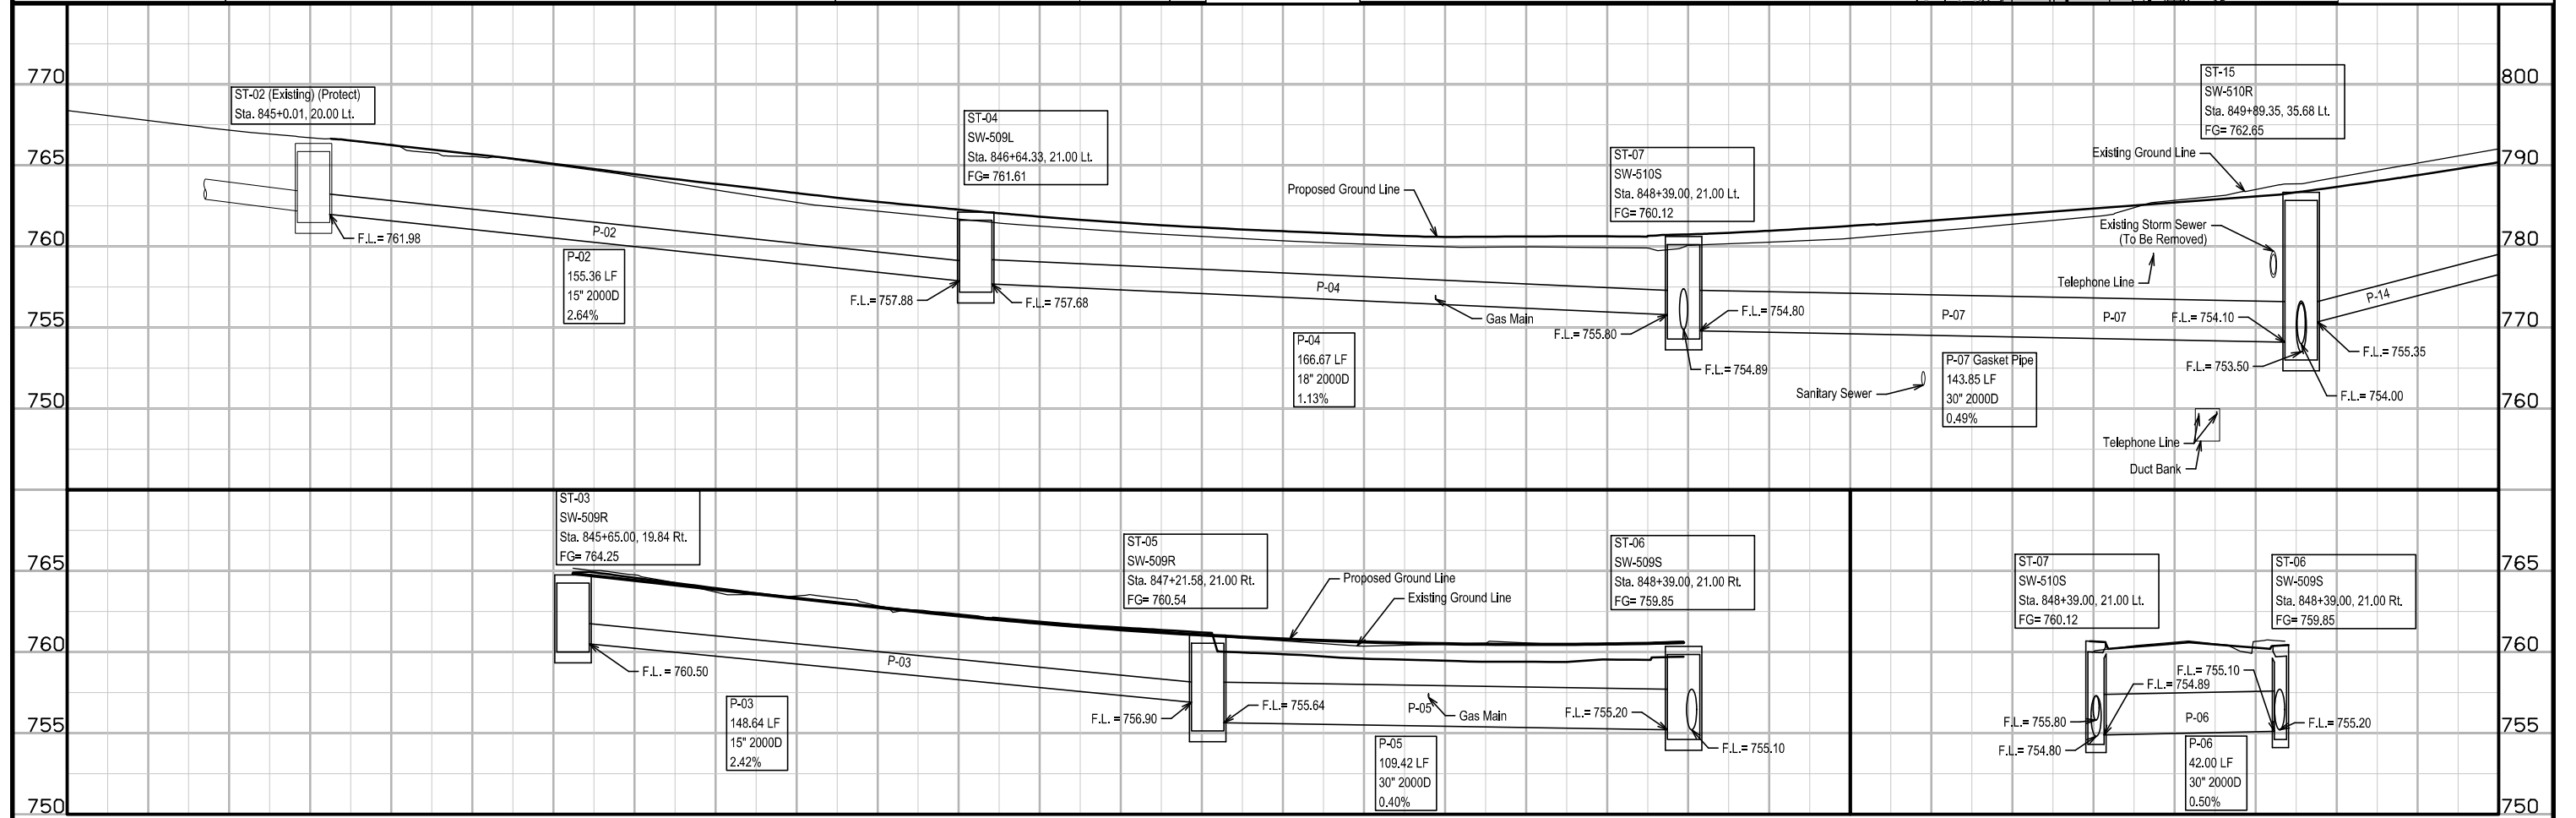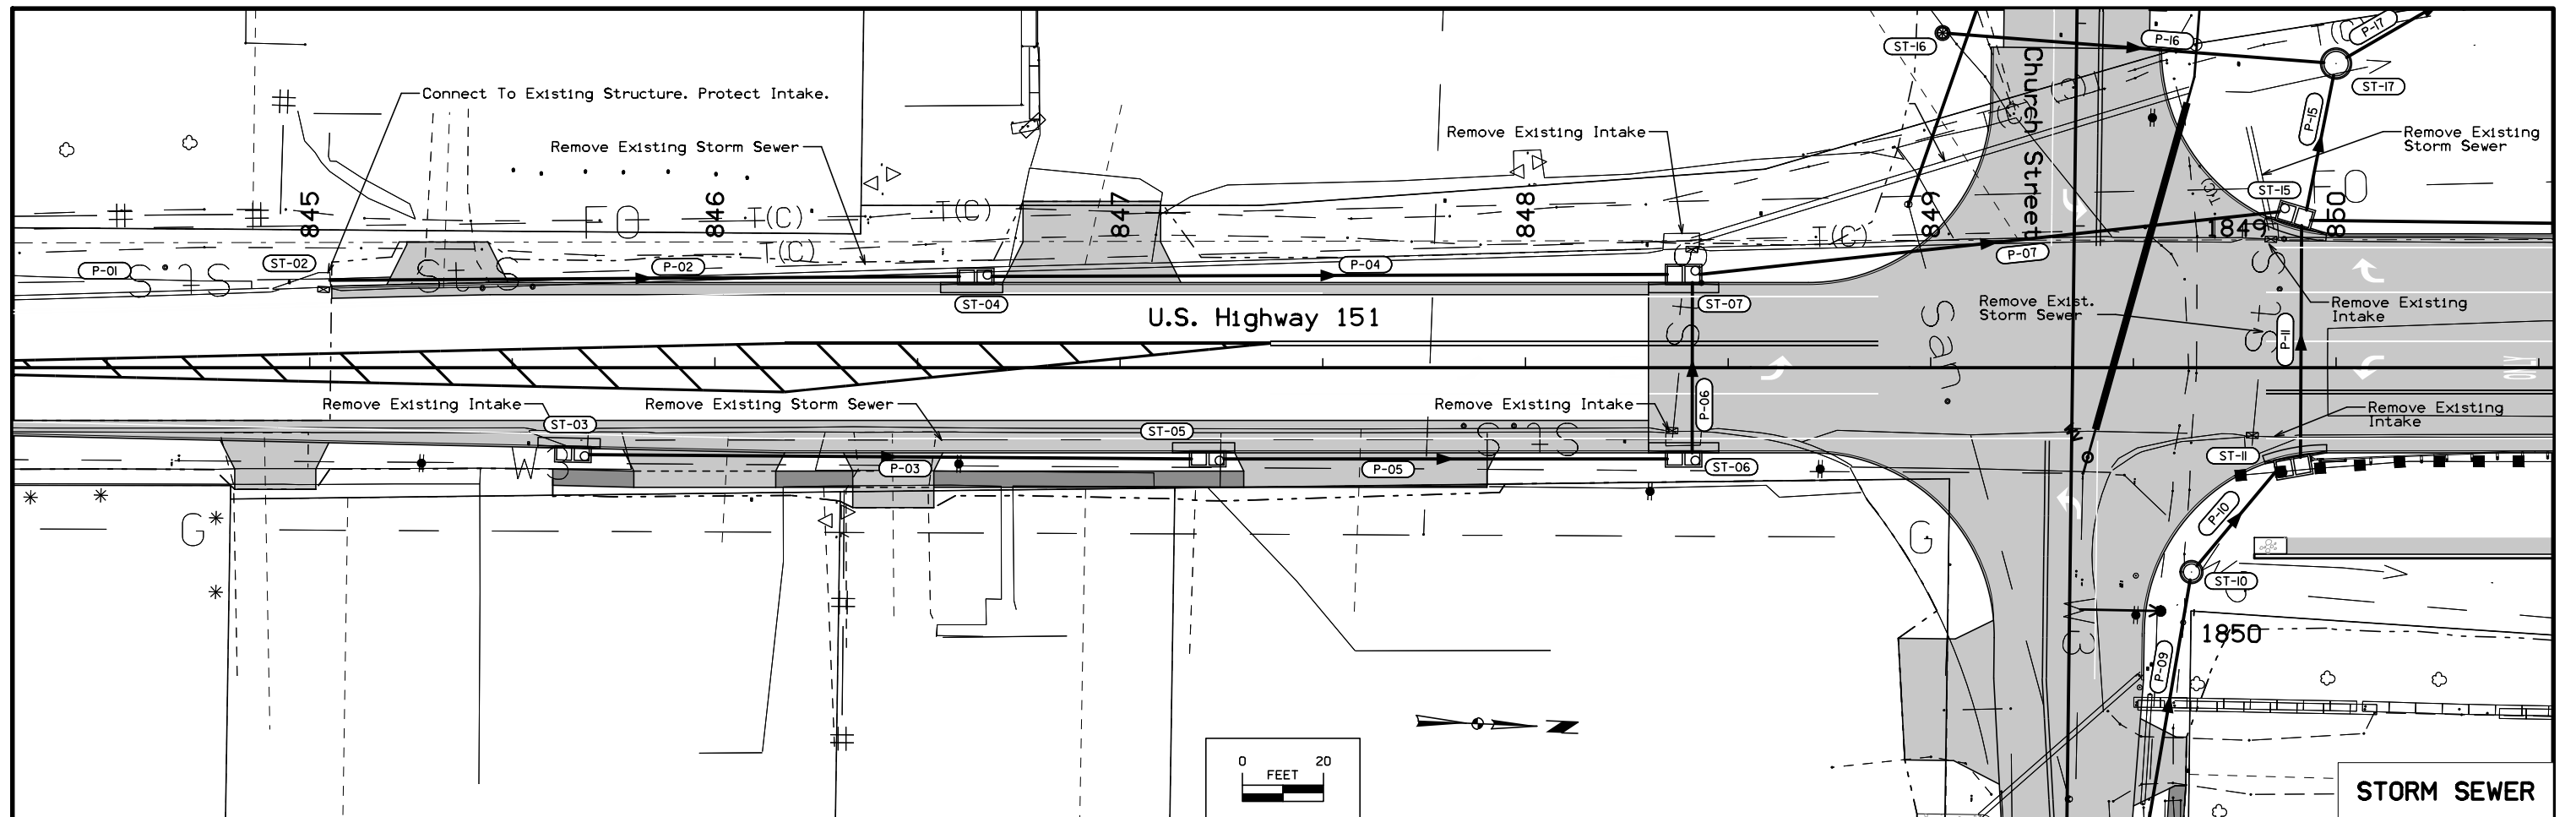


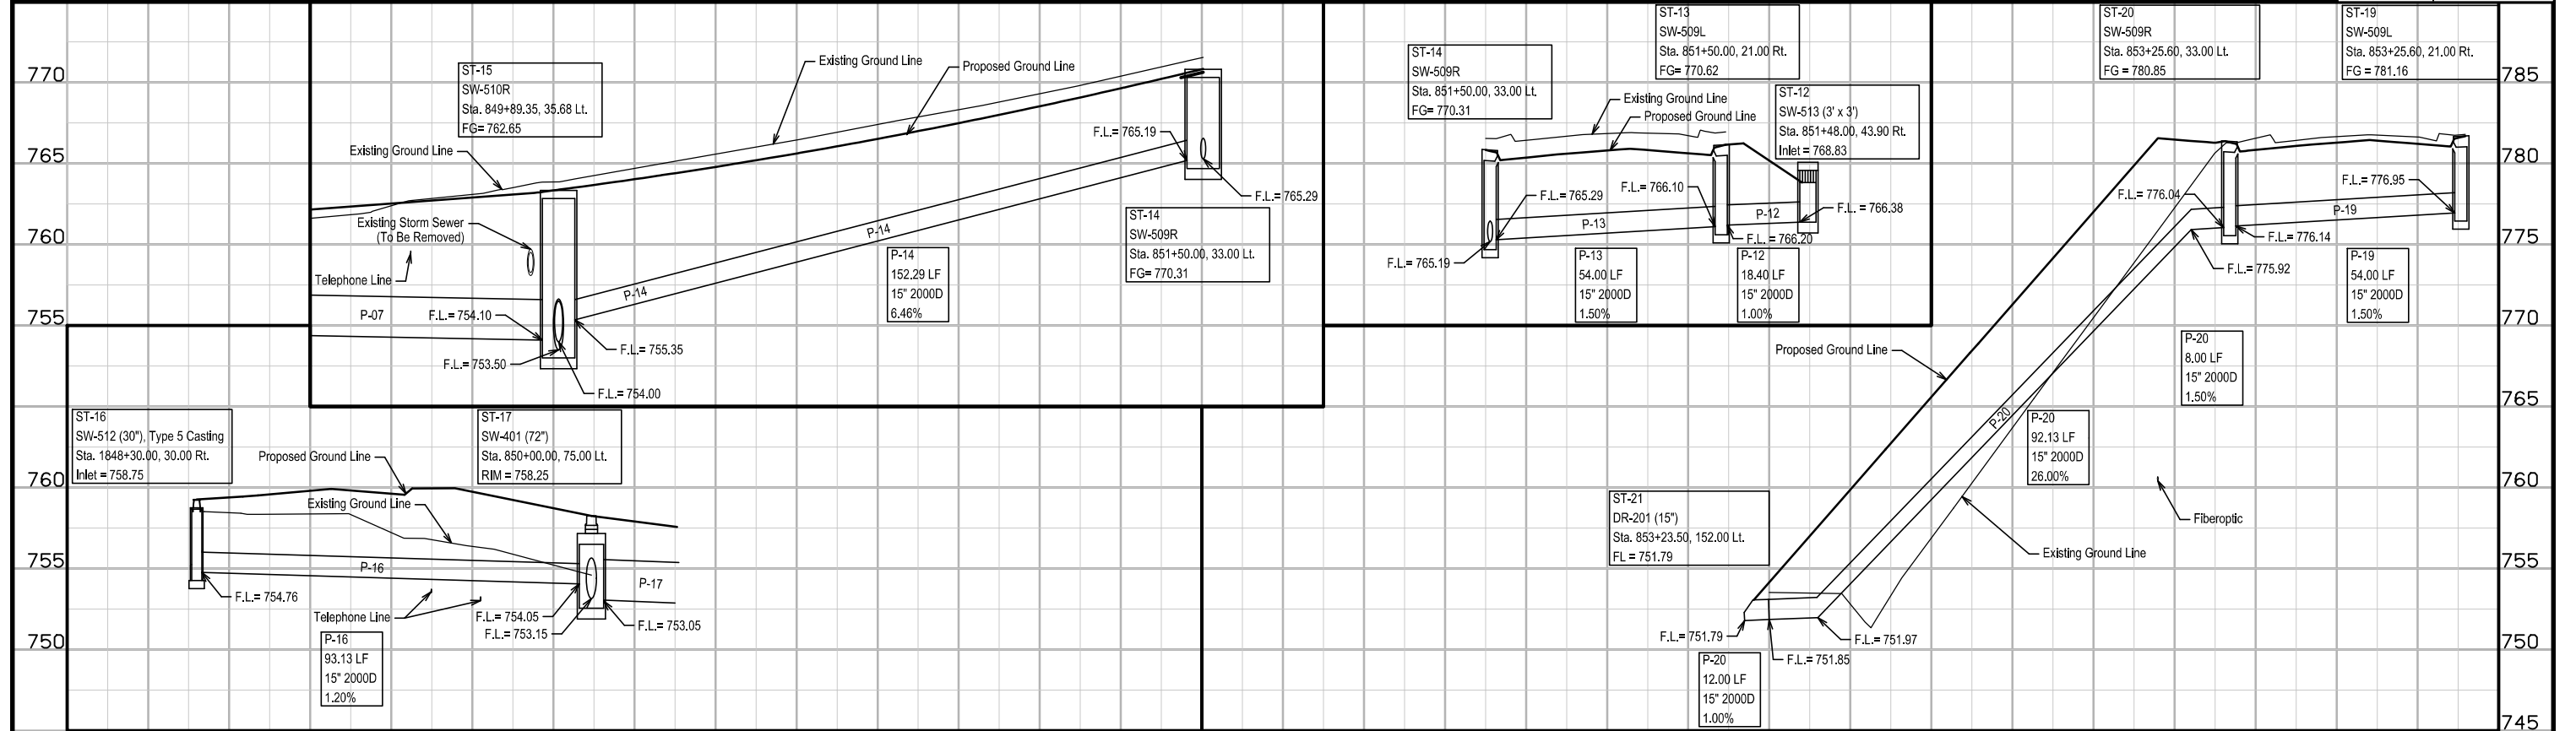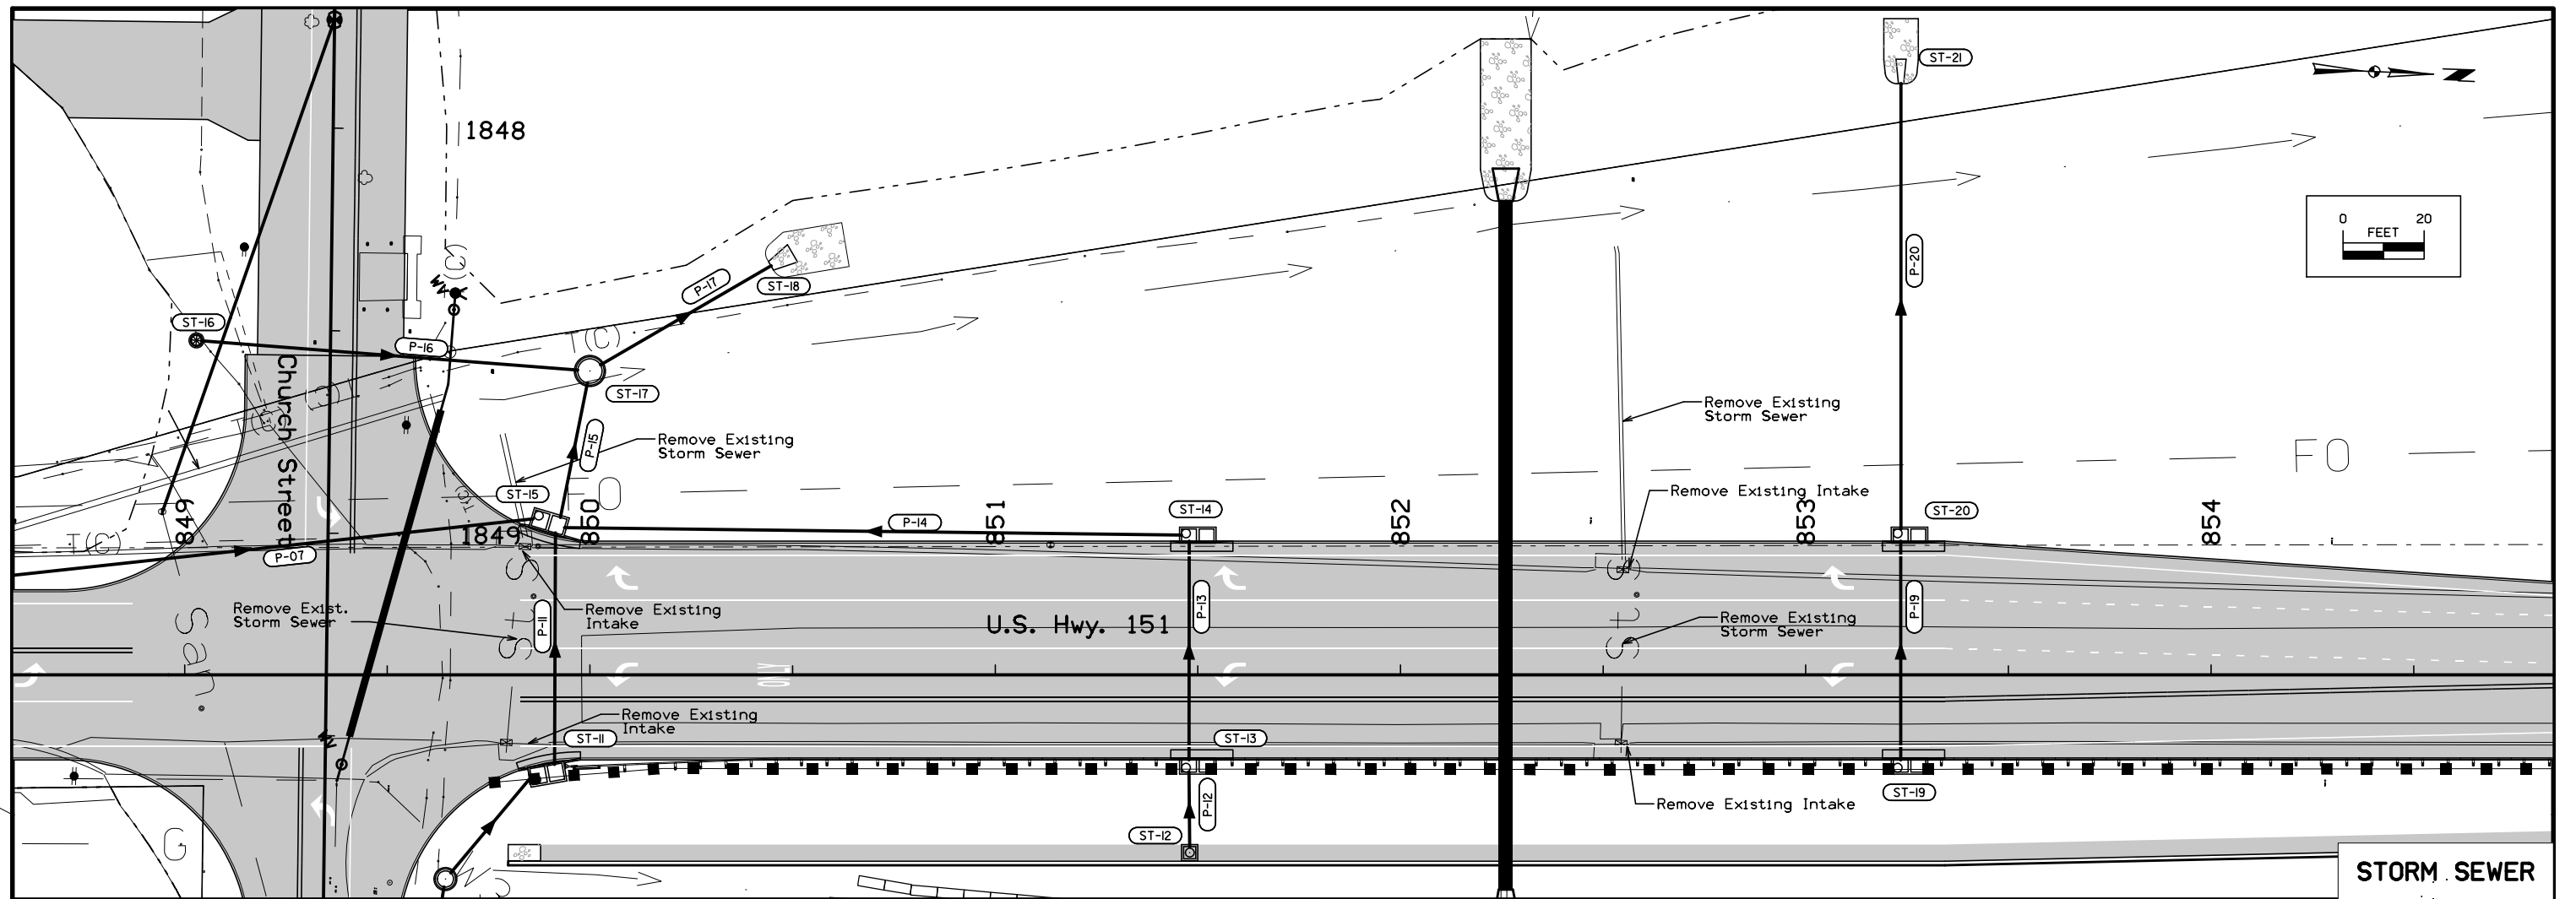

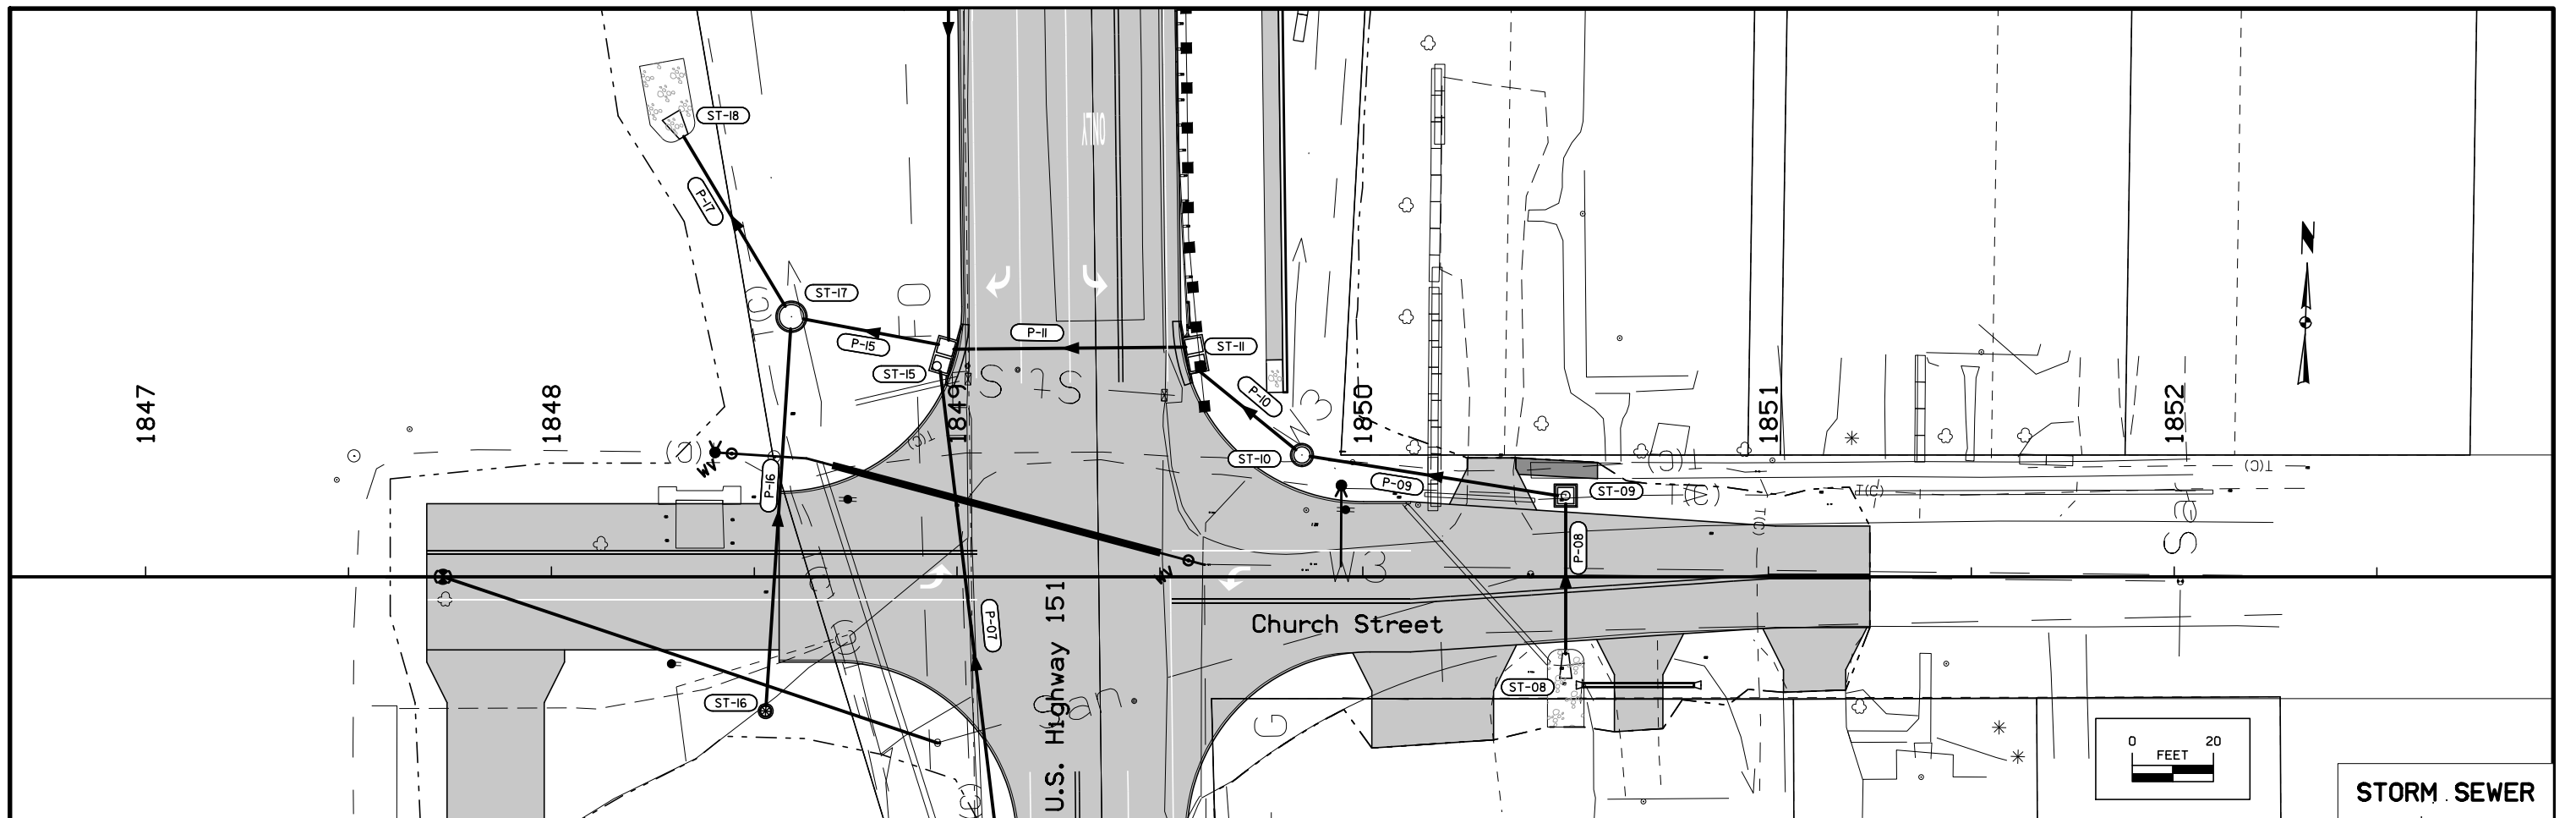




STORM SEWER

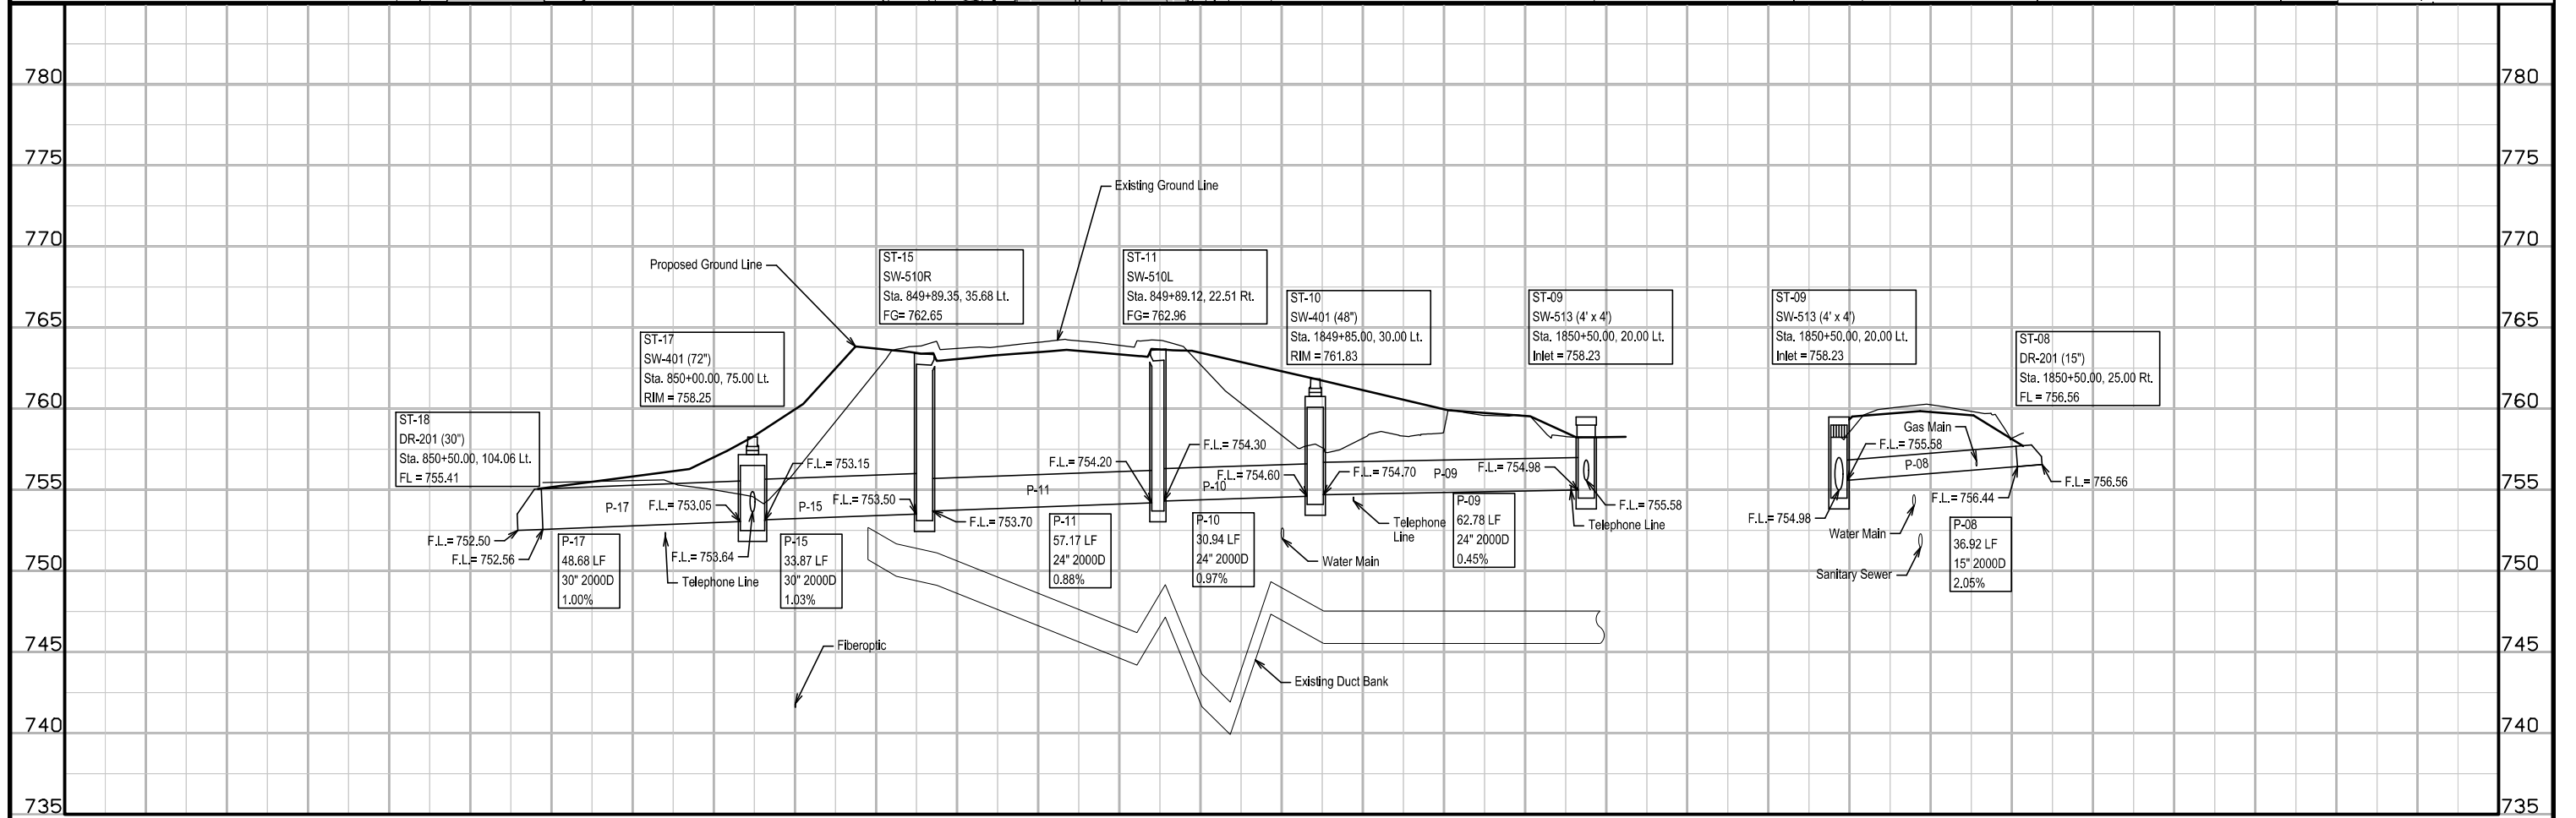


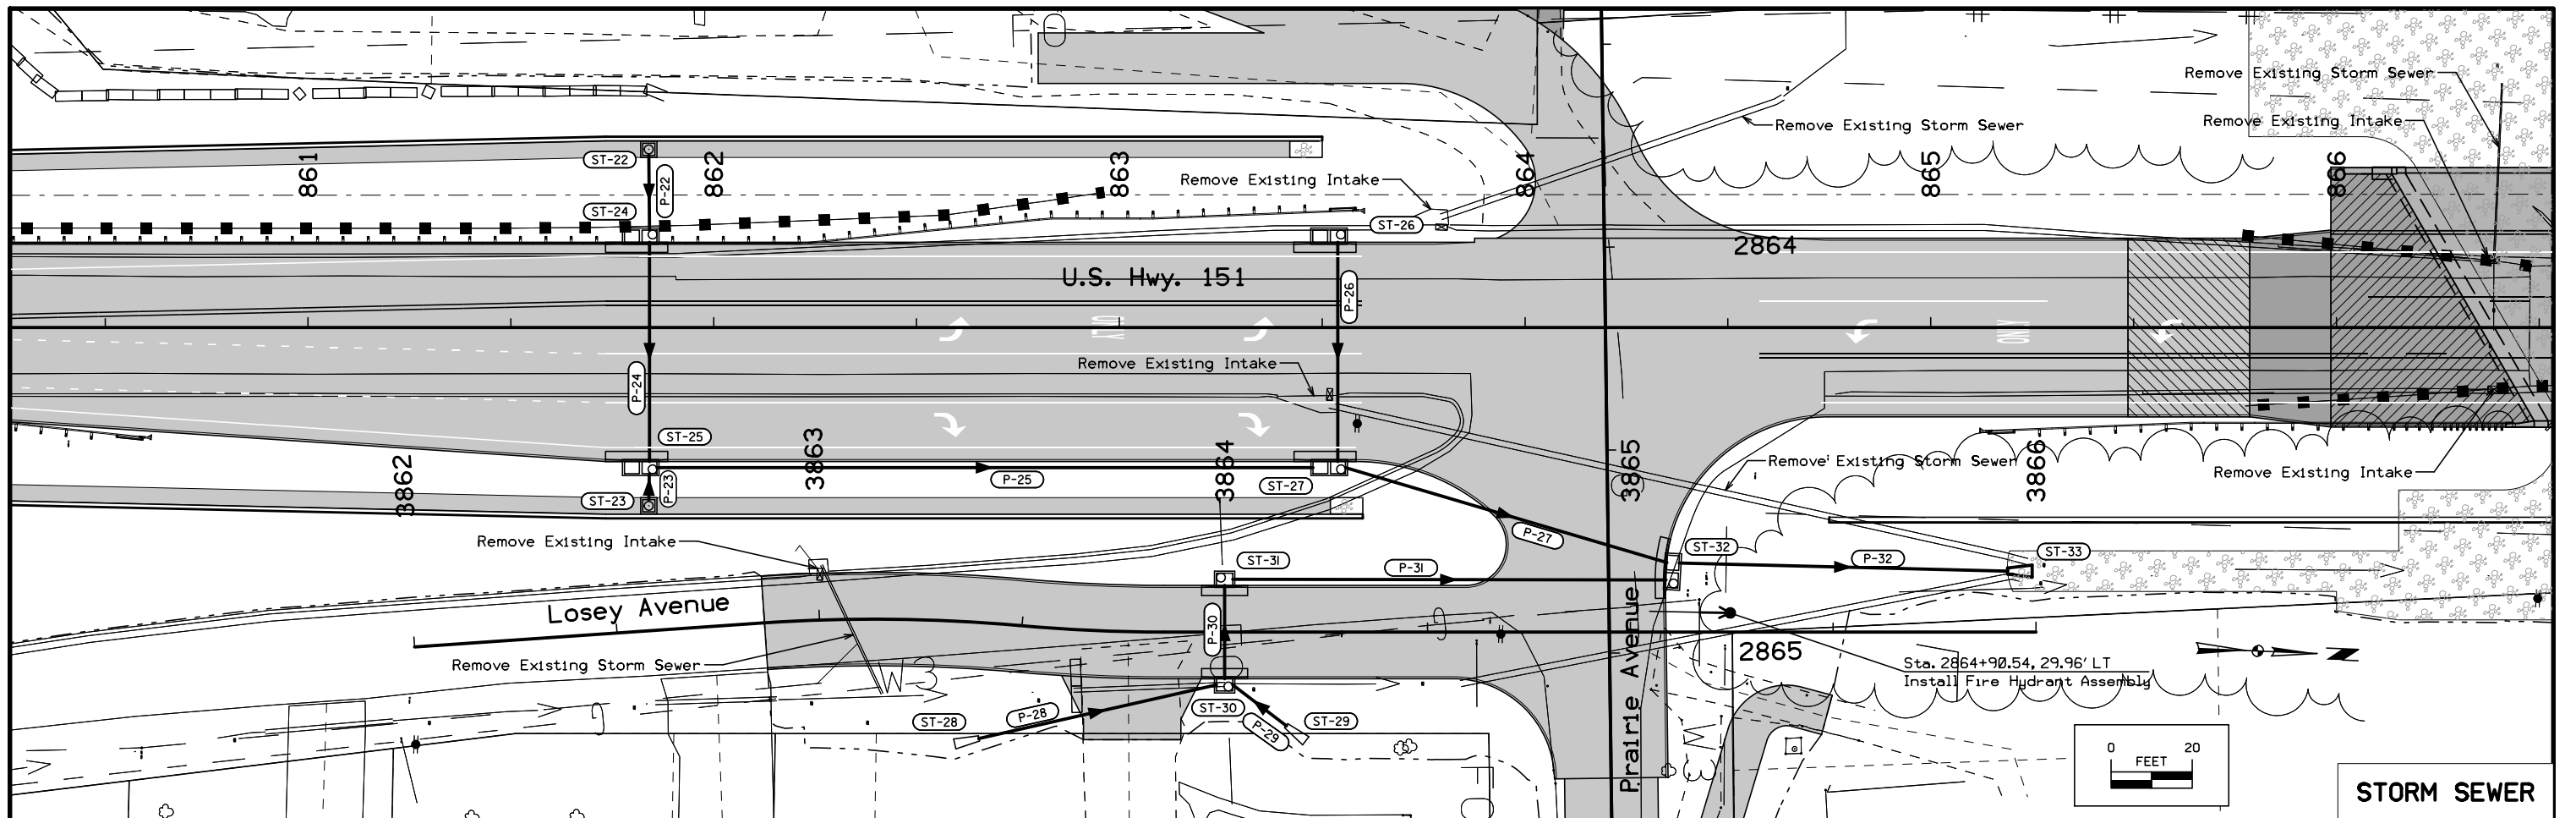


STORM SEWER


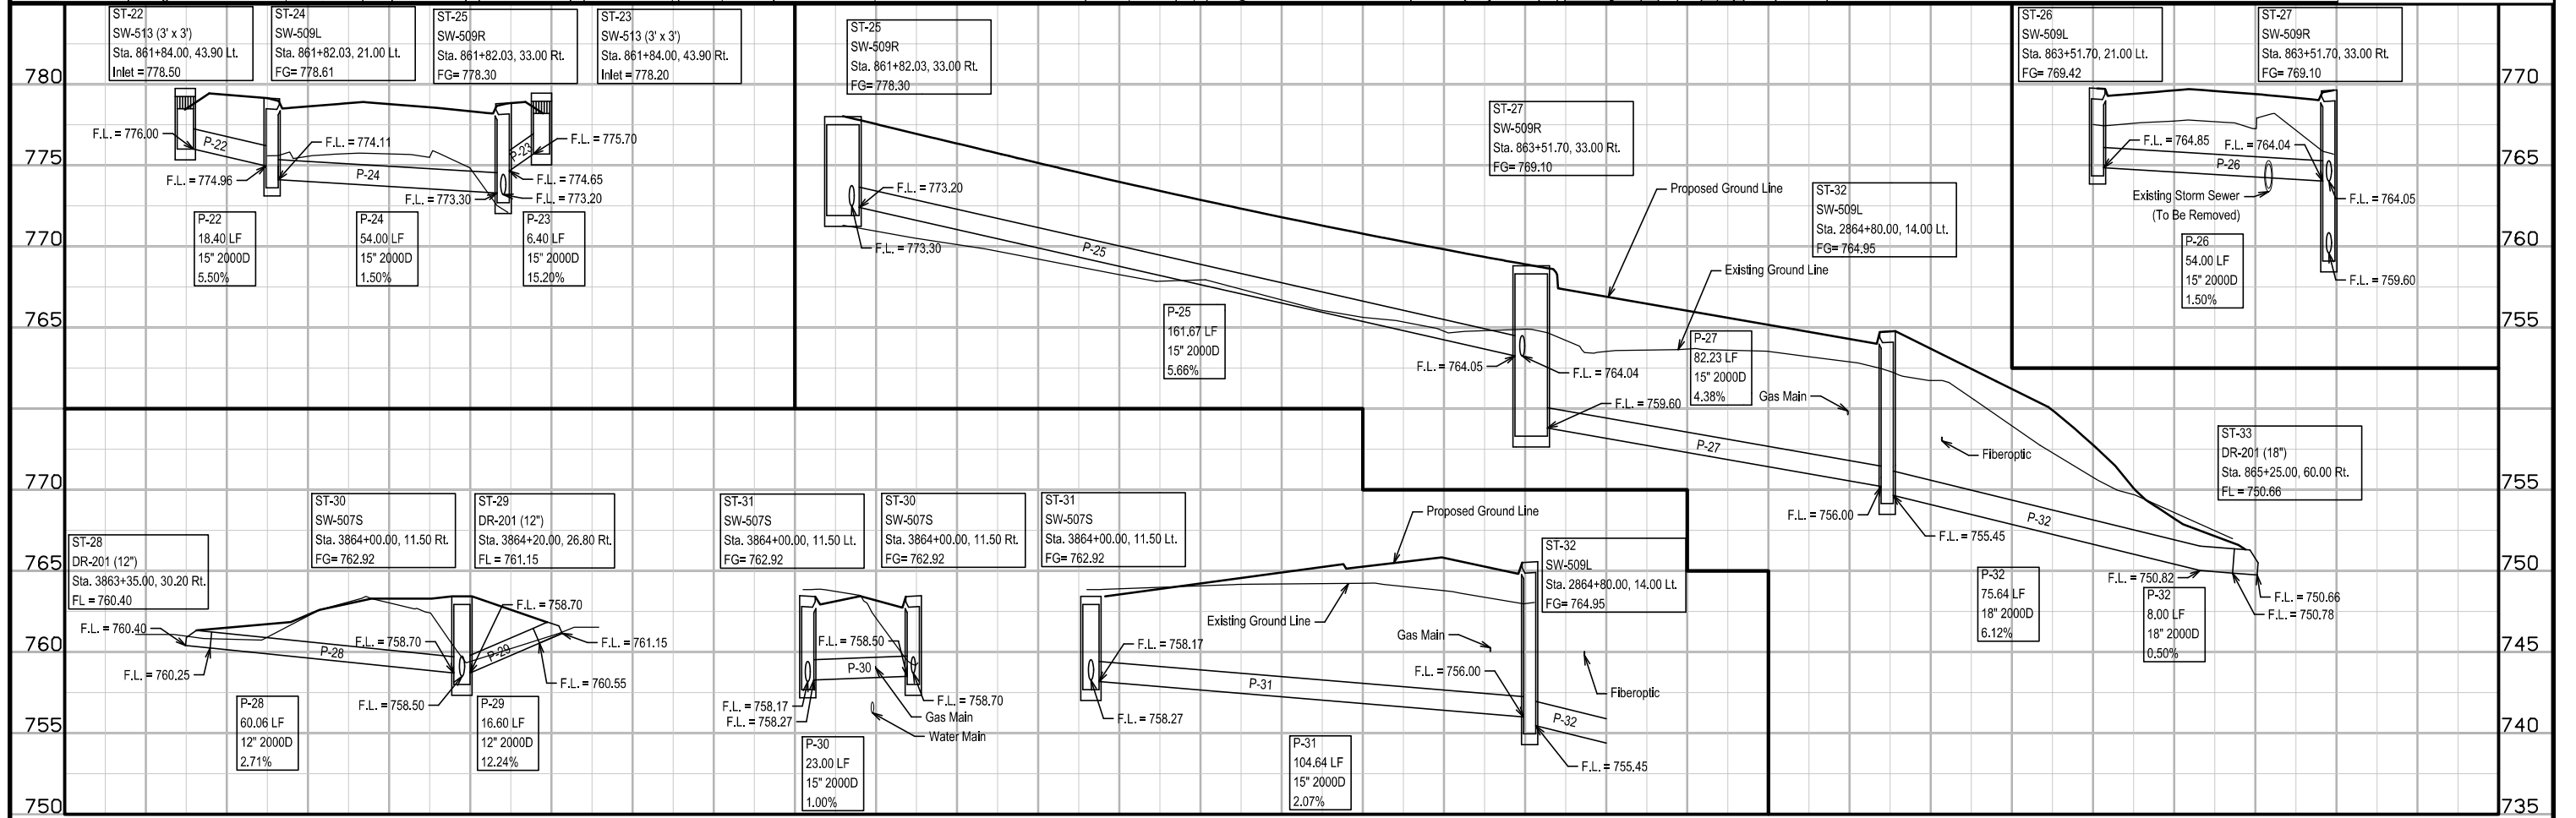


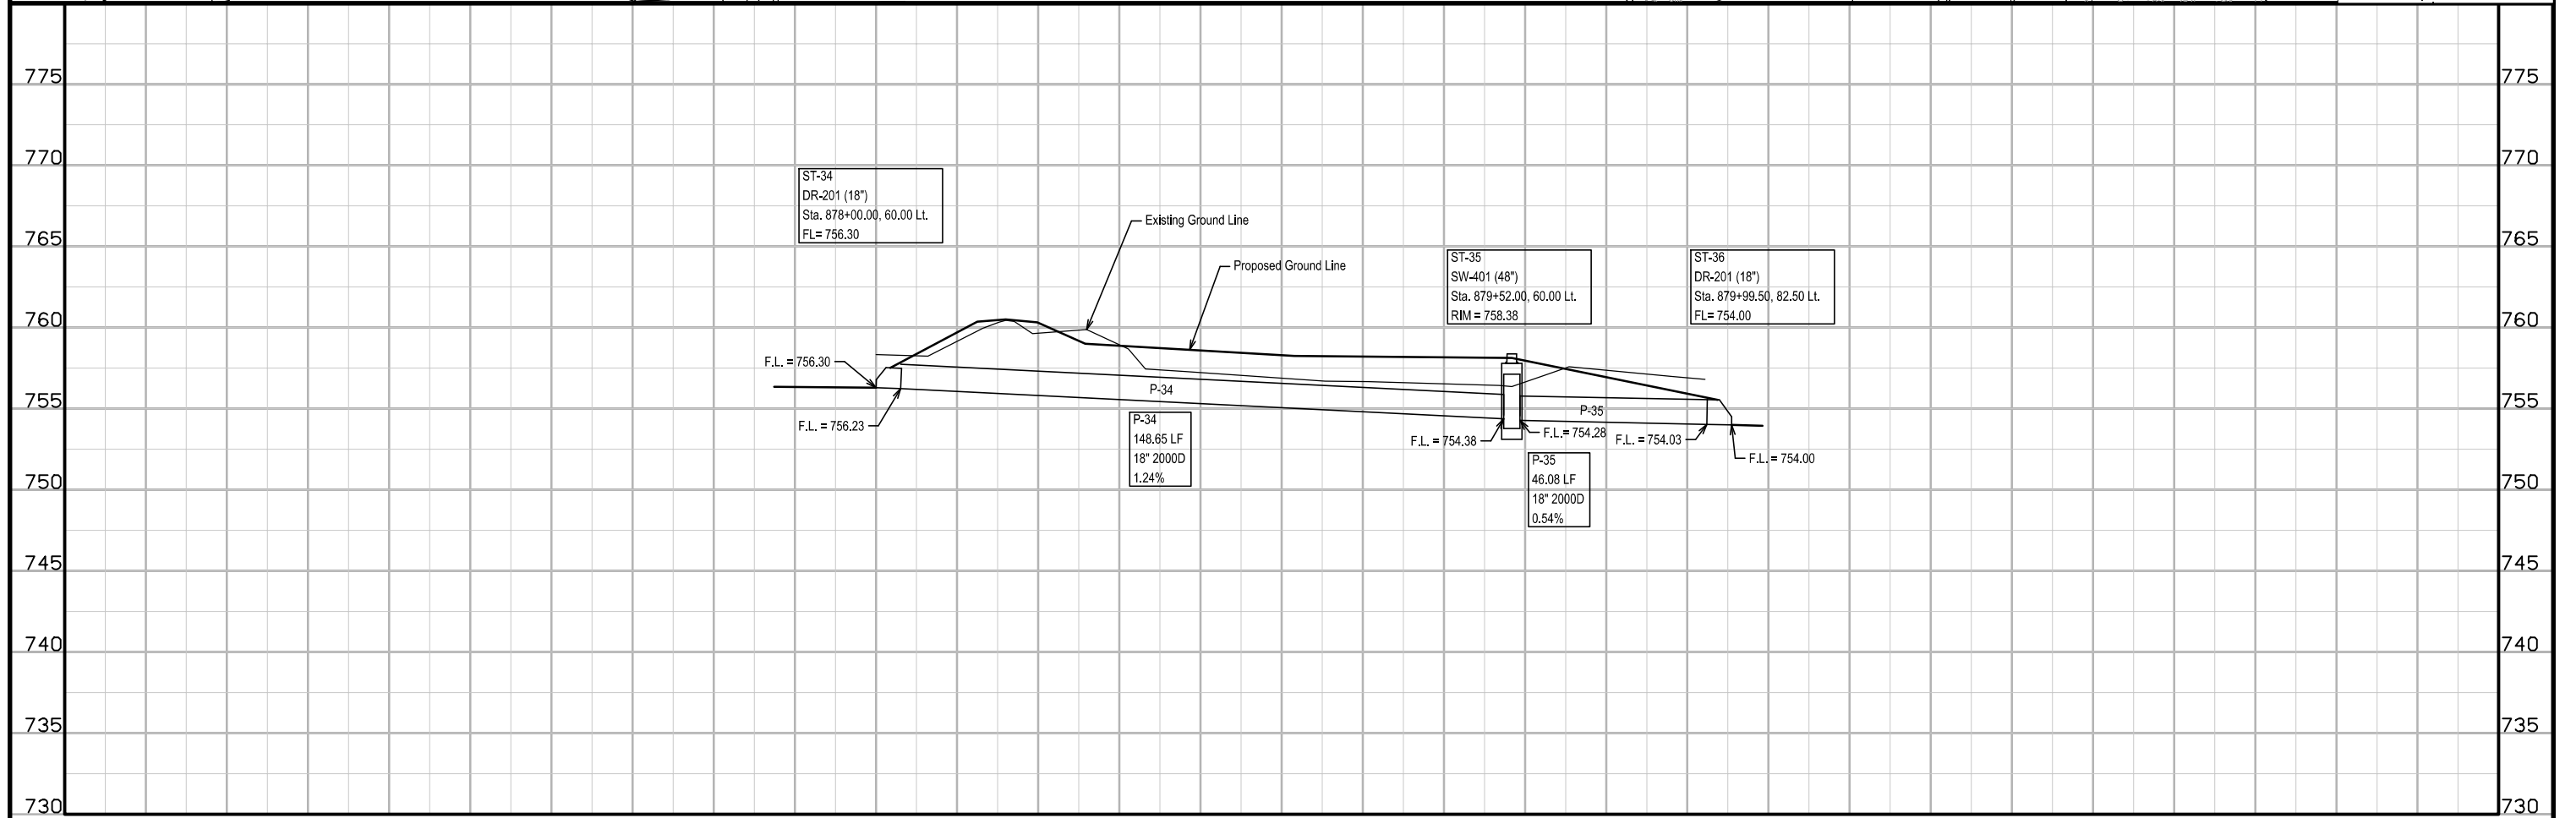
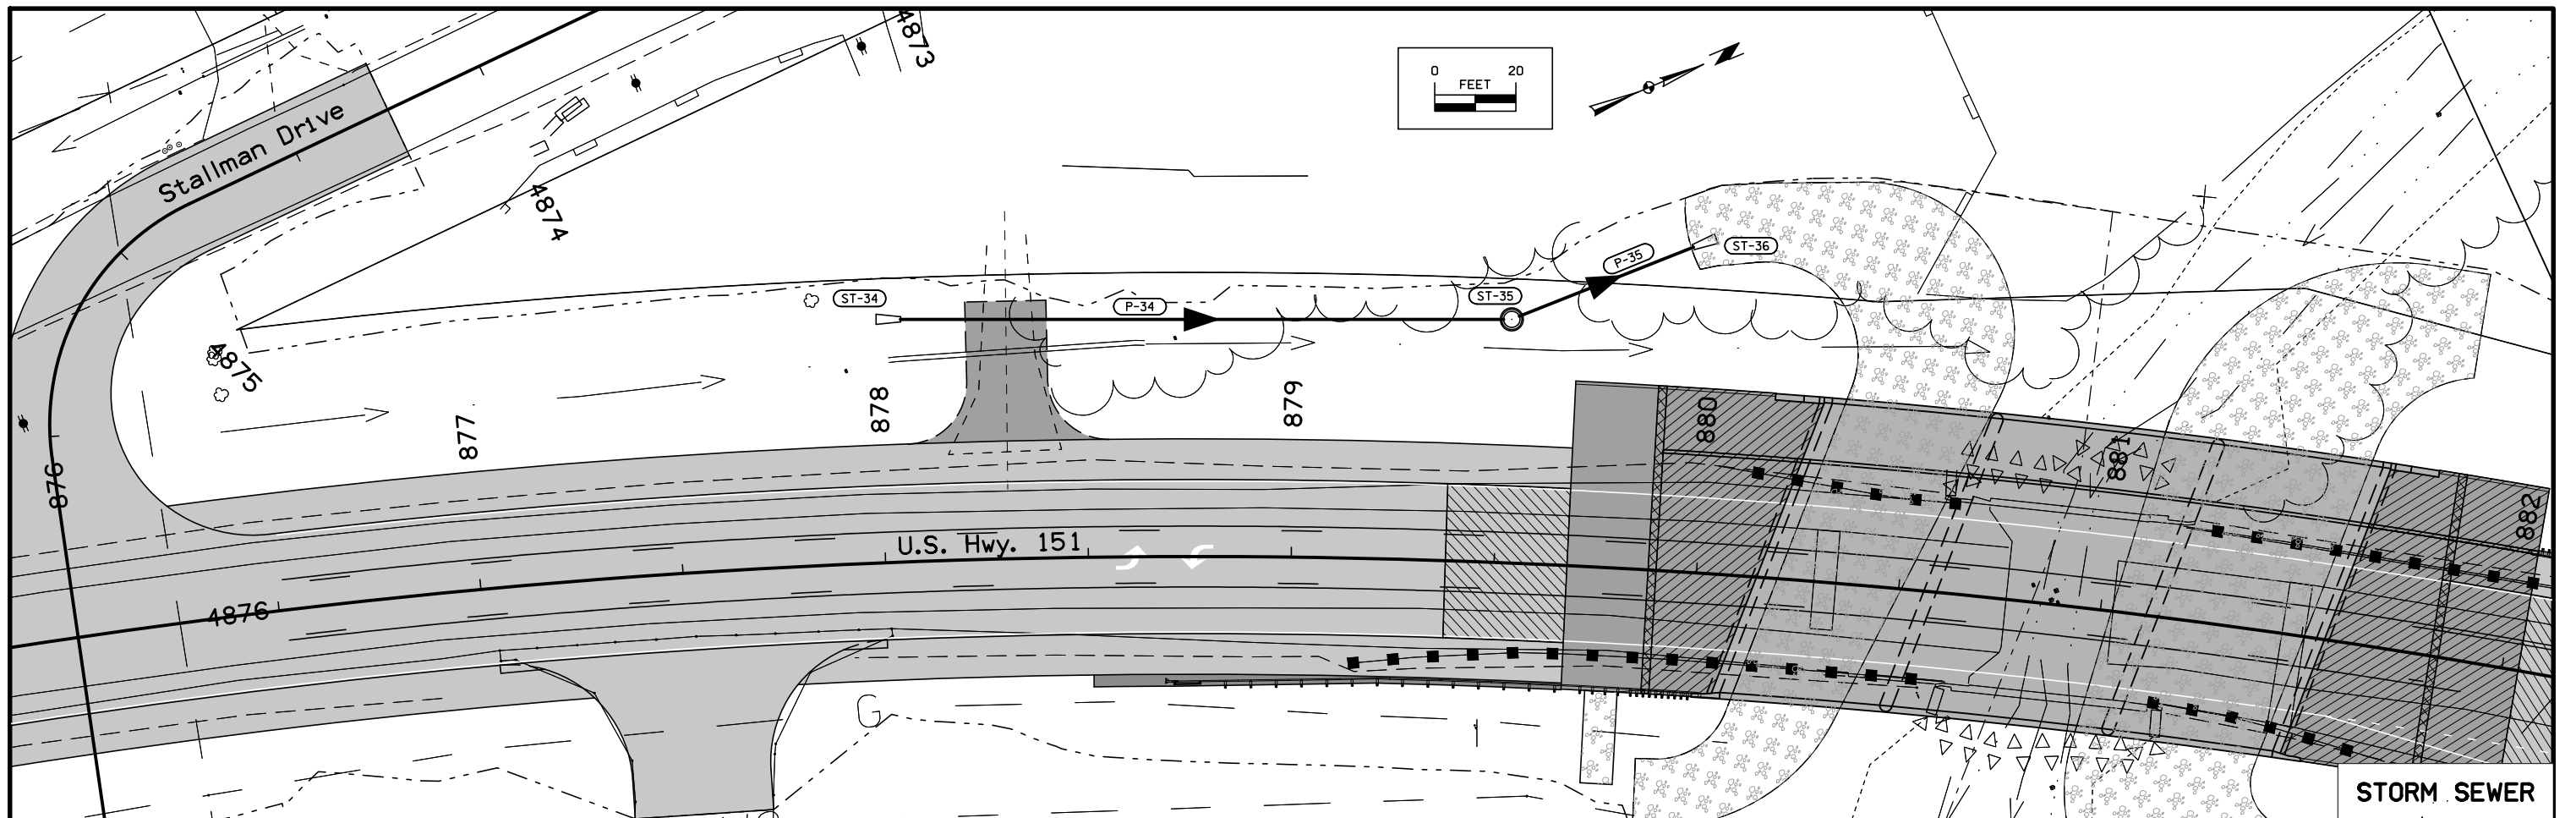


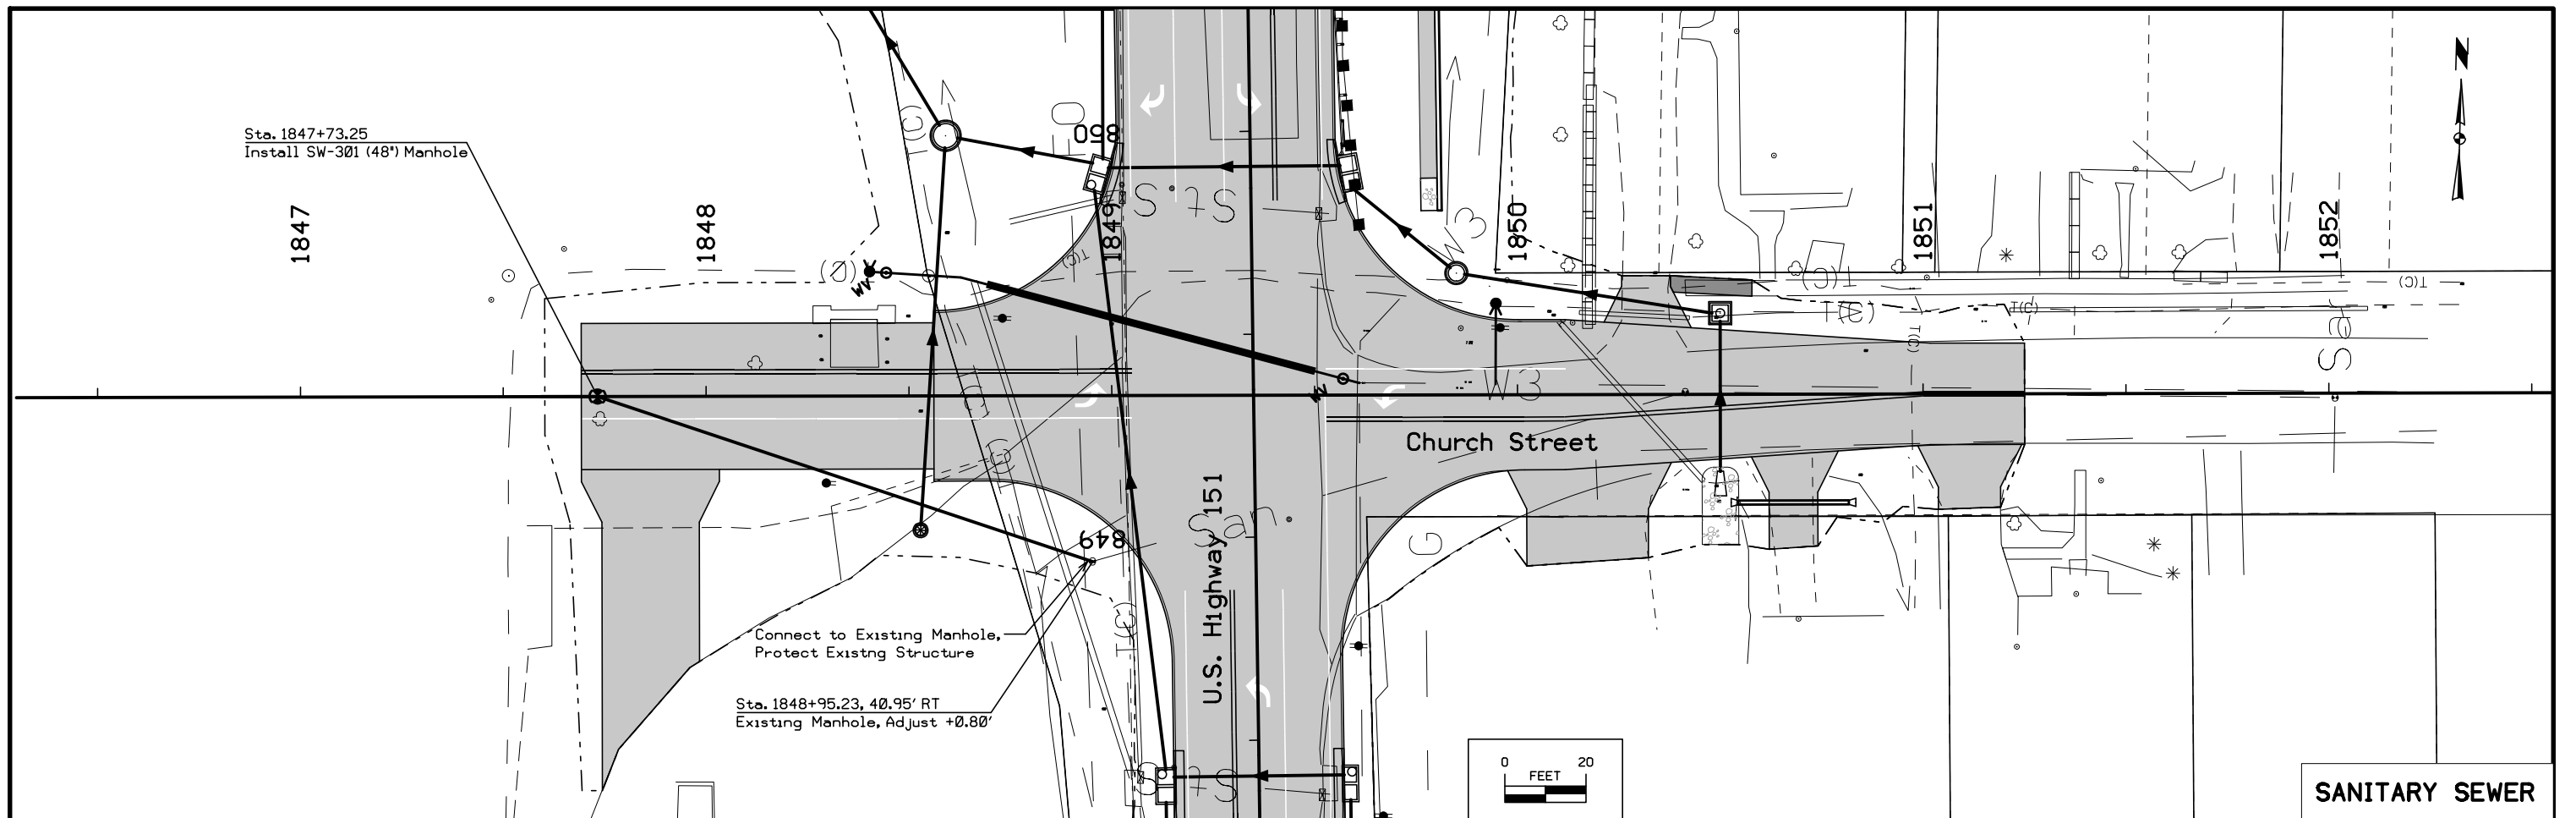

SANITARY SEWER

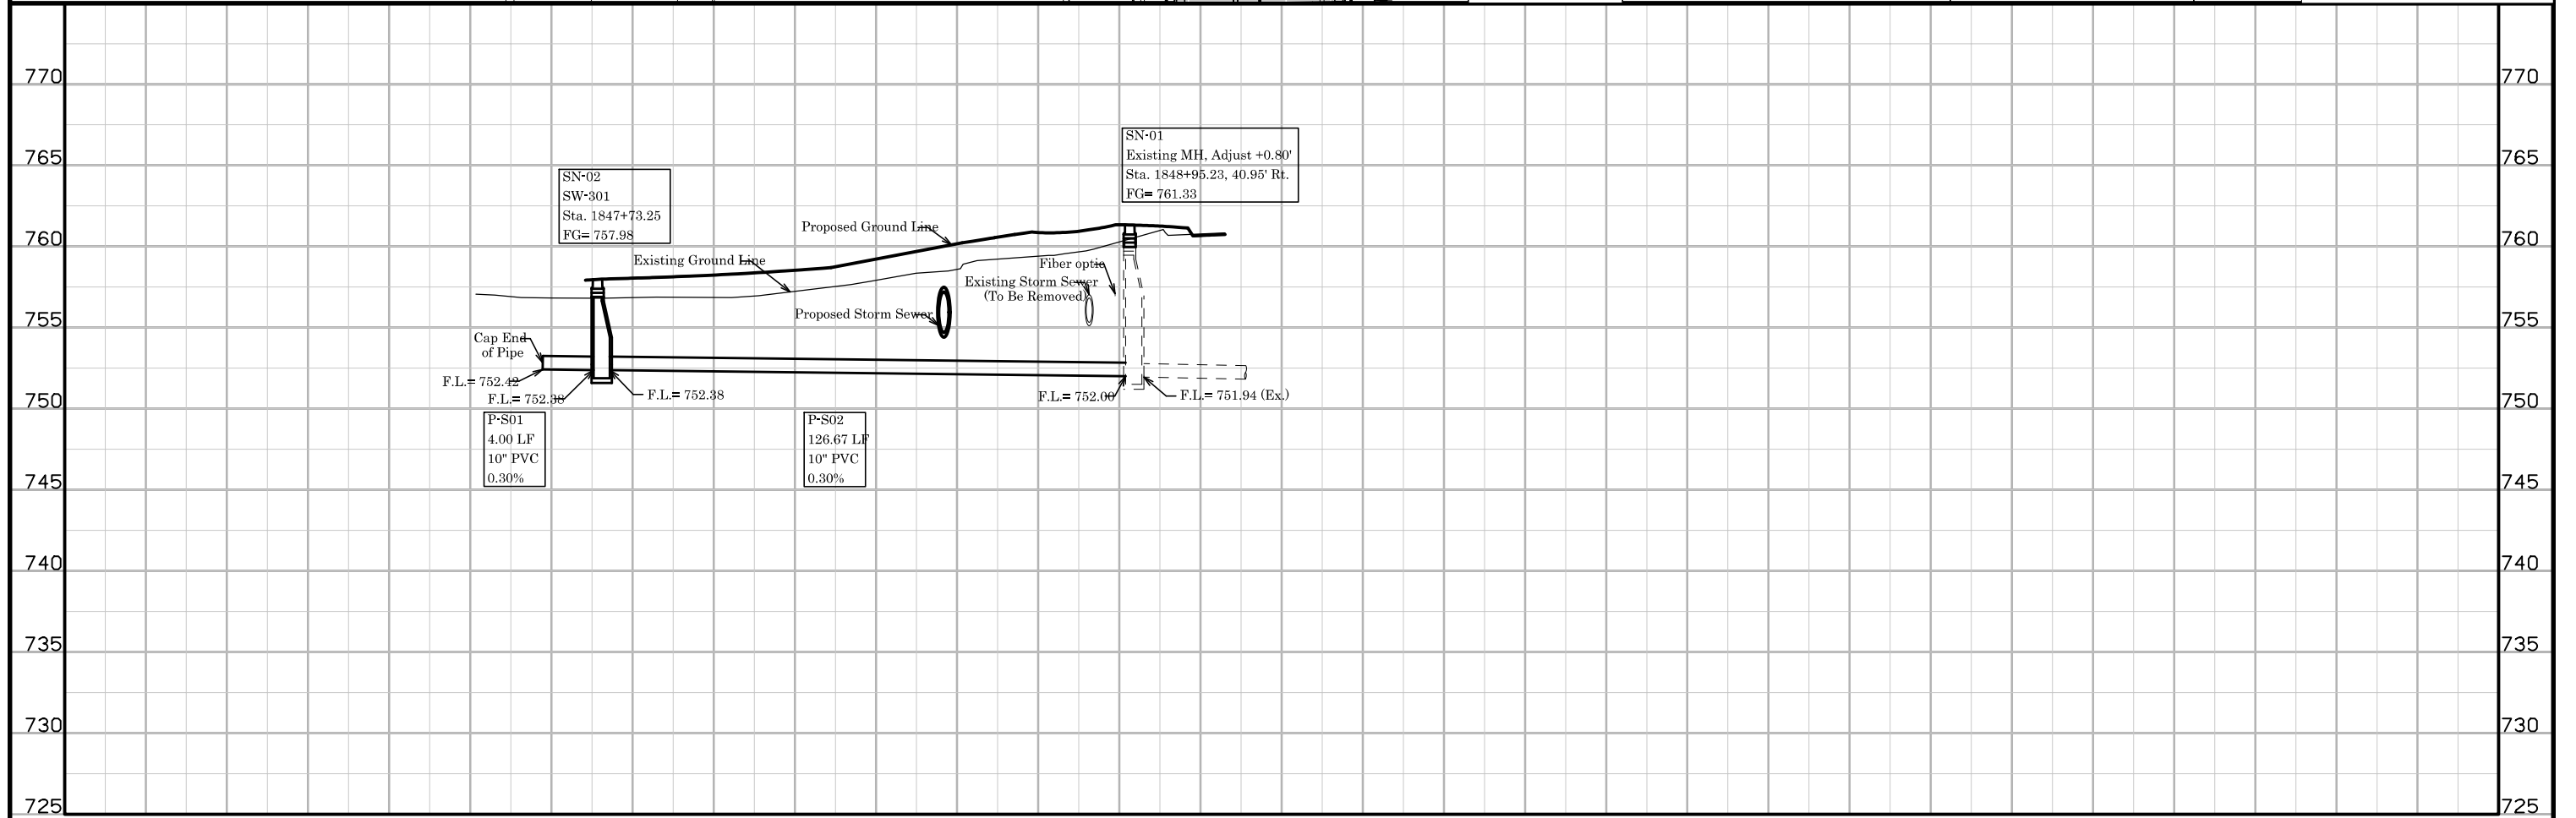

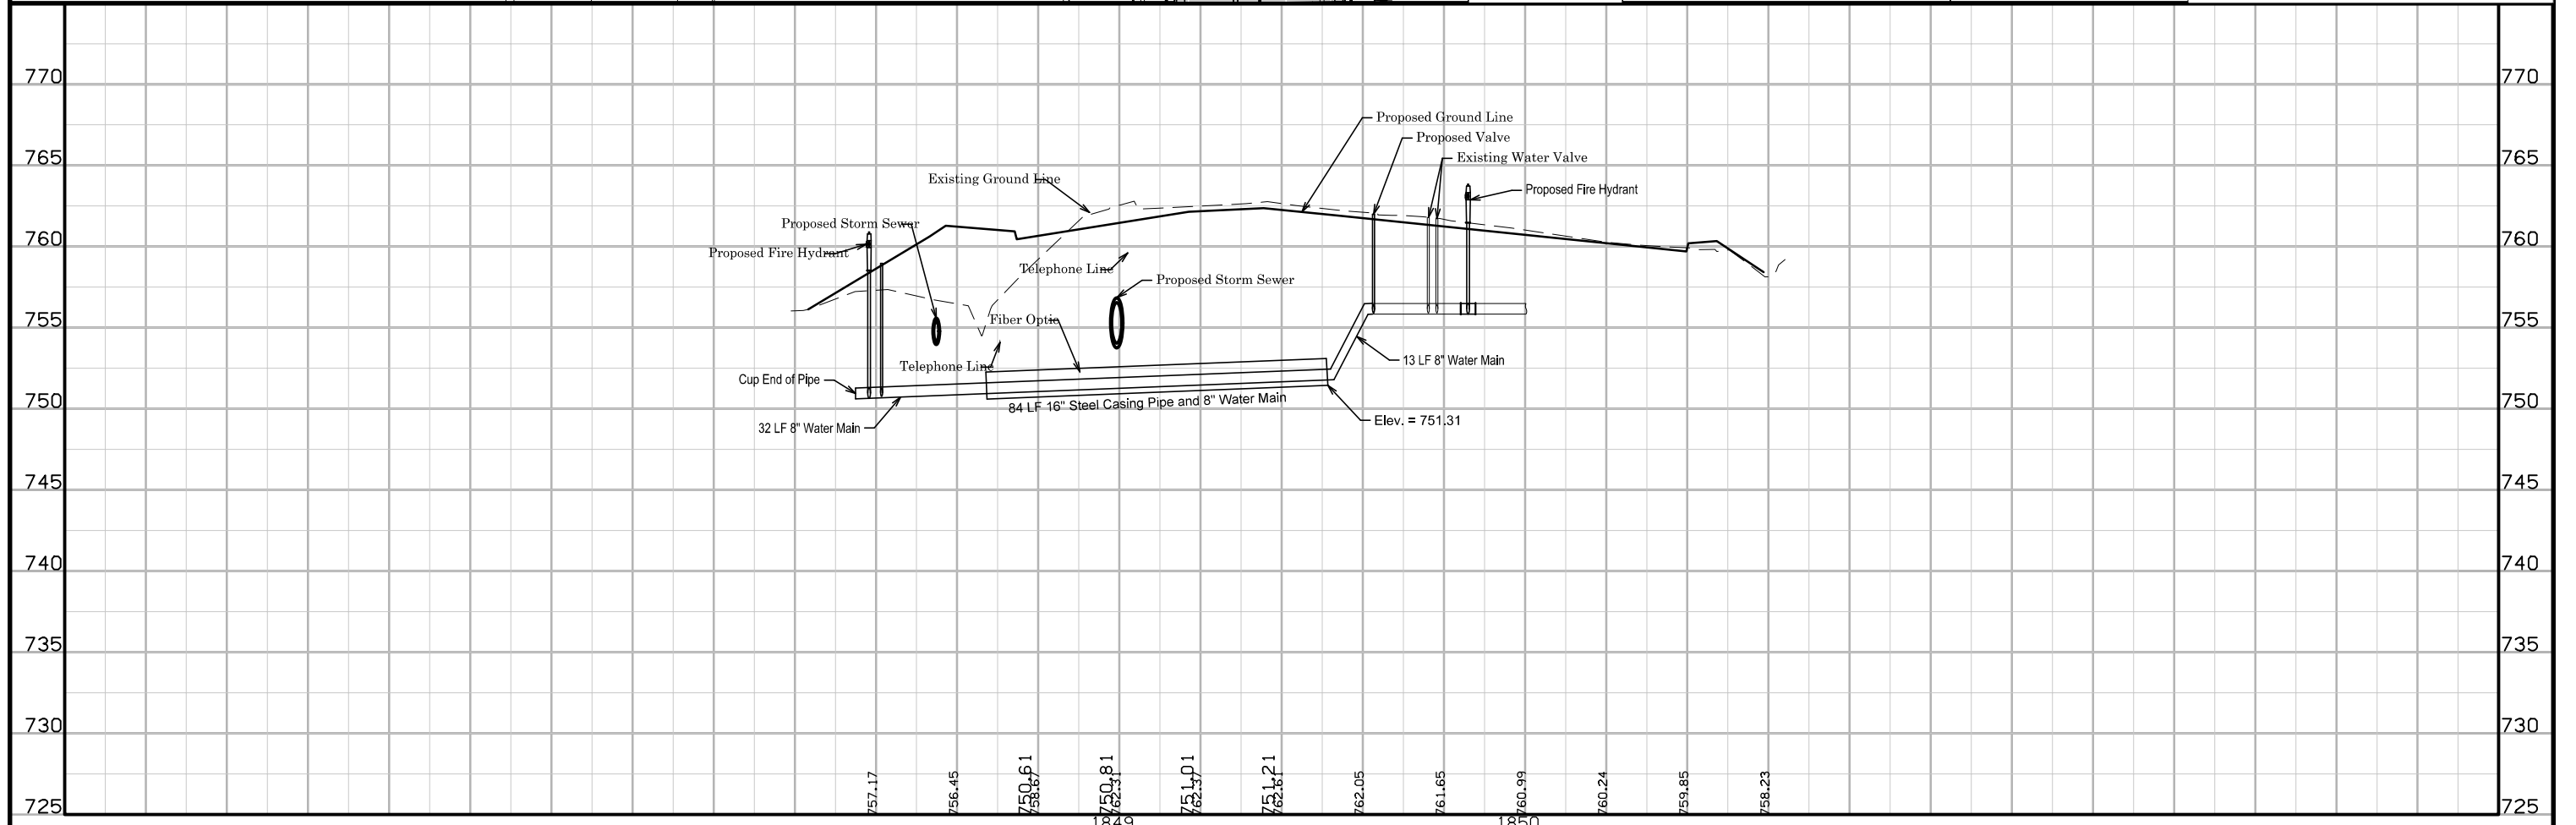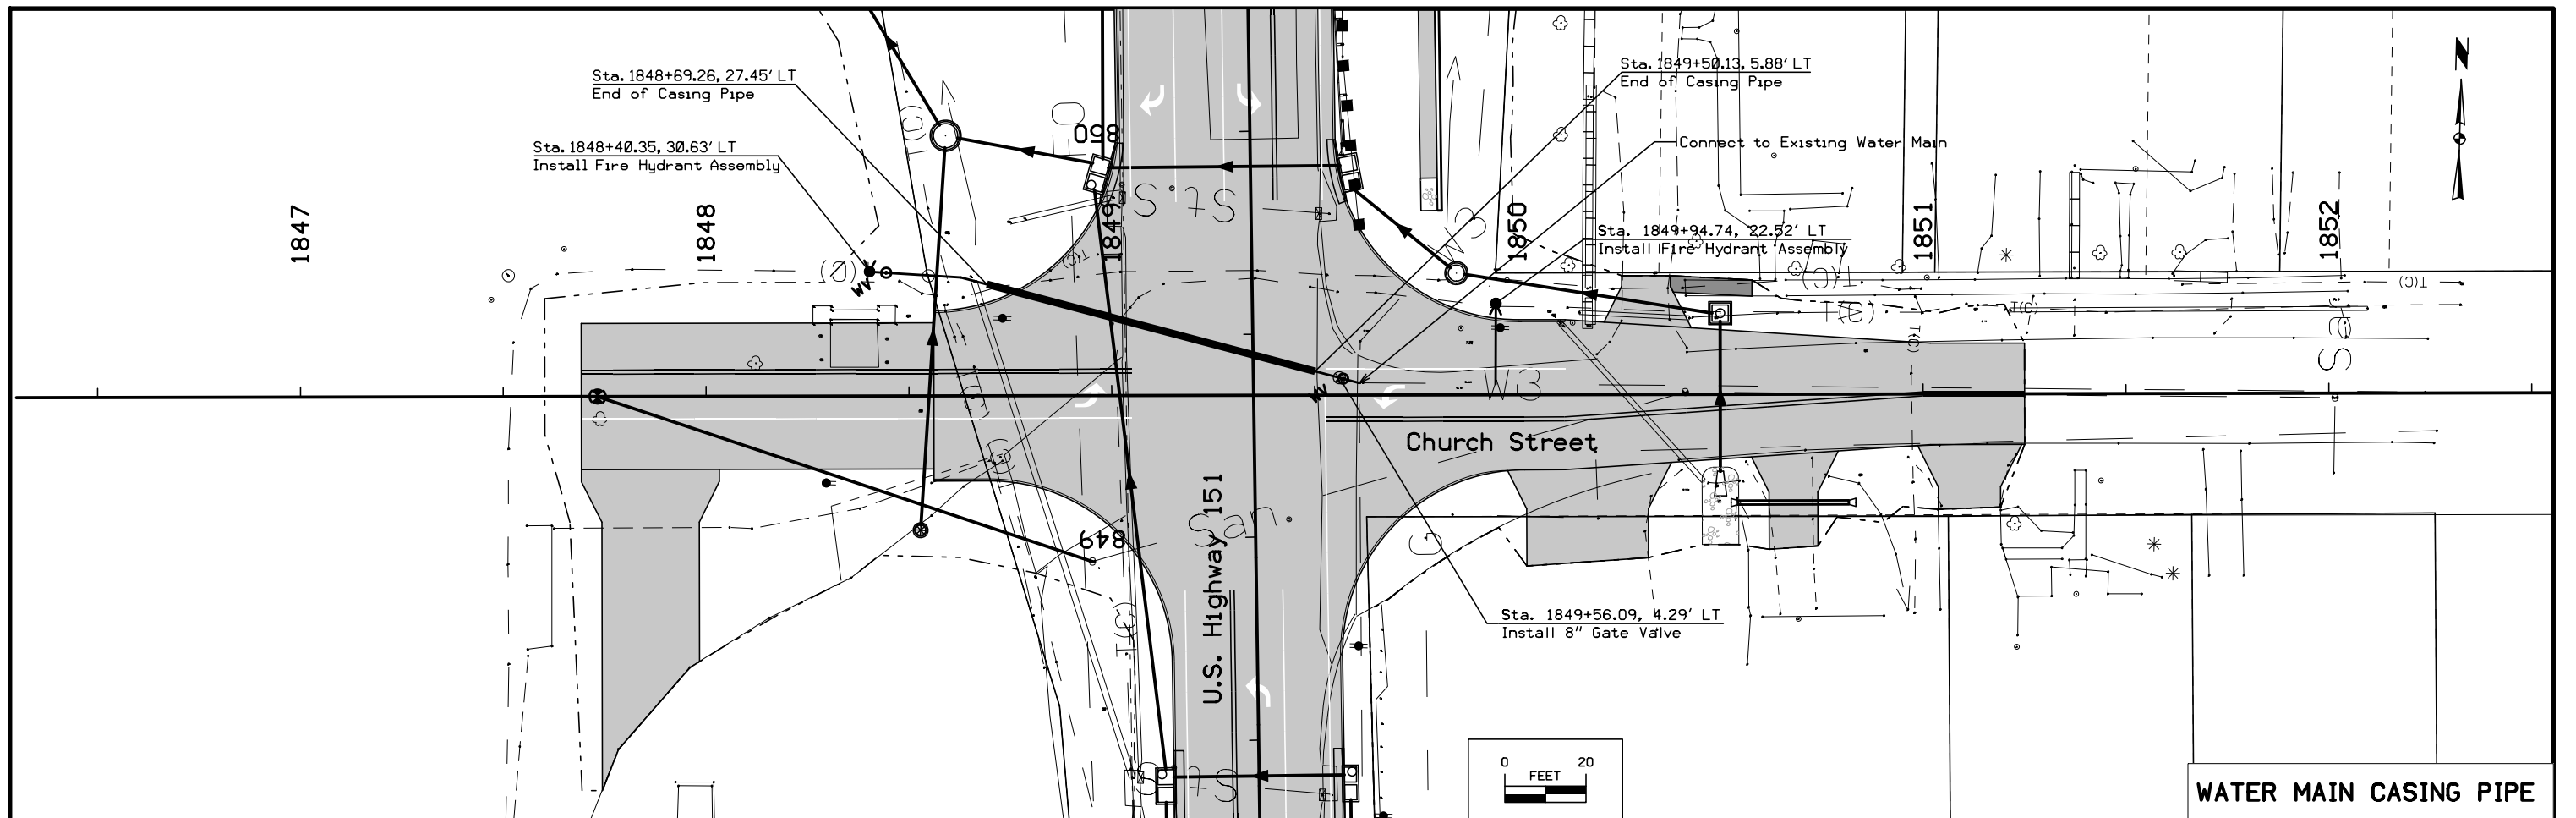

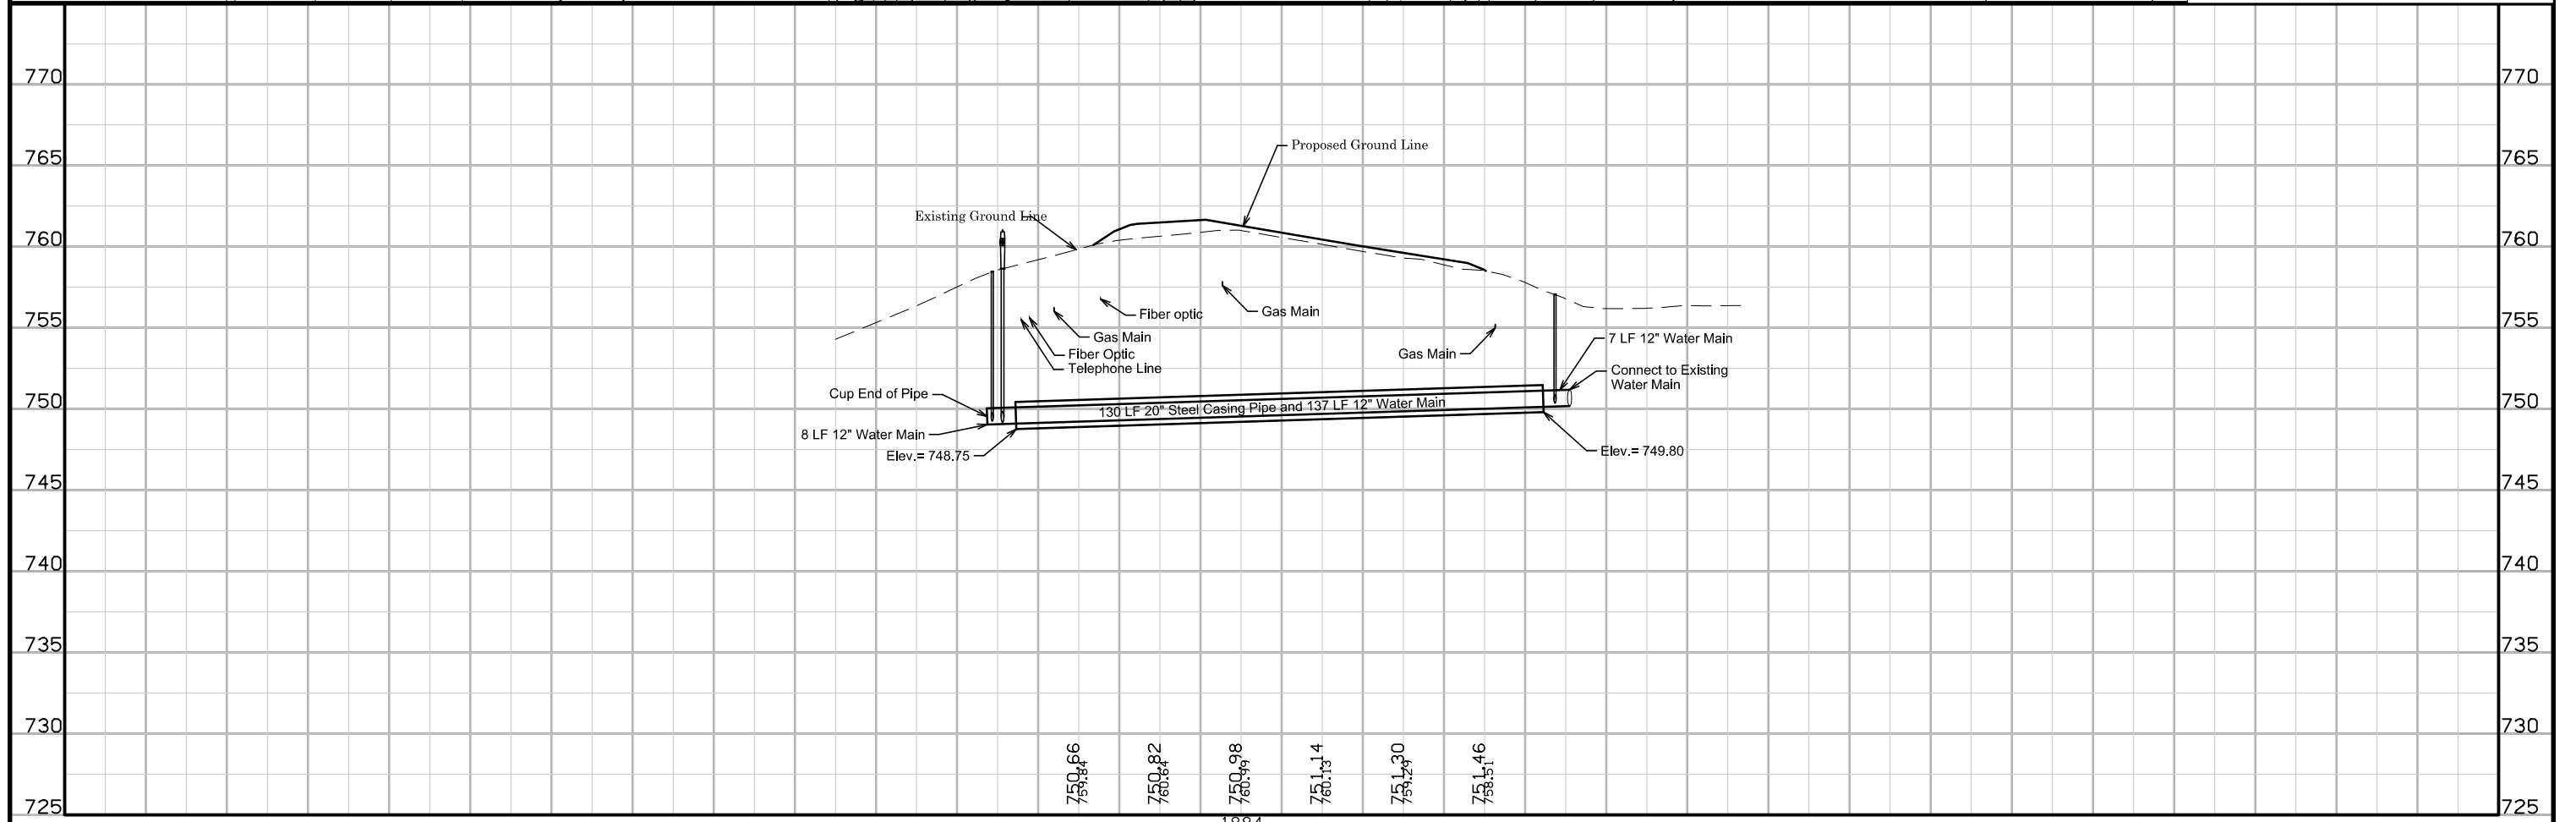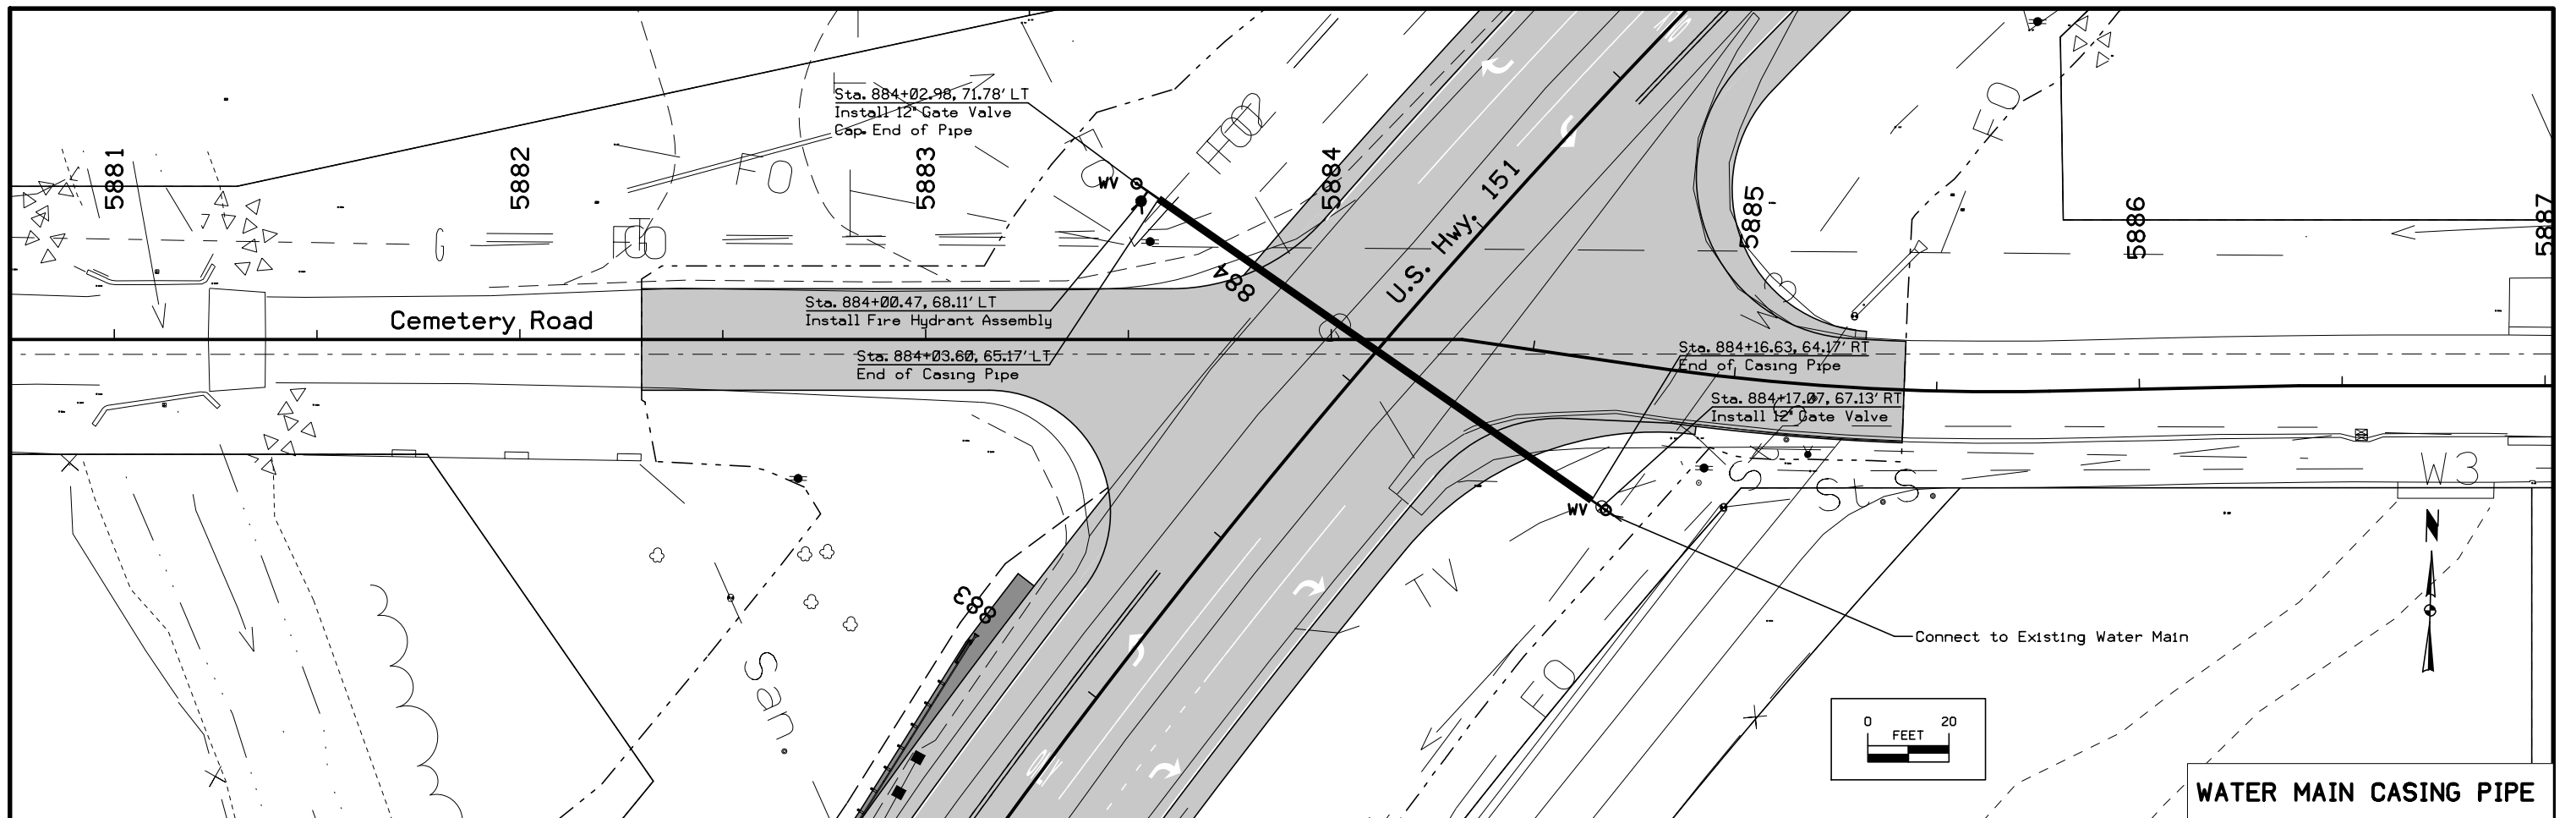

TABULATION OF TEMPLATE QUANTITIES AND ADJUSTMENTS

Station	Cut				Fill						Checks (EW-102)		Topsoil				[17]	[18]	[19]	[20]	[21]	[22]
	[1]	[2]	[3]	[4]	[5]	[6]	[7]	[8]	[9]	[10]	[11]	[12]	[13]	[14]	[15]	[16]						
	Total Cut Unadjusted Volume	Total Class 10 Unadjusted Volume	Topsoil Cut Volume	Total Cut Adjusted	Total Fill Unadjusted Volume	Existing Topsoil Stripping Undercut (+ Fill)	Existing Pavement Undercut (+Fill)	Total Fill Adjusted	Total Fill Adjusted w/ Weighted Average 1.3 Shrink Factor	Total Cut Adjusted Minus Fill w/ Shrink	Approx. Fill Vol. Below 5' & Above 20' w/ Shrink	Approx. Fill Volume Below 3' w/ Shrink	Topsoil Stripping Undercut Volume	Topsoil Placement Undercut Volume	Topsoil Placement With 1.4 Shrink Factor	Topsoil Stripping Minus Topsoil Placement w/Shrink						
CEMETERY																						
5882+50.00	53	51	2	51	0	2	44	46	60	-9	0	0	2	2	3	-1						
5883+00.00	32	29	3	29	52	3	109	164	213	-184	0	0	3	17	24	-21						
5883+50.00	0	0	0	0	0	0	0	0	0	0	0	0	0	0	0	0						
5884+00.00	210	173	37	173	11	37	86	134	174	-1	0	0	37	33	46	-9						
5884+50.00	288	256	32	256	6	32	128	166	216	40	0	0	32	24	34	-2						
5885+00.00																						
CEMETERY																						
Totals:	583	509	74	509	69	74	367	510	663	-154	0	0	74	76	107	-33						

TABULATION OF TEMPLATE QUANTITIES AND ADJUSTMENTS

Station	Fill				Checks (EW-102)		Topsoil																
	[1]	[2]	[3]	[4]	[5]	[6]	[7]	[8]	[9]	[10]	[11]	[12]	[13]	[14]	[15]	[16]	[17]	[18]	[19]	[20]	[21]	[22]	
	Total Cut Unadjusted Volume	Total Class 10 Unadjusted Volume	Topsoil Cut Volume	Total Cut Adjusted	Total Fill Unadjusted Volume	Existing Topsoil Stripping Undercut (+ Fill)	Existing Pavement Undercut (+Fill)	Total Fill Adjusted	Total Fill Adjusted w/ Weighted Average 1.3 Shrink Factor	Total Cut Adjusted Minus Fill w/ Shrink	Approx. Fill Vol. Below 5' & Above 20' w/ Shrink	Approx. Fill Volume Below 3' w/ Shrink	Topsoil Stripping Undercut Volume	Topsoil Placement Undercut Volume	Topsoil Placement With 1.4 Shrink Factor	Topsoil Stripping Minus Topsoil Placement w/Shrink							
CHURCH																							
1847+69.25	19	10	9	10	7	9		16	21	-11	0	0	9	2	3	6							
1848+00.00	37	5	32	5	58	32		90	117	-112	0	0	32	16	22	10							
1848+50.00	7	1	6	1	18	6		24	31	-30	0	0	6	2	3	3							
1848+56.14	10	2	8	2	72	8	6	86	112	-110	0	0	8	4	6	2							
1848+69.79	33	29	4	29	102	4	29	135	176	-147	0	0	4	8	11	-7							
1849+00.00	224	206	18	206	27	18	74	119	155	51	0	0	18	19	27	-9							
1850+00.00	5	4	1	4	2	1	2	5	7	-3	0	0	1	1	1	0							
1850+01.77	21	17	4	17	7	4	12	23	30	-13	0	0	4	3	4	0							
1850+11.77	84	71	13	71	13	13	39	65	85	-14	0	0	13	11	15	-2							
1850+50.00	105	92	13	92	6	13	44	63	82	10	0	0	13	15	21	-8							
1851+00.00	2	2	0	2	0		2	2	3	-1	0	0	0	0	0	0							
1851+01.77																							
CHURCH Totals:	547	439	108	439	312	108	208	628	817	-378	0	0	108	81	114	-6							

TABULATION OF TEMPLATE QUANTITIES AND ADJUSTMENTS

Station	Cut				Fill						Checks (EW-102)		Topsoil				[17]	[18]	[19]	[20]	[21]	[22]
	[1]	[2]	[3]	[4]	[5]	[6]	[7]	[8]	[9]	[10]	[11]	[12]	[13]	[14]	[15]	[16]						
	Total Cut Unadjusted Volume	Total Class 10 Unadjusted Volume	Topsoil Cut Volume	Total Cut Adjusted	Total Fill Unadjusted Volume	Existing Topsoil Stripping Undercut (+ Fill)	Existing Pavement Undercut (+Fill)	Total Fill Adjusted	Total Fill Adjusted w/ Weighted Average 1.3 Shrink Factor	Total Cut Adjusted Minus Fill w/ Shrink	Approx. Fill Vol. Below 5' & Above 20' w/ Shrink	Approx. Fill Volume Below 3' w/ Shrink	Topsoil Stripping Undercut Volume	Topsoil Placement Undercut Volume	Topsoil Placement With 1.4 Shrink Factor	Topsoil Stripping Minus Topsoil Placement w/Shrink						
LOSEY																						
3863+00.00	73	73	0	73	32		38	70	91	-18	0	0	0	13	18	-18						
3863+49.39	14	1	13	1	1	13		14	18	-17	0	0	13	0	0	13						
3863+50.00	50	50	0	50	15		24	39	51	-1	0	0	0	4	6	-6						
3863+85.02	27	21	6	21	7	6	9	22	29	-8	0	0	6	2	3	3						
3864+00.00	65	62	3	62	58	3	29	90	117	-55	0	0	3	14	20	-17						
3864+50.00	24	6	18	6	11	18		29	38	-32	0	0	18	2	3	15						
3864+56.28	5	2	3	2	7	3		10	13	-11	0	0	3	1	1	2						
3864+59.42																						
LOSEY																						
Totals:	258	215	43	215	131	43	100	274	357	-142	0	0	43	36	51	-8						

TABULATION OF TEMPLATE QUANTITIES AND ADJUSTMENTS

Station	Cut				Fill						Checks (EW-102)		Topsoil				[17]	[18]	[19]	[20]	[21]	[22]		
	[1]	[2]	[3]	[4]	[5]	[6]	[7]	[8]	[9]	[10]	[11]	[12]	[13]	[14]	[15]	[16]								
	Total Cut Unadjusted Volume	Total Class 10 Unadjusted Volume	Topsoil Cut Volume	Total Cut Adjusted	Total Fill Unadjusted Volume	Existing Topsoil Stripping Undercut (+ Fill)	Existing Pavement Undercut (+Fill)	Total Fill Adjusted	Total Fill Adjusted w/ Weighted Average 1.3 Shrink Factor	Total Cut Adjusted Minus Fill w/ Shrink	Approx. Fill Vol. Below 5' & Above 20' w/ Shrink	Approx. Fill Volume Below 3' w/ Shrink	Topsoil Stripping Undercut Volume	Topsoil Placement Undercut Volume	Topsoil Placement With 1.4 Shrink Factor	Topsoil Stripping Minus Topsoil Placement w/Shrink								
PRAIRIE																								
2864+82.50	1	0	1	0	22	1	23	30	-30	0	0	1	6	8	-7									
2865+00.00	6	1	5	1	40	5	61	79	-78	0	0	5	10	14	-9									
2865+30.81	10	1	9	1	11	9	44	57	-56	0	0	9	2	3	6									
2865+50.00	24	22	2	22	8	2	24	31	-9	0	0	2	2	3	-1									
2866+00.69	51	48	3	48	0	3	39	51	-3	0	0	3	0	0	3									
2866+50.00																								
PRAIRIE																								
Totals:	92	72	20	72	81	20	191	249	-177	0	0	20	20	28	-8									

TABULATION OF TEMPLATE QUANTITIES AND ADJUSTMENTS


Station	Cut				Fill						Checks (EW-102)		Topsoil				[17]	[18]	[19]	[20]	[21]	[22]		
	[1]	[2]	[3]	[4]	[5]	[6]	[7]	[8]	[9]	[10]	[11]	[12]	[13]	[14]	[15]	[16]								
	Total Cut Unadjusted Volume	Total Class 10 Unadjusted Volume	Topsoil Cut Volume	Total Cut Adjusted	Total Fill Unadjusted Volume	Existing Topsoil Stripping Undercut (+ Fill)	Existing Pavement Undercut (+Fill)	Total Fill Adjusted	Total Fill Adjusted w/ Weighted Average 1.3 Shrink Factor	Total Cut Adjusted Minus Fill w/ Shrink	Approx. Fill Vol. Below 5' & Above 20' w/ Shrink	Approx. Fill Volume Below 3' w/ Shrink	Topsoil Stripping Undercut Volume	Topsoil Placement Undercut Volume	Topsoil Placement With 1.4 Shrink Factor	Topsoil Stripping Minus Topsoil Placement w/Shrink								
STALLMAN																								
4874+50.00	49	44	5	44	0	5	21	26	34	10	0	0	5	4	6	-1								
4874+79.34	27	24	3	24	0	3	15	18	23	1	0	0	3	2	3	0								
4875+00.00	8	7	1	7	0	1	6	7	9	-2	0	0	1	1	1	0								
4875+07.57	4	3	1	3	0	1	3	4	5	-2	0	0	1	0	0	1								
4875+11.36	27	13	14	13	16	14	30	30	39	-26	0	0	14	6	8	6								
4875+43.95	4	0	4	0	8	4	12	12	16	-16	0	0	4	1	1	3								
4875+50.00	5	1	4	1	7	4	11	11	14	-13	0	0	4	0	0	4								
4875+55.65																								
STALLMAN																								
Totals:	124	92	32	92	31	32	45	108	141	-49	0	0	32	14	20	13								

TABULATION OF TEMPLATE QUANTITIES AND ADJUSTMENTS

Station	Cut				Fill						Checks (EW-102)		Topsoil				[17]	[18]	[19]	[20]	[21]	[22]
	[1]	[2]	[3]	[4]	[5]	[6]	[7]	[8]	[9]	[10]	[11]	[12]	[13]	[14]	[15]	[16]						
	Total Cut Unadjusted Volume	Total Class 10 Unadjusted Volume	Topsoil Cut Volume	Total Cut Adjusted	Total Fill Unadjusted Volume	Existing Topsoil Stripping Undercut (+ Fill)	Existing Pavement Undercut (+Fill)	Total Fill Adjusted	Total Fill Adjusted w/ Weighted Average 1.3 Shrink Factor	Total Cut Adjusted Minus Fill w/ Shrink	Approx. Fill Vol. Below 5' & Above 20' w/ Shrink	Approx. Fill Volume Below 3' w/ Shrink	Topsoil Stripping Undercut Volume	Topsoil Placement Undercut Volume	Topsoil Placement With 1.4 Shrink Factor	Topsoil Stripping Minus Topsoil Placement w/Shrink						
Summary:																						
CEMETERY	583	509	74	509	69	74	367	510	663	-154	0	0	74	76	107	-33						
CHURCH	547	439	108	439	312	108	208	628	817	-378	0	0	108	81	114	-6						
LOSEY	258	215	43	215	131	43	100	274	357	-142	0	0	43	36	51	-8						
ML151	39,953	32,790	7,163	32,790	40,052	7,163	8,103	55,318	71,914	-39,124	0	0	7,163	8,013	11,219	-4,056						
PRAIRIE	92	72	20	72	81	20	90	191	249	-177	0	0	20	20	28	-8						
STAGE1C	3,918	3,918	0	3,918	2,662	0	0	2,662	3,461	458	0	0	0	0	0	0						
STALLMAN	124	92	32	92	31	32	45	108	141	-49	0	0	32	14	20	13						
MSE WALL 1	15,482	0	0	15,482	0	0	0	0	0	15,482	0	0	0	0	0	0						
MSE WALL 2	2,470	0	0	2,470	0	0	0	0	0	2,470	0	0	0	0	0	0						
MSE WALL 3	6,845	0	0	6,845	0	0	0	0	0	6,845	0	0	0	0	0	0						
STAGE 2B	590	0	0	590	574	0	0	0	746	-156	0	0	0	0	0	0						
UPRR S. ABUT.	3,386	0	0	3,386	1,797	0	0	0	2,336	1,050	0	0	0	0	0	0						
UPRR N. ABUT	3,629	0	0	3,629	257	0	0	0	334	3,295	0	0	0	0	0	0						
P. CREEK S. ABUT.	1,867	0	0	1,867	656	0	0	0	853	1,014	0	0	0	0	0	0						
P. CREEK N. ABUT.	2,526	0	0	2,526	634	0	0	0	824	1,702	0	0	0	0	0	0						
DD1 S. ABUT.	2,654	0	0	2,654	346	0	0	0	450	2,204	0	0	0	0	0	0						
DD1 N. ABUT.	1,787	0	0	1,787	695	0	0	0	904	883	0	0	0	0	0	0						
Project Totals:	86,711	38,035	7,440	79,271	48,297	7,440	8,913	59,691	84,049	-4,777	0	0	7,440	8,240	11,539	-4,098						

LEGEND

EXISTING		PROPOSED (AS-BUILT)
—SS—	SANITARY SEWER	—SS—
—ST—	STORM SEWER	—ST—
—SD—	SUBDRAIN	—SD—
—FM—	FORCE MAIN	—FM—
—W—	WATER	—W—
—G—	GAS	—G—
—S—	STEAM	—S—
—OHE—	ELECTRICAL - OVERHEAD	—OHE—
—UG—	ELECTRICAL - UNDERGROUND	—UG—
—OHT—	TELEPHONE - OVERHEAD	—OHT—
—T—	TELEPHONE - UNDERGROUND	—T—
—OHC—	CATV - OVERHEAD	—OHC—
—C—	CATV - UNDERGROUND	—C—
—OFO—	FIBER OPTIC - OVERHEAD	—OFO—
—FO—	FIBER OPTIC - UNDERGROUND	—FO—
—X—	FENCE LINE	—X—
	REMOVALS	
☼	LIGHT POLE W/O MAST	☼
☼	LIGHT POLE W/MAST	☼
⊕	FIRE HYDRANT	⊕
⊕	UTILITY POLE	⊕
→	GUY ANCHOR	→
⊠	TELEPHONE PEDESTAL	⊠
⊠	HANDHOLE	⊠
○	MANHOLE	○
⊗	VALVE, WATER OR GAS	⊗
⊙	CLEANOUT, STORM OR SANITARY	⊙
▨	CURB AND APRON INTAKE	▨
▨ OR ⊕	GRATE INTAKE	▨ OR ⊕
▨	METRO RA-3 OR RA-5 INTAKE	▨
▨	METRO RA-8 INTAKE	▨
▨	FLARED END SECTION	▨
⊠	UTILITY/CONTROL CABINET	⊠
☼	TRAFFIC SIGNAL	☼
BM	BENCHMARK	BM
⊕	SOIL BORING	⊕
⊗	VALVE MANHOLE	⊗
⊗	WATER BLOWOFF	⊗

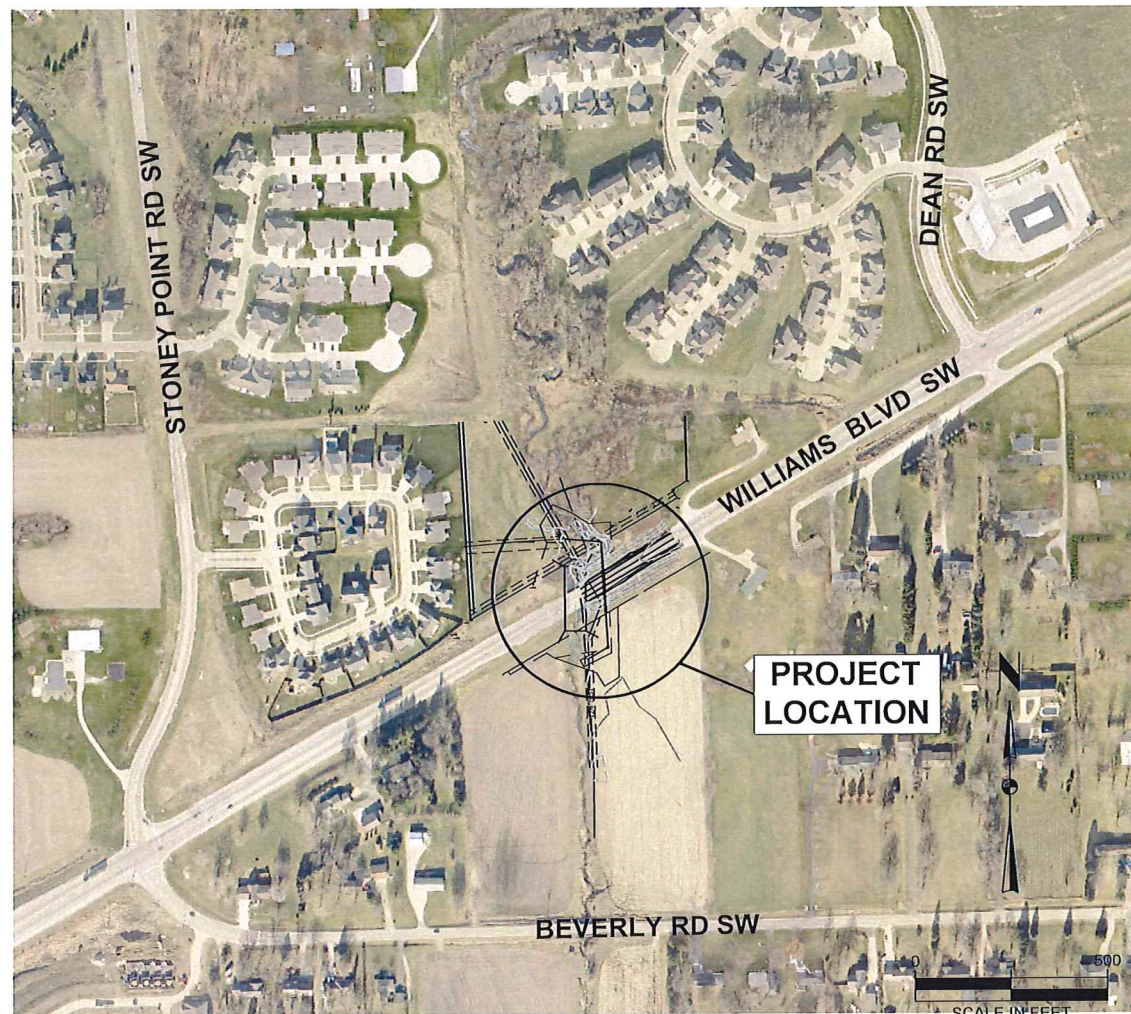

GENERAL NOTES:

1. PROTECT ALL EXISTING UTILITIES AND PAVED AREAS, INCLUDING ANY NOT SHOWN ON THESE DRAWINGS. VERIFY ALL EXISTING UTILITIES PRIOR TO CONSTRUCTION AND NOTIFY THE ENGINEER IF ANY CONFLICTS WITH THE DRAWINGS OCCUR. ANY DAMAGE TO EXISTING UTILITIES, SOD, LANDSCAPE AND/OR PAVED AREAS CAUSED BY TRENCHING, GRADING, AND PAVING OPERATIONS NOT IDENTIFIED FOR REPLACEMENT SHALL BE REPAIRED AT THE CONTRACTOR'S EXPENSE. EXISTING UTILITY LOCATIONS SHOWN ON THE DRAWINGS ARE APPROXIMATE.
2. ALL DEBRIS RESULTING FROM CONSTRUCTION OPERATIONS SHALL BE PROPERLY DISPOSED OF OFF-SITE.
3. ALL WORK TO BE COMPLETED WITHIN EASEMENTS AND PUBLIC R.O.W.
4. WORK ITEMS NOT SPECIFICALLY CALLED OUT FOR PAYMENT SHALL BE INCIDENTAL TO CONTRACT ITEMS.
5. REFER TO G-SHEETS FOR CONTROL POINT INFORMATION.
6. INSPECTION FOR SANITARY SEWER CONSTRUCTION WILL BE PROVIDED BY THE CEDAR RAPIDS PUBLIC WORKS DEPARTMENT CONSTRUCTION ENGINEERING DIVISION. PROVIDE A MINIMUM OF 72 HOURS NOTICE PRIOR TO STARTING CONSTRUCTION.
7. THE CONTRACTOR SHALL ASSIST THE CITY'S INSPECTOR WITH DAILY RECORD KEEPING INCLUDING DOCUMENTING ALL NECESSARY FIELD LOCATIONS AND MEASUREMENTS. THE CONTRACTOR IS REQUIRED TO ATTEND FINAL AND INTERMEDIATE INSPECTIONS OF THE PROJECT AND IS RESPONSIBLE FOR OPENING ALL MANHOLES FOR INSPECTION.
8. TRAFFIC CONTROL SHALL CONFORM TO OTHER PROJECT STAGING PLANS AND SHALL NOT CONFLICT WITH SAID PLAN.
9. ANY TEMPORARY GRADING AND SUBSEQUENT RESTORATION REQUIRED FOR SITE ACCESS SHALL BE INCIDENTAL TO SANITARY SEWER CONSTRUCTION.

Design drawings U.1-U.5 incorporate underground utility information based upon subsurface utility engineering practices and standard guidelines for the collection and depiction of existing subsurface utility data (CI/ASCE 38-02).

Utility quality level A: Precise horizontal and vertical location of utilities obtained by the actual exposure (or verification of previously exposed and surveyed utilities) and subsequent measurement of subsurface utilities, usually at a specific point. Minimally intrusive excavation equipment is typically used to minimize the potential for utility damage. A precise horizontal and vertical location, as well as other utility attributes, is shown on plan documents. Accuracy is typically set to 15-mm vertical and to applicable horizontal survey and mapping accuracy as defined or expected by the project owner.

Utility quality level B: Information obtained through the application of appropriate surface geophysical methods to determine the existence and approximate horizontal position of subsurface utilities. Quality level B data should be reproducible by surface geophysics at any point of their depiction. This information is surveyed to applicable tolerances defined by the project and reduced onto plan documents.

Utility quality level C: Information obtained by surveying and plotting visible above-ground utility features and by using professional judgement in correlating this information to quality level D information.

Utility quality level D: Information derived from existing records or oral recollections.

NOTE:
THE PROPOSED SANITARY SEWER IMPROVEMENTS INCLUDED IN THESE DRAWINGS HAVE BEEN DESIGNED IN ACCORDANCE WITH THE STATEWIDE URBAN DESIGN AND SPECIFICATIONS (SUDAS) (LATEST EDITION) WITH NO DESIGN EXCEPTIONS.

UTILITY	OWNER	QUALITY LEVEL
EXISTING SANITARY SEWER	CITY OF CEDAR RAPIDS	C



I HEREBY CERTIFY THAT THIS ENGINEERING DOCUMENT WAS PREPARED BY ME OR UNDER MY DIRECT PERSONAL SUPERVISION AND THAT I AM A DULY LICENSED PROFESSIONAL ENGINEER UNDER THE LAWS OF THE STATE OF IOWA.

Matthew J. Feuerhelm 9/4/18
MATTHEW J. FEUERHELM, P.E. DATE

LICENSE NUMBER: 21301
MY LICENSE RENEWAL DATE IS: DECEMBER 31, 2019


PAGES OR SHEETS COVERED BY THIS SEAL: U.1-U.5

SANITARY SEWER

UTILITY ACCESSES						PIPES										
* Bid Item						1 LENGTH COMPUTED FROM CENTER OF STRUCTURE TO CENTER OF STRUCTURE.										
No.	Location Station and Offset	Type or Standard Road Plan*	Rim	Bottom Well	Notes	No.	UTILITY ACCESS NO.		TYPE	PIPE SIZE	LENGTH ¹	SLOPE %	FLOW LINES		Pipe Profile Sheet No.	Notes
			Elev.	Elev.			FROM	TO					INLET ELEVATION	OUTLET ELEVATION		
SMH-01	979+67.8, 152.7' Rt.	SW-301 (60")	772.03	758.34	Bolt-down lid, connected manhole joints, A-Lok Flexible Pipe Connections	P-1	SMH-01	SMH-02	DIP	24"	59.0	0.35	758.52	758.34	U.3	Restrained Joint DIP w/ Ceramic Epoxy interior lining
SMH-02	980+26.8, 152.7' Rt.	SW-301 (60")	770.33	758.52	Bolt-down lid, connected manhole joints, A-Lok Flexible Pipe Connections	P-2	SMH-02	SMH-03	DIP	24"	275.7	0.35	759.47	758.52	U.3	Restrained Joint DIP w/ Ceramic Epoxy interior lining, 48" Dia. Casing Pipe
SMH-03	981+51.2, 93.4' Lt.	SW-301 (60")	769.45	759.47	Bolt-down lid, connected manhole joints, A-Lok Flexible Pipe Connections	P-3	SMH-03	SMH-04	DIP	24"	97.3	0.35	759.86	759.47	U.3	Restrained Joint DIP w/ Ceramic Epoxy interior lining, PC Concrete Arch
SMH-04	980+71.2, 148.9' Lt.	SW-301 (60")	769.77	759.86	Replace Ex. Structure, bolt-down lid, connected manhole joints, A-Lok Flexible Pipe Connections											

SANITARY SEWER ABANDONMENT, FILL AND PLUG, LESS THAN OR EQUAL TO 36 IN. DIA.		
Location	Length (LF)	Remarks
Sta. 979+91.9, 107.5' Rt. to Sta. 980+70.6, 98.9' Lt.	246	Plug upstream and downstream ends, remove and dispose of existing cone sections. Fill pipe with flowable mortar.

REMOVE SANITARY SEWER PIPE LESS THAN OR EQUAL TO 36 IN.		
Location	Length (LF)	Remarks
Sta. 979+67.8, 152.7' Rt. to Sta. 979+91.9, 107.5' Rt.	50	Remove ex. 24" RCP from SMH-01 upstream to Ex. MH
Sta. 980+70.6, 98.9' Lt. to Sta. 980+71.2, 148.9' Lt.	50	Remove ex. 24" RCP to 50' downstream of SMH-04.

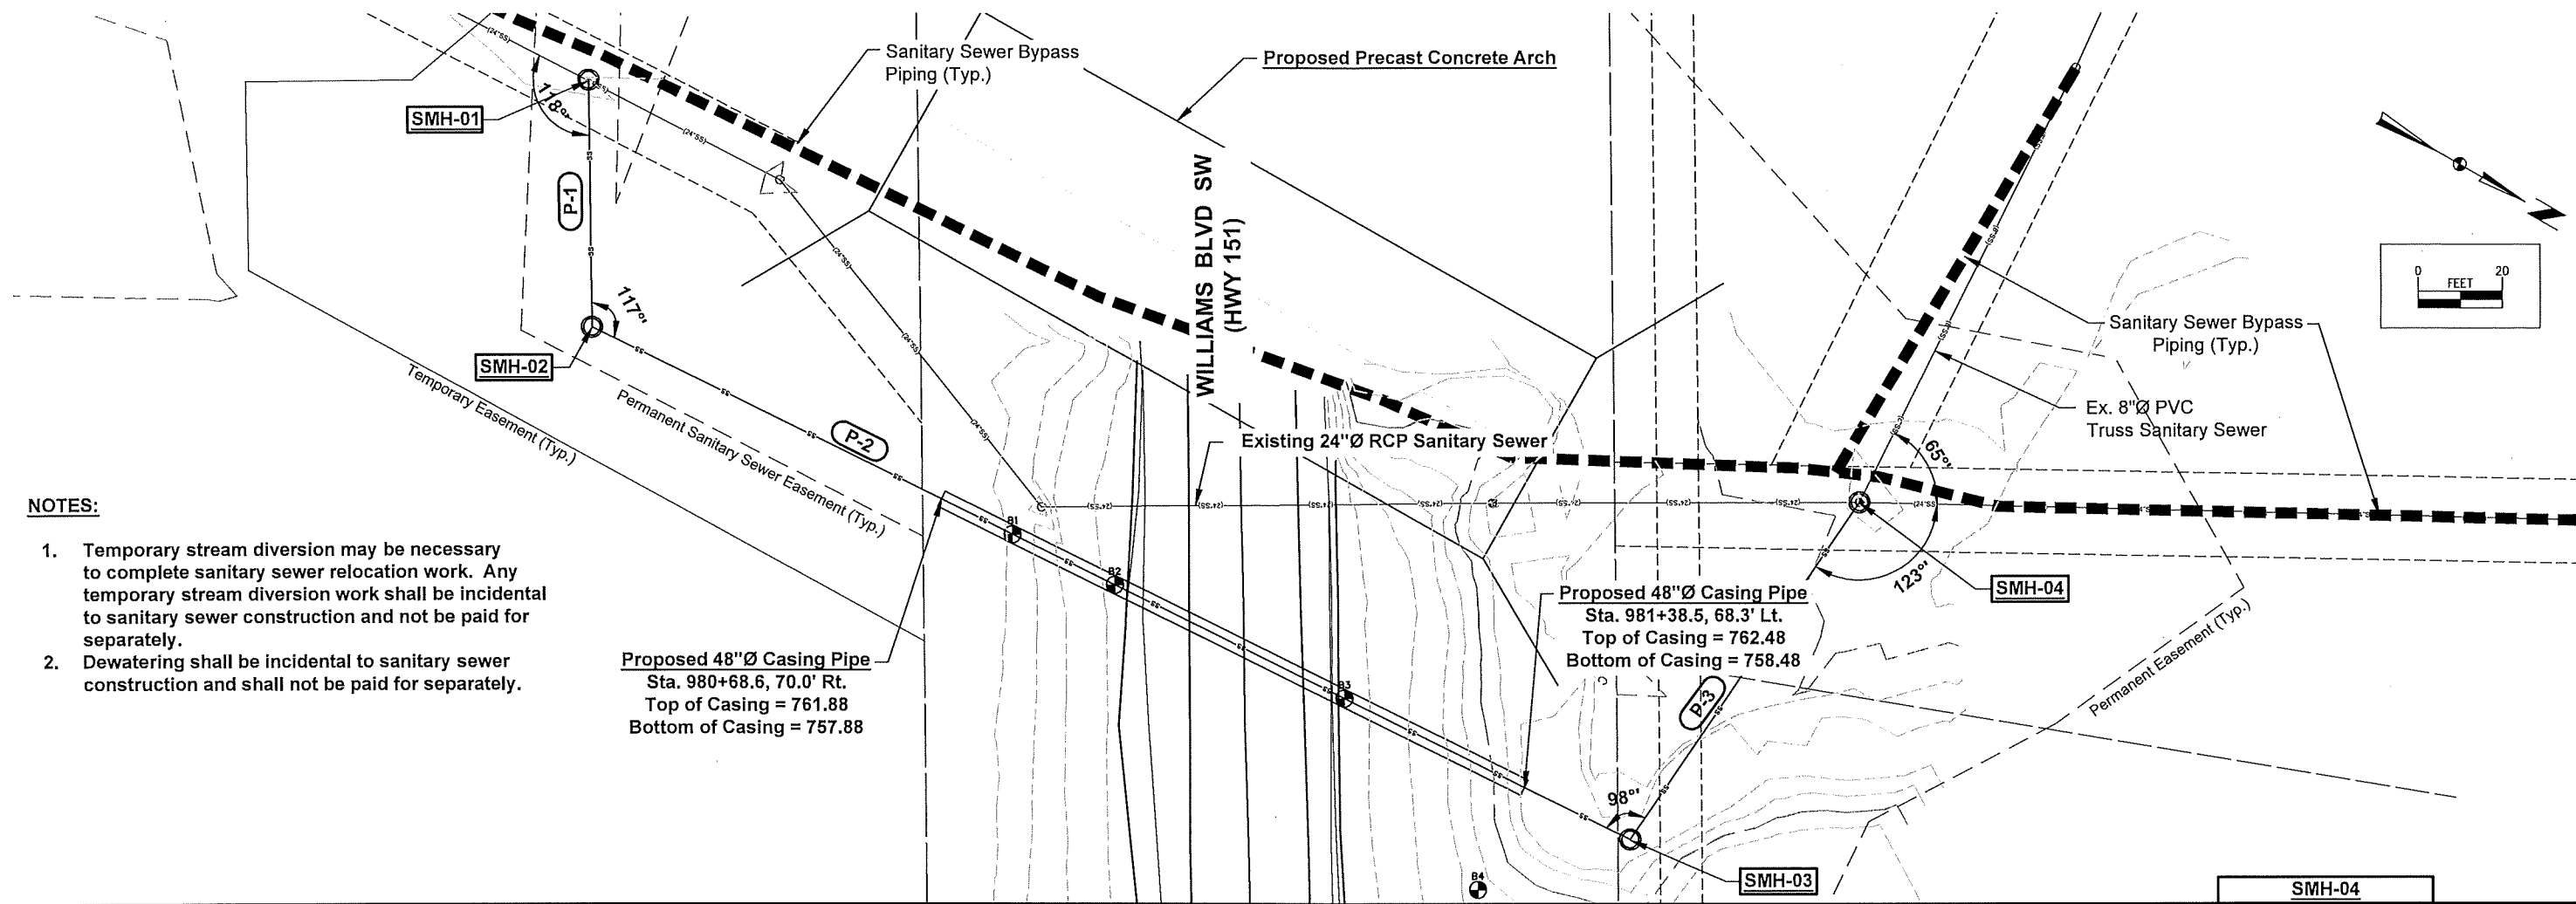


NOTES:

1. Temporary stream diversion may be necessary to complete sanitary sewer relocation work. Any temporary stream diversion work shall be incidental to sanitary sewer construction and not be paid for separately.
2. Dewatering shall be incidental to sanitary sewer construction and shall not be paid for separately.



Proposed 48"Ø Casing Pipe
 Sta. 980+68.6, 70.0' Rt.
 Top of Casing = 761.88
 Bottom of Casing = 757.88



Proposed 48"Ø Casing Pipe
 Sta. 981+38.5, 68.3' Lt.
 Top of Casing = 762.48
 Bottom of Casing = 758.48

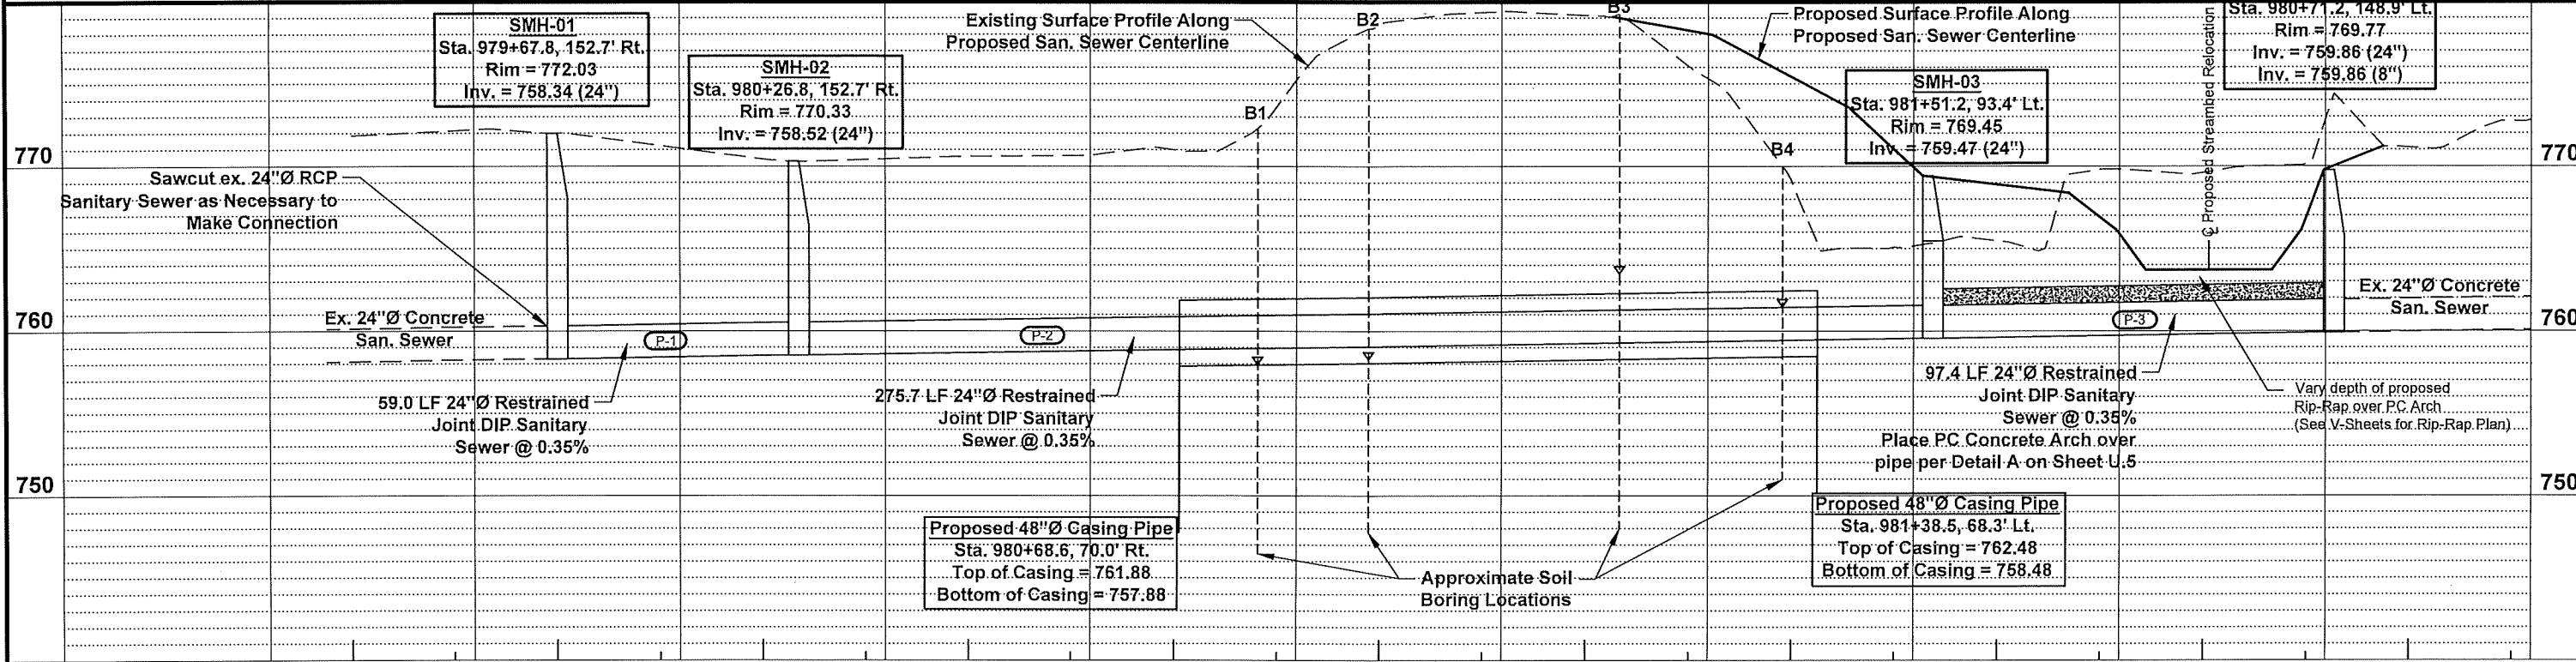


NOTES:

1. Confine all work to existing easements shown.
2. Suction and discharge manholes are buried (2'-3'). Contact City of Cedar Rapids Sewer Maintenance a minimum of 2 weeks prior to work for locates.
3. Plug locations shall be downstream inverts of suction manholes unless approved otherwise.
4. Submit bypass pumping plan to City of Cedar Rapids for approval. Prior to operation, bypass piping shall be pressure tested. System shall be tested and hold at 35 psi for 2 hours.
5. Existing pipe flow data:
 8" PVC (west of SMH-04) - FULL FLOW CAPACITY = 780 gpm
 24" RCP (north of SMH-04) - FULL FLOW CAPACITY = 6,450 gpm
 Flows assume gravity flow conditions. No historical data available.

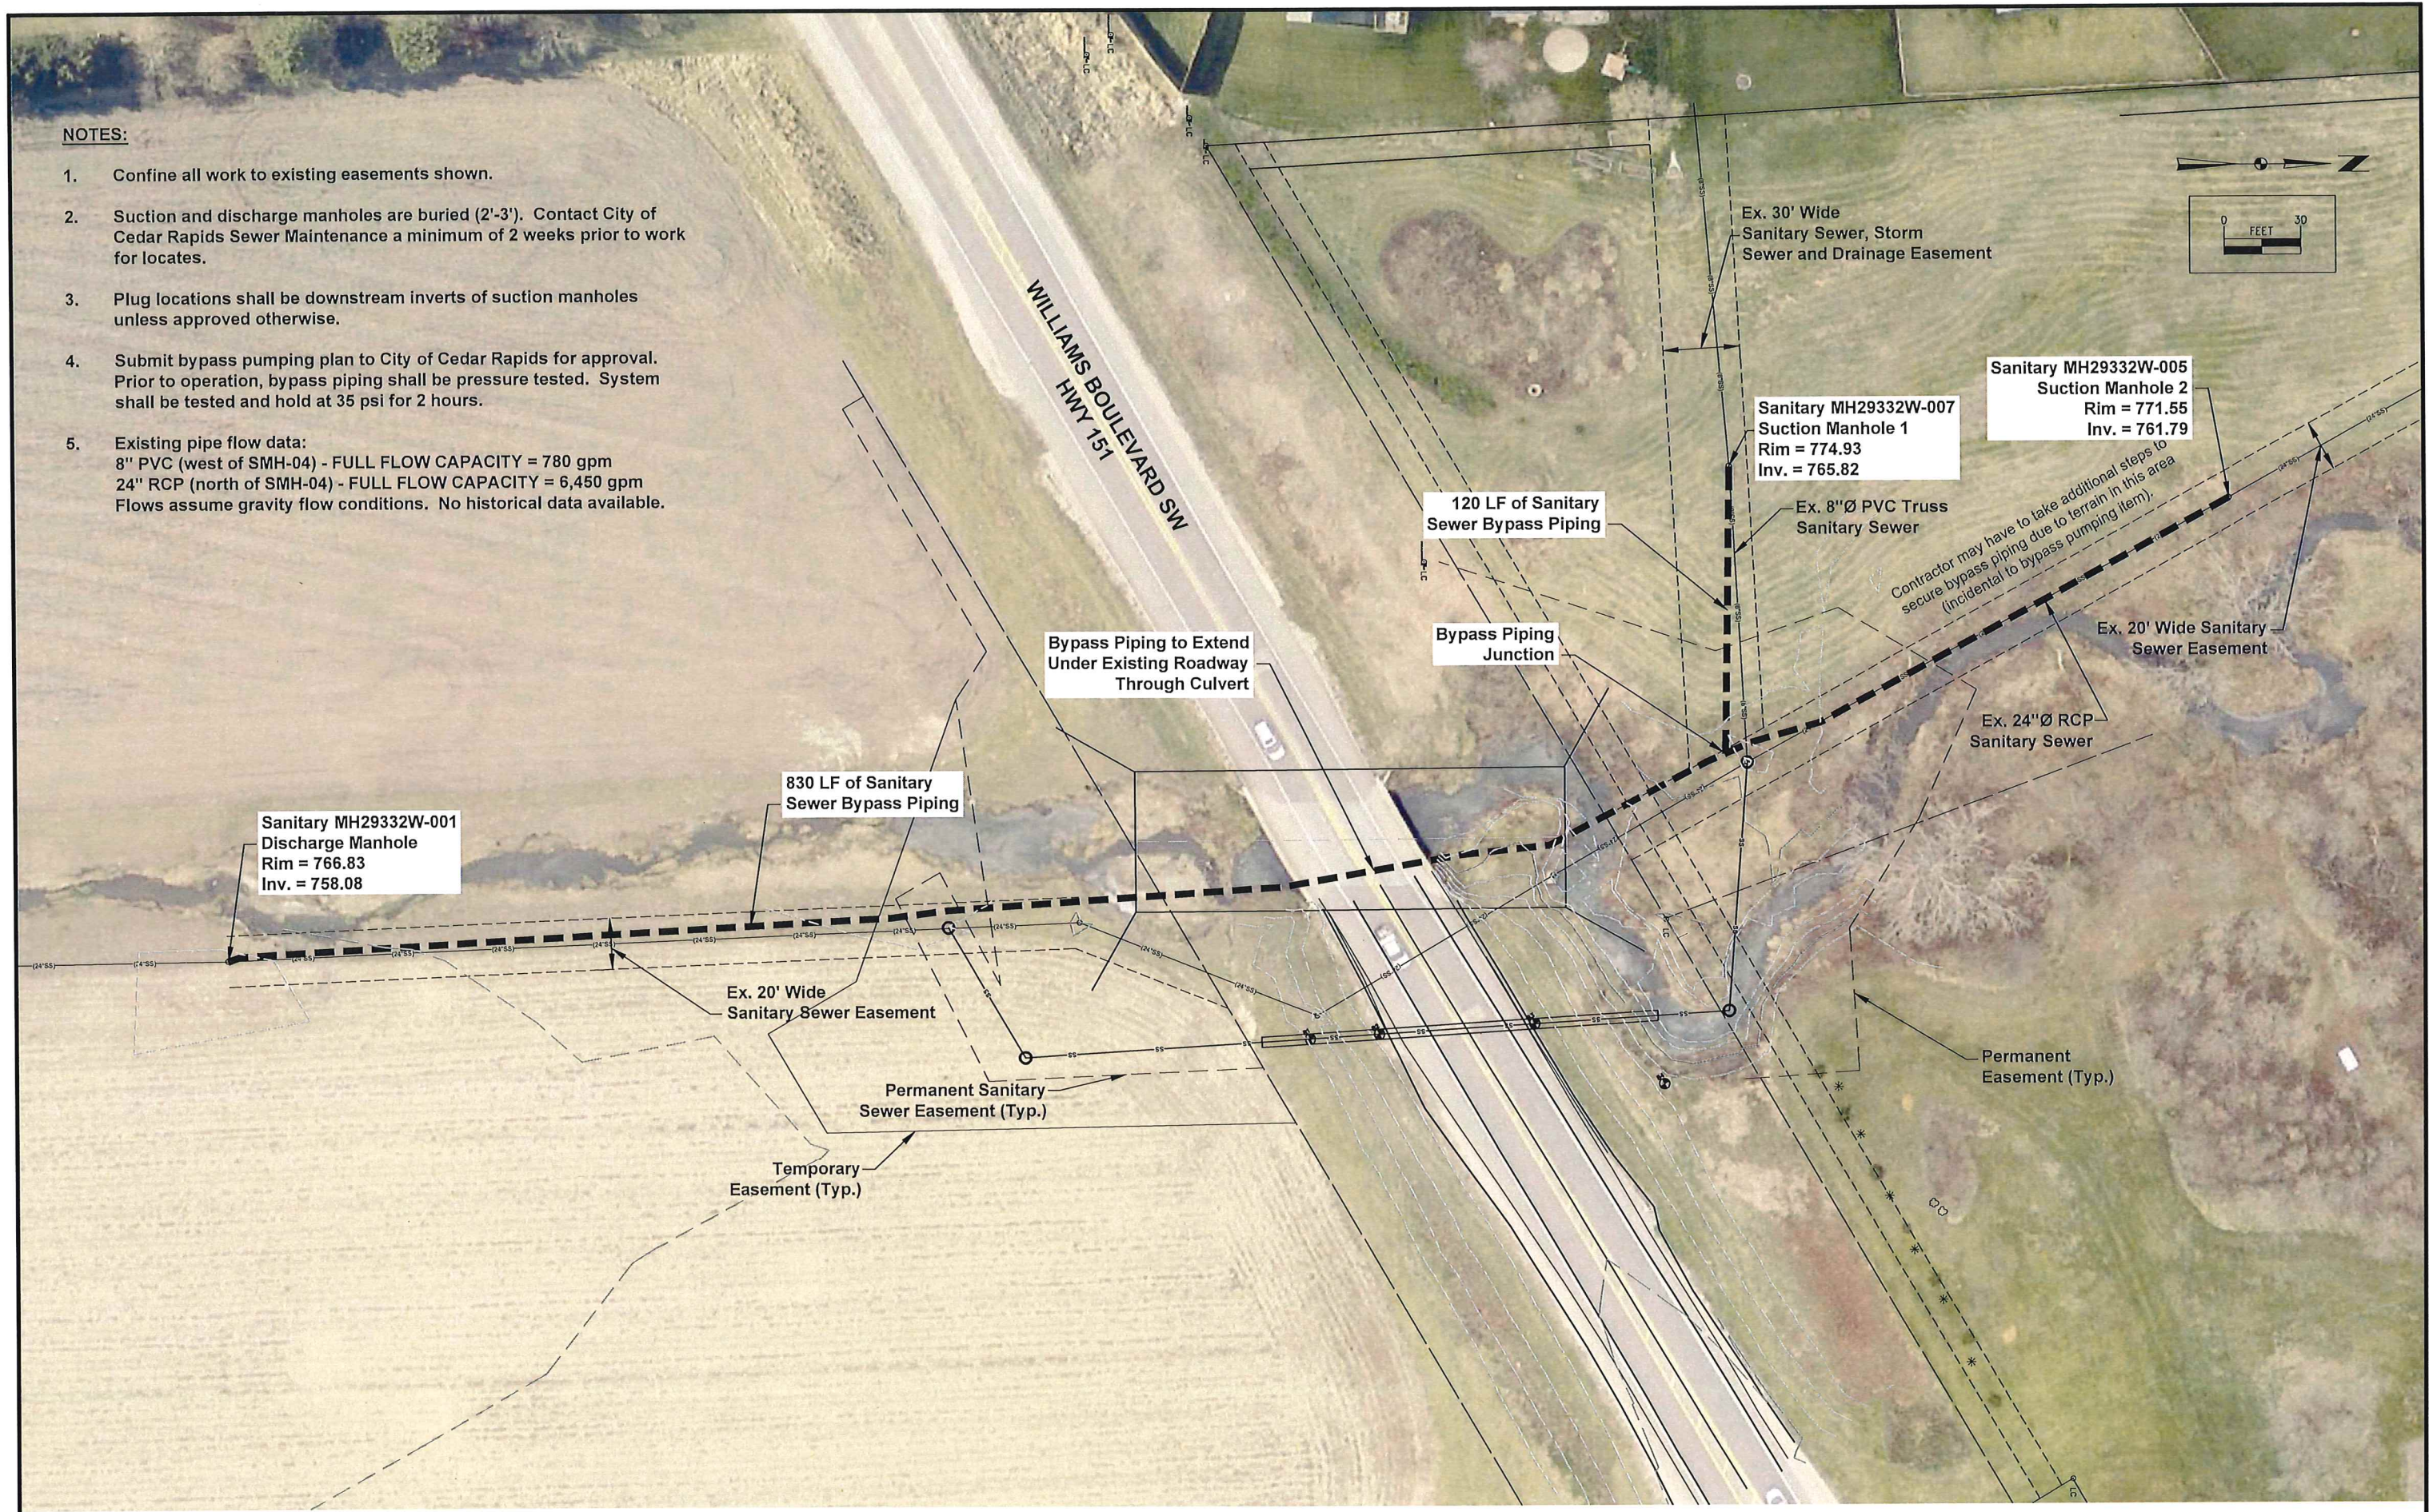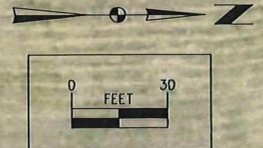

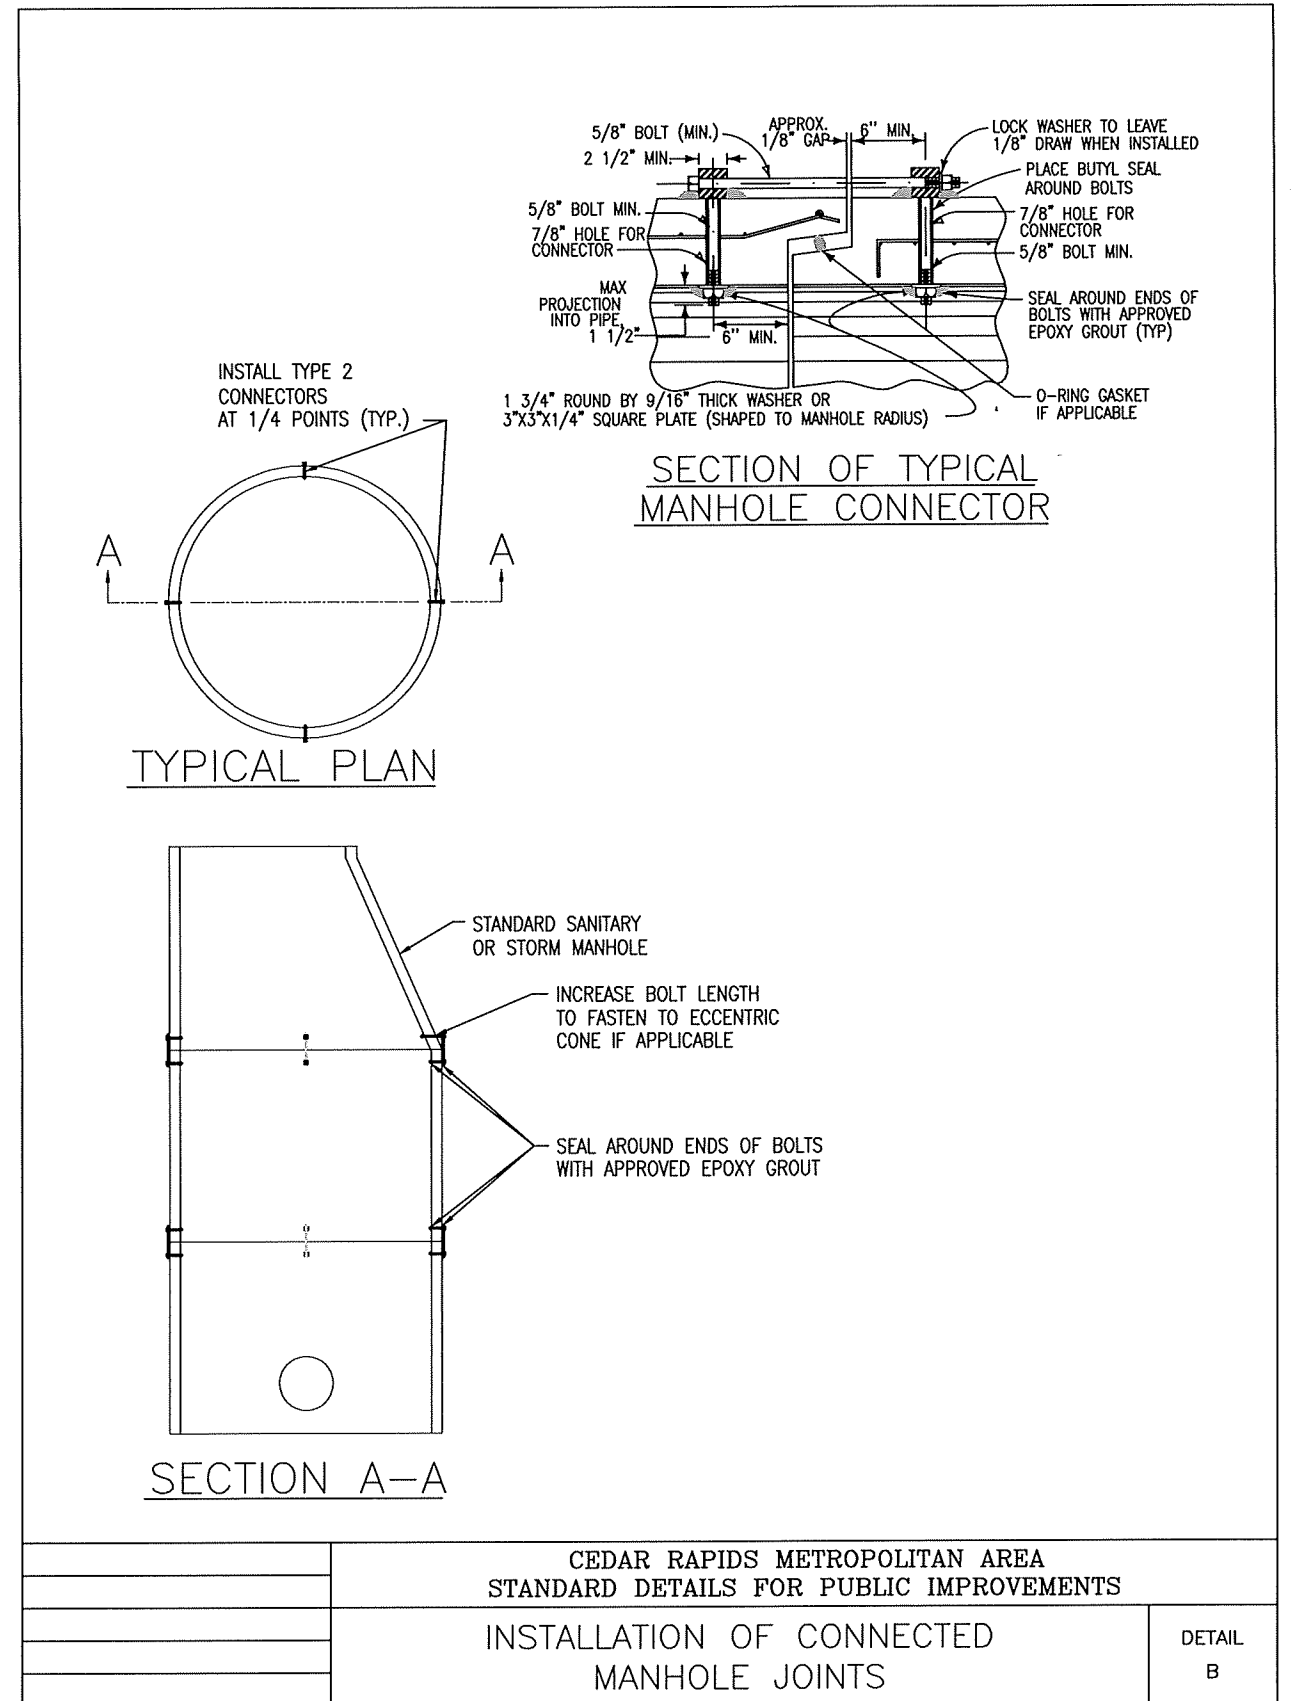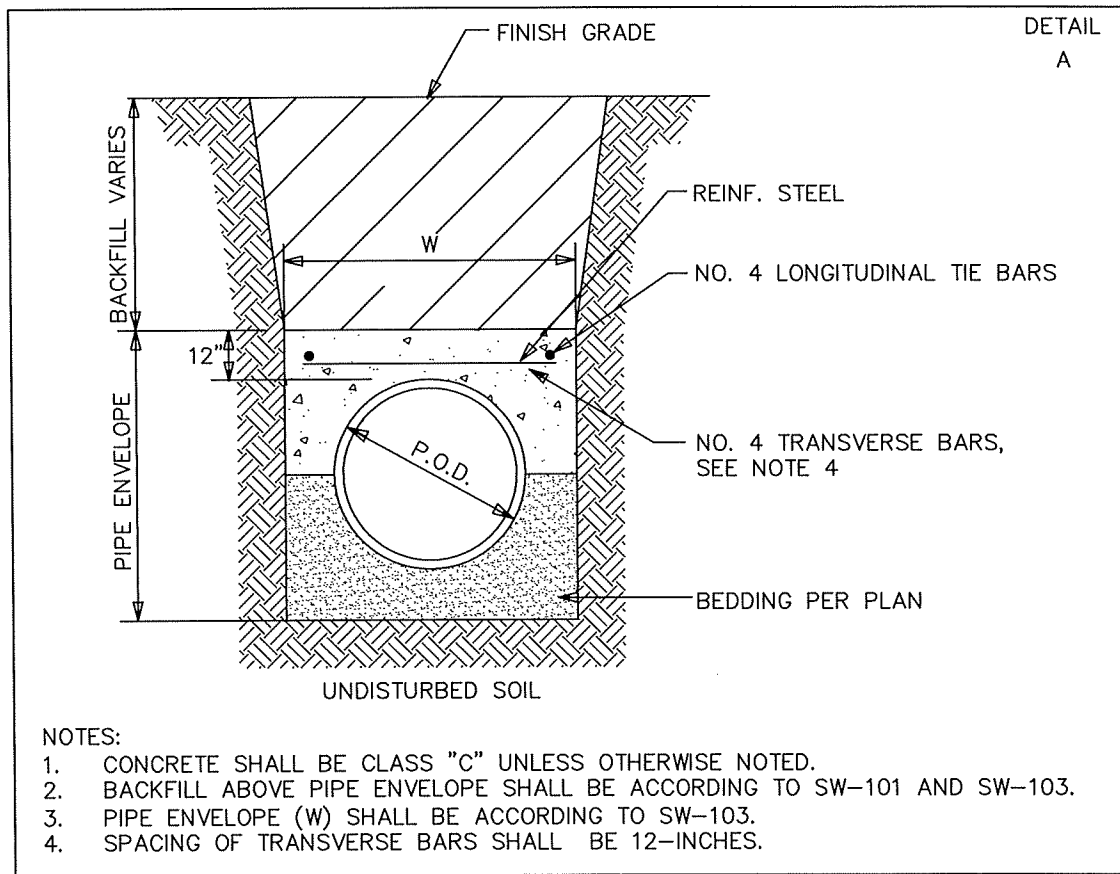


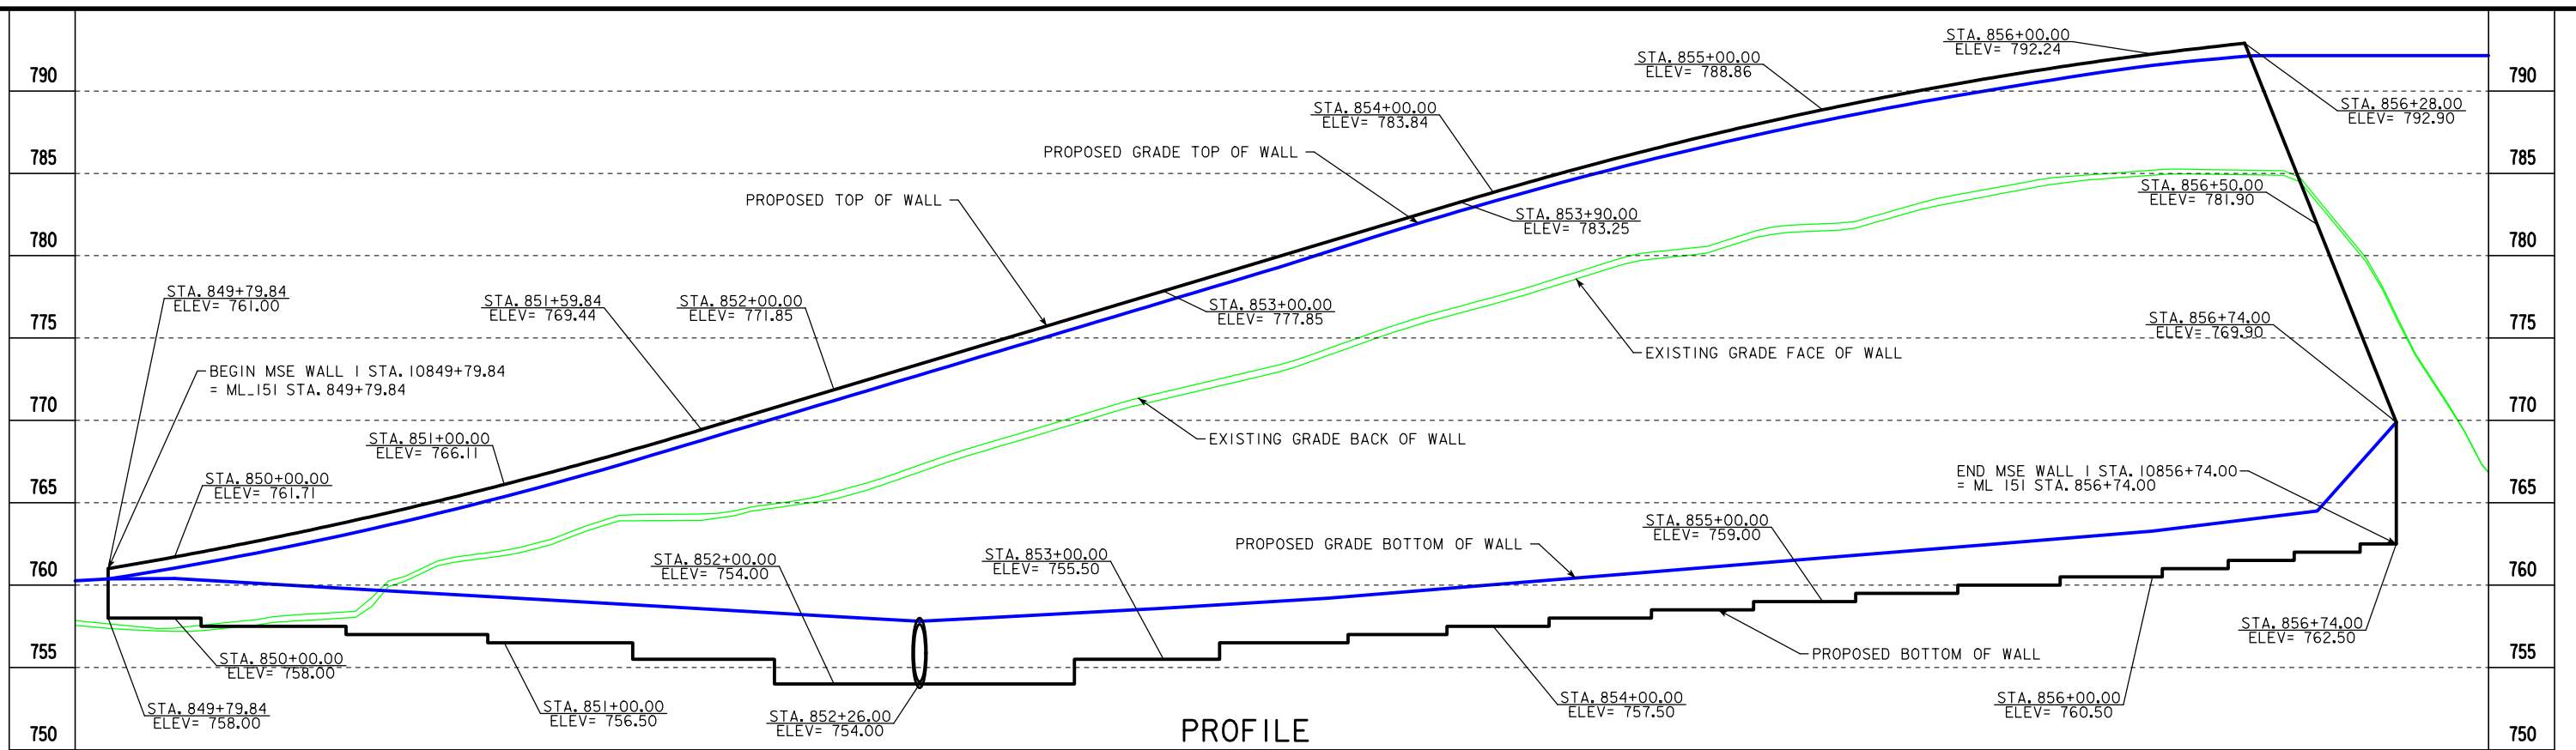


BENCH MARK: BMI
 DESCRIPTION: GIN SPIKE IN POWER POLE, EAST
 SIDE HWY 151, ACROSS FROM "PIT STOP"
 STA. 846+60.91, 23.069' RT.
 ELEV. = 763.60



UTILITIES LEGEND:
 REFER TO SHEET D.1

LOCATION


U.S. 151
 T-82N R-8W
 SECTION 16
 FAIRFAX TOWNSHIP
 LINN COUNTY

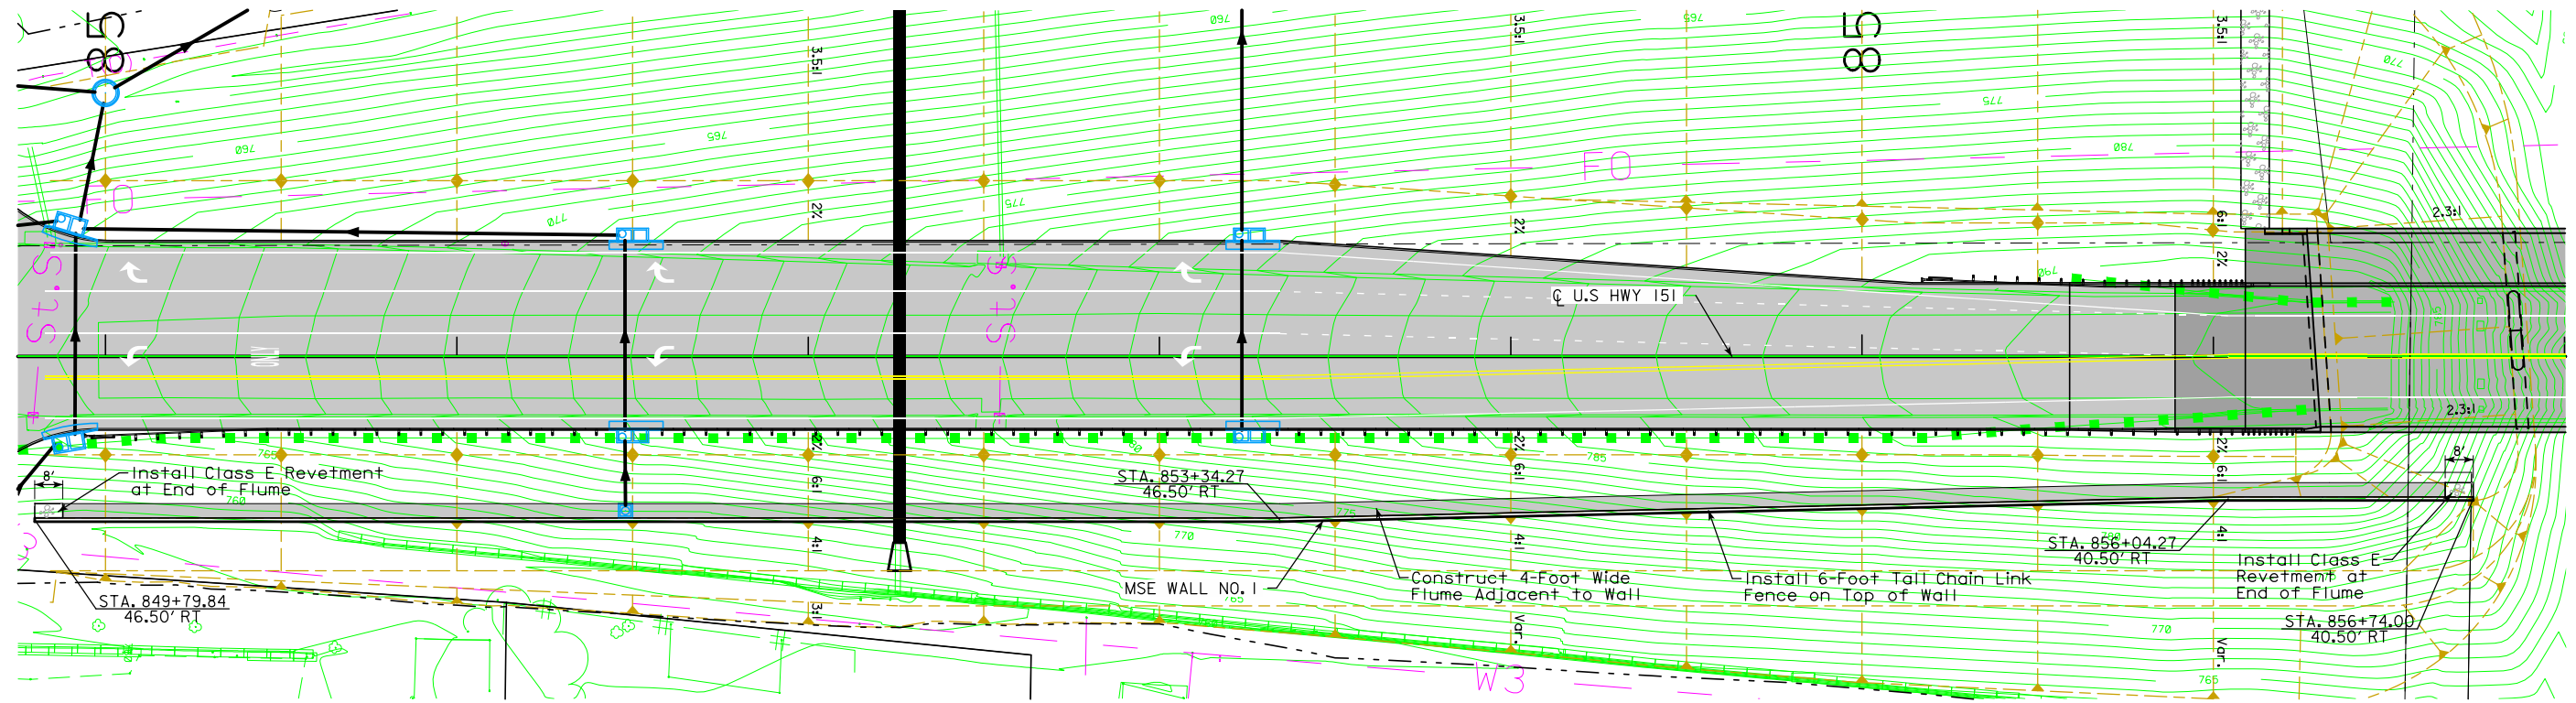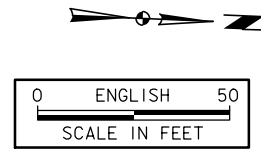

**MSE WALL NO. 1
 SITUATION PLAN**

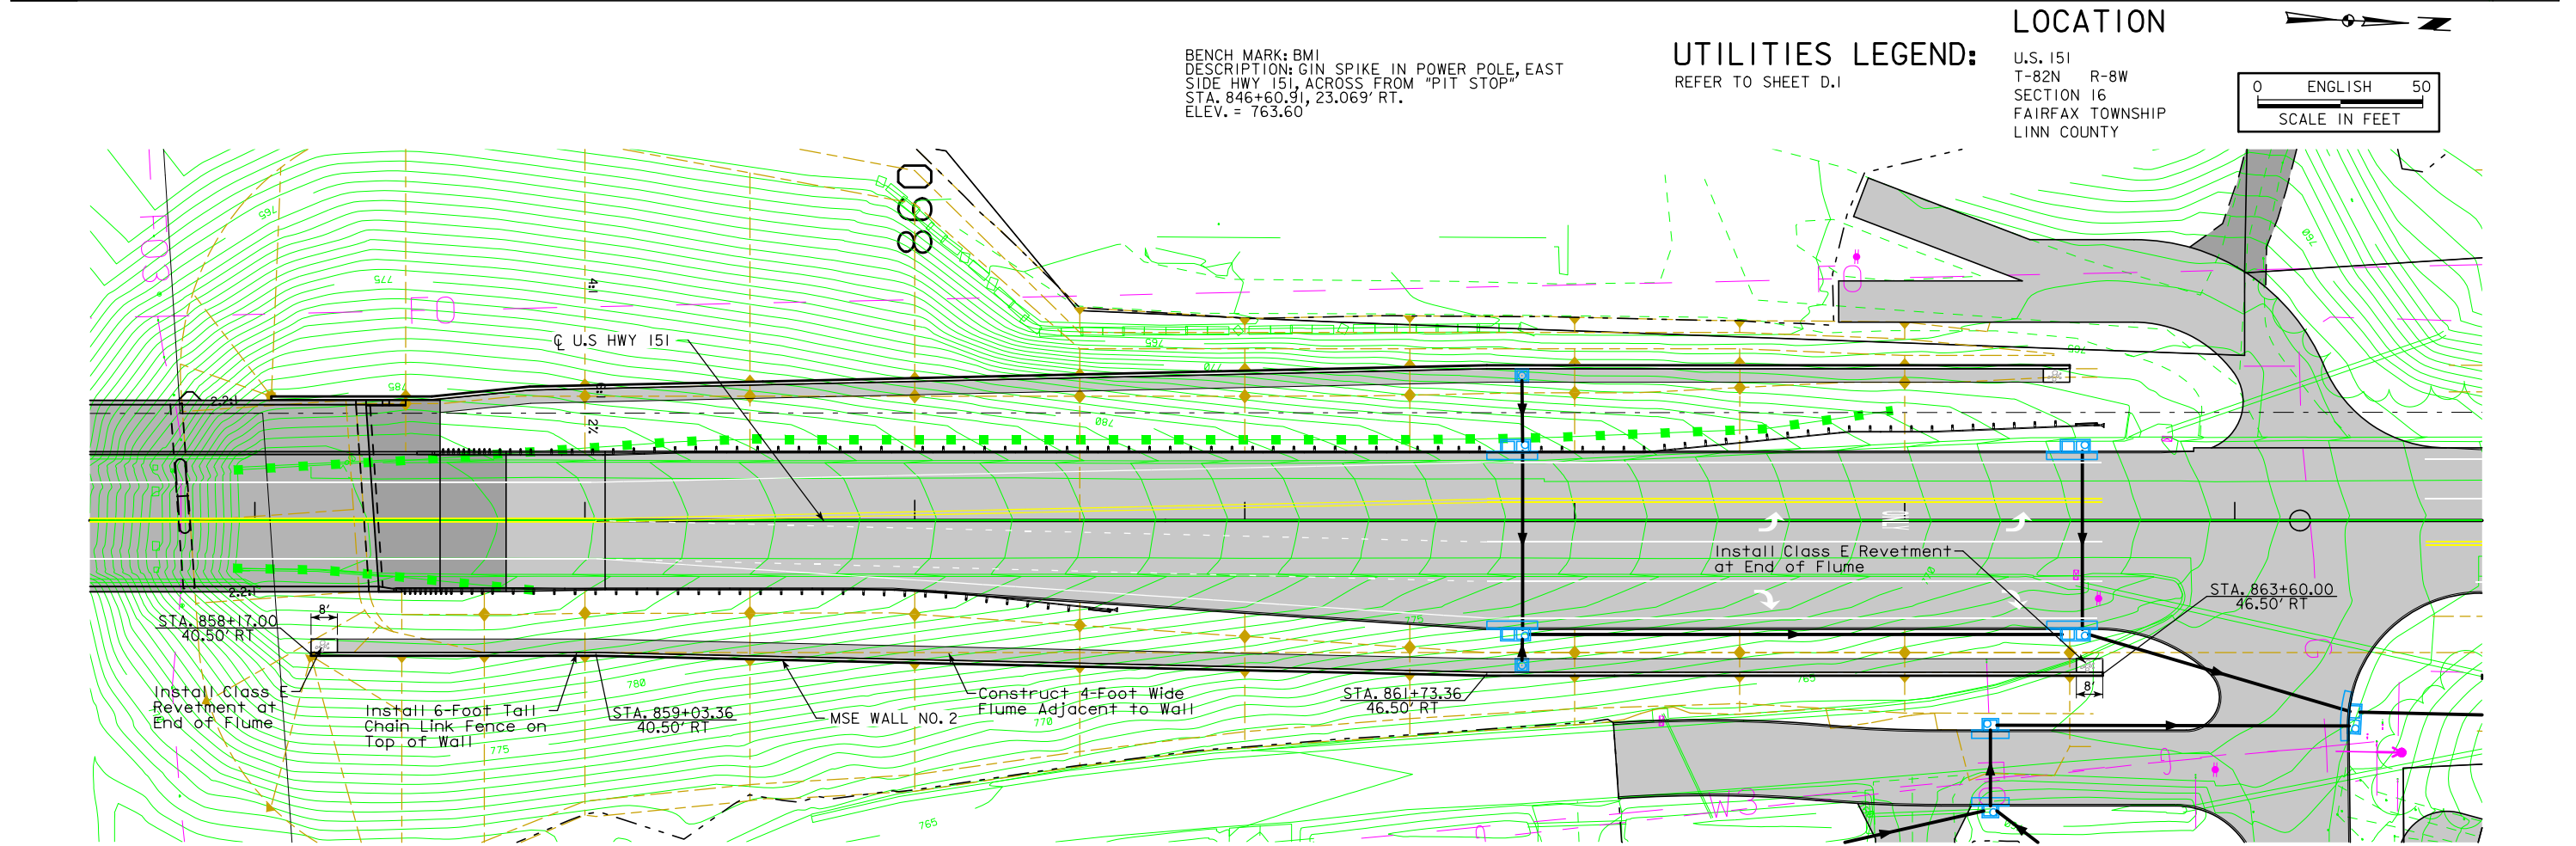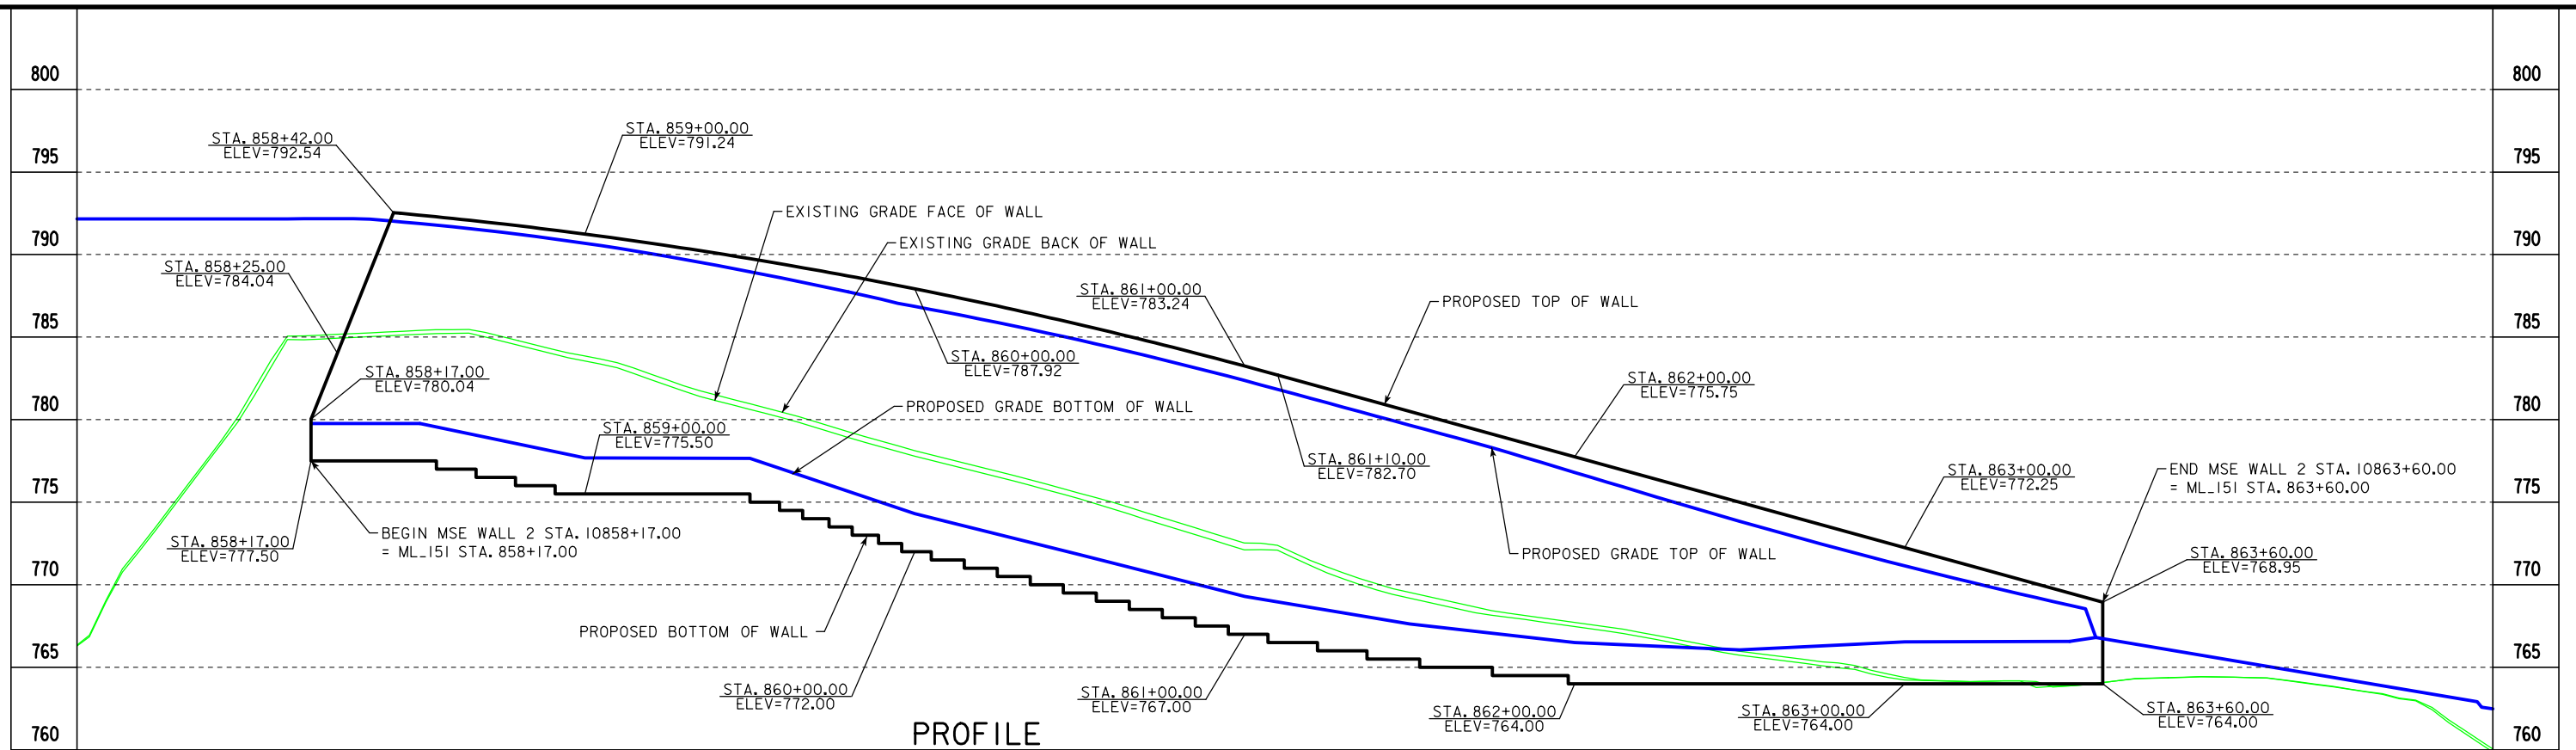

**MSE WALL NO. 2
 SITUATION PLAN**

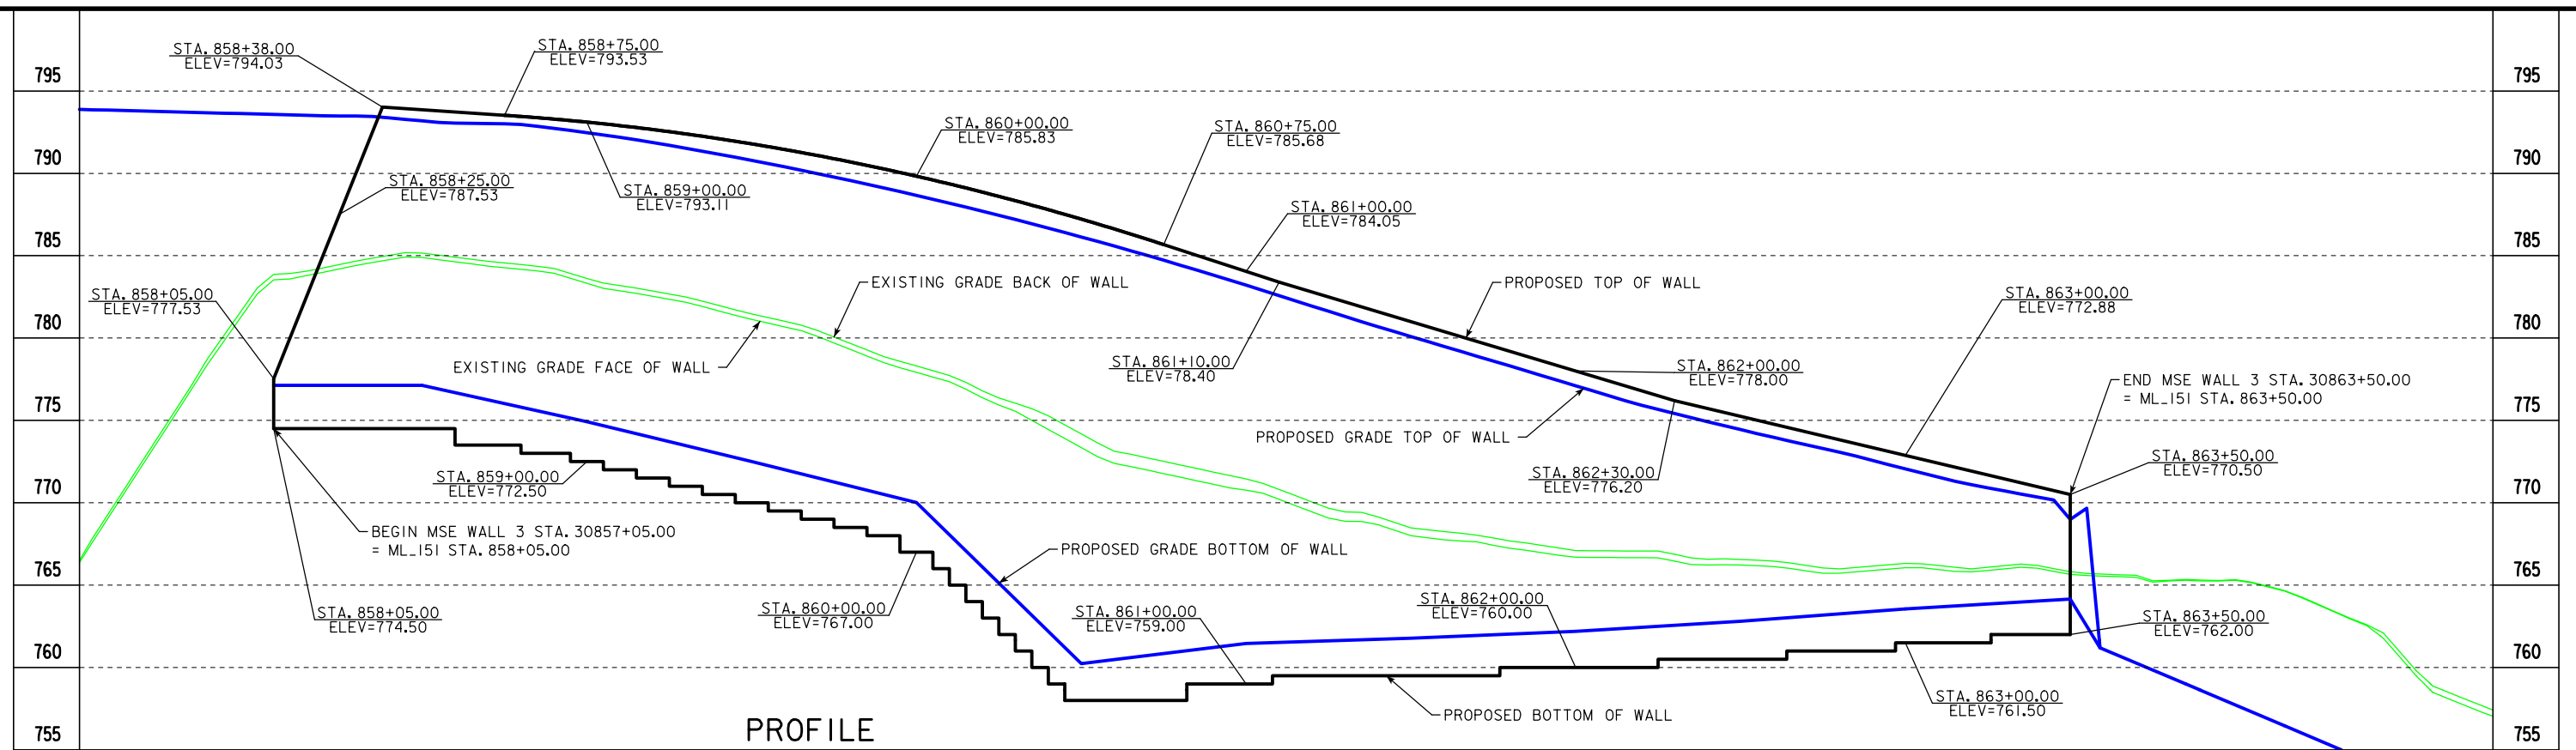

PROFILE


LOCATION

U.S. 151
T-82N R-8W
SECTION 16
FAIRFAX TOWNSHIP
LINN COUNTY



BENCH MARK: BMI
DESCRIPTION: GIN SPIKE IN POWER POLE, EAST
SIDE HWY 151, ACROSS FROM "PIT STOP"
STA. 846+60.91, 23.069' RT.
ELEV. = 763.60

UTILITIES LEGEND:
REFER TO SHEET D.1

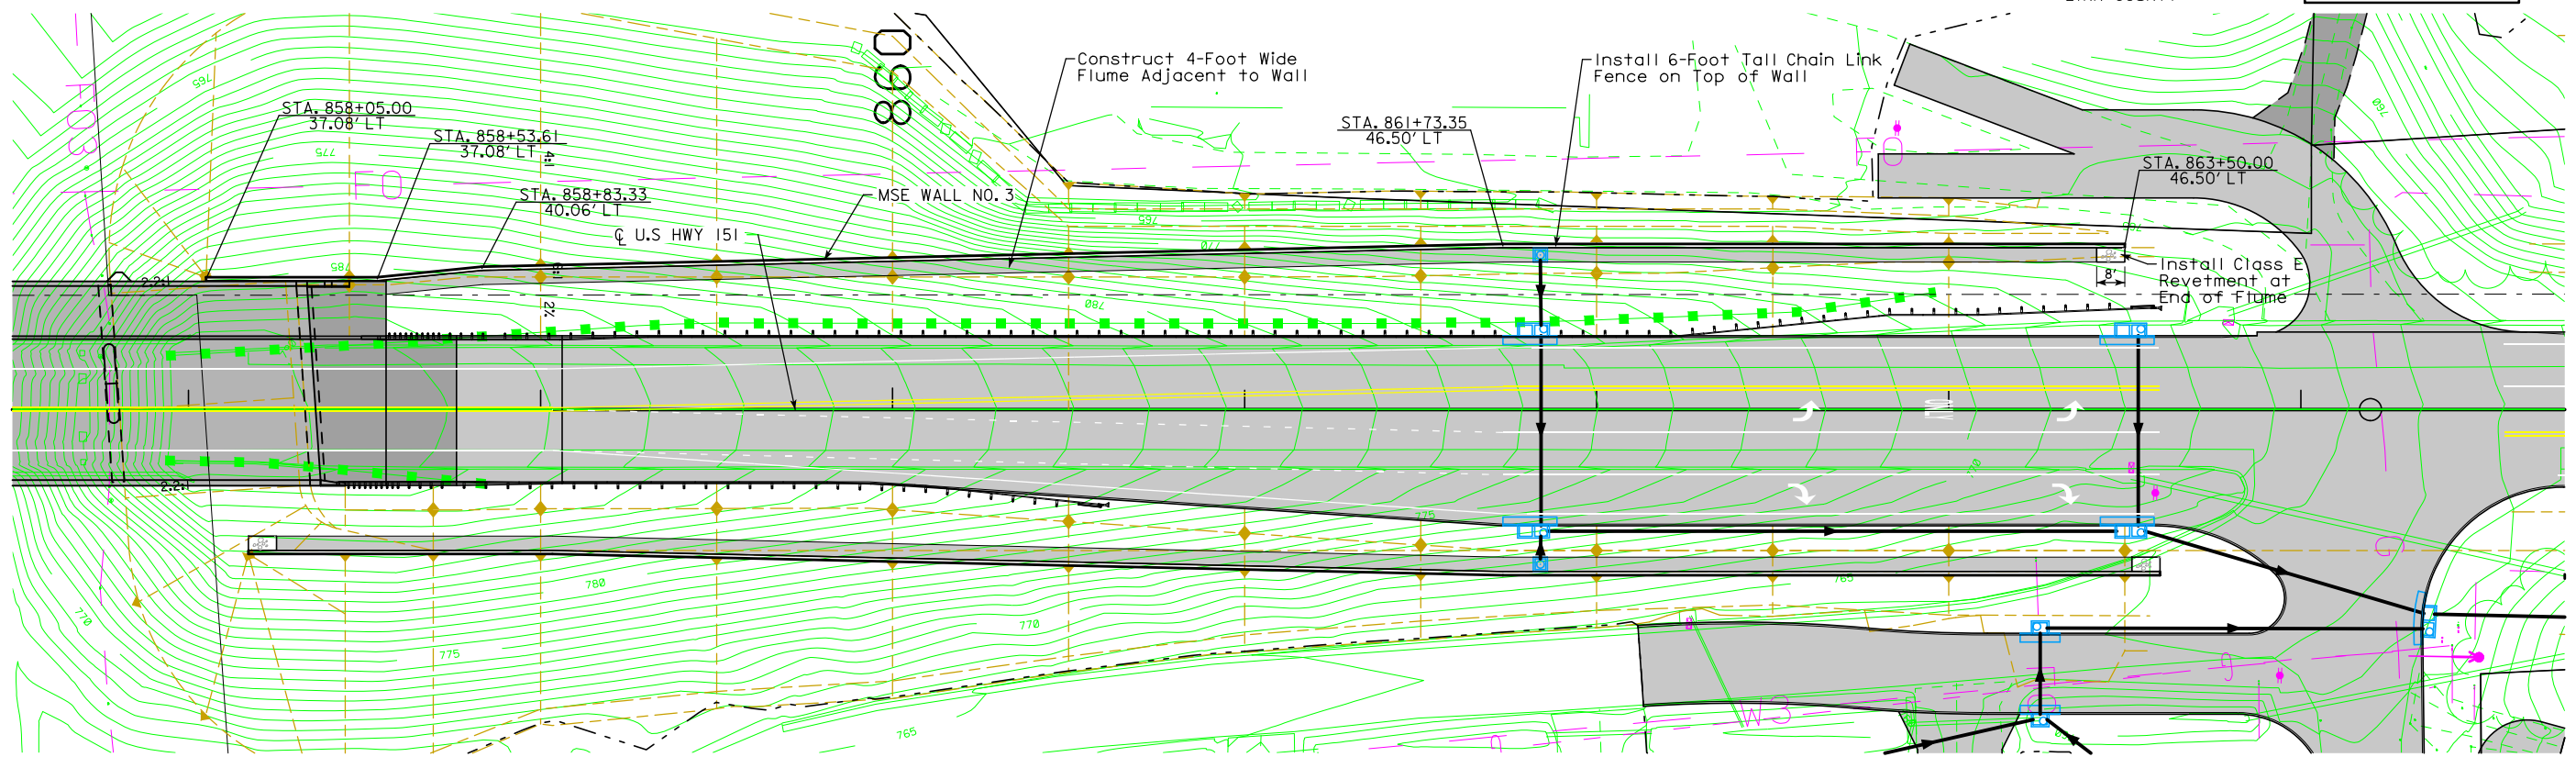

SITUATION PLAN

MSE WALL NO. 3
SITUATION PLAN

LINE STYLE LEGEND OF CROSS SECTION SHEETS (ROAD)

- Existing Ground Line
- ===== Proposed Template
- ===== Proposed Topsoil Placement
- Additional Topsoil Removal
- Subgrade Treatment
- Granular Shoulder
- ===== Pavement
- Existing Pipe\R/CB
- ===== Proposed Pipe\R/CB
- ===== Proposed Dike
- ===== All Elements Associated with Proposed Entrances

LINE STYLE LEGEND OF CROSS SECTION SHEETS (SOILS)

- Topsoil (Class 10)
- SLOPE DRESSING --- Slope Dressing Only
- Class 10 Materials
- Select Loams And Clay-Loams
- Select Sand
- Unsuitable Type A Disposal
- Unsuitable Type B Disposal
- Unsuitable Type C Disposal
- Shale
- Waste
- Broken and Weathered Rock
- Solid Rock
- Boulders

Note: All layer lines and descriptions identify layers above the line.

Note: Vertical or near vertical lines connecting soil layers at edges of cross sections are only for the purpose of calculating template quantities and do not depict soil stratification.


SYMBOL LEGEND OF CROSS SECTION SHEETS

- Existing ROW
----- Existing Right-of-Way Limit
- Proposed ROW
----- Proposed Right-of-Way Limit
- Temporary ROW
----- Temporary Right-of-Way Limit


**CROSS SECTION
LEGEND AND SYMBOL
INFORMATION SHEET**

(COVERS SHEET SERIES W, X, Y, & Z)


US Highway 151

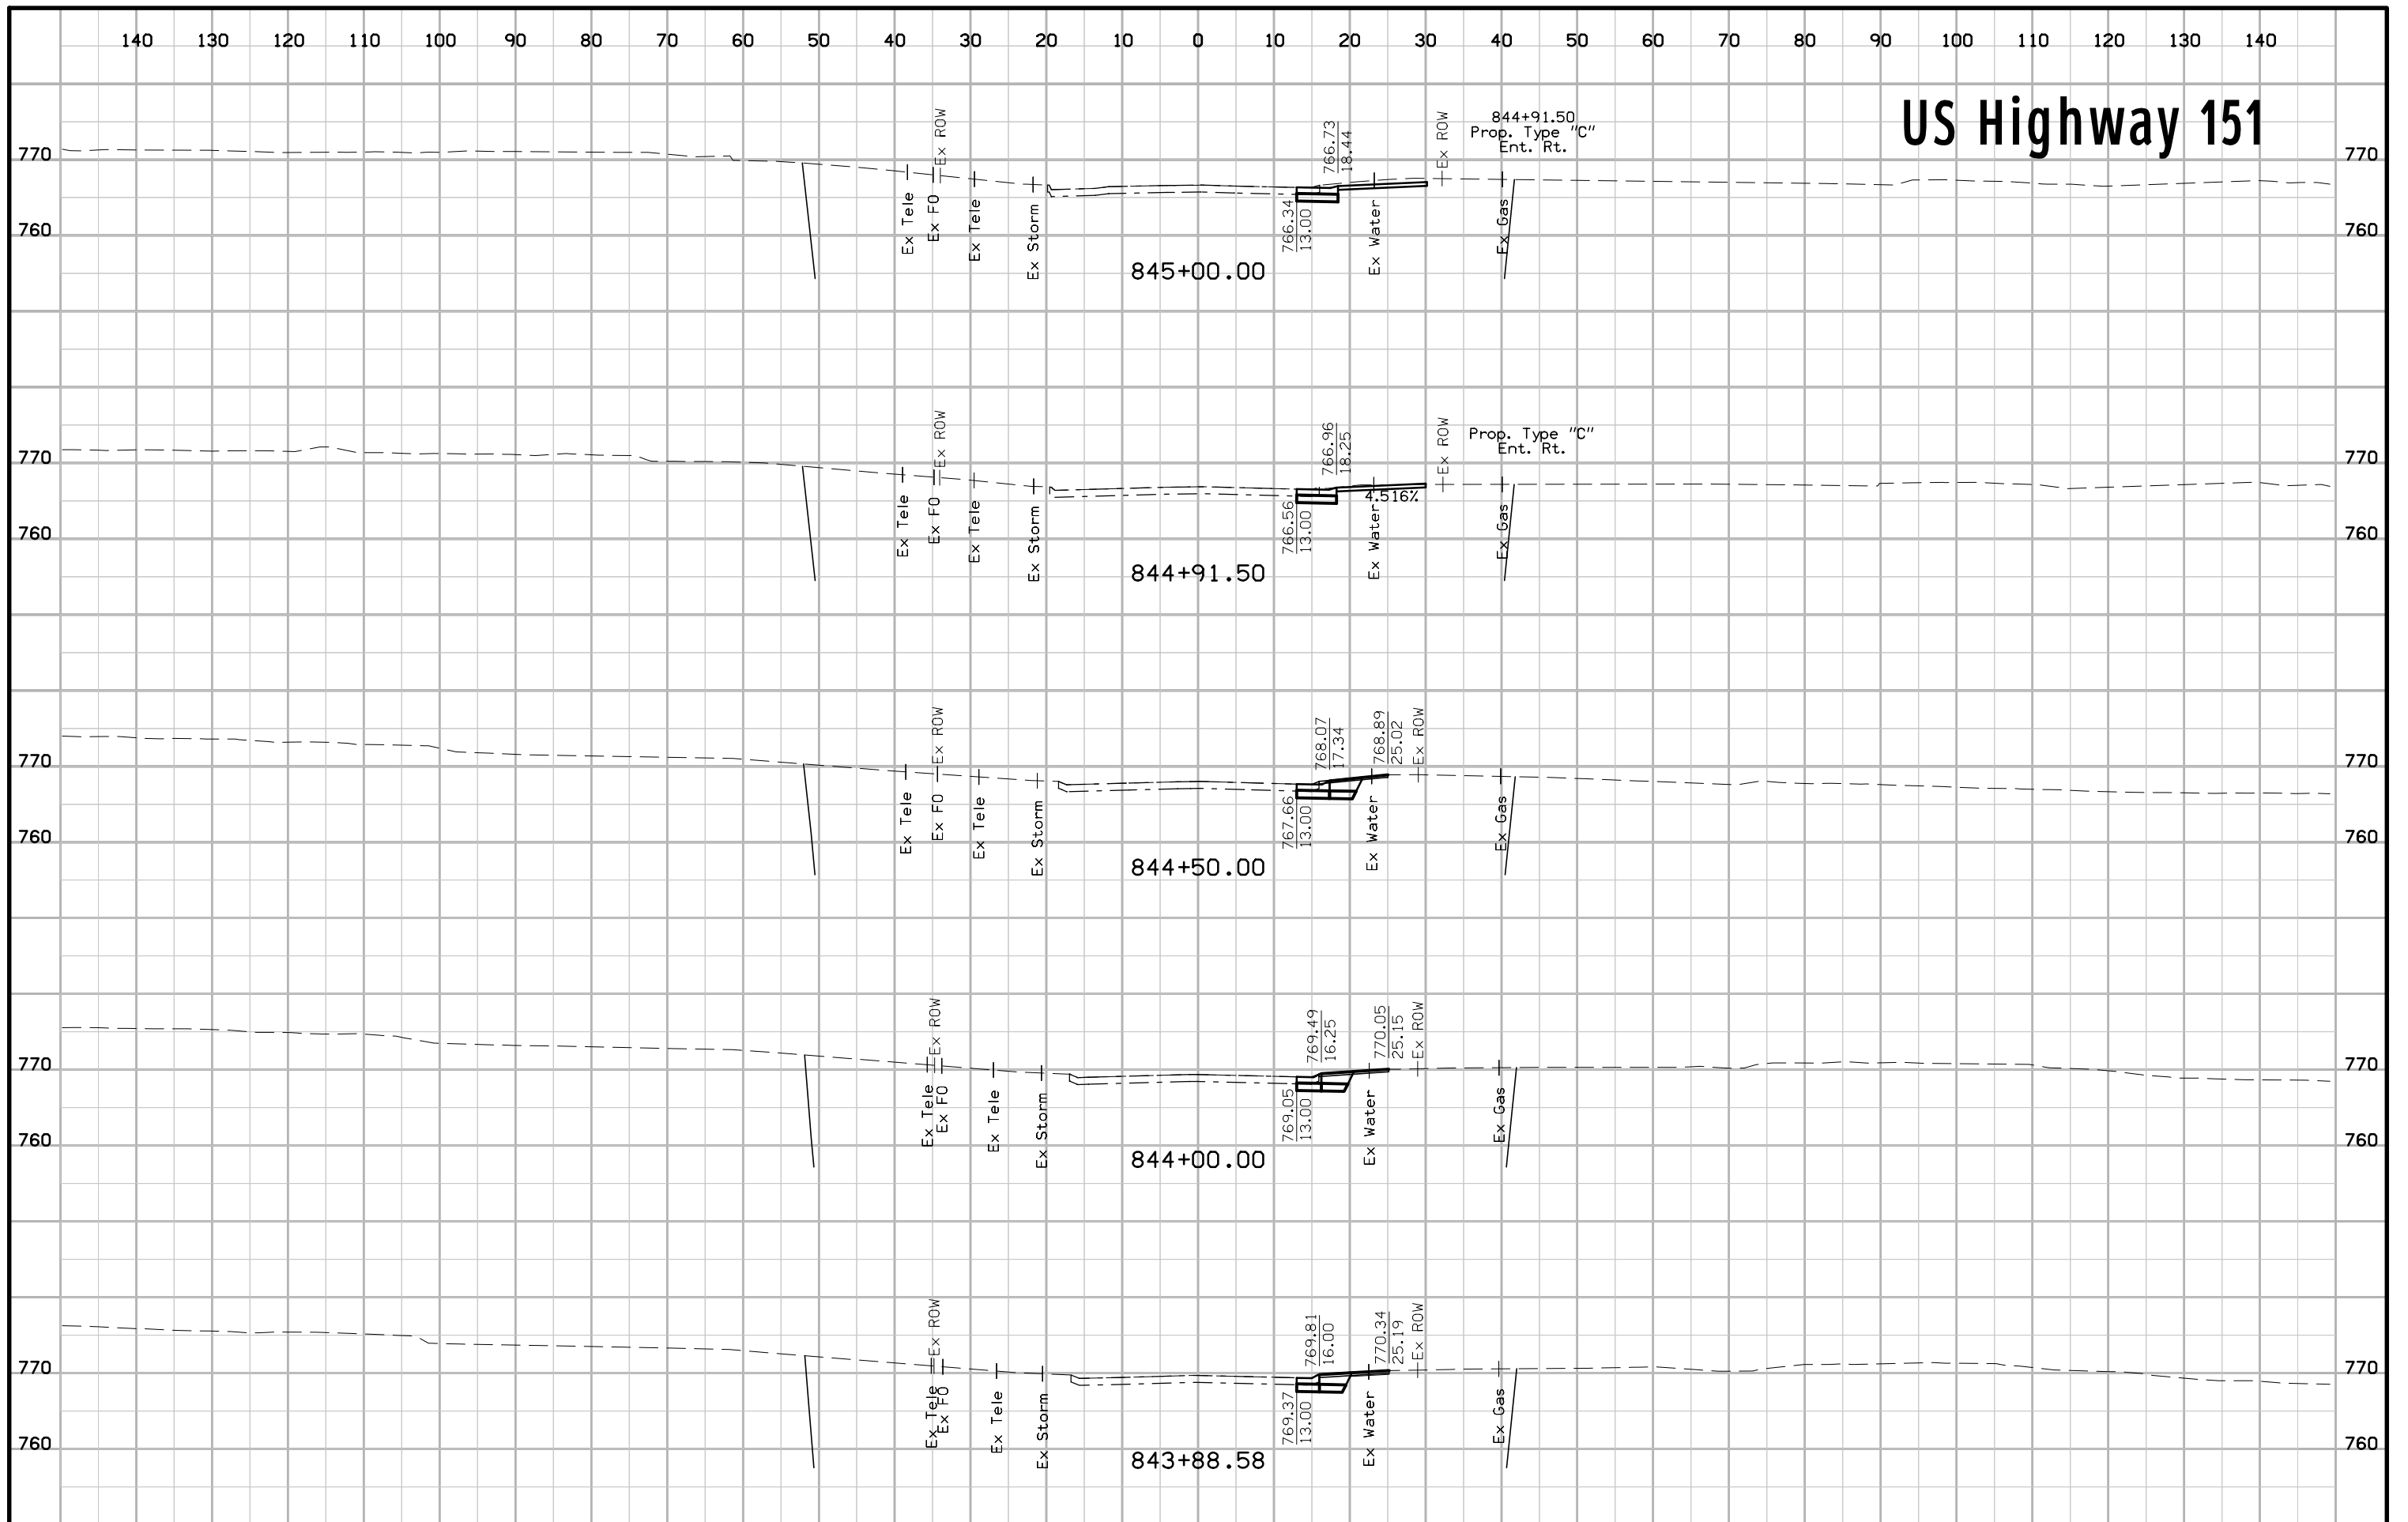


US Highway 151

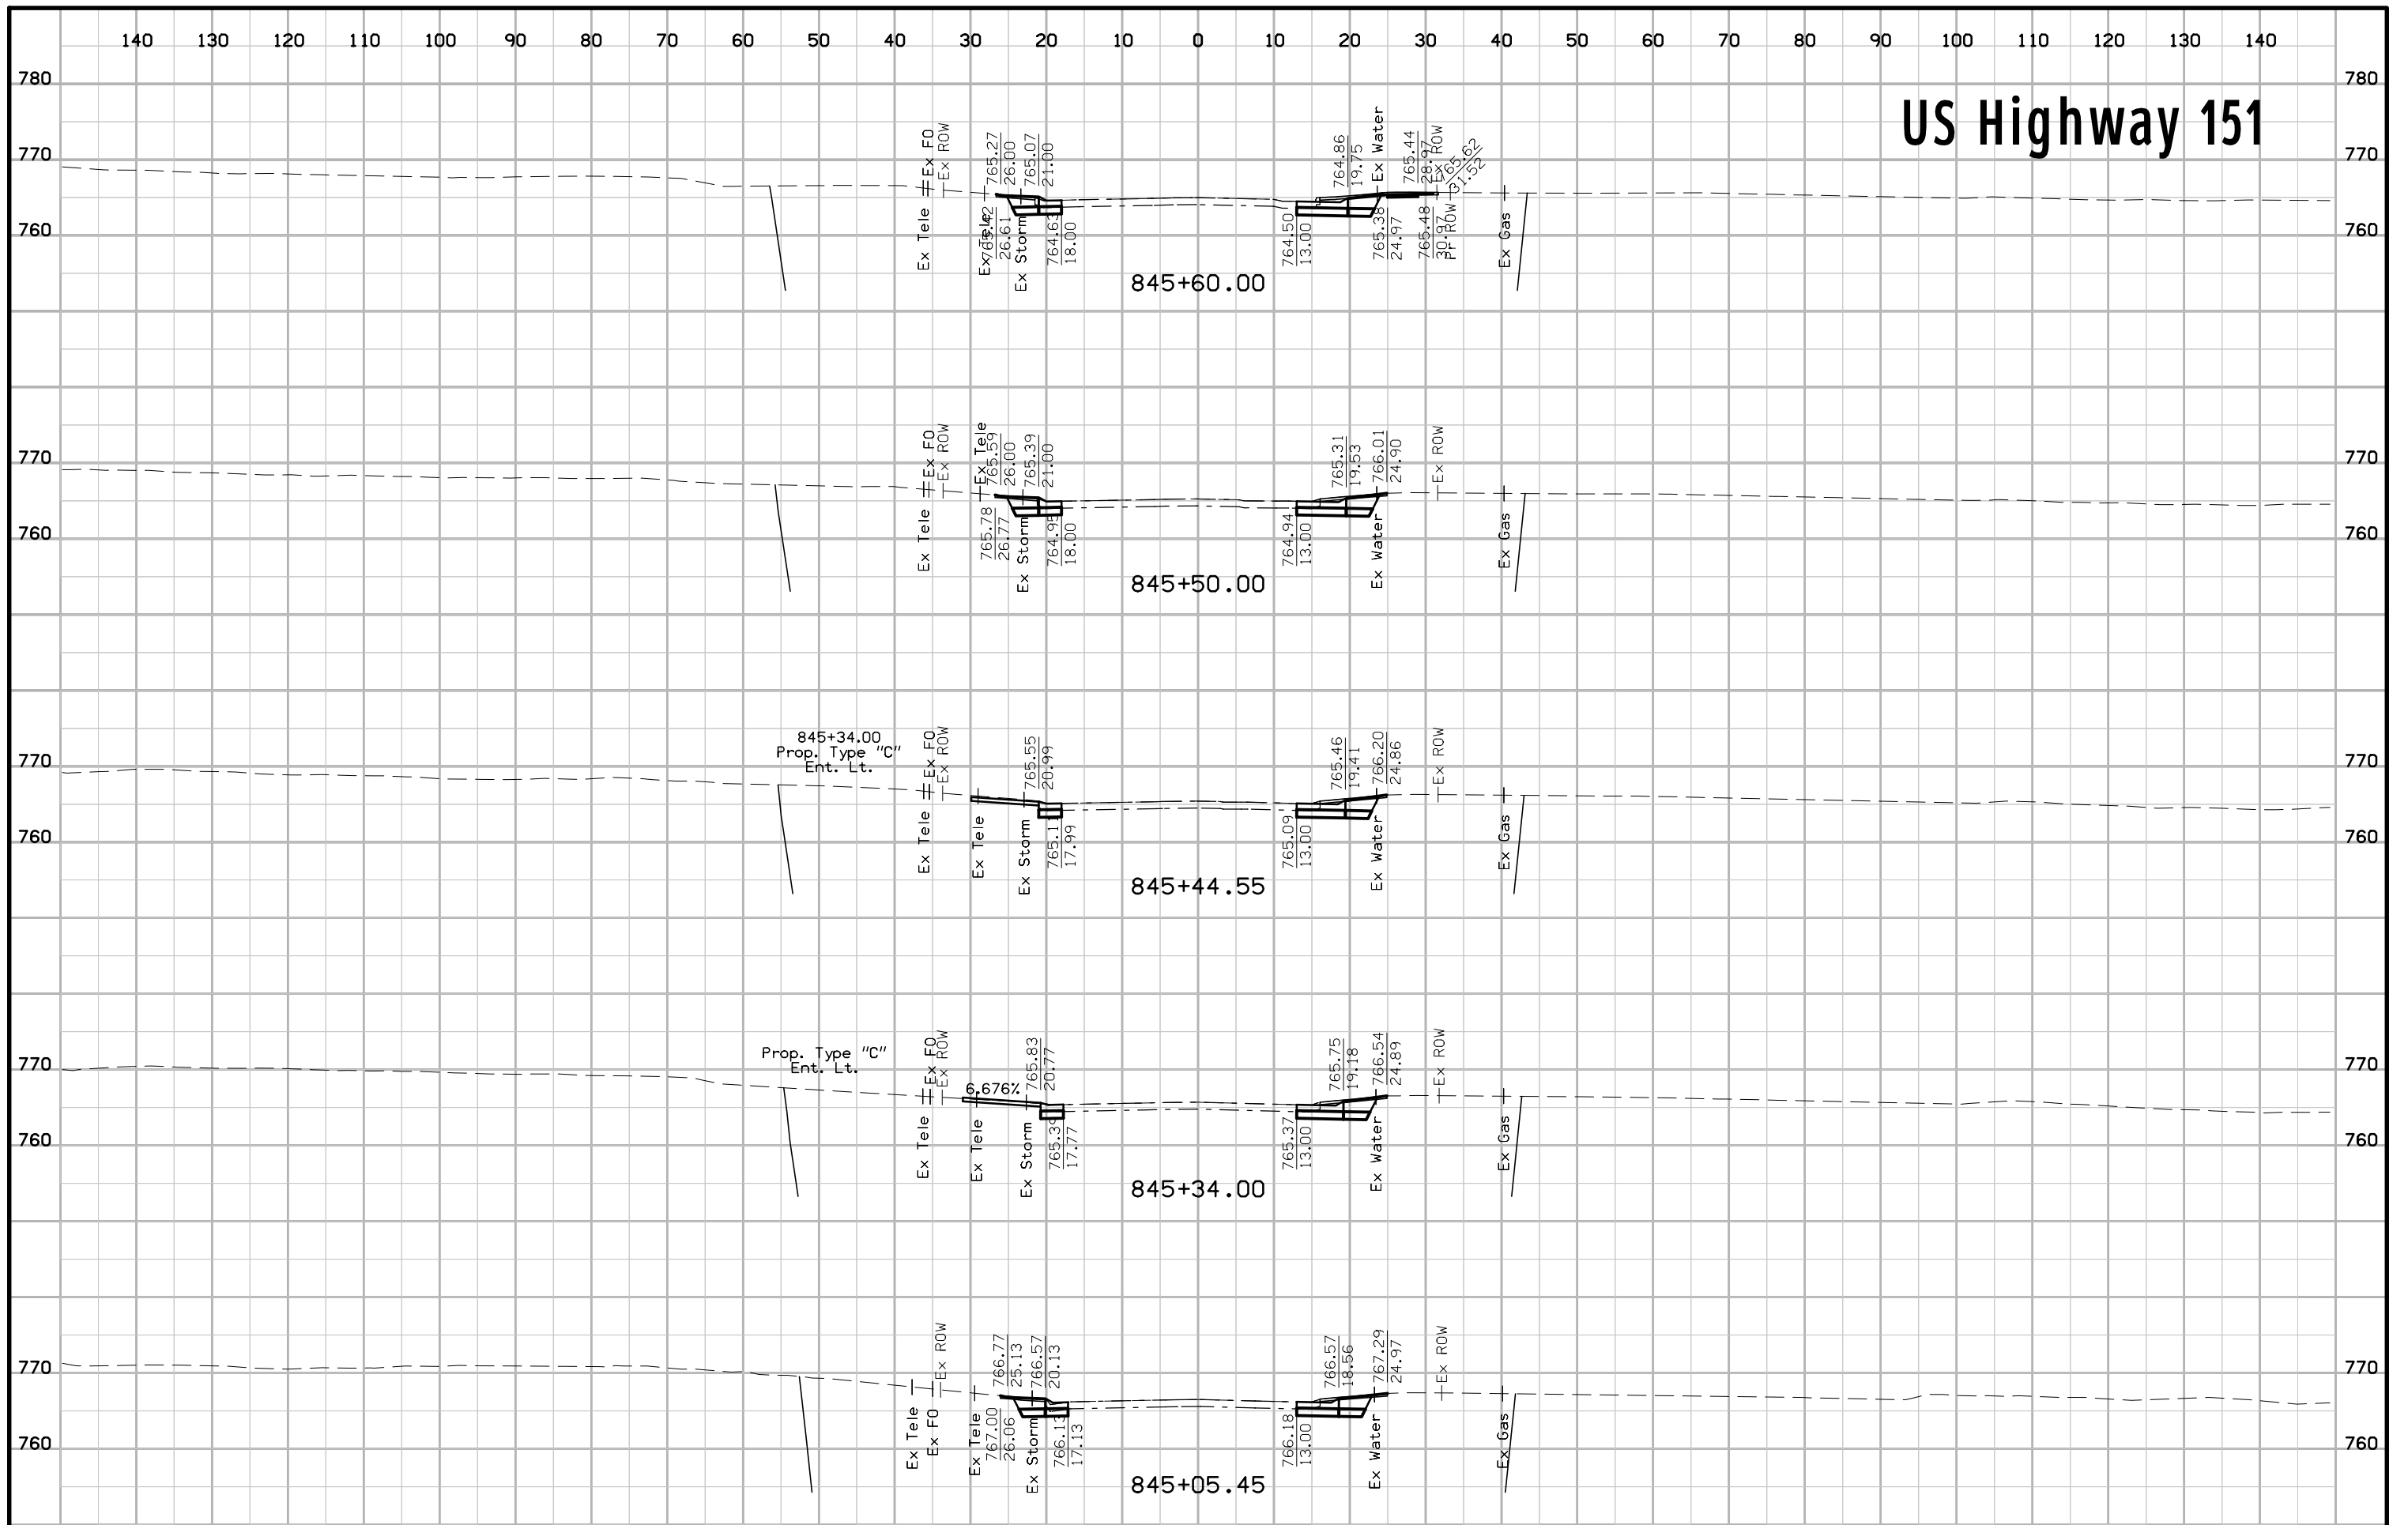


US Highway 151

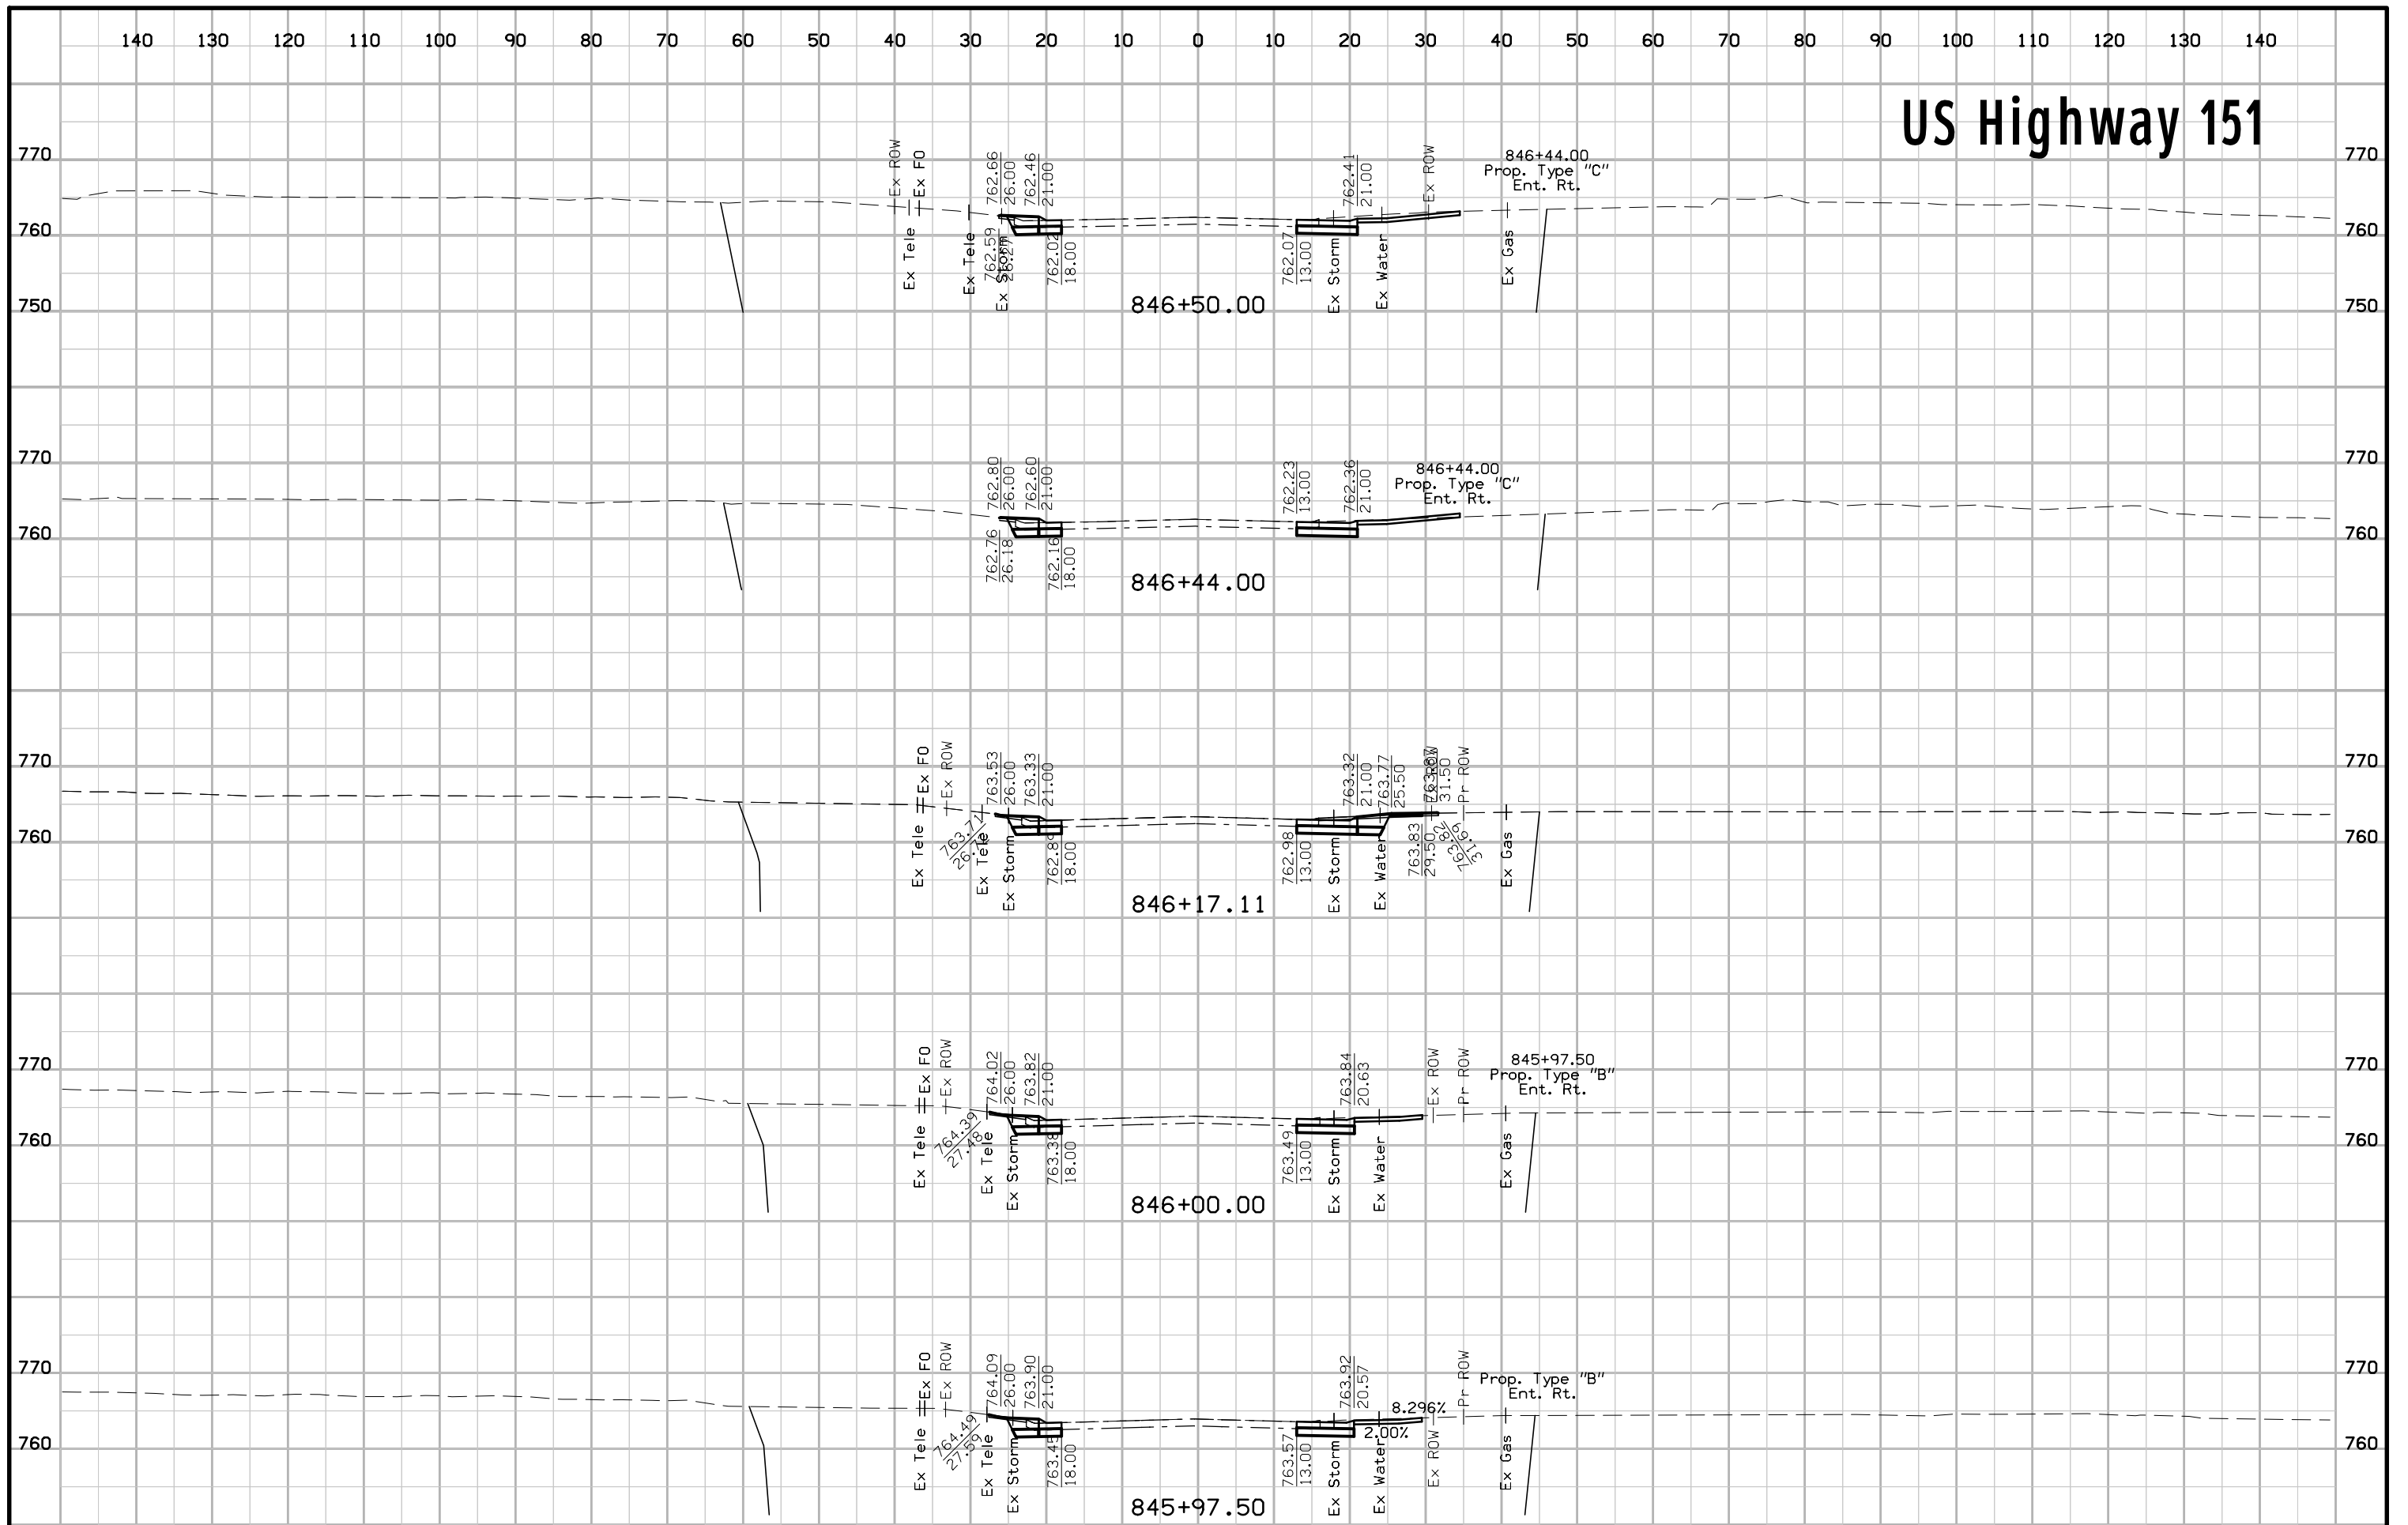


US Highway 151

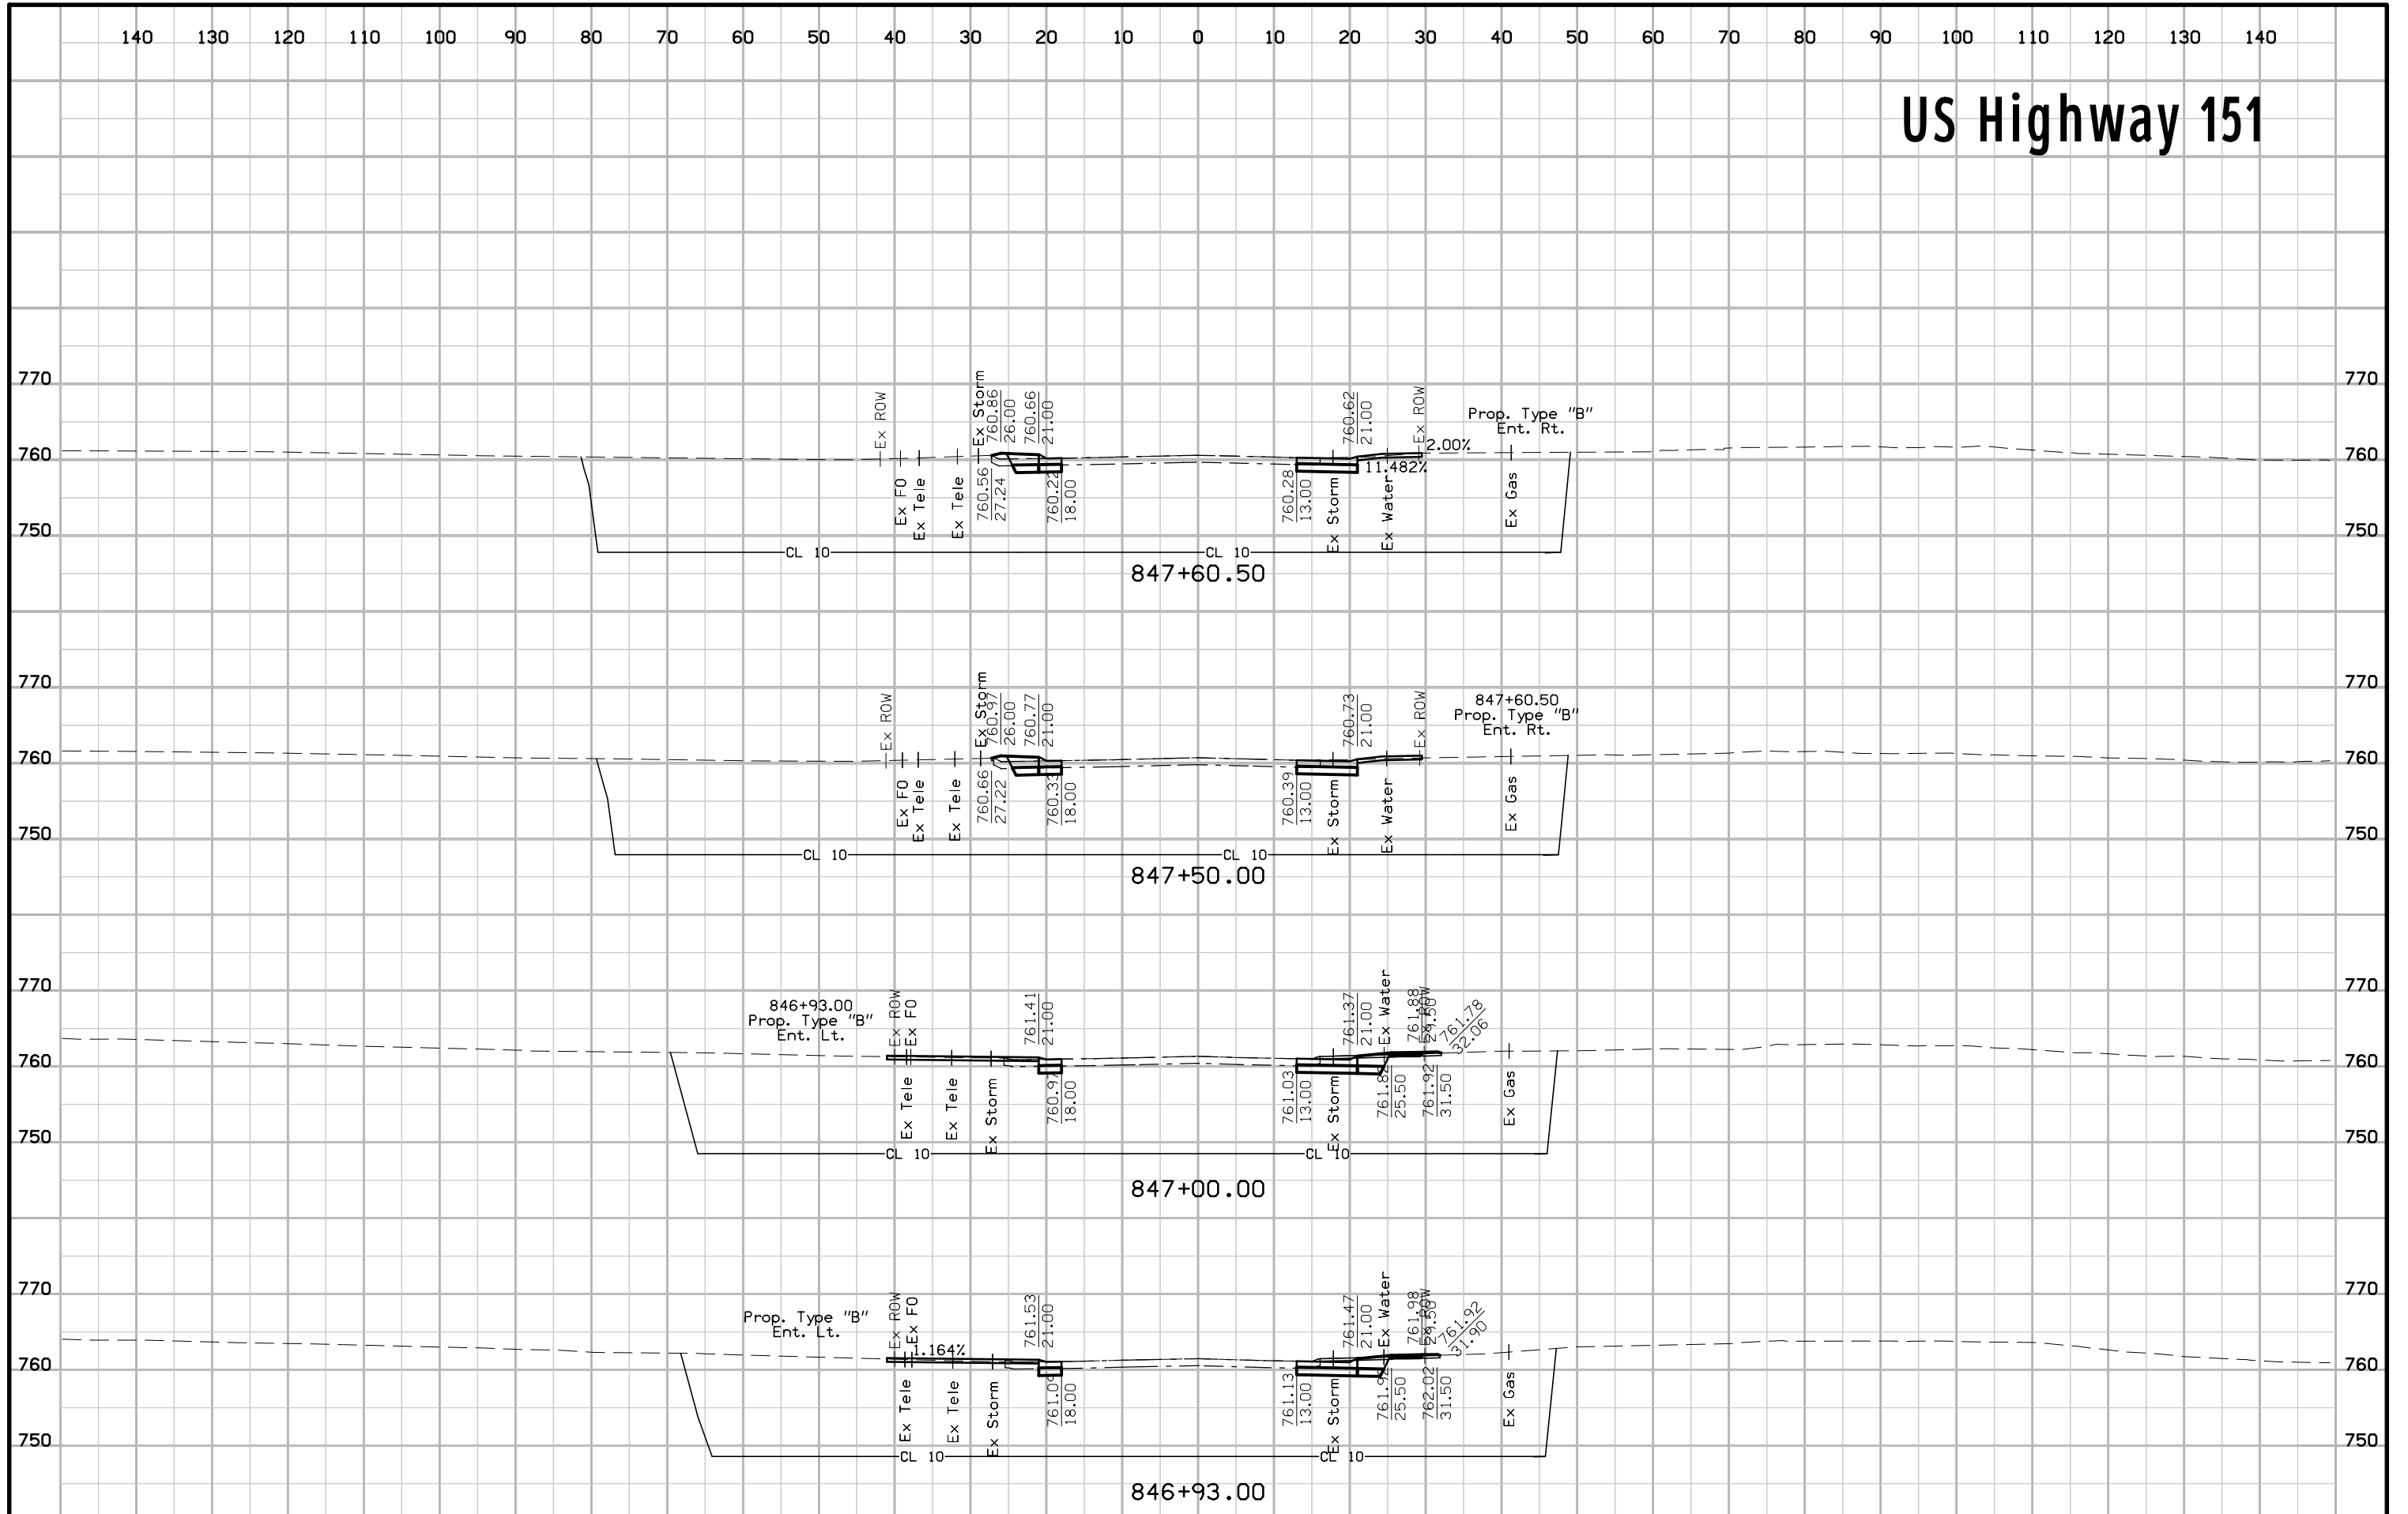


US Highway 151

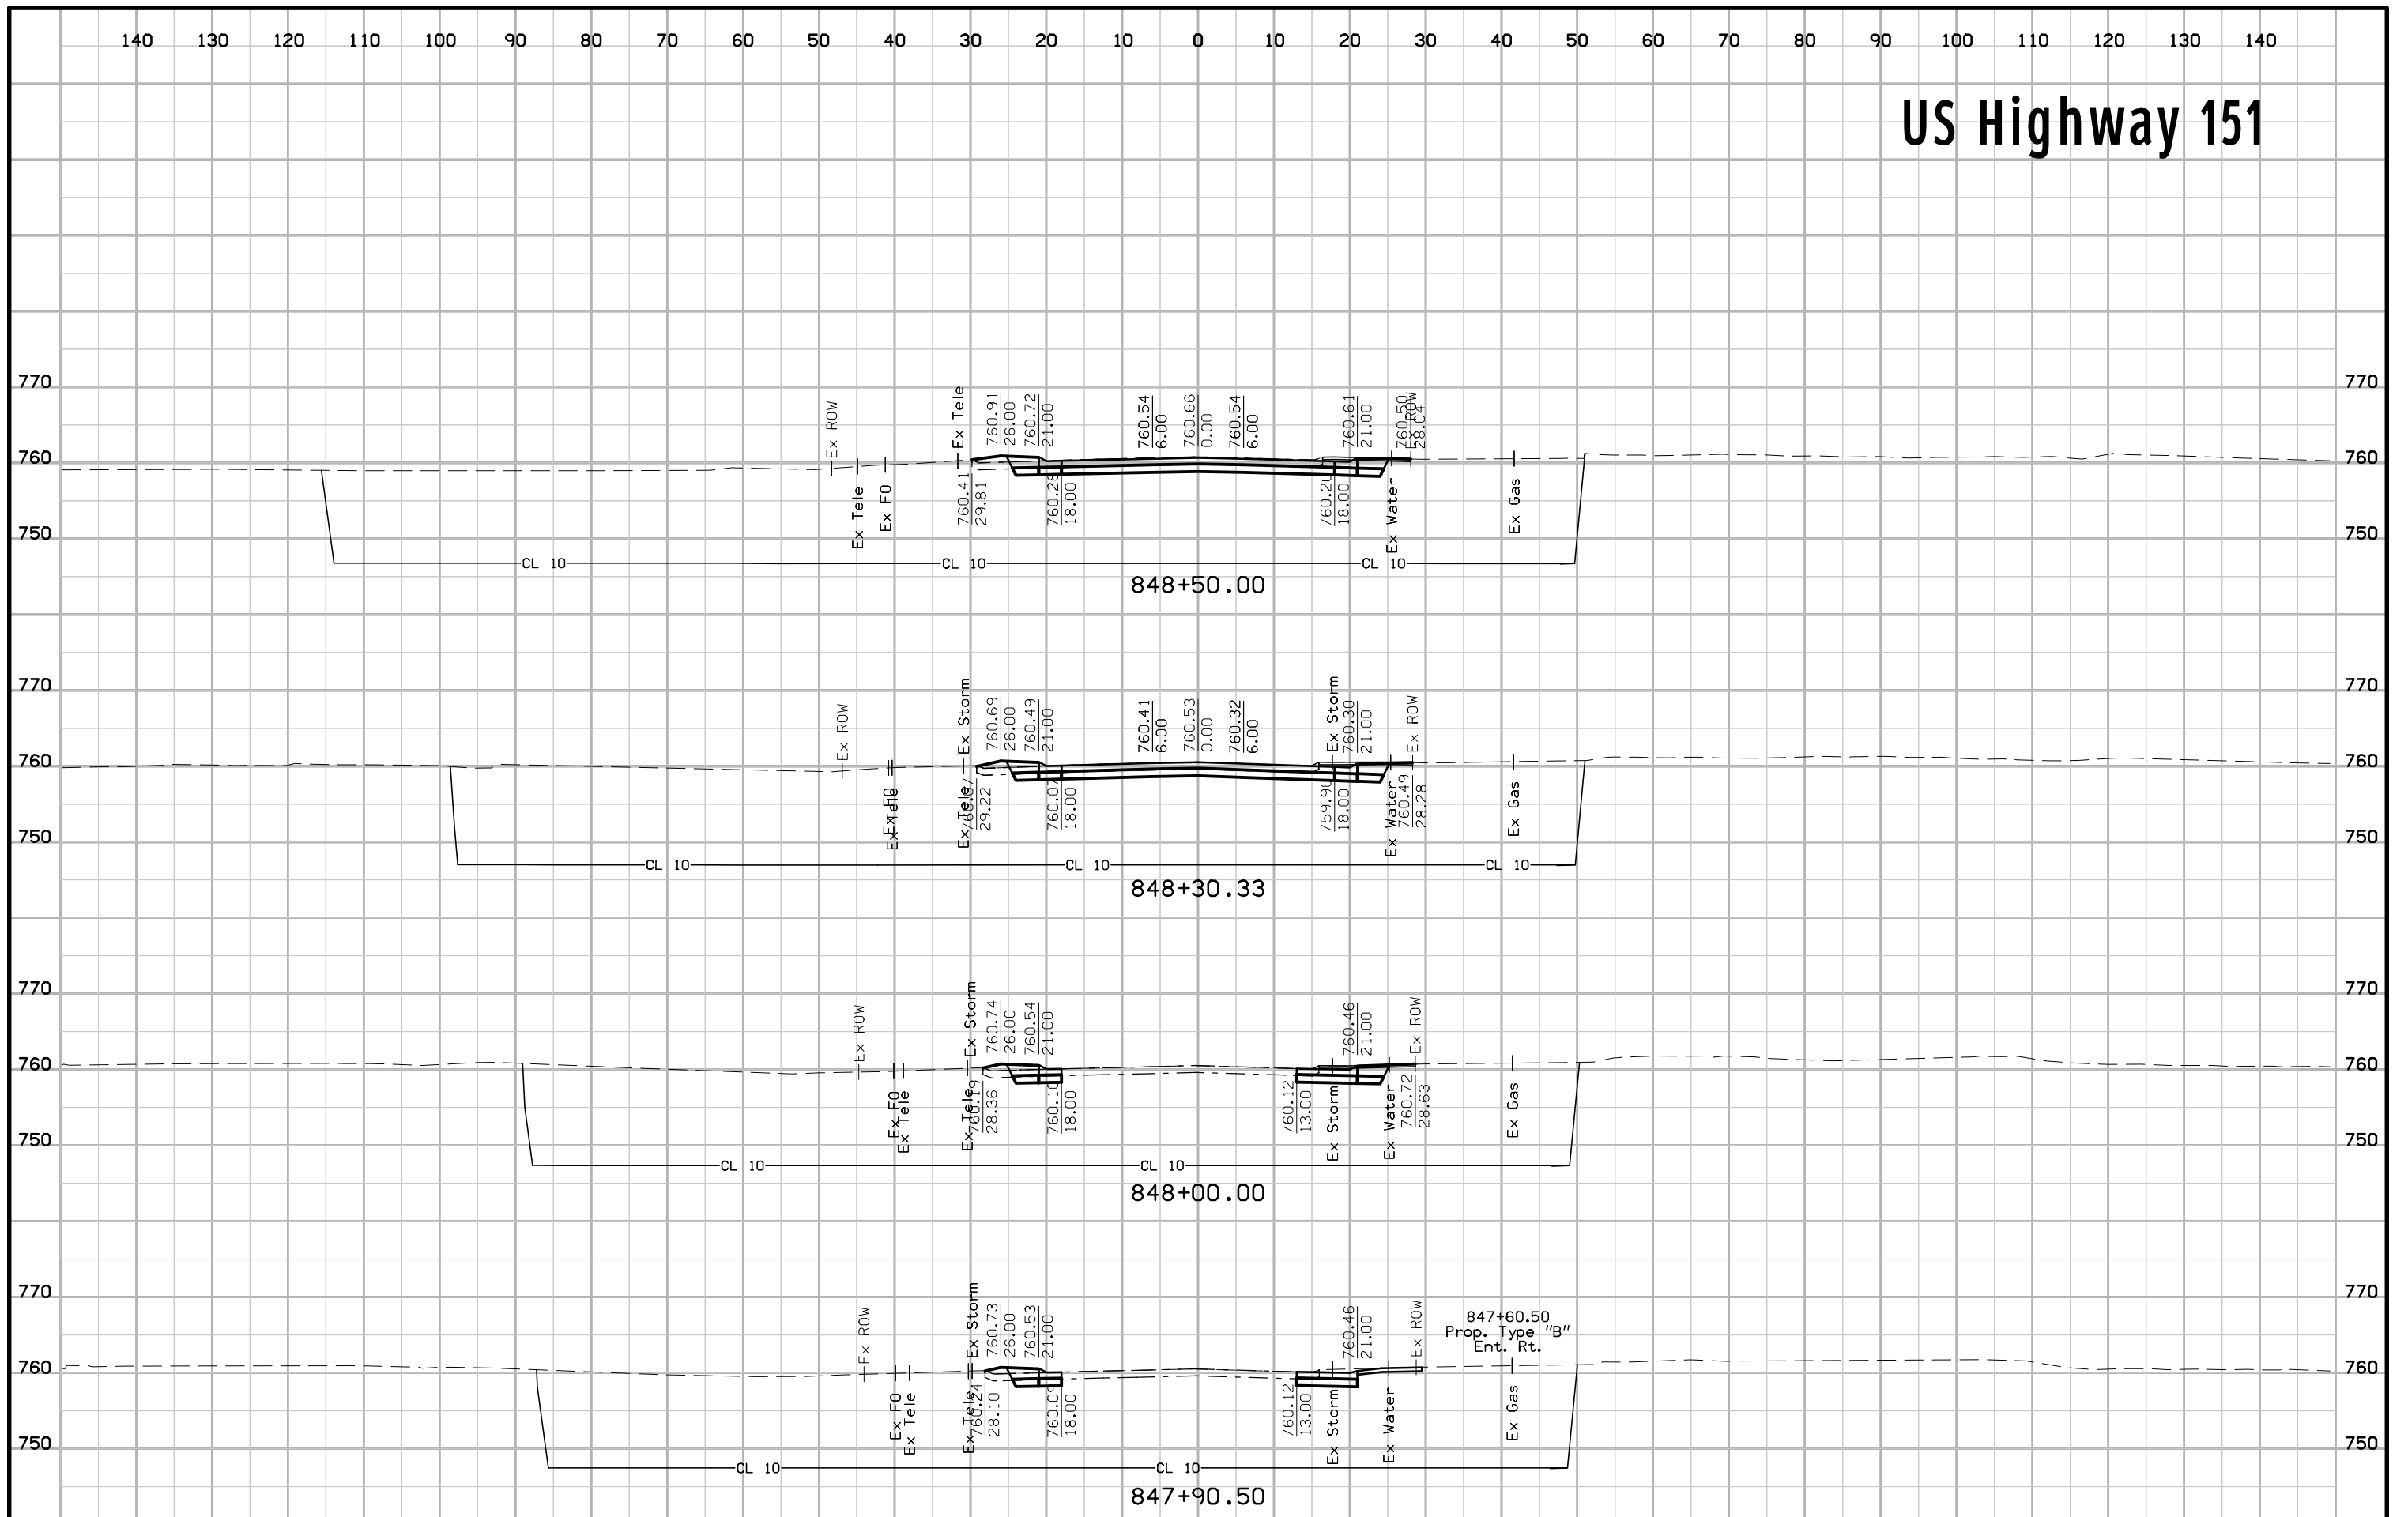


US Highway 151

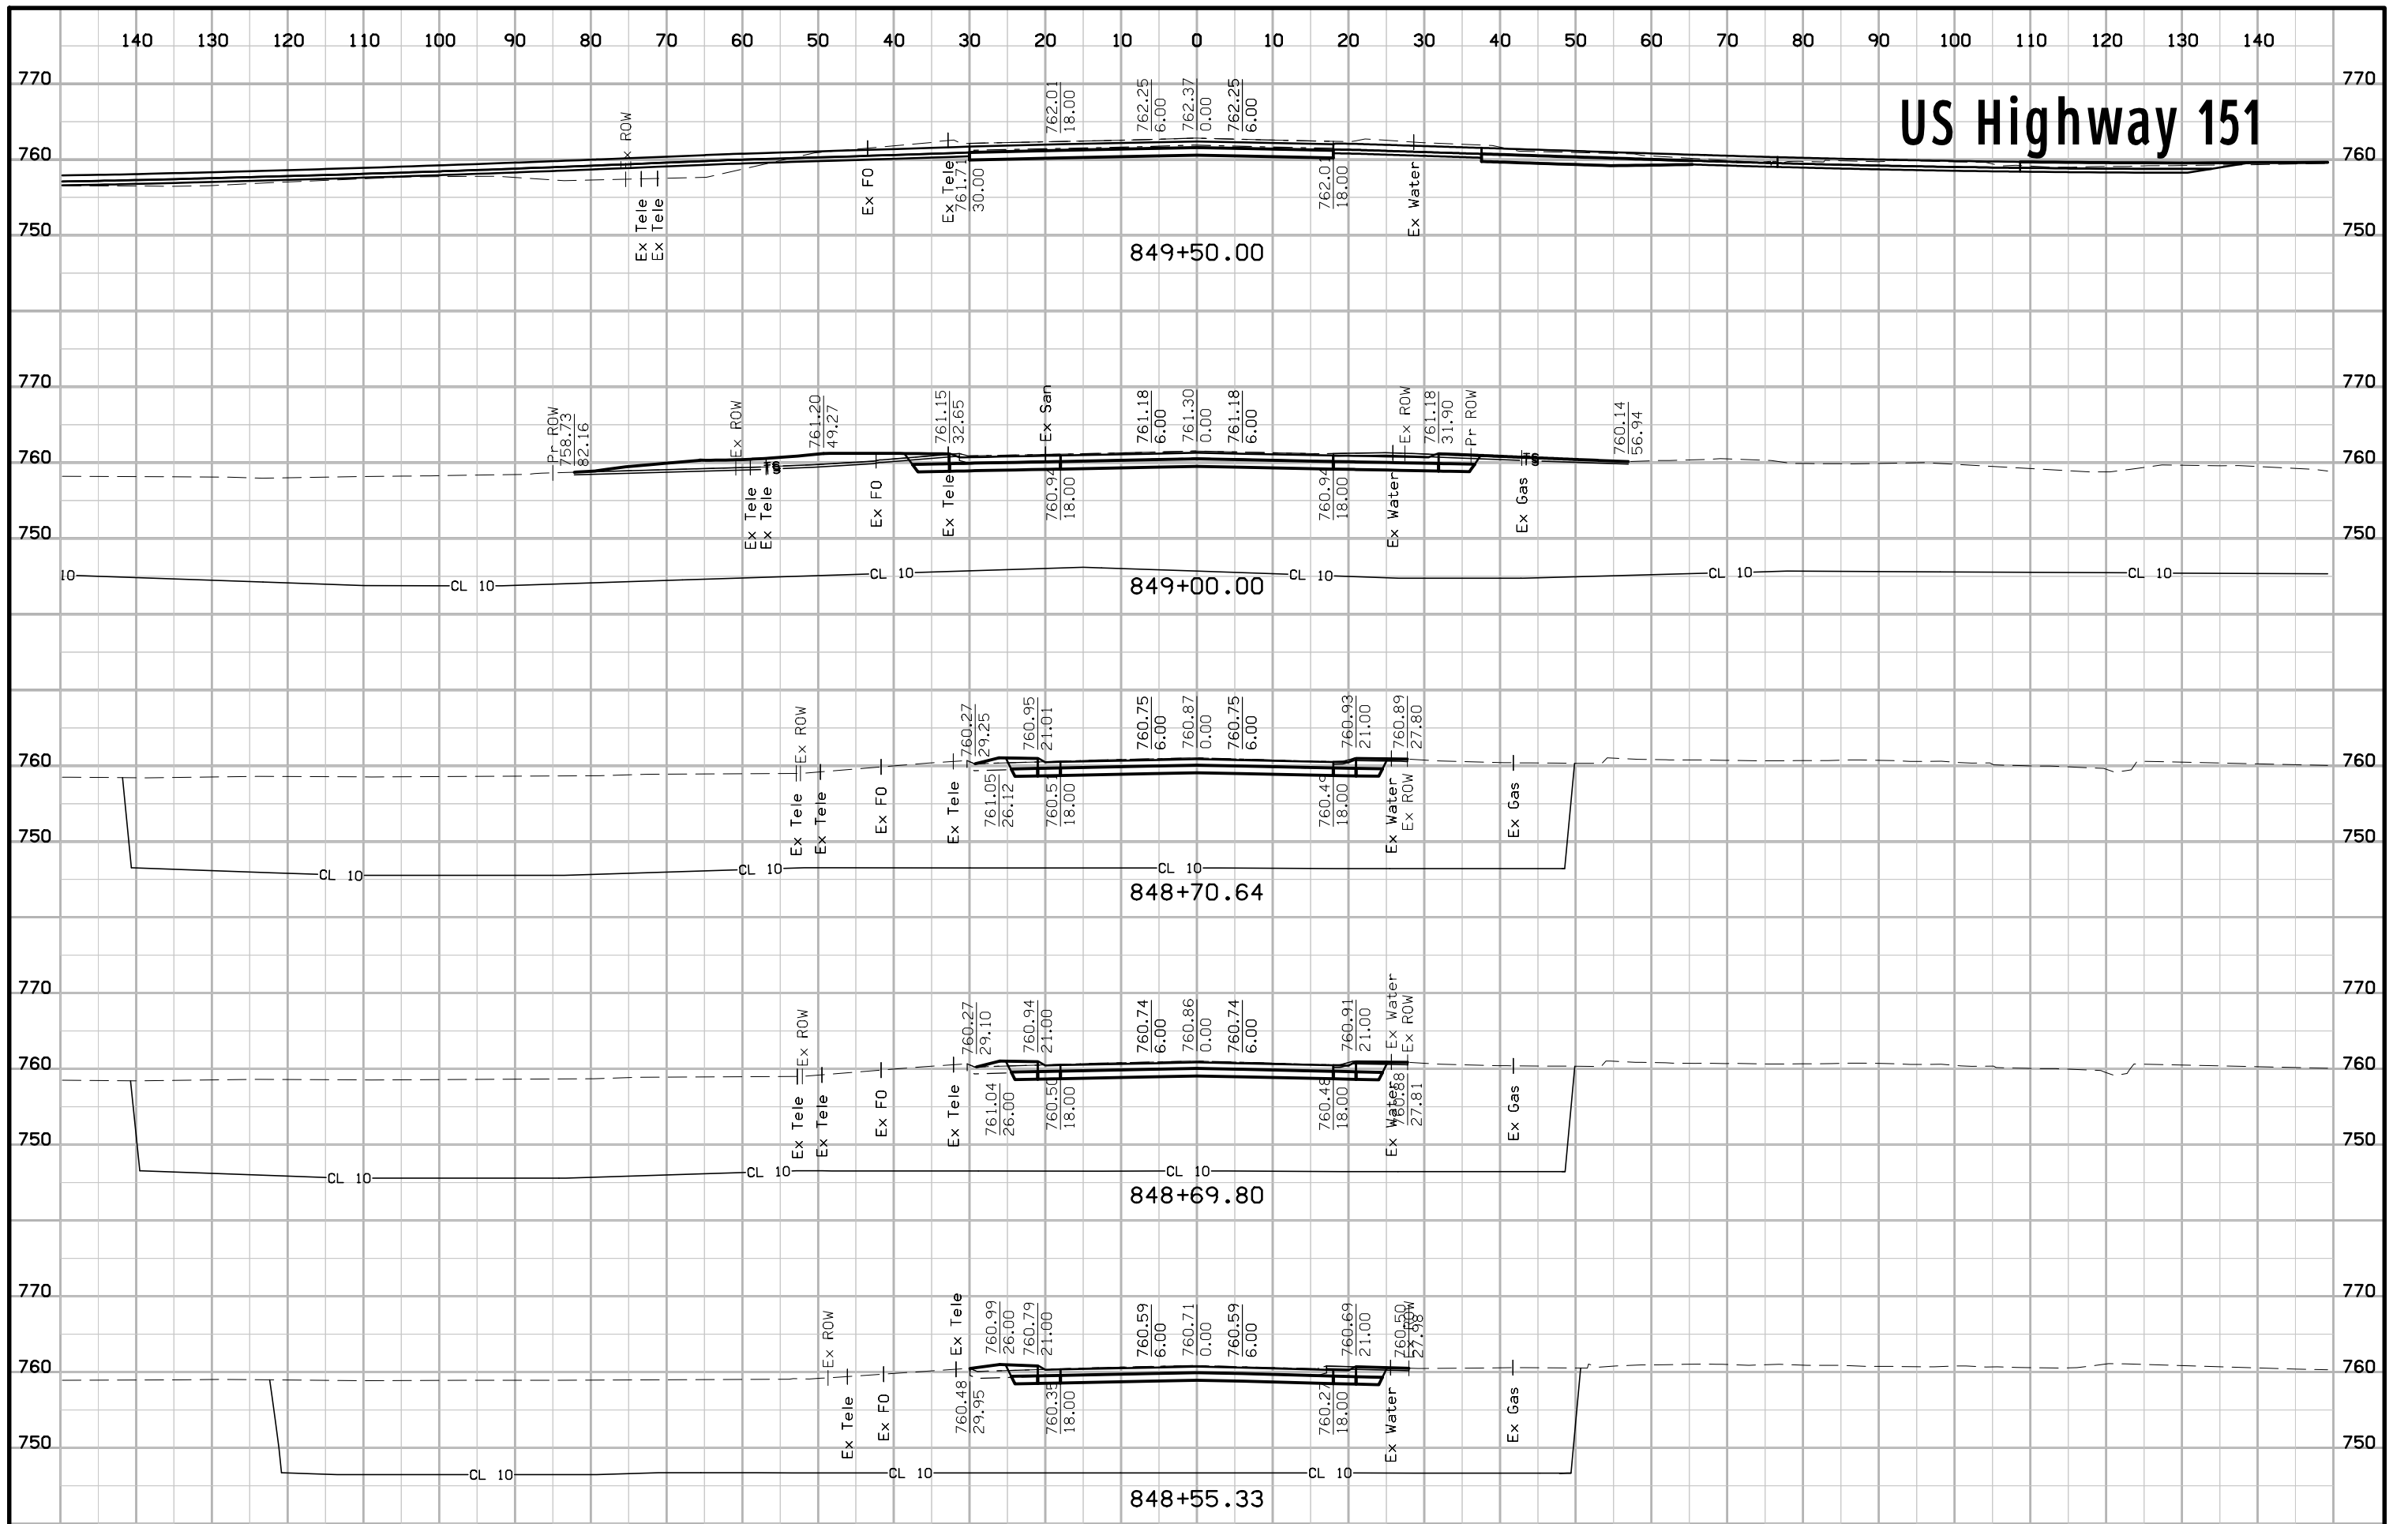


US Highway 151

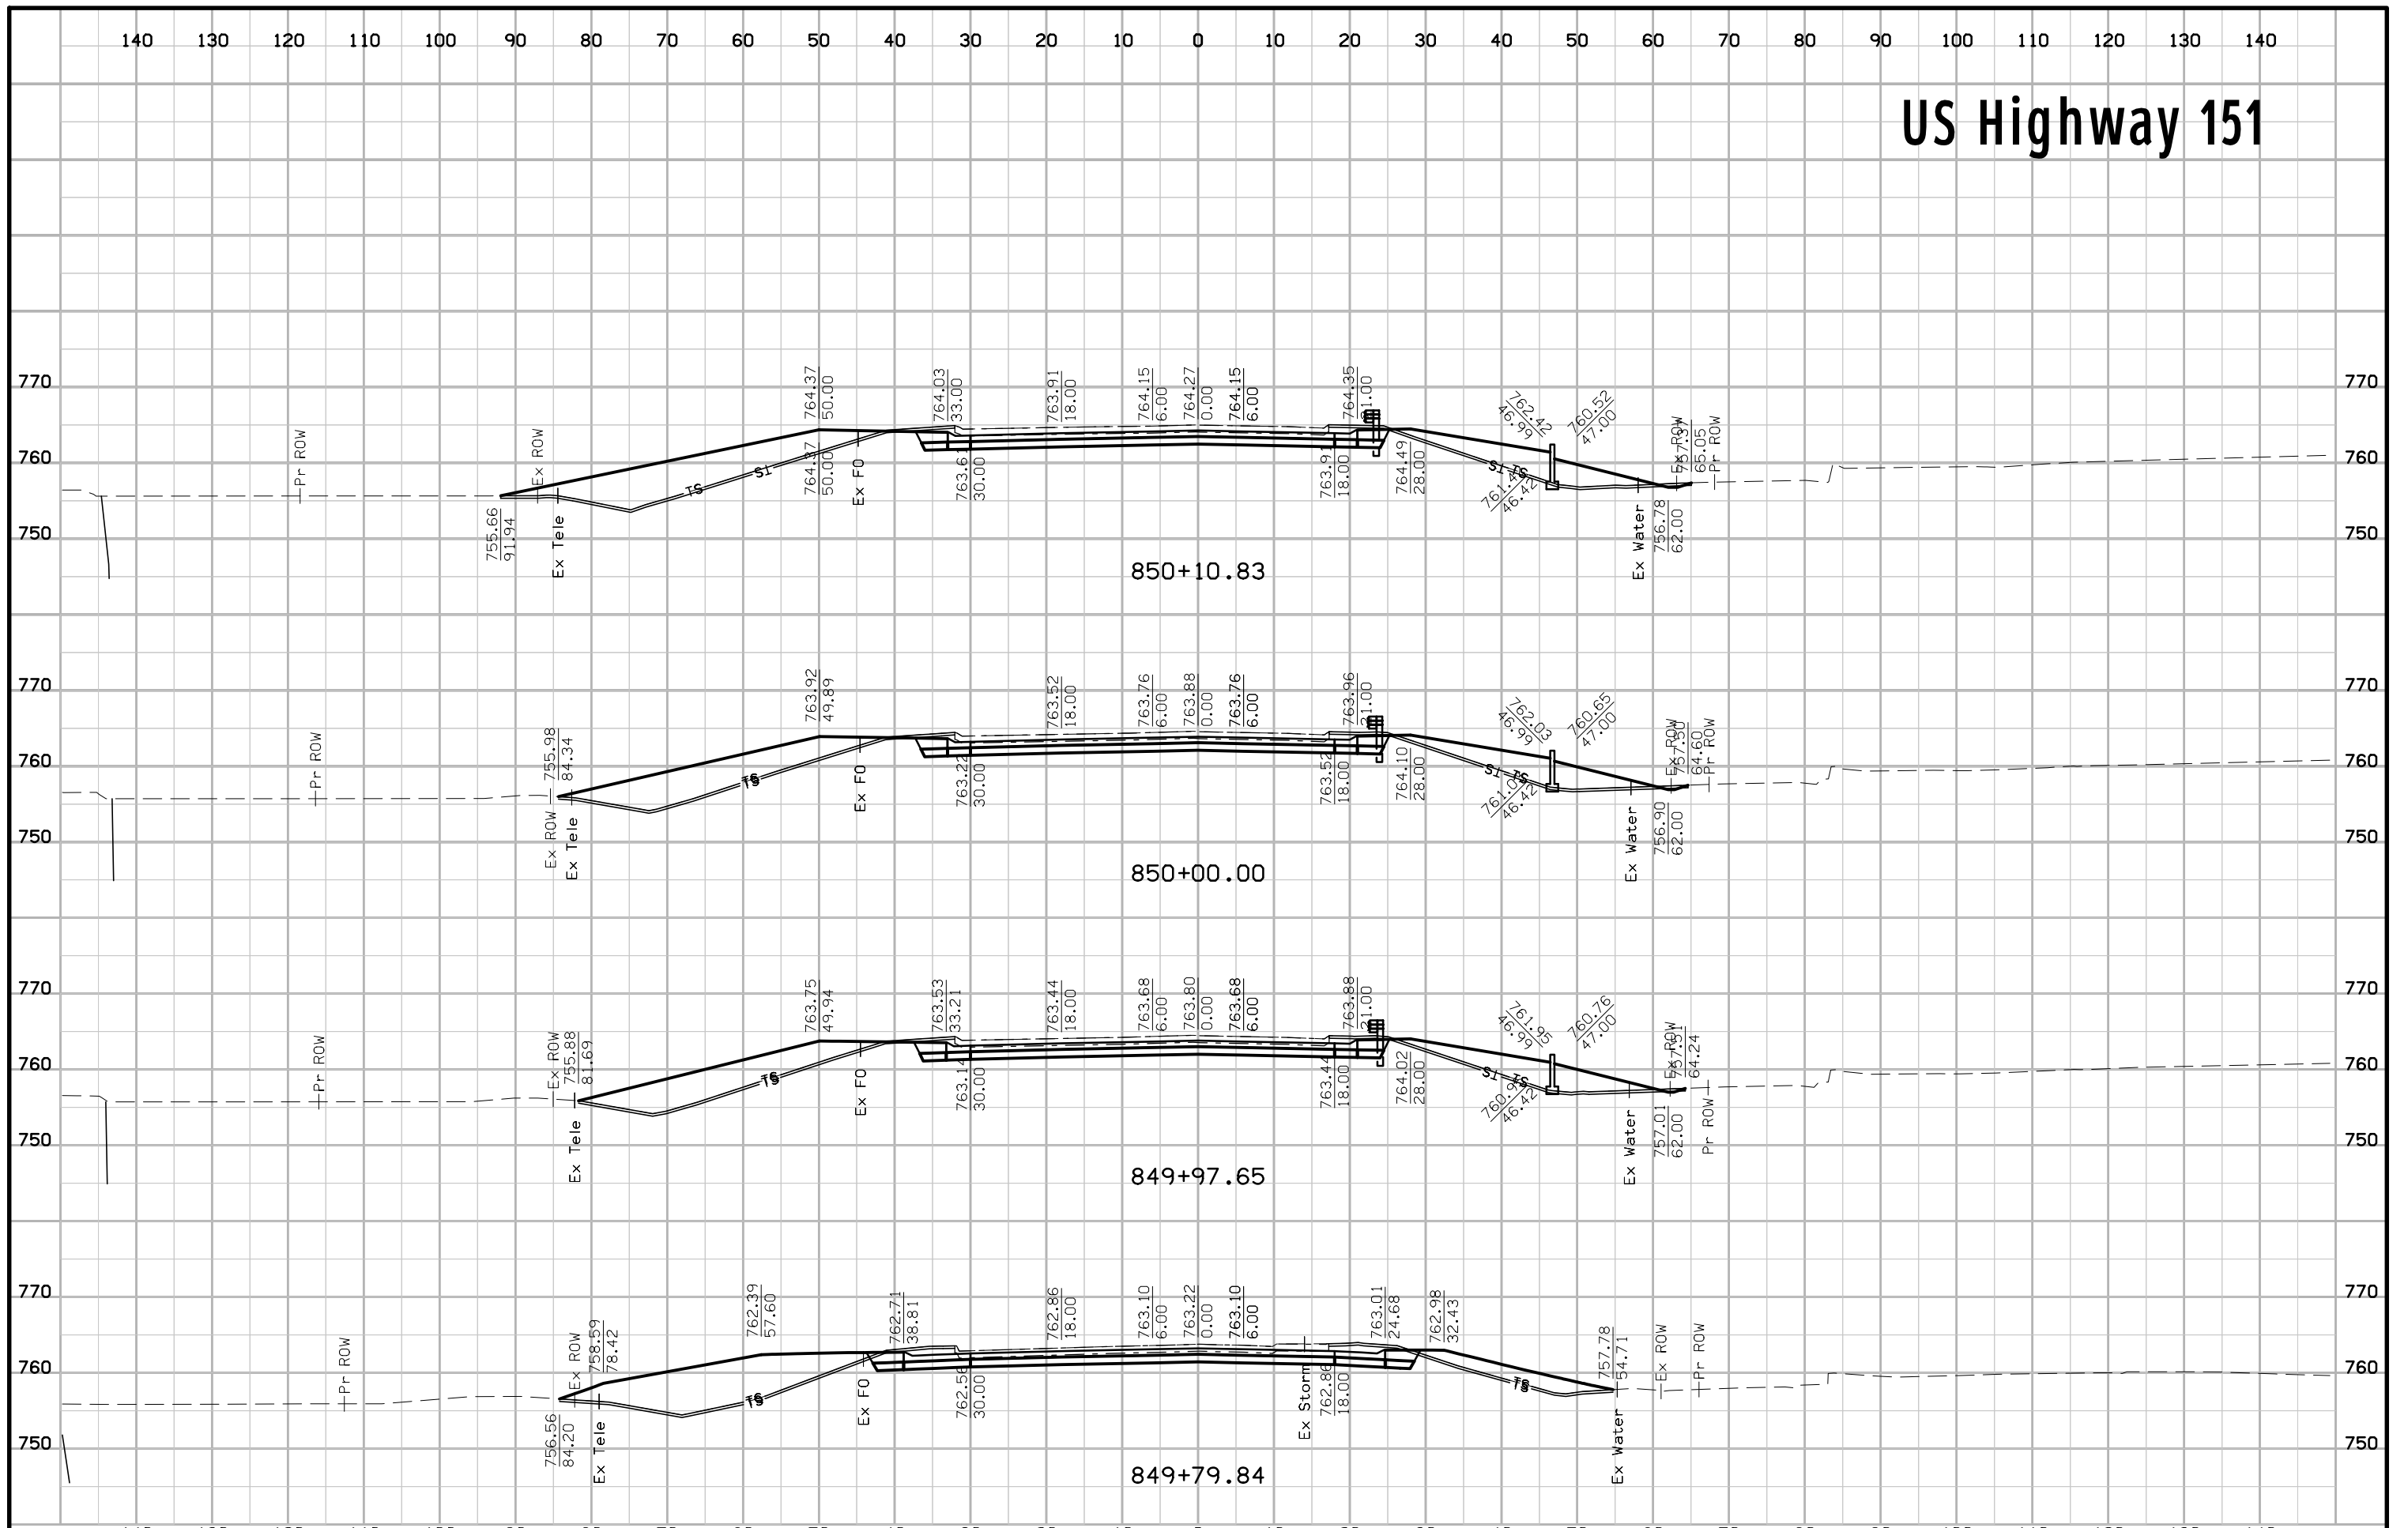


US Highway 151

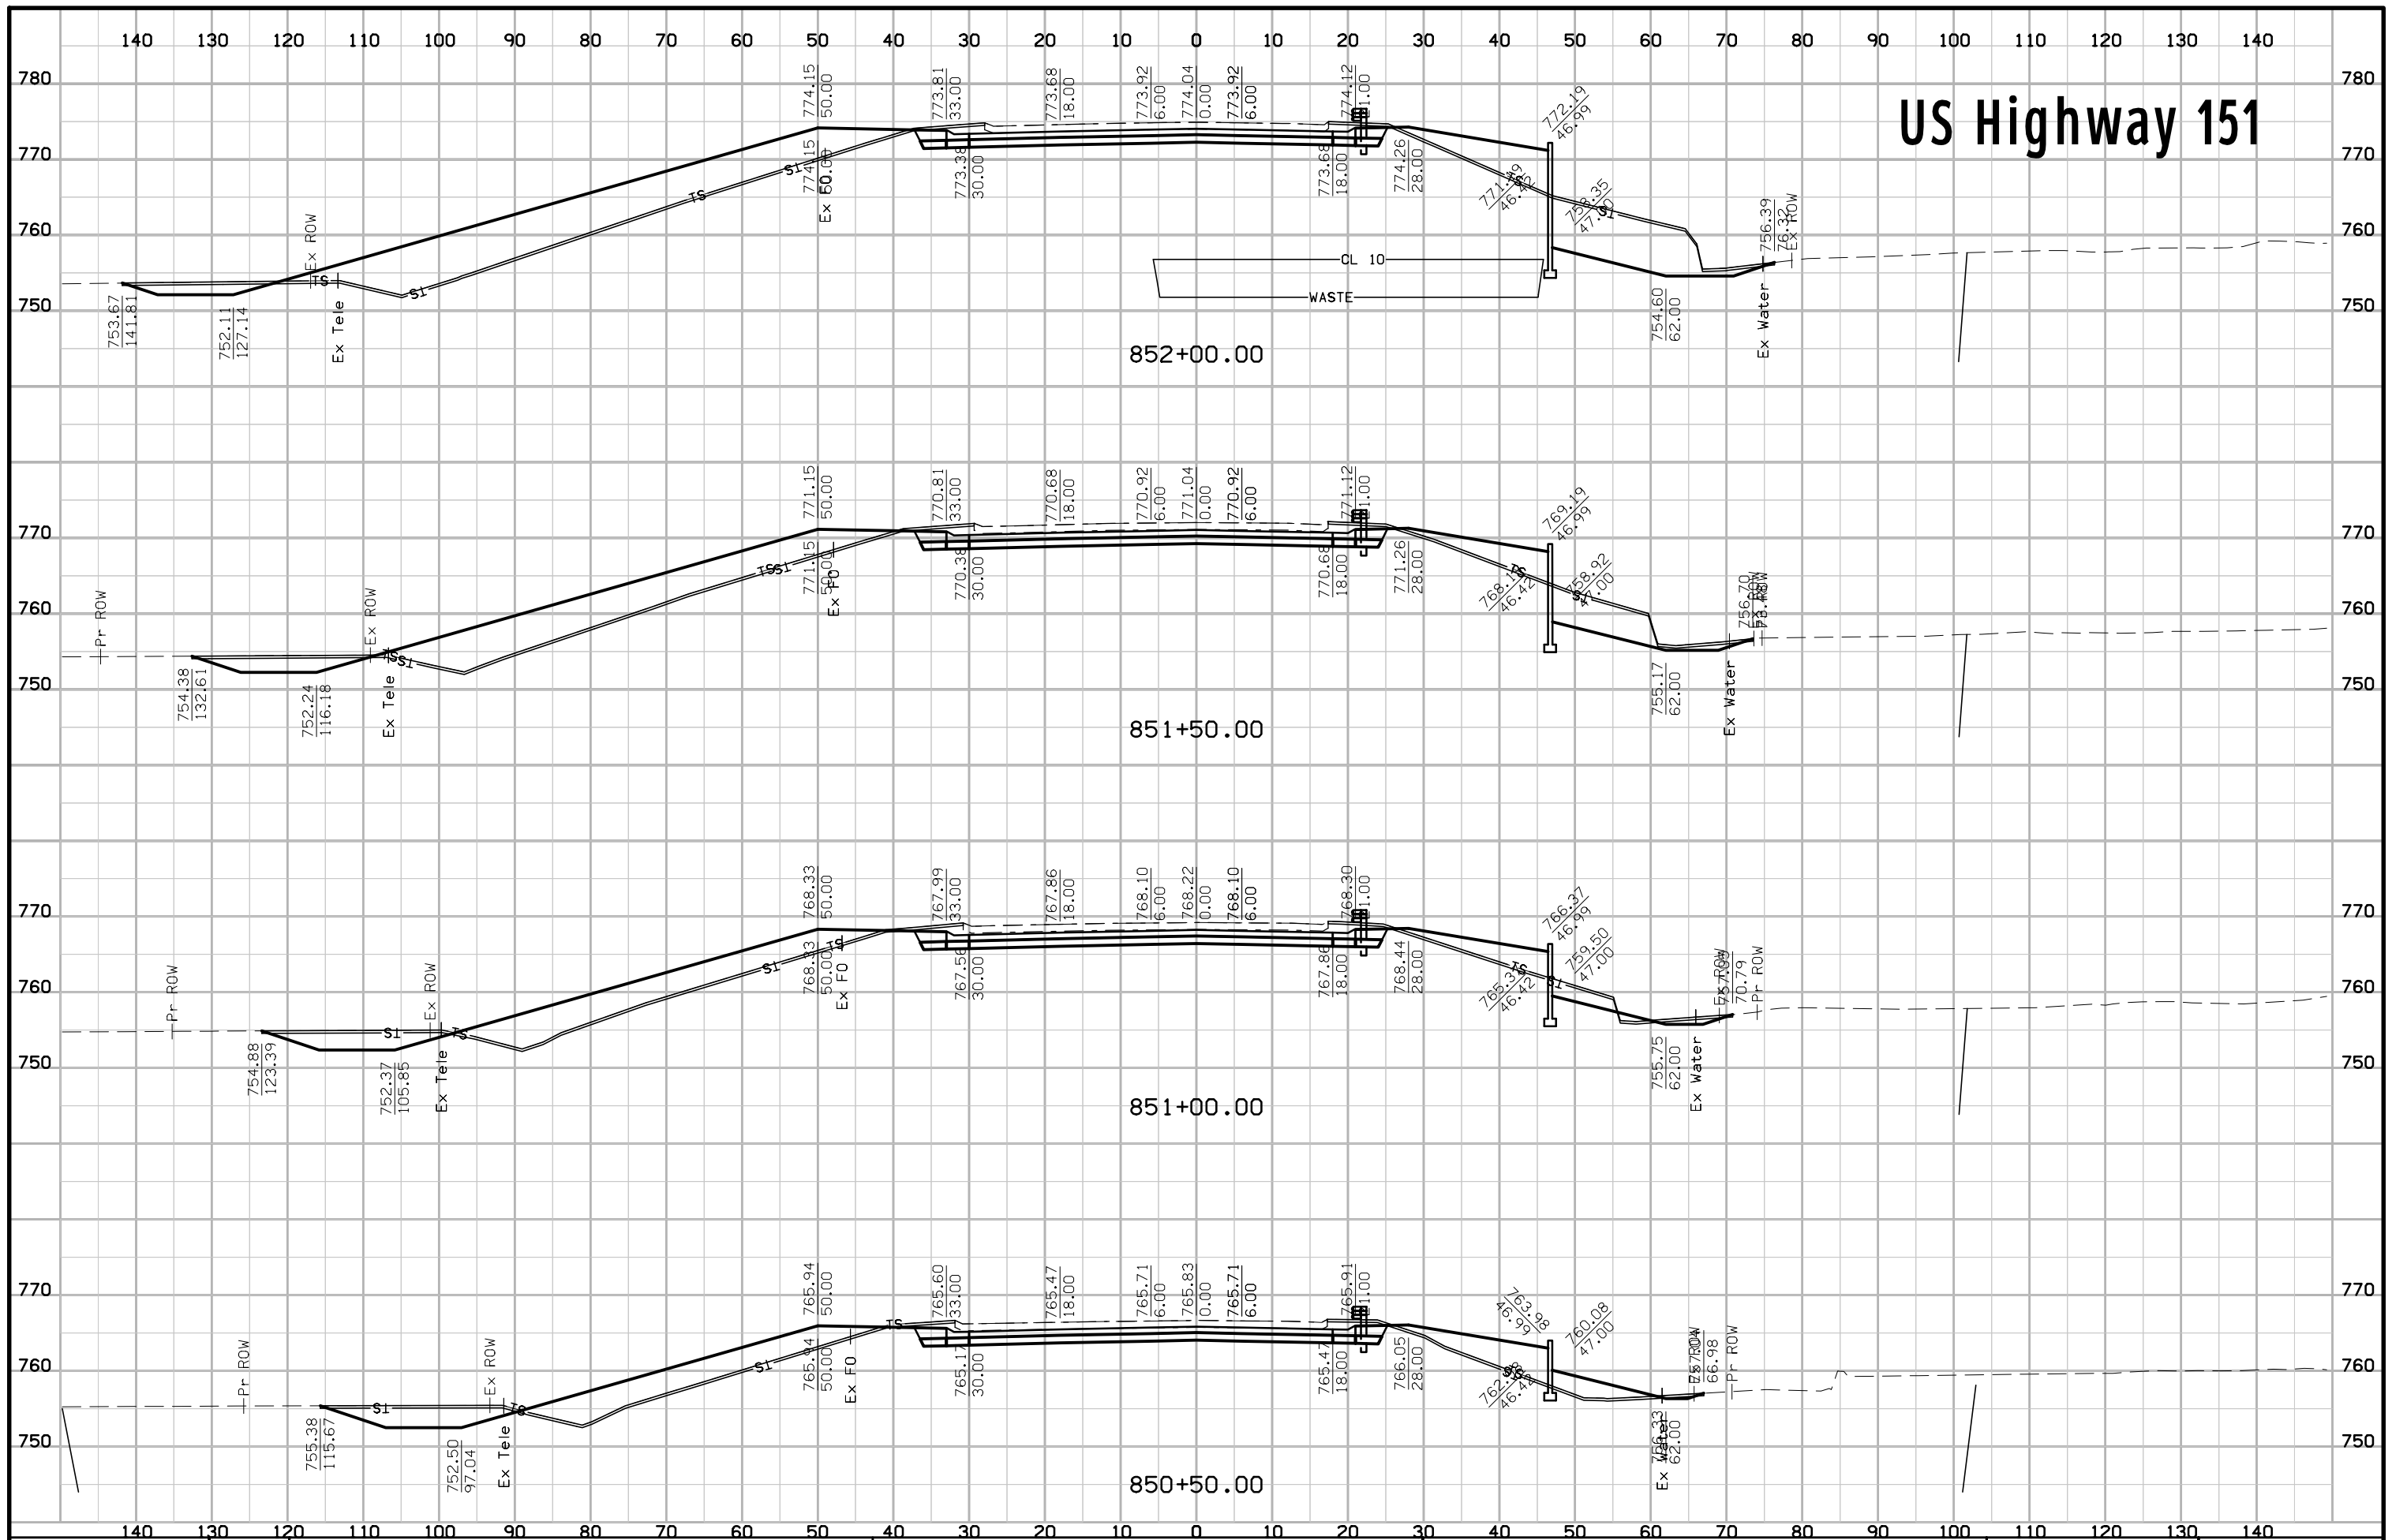


US Highway 151

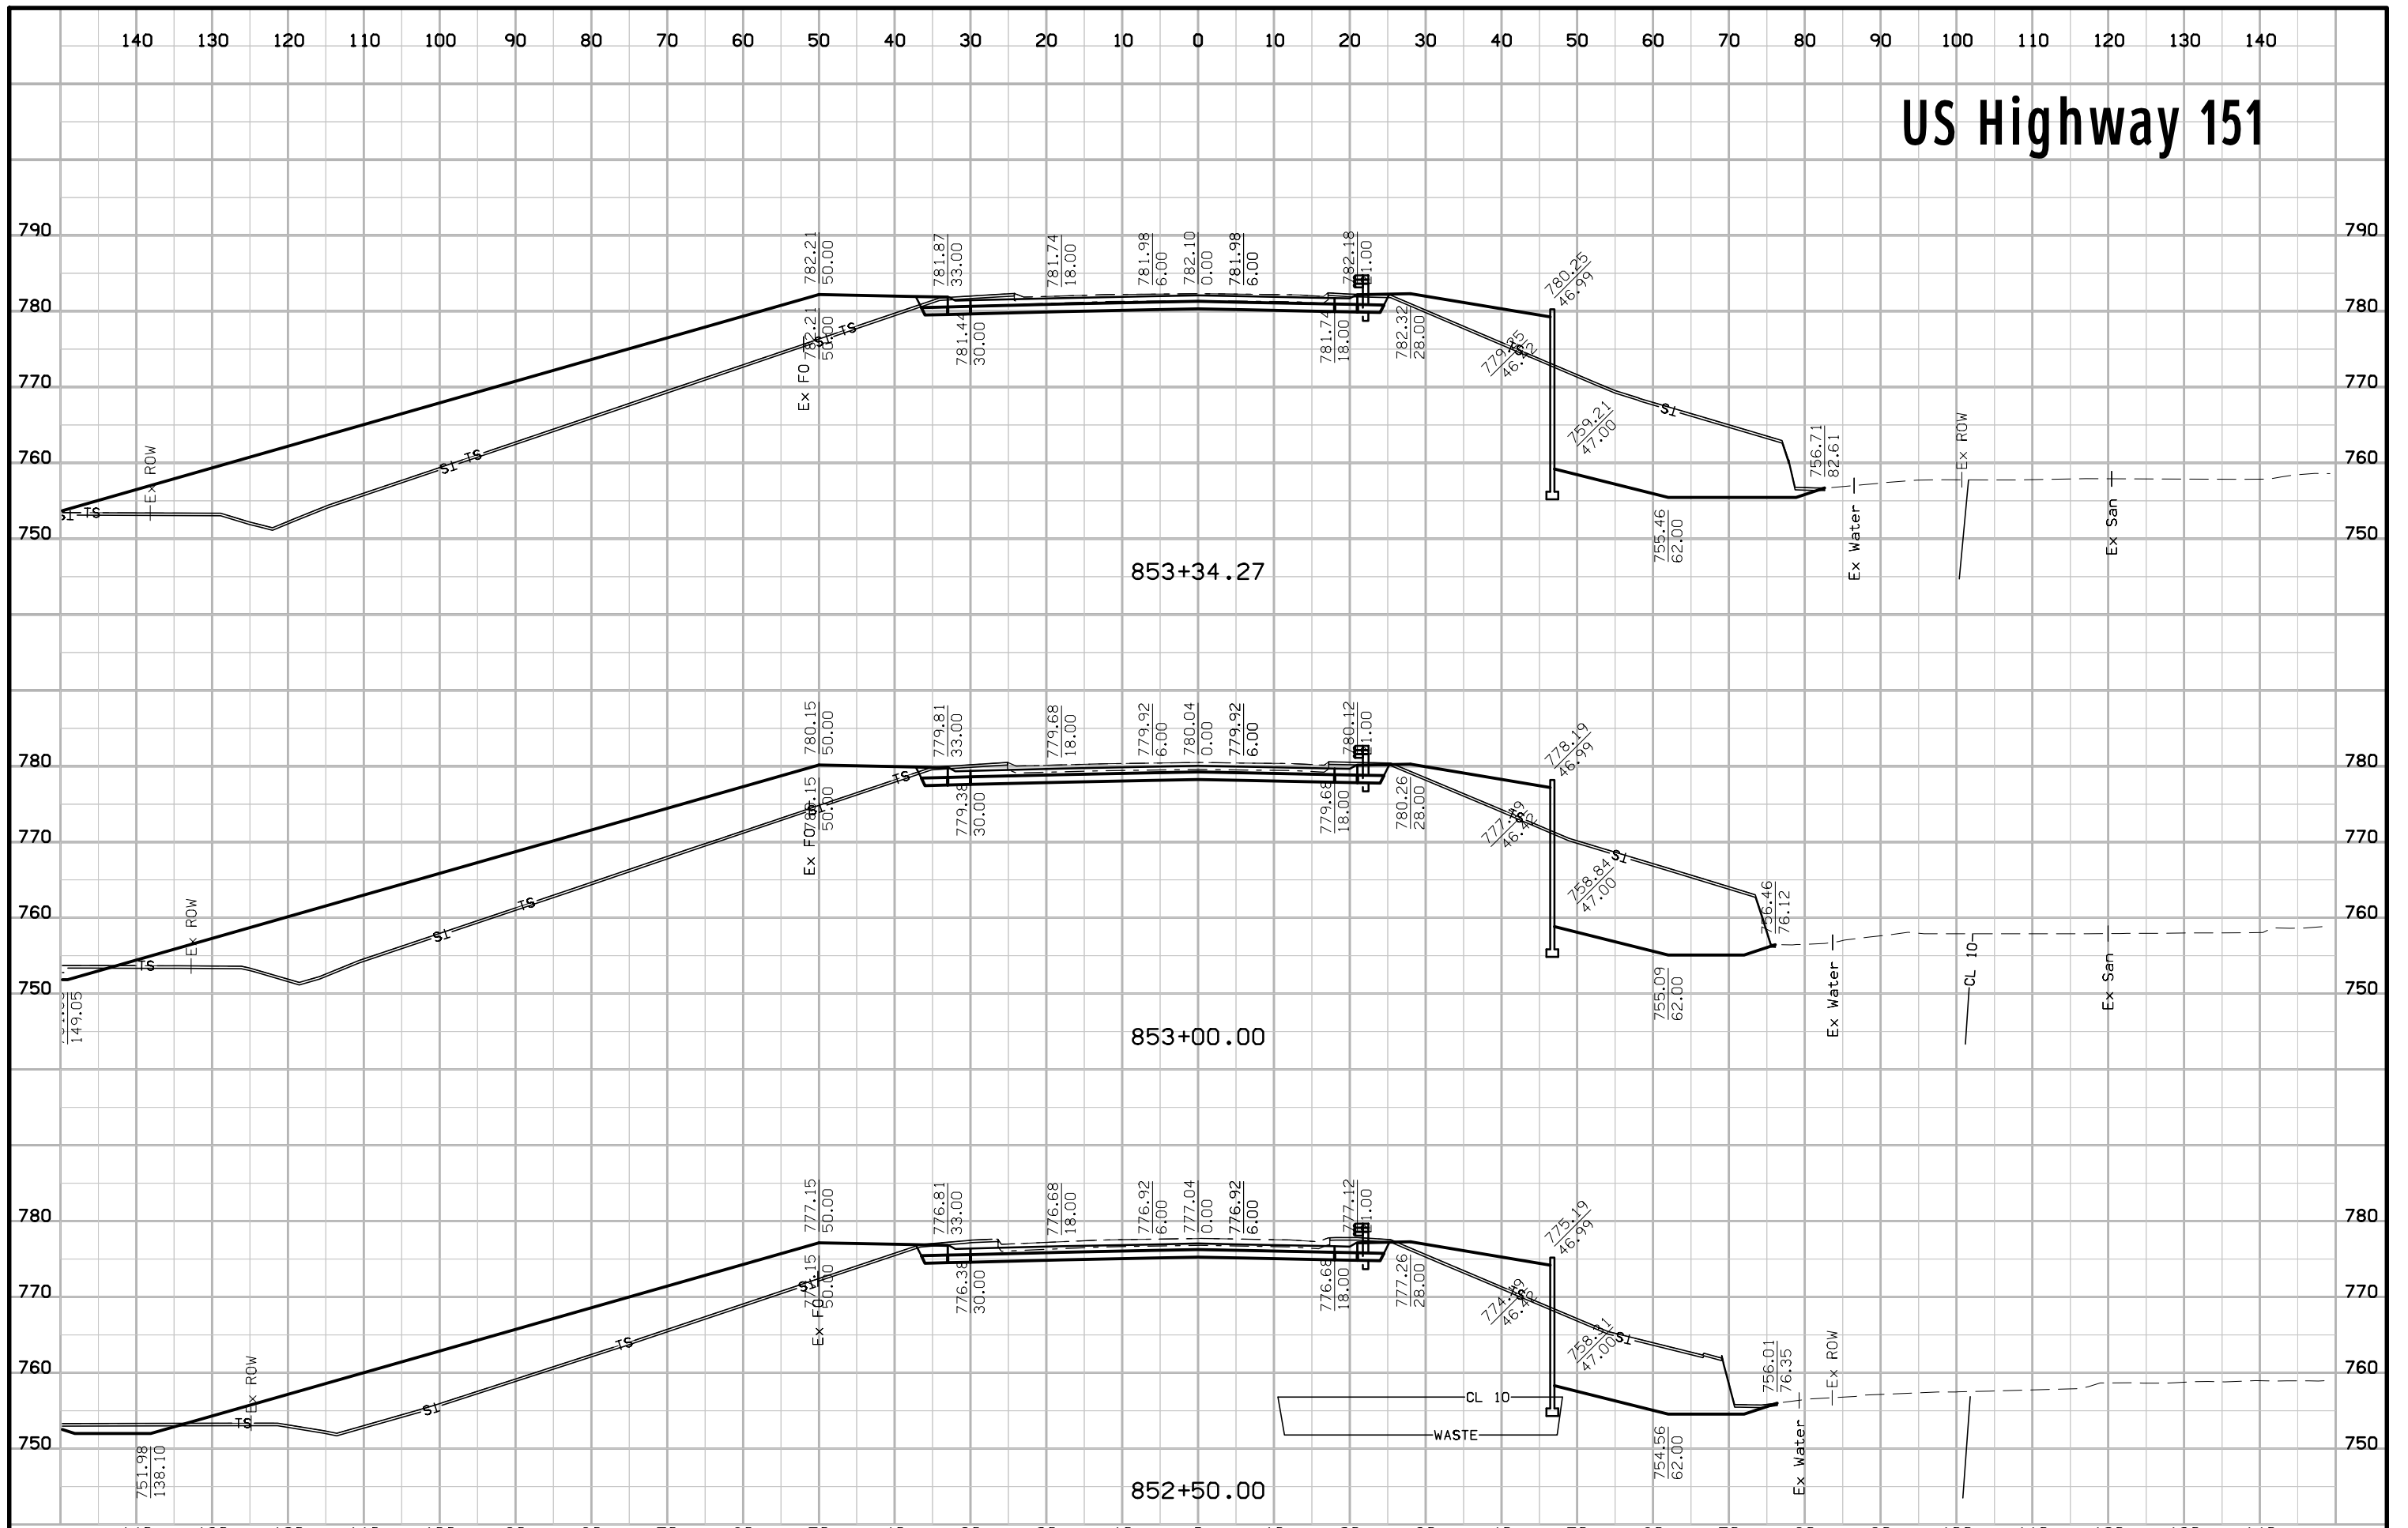


US Highway 151

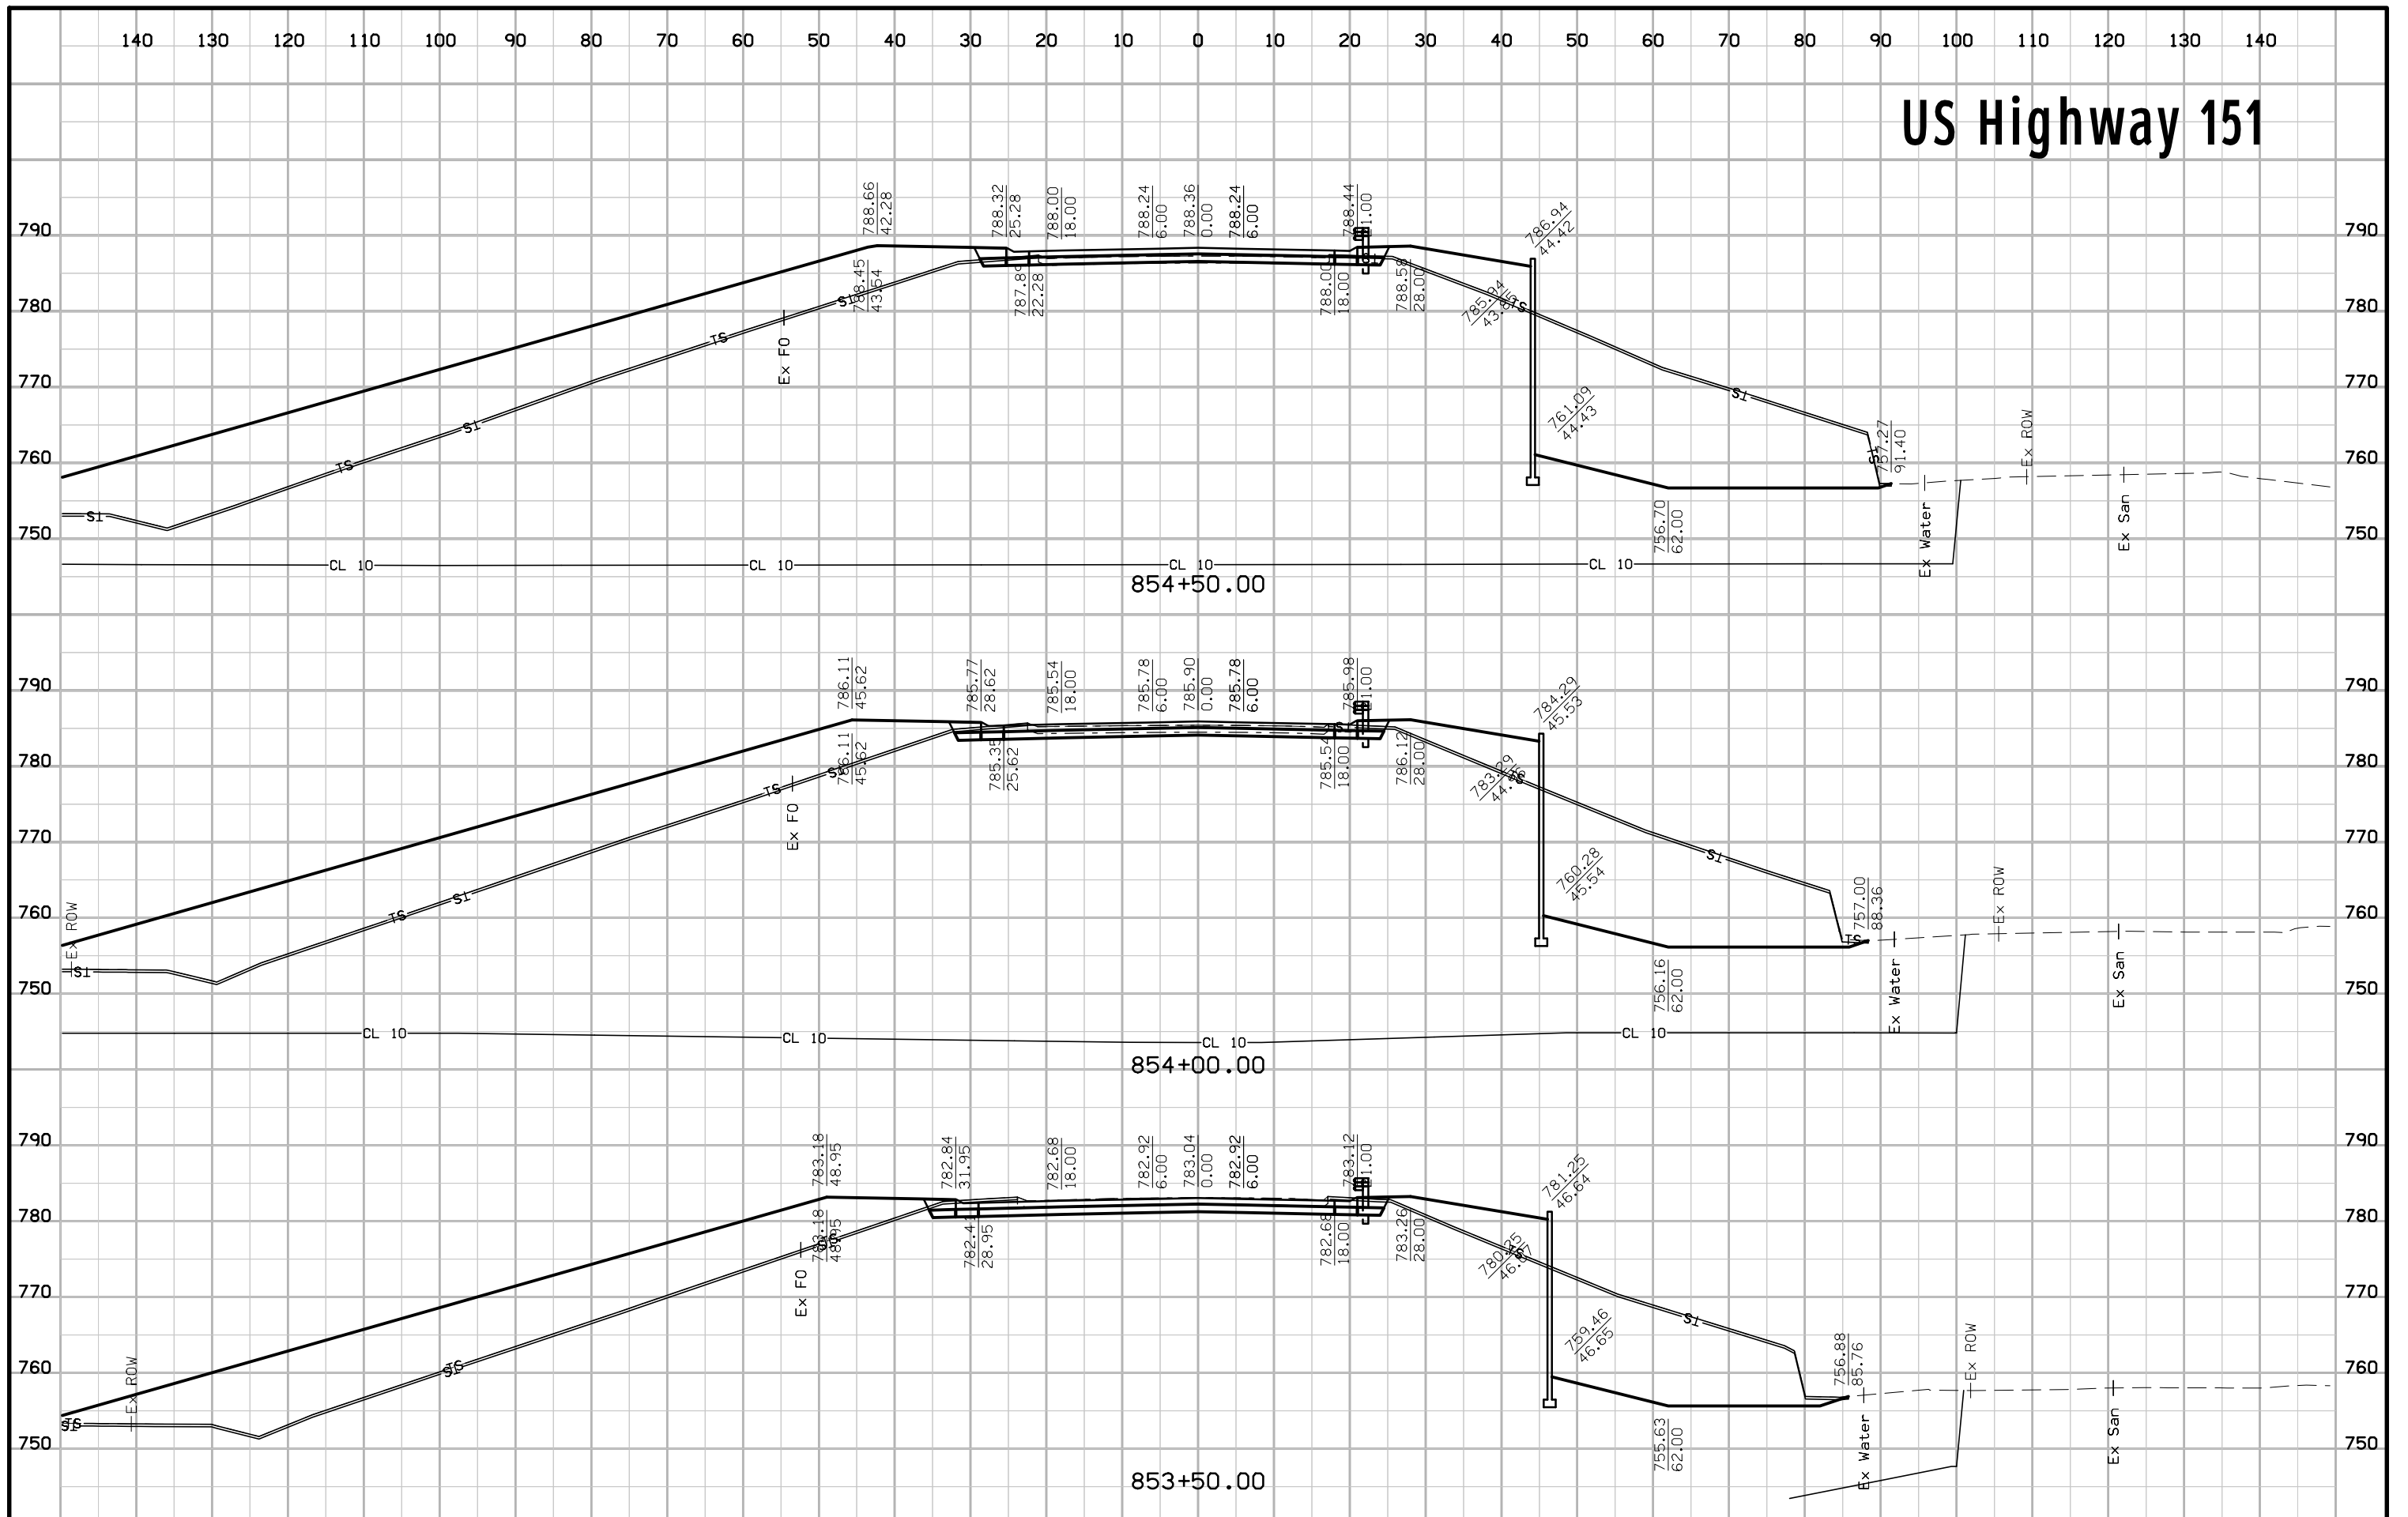


US Highway 151

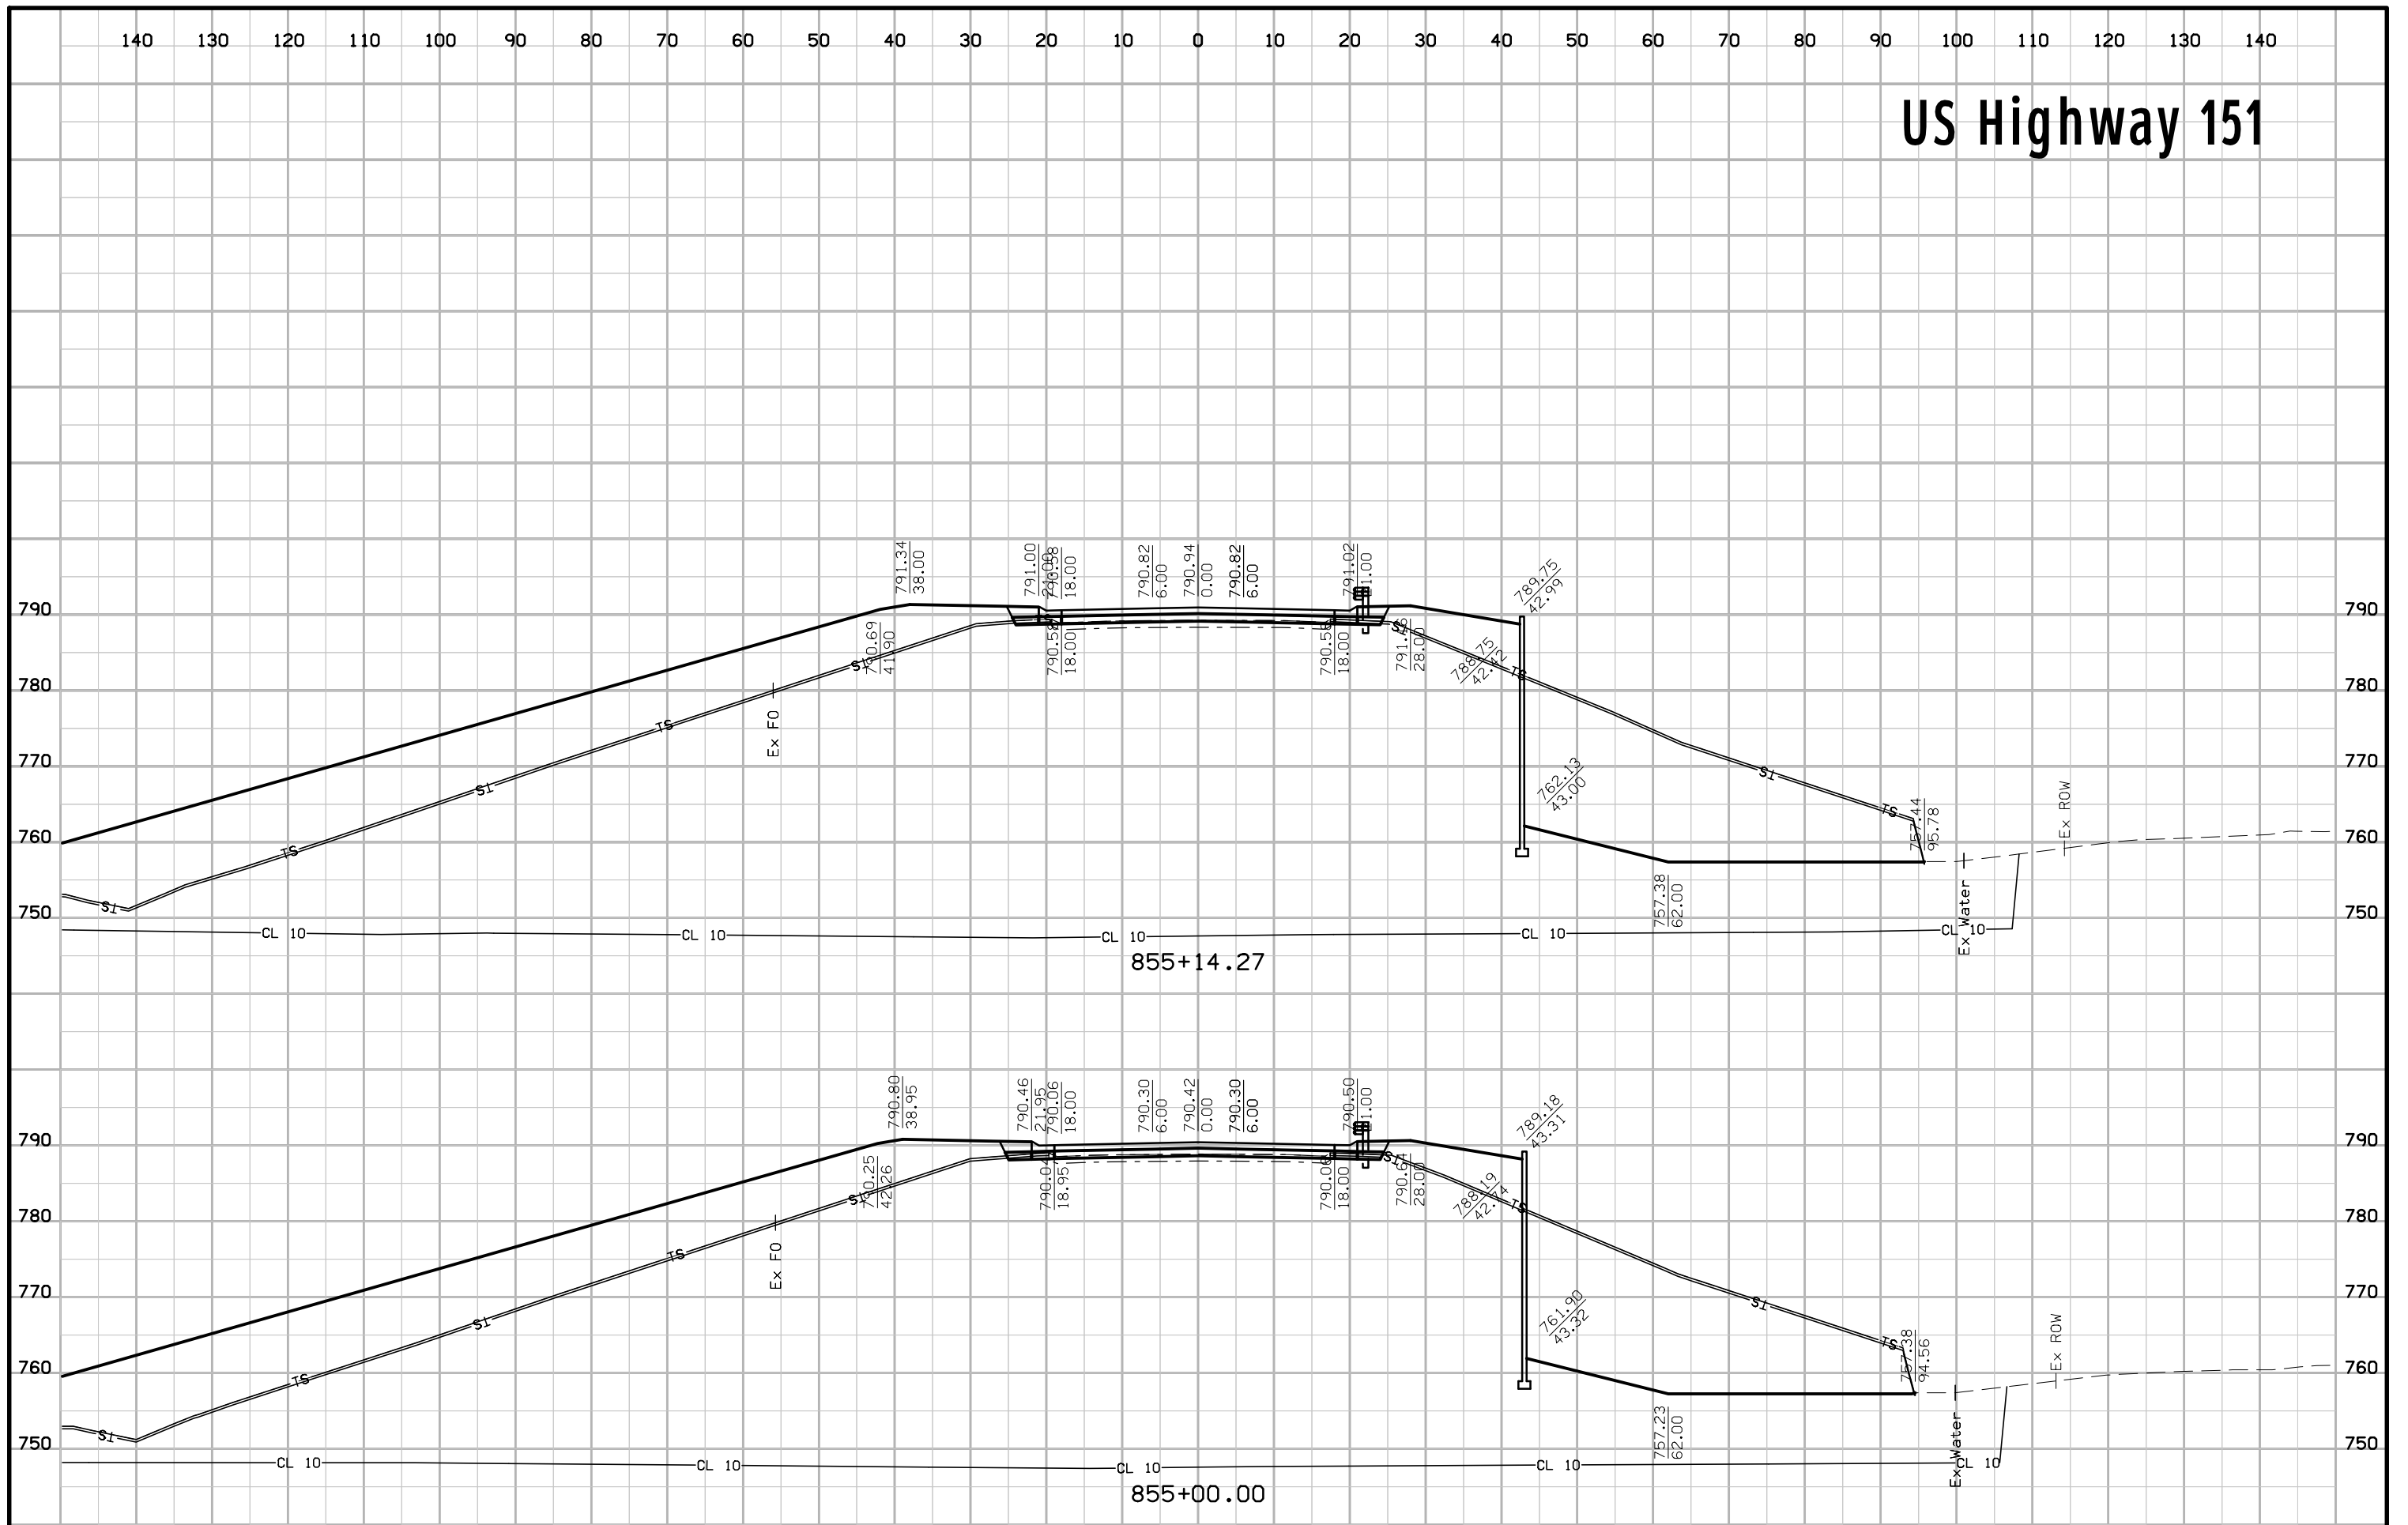


US Highway 151

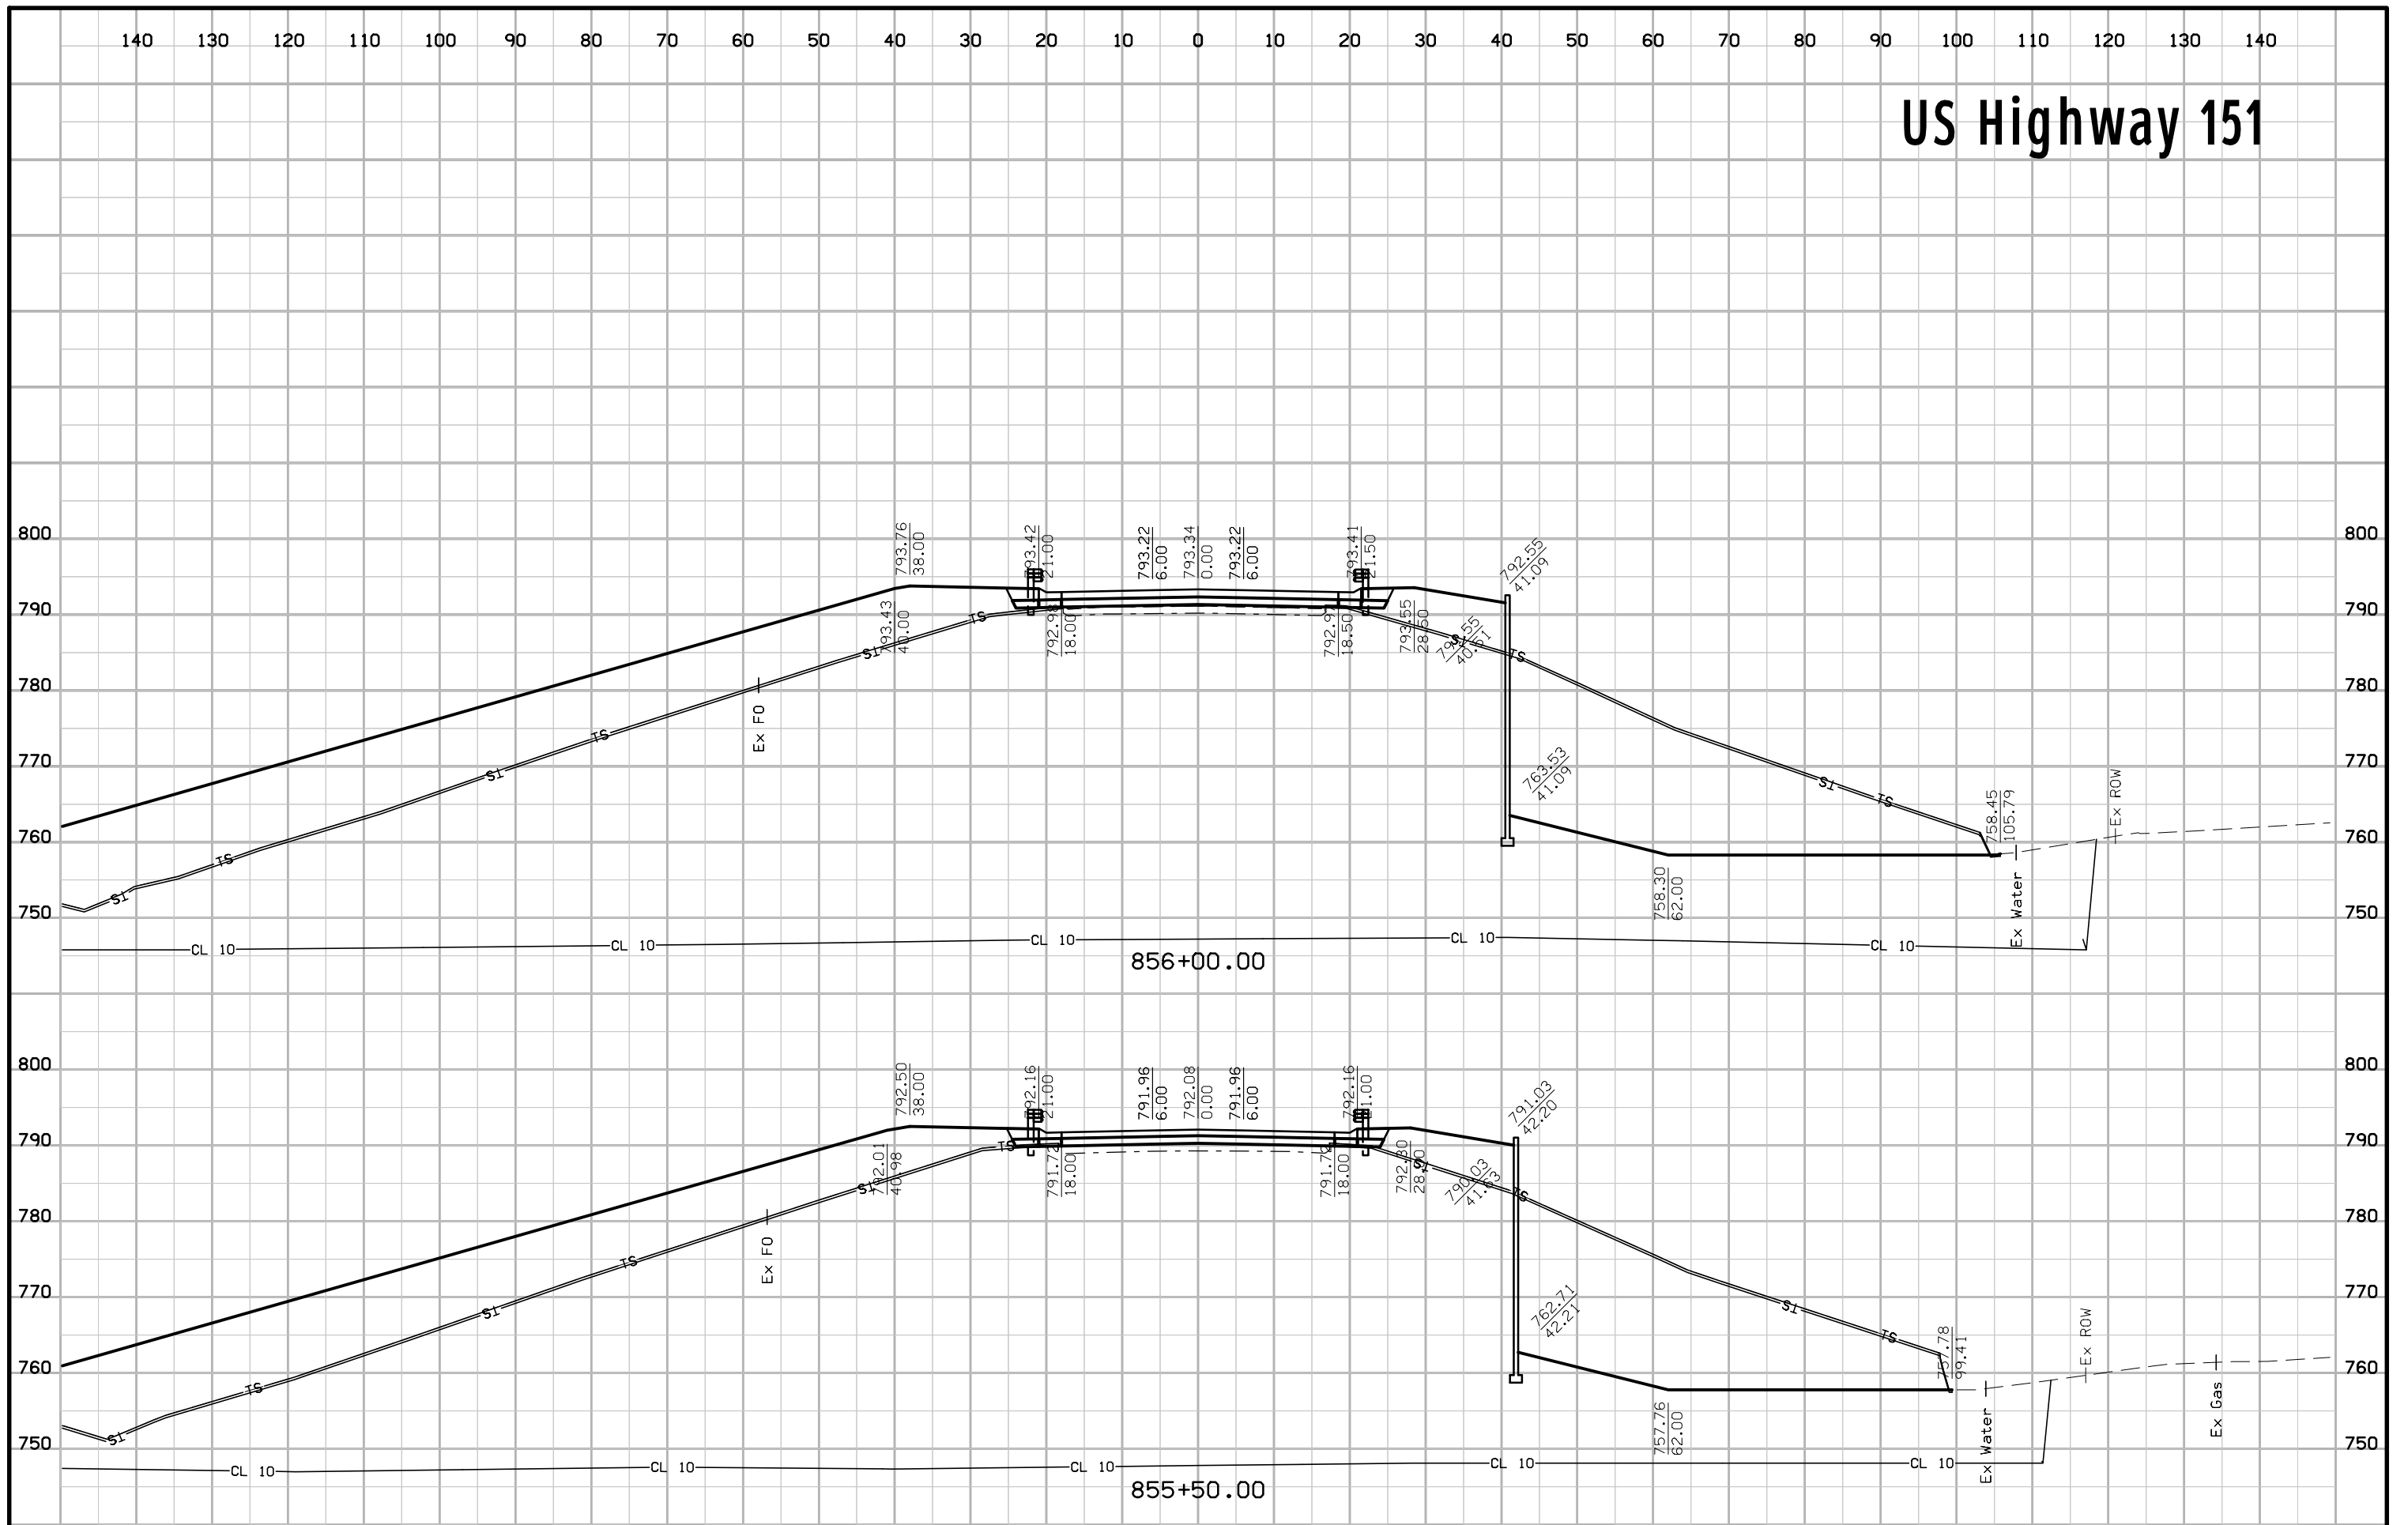


US Highway 151

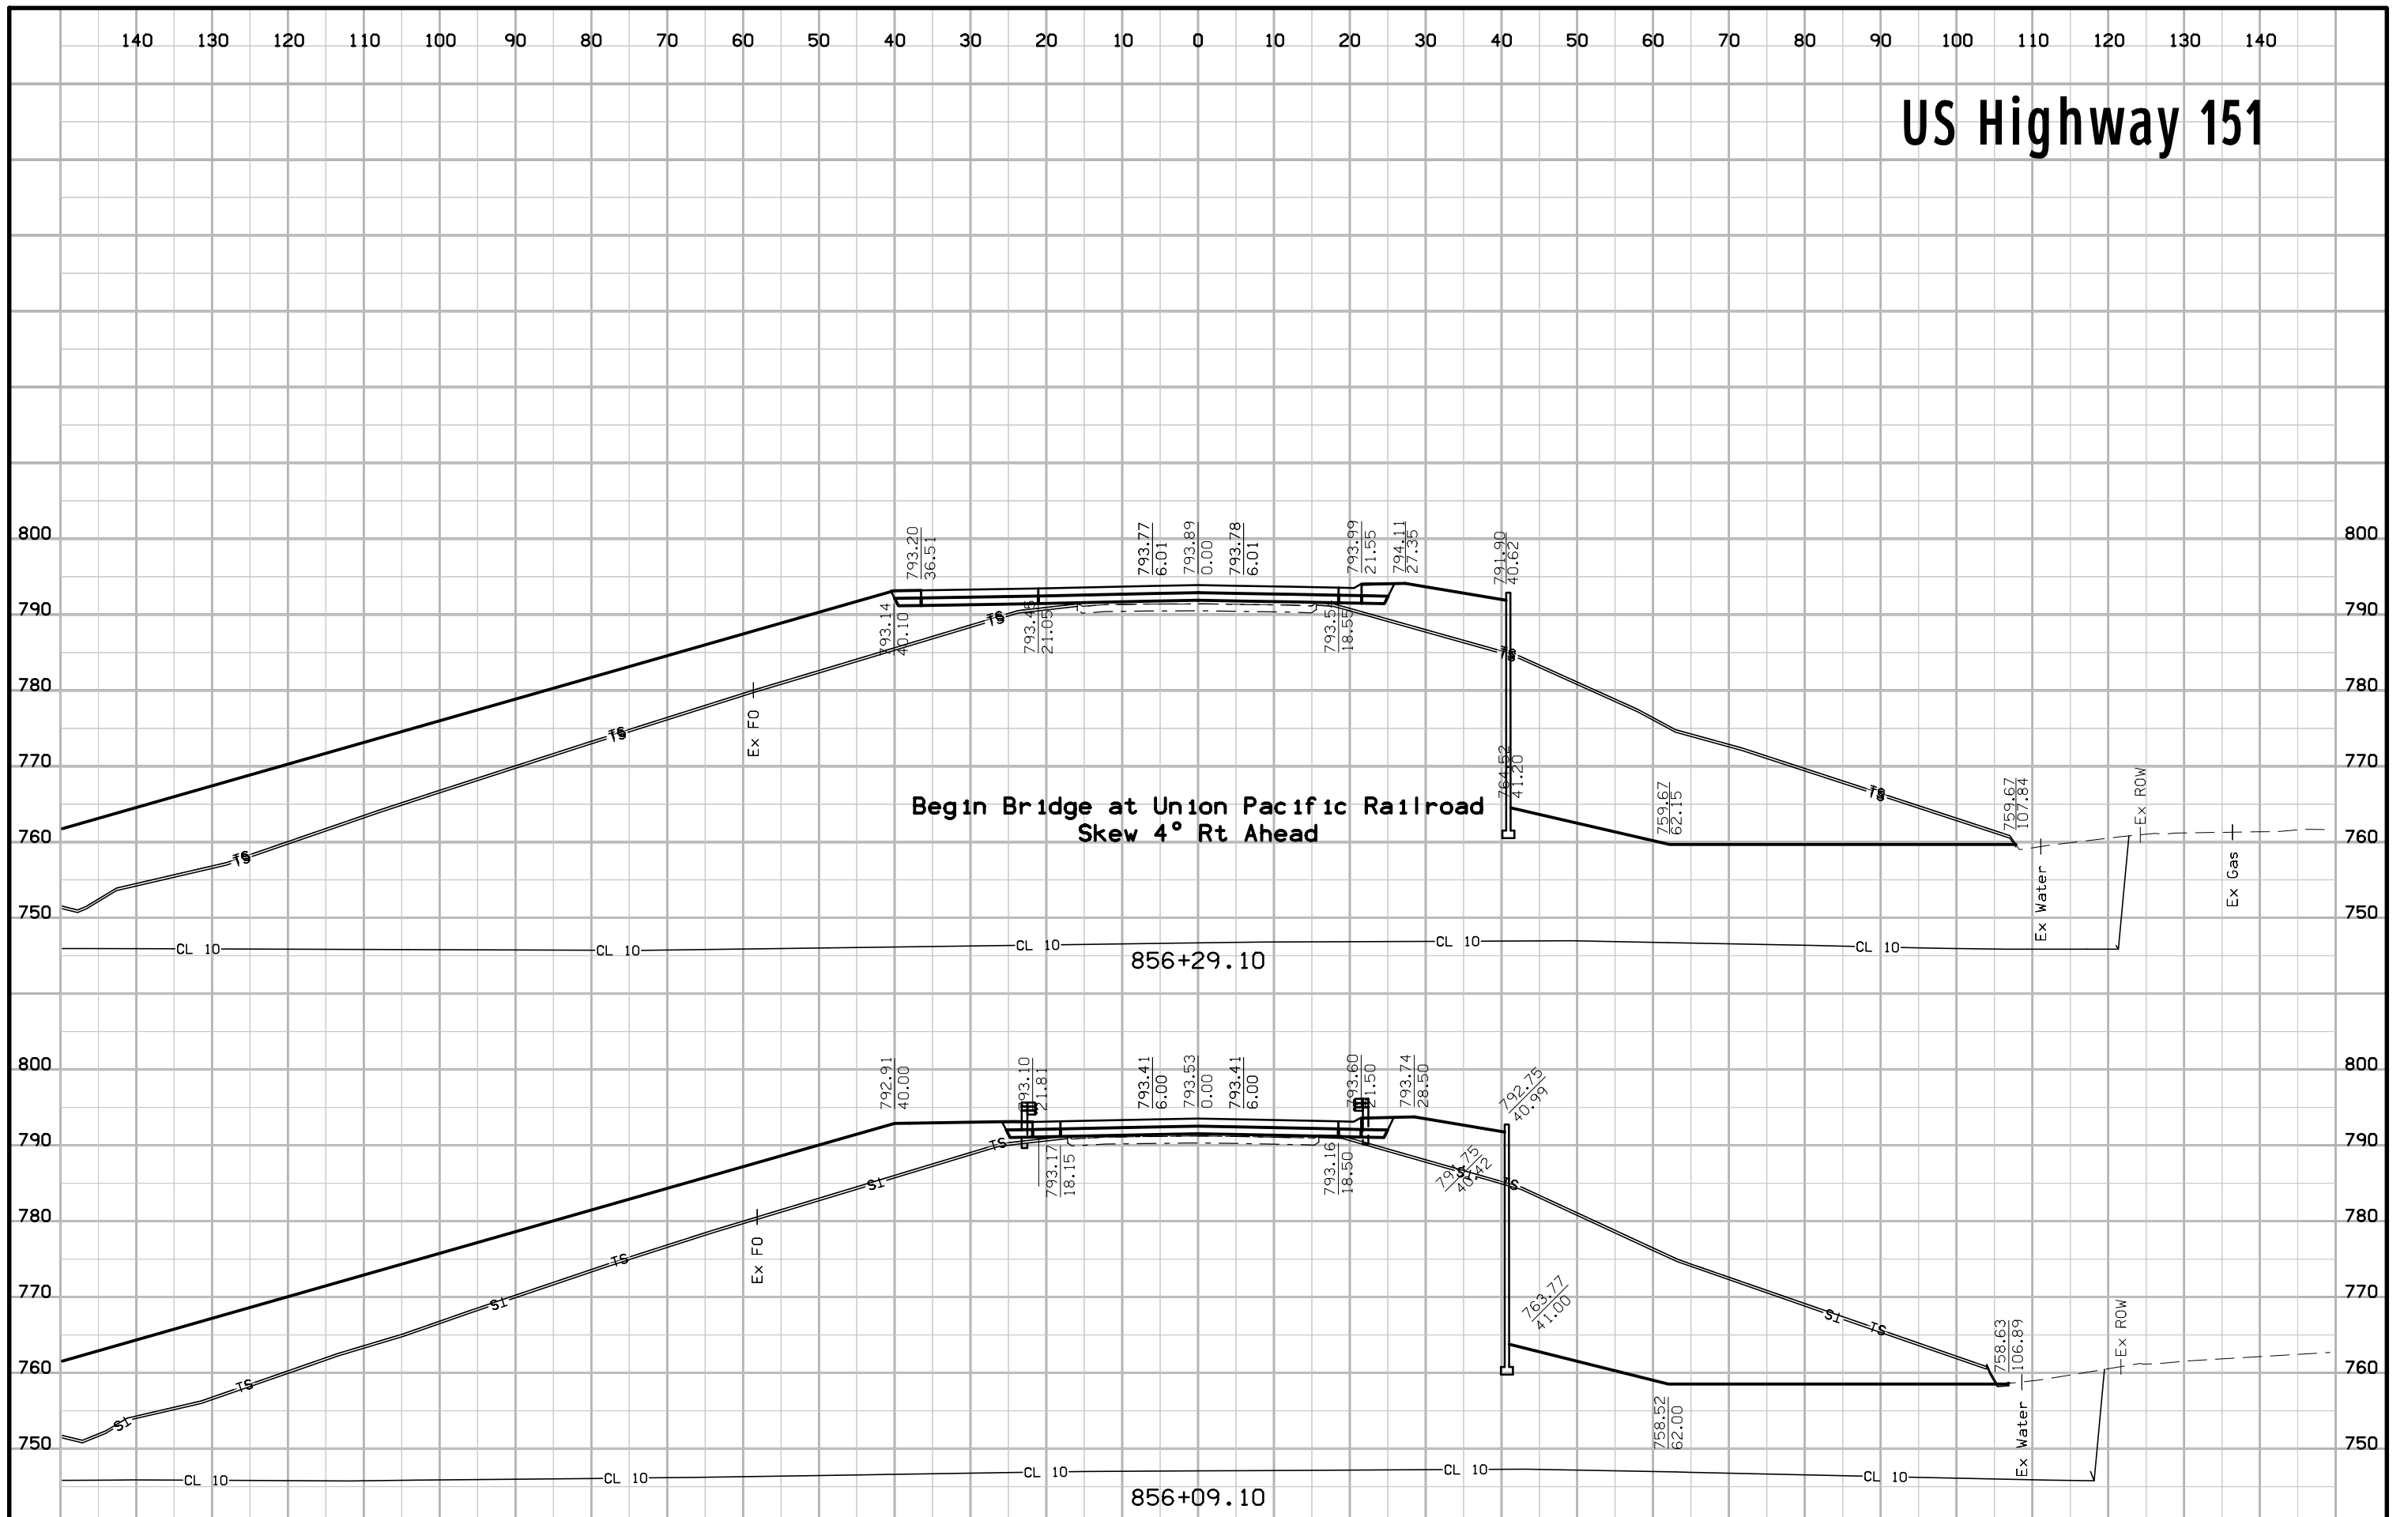


US Highway 151

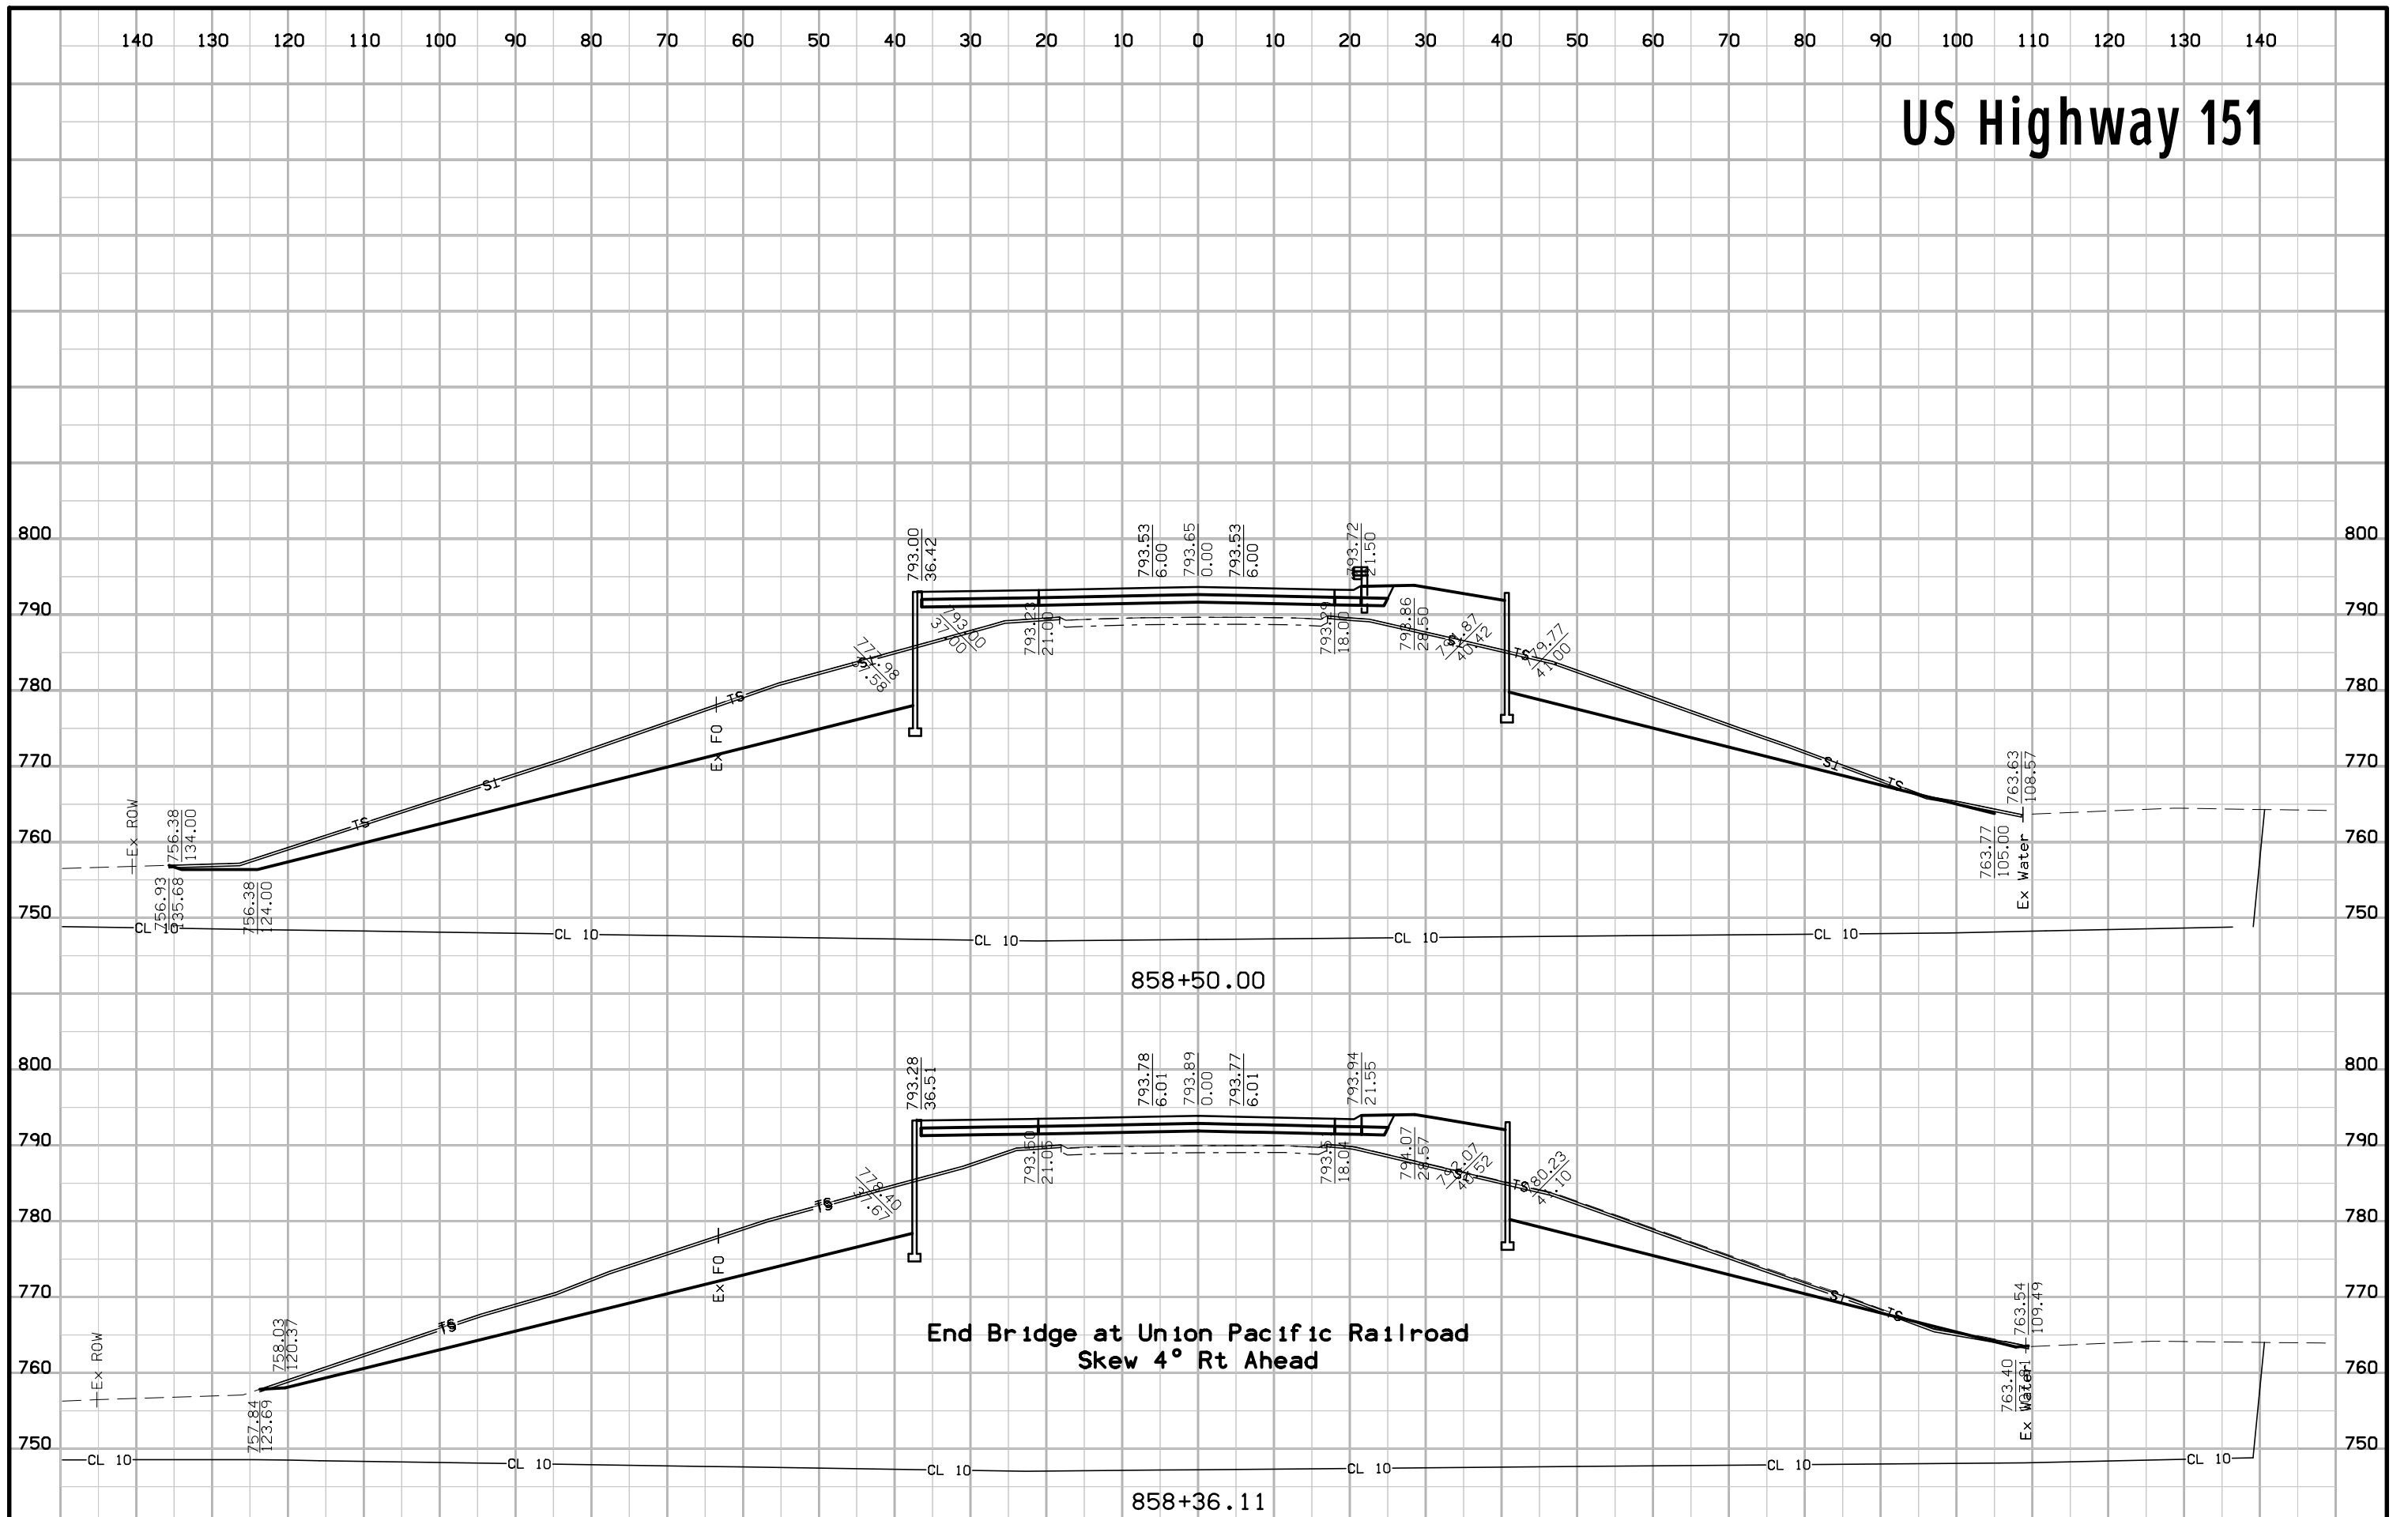


US Highway 151

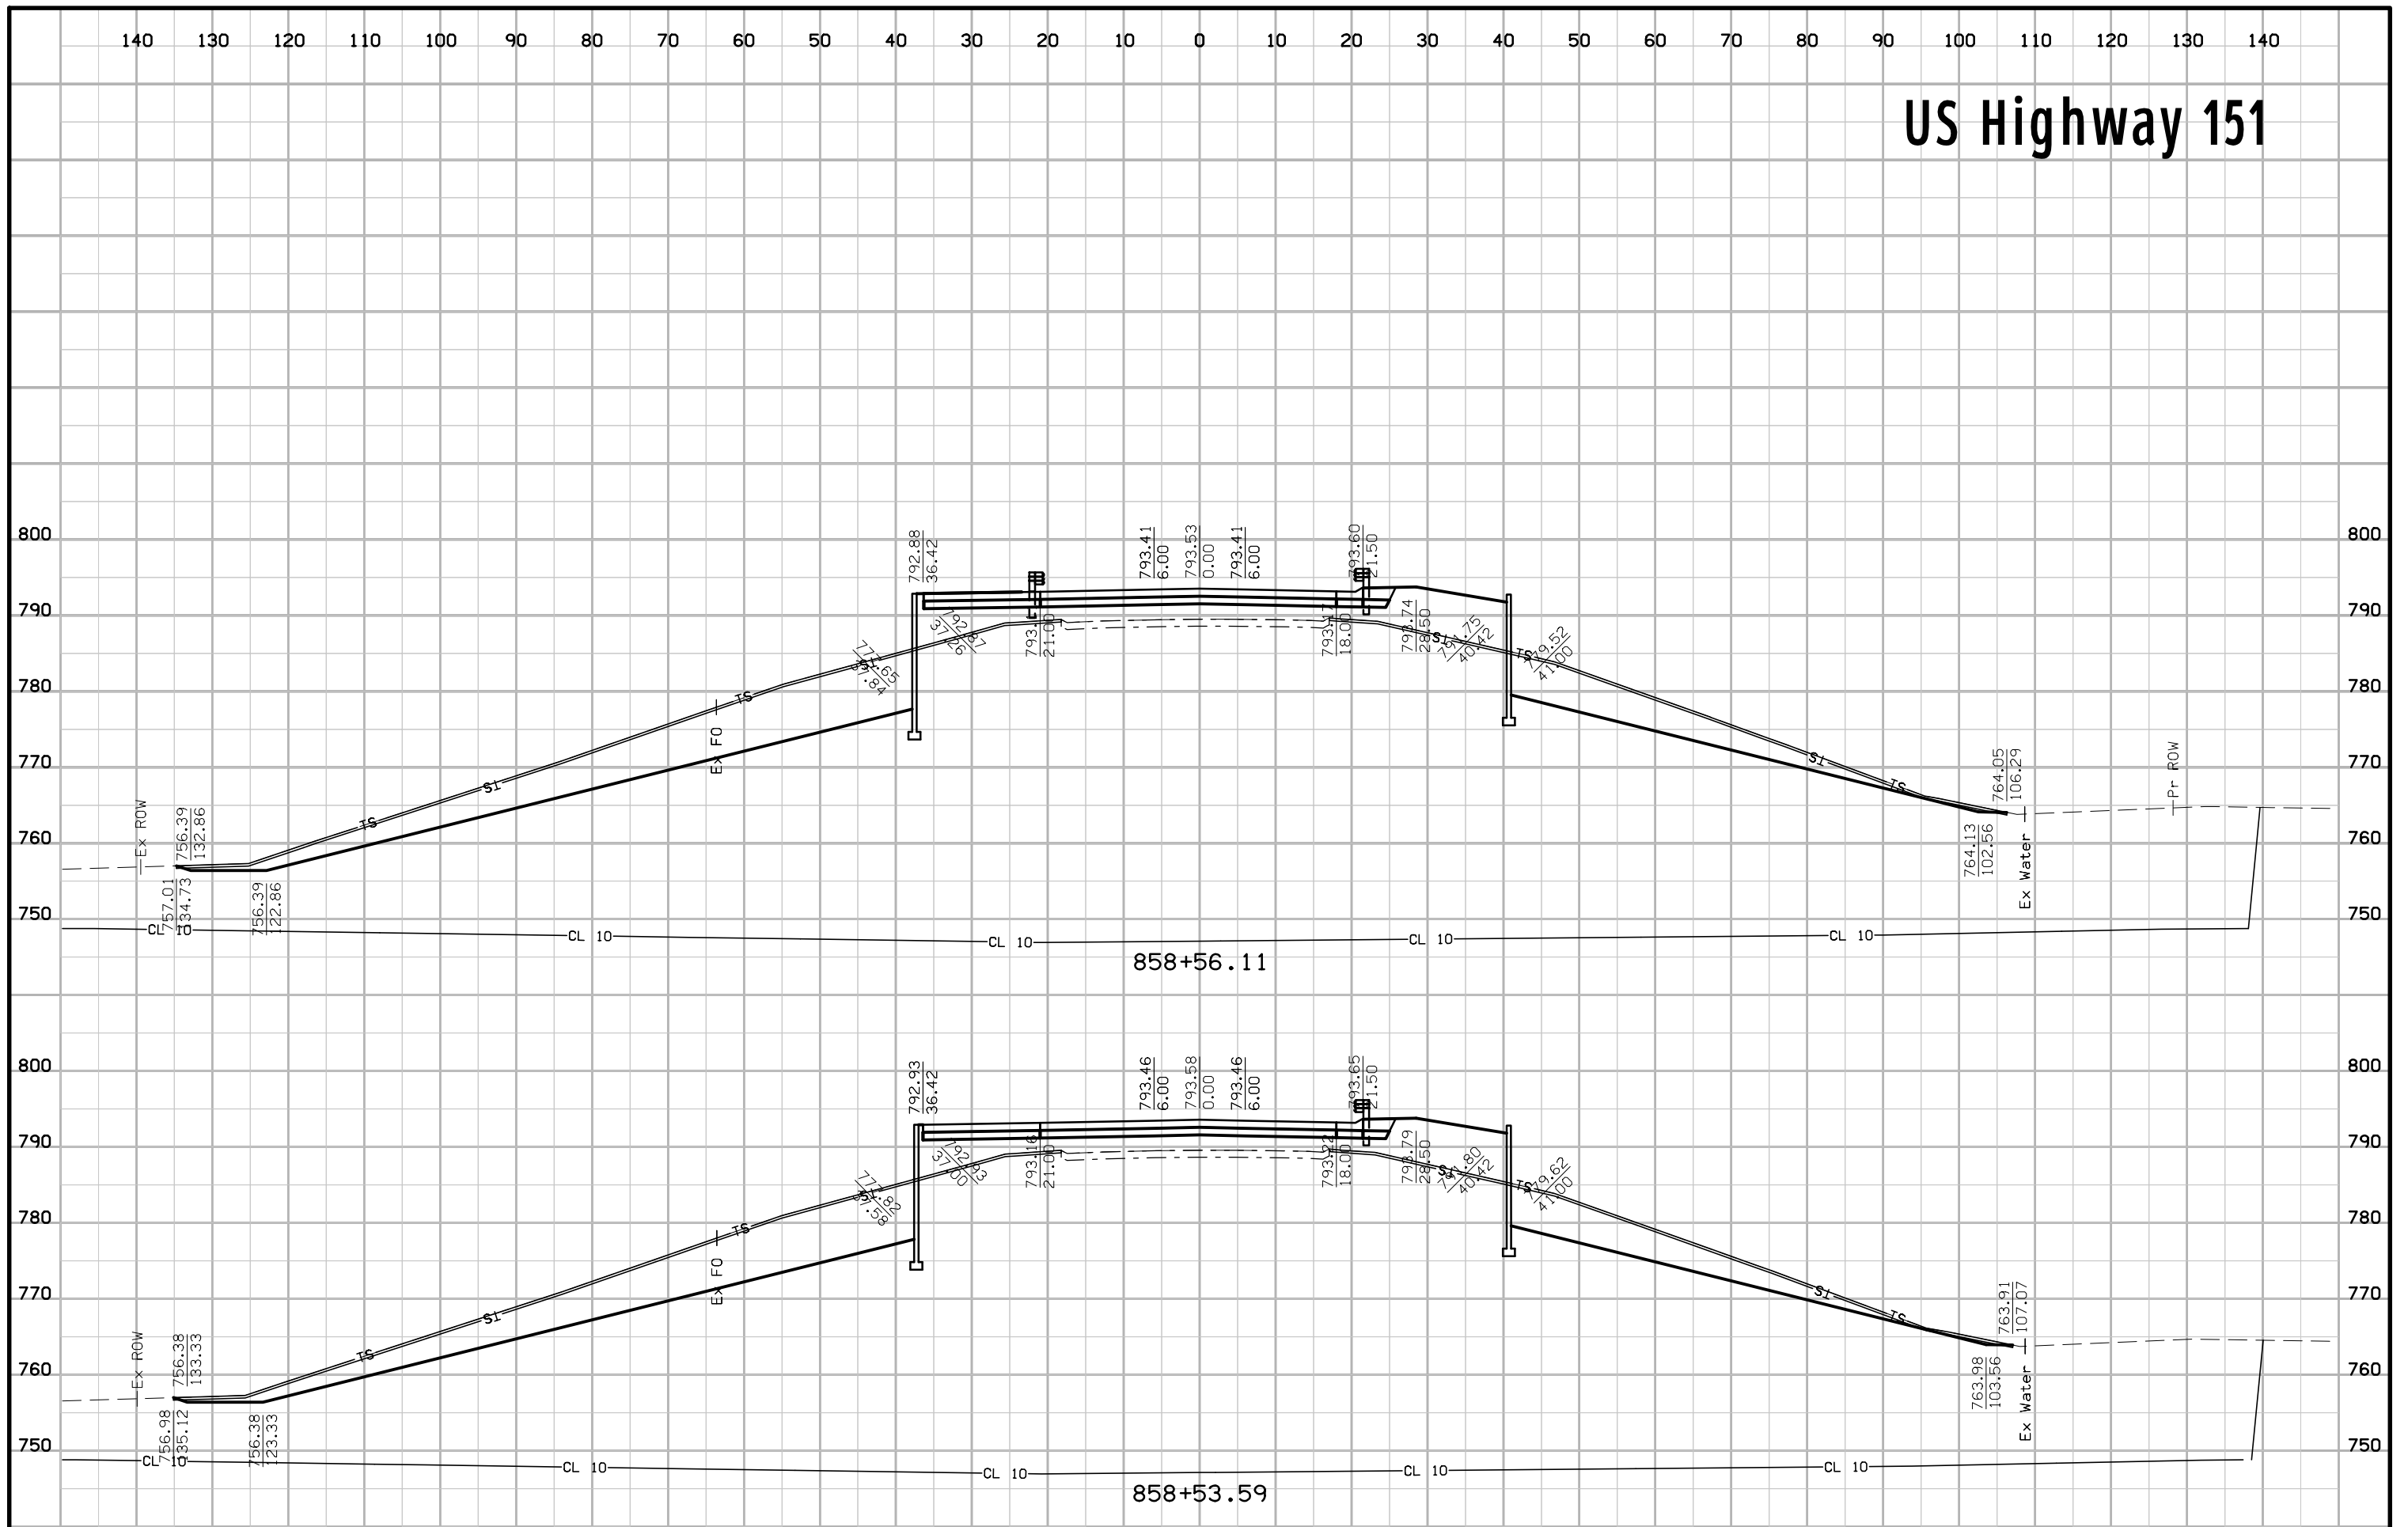


US Highway 151

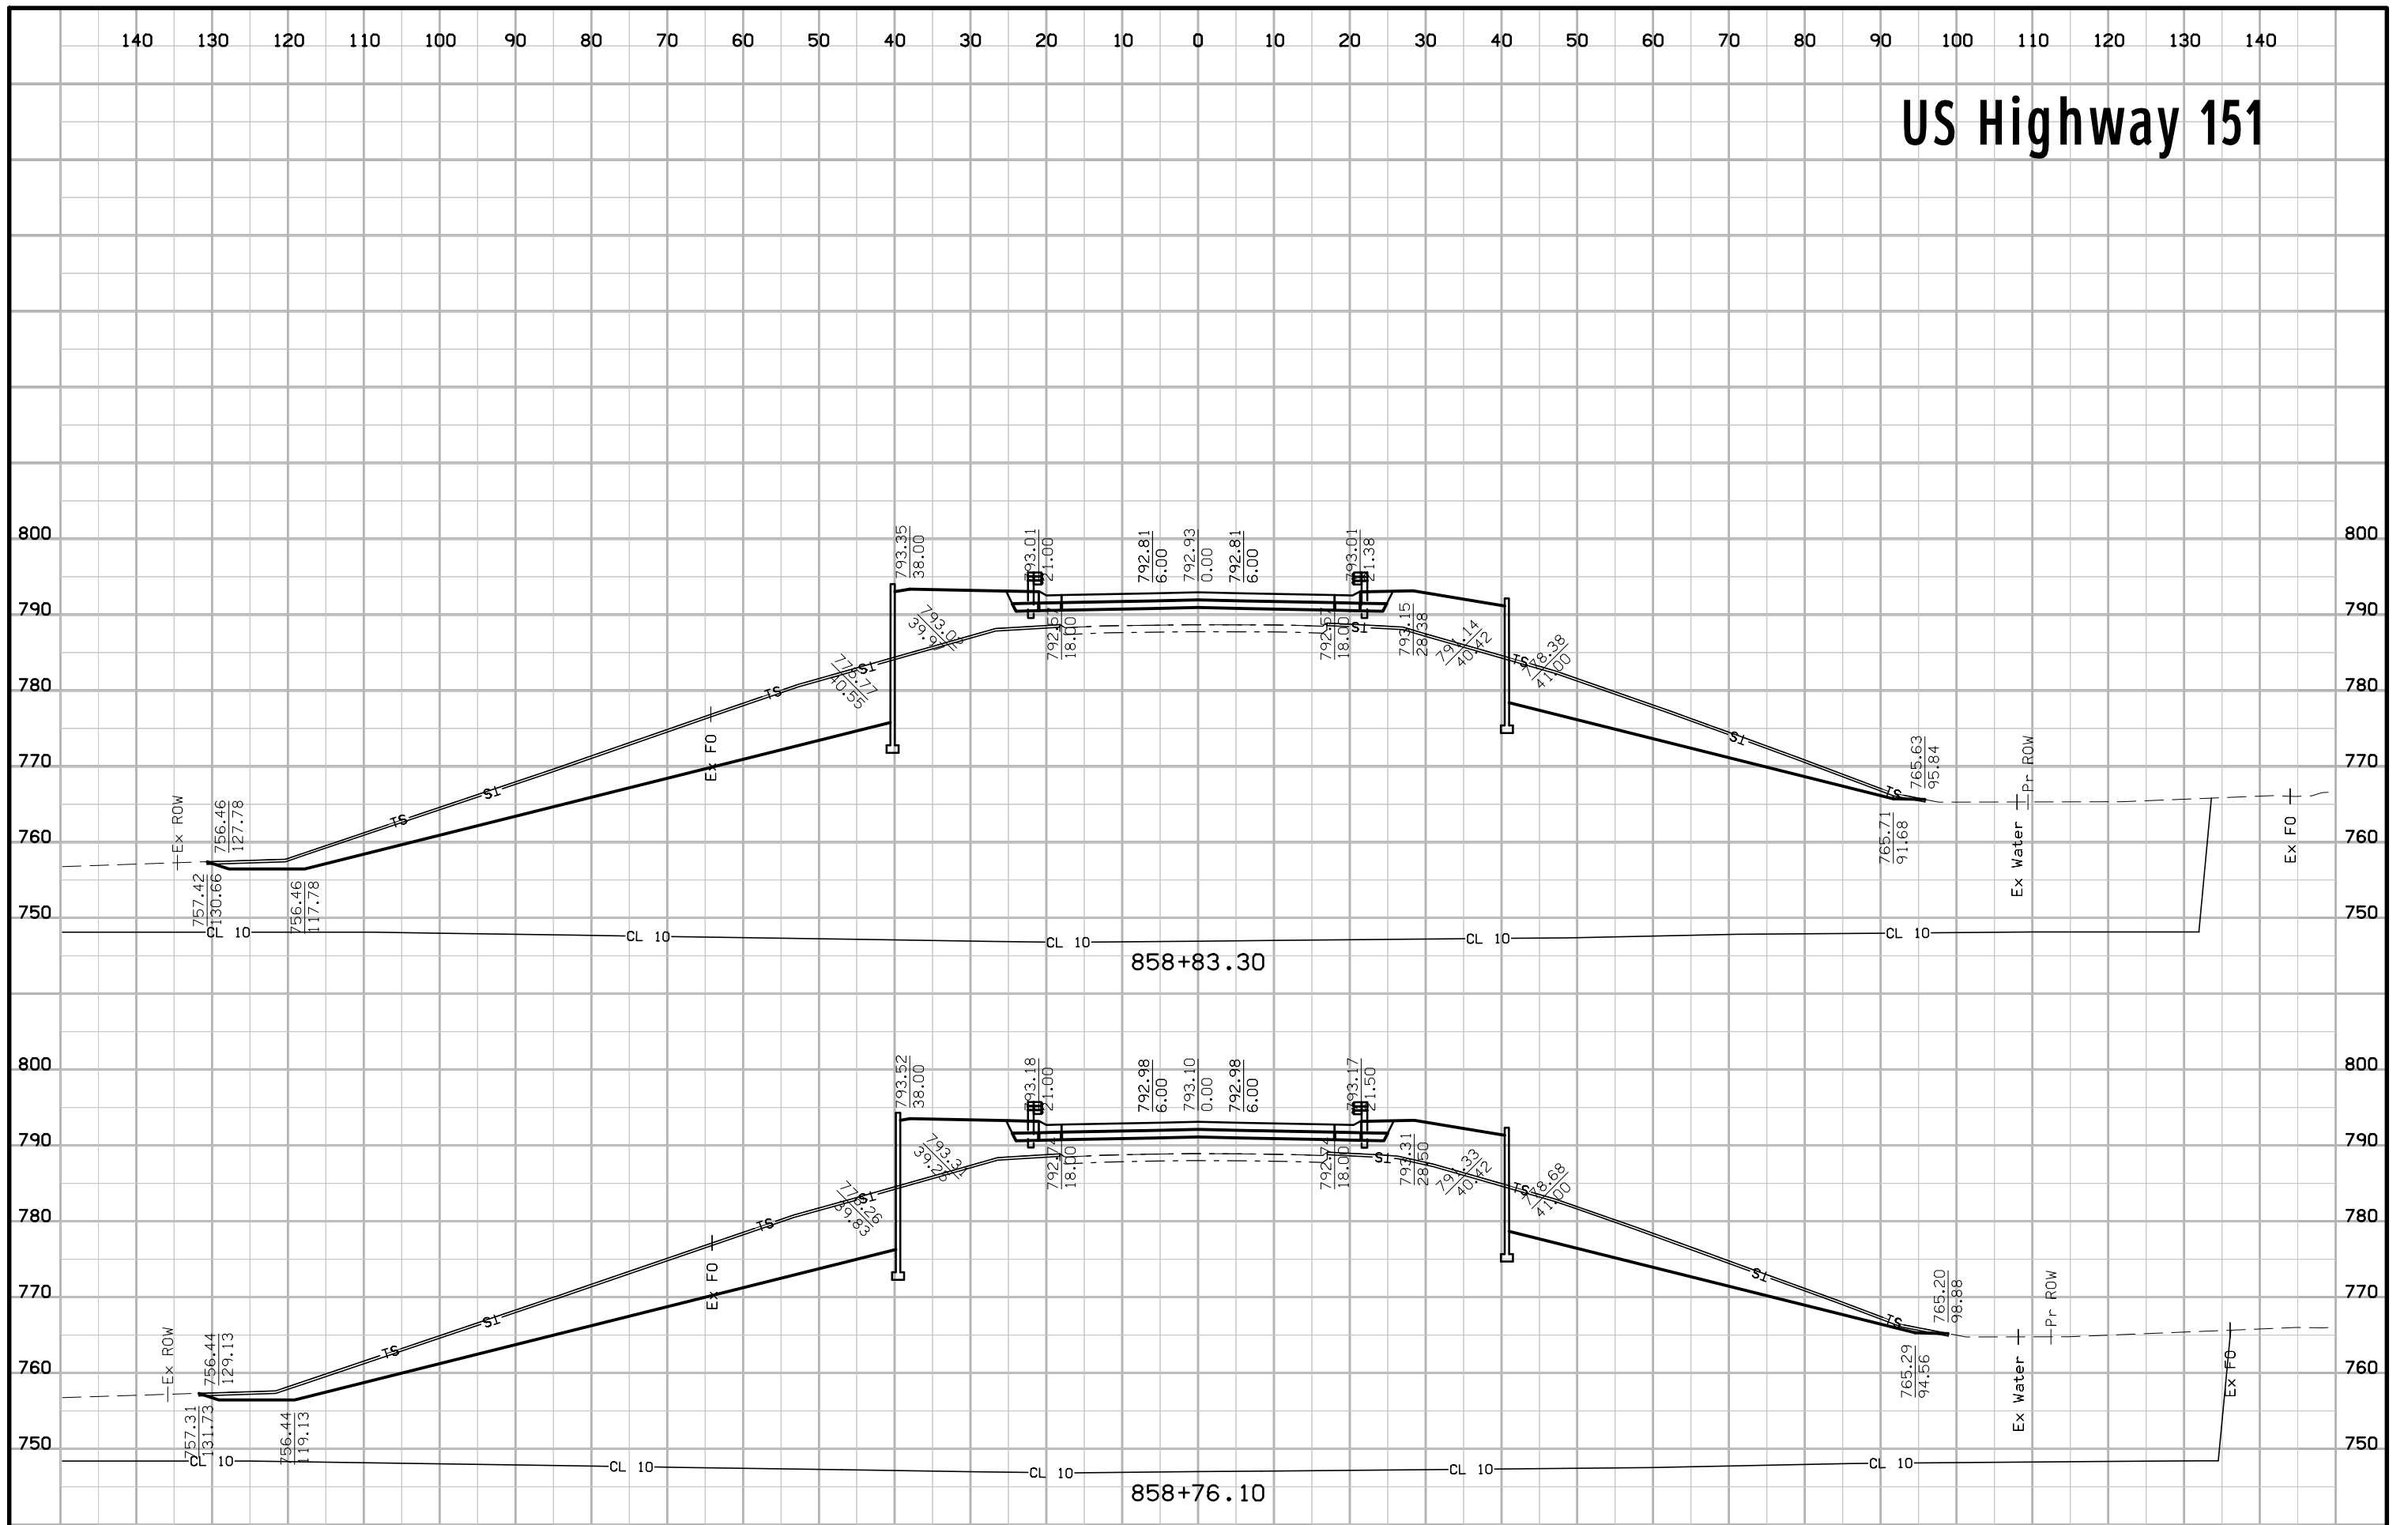


US Highway 151

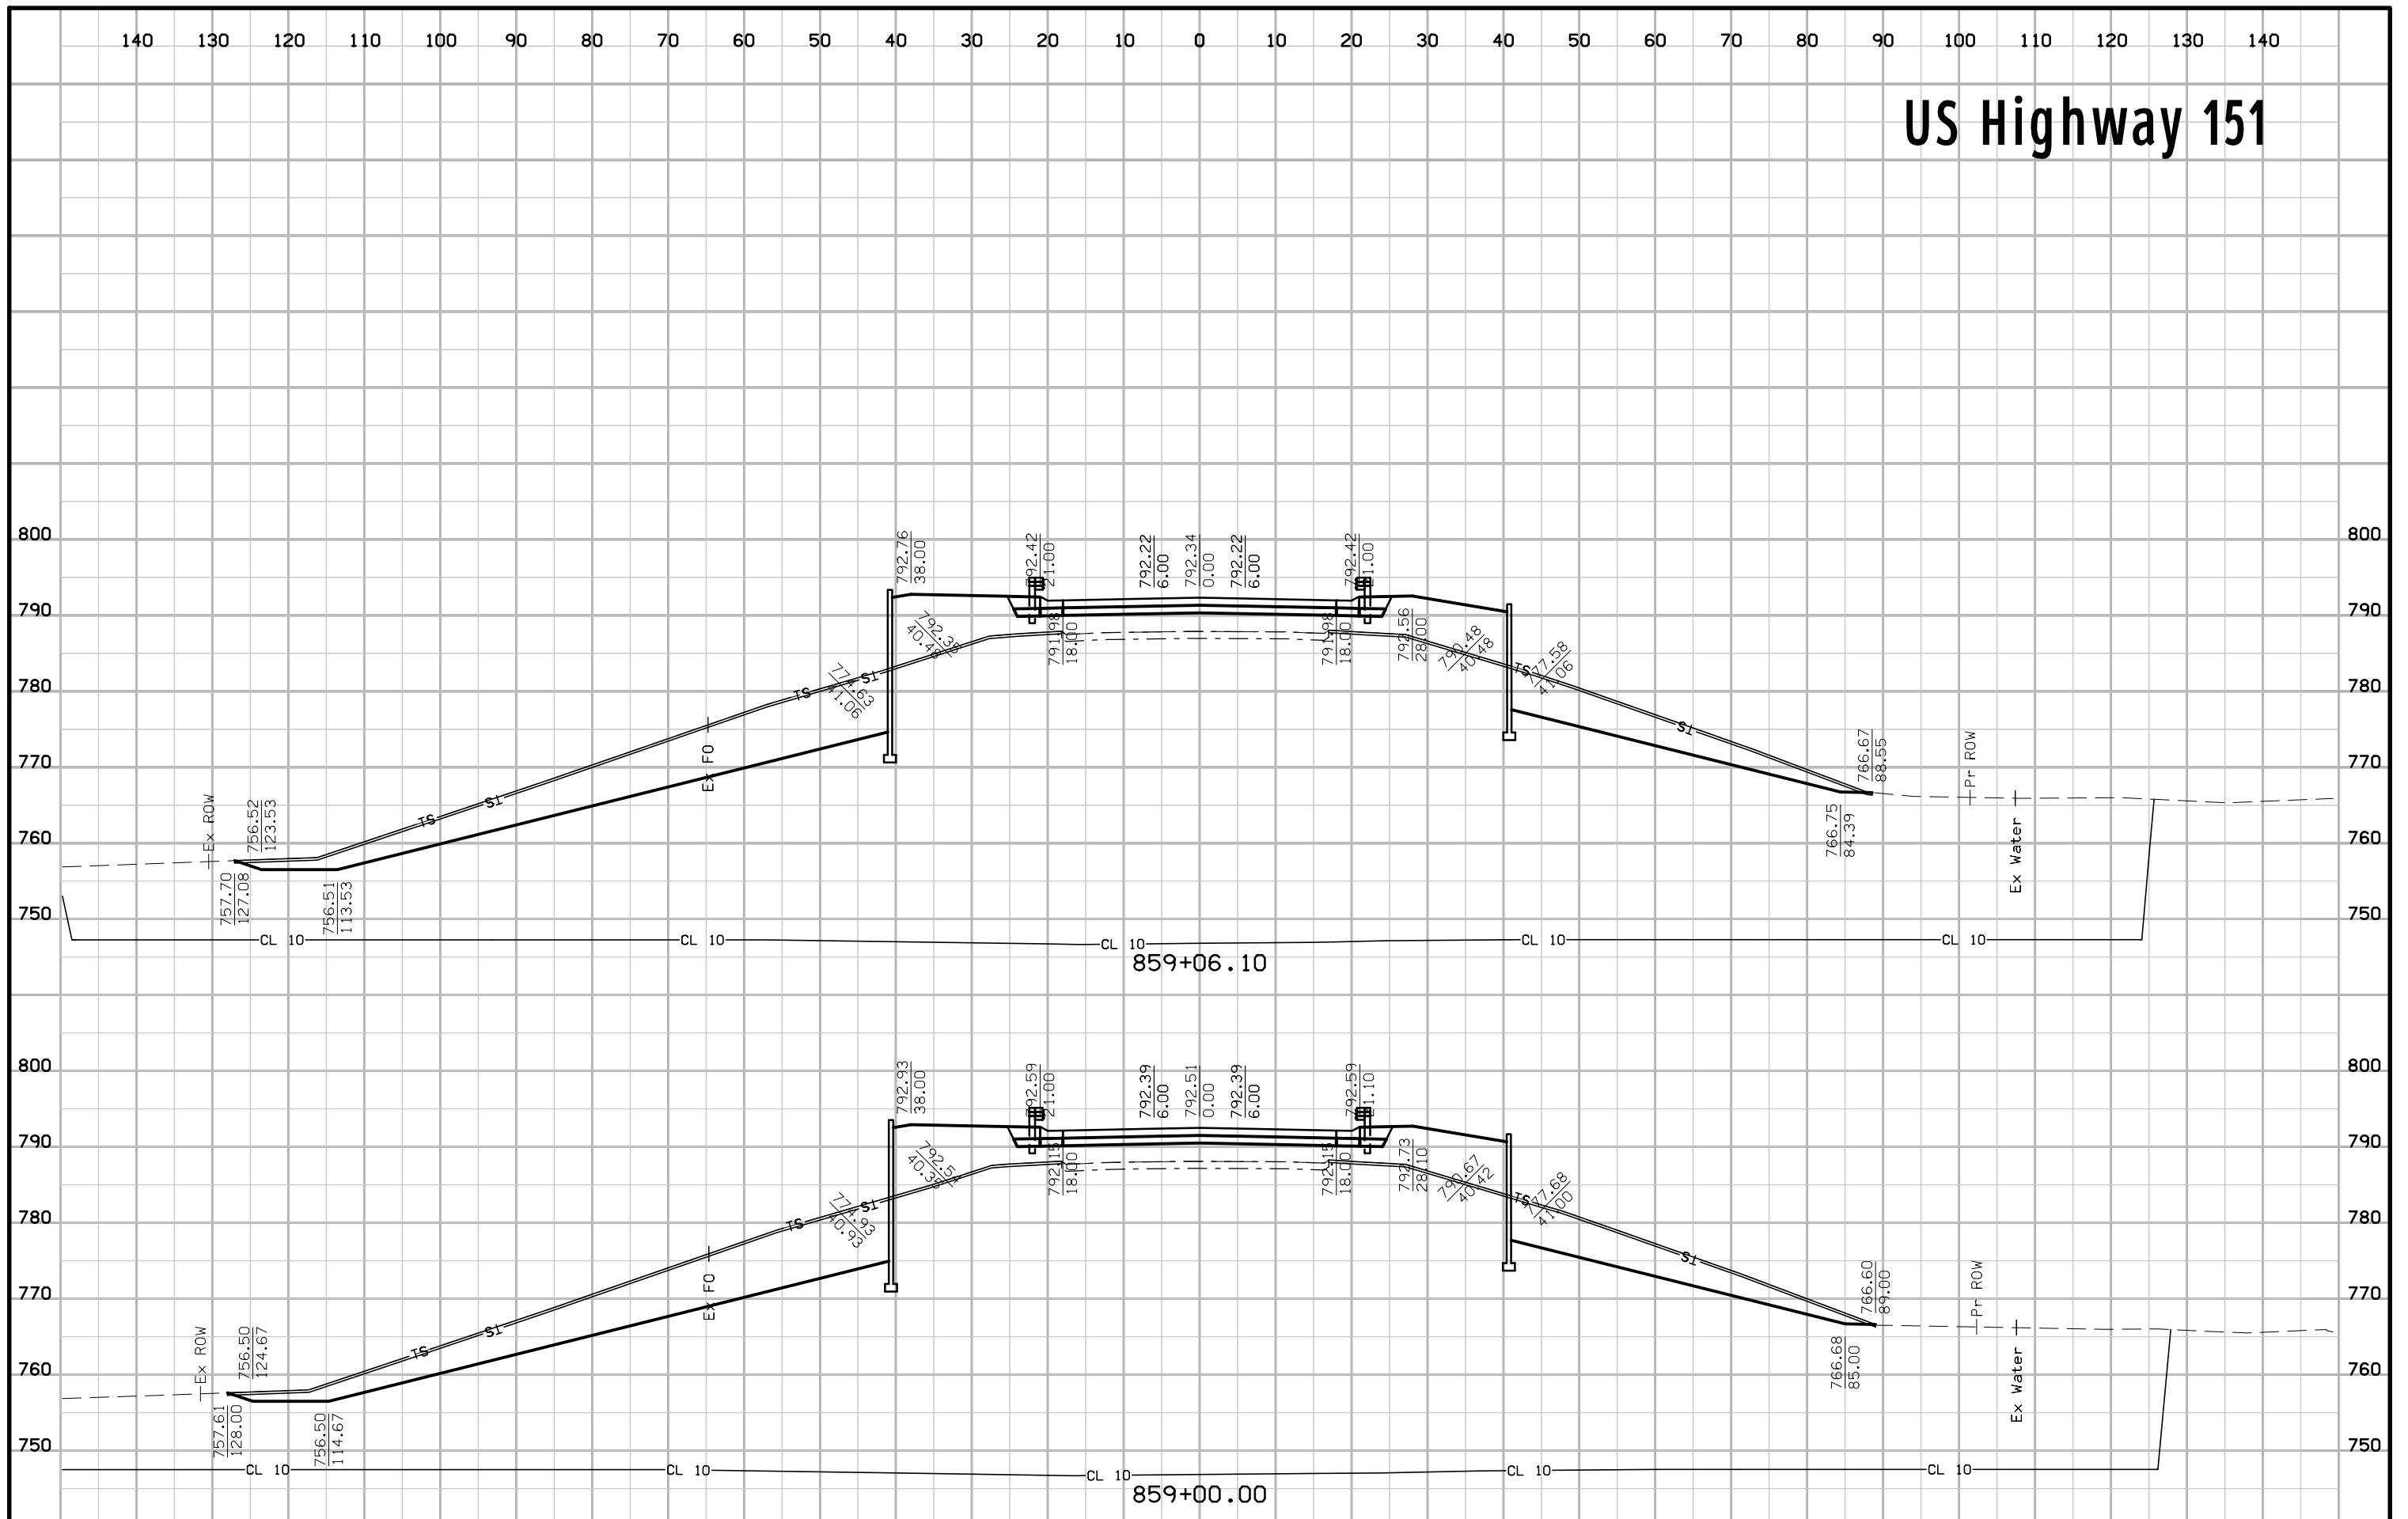


US Highway 151

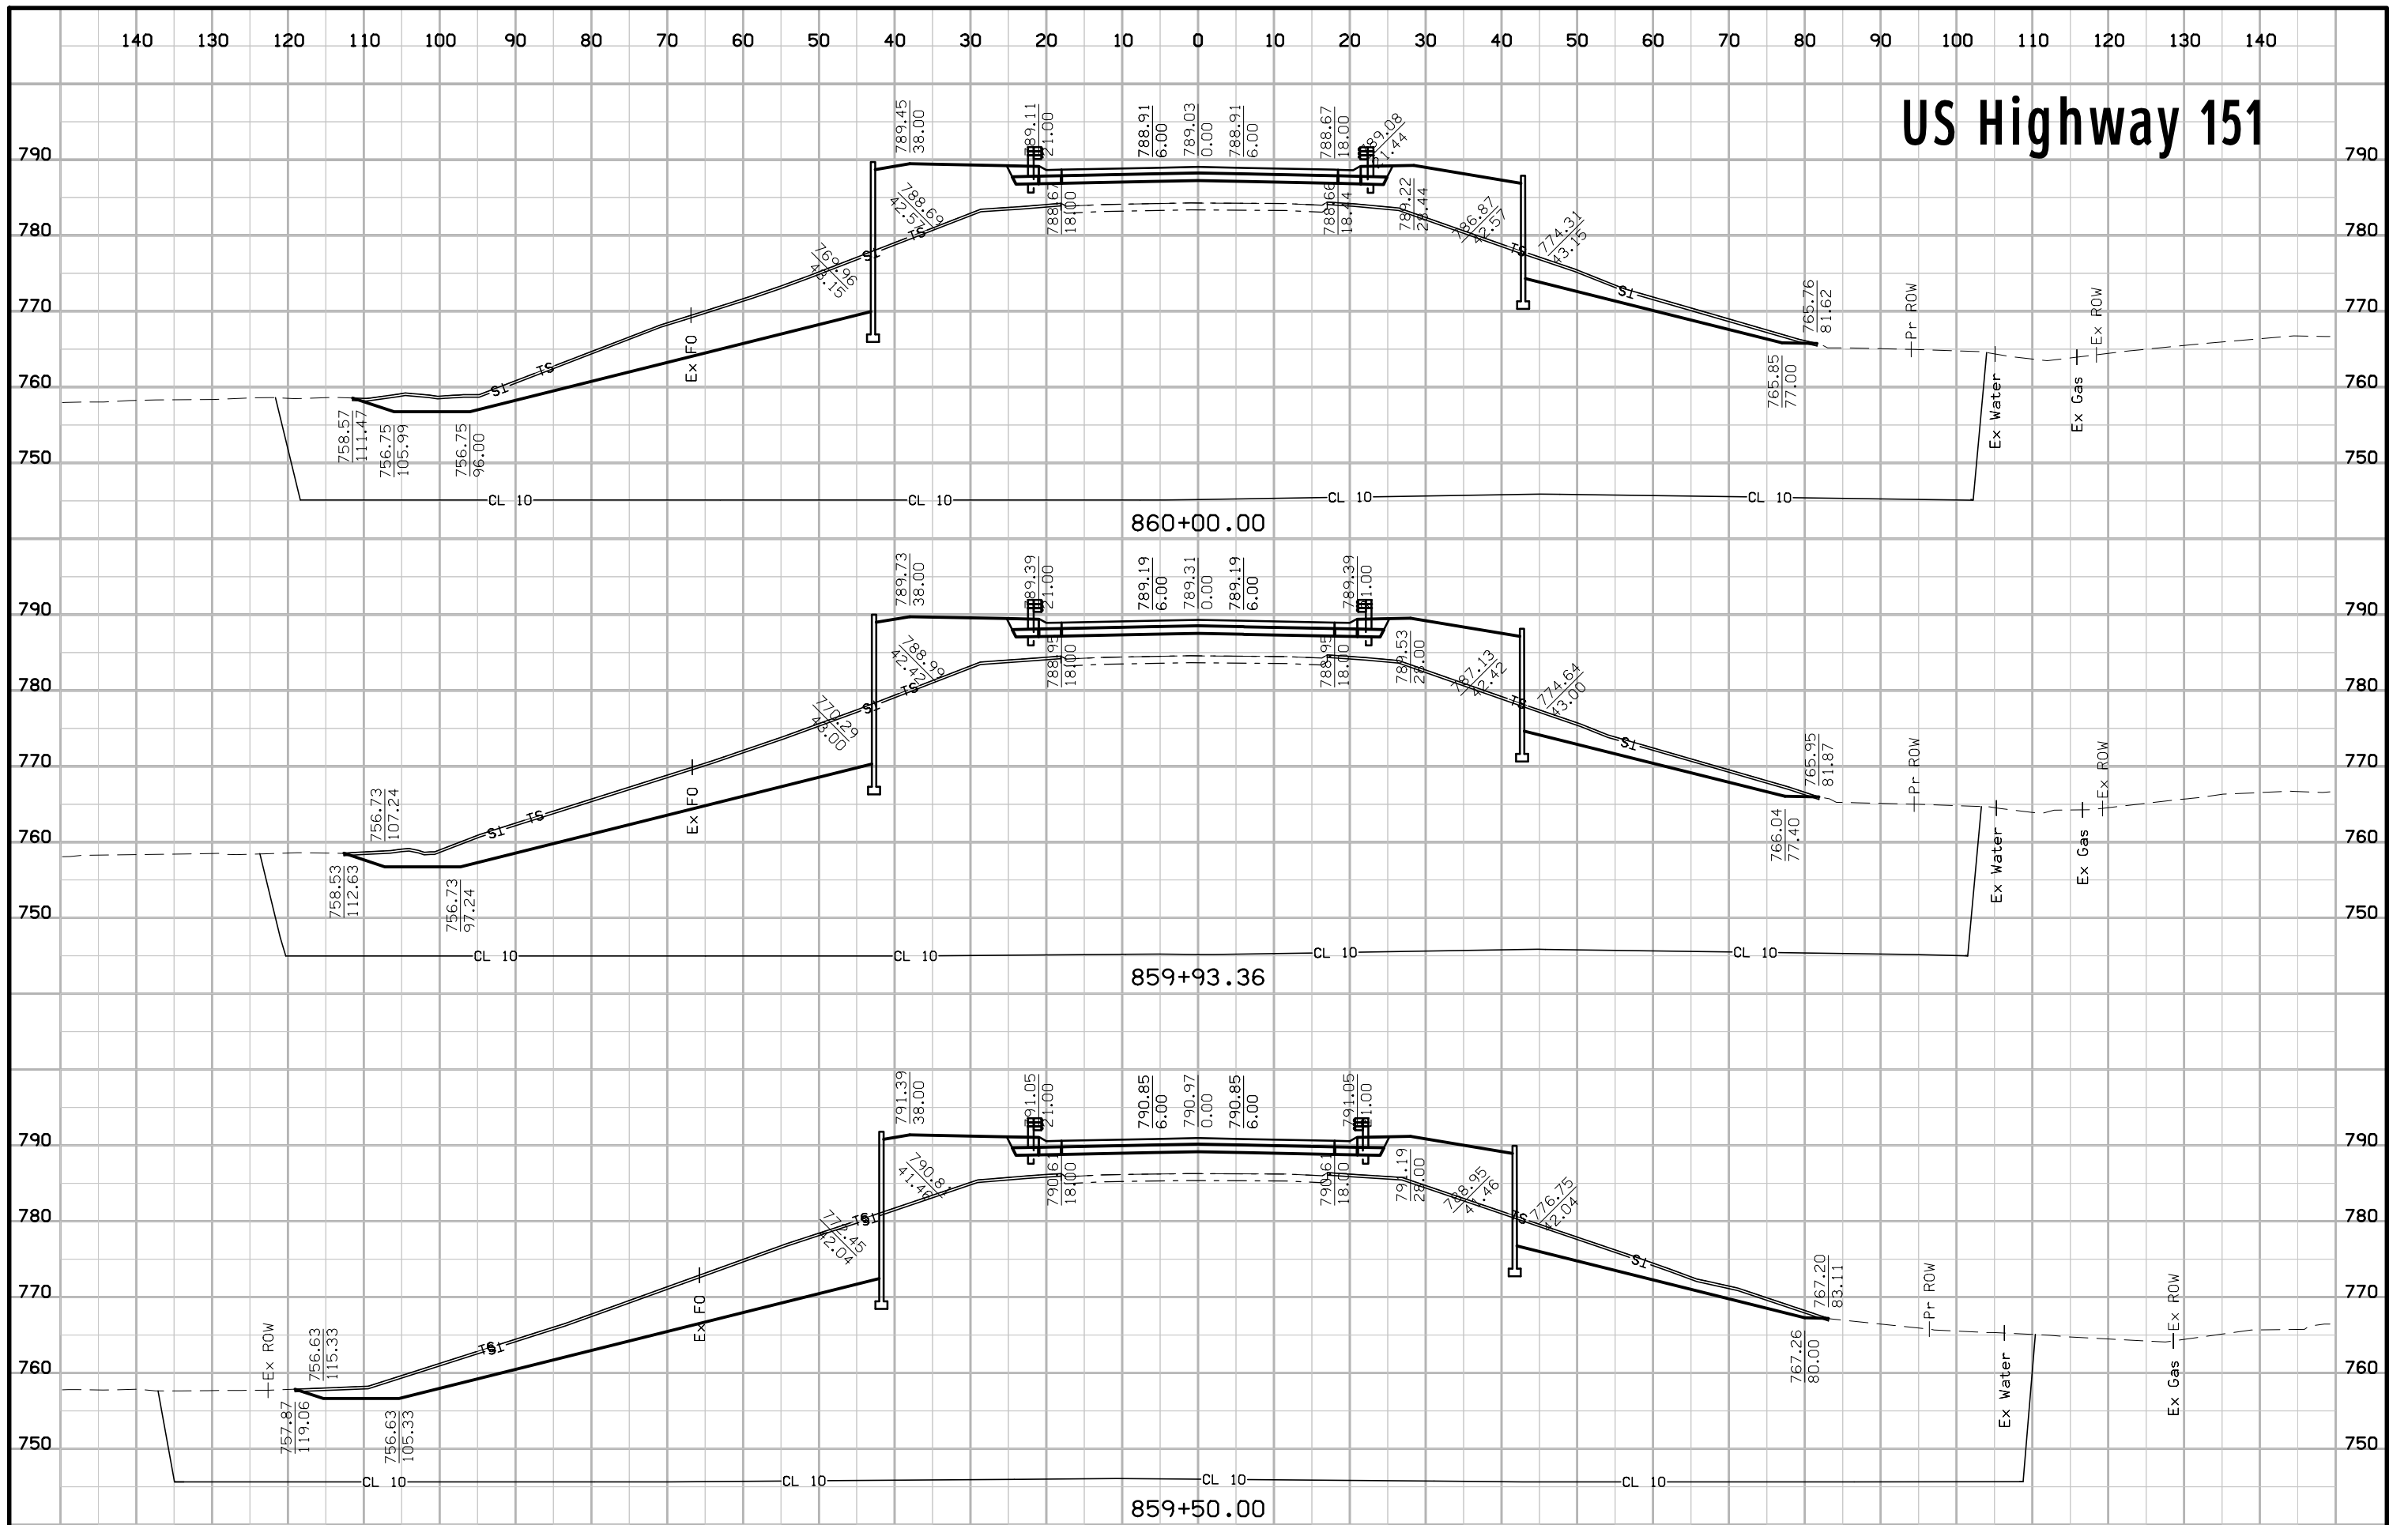


US Highway 151

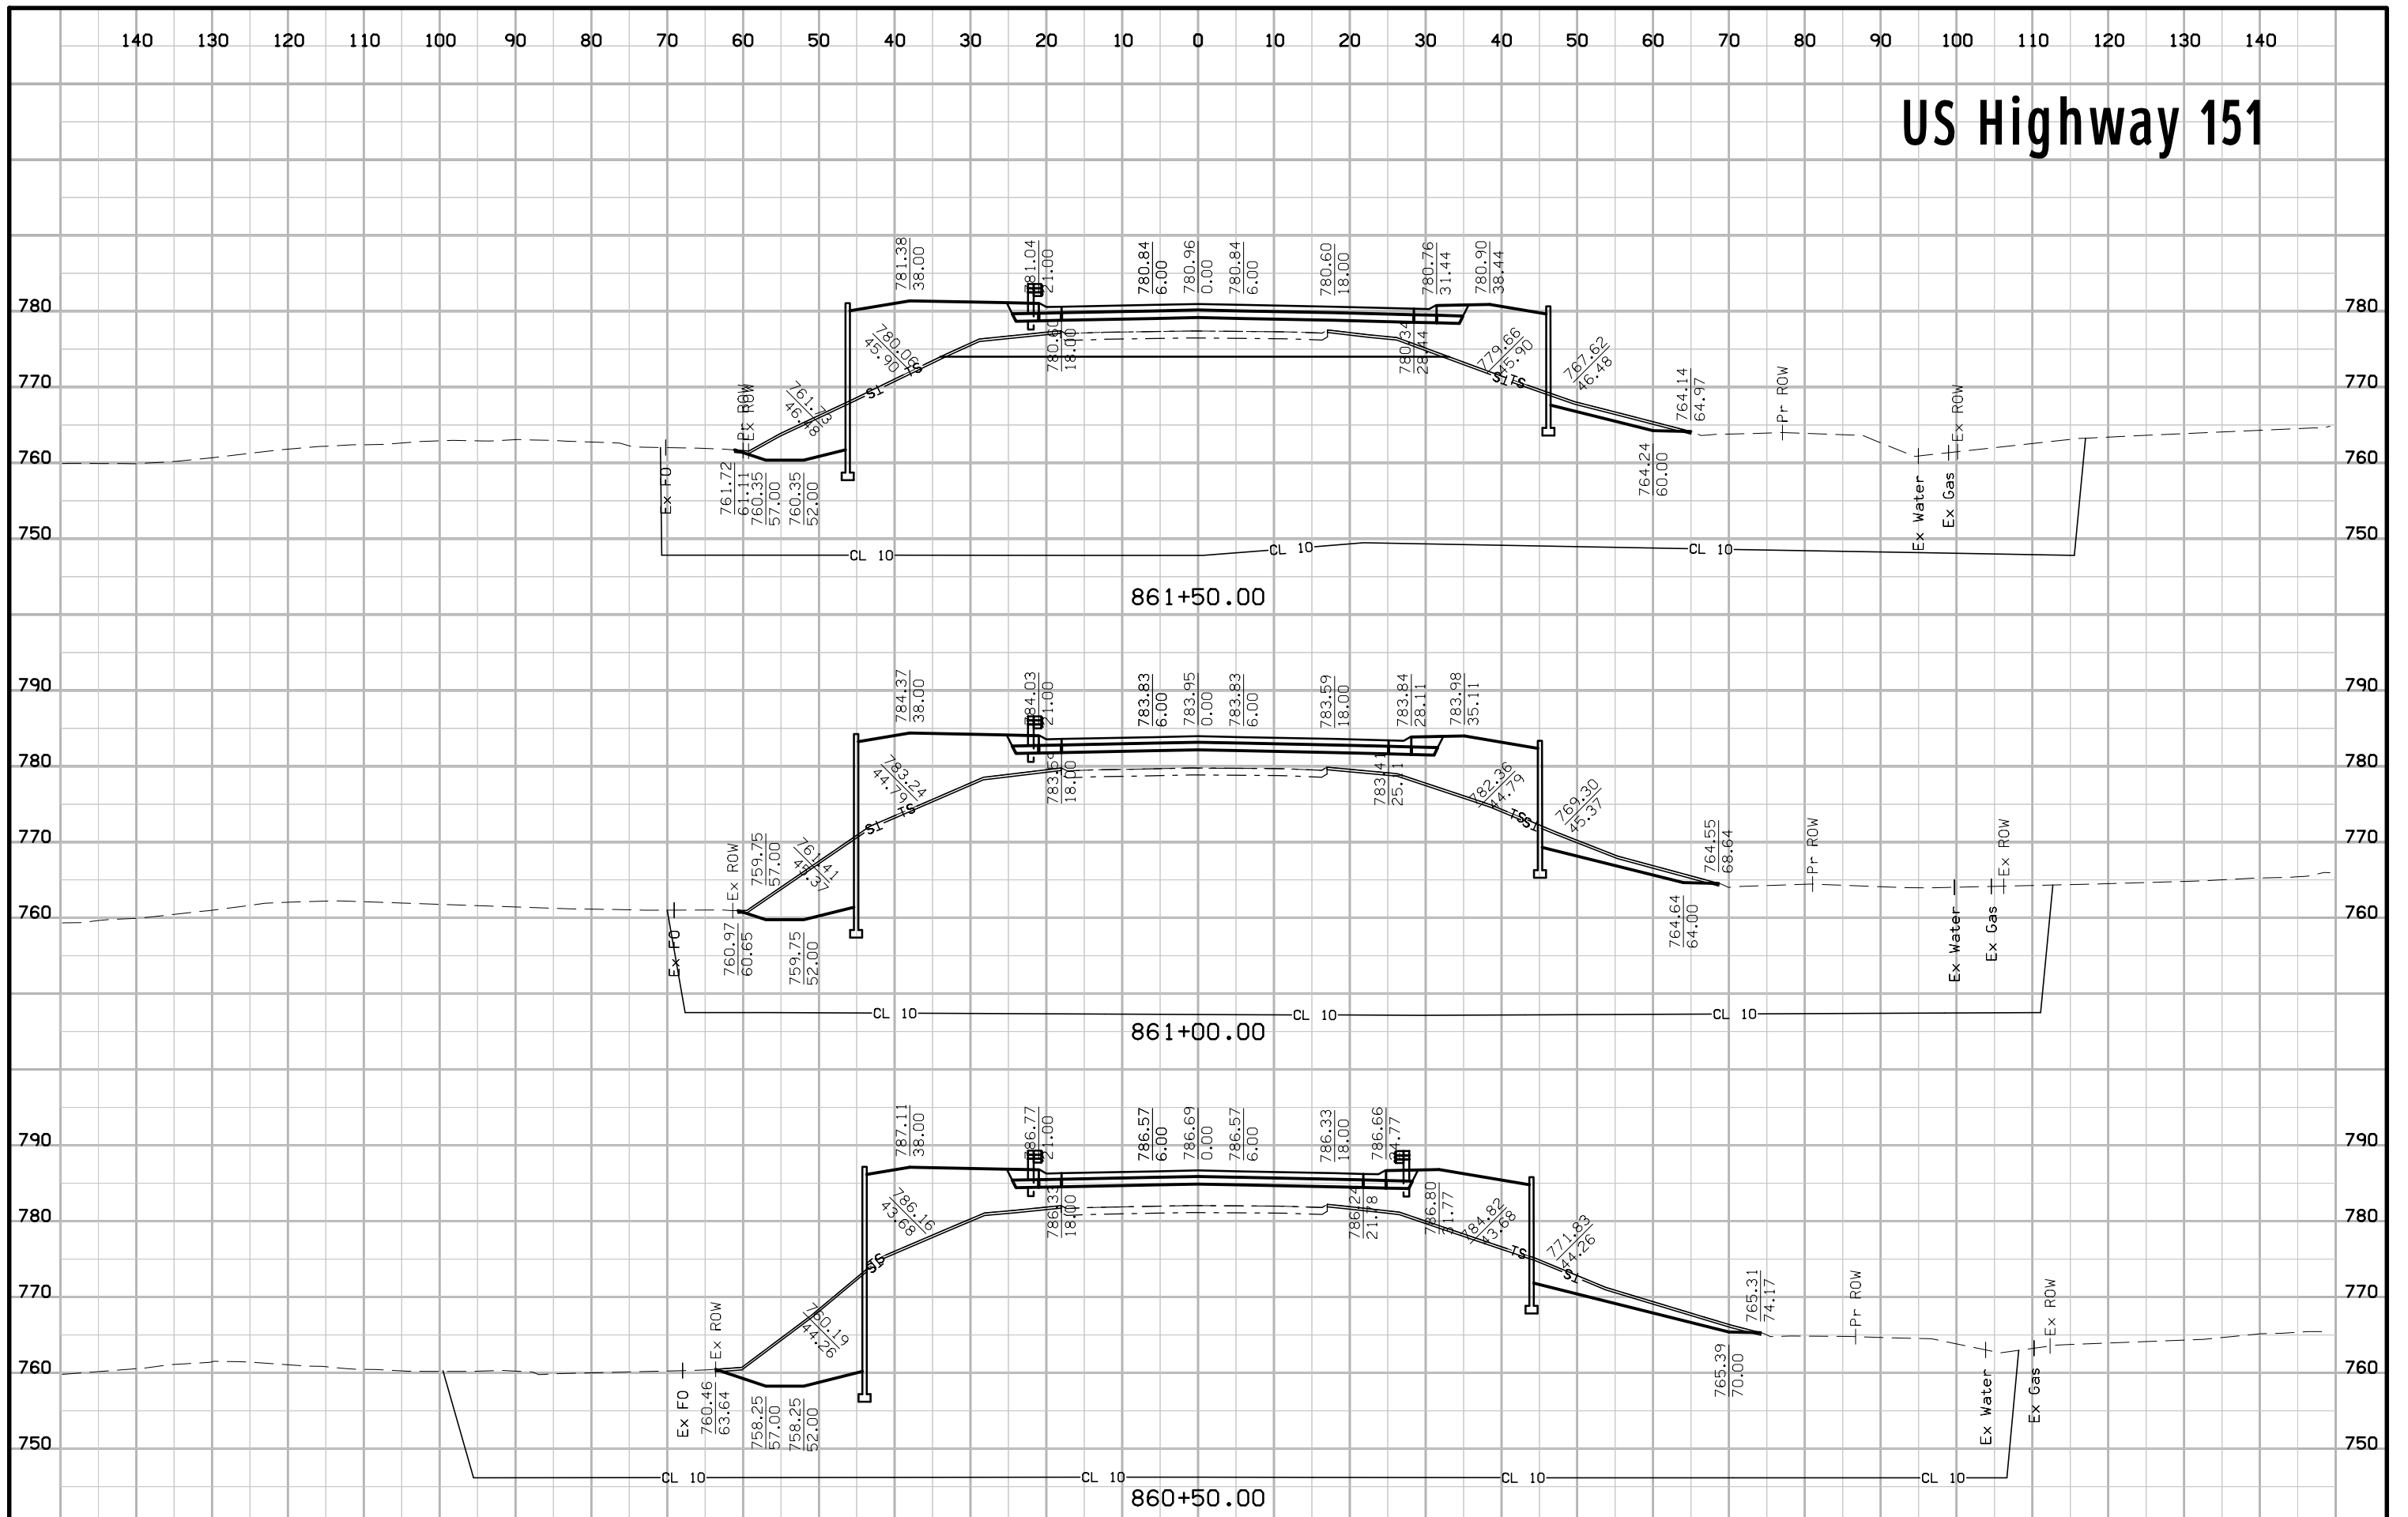


US Highway 151

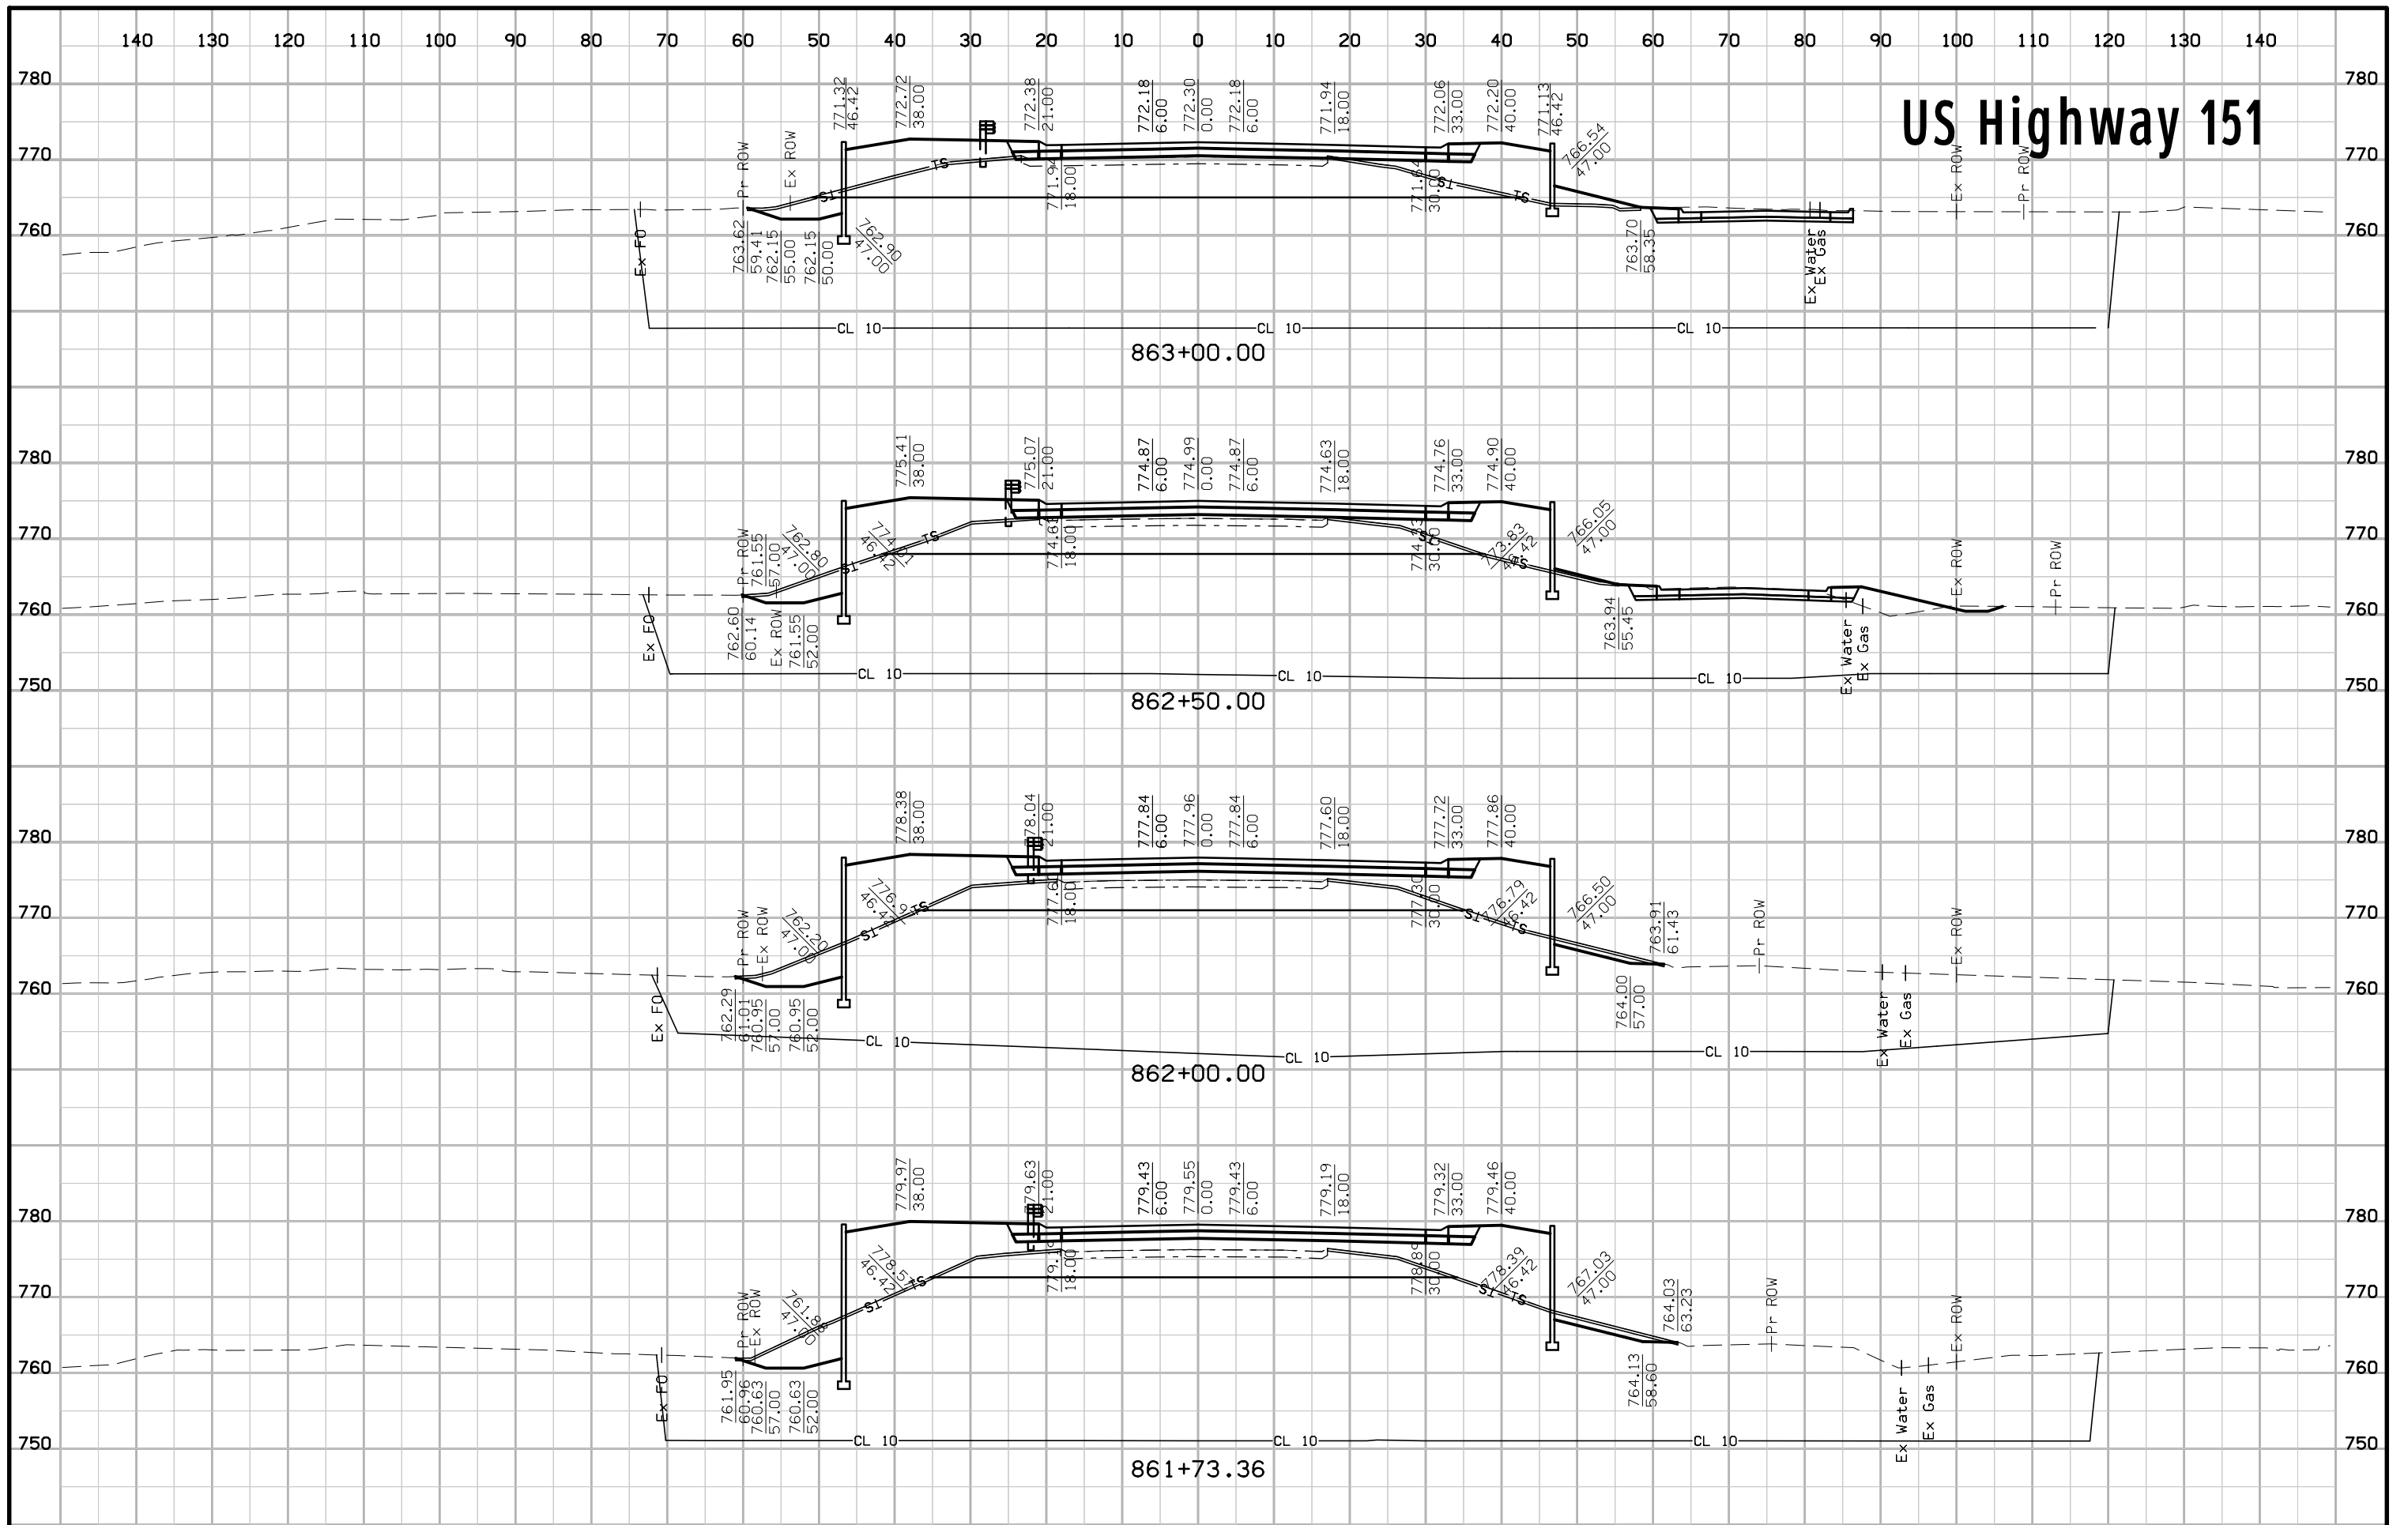


US Highway 151

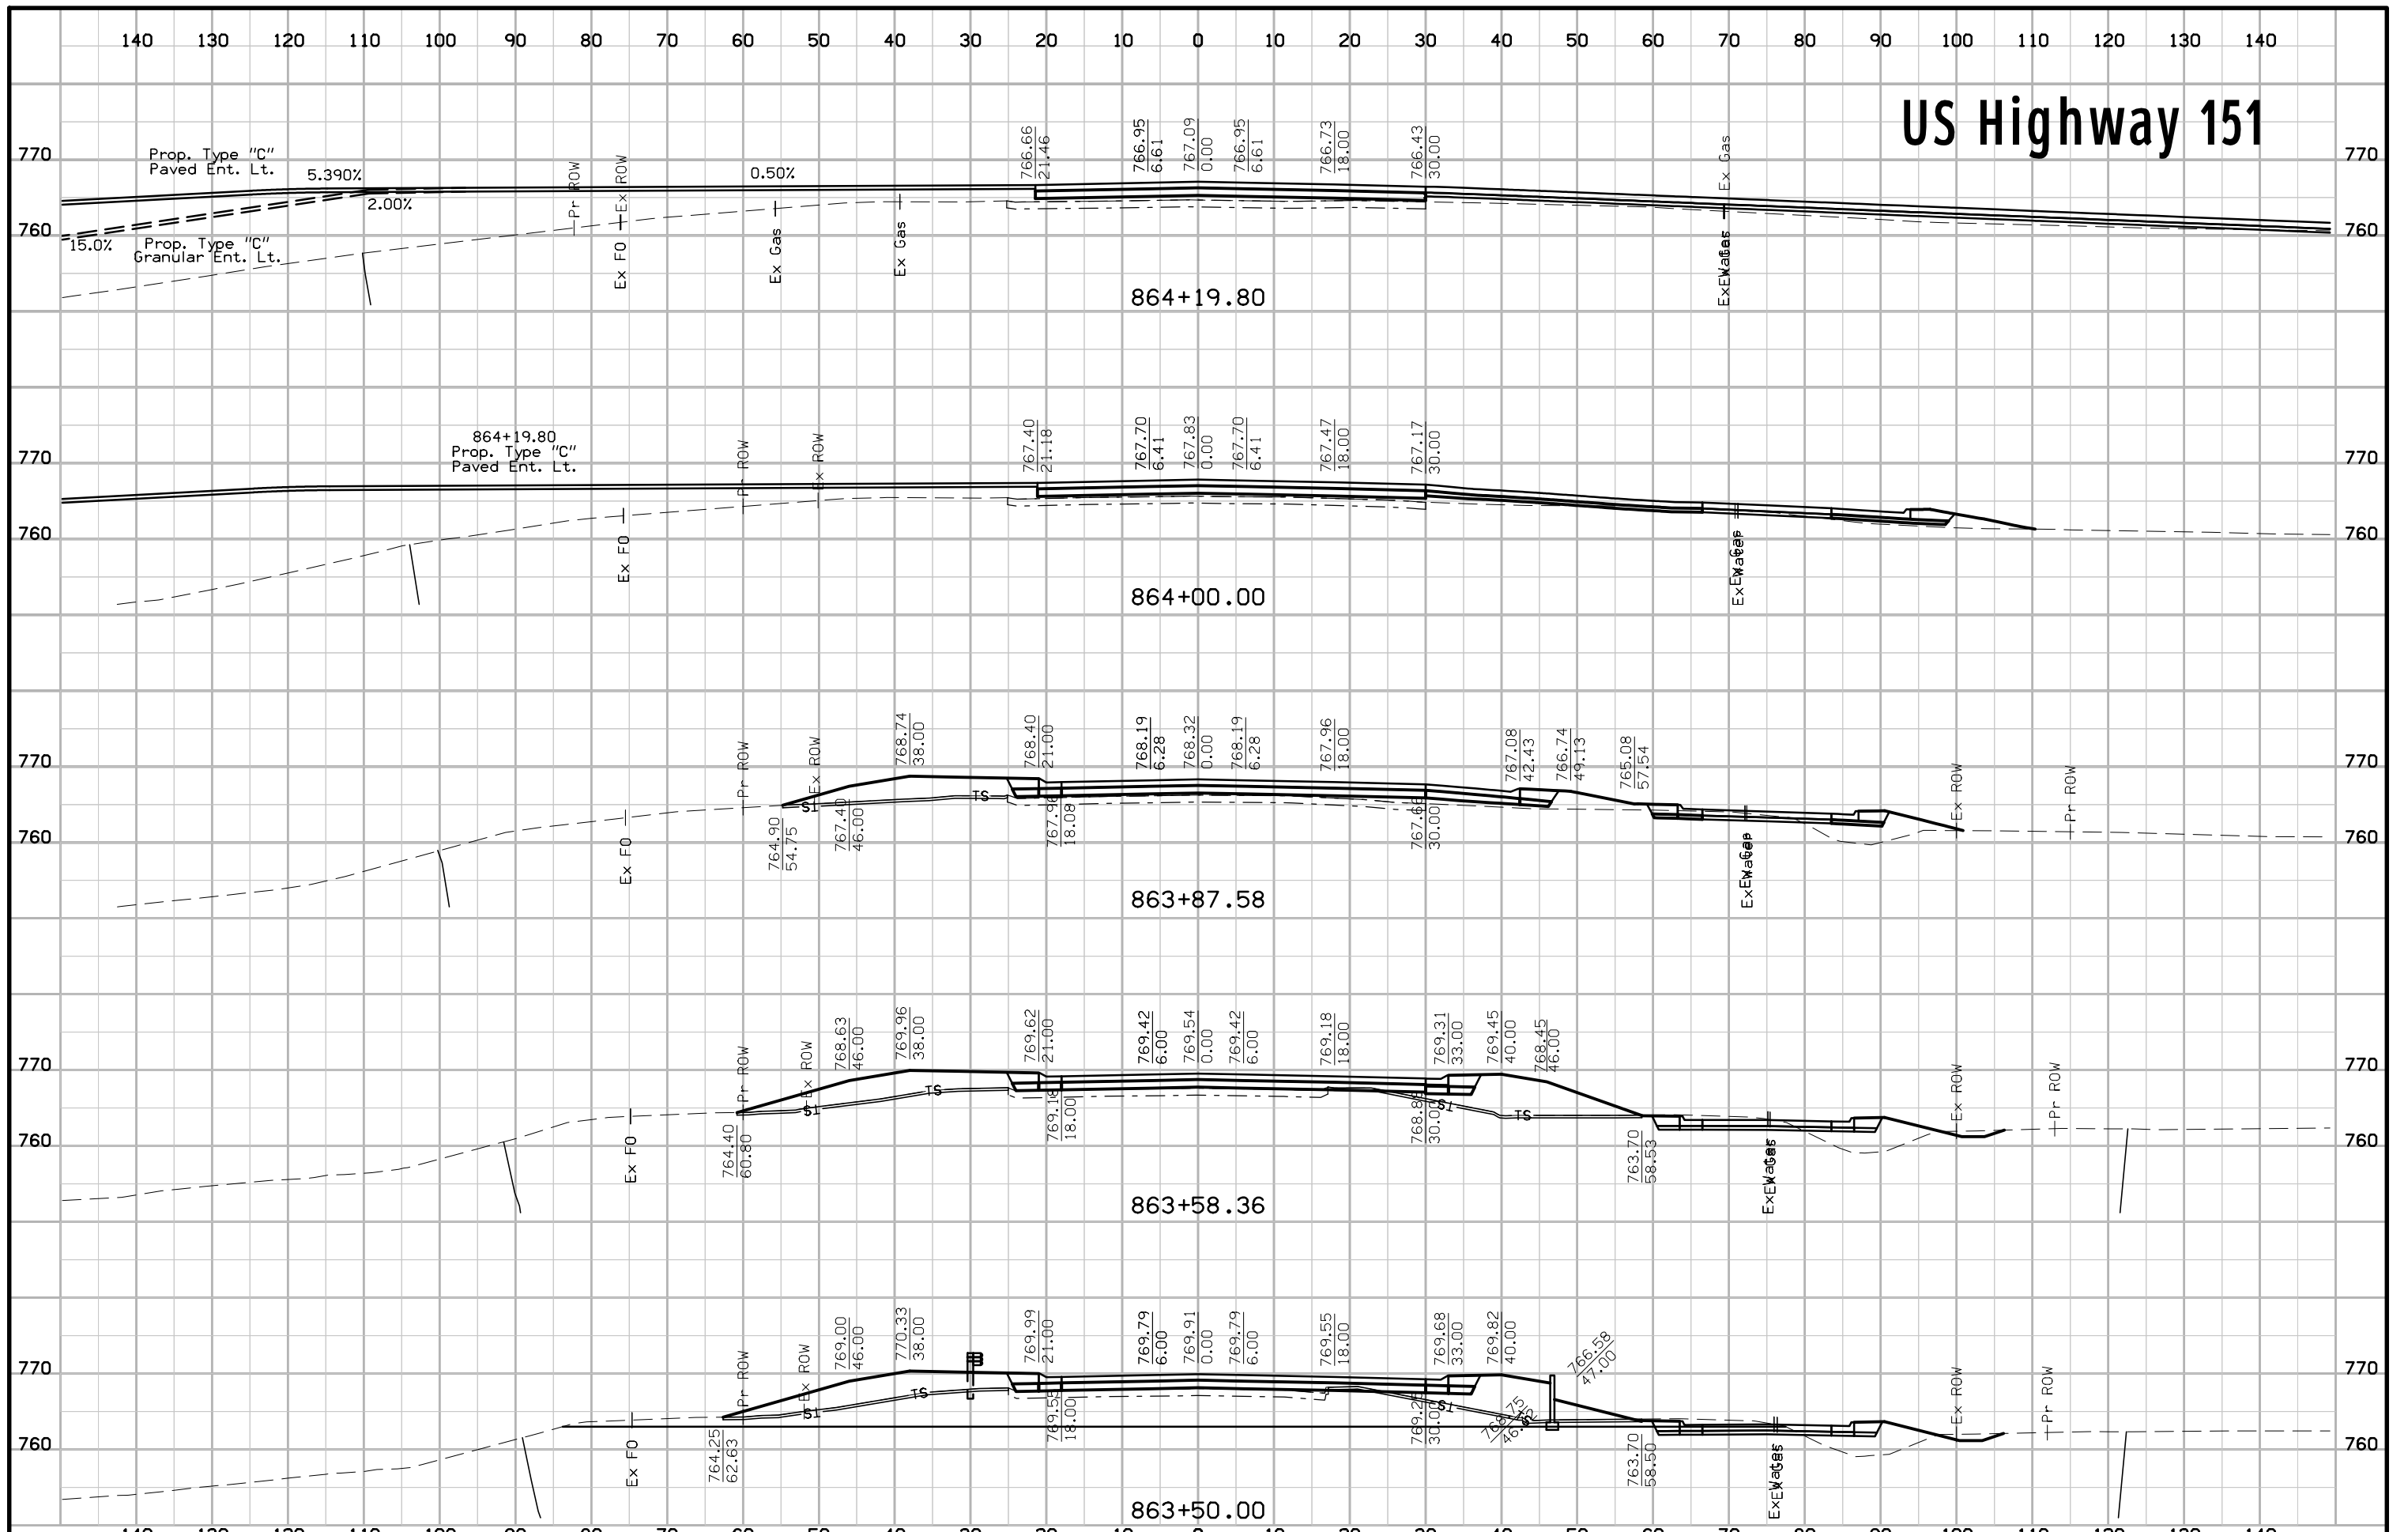


US Highway 151

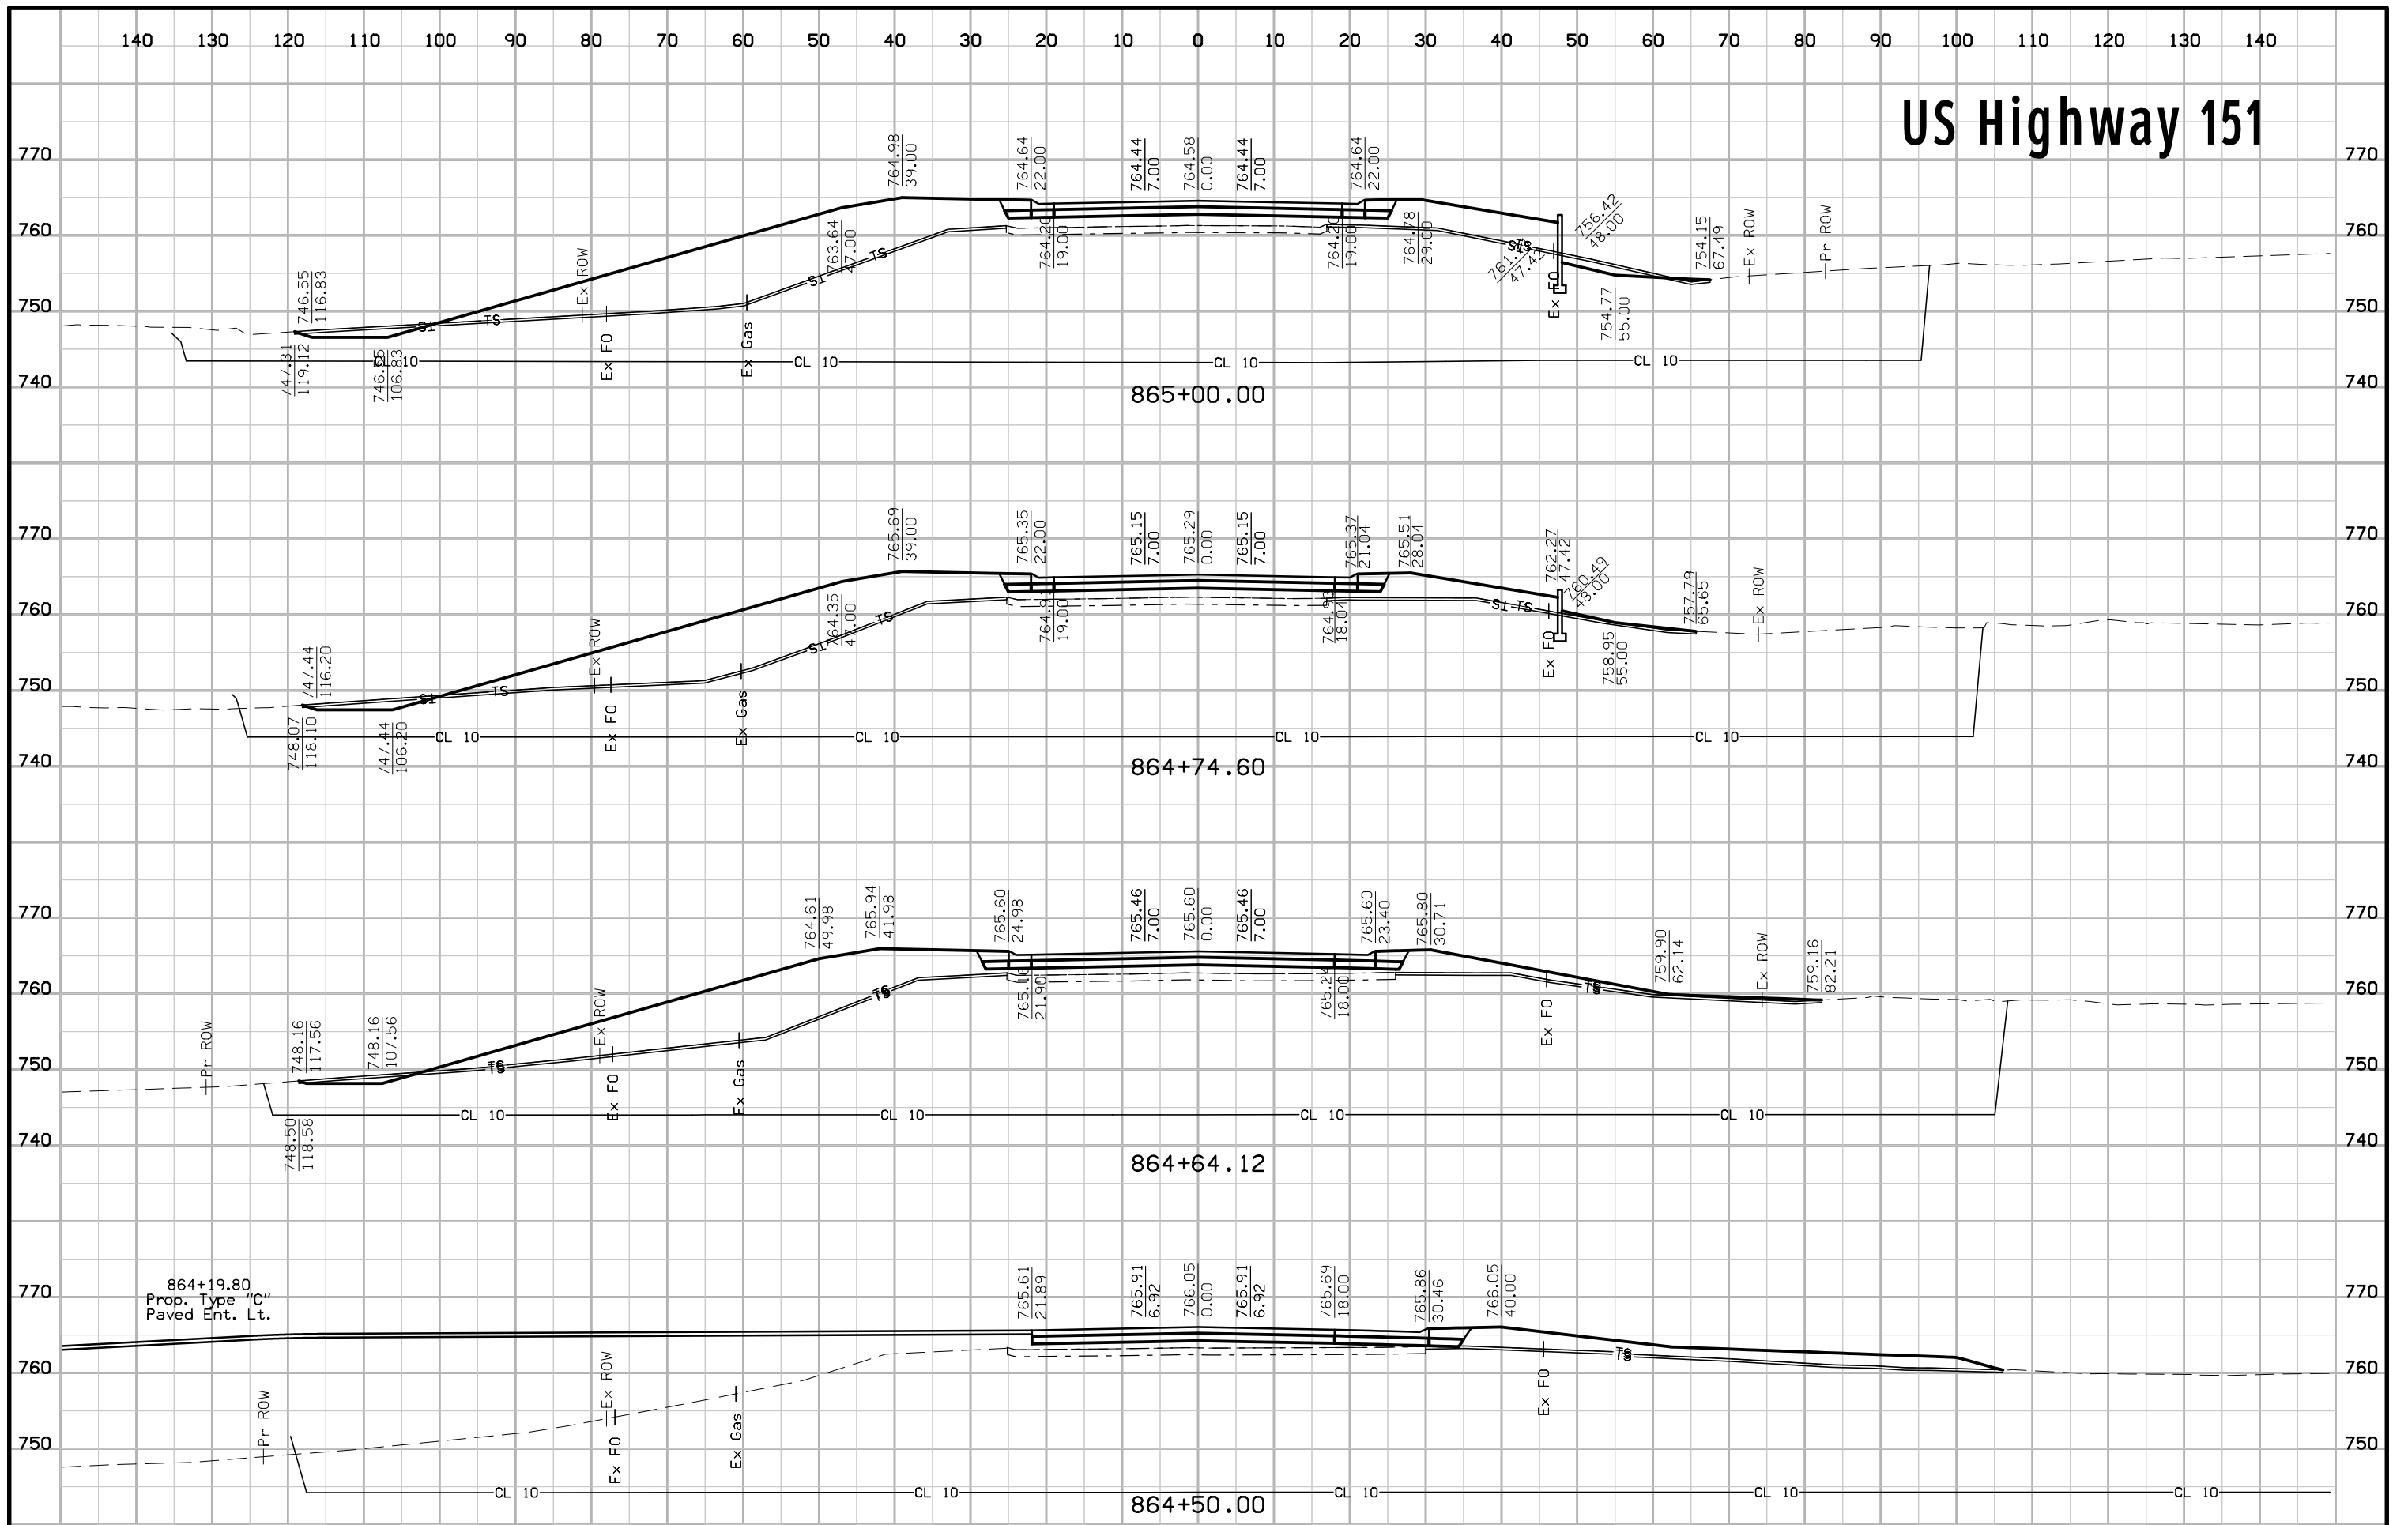

US Highway 151

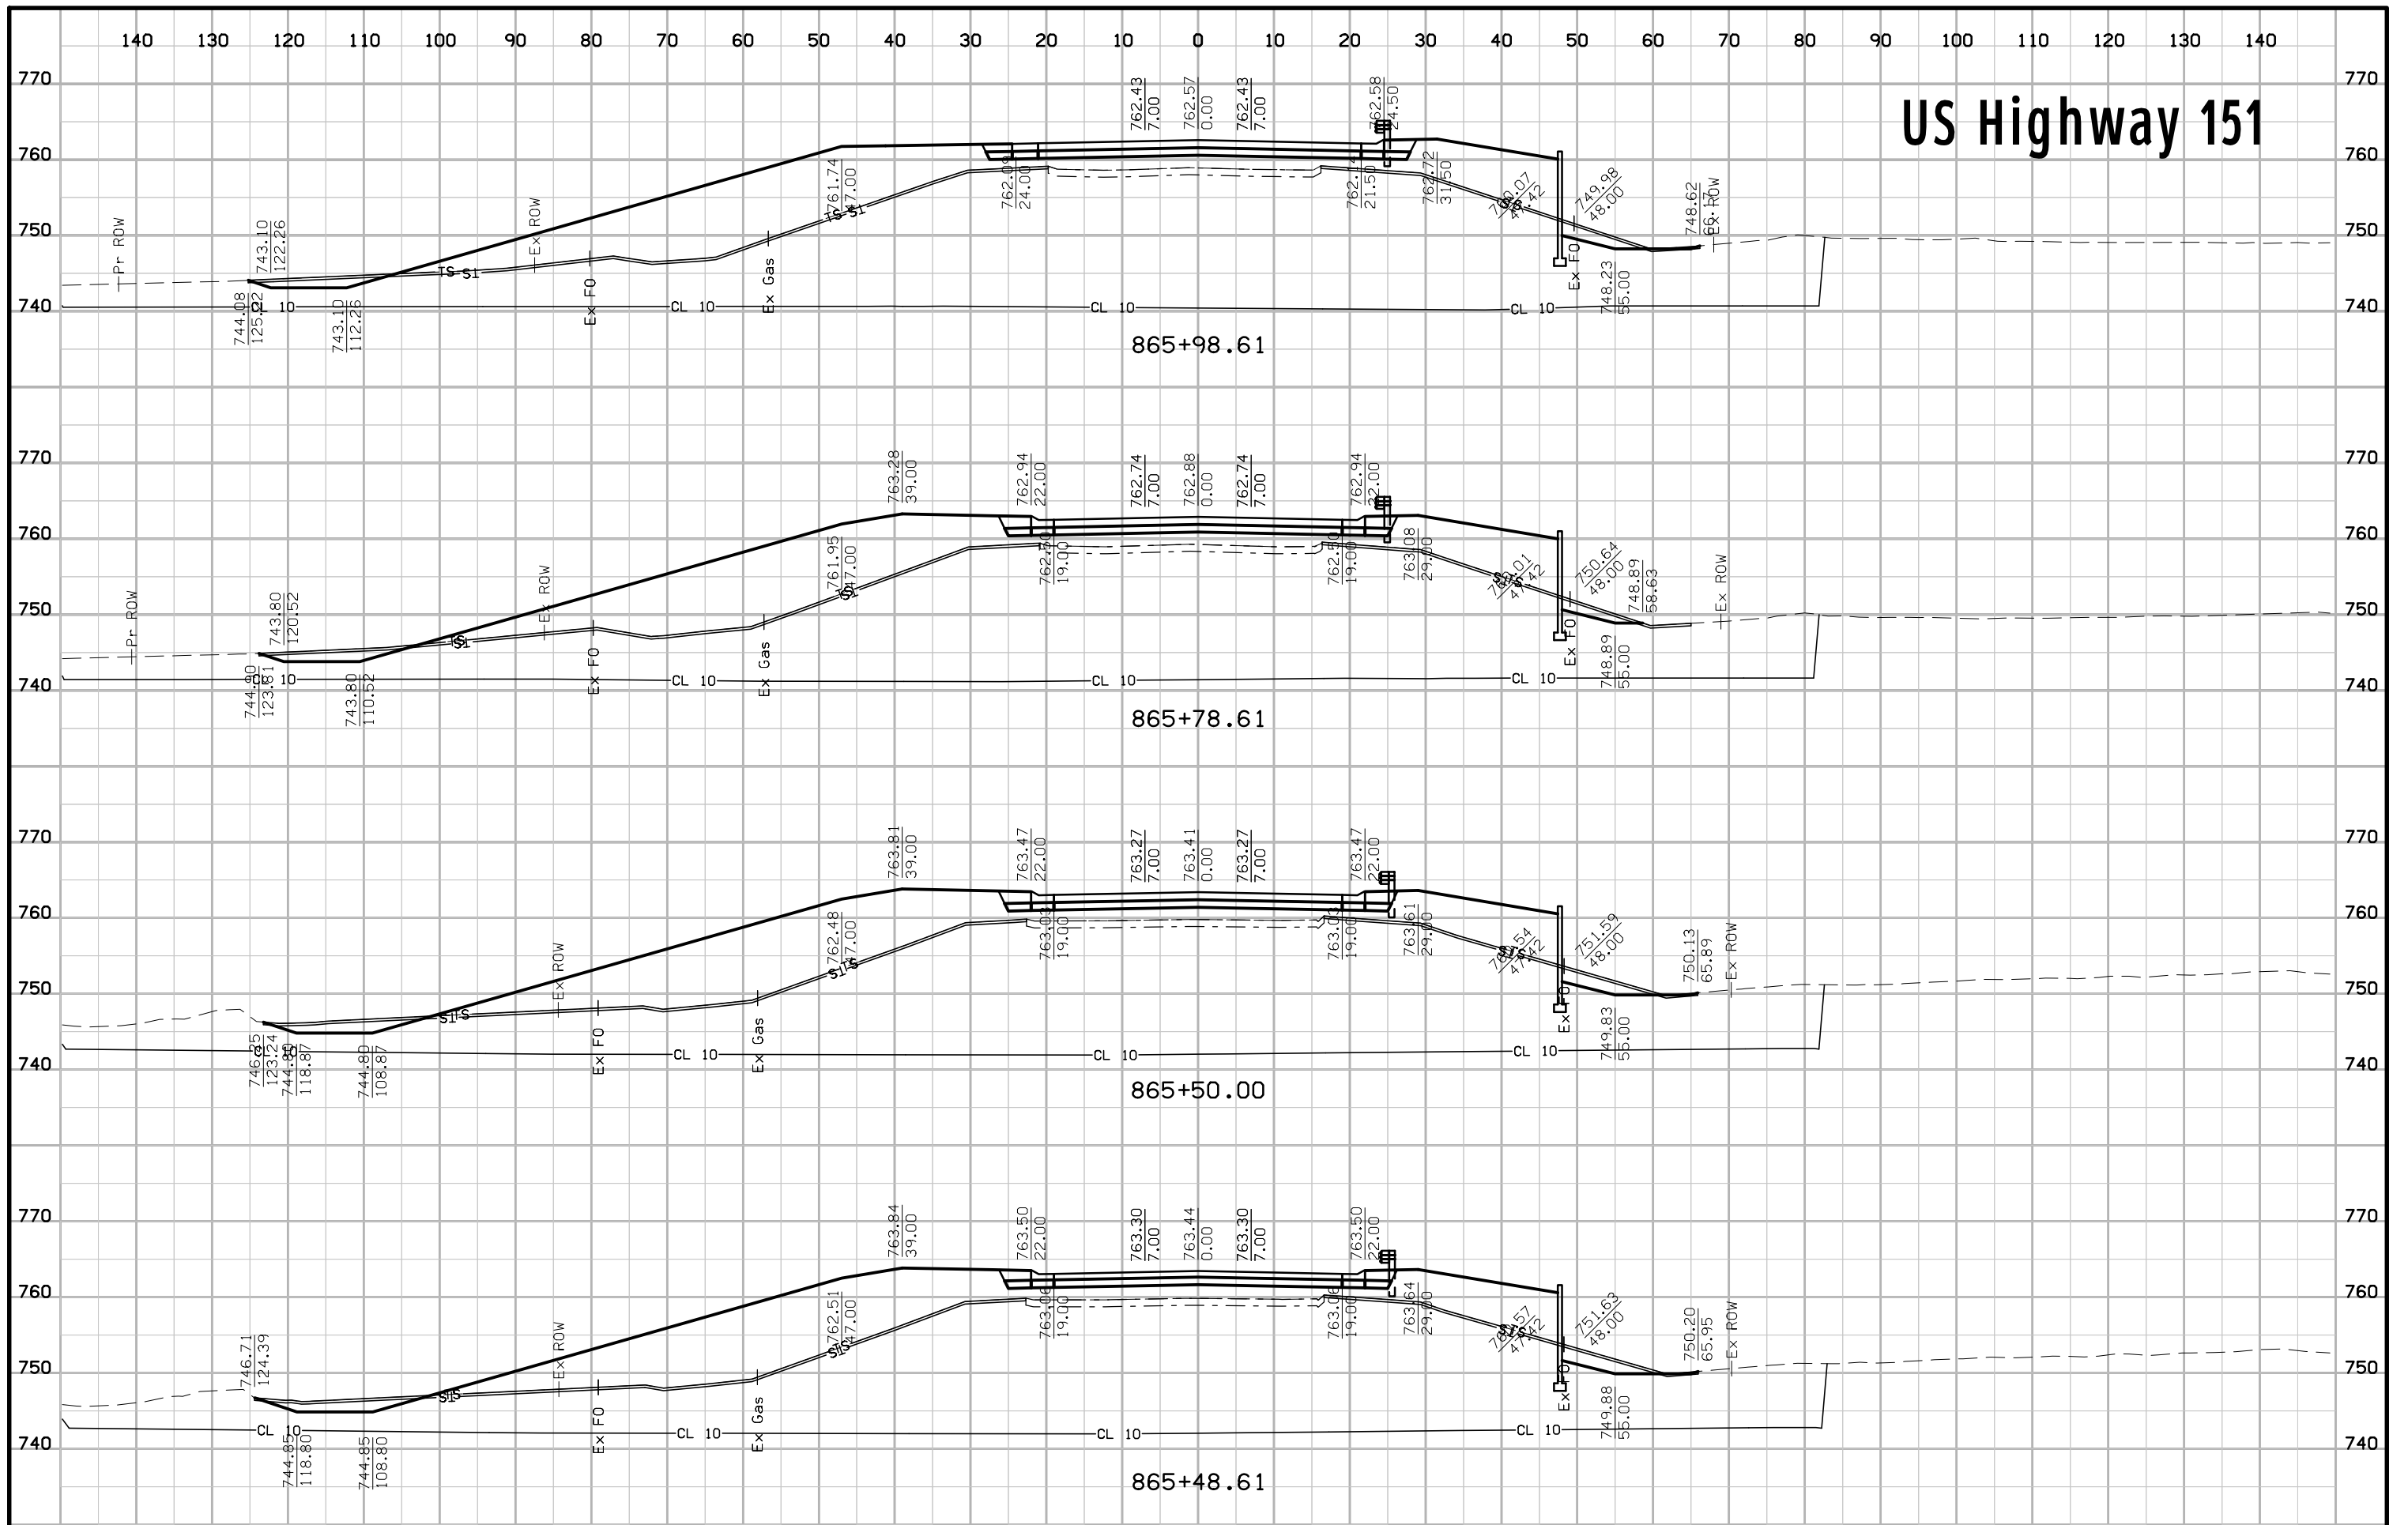


US Highway 151

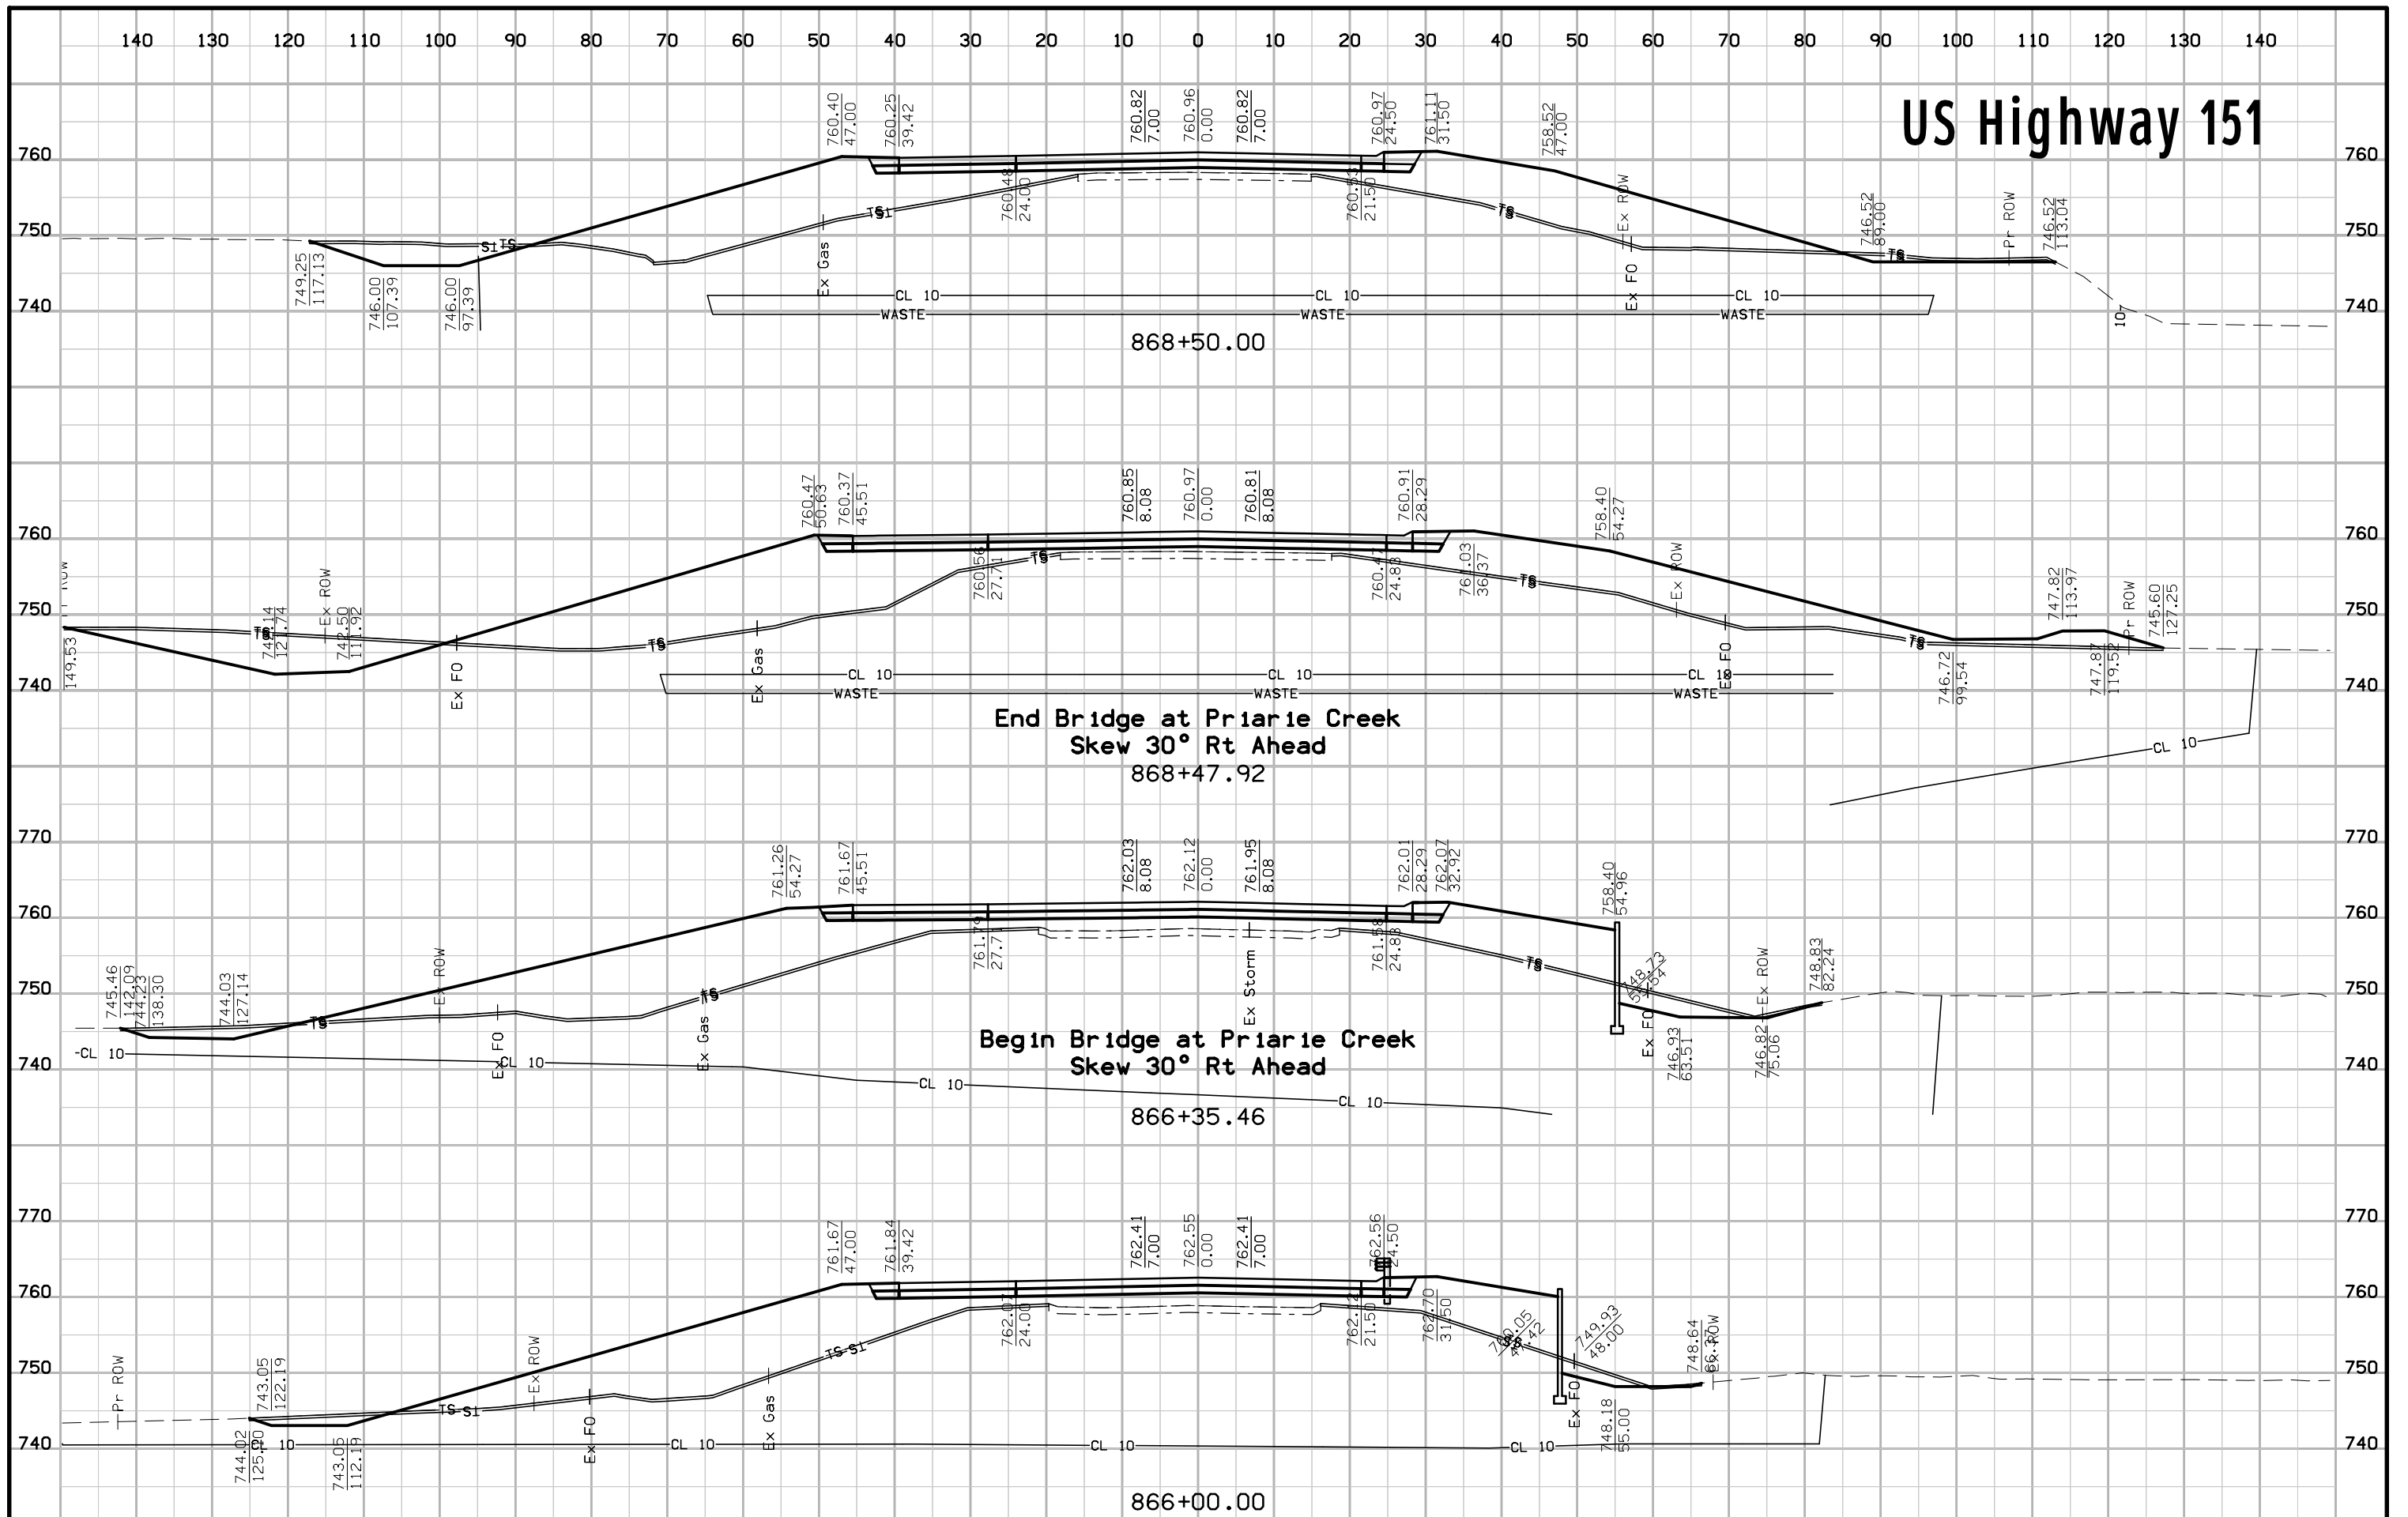


**End Bridge at Prairie Creek
Skew 30° Rt Ahead
868+47.92**

**Begin Bridge at Prairie Creek
Skew 30° Rt Ahead
866+35.46**


US Highway 151

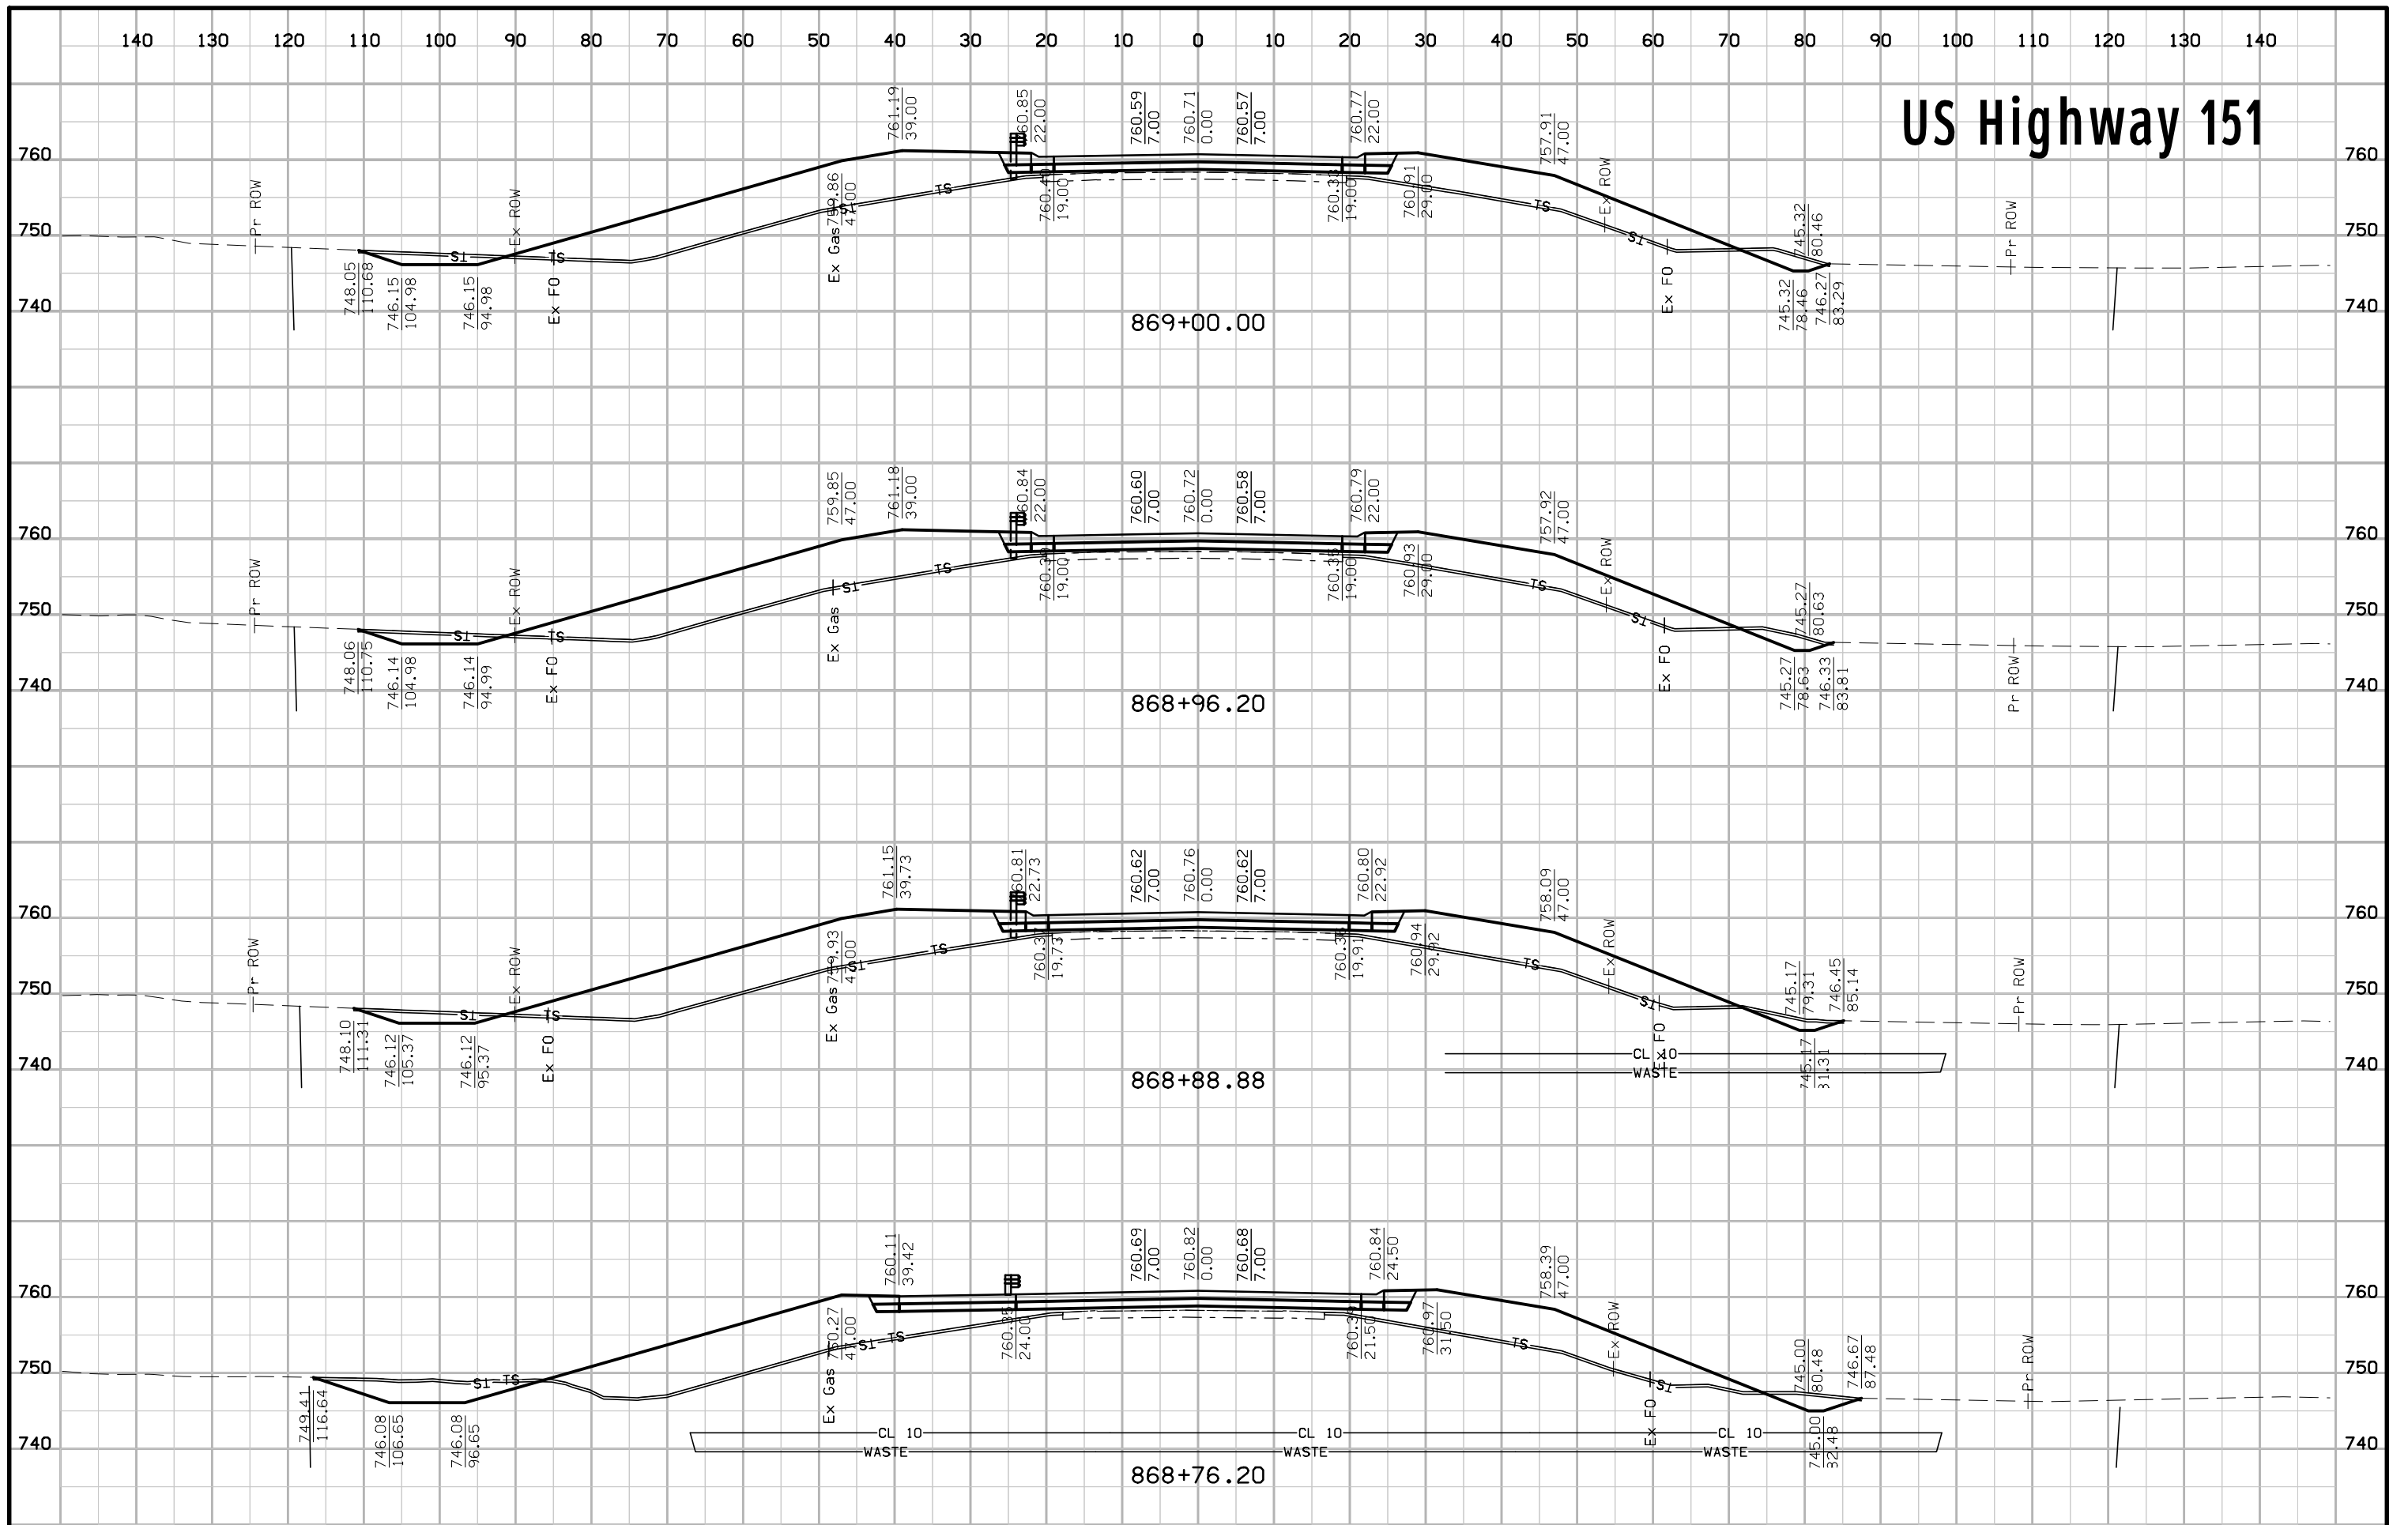


US Highway 151

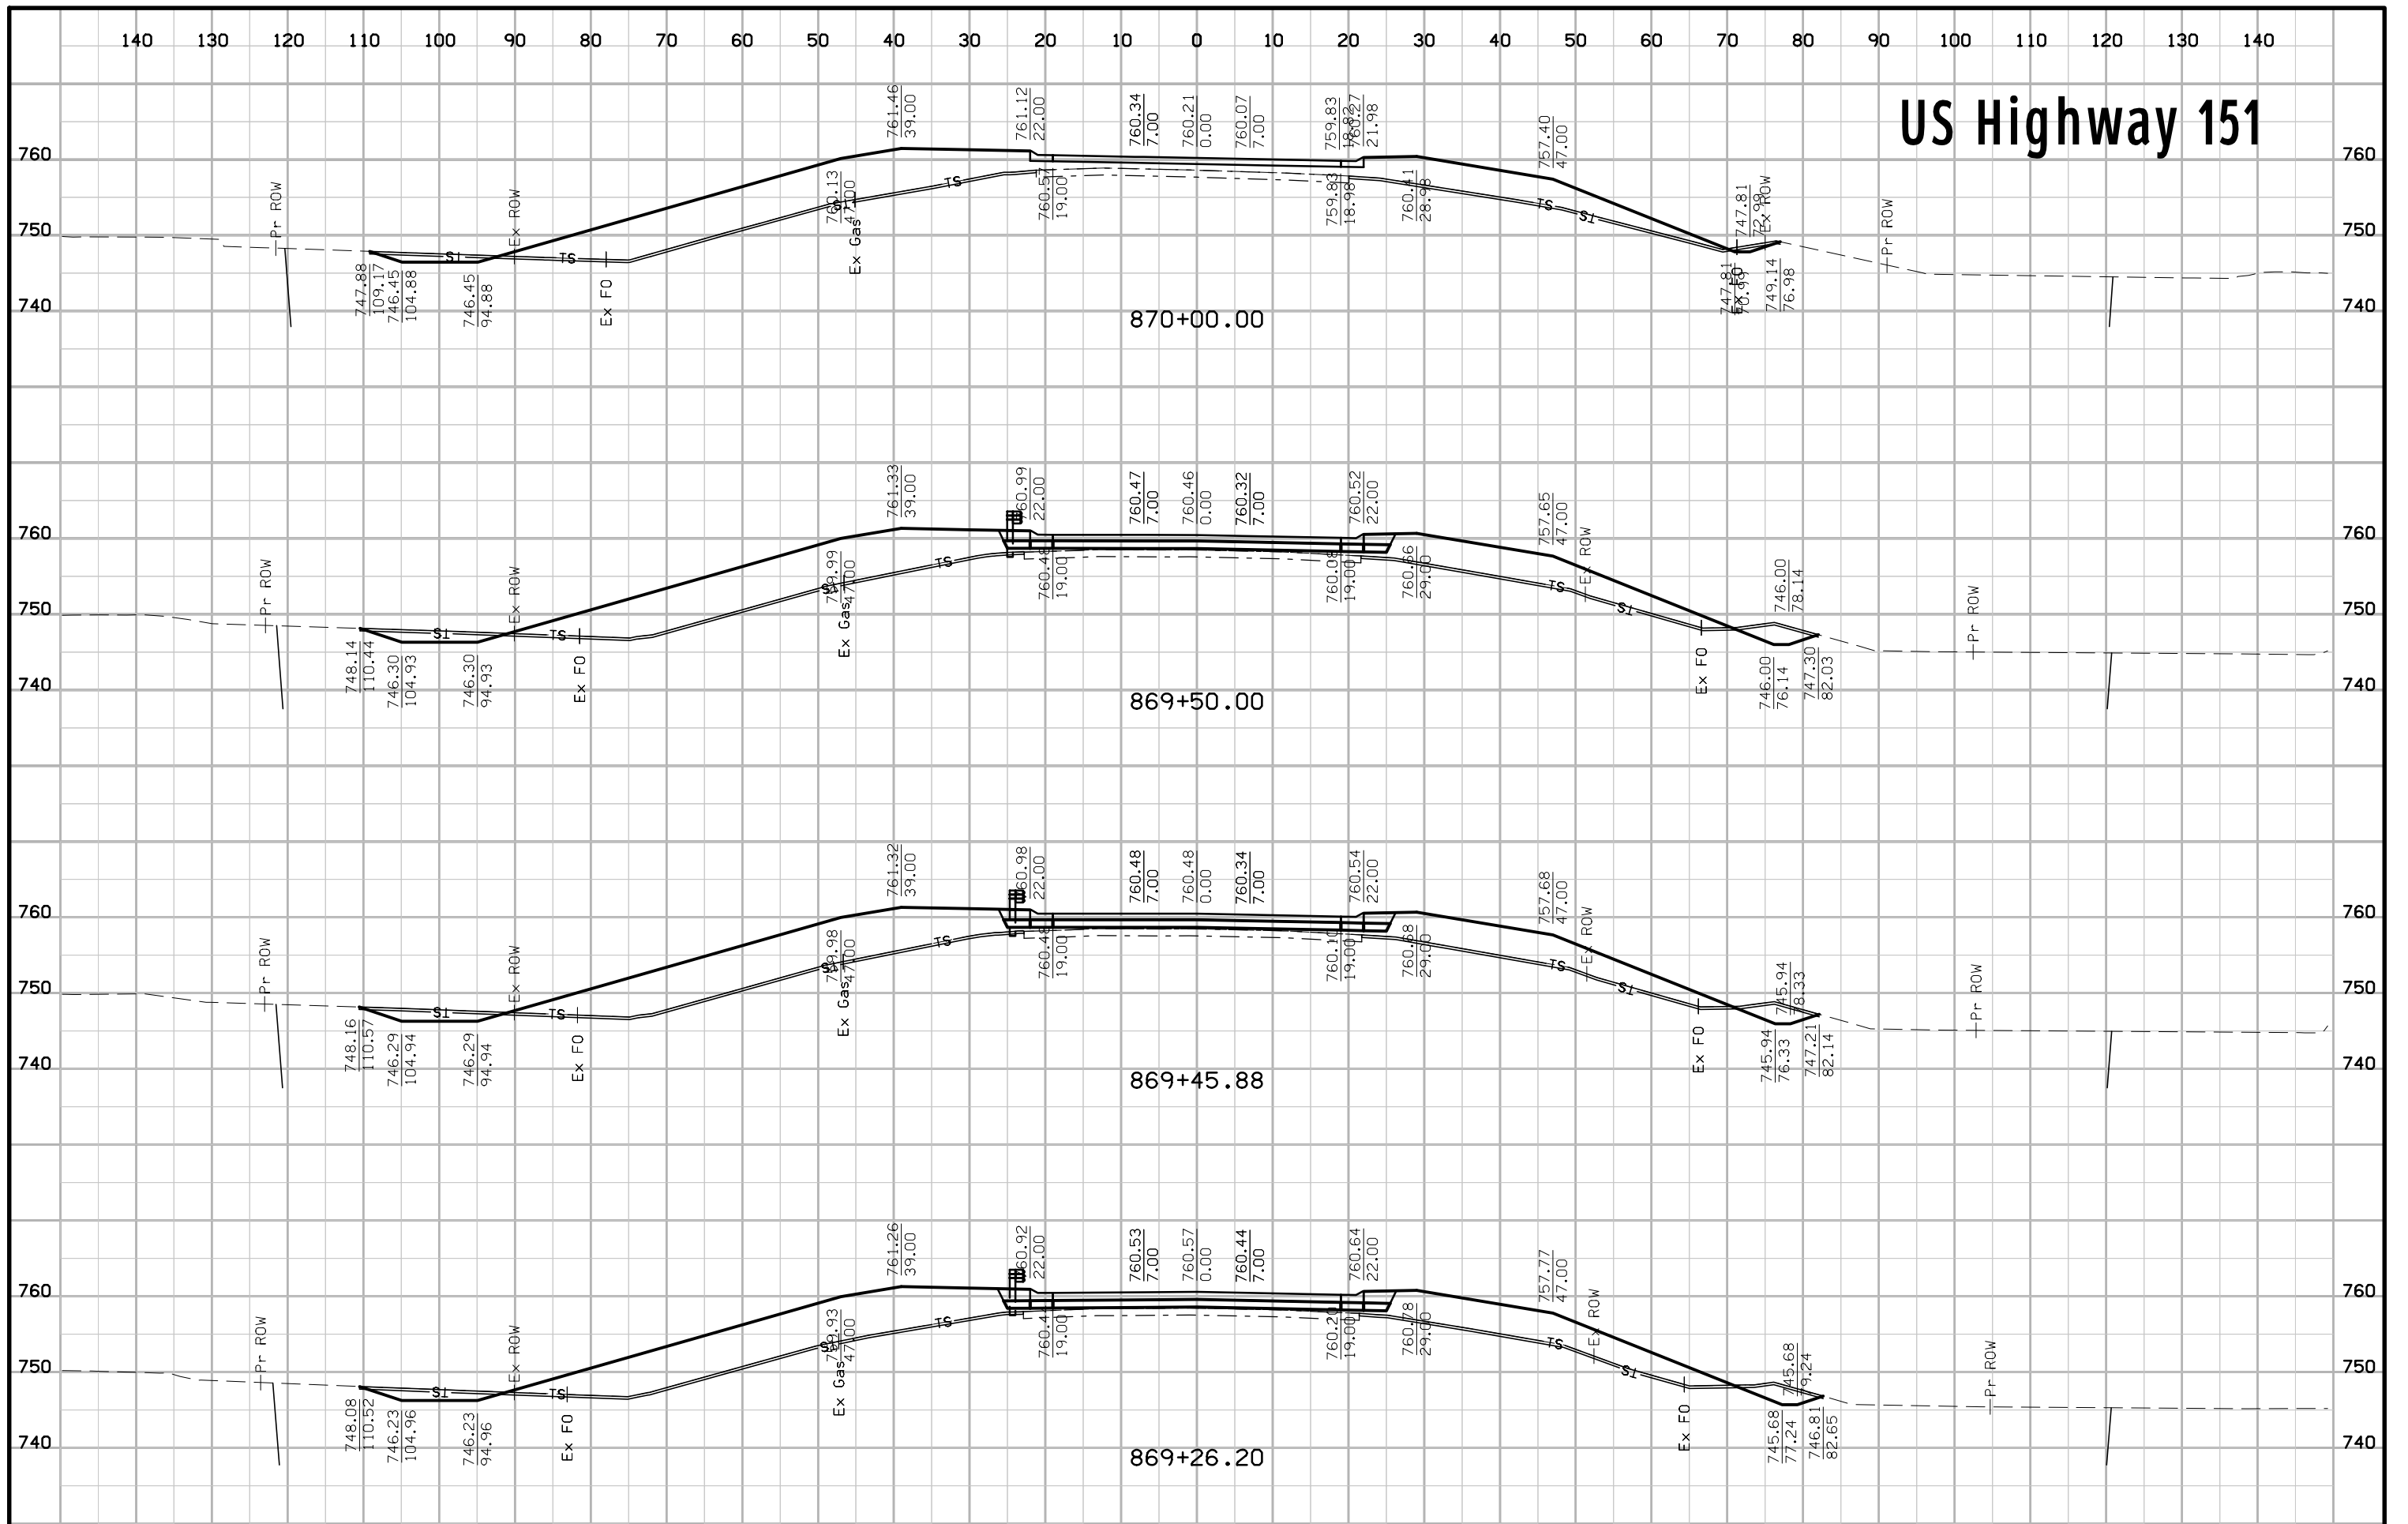


US Highway 151

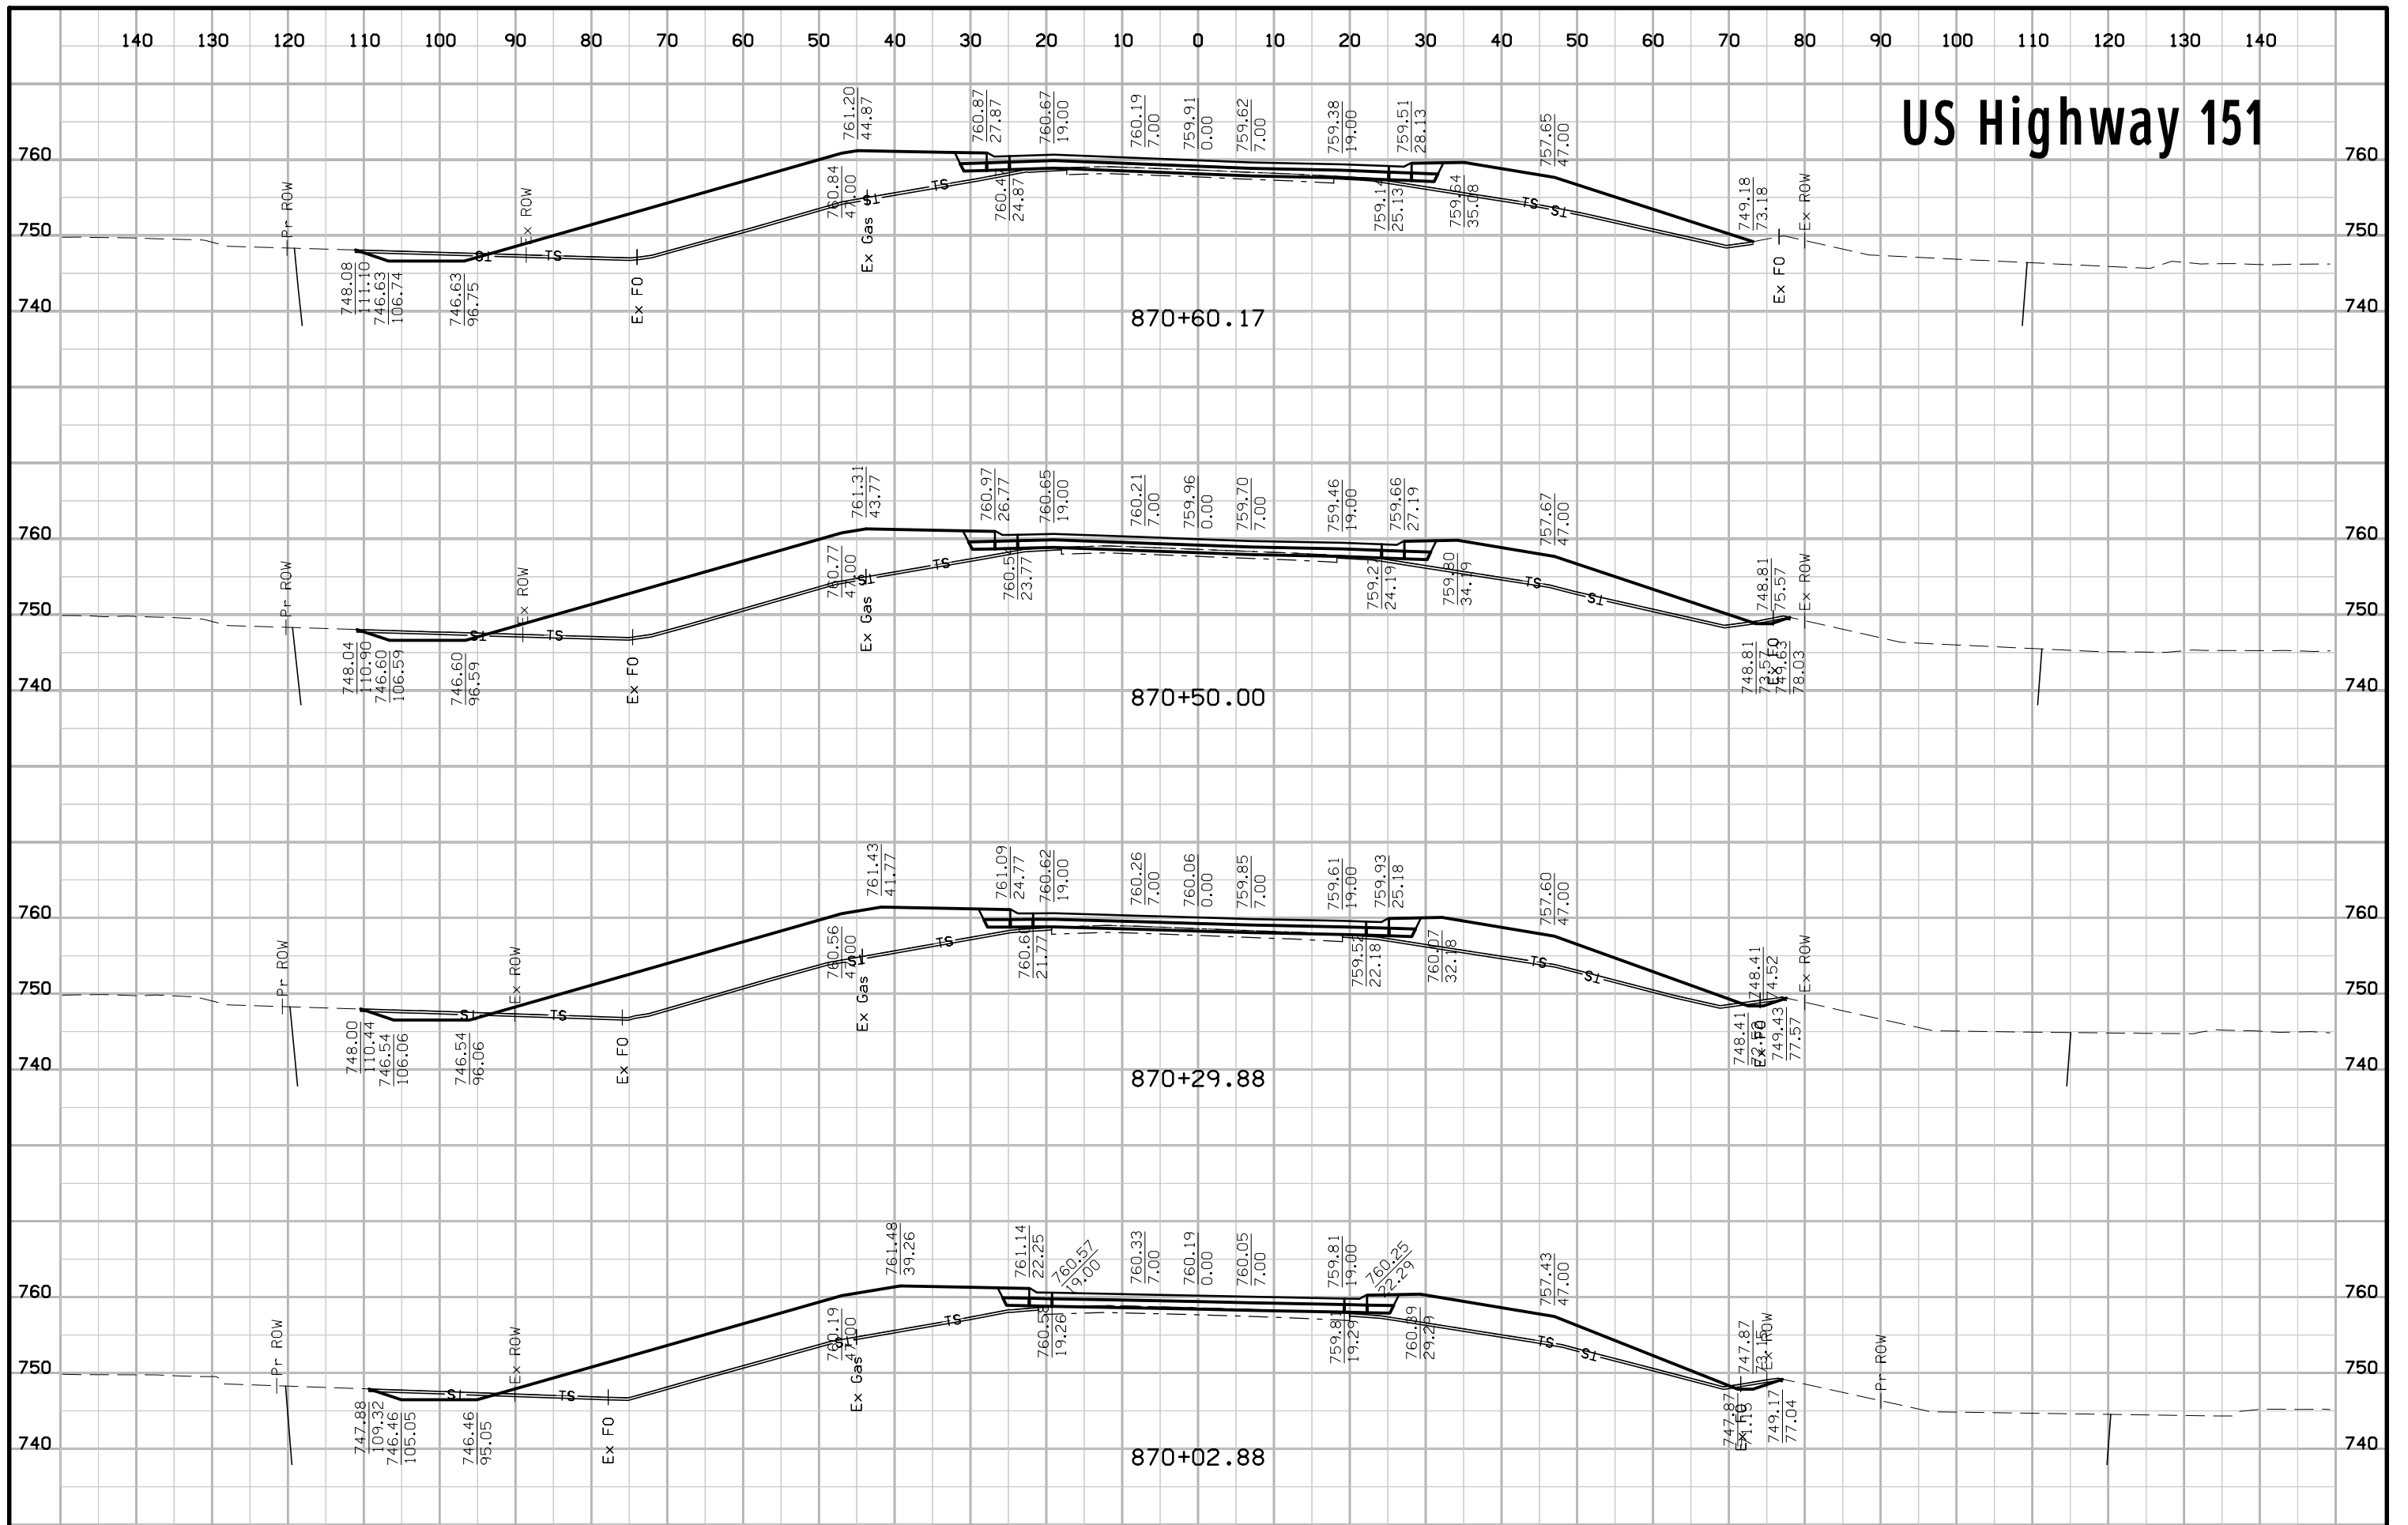


US Highway 151

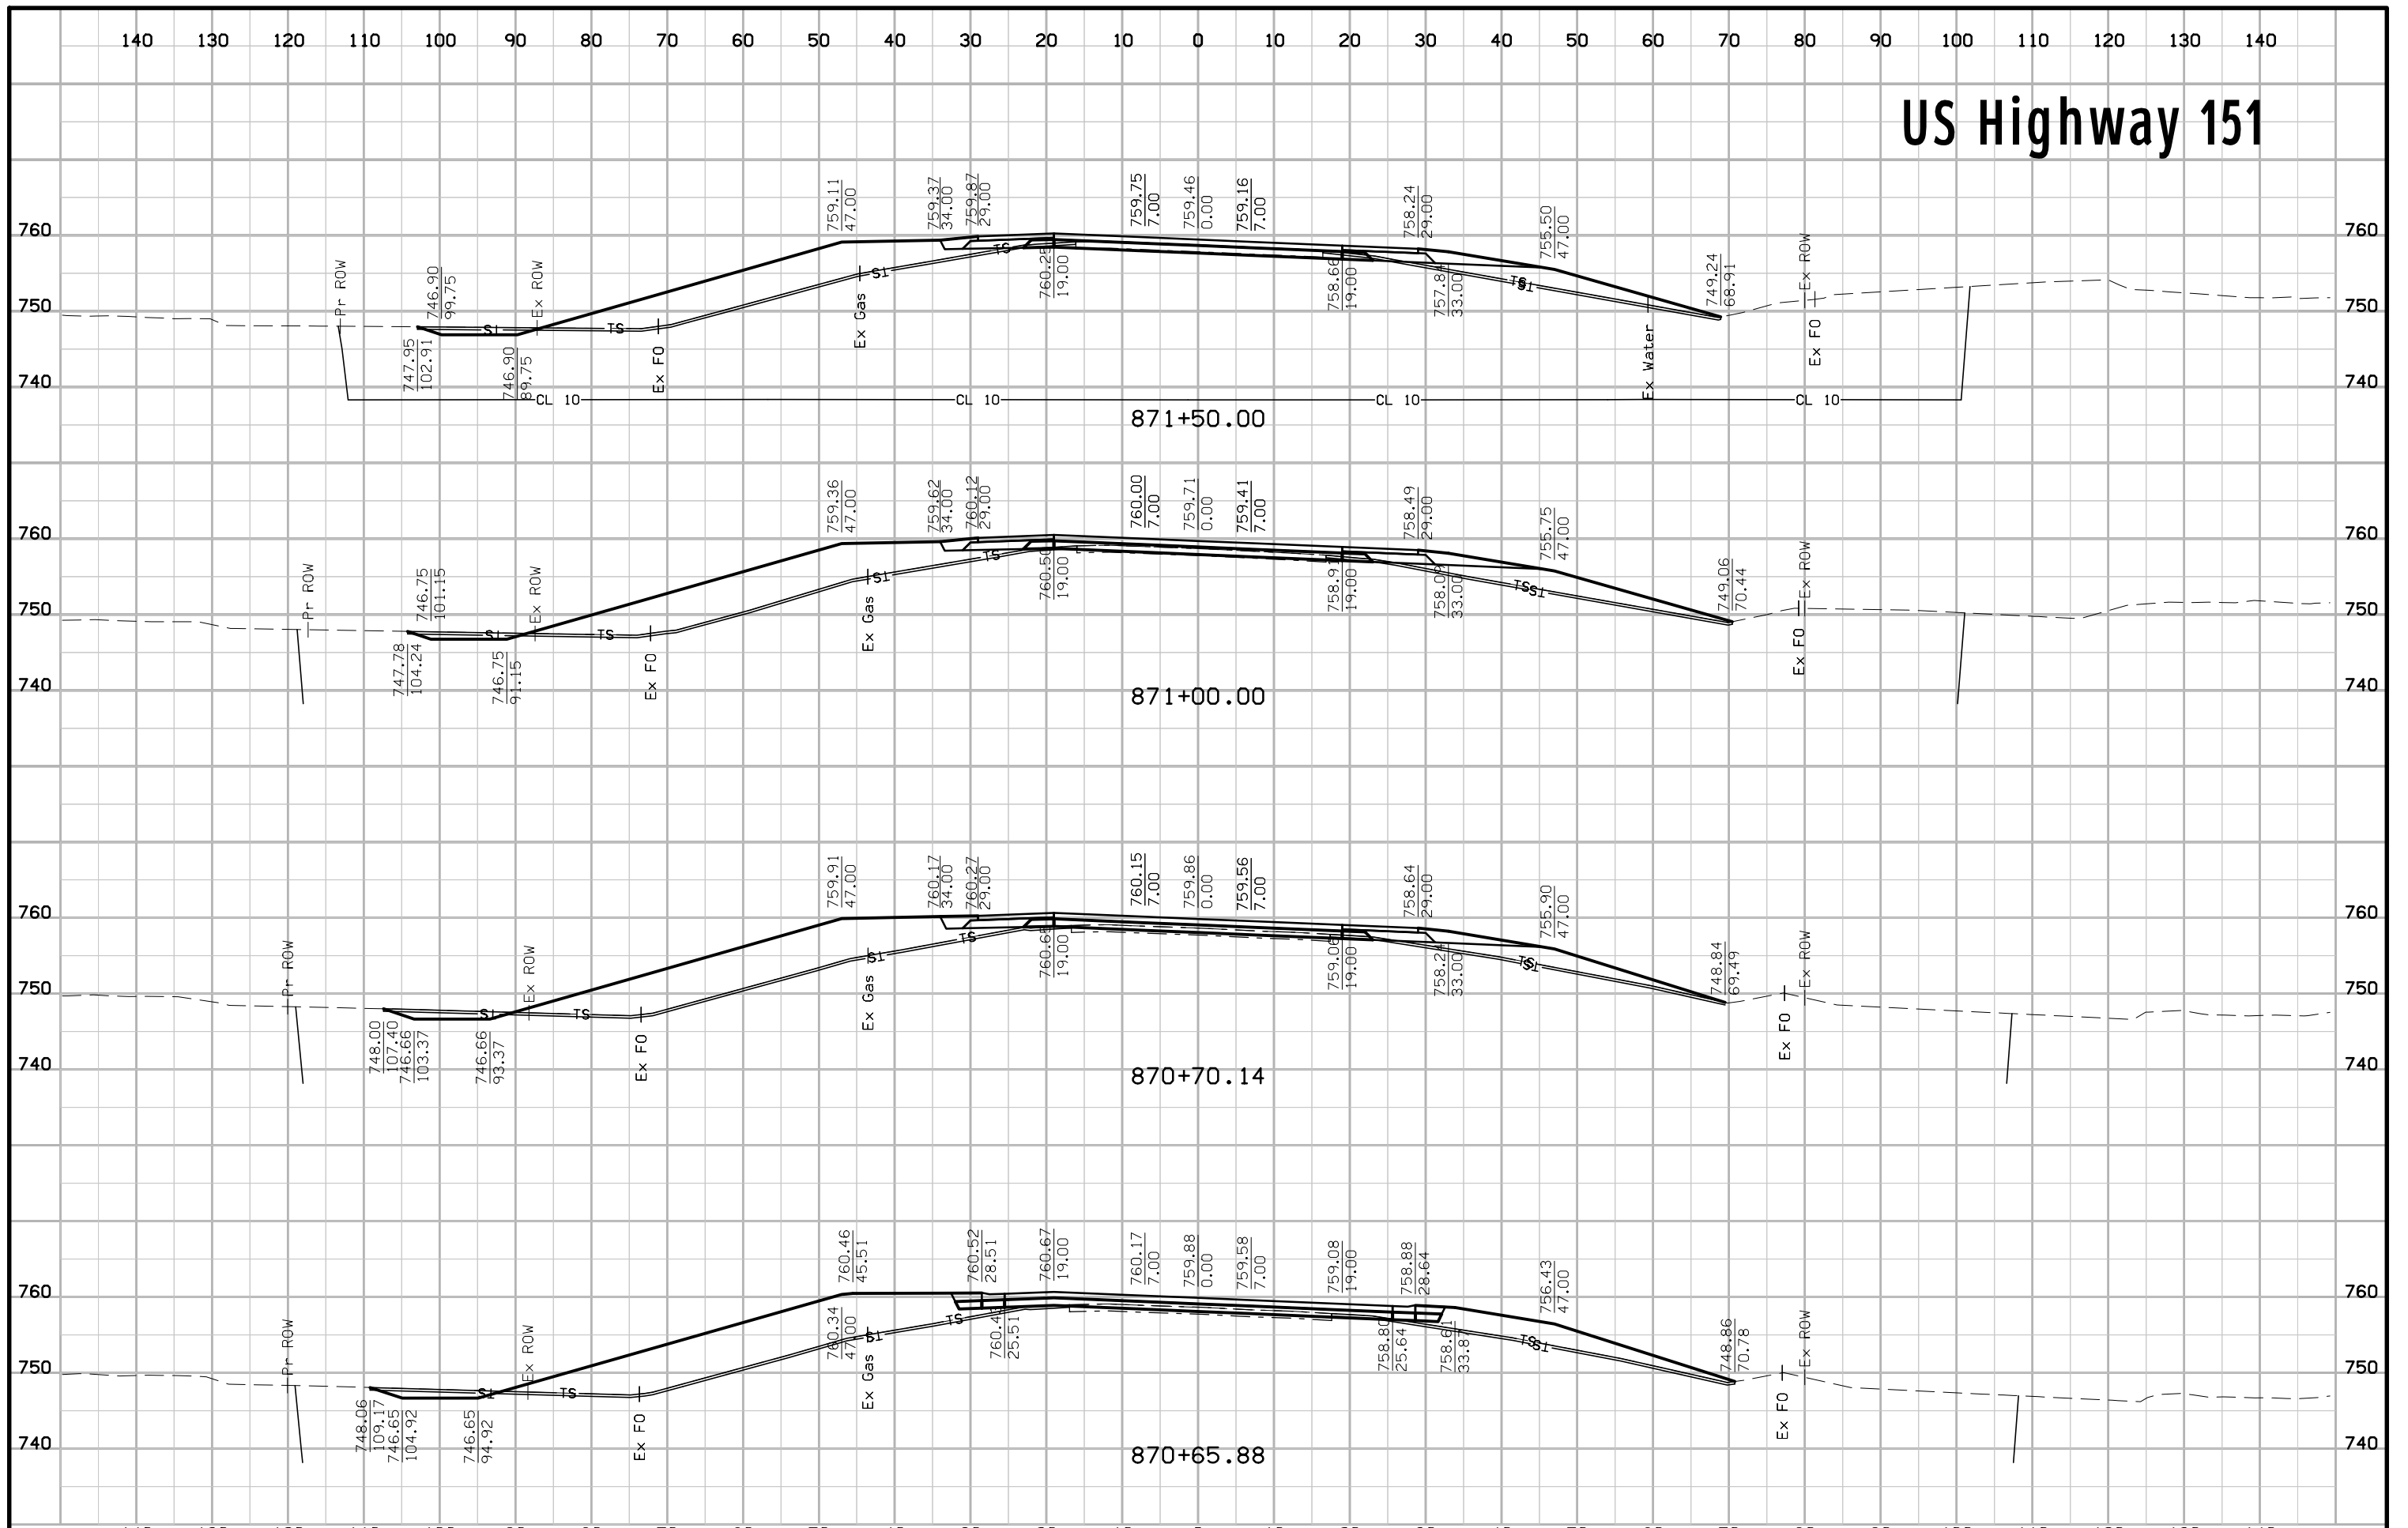


US Highway 151

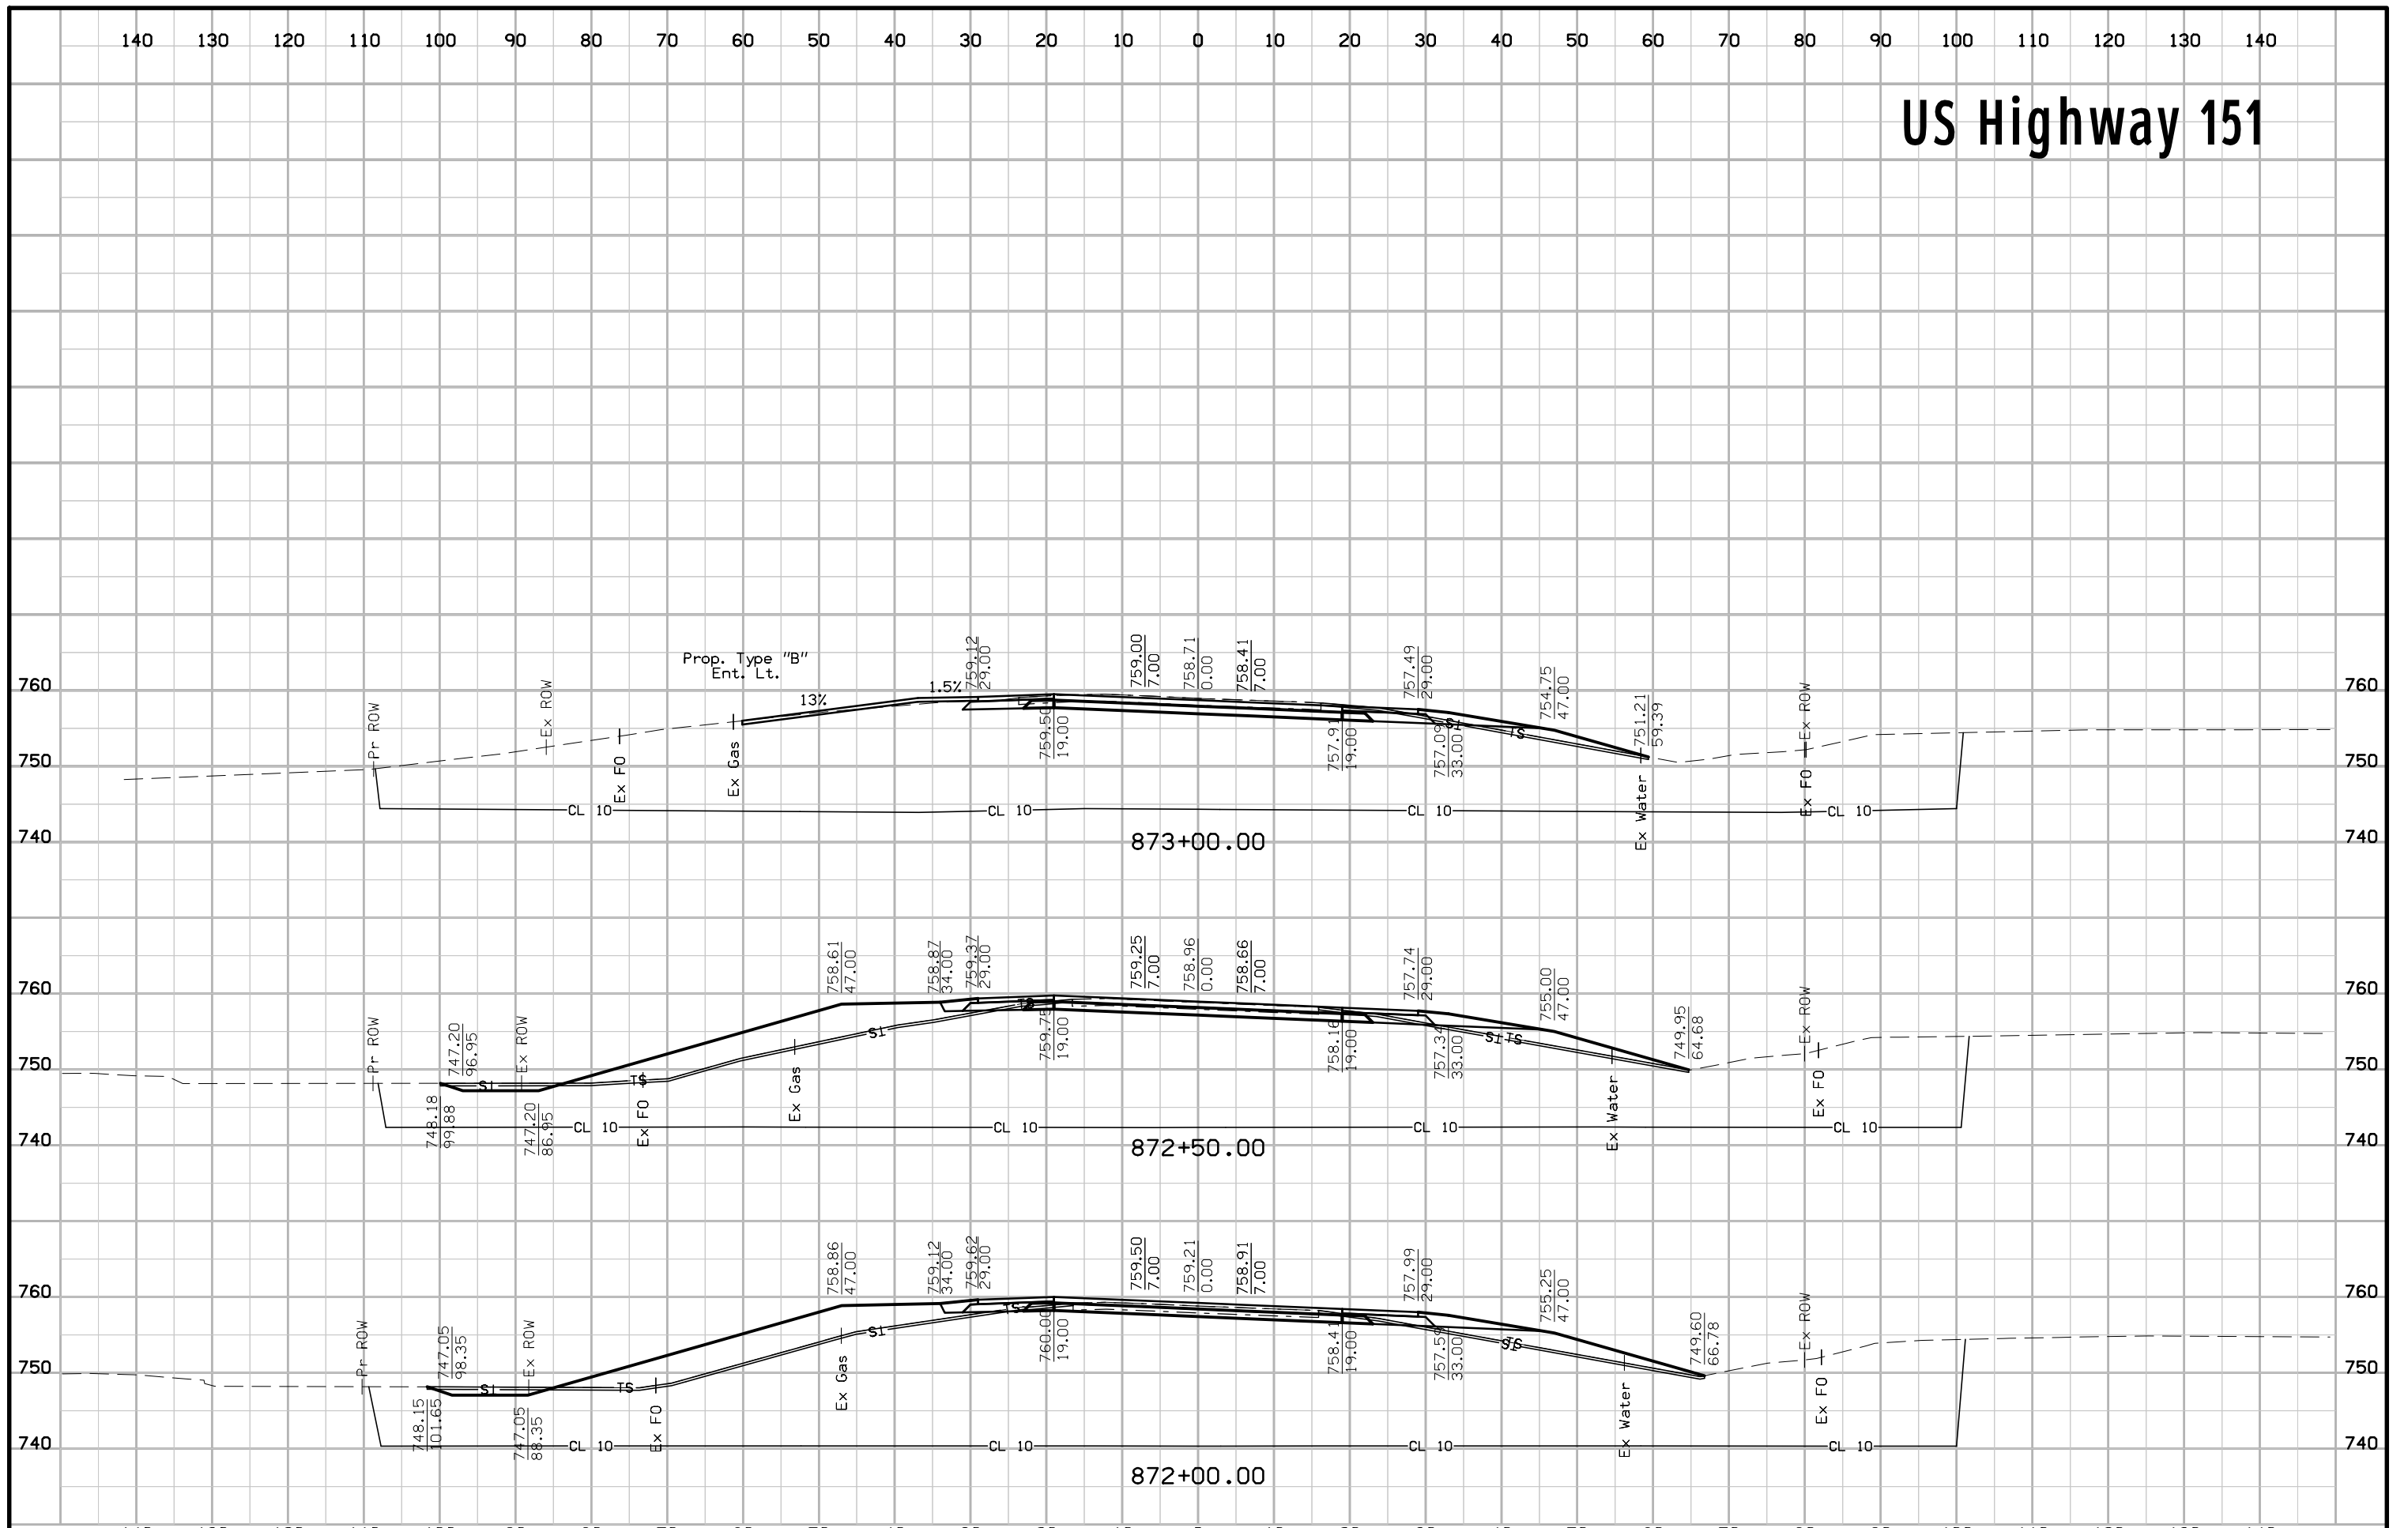


US Highway 151

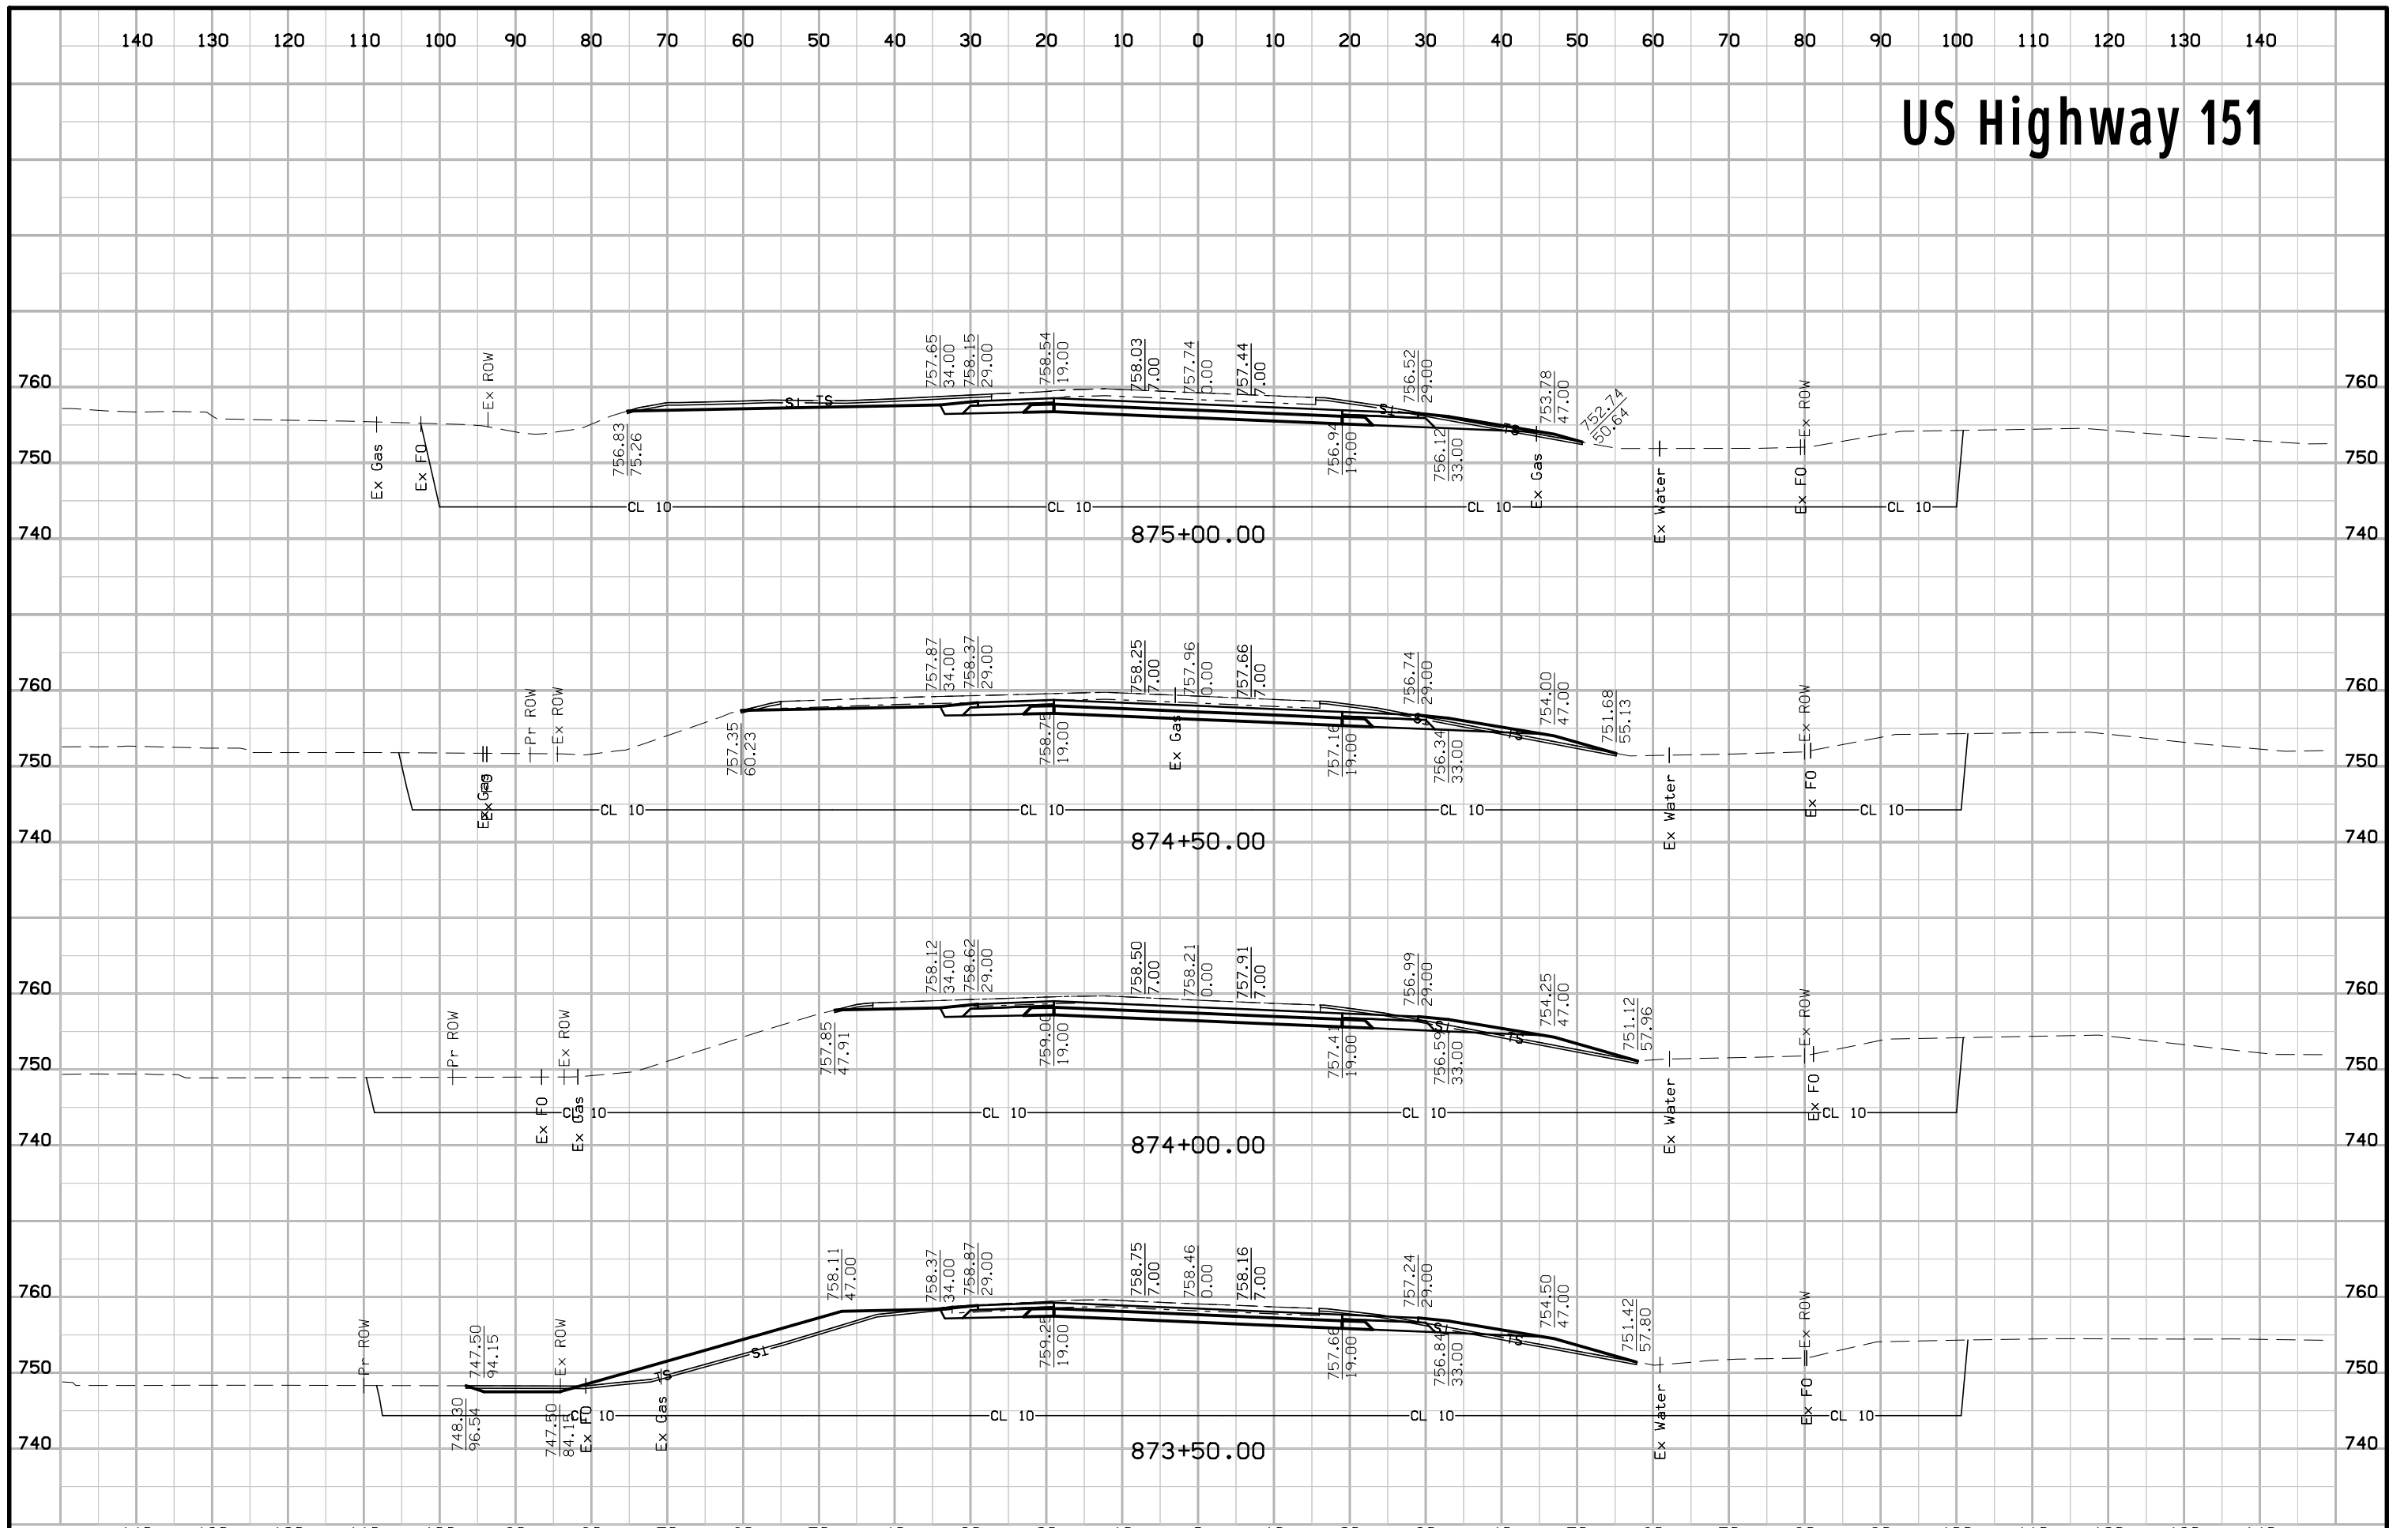


US Highway 151

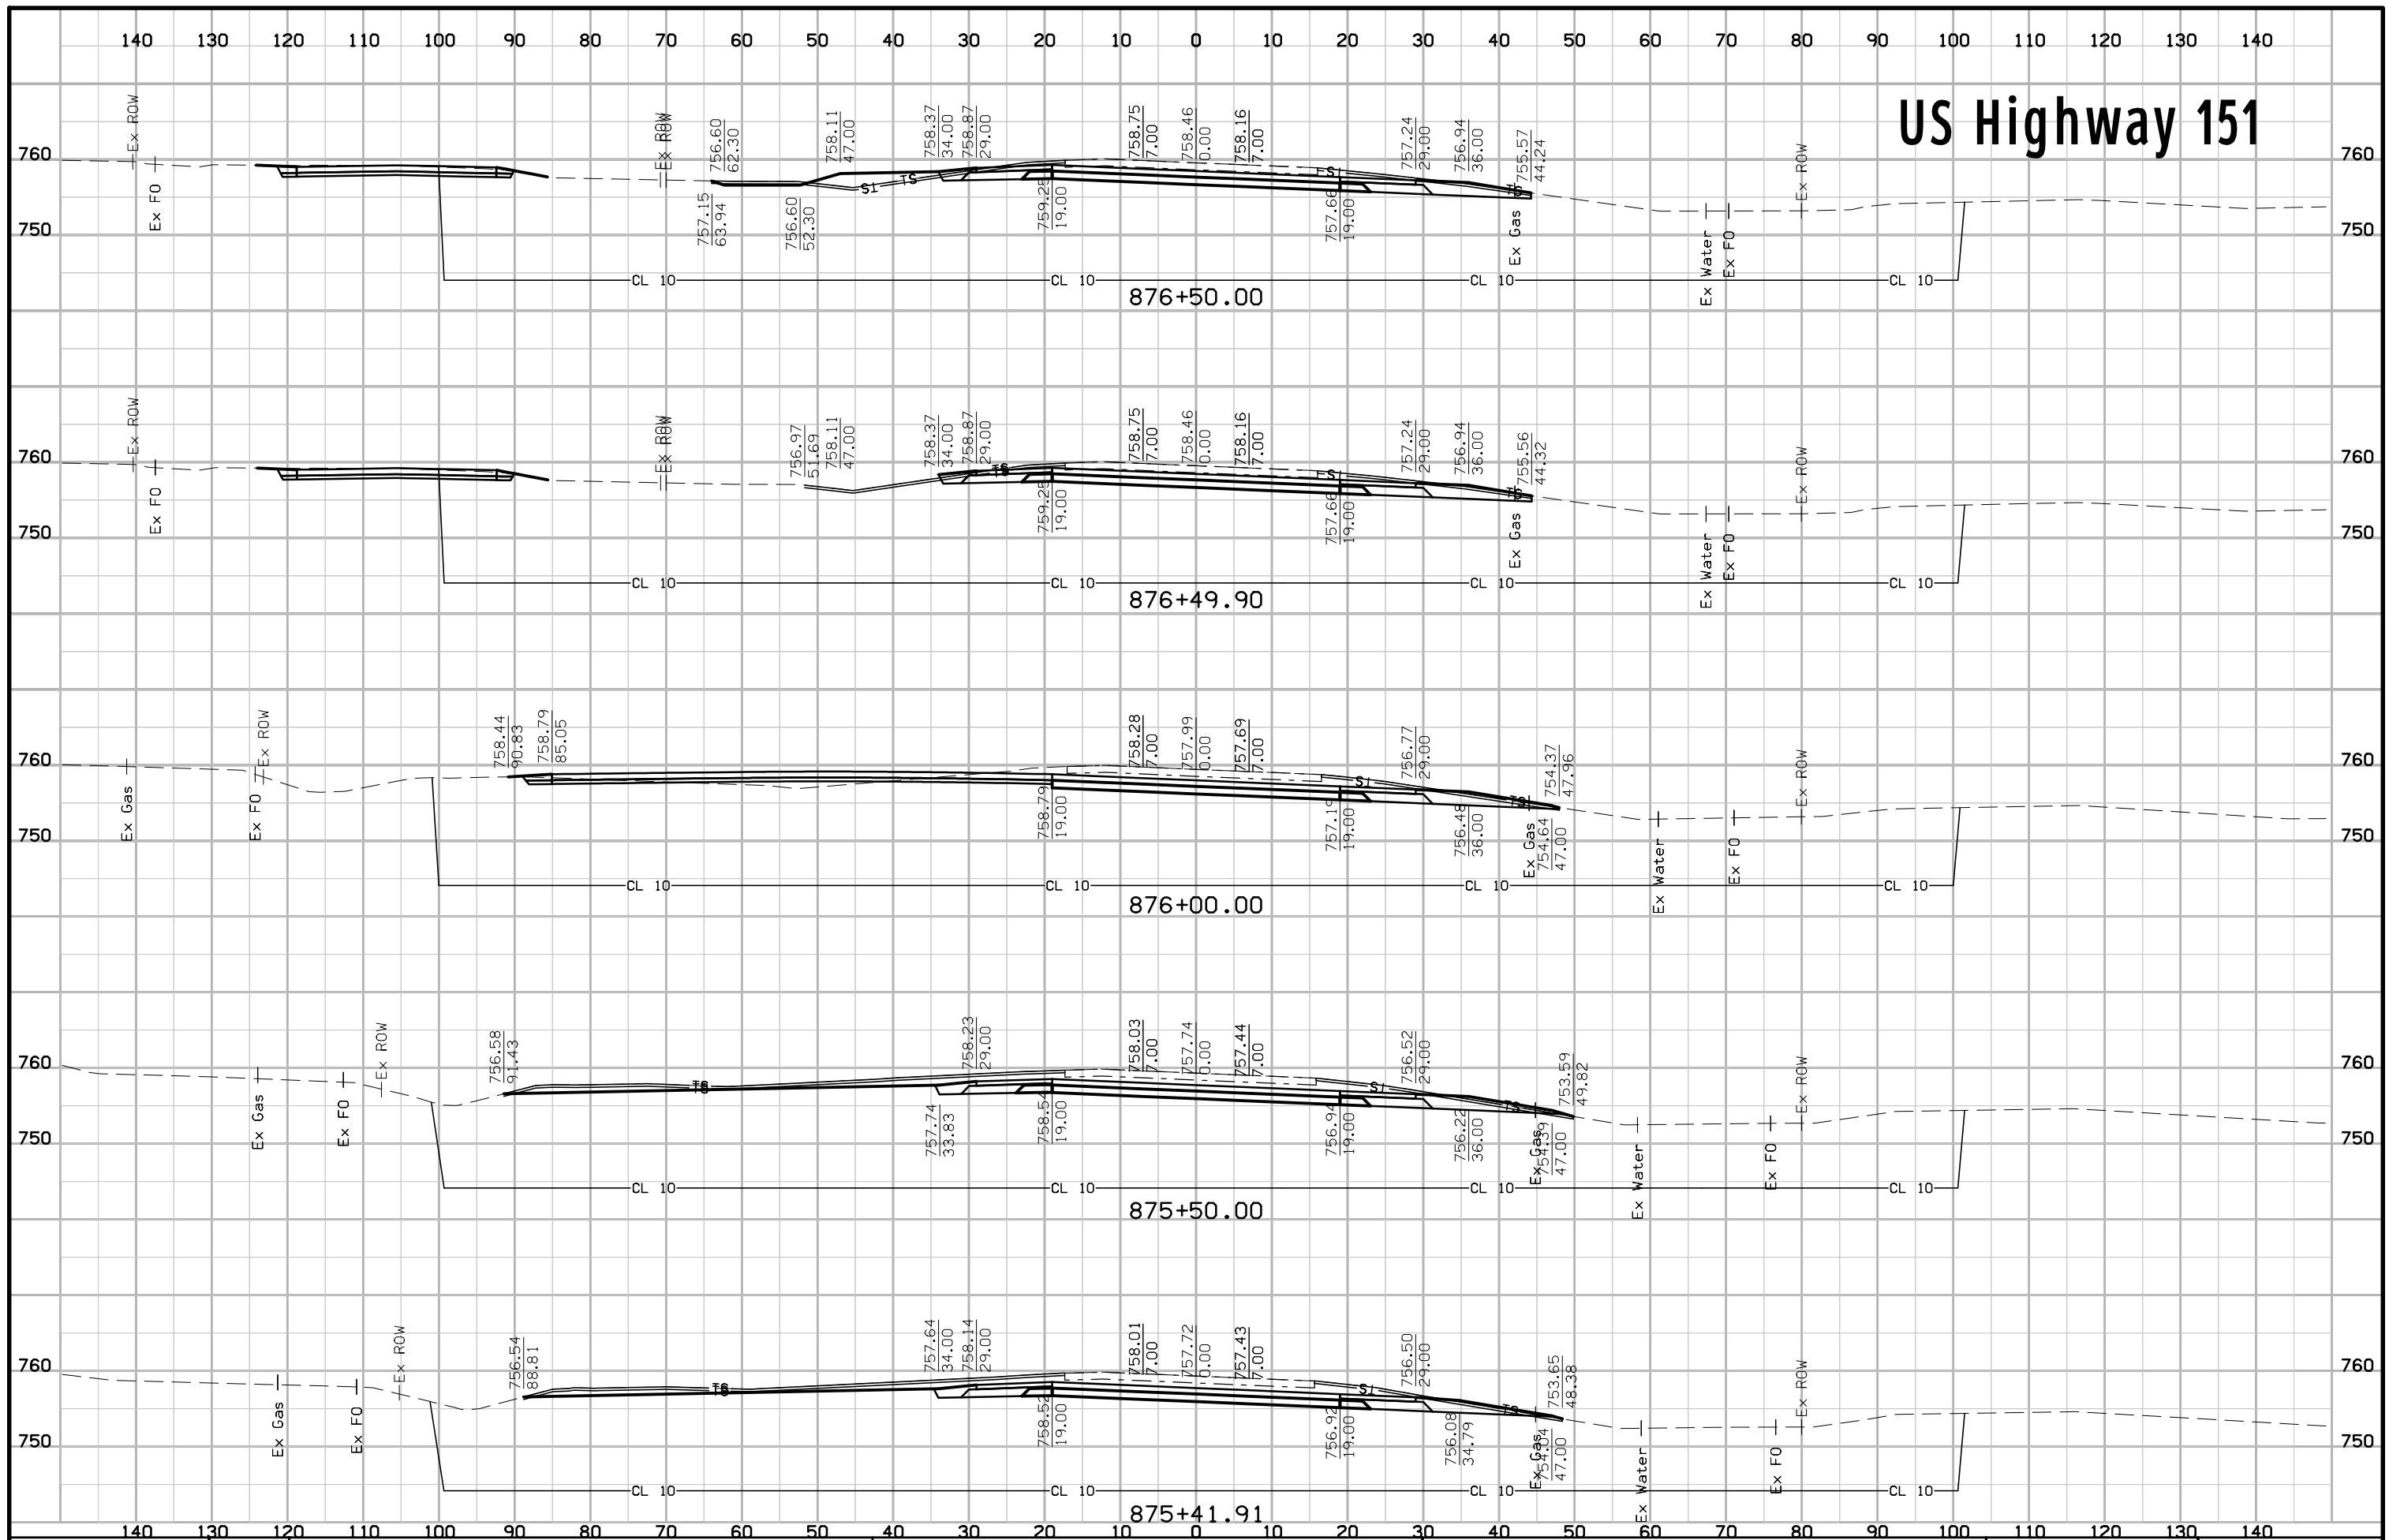


US Highway 151

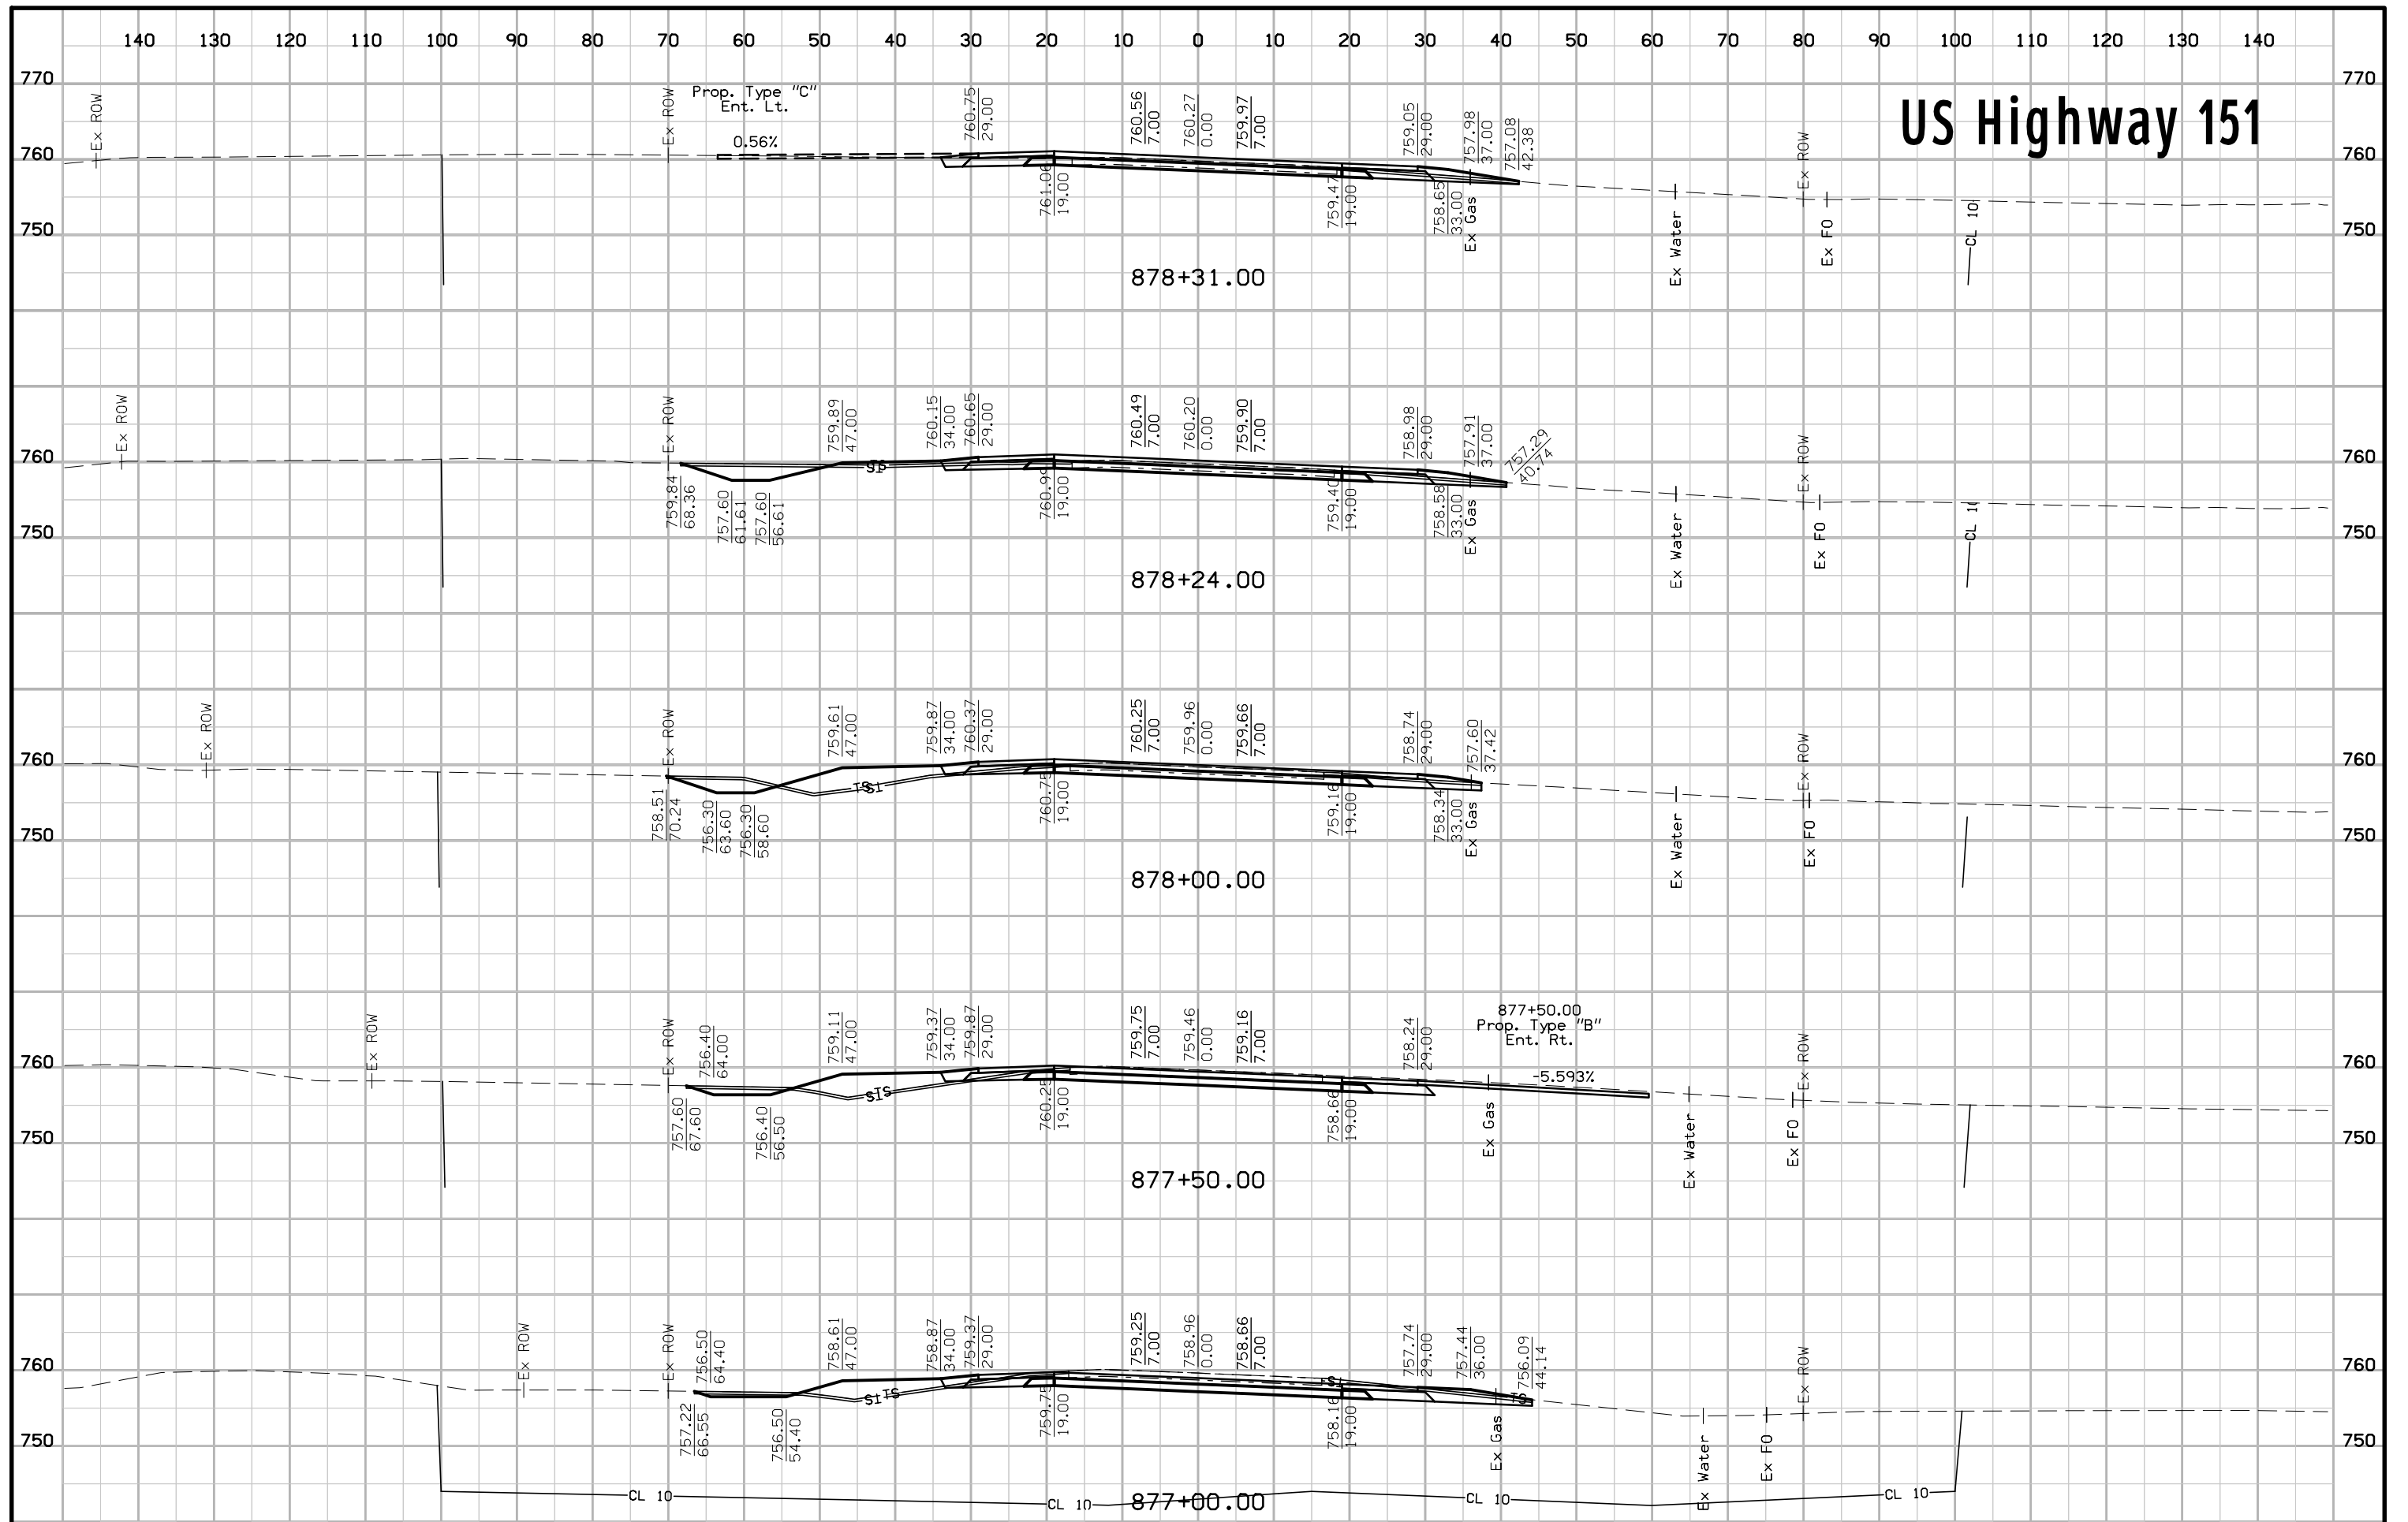


US Highway 151

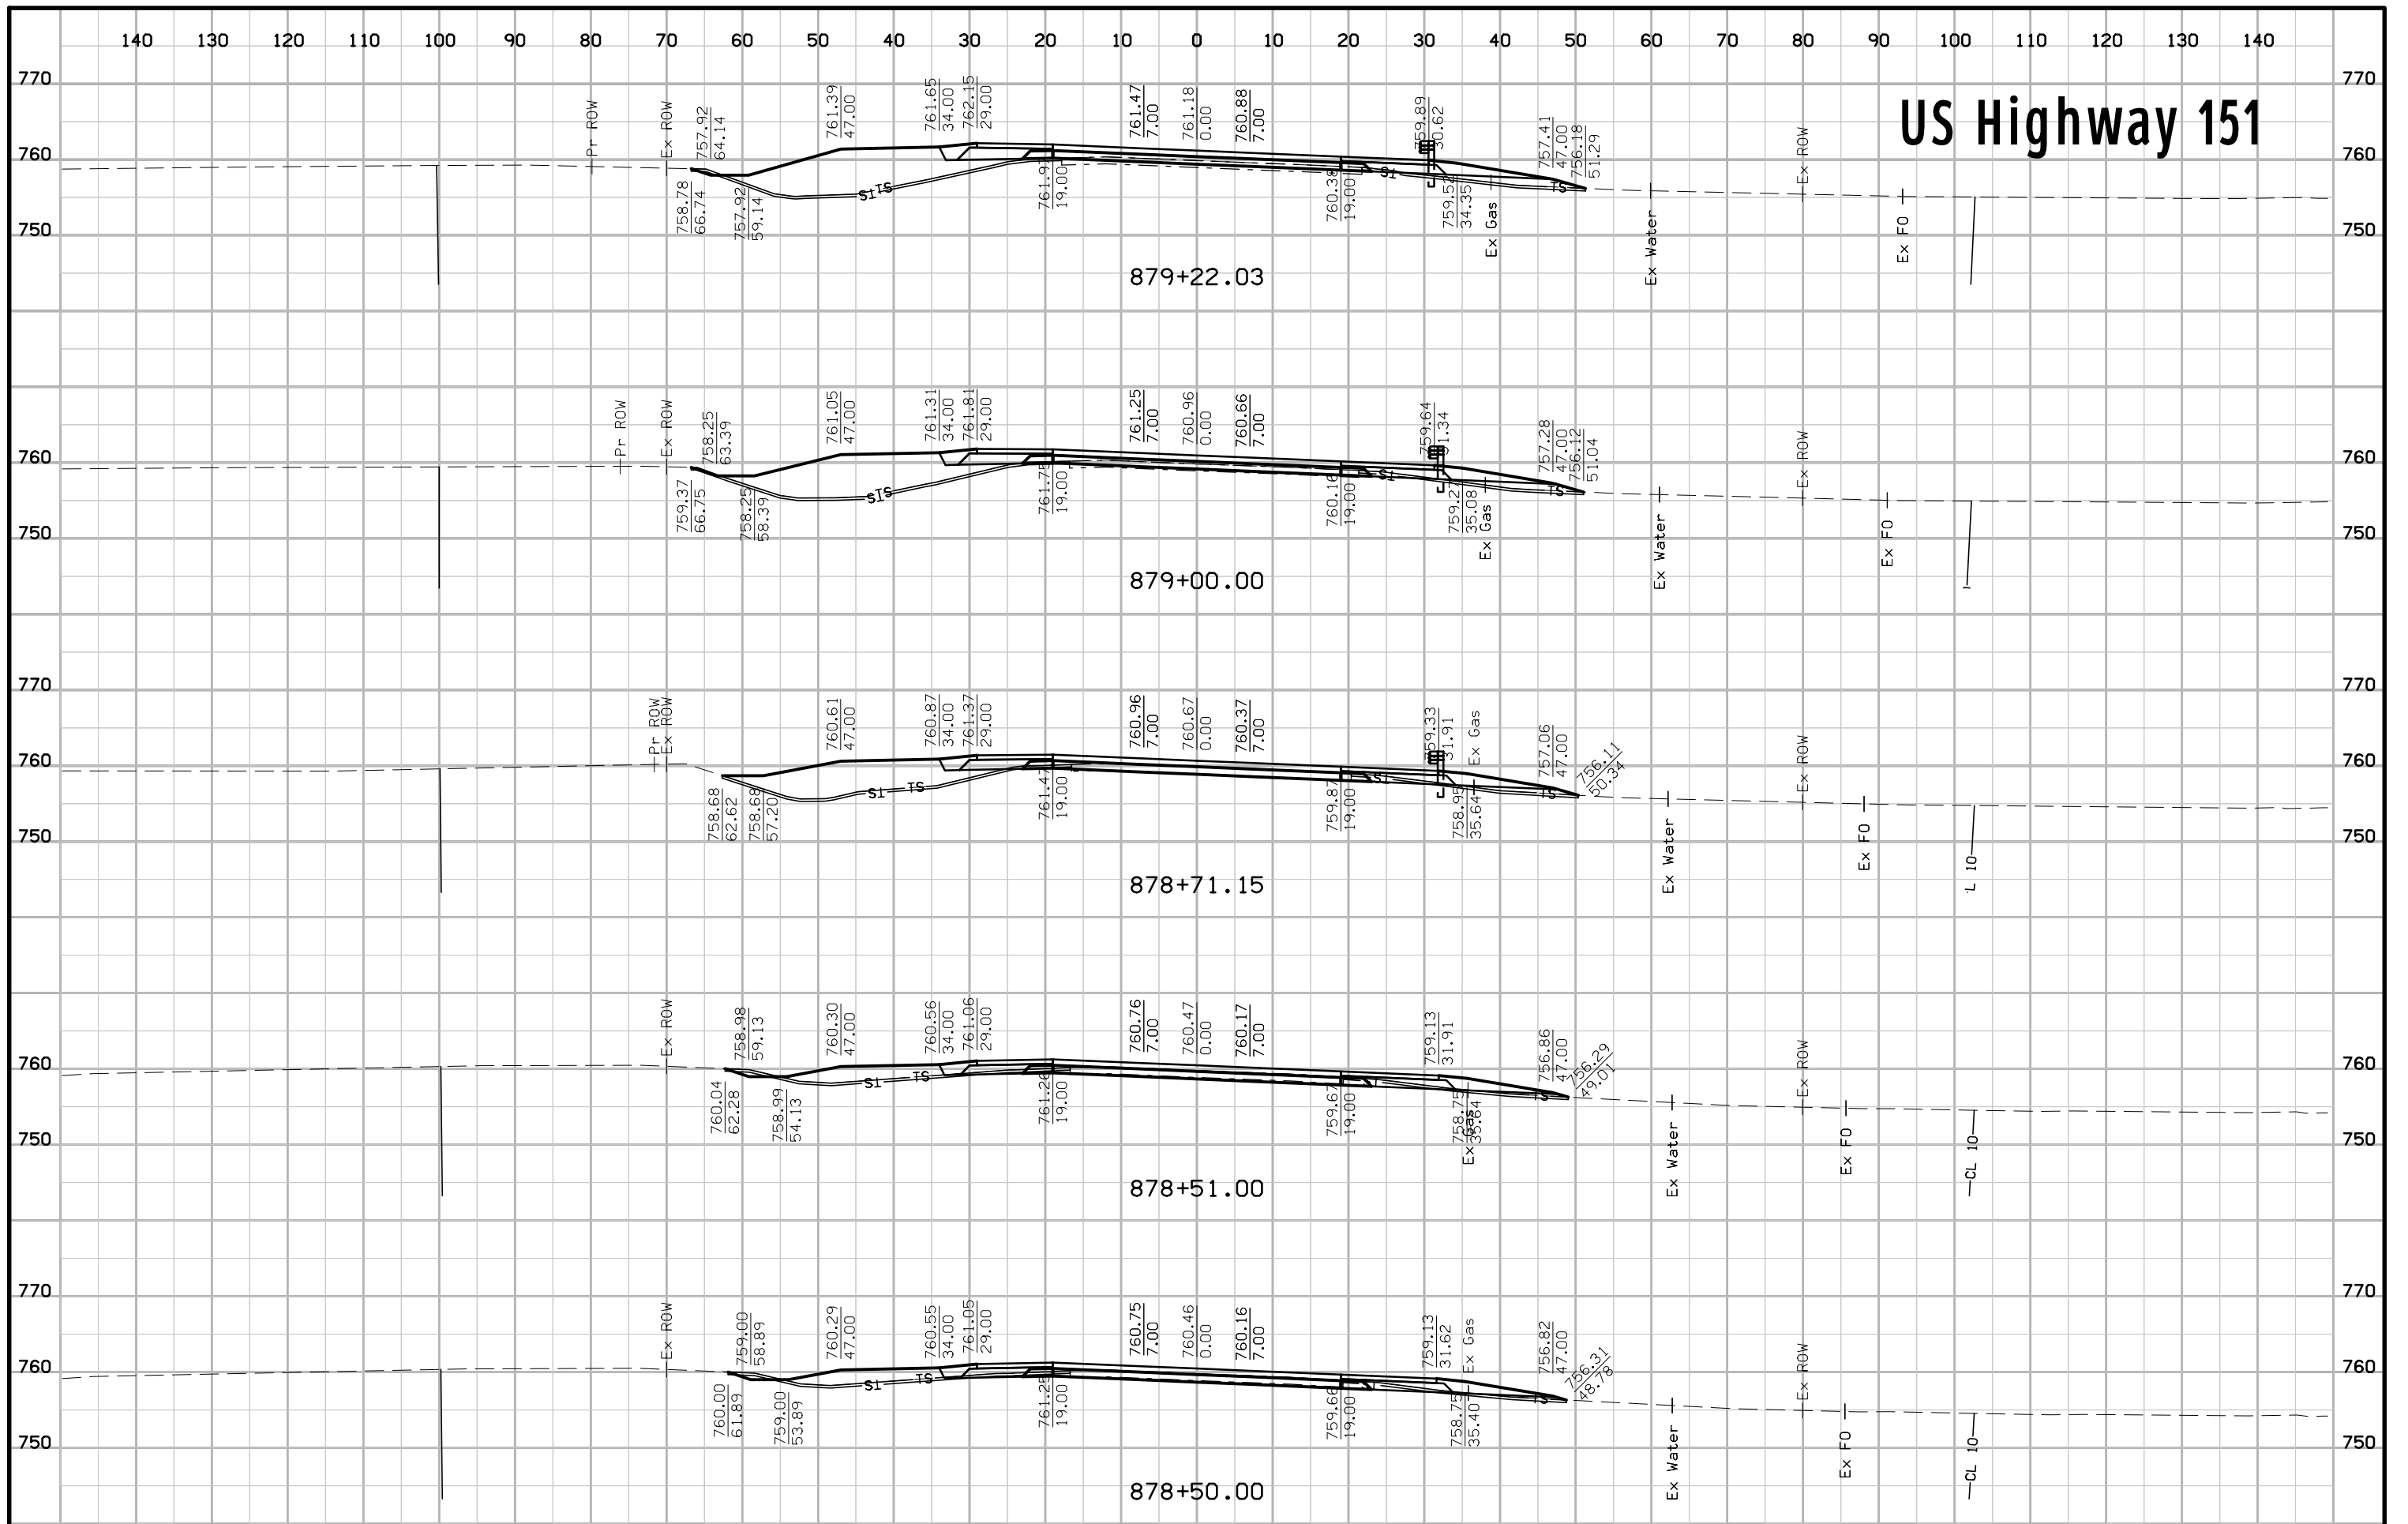


US Highway 151

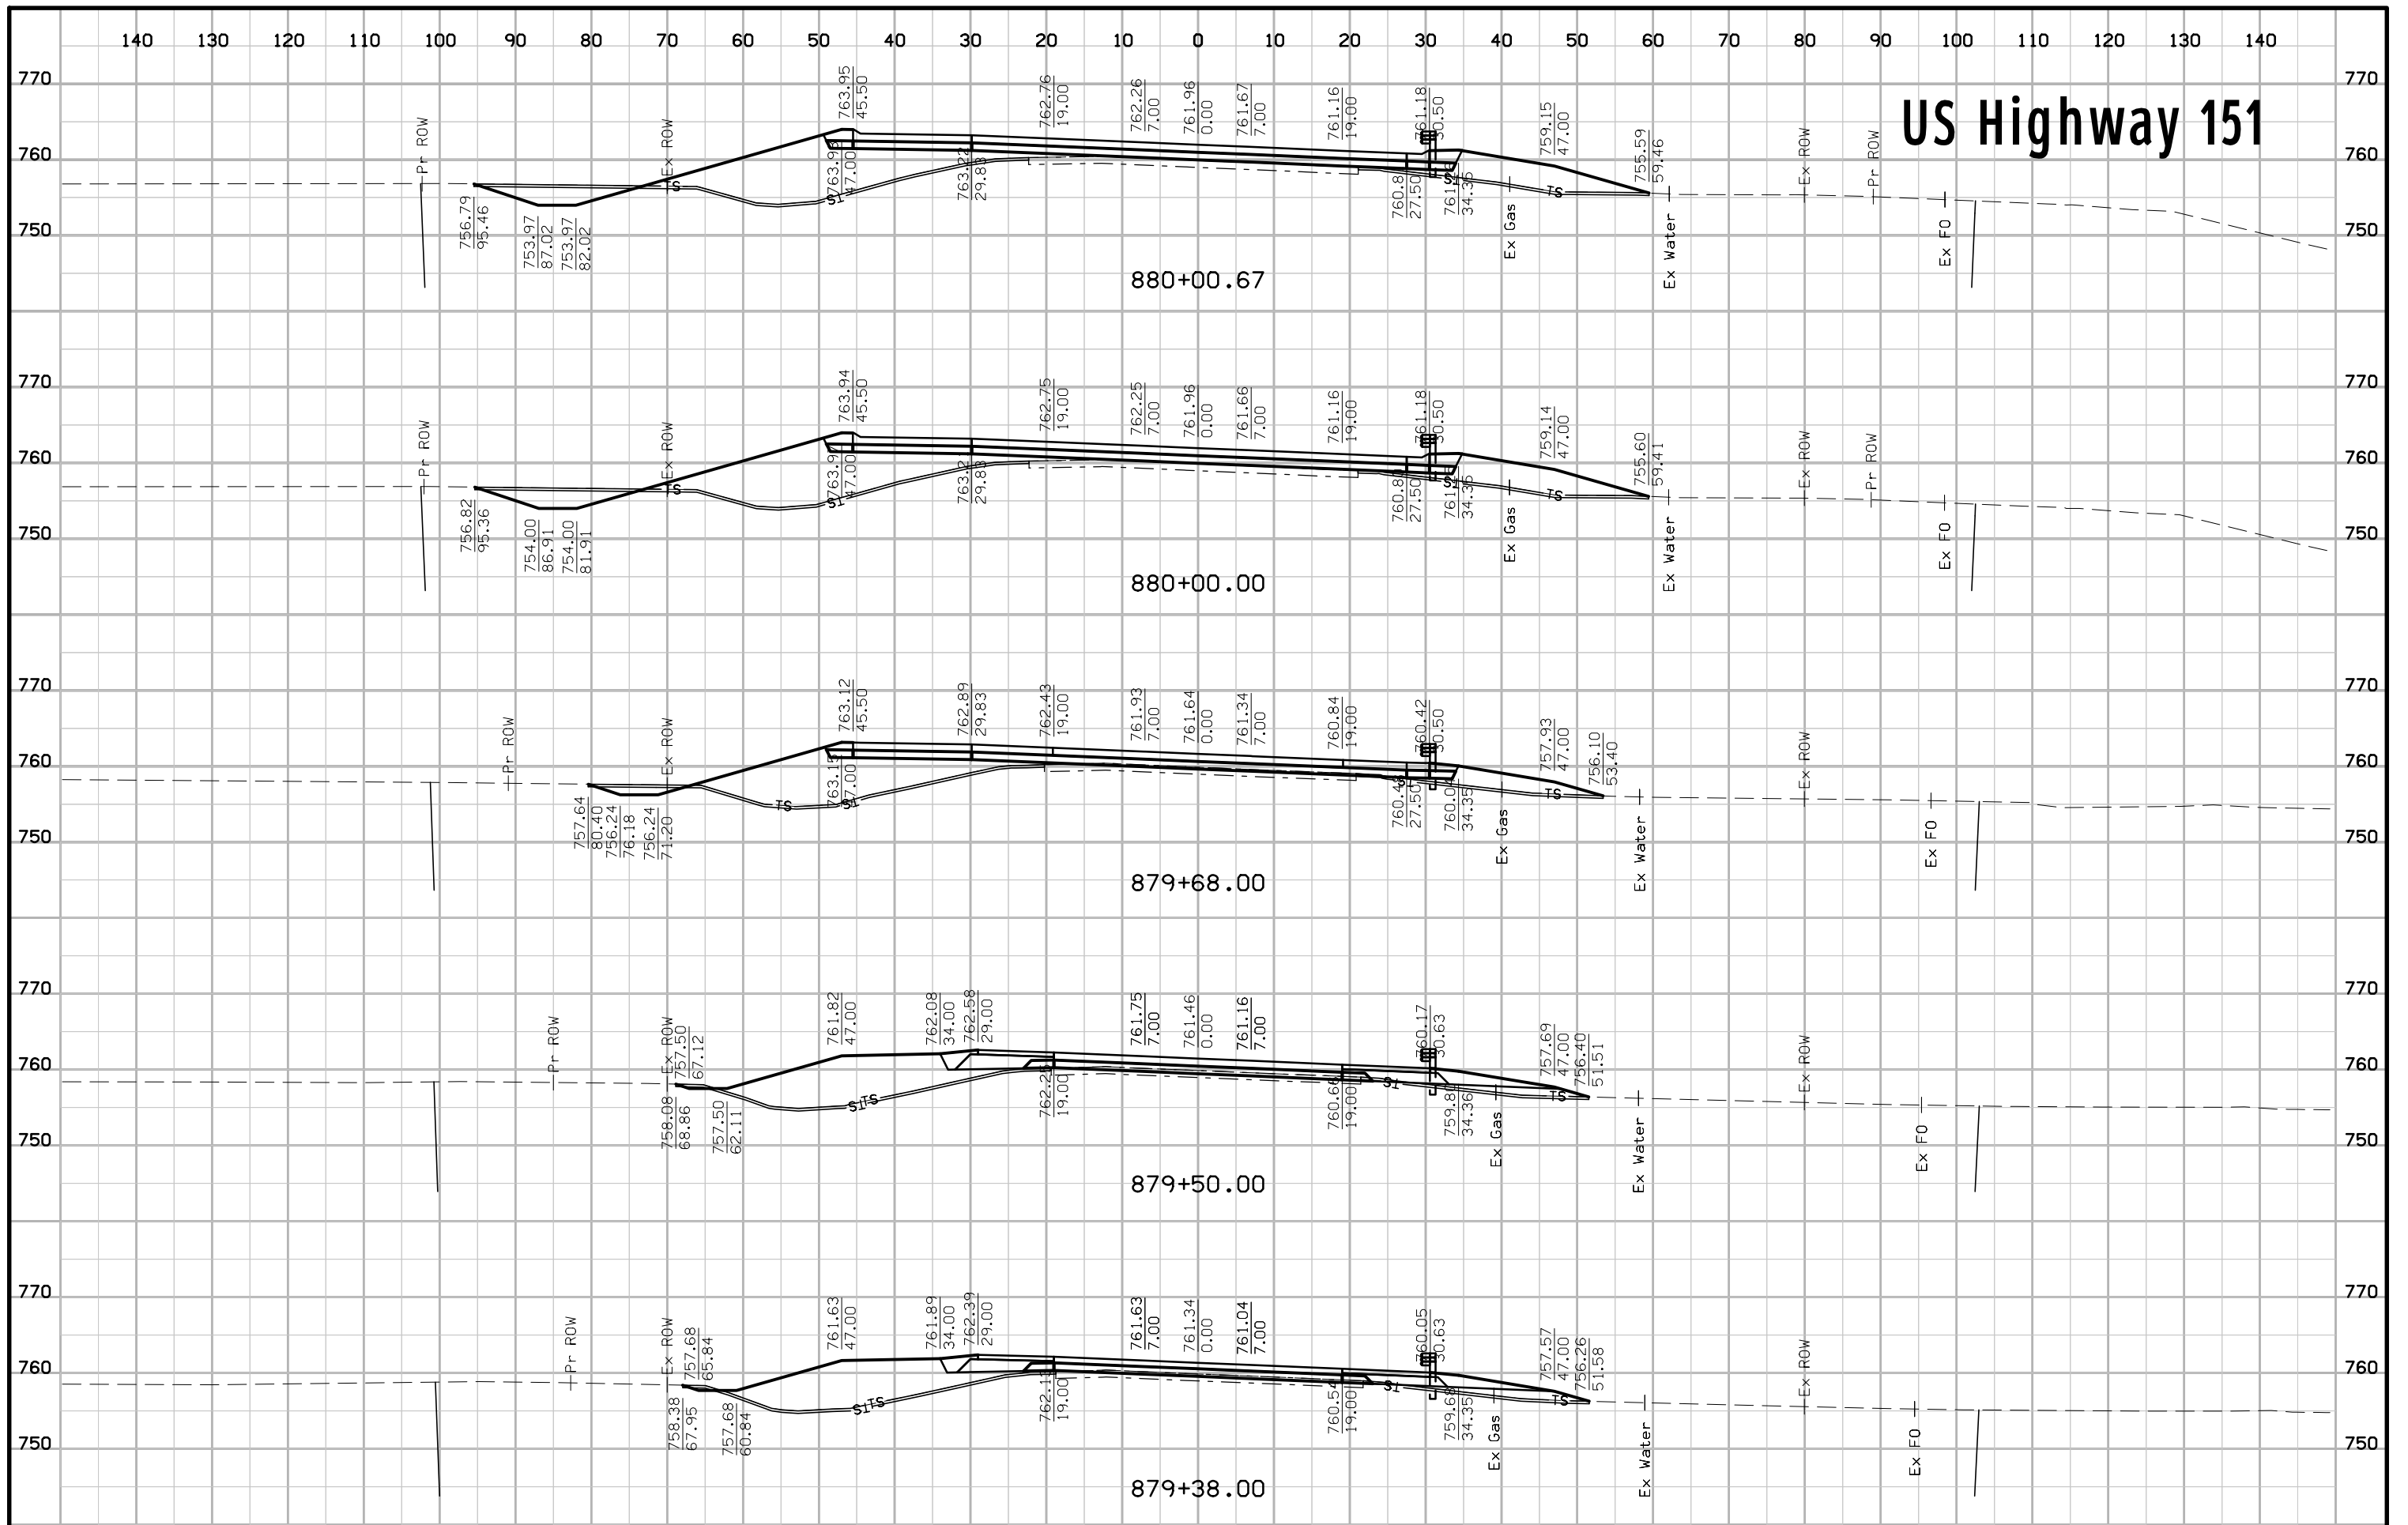


US Highway 151

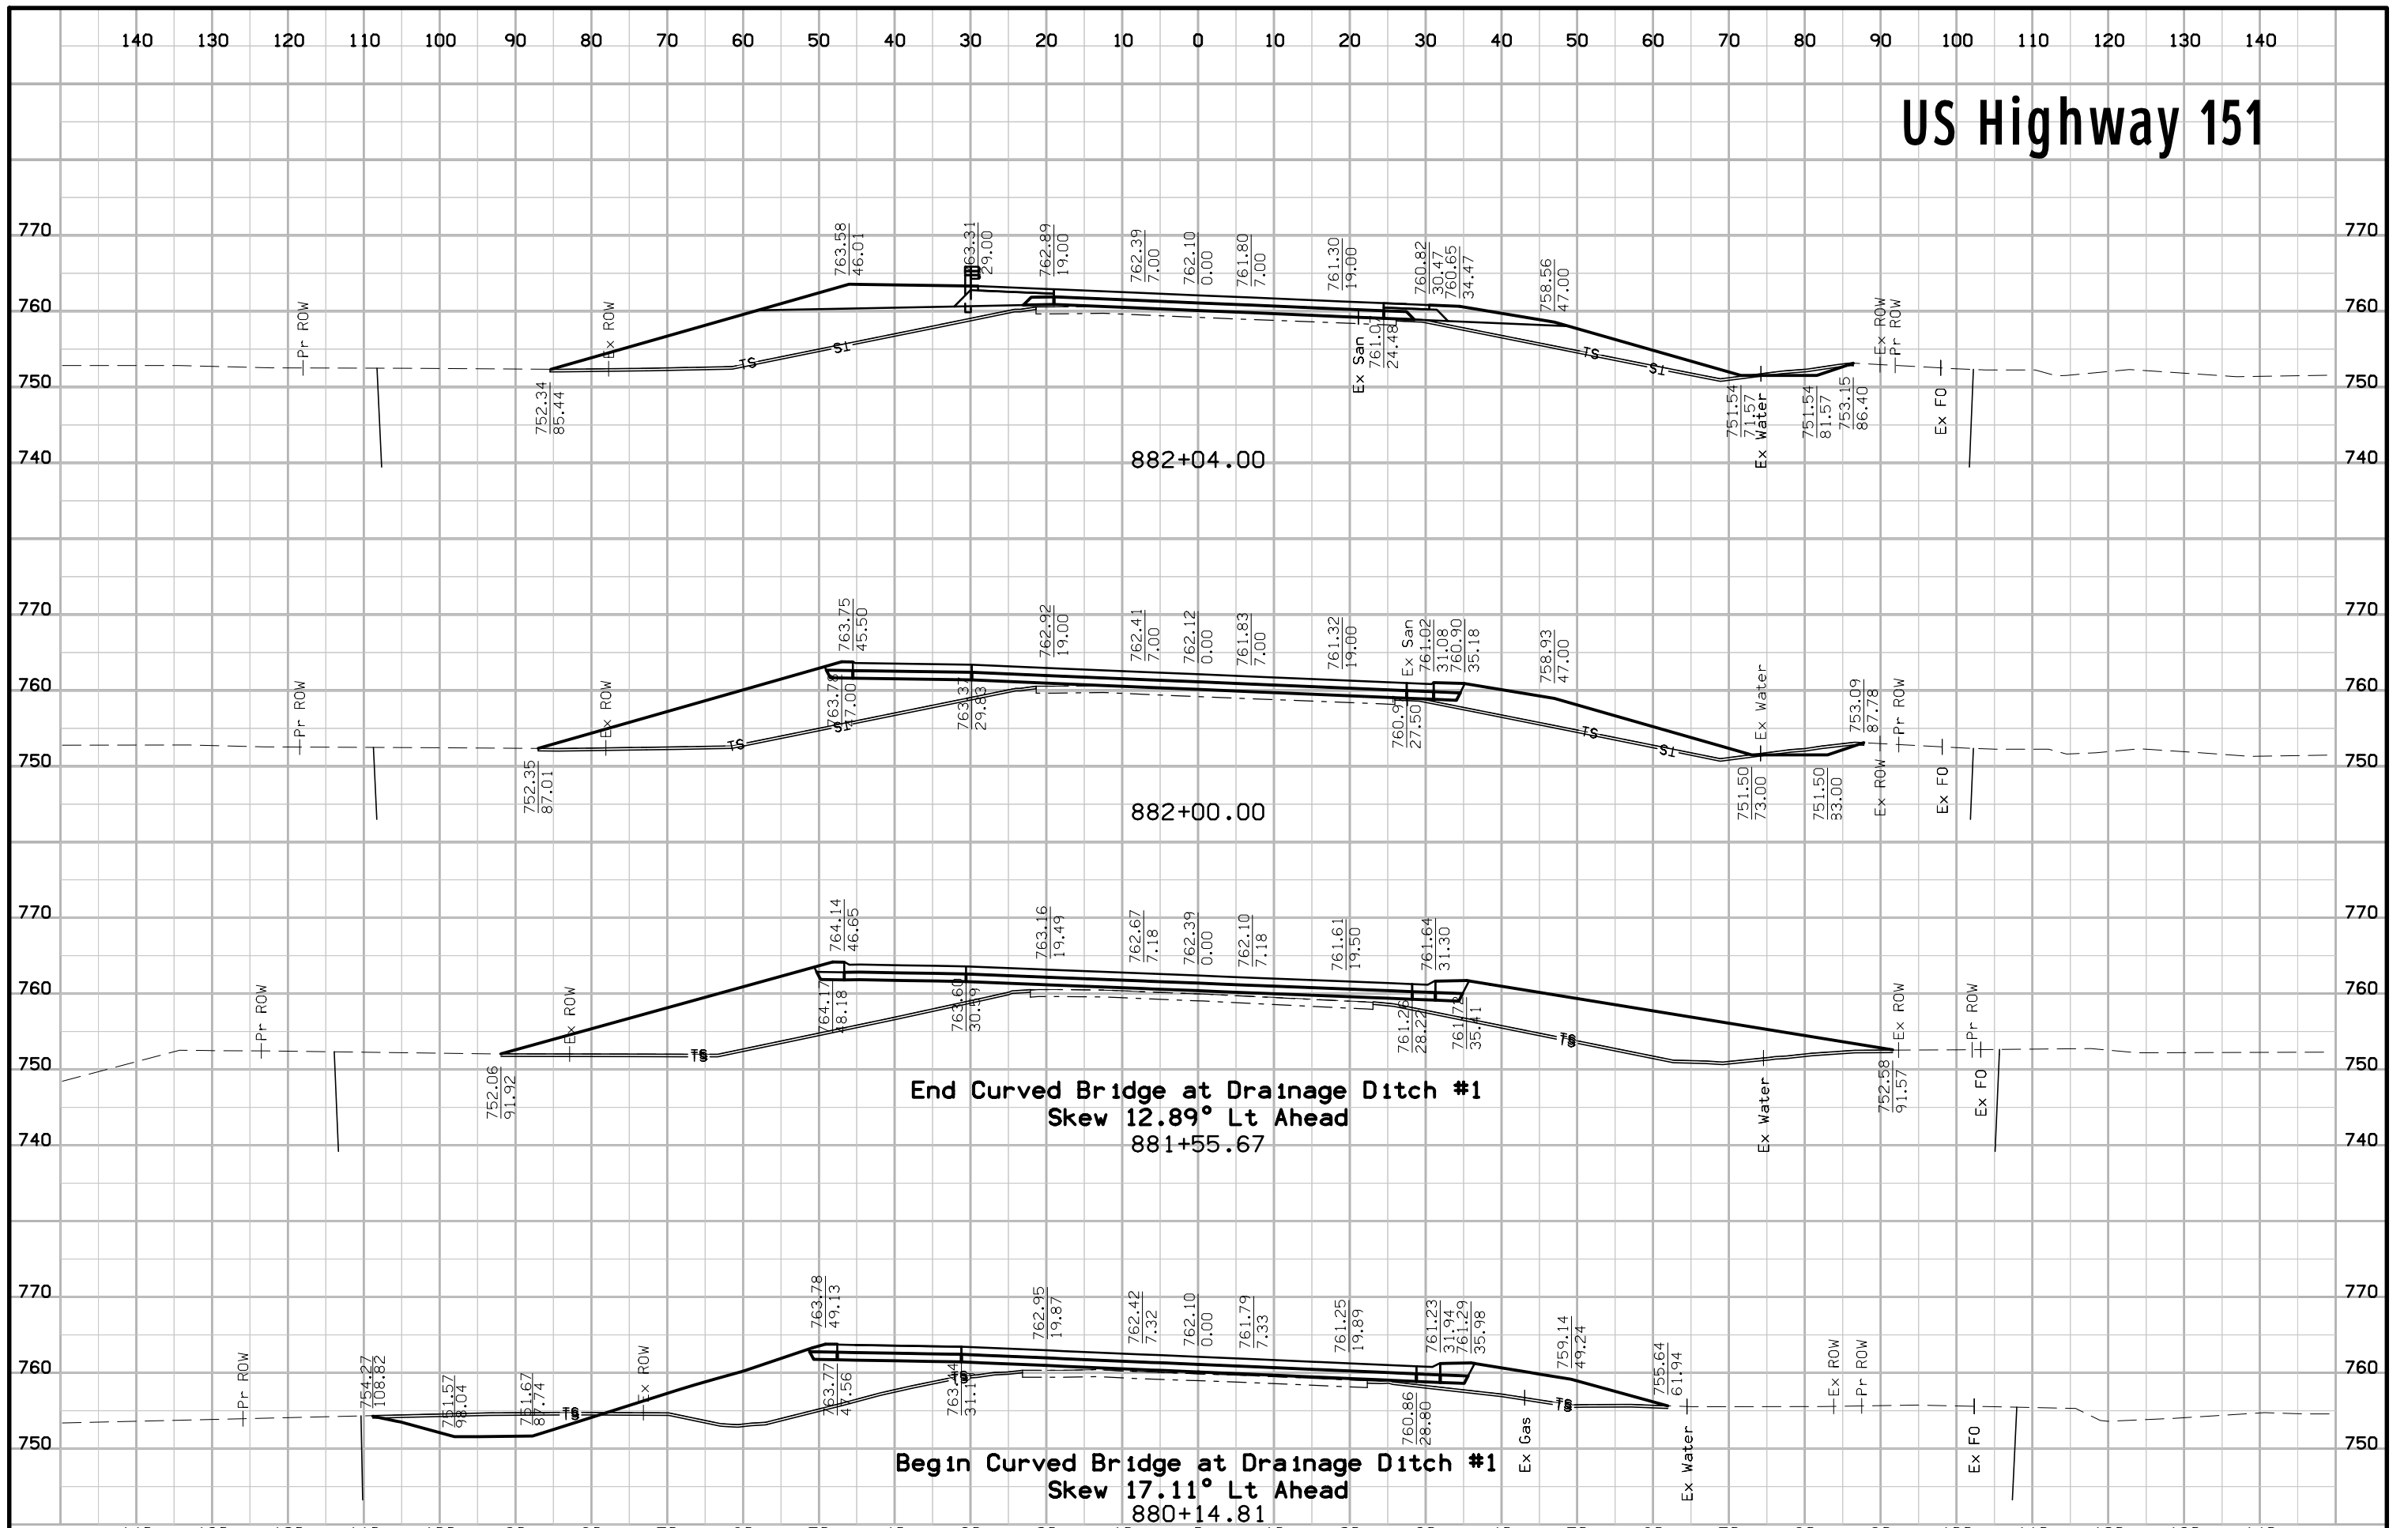


US Highway 151

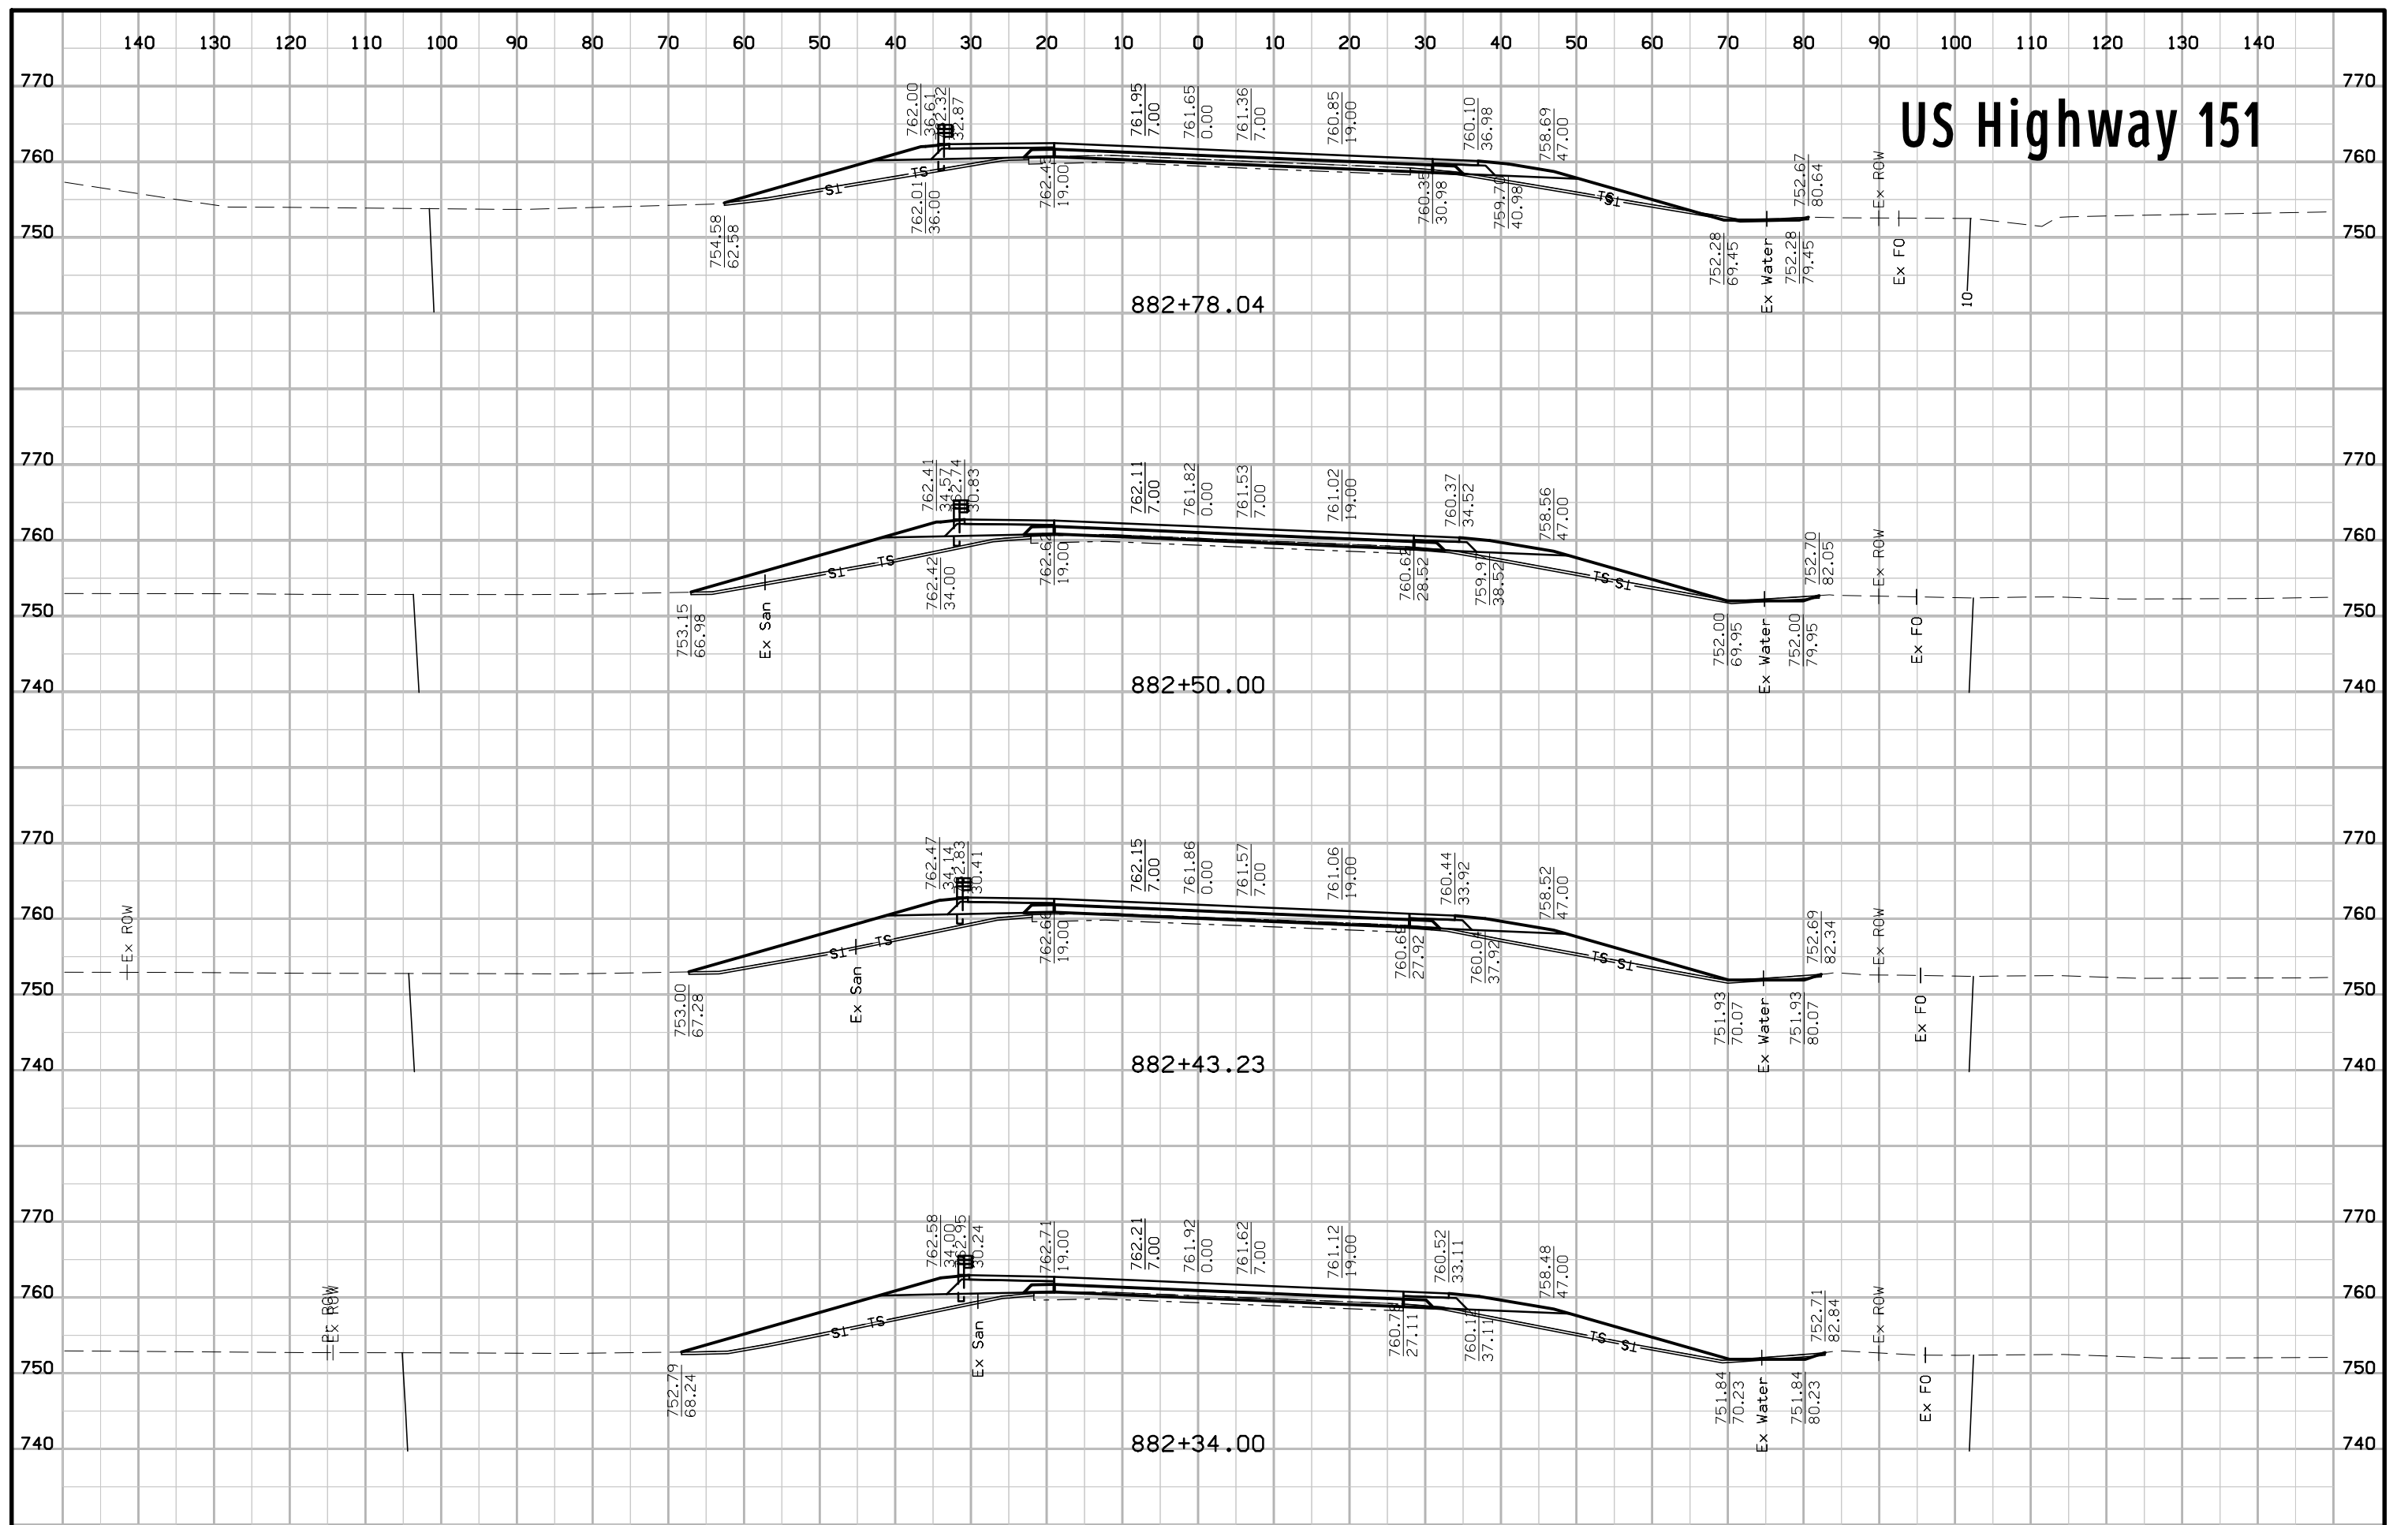


US Highway 151

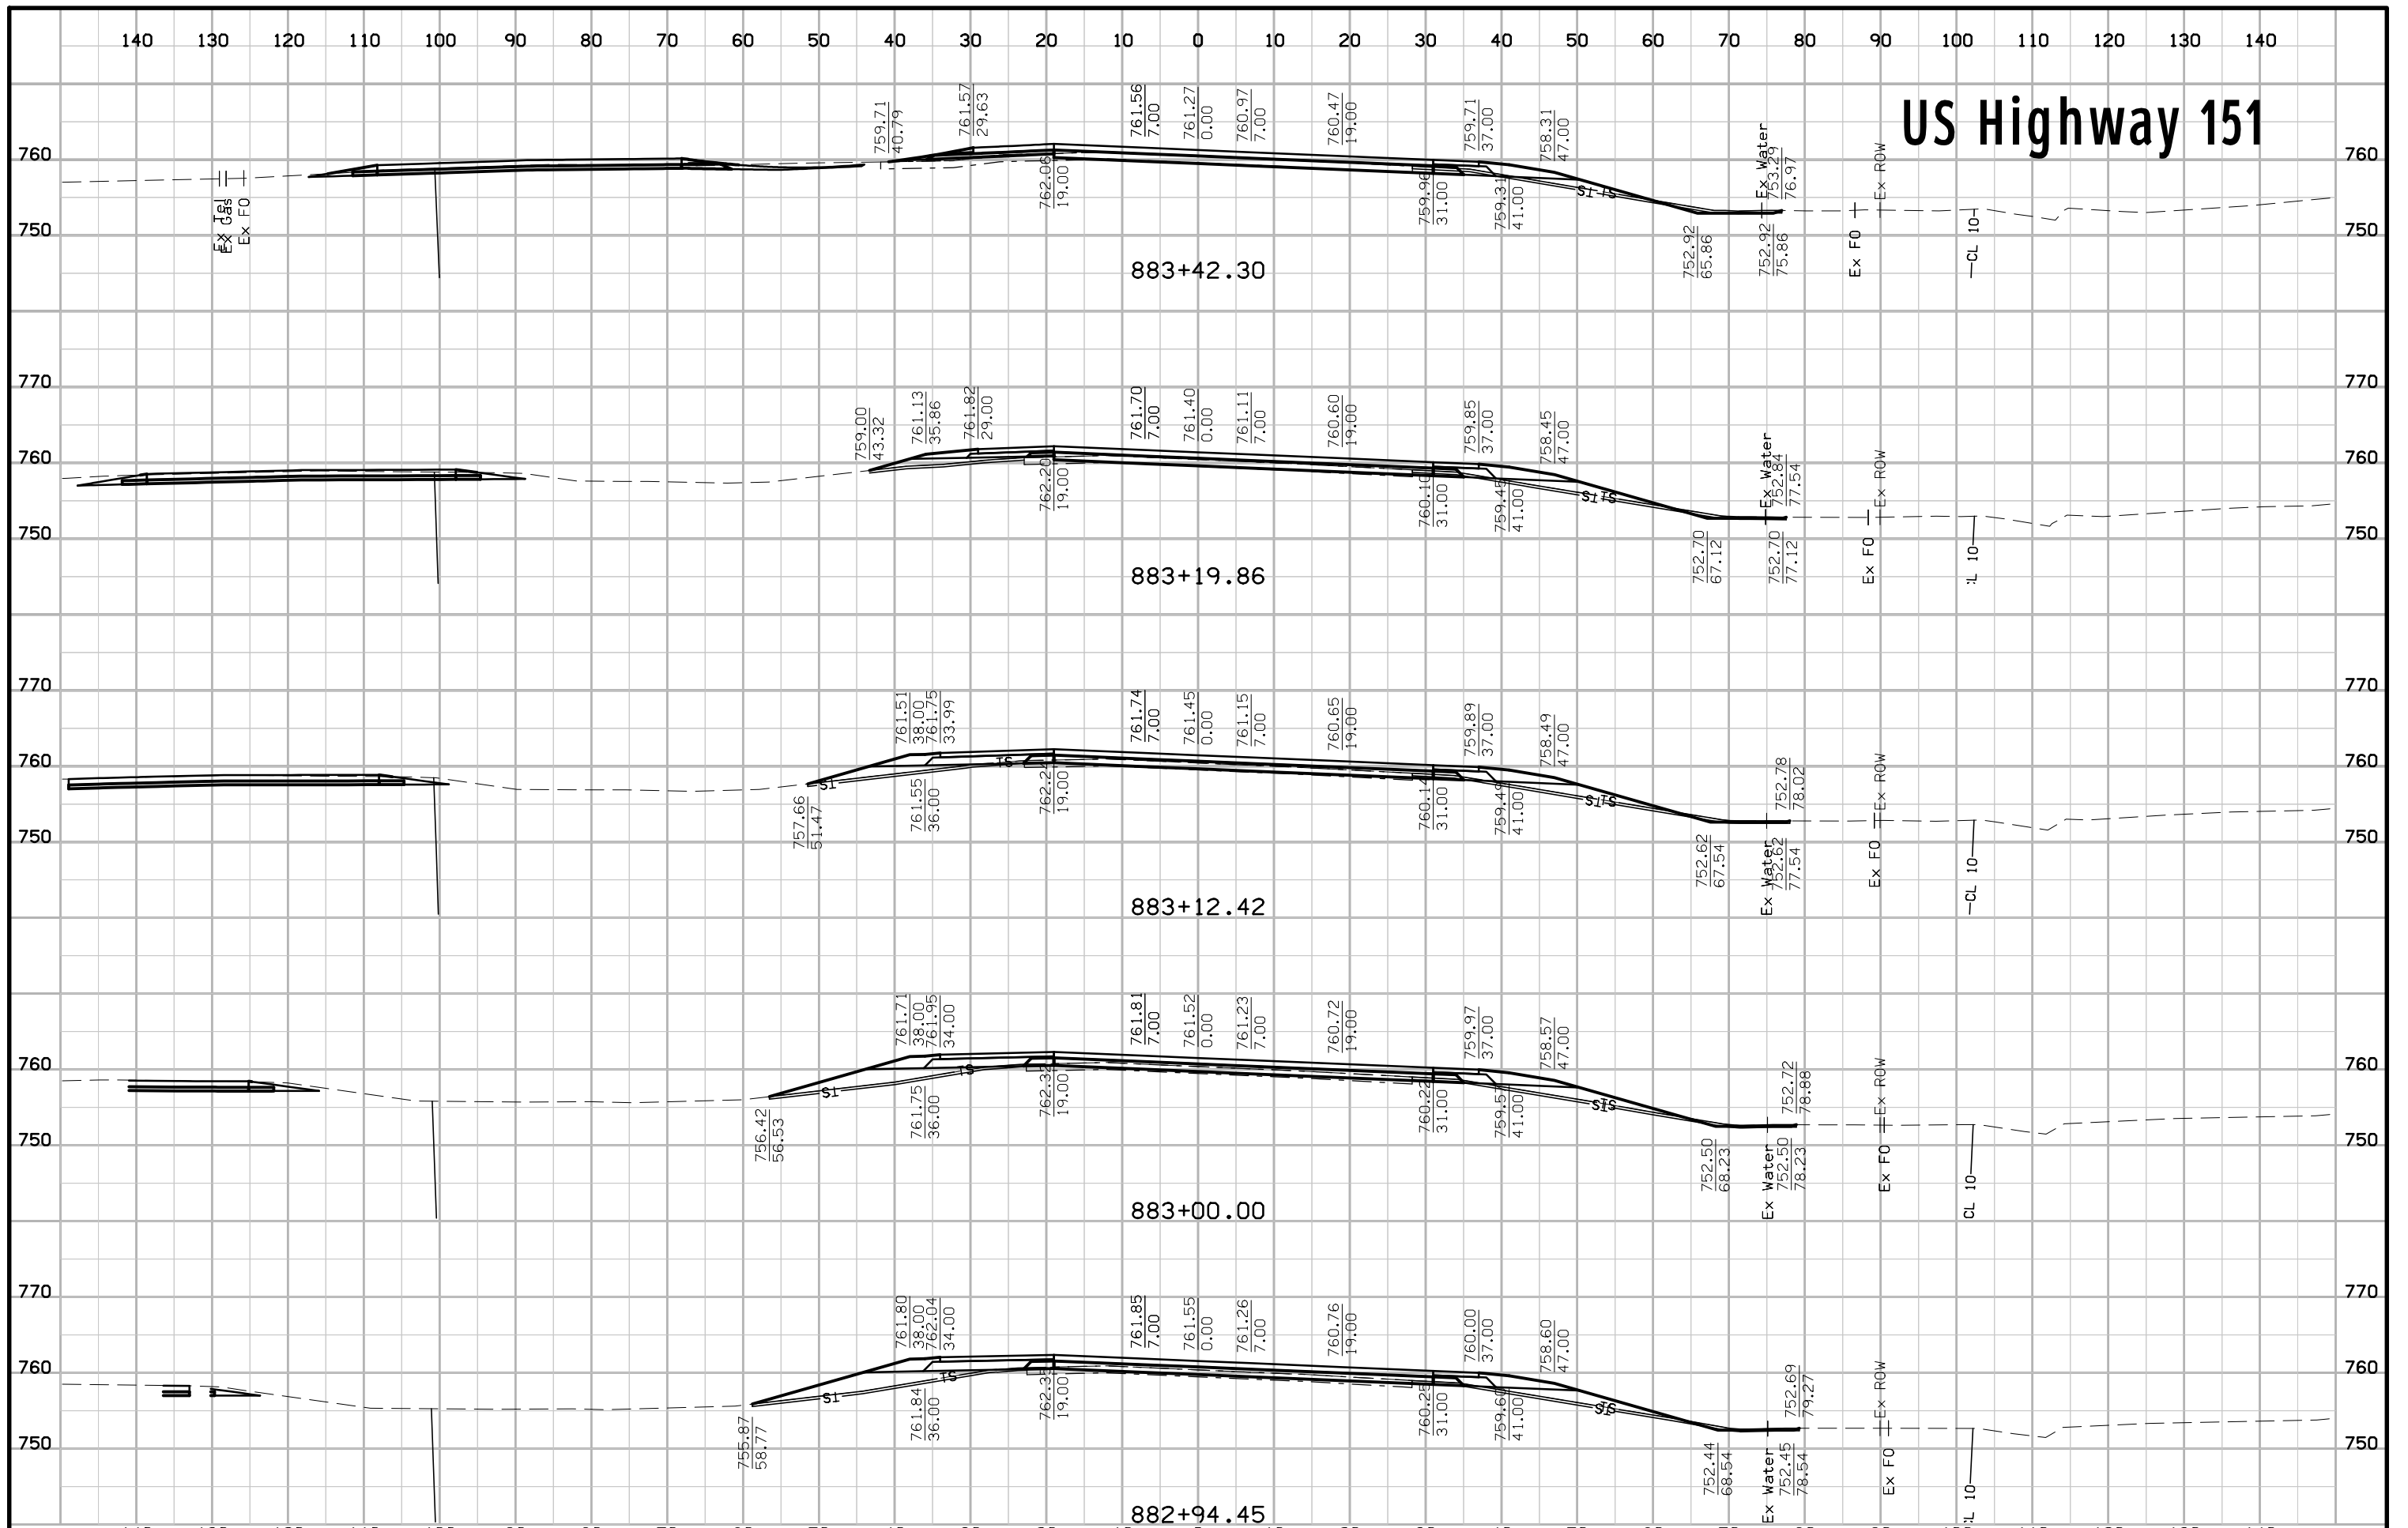


US Highway 151

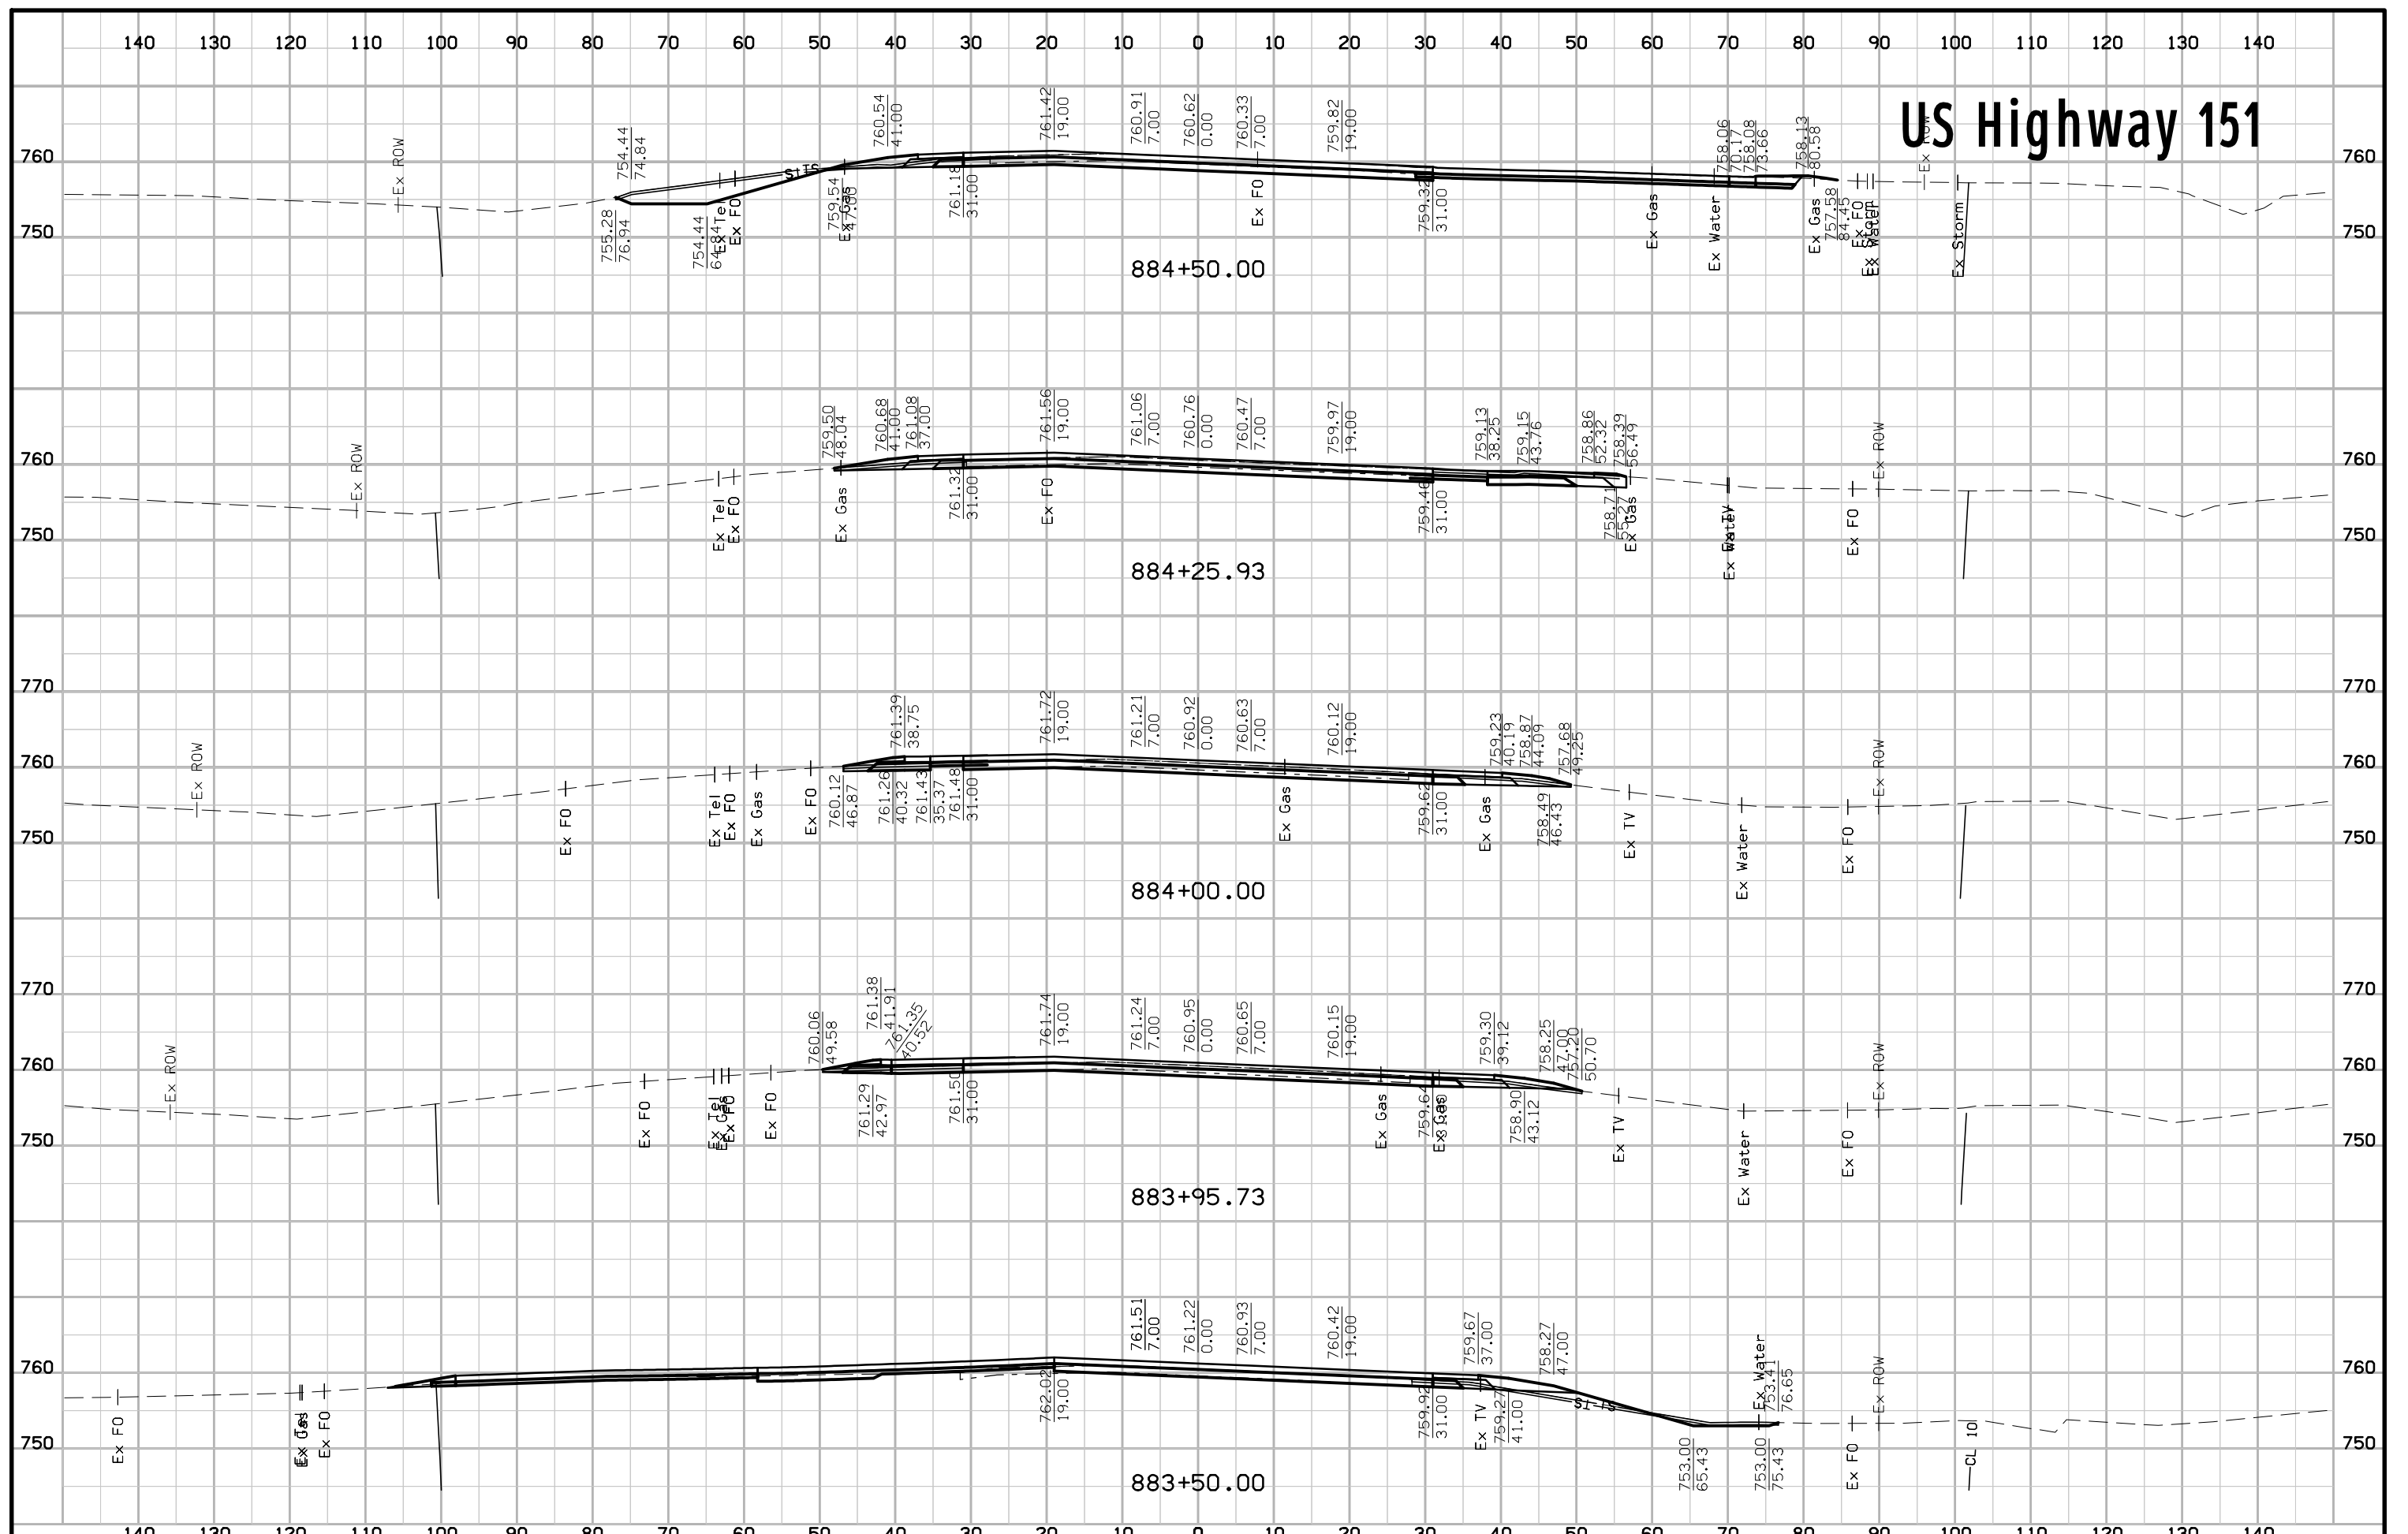


US Highway 151

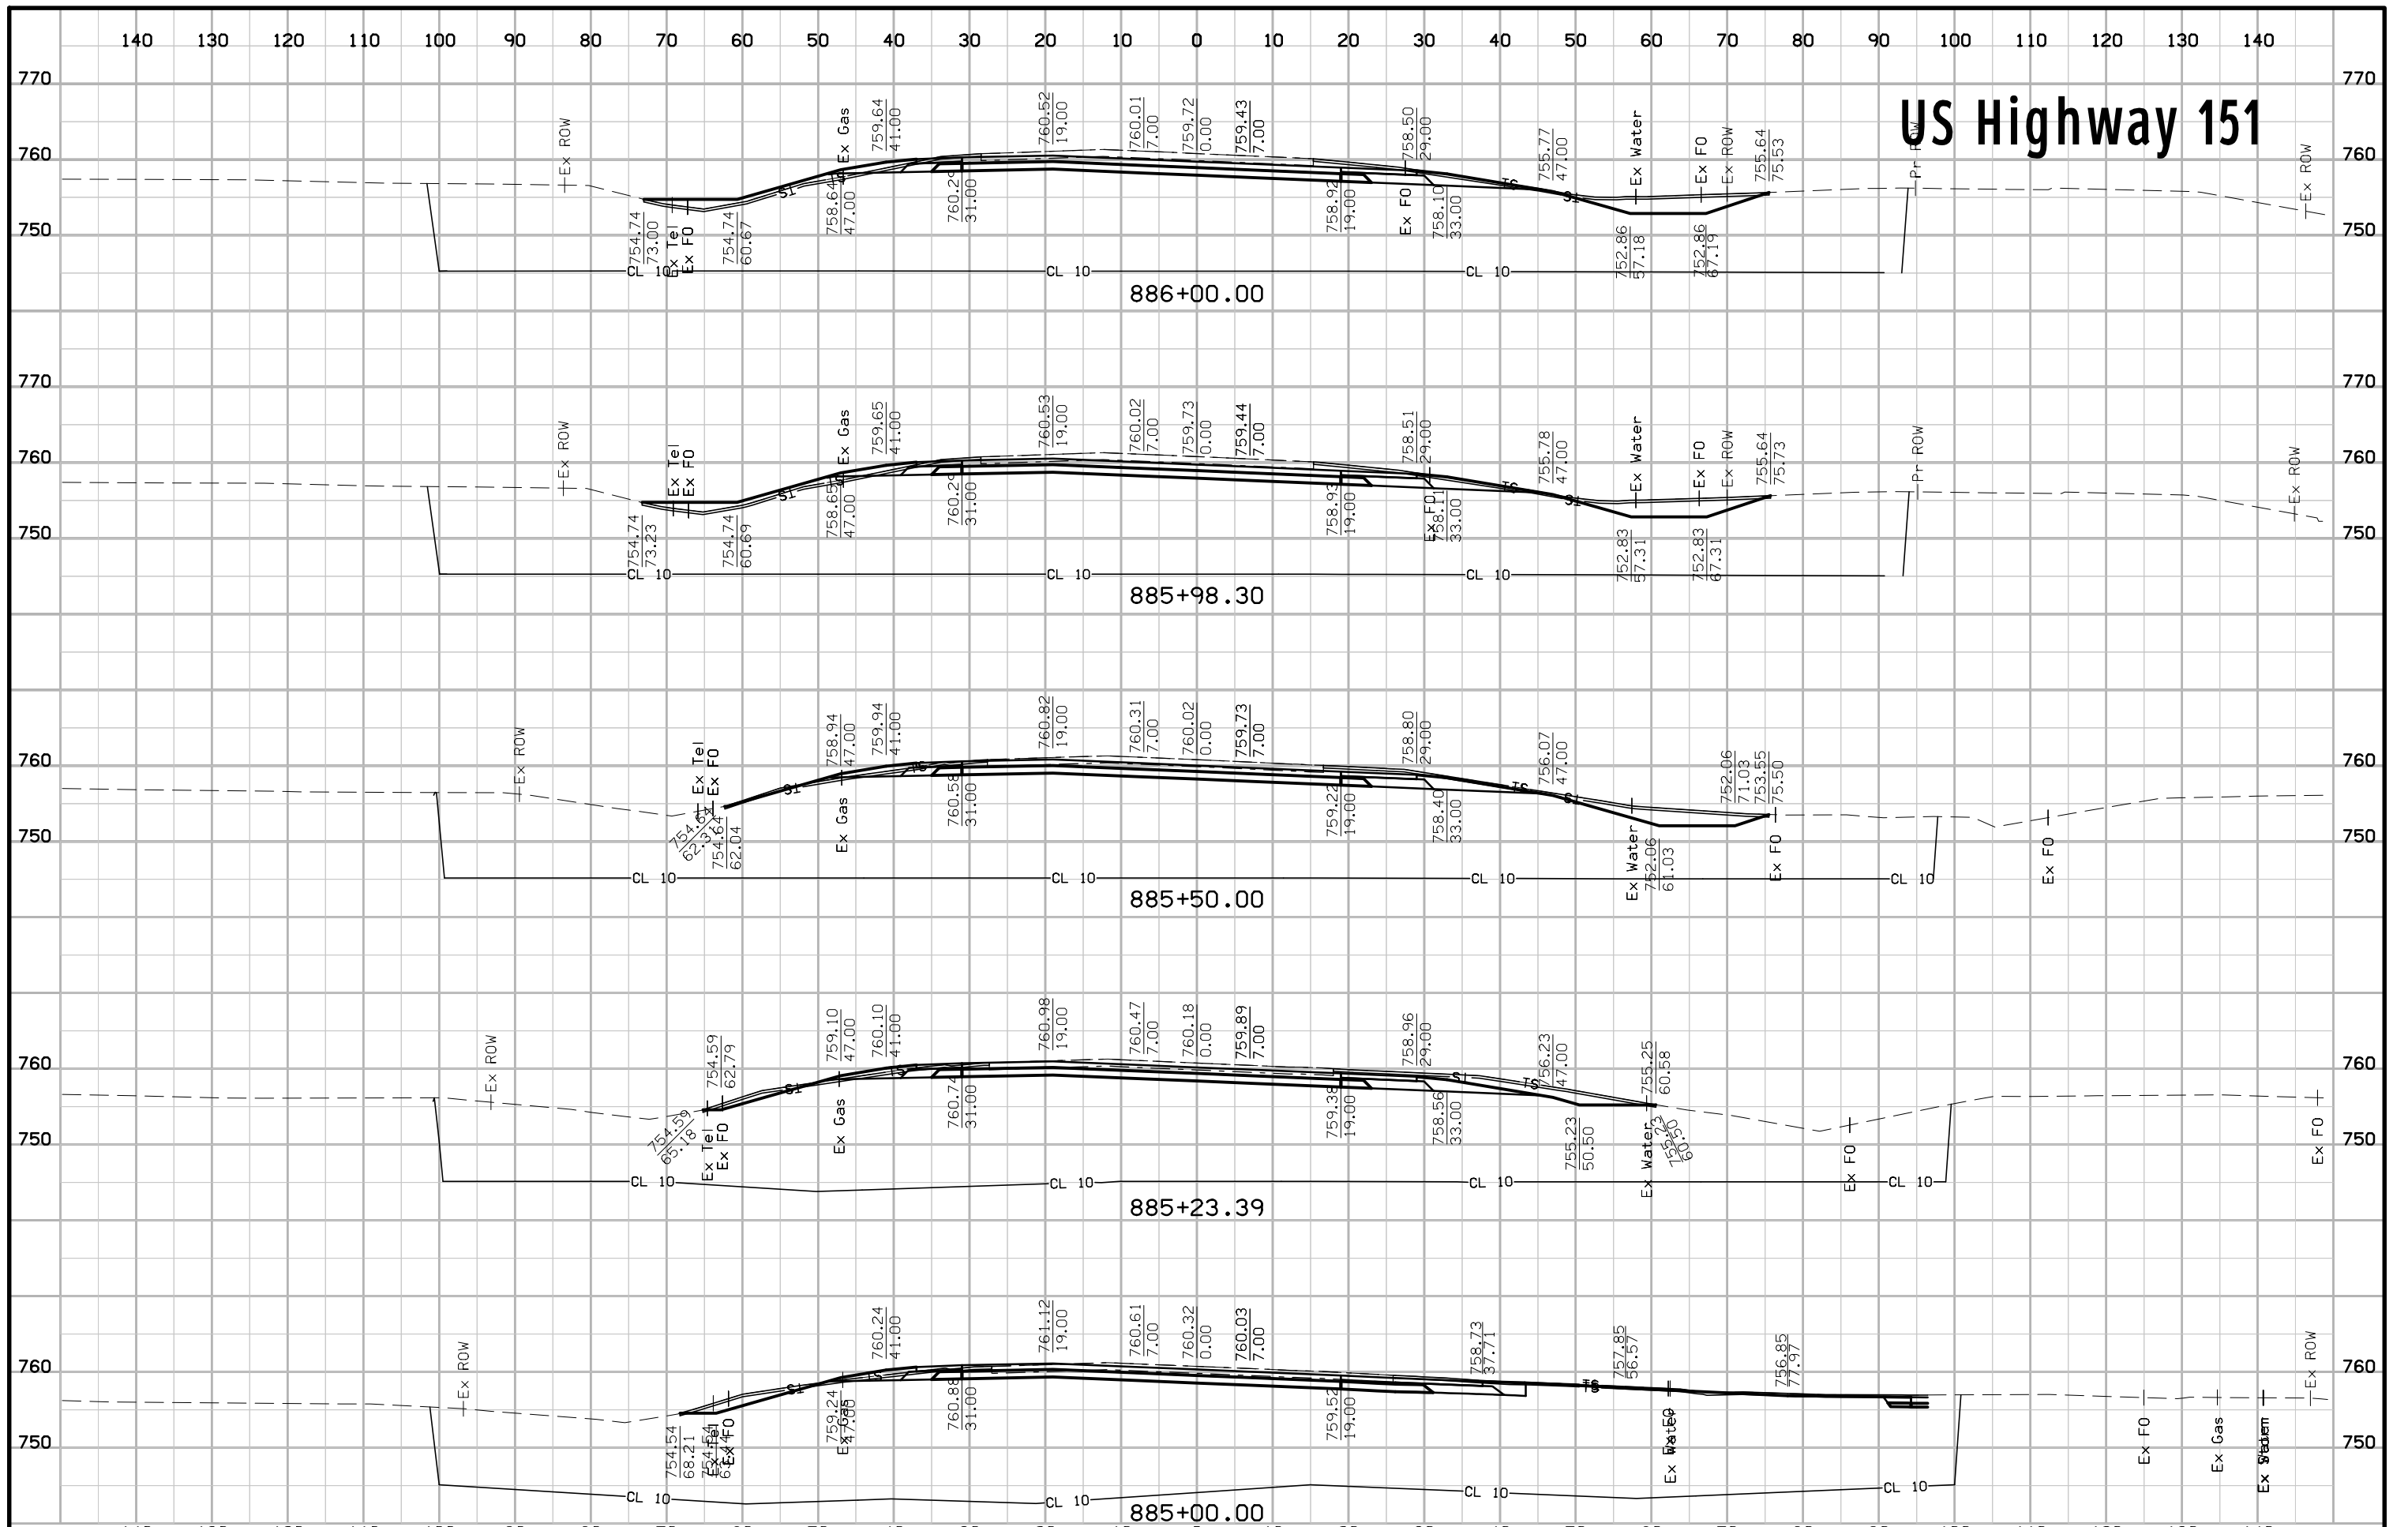


US Highway 151

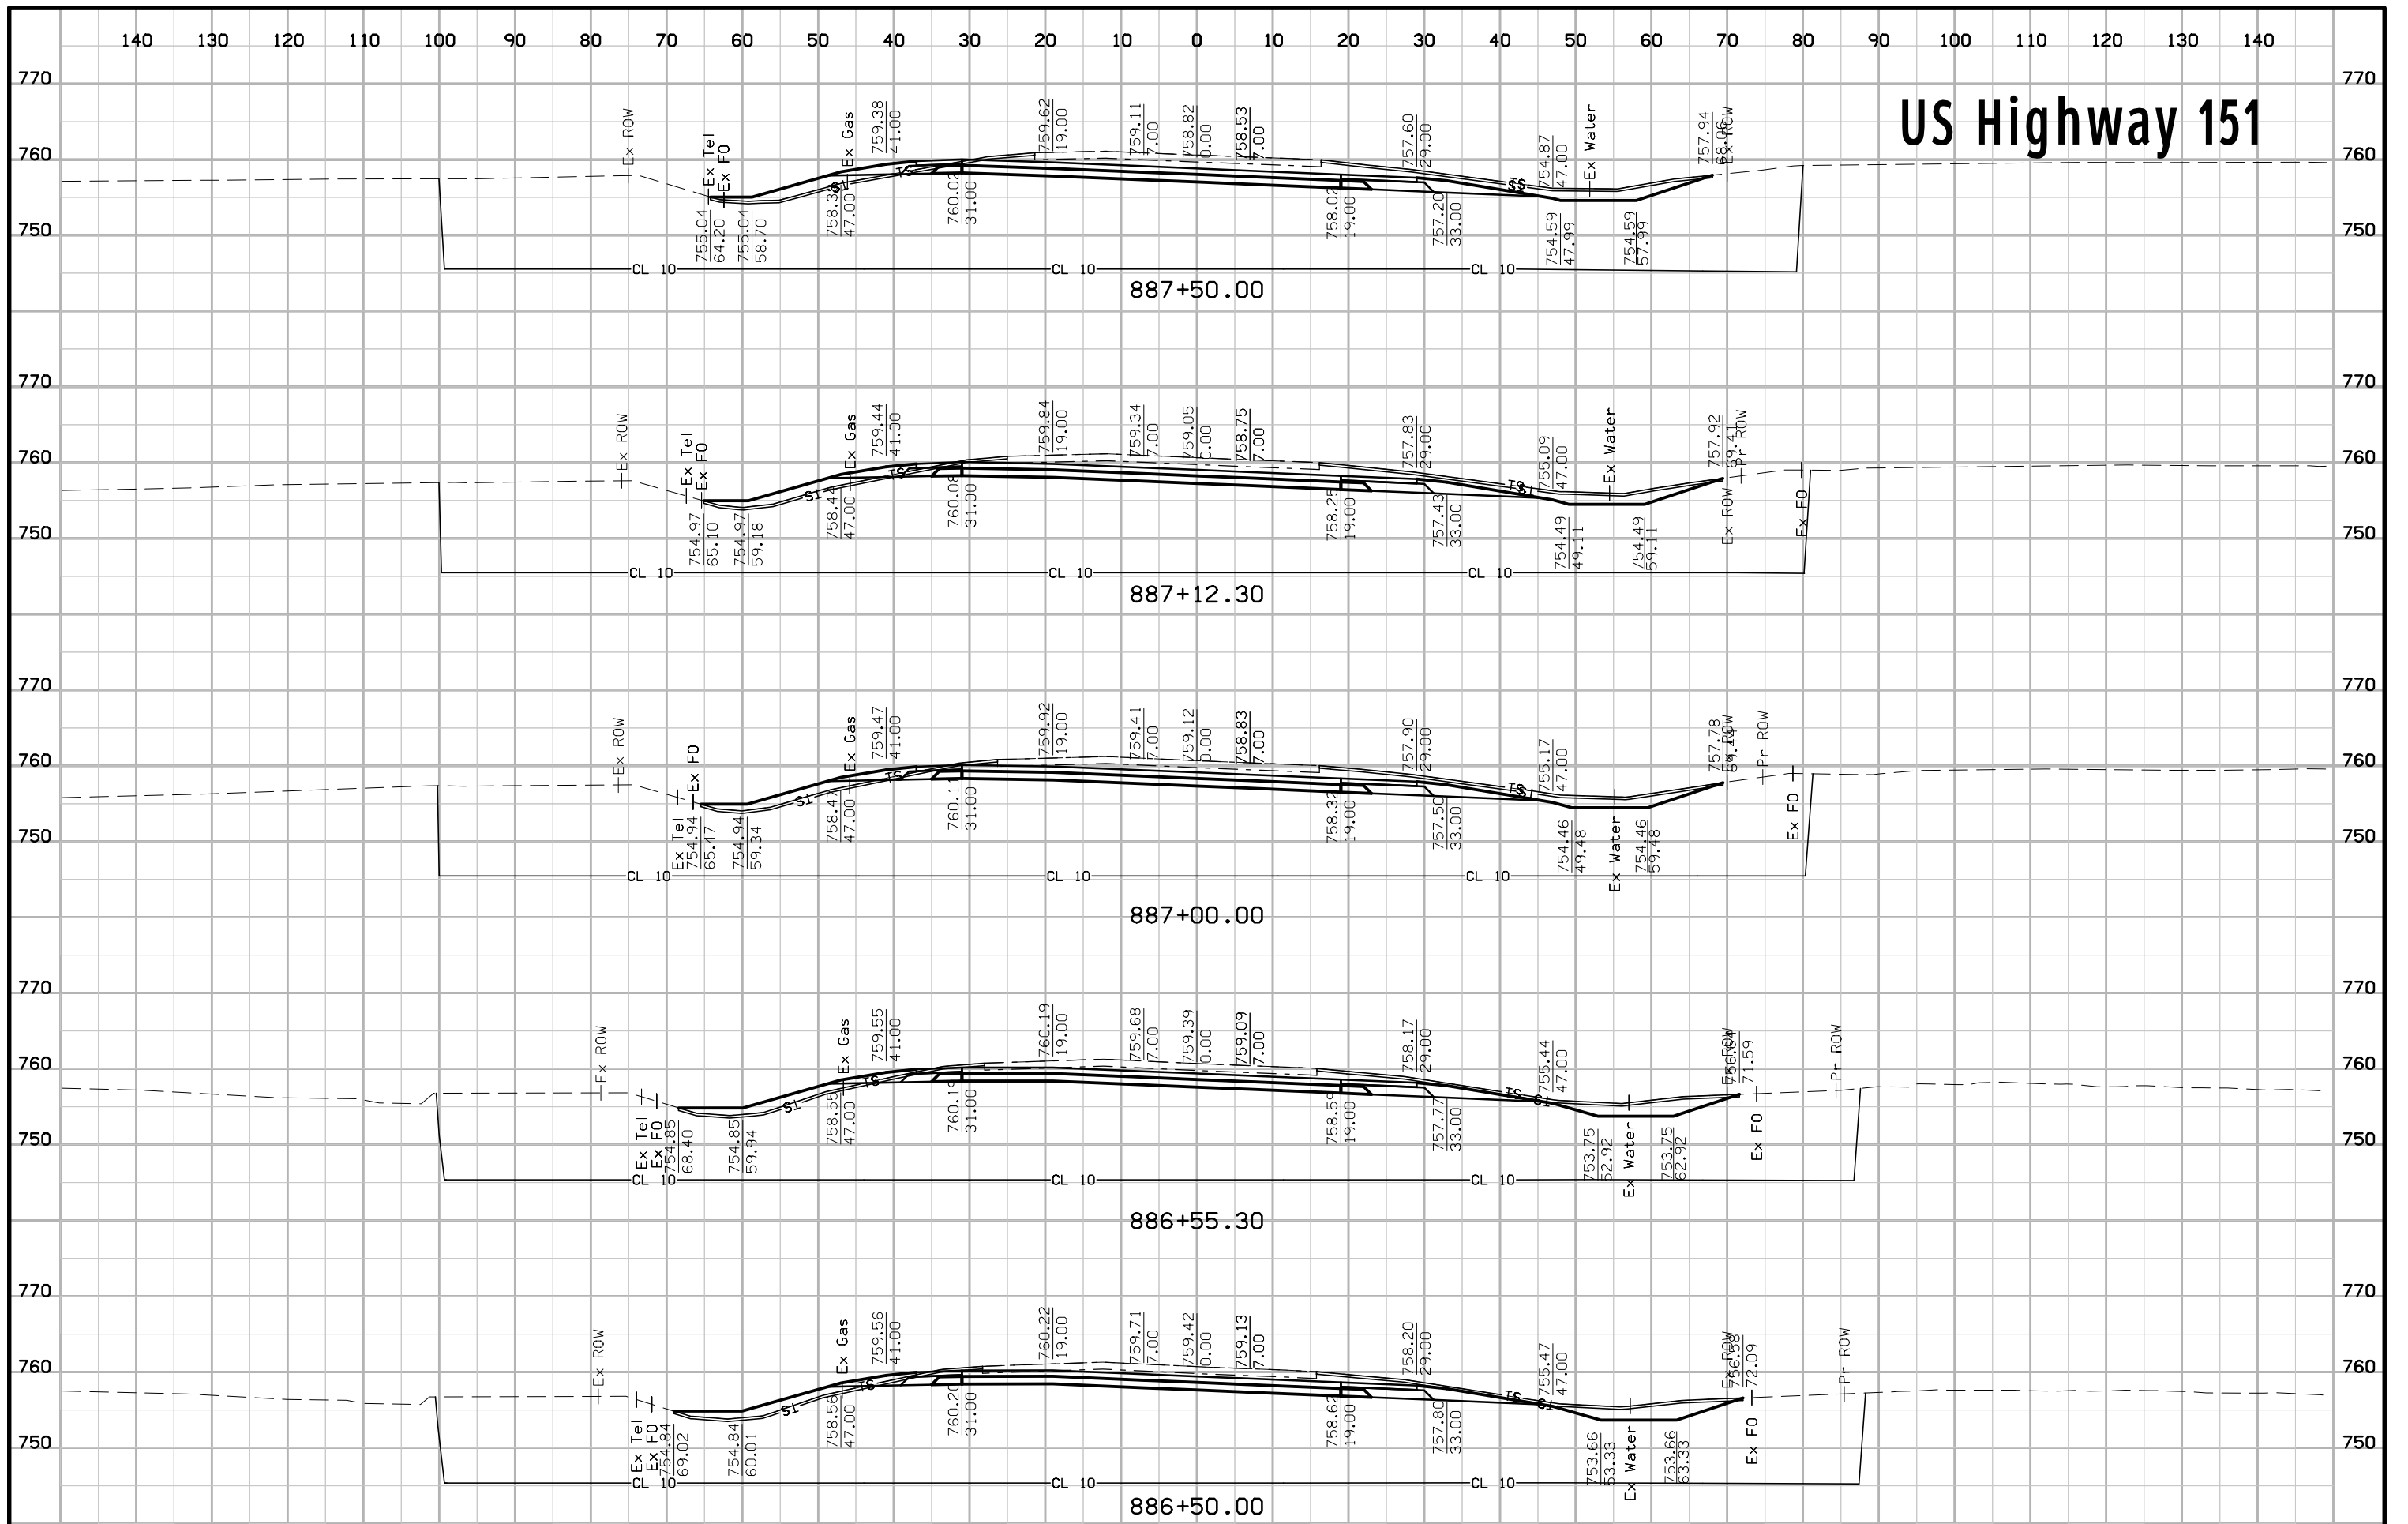


US Highway 151

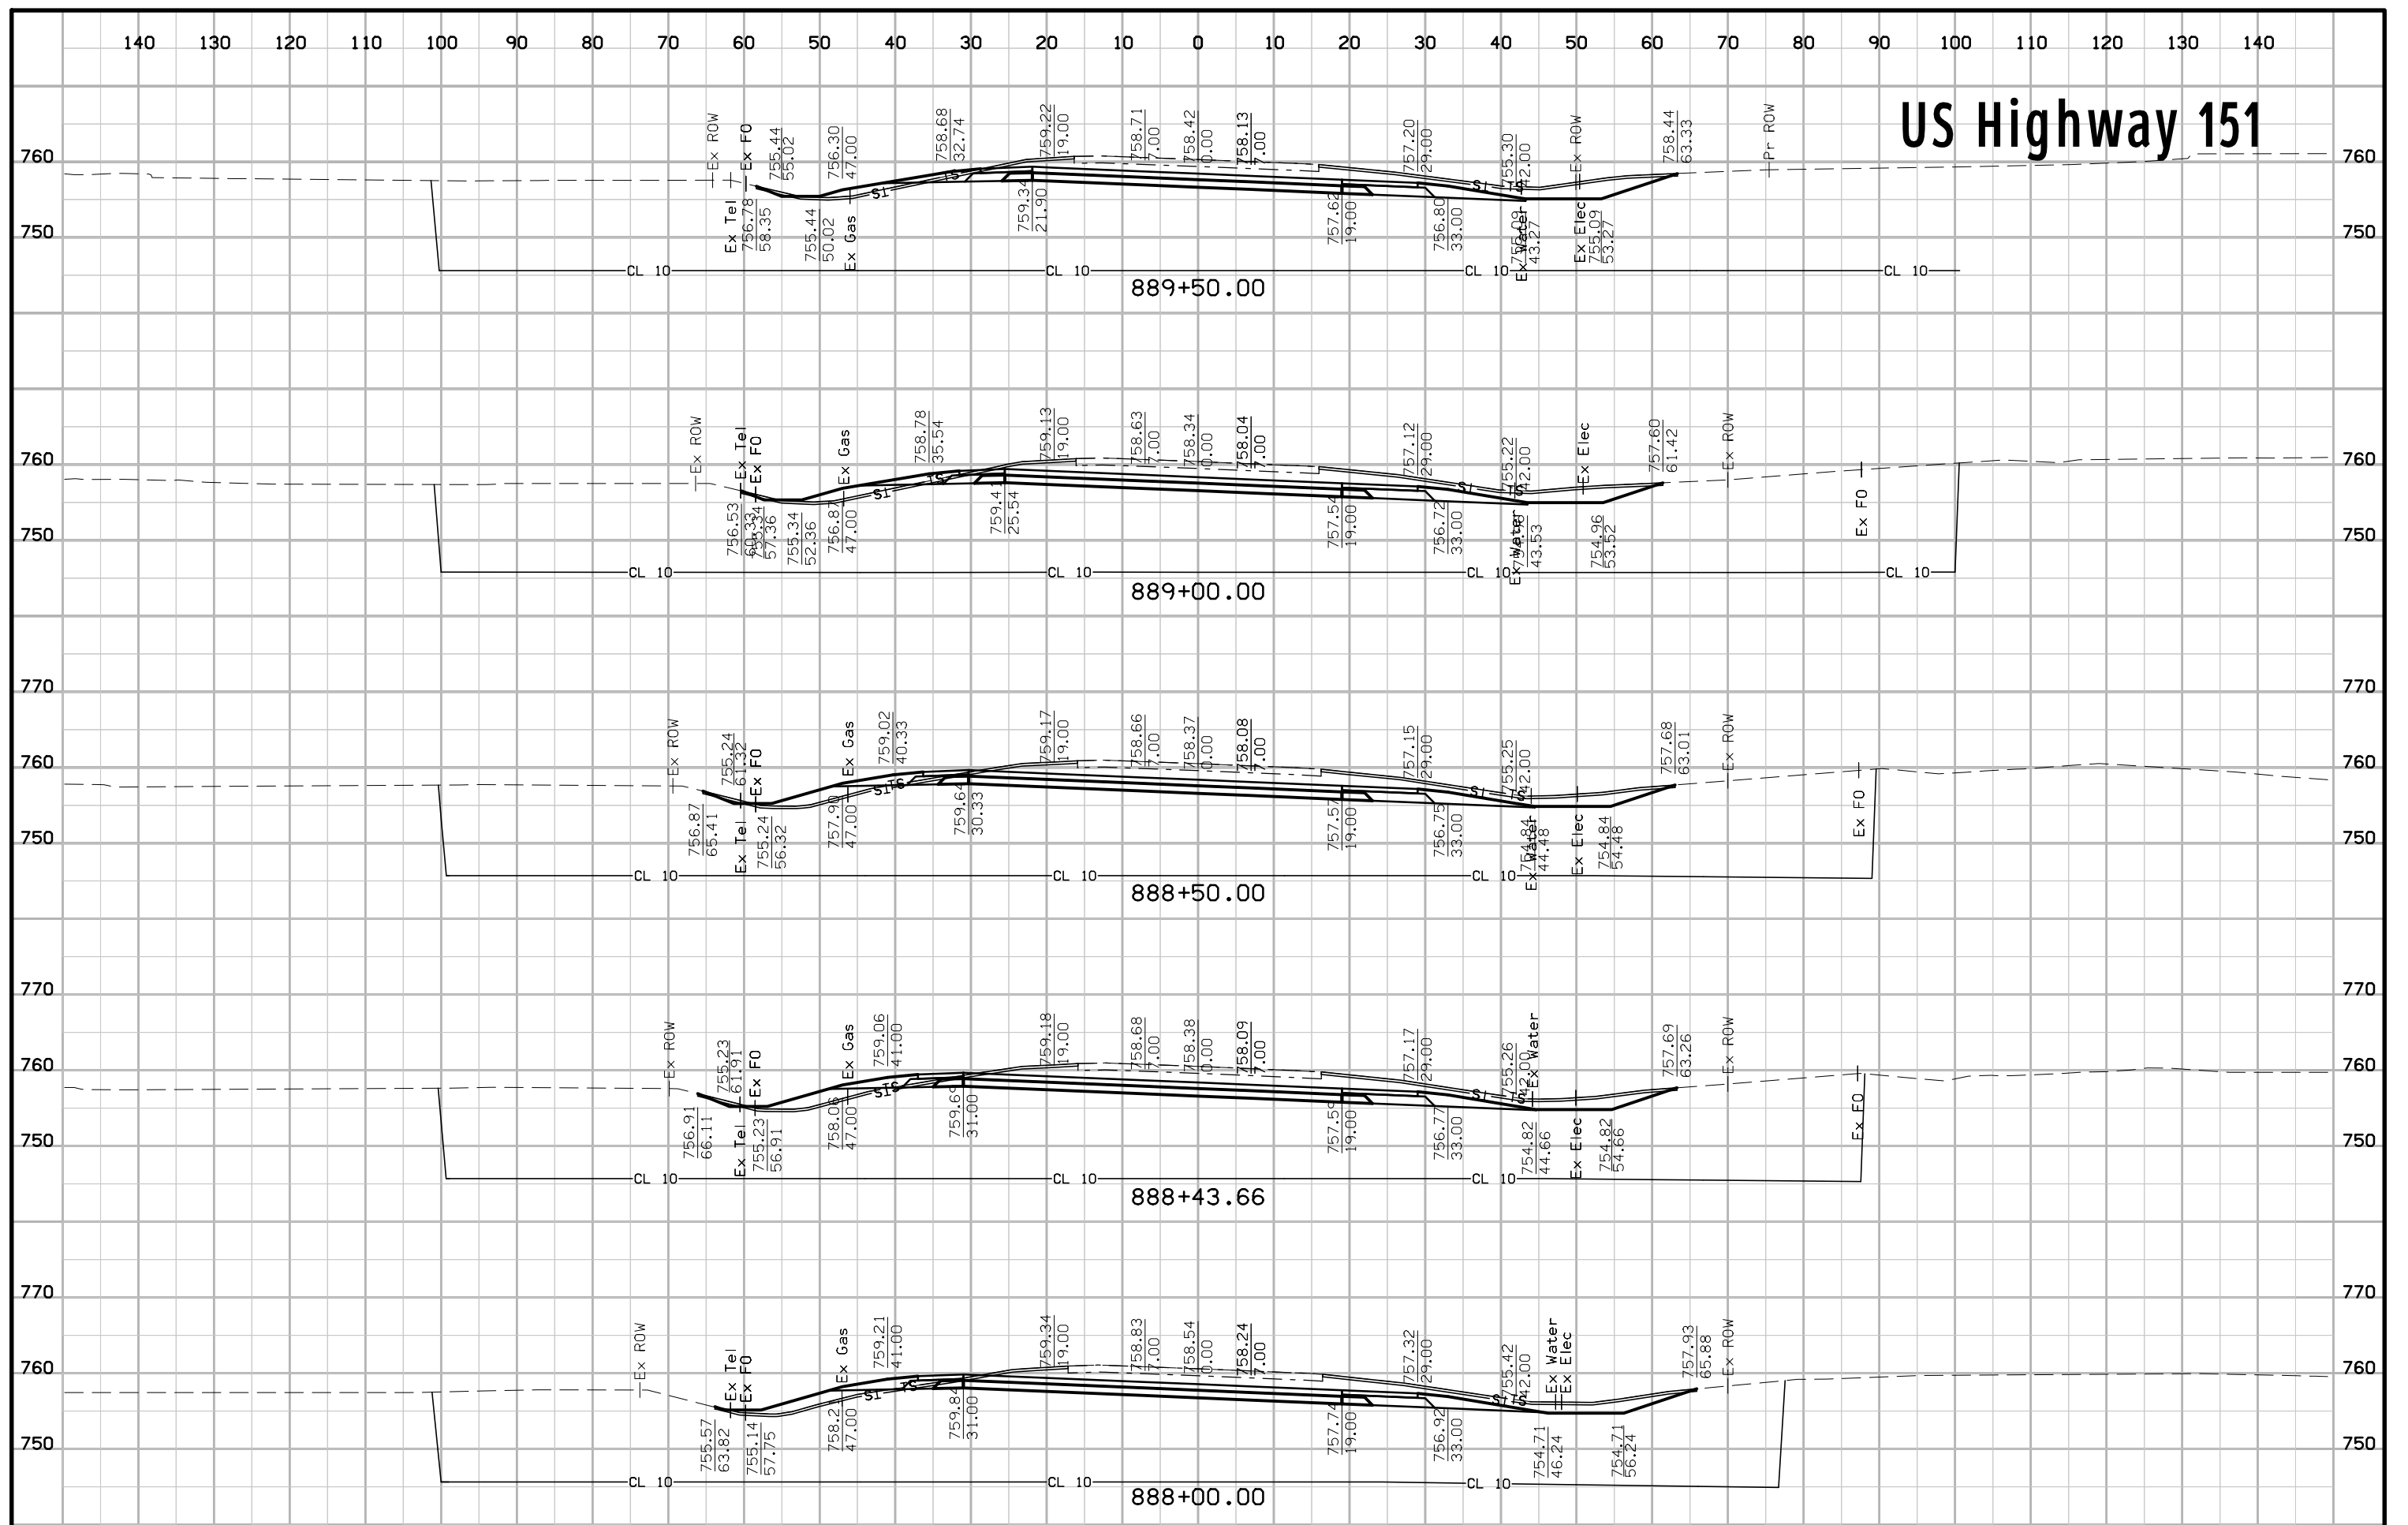


US Highway 151

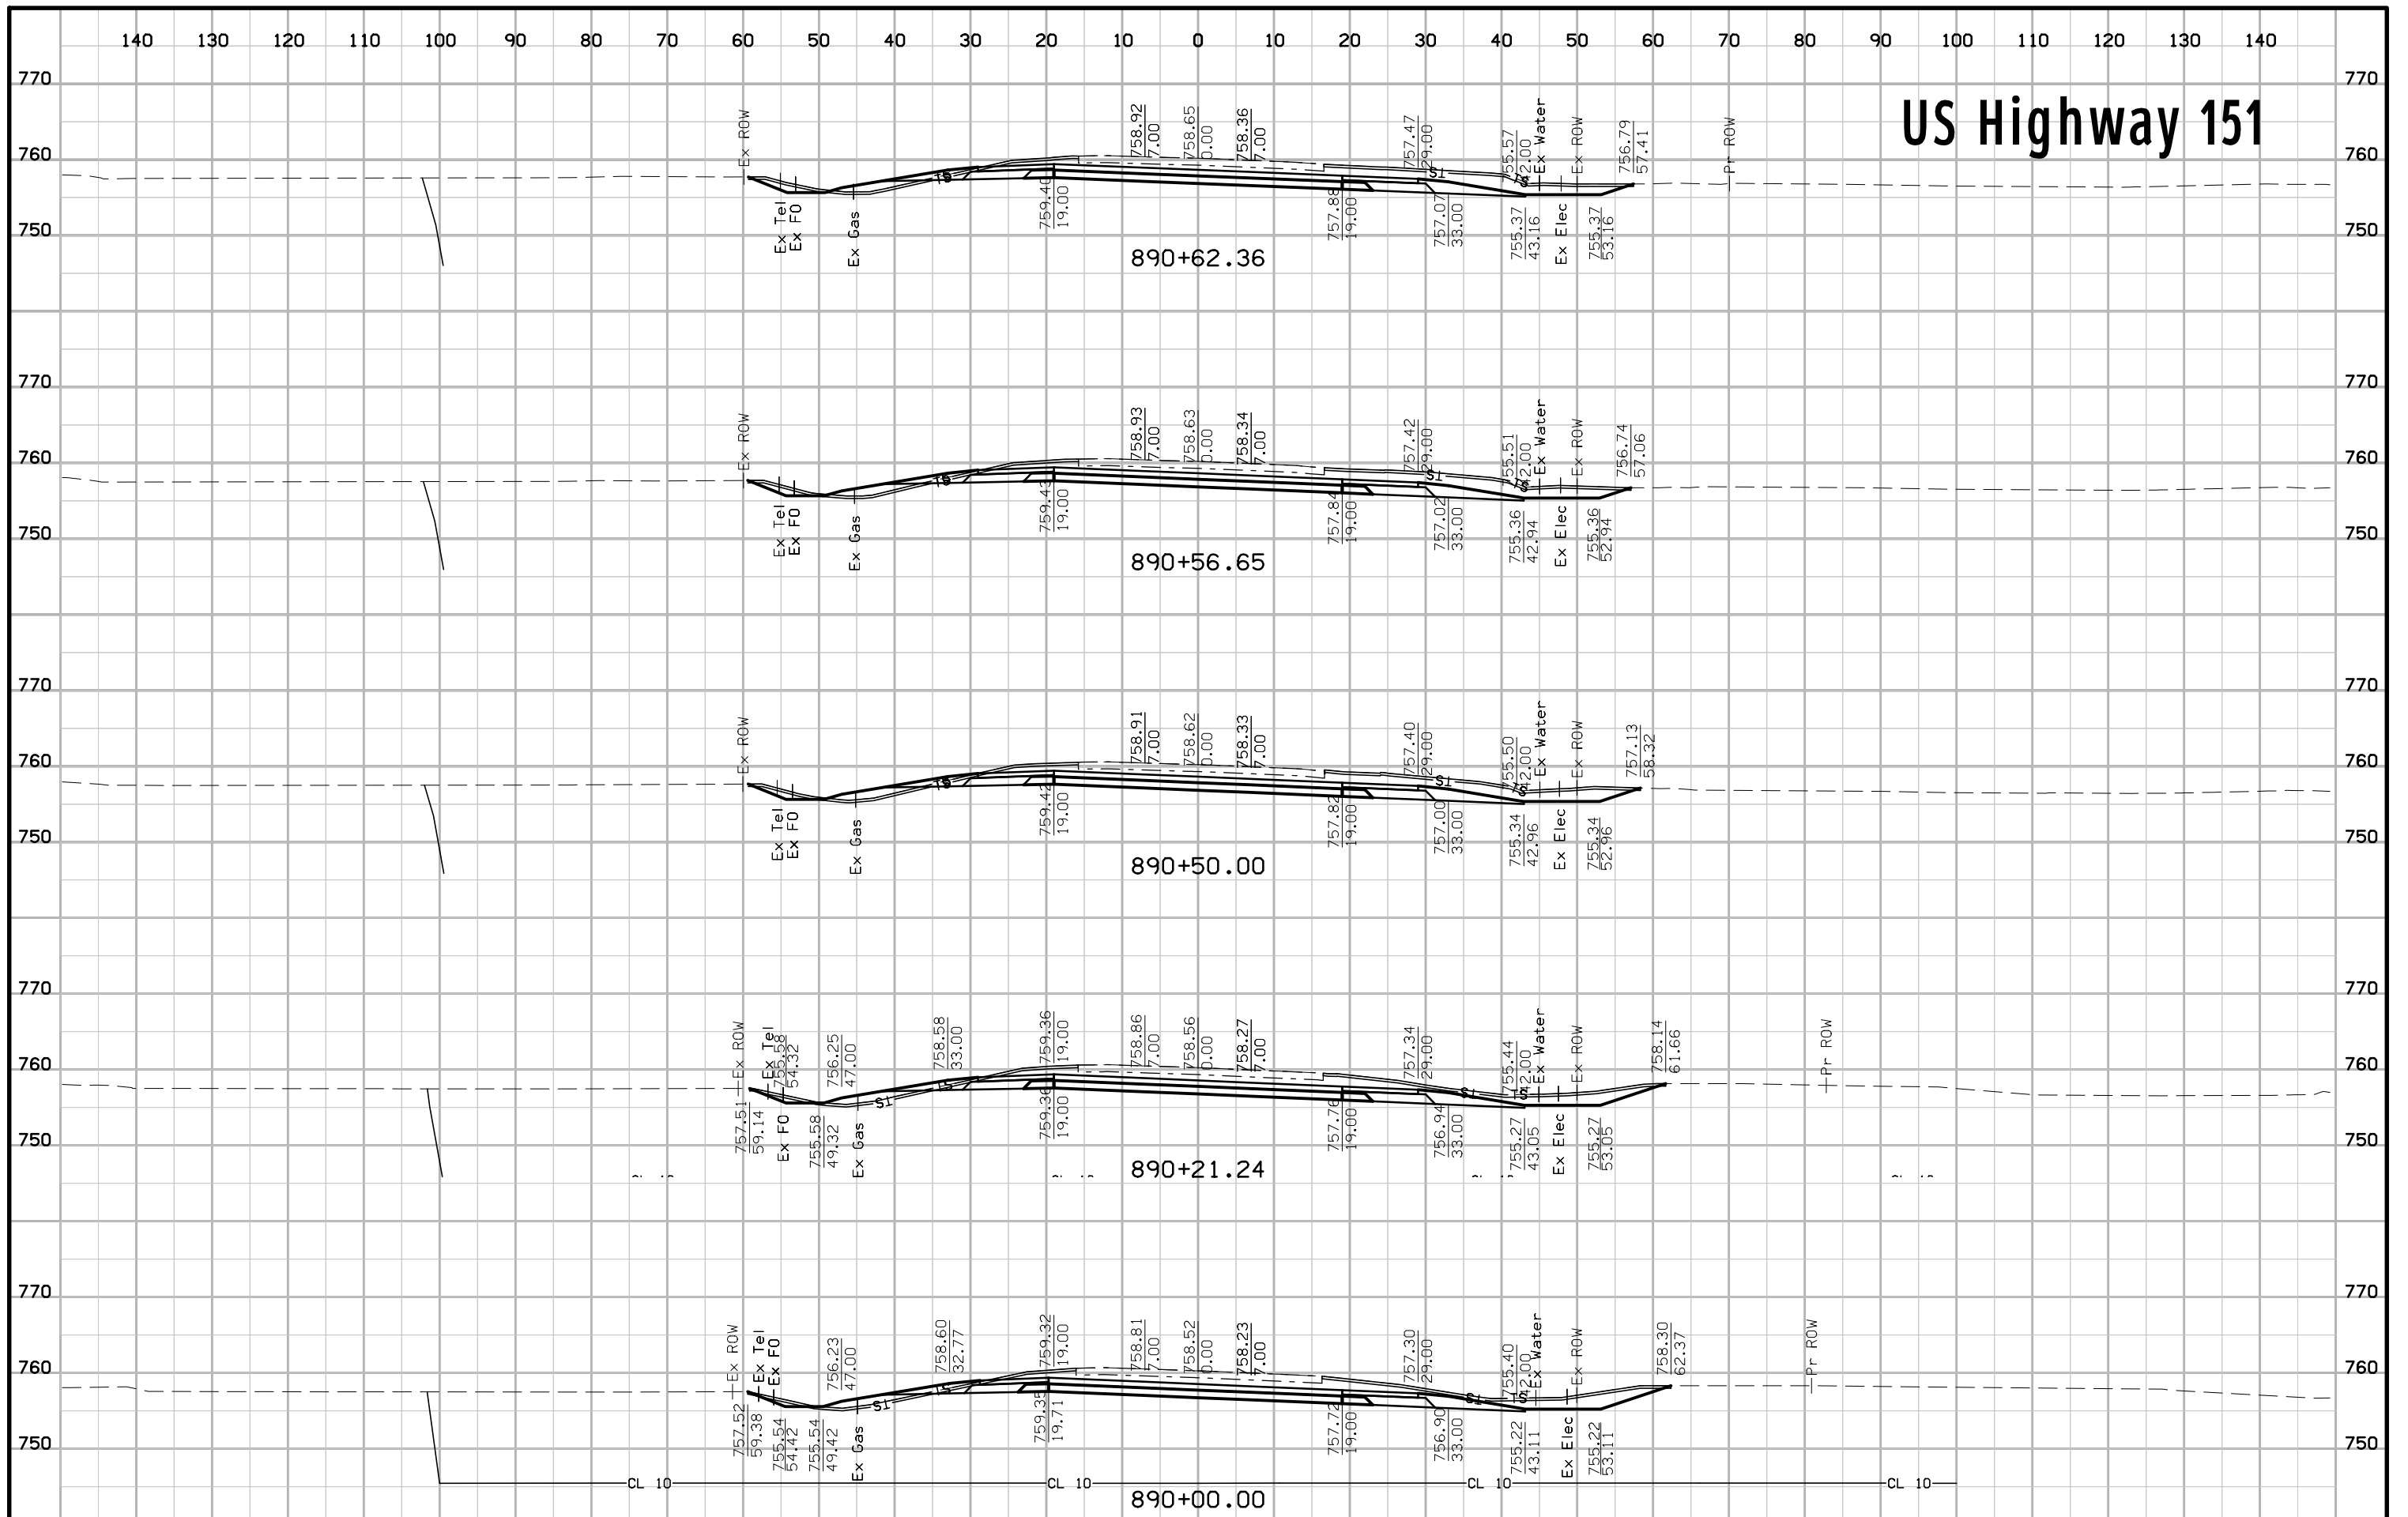


US Highway 151

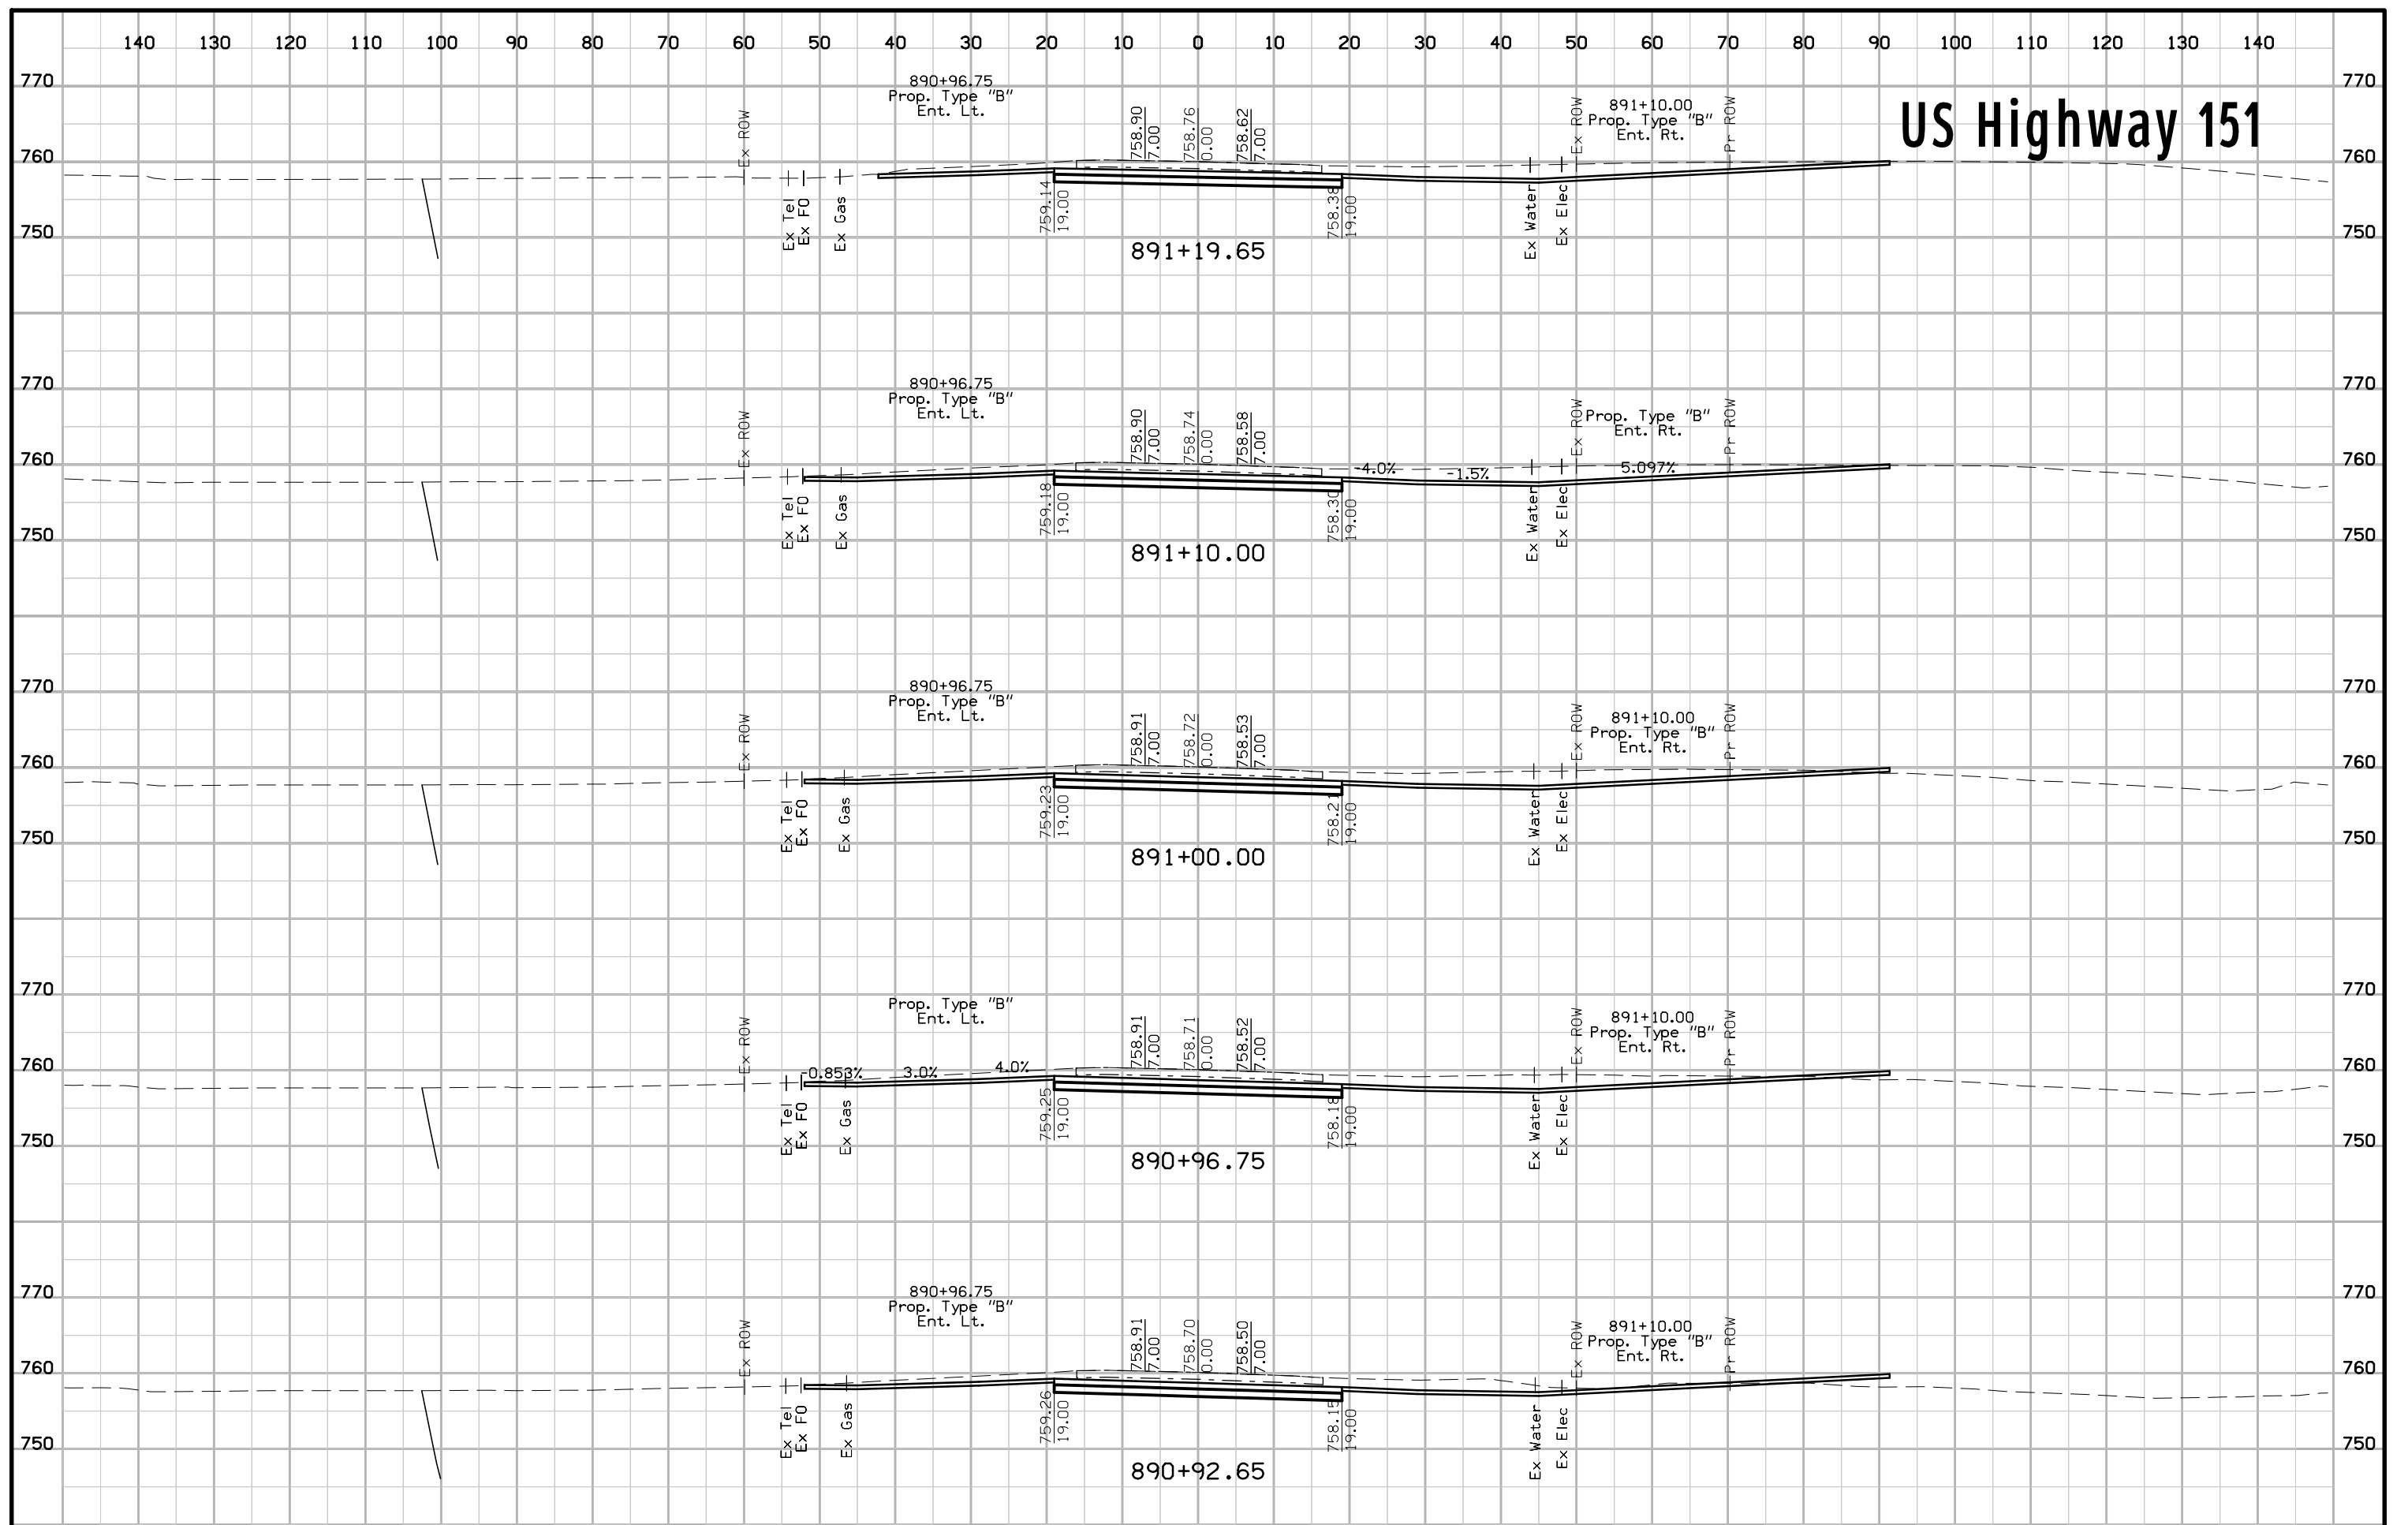


US Highway 151

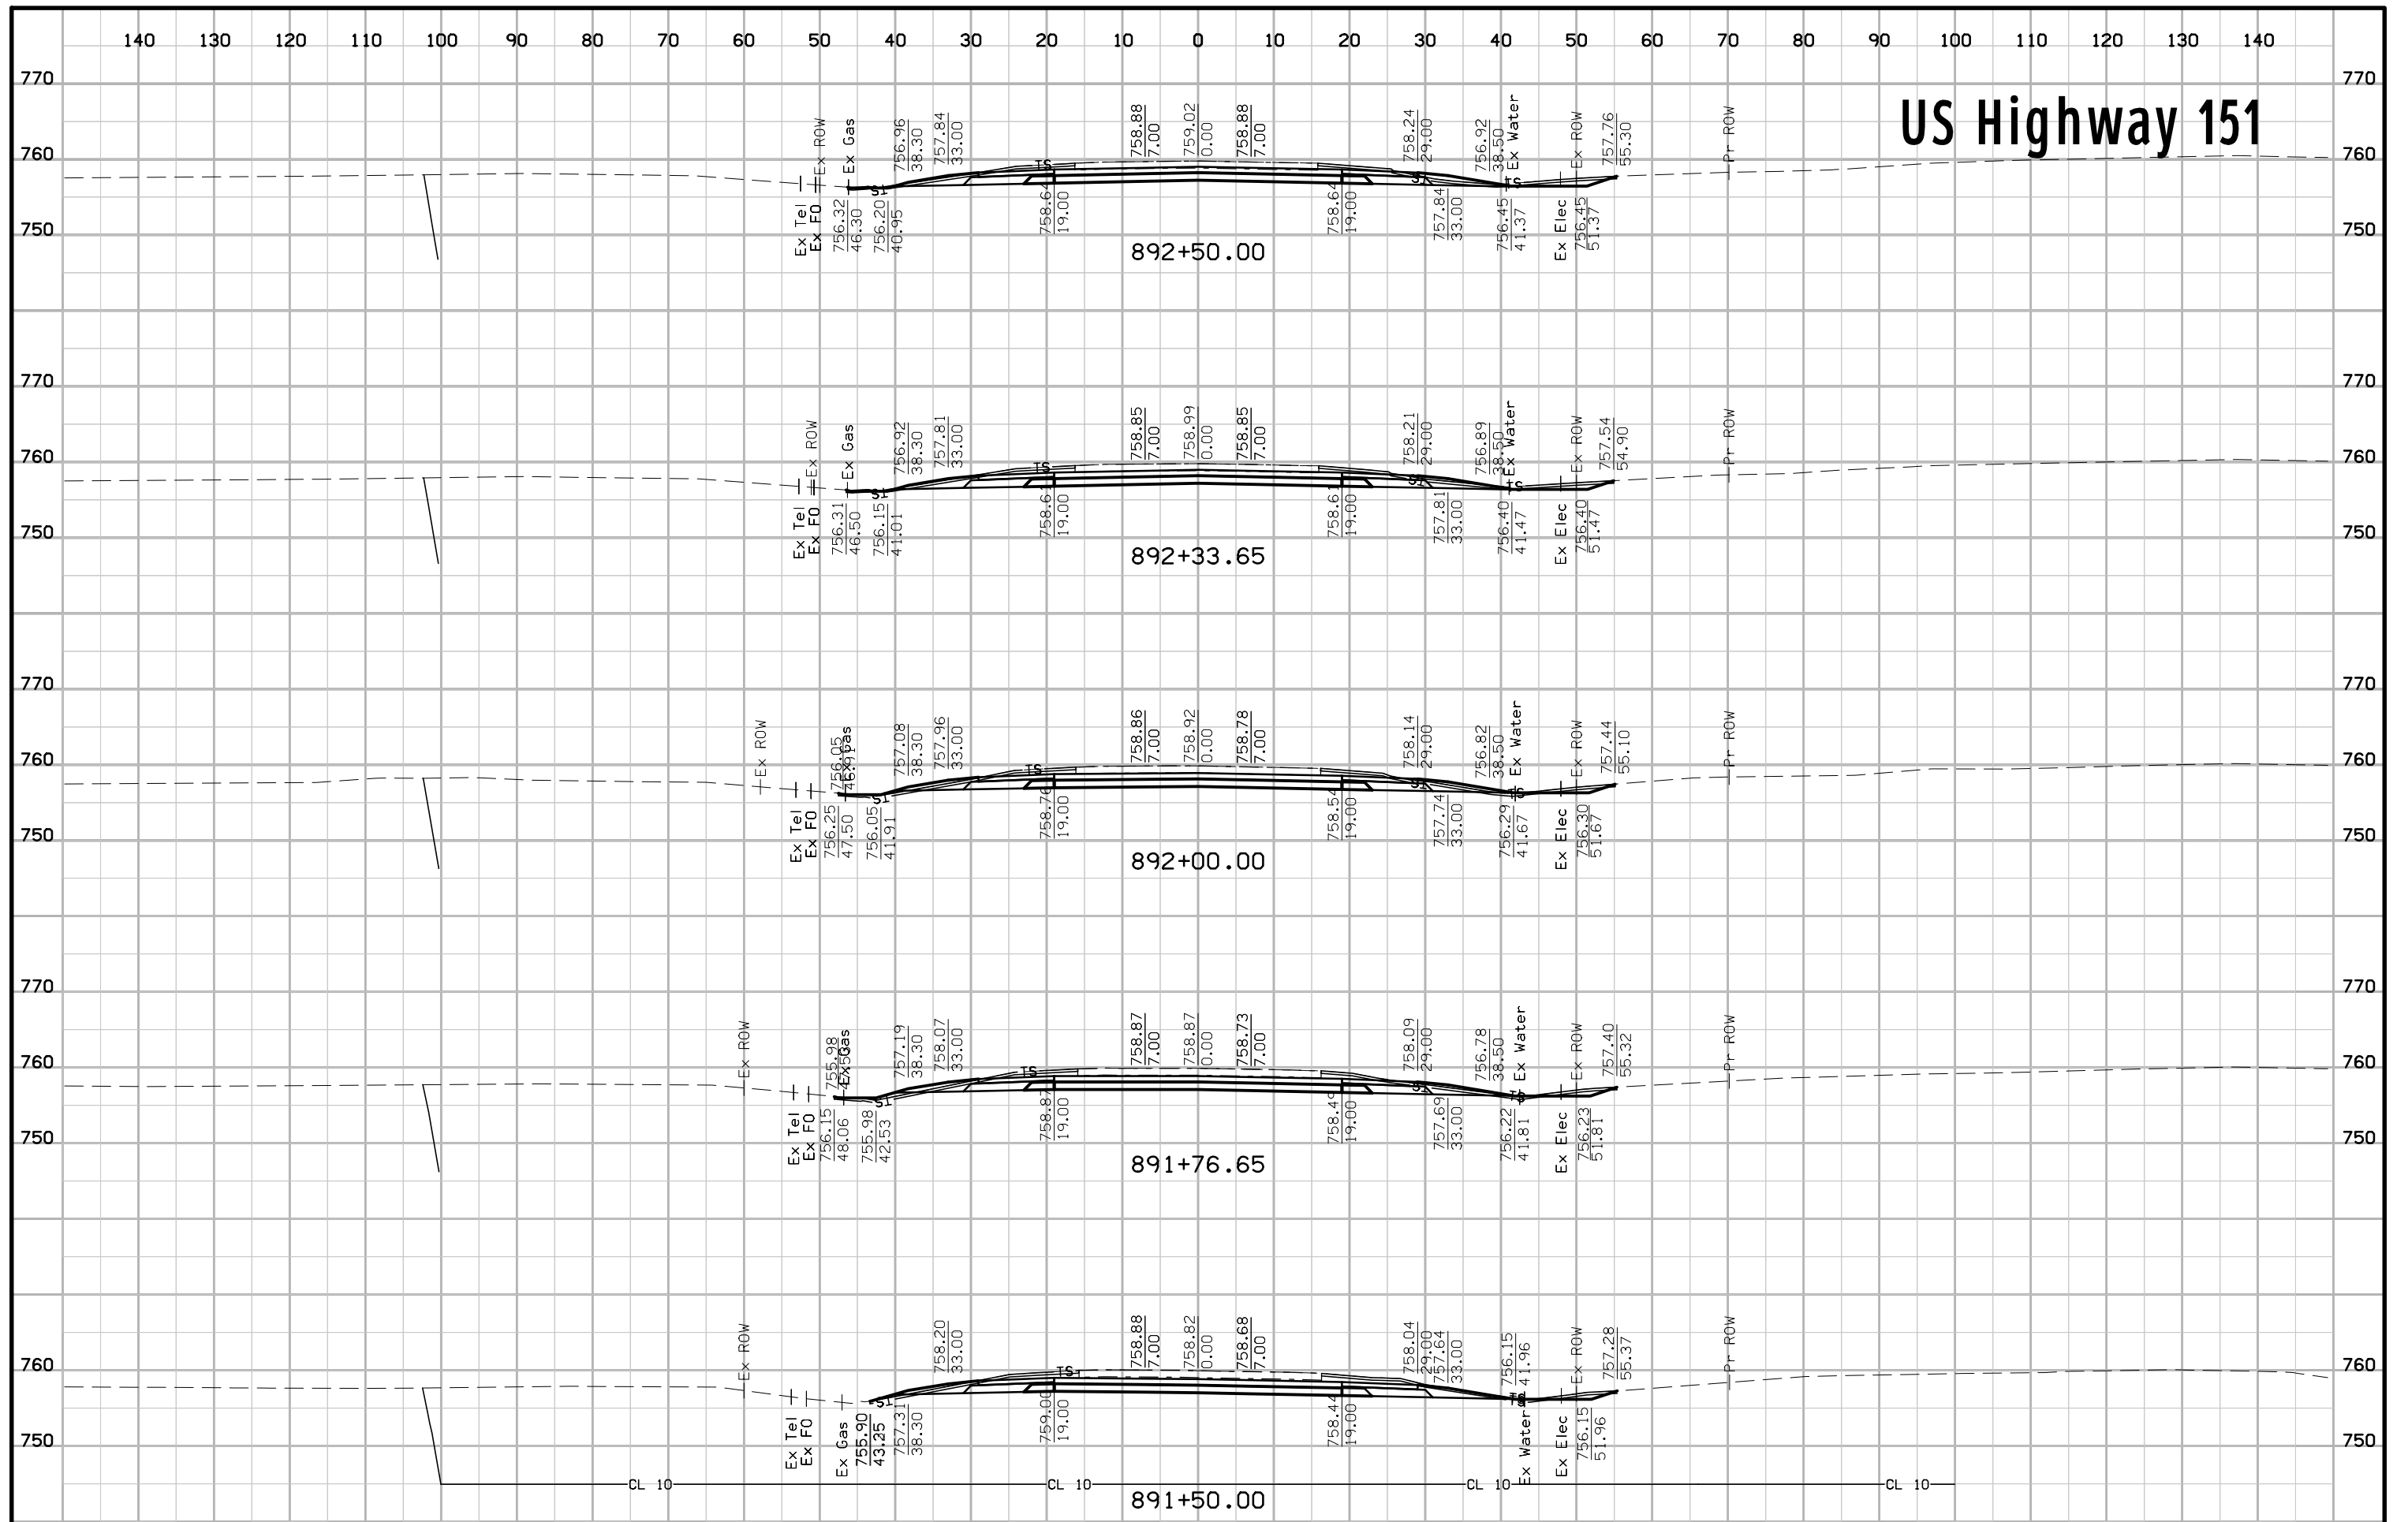


US Highway 151

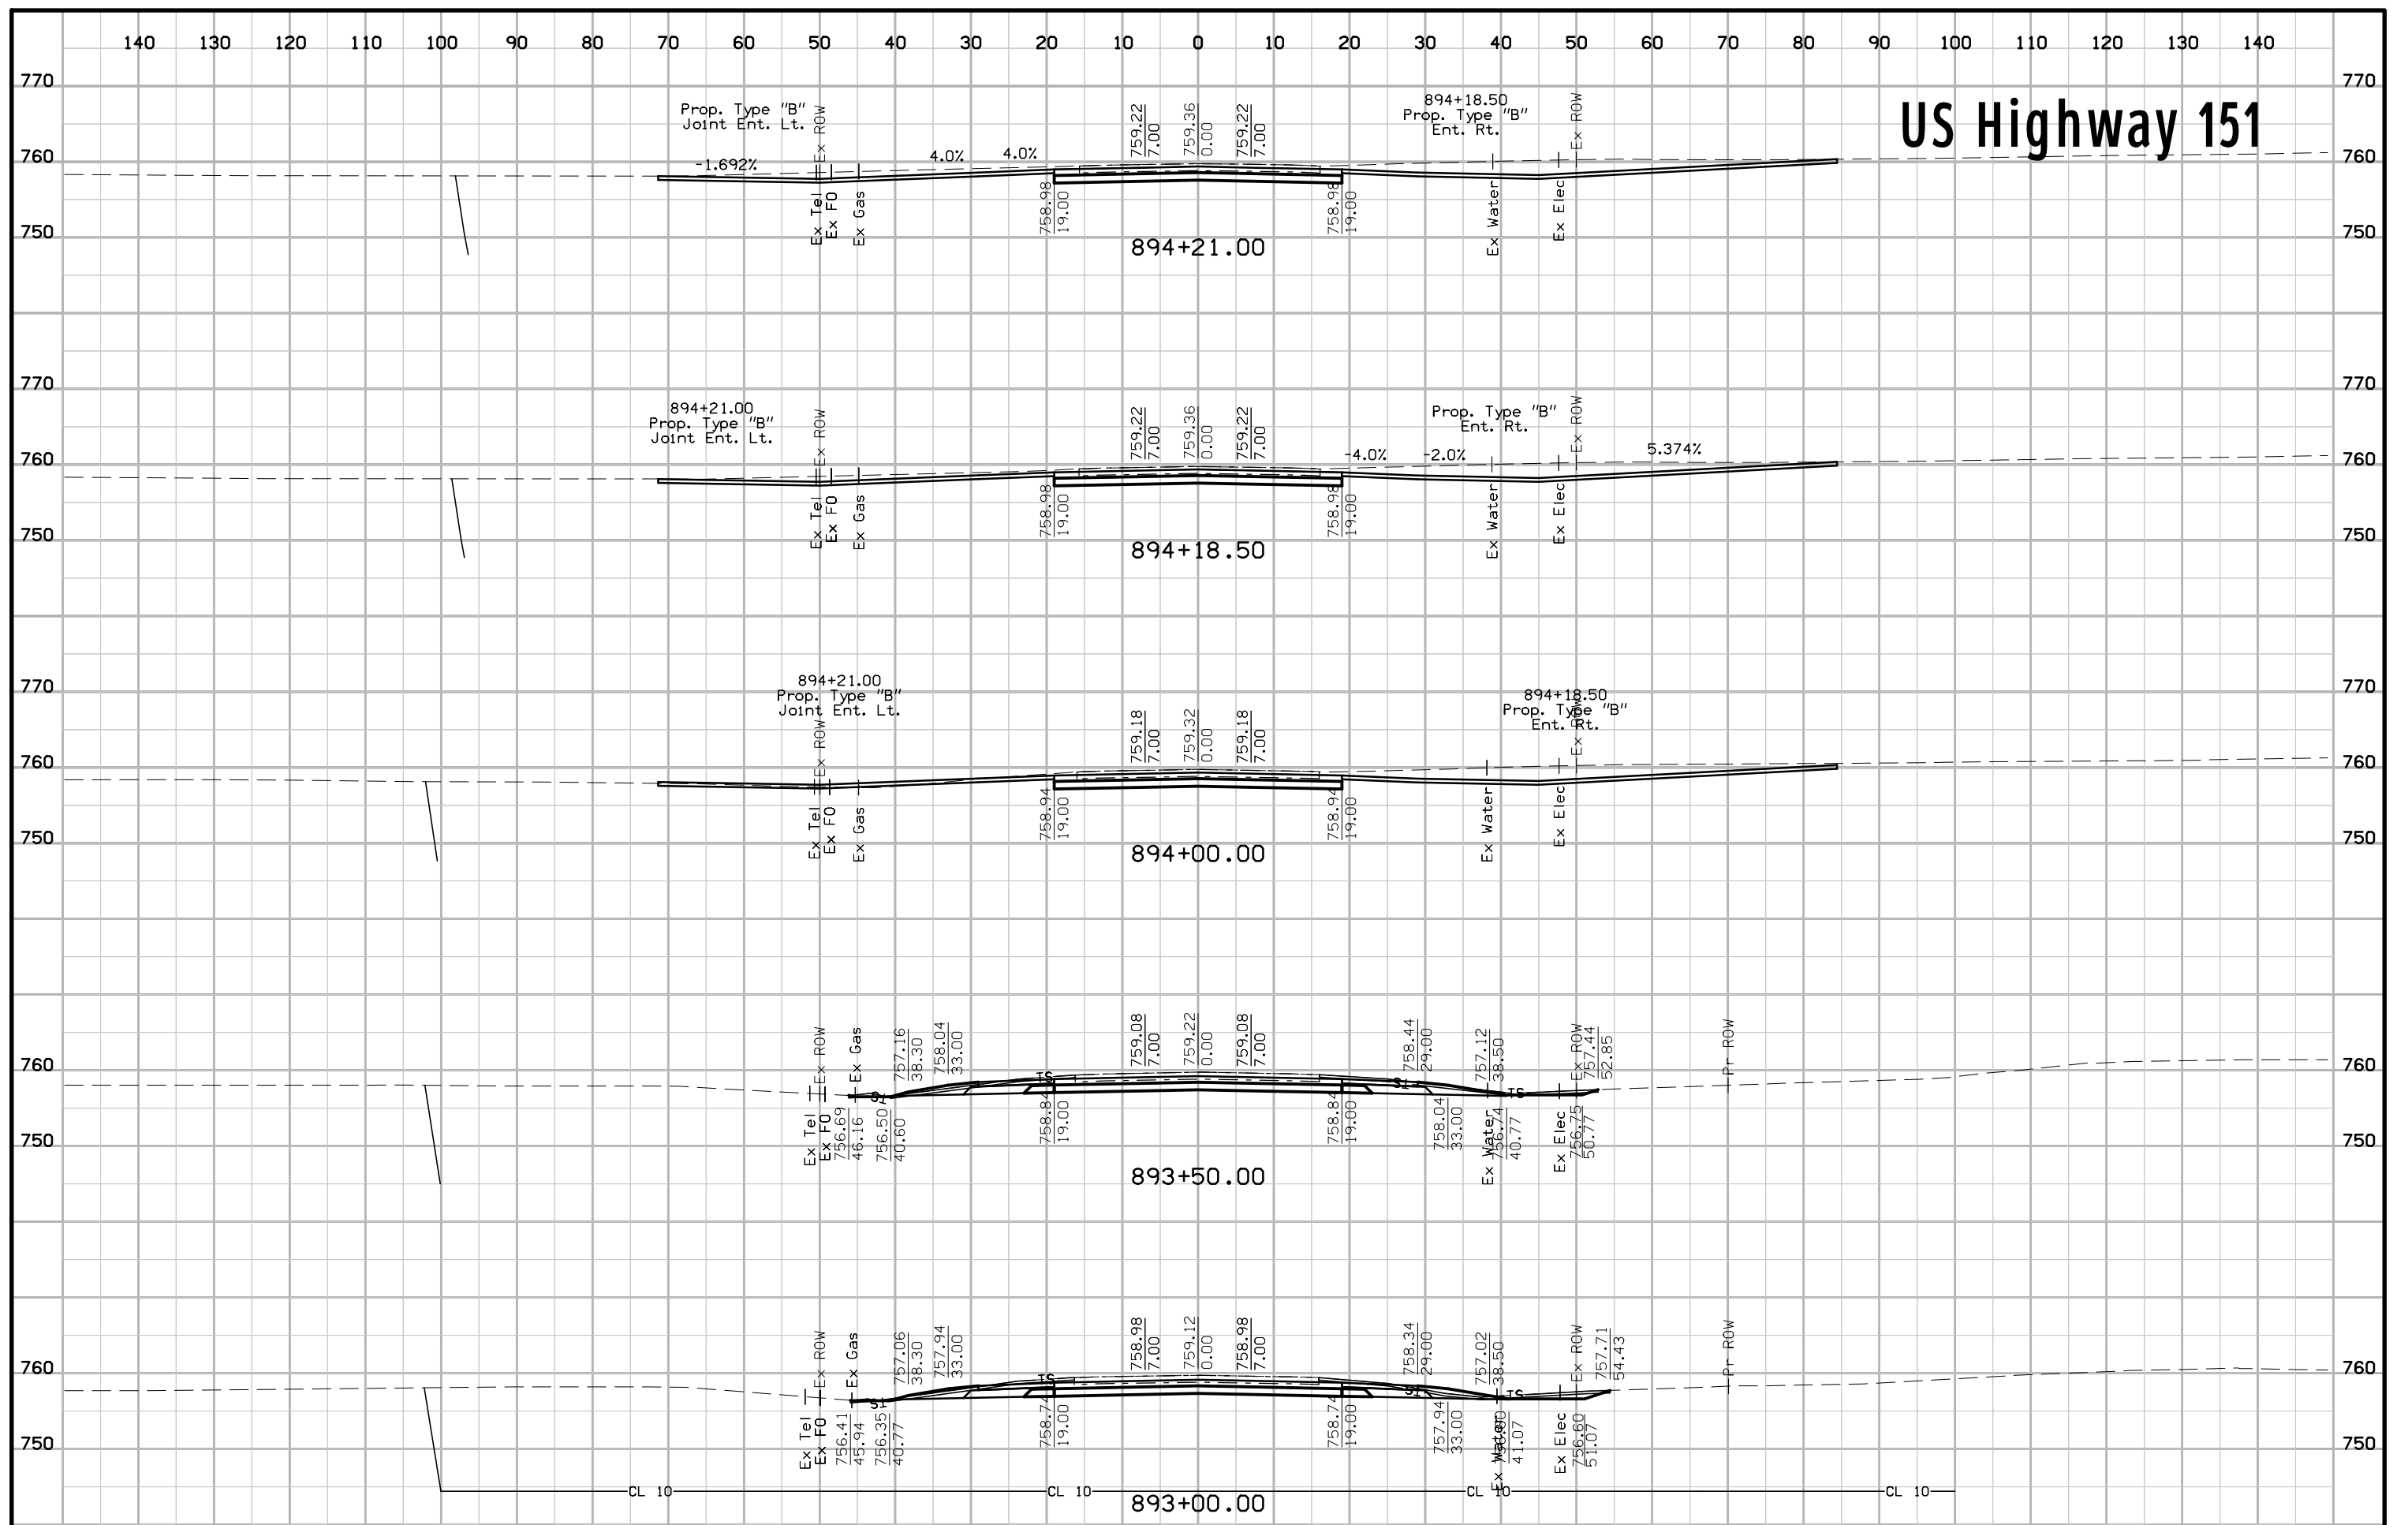


US Highway 151

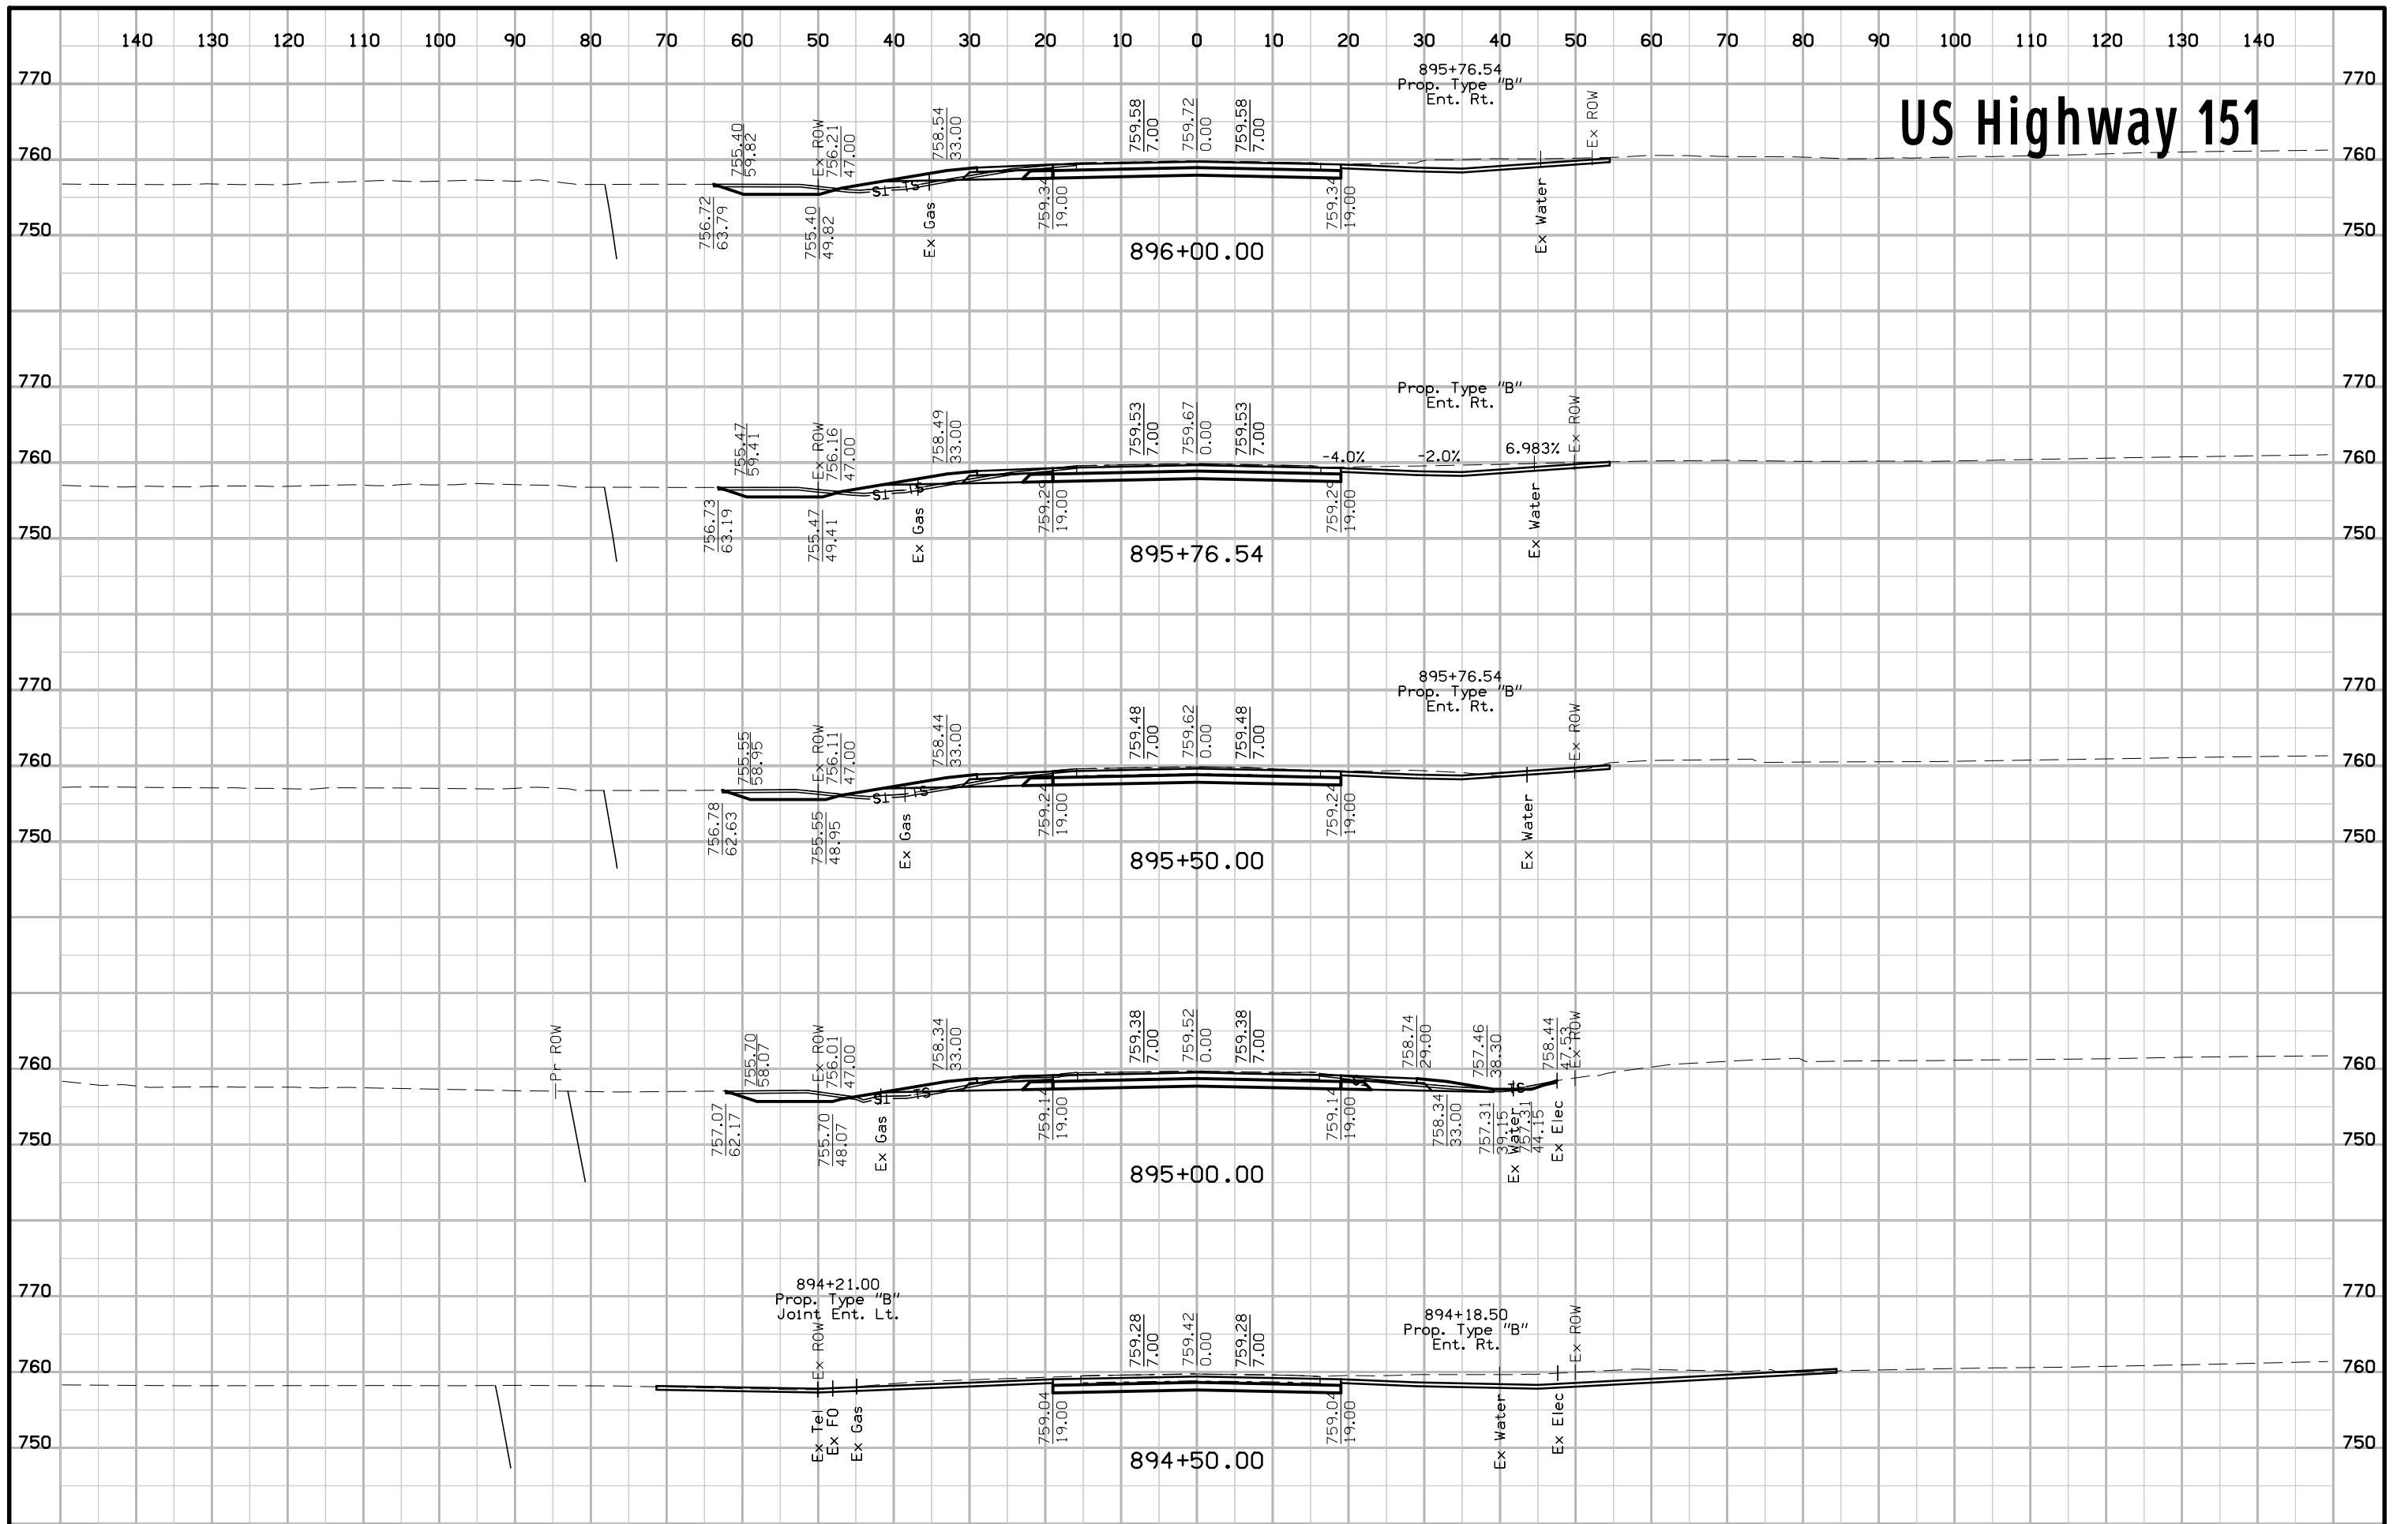


US Highway 151

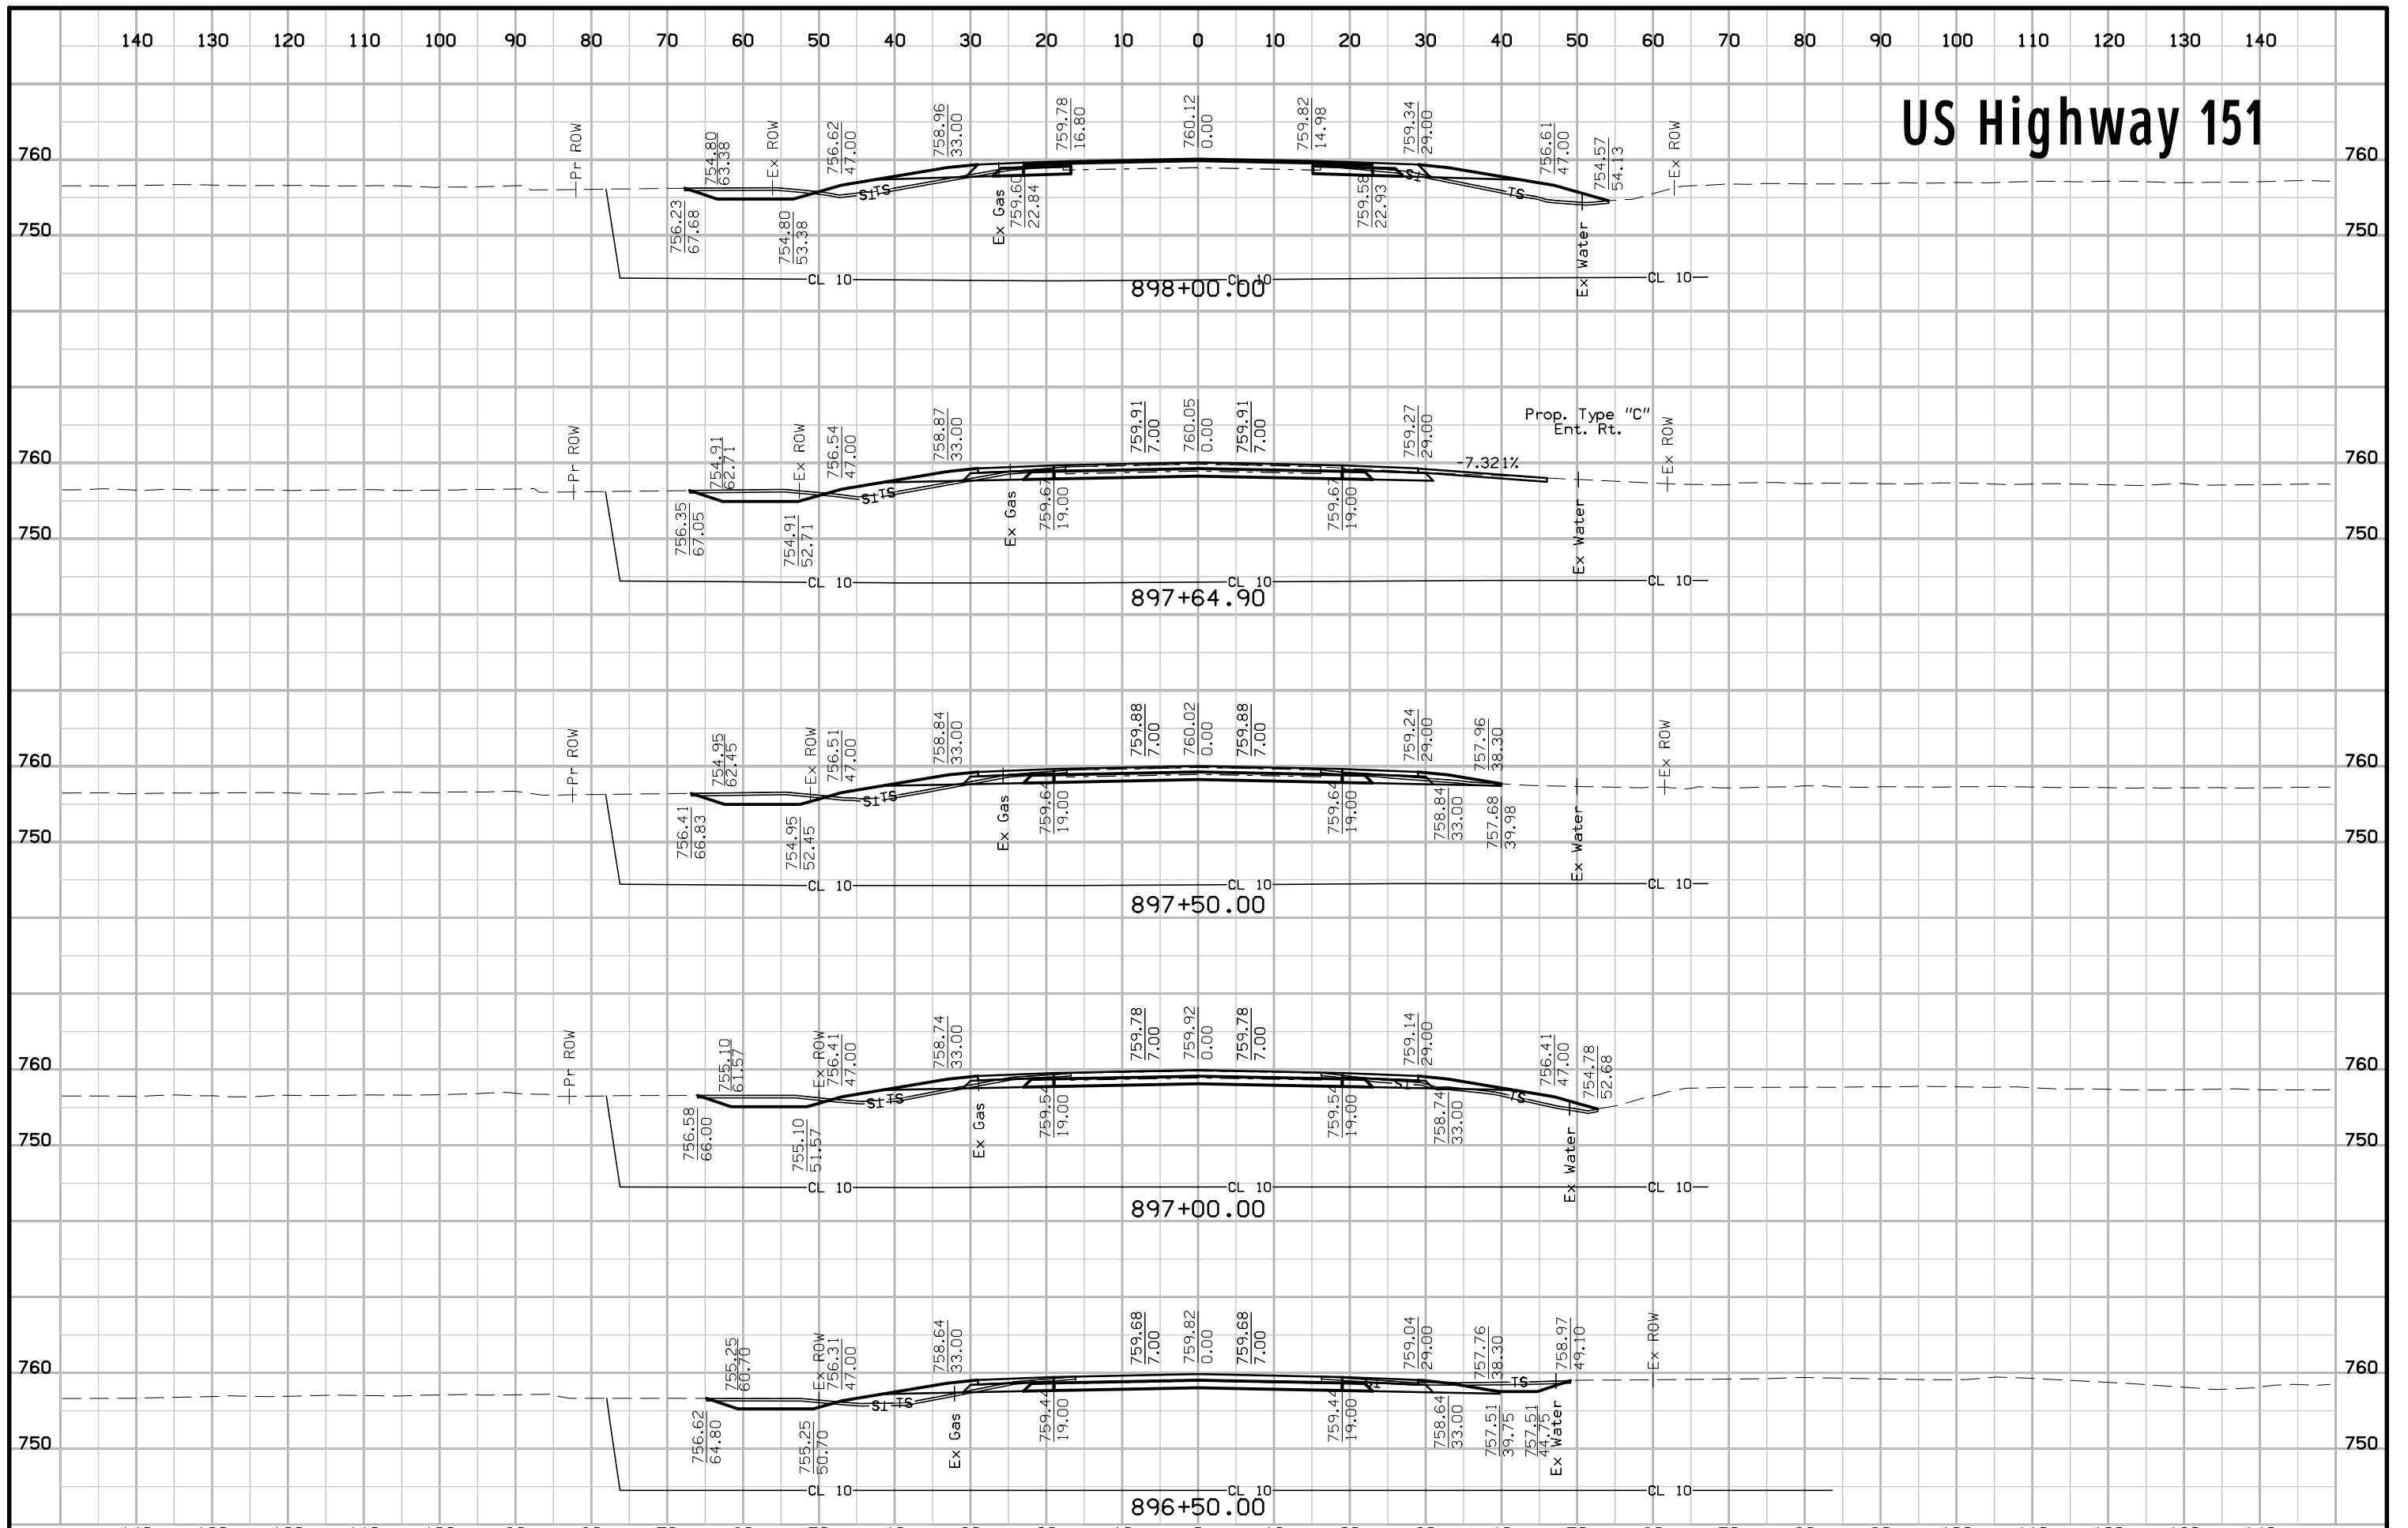


US Highway 151

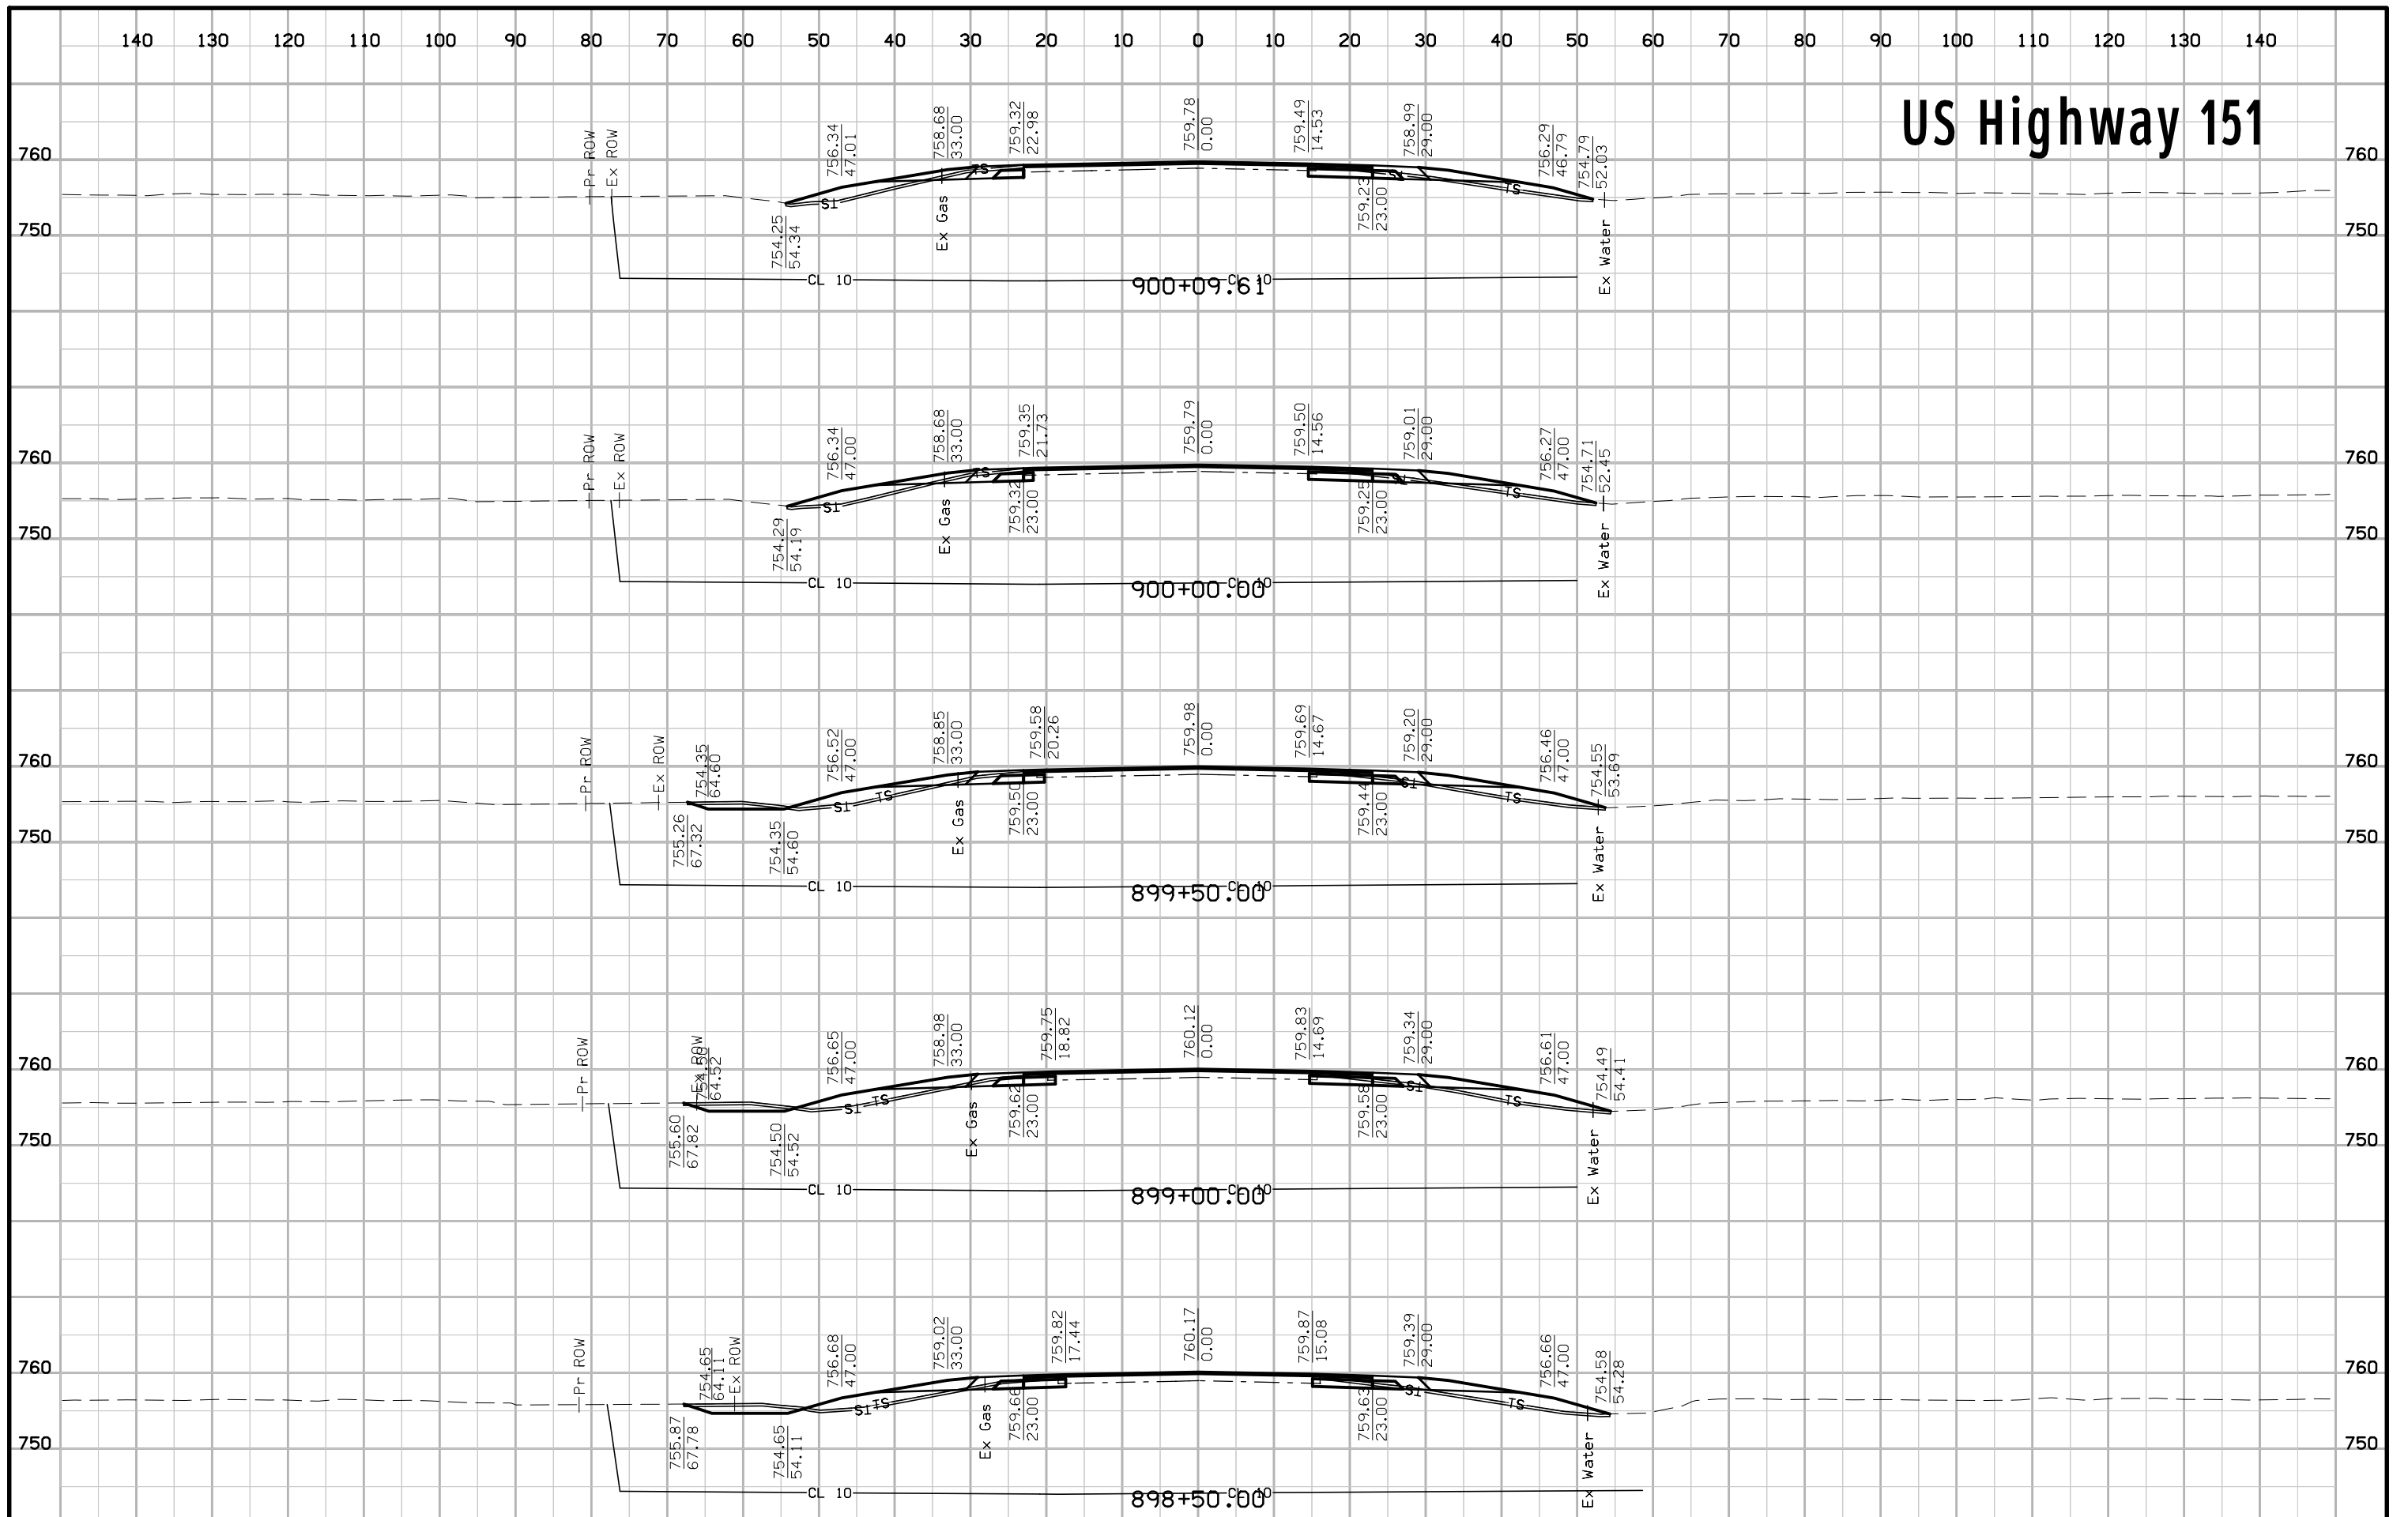


US Highway 151

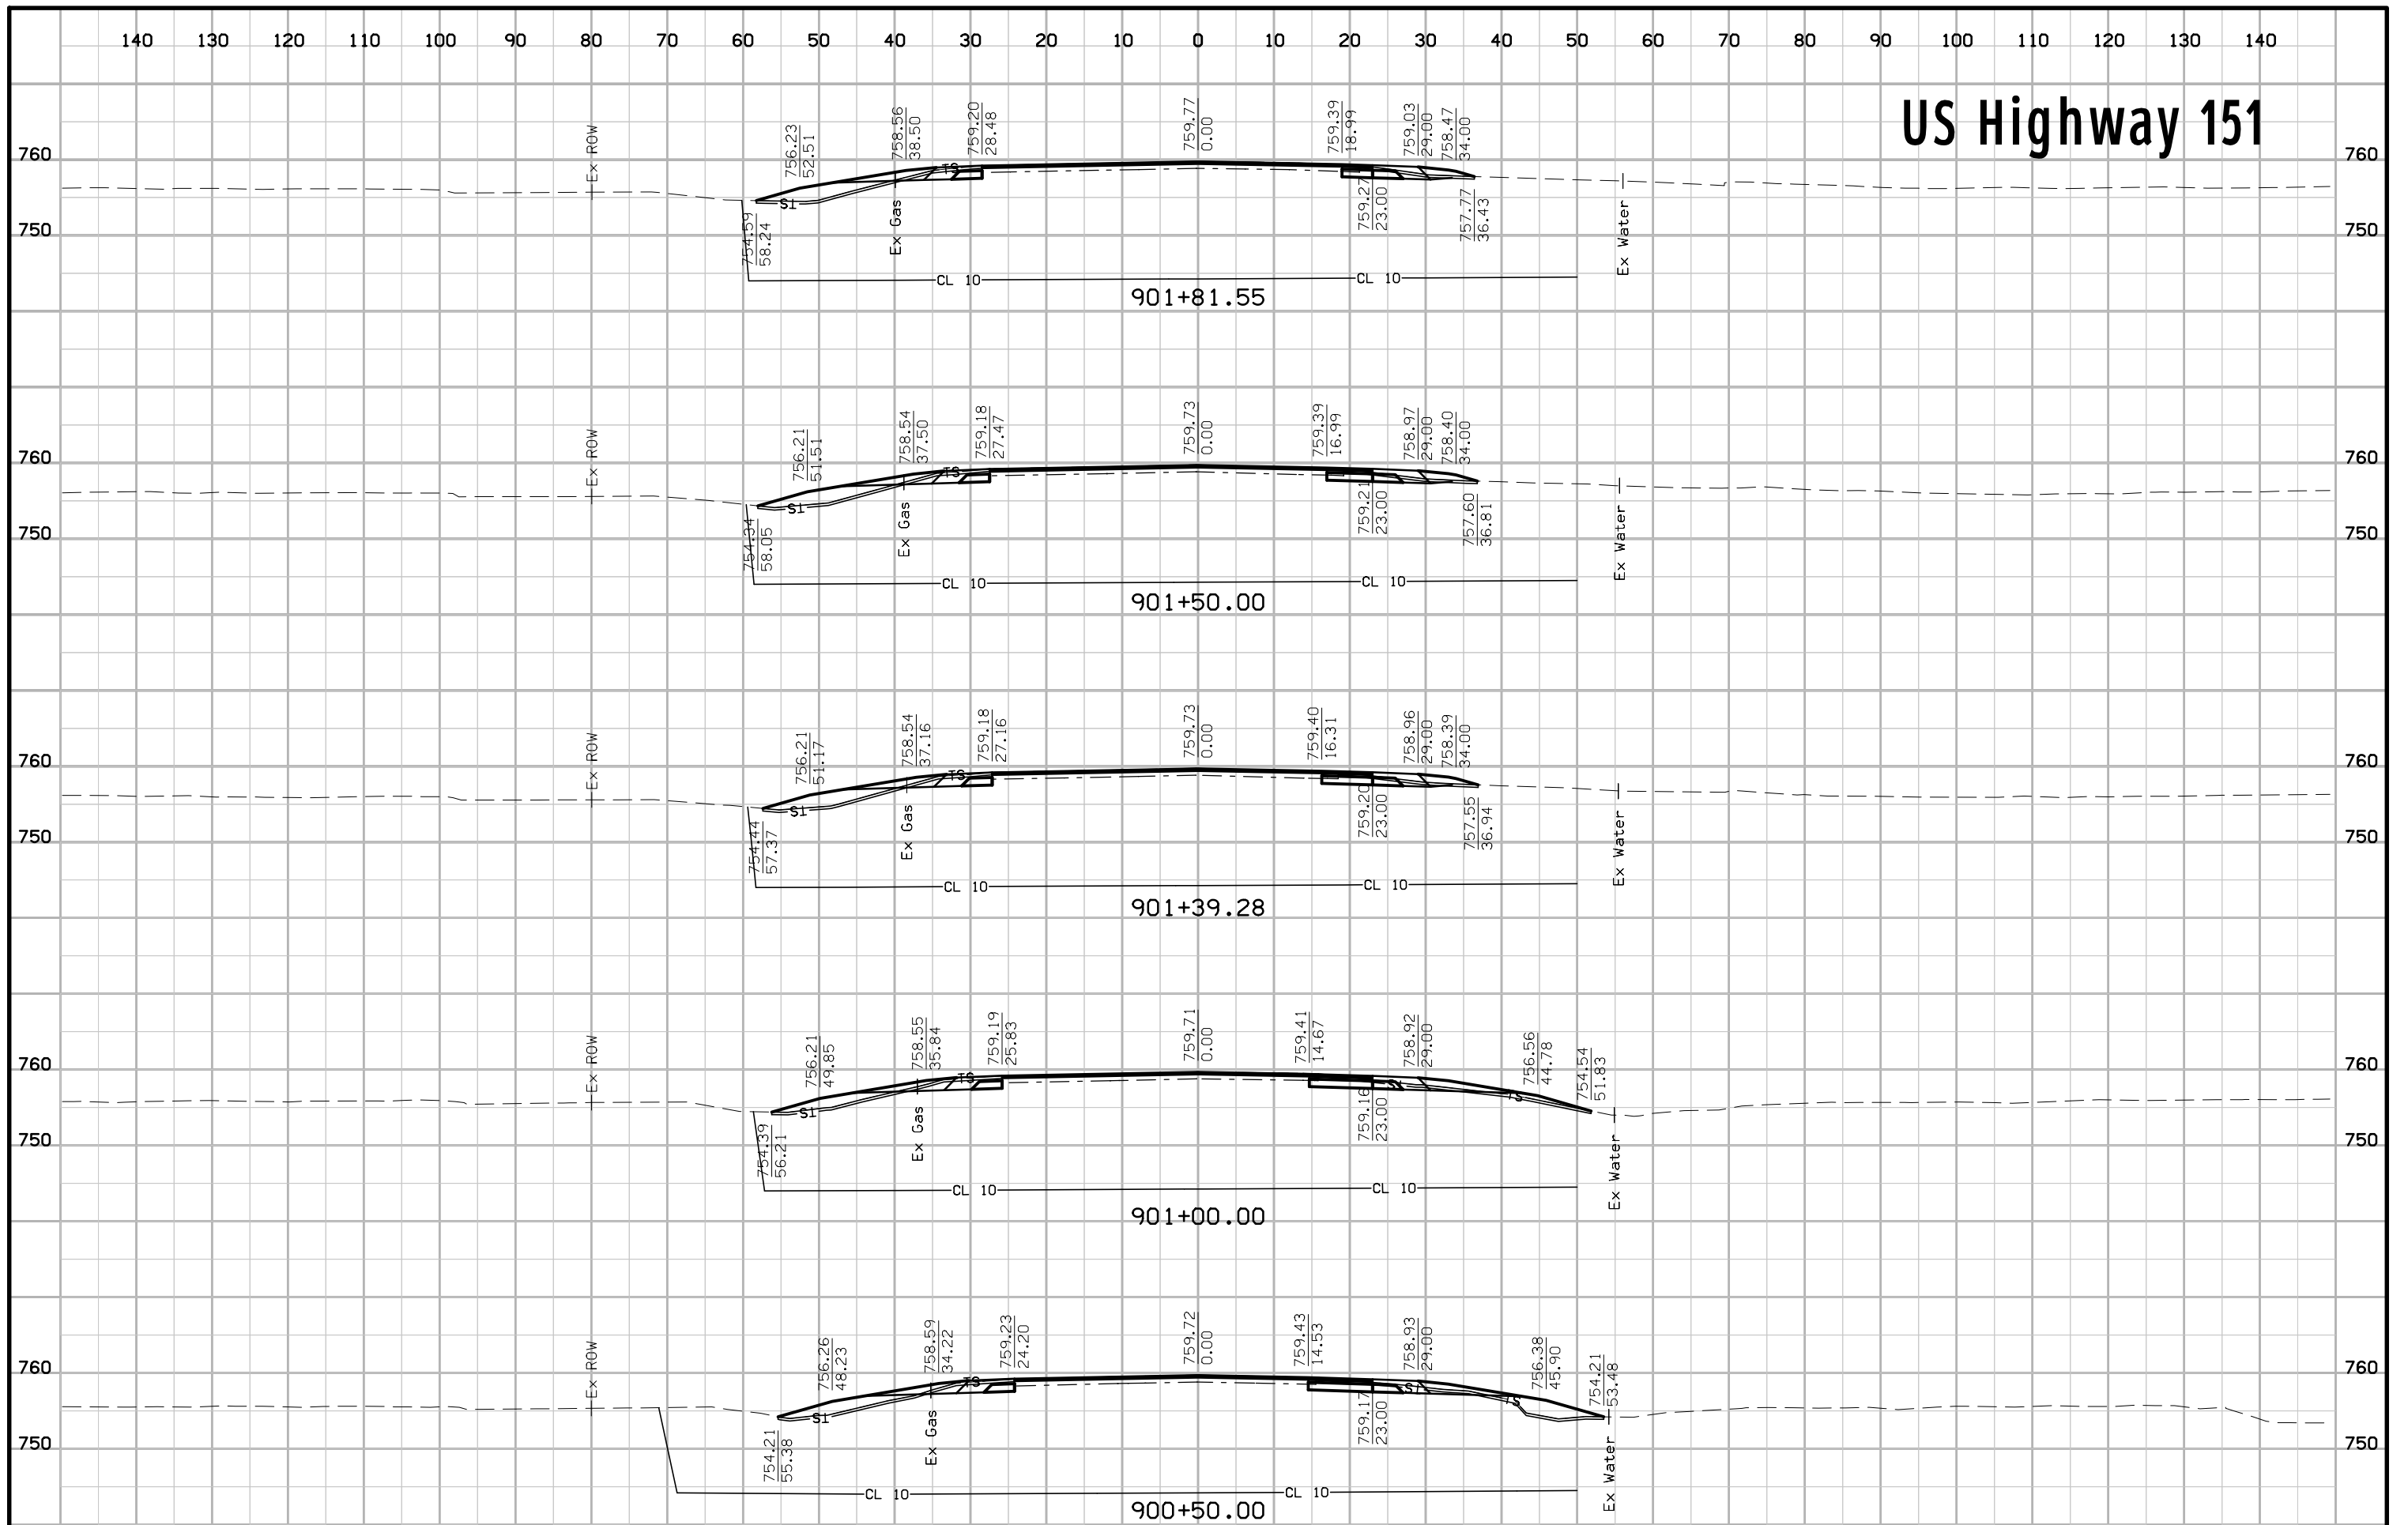


US Highway 151

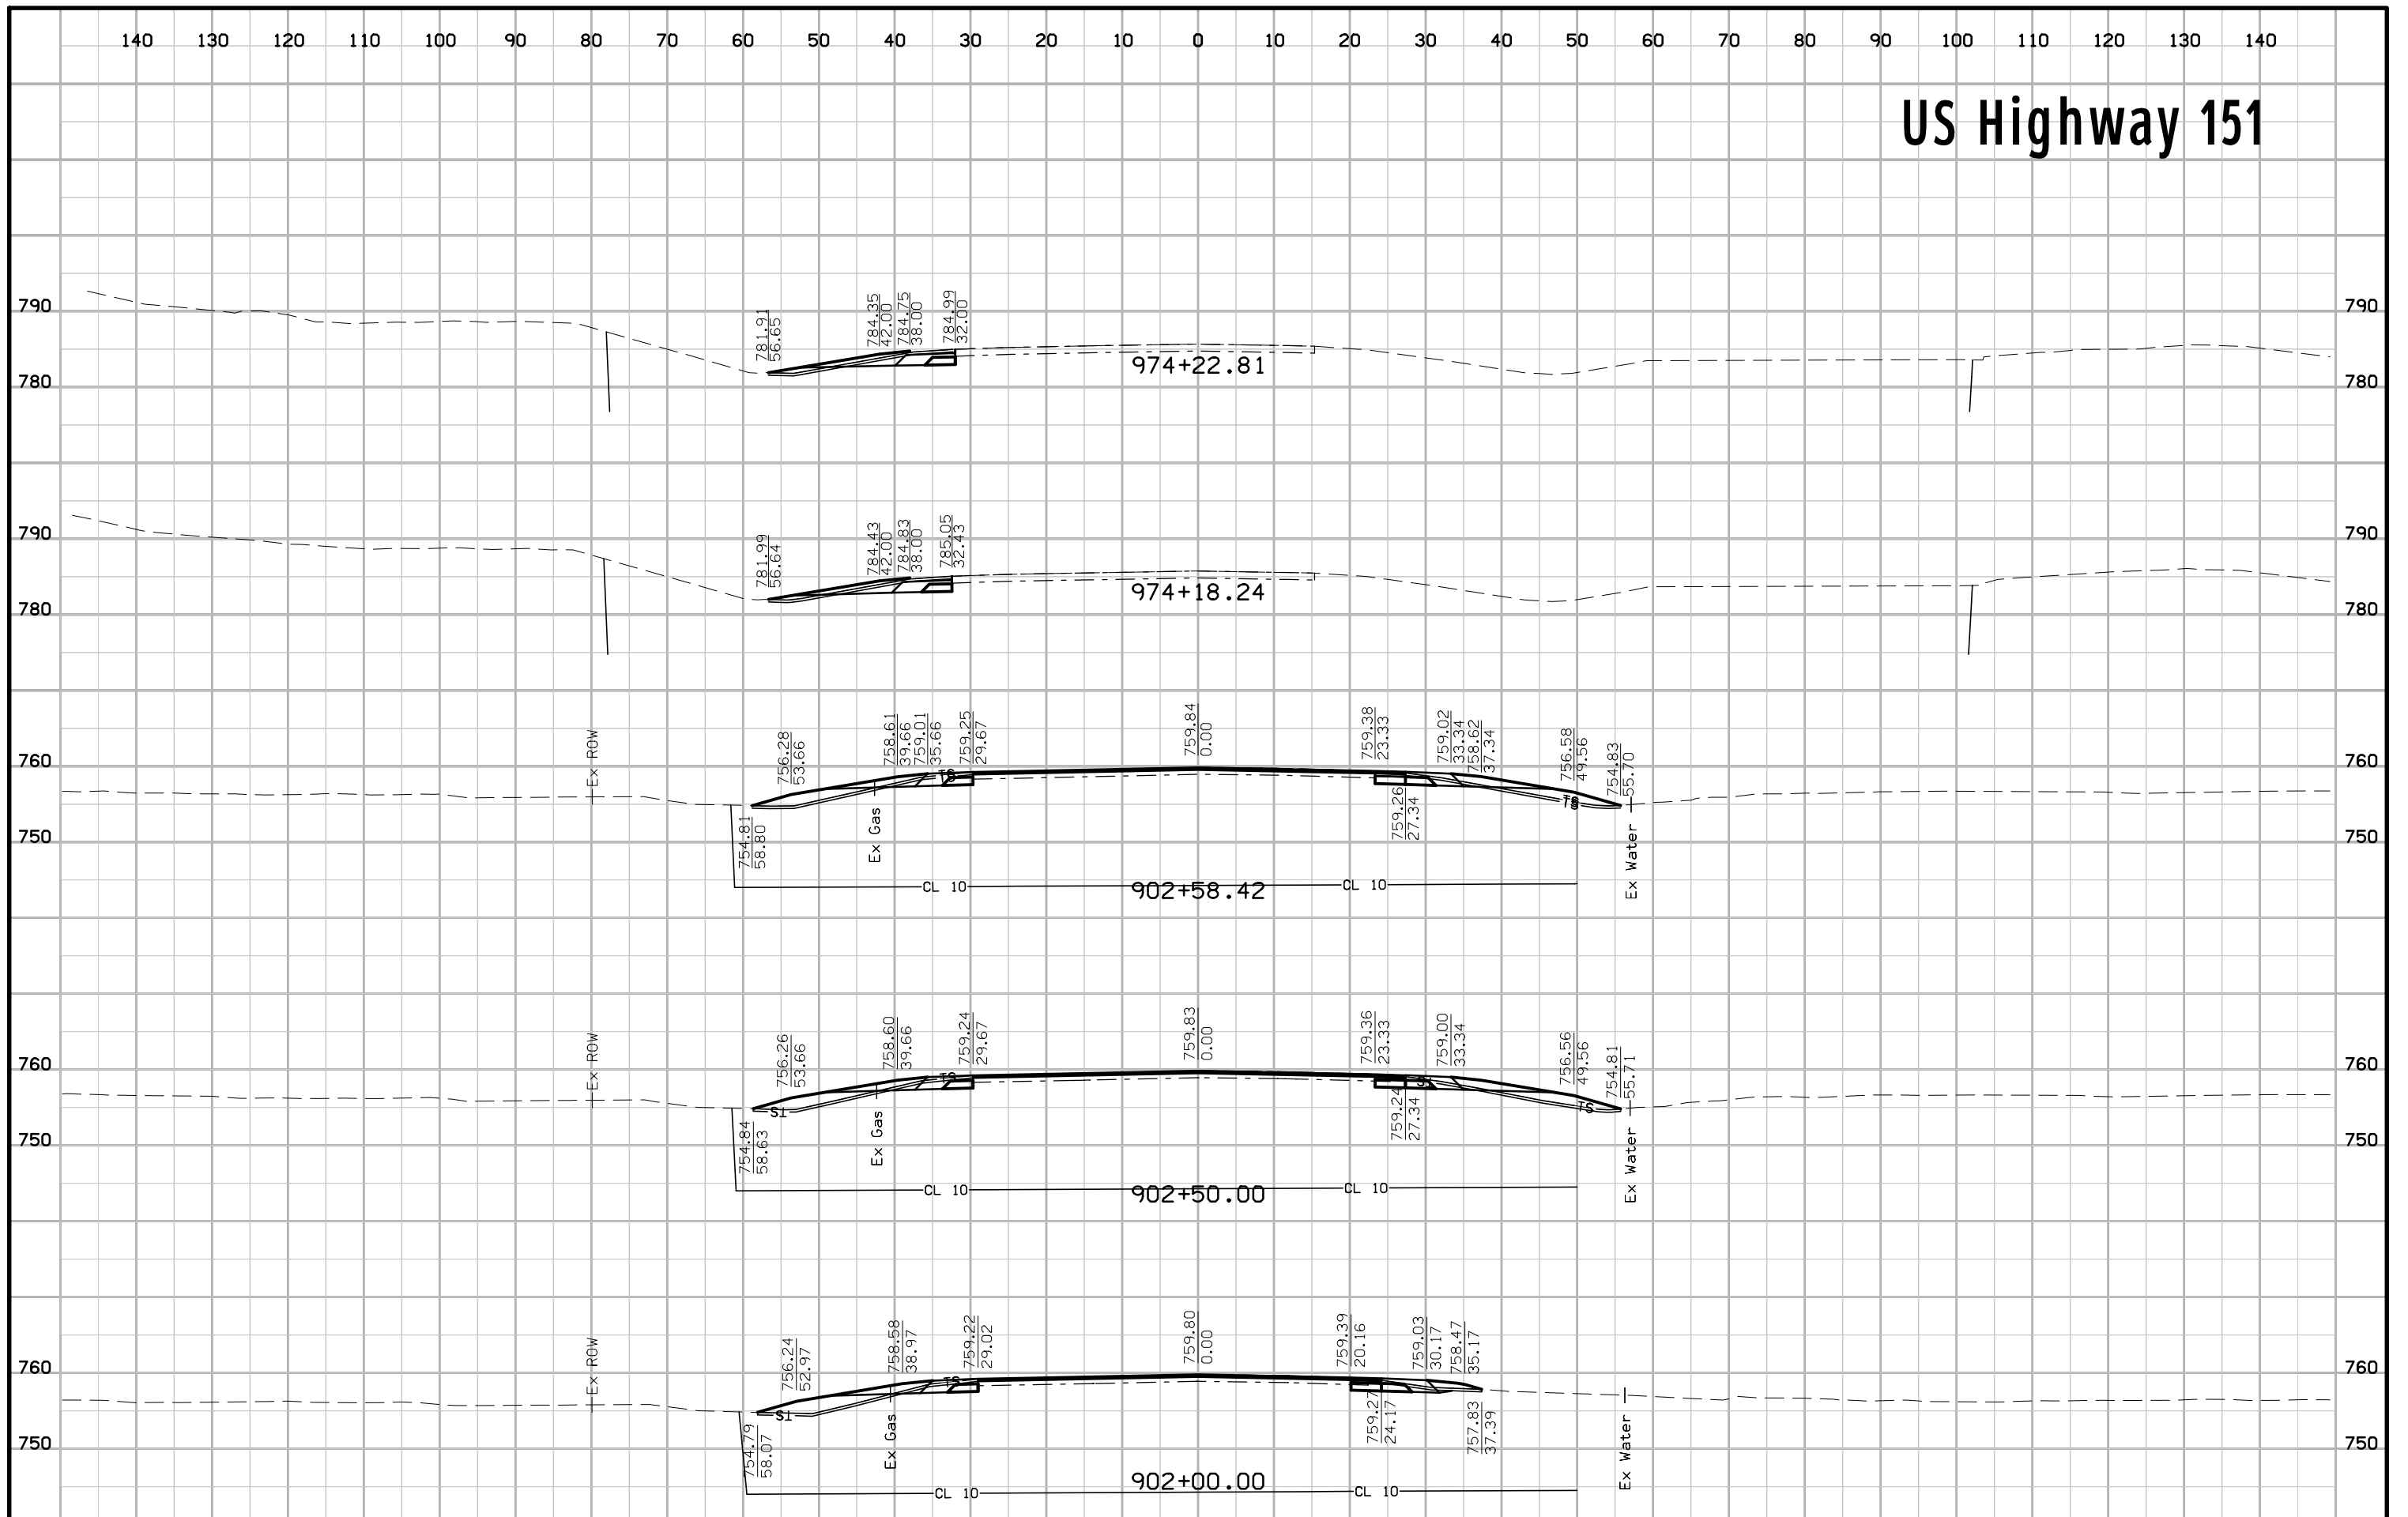


US Highway 151

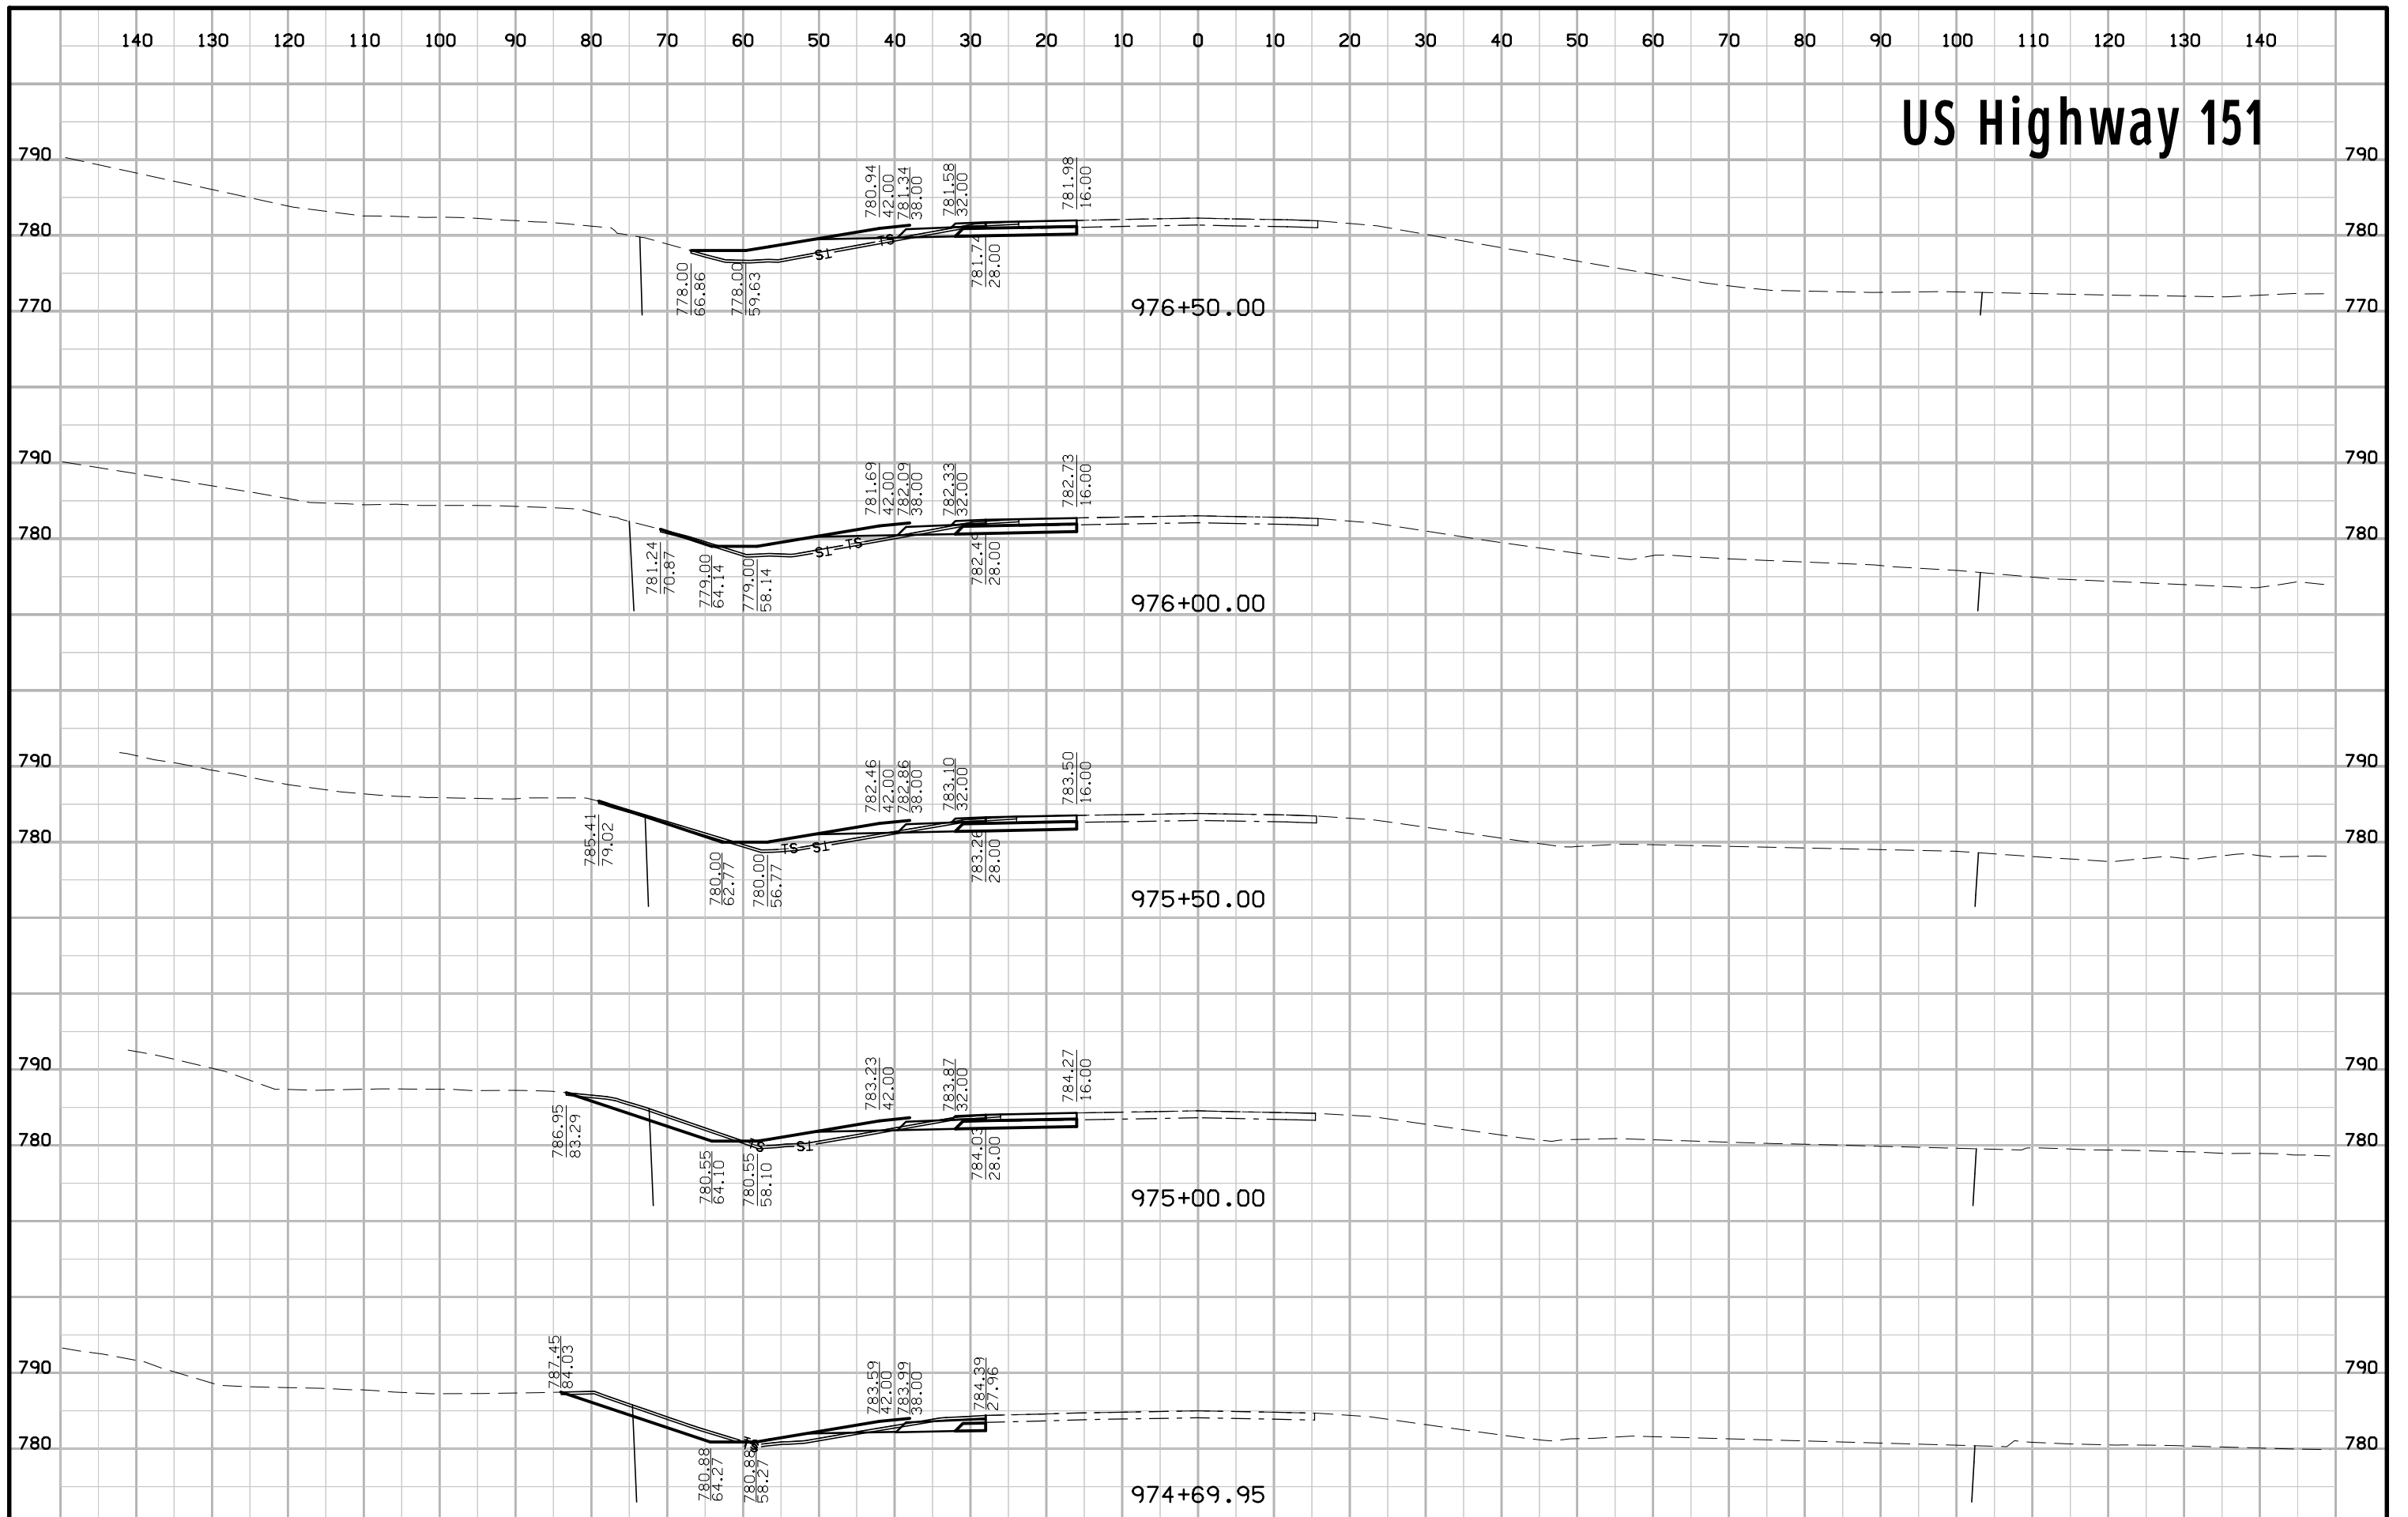


US Highway 151

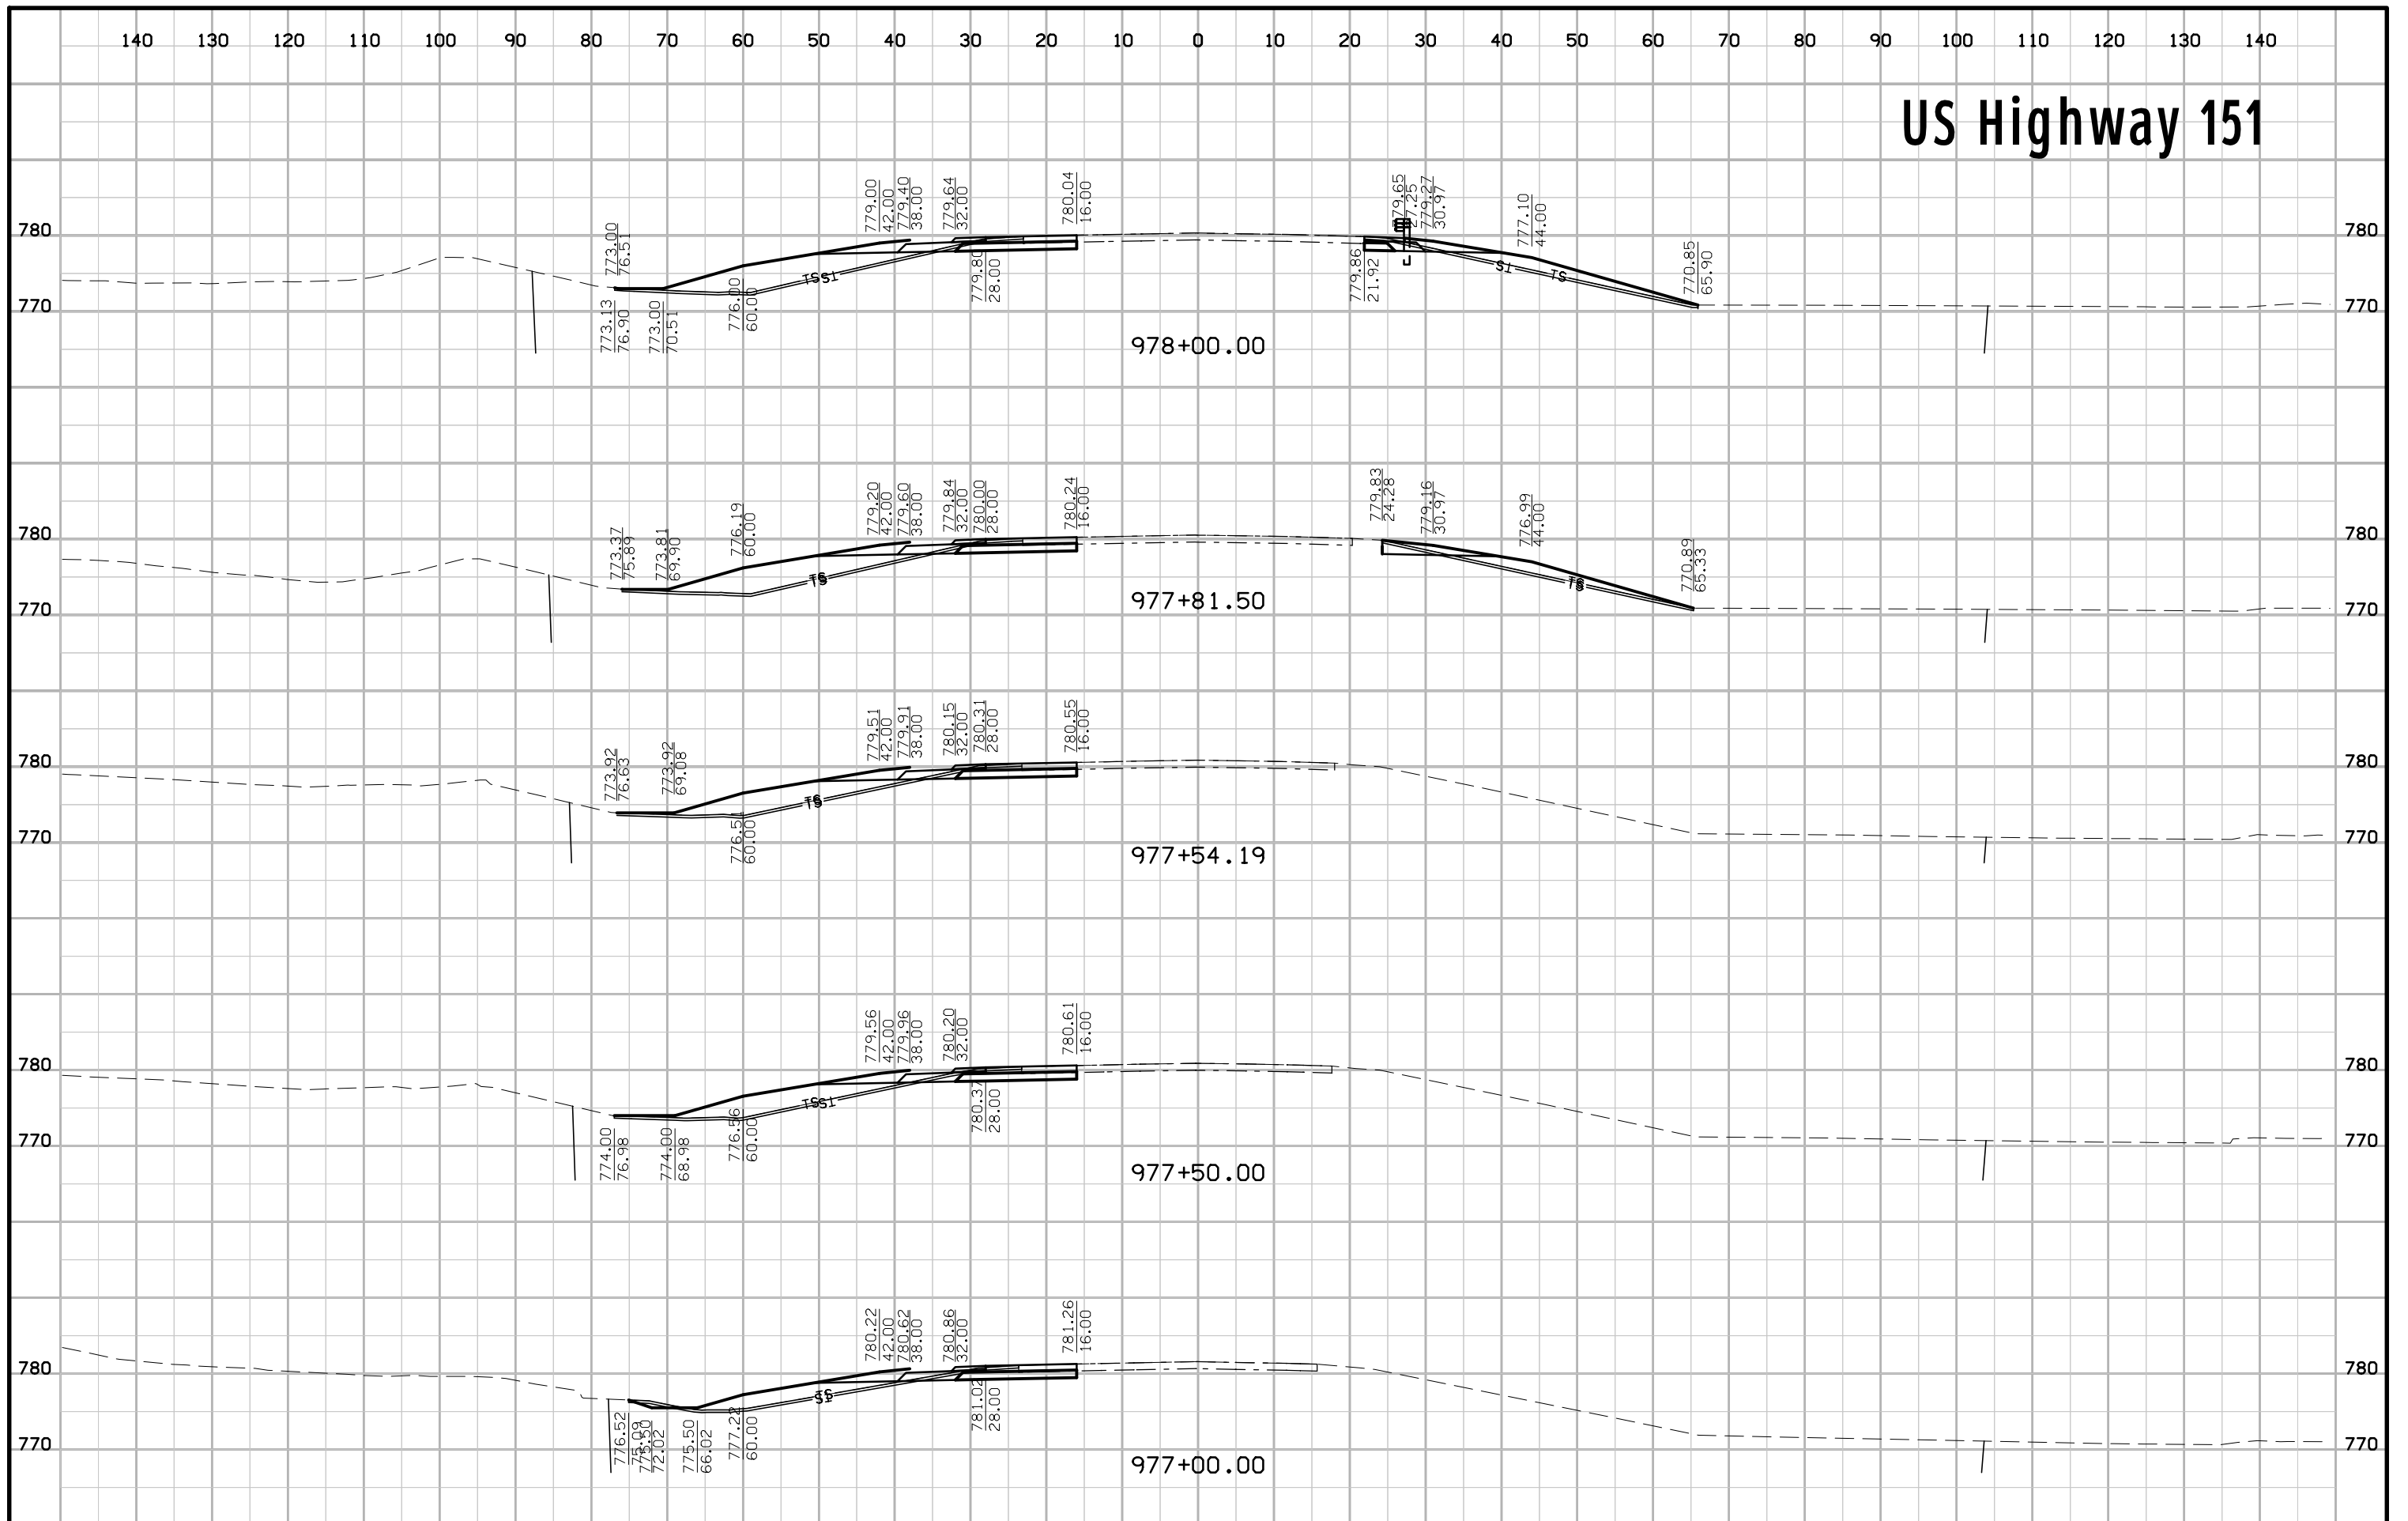


US Highway 151

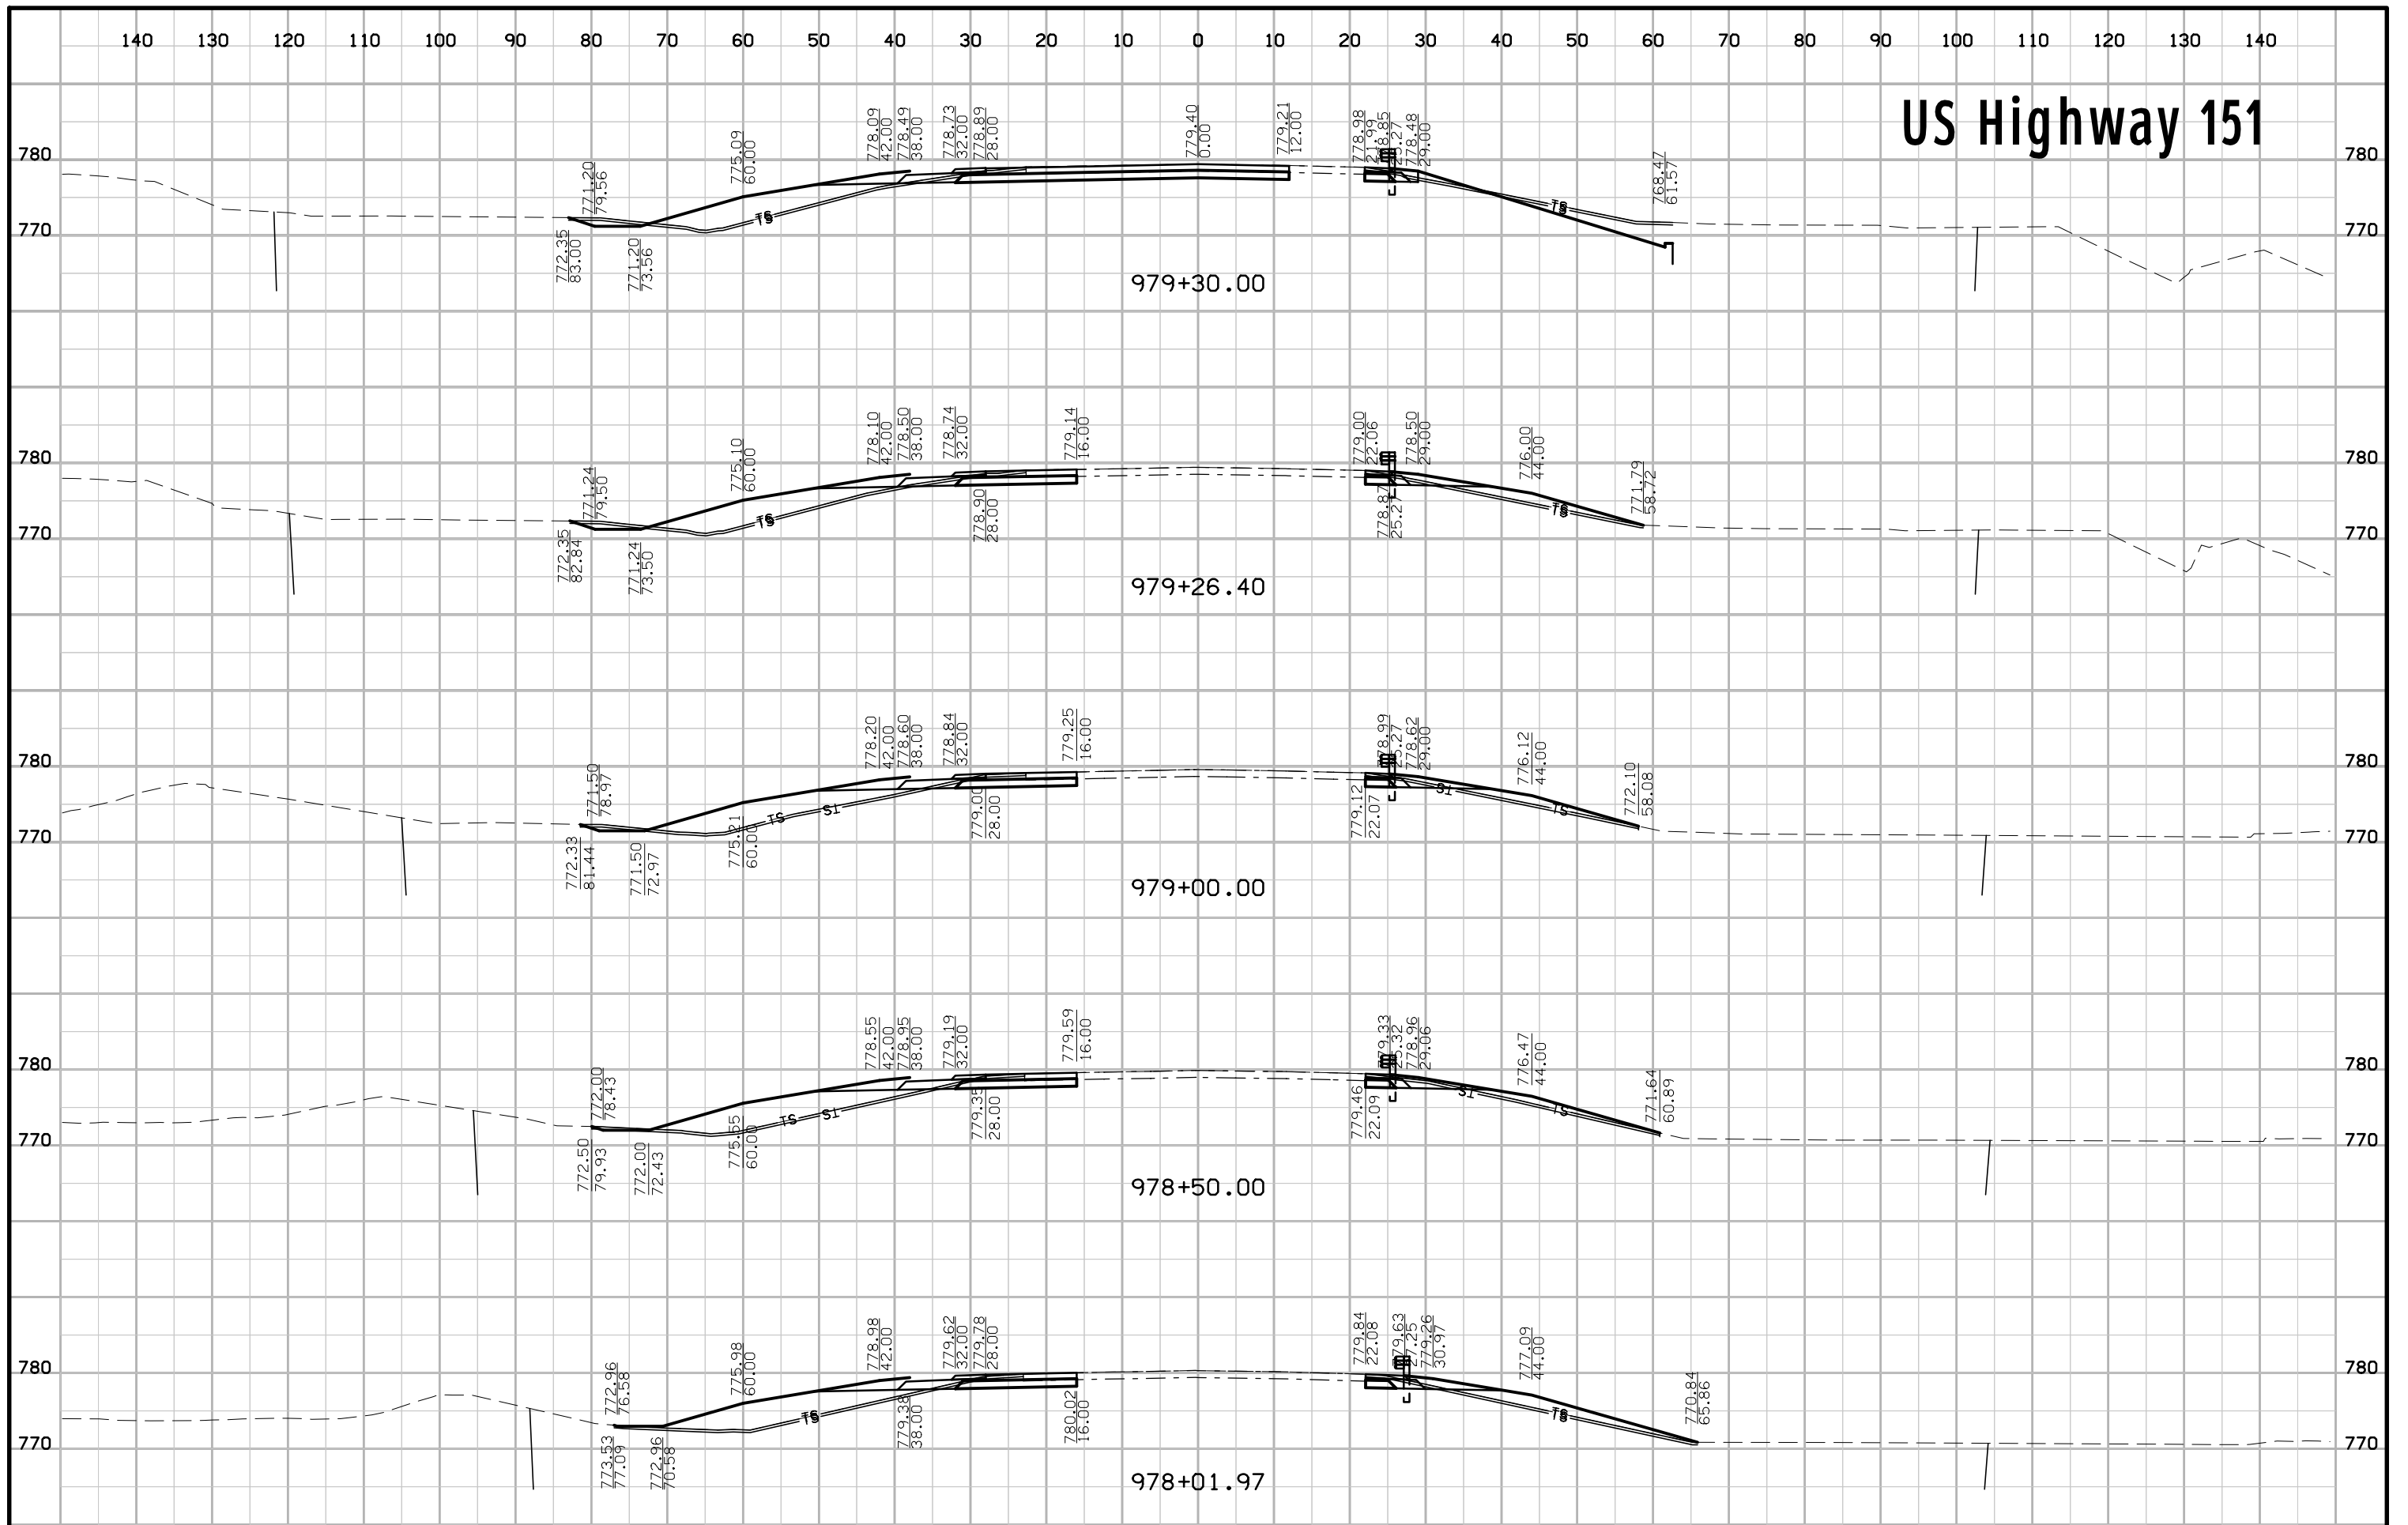


US Highway 151

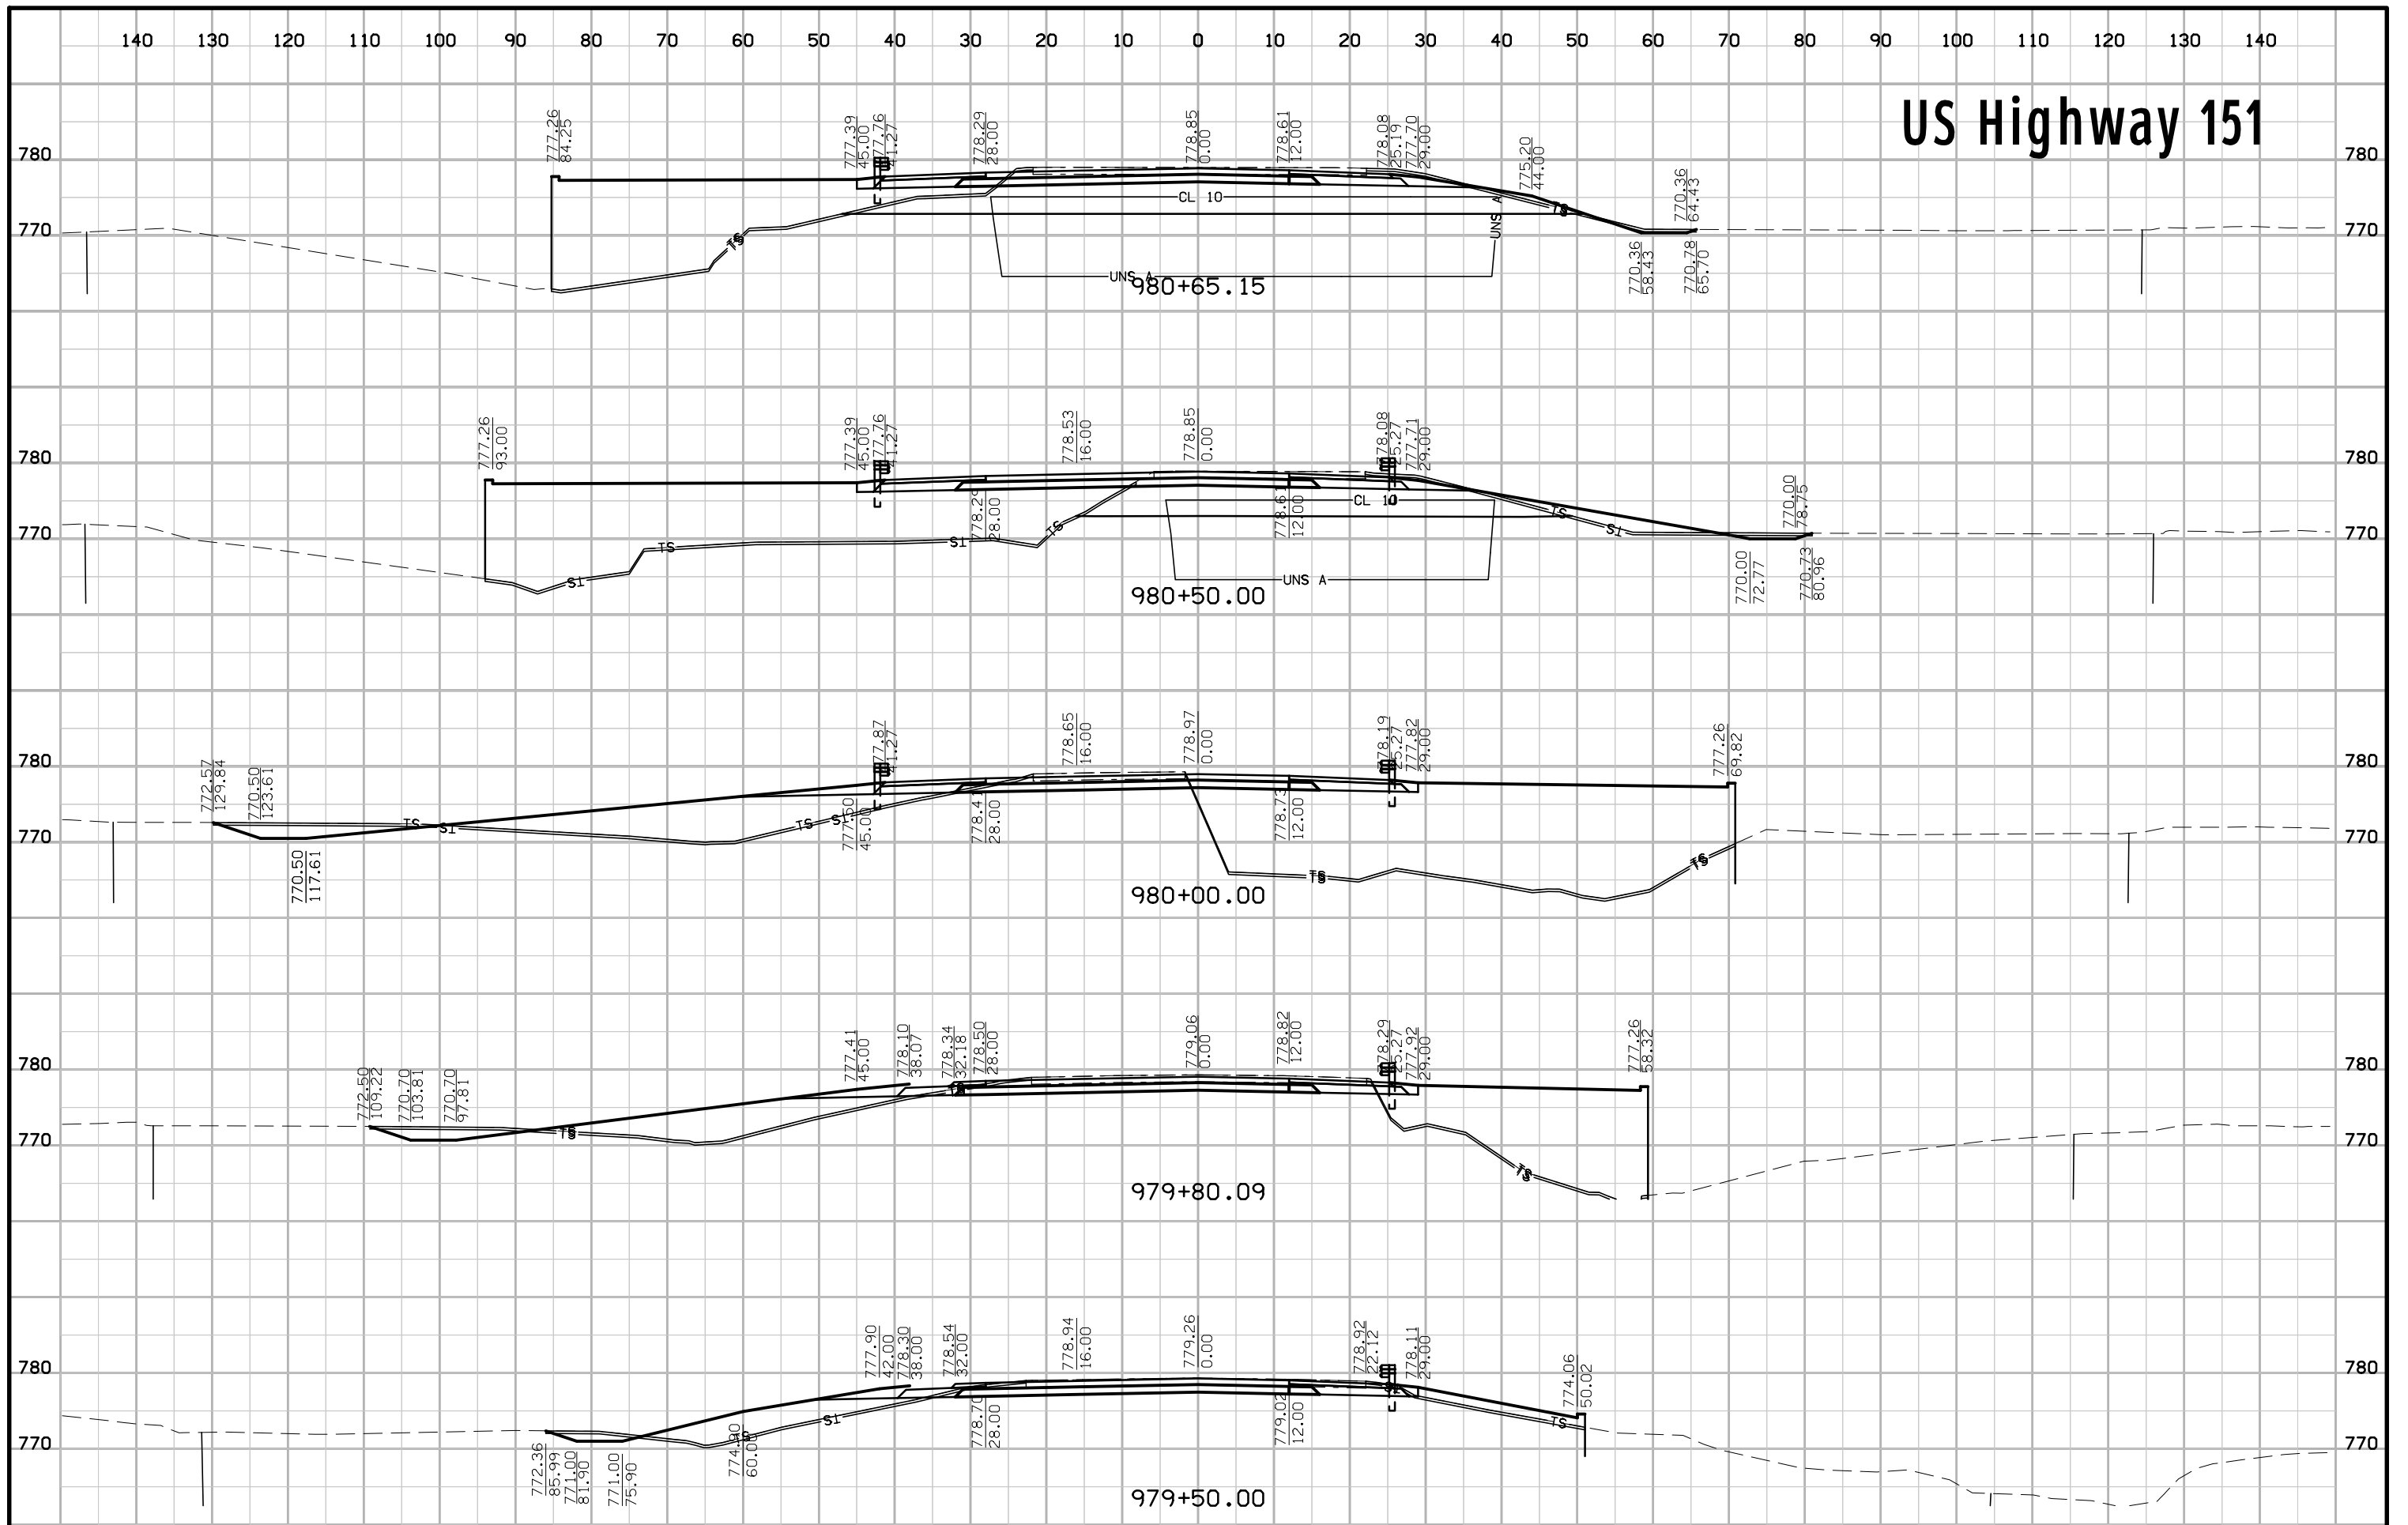


US Highway 151

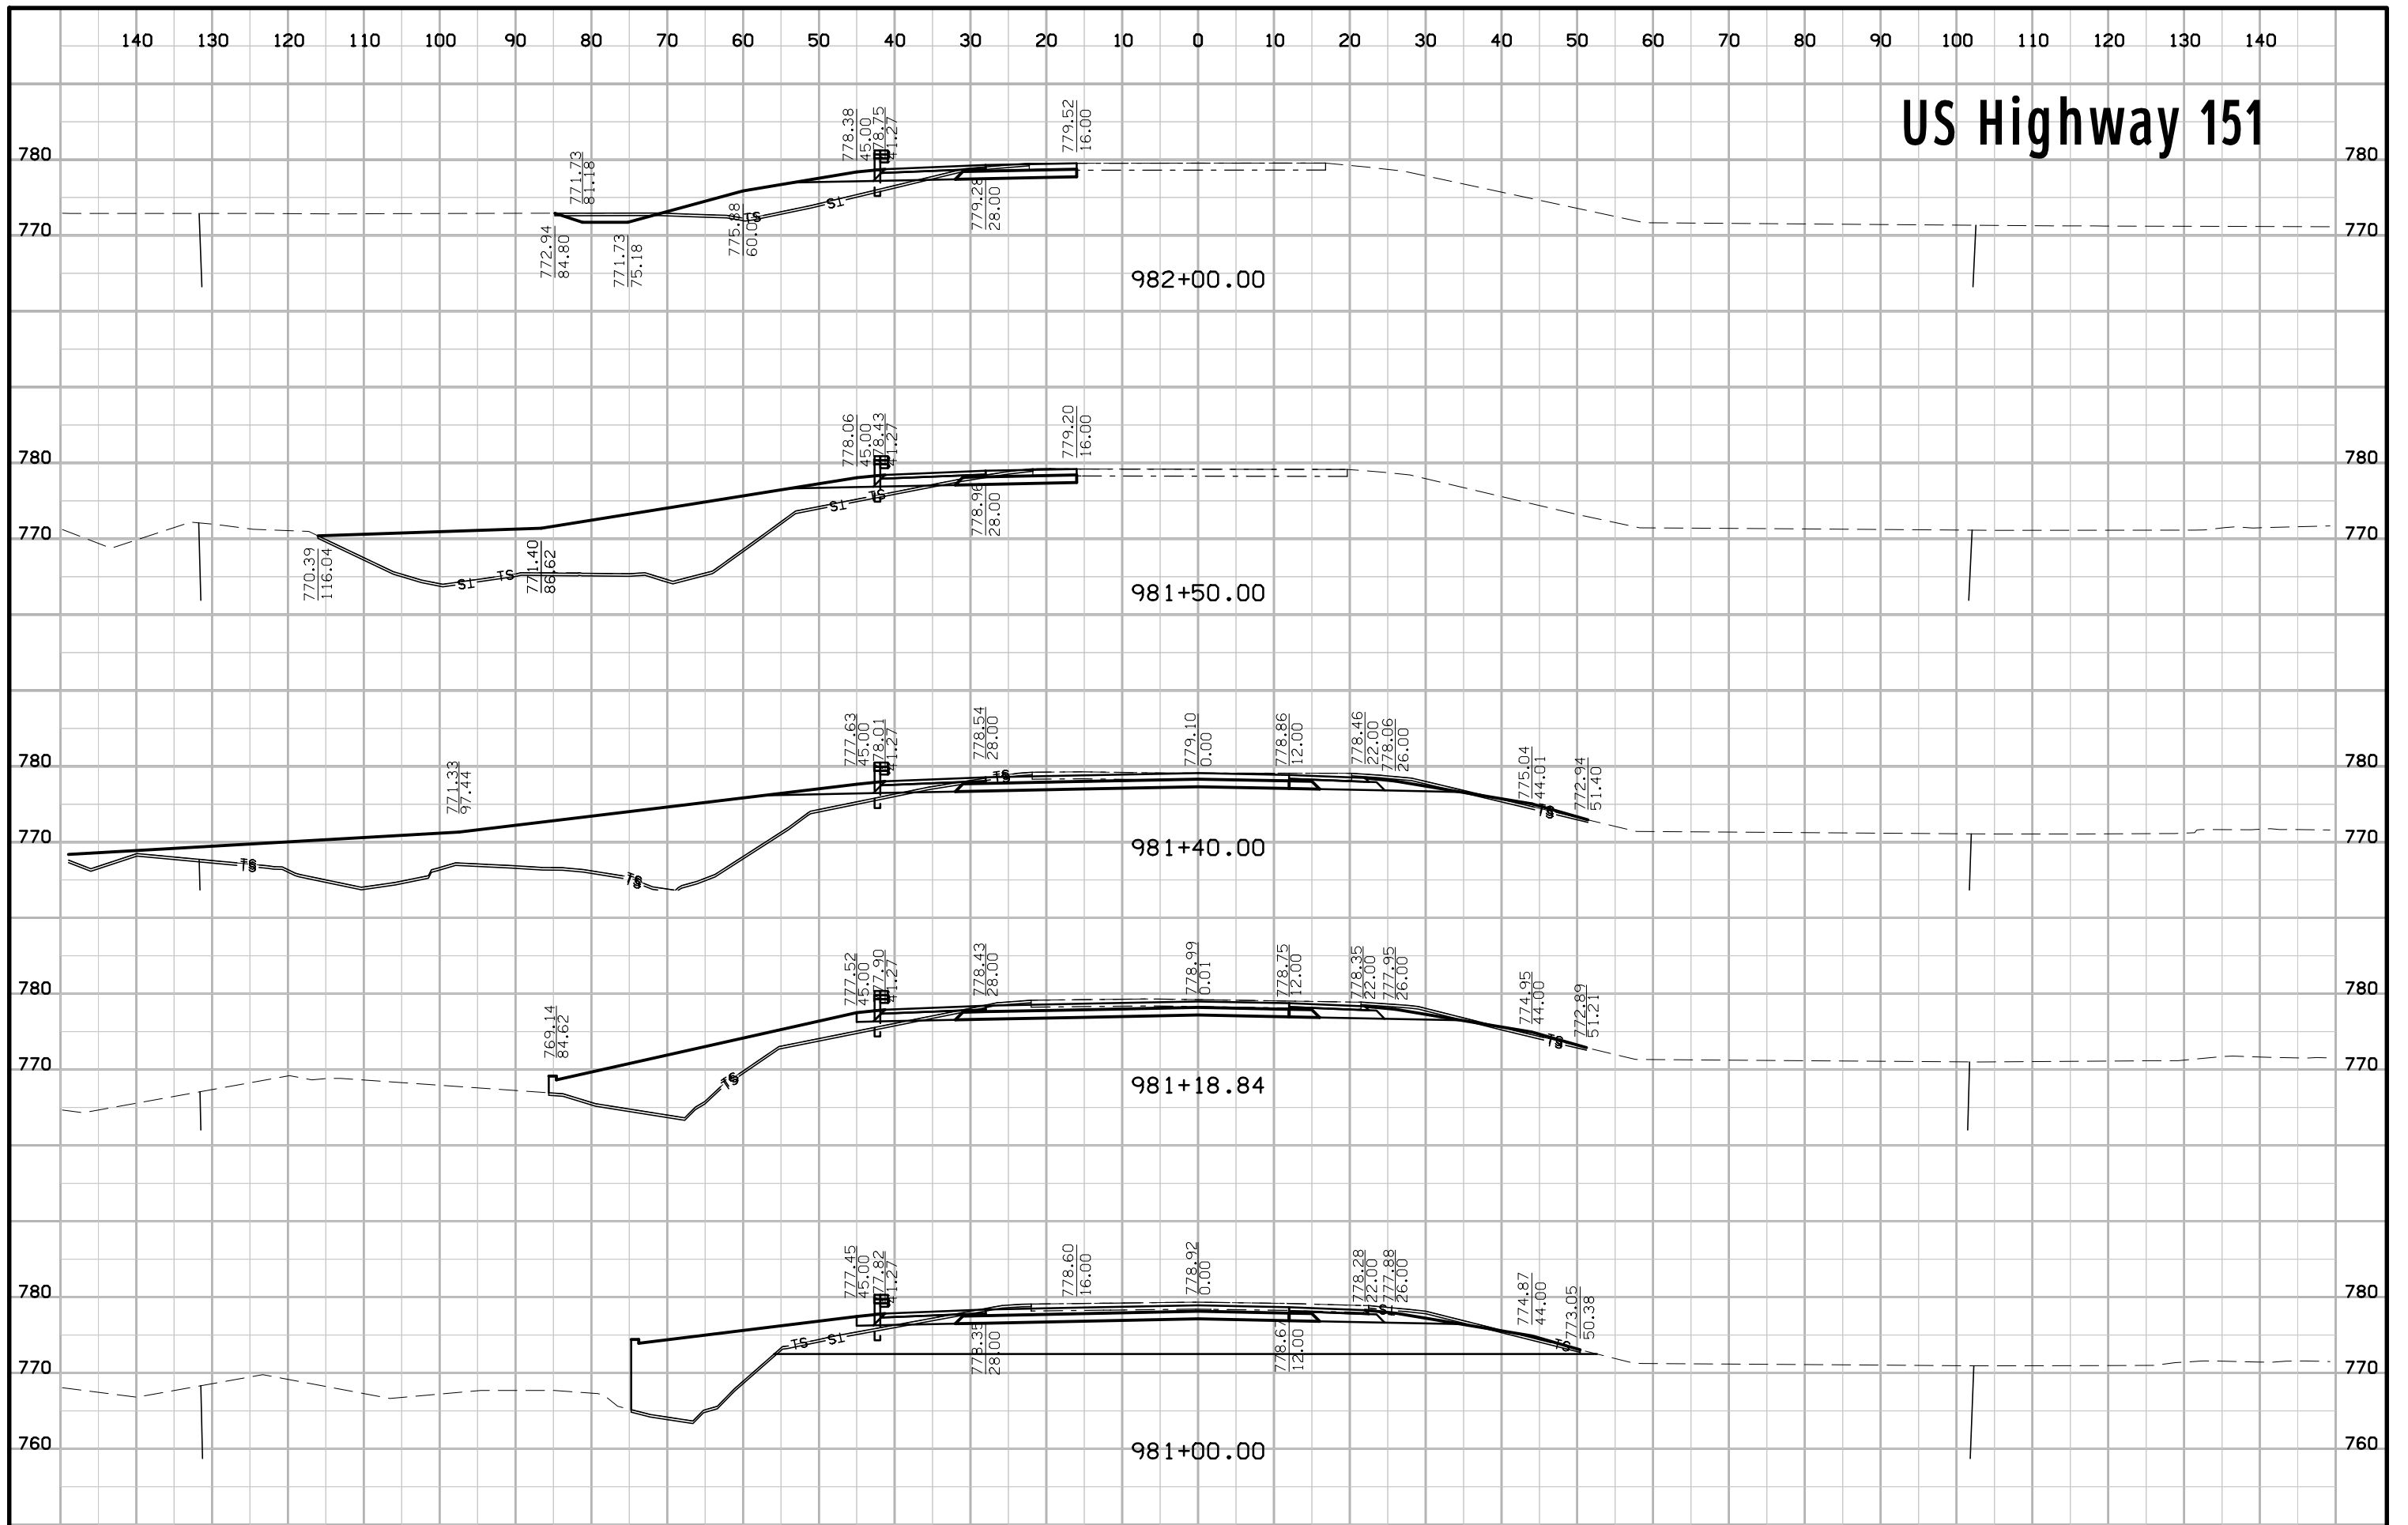


US Highway 151

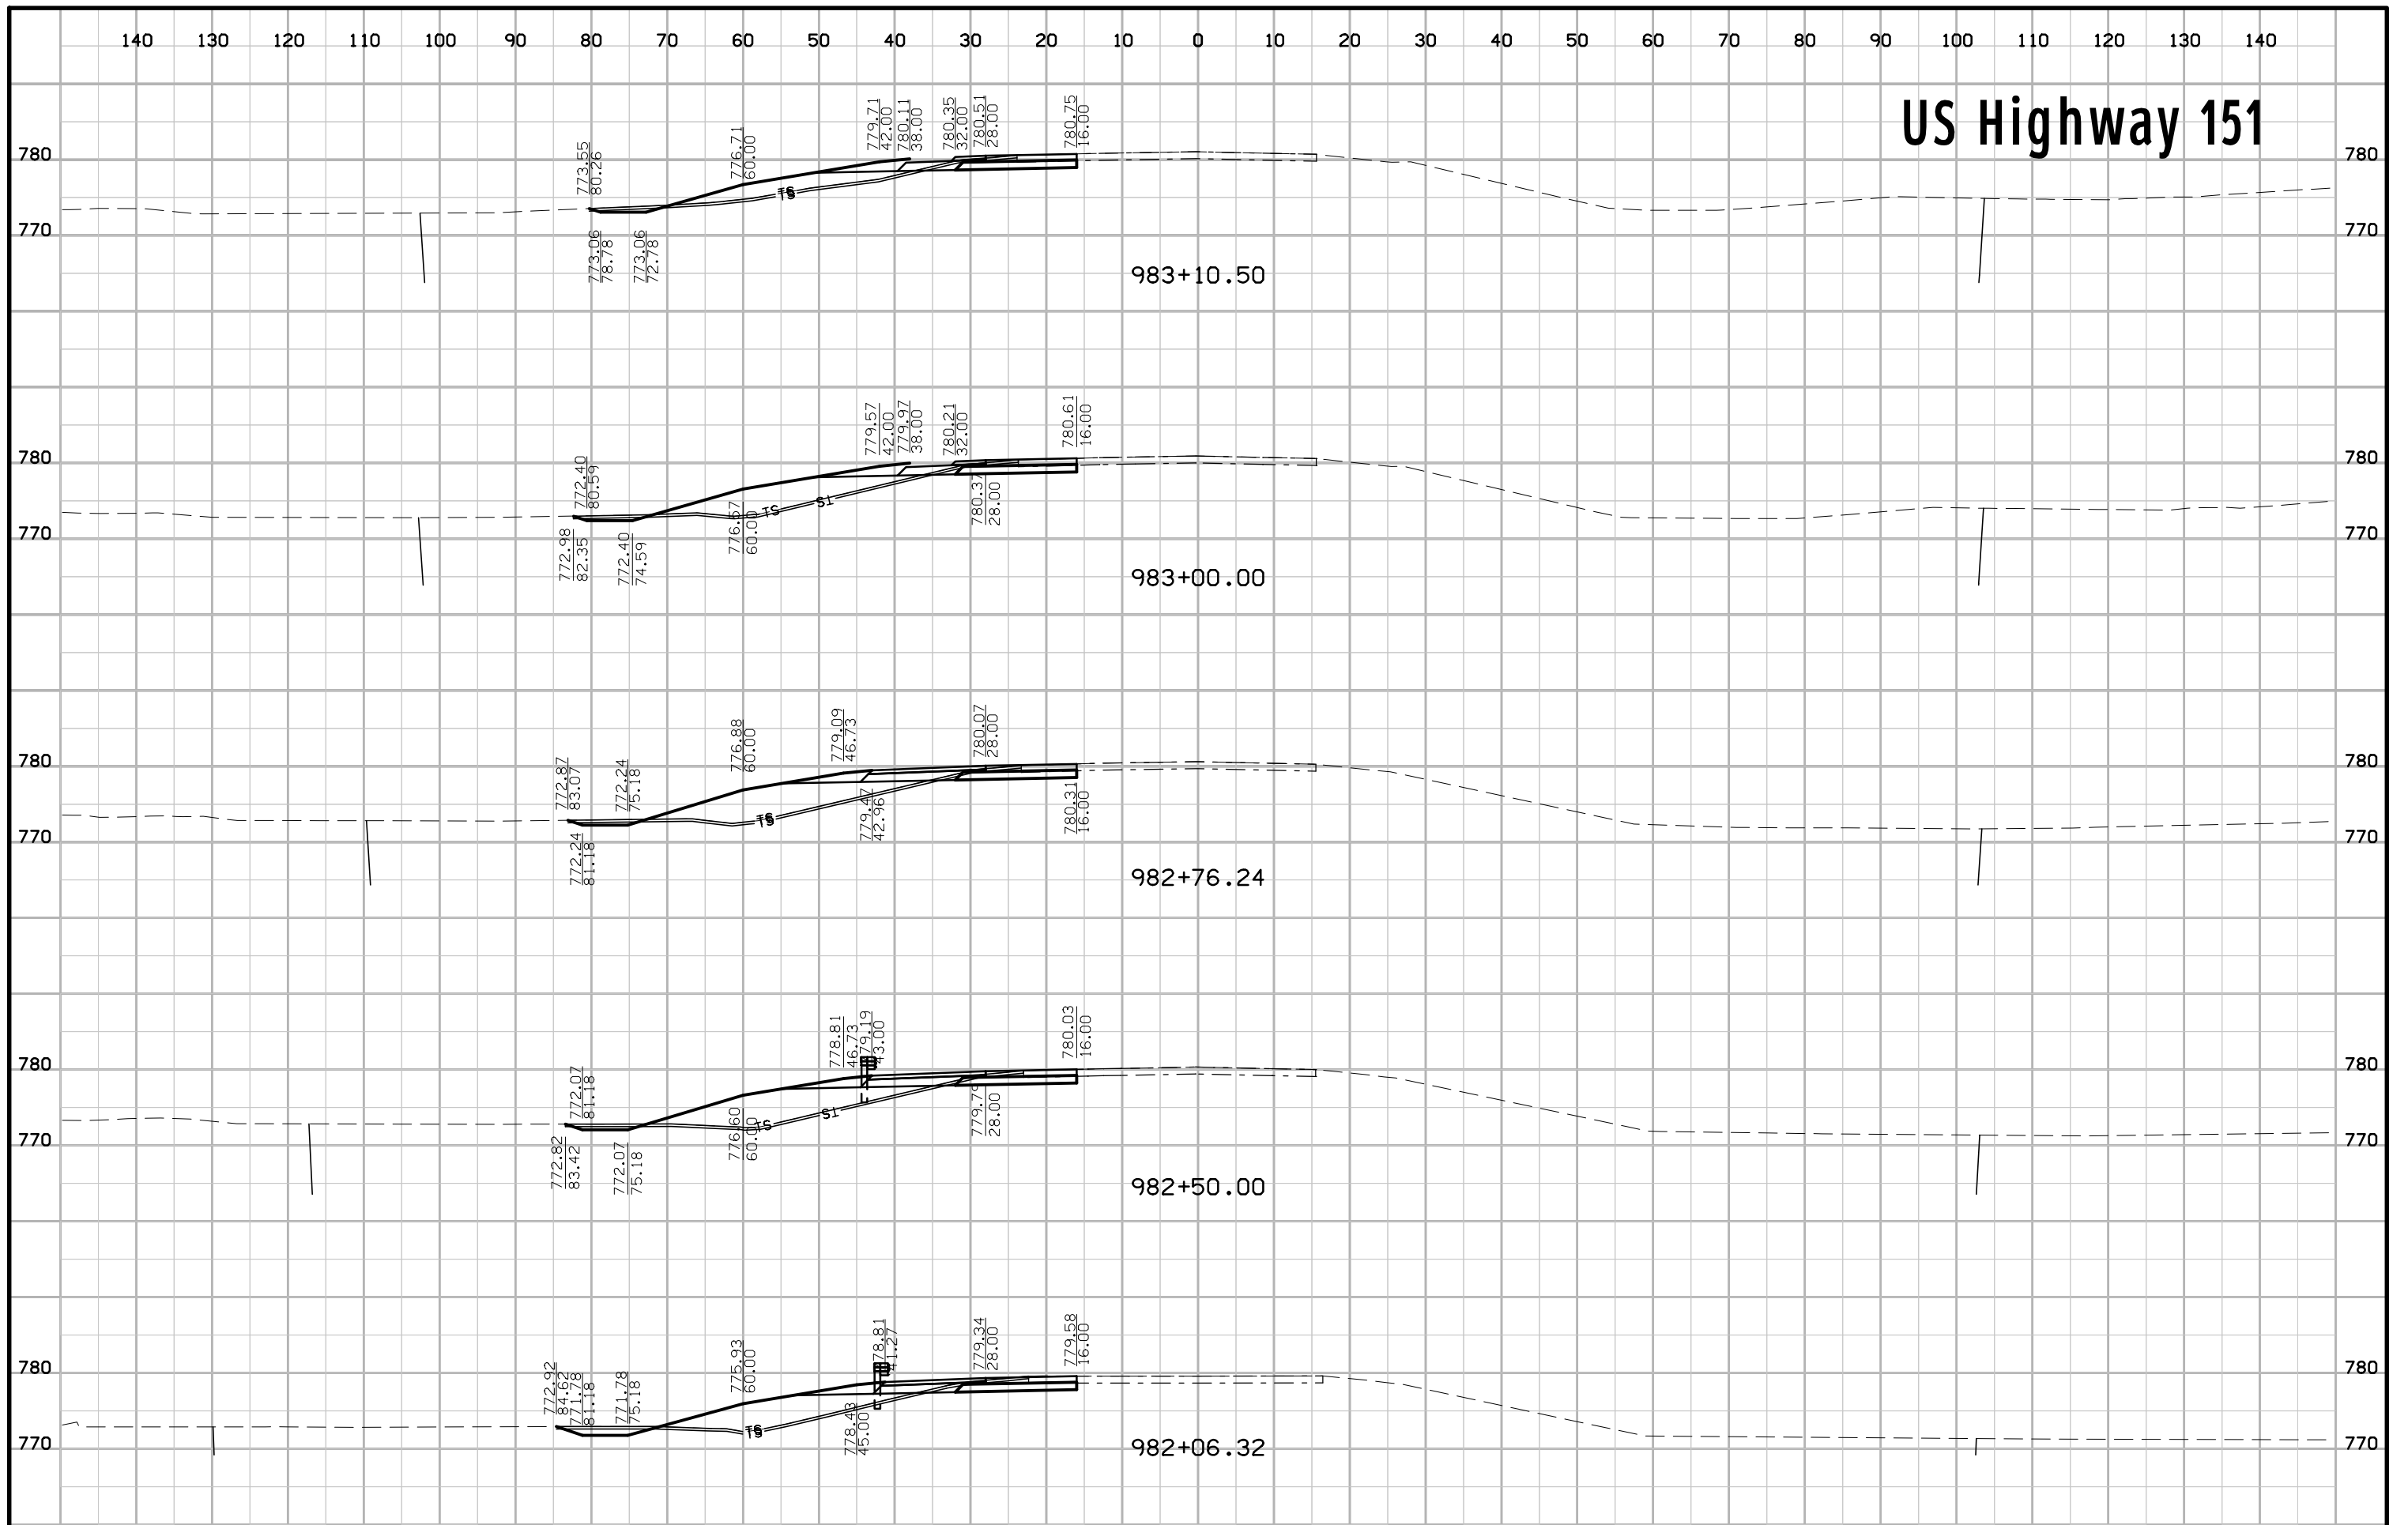


US Highway 151

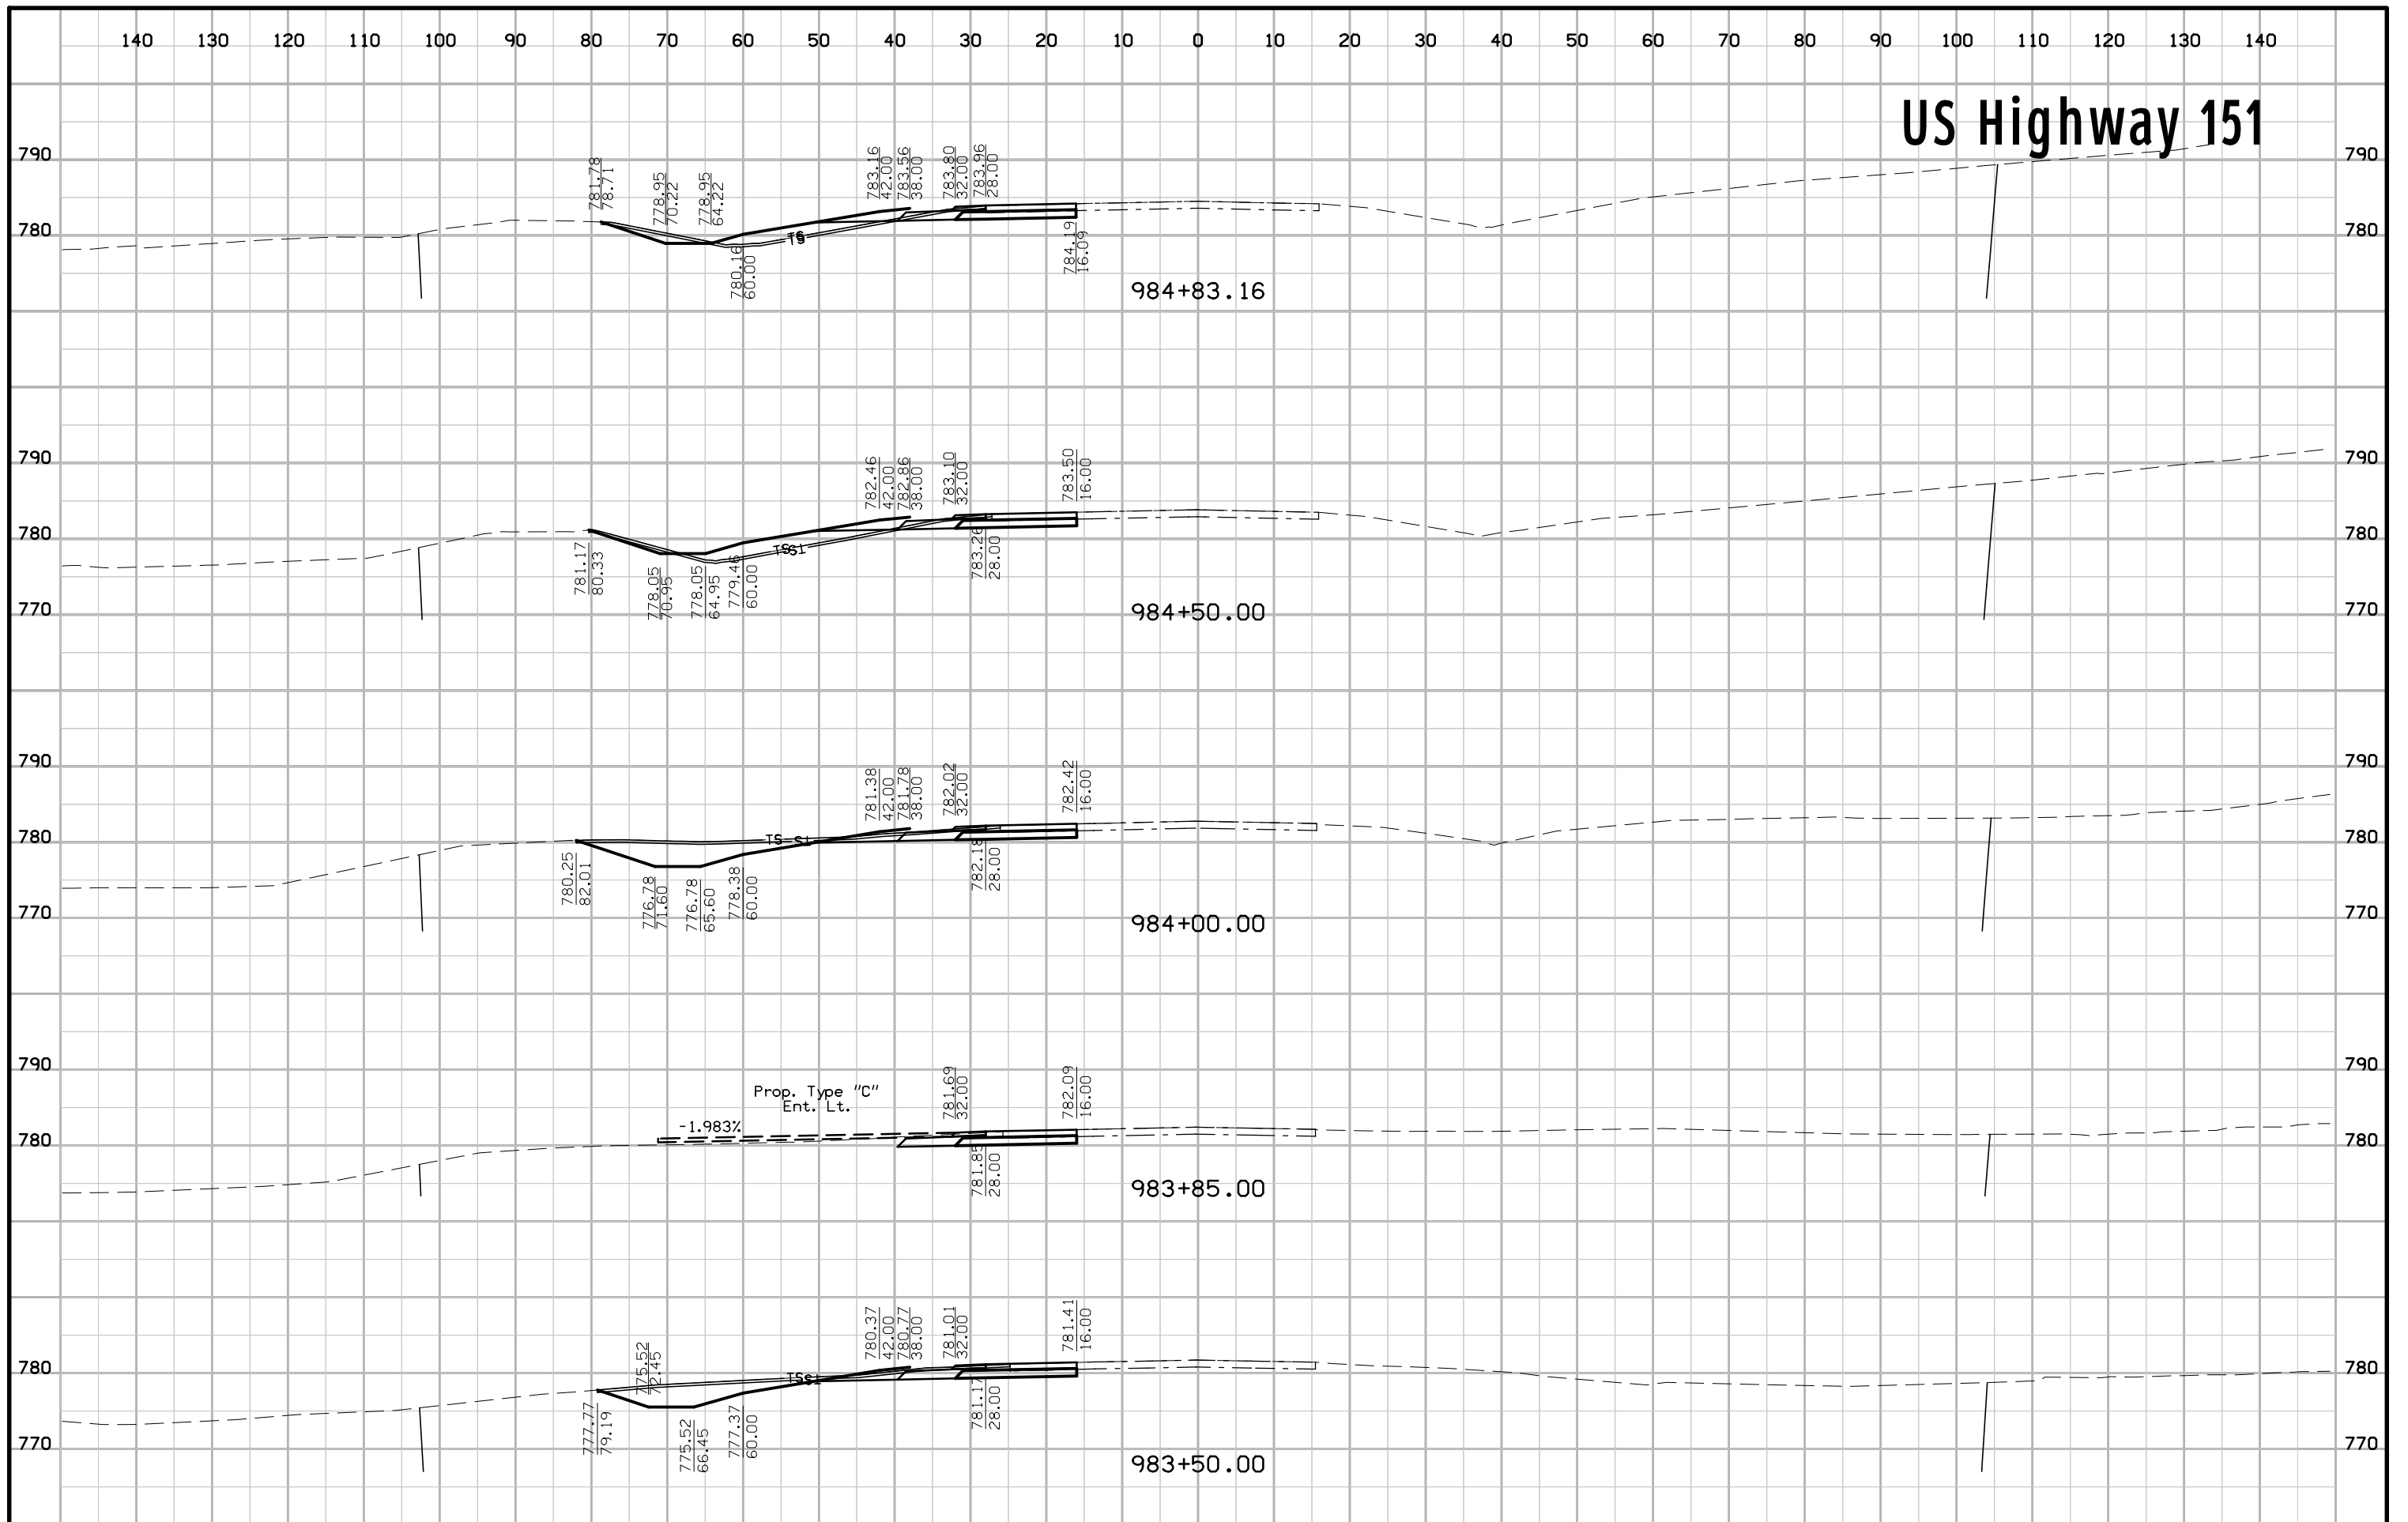


Church Street

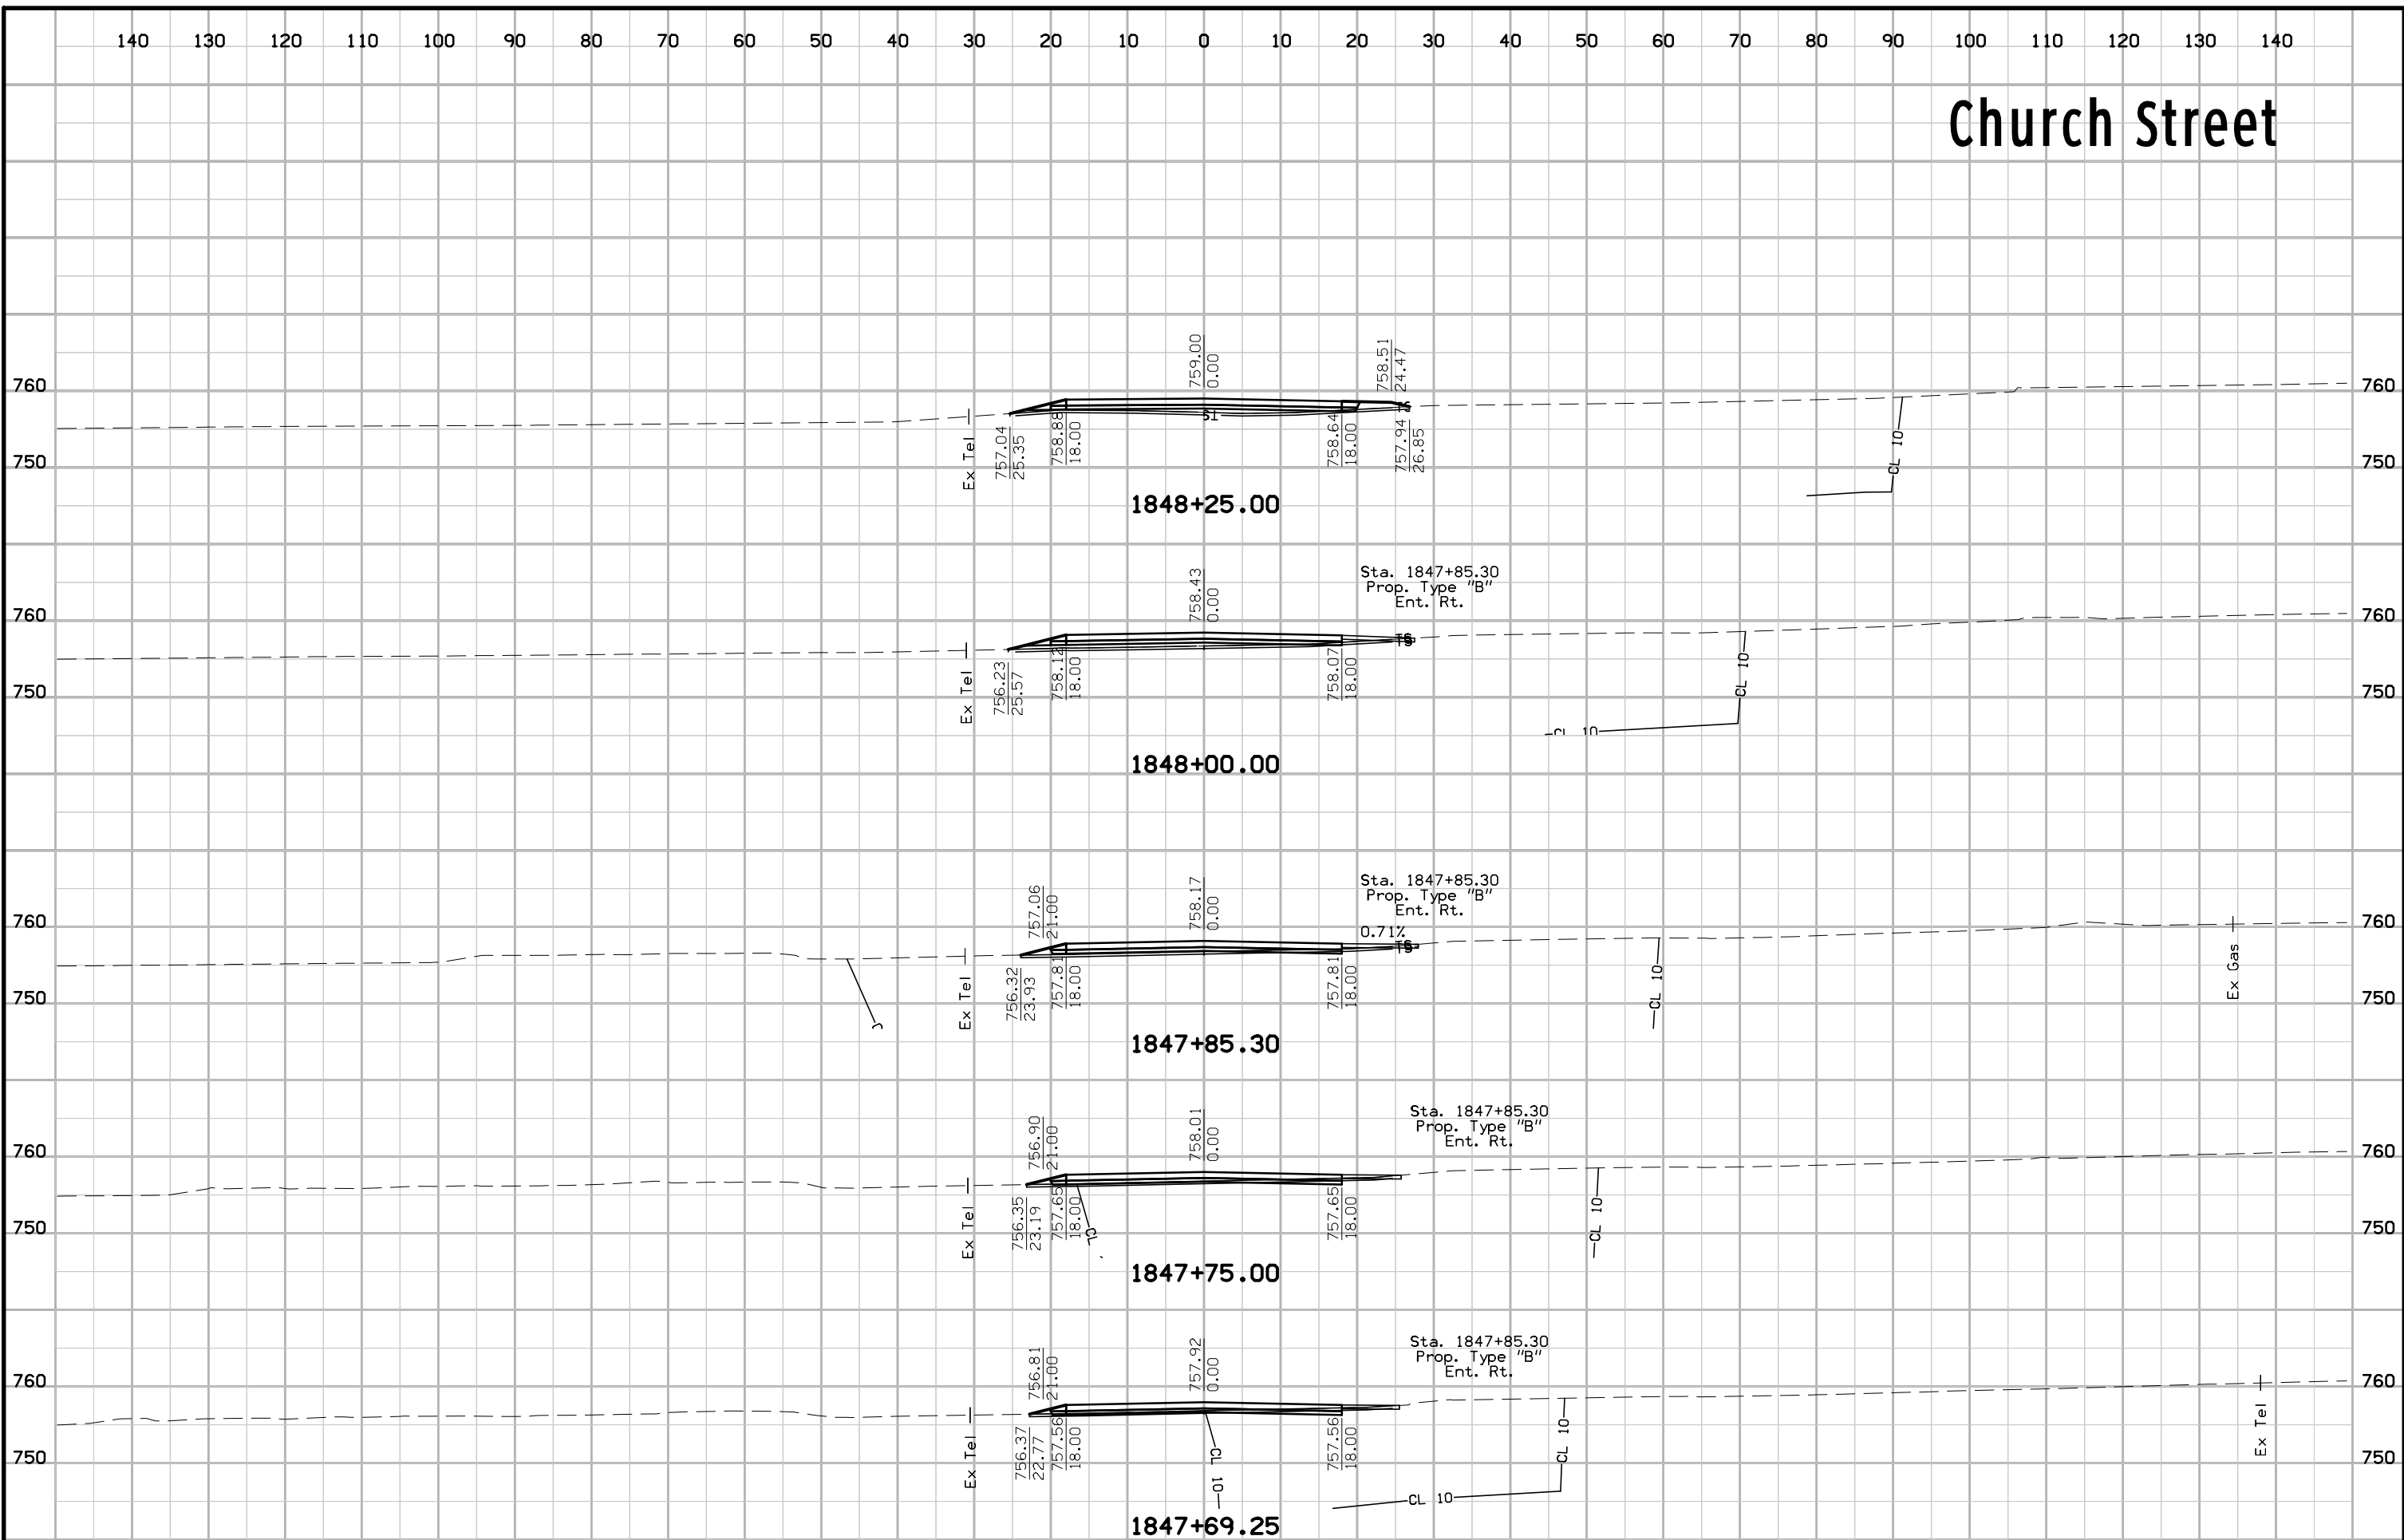


Church Street

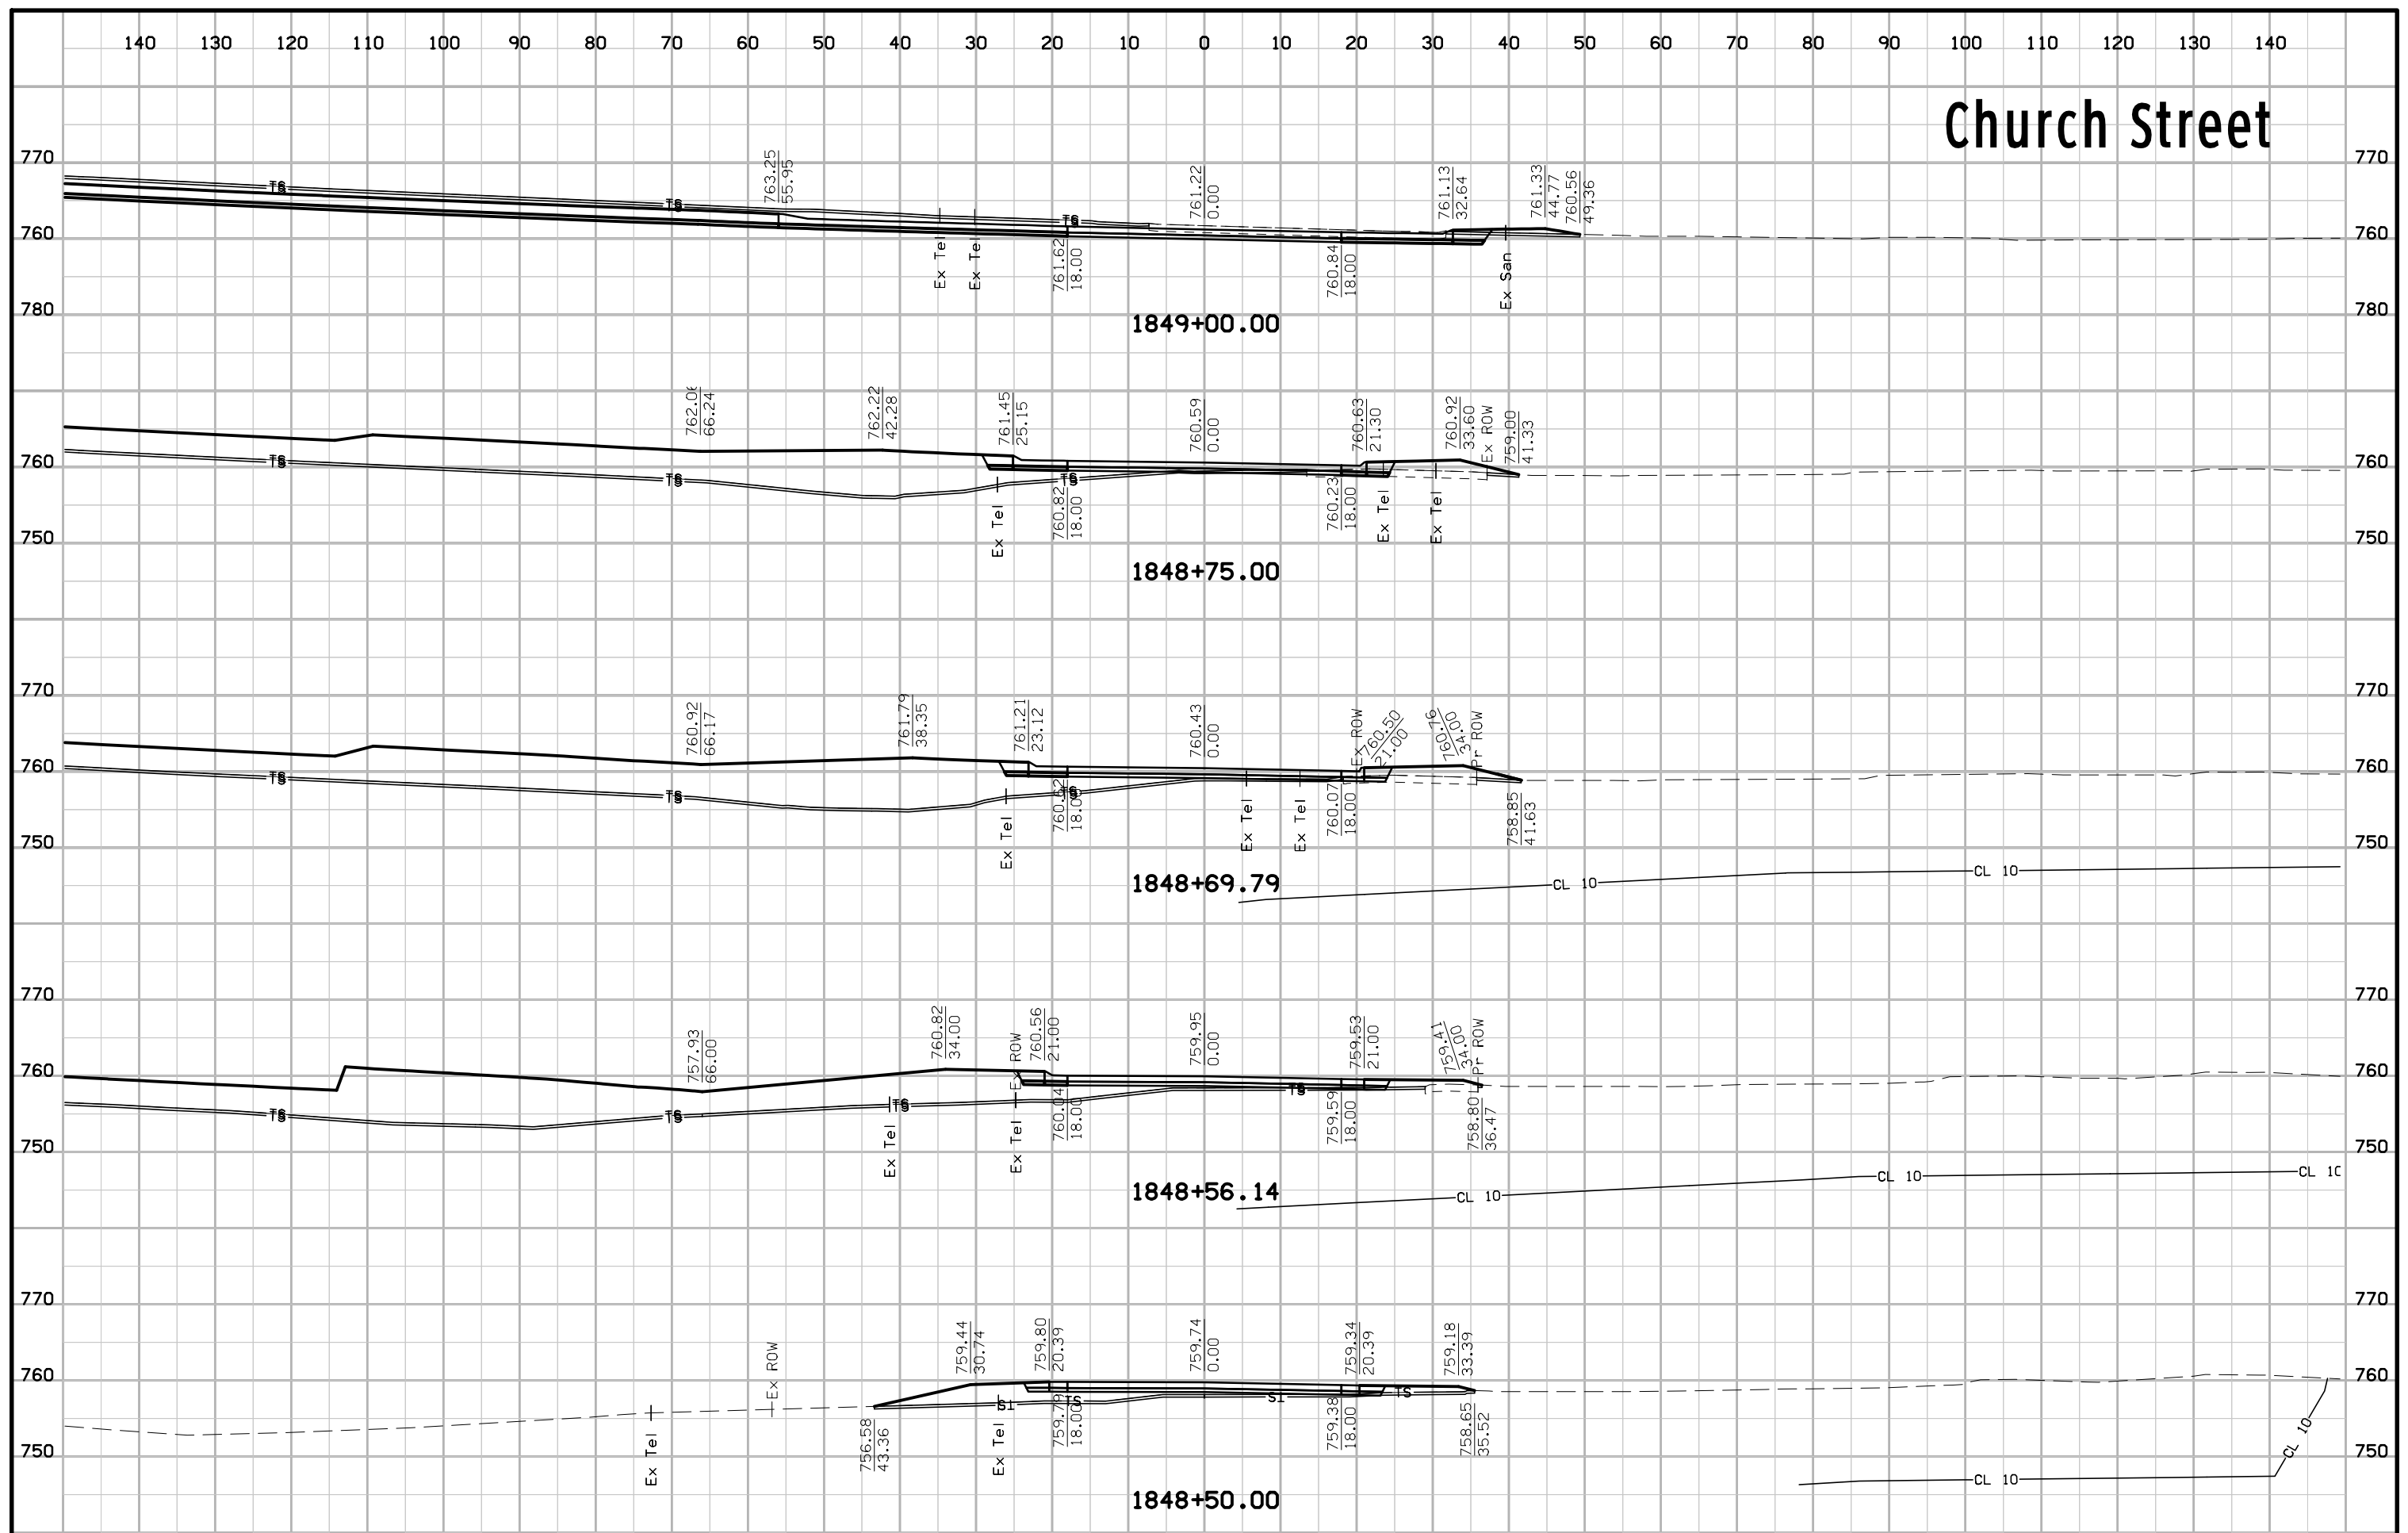


Church Street

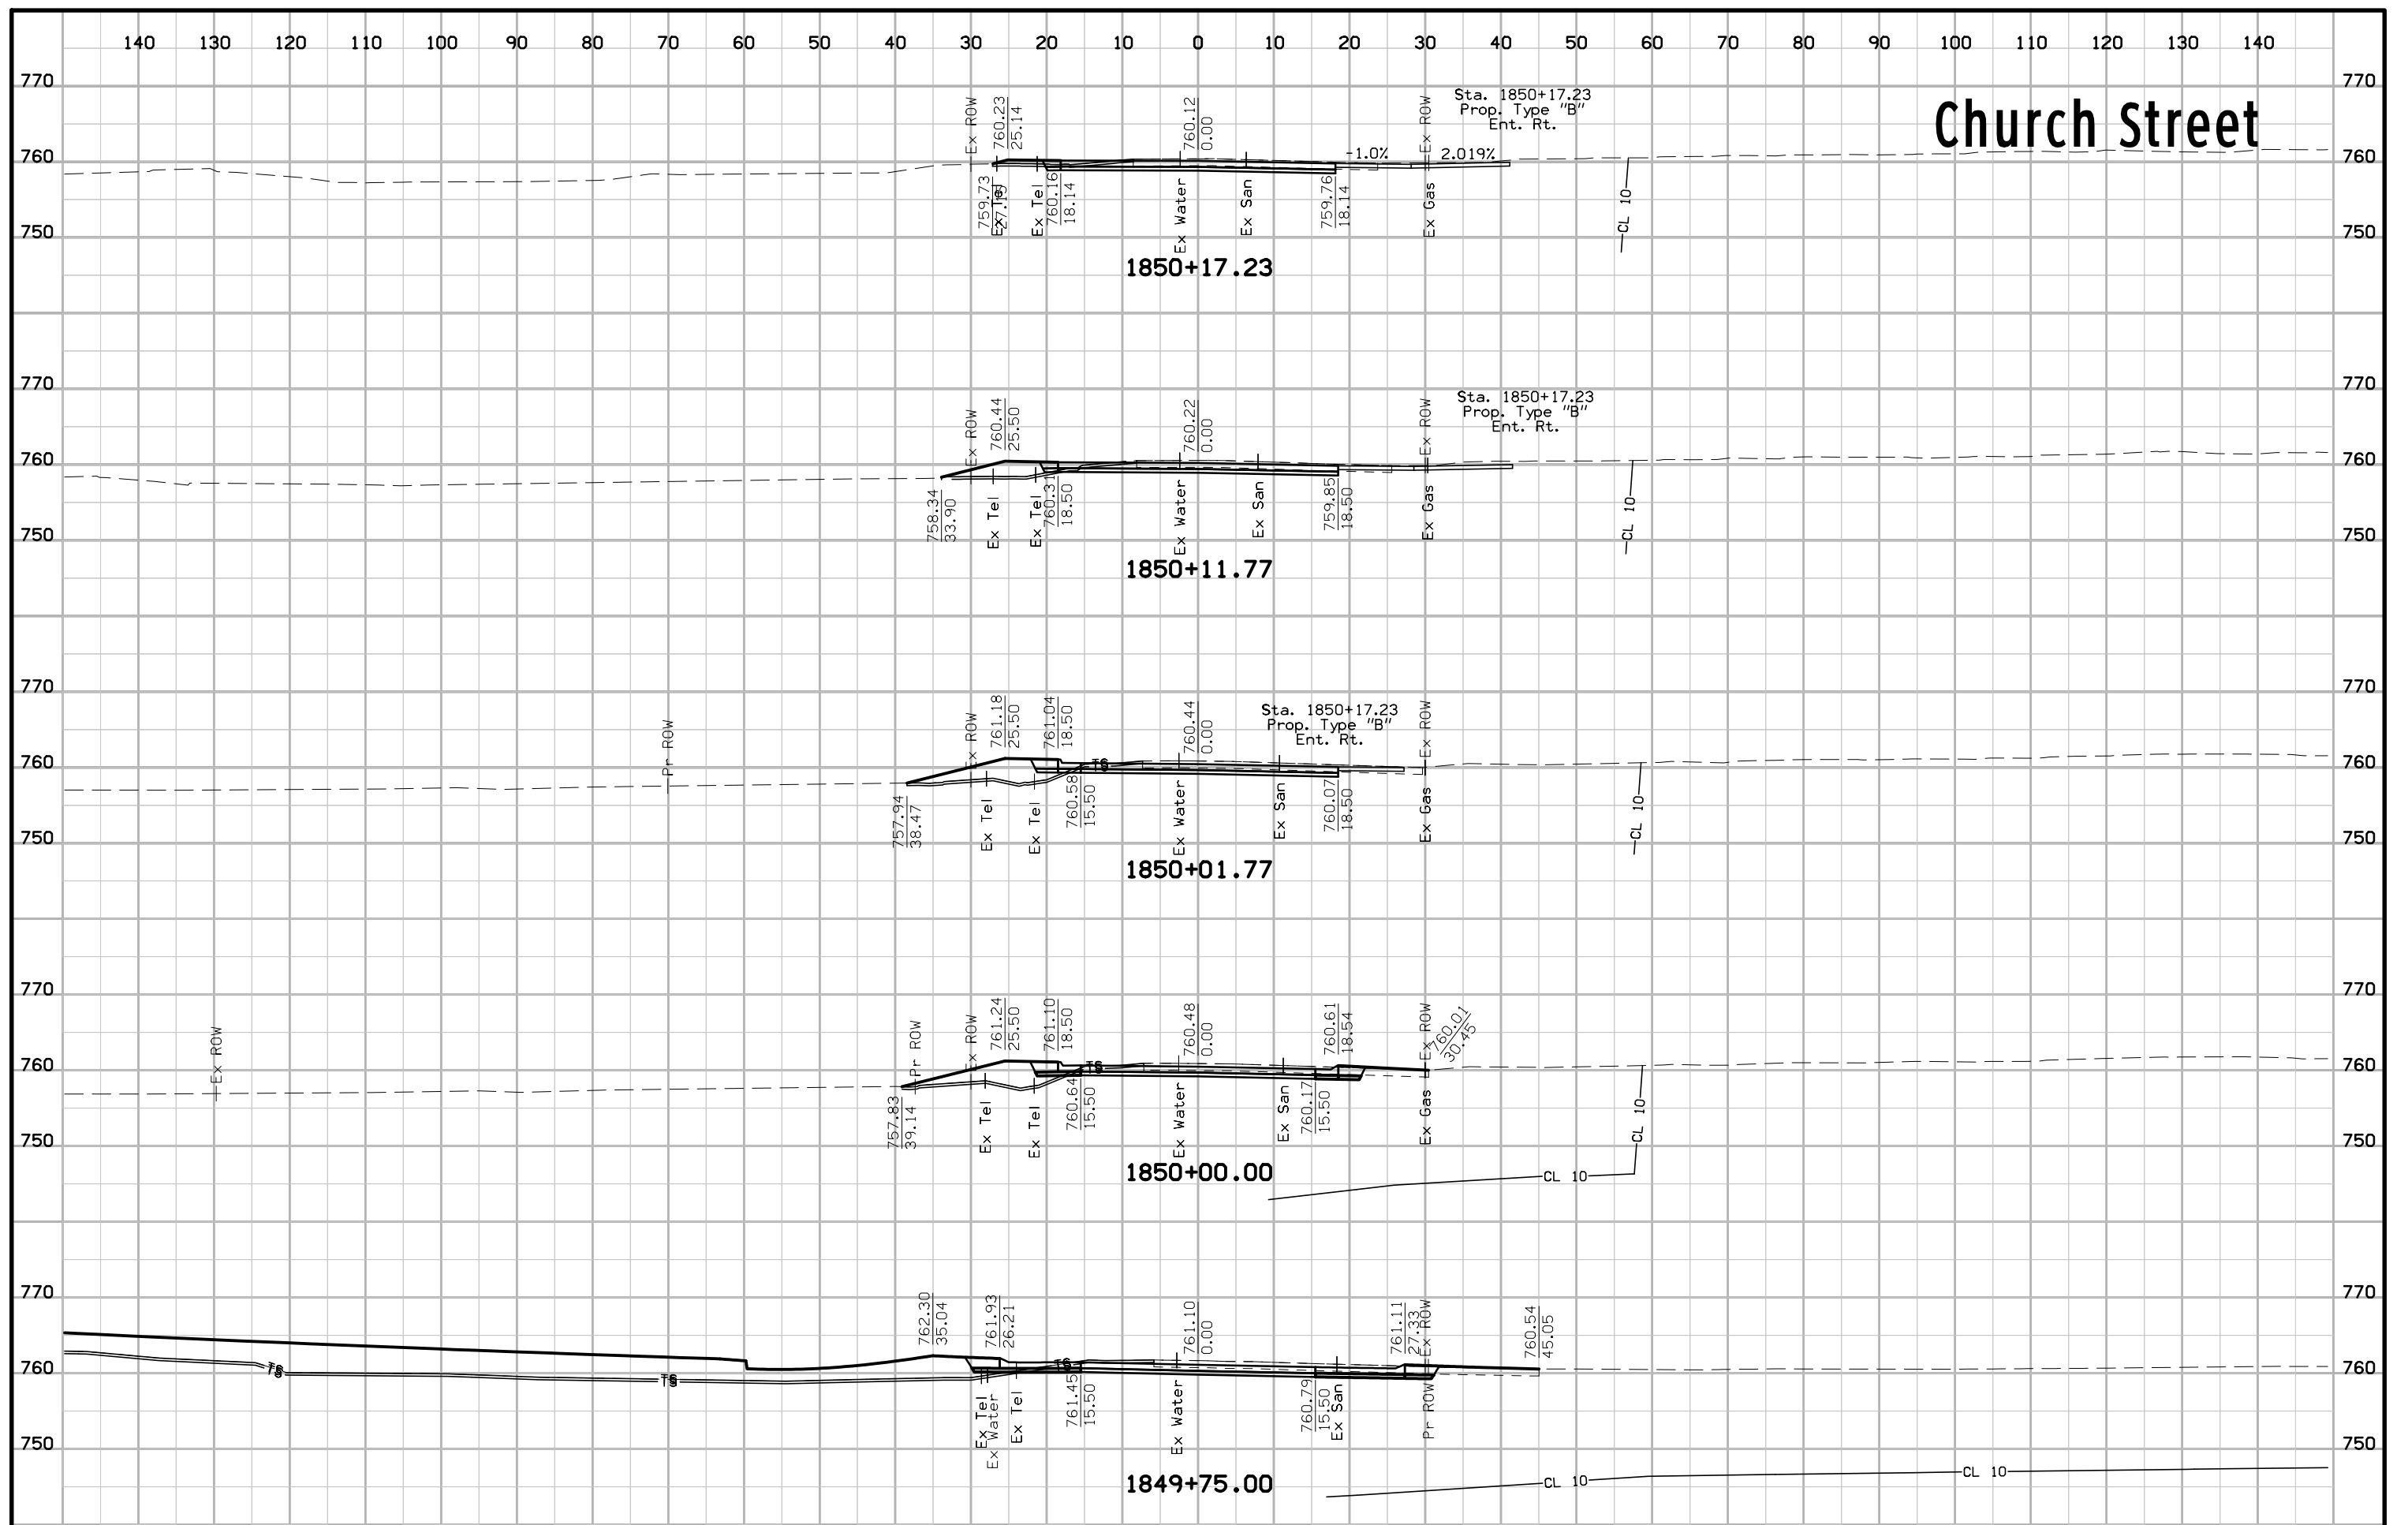


Church Street

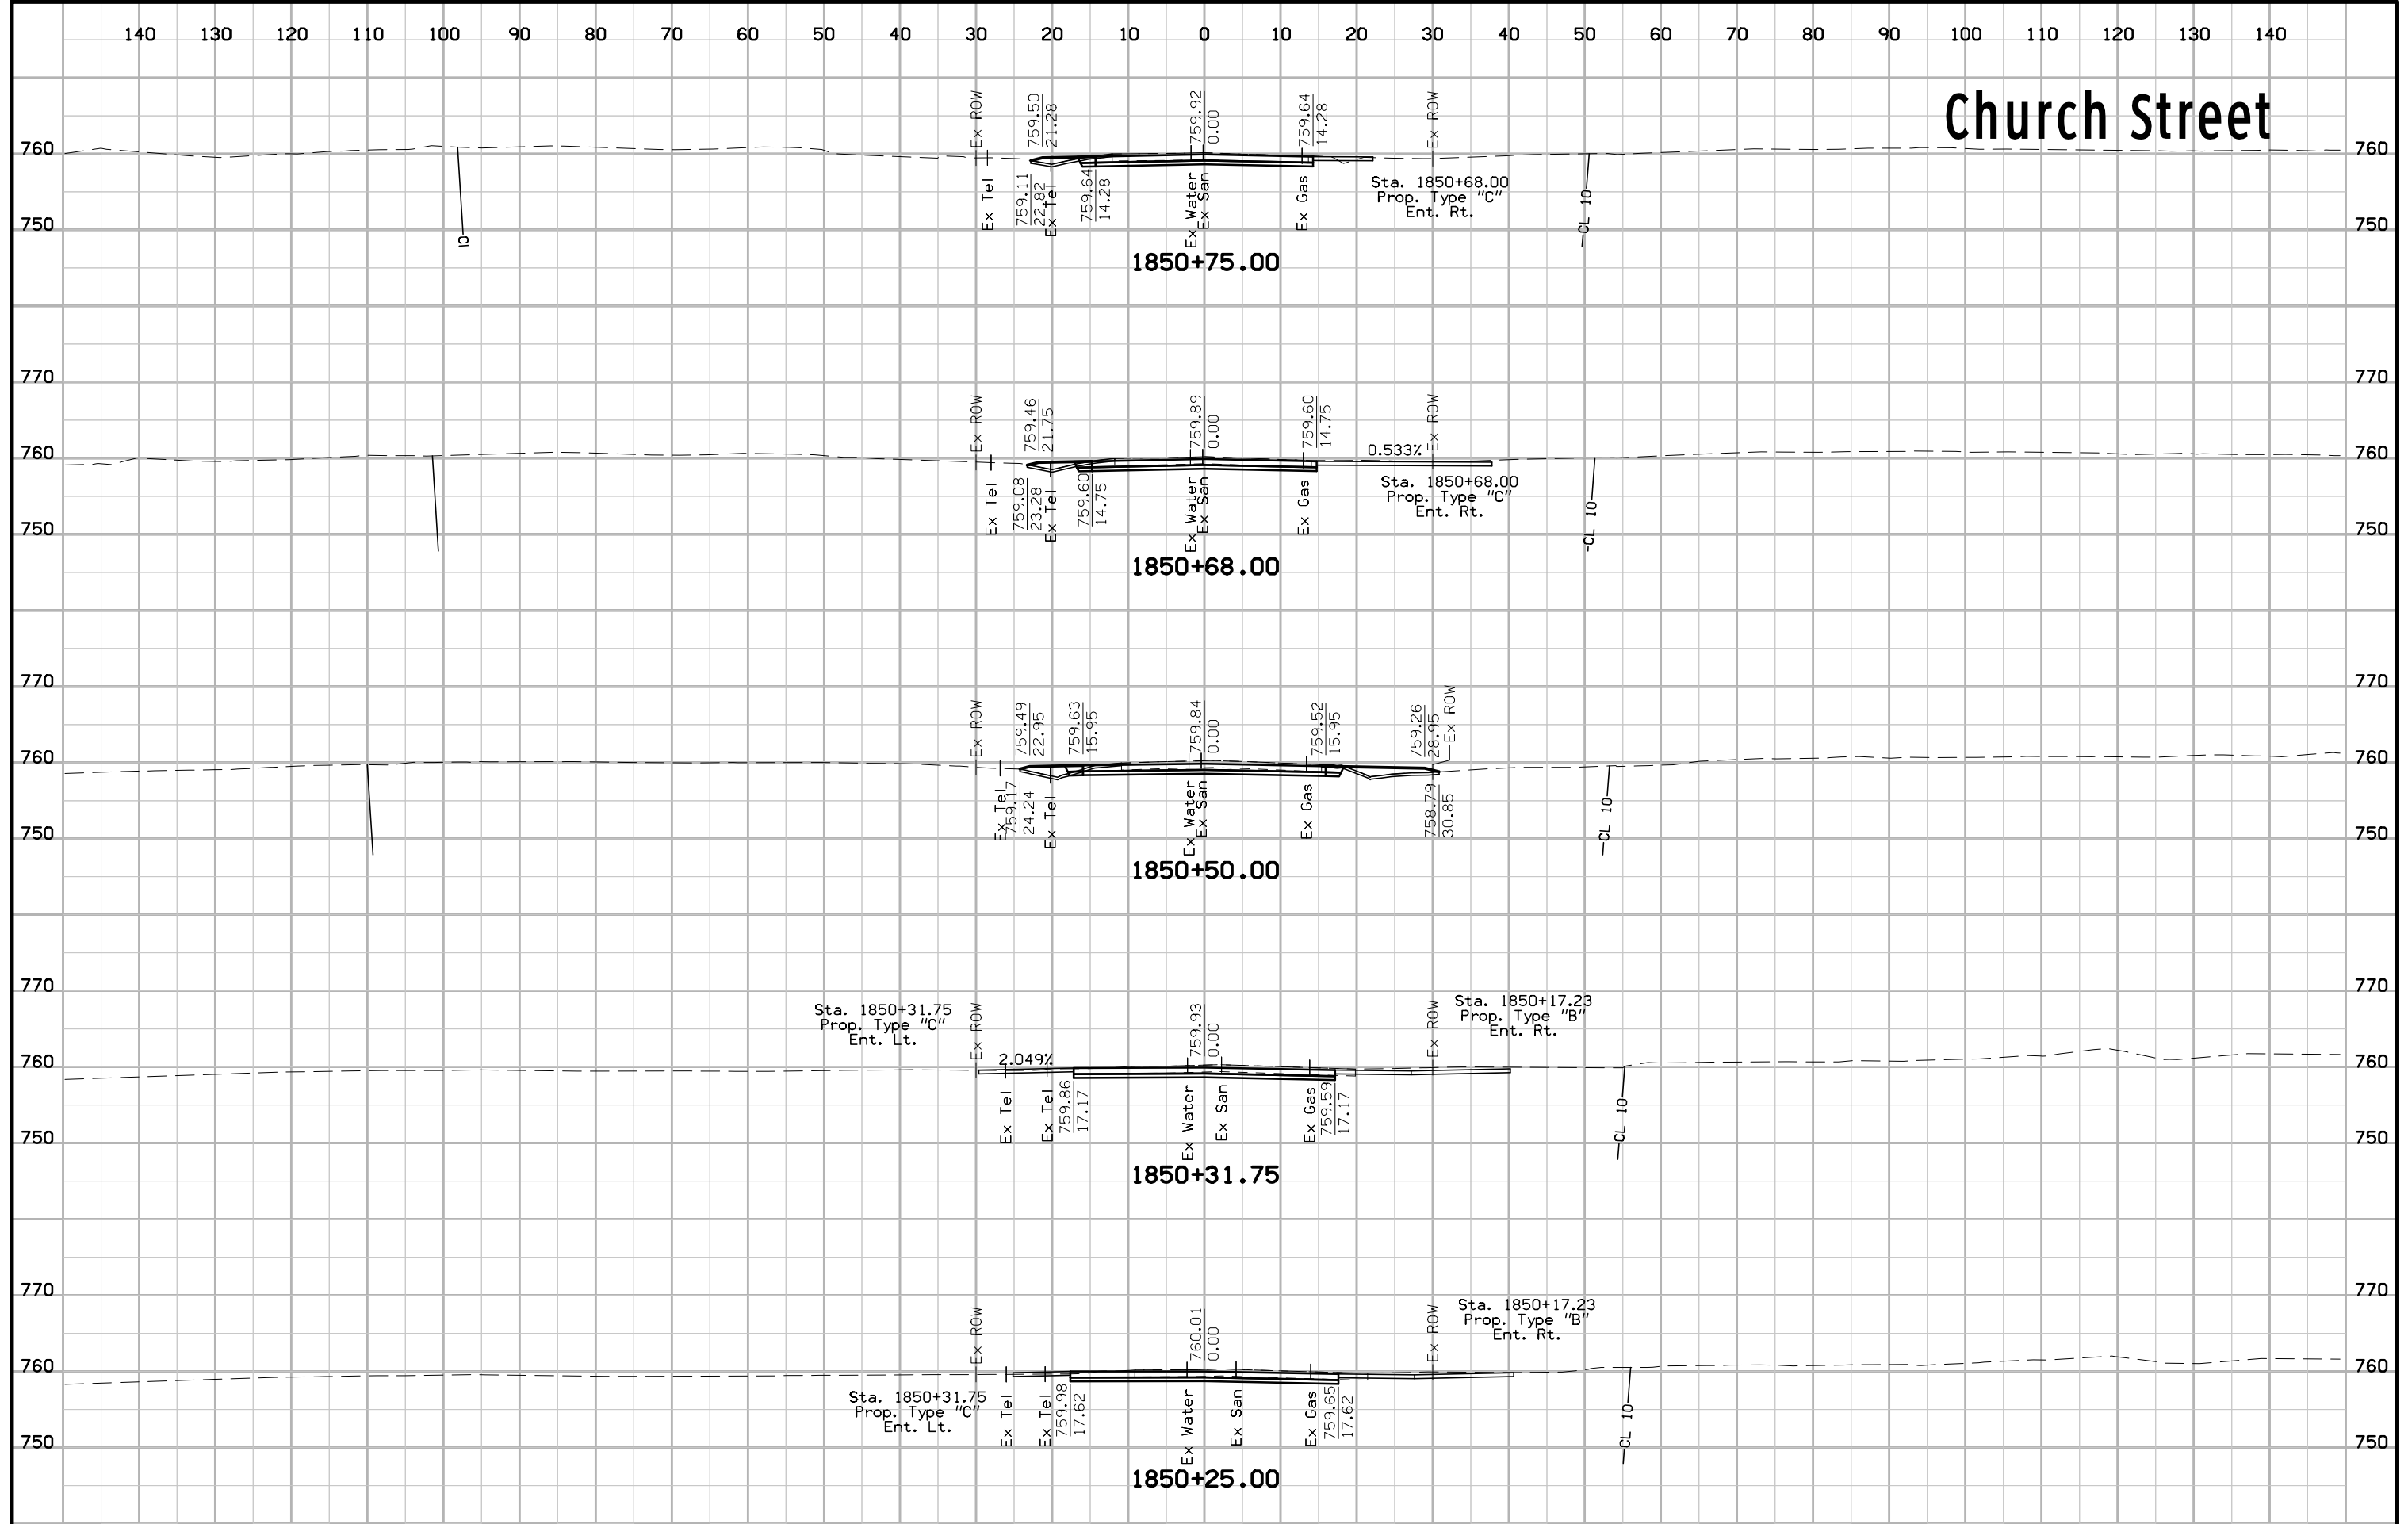


Church Street

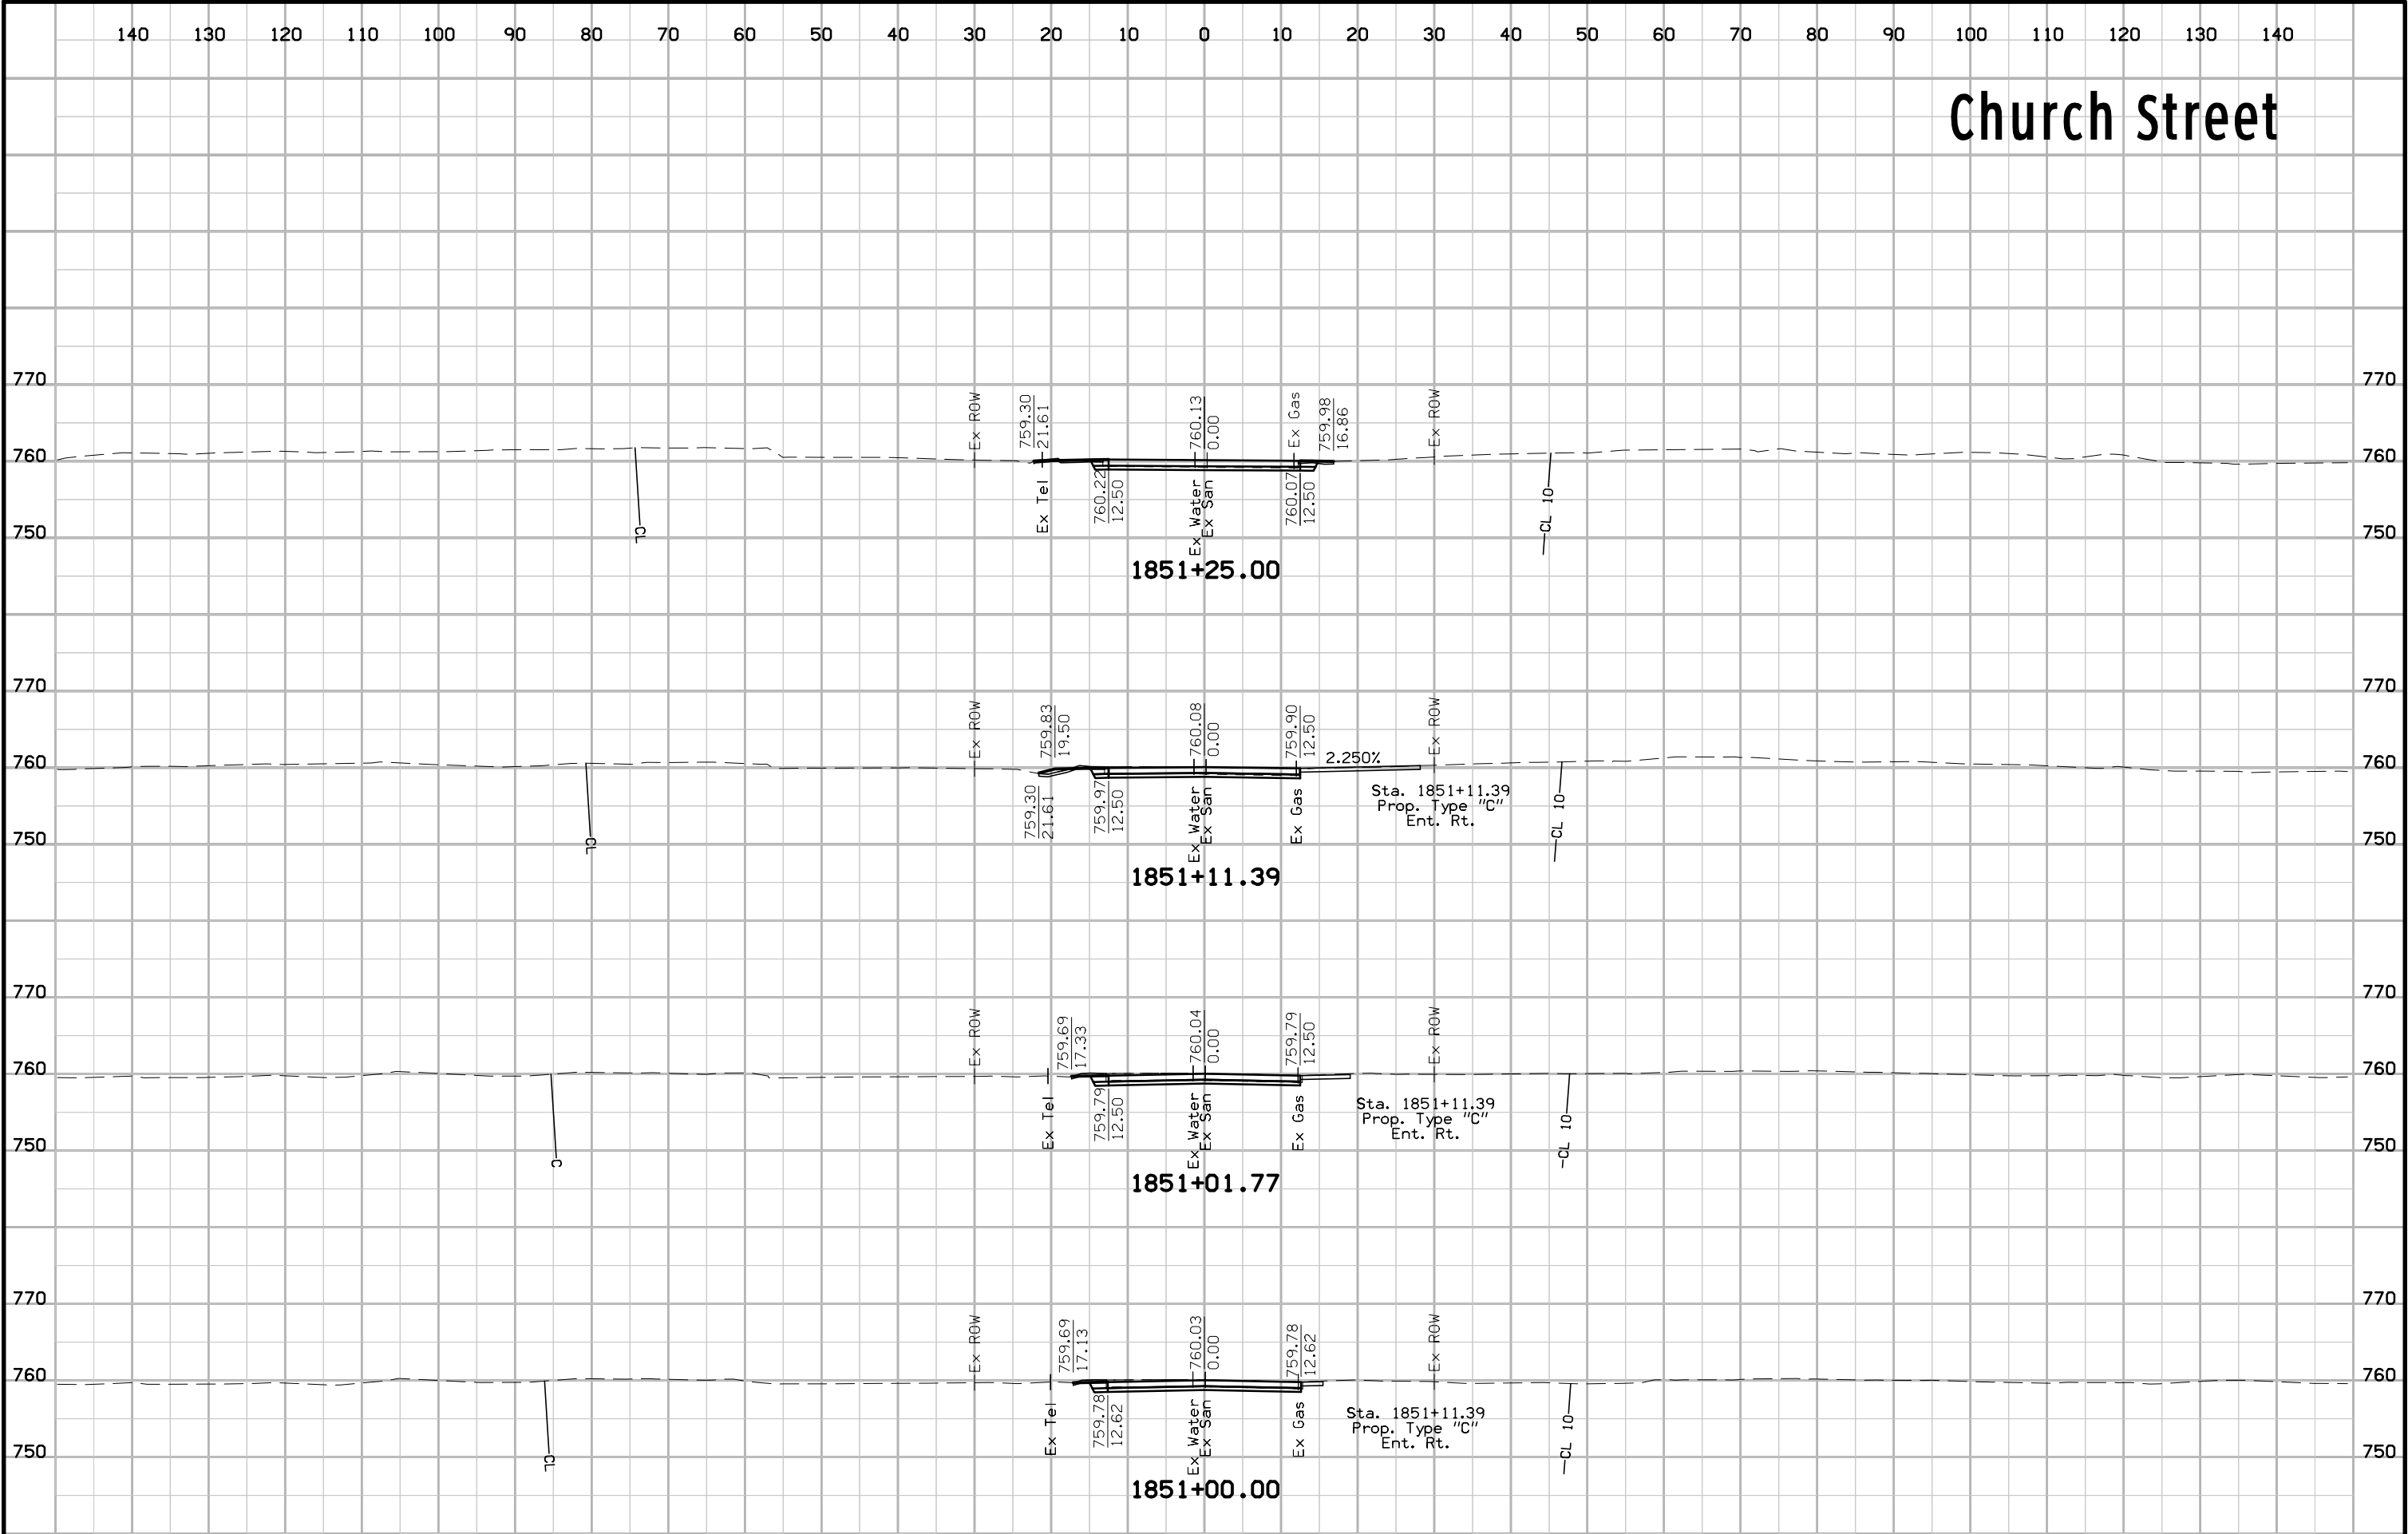


Prairie Avenue

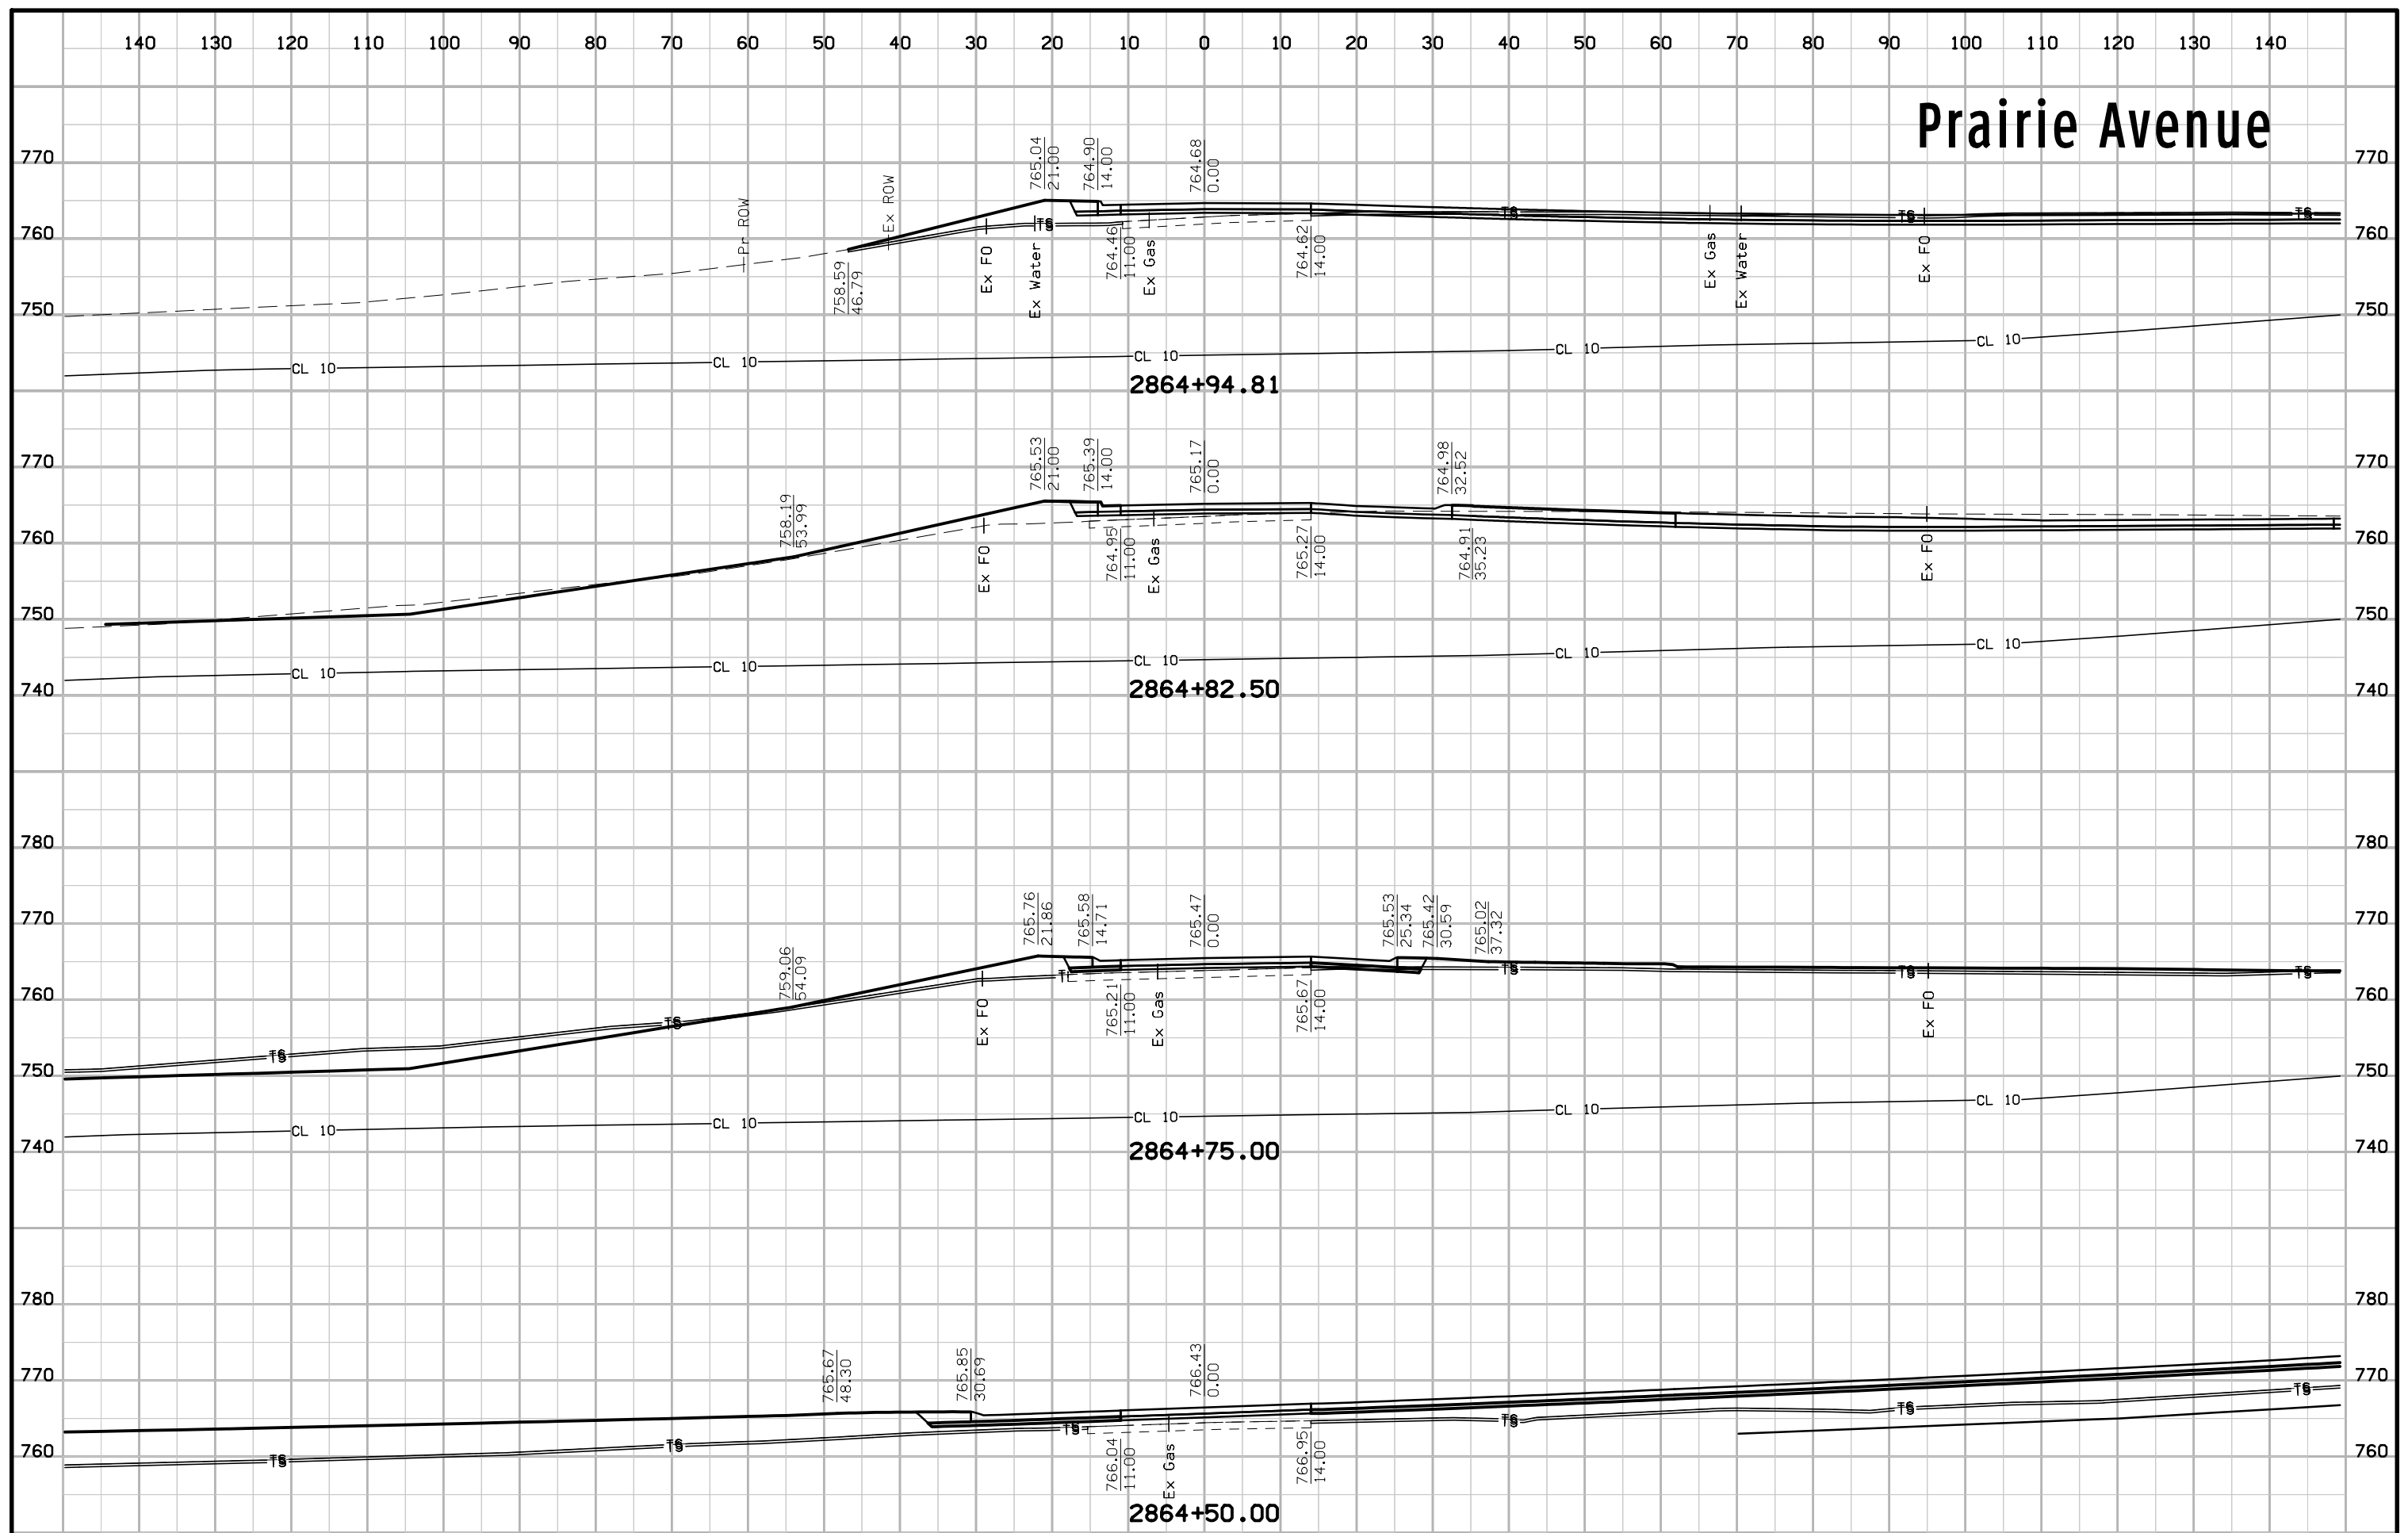


Prairie Avenue

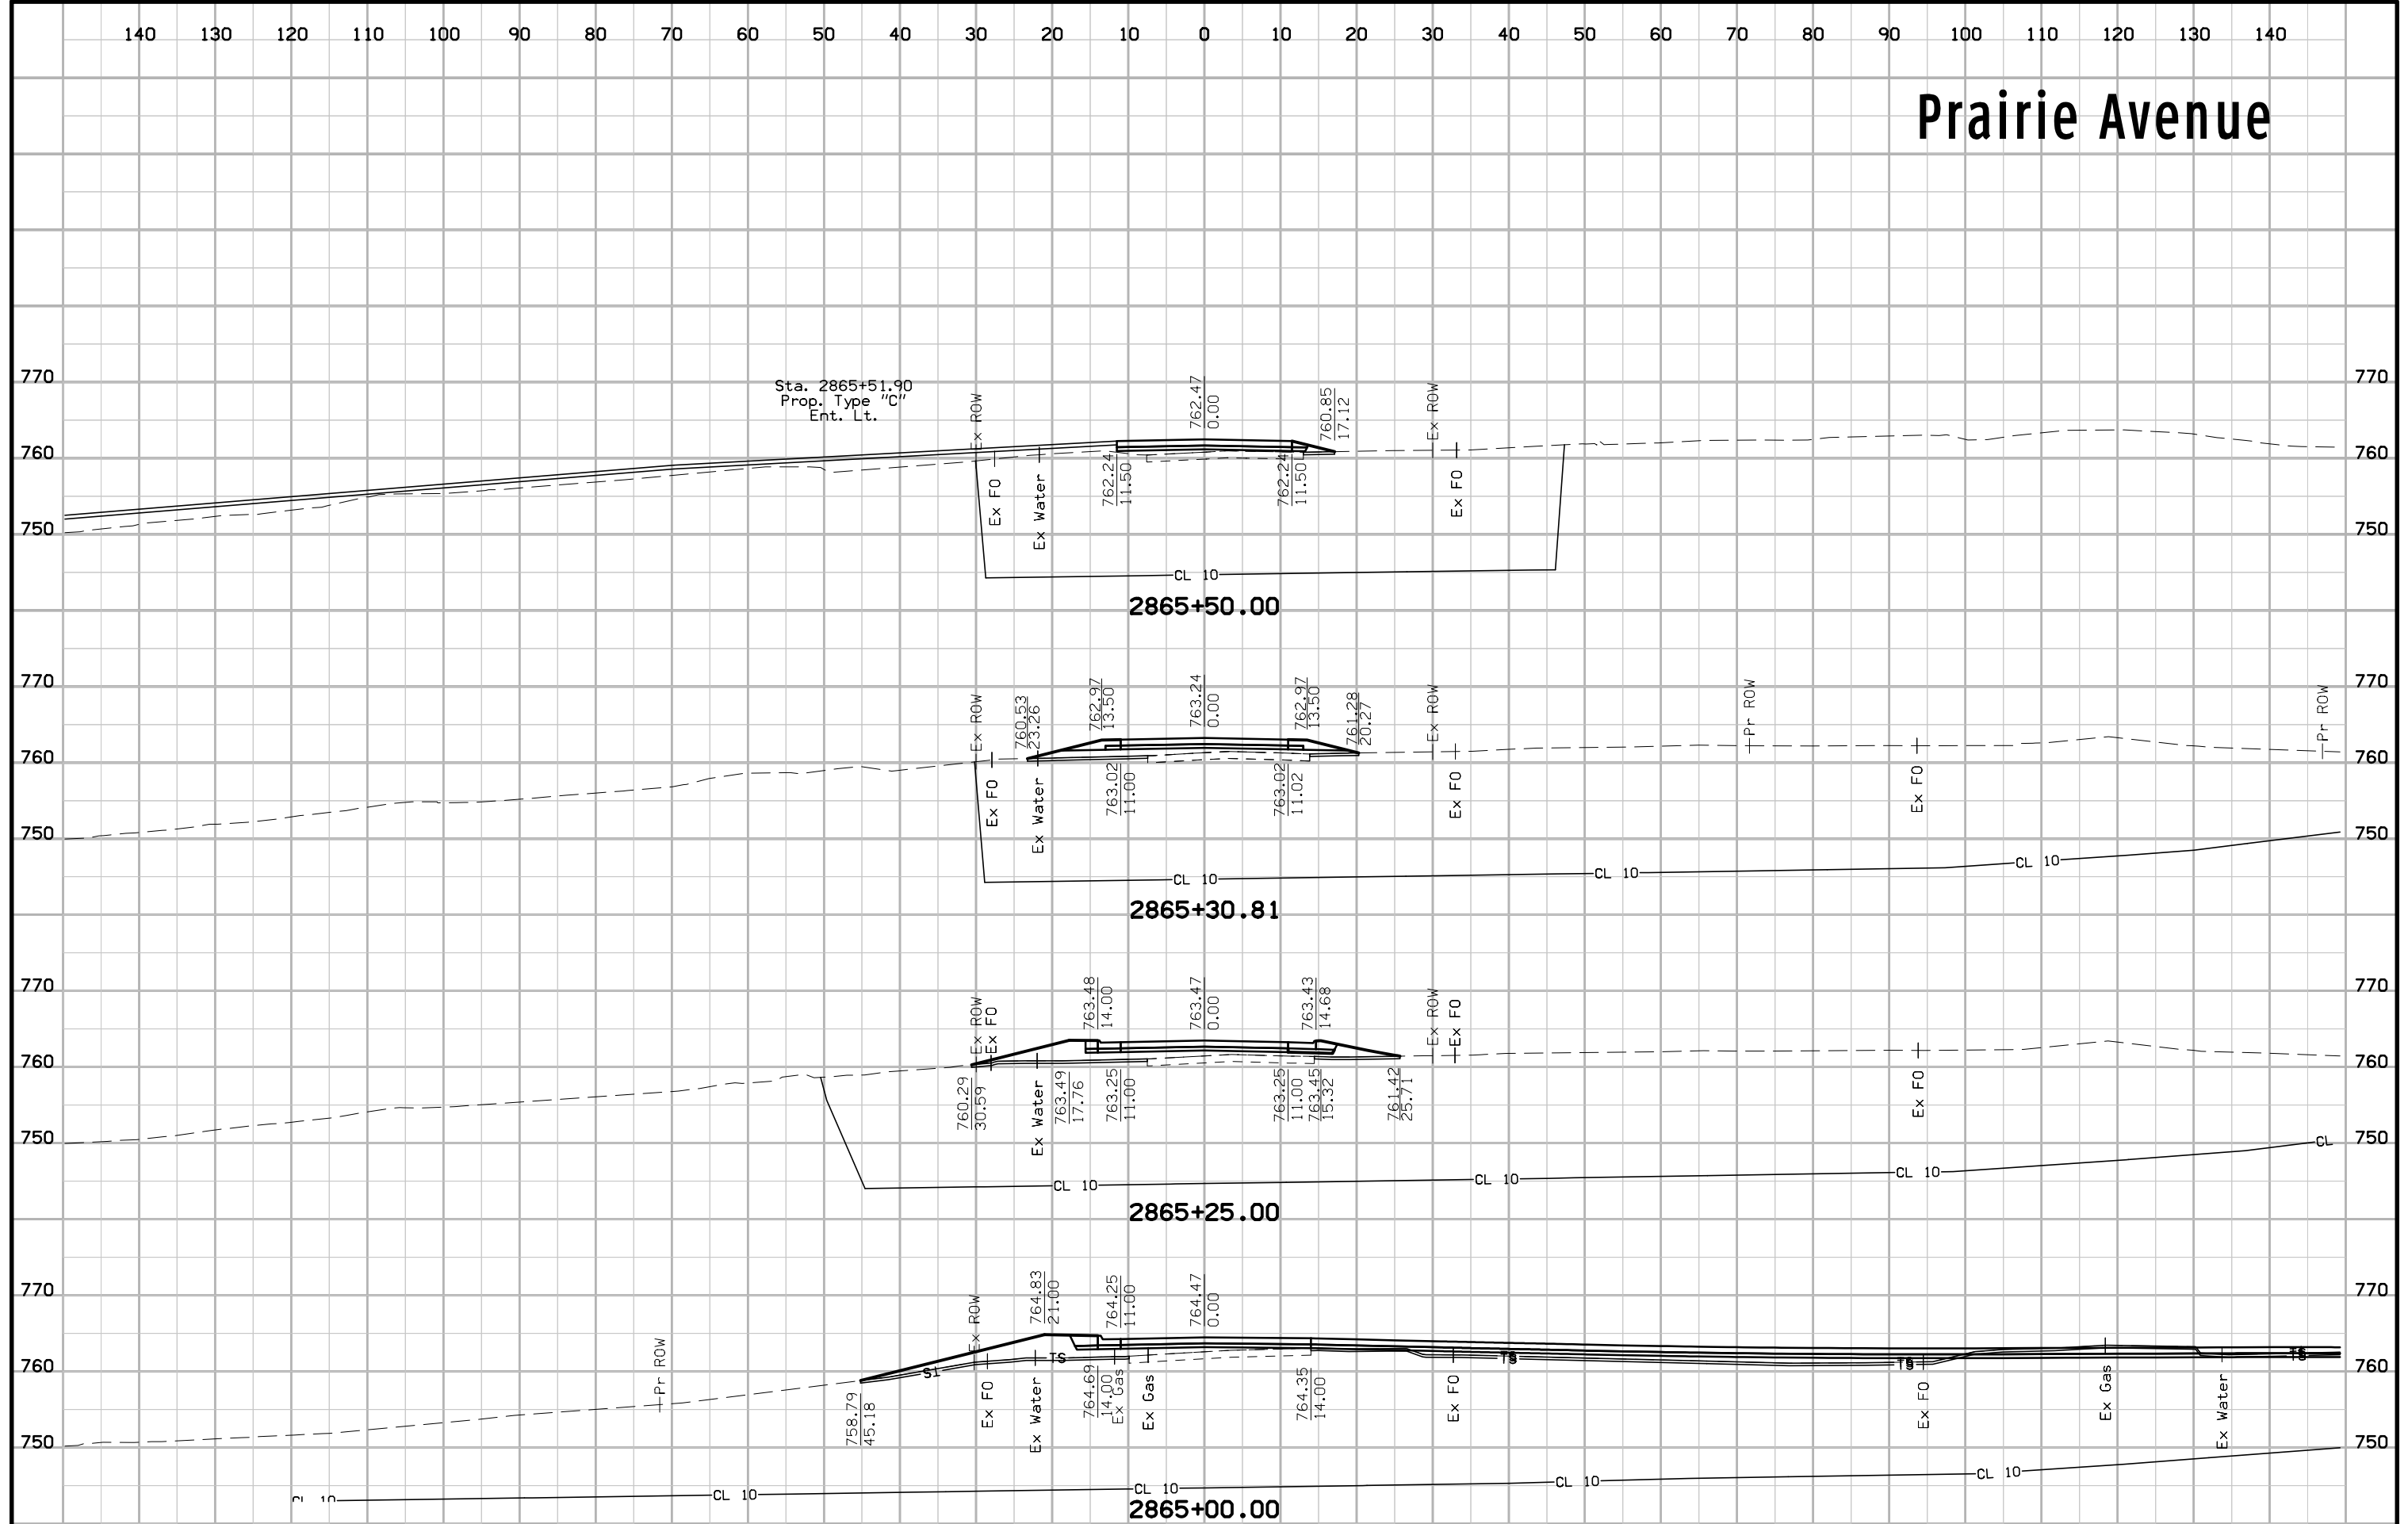


Prairie Avenue

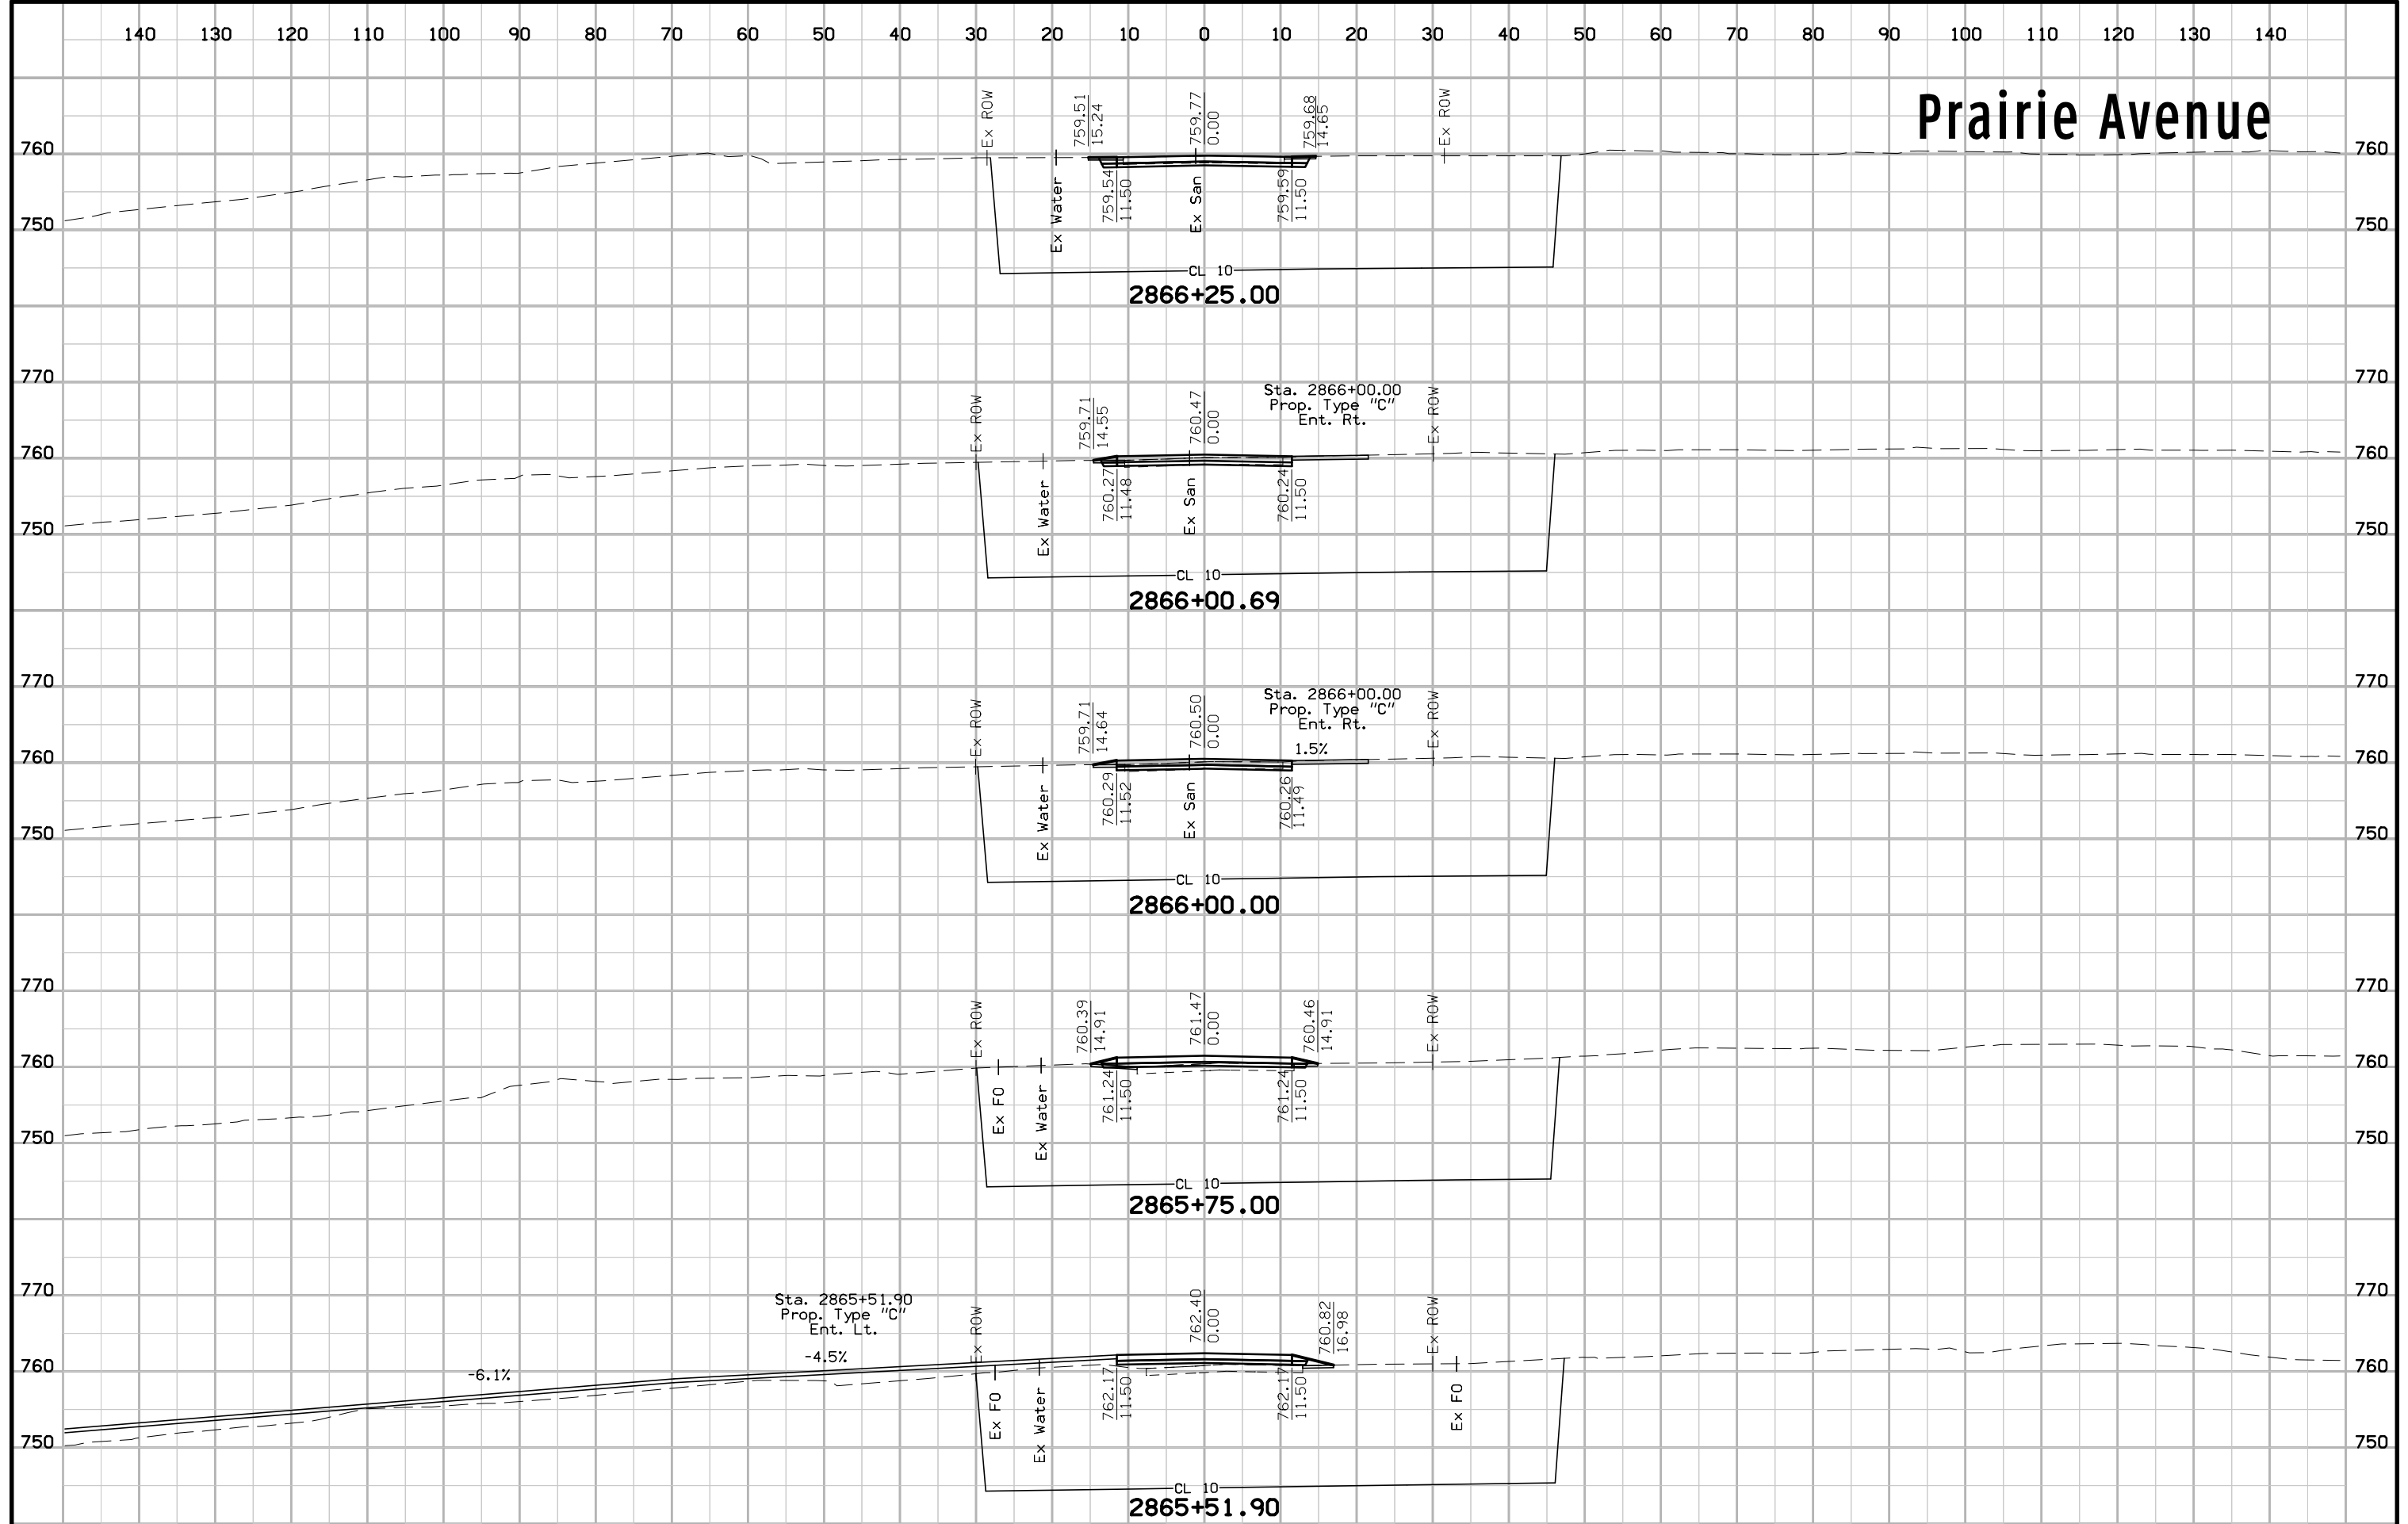


Prairie Avenue

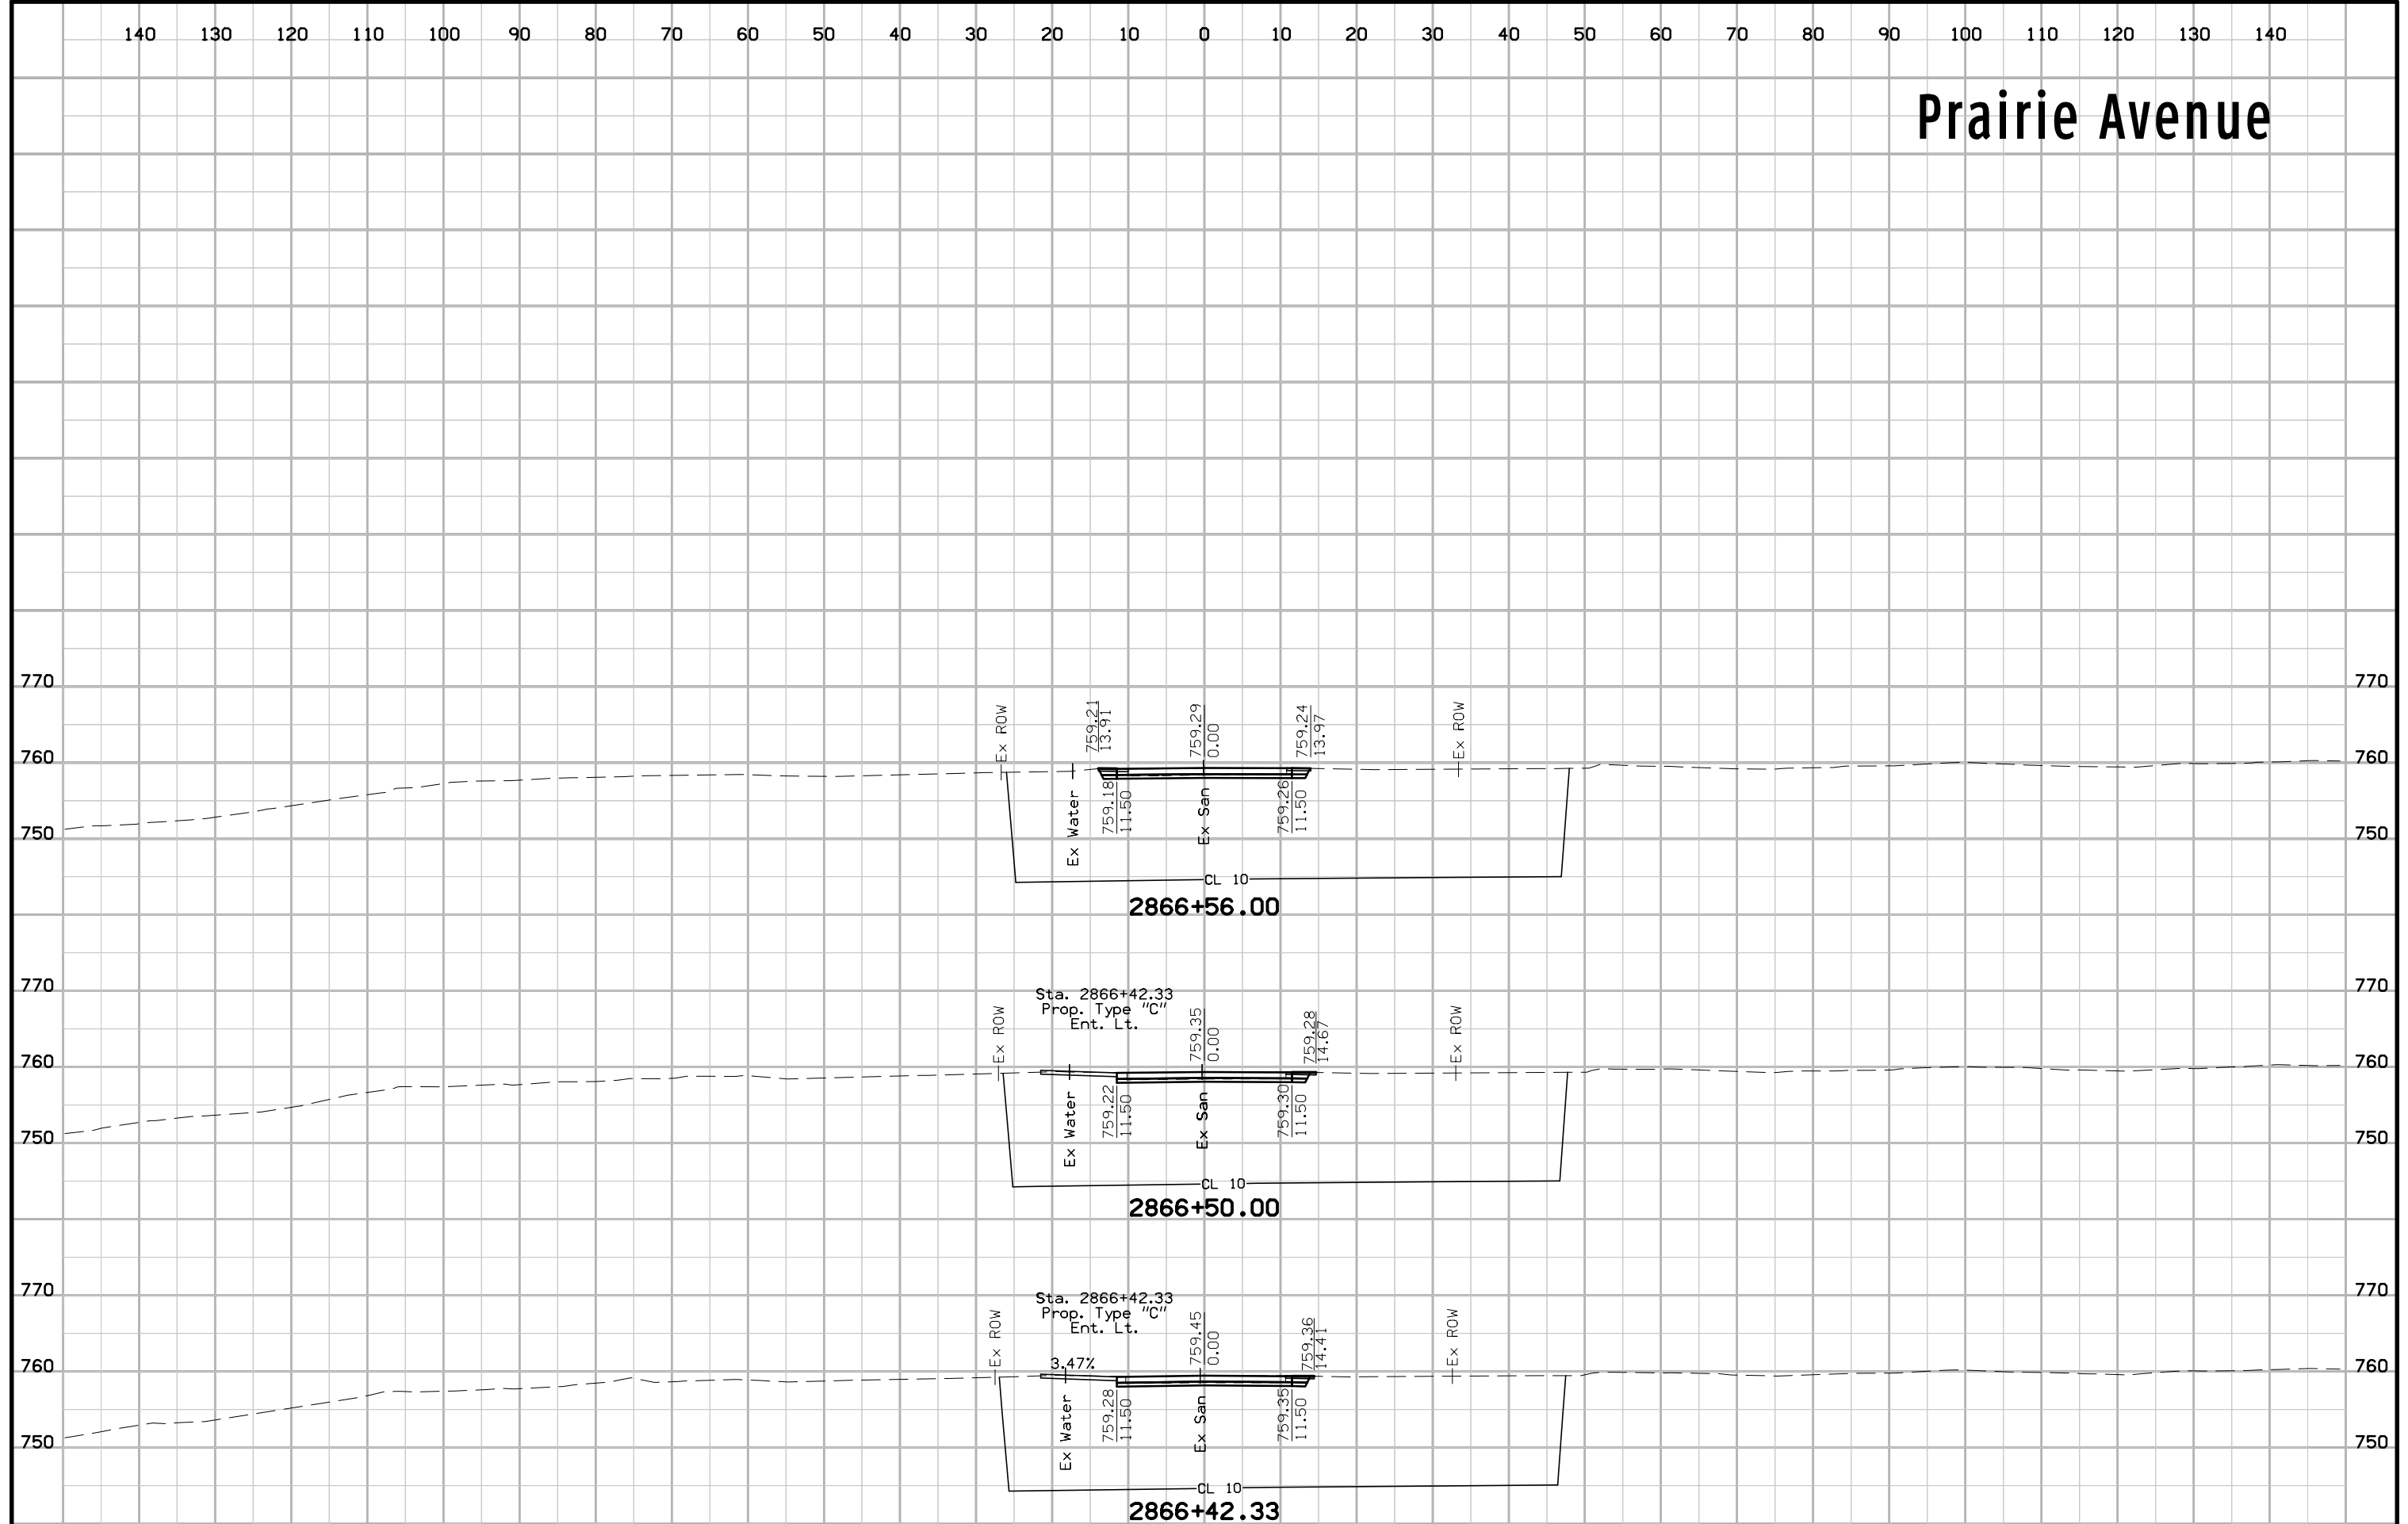


Losey Avenue

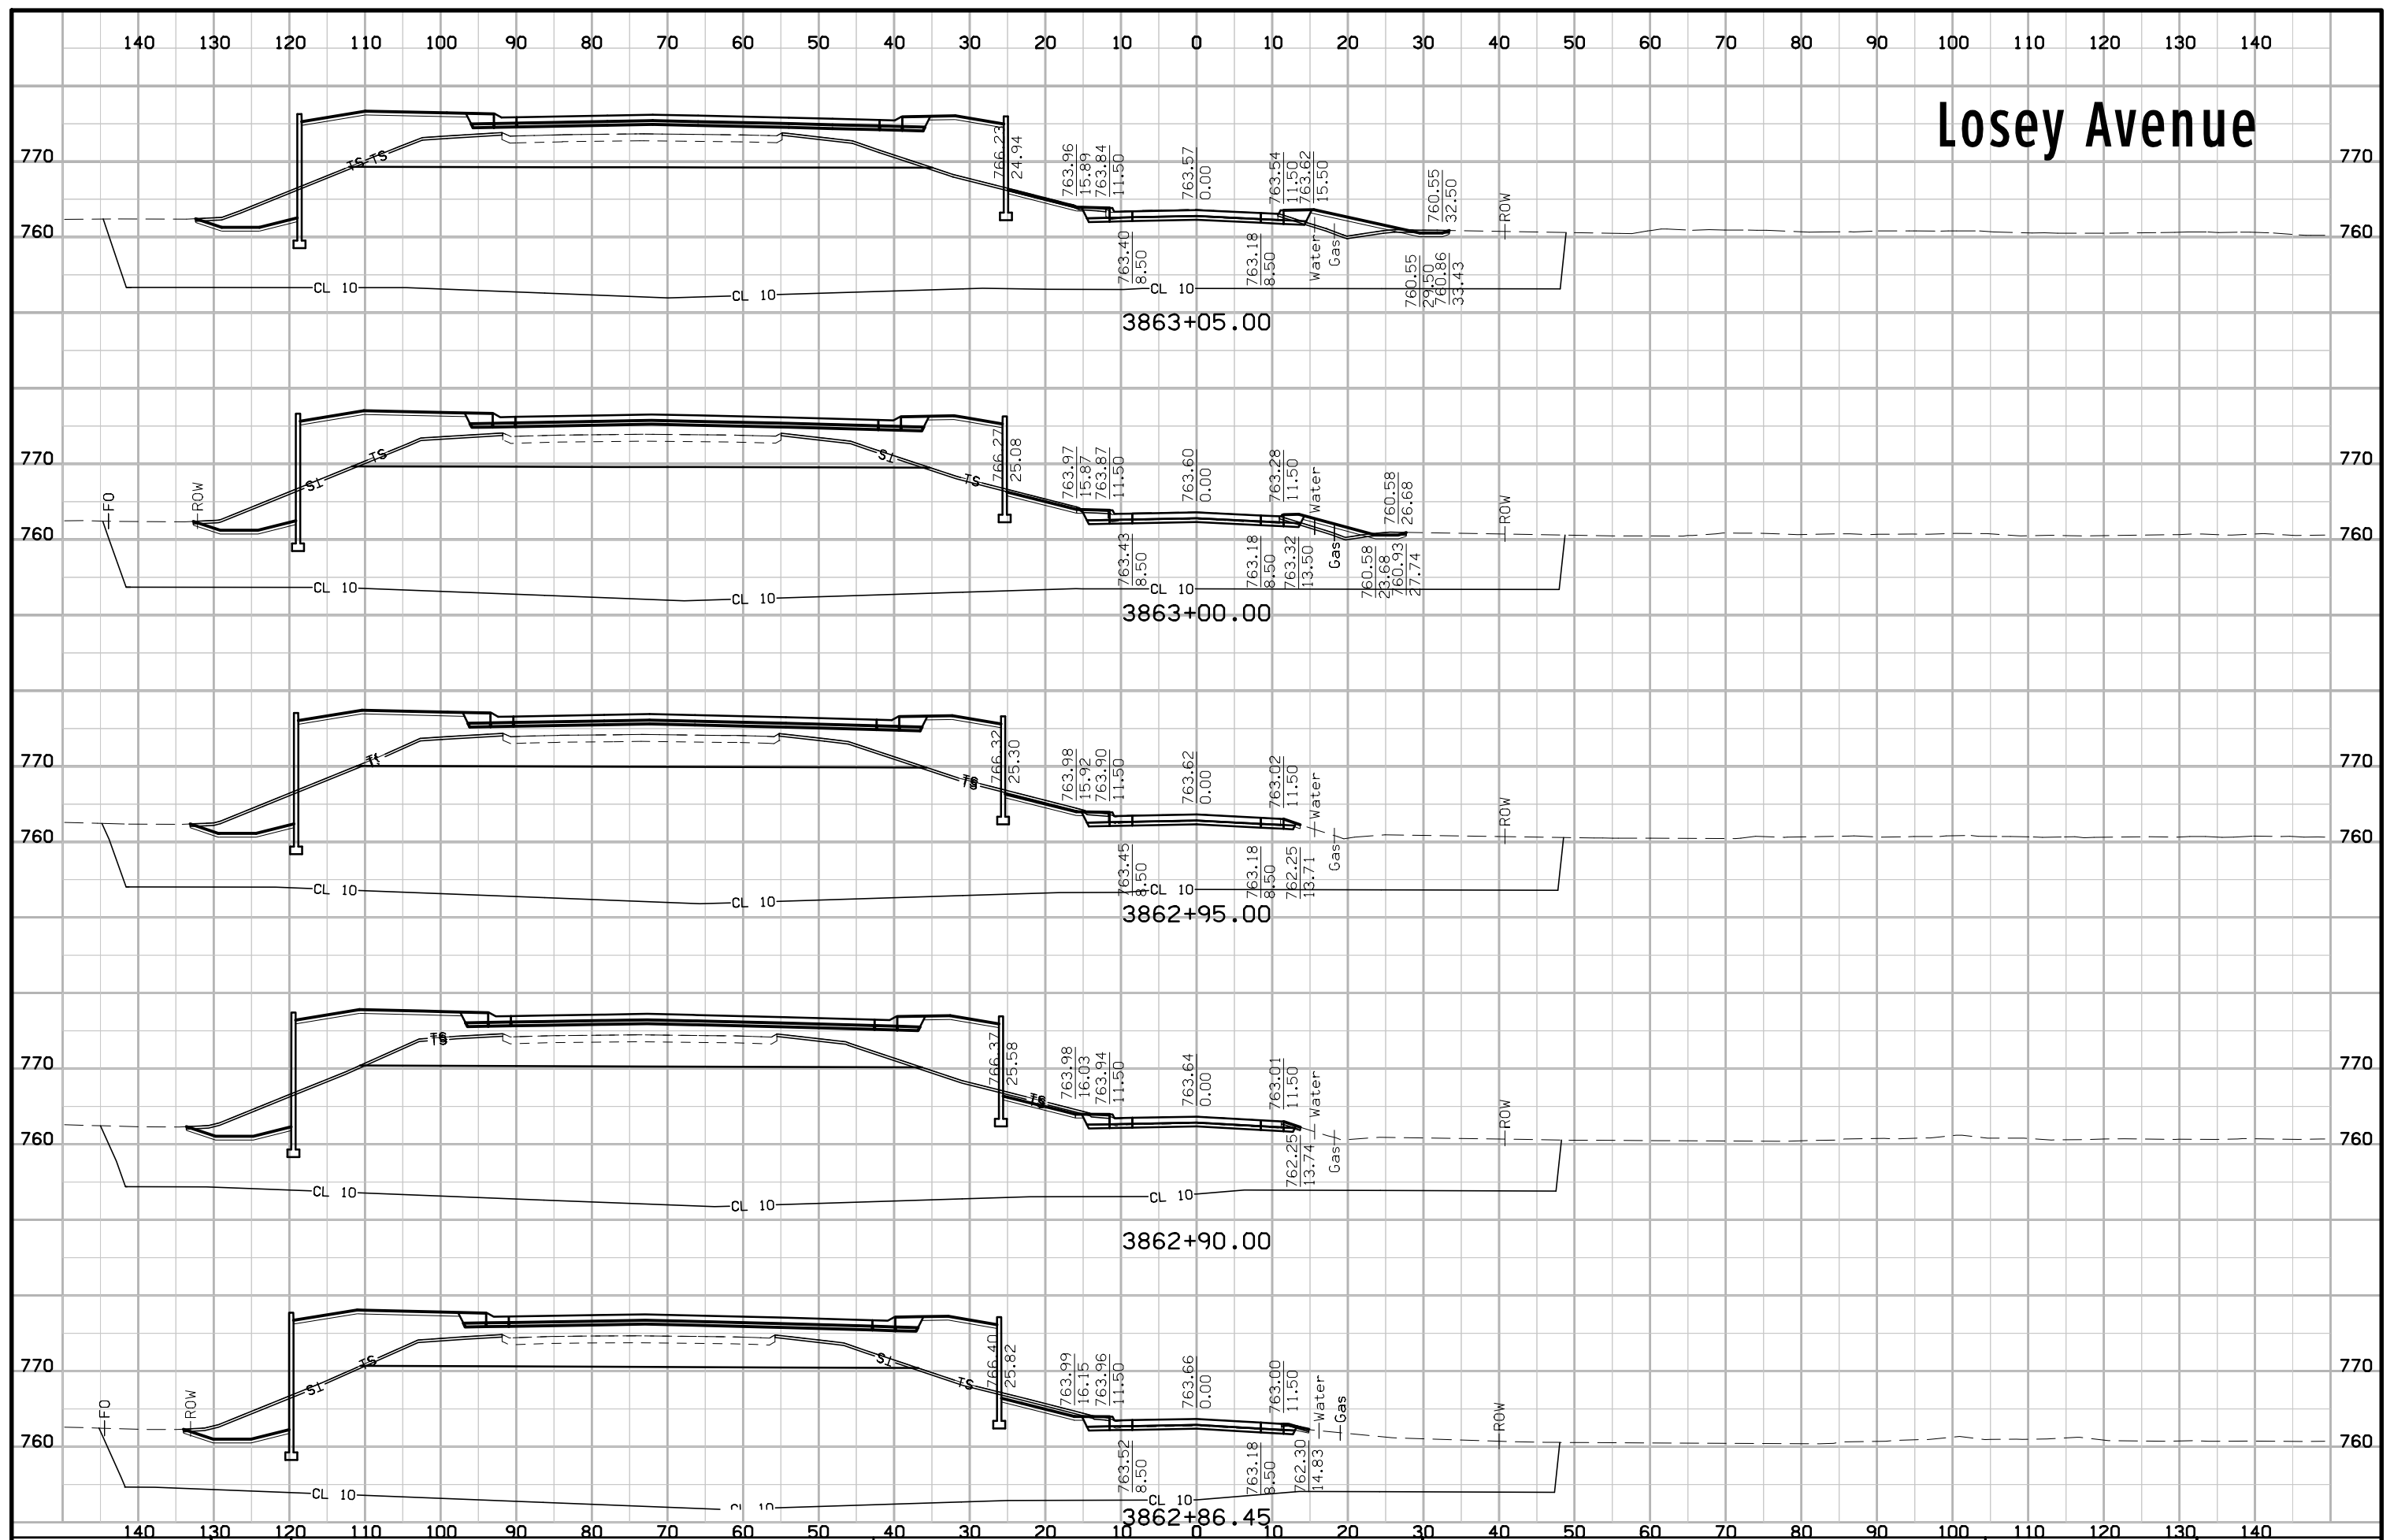


Losey Avenue

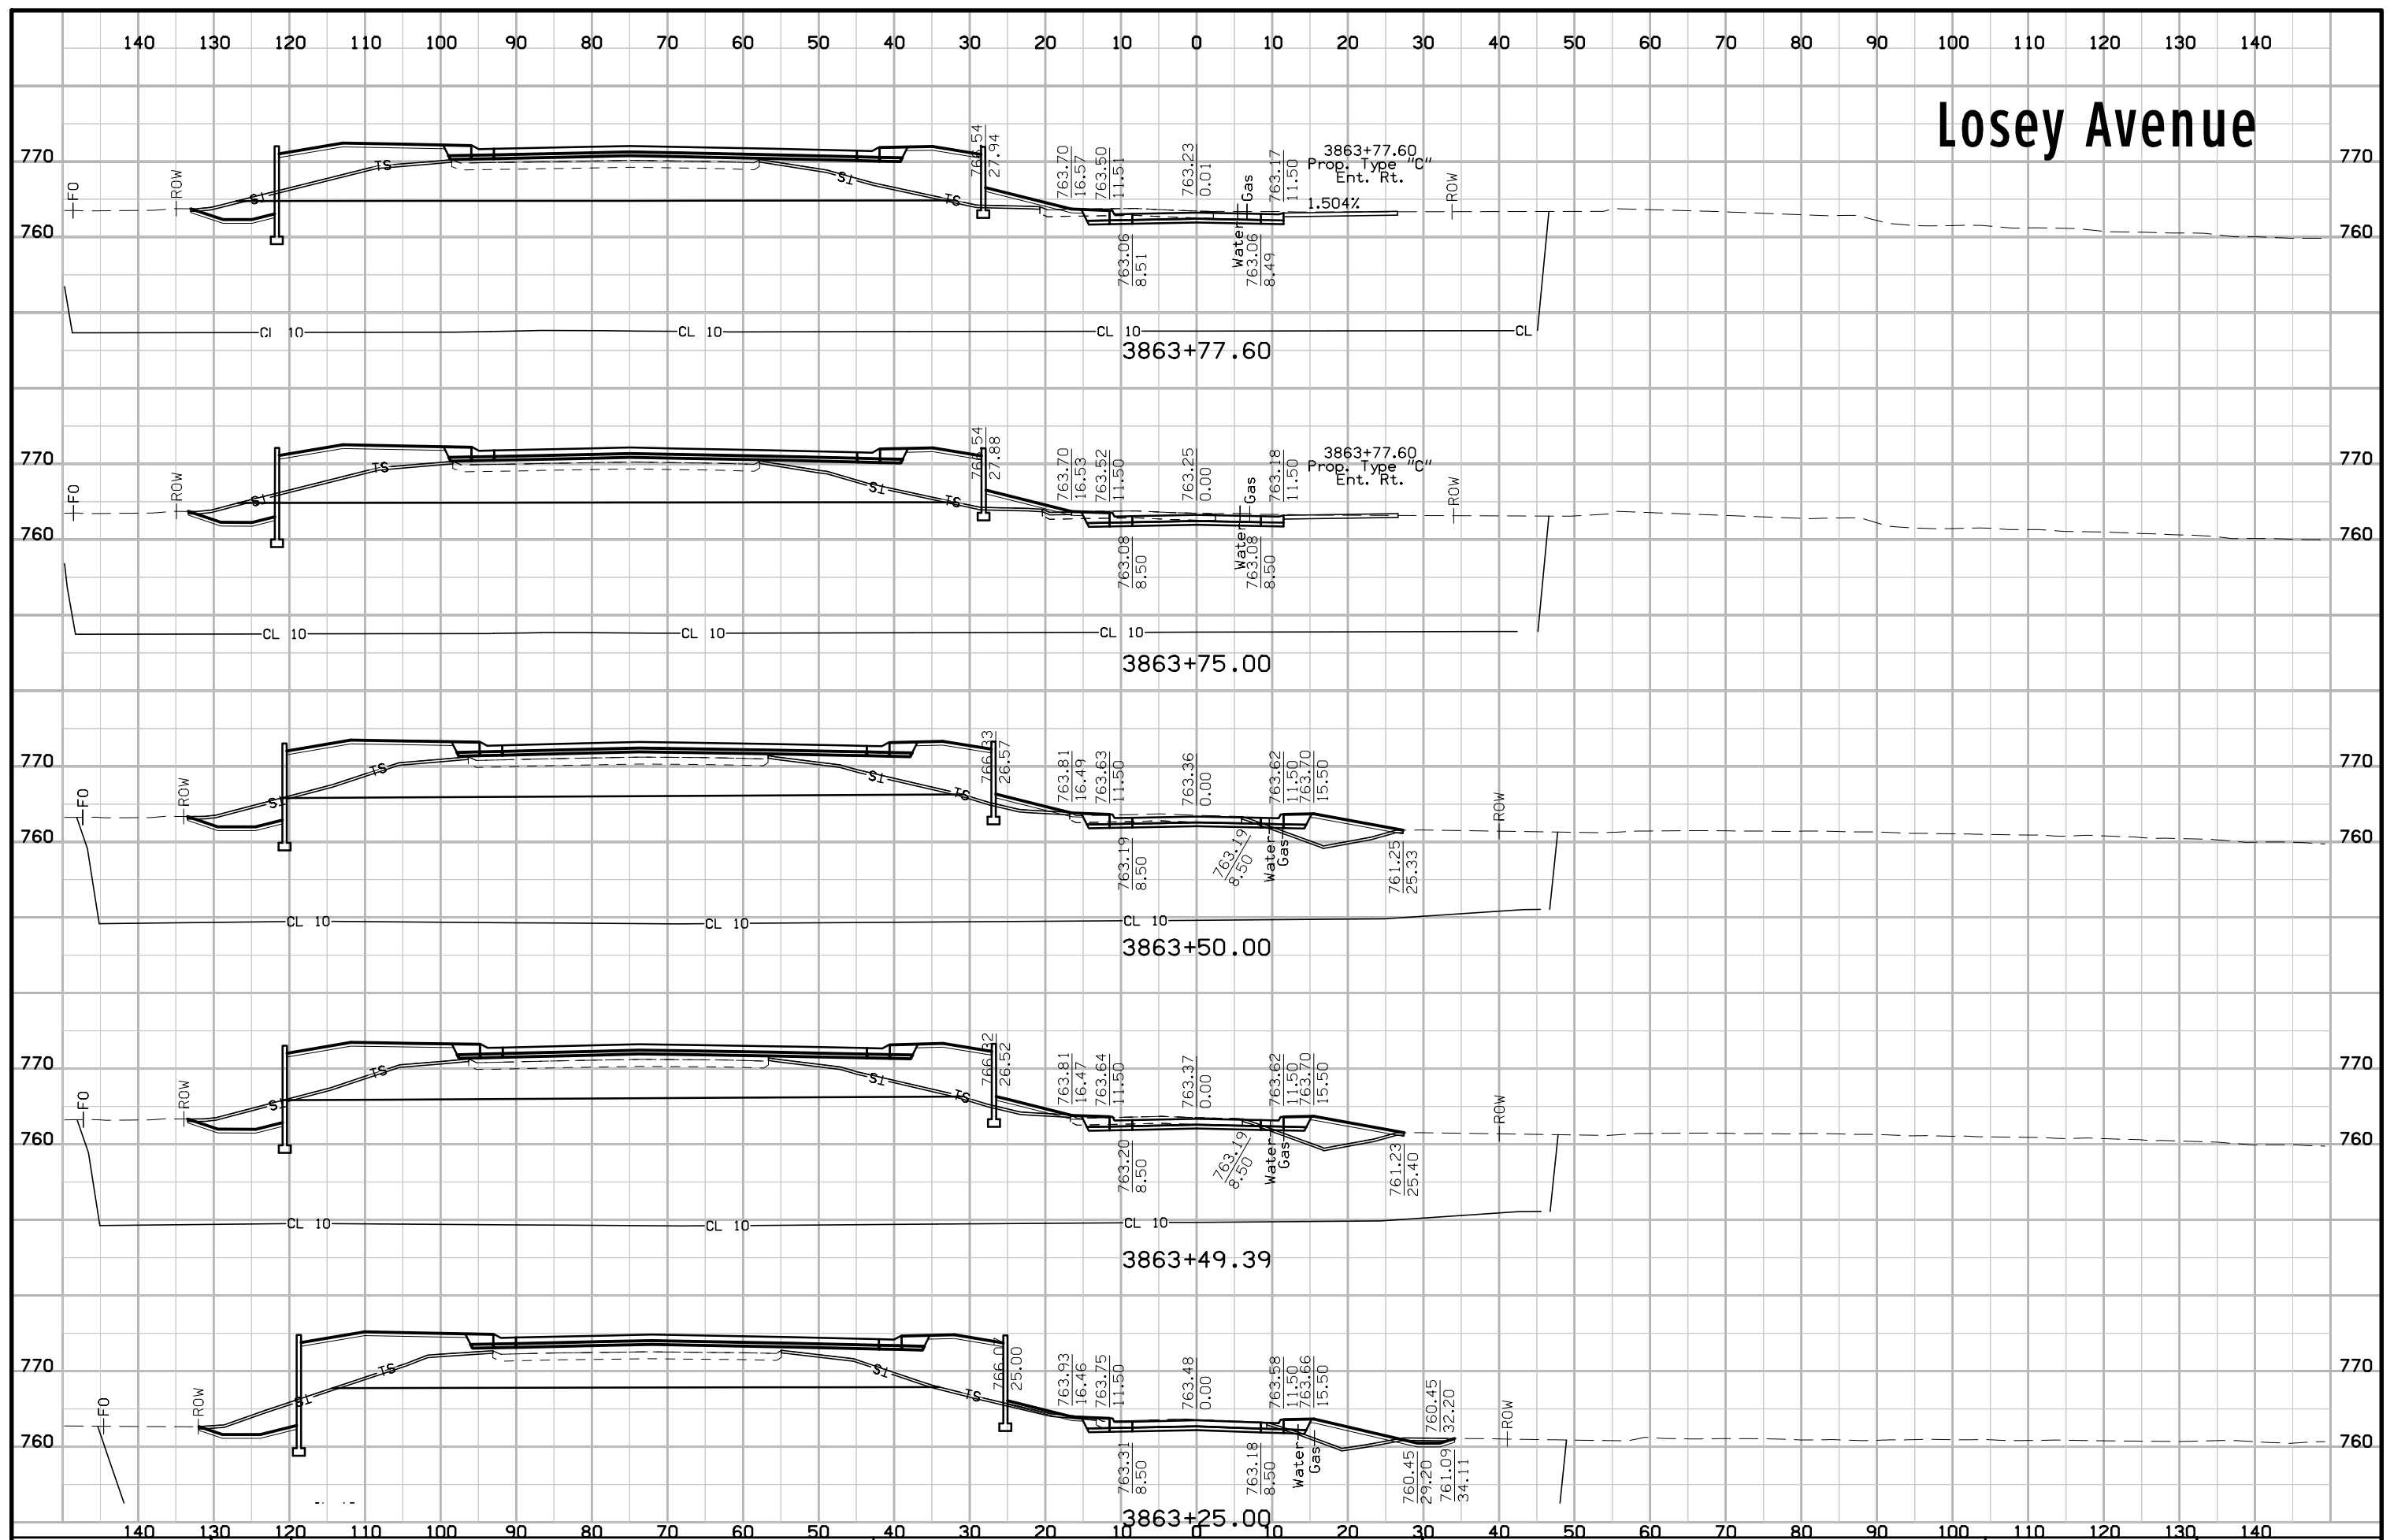


Losey Avenue

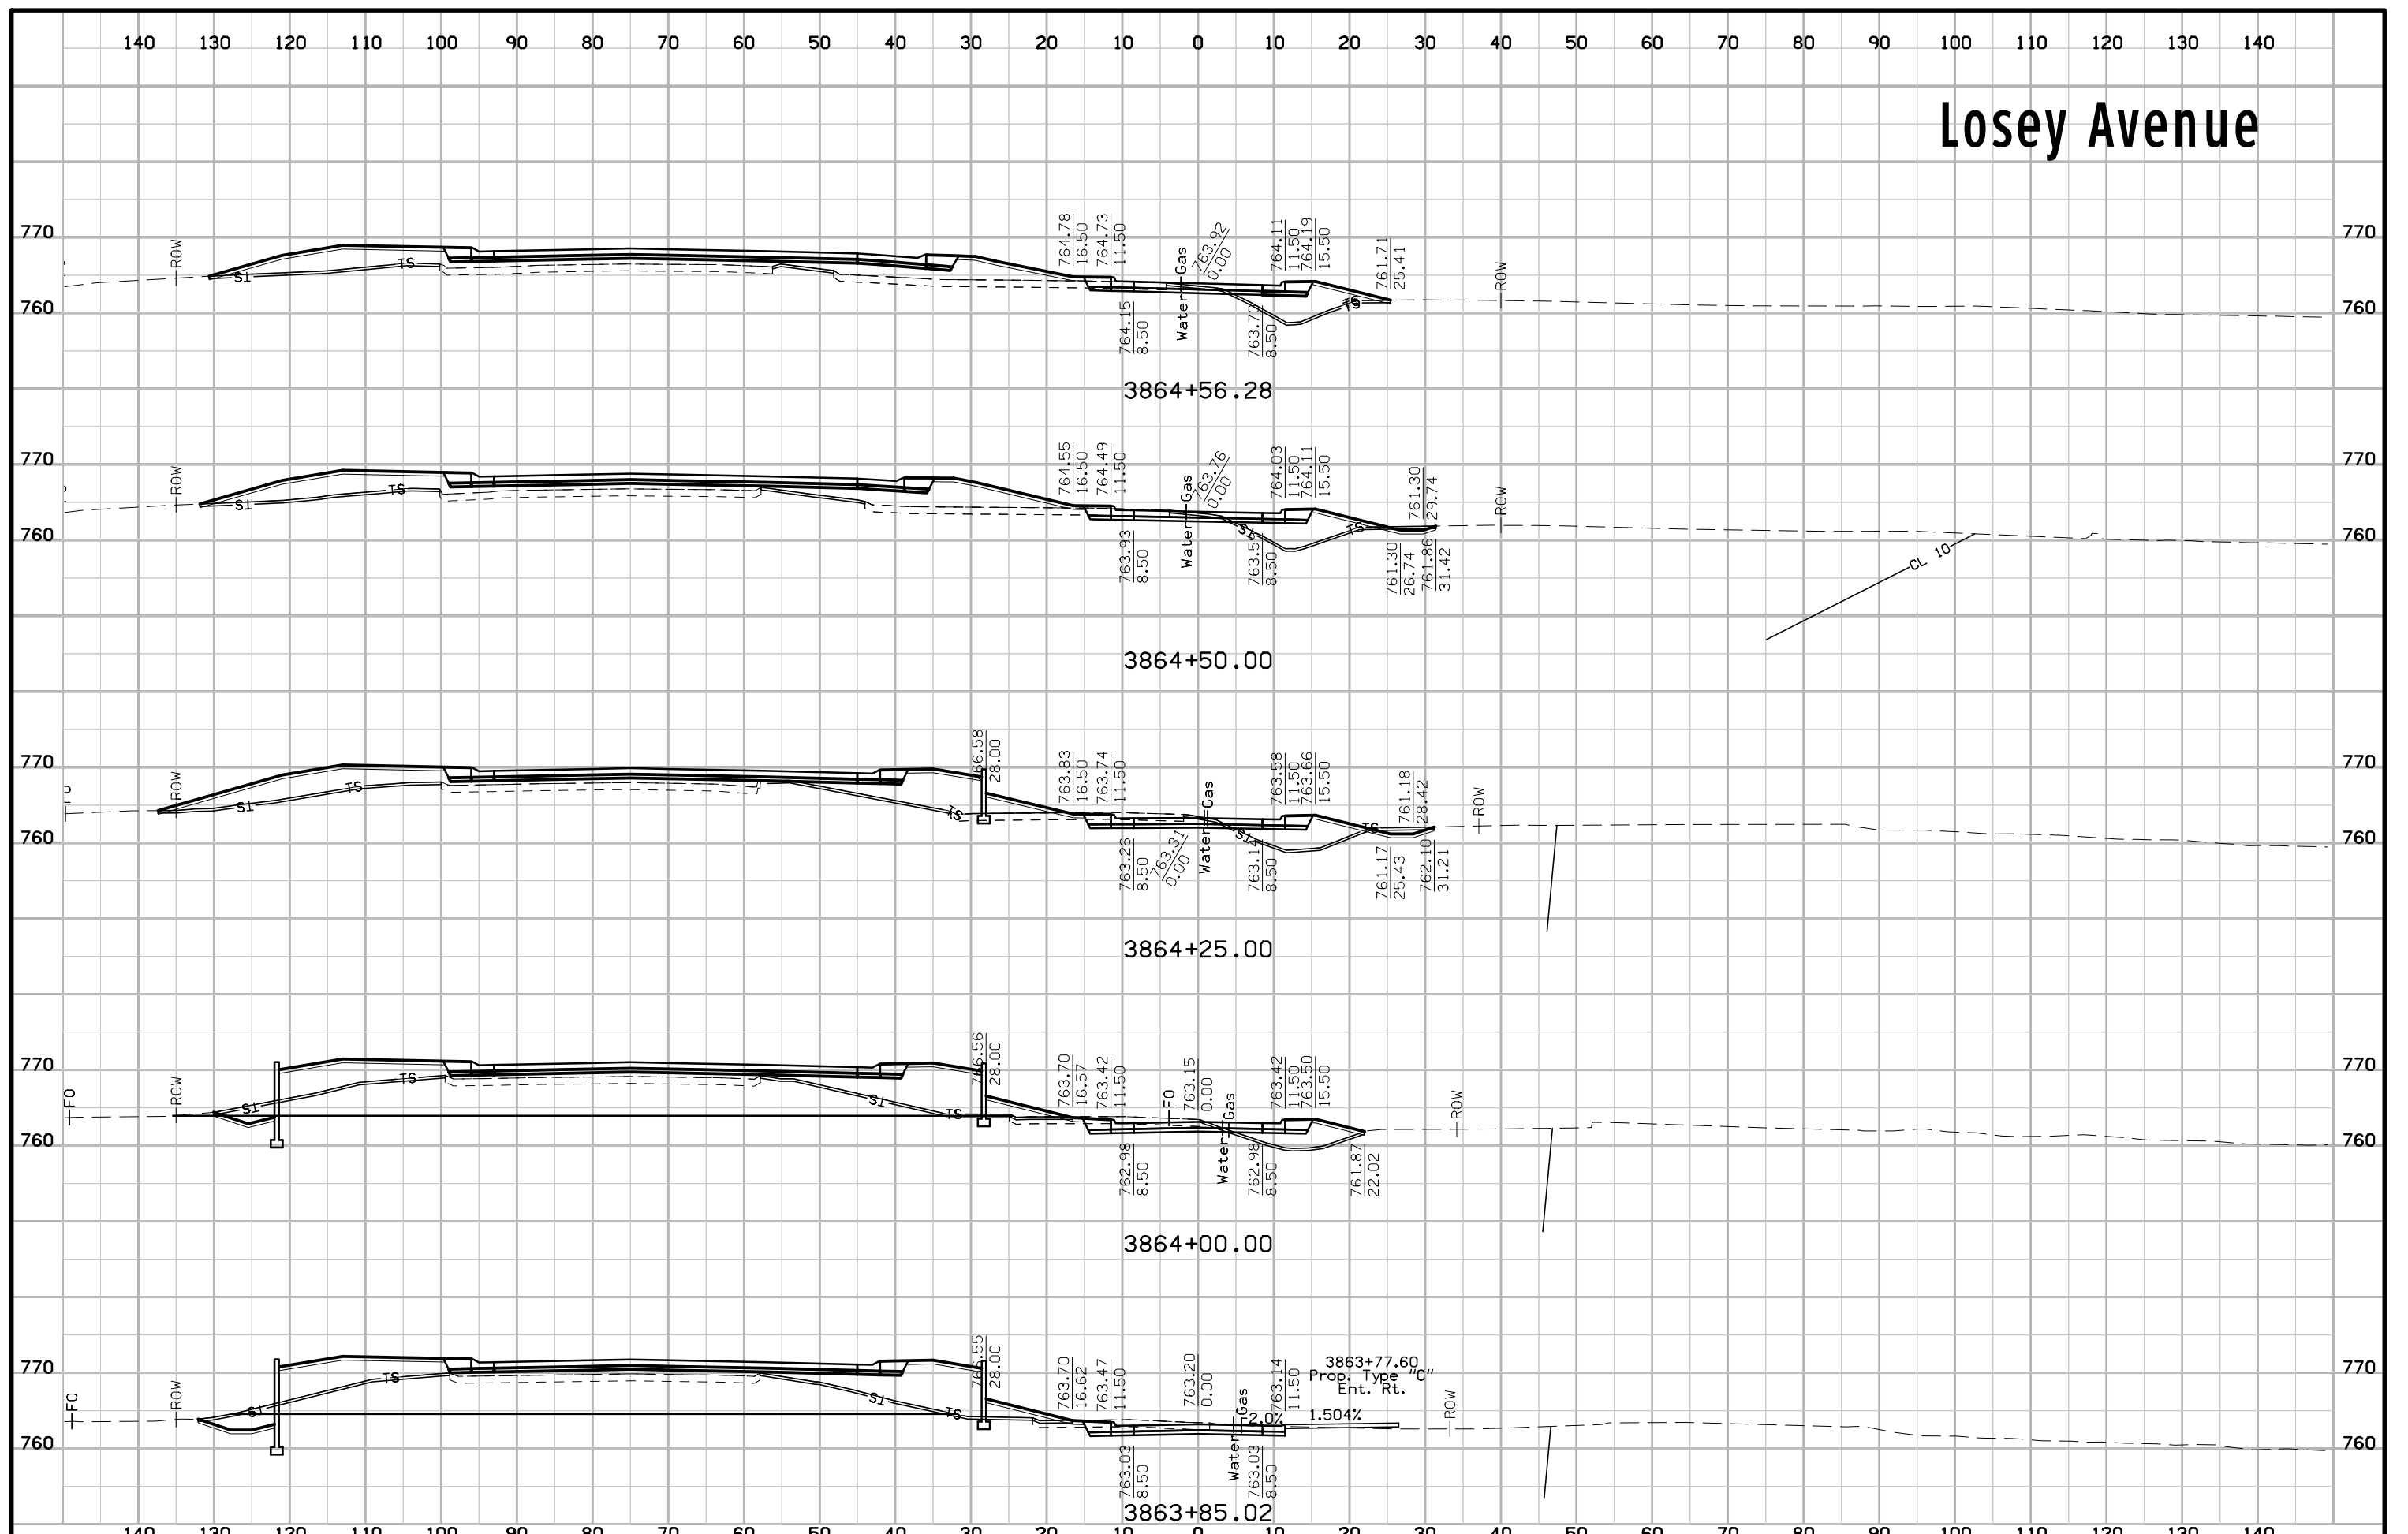


Losey Avenue

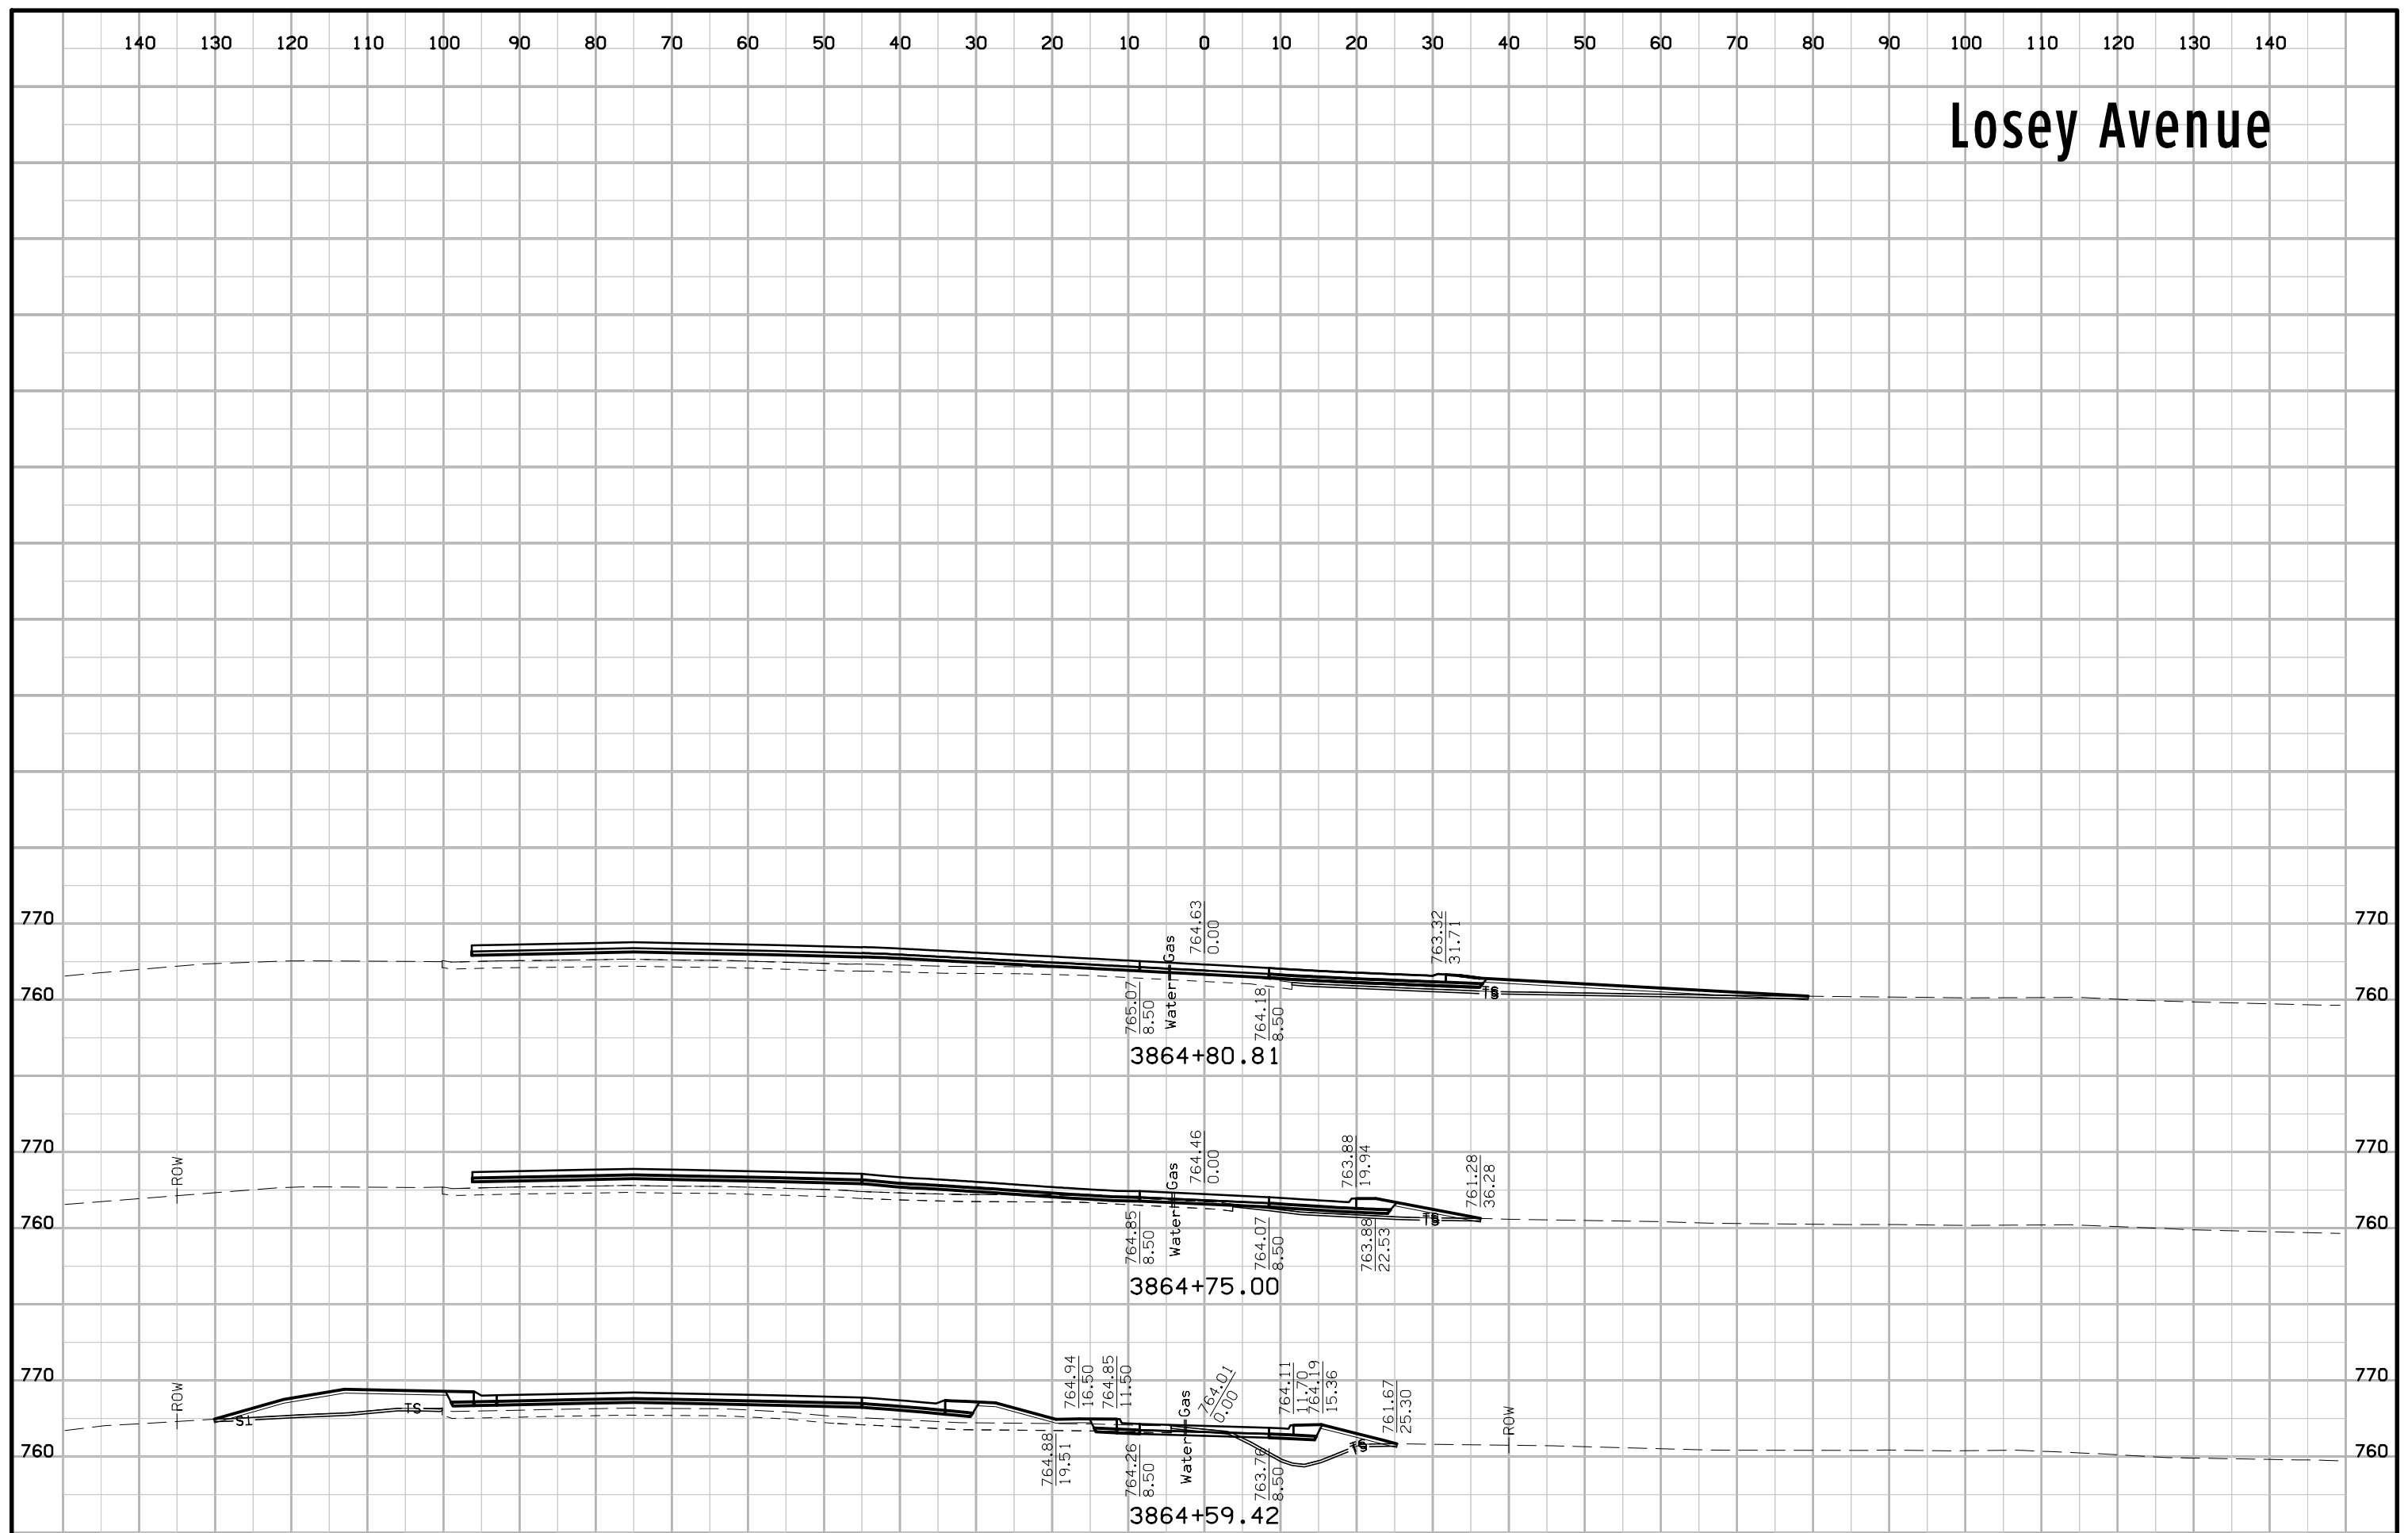



Stallman Drive

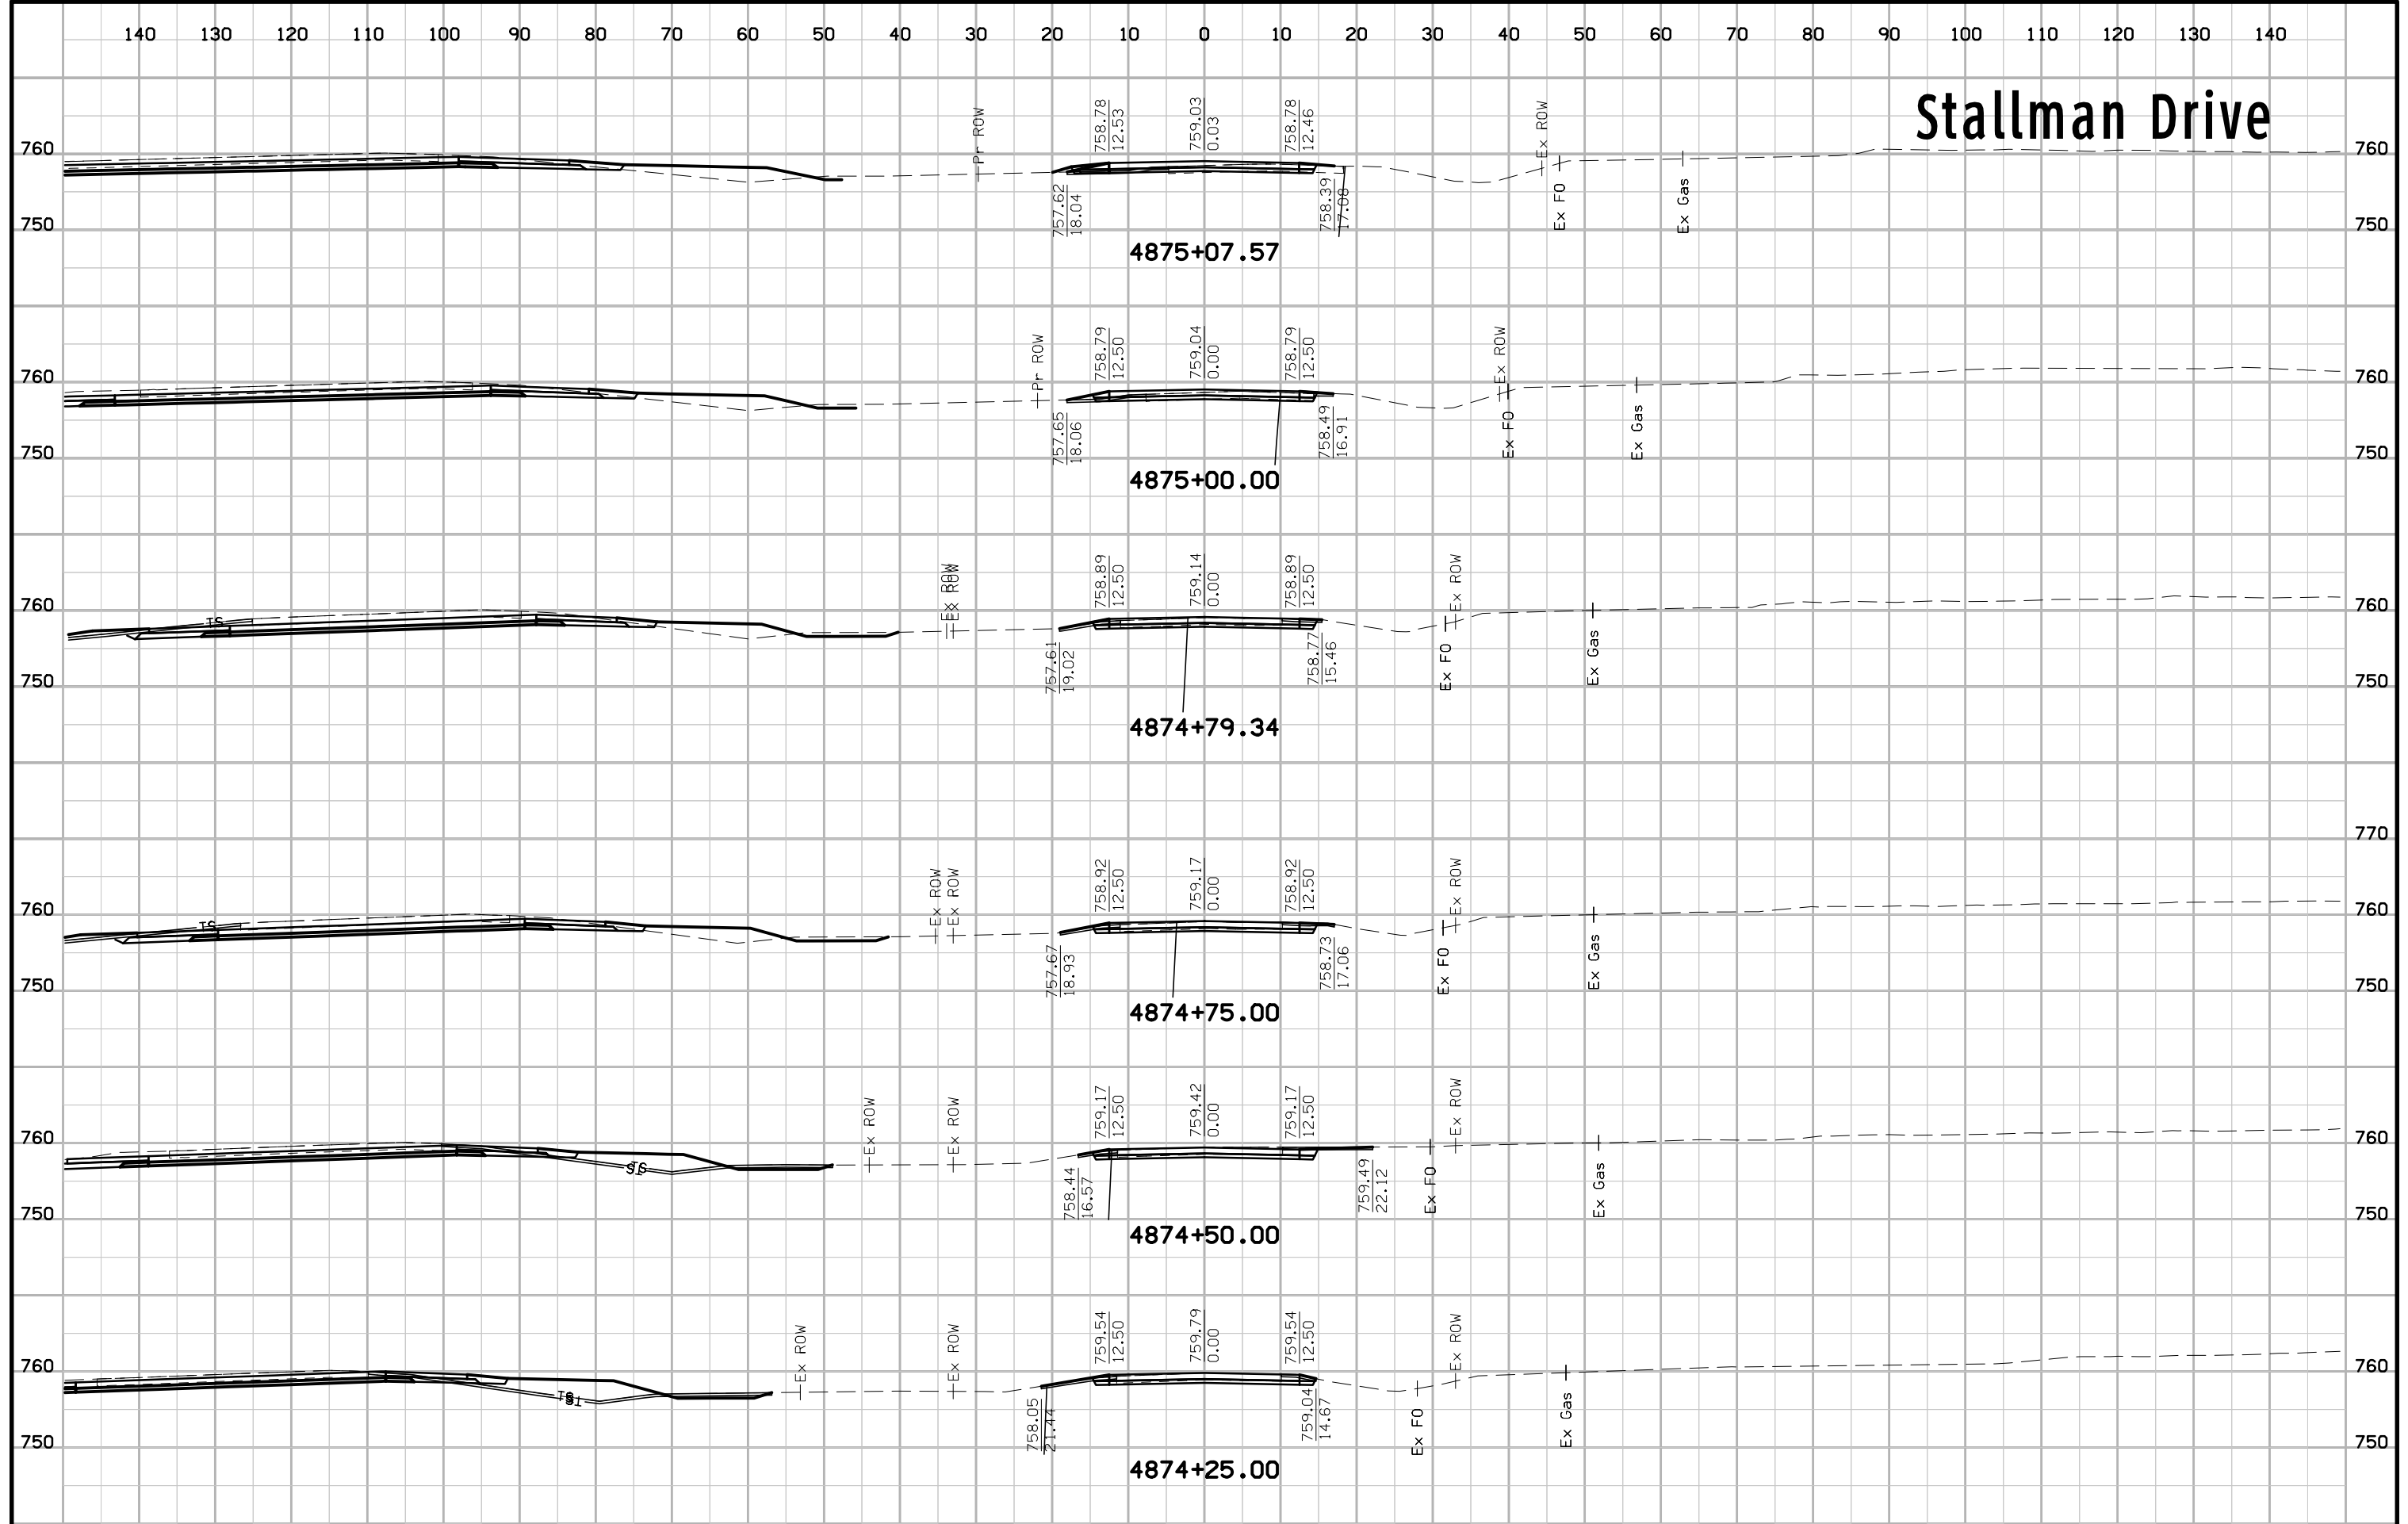


Stallman Drive

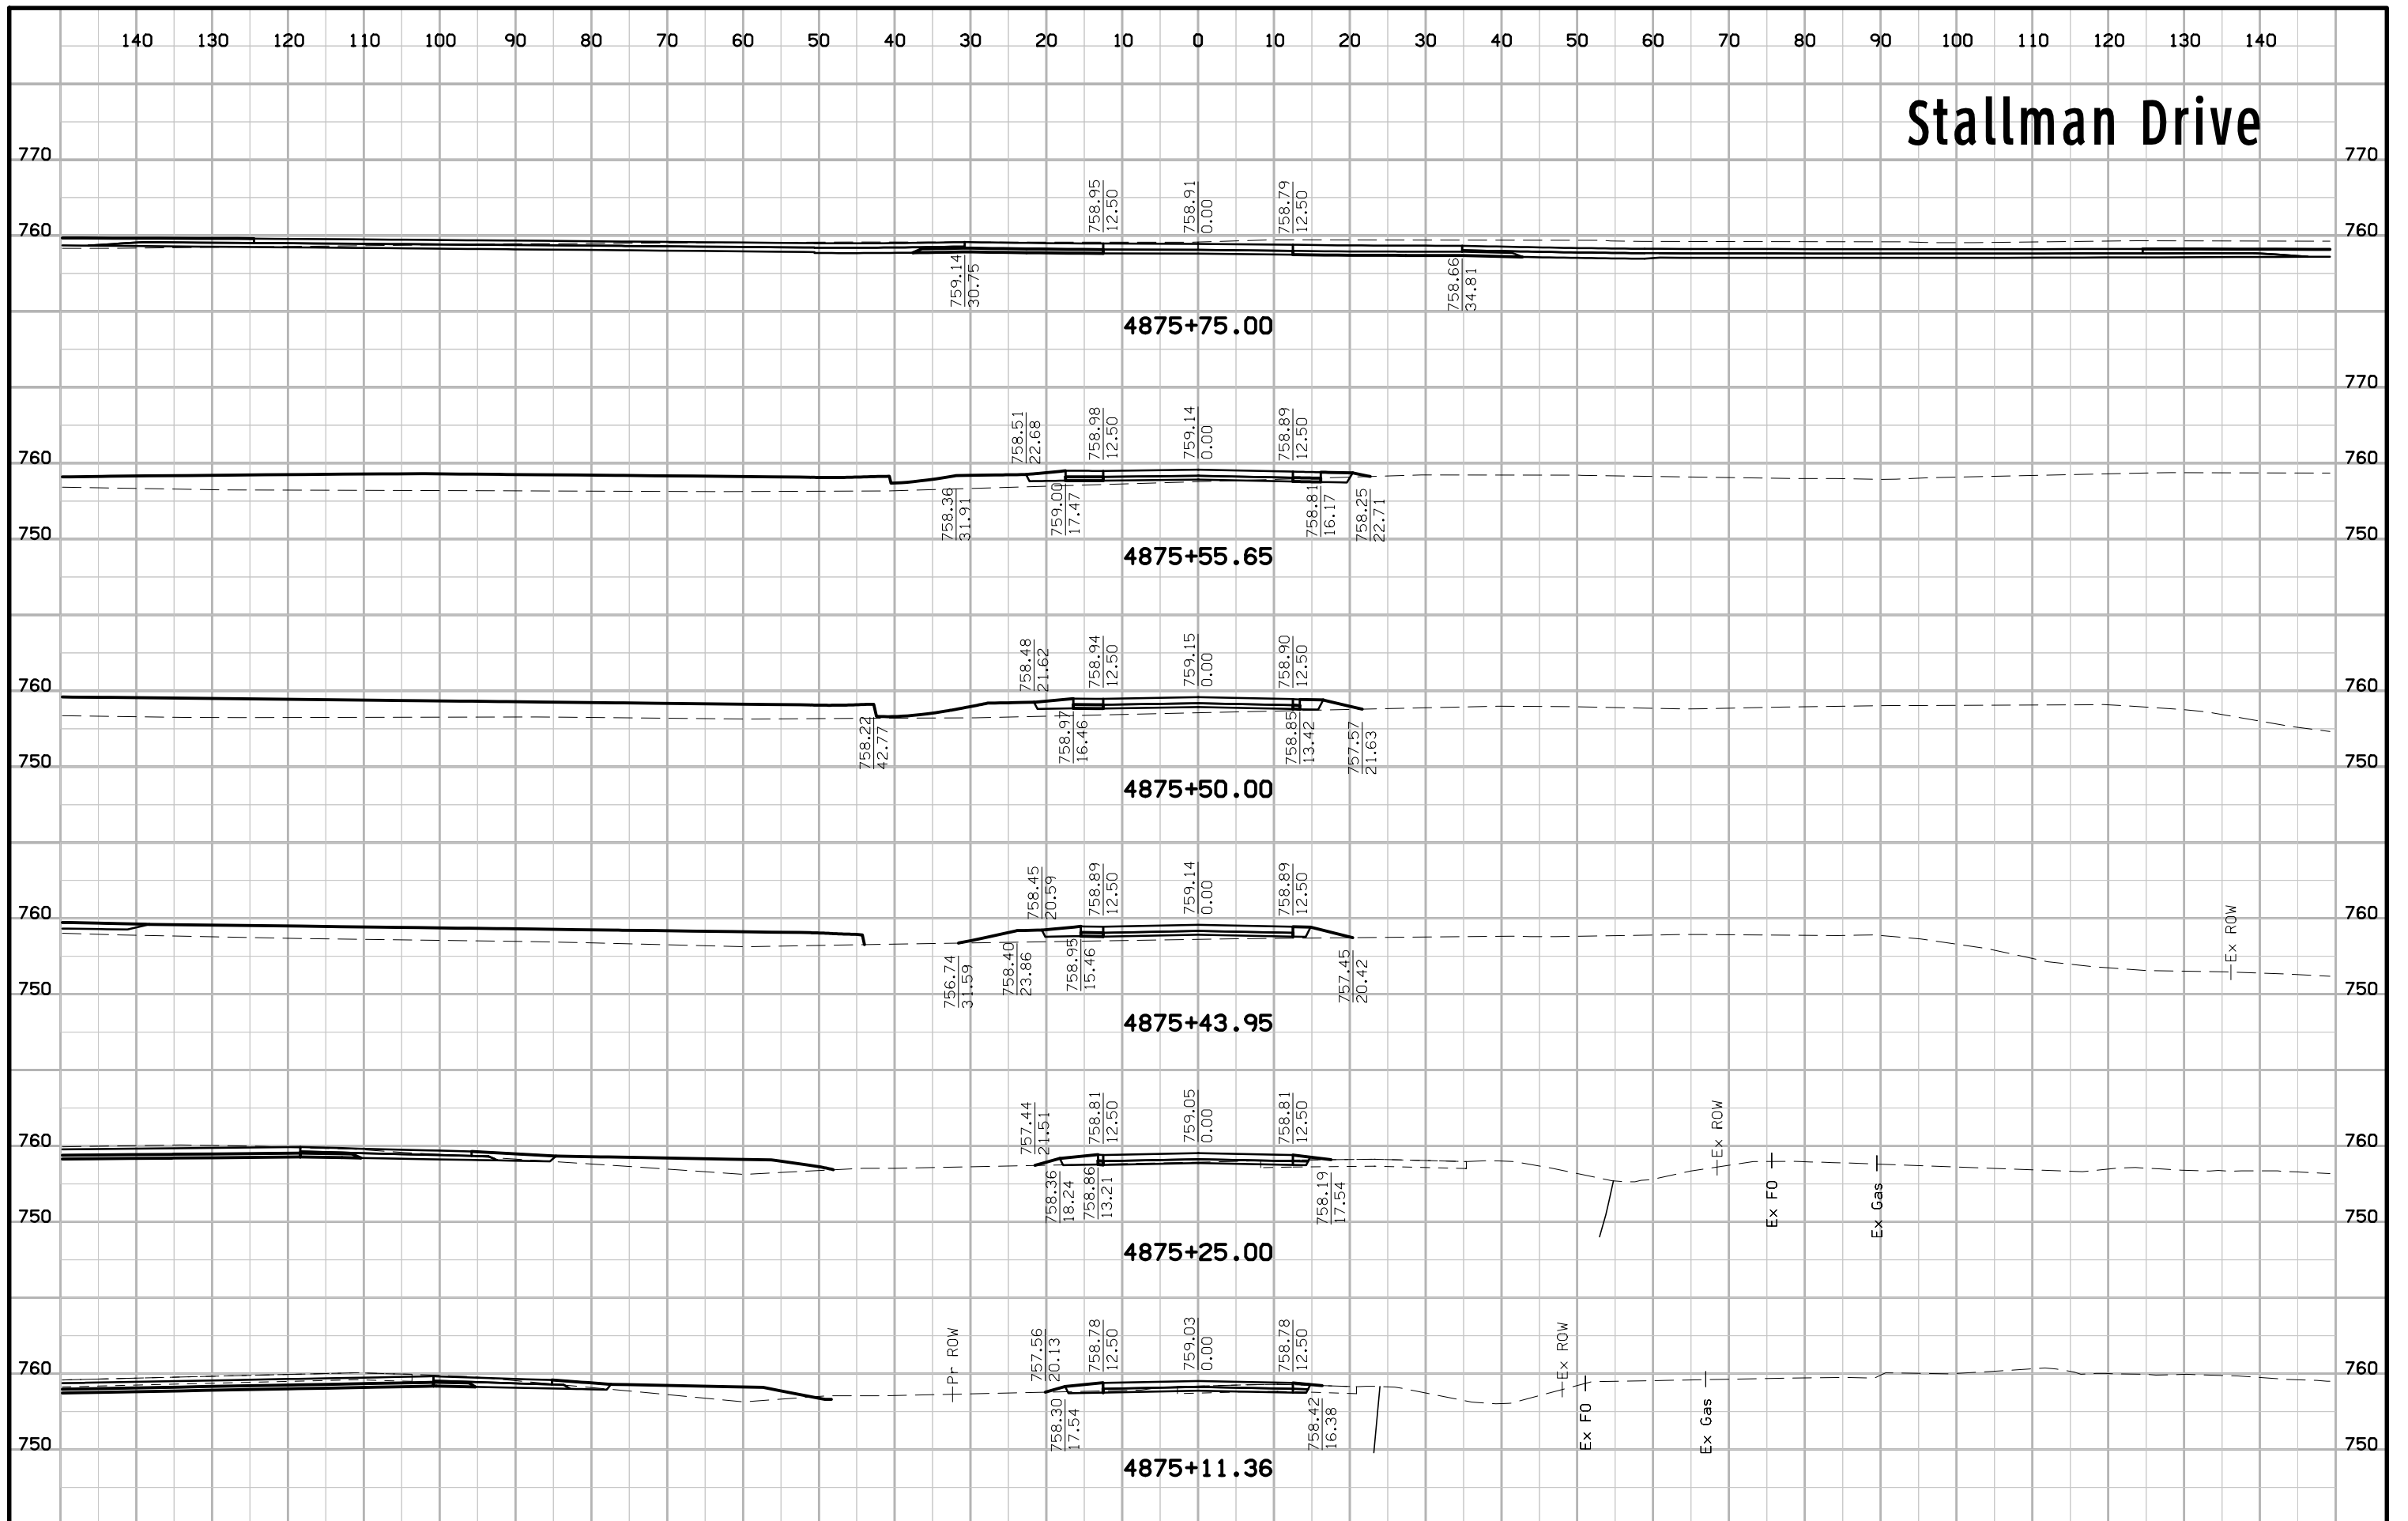

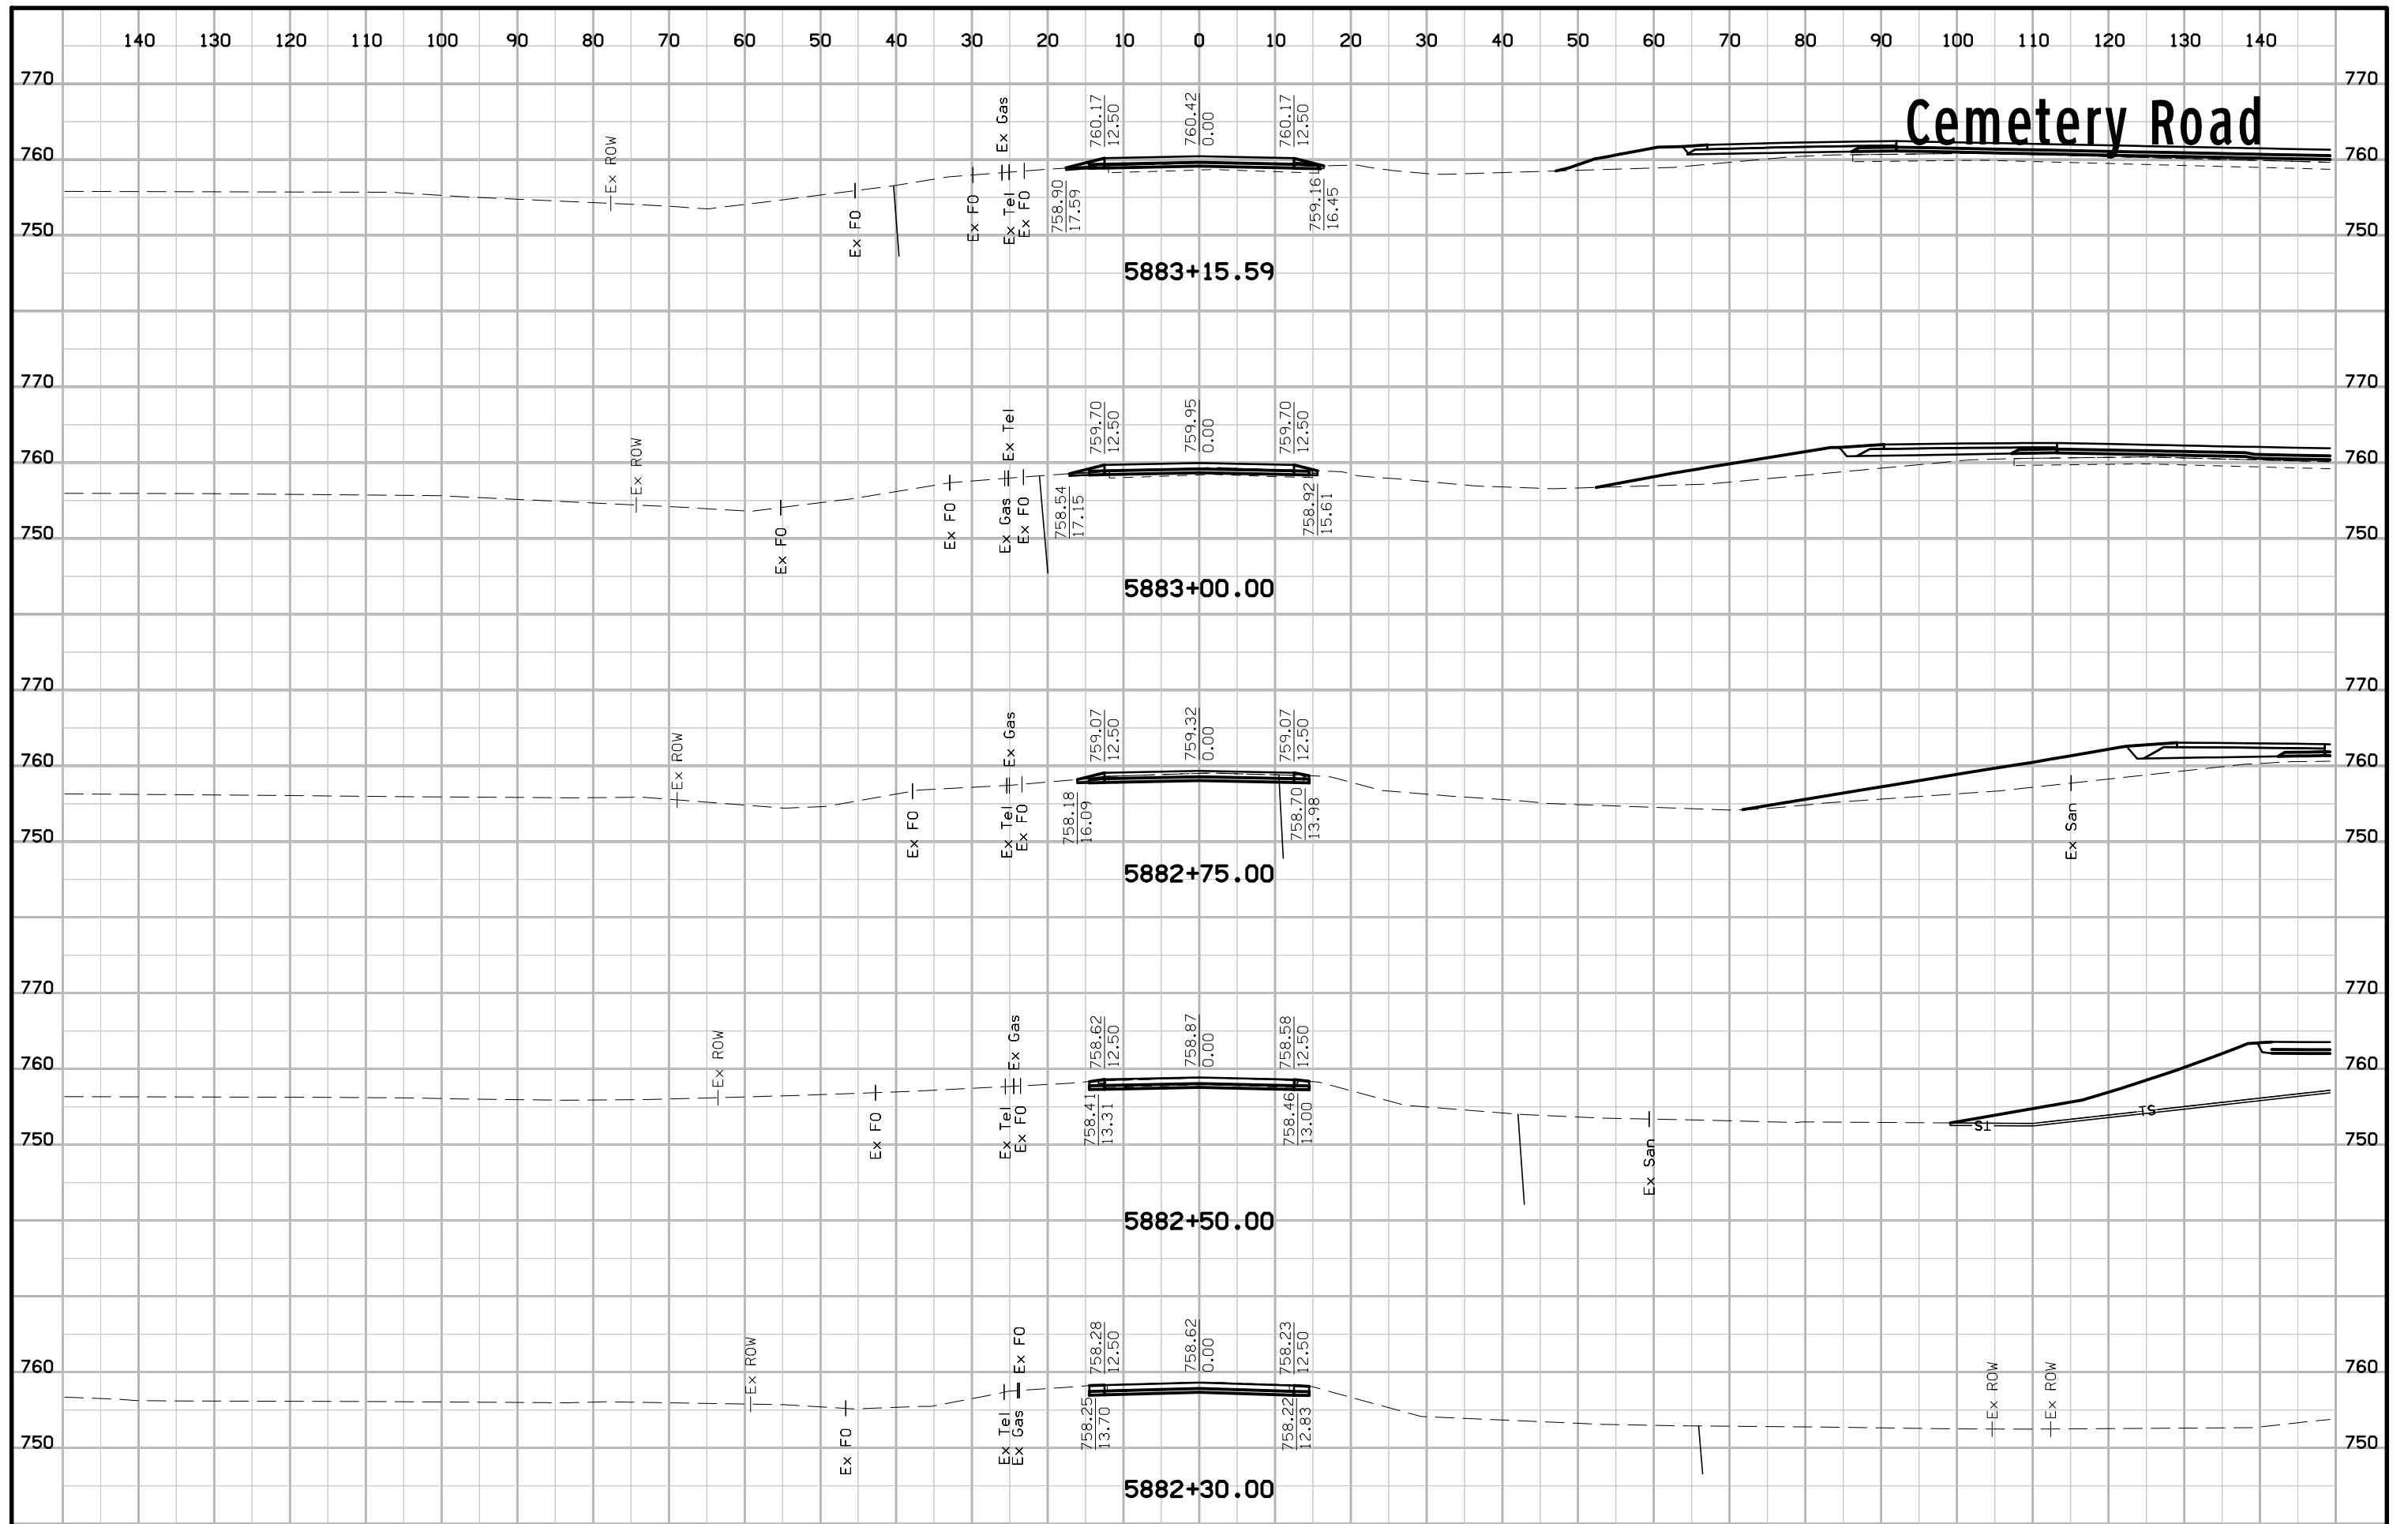

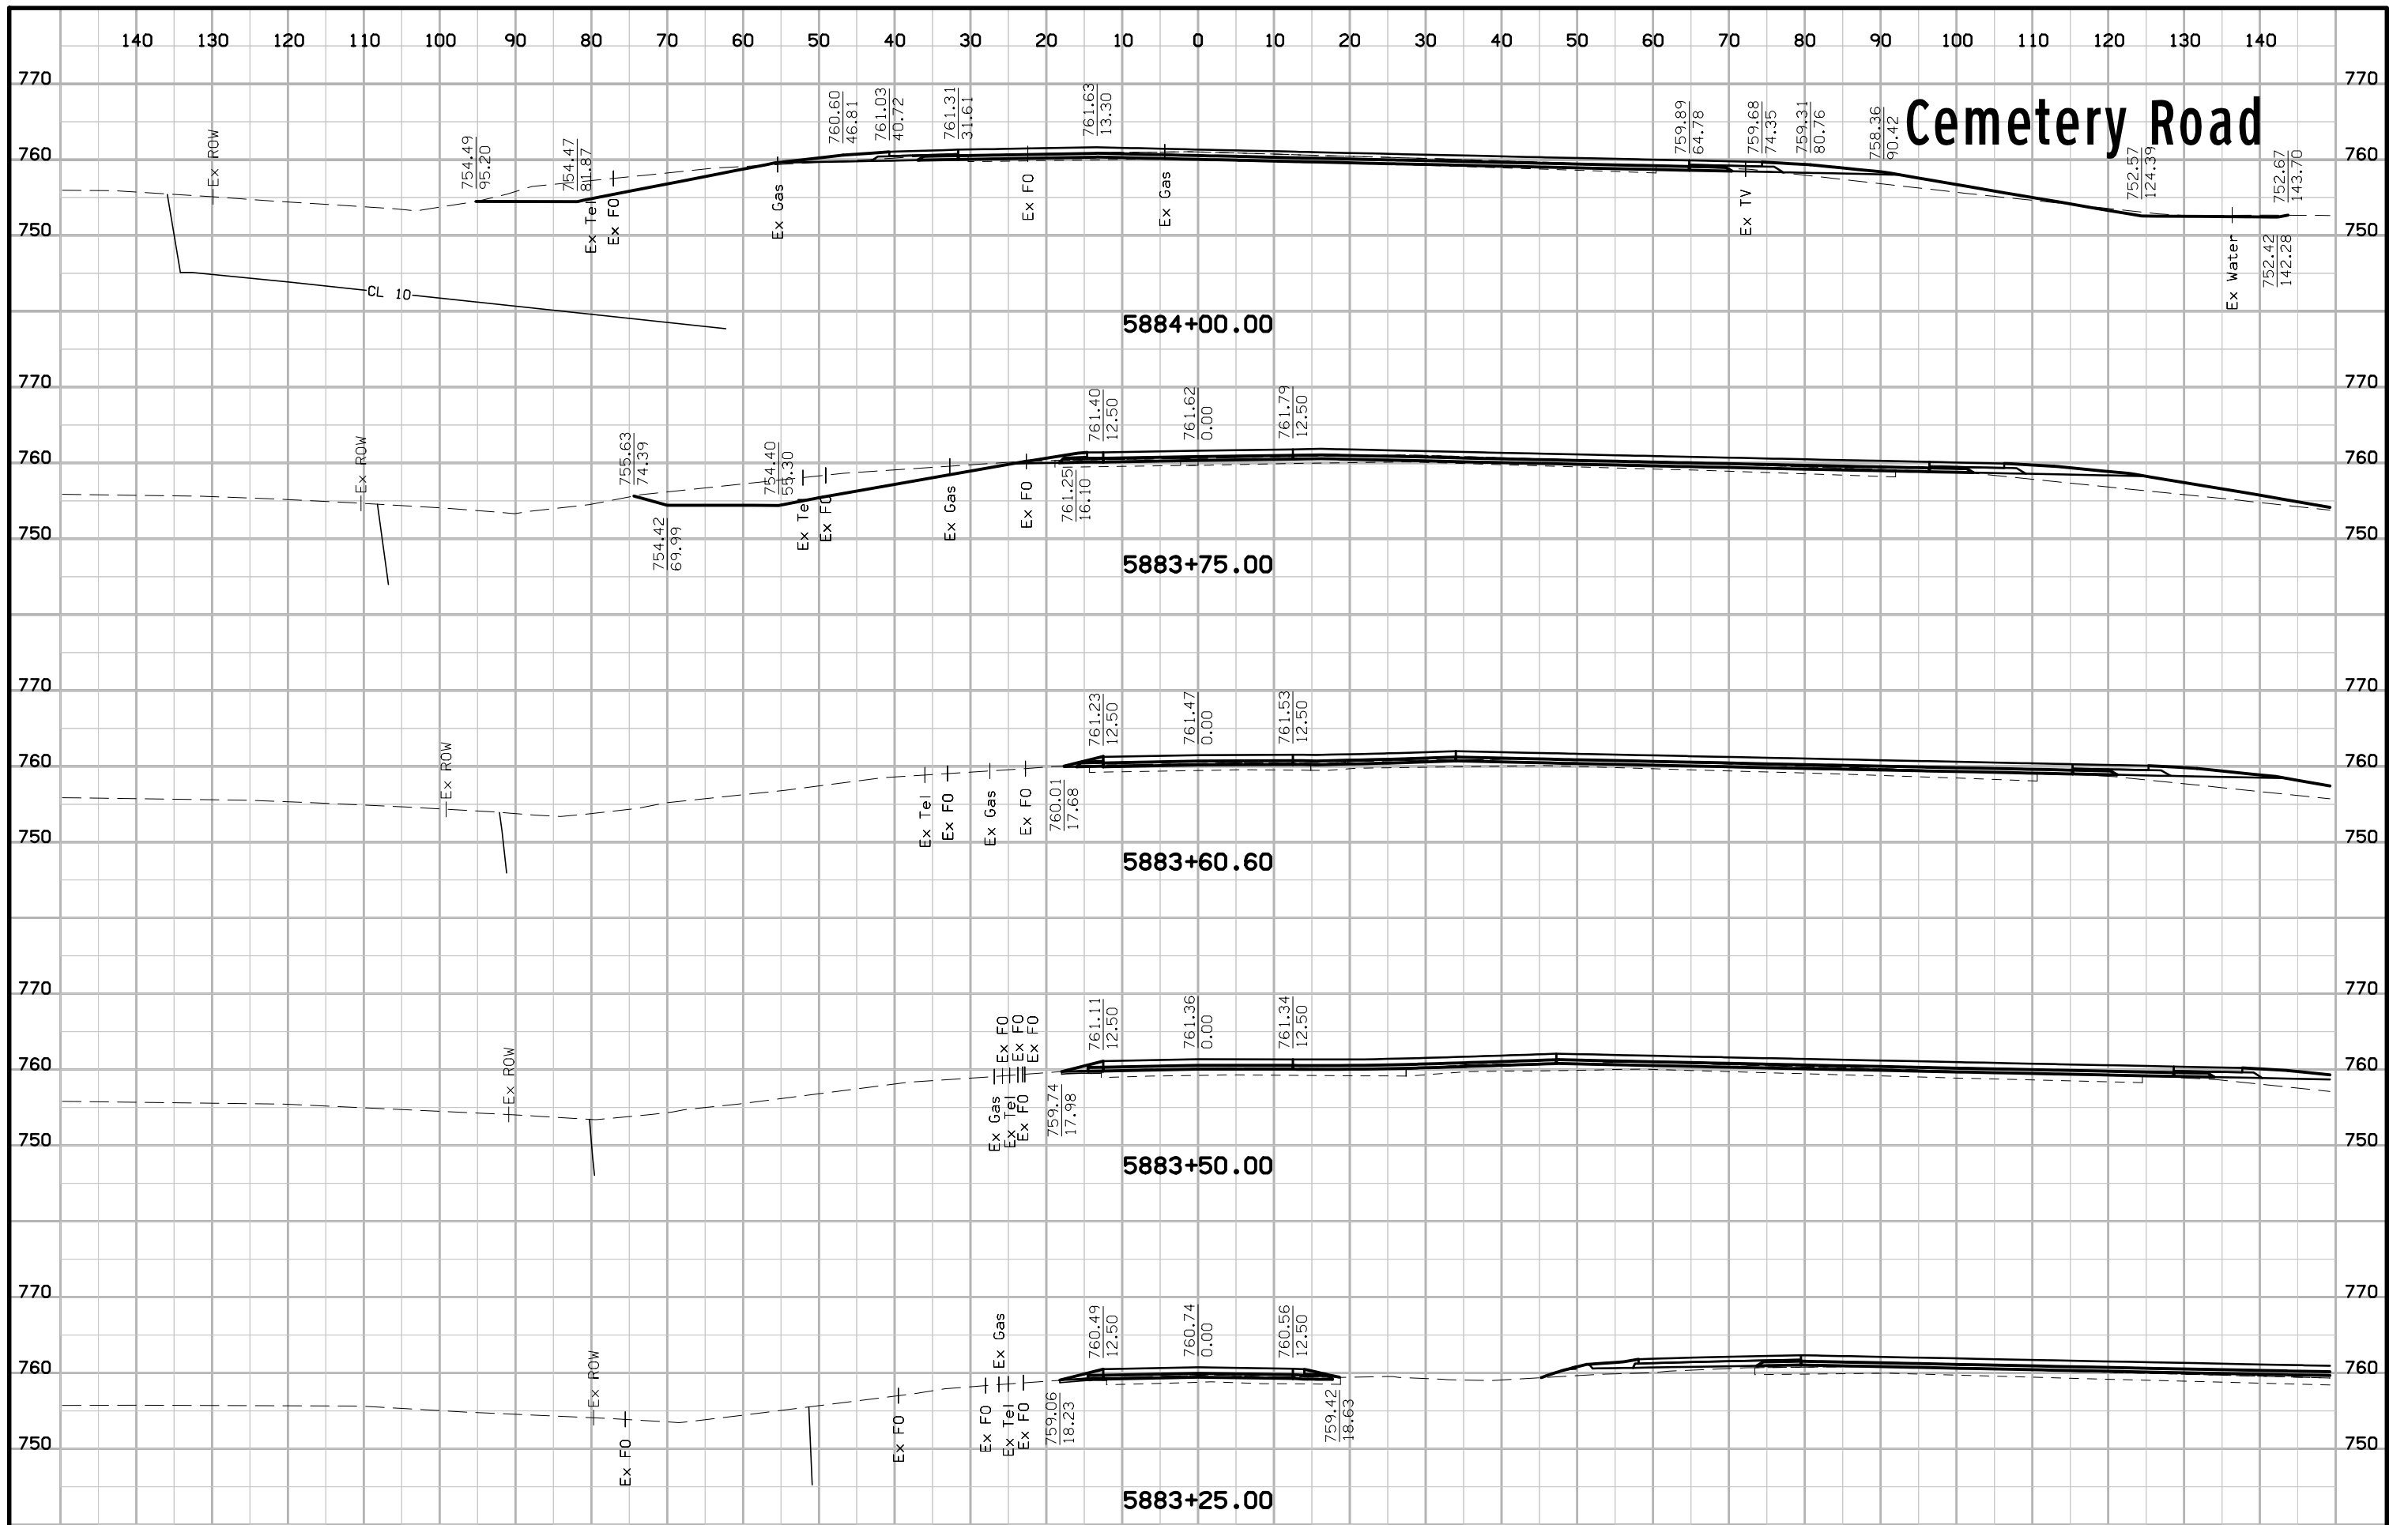

Cemetery Road

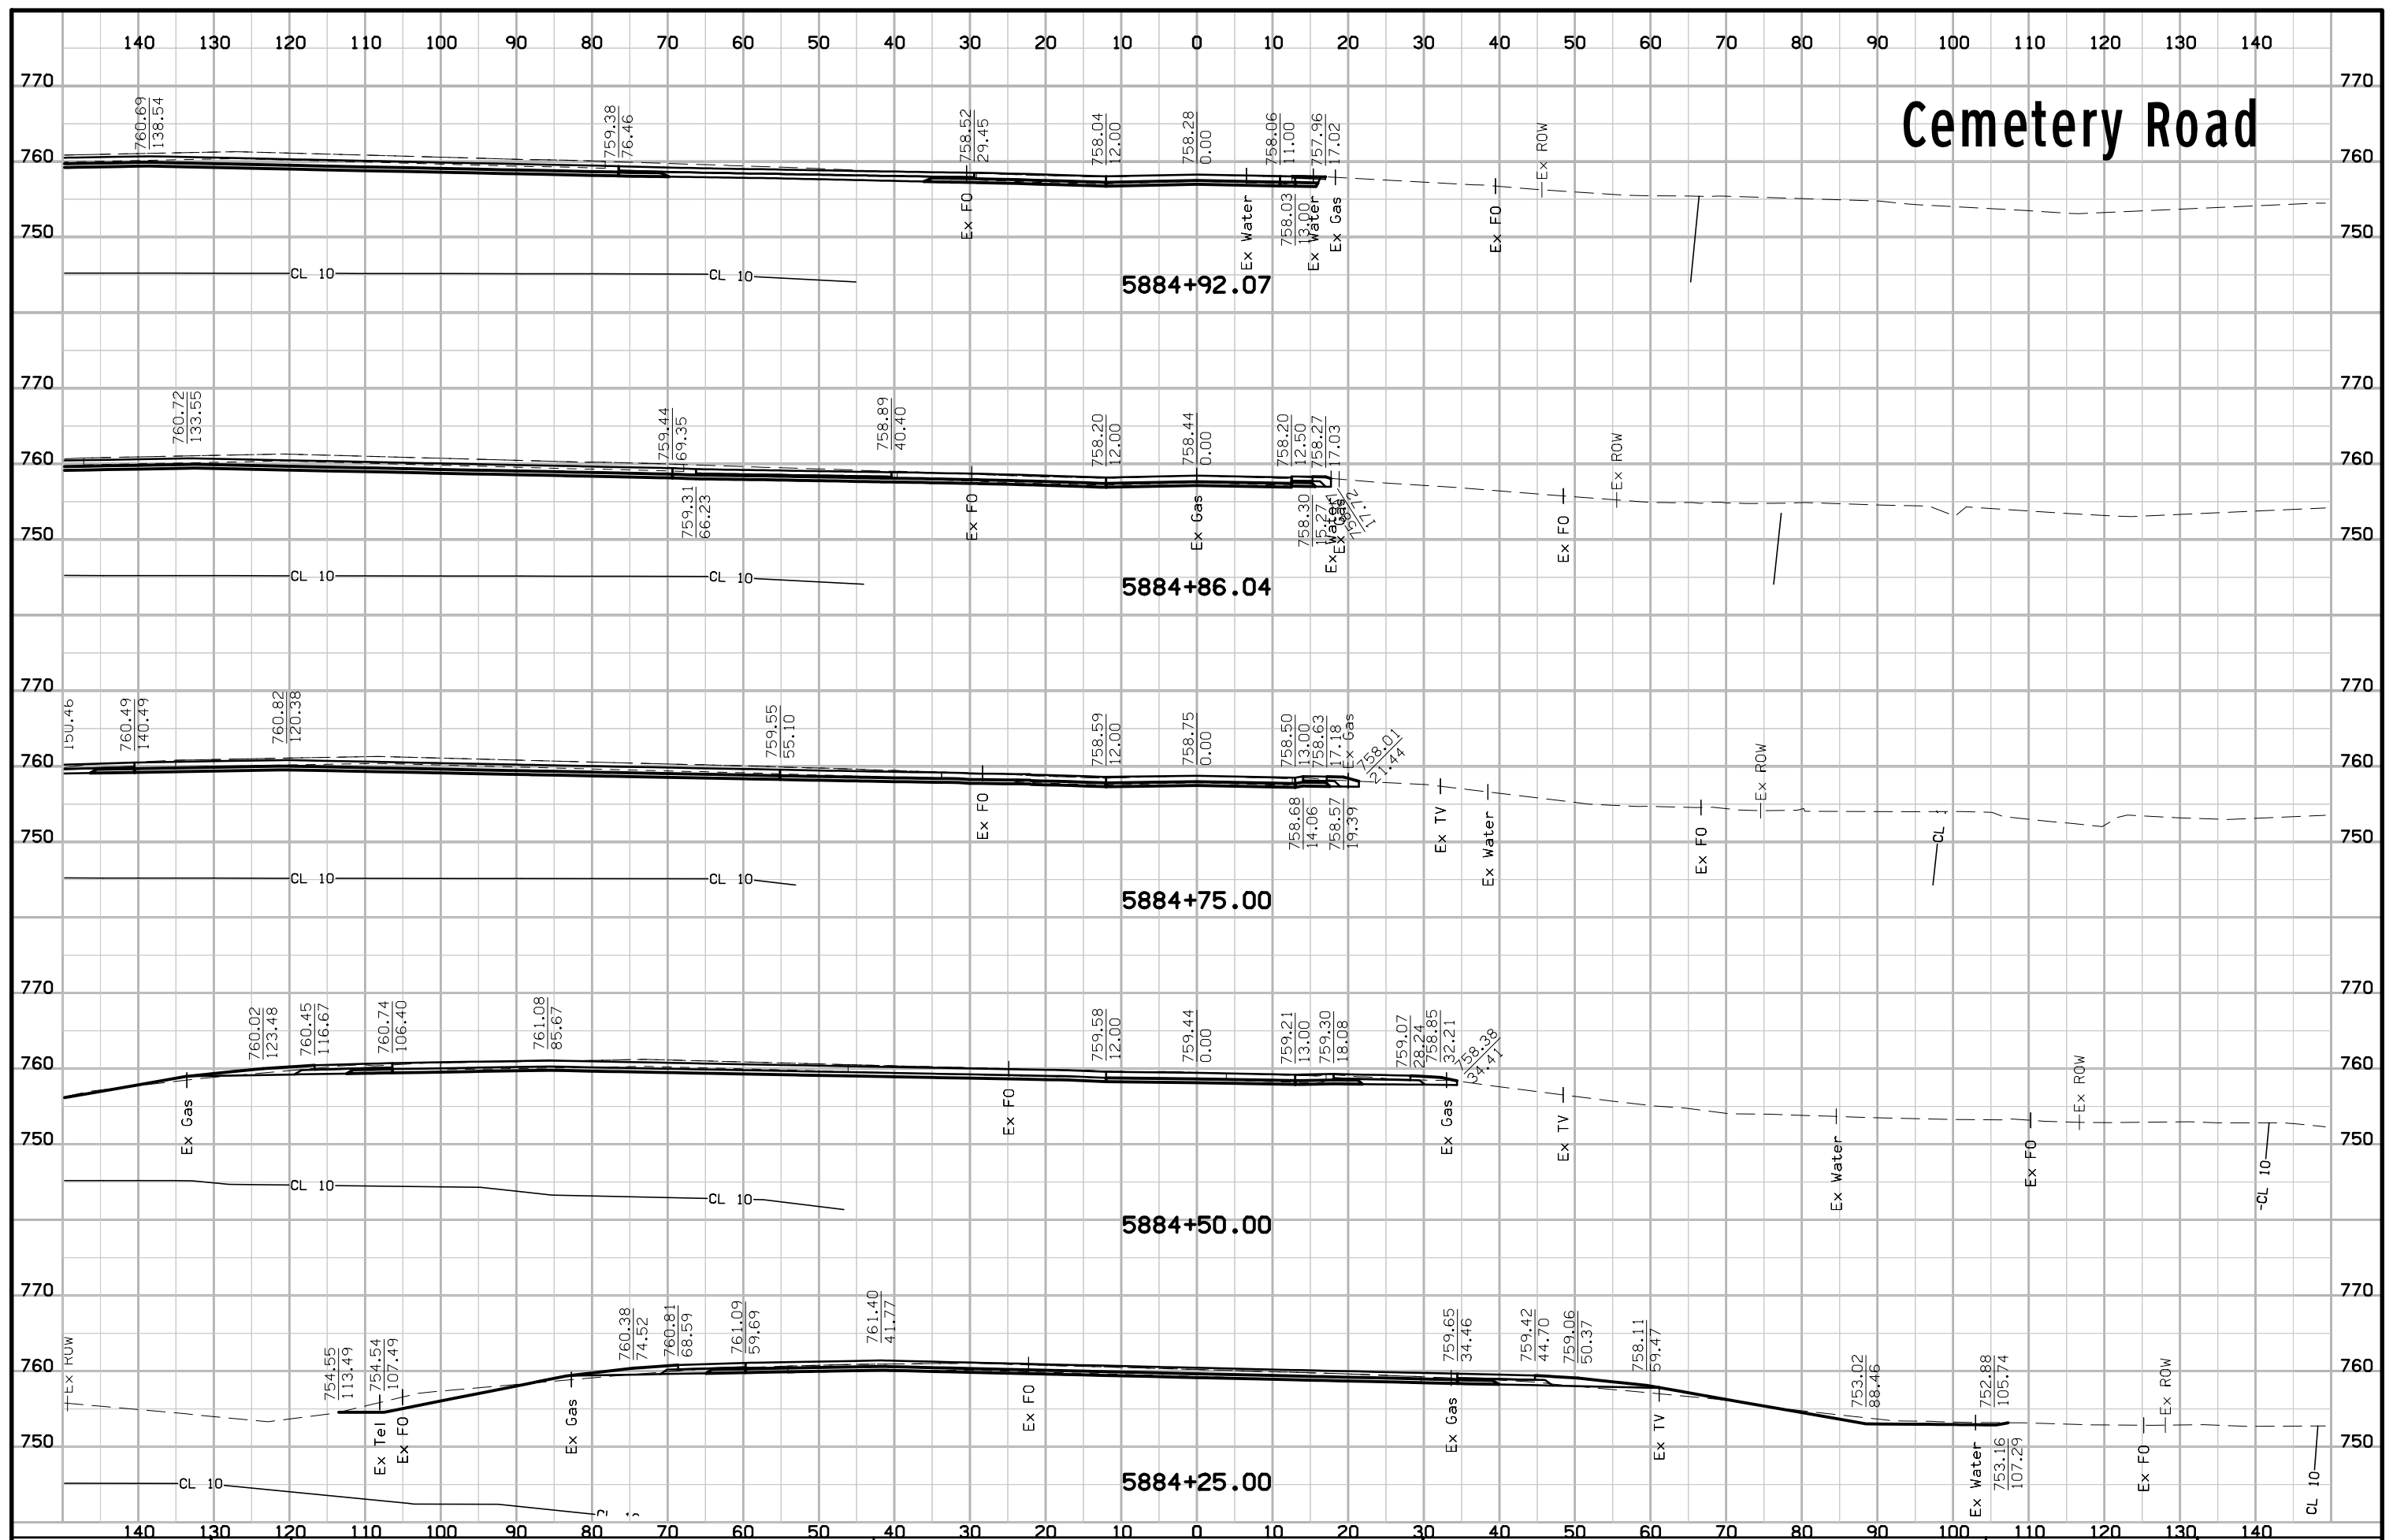

Cemetery Road

