

Revised

Form 520003wd (11-03)

I hereby certify that this project was constructed in accordance with the contract documents, the "as-built" plans were prepared under my supervision, and that I am a duly licensed Professional Engineer under the laws of the State of Iowa.

Robert L. Lentz
16297
Iowa

Robert L. Lentz 12-31-04
Project Engineer Date

My license renewal date is December 31, 2005

Year Contractor Project Inspector

TOTAL SHEETS	90
PROJECT NUMBER	NHS-151-4(63)--3H-53
R.O.W. PROJECT NUMBER	NHS-151-4(58)--19-53
PROJECT IDENTIFICATION NUMBER	94-53010-3

Iowa Department of Transportation
Project Development Division

PLANS OF PROPOSED IMPROVEMENT ON THE
PRIMARY ROAD SYSTEM
JONES COUNTY
Springville to Anamosa
On U.S. 151
from the Wapsipinicon River to N.E. of Anamosa

SCALES: As Noted

The Iowa Department of Transportation Metric Standard Specifications for Highway and Bridge Construction, series of 1995, plus current supplemental specifications and special provisions shall apply to construction work on this project.

Value Engineering Saves. Refer to Standard Notation 203-4 on Sheet C.03

INDEX OF SHEETS		105-3
		09-27-94
NO.	DESCRIPTION	
A.01-A.02	Title Sheet, Legend, and Access Control Sheet	
B.01-B.12	Typical Cross Sections	
C.01-C.16	Estimate of Quantities and General Information	
D.01-D.09	Plan and Profile Sheets - Mainline	
E.01-E.03	Plans and Profile Sheets - Sideroad	
F.01-F.02	Plan and Profile Sheets - Detour	
G.01-G.08	Reference Ties and Bench Marks	
J.01-J.07	Staging and Traffic Control Sheets	
K.01-K.11	Interchange Geometric Staking, Jointing and Edge Profiles	
L.01-L.04	Intersection Geometric Staking, Jointing and Edge Profiles	
T.01-T.05	Tabulation of Earthwork	
U.01-U.04	Standards and Special Detail	
V.01-V.07	Culvert Situation Plans	


PROJECT LENGTH SUMMARY				105-1
				09-27-94
DIV.	LOCATION	m	km	
ROADWAY	Sta. 135+32.717 to Sta. 187+25.000	5,192.283	5.192	
BRIDGES	Sta. 157+59.890 to Sta. 158+08.140	-48.250	-0.048	
TOTAL LENGTH OF PROJECT		5,144.033	5.144	

METRIC STANDARD ROAD PLANS								105-4
								09-27-94
The following Standard Road Plans shall be considered applicable to construction work on this project.								
NUMBER	DATE	NUMBER	DATE	NUMBER	DATE	NUMBER	DATE	
RA-40	03-26-96	RF-14	04-28-98	RL-2A	01-12-99	RS-64B	04-30-96	
RA-55	03-26-96	RF-19B	12-13-94	RL-4	9-21-99			
RB-6	04-27-99	RF-19C	9-21-99	RL-6	12-13-94			
RC-7	10-28-97	RF-19E	9-21-99	RL-7	12-13-94			
RC-8	04-27-99	RF-19F	12-13-94	RL-9	12-08-95			
RC-9	04-27-99	RF-26	06-06-95	RL-12	06-06-95			
RC-10	04-27-99	RF-30A	03-28-95	RL-13	12-13-94			
RC-11	04-27-99	RF-30B	01-12-99	RL-14	01-12-99			
RC-16A	10-27-98	RF-31	10-28-97	RM-33	09-21-99			
RC-16B	09-21-99	RH-19	09-27-94	RP-1	04-28-98			
RE-3A	07-15-99	RH-37D	01-12-99	RP-2	04-28-98			
RE-7	10-28-97	RH-41B	01-12-99	RP-3	04-28-98			
RF-1	03-28-95	RH-50	04-27-99	RS-2	10-27-98			
RF-2	06-06-95	RH-51	04-27-99	RS-8	9-21-99			
RF-3	01-12-99	RH-52	03-26-96	RS-15	9-21-99			
RF-5	10-31-95	RH-53	01-12-99	RS-16	10-28-97			
RF-7	06-06-95	RL-1A	07-15-97	RS-26A	10-28-97			
RF-13	10-28-97	RL-1B	10-28-97	RS-64A	04-30-96			

INDEX OF SEALS		
SHEET NO.	NAME	TYPE
A.01	ROBERT L. LENTZ	Primary Signature Block
C.06	ROBERT L. STANLEY	Geotechnical Design
E.01	WILLIAM OTTESEN	Side Road Design
A.03	ROBERT L. LENTZ	REVISION SHEET

DESIGN DATA RURAL		
10-27-98	101-4	
2001 AADT	6,640	V.P.D.
2021 AADT	7,950	V.P.D.
2021 DHV	850	V.P.H.
TRUCKS	11 %	
Total Design ESALs		

REVISIONS
REVISED FEBRUARY 14, 2000
SEE TABULATION OF REVISIONS, SHEET A.03

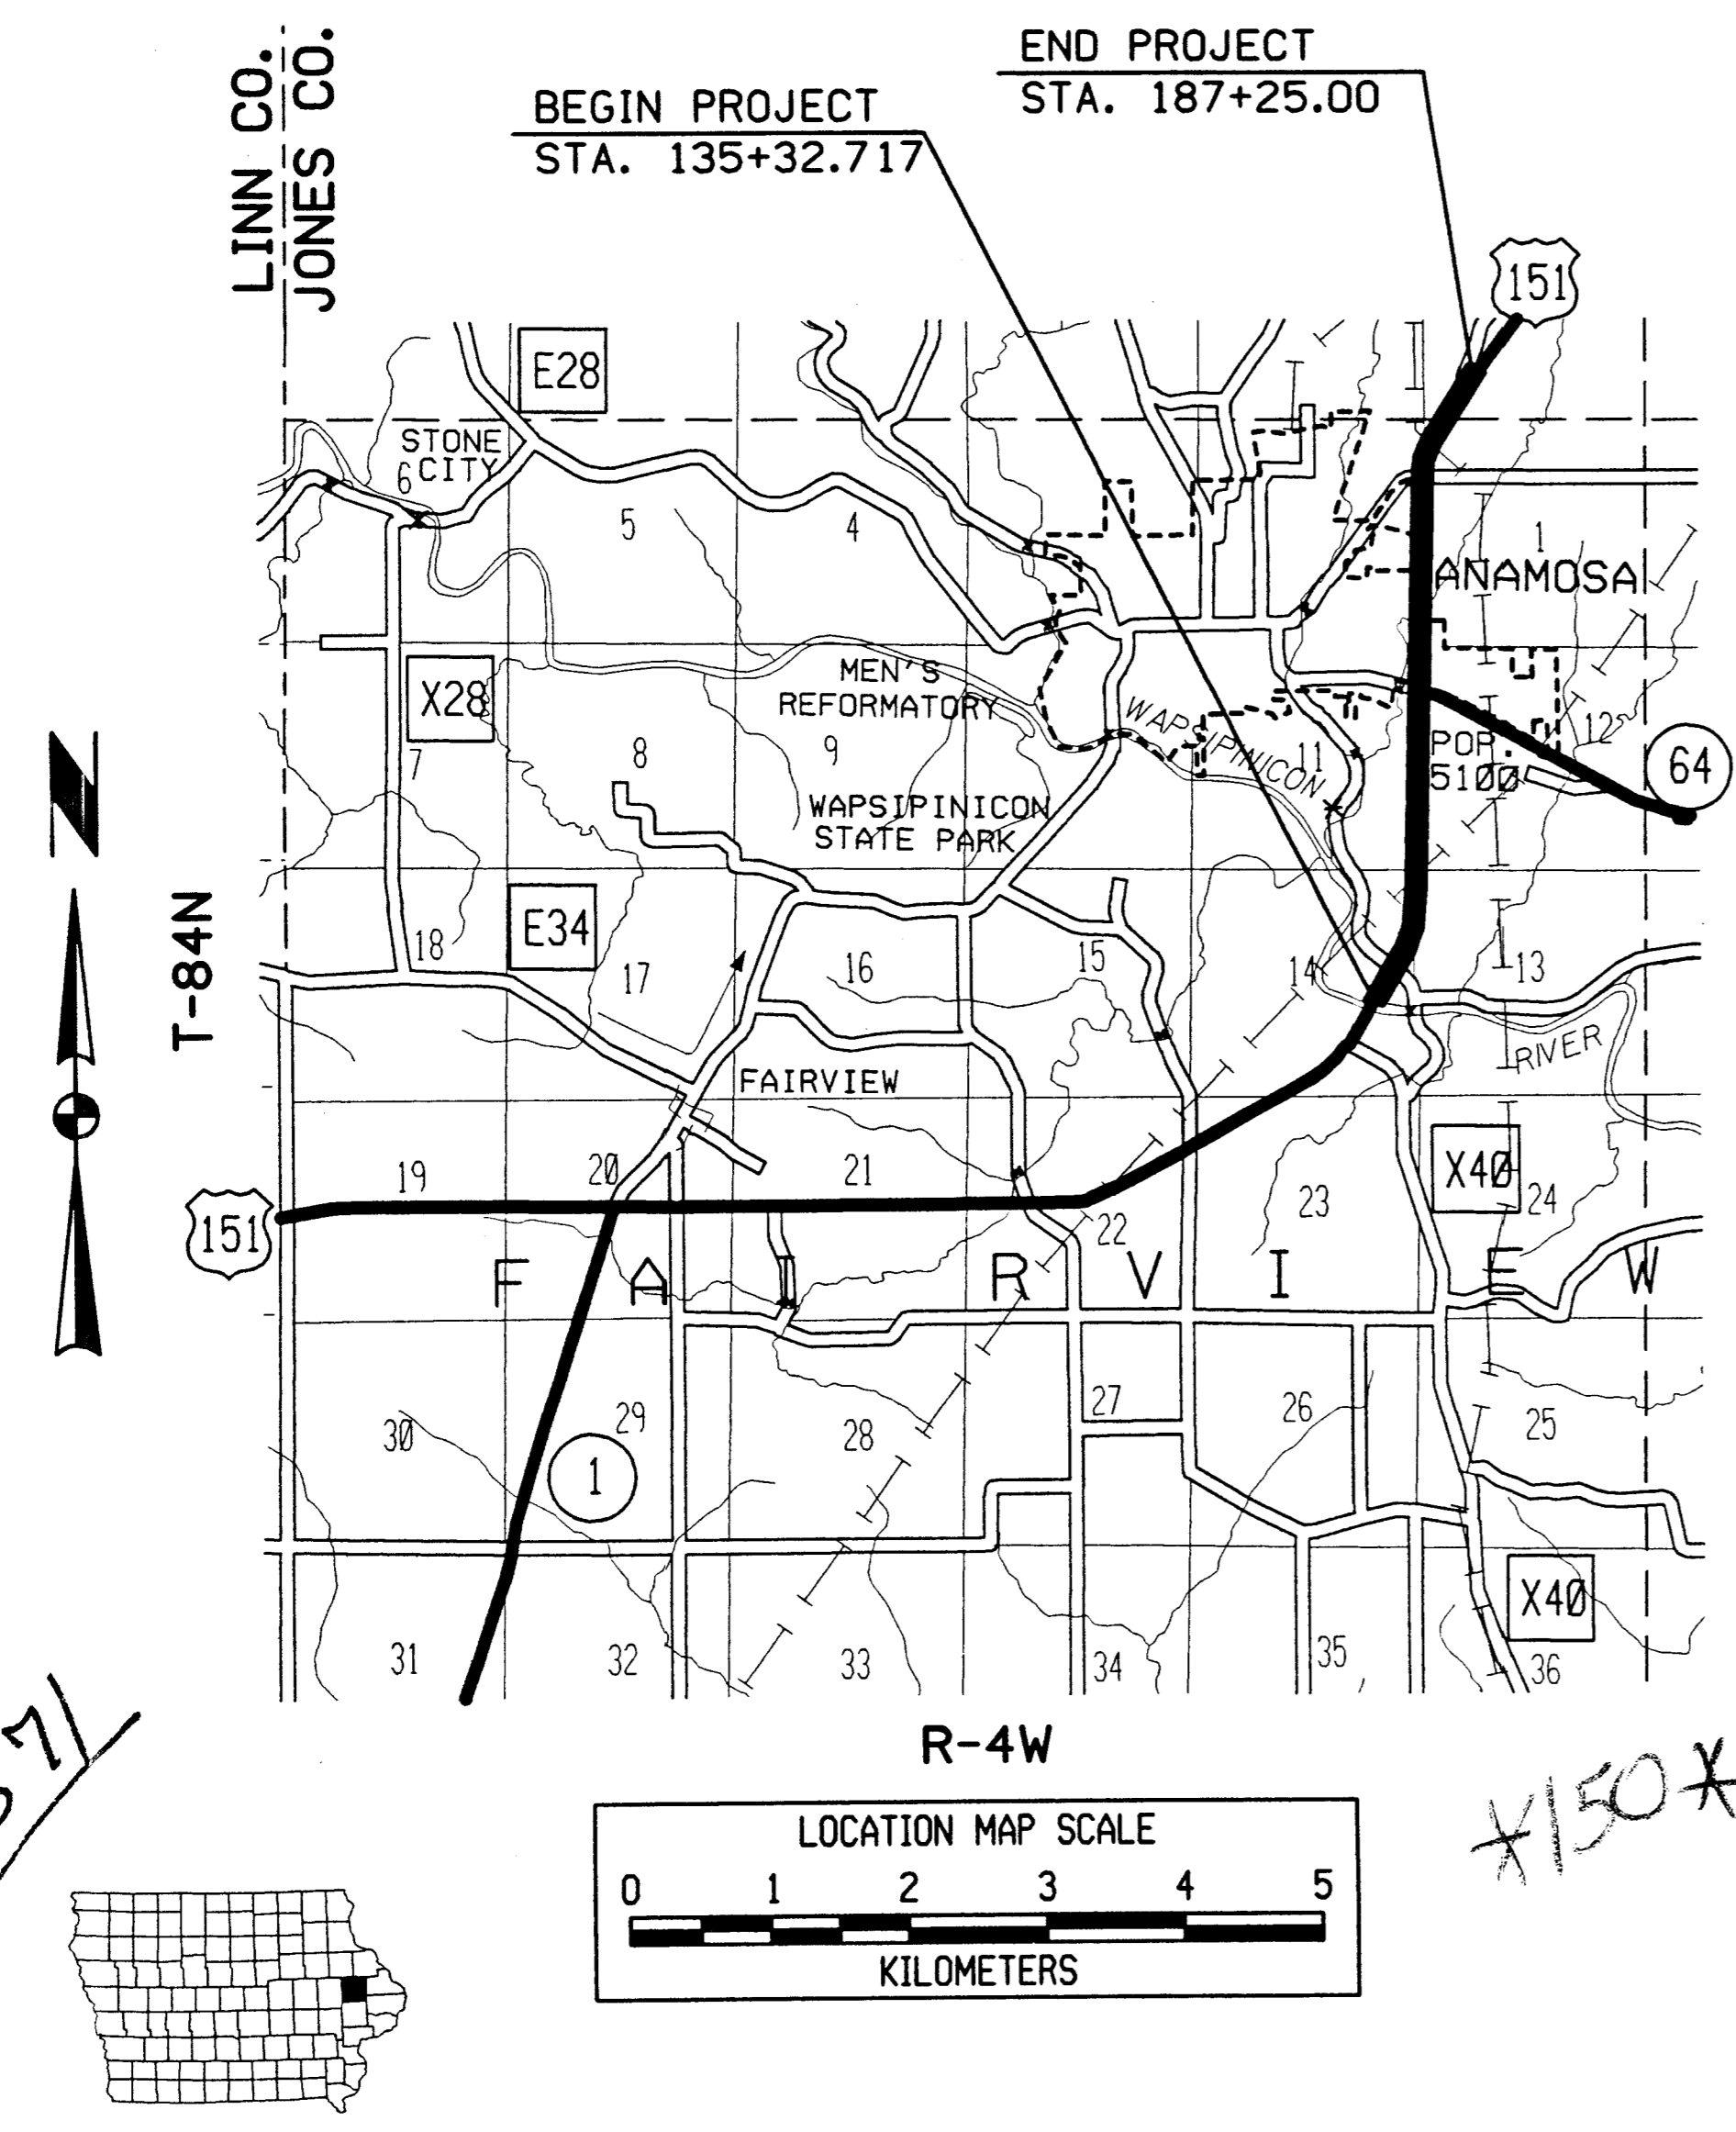

LETTING DATE 1-11-00

GRADING NHSX-151-4(63)--3H-53

dgn = I:\work\project\3412\UVCADD\EA51\53151063.a01
prf = \\WATSON\DATA\PLT\PL463P\ao01.prf
date = Tue Nov 9 07:59:29 1999

STANDARD SYMBOLS

	Interstate Highway Symbol		Fire Hydrant
	U.S. Highway Symbol		Water Hydrant (Rural)
	Iowa Highway Symbol		Septic Tank
	County Road Highway Symbol		Cistern
	Evergreen Tree		L.P. Gas Tank (No Footing)
	Deciduous Tree		Underground Storage Tank
	Fruit Tree		Latrine
	Shrub (Bushes)		Luminaire
	Timber		Traffic Signal
	Hedge		Traffic Signal with Luminaire
	Stump		Telephone Pedestal
	Swamp		TVP Television Pedestal
	Rock Outcrop		Telephone Pole
	Broken Concrete		Telephone Pole (Second Company)
	Revetment (Rip Rap)		Telephone Pole (Third Company)
	Cemetery		Telephone Pole (Fourth Company)
	Grave		Telephone Pole (Fifth Company)
	Cave		Power Pole
	Sink Hole		Power Pole (Second Company)
	Board Fence		Power Pole (Third Company)
	Chain Link Fence		Power Pole (Fourth Company)
	Barbwire Fence		Power Pole (Fifth Company)
	Security Fence		Electrical Highline Tower (Metal or Concrete)
	Woven Fence		Telephone Riser Pole
	Barbwire and Woven Fence		Power Riser Pole
	Terrace		Telegraph Pole
	Earth Dam or Dike (Existing)		Satellite TV Dish
	Earth Dam or Dike (Proposed)		Existing Water Line
	Tile Outlet		Existing Water Line (Second Company)
	Edge of Water		Existing Sanitary Sewer Line
	Existing Drainage		Existing Telephone Line
	Proposed Drainage		Existing Telephone Line (Second Company)
	Right of Way Rail or Lot Corner		Existing Fiber Optics Telephone Line
	Concrete Monument		Existing Storm Sewer Line
	Well		Existing Gas Line
	Windmill		Existing High Pressure Gas Line
	Beehive Intake		Existing Gas Line (Second Company)
	Existing Intake		Existing High Pressure Gas Line (Second Company)
	Proposed Intake		Existing Power Line
	Existing Utility Access (Manhole)		Existing Power Line (Second Company)
	Proposed Utility Access (Manhole)		Cable Television Line

	Guardrail (Beam or Cable)
	Guard Post (one or two)
	Guard Post (over two)
	Filler Pipe
	Gas Valve
	Water Valve
	Speed Limit Sign
	Mile Marker Post
	SIGN Sign
	Water Hook Up
	Radio Tower
	Electric Box
	Traffic Signal Control Box
	Rail Road Signal Control Box
	Telephone Switch Box
	Guy Wire
	Fiber Optics Marker

UTILITY LEGEND

	Iowa D.O.T. Maintenance Building 704 E. First Street Anamosa, Iowa 52205
	IES Utilities Inc. 105 Kraiburg Boulevard Lisbon, Iowa 52253 1-319-455-0075
	Linn County Rural Electric Cooperative Association 999 35th Street P.O. Box 69 Marion, Iowa 52302 1-319-377-1587
	Maquaketa Valley Rural Electric Cooperative Association 109 North Humber Street Anamosa, Iowa 52205 1-319-462-3542
	Iowa Communications Network Hoover Building, Level A Des Moines, Iowa 50319 1-515-242-5314
	MCI Telecommunications Corporation 500 Second Avenue S.E. Cedar Rapids, Iowa 52401 1-319-375-1908
	Martelle Coop Telephone Association P.O. Box 128 Martelle, Iowa 52305 1-319-482-2381
	Amoco Pipeline Company 2192 N. Hwy 965 North Liberty, Iowa 52317 1-800-548-6482
	Northern Natural Gas 5557 County D Platteville, Wisconsin 53818 1-608-348-2738
	Martelle Coop Telephone Association P.O. Box 128 Martelle, Iowa 52305 1-319-482-2381
	Springville Co-Operative Telephone Association, Inc. 207 Broadway Street Springville, Iowa 52336 1-319-227-7111
	U.S. West Communications 615 3rd Avenue SE Cedar Rapids, Iowa 52401 1-319-399-7820
	City of Anamosa City Hall 107 S. Ford Street Anamosa, Iowa 52205
	City of Anamosa City Hall 107 S. Ford Street Anamosa, Iowa 52205

RIGHT OF WAY LEGEND

	Proposed Right of Way
	Existing Right of Way
	Existing and Proposed Right of Way
	Easement and Existing Right of Way
	Borrow
	Easement (Temporary)
	Easement
	Excess
	Property Line
	Access Control

CONVENTIONAL SIGNS

	Survey Line
	Section Corner
	Proposed Profile Grade
	Railroad
	Field Tile
	Culverts
	Stream

Legend And Symbol Information Sheet

(Symbols are Typical Only, actual size may vary)

dgn = I:\work\project\34120\cadd\east\53151063.a02
 prf = \\WATSO1\DATA\PL01\PL463P.a02.prf
 date = Fri Oct 29 15:53:45 1999
 pen table = I:\plot\tables\hal.fwt.tbl
 levels = 1-63


Revised

LISTING OF PROJECT REVISIONS


111-23
09-27-94

DATE	SHEET NO.	DESCRIPTION OF REVISIONS
01-28-00	A.03	Add Sheet for Tabulation of Revisions 111-2.
	B.03	Correct Location Station from 2161+25 to 2161+37 on Typical 3205.
	B.09	Add Pavement Marking Detail 9016 for Left Lane Drop.
	C.01	Add Bid Item Painted Symbol and Legend, Item Code 2527--104000, Quantity of 17 Each and Renumber Items Accordingly. Revised Item No. 6, Item Code 2102--230100 from 9328.5 Mg to 9417.1 Mg. Revised Item No. 19, Item Code 2301--133240 from 17,134.2 Sq. M. to 17,339 Sq. M. Revised Item No. 20, Item Code 2301--153180 from 986.2 Sq. M. to 1,066.0 Sq. M. Revised Item No. 87, Item Code 2527--101000 from 13,340 M to 13,150.5 M. Revised Item No. 90, Item Code 2527--108000 from 2,867 M to 2,538 M. Revised Estimate Reference Note for Item 6.
	C.02	Revise Estimate Reference Notes Based on the Changes Made to Sheet C.01. Insert Note for Item No. 89 and renumber accordingly.
	C.04	Add Tabulation of Symbols, Tab. 108-29.
	C.10 - C.12	Revised Tabulation of Pavement Markings for the Revised Pavement Marking Layout on Ia-64.
	E.02	Revised Sheet for Additional Length to Right Lane From Sta. 2160+90 to Sta. 2161+01.
	K.09	Removed Stop Island.
	K.10	Removed Stop Island and Revised Jointing Accordingly.
	L.04	Revised Sheet for Additional Length to Right Lane From Sta. 2160+90 to Sta. 2161+01.
	R.01 - R.11	Revised Borrow Site Cross Sections to Show Updated Soils Information.
	R.12 - R.19	Revised Borrow Site Layout and Cross Sections.
	R.20 - R.21	Removed from Plans.
	U.05	Revised Pavement Marking Detail for the Ia-64 Area.

dgn = I:\WORK\proj\sect\34120\cadd\east\531b1063.a03
prf = \\WA1501\DATA\PL01\PL463P\503.prf
date = Mon Mar 6 15:00:57 2000
level = 1-63
pen_table = I:\plot\tables\ha\lwt.tbl




I hereby certify that this plan was prepared under my supervision and that engineering decisions with regard to the design were made by me or by other duly licensed Professional Engineers under the laws of the State of Iowa.

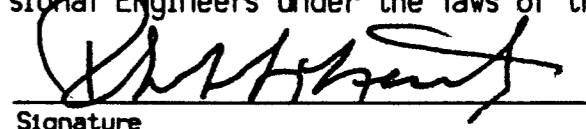
6 Mar 2000
 Signature _____ Date
 Printed or Typed Name
 Robert L. Lentz
 My license renewal date is December 31, 2000.

Pages or sheets covered by this seal: _____
 A.03, B.03, B.09, C.01, C.02, C.04, C.10 - C.12,
 E.02, K.09, K.10, L.04, R.01 - R.21, U.05


dcn = L:\WORK\PROJECT\34120\CAUDAEAS\53151063.b01
 pdf = \\WA750\IN\DATA\PILOT\PI463PV801.PRF
 date = Thu Oct 28 07:57:37 1999
 pen table = I:\pilot\tables\halfwt.tbl
 levels = 1-63

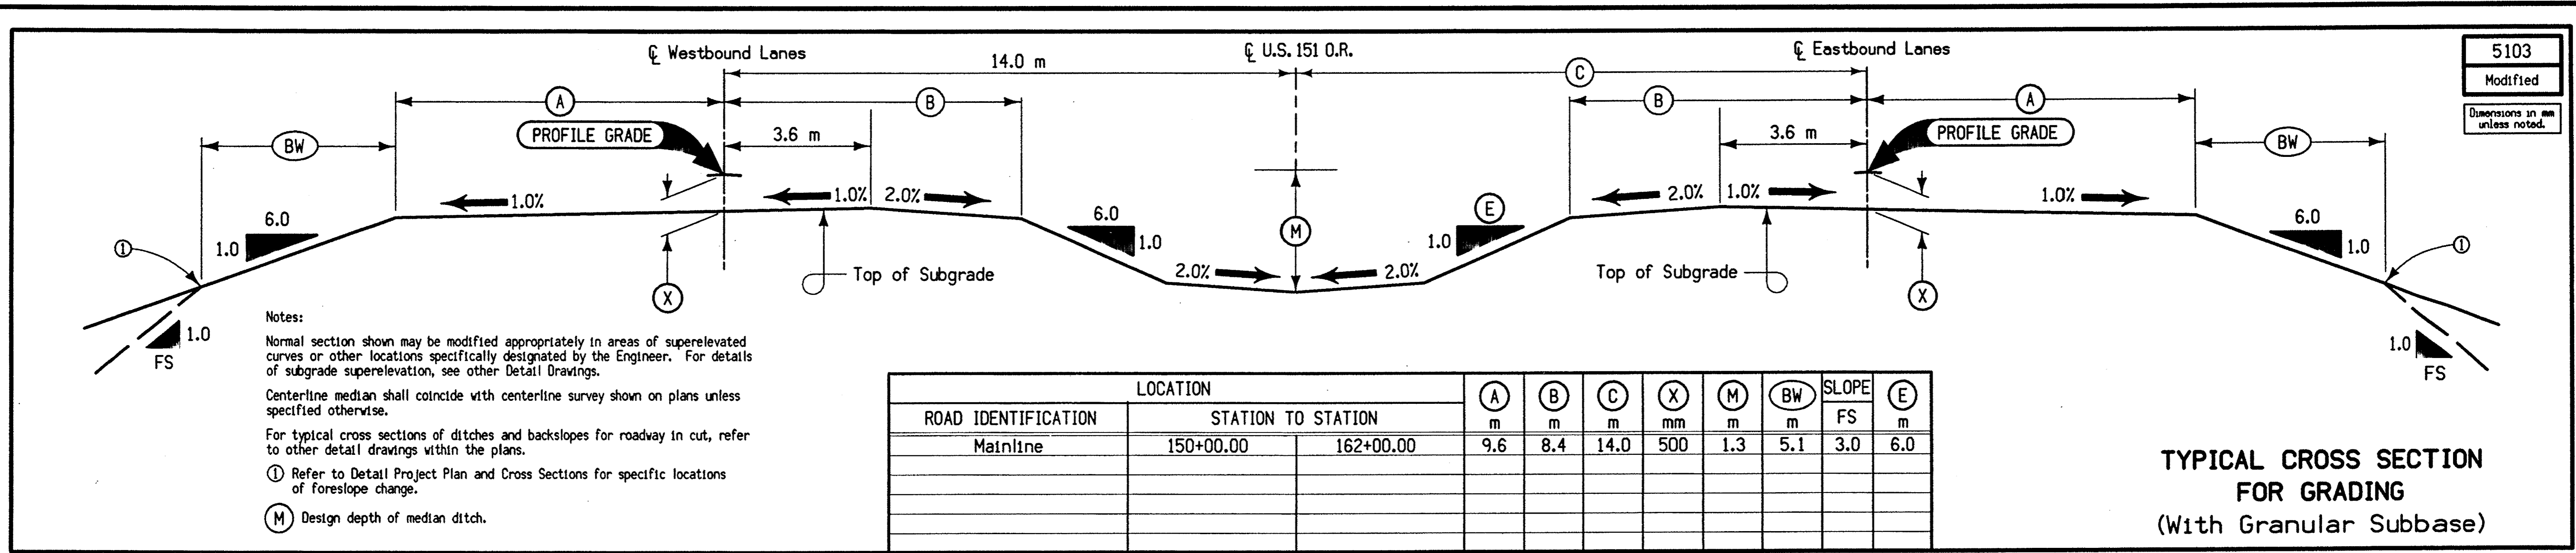

5103
Modified
Dimensions in mm unless noted.

LOCATION		A	B	C	X	M	BW	SLOPE	E
ROAD IDENTIFICATION	STATION TO STATION	m	m	m	mm	m	m	FS	m
Mainline	150+00.00 - 162+00.00	9.6	8.4	14.0	500	1.3	5.1	3.0	6.0


TYPICAL CROSS SECTION FOR GRADING (With Granular Subbase)

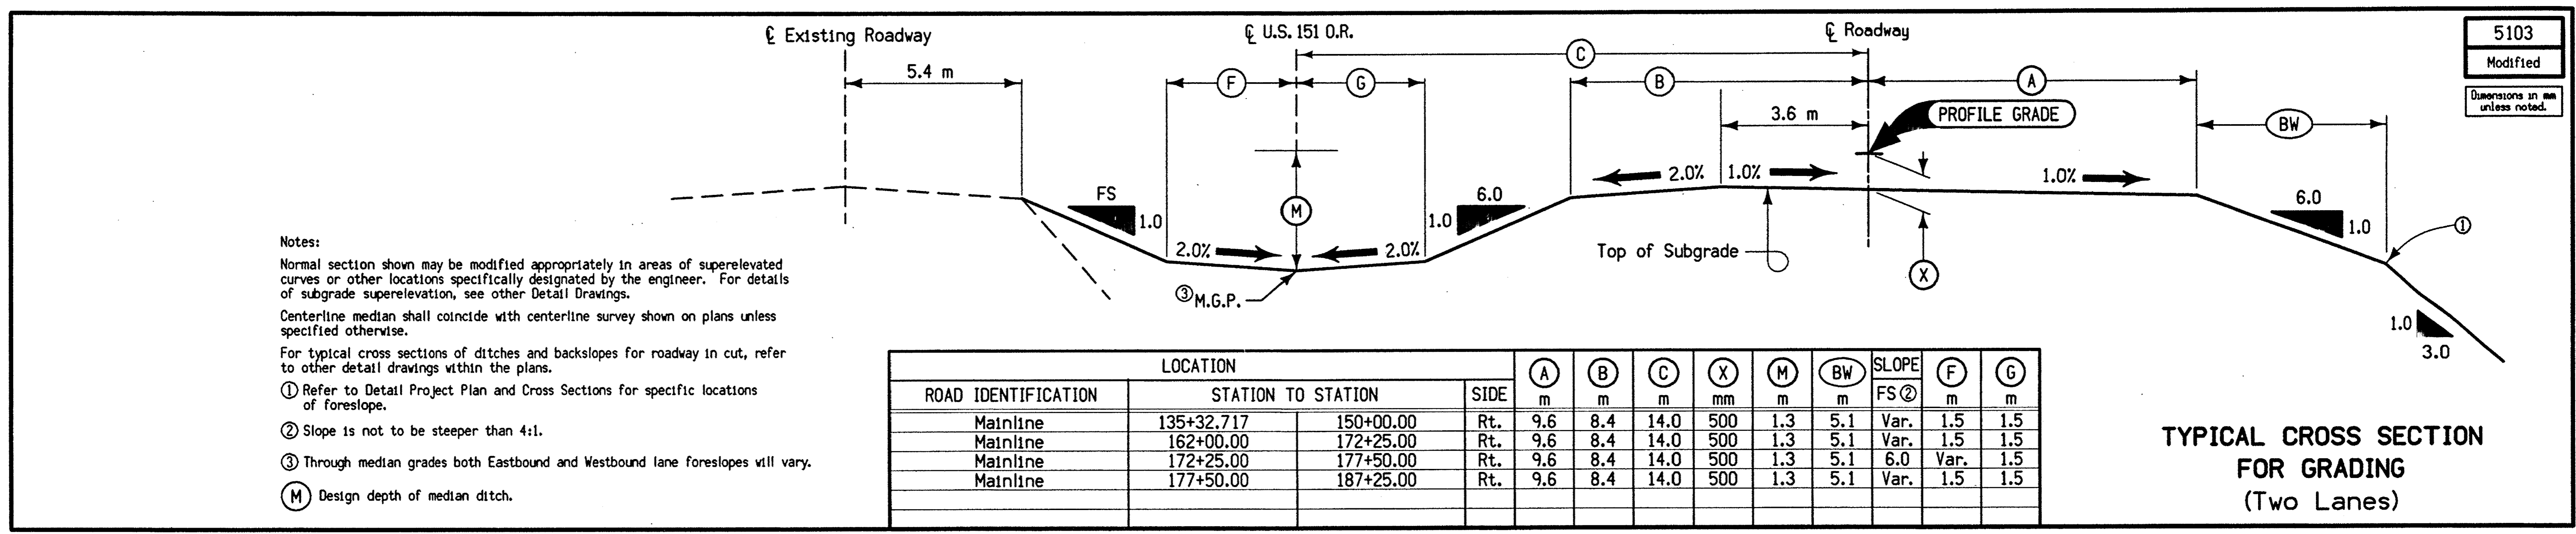

5103
Modified
Dimensions in mm unless noted.

LOCATION		A	B	C	X	M	BW	SLOPE	F	G
ROAD IDENTIFICATION	STATION TO STATION	m	m	m	mm	m	m	FS ②	m	m
Mainline	135+32.717 - 150+00.00	9.6	8.4	14.0	500	1.3	5.1	Var.	1.5	1.5
Mainline	162+00.00 - 172+25.00	9.6	8.4	14.0	500	1.3	5.1	Var.	1.5	1.5
Mainline	172+25.00 - 177+50.00	9.6	8.4	14.0	500	1.3	5.1	6.0	Var.	1.5
Mainline	177+50.00 - 187+25.00	9.6	8.4	14.0	500	1.3	5.1	Var.	1.5	1.5


TYPICAL CROSS SECTION FOR GRADING (Two Lanes)

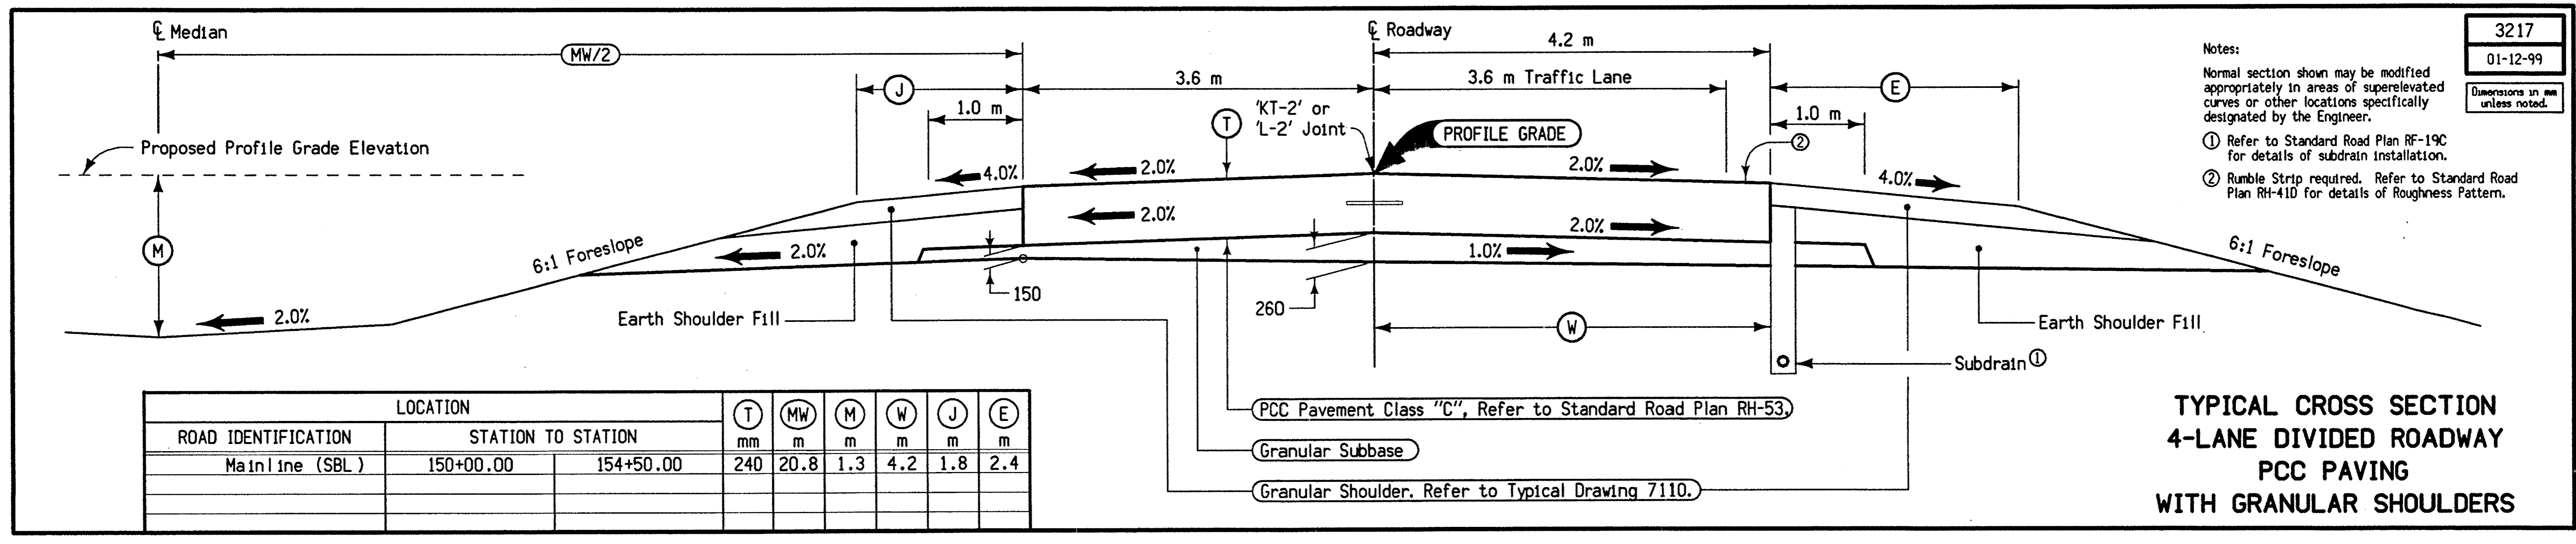


3217
01-12-99
Dimensions in mm unless noted.

LOCATION		T	MW	M	W	J	E
ROAD IDENTIFICATION	STATION TO STATION	mm	m	m	m	m	m
Mainline (SBL)	150+00.00 - 154+50.00	240	20.8	1.3	4.2	1.8	2.4


TYPICAL CROSS SECTION 4-LANE DIVIDED ROADWAY WITH GRANULAR SHOULDERS

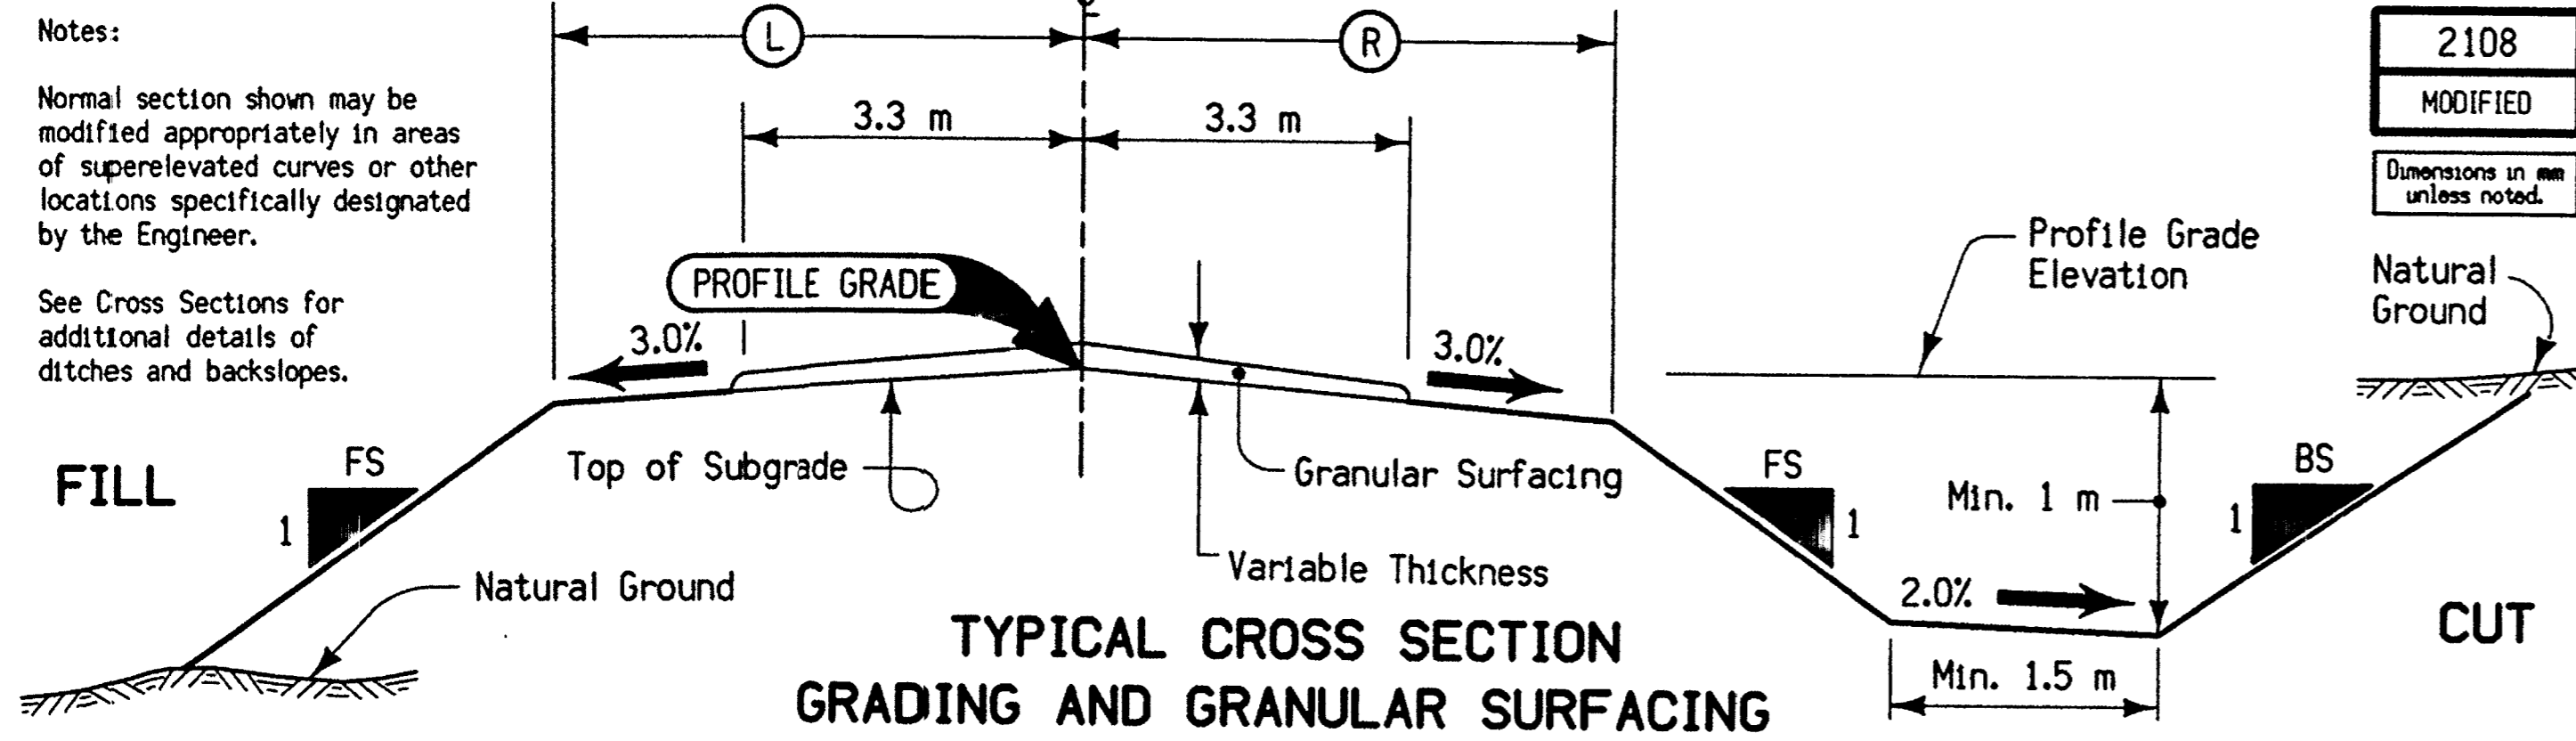

LOCATION		DIMENSIONS		SLOPES	
ROAD IDENTIFICATION	STATION TO STATION	(L)	(R)	FS	BS
Shaw Road	3136+50.00 - 3137+41.00	5.4	5.4	3.0	2.5

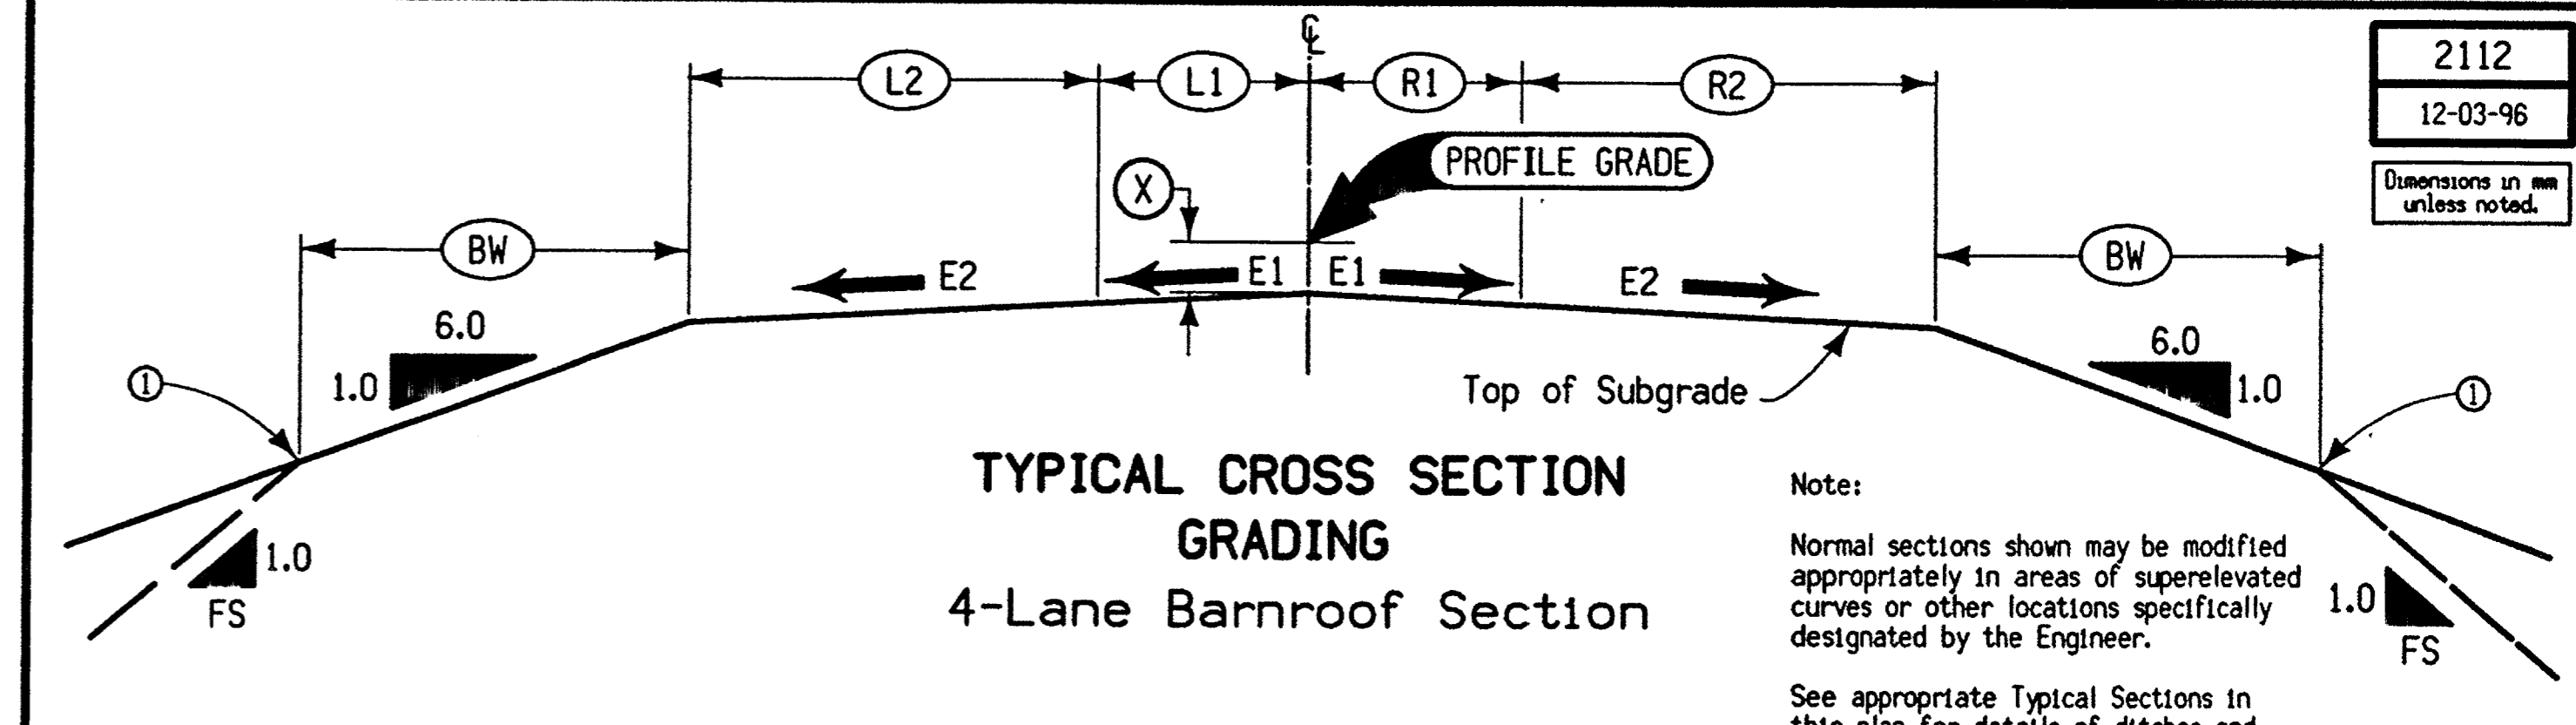


LOCATION		(L1)	(L2)	(R1)	(R2)	(X)	(BW)	FS	E1%	E2%
ROAD IDENTIFICATION	STATION TO STATION	m	m	m	m	mm	m			
Iowa Highway 64	2156+25.00 - 2159+60.00	N/A	N/A	3.6	9.9	390	4.1	3.0	2.0	3.0

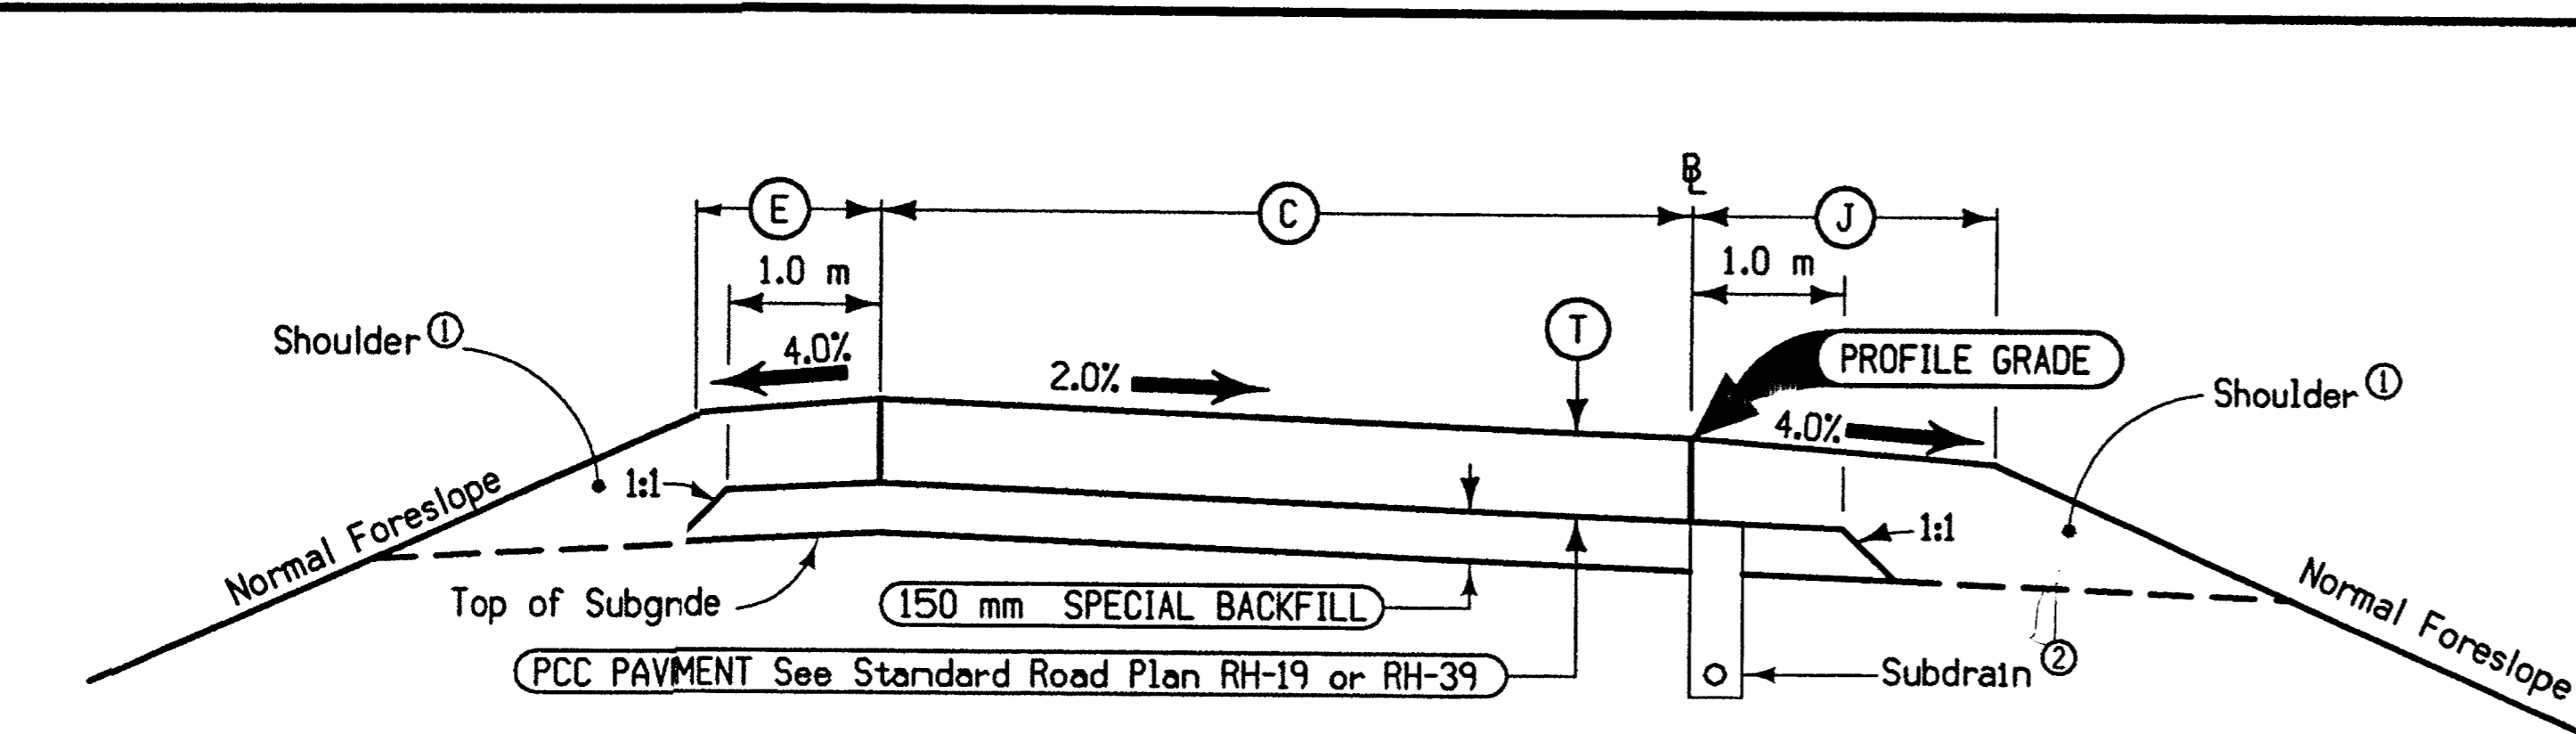

TYPICAL CROSS SECTION PCC RAMP PAVING

LOCATION		DIMENSIONS				SHOULDER TYPE	
INTERCHANGE	RAMP	STATION TO STATION	(T)	(C)	(E)		(J)
			mm	m	m	m	
Iowa Highway 64	A	5154+30.0 - 5158+17.8	240	4.8	1.2	1.8	Paved
Iowa Highway 64	B	6157+20.3 - 6157+60.5	240	4.8	1.2	1.8	Paved
Iowa Highway 64	D	8158+13.2 - 8161+89.2	240	4.8	1.2	1.8	Paved

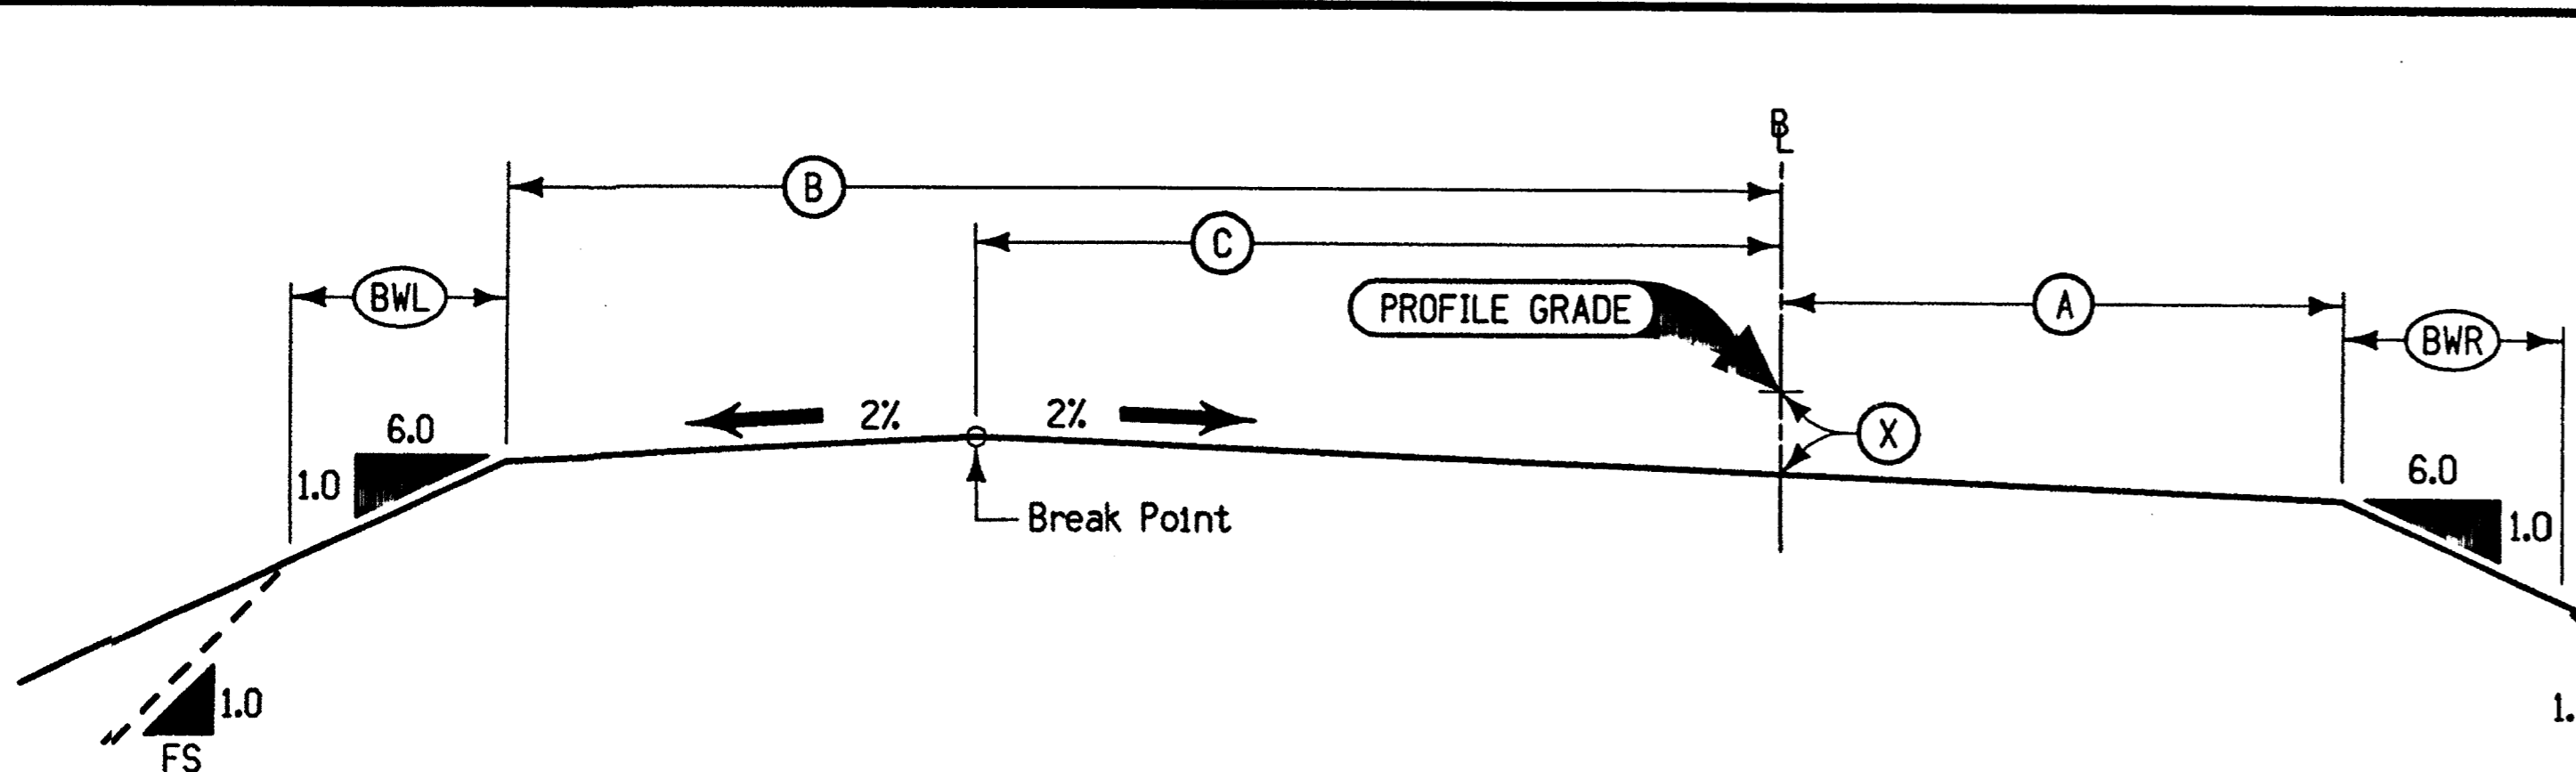


TYPICAL CROSS SECTION RAMP GRADING

LOCATION		DIMENSIONS							
INTERCHANGE	RAMP	STATION TO STATION	(A)	(B)	(C)	(X)	FS	(BWL)	(BWR)
			m	m	m	mm		m	m
Iowa Highway 64	A	5154+30.0 - 5158+17.8	4.8	9.1	4.8	390	3.0	6.4	5.7
Iowa Highway 64	B	6153+10.0 - 6157+60.5	4.8	9.1	4.8	390	3.0	6.4	5.7
Iowa Highway 64	Loop C	7154+94.3 - 7156+55.3	4.8	9.8	5.5	390	3.0	6.5	5.7
Iowa Highway 64	D	8158+13.2 - 8161+89.2	4.8	9.1	4.8	390	3.0	6.4	5.7

dgm = L:\WORK\PROJECT\34120\CAD\DWG\AS\153151063.b01
 level = 1-63
 pen table = L:\plot\tables\half.tbl
 prf = \WATS01\DATA\PLT\PL463P\B02.PRF
 date = Fri Sep 17 14:39:06 1999

Revised

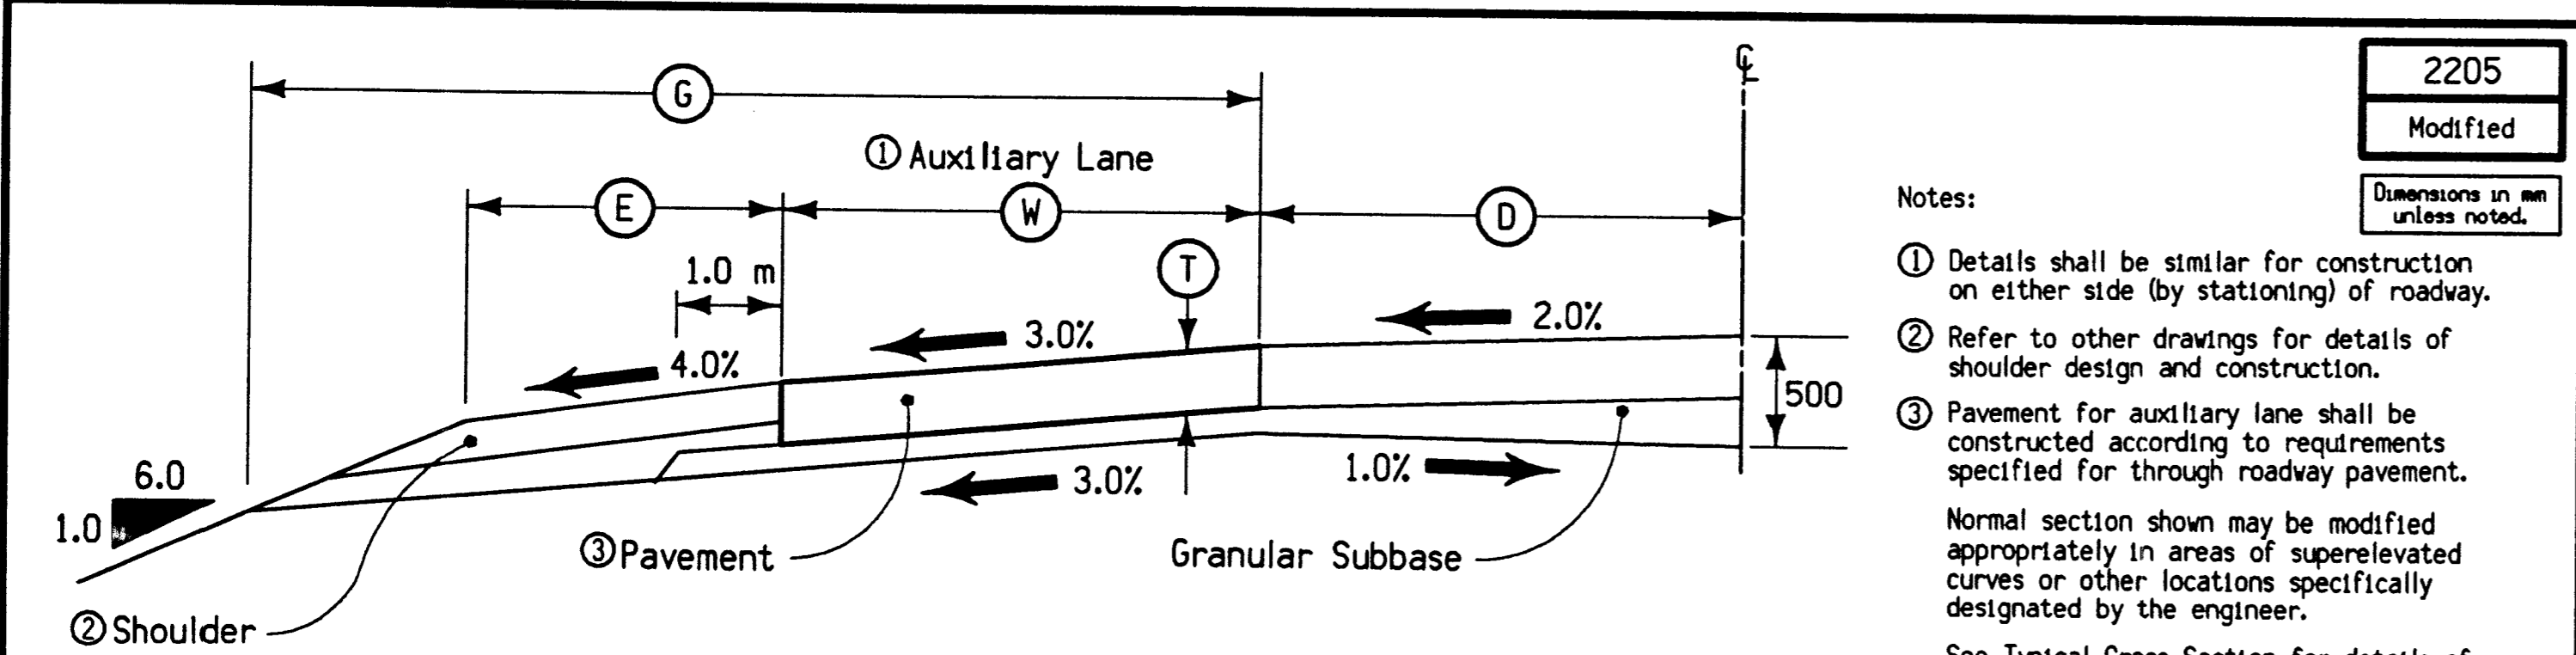


LOCATION		SIDE	D m	E m	W m	G m	T mm
ROAD IDENTIFICATION	STATION TO STATION						
Main line	136+89.00 137+39.00	NBL	3.6	1.8	3.6	8.8	240
Main line	137+88.00 138+38.00	SBL	3.6	1.8	3.6	8.8	240
Main line	172+42.95 172+92.73	NBL	3.6	1.8	3.6	8.8	240
Main line	173+43.08 173+93.00	SBL	3.6	1.8	3.6	8.8	240
Main line	180+00.50 180+50.50	NBL	3.6	1.8	3.6	8.8	240

**GRADING AND PAVING
TYPICAL HALF SECTION
PROPOSED LEFT TURN LANE**

Notes:
 ① Details shall be similar for construction on either side (by stationing) of roadway.
 ② Refer to other drawings for details of shoulder design and construction.
 ③ Pavement for auxiliary lane shall be constructed according to requirements specified for through roadway pavement.
 Normal section shown may be modified appropriately in areas of superelevated curves or other locations specifically designated by the engineer.
 See Typical Cross Section for details of ditches and backslopes.
 Refer to Intersection Details (L sheets) for additional information.
 Section view is in direction of traffic.

2205
Modified
Dimensions in mm unless noted.

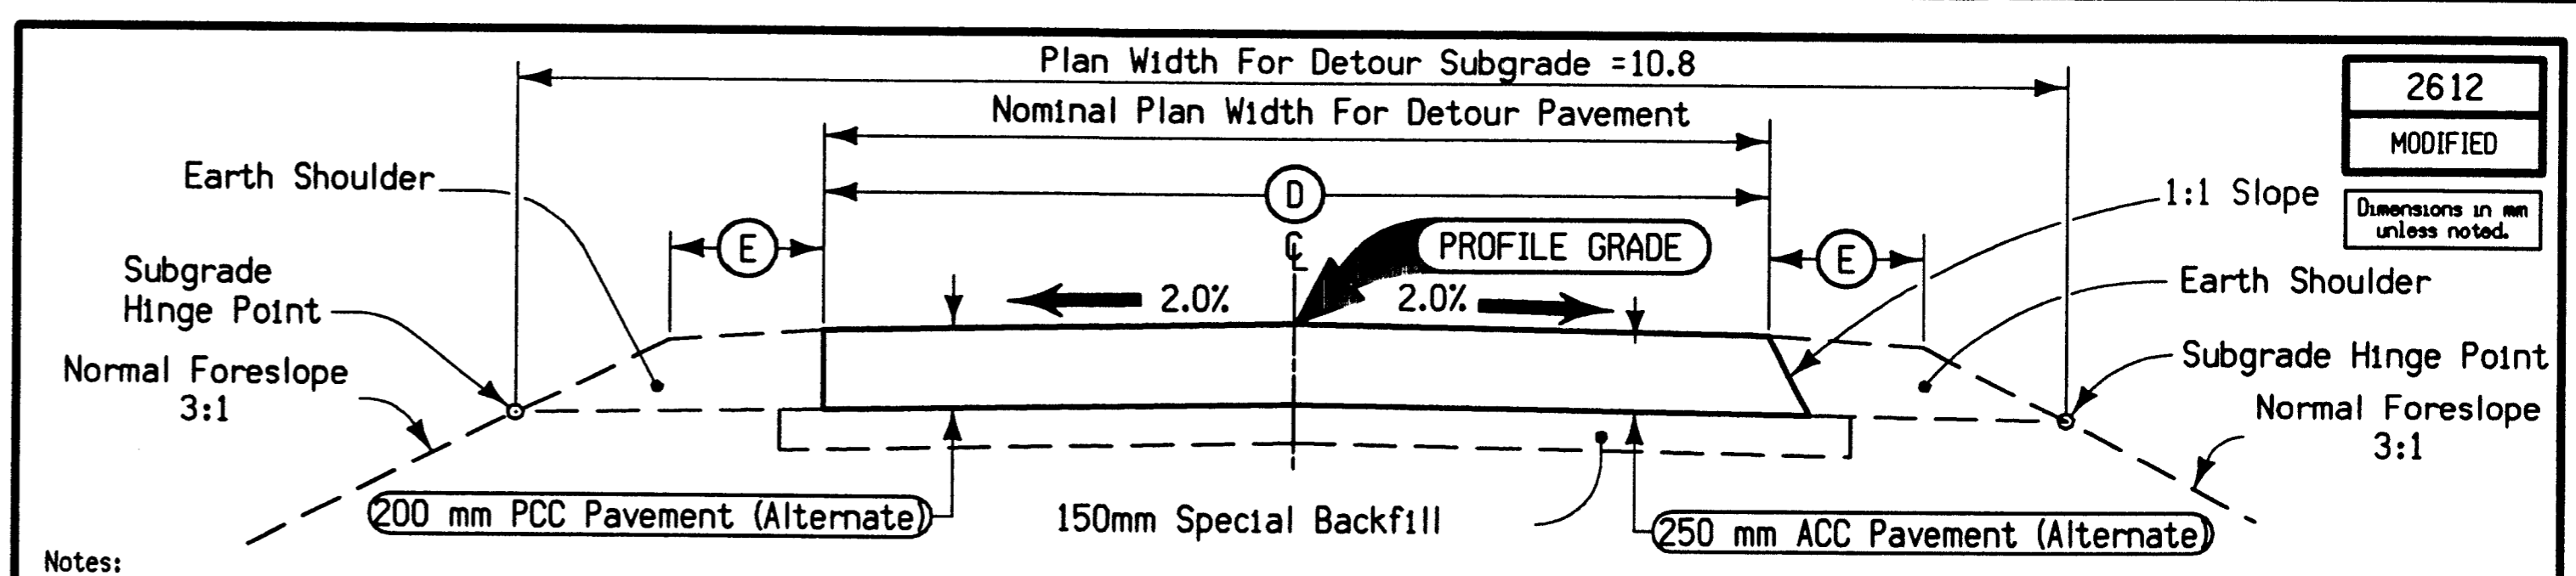


Notes:
 Details indicated herein illustrate the general requirements for the construction of a paved detour sections where the pavement may be constructed as either of two types at the option of the contractor.
 The P.C. Concrete option shall be constructed in conformance with current specifications for Class "A" P.C. Concrete Pavement. Transverse joints, center tie bars and sealing of the center longitudinal joint are not required.
 Special compaction of subgrade is required and will be constructed and paid for in conformance with current specifications. (See Section 2109)

**TYPICAL CROSS SECTION
DETOUR PAVEMENT ALTERNATES**

LOCATION		D m	E m	EARTH SHOULDER MATERIAL (m ³) ①②
STATION TO STATION	STATION TO STATION			
8148+83.252	8155+56.433	7.2	1	81.4

Notes:
 The Asphalt Cement Concrete option shall be constructed in conformance with current specifications for Type "B" Asphalt Cement Concrete Base (Class 1), an approved commercial mix or a mix of higher quality. The price bid for "Detour Pavement" in square meters will be considered full compensation for building the detour pavement as detailed herein.
 ① Per shoulder per station
 ② Quantity include 40% for shrinkage

2612
MODIFIED
Dimensions in mm unless noted.

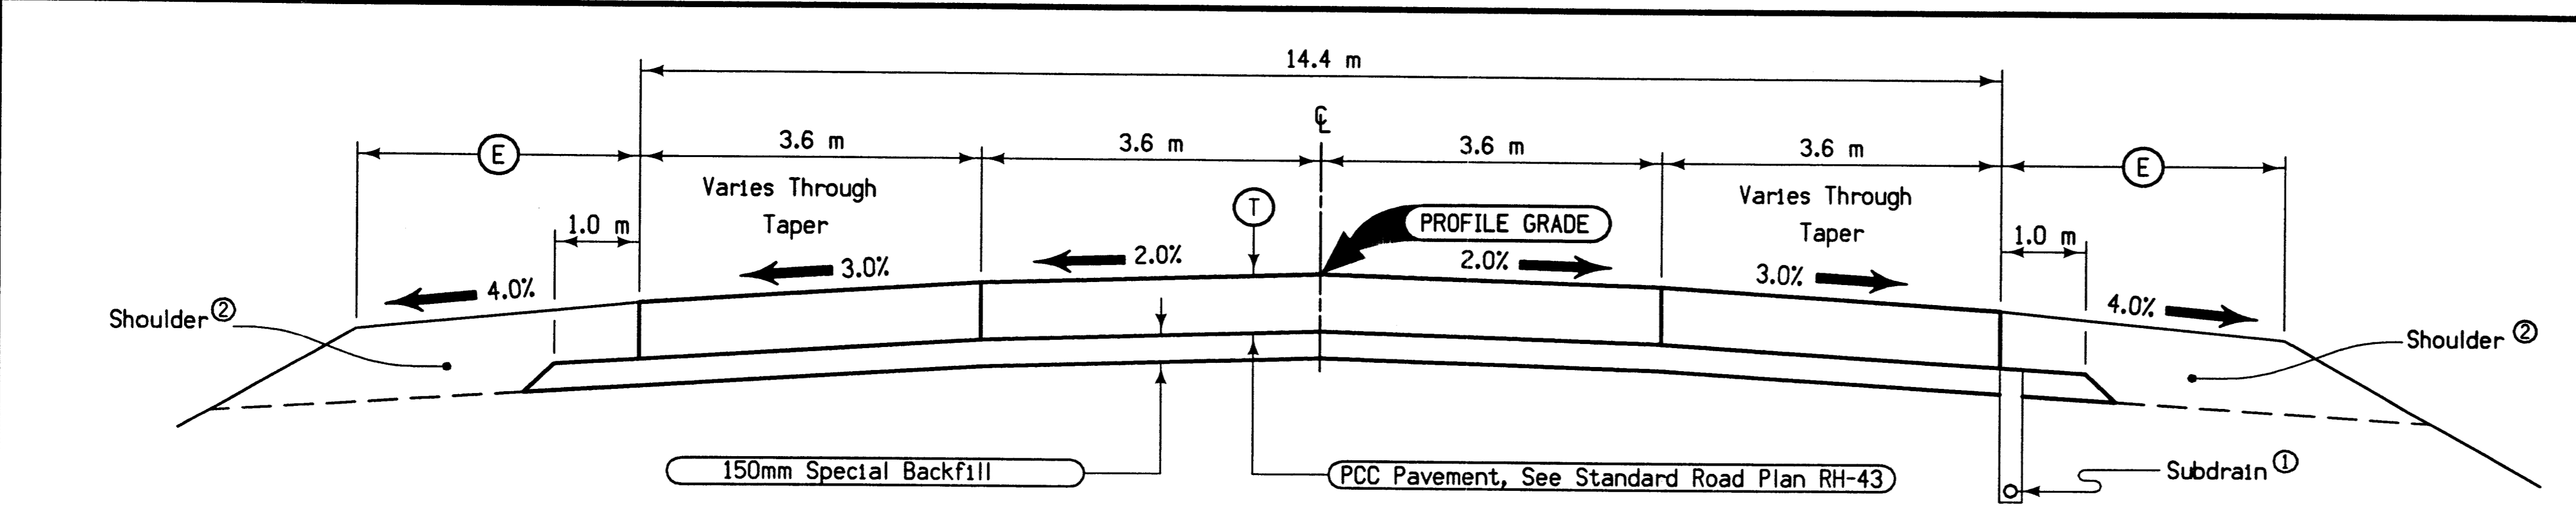

Notes:
 Normal sections shown may be appropriately modified for areas specifically designated by the Engineer such as intersections or superelevated curves.
 Refer to other drawings for details of shoulder design and construction.


- ① Refer to Standard Road Plan RF-19C.
- ② Refer to other Detail Drawings for details of shoulder design and construction.

**TYPICAL CROSS SECTION
4-LANE
PCC PAVEMENT**

LOCATION		T mm	E m
ROAD IDENTIFICATION	STATION TO STATION		
Iowa Highway 64	2156+25 2156+70	240	3.0
Lt. and Rt. (1)	2159+60 2161+37	240	3.0
Rt. (1)	2161+37 2161+60	240	3.0

(1) = Utilize Existing Pavement for Center Two Lanes

3205
08-20-96
Dimensions in mm unless noted.

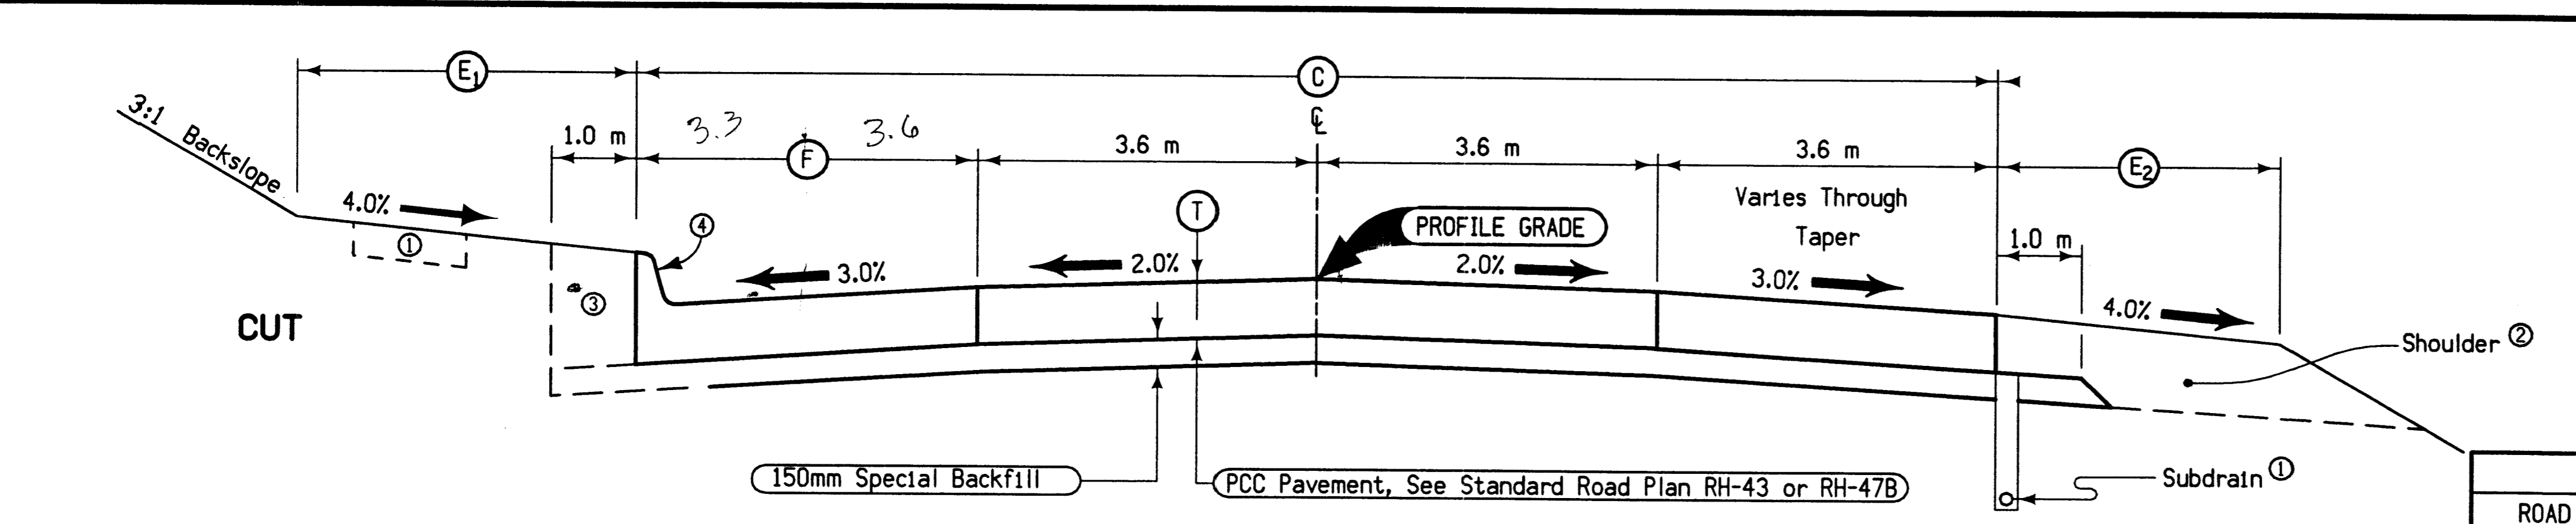

Notes:
 Normal sections shown may be appropriately modified for areas specifically designated by the Engineer, such as intersections or superelevated curves.
 Refer to other drawings for details of shoulder design and construction.

- ① Future Recreational Trail
- ② Excavate and Backfill 1.0 m.
- ③ Backfill
- ④ 150 mm Sloped Curb
- ⑤ Refer to Standard Road Plan RF-19C.





**TYPICAL CROSS SECTION
4-LANE
PCC PAVEMENT WITH CURBS**

LOCATION		E ₁ m	T mm	C m	F m	E ₂ m
ROAD IDENTIFICATION	STATION TO STATION					
Iowa Highway 64	2156+70 2159+60	5.2	240	N.A.	6.9	3.0
N.A. = Not Applicable						





3206
Modified
Dimensions in mm unless noted.





dgn = I:\WORK\proj\ec\34120\cadd\east\3151063.b01
 prf = \\WAI\S01\DATA\VP\LO\VP\463\N503.prf
 date = Tue Feb 22 14:26:08 2000
 level = 1-63
 pen table = I:\plot\tables\half.ttb

dgn = L:\WORK\PROJECT\134120\CAD\UN\EA5153151083.b05
 prf = \\WATSON\DATA\PLT\PL463P\B06.PRF
 date = Fri Sep 17 10:08:03 1994
 level = 1-63
 pen table = I:\plot\tab\es\half\ft.tbl

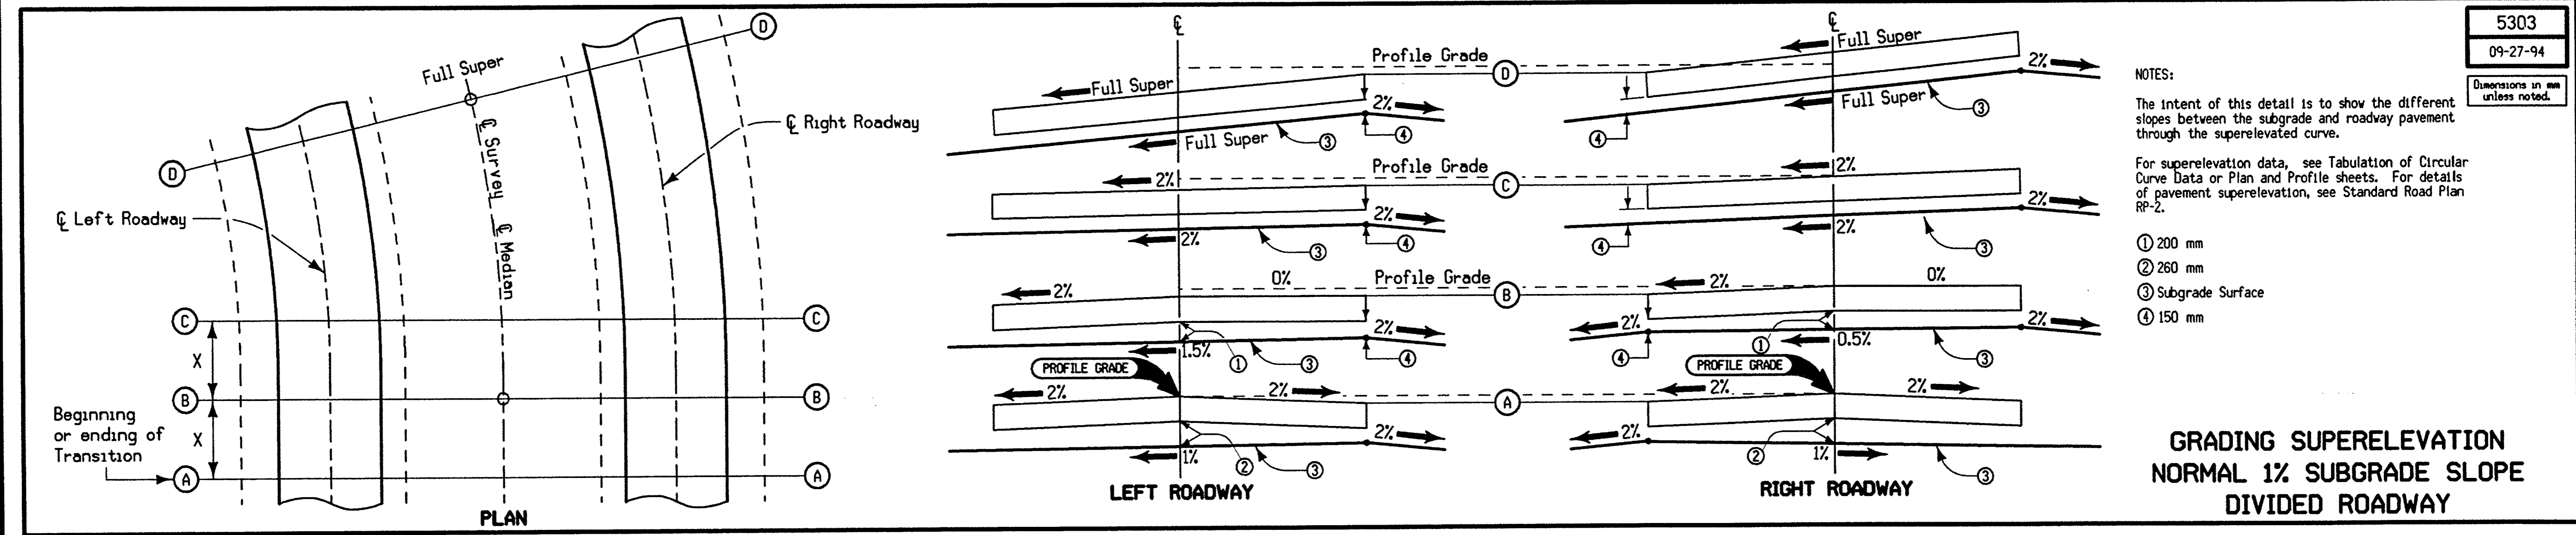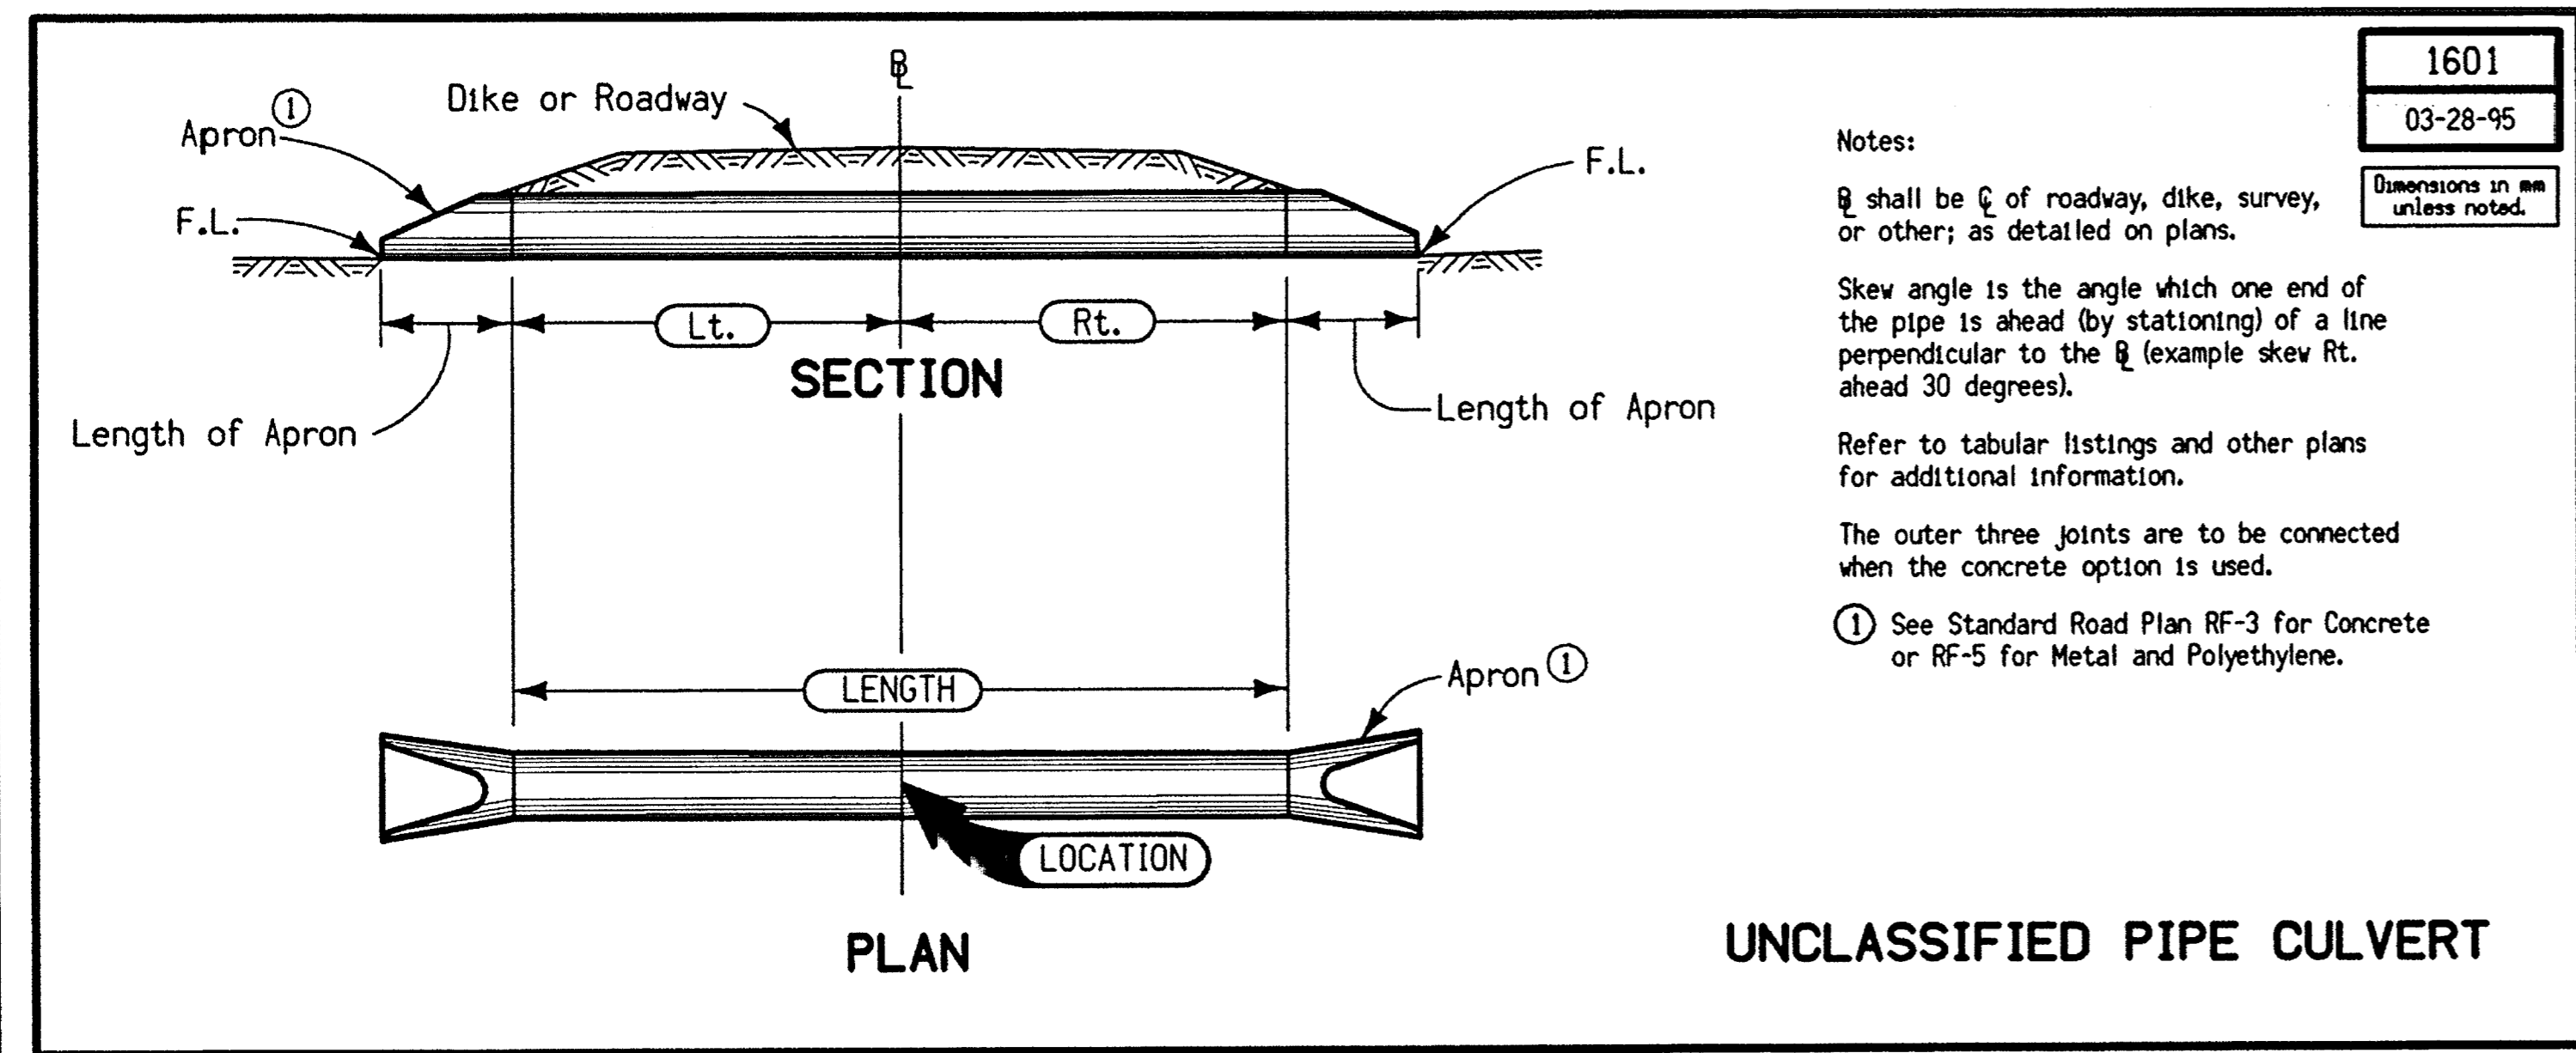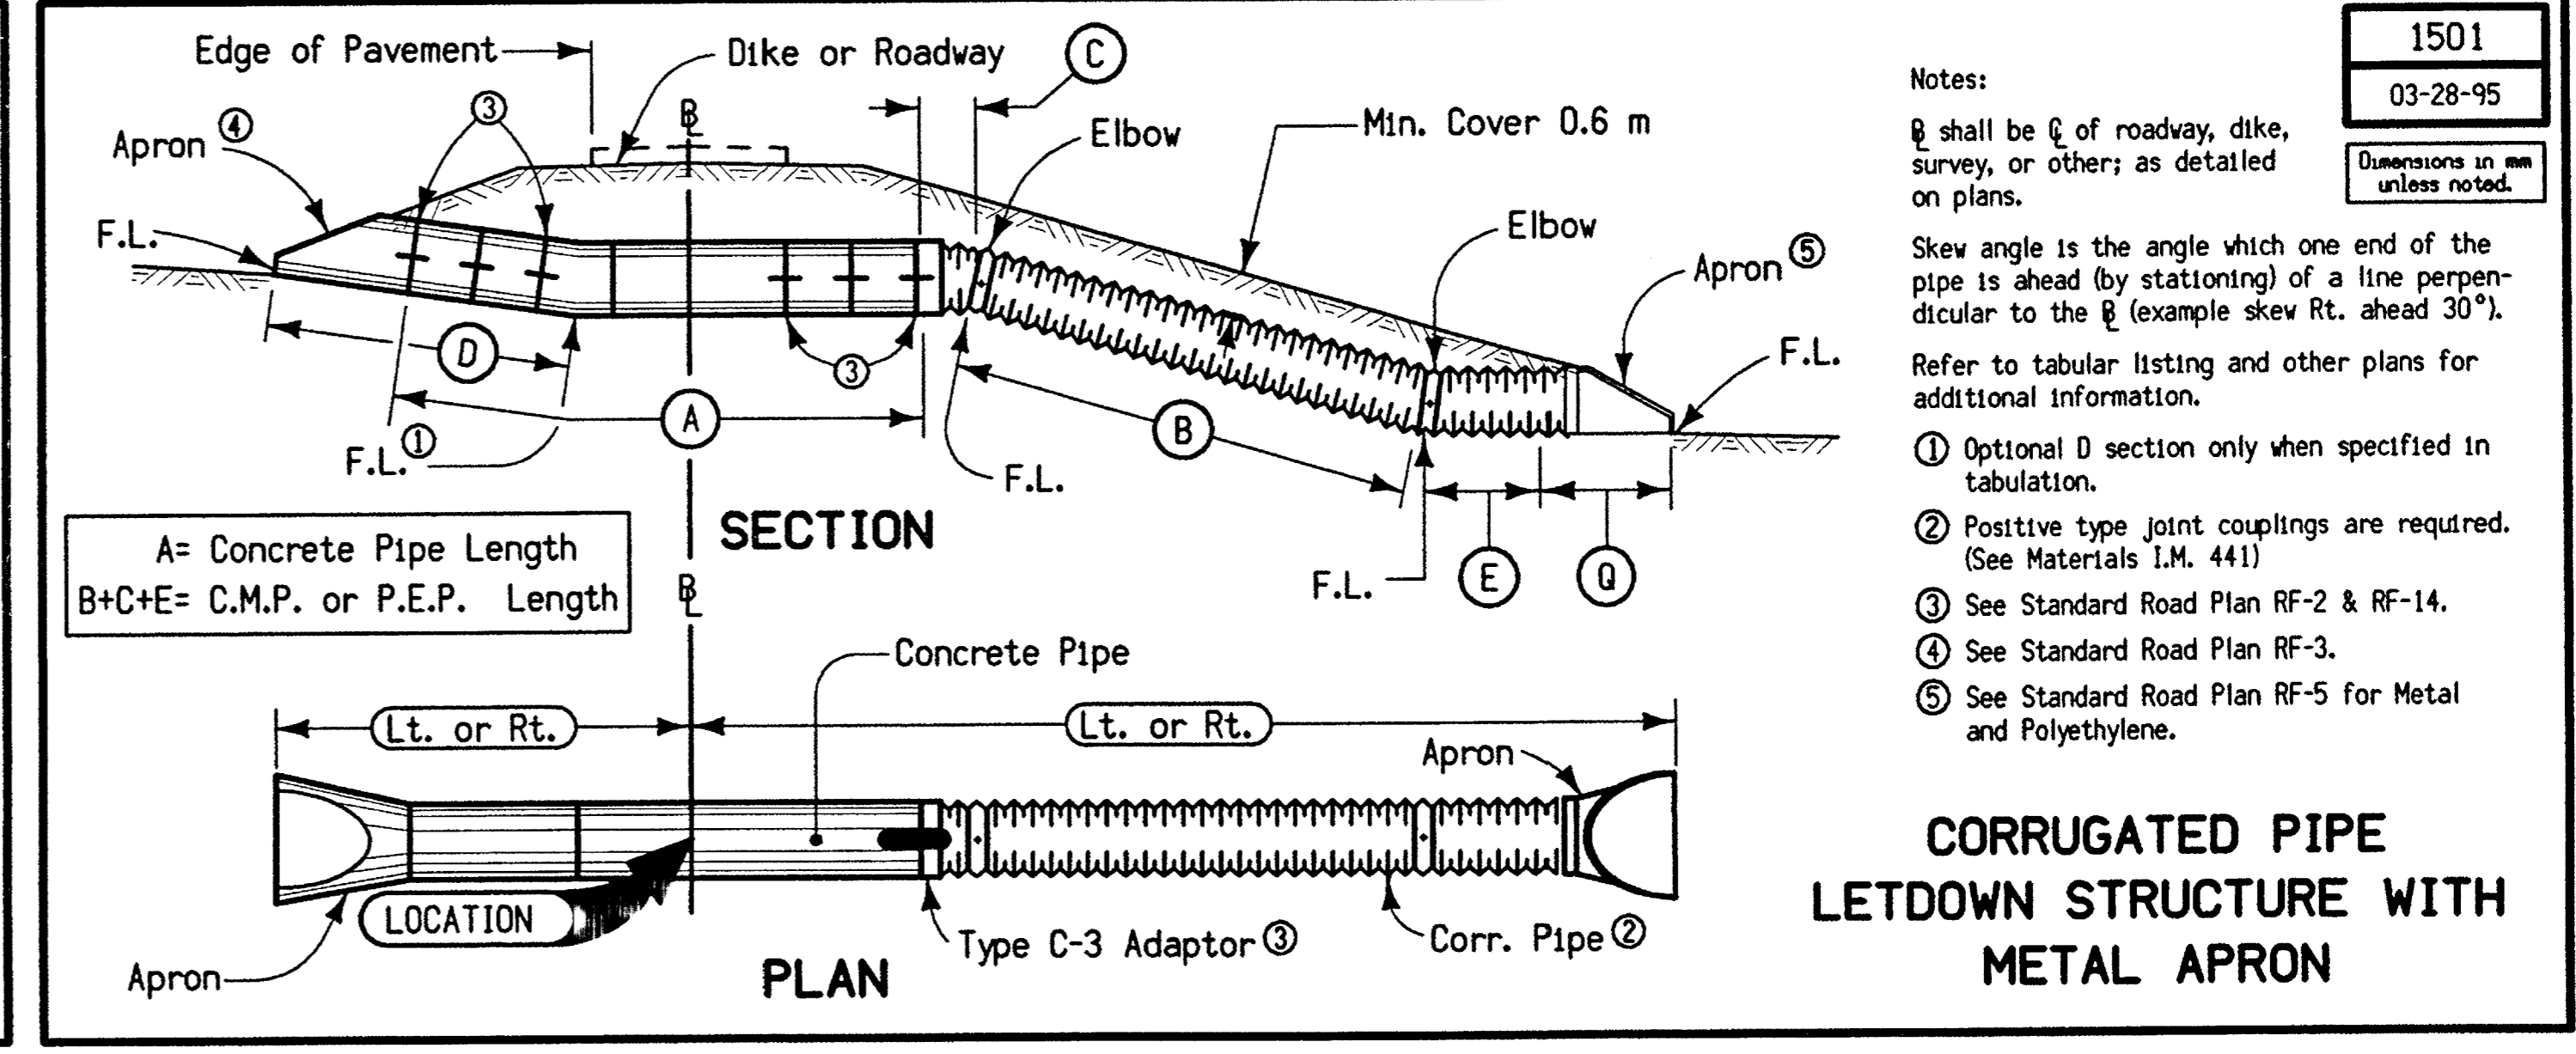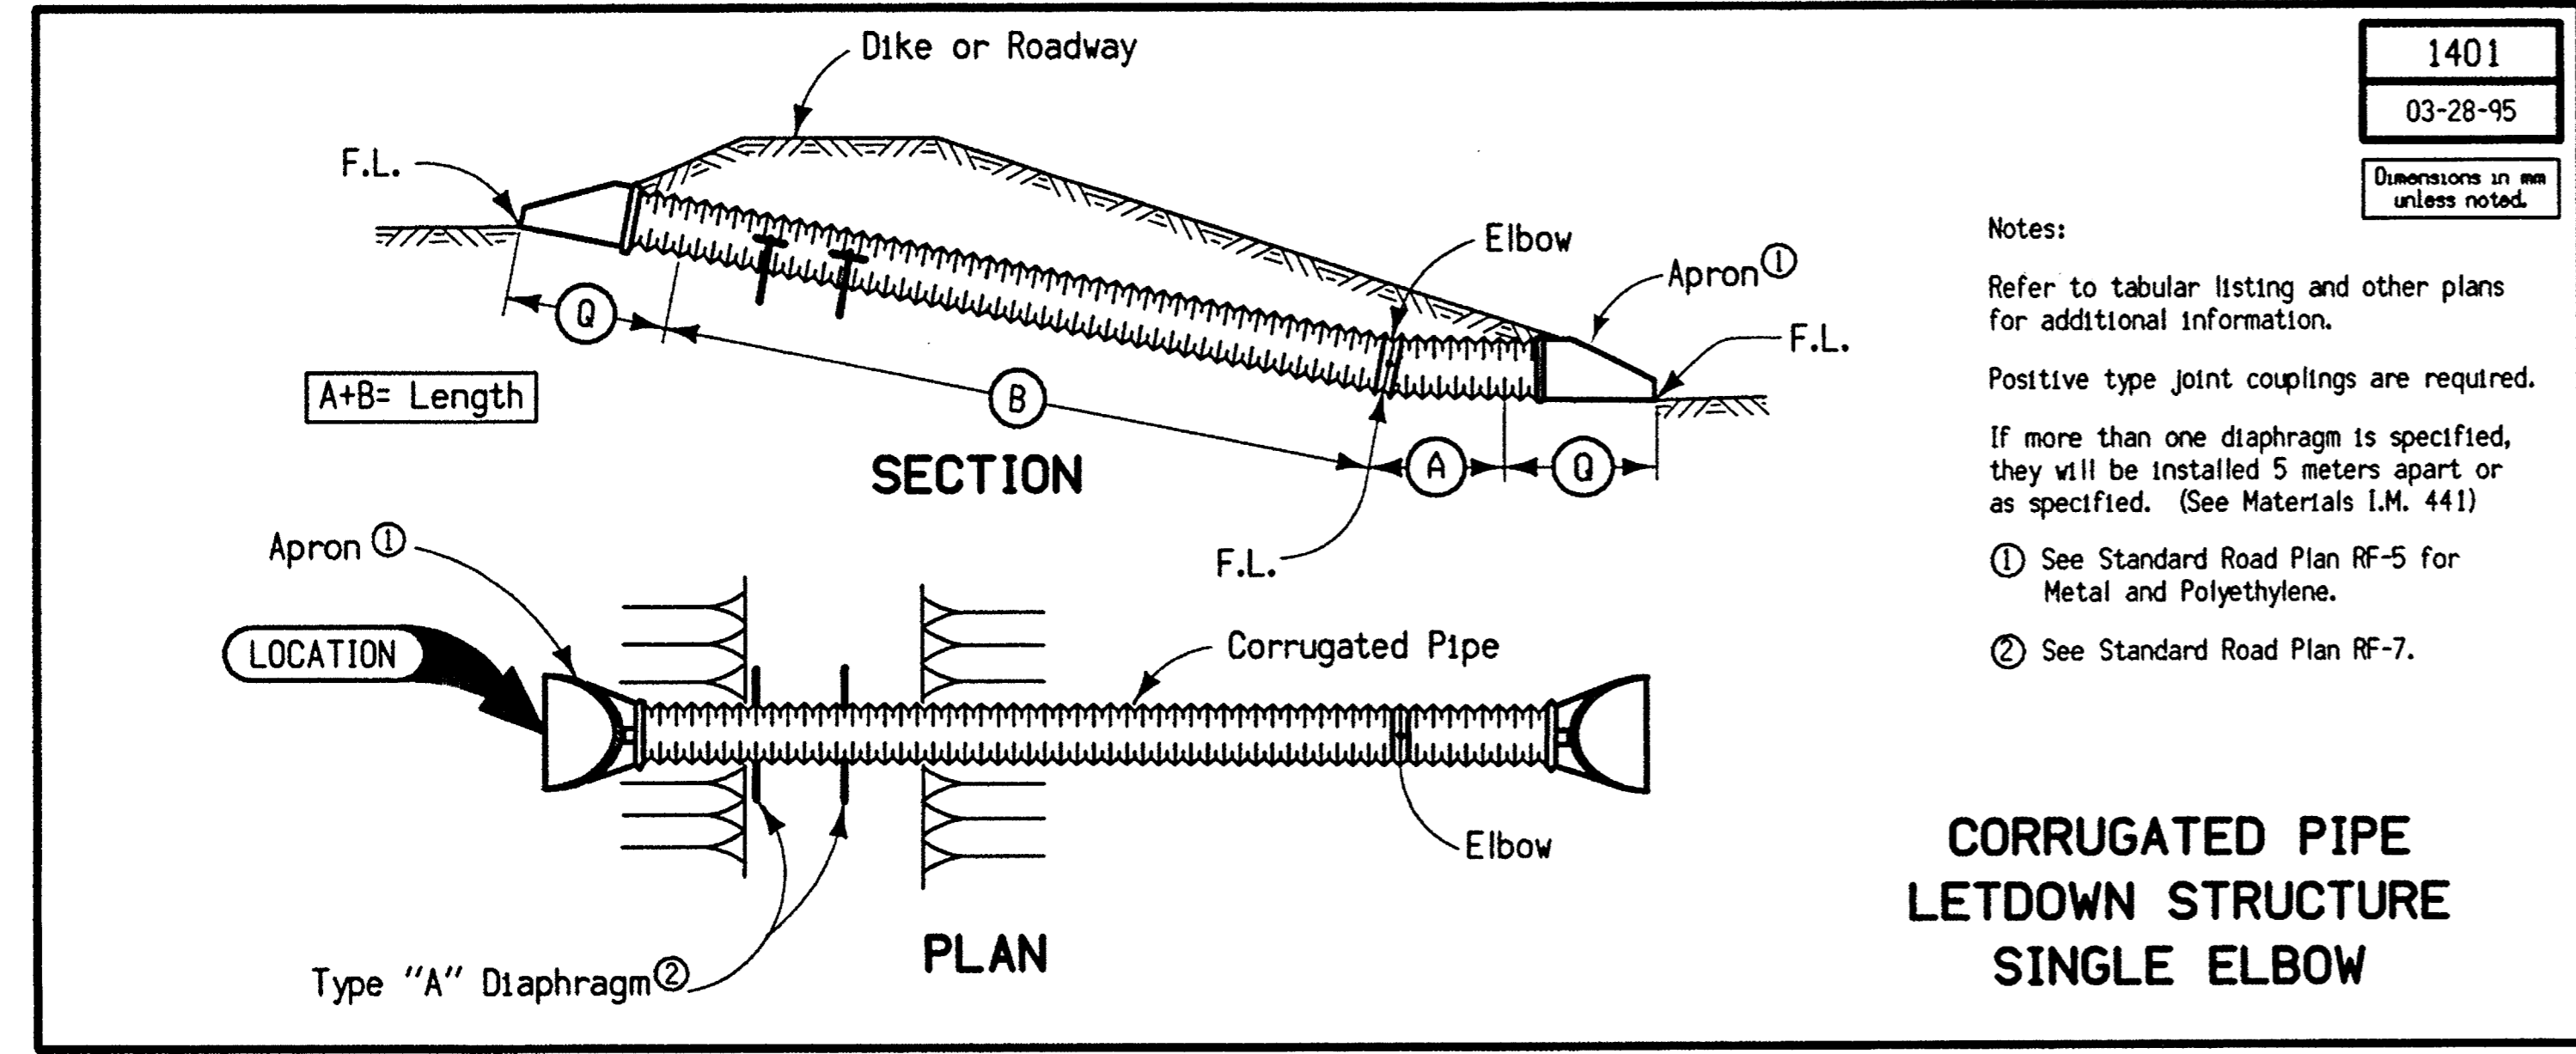






dgm = L:\WORK\PROJECT\34120\CADD\YEAS\153151063.b05
 prf = \\WATSON\DATA\PILOT\PL463P\B07.PRF
 date = Fri Sep 17 10:08:10 1999

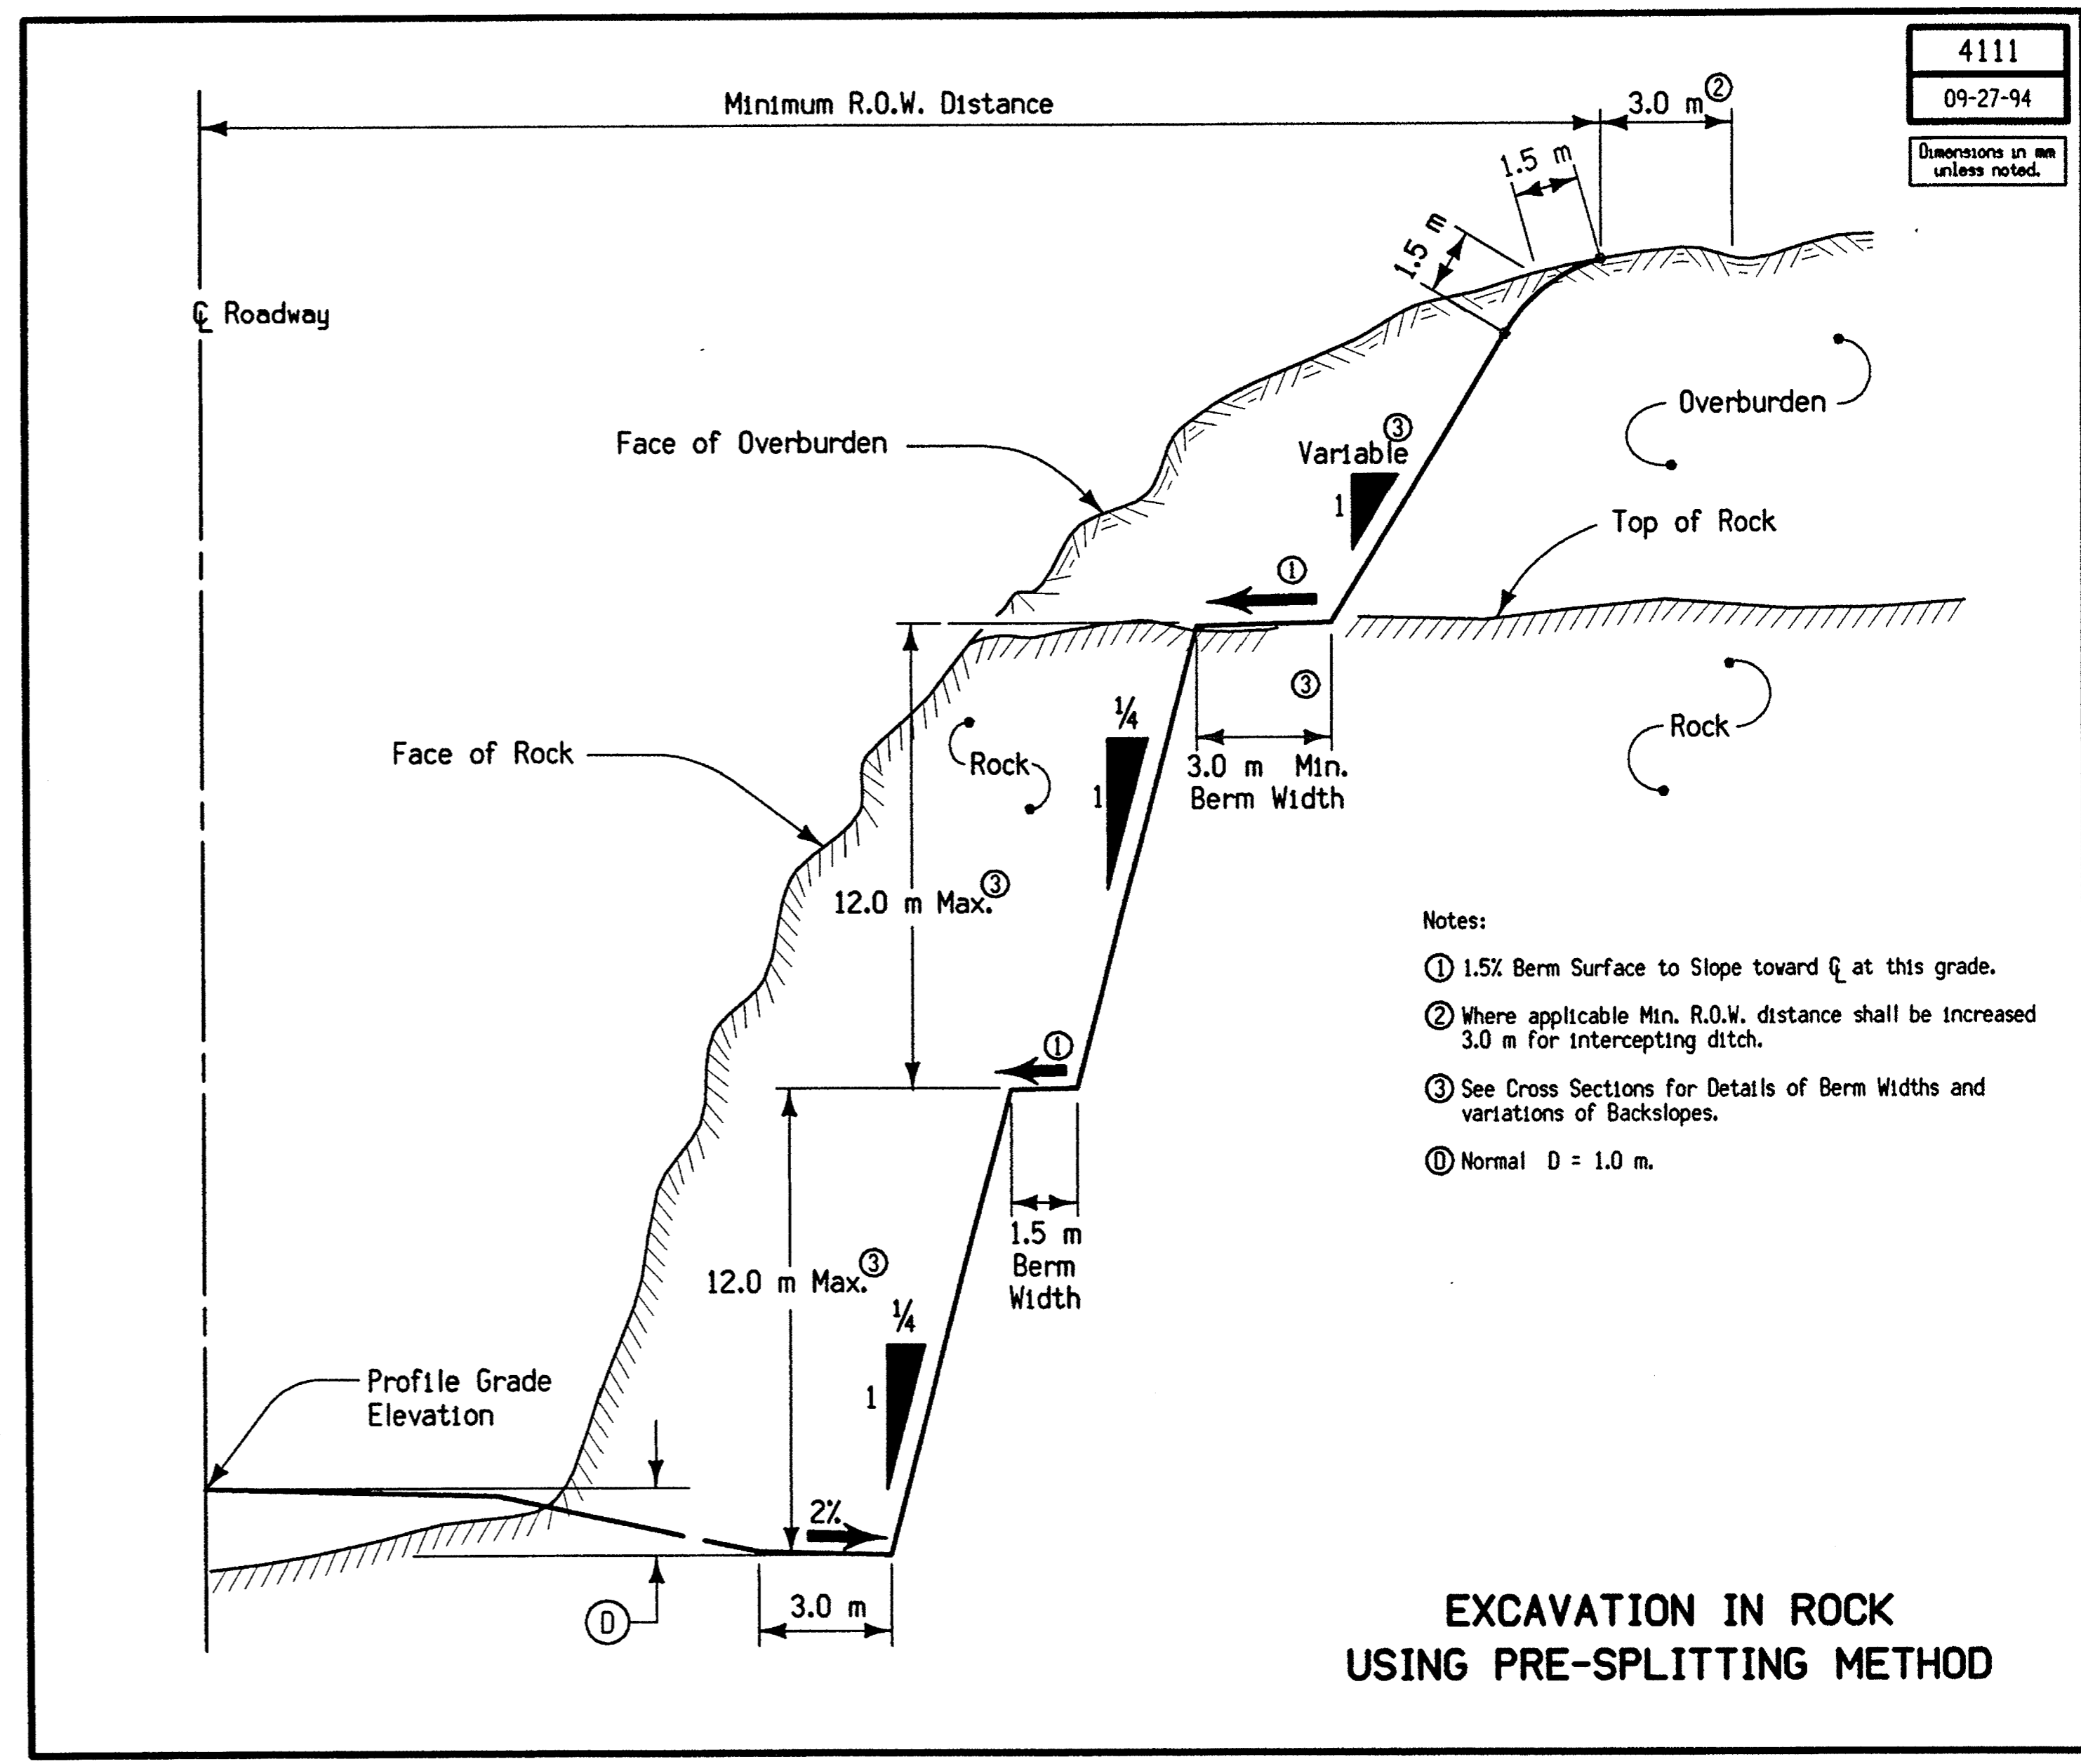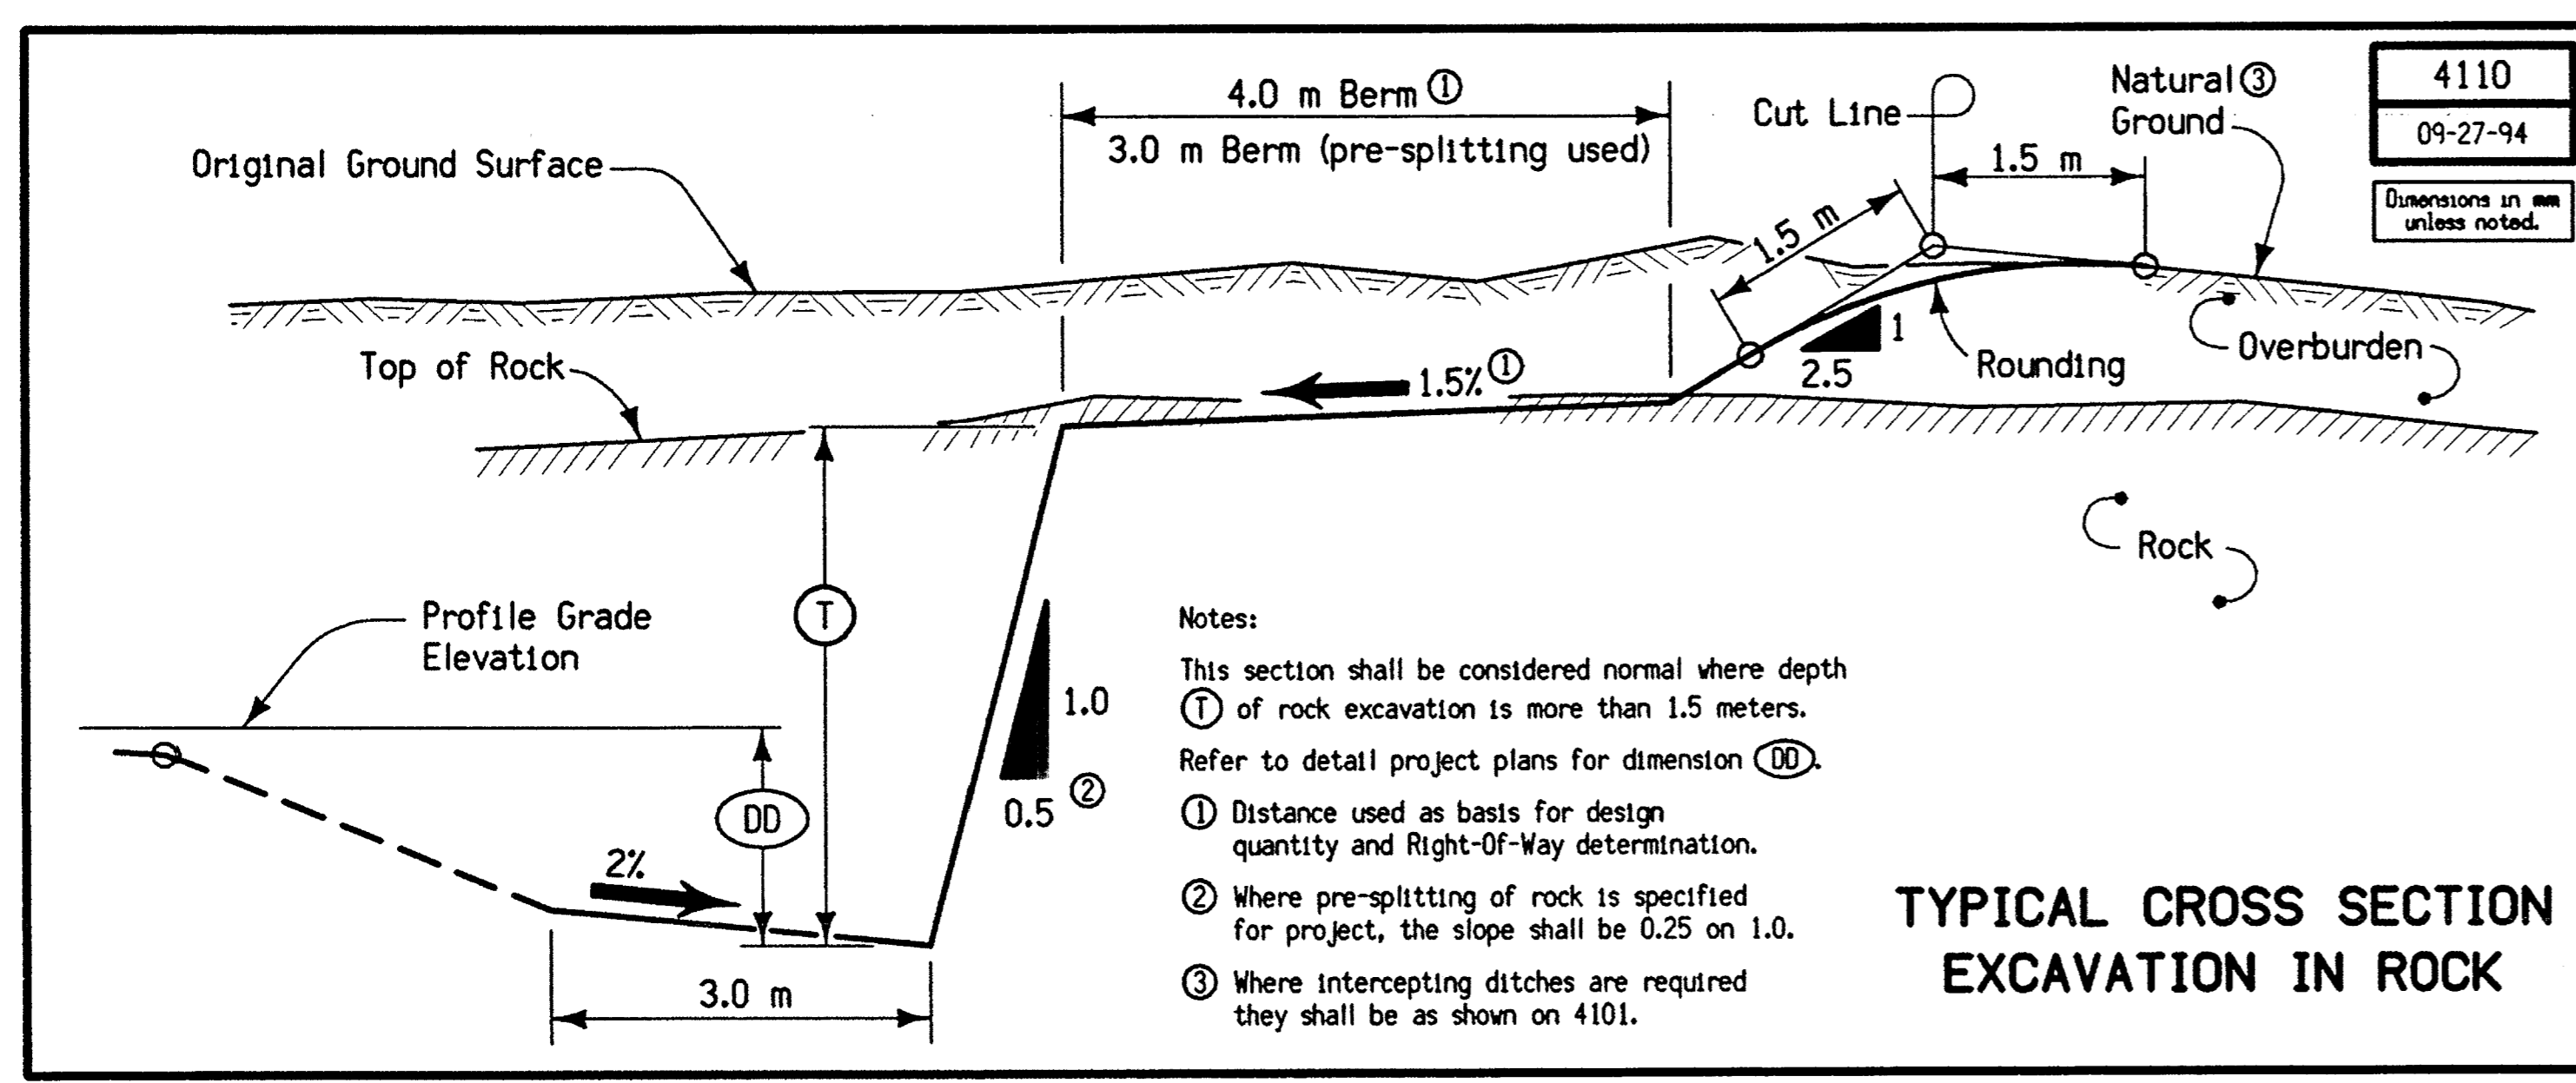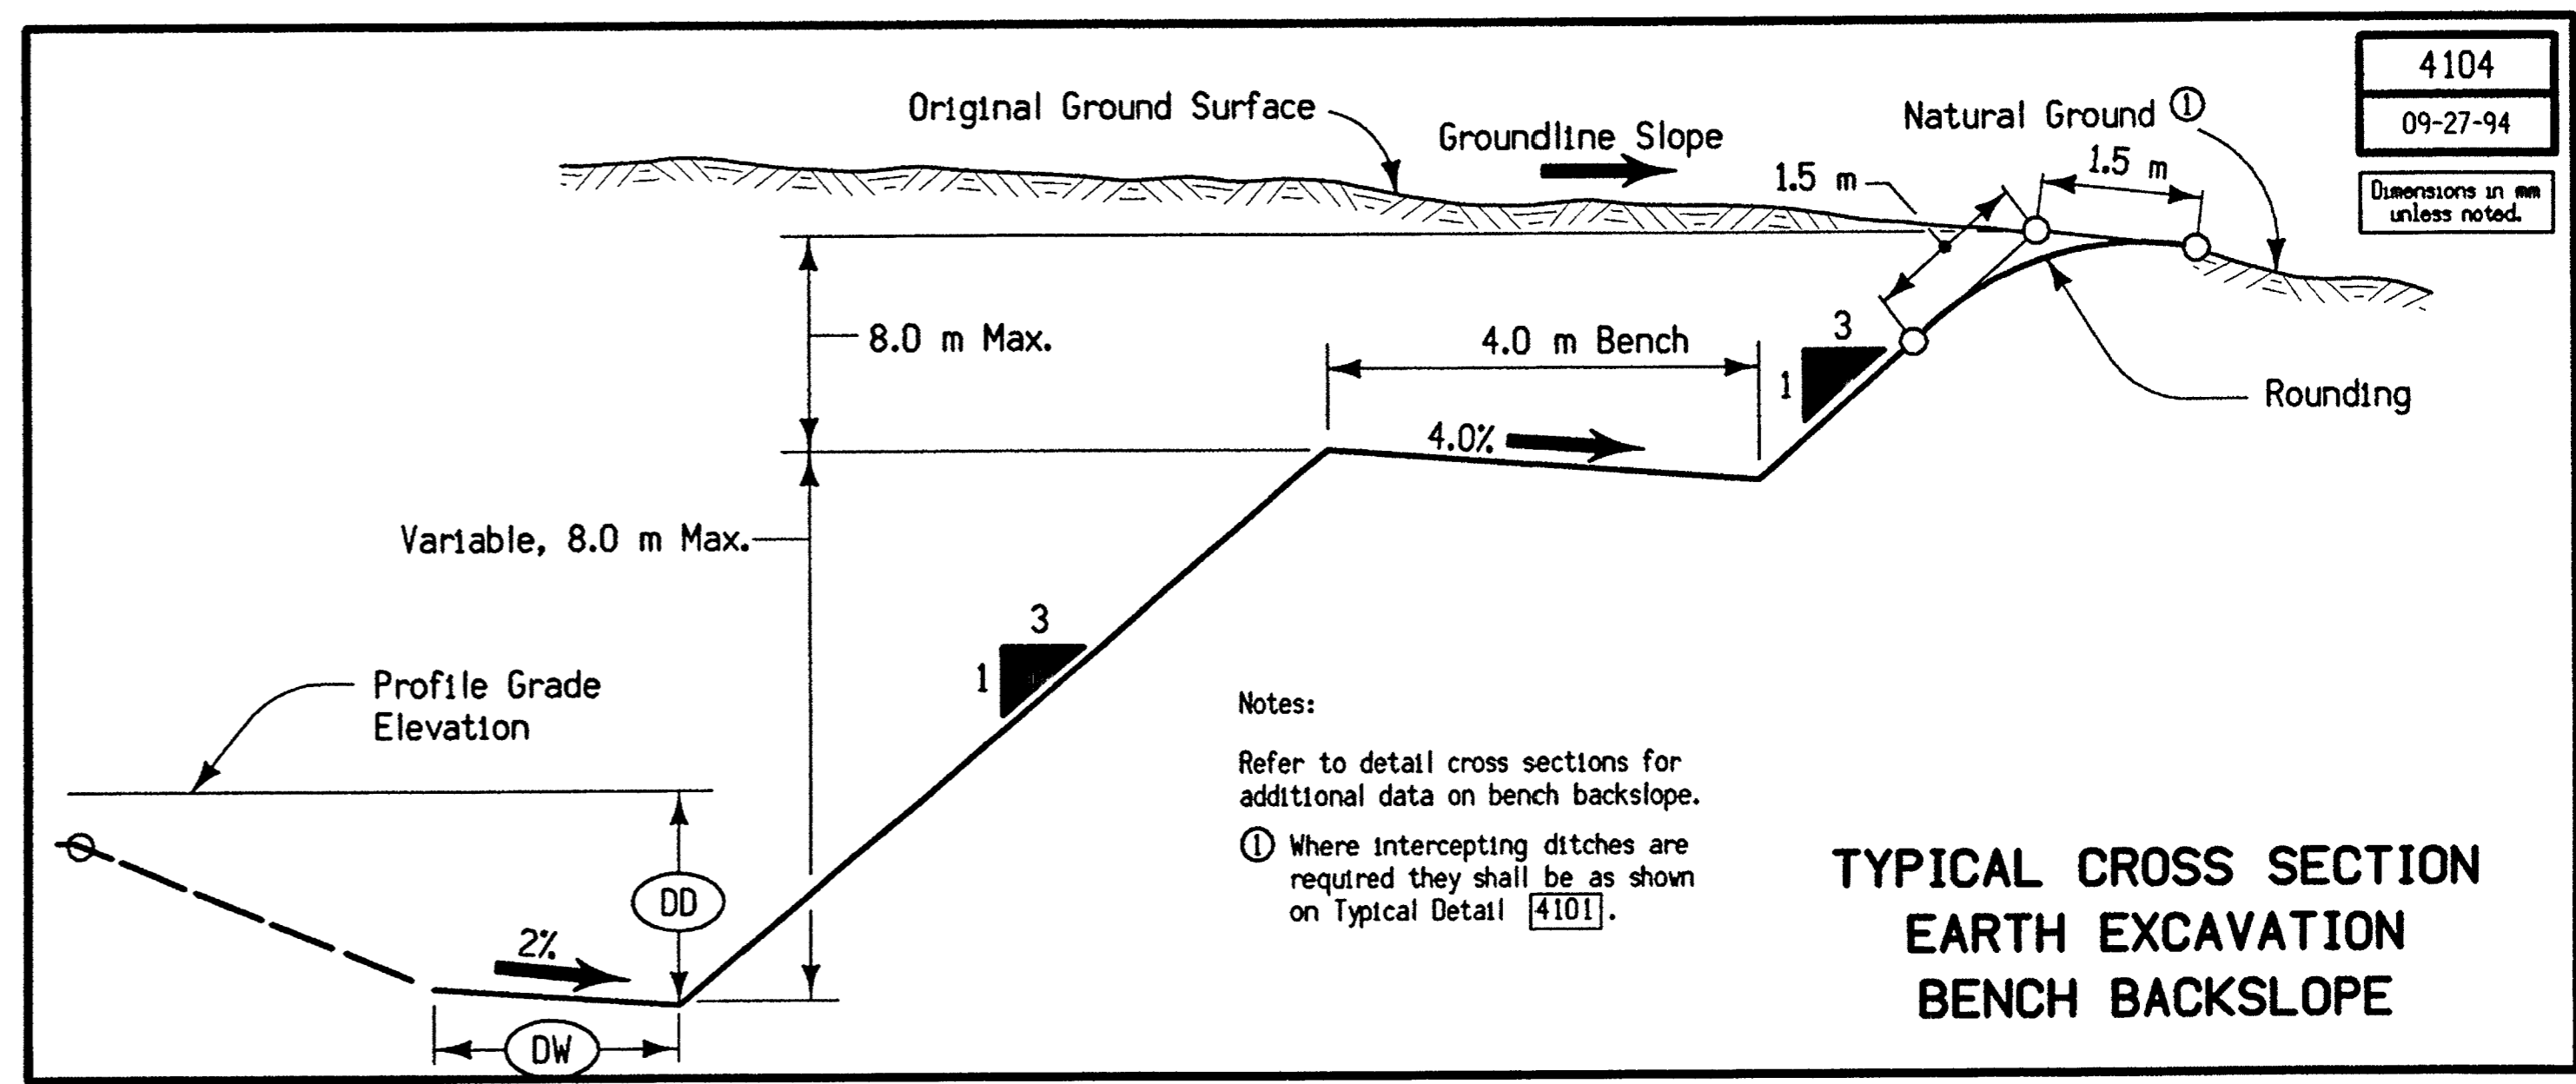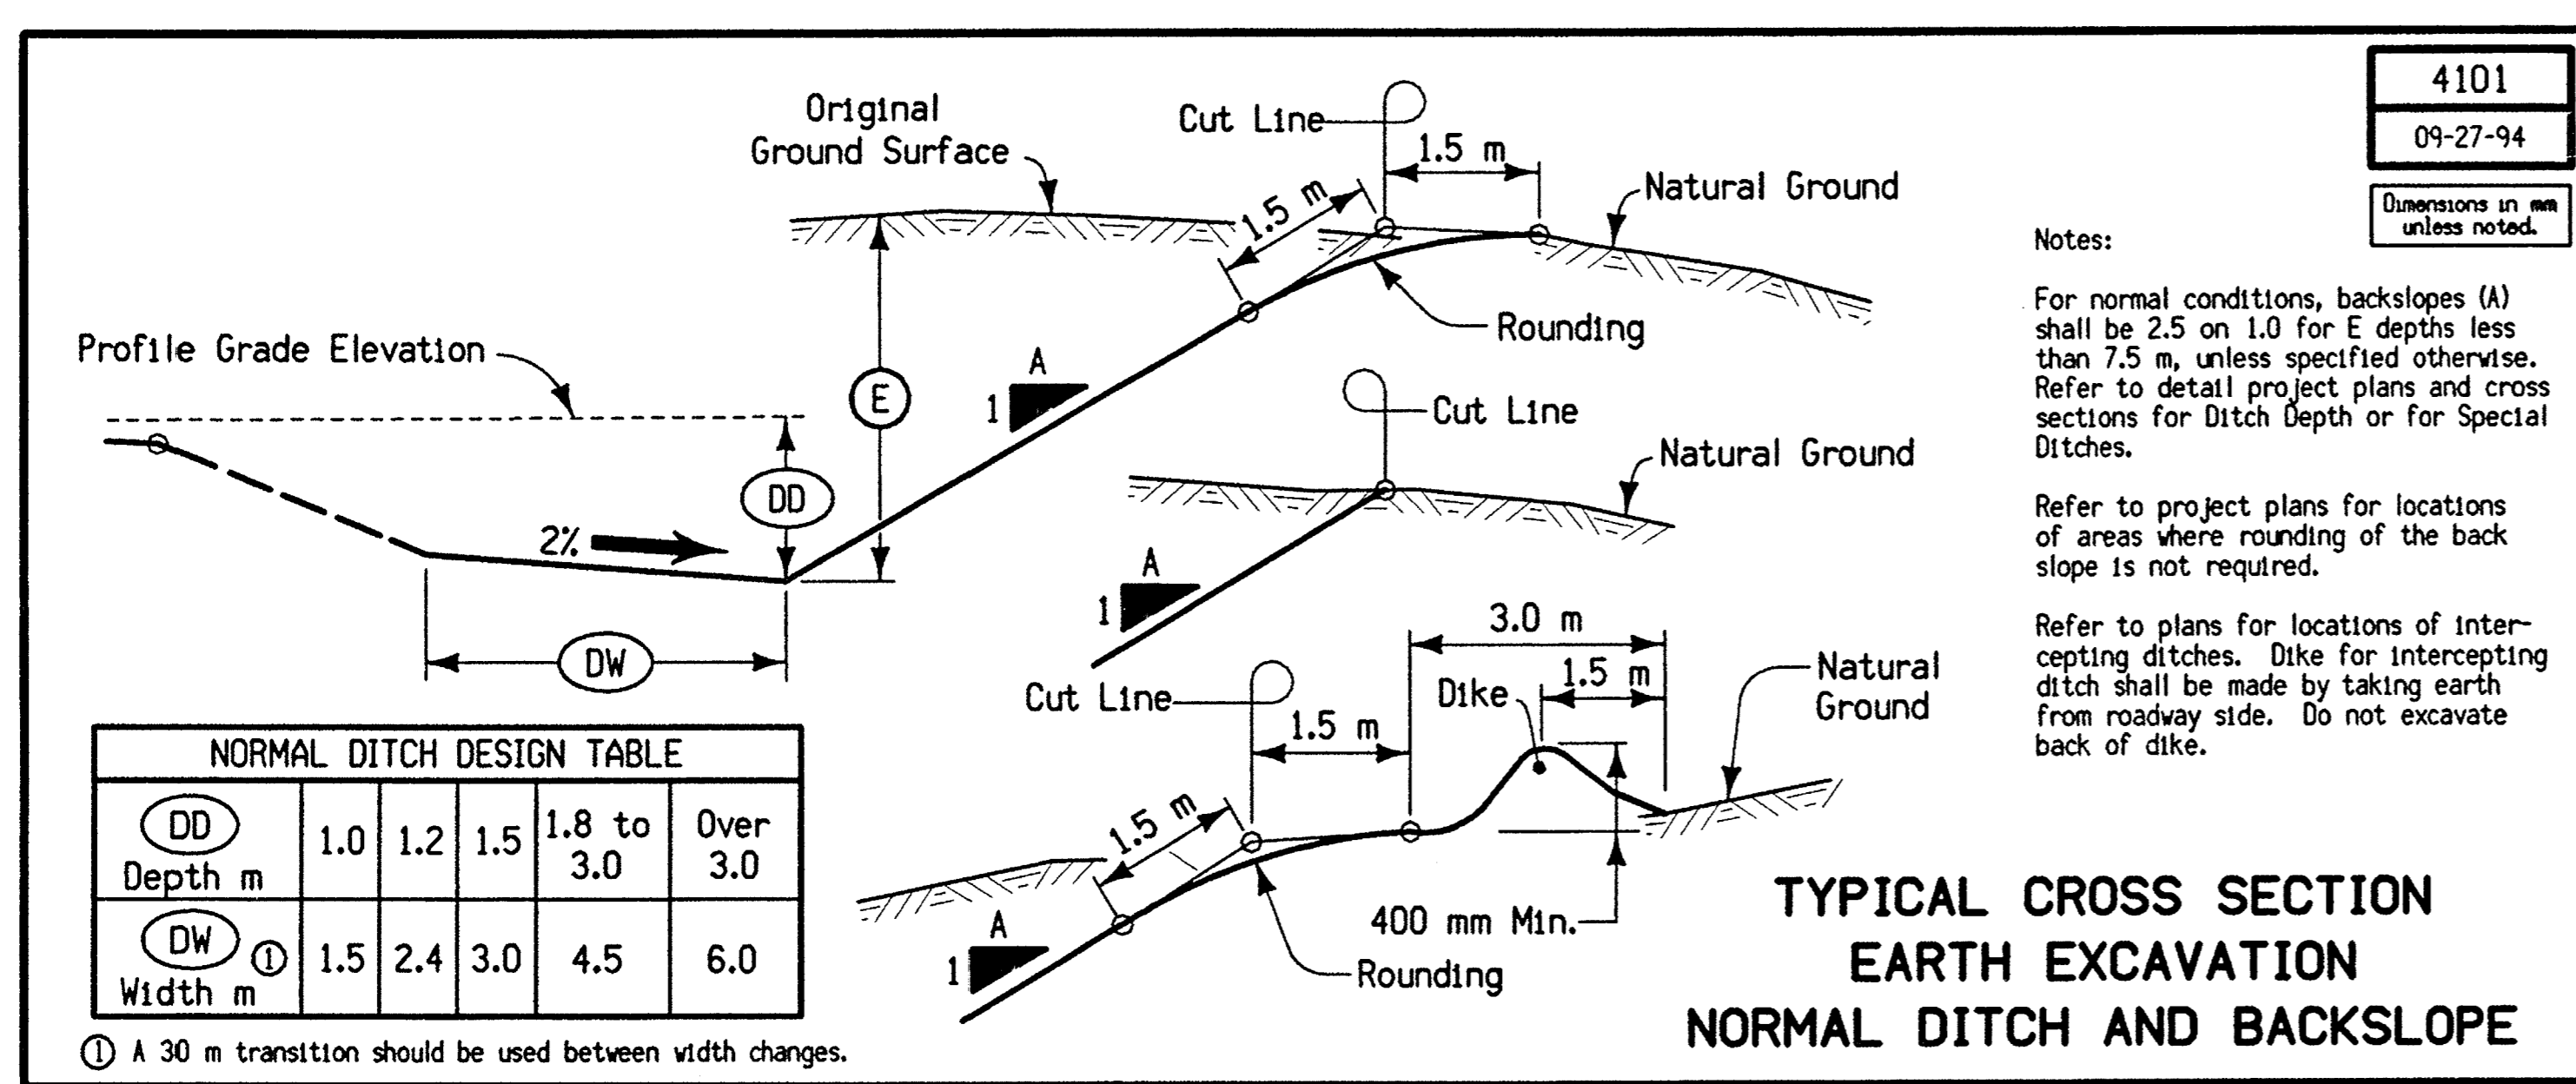

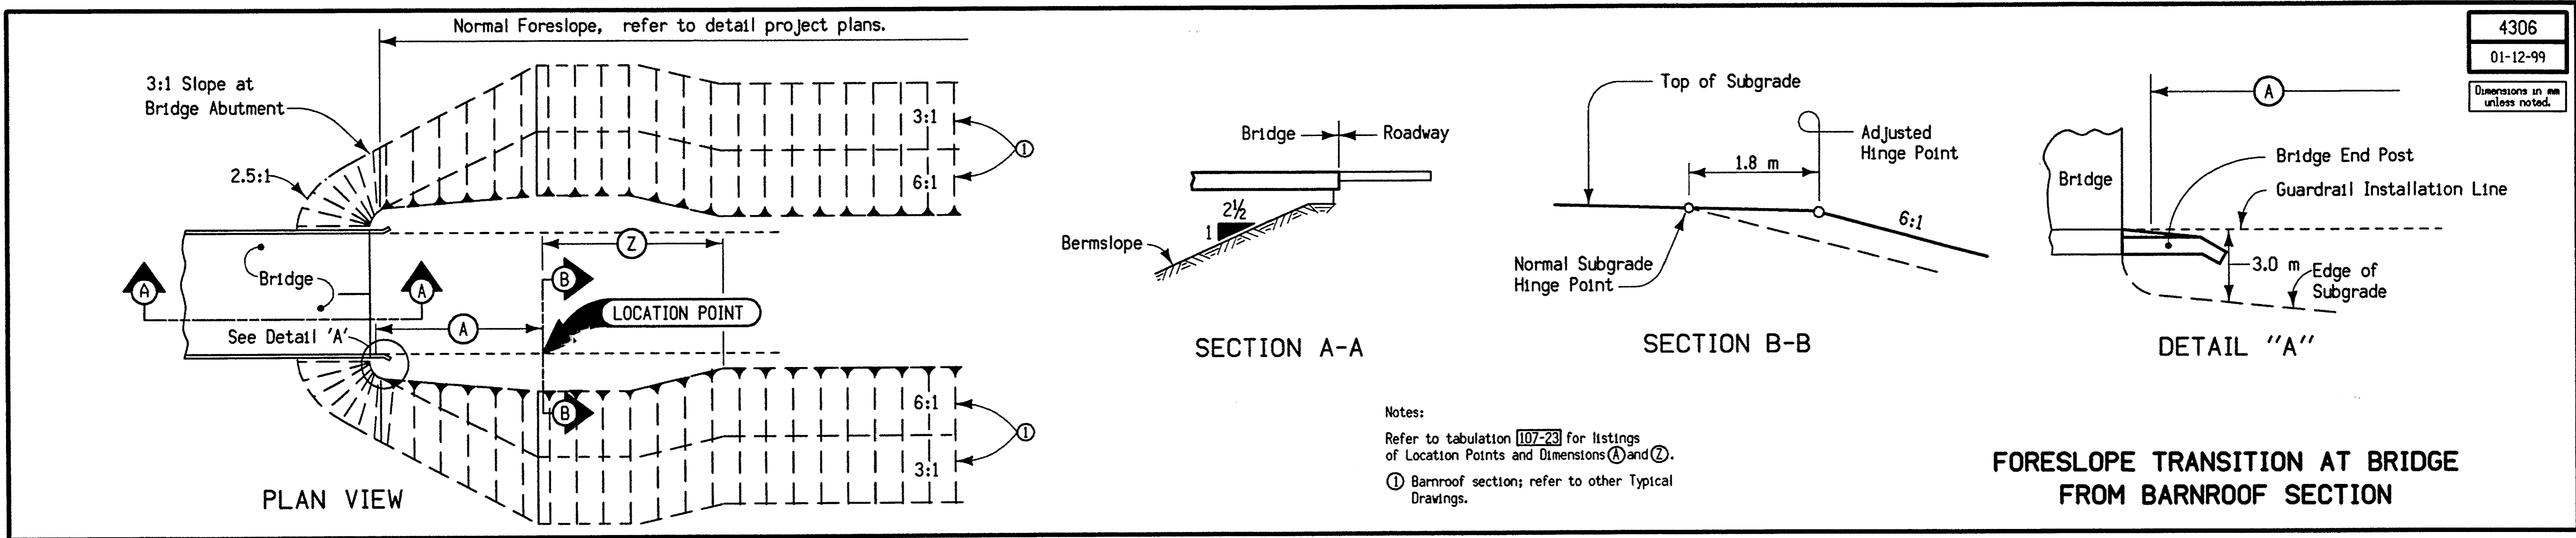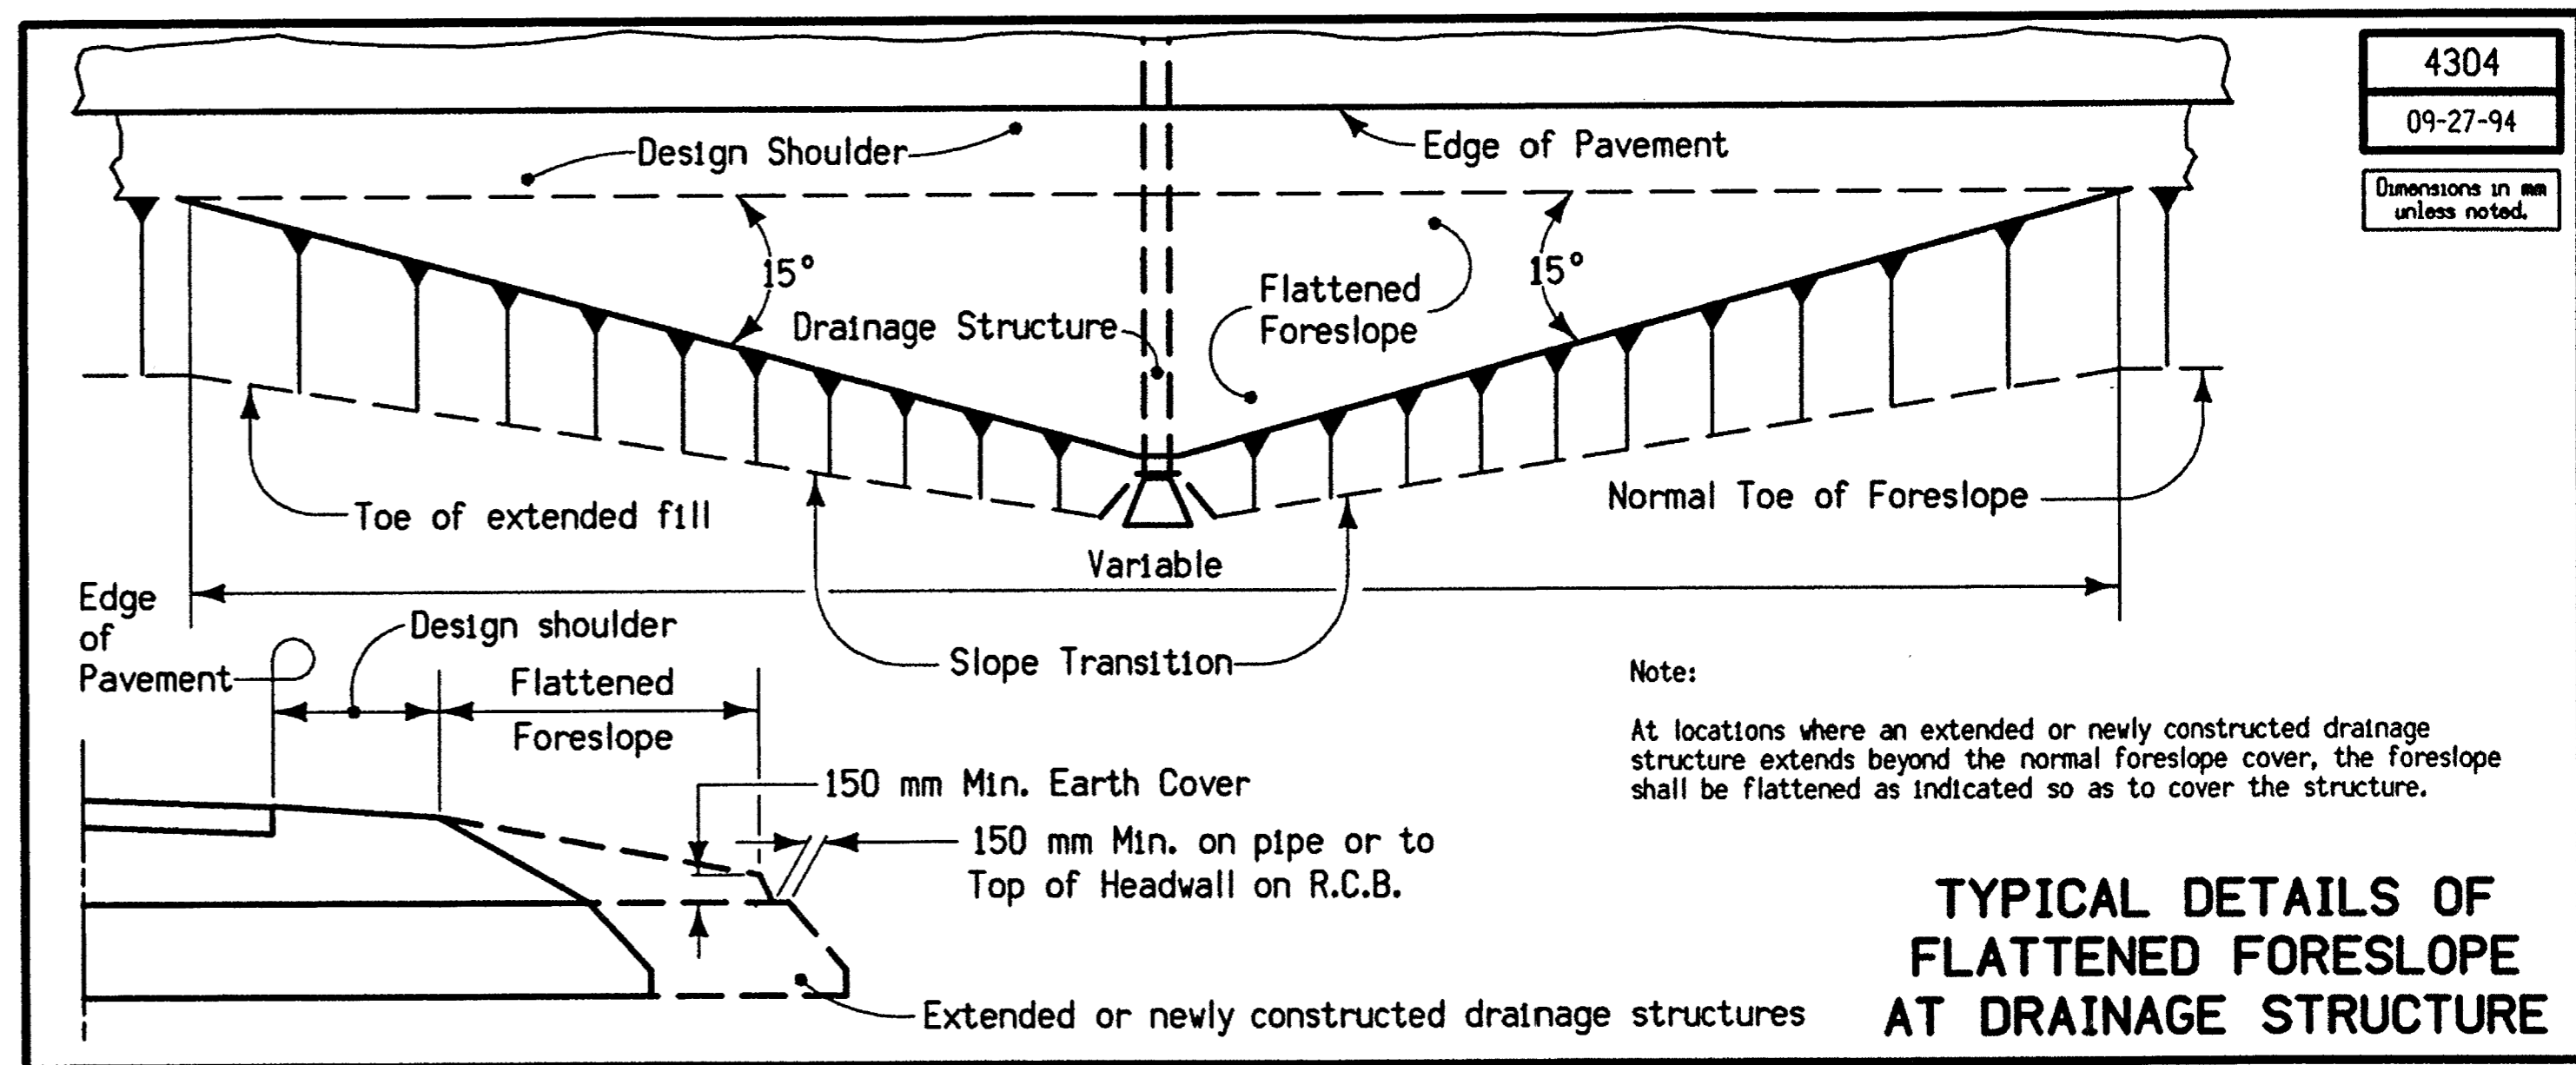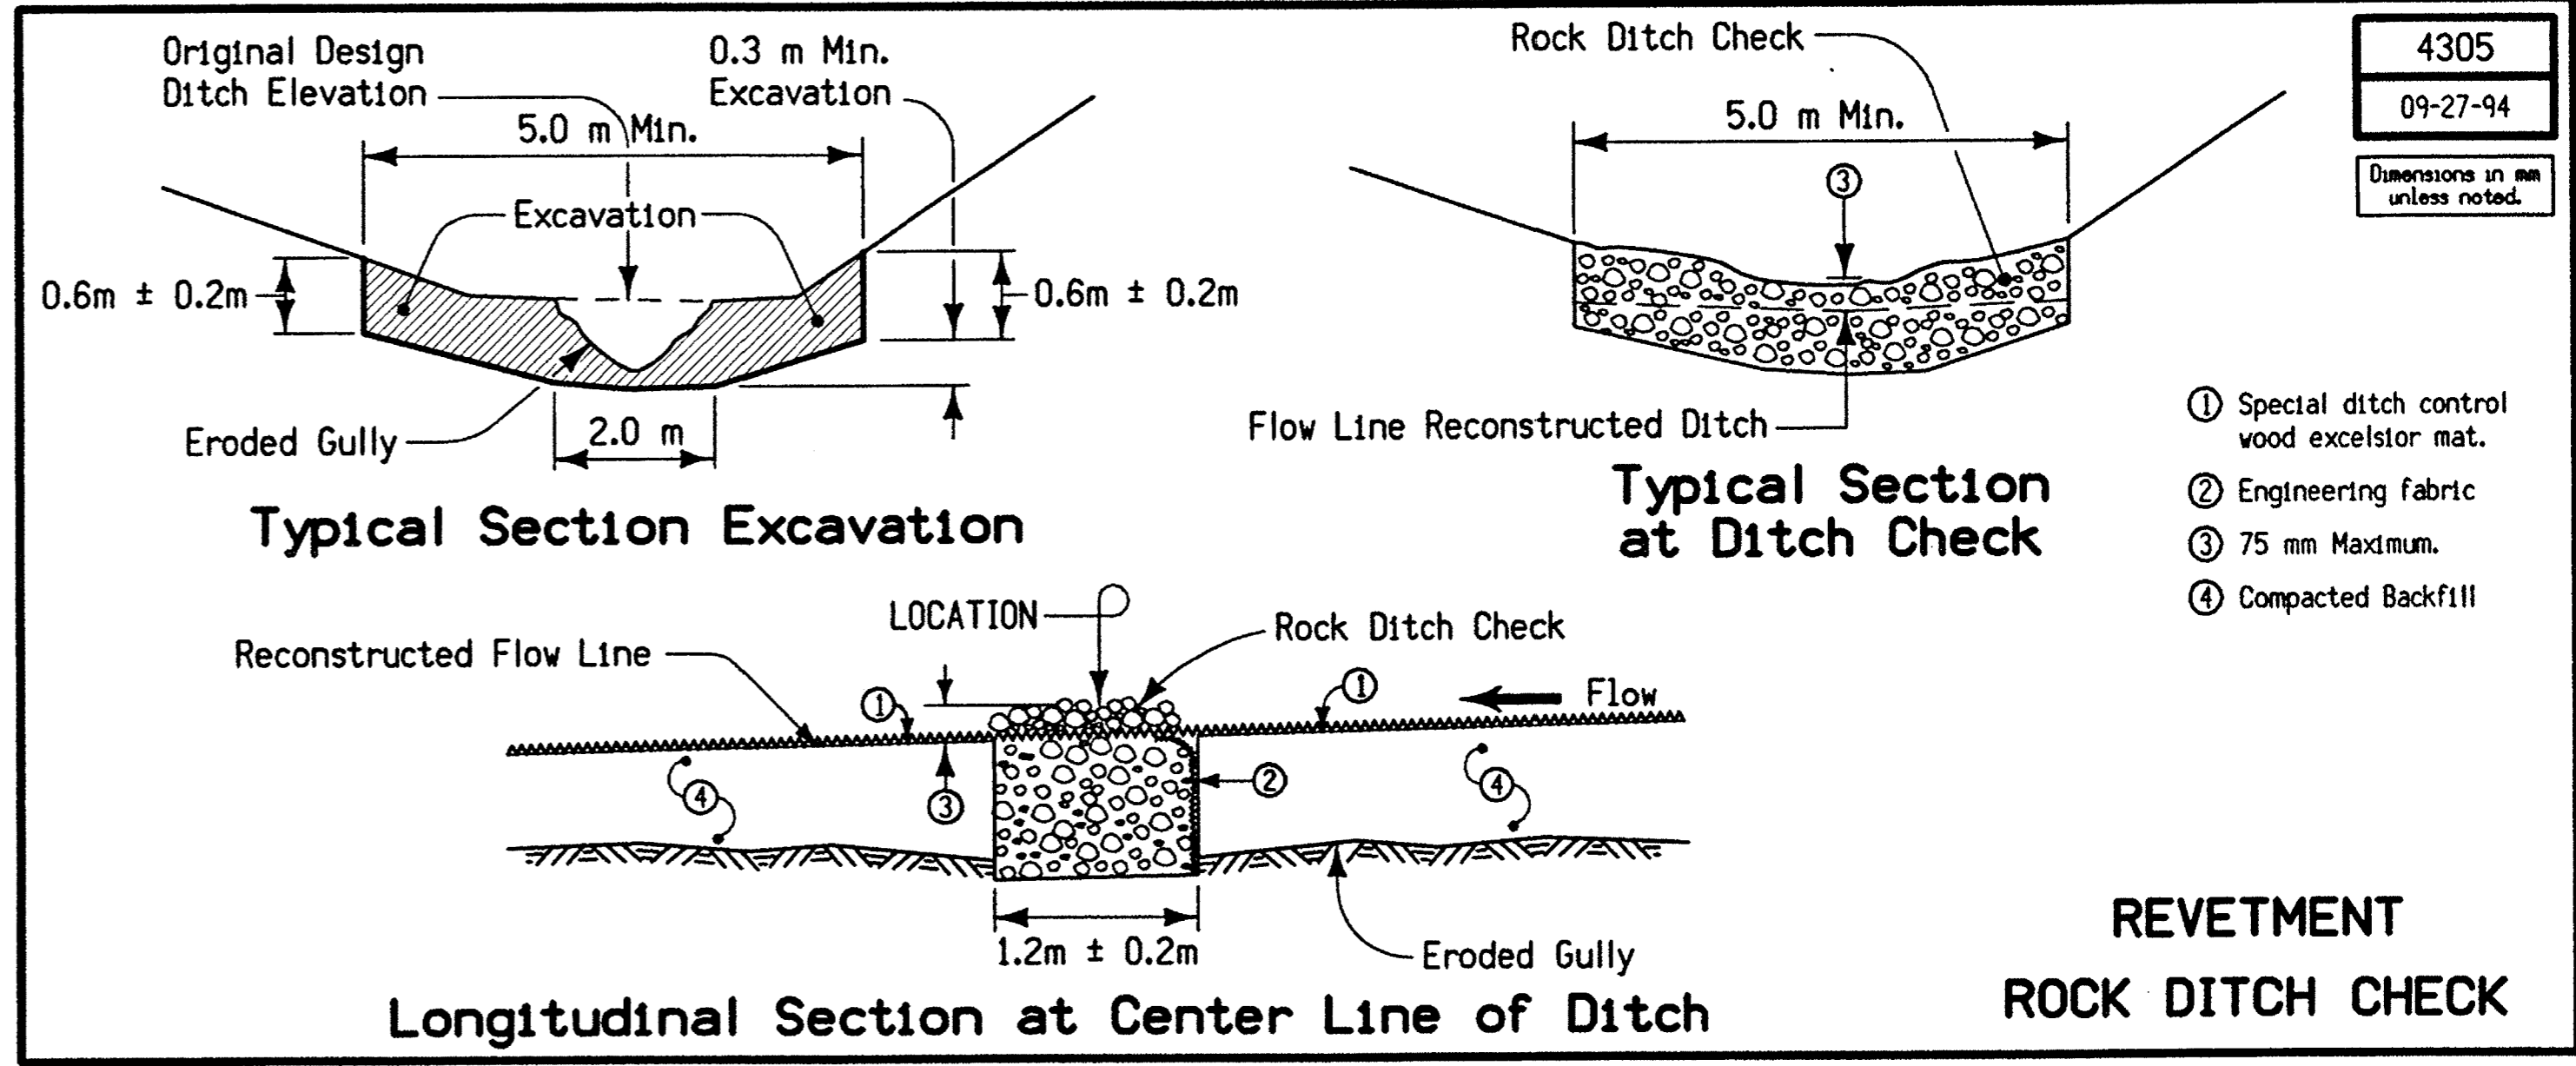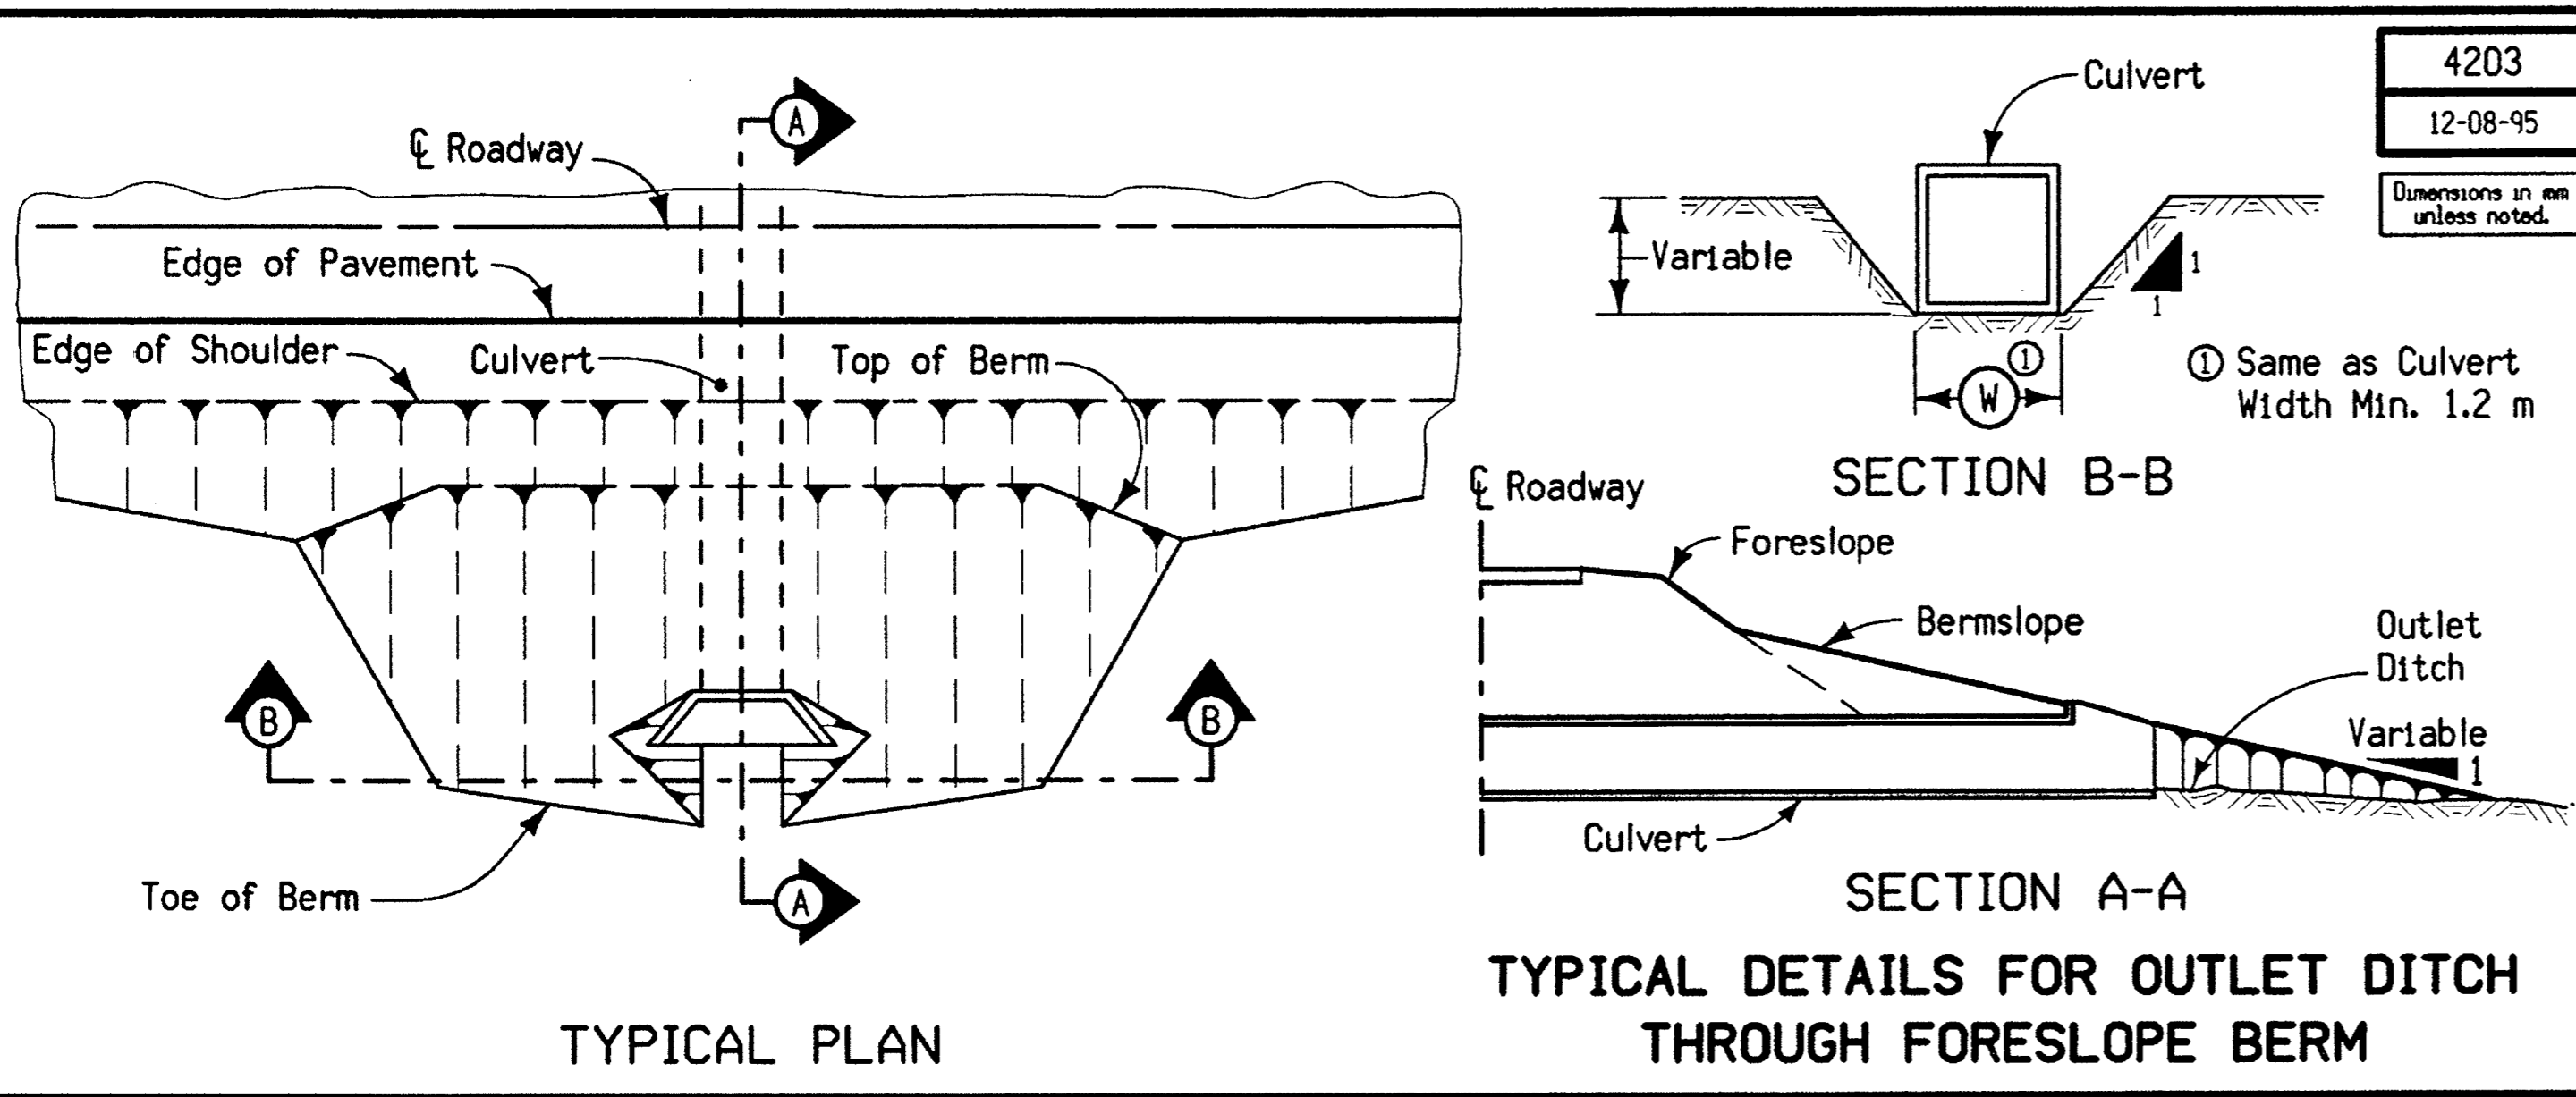


dgn = L:\WORK\PROJECTS\134120\CAD\DWG\AS\153151063.b05
 prf = L:\WORK\PROJECTS\134120\CAD\DWG\AS\153151063.b05
 date = Fri Sep 17 10:08:17 1999

Revised

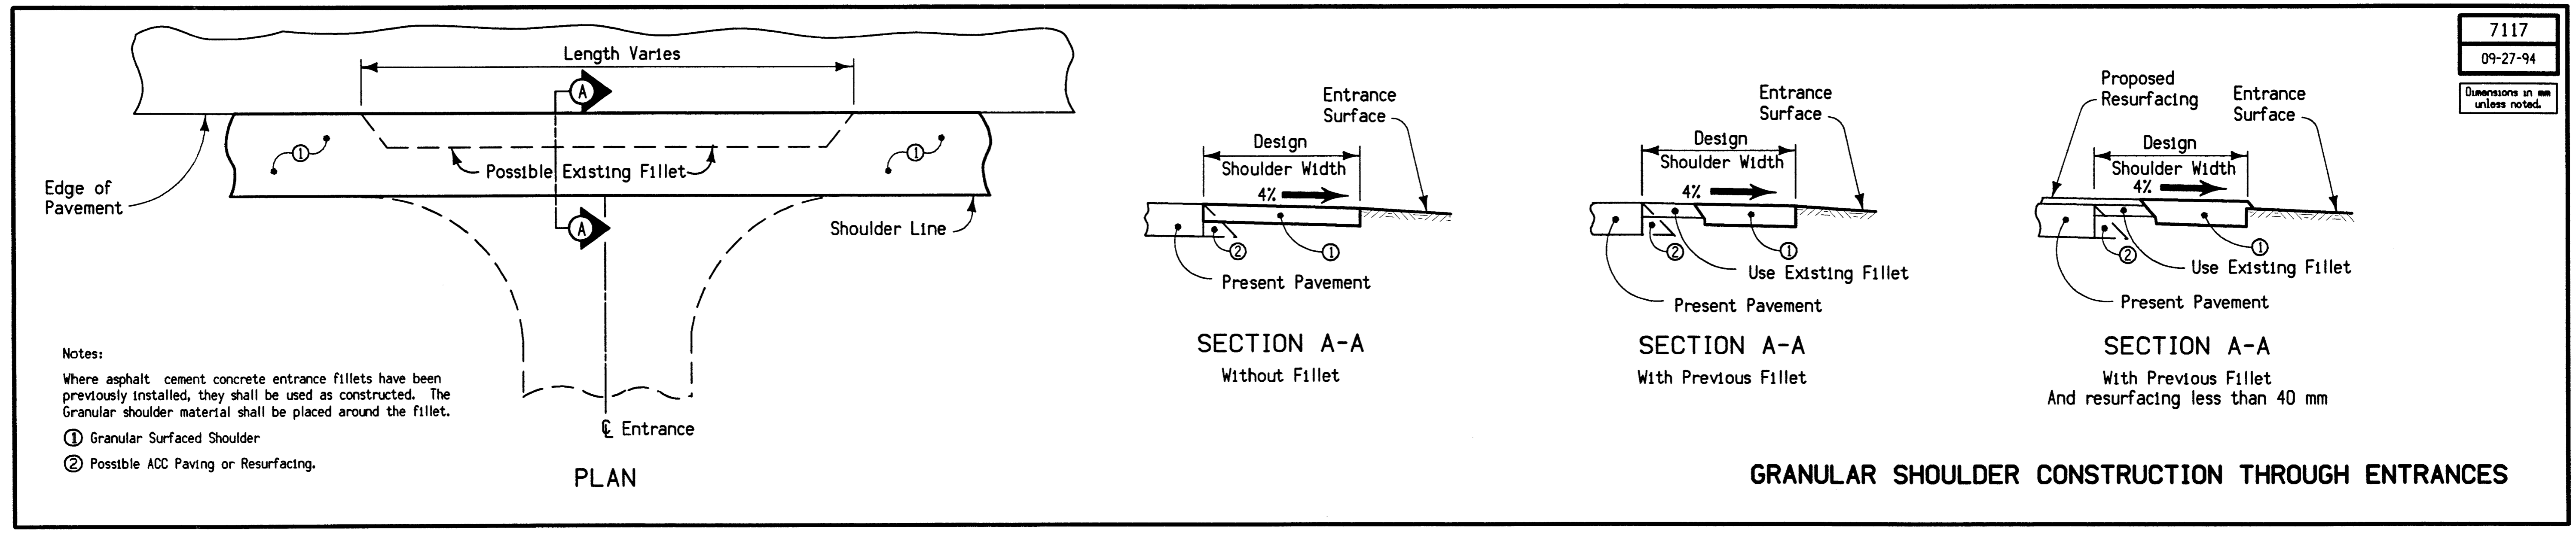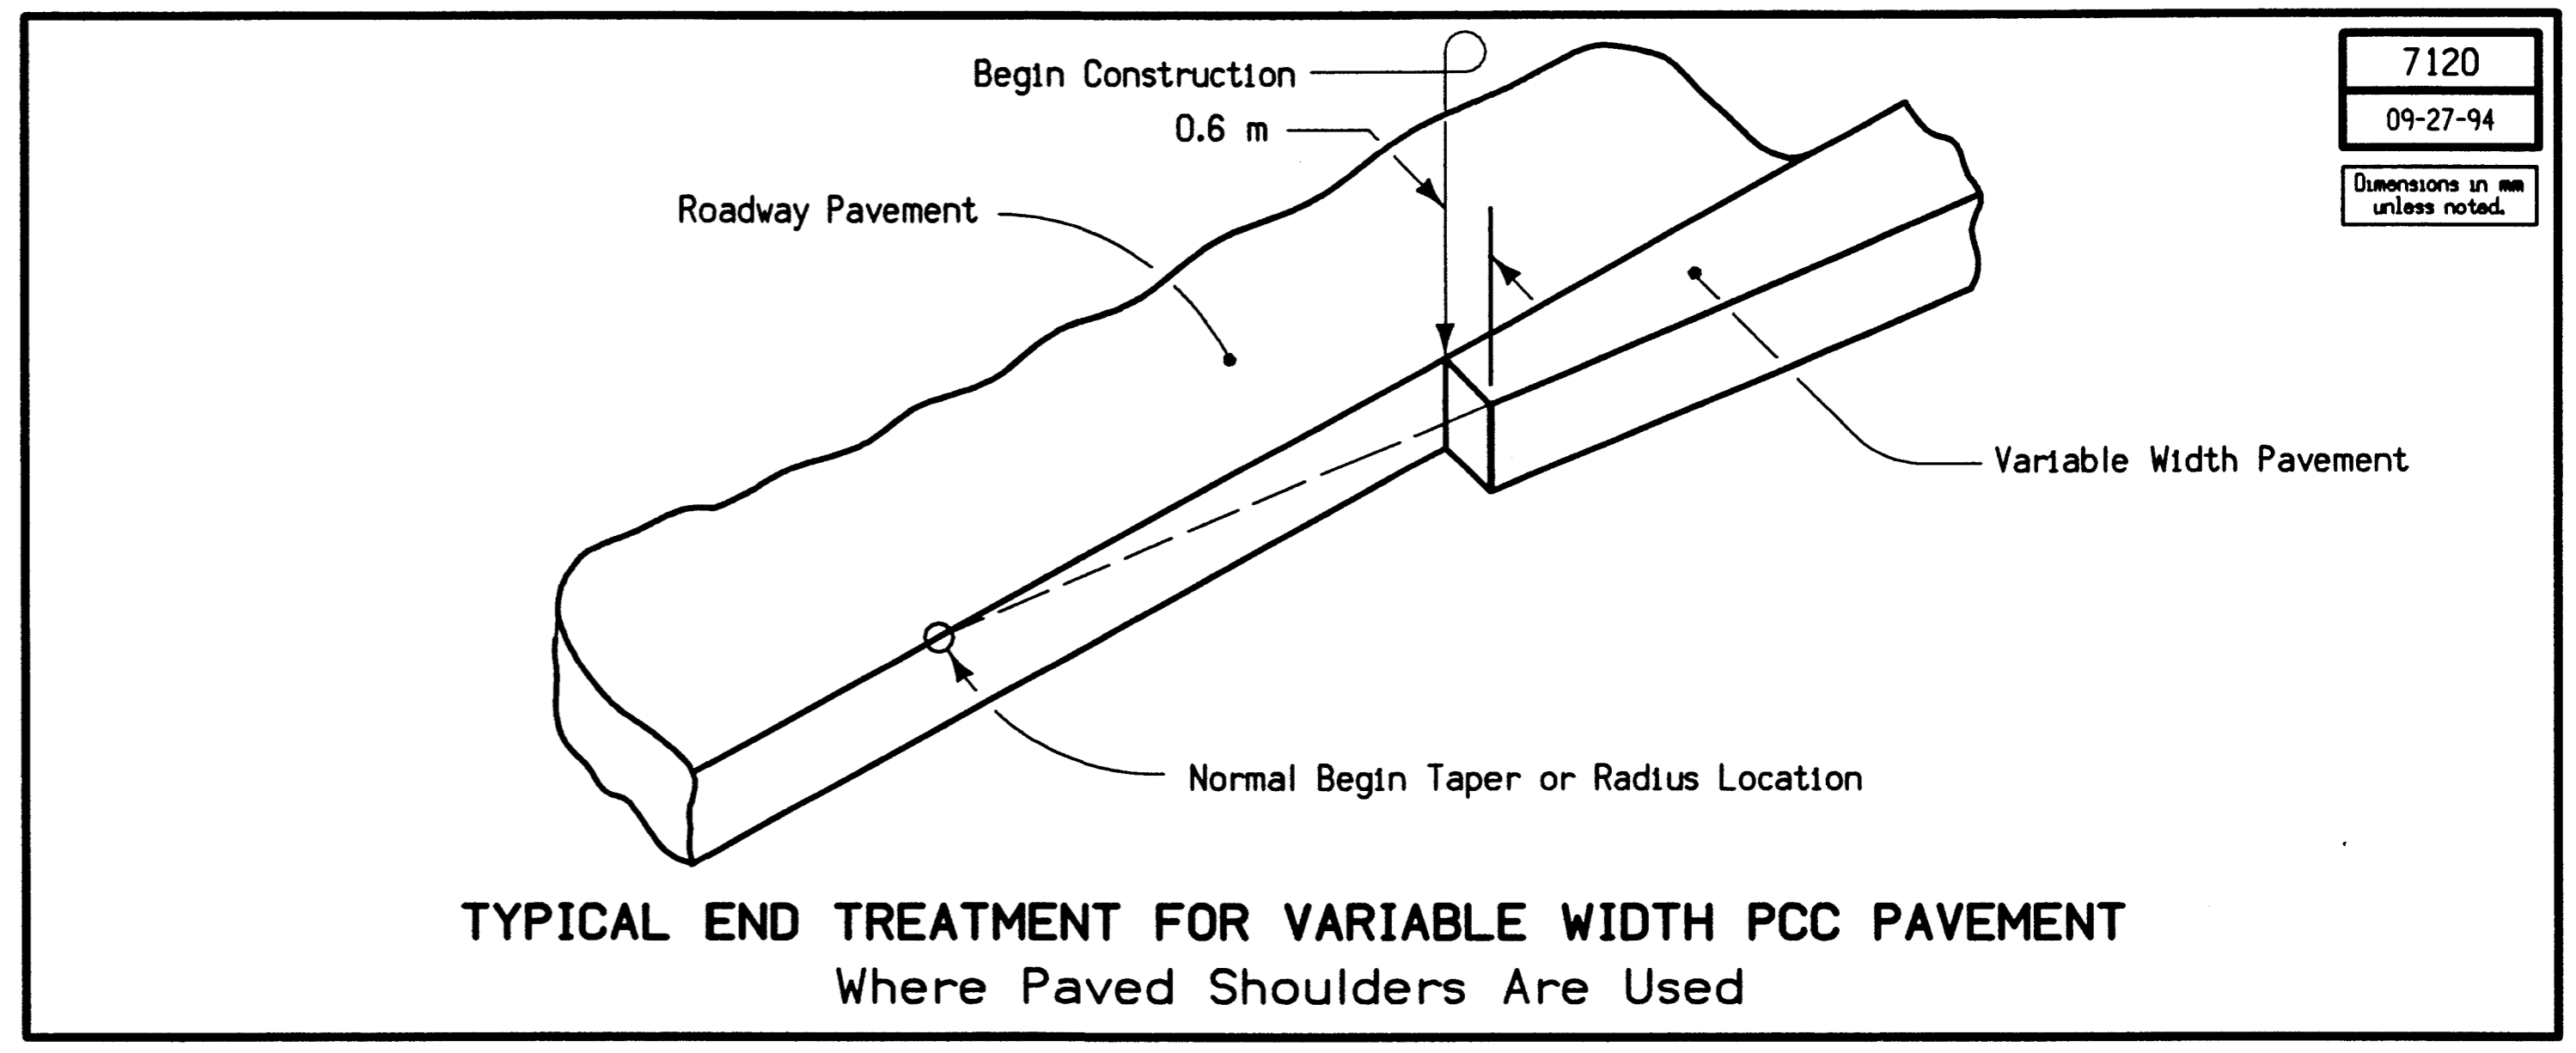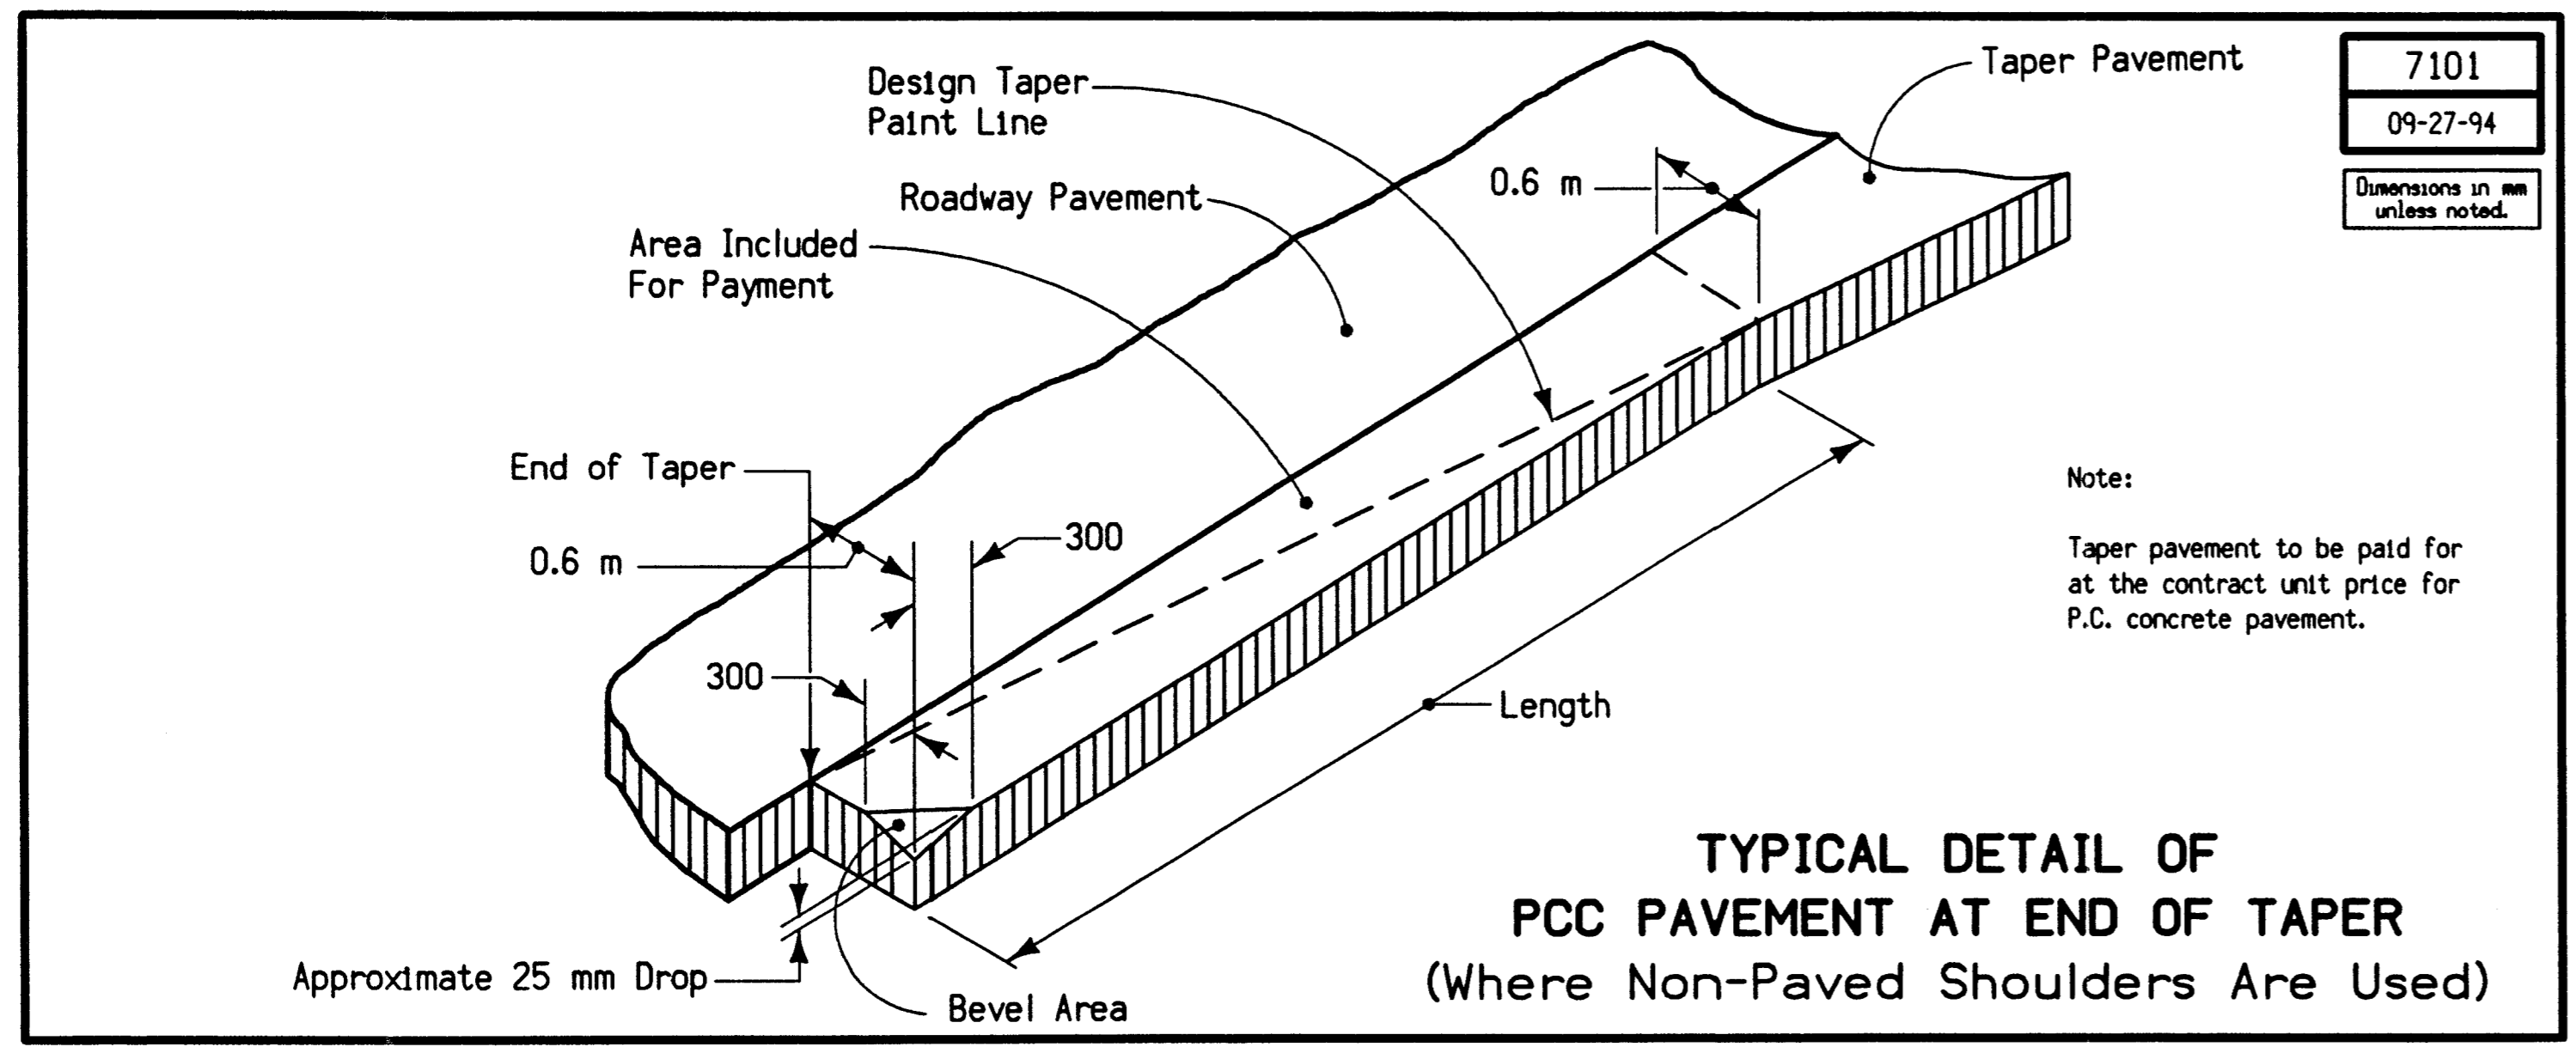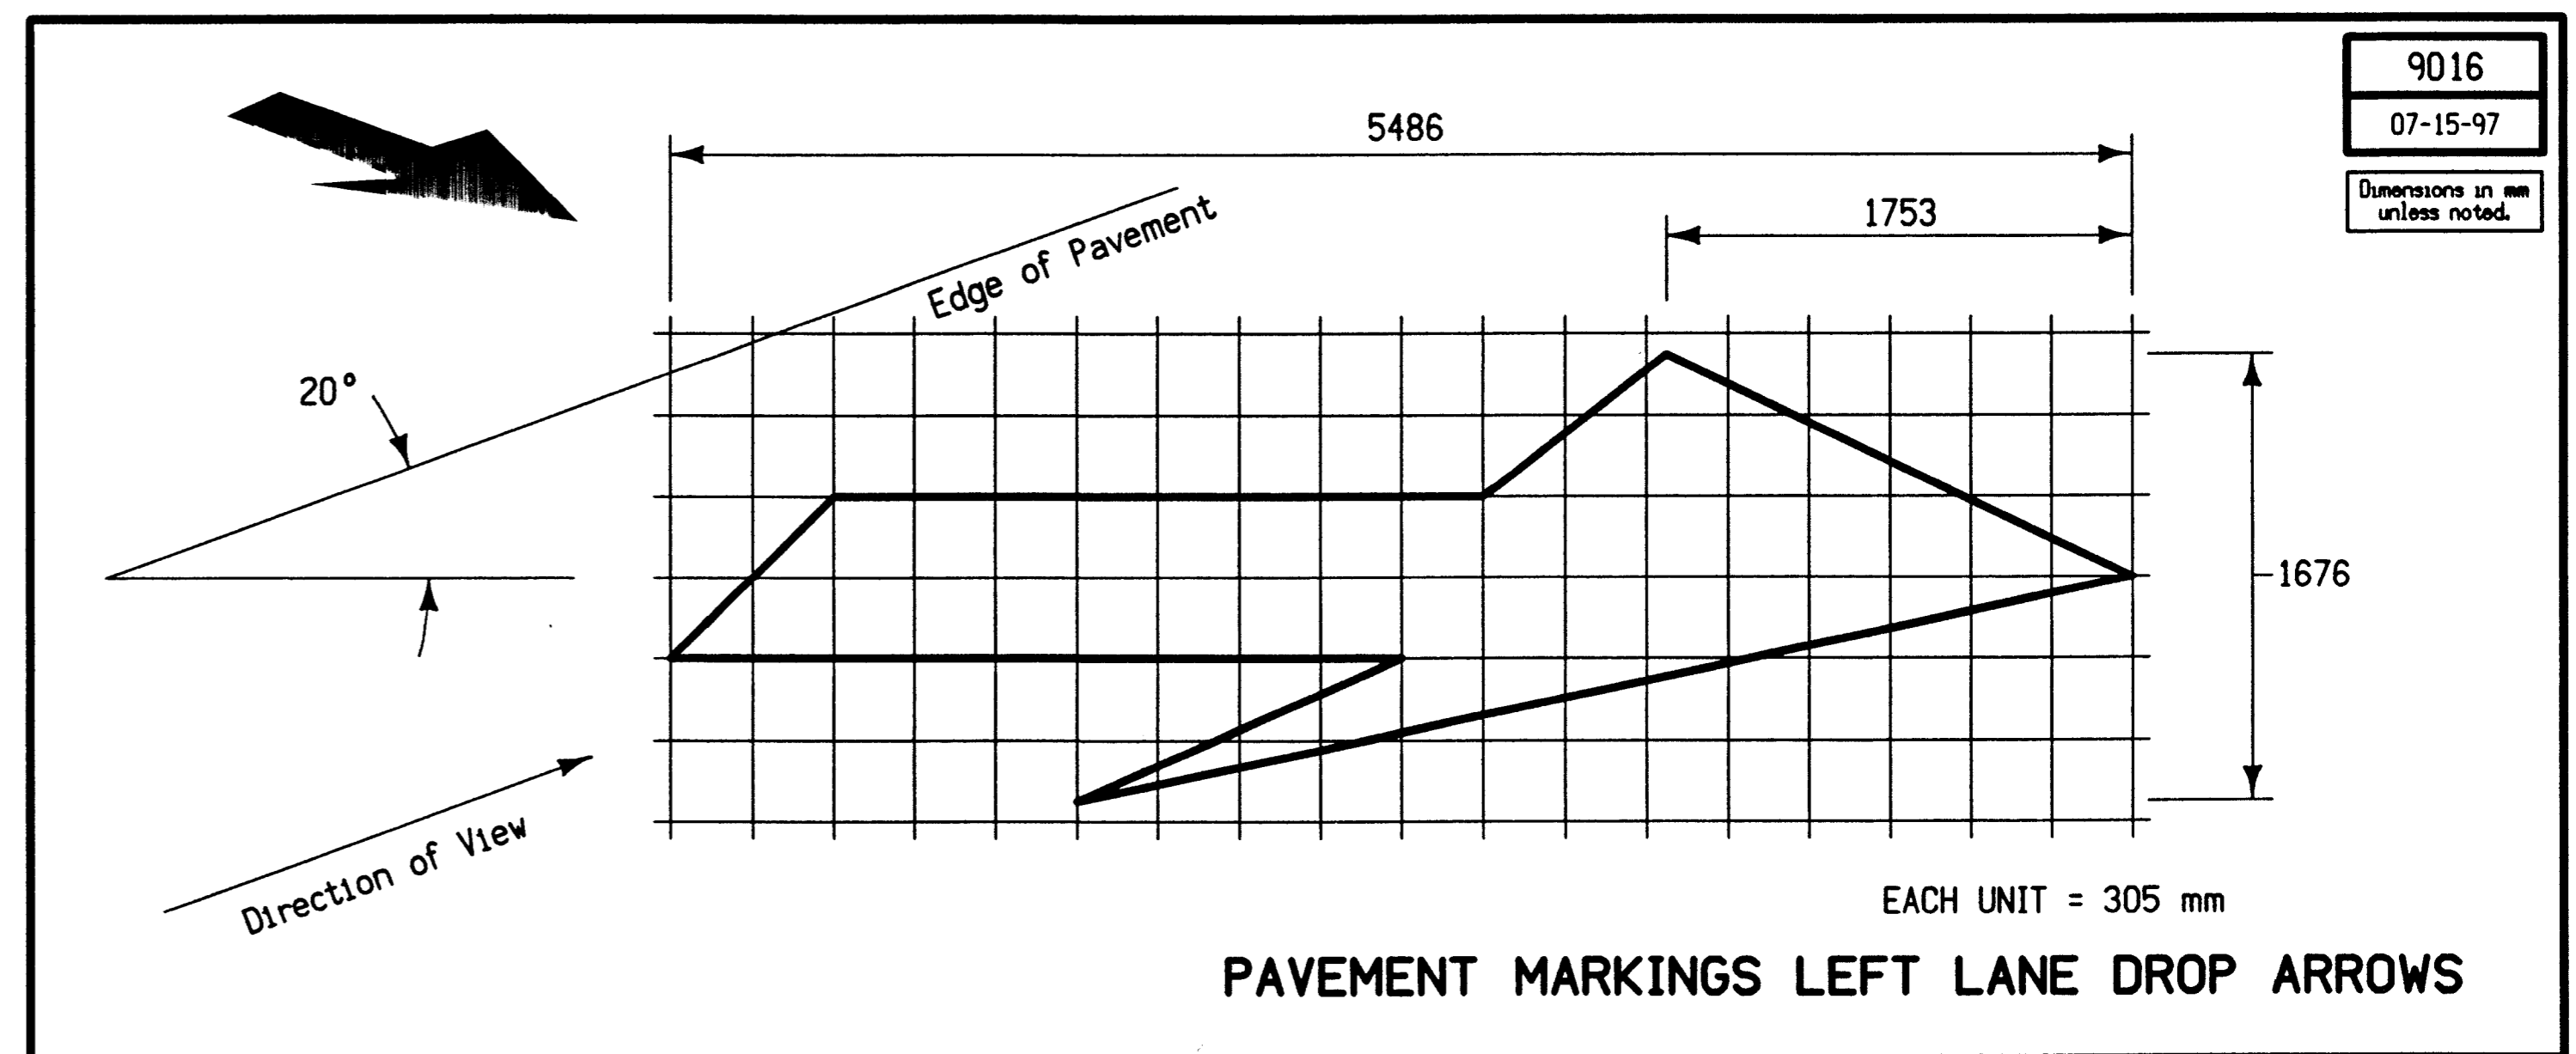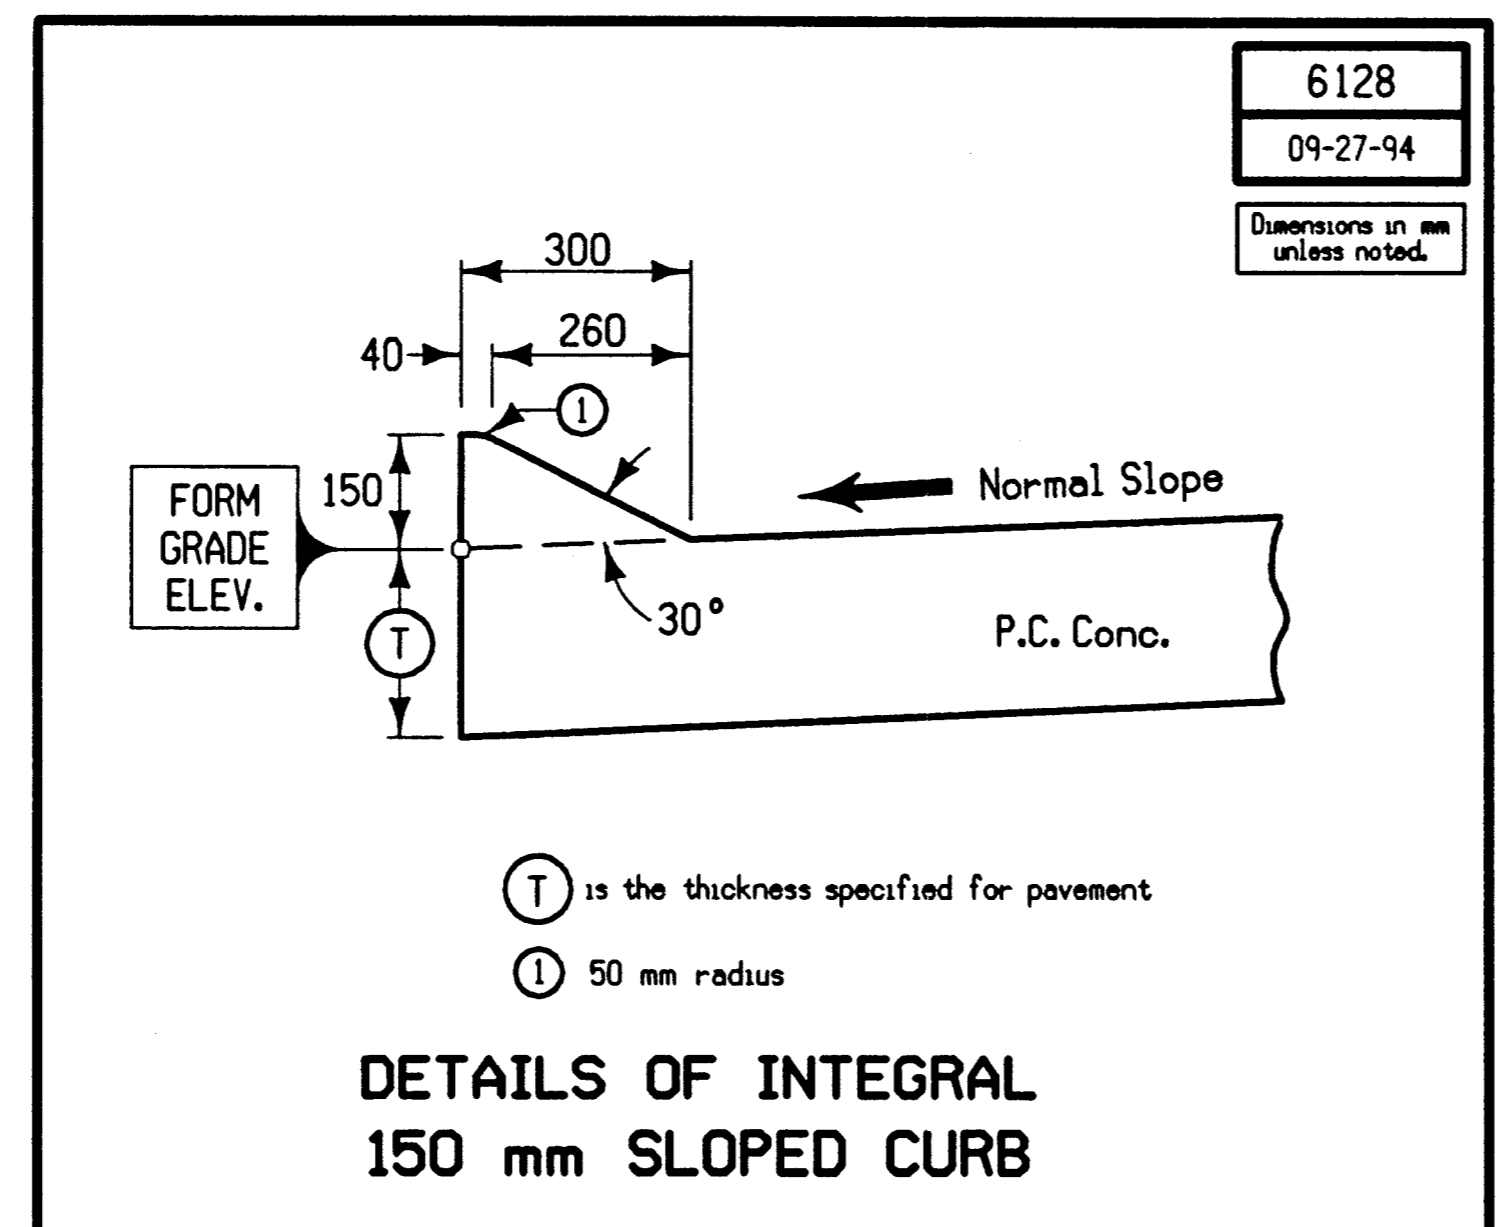

dgn = I:\WORK\project\34120\cadd\east\53151063.b09
prf = \WA1501\DATA\PL01\PL463P\B09h.prf
date = Tue Feb 22 14:26:18 2000
pen table = I:\plot\tables\haifwt.tbl
levels = 1-63

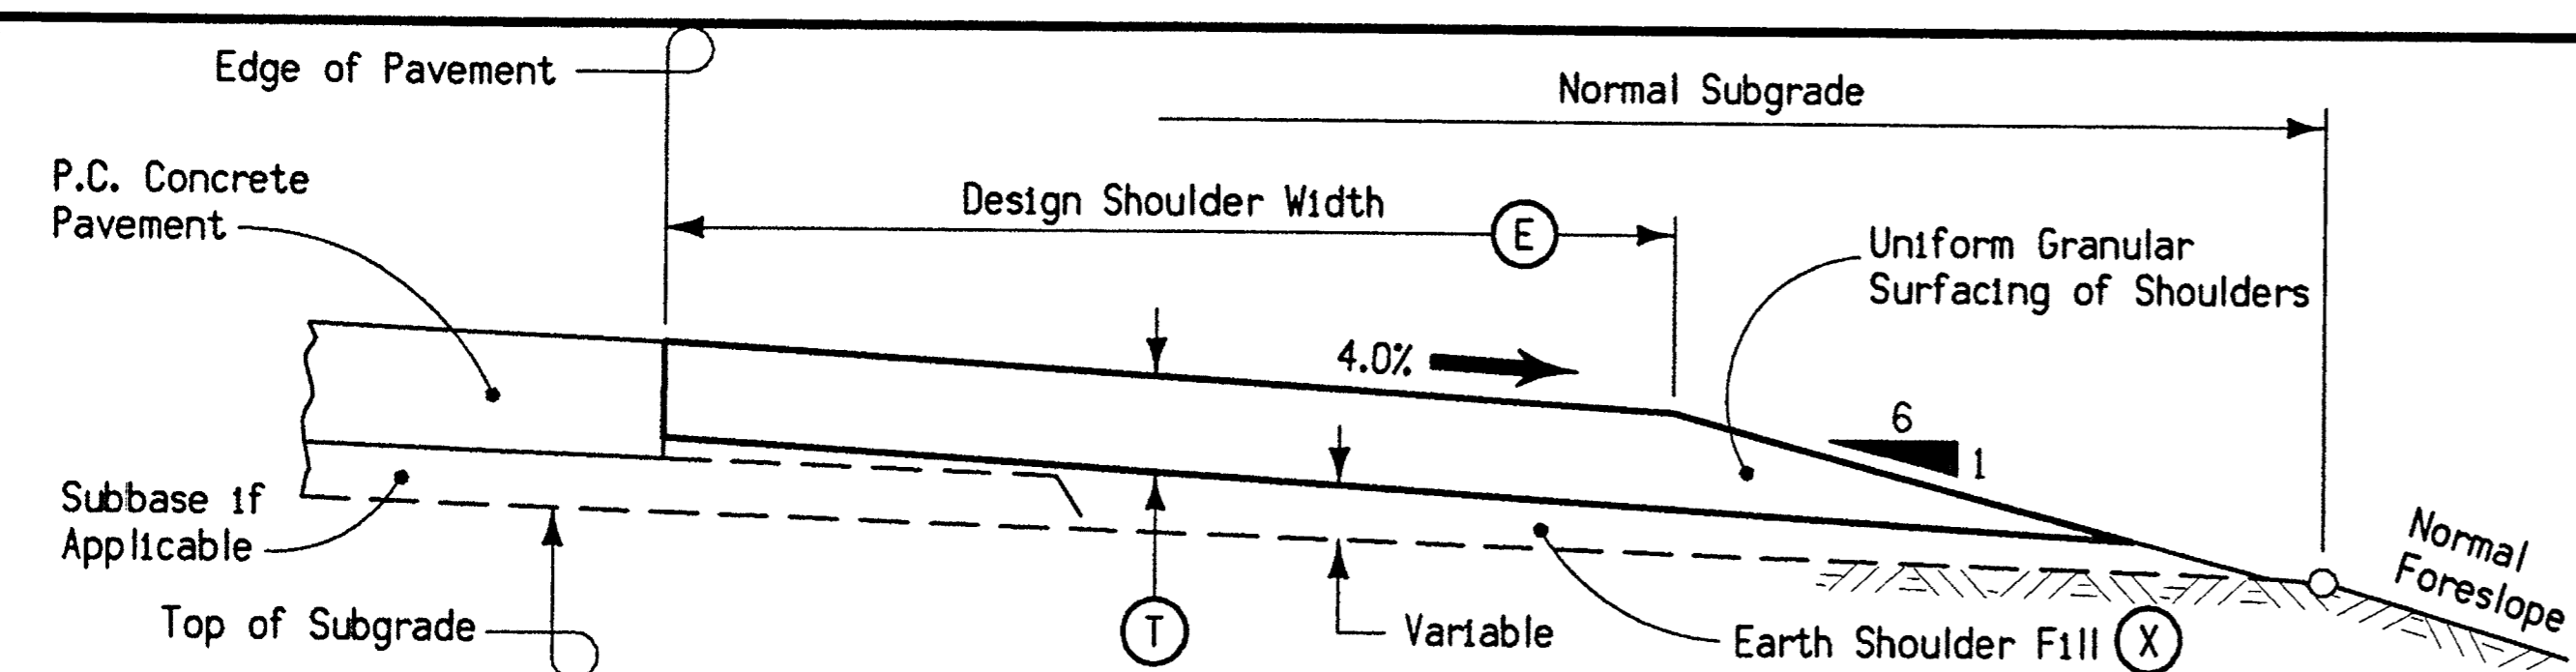


7110
12-03-96
Dimensions in mm unless noted.

**TYPICAL SECTION
TYPE 'A' OR 'B' GRANULAR SHOULDER
Adjacent to PCC Pavement**

Note:
Earth Shoulder fill requires approximately 40% cubic meters of excavation, including 40% for shrinkage, per station.
See Standard Road Plan RH-37D for construction requirements.

LOCATION		E m	T mm	SIDE	X m ³
ROAD IDENTIFICATION	STATION TO STATION				
U. S. HWY. 151 (S. B. LANES)	150+00 - 153+95	2.4	150	LT.	113.8
U. S. HWY. 151 (S. B. LANES)	150+00 - 153+95	1.8	150	RT.	81.9
IOWA HIGHWAY 64	2158+50 - 2159+80	3.0	150	RT.	130.1
IOWA HIGHWAY 64	2156+90 - 2161+74	3.0	150	RT.	130.1
IOWA HIGHWAY 64	2159+50 - 2161+84	3.0	150	LT.	130.1
ENTRANCE RAMP A 64	5153+60 - 5157+89	VAR	VAR	BOTH	VAR.
EXIT RAMP D 64	8158+41 - 8163+50	VAR	VAR	BOTH	VAR.

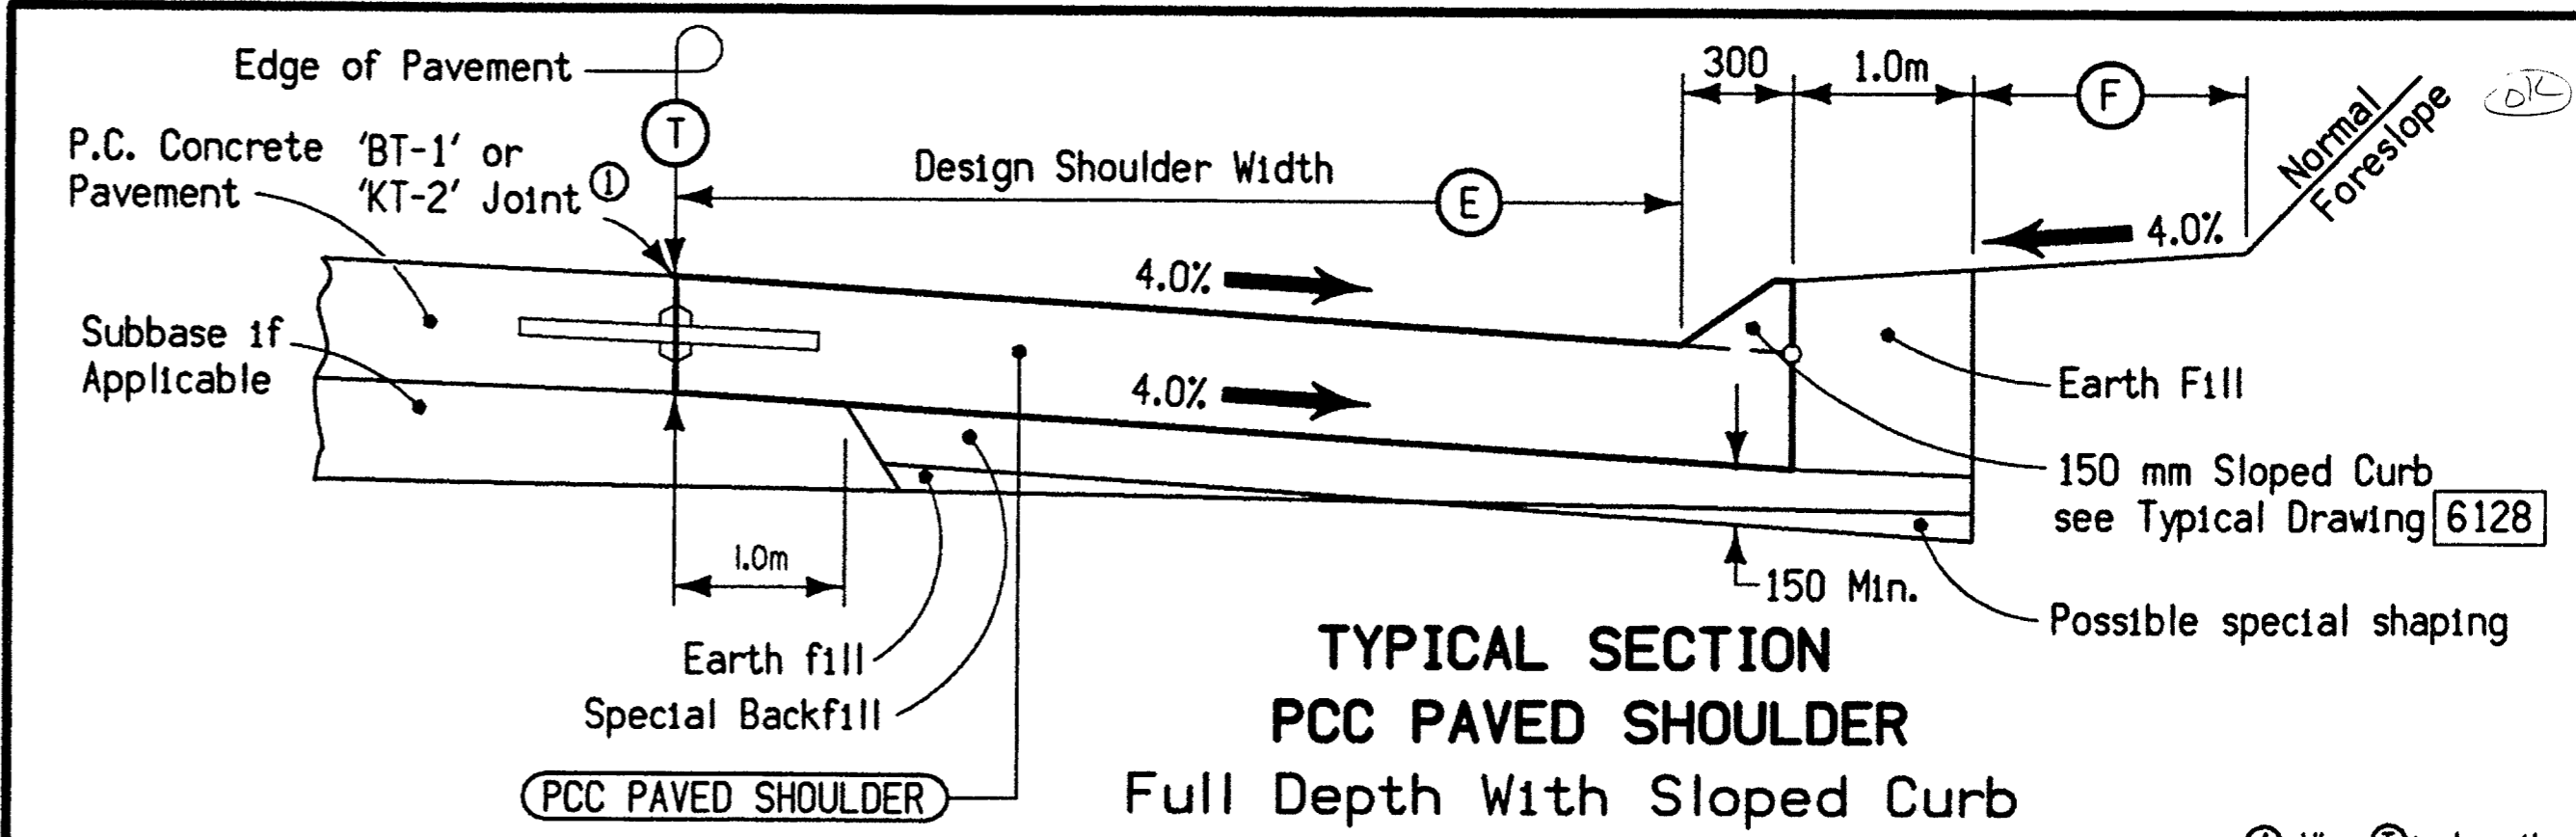


7129
MODIFIED
Dimensions in mm unless noted.

**TYPICAL SECTION
PCC PAVED SHOULDER
Full Depth With Sloped Curb**

LOCATION		DIMENSIONS			QUANTITIES ②			
ROAD IDENTIFICATION	STATION TO STATION	SIDE	T	E	F	SURFACE AREA m ² ③	EARTH FILL VOLUME m ³	SPECIAL BACKFILL Mg ③
			mm	m	m			
IOWA HIGHWAY 64	2156+89 - 2159+26	LT.	240	3	4.2	330	39.09	111.375

① When ① is less than 200 mm use 'BT-1' joint. When ① is equal to or more than 200 mm use 'L-2', 'KT-2' or modified 'BT-3' joint. Modified 'BT-3' requires a keyway. See Standard Road Plan RH-51 for joint details.
② Per Station Per Side.
③ Bid Items

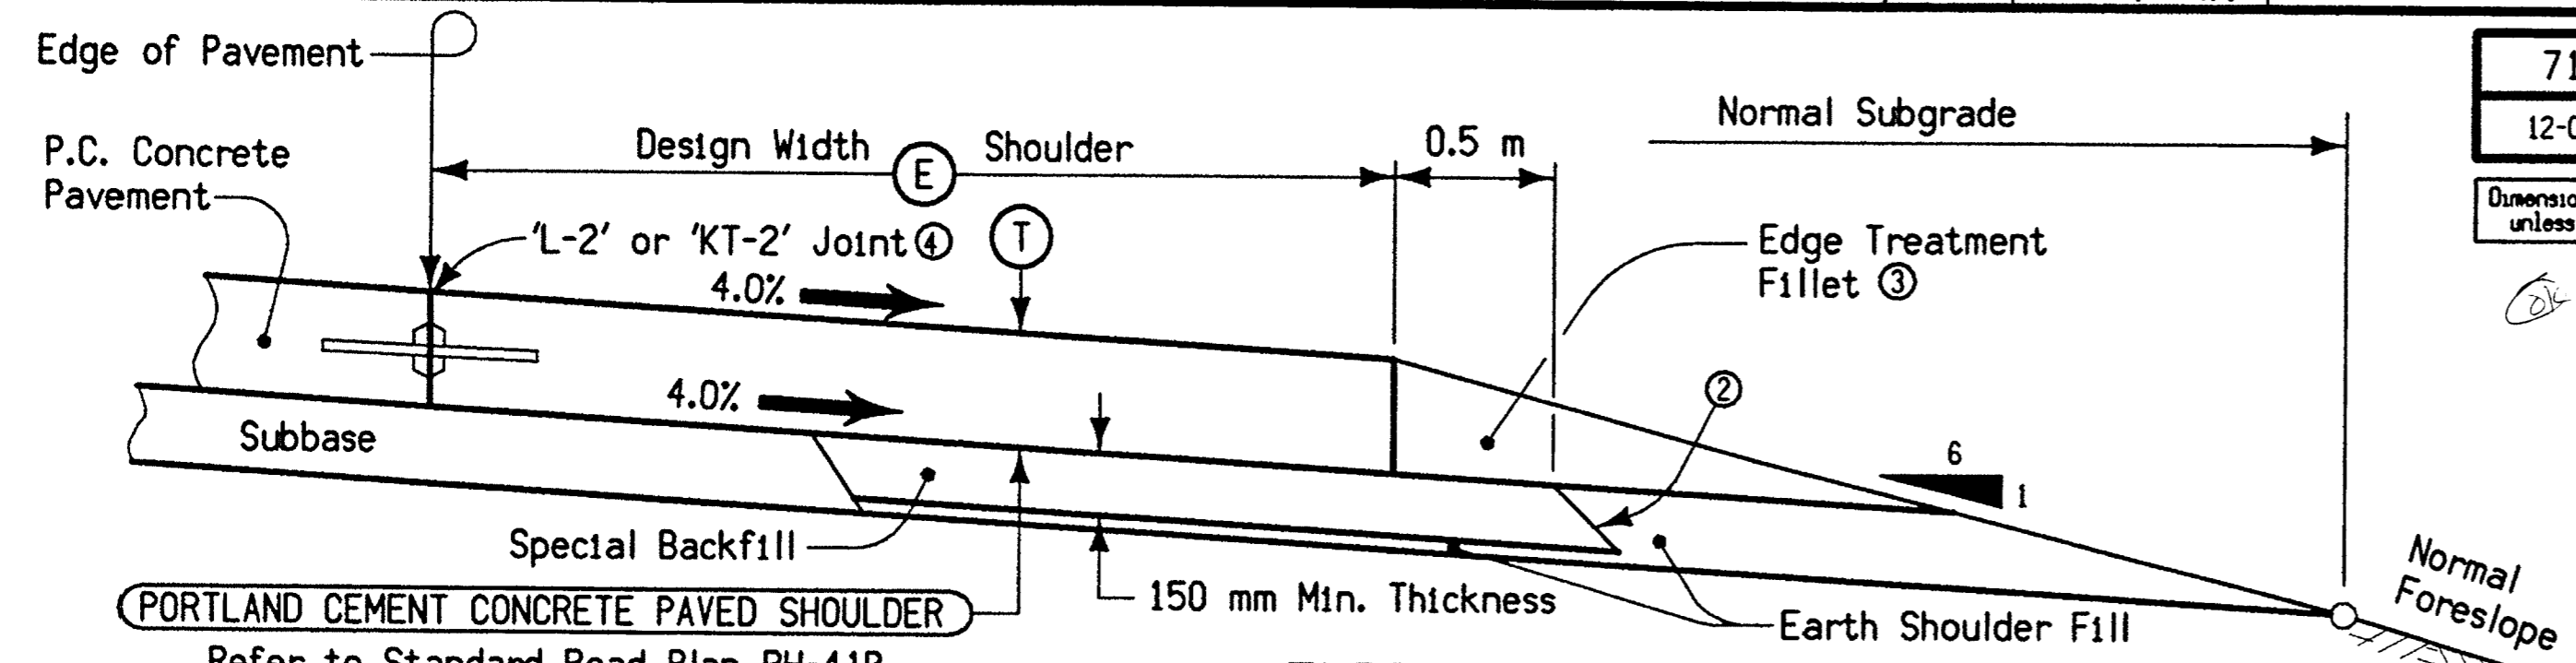


7126
12-03-96
Dimensions in mm unless noted.

**TYPICAL SECTION
Full Depth PCC Paved Shoulder**

LOCATION		DIMENSIONS		QUANTITIES ①			
ROAD IDENTIFICATION	STATION TO STATION	SIDE	T	E	SURFACE AREA m ² ③	EARTH FILL m ³	SPECIAL BACKFILL Mg ③
			mm	m			
MAINLINE SOUTHBOUND	153+50 - 154+30	LT.	240	1.8	⑥	21.4	⑧
MAINLINE SOUTHBOUND	161+89 - 163+05	LT.	240	2.4	⑥	21.4	⑧
RAMP A	5154+30 - 5158+20	LT.	240	1.8	⑥	21.4	⑧
RAMP A	5154+30 - 5158+10	RT.	240	1.2	⑥	21.4	⑧
RAMP B	6153+10 - 6157+40	RT.	240	1.8	⑥	21.4	⑧
RAMP B	6152+95 - 6156+60	LT.	240	1.2	⑥	21.4	⑧
RAMP D	8158+12 - 8161+89	LT.	240	1.8	⑥	21.4	⑧
RAMP D	8158+10 - 8161+89	RT.	240	1.2	⑥	21.4	⑧

① Per station per side. See Standard Road Plan RH-41B for basis of estimate.
② Approximately 1:1 Slope
③ Refer to appropriate detail drawings.
④ When ① is less than 200 mm use 'BT-1' joint. When ① is equal to or more than 200 mm use 'L-2', 'KT-2' or modified 'BT-3'. Modified 'BT-3' requires a keyway. See Standard Road Plan RH-51 for joint details.
⑤ Bid Items
⑥ See Tab. 112-9
⑦ Earth Shoulder fill requires approximately 40% cubic meters of excavation, including 40% for shrinkage, per station
⑧ Included with special backfill under ramps and tapers.

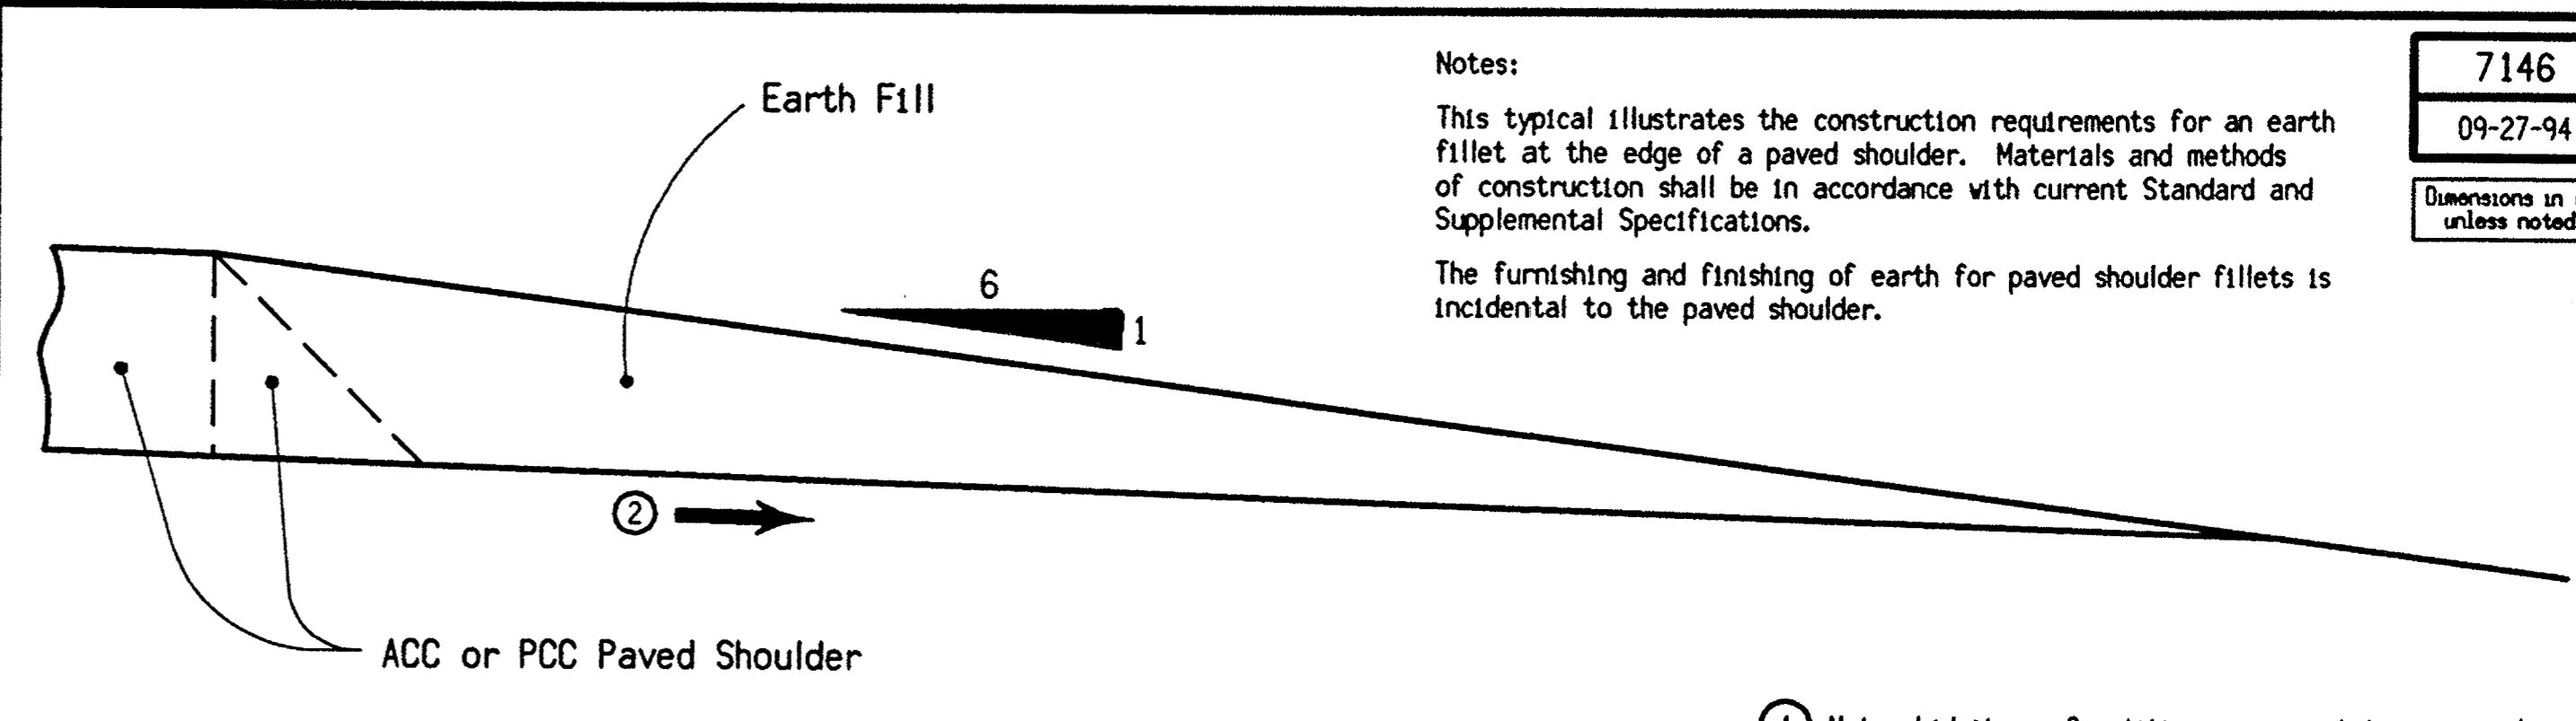

7146
09-27-94
Dimensions in mm unless noted.


Notes:
This typical illustrates the construction requirements for an earth fillet at the edge of a paved shoulder. Materials and methods of construction shall be in accordance with current Standard and Supplemental Specifications.
The furnishing and finishing of earth for paved shoulder fillets is incidental to the paved shoulder.

① Not a bid item. Quantities are per station per side.
② Match slope of under side of shoulder pavement.

**EARTH FOR
PAVED SHOULDER FILLET**

LOCATION		QUANTITIES ①	
ROAD IDENTIFICATION	STATION TO STATION	SIDE	EARTH FILL m ³
MAINLINE SOUTHBOUND	153+50 - 154+30		40% SHRINK
RAMP A	5154+30 - 5158+20	LT.	31.8
RAMP A	5154+30 - 5158+10	RT.	31.8
RAMP B	6153+10 - 6157+40	RT.	31.8
RAMP B	6152+95 - 6156+60	LT.	31.8
RAMP D	8158+12 - 8161+89	LT.	31.8
RAMP D	8158+10 - 8161+89	RT.	31.8
DETOUR PAVEMENT	149+12 - 154+92	LT.	
DETOUR PAVEMENT	148+12 - 155+59	RT.	
MAINLINE 151	150+00 - 153+60	LT.	
MAINLINE 151	150+00 - 154+50	RT.	
MAINLINE 64	2156+25 - 2161+74	RT.	
MAINLINE 64	2156+89 - 2161+37	LT.	


d:\work\project\134120\CADLINEAS\153151063.b09
 level = 1-63
 date = Fri Oct 29 10:53:26 1999
 pcr table = l:\p\lot\tables\h1\ft.tbl

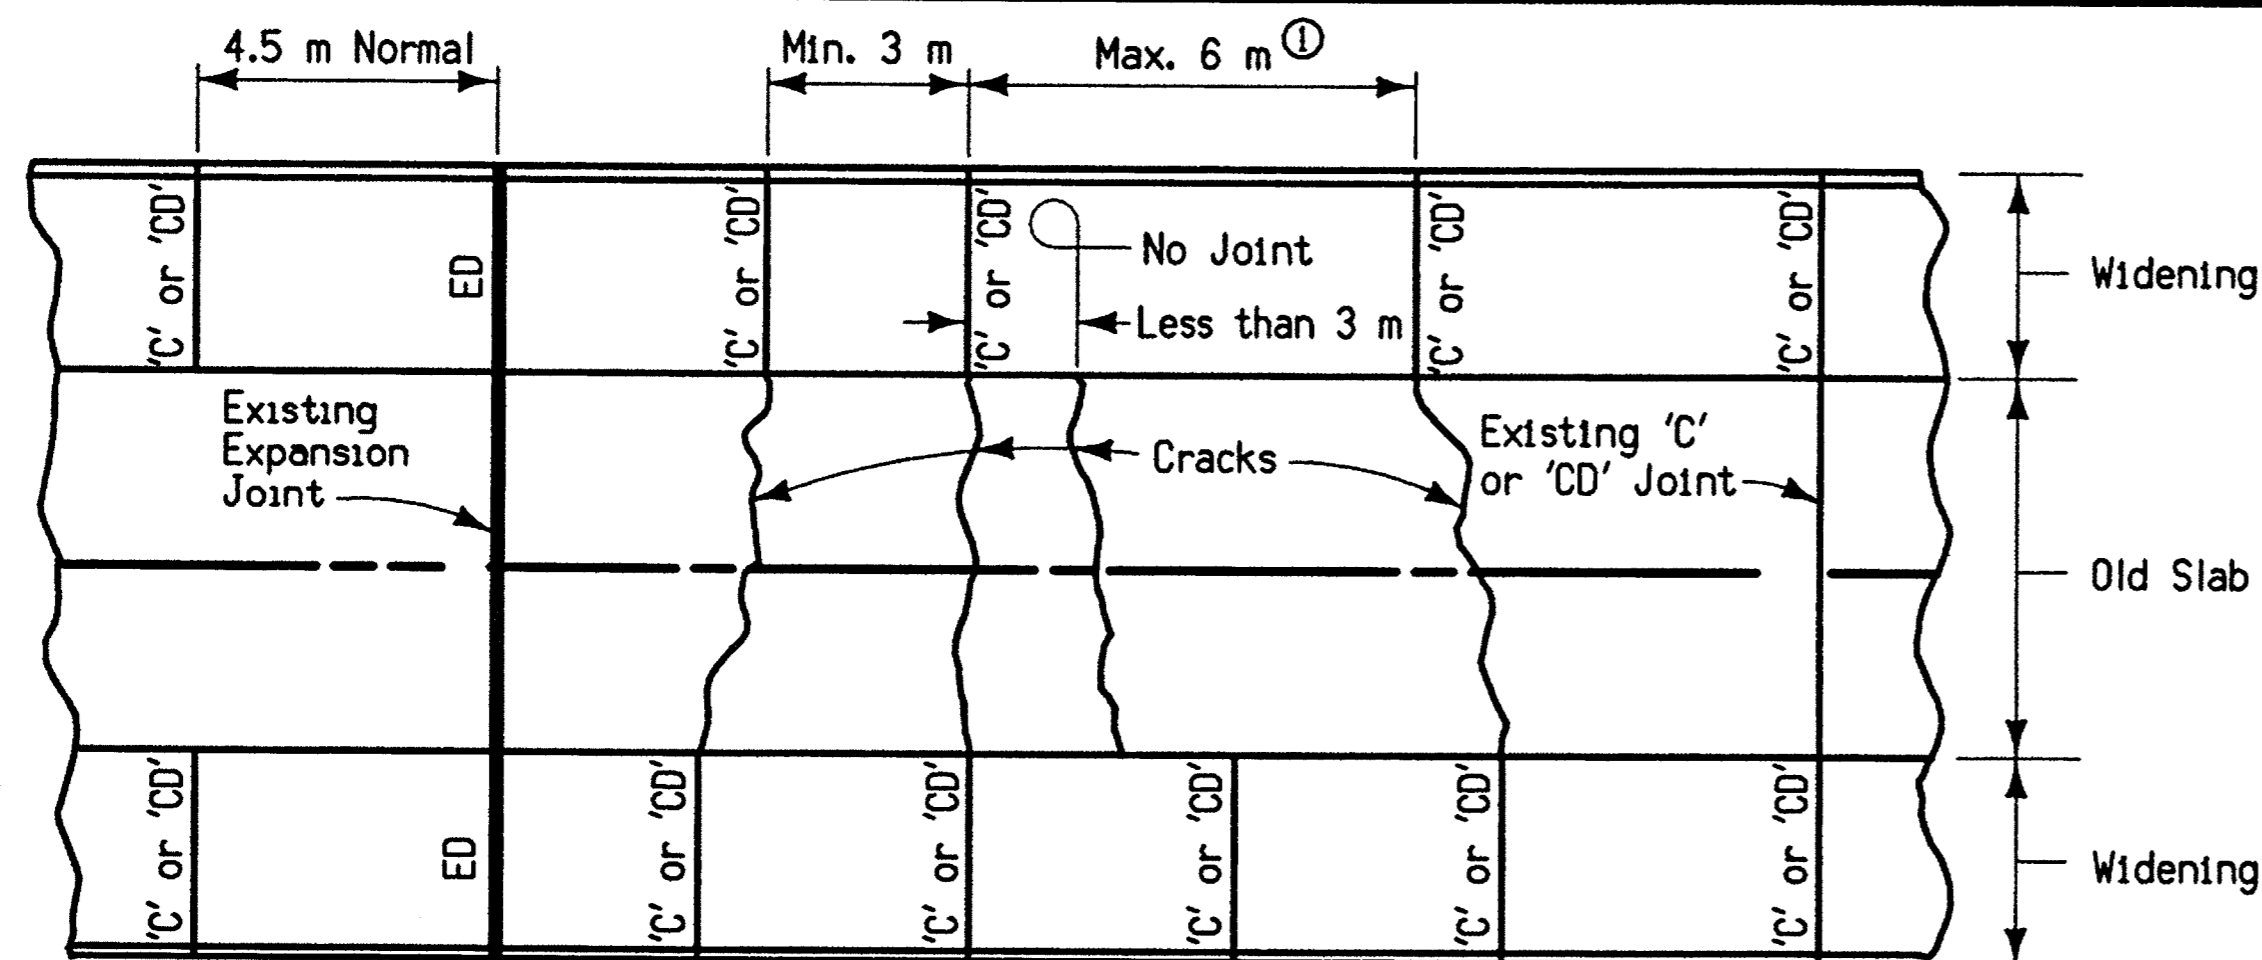

7203
09-27-94
Dimensions in mm unless noted.

Notes:
For joint details refer to Standard Road Plans RH-50 and RH-52.
① If more than 6 m make extra joint 1/2 distance.



TYPICAL JOINTING DIAGRAM FOR WIDENING EXISTING PAVEMENT

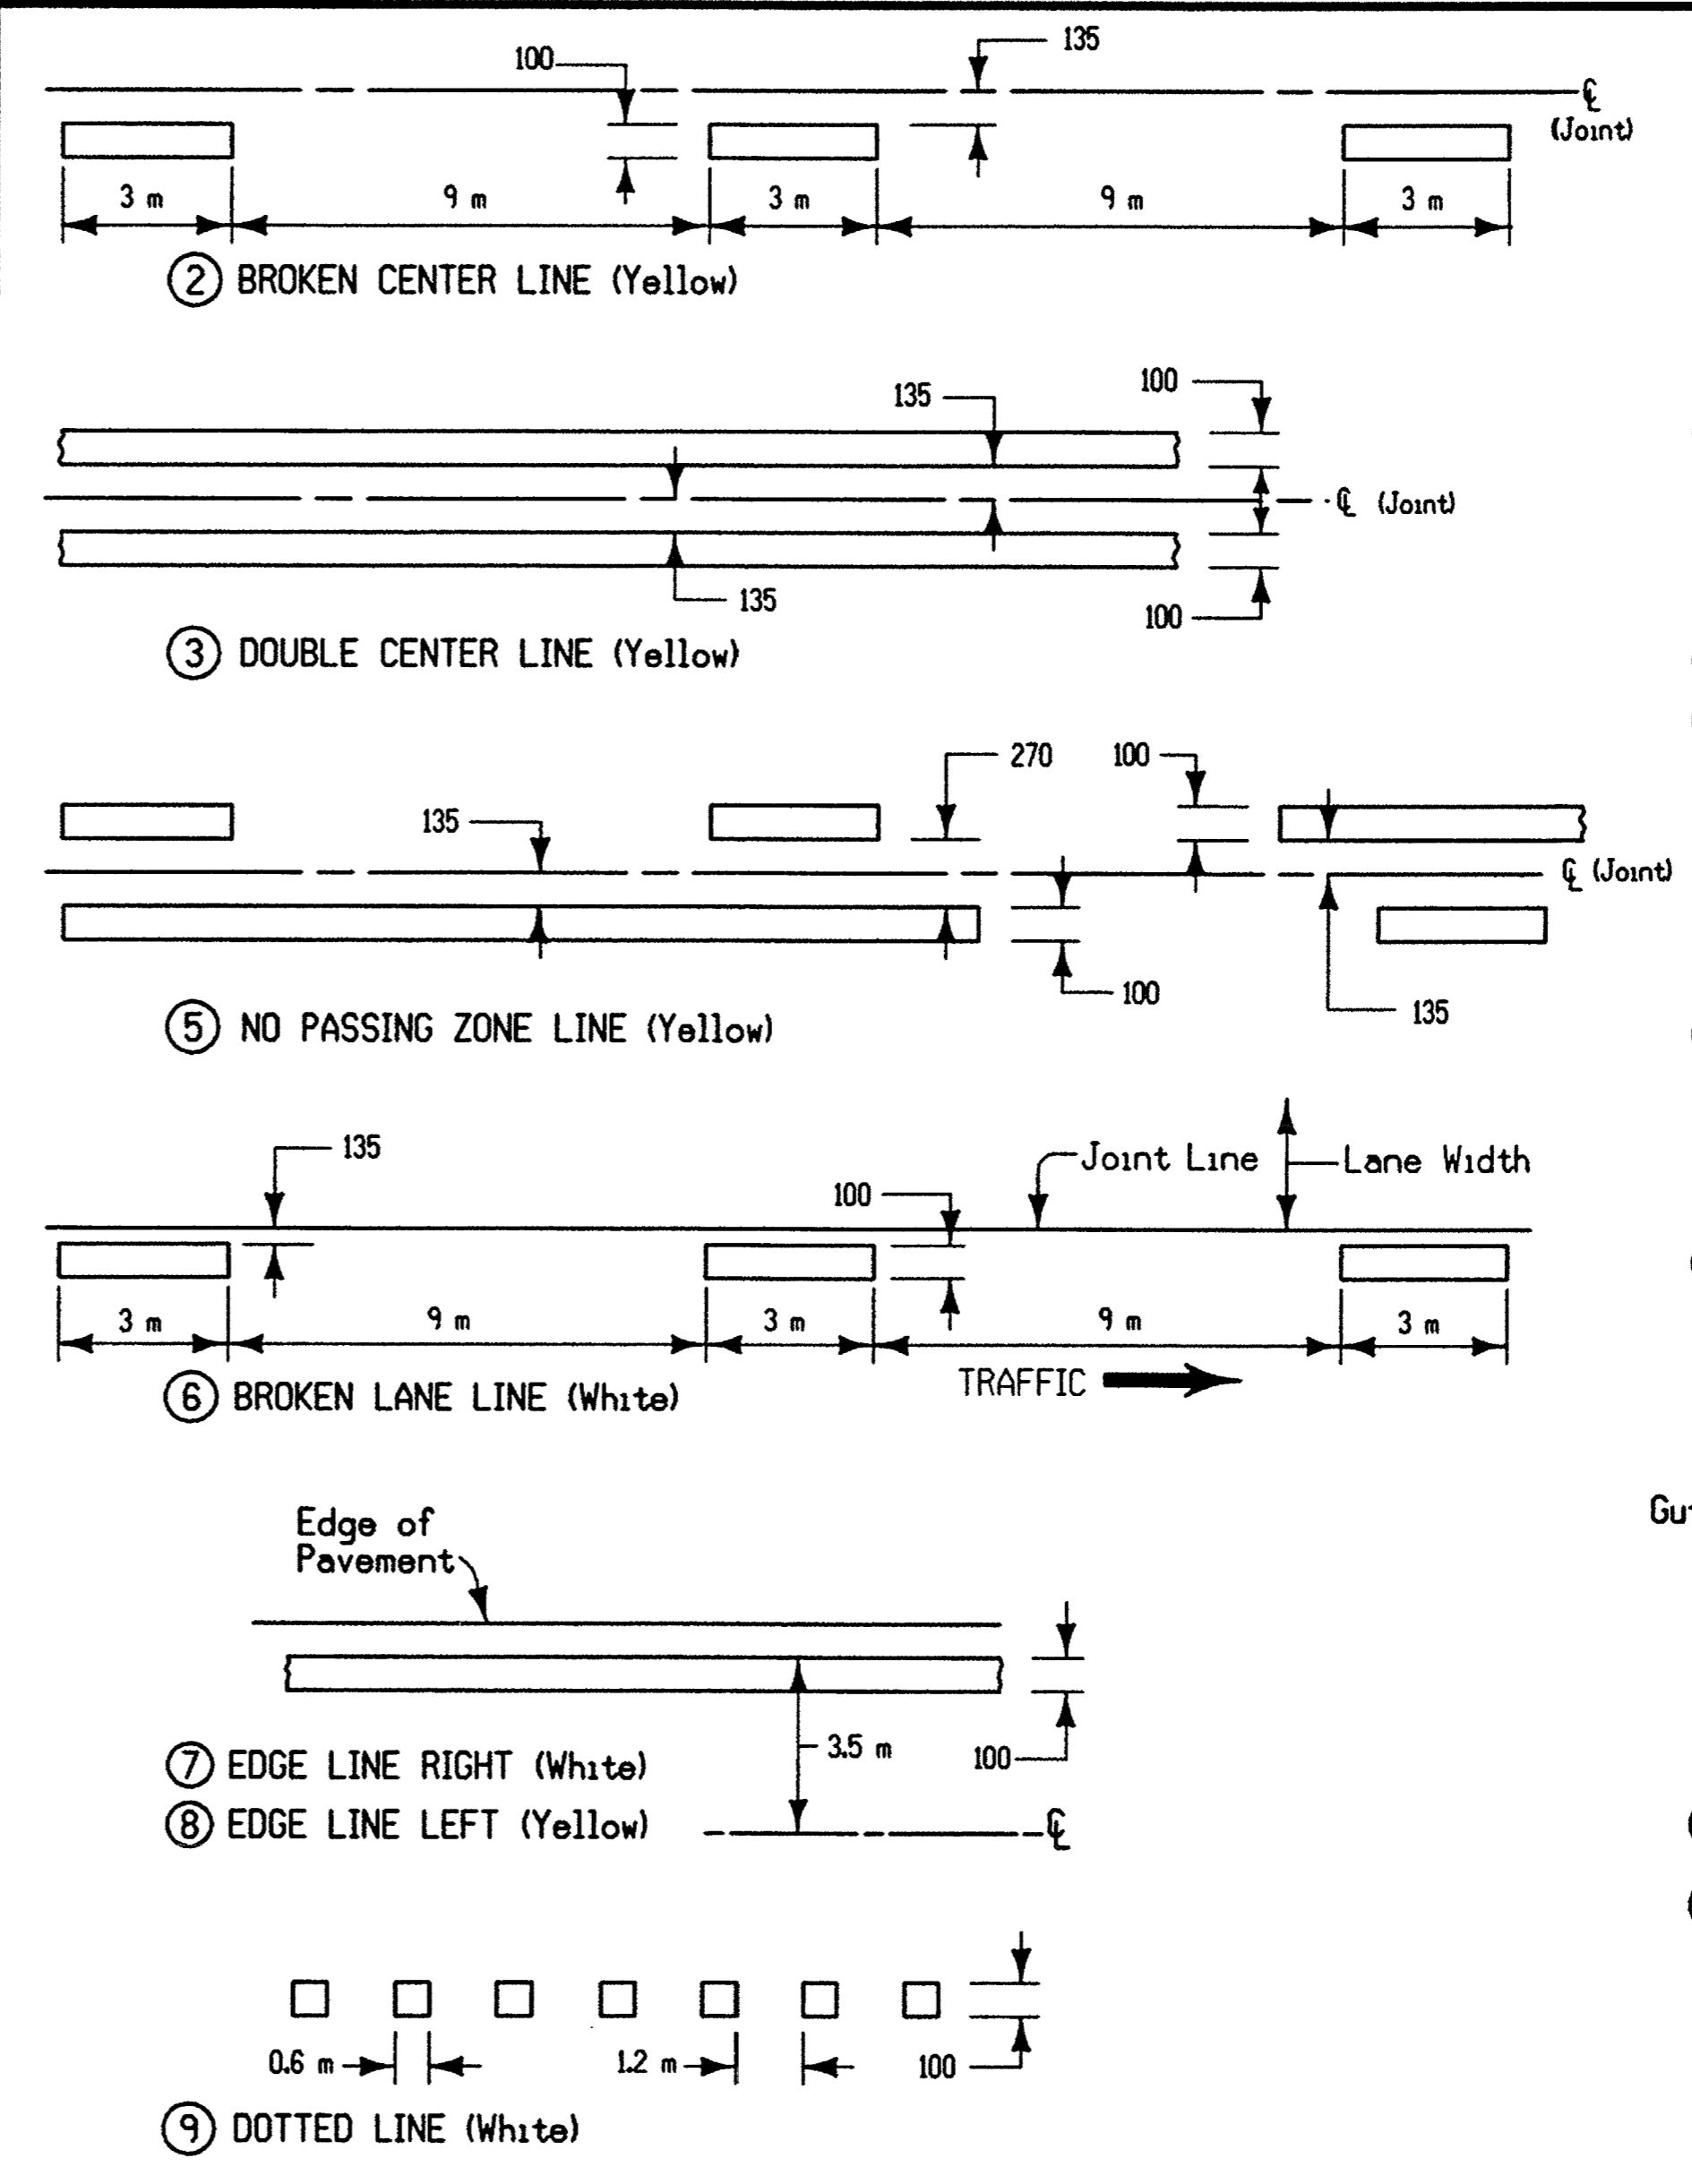

9001
10-31-95
Dimensions in mm unless noted.


④ Paint 300 mm width for 150 mm Standard Curb, Paint 360 mm width for 150 mm Sloped Curb.
⑮ YELLOW CURB
⑯ WHITE CURB

STANDARD TYPES OF PAVEMENT MARKINGS

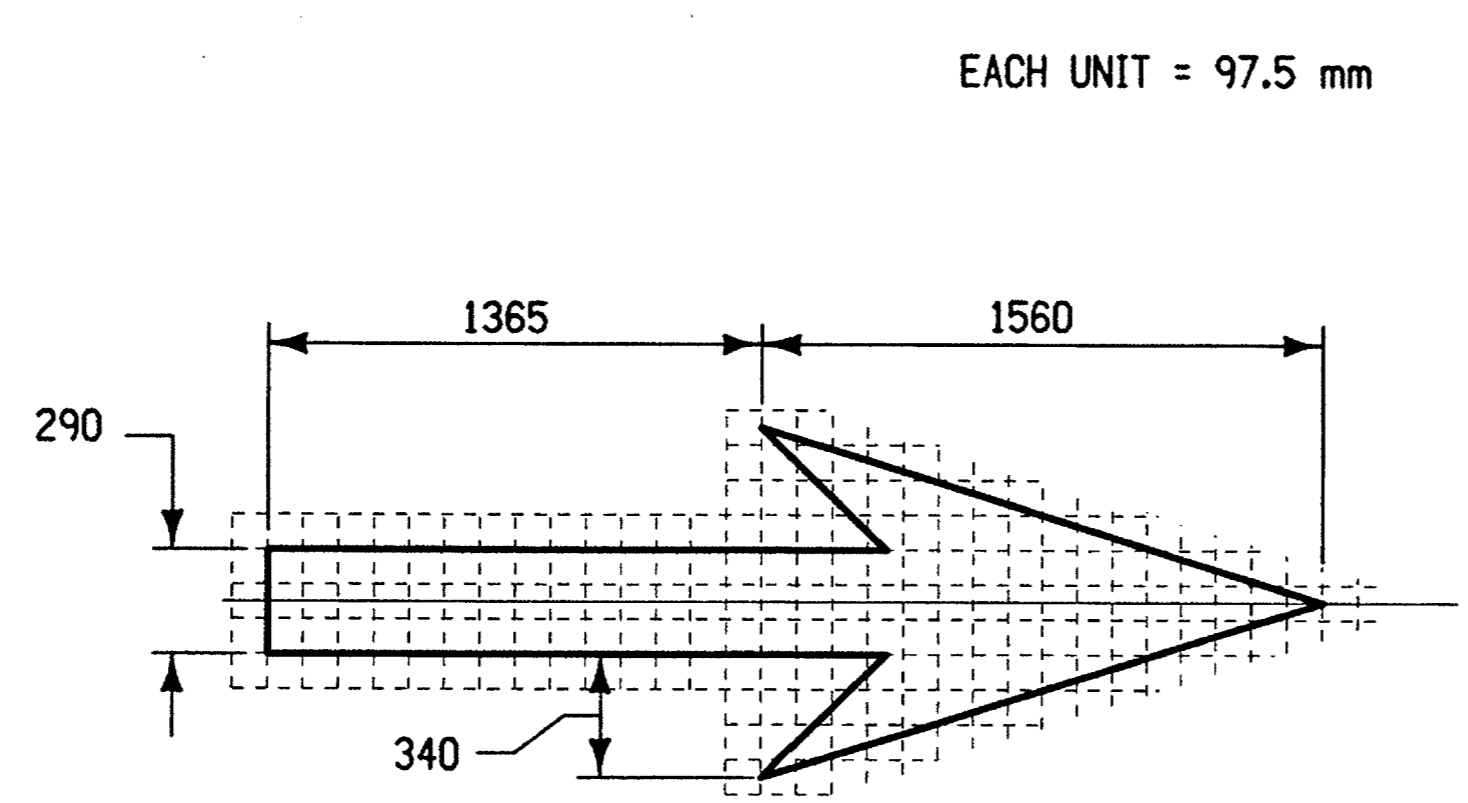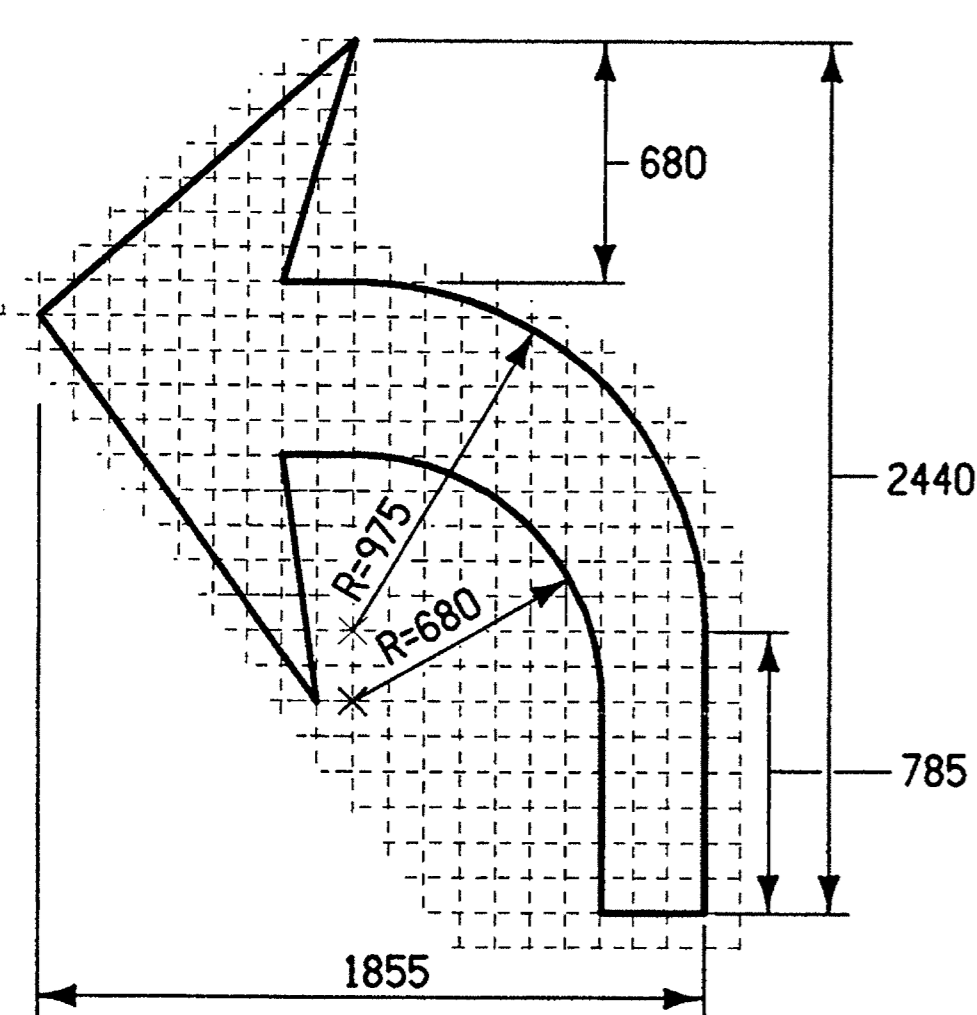


9002
04-28-98
Dimensions in mm unless noted.

PAVEMENT MARKINGS STRAIGHT AND CURVE ARROWS

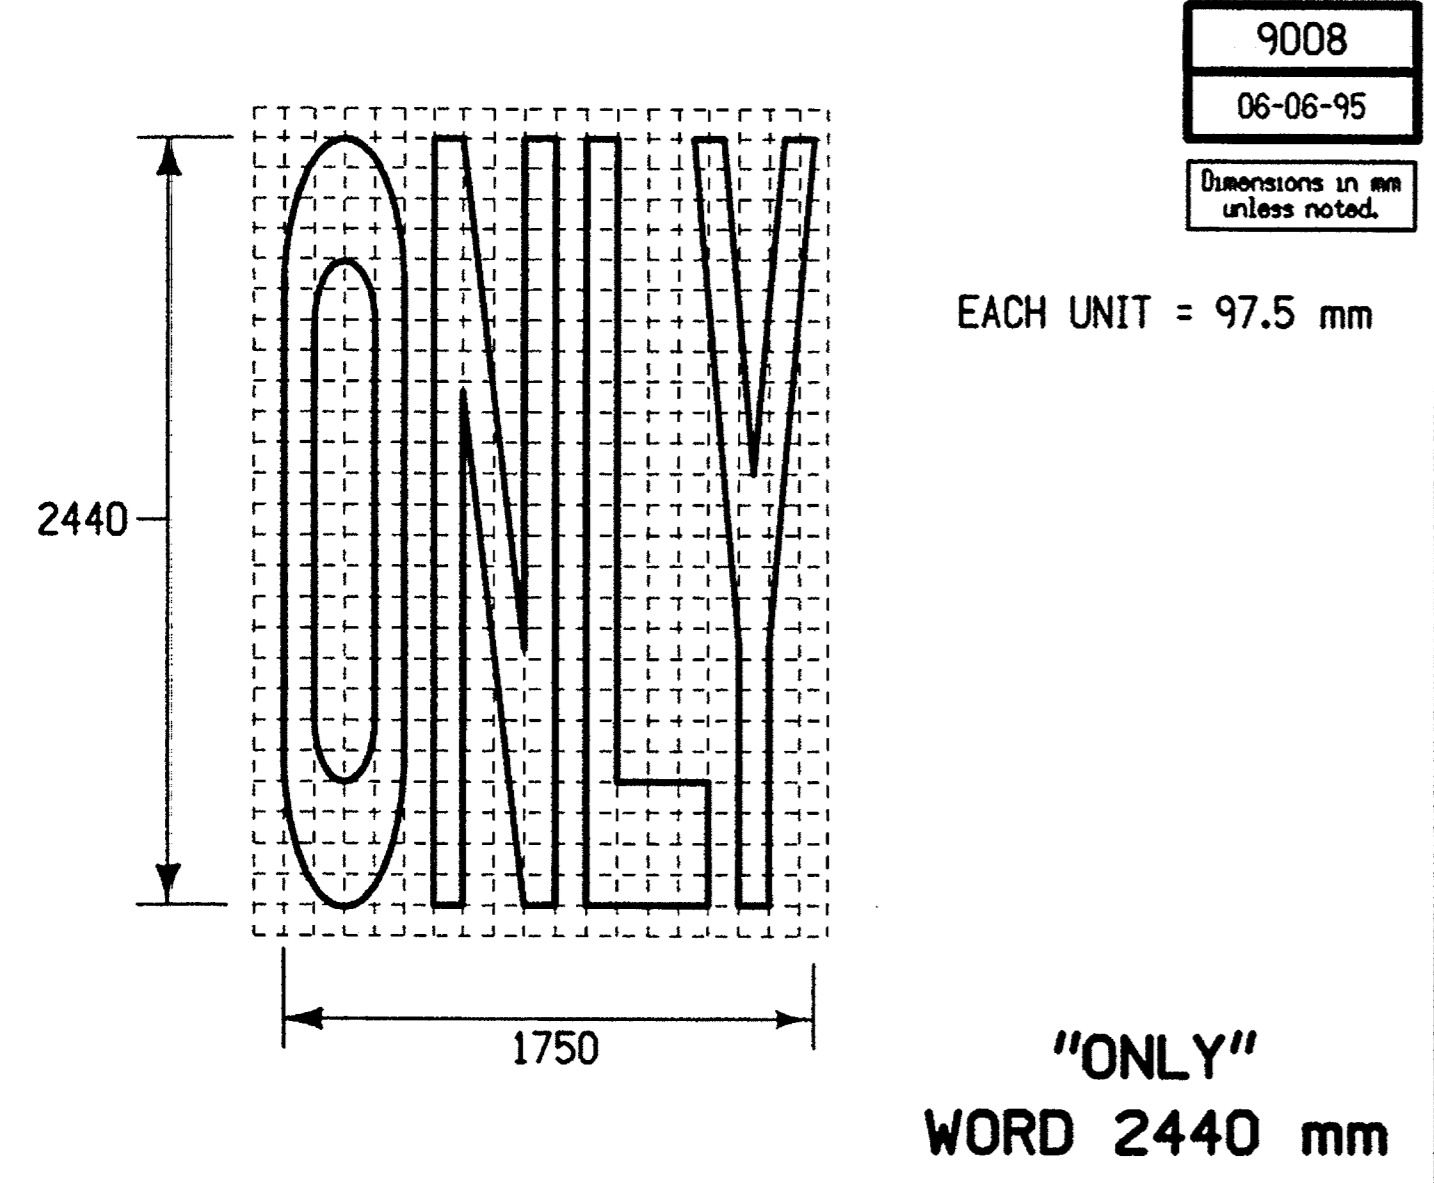

9008
06-06-95
Dimensions in mm unless noted.

"ONLY" WORD 2440 mm

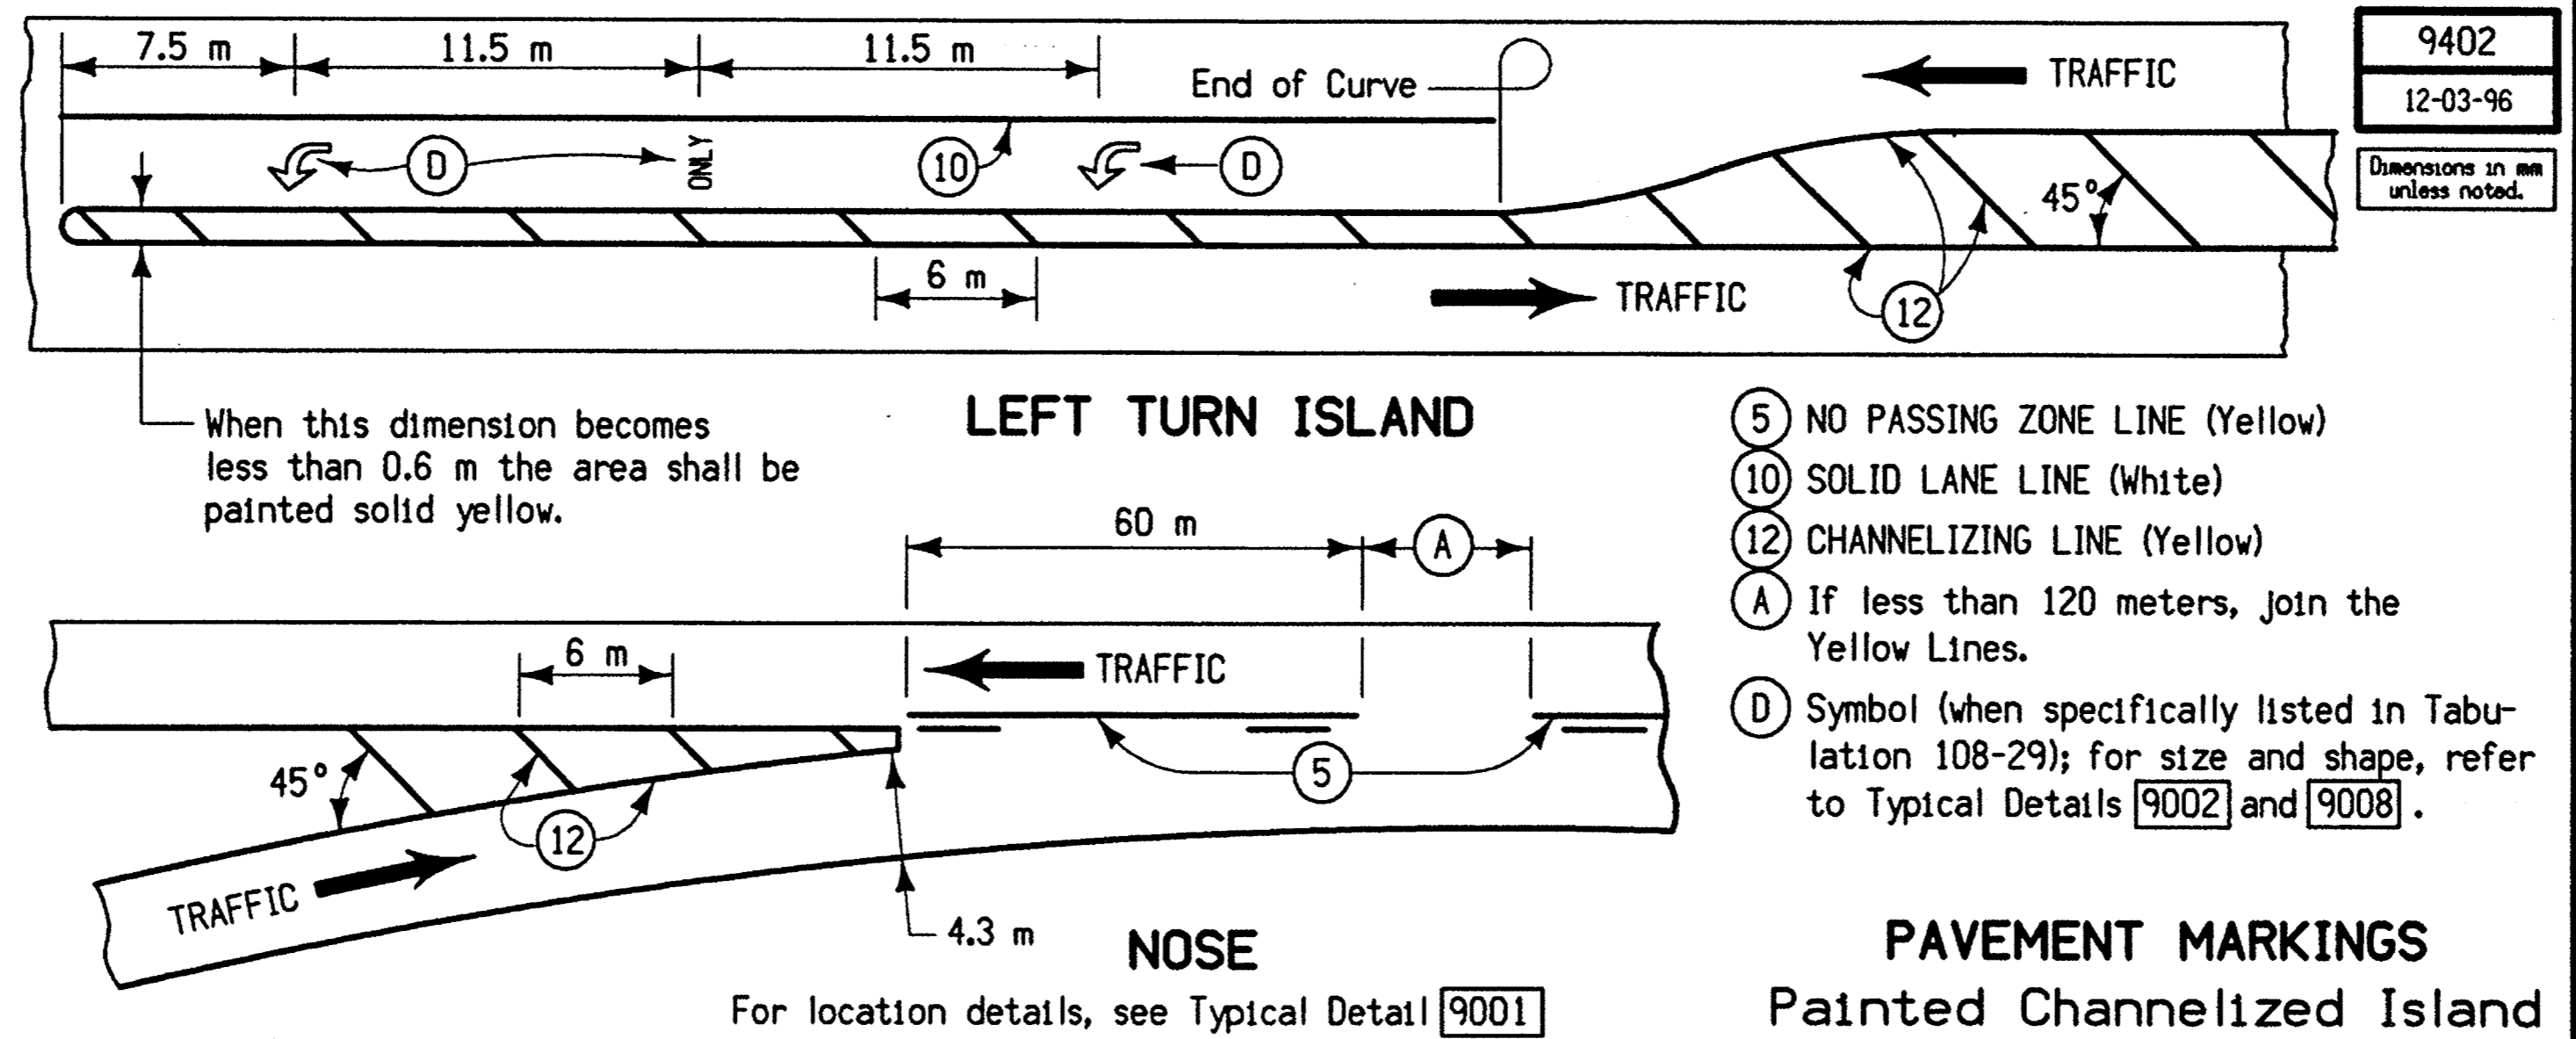

9402
12-03-96
Dimensions in mm unless noted.

⑤ NO PASSING ZONE LINE (Yellow)
⑩ SOLID LANE LINE (White)
⑫ CHANNELIZING LINE (Yellow)
A If less than 120 meters, join the Yellow Lines.
D Symbol (when specifically listed in Tabulation 108-29); for size and shape, refer to Typical Details 9002 and 9008.

PAVEMENT MARKINGS Painted Channelized Island

c:\work\project\34120\CAUD\EA5\53151063.b09
 levels = 1-63
 pen table = I:\Lot\Tables\half.tbl
 pcf = \\wts01\data\p101\PL463p\B11.PRF
 date = Thu Oct 28 07:57:58 1999

Revised

100-1A
07-15-97

AS BUILT PROJECT QUANTITIES				PROP. LINE	ITEM CODE	AS BUILT PROJECT QUANTITIES	UNITS	QUANTITY PLACED	PROP. LINE	ITEM CODE	AS BUILT PROJECT QUANTITIES	UNITS	QUANTITY PLACED		
Prop	Line	Item Code	Item Description	Units	Quantity Placed										
	10	2101--100100	CLEAR+GRUB	UNIT	12,942.60	870	2527--101000	PAINTED PAVT MARK	M	24,014.55	1125	2524--610100	DELINEATOR SINGLE WHITE (RE-7)	EACH	46
	20	2102--100100	CL 10 EXCAVATION RDWY+BORROW	M3	702,009.00	880	2527--103000	REMOVABLE TAPE MARK	M	2,248.80	1130	2524--610200	DELINEATOR DOUBLE WHITE (RE-7)	EACH	179
	30	2102--120400	CL 12 EXCAVATION BOULDER/ROCK FRAGMENT	M3	327.842	890	2527--108000	PAVT MARK RMVD	M	2,874.50	1135	2524--610300	RMV+REINSTALL DELINEATOR POST	EACH	76
	40	2102--210000	INTERCEPT DITCH+FLUME	M	270	900	2528--101000	TRAFFIC CONTROL	LS	1	1140	2599--999916	('LUMP SUM' ITEM) Four-Way Flasher	LS	1
	50	2102--220100	SELECTED BACKFILL MAT'L	M3	53,732.90	910	2528--104000	TEMPORARY TRAFFIC SIGNAL	EACH	0	1145	2599--999915	('EACH' ITEM) Mount Signs on Wood Posts	EACH	11
	60	2102--230100	SPECIAL BACKFILL MAT'L	M	17,408.80	920	2528--105000	TEMPORARY FLOODLIGHT LUMINAIRE	EACH	9	1150	2303--100000	ACC COMMERCIAL MIX AS PER PLAN	MG	183.64
	70	2102--250000	LOCATING TILE LINE	M	2,122.00	930	2528--107000	FLAGGER	LS	0	1155	2599--999901	('METER' ITEM) Bale Checks	M	193.3
	80	2105--100100	TOPSOIL STRIP SALVAGE+SPREAD	M3	50,083.20	940	2533--100000	MOBILIZATION	LS	0	1160	2599--999916	('LUMP SUM' ITEM) Fuel Adjustment	LS	1
	90	2105--101000	TOPSOIL SPREAD	M3	23,686.00	950	2601--103000	STABILIZE CROP SEED+FERTILIZE	HA	64.01	1165	2519--420000	RMVL OF EXIST FENCE	M	171
	100	2105--102000	TOPSOIL STRIP+STKP	M3	26,186.00	960	2601--103100	STABILIZE CROP SEED+FERTILIZE (URBAN)	HA	0.94	1170	2502--308200	SUBDRAIN OUTLET 200 MM DIA	EACH	6
	110	2107--100200	COMPACTION W/MOISTURE CONTROL	M3	5,097.50	970	2601--104100	FERTILIZE	HA	8.88	1175	2416--161000	RMV+REINSTALL RIGID PIPE CULV <= TO 1000	M	28.6
	120	2107--100400	COMPACT BACKFILL ADJ TO BRDG/CULV/STRUCT	M3	0	980	2601--104200	MULCH	HA	15.78	1180	2599--999916	('LUMP SUM' ITEM) Purchase Traffic Control Materials	LS	1
	130	2108--100000	OVERHAUL (STATION METER)	ST-M	1,335,165.00	990	2599--000002	TRAINEE REIMBURSEMENT	HOUR	0	1185	2301--600100	PCC PAVT SAMPLE	LS	1
	140	2111--100000	GRANULAR SUBBASE	M2	6,675.63	1000	2416--161001	RMV+REINSTALL RIGID PIPE CULV > 1000 MM	M	467	1190	6100--230110	EWO/PCC PAVT COLD WEATHER PROTECTION	M2	798.99
	150	2121--100100	GRANULAR SHLD TYPE A	MG	2,958.52	1005	2213--100200	RMVL OF FLUME	M	7.93	1195	2599--999916	('LUMP SUM' ITEM) Pavement Thickness Incentive	LS	1
	160	2122--200240	PAVED SHLD PCC 240 MM	M2	3,684.68	1015	2599--999902	('SQUARE METER' ITEM) Place CD baskets in PCC Paved Shoulder, 240mm	M2	2,612.80	1200	2599--999916	('LUMP SUM' ITEM) Relocate Chain Link Fence	LS	1
	170	2123--100200	EARTH SHLD CONSTRUCTION	M	4,918.00	1020	2599--999911	('MEGAGRAM' ITEM) Sand Blanket	MG	4,163.17	1205	2599--999916	('LUMP SUM' ITEM) Realign Type C Entrance	LS	1
	180	2213--100200	RMVL OF FLUME	EACH	2	1030	2102--100100	CL 10 EXCAVATION RDWY+BORROW Over Depth Excavation	LS	1	1210	2599--999916	('LUMP SUM' ITEM) Earth Dike	LS	1
	190	2301--133240	STD/S-F PCC PAVT CL C CL 3 240 MM	M2	17,130.01	1035	2599--999916	('LUMP SUM' ITEM) Relocate Creek Channel	LS	1	1215	2599--999916	('LUMP SUM' ITEM) Reshape Foreslope	M	392
	200	2301--153180	STD/S-F PCC PAVT CL M CL 3 180 MM	M2	1,021.30	1040	2507--002000	EROSION STONE	MG	324.3	1220	2599--999901	('METER' ITEM) Full Depth Saw Cut	M	135
	210	2301--600100	PCC PAVT SAMPLE	LS	1	1045	2599--999915	('EACH' ITEM) Removal of Light poles and Bases	EACH	14	1225	2599--999901	('METER' ITEM) Extra Cost For CD Baskets	LS	1
	220	2312--110100	GRANULAR SURF ON RD CL A CR STONE	MG	1,643.09	1055	6100--250310	EWO/OVERDEPTH EXCAVATION-SUBDRAIN/SEWER	M	489	1230	2599--999916	('LUMP SUM' ITEM) Extra Costs for Paving Ramp D	LS	1
	230	2399--100110	DETOUR PAVT	M2	8,300.33	1060	2599--999916	('LUMP SUM' ITEM) Remove RCB Culvert	EACH	12	1235	2599--999916	('LUMP SUM' ITEM) Extra Costs for Correcting Drain	LS	1
	240	2401--205030	RMVL OF INTAKE	EACH	4	1065	6100--260162	EWO/MOBILIZATION, EROSION CONTROL	EACH	12	1240	2599--999916	('LUMP SUM' ITEM) Over Depth Excavation for Selected Backfill Material	LS	1
	250	2402--220000	EXCAVATION CL 20-RDWY PIPE CULV	M3	4,325.50	1070	2422--100450	UNCL ENT PIPE CULV 450 MM	M	6.1	1245	2599--999915	('EACH' ITEM) C-1 Collar	EACH	1
	260	2416--100600	CONC 100D RDWY PIPE CULV 600 MM	M	524.11	1075	2599--999915	('EACH' ITEM) Type 3 Pipe Joint Connectors (RF-14)	EACH	3	1255	2599--999916	('LUMP SUM' ITEM) Participating Costs for Correcting Drain	LS	1
	270	2416--100750	CONC 100D RDWY PIPE CULV 750 MM	M	114.9	1080	6100--110710	EWO/WATER-DUST CONTROL	KL	880.84	1260	2599--999916	('LUMP SUM' ITEM) Price Adj. 50.8 mm Plastic Conduit	EACH	-1
	280	2416--100900	CONC 100D RDWY PIPE CULV 900 MM	M	40.81	1085	2599--999915	('EACH' ITEM) Standpipe for Erosion Control, 750 MM Dia.	EACH	1	1265	2599--999915	('EACH' ITEM) Price Adj. 50.8 mm Plastic Conduit	EACH	1
	290	2416--101050	CONC 100D RDWY PIPE CULV 1050 MM	M	52.43	1090	2599--999915	('EACH' ITEM) Standpipe for Erosion Control, 1200 MM Dia.	EACH	0	1270	6200--700041	PRICE ADJINCENTIVE-PCC PAVT SMOOTHNESS	EACH	1
	300	2416--110600	CONC 150D RDWY PIPE CULV 600 MM	M	104.25	1095	2599--999916	('LUMP SUM' ITEM) Consultant Design Fees	LS	1					
	310	2416--111200	CONC 150D RDWY PIPE CULV 1200 MM	M	48.8	1100	2599--999916	('LUMP SUM' ITEM) VEIP for Alternate On-Site Detour "C"	LS	1					
	320	2416--120600	CONC 175D RDWY PIPE CULV 600 MM	M	99.99	1105	2599--999907	('HECTARE' ITEM) Borrow Rights	HA	3.44					
	330	2416--121050	CONC 175D RDWY PIPE CULV 1050 MM	M	112.2	1110	2599--999916	('LUMP SUM' ITEM) Archeological Survey	LS	1					
	340	2416--200600	CONC PIPE ELBOW 600 MM	EACH	7	1115	2599--999916	('LUMP SUM' ITEM) VEIP for the Alternate Borrow	LS	1					
	350	2416--200900	CONC PIPE ELBOW 900 MM	EACH	1	1120	2528--102000	TEMP BARRIER RAIL	M	280.42					
	360	2416--240375	CONC PIPE APRON 375 MM	EACH	1										
	370	2416--240600	CONC PIPE APRON 600 MM	EACH	35										
	380	2416--240750	CONC PIPE APRON 750 MM	EACH	3										
	390	2416--240900	CONC PIPE APRON 900 MM	EACH	2										
	400	2416--241050	CONC PIPE APRON 1050 MM	EACH	2										
	410	2416--241200	CONC PIPE APRON 1200 MM	EACH	2										
	420	2416--281000	RMV+REINSTALL CONC APRON <= TO 1000 MM	EACH	6										
	430	2416--281001	RMV+REINSTALL CONC APRON > 1000 MM	EACH	2										
	440	2416--320600	PIPE APRON GUARD (RF-26) 600 MM	EACH	16										
	450	2417--140450	CORR POLYETHYLENE RDWY PIPE CULV 450 MM	M	27.08										
	460	2417--140600	CORR POLYETHYLENE RDWY PIPE CULV 600 MM	M	208										
	470	2417--140750	CORR POLYETHYLENE RDWY PIPE CULV 750 MM	M	185.1										
	480	2417--220450	CORR METAL DPHRGM TYPE A 450 MM	EACH	2										
	490	2417--220750	CORR METAL DPHRGM TYPE A 750 MM	EACH	4										
	500	2417--330450	CORR POLYETHYLENE PIPE ELBOW 450 MM	EACH	1										
	510	2417--330600	CORR POLYETHYLENE PIPE ELBOW 600 MM	EACH	26										
	520	2417--330750	CORR POLYETHYLENE PIPE ELBOW 750 MM	EACH	2										
	530	2417--340450	METAL APRON 450 MM	EACH	2										
	540	2417--340600	METAL APRON 600 MM	EACH	13										
	550	2417--340750	METAL APRON 750 MM	EACH	4										
	560	2422--100600	UNCL ENT PIPE CULV 600 MM	M	185.25										
	570	2422--200600	UNCL RDWY PIPE CULV 600 MM	M	23.2										
	580	2422--300600	UNCL APRON 600 MM	EACH	12										
	590	2502--140100	STD SUBDRAIN DRAIN TILE 100 MM	M	37.5										
	600	2502--140150	STD SUBDRAIN DRAIN TILE 150 MM	M	80.6										
	610	2502--140200	STD SUBDRAIN DRAIN TILE 200 MM	M	185.3										
	620	2502--140250	STD SUBDRAIN DRAIN TILE 250 MM	M	129.2										
	630	2502--140300	STD SUBDRAIN DRAIN TILE 300 MM	M	0										
	640	2502--140375	STD SUBDRAIN DRAIN TILE 375 MM	M	0										
	650	2502--200100	LONGITUDINAL SUBDRAIN (BACKSLOPE) 100 MM	M	336										
	660	2502--250100	LONGITUDINAL SUBDRAIN (SHLD) 100 MM	M	1,693.00										
	670	2502--300195	SUBDRAIN OUTLET RF-19E	EACH	26										
	680	2503--140375	CONC 100D STORM SWR 375 MM	M	50										
	690	2503--400400	INTAKE RA-40	EACH	2										
	700	2505--000100	RMVL OF GRAIL	M	242.8										
	710	2505--000200	RMVL OF POST	EACH	138										
	720	2505--000300	RMVL OF GRAIL END ANCHOR	EACH	8										
	730	2506--100000	FLOWABLE MORTAR	M3	32.11										
	740	2507--001500	REVTMENT CL E	MG	3,443.61										
	750	2507--004000	ENGINEERING FABRIC	M2	4,687.81										
	760	2510--001000	RMVL OF PAVT	M2	28,064.77										
	770	2518--000100	SAFETY CLOSURE	EACH	29										
	780	2518--100031	PERMANENT RD CLOSURE (RURAL) RE-3A	EACH	1										
	790	2519--100047	FIELD FENCE TYPE 47	M	943										
	800	2519--201800	CHAIN LINK FENCE 1.8 M (RC-10)	M	2,687.00										
	810	2520--100100	FIELD LABORATORY	EACH	1										

Revised

REFERENCE INFORMATION

100-4B
07-15-97

Data listed below is for informational purposes only and shall not constitute a basis for any extra work orders.

ITEM NO.	ITEM CODE	DESCRIPTION
22	2312--110100	Includes 792.7 Mg for entrances, 342.8 Mg for side roads and 750 Mg for maintaining local access during construction as directed by the engineer.
23	2399--100110	It shall be the contractor's option to use Class "A" P.C. Concrete, Type "B" A.C. Concrete Base (Class 1), an approved commercial mix, or a mix of higher quality for the paved detour surface. The pavement thickness shall be 200 mm for P.C. Concrete and 250 mm for A.C. Concrete. A. The area of the detour pavement constructed of the type, class and thickness specified will be determined from the dimensions shown in the contract documents. B. For the area of the detour pavement as measured above, the Contractor will be paid the contract price per square meter. These payments shall be full compensation for furnishing all tools, materials, labor, and equipment necessary for construction of the pavement in accordance with the contract documents. C. See J-Sheets and F-Sheets for locations and details.
24	2401--205030	See Tab. 110-2, Sheet C.09 for locations and details.
25	2402--220000	See Tab. 104-3 Sheets C.14 - C.16
26	2416--100600	
27	2416--100750	
28	2416--100900	
29	2416--101050	
30	2416--110600	
31	2416--111200	
32	2416--120600	
33	2416--121050	
34	2416--200600	
35	2416--200900	
36	2416--240375	See Tab. 104-58, Sheet C.05 for locations and details.
37	2416--240600	
38	2416--240750	
39	2416--240900	
40	2416--241050	
41	2416--241200	
42	2416--281000	
43	2416--281001	
44	2416--320600	
45	2417--140450	
46	2417--140600	
47	2417--140750	
48	2417--220450	
49	2417--220750	
50	2417--330450	
51	2417--330600	
52	2417--330750	
53	2417--340450	
54	2417--340600	
55	2417--340750	
57	2422--200600	
56	2422--100600	See Tab. 102-1 Sheet C.04 for locations and details.
58	2422--300600	See Tab. 102-1 Sheet C.04 and Tab. 104-3 Sheet C.14-C.16 for locations and details.
59	2502--140100	Items are for modifications to tile lines encountered during "Locating Tile Lines". Location and details to be determined at time of construction.
60	2502--140150	
61	2502--140200	
62	2502--140250	
63	2502--140300	
64	2502--140375	
65	2502--200100	See Tab. 104-9, Sheet C.07 for locations and details.
66	2502--250100	
67	2502--300195	
68	2503--140375	See Tab. 104-58, Sheet C.05 for locations and details.
69	2503--400400	See Tab. 104-5A, Sheet C.05 for locations and details.
70	2505--000100	See Tab. 110-7B, Sheet C.09 for locations and details.
71	2505--000200	
72	2505--000300	
73	2506--100000	See Tab. 110-9, Sheet C.09 for locations and details.
74	2507--001500	See Tab. X-2, Sheet C.107 or locations and details.
75	2507--004000	
76	2510--001000	See Tab. 110-1 Sheet C.09 and Tab. X-1 Sheet C.08 for locations and details.

REFERENCE INFORMATION

100-4B
07-15-97

Data listed below is for informational purposes only and shall not constitute a basis for any extra work orders.

ITEM NO.	ITEM CODE	DESCRIPTION
77	2518--000100	See Tab. 108-13A Sheet C.08 for locations and details.
78	2518--100031	Item is for permanent road closure on Old Ia. - 64 near Exit Ramp 'B'.
79	2519--100047	See Tab. 100-7B Sheet C.04 for locations and details.
80	2519--201800	
82	2523--000200	See Tab. 108-2, Sheet C.05 for locations and details item is only for conduit
83	2525--002000	See Tab. 100-17 Sheet C.04 for locations and details.
84	2525--003000	See Tab. 100-18 Sheet C.05 for locations and details.
85	2525--005000	See Tab. 100-14 Sheet C.04 for locations and details.
87	2527--101000	See Tab. 108-22 Sheet C.10 - C.12 for locations and details.
88	2527--103000	
89	2527--108000	See Tab. 108-29, Sheet C.04 for locations and details.
90	2527--108000	
91	2528--101000	See Tab. 108-23, Sheet J.01 for locations and details.
92	2528--104000	See Tab. 108-28, Sheet C.05 for locations and details.
93	2528--105000	See Tab. 108-27, Sheet C.05 for locations and details.
95	2601--103000	Included for all rural areas of the right of way as designated by the engineer. Seed Mixture (Rural) Spring--March 1 to May 20 Oats 72 kg per hectare Winter Rye 63 kg per hectare Red Clover 6 kg per hectare Timothy 6 kg per hectare Summer--May 21 to July 20 Oats 108 kg per hectare Annual Ryegrass 39 kg per hectare Red Clover 6 kg per hectare Timothy 6 kg per hectare Fall--July 21 to September 30 Oats 72 kg per hectare Winter Rye 125 kg per hectare Red Clover 6 kg per hectare Timothy 6 kg per hectare Fertilizer: Rate--500 kg of 13-13-13 or equivalent chemically combined commercial fertilizer per hectare.
96	2601--103100	Included for all urban areas of the right of way as designated by the engineer. Seed Mixture (Urban) Spring--March 1 to May 20 Annual Ryegrass 28 kg per hectare Bluegrass, Ky (Park) 17 kg per hectare Perennial Ryegrass 17 kg per hectare Summer--May 21 to July 20 Annual Ryegrass 51 kg per hectare Bluegrass, Ky (Park) 17 kg per hectare Perennial Ryegrass 17 kg per hectare Fall--July 21 to September 30 Annual Ryegrass 28 kg per hectare Bluegrass, Ky (Park) 17 kg per hectare Perennial Ryegrass 17 kg per hectare Fertilizer: Rate--500 kg of 13-13-13 or equivalent chemically combined commercial fertilizer per hectare.
97	2601--104100	Fertilizer: Rate--500 kg of 13-13-13 or equivalent chemically combined commercial fertilizer per hectare.
98	2601--104200	Areas disturbed but not seeded with stabilizing crop by September 30 shall be scarified to a 75 mm depth, fertilized and mulched. All mulch to be consolidated into the soil with the mulch stabilizer. Mulch: Rate--3.5 megagrams of dry cereal straw per hectare.

dgn = I:\WORK\project\34120\cadd\east\5315\1063.c01
prf = \\WATSON1\DA\AY\LOT\PL\463P\c02.prf
date = Tue Feb 22 14:26:40 2000
dep table = I:\Lot\Tables\half.tbl
level = 1-3,6-11,15-19,26-30,32-40,42-45,50-53,60-63

d:\work\project\34120\cadd\east\53151063.c03
 title = \\WATSON\DA\Y\PILOT\PL\463\PC03.PRF
 date = Fri Oct 29 15:53:58 1999
 level = 1-3 5-63
 den table = I:\pilot\tables\ha1.fwt.tbl

09-27-94 203-1
 Plan and profile sheets included in the project are for the purpose of alignment, location and specific directions for the work to be performed under this contract. Irrelevant data on these sheets is not to be considered a part of this contract.

09-27-94 212-1
 Sounding and test boring data shown on plans were accumulated for designing and estimating purposes. Their appearance on the plan does not constitute a guarantee that conditions other than those indicated will not be encountered.

09-27-94 213-7
 Unless otherwise directed or authorized, all asphaltic cement concrete and other bituminous materials which are not specifically addressed or described in the plans shall become the property of the contractor. The contractor, in accordance with current rules and regulations of the Iowa Department of Natural Resources, may:

09-27-94 251-1
 The contractor shall be responsible to maintain access to individual properties during construction. Relocated access shall be completed to individual properties prior to removal of existing access. If the permanent access cannot be completed prior to removal of the existing access, the contractor shall provide and maintain an alternate access. Temporary Granular Surfacing will be paid for as a contract item or by extra work.

10-27-98 203-2
 During construction of this project, the contractor will be required to coordinate his operations with those of other contractors working within the same area. Other work in progress during the same period of the time will include construction of the following projects:

Project	Type of Work
NHS-151-4(65)--19-53	Wapsi. River Bridge
NHS-151-4(66)--19-53	Ia. 1 Interchange
NHS-151-4(67)--34-53	Ia. 64 Interchange
NHSX-151-4(64)--3H-53	RCB Culverts
NHSX-151-3(102)--3H-57	US 151 Grading - Springville to Wapsi.

09-27-94 212-3
 Presplitting operation shall consist of establishing a free surface in rock by the controlled use of explosives prior to primary blasting of the main excavation. The rock cut face formed shall be at a design slope of 0.25 on 1.0 unless noted otherwise on typical sections. The presplit holes shall follow the design slope lines and shall be spaced at intervals of not more than 1.2 meters. Except for the above limitation, the procedures followed shall be as recommended by a reliable powder company. This work shall be considered incidental to Class 12 excavation.

1. With the approval of the Engineer, blend or otherwise process the material for use with shoulder or special backfill aggregate, for use on the project.
2. With the approval of the Engineer, place with material in areas designated by the Engineer as Soil Aggregate Subbase without extra charge.
3. Remove the material from the project and stockpile for the contractor's future use.

09-27-94 251-2
 The contractor is hereby notified that removal of any existing traffic markers, warning devices or guardrail barriers shall be scheduled subject to the approval of the Engineer. The contractor may be required to place temporary warning devices at certain locations where replacement features are not installed the same day during which any such removals take place.

The contractor shall submit to the Engineer a schedule for performing work items. Some items cannot be completed until prior work by other contractors has been completed. The contractor's schedule must therefore be coordinated with the schedules of others by the Engineer to obtain a schedule that is mutually acceptable. The contractor shall then perform the work as to conform to the accepted schedule.

09-27-94 213-1
 It shall be the contractor's responsibility to provide waste areas or disposal sites for excess material (excavated material or broken concrete) which is not desirable to be incorporated into the work involved on this project. No payment for overhaul will be allowed for material hauled to these sites. No material shall be placed within the right-of-way, unless specifically stated in the plans or approved by the engineer.

09-27-94 221-3
 Estimated quantity for new concrete pavement includes all integral curb, all street returns and special areas of repairs to connecting pavements.

09-27-94 251-3
 A plan for stage construction of local accesses which are required to remain open to traffic during construction shall be submitted by the contractor for approval by the engineer.

07-15-97 203-4
 The contractor is encouraged to take full advantage of specification 1105.15 - Value Engineering Incentive Proposal. A pamphlet and conceptual proposal form will be available at the preconstruction conference.

09-27-94 213-2
 The contractor's attention is directed to the following consideration in regard to removal and replacement of topsoil in borrow areas: Quantities estimated for topsoil are calculated on the basis of a uniform removal of topsoil to a depth of 0.3 meters. The material removed is to be spread uniformly to a minimum depth of 0.2 meters over the borrow area upon completion of excavation work.

09-27-94 221-4
 In order to avoid any unnecessary surface breaks or premature spalling, the contractor is cautioned to exercise extreme care when performing any of the necessary saw cutting operations for the proposed pavement removal.

10-31-95 251-4
 The centerline pavement marking shall always be placed on one side of the roadway except where a "No Passing Zone" line is used, at which point it is placed on the opposite side of the roadway. The centerline shall be placed on the same side of the roadway as to match existing markings near the project.

09-27-94 204-2
 All holes resulting from operations of the contractor, including removal of guardrail posts, fence posts, utility poles, or foundation studies, shall be filled and consolidated to finished grade as directed by the engineer to prevent future settlement. The voids shall be filled as soon as practical - preferably the day created and not later than the following day. Any portion of the right-of-way or project limits (including borrow areas and operation sites) disturbed by any such operations shall be restored to an acceptable condition. This operation shall be considered incidental to other bid items in project.

09-27-94 213-3
 All borrow areas, stockpile areas, haul roads and areas used for equipment on this project will require subsoil tillage to an average depth of 0.4 meters to 0.5 meters prior to placement of topsoil and/or stabilizing crop seeding. Such tillage shall be accomplished on maximum of one meter centers and at right angles to the finished slope of the borrow. Equipment used to accomplish the tillage shall be equipped with an arrowhead-type shoe so as to provide lateral displacement and limit the movement of the subsoil to the surface. It shall be approved by the Engineer for the use intended. This work will be considered incidental to other work on the project and no payment will be allowed. It is intended that following subsoil tillage, the area remains in a "loosened" condition. Additional compaction or the operation of heavy equipment, other than required for topsoil placement and shaping shall not be allowed on areas which have received subsoil tillage.

09-27-94 222-2
 To obtain the correct form grades at low points where intakes are located, the contractor must exercise extreme care when paving full width pavements. This may require pouring one half of the pavement at a time or other methods approved by the engineer.

09-27-94 251-5
 On all new or reconstructed pavements, the location of "NO PASSING" zone lines shall be located in the field. The locations of the proposed "NO PASSING" zone lines shown on the pavement marking tabulation is for estimating quantities only.

09-27-94 204-4
 All guardrail materials that are removed and not reused on this project shall become the property of the contractor. Any material to be used on this project that is damaged due to the carelessness of the contractor shall be replaced at the contractor's expense without cost to the State of Iowa.

09-27-94 213-8
 The top 150 millimeters of the disturbed areas shall be free of rock and debris and shall be suitable for the establishment of vegetation, subject to the approval of the Engineer.

09-27-94 232-5
 The contractor shall not disturb desirable grass areas and desirable trees outside the construction limits. The contractor will not be permitted to park or service vehicles and equipment or use these areas for storage of materials. Storage, parking and service area(s) will be subject to the approval of the resident engineer.

03-26-96 254-1
 An incident management plan, provided by the Transportation Center, will be discussed at the pre-construction conference.

07-15-97 203-6
 All the right-of-way for this project has been acquired in accordance with Standard Specification 1104.09, except the parcels listed below. The Contractor shall contact the Project Engineer prior to entering these properties to verify that acquisition has been completed.

10-27-98 213-4
 The contractor shall apply necessary moisture to the construction area and haul roads to prevent the spread of dust. Refer to Article 1107.07 of the current Standard Specifications for additional details.

10-28-97 232-10
 The contractor is expected to have materials, equipment, and labor available on a daily basis to install and maintain erosion control features on the project. This may involve seeding, silt fence, rock ditch checks, silt basins, or silt dikes.

09-27-94 261-2
 Before performing earthwork, tiling, or excavation within 91.4 meters of an existing pipeline, the contractor shall notify the pipeline company and the pipeline company shall mark the location of the pipeline as required by Section 479.47 of the Code of Iowa. The contractor shall exercise all due caution when working in the vicinity of pipelines carrying combustible or toxic materials which are present on this project. Pipeline location shown on the plans represents the best information available at the time of plan preparation.

Parcel No.	Station to Station	Reason Not Yet Available	Expected Date of Physical Occupancy
183A	158+25 159+86	In Condemnation- No Hearing date set.	Nov. 30, 1999
186	159+93 163+21	R/W revised- In Condemnation- No Hearing date set.	Nov. 30, 1999

09-27-94 213-6
 The backfilling and associated embankment construction shall be completed within 14 working days after the curing period has expired for culvert extension. The immediate embankment shall be placed to provide 8:1 slopes away from the culvert top.

09-27-94 241-1
 Road contractor is to use due caution in working over and around all tile lines. Breaks in the tile line due to the contractor's carelessness are to be replaced at his expense without cost to the State of Iowa. Any tile lines broken or disturbed by our cut lines will be replaced as directed by the engineer in charge of construction and at the State of Iowa's expense.

Revised

TABULATION OF SILT BASINS			100-14
			09-27-94
LOCATION STATION	SIDE	REMARKS	
Mainline			
150+46			
157+53			
161+73			
162+42			
Exit Ramp B			
6157+34.5			
Entrance Loop C			
7155+57			
Exit Ramp D			
8158+25			
Dubuque-130th Street			
1173+84.4			
Iowa Highway 64			
2158+75			
Shaw Road			
3137+40.4			

STAGE 2 FENCING BY GRADING CONTRACTOR					100-78
					09-27-94
After completion of Grading Work					
LOCATION	SIDE	LENGTH m	REMARKS		
Mainline : 168+00					
172+60					
RT					
344.55					
1.8 m CHAIN LINK Fe					
151+20					
153+00					
LT					
183.60					
Type 47 Field Fence					
148+15					
152+93					
RT					
462.00					
Type 47 Field Fence					
159+00					
168+00					
RT					
842.95					
1.8 m Chain Link Fe					
161+89					
172+50					
LT					
992.00					
1.8 m Chain Link Fe					
Entrance Ramp 'A'					
5156+48					
5156+71					
LT					
23.00					
Type 47 Field Fence					
Exit Ramp 'B'					
6152+93					
6155+83					
RT					
274.40					
Type 47 Field Fence					
6155+83					
6157+26					
RT					
143.34					
1.8 m Chain Link Fe					
Exit Ramp 'D'					
8158+40					
8161+89					
LT					
364.16					
1.8 m Chain Link Fe					
TOTAL TYPE 47 FIELD FENCE					
943.00					
TOTAL 1.8 m CHAIN LINK FENCE					
2687.00					

POINTS OF ACCESS (RL-7)										102-1	
										03-26-96	
Refer to Detail Cross-Sections											
LOCATION (RL-7)		PIPE CULVERT (RF-30A or RF-30B)		SURFACE MATERIAL							
Station	Side	W	TYPE	H	Size			APRON No.	Mg		
					450 mm	600 mm	750 mm				
					m	m	m				
Mainline											
144+85 NBL											
RT											
11.0											
C-Joint											
6.50											
93.30											
2											
325.01											
0.00											
148+00 NBL											
RT											
11.0											
B-Joint											
1.15											
28.50											
2											
107.98											
177+15 SBL											
LT											
7.2											
C											
NP											
0.00											
177+15 NBL											
RT											
7.2											
C											
NP											
212.99											
180+73 NBL											
RT											
7.2											
C											
NP											
22.60											
2											
0.00											
183+75 NBL											
RT											
11.0											
C-Joint											
NP											
119.95											
180+73 NBL											
RT											
12.20											
Shaw Road											
3136+91											
LT											
7.2											
C											
0.7											
14.63											
2											
0.00											
3136+91											
RT											
7.2											
C											
0.5											
14.02											
2											
26.76											
Total: 792.69											
183+75											
6.10											
CONTRACT											

TABULATION OF INTERCEPTING DITCHES				100-16
				09-27-94
LOCATION	LENGTH	REMARKS		
STATION TO STATION	SIDE			
m				
Mainline				
149+31				
151+00				
RT				
169.00				
Place Rock Flume				
151+00				
RT				
101.00				
Place Rock Flume				
Total				
270.00				

TABULATION OF SILT FENCES					100-17
					09-27-94
LOCATION		LENGTH		REMARKS	
STATION TO STATION	SIDE	m			
Mainline					
135+25					
139+65					
RT					
488					
144+15					
145+35					
RT					
132					
148+10					
150+52					
RT					
272					
150+52					
153+07.8					
RT					
285.8					
151+50					
153+50					
LT					
224					
159+55					
161+85					
RT					
254					
161+85					
163+00					
RT					
127					
163+90					
164+25					
LT					
41					
164+38					
168+30					
RT					
454					
170+70					
171+80					
RT					
122					
173+75					
176+00					
RT					
244					
179+50					
180+50					
RT					
112					
181+87					
183+00					
RT					
125					
184+10					
184+50					
RT					
46					
186+00					
187+00					
RT					
112					
Ramp A					
5154+29.6					
5155+60					
LT					
148.4					
5156+20					
5157+80					
RT					
178					
Ramp B					
6153+10					
6154+70					
RT					
178					
6157+20					
6157+40					
RT					
26					
6157+30					
6157+55					
LT					
31					
Loop C					
7154+94.3					
7155+20					
RT					
31.7					
7155+45					
7156+10					
LT					
77					
7155+95					
7156+55.3					
RT					
72.3					
Ramp D					
8158+37					
8159+50					
RT					
125					
8158+37					
8159+30					
LT					
105					
Dubuque-130th Street					
1173+75					
1174+75					
LT					
12					
Iowa Highway 64					
2156+25					
2157+25					
LT					
112					
2156+25					
2160+15					
RT					
432					
2158+55					
2159+30					
LT					
87					
Shaw Road					
3136+50					
3137+28.4					
RT					
90.4					
3136+50					
3137+28.4					
LT					
90.4					
Total Length (m):					
4840					

TABULATION OF SPECIAL EVENTS			102-15
			09-27-94
EVENT	LOCATION	DATE	
HILL CLIMBER'S COMPETITION			
STA. 134+00 RT.			
First Sunday in			
June and September			

TABULATION OF PAVEMENT MARKING SYMBOLS AND LEGENDS					108-29
					Modified
ROAD IDENTIFICATION	LOCATION	STATION	SIDE	SYMBOL	ONLY
IOWA HIGHWAY 64					
2155+80					
RT.					
TYP. 9016					
2155+95					
RT.					
TYP. 9016					
2157+08					
RT.					
TYP. 9002					
2157+20					
RT.					
TYP. 9008					
2157+31					
RT.					
TYP. 9002					
2158+87					
RT.					
TYP. 9002					
2158+99					
RT.					
TYP. 9008					
2159+10					
RT.					
TYP. 9002					
2159+62					
RT.					
TYP. 9002					
2159+75					
RT.					
TYP. 9008					
2159+89					
RT.					
TYP. 9002					
2160+30					
RT.					
TYP. 9008					
2160+39					
RT.					
TYP. 9008					
2160+47					
RT.					
TYP. 9002					
2160+79					
RT.					
TYP. 9002					
2160+87					
RT.					
TYP. 9008					
2160+96					
RT.					
TYP. 9002					
TOTAL SYMBOLS = 17					

dgn = I:\WORK\proj\sect\34120\cadd\east\53151063.c04
 prf = \\WA7501\DA\Y\PILOT\PL463P\C04.prf
 date = Tue Feb 22 14:26:50 2000

dcn = I:\work\project\34120\cadd\east\53151063.c04
 prf = \WATS01\DA\A\PILOT\PL463P\c05.prf
 date = Fri Oct 29 09:16:09 1999
 levels = 1-4, 6-11, 15-19, 26-30, 32-40, 42-45, 50-53, 60-63
 open table = I:\pilot\tables\half\rt.tbl

TABULATION OF SILT FENCES FOR DITCH CHECKS				100-18 09-27-94
LOCATION STATION	SIDE	m	REMARKS	
Mainline				
135+50	RT	6		
136+40	RT	6		
137+30	RT	6		
138+40	RT	6		
139+10	RT	6		
144+30	RT	6		
145+20	RT	6		
148+40	RT	6		
149+00	RT	6		
149+90	RT	6		
150+40	RT	6		
151+20	RT	6		
151+50	RT	6		
151+10	LT	6		
151+80	RT	6		
151+90	LT	6		
152+10	RT	6		
152+20	LT	6		
152+40	RT	6		
152+50	LT	6		
152+80	LT	6		
153+00	LT	6		
153+10	RT	6		
153+40	LT	6		
159+70	RT	6		
160+90	RT	6		
162+10	RT	6		
162+90	RT	6		
164+10	LT	6		
164+50	RT	6		
164+80	RT	6		
166+00	RT	6		
166+90	RT	6		
167+50	RT	6		
168+10	RT	6		
170+90	RT	3	V-Ditch	
171+50	RT	3	V-Ditch	
173+90	RT	6		
174+50	RT	6		
175+10	RT	6		
175+70	RT	6		
179+60	RT	6		
180+20	RT	6		
182+00	RT	6		
182+30	RT	6		
182+60	RT	6		
182+90	RT	6		
184+30	RT	6		
186+50	RT	6		

TABULATION OF SILT FENCES FOR DITCH CHECKS				100-18 09-27-94
LOCATION STATION	SIDE	m	REMARKS	
Ramp A				
5154+50	LT	6		
5154+80	LT	6		
5155+10	LT	6		
5155+40	LT	6		
5156+50	RT	6		
5157+20	RT	6		
5157+70	RT	6		
Ramp B				
6154+00	RT	6		
6157+30	RT	6		
6157+40	LT	6		
Loop C				
7155+10	RT	6		
7155+80	LT	6		
7156+20	RT	6		
Ramp D				
8158+80	RT	6		
8158+90	LT	6		
8159+20	LT	6		
Dubuque-130th Street				
1173+90	LT	6		
Iowa Highway 64				
2156+40	LT	6		
2157+00	LT	6		
2157+10	RT	6		
2158+00	RT	6		
2158+90	RT	6		
2159+90	RT	6		
2158+80	LT	6		
Shaw Road				
3136+70	RT	6		
3136+70	LT	6		
Total		444		

TABULATION OF TEMPORARY FLOODLIGHTING LUMINAIRES					108-27 04-30-96
NO.	LOCATION STATION	TYPE	NUMBER LUMIN.	REMARKS	
RAMP 'A'					
5154+00	Offset		1	Traffic Control, See Sheet J.07	
MAINLINE					
151+80	Offset		1	Haul Road, See Tab. 108-28	
152+20	Offset		1	Haul Road, See Tab. 108-28	
164+34	Offset		1	Traffic Control, See Sheet J.04	
IA - 64					
2156+50	Offset		1	Haul Road, See Tab. 108-28	
2156+90	Offset		1	Haul Road, See Tab. 108-28	
TOTAL			6		

TABULATION OF ELECTRICAL DUCTS					108-2 09-27-94
LOCATION	CONDUIT TYPE	DIA. mm	LENGTH m	REMARKS	
IA - 64					
Sta. 2156+47	Plastic	50.8	33.20	ACROSS LT HALF HWY 64	
Sta. 2159+30	Plastic	50.8	36.60	18.3 m LT OF CL	
Sta. 2159+60	Plastic	50.8	38.40	15.2 m LT OF CL HWY 64	
Ramp A					
Sta. 5158+07.4	Plastic	50.8	28	UNDER RAMP A	
Ramp B					
Sta. 6157+49	Plastic	50.8	39.60		
Ramp D					
Sta. 8158+23	Plastic	50.8	26	ACROSS RAMP D	
Chamber Drive					
Lt. 19.8 From	Plastic	50.8	27.40	19.8 m RT OF CL HWY 64	
IA - 64 CL				WEST END CONDUIT @	
Sta. 3159+60				Sta. 2159+30	
Total			228.20		

TABULATION OF TEMPORARY TRAFFIC SIGNALS						108-28 04-30-96
NO.	LOCATION STATION	NUMBER SET-UPS	TYPE			REMARKS
			One Lane Traffic	Haul Road	Intersection	
IA - 64						
2156+70		1		1		SEE RS-16
HWY. 151						
152+00		1		1		SEE RS-16

LIST OF INTAKES AND UTILITY ACCESSES						104-5A 09-27-94
NUMBER	LOCATION	TYPE OR STANDARD ROAD PLAN	FORM GRADE Elev.	BOTTOM WELL Elev.	NOTE	
IOWA HIGHWAY 64						
100	2157+23.9 Lt. 10.5 m	RA-40	247.481	244.500	TIED LAST 3 JOINTS OF STORM	
101	2157+50 Lt. 10.5 m	RA-40	247.508	245.000	SEWER PIPE (TYPE 3 RF-14)	
160+50						

LIST OF STORM SEWER PIPE													104-5B 09-27-94
LINE NUMBER	LOCATION	CLASS "D"	PIPE DIAMETER mm	LENGTH OF LINE m	SLOPE %	FLOW LINES			GRANULAR BACKFILL Mg	PIPE PROFILE SHEET NO.	NOTE		
						INLET Elevation	OUTLET Elevation	OTHER Elevation					
P-100	RF-3 Apron	100	1000	25.1	1.20%	244.560	244.260				RF-3 Apron @ Sta. 2157+00, Lt. 25.4 m.		
P-101	101	100	1000	24.9	1.81%	245.050	244.600						
TOTAL				50.0									
750				2.44							INCREASED CITY STORM SEWER LINE		

PROPOSED SUBGRADE TREATMENT

(For Additional Details see Soils Survey Sheet No. _____ to _____)

103-3

09-27-94

NO.	LOCATION		DESCRIPTION			TYPE		QUANTITY		POLYMER GRID m ²	AVAILABLE FROM		REMARKS
	Station to Station	Side	Depth	Width	Material + Shrink %	m ³	Mg	Quantity	Station to Station				
1	135+48 to 143+50	N.B.	0.6	9.2	Loam - Clay Loam F+15%	5906		66250	Borrow "A"	(151+00 - 153+00)	Includes Crossover and Storage Lanes		
2	143+50 to 151+00	N.B.	0.6	9.2	Loam - Clay Loam F+15%	4761			Borrow "A"	(151+00 - 153+00)			
3	151+00 to 157+41	N.B.	0.6	Var1.	Loam - Clay Loam F+15%	5478			Borrow "A"	(151+00 - 153+00)	Includes Ramp and Loop Tapers		
4	158+38 to 166+00	N.B.	Var1.	Var1.	Loam - Clay Loam F+15%	6102		192750	Borrow "B"	(161+75 - 164+50)	Includes Collector Lane		
5A	166+00 to 172+90	N.B.	Var1.	9.2	Loam - Clay Loam F+15%	4380			Borrow "B"	(161+75 - 164+50)	Includes Crossover and Storage Lanes		
5B	172+90 to 173+50	N.B.	0.6	9.2	Loam - Clay Loam F+15%	2070			Borrow "B"	(161+75 - 164+50)	Includes Crossover and Storage Lanes		
6	173+50 to 181+00	N.B.	0.6	9.2	Loam - Clay Loam F+15%	5334			Borrow "B"	(161+75 - 164+50)	Includes Crossover and Storage Lanes		
7	181+00 to 187+25	N.B.	0.6	9.2	Loam - Clay Loam F+15%	3968			Borrow "A"	(161+75 - 164+50)			
8	150+00 to 157+41	S.B.	0.6	Var1.	Loam - Clay Loam F+15%	4644			Borrow "A"				
9	158+38 to 164+00	S.B.	0.6	Var1.	Loam - Clay Loam F+15%	4429			Borrow "B"				
SUBTOTAL =						47,735.9							
10	5154+38 to 5155+00		Var1.	Var1.	Loam - Clay Loam F+15%	1915			Borrow "A"		Includes Return to IA 64		
11	6152+92 to 6157+60		0.6	Var1.	Loam - Clay Loam F+15%	2754			Borrow "A"		Includes Return to IA 64		
12	7154+94 to 7156+55		0.6	7.5	Loam - Clay Loam F+15%	833			Borrow "A"				
13	8158+13 to 8162+05		0.6	Var1.	Loam - Clay Loam F+15%	495			Borrow "B"		Includes Return to IA 64		
14	2156+25 to 2159+00		0.3	16.4	Special Backfill Art. 4132		3035						
SUBTOTAL =						5997.0							
TOTAL :						53,732.90							

EMBANKMENT WITH MOISTURE CONTROL

103-6

09-27-94

Moisture content shall be within the limits of minus _____ and plus _____ percentage points of optimum for maximum density within the area described and listed below.

LOCATION	DEPTH	COMPACT	REMARKS
Station to Station	Lane	m	m ³
144+00 to 144+50	1	Start 8 m below grade	5097.5 ML

Note: Moisture control is required for all fill placed at a level of more than 8 meters below profile grade at any location. This does include backfill for culverts, including separate culvert contracts, but excludes stability berms beyond the normal foreslope template line. This shall include but not be limited to the following locations.

SHRINKAGE DATA

103-7

09-27-94


COUNTY: _____ DATE: _____
PROJECT: _____

STATION TO STATION	%	REMARKS
All ML cut	30%	
Borrow - "A" Previous "C"	30%	
Borrow - "B" Previous "D"	20%	
Limestone	0%	
Boulder Est. 500 cu. m		

TABULATION OF SPREADING TOPSOIL

103-4


10-27-98

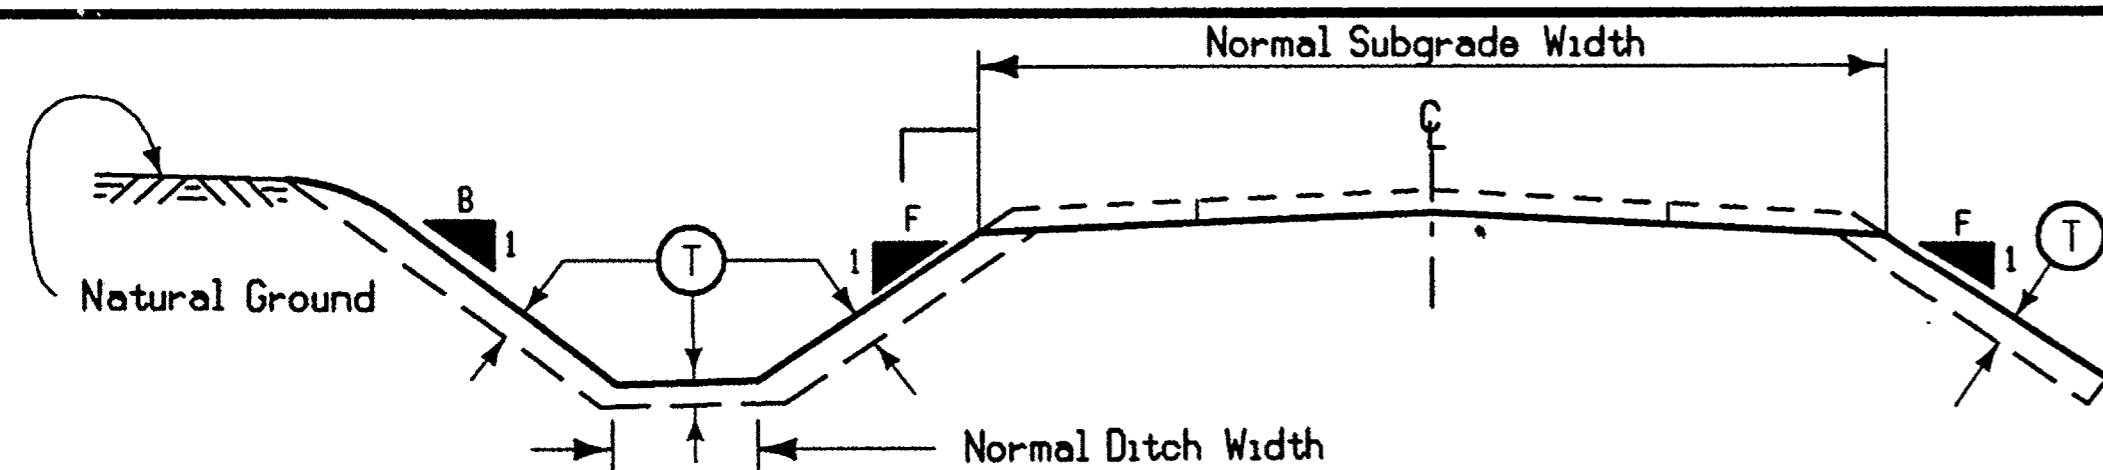

NOTE:
This work shall be done in accordance with current specifications for "Stripping, Salvaging, and Spreading Topsoil". Prior to placing of topsoil on any cohesive soil, the area to be covered shall be scarified to a minimum depth of 75 mm.
Appropriate adjustments have been made in the template quantities to reflect the placement of topsoil on foreslope, backslope and ditch bottom as detailed herein.

AREA No.	QUANTITY m ³ (1)	PLACEMENT DESCRIPTION				TOPSOIL EXCAVATION AVAILABLE FROM Station to Station	REMARKS
		LOCATION Station to Station	SIDE L or R	SLOPE B or F	(T) mm		
	1096.2	136+50	138+50	R	BOTH	200	Mainline as indicated on T-sheets.
	11667.6	141+00	156+00	R	F	200	
	9424.8	156+00	164+50	BOTH	BOTH	200	
	432.6	168+00	169+00	R	BOTH	200	
	152.6	172+00	172+50	R	BOTH	200	
	1675.8	Ramp A 5154+30	5158+00	BOTH	F	200	Ramp A
	1366.4	Ramp B 6153+10	6157+61	BOTH	F	200	Ramp B
	333.2	Loop C 7155+00	7156+55	BOTH	F	200	Loop C
	1594.6	Ramp D 6158+13	6161+89	BOTH	F	200	Ramp A/ Ramp D Mainline
	2720	IA 64 2156+25	2161+15	BOTH	F	200	Ramp B/ Loop C

(1) Includes 40% shrink 30, 124m³

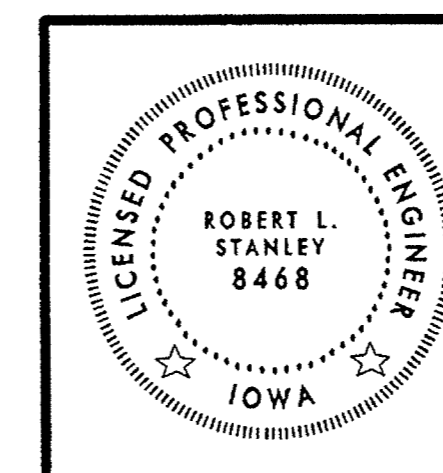

I hereby certify that this plan was prepared under my supervision and that engineering decisions with regard to the design were made by me or by other duly licensed Professional Engineers under the laws of the State of Iowa.

Signature: *Robert L. Stanley* Date: 11-1-99
Printed or Typed Name: Robert L. Stanley

My license renewal date is December 31, 2000.

Pages or sheets covered by this seal: C.06, C.07, 0.01-0.13

dgn = I:\work\proj\sect\34120\caddy\east\53151063.c04
 prf = \WA\SOI\DA\Y\PILOT\PL463P\C06.prf
 date = Fri Oct 29 09:16:20 1999
 level = 1-4, 6-11, 15-19, 26-30, 32-40, 42-45, 50-53, 60-63
 pen table = I:\pilot\tables\half.tbl

dgn = I:\work\project\34120\cadd\east\b31b1063.c04
 prf = \\WATSO1\DA\PL\LOT\PL463P\c07.prf
 date = Fri Oct 29 09:16:28 1999
 level = 1-4,6-11,15-19,26-30,32-40,42-45,50-53,60-63
 den table = I:\lot\tables\ha\fv.tbl

- ① Refer to Standard Road Plan RF-19C.
- ② Refer to Soils Sheets

TABULATION OF LONGITUDINAL SUBDRAIN SHOULDER AND BACKSLOPE

104-9
03-28-95
*Not a bid item

Line No.	Road or Lane Ident.	LOCATION Station to Station		Side	LONGITUDINAL SUBDRAIN				SUBDRAIN OUTLET RF-19E or RF-22		POROUS BACKFILL* Mg	CLASS "A" CRUSHED STONE * Mg	REMARKS	
					Depth Ⓚ m	Shoulder ①		Backslope ②		Station				Type
						Dia. mm	Length m	Dia. mm	Length m					
1	US 151	145+94	148+20	RT	1.8				231.0	145+94 148+20	19.E 19.E	113		.30 m BELOW DITCH BOTTOM
50	US 151 SBL	151+00	152+50	LT	1.1	165				151+00 152+50	E E	68.6	0.9	ALONG RAMP TAPER
51	US 151 SBL	152+50	154+30	LT	1.1	196				152+50 154+30	E E	81.1	0.9	ALONG RAMP TAPER
74	IA 64	2156+25	2156+90	RT	1.1	69				2156+25 2156+90	E E	45.6	0.9	
75	IA 64	2156+90	2158+70	RT	1.1	198				2158+70 2158+70	E E	68.6	0.9	
76	IA 64	2158+70	2159+80	RT	1.1	126				2159+80 2159+80	E E	51.8	0.9	
77	Ramp A	5154+30	5156+00	LT	1.1	185				5154+30 5156+00	E E	76.9	0.9	
78	Ramp A	5156+00	5157+50	LT	1.1	164				5156+00 5157+50	E E	68.6	0.9	
79	Ramp A	5157+50	5158+00	LT	1.1	65				5157+50 5157+50	E E	26.8	0.9	
80	Ramp A	5158+00	5158+25	LT	1.1	39				5158+00 5158+00	E E	16.3	0.9	Around Return
87	Ramp D	8158+22	8159+20	LT	1.1	115				8158+22 8159+20	E E	51.8	0.9	
88	Ramp D	8159+20	8160+50	LT	1.1	145				8159+20 8160+50	E E	60.2	0.9	
89	Ramp D	8160+50	8161+89	LT	1.1	155				8160+50 8161+89	E E	70.6	0.9	
	Ramp B	6155+30	6156+35	RT				100	105.0	6155+30 6156+35	19.E 19.E			(EXTRA) SOUTH OF SUPER 8 MOTEL
	US 151 SBL	150+01	151+00	LT		100	110			150+01 151+00	E E			CONTINUED TO EXISTING S.B. LANES (EXTRA)

Tabulation of Rock Flumes and Ditches					X-22 10/29/1999
Location	Width	Rock	Eng. Fabric	Type	Remarks
Type: (1) Rip Rap (2) Erosion Stone					
Mainline					
Sta. 135+07 - 135+25	4.6 m	86.15 mg	81.80 m2	1	Length = 17.80 m
Sta. 135+25 - 136+25	4.5 m	248.64 mg	450.0 m2	1	Length = 100.0 m (rt) broken concrete
Sta. 135+32		13.58 mg		2	Median
Sta. 135+35	3.5 m	110.25 mg	35.0 m2	1	Length = 10.0 m (top of backslope)
Sta. 136+25 - 137+10	6.0 m	217.56 mg	510.0 m2	1	Length = 85.0 m (rt) broken concrete
Sta. 136+30		13.58 mg		2	Median
Sta. 137+03 - 137+40	4.4 m	125.57 mg	162.80 m2	1	Length = 37.0 m (rt)
Sta. 138+02		13.58 mg		2	Median
Sta. 138+76		13.58 mg		2	Median
Sta. 139+50		13.58 mg		2	Median
Sta. 140+24		13.58 mg		2	Median
Sta. 141+00		13.58 mg		2	Median
Sta. 141+87		13.58 mg		2	Median
Sta. 142+48		13.58 mg		2	Median
Sta. 143+09		13.58 mg		2	Median
Sta. 143+40 - 143+65 (rt)	4.5 m	143.19 mg	113.40 m2	1	Length = 25.20 m
Sta. 143+67		13.58 mg		2	Median
Sta. 144+31		13.55 mg		2	Median
Sta. 151+00	4.6 m	40.97 mg	59.80 m2	1	Length = 13.0 m (rt) backslope
Sta. 151+31 - 151+83	5.1 m	82.22 mg	264.18 m2	1	Length = 51.80 m
Sta. 151+83 - 152+07	5.1 m	159.29 mg	122.40 m2	1	Length = 24.0 m
Sta. 152+07 - 152+65	5.1 m	223.56 mg	301.92 m2	1	Length = 59.20 m
Sta. 152+65 - 153+20	5.1 m	182.59 mg	280.50 m2	1	Length = 55.0 m
Sta. 157+65	5.1 m	12.50 mg	38.76 m2	1	Length = 7.60 m
Sta. 173+32 - 173+71 (rt)	4.5 m	199.91 mg	175.50 m2	1	Length = 39.0 m
Sta. 174+04		12.03 mg		2	Median
Sta. 174+32		12.04 mg		1	Median
Sta. 174+62		12.04 mg		1	Median
Sta. 174+92		12.04 mg		1	Median
Sta. 175+22		12.04 mg		1	Median
Sta. 175+52		12.04 mg		1	Median
Sta. 175+82		12.04 mg		1	Median
Sta. 176+12		12.00 mg		1	Median
Sta. 181+87 - 183+00	4.5	637.97 mg	508.50 m2	2	Length = 113.0 m
Entrance Ramp A					
Sta. 5155+35 - 5156+13	5.10 m	300.73 mg	403.41 m2	1	Length = 79.10 m
Sta. 5156+00 - 5156+38	6.35 m	170.79 mg	242.57 m2	1	Length = 38.20 m
Sta. 5156+60 - 5156+83.6	8.20 m	90.68 mg	193.52 m2	1	Length = 23.60 m
Sta. 5157+74 - 5157+80	5.10 m	94.88 mg	93.33 m2	1	Length = 18.30 m
Sta. 5157+90 - 5158+10.7	5.60 m	37.47 mg	115.92 m2	1	Length = 20.70 m
Exit Ramp D					
Sta. 8161+81 - 8161+90	16.20 m	x	145.80 m2	x	Length = 9.00 m
Exit Ramp B					
Sta. 6155+90	5.80 m	53.79 mg	60.32 m2	2	Length = 10.40 m
Sta. 6155+90	7.35 m	136.54 mg	105.15 m2	1	Length = 14.30 m
Sta. 6155+90	6.90 m	48.78 mg	80.40 m2	1	Length = 11.60 m
Iowa HWY 64					
Sta. 2156+83 - 2157+02	4.50 m	66.33 mg	85.50 m2	1	Length = 19.0 m
Sta. 2158+52	4.50 m	27.40 mg	34.20 m2	1	Length = 7.60 m (Flume)
Sta. 2160+57	3.50 m	11.29 mg	23.45 m2	2	Length = 6.70 m

Tabulation of Tile Lines

Station To Station	Type	Depth	Remarks
159+65	200 Plastic		Lt. foreslope, line from behind Walmart
160+86	100mm Plastic	1.12 m	Running NW
161+04	150mm Concrete	1.68 m	Running EW
161+09	75mm Clay	1.47 m	Running EW
161+09	200 mm Plastic		Lt. side, empty's into Fawn Creek
161+86	100 mm Clay	1.37 m	
162+51	75mm Clay	.91 m	Running SW
170+50 - 171+50	100mm Clay		
173+50 - 175+70	100mm		Found under pipe
181+89	200 Plastic		Rt. Ditch, tile line through NBL
186+00 - 187+12			Found 2 lines
187+20	200 Plastic		Rt. Backslope, tile line out of old farmstead
2059+66	200 Plastic		Lt. Side HWY 64, tile line from Theisen's roof
2060+18	200 Plastic		Lt. Side HWY 64, tile line from Goodyear Store

DRAINAGE STRUCTURES BY CULVERT CONTRACTOR

104-4
04-30-96

LOCATION	DESIGN NUMBER	SIZE m	KIND	LENGTH NEW CONST. m	NO. OF APRONS	FLOW LINE ELEVATION				DIMENSIONS - m				SKEW AHEAD		BY ROAD CONTRACTOR				REMARKS
										Total		Extensions		Degrees		DIKE			COMP. BACKFILL m ³	
						Left	Right	Other	Other	Left	Right	Left	Right	Left	Right	Lt.	Rt.	LOCATION STATION		
143+97.1	1198	0.9 X 0.9	RCB Ext. w/ Flume	95.1		261.96	251.50	255.67	250.00		137.90		95.1	15					⊗	Remove Existing Flume and Extend Rt.
153+54.3	1398	0.9 X 0.9	RCB Ext. Lt./Rt.	74.2		242.80	251.80	241.30 243.08	250.50	67.90	84.31	15.8	58.4	30					⊗	Remove Exist. Flume Lt. and Extend Lt. and Rt.
164+07.9	1698	3.6 X 3.6	RCB Ext. Lt./Rt.	46.8		244.20	244.80	244.24	244.40	16.73	46.93	8.3	38.5	30					⊗	Extend Left and Right.
186+03.92	1798	0.9 X 0.9	RCB Ext. w/ Flume	34.7		273.22	270.85	271.70	269.37		59.90		34.7	10					⊗	Remove Existing Flume and Extend Rt.
																			⊗	TOTAL
																			⊗	ITEM NOT USED

TABULATION OF GRADING FOR GUARDRAIL INSTALLATIONS

107-23
04-27-99

① Lane(s) to which the installation is adjacent. ② Refer to Standard Road Plans RL-12, RL-14, and Typicals 4303 or 4306.

No.	Direction of Traffic	LOCATION POINT		SIDE	TYPE	DIMENSIONS ②				CLASS 10 EXCAV. (1) m ³	EMBANK. IN PLACE m ³	PIPE			REMARKS
		Station				Ⓚ		Ⓢ				Size mm	Type	Length m	
						A	T	A	T						
1		157+14.918		Med.	5					250					
2		158+65.835		Med.	5					250					
3	NB	157+54.100		Rt.	2	2.5		15.3		100					
4	SB	158+25.200		Lt.	2	2.5		15.3		100					
5		137+76.586		Med.	5					250					

(1) Quantity Added to Templates Quantities. See the T-Sheets for the Tabulation of Earthwork.

TABULATION OF SAFETY CLOSURES

108-13A
10-28-97

Refer to Section 2518 of the Standard Specifications

STATION	CLOSURE TYPE		REMARKS
	Road Qty.	Hazard Qty.	
MAINLINE			
135+32.717			1 Bridge Approach
137+62	2		Access Location
143+97.1			2 0.9 m x 0.9 m RCB Ext.
149+90	1		Stage 3
153+54.3			4 0.9 m x 0.9 m RCB Ext.
157+70	3		Stage 5
157+90.6			4 Bridge Approach
164+07.9	2		3.6 m x 3.6 m RCB Ext.
173+20	2		Break in Grading
186+03.9	2		0.9 m x 0.9 m RCB Ext.
IA. 64			
2156+25	1		Stage 2
2157+05	1		Stage 3
2157+00	1		Stage 6
ENT. RAMP 'A'			
5158+05	1		Stage 3
EXIT RAMP 'B'			
6157+50	1		Stage 6
EXIT RAMP 'D'			
8158+35	1		Stage 2
Subtotal	12	17	
Total		29	

**TABULATION OF
DETOUR PAVEMENT**

X-1
06-03-99

LOCATION STATION	SHEET NO.	SPECIAL BACKFILL (Mg)	AREA (Sq. m)
2156+02 To 2157+22	J.03	37.3	379.93
2156+90 To 2157+05		37.3	157.85
		41.7	
8161+89 To 164+41	J.04	217.2	1587.99 (4)
2156+88 To 2158+18	J.05		332.41
2158+36 To 2160+50		330.4	852.82
2161+38 To 2162+04		43.3	73.99
148+12 To 155+59	F - SHEETS	2197.9	4915.34
	TOTALS	2905.2	8300.33

(1) PAVEMENT WILL NOT BE REMOVED UNDER THIS CONTRACT.

gdp = I:\work\project\34120\cadd\east\53151063.c04
 pcf = \\WATSON\DATA\PLT\PL463P\C08.prf
 Date = Fri Oct 29 08:55:39 1999
 pen table = I:\plot\tables\half.tbl
 levels = 1-4,6-11,15-19,26-30,32-40,42-45,50-53,60-63

TABULATION OF PAVEMENT MARKINGS

108-22
10-31-95

- ② Broken Center Line (Yellow)
- ⑤ No-Passing Zone Line (Yellow)
- ⑦ Edge Line Right (White)
- ⑨ Dotted Line (White)
- ⑪ Channelizing Line (White)
- ⑬ Stop Line (White)
- ⑮ Yellow Curb
- ③ Double Center Line (Yellow)
- ⑥ Broken Lane Line (White)
- ⑧ Edge Line Left (Yellow)
- ⑩ Solid Lane Line (White)
- ⑫ Channelizing Line (Yellow)
- ⑭ Crosswalk Line (White)
- ⑯ White Curb

ROAD IDENTIFICATION	LOCATION STATION TO STATION		SIDE L R		LENGTH (m)												REMARKS		
					②	③	⑤	⑥	⑦	⑧	⑨	⑩	⑪	⑫	⑬	⑭		⑮	⑯
STAGE 2																			
IOWA HIGHWAY 64	2154+70	2156+25	X														Place Removable Tape Marking		
	2155+10	2156+25		X					115								Place Removable Tape Marking		
	2156+25	2157+20		X					95										
	2156+25	2157+65	X							140									
	2156+00	2156+85	X							85									
STAGE 3																			
IOWA HIGHWAY 64	2155+60	2156+25	X						65								Place Removable Tape Marking		
	2154+70	2156+25	X							155							Remove Removable Tape Marking		
	2155+10	2156+25		X					115								Remove Removable Tape Marking		
	2155+62	2156+25		X						63							Place Removable Tape Marking		
	2157+20	2157+65		X						95							Place Removable Tape Marking		
	2156+25	2157+20		X						45							Place Removable Tape Marking		
	2157+20	2157+65		X						65									
	2155+60	2156+25		X															
STAGE 4																			
MAINLINE	166+50	170+40	CL				390												
	166+50	170+40	CL		390														
	163+80	170+40	CL			680											Pavement Marking Removed		
	162+00	166+50		X					450										
	162+05	166+50	X						445										
	162+05	166+50	CL			445													
ON-SITE DETOUR 'C'																			
	8148+00	8156+95	X						1025										
	8149+85	8155+25		X					560										
	8148+00	8155+70	CL			770													
	8155+25	8156+53		X					128								Place Removable Tape Marking		
	8155+70	8156+53	CL			83											Place Removable Tape Marking		
	8158+13	8162+05	X						392										
	8158+13	8162+05		X					392										
	8158+13	8162+05	CL			392													
ENTRANCE RAMP 'A'																			
	5156+53	5158+15	CL			162													
	5156+53	5158+15		X					162										
	5156+95	5158+15	X						120										
	5158+08			X								22							
IOWA HIGHWAY 64																			
	2156+60			X								7							
	2156+85		X									4							
EXIT RAMP 'D'																			
	8158+20		X									12							
STAGE 5																			
IOWA HIGHWAY 64	2155+60	2156+25	X						65								Remove Removable Tape Marking		
	2155+62	2156+25		X					63								Remove Removable Tape Marking		
	2157+20	2157+65		X					45								Remove Removable Tape Marking		
	2157+20	2157+65		X					360								Remove Removable Tape Marking		
	2156+90	2160+50		X					360										
	2156+90	2160+50	X						360										
	2158+90	2160+50	CL						360										

dgn = I:\WORK\project\34120\cadd\east\p31b1063.c10
 prf = I:\WORK\project\34120\cadd\east\p31b1063.c10.prf
 date = Tue Feb 22 14:27:00 2000

TABULATION OF PAVEMENT MARKINGS

108-22
10-31-95

ROAD IDENTIFICATION	LOCATION		LENGTH (m)																REMARKS
	STATION TO STATION		SIDE		②	③	⑤	⑥	⑦	⑧	⑨	⑩	⑪	⑫	⑬	⑭	⑮	⑯	
	L	R	L	R															
Marking Length Subtotal					415	1769	390	310	5807	980	0	310	0	753	73	0	0	0	
Quantity Factors					0.25	2.00	1.00	0.25	1.00	1.00	0.33	1.00	2.00	2.00	6.00	1.50	1.00	1.00	
Pavement Marking Total					103.75	3538	390	77.5	5807	980	0	310	0	1506	438	0	0	0	
TOTAL PAINTED PAVEMENT MARKINGS					13150.25														
Removable Tape Marking Subtotal					0	83	0	0	972	487	0	0	0	0	0	0	0	0	
Quantity Factors					0.25	2.00	1.00	0.25	1.00	1.00	0.33	1.00	2.00	2.00	6.00	1.50	1.00	1.00	
Pavement Marking Total					0	166	0	0	972	487	0	0	0	0	0	0	0	0	
TOTAL REMOVABLE TAPE MARKINGS					1625														
Pavement Markings Removed Subtotal					0	904	0	0	495	235	0	0	0	0	0	0	0	0	
Quantity Factors					0.25	2.00	1.00	0.25	1.00	1.00	0.33	1.00	2.00	2.00	6.00	1.50	1.00	1.00	
Pavement Marking Total					0	1808	0	0	495	235	0	0	0	0	0	0	0	0	
TOTAL PAVEMENT MARKINGS REMOVED					2538														
Removable Markings Removed Subtotal					0	0	0	0	180	487	0	0	0	0	0	0	0	0	
Quantity Factors					0.25	2.00	1.00	0.25	1.00	1.00	0.33	1.00	2.00	2.00	6.00	1.50	1.00	1.00	
Pavement Marking Total					0	0	0	0	180	487	0	0	0	0	0	0	0	0	
TOTAL REMOVABLE MARKINGS REMOVED					667														

dgn = I:\WORK\PROJECTS\4120\cadd\east\3d1b1063.c10
 prf = I:\WORK\PROJECTS\4120\cadd\east\3d1b1063.c10
 date = Tue Feb 22 14:27:23 2000
 pen table = I:\p101\tables\half.ctb

POLLUTION PREVENTION PLAN

110-12
09-27-94

All contractors / subcontractors shall conduct their operations in a manner that minimizes erosion and prevents sediments from leaving the highway right-of-way. The prime contractor shall be responsible for compliance and implementation of the Pollution Prevention Plan (PPP) for their entire contract. This responsibility shall be further shared with subcontractors whose work is a source of potential pollution as defined in this PPP.

1. SITE DESCRIPTION

This Pollution Prevention Plan (PPP) is for the construction on the four-lane improvement of U.S. 151 from the existing four-lane highway east of Springville to north of Anamosa.

This PPP covers approximately 200 hectares with an estimated 122 hectares being disturbed.

The project is located in an area of 3 soil associations (Fayette, Dinsdale-Tama, Kenyon-Floyd-Clyde). The estimated average SCS runoff curve number for this PPP after completion will be 66.3.

Refer to the grading plans (Linn and Jones counties, NHSX-151-3(102)--3H-57 and NHSX-151-4(63)--3H-53) for locations of typical slopes, ditch grades, and major structural and non-structural controls. A copy of this plan will be on file at the project engineer's office. Runoff from this project will flow into various unnamed ditches and waterways, Dutch Creek and Fawn Creek which flow into the Wapsipinicon River and East Big Creek which flows into the Cedar River.

POTENTIAL SOURCES OF POLLUTION:

Site sources of pollution generated as a result of this work relate to silts and sediment which may be transported as a result of a storm event. However, this PPP provides conveyance for other (non-project related) operations. These other operations have storm water runoff, the regulation of which is beyond the control of this PPP. Potentially this runoff can contain various pollutants related to site-specific land uses. Examples are:

Rural Agricultural Activities:
Runoff from agricultural land use can potentially contain chemicals including herbicides, pesticides, fungicides and fertilizers.

Commercial and Industrial Activities:
Runoff from commercial, industrial, and commerce land use may contain constituents associated with the specific operation. Such operations are subject to potential leaks and spills which could be commingled with runoff from the facility. Pollutants associated with commercial and industrial activities are not readily available since they are typically proprietary.

POLLUTION PREVENTION PLAN

110-12
09-27-94

2. CONTROLS

Prior to beginning grading, excavation or clearing and grubbing operations, silt fence shall be placed along the perimeter of the areas to be disturbed at locations where runoff can move offsite. Vegetation in areas not needed for construction shall be preserved. As areas reach their final grade, additional silt fences, silt basins, intercepting ditches, sod flumes, letdowns, bridge end drains, and earth dikes shall be installed as specified in the plans and/or as required by the project engineer. This will include using silt fence as ditch checks and to protect intakes. Temporary stabilizing seeding shall be completed as the disturbed areas are constructed. If construction activity is not planned to occur in a disturbed area for at least 21 days, the area shall be stabilized by temporary seeding or mulching within 14 days. No more than 70,000 square meters of exposed erodible area is allowed in any one grading spread without permission of the project engineer. Other stabilizing methods shall be used outside the seeding period.

This work shall be done in accordance with Section 2525 of the Standard Specification. If the work involved is not applicable to any contract items, the work shall be paid for according to Article 1109.03 paragraph B.

As the work progresses, additional erosion control items such as sod flumes, ditch checks, rock outlet protection, and letdown structures and other appropriate measures shall be installed by the grading contractors as determined by the engineer after field investigation. The construction will be completed with the establishment of permanent perennial vegetation of all disturbed areas by the grading contractors.

3. OTHER CONTROLS

Contractor disposal of unused construction materials and construction material wastes shall comply with applicable state and local waste disposal, sanitary sewer, or septic system regulations. In the event of a conflict with other governmental laws, rules and regulations, the more restrictive laws, rules or regulations shall apply.

APPROVED STATE OR LOCAL PLANS:
During the course of this construction, it is possible that situations will arise where unknown materials will be encountered. When such situations are encountered, they will be handled according to all federal, state, and local regulations in effect at the time.

4. MAINTENANCE

The contractor is required to maintain all temporary erosion control measures in proper working order, including cleaning, repairing or replacing them throughout the contract period. Cleaning of silt control devices shall begin when the features have lost 50% of their capacity.

POLLUTION PREVENTION PLAN

110-12
09-27-94

5. INSPECTIONS

Inspections shall be made jointly by the contractor and the contracting authority every seven calendar days and after each rain event that is 13mm or greater. The contractor shall immediately begin corrective action on all deficiencies found. The findings of this inspection shall be recorded in the project diary. This PPP may be revised based on the findings of the inspection. The contractor shall implement all revisions. All corrective actions shall be completed within 3 calendar days of the inspection.

6. NON-STORM DISCHARGES

This includes subsurface drains (i.e. longitudinal and standard subdrains), slope drains and bridge end drains. The velocity of the discharge from these features may be controlled by the use of patio blocks, Class A stone or erosion stone.

dgn = I:\work\project\34120\cadd\east\531b1063.c13
prf = \\WATSO1\DATA\PLLOT\PL463P\c13.prf
date = Fri Oct 29 15:44:50 1999
dep table = I:\plot\tables\halif.tbl

DRAINAGE STRUCTURE BY ROAD CONTRACTOR

104-3

12-03-96

* Not a bid item

LOCATION	TYPE	SIZE mm	KIND OF PIPE	LENGTH NEW CONST. m	BEDDING CLASS	DESIGN COVER (D)	CAMBER m	APRON NO.		ADAPTORS* RF-2		CONNECTED PIPE JOINT* RF-14		FLOW LINE ELEVATIONS			DIMENSIONS m				SKEW AHEAD Degrees		DIKE				CLASS 20 m ³	EMBANK- MENT IN PLACE m ³	REMARKS	
								Inlet	Outlet	Type	No.	Type	No.	Lt.	Rt.	Other	Total		Extensions		Lt.	Rt.	Lt.	Rt.	Type	Location Station				Top Elevation
																	Lt.	Rt.	Lt.	Rt.										
136+25 NBL	1501 Med.	600	1000 PEP	17.64 10.61	C	0.8		1				3	6	239.800 239.599	239.599 237.035	237.075		9.89	21.80									16		Apron guard on inlet end. Use two 18" PEP elbows. A=17.64, B=7.94, C=0.61, E=2.06, Q=1.98
137+90 NBL	1101 Med.	600	1000	24.38	C	1.1		1	1			3	6	241.978	241.030			11.88	16.24									20		Apron guard on inlet end.
139+95 NBL	1401 Side	450	PEP	27.08	C	1.1		1	1					250.554	245.000	245.072					21	Rt.	139+93	250.950	F				Use one 11" PEP elbow and two Type A diaphragms. F.L. Lt.=29.8 m Rt. and F.L. Rt.=42.5 m Rt. Dike is 30.6 m Rt., 1.5 m wide, inlet slope=6:1, and outlet slope=5.5:1. A=5.22, B=25.37, Q=2.01	
141+50 NBL	1501 Med.	600	1000 PEP	20.08 18.16	C	0.8		1				3	6	256.661 256.435	256.435 251.477	251.517		9.51	31.77				Med.	141+37	257.300	M	3		Apron guard on inlet end. Use two 18" PEP elbows. A=20.08, B=15.49, C=0.61, E=2.06, Q=1.98 Subgrade superelevation=7.31%	
143+24.0	1305	600	1750 PEP	26.84 59.49	C	5.9						3	13	262.491ex 259.411	259.411 251.500	259.624ex 251.583					11	Ext.					881		Remove flume. Use one 4" RCP elbow, one 11" RCP elbow, and two 8" PEP elbows. Place 11" bend at 23.6 offset from O.R. A=20.73, B=52.58, C=0.61, E=6.30, Q=1.98	
144+15 NBL	1401 Side	750	PEP	101.07	C	1.6		1	1					261.700	251.500	251.680						18	Rt.	144+11	262.600	F			Use one 6" PEP elbow and two Type A diaphragms. F.L. Lt.=57.4 m Rt. and F.L. Rt.=89.5 m Rt. Dike is 58.7 m Rt., 1.6 m wide, inlet slope=6:1, and outlet slope=9.5:1. A=15.17, B=84.80, Q=2.82	
145+11.1 NBL	1201 Med.	600	1500	65.23	C	4.1		1	1			3	37	271.233	264.093	264.257		11.54	57.41			31	Rt.	145+36	265.250	M	0		Apron guard on inlet end. Use one 7" RCP elbow. F=16.41 m Build dike at 56.9 m Rt. for cover.	
147+80 NBL	1101 Med.	600	1000	20.12	C	0.8		1	1			3	6	274.194	273.994			10.02	13.83								38		Apron guard on inlet end. Flatten foreslope per Typical 4304.	
150+58.6	1302	900	1000	28.65	C	1.6		1				3	17	255.515ex	265.250	262.445ex											29.5		Remove inlet apron and top of headwall. Use one 12" RCP elbow. Steepen foreslope to tie in to existing RCB outlet. REMOVE FLUME	
151+00 NBL	1101 Med.	600	1000	23.16	C	1.1		1	1			3	6	266.65	265.526			10.05	16.85				Med.	151+11	267.300	M	91		Apron guard on inlet end.	
153+15 NBL	1401 Side	750	PEP	84.07	C	1.8		1	1					251.75	242.850	242.967						15	Lt.	153+22	253.000	F			Use one 6" PEP elbow and two Type A diaphragms. F.L. Lt.=55.8 m Lt. and F.L. Rt.=78.3 m Lt. Dike is 57.6 m Lt., 8.3 m wide, inlet slope=2.5:1, and outlet slope=8:1. A=9.70, B=74.36, Q=1.95	
155+35 NBL	1101 Med.	600	1000	20.73	C	0.9		1	1			3	6	255.408	254.825			9.99	14.47								85		Apron guard on inlet end.	
156+90 NBL	1501 Med.	600	1000 PEP	24.34 19.51	C	0.7		1				3	6	255.221 254.953	254.953 249.588	249.629		9.51	37.33								87		Apron guard on inlet end. Depressed inlet=0.01 m Use two 18" PEP elbows. A=24.34, B=18.77, C=0.61, E=2.14, Q=1.98	
157+65.4	1101	1050	1750	112.20	C	6.2		1	1			3	63	243.000	246.500			61.50	55.55				10				1157			
161+85.7	1301-X	1050	1000	52.43	C	2.4						3	30	244.800	246.100	245.798ex 245.235ex		47.98	31.54	21.95	35.36						56		Remove and reinstall both aprons.	

dgm = I:\work\proj\sect\34120\cadd\east\53151063.c14
 pff = \\WATSON\DA\PILOT\PL163P\C14.pff
 Date = Fri Oct 29 15:45:00 1999
 levels = 1-3, 6-11, 15-19, 26-30, 32-40, 42-45, 50-53, 60-63
 den table = I:\work\proj\sect\34120\cadd\east\53151063.tbl

DRAINAGE STRUCTURE BY ROAD CONTRACTOR

104-3

12-03-96

* Not a bid item

LOCATION	TYPE	SIZE mm	KIND OF PIPE	LENGTH NEW CONST. m	BEDDING CLASS	DESIGN COVER (H)	CAMBER m	APRON NO.		ADAPTORS* RF-2		CONNECTED PIPE JOINT* RF-14		FLOW LINE ELEVATIONS			DIMENSIONS m				SKEW AHEAD Degrees		DIKE				CLASS 20 m ³	EMBANK- MENT IN PLACE m ³	REMARKS
								Inlet	Outlet	Type	No.	Type	No.	Lt.	Rt.	Other	Total		Extensions		Lt.	Rt.	Lt.	Location Station	Top Elevation	Type			
																	Lt.	Rt.	Lt.	Rt.									
161+90 NBL	1501 Med.	600	100D PEP	17.64 7.11	C	0.8		1		C-3	1	3	6	247.781	247.580	246.163	9.89	18.48									10		Apron guard on inlet end. Use two 18° PEP elbows. A=17.64, B=4.46, C=0.61, E=2.04, Q=1.98
164+50 NBL (NEW LINE)	1501 MED	600	100 D	28.59	C	0.8		1		C-1																47		USE ONE 11° RCP ELBOW (NEW LINE)	
166+40 NBL	1501 Med.	600	100D PEP	17.64 7.13	C	0.8		1		C-3	1	3	6	249.736 249.535	249.535 248.073	248.113	9.89	18.50			Med.	166+30	250.400	M	10		Apron guard on inlet end. Use two 18° PEP elbows. A=17.64, B=4.47, C=0.61, E=2.05, Q=1.98		
170+60 NBL	1501 Med.	600	100D PEP	17.64 10.32	C	0.8		1		C-3	1	3	6	258.419 255+218	258.218 255.750	255.791	9.89	21.52			Med.	170+50	259.100	M	0		Apron guard on inlet end. Use two 18° PEP elbows. A=17.64, B=7.64, C=0.61, E=2.07, Q=1.98		
170+69.9	1301-X	600	100D	37.19	C	2.6		1		C-1	1	3	22	257.747ex	255.650	256.712ex	2.76	36.29								198		Clean silted outlet. Remove and reinstall outlet apron.	
173+45 NBL	1501 Med.	600	100D PEP	17.64 15.29	C	0.8		1		C-3	1	3	6	264.313 264.112	264.112 260.075	260.116	12.08	24.05								1		Apron guard on inlet end. Use two 18° PEP elbows. A=17.64, B=12.58, C=0.61, E=2.10, Q=1.98 Subgrade superelevation=6.50%	
173+76.5	1301-X	600	100D	42.06	C	4.8		1		C-1	1	3	24	263.581ex	260.679	261.147ex	4.72	39.21								46		Remove and reinstall outlet apron. Use one 4° RCP elbow. Subgrade superelevation=6.50%	
177+35 NBL	1501 Med.	600	100D PEP	17.03 13.31	C	0.8		1		C-3	1	3	6	272.378 272.183	272.183 268.824	268.866	9.90	23.75								0		Apron guard on inlet end. Use two 18° PEP elbows. A=17.03, B=10.44, C=0.61, E=2.26, Q=1.98 Subgrade superelevation=2.07%	
180+43.8	1301	750	100D	39.01	C	3.2				C-1	1	3	23	277.674ex	272.450	275.916ex		41.98								1			
181+00.5 NBL	1501 Med.	600	100D PEP	23.73 10.46	C	0.8		1		C-3	1	3	6	277.582 277.32	277.320 274.818	274.854	13.69	23.97								0		Apron guard on inlet end. Use two 17° PEP elbows. A=23.73, B=8.19, C=0.61, E=1.66, Q=1.98 Depressed inlet=0.01 m	
181+82.6	1305	600	175D PEP	32.31 11.08	C	6.3		1		C-1 C-3	1 1	3	19	274.731ex 271.837	271.837 269.250	272.166ex 269.294		53.25								78		Use one 22° RCP elbow and two 18° PEP elbows. A=32.31, B=8.01, C=0.61, E=2.46, Q=1.98 Existing skew is 23° Rt. Ahead.	
182+35.6	1305	600	175D PEP	40.84 13.29	C	6.6		1		C-1 C-3	1 1	3	24	275.152ex 271.575	271.575 269.250	271.990ex 269.306		70.35								901		Use one 4° RCP elbow and two 14° PEP elbows. A=40.84, B=9.04, C=0.61, E=3.64, Q=1.98 Existing skew is 4° Lt. Ahead.	
184+09.8 NBL	1101 Med.	600	100D	24.99	C	1.3		1	1			3	6	278.134	277.198		11.69	17.03								12		Apron guard on inlet end. Vary SBL median ditch foreslope to 3.6:1 and construct median ditch grade. Shape to drain from existing RCP.	
187+06.4	1305	600	150D PEP	39.02 12.24	C	4.6		1		C-1 C-3	1 1	3	21	277.072ex 275.017	275.017 272.126	275.389ex 272.176		56.31								61		Use two 16° PEP elbows. A=36.58, B=9.99, C=0.61, E=3.02, Q=1.98	
Ramp A - IA Hwy. 64 5157+90.5	1101	1200	150D	48.80	C	4.8		1	1			3	28	241.000	242.500		26.46	27.19								79		Subgrade superelevation=1.17% at Sta. 5158+00.	
Ramp B - IA Hwy. 64 6157+41.5	1101	600	100D	42.06	C	1.5		1	1			3	6	247.000	247.500		28.60	17.19								66		Subgrade superelevation=0.96%	
Loop C - IA Hwy. 64 7155+45.0	1101	600	100D	23.77	C	1.0		1	1			3	6	251.700	251.525		17.10	10.41								154		Flatten foreslope per Typical 4304. Subgrade superelevation=8.00%	
Ramp D - IA Hwy. 64 8158+37.0	1101	600	100D	42.61	C	3.8		1	1			3	23	242.050	244.050		21.90	20.84								97			
Iowa Highway 64 2158+66.2	1301	900	100D	12.16	C	1.2		1		C-1	2	3	8	247.100	246.600	246.732ex 246.672ex	23.14	20.29	9.89	4.74	29					10		Remove and reinstall inlet and outlet aprons. Subgrade superelevation=3.00%	

dcn = I:\work\project\34120\cadd\east\341b1063.c14
 pcf = \NWA\501\DA\IA\PLC\PL469\c15.pr
 date = Fri Oct 29 15:45:20 1995
 level = 1-3, 6-11, 15-19, 26-30, 32-40, 42-45, 50-53, 60-63
 gen table = 1, 10, tot, tables, half, wt, tb

DRAINAGE STRUCTURE BY ROAD CONTRACTOR


104-3
12-03-96

* Not a bid item


LOCATION	TYPE	SIZE mm	KIND OF PIPE	LENGTH NEW CONST. m	BEDDING CLASS	DESIGN COVER (H)	CAMBER m	APRON NO.		ADAPTORS* RF-2		CONNECTED PIPE JOINT* RF-14		FLOW LINE ELEVATIONS			DIMENSIONS m				SKEW AHEAD Degrees		DIKE				CLASS 20 m ³	EMBANK- MENT IN PLACE m ³	REMARKS		
								Inlet	Outlet	Type	No.	Type	No.	Lt.	Rt.	Other	Total		Extensions		Lt.	Rt.	Lt.	Rt.	Location	Station				Top Elevation	Type
																	Lt.	Rt.	Lt.	Rt.											
Chamber Drive 2159+44	1101	750	1000	43.85	C			1				3	6	243.390	248.300		26.60	21.00			7								PLACED CONCRETE FLUME (CONTRACT MOD.)		
Grant Wood Drive 2160+11.9 Lt.	1101	750	1000	29.61	C			1				3	6	249.400	249.274		14.40	15.30			5										
Grant Wood Drive 2160+13.5 Rt.	1101	600	1000	21.07	C			1	1			3	6	249.050	249.000		12.30	12.50			5								Twin Pipe		
Grant Wood Drive 2160+13.5 Rt.	1101	600	1000	21.07	C			1	1			3	6	249.050	249.000		12.30	12.50			3.5								Twin Pipe		
Shaw Road 3137+28.4	1601	600	Uncl.	23.20	C	0.9		1	1			3	6	240.531	240.797		13.56	9.61			7										
130th Street 1173+82.4	1601	750	Uncl.	1.83	C	2.6		1		C-1	1	3	2	259.310	259.290ex		15.10		3.70		29										
On-Site Detour 'C' 8149+81.6	Ext.	600	PEP	13.22					1					258.616ex	255.800			15.20			10 Ext.									Pipe inlet is 34.0 m Lt. of detour centerline. Use one 10° PEP elbow.	
On-Site Detour 'C' 8149+85.2	Ext.	600	PEP	19.95					1	C-2	1			258.000ex	255.800			21.93			30 Ext.									Pipe inlet is 39.7 m Lt. of detour centerline. Use one 30° PEP elbow.	
On-Site Detour 'C' 8150+60.1	Ext.	600	PEP	13.41					1	C-2	1			255.515ex	255.400			15.39			25 Ext.									Pipe inlet is 31.7 m Lt. of detour centerline. Use one 25° PEP elbow.	
On-Site Detour 'C' 8154+08.3	Ext.	600	PEP	19.80					1	C-2	1			242.800	242.700			21.78												Pipe inlet is 31.0 m Lt. of detour centerline.	
On-Site Detour 'C' 8154+50.0	1403	450	PEP	20.43 20.42					1					248.700 254.895	254.895 255.000	248.730	25.41	6.51												Use two 18° PEP elbows and one Type A diaphragm. A=1.02, B=19.41, C=8.49	

dgn = L:\WORK\PROJECT\34120\CAUD\EAS\53151063.c14
 prf = \\WATS01\DATA\PL01\PL463P\C16.PRF
 date = Fri Oct 29 15:59:28 1999
 levels = 1-3,6-11,15-19,26-30,32-40,42-45,50-53,60-63
 pen table = i:\plot\tab\es\half\vt.tbl


ACCESS LOCATIONS
STA. 131+32 RT.

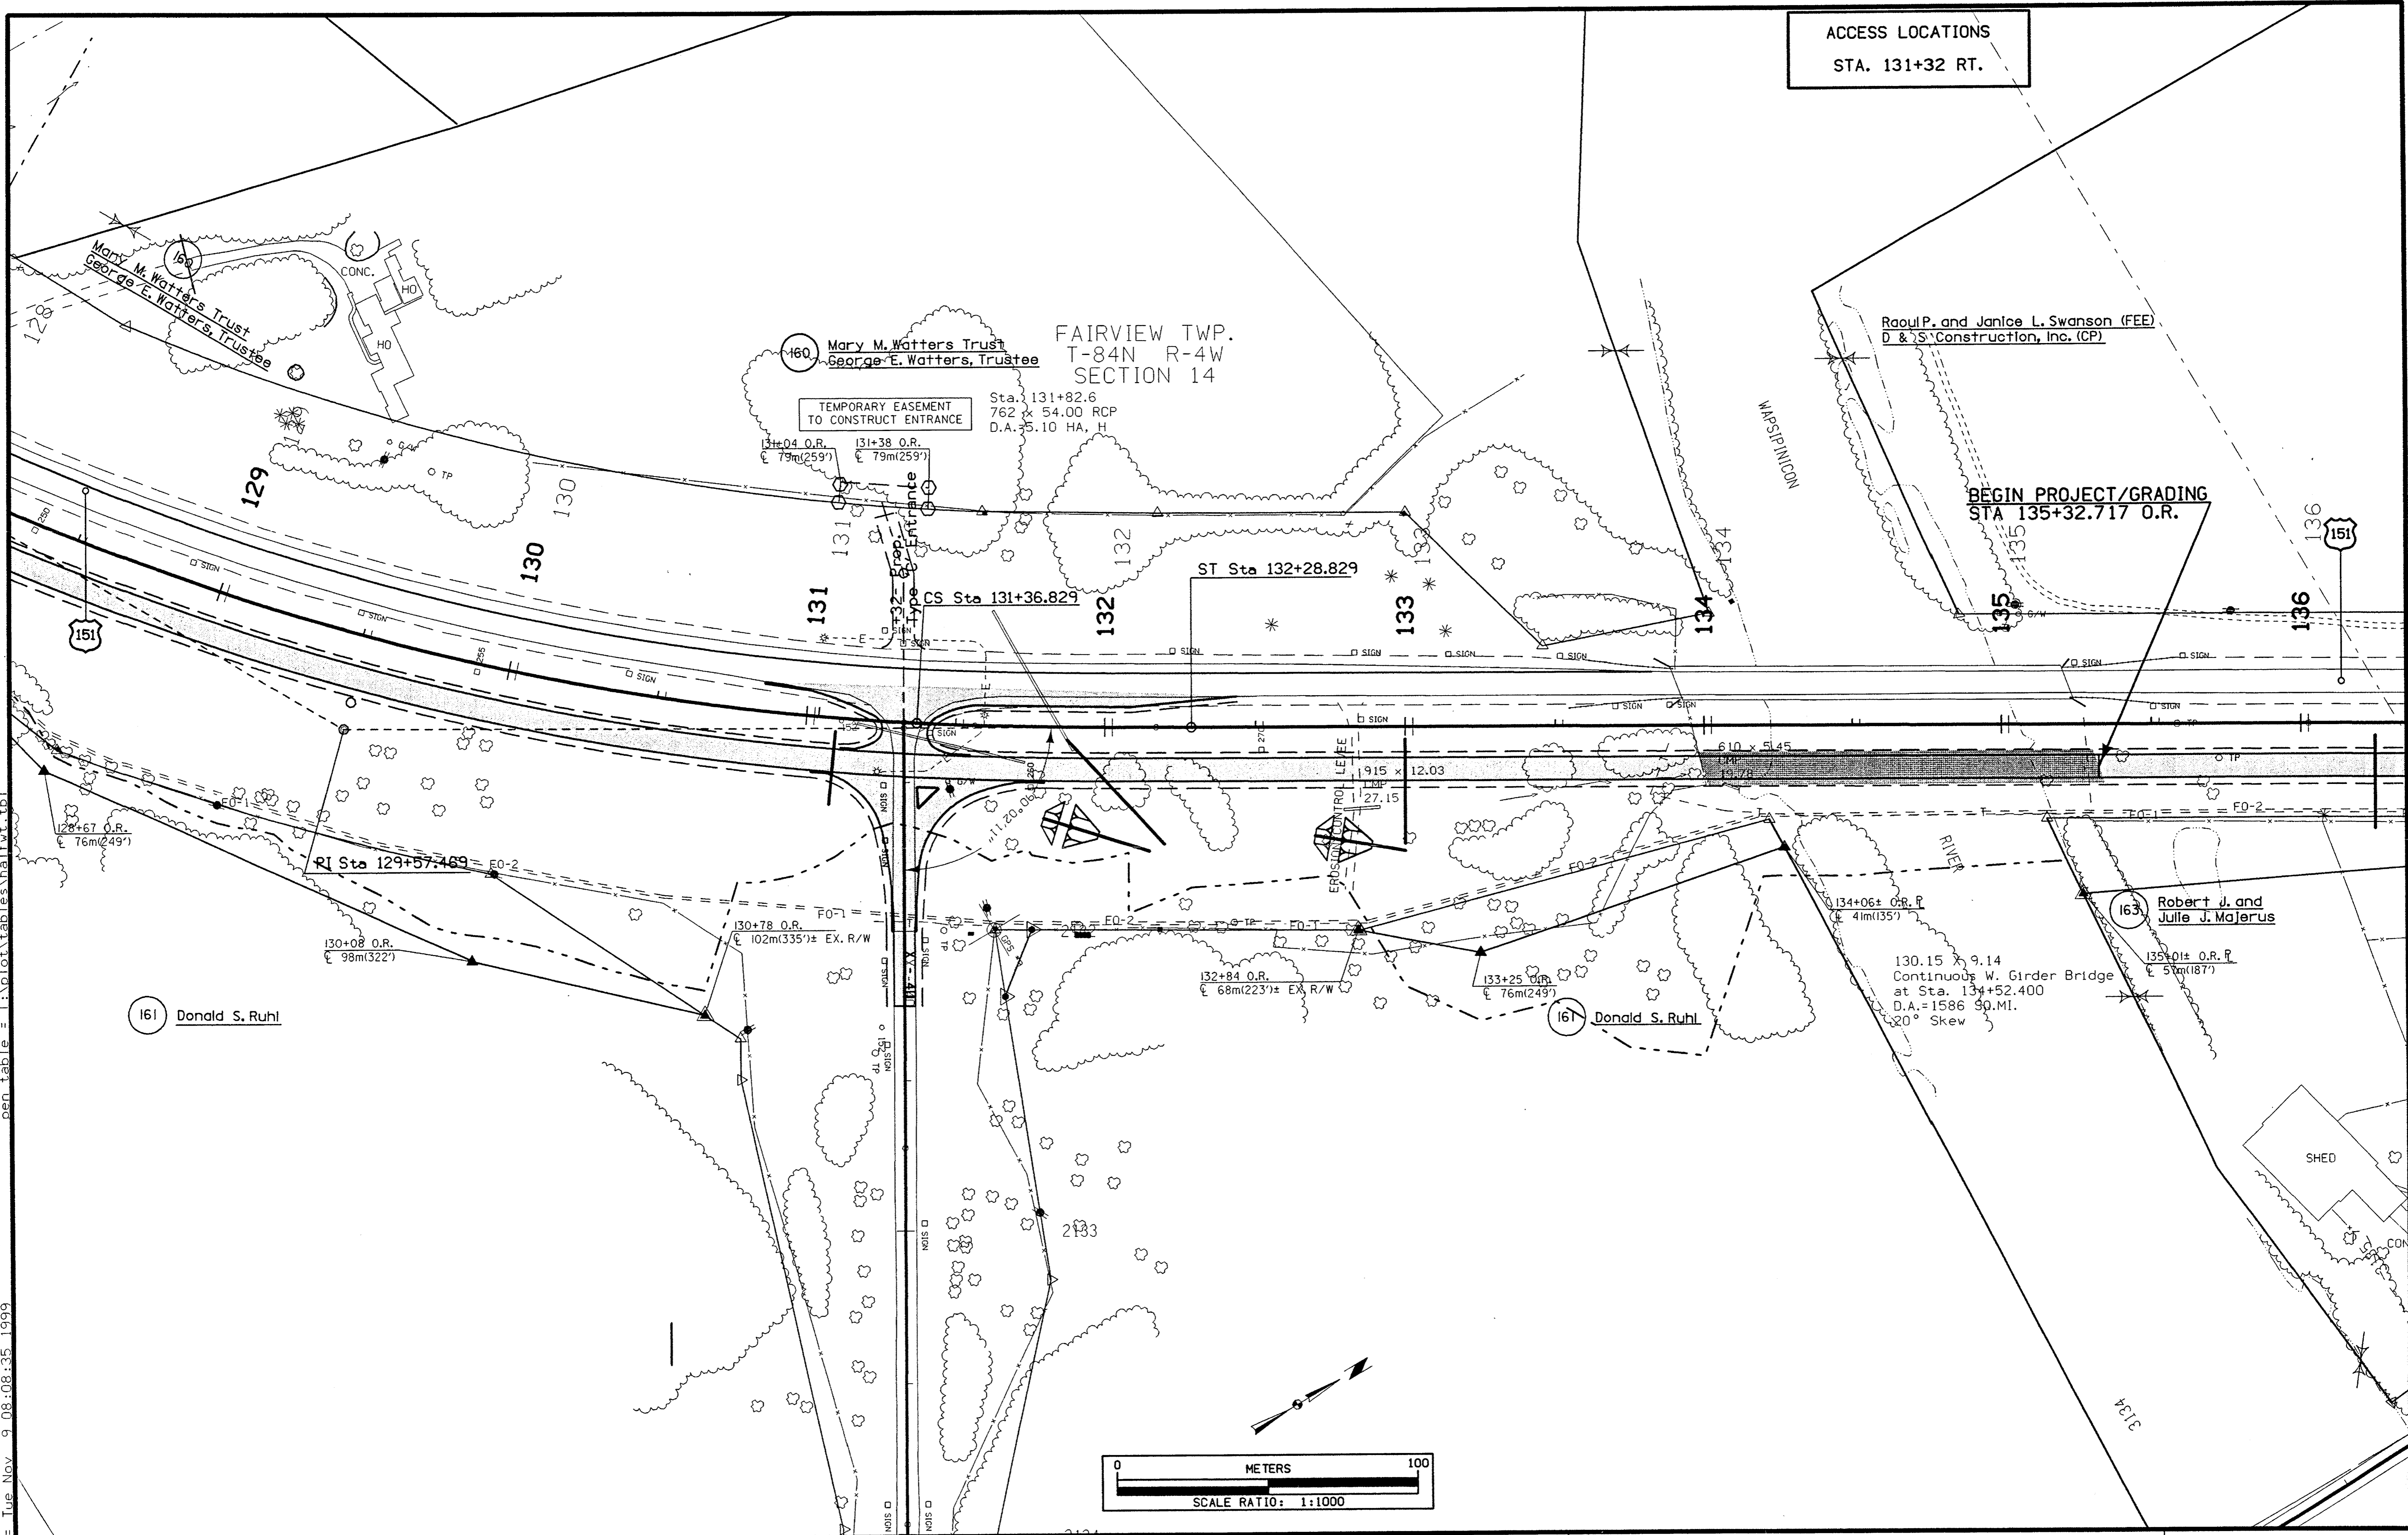

d01 = I:\work\project\34120\cadd\EA5T\53151063.d01
 prf = \\WAT501\DATA\PLT\PL463P\001H.prf
 Date = Tue Nov 9 08:08:35 1999
 levels = 1-4,7,8
 pen table = I:\p\lot\tables\halfwt.tbl

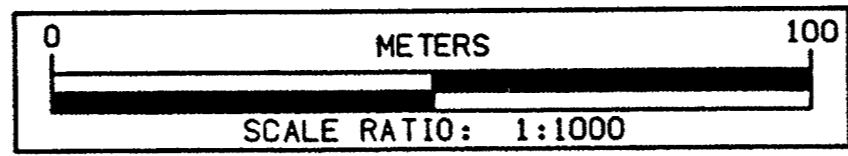

prf = \\WATSON\DATA\PLT\PL463P\002H.PRF
 date = Fri Oct 29 10:53:50 1999



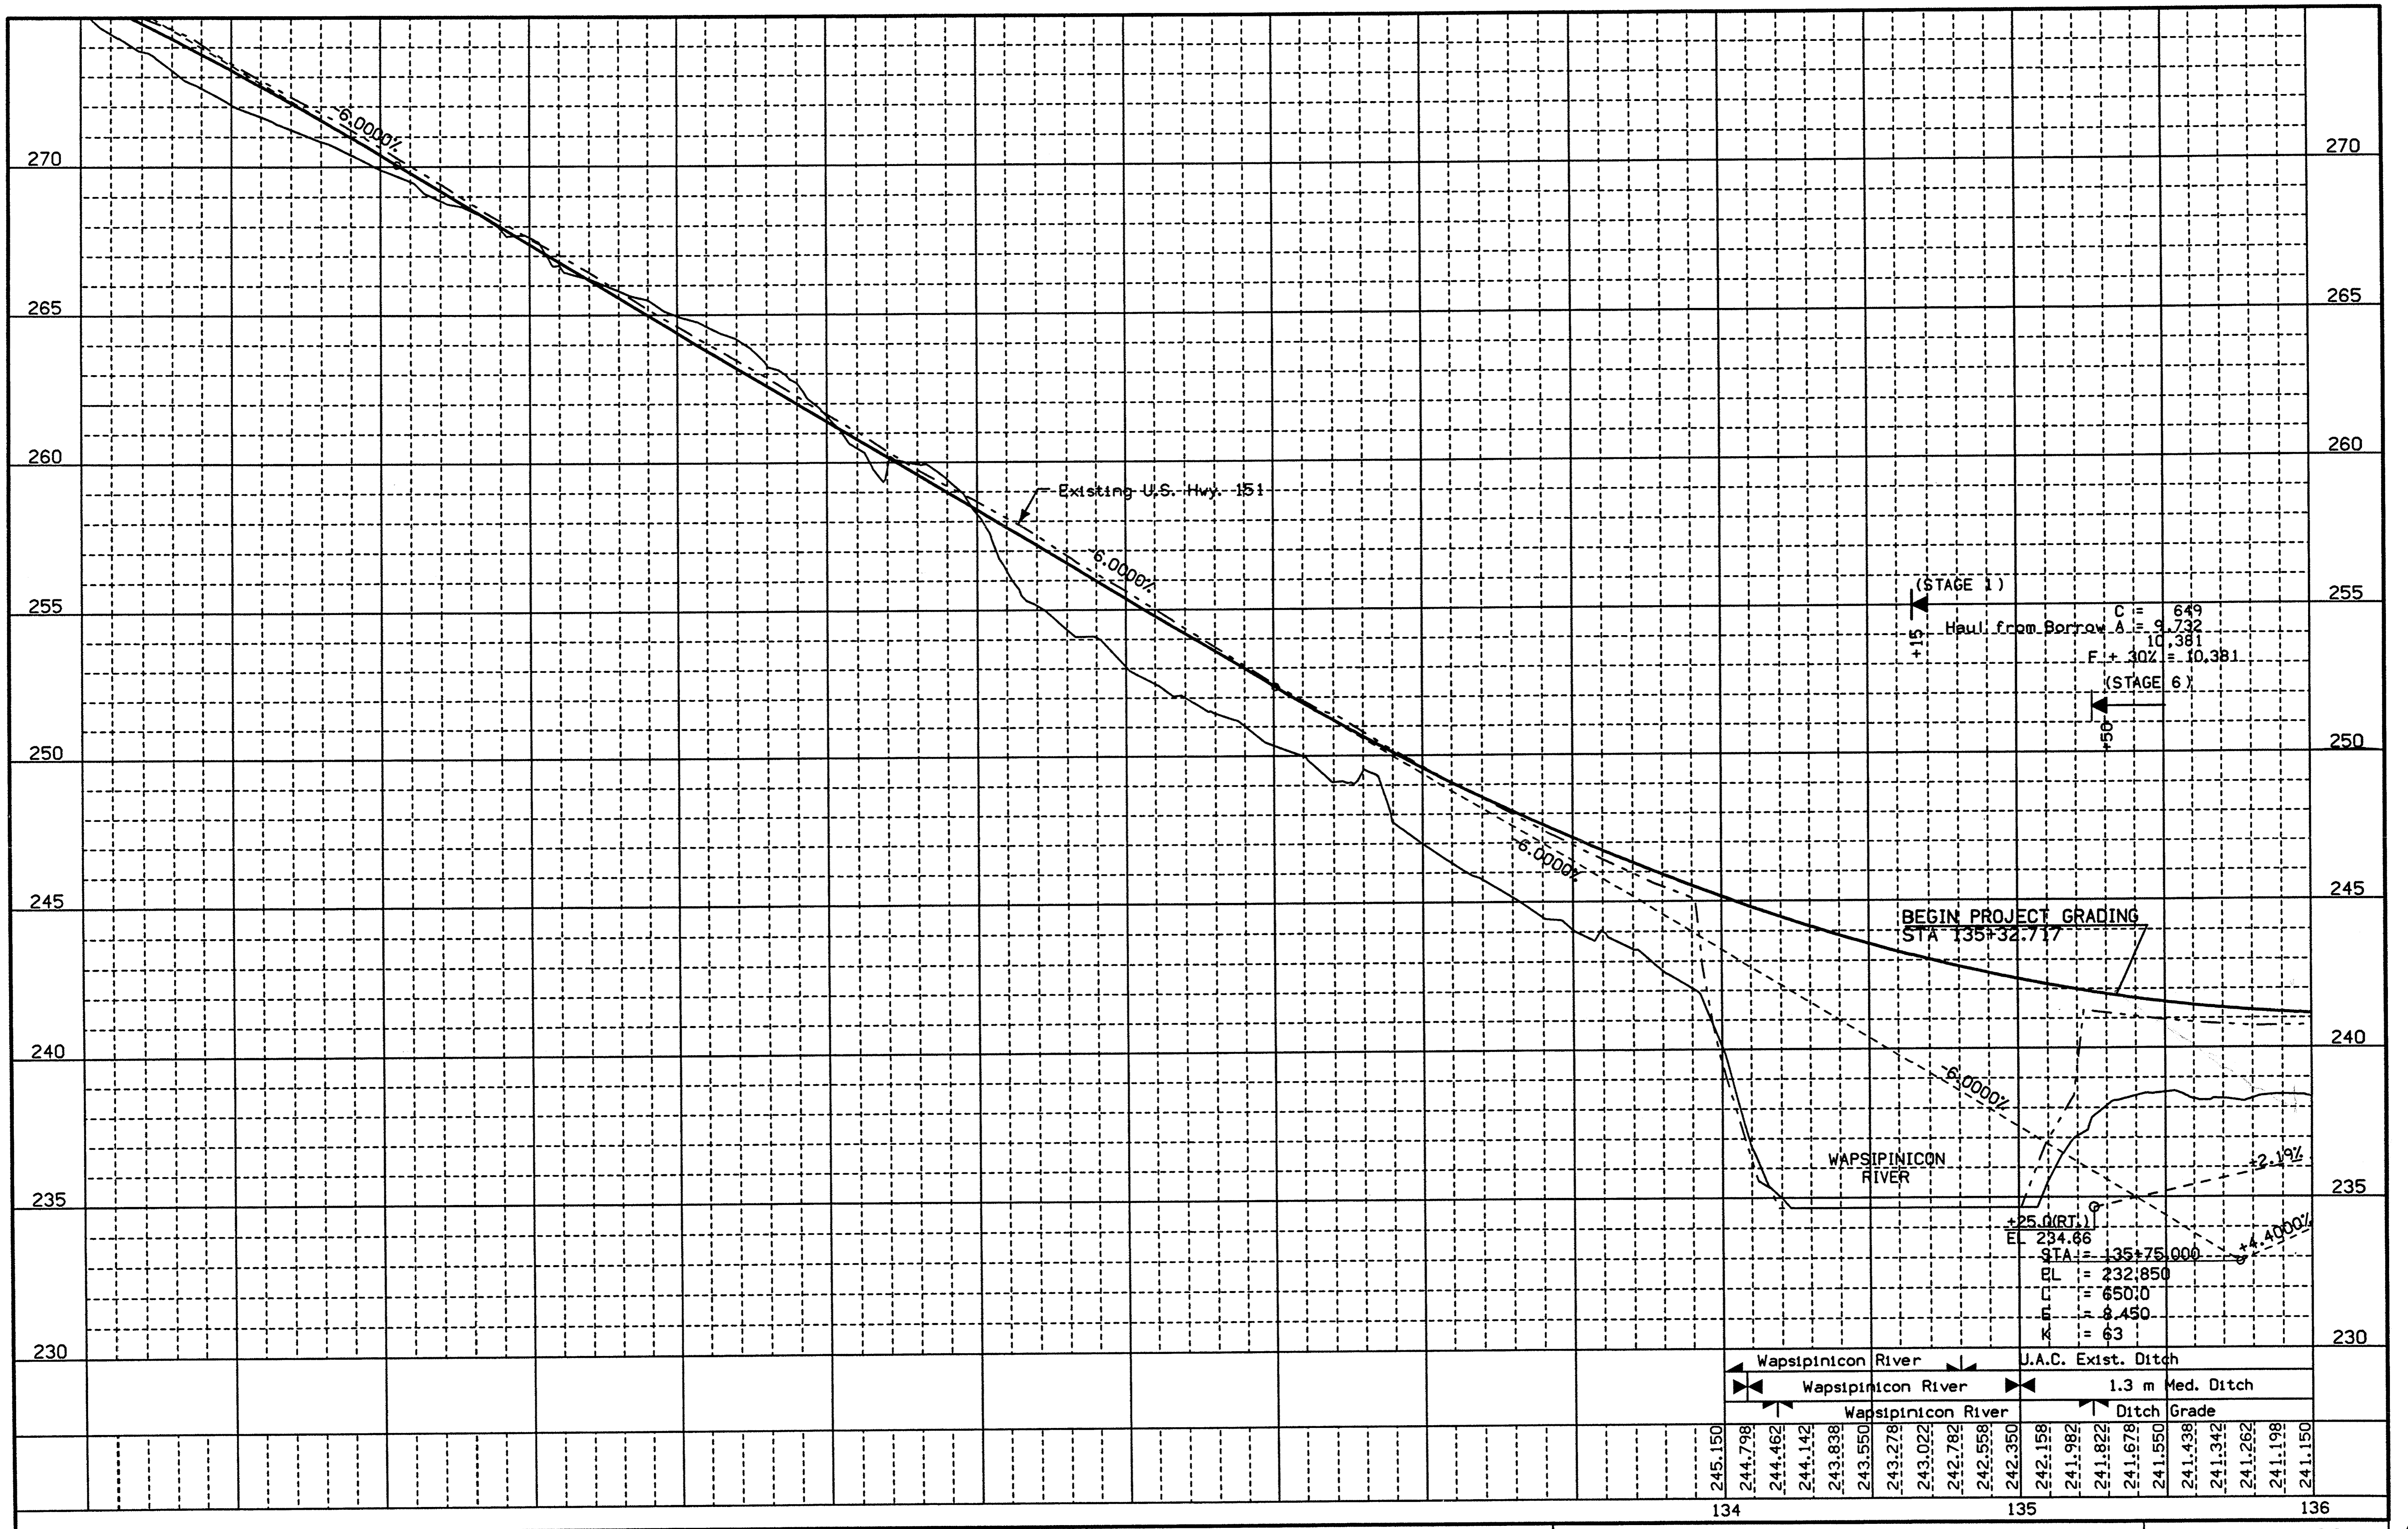


(STAGE 1)
 Haul from Borrow A = 9,732
 C = 649
 F + 30% = 10,381
 (STAGE 6)



BEGIN PROJECT GRADING
 STA 135+32.717

EL 234.66
 STA 135+75.000
 EL = 232.850
 C = 650.0
 F = 8,450
 K = 63


Wapsipinicon River
 Wapsipinicon River
 Wapsipinicon River
 J.A.C. Exist. Ditch
 1.3 m Med. Ditch
 Ditch Grade

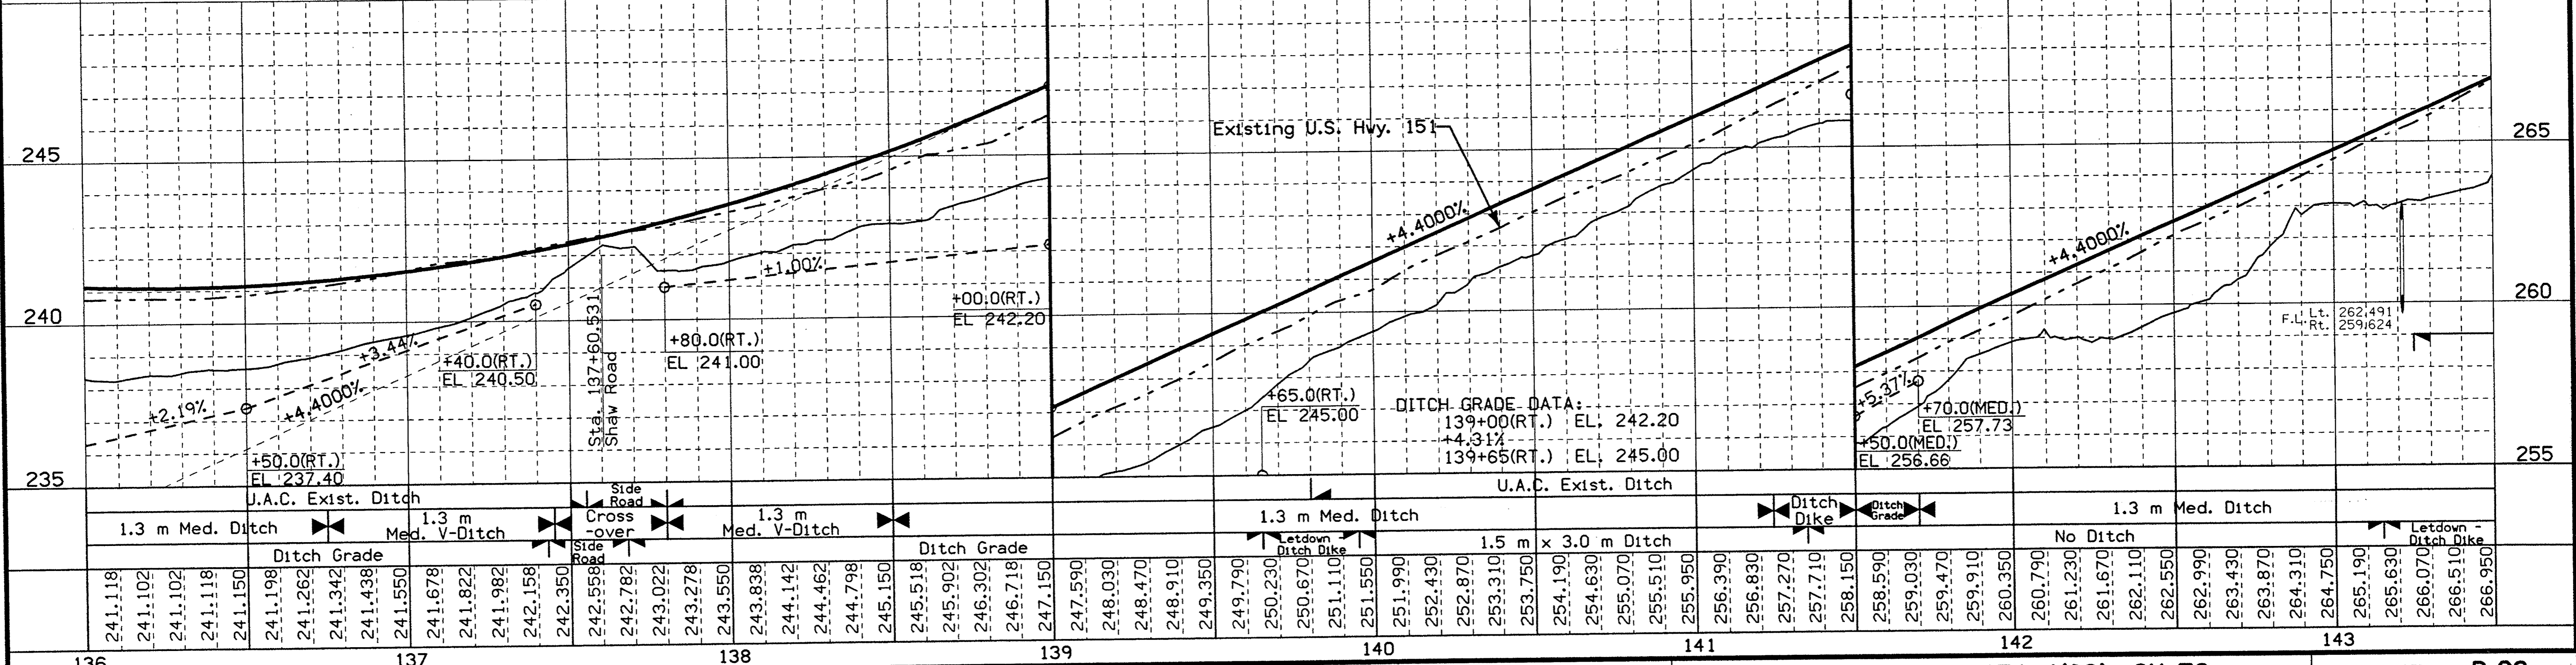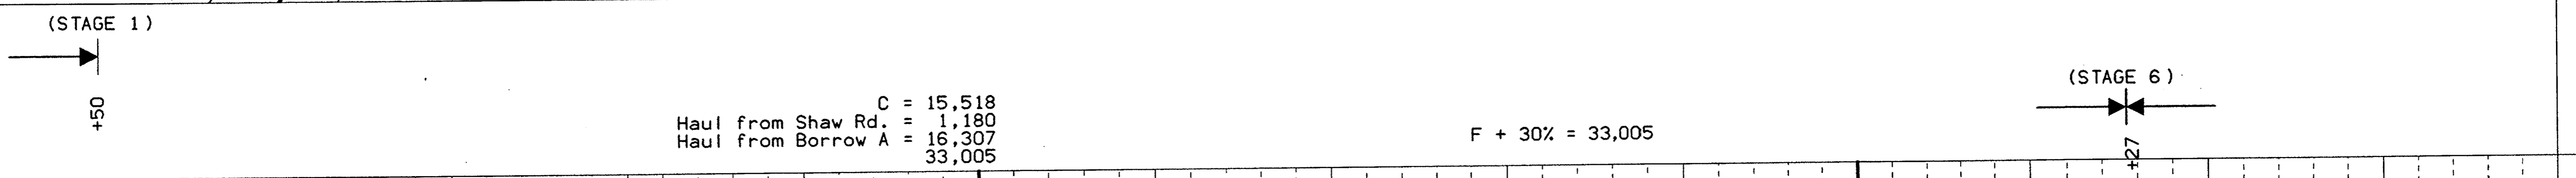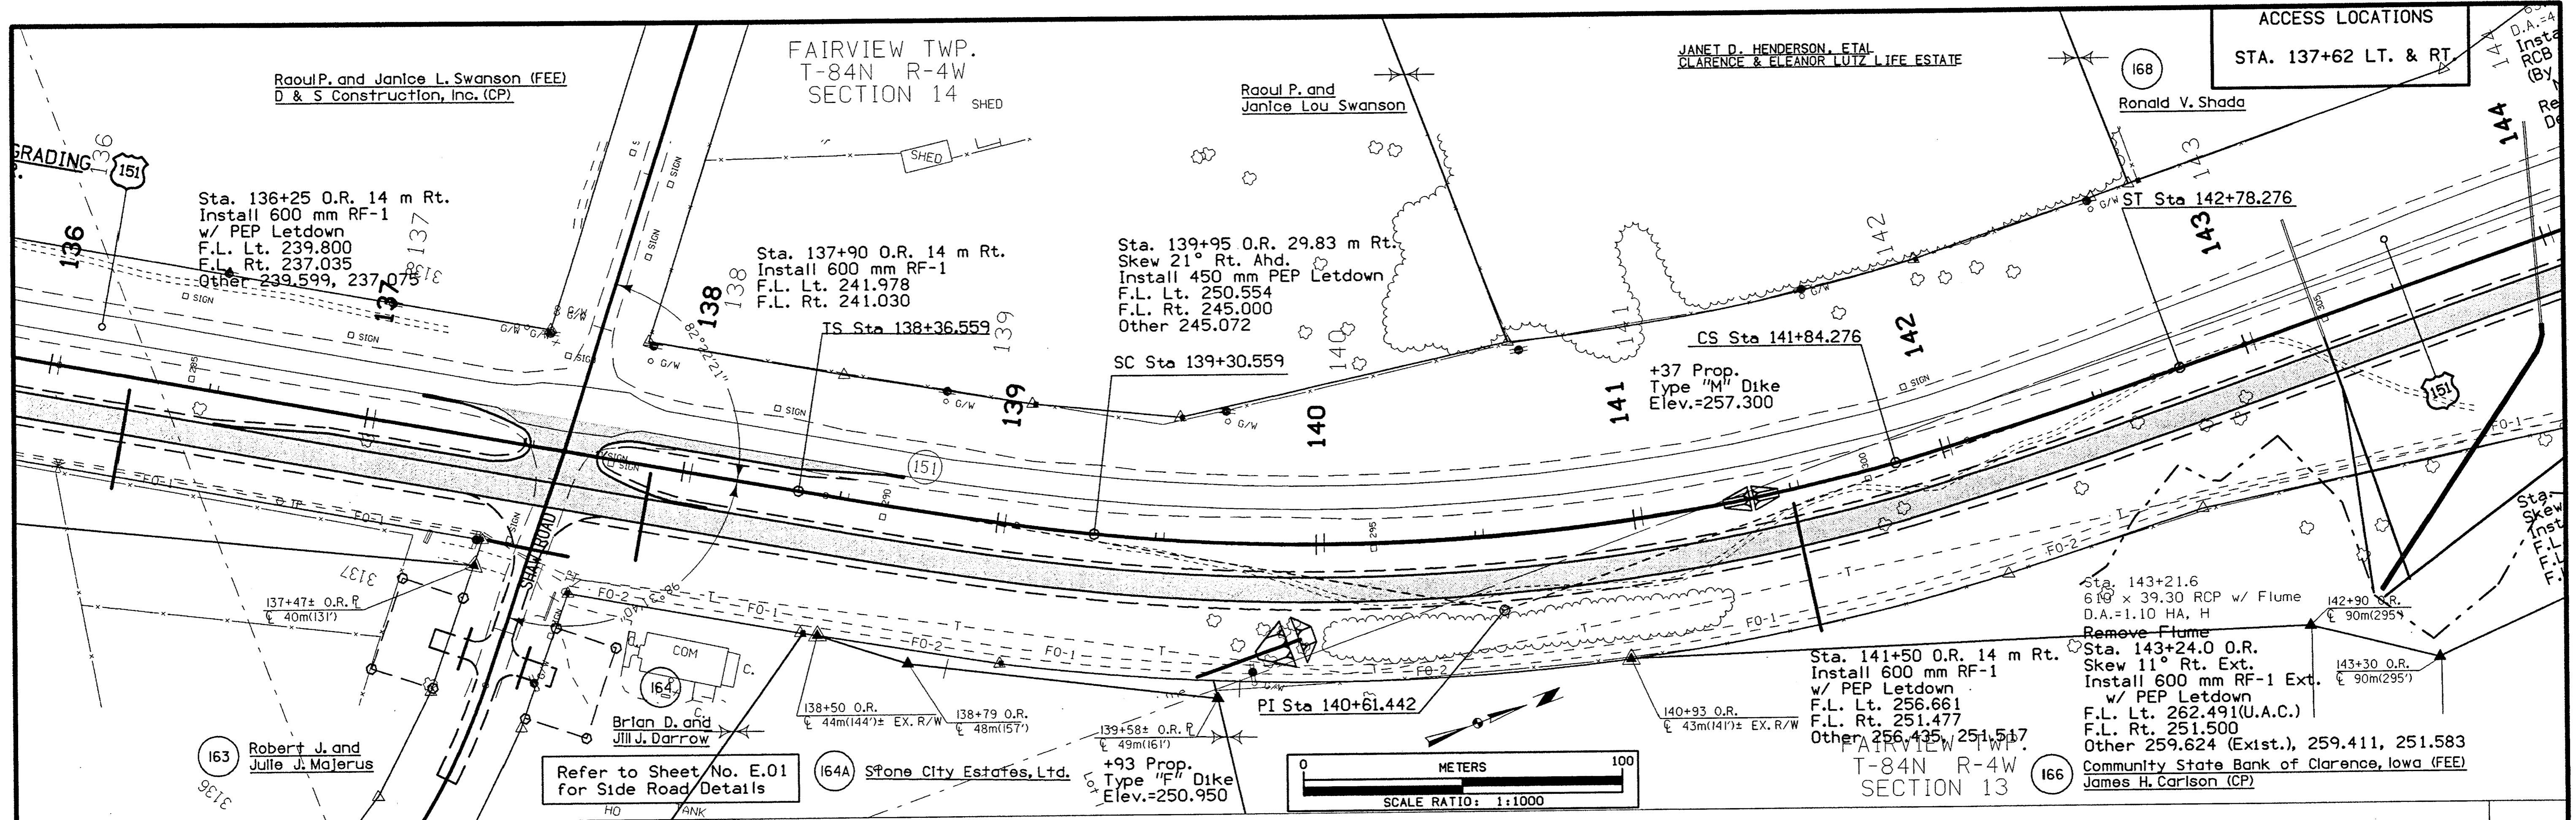



prf = \\WATSON\DATA\PLT\463P\003H.PRF
date = Fri Oct 29 10:54:03 1999

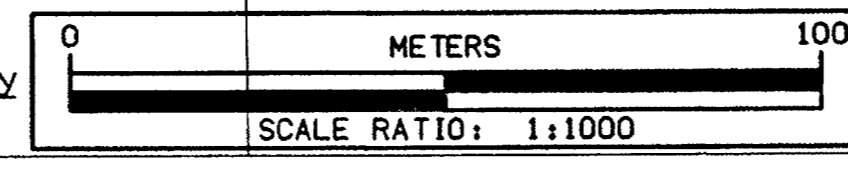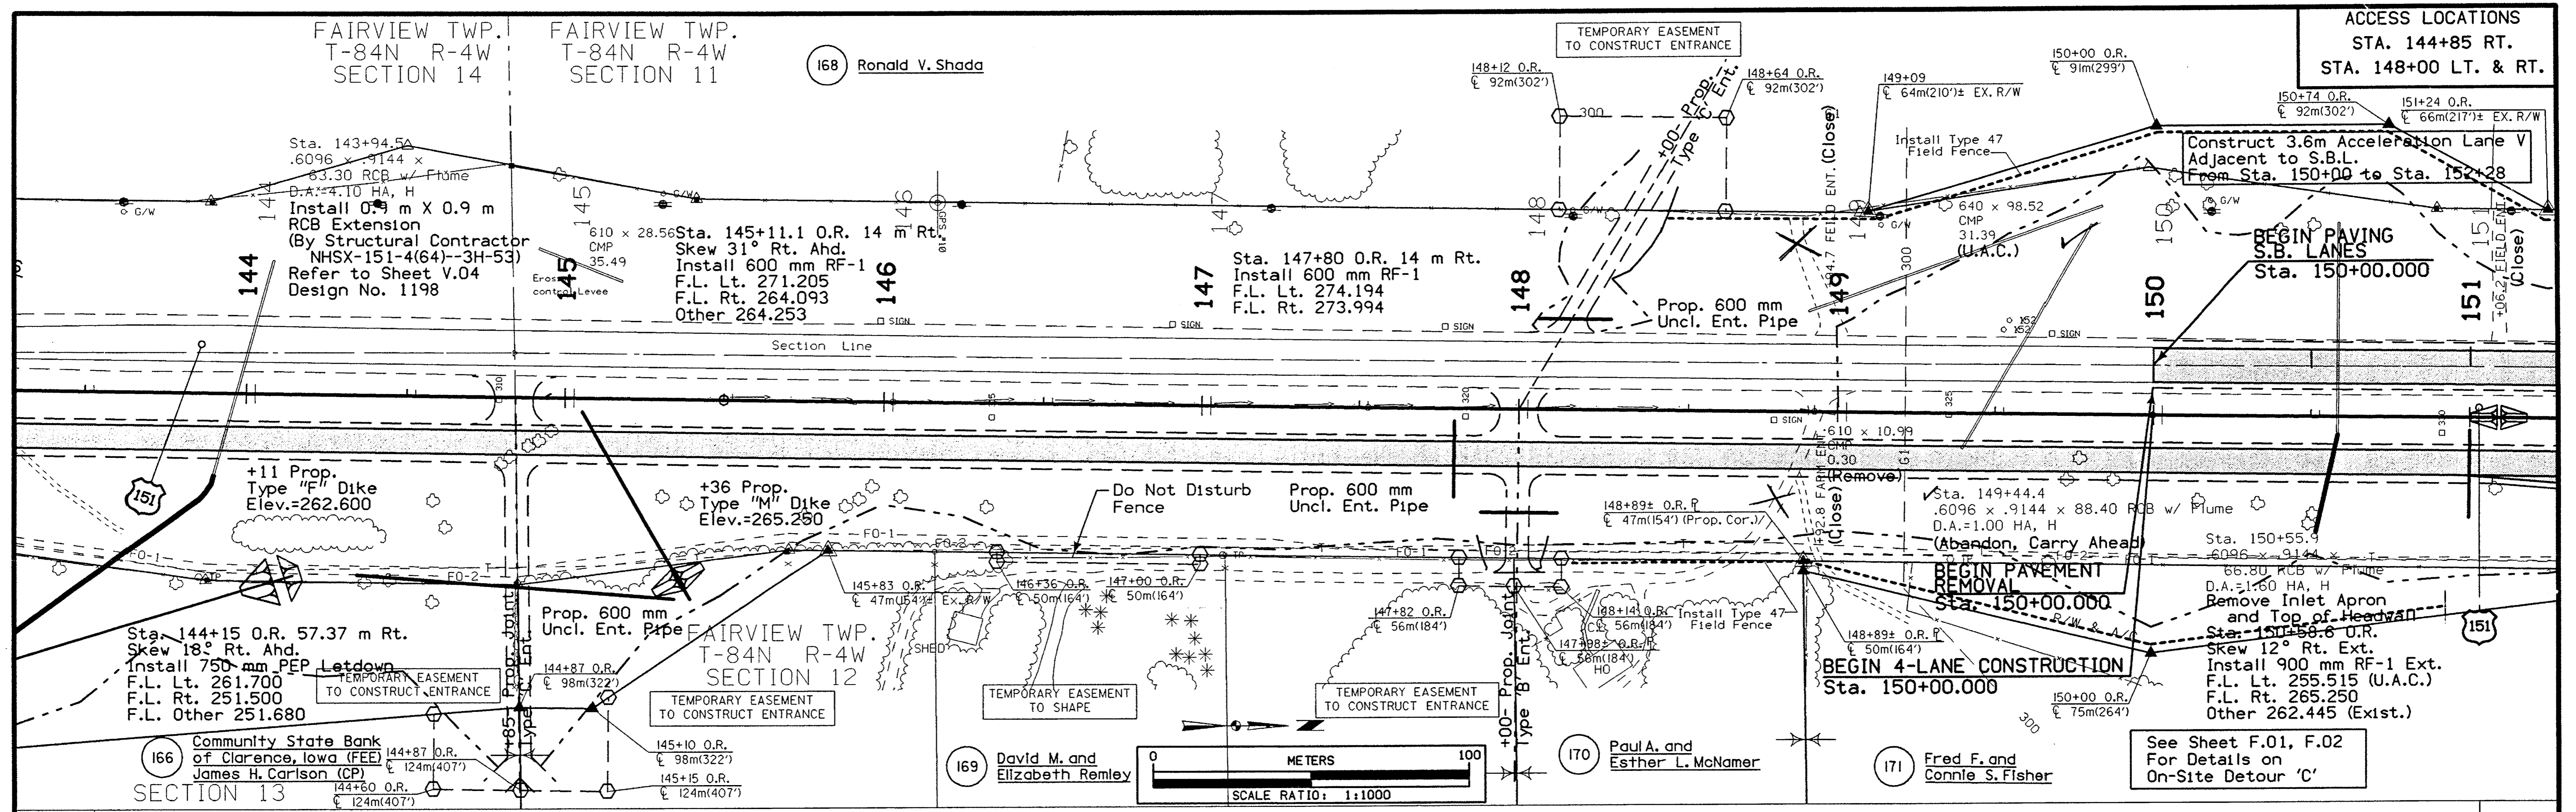


See Sheet F.01, F.02
For Details on
On-Site Detour 'C'

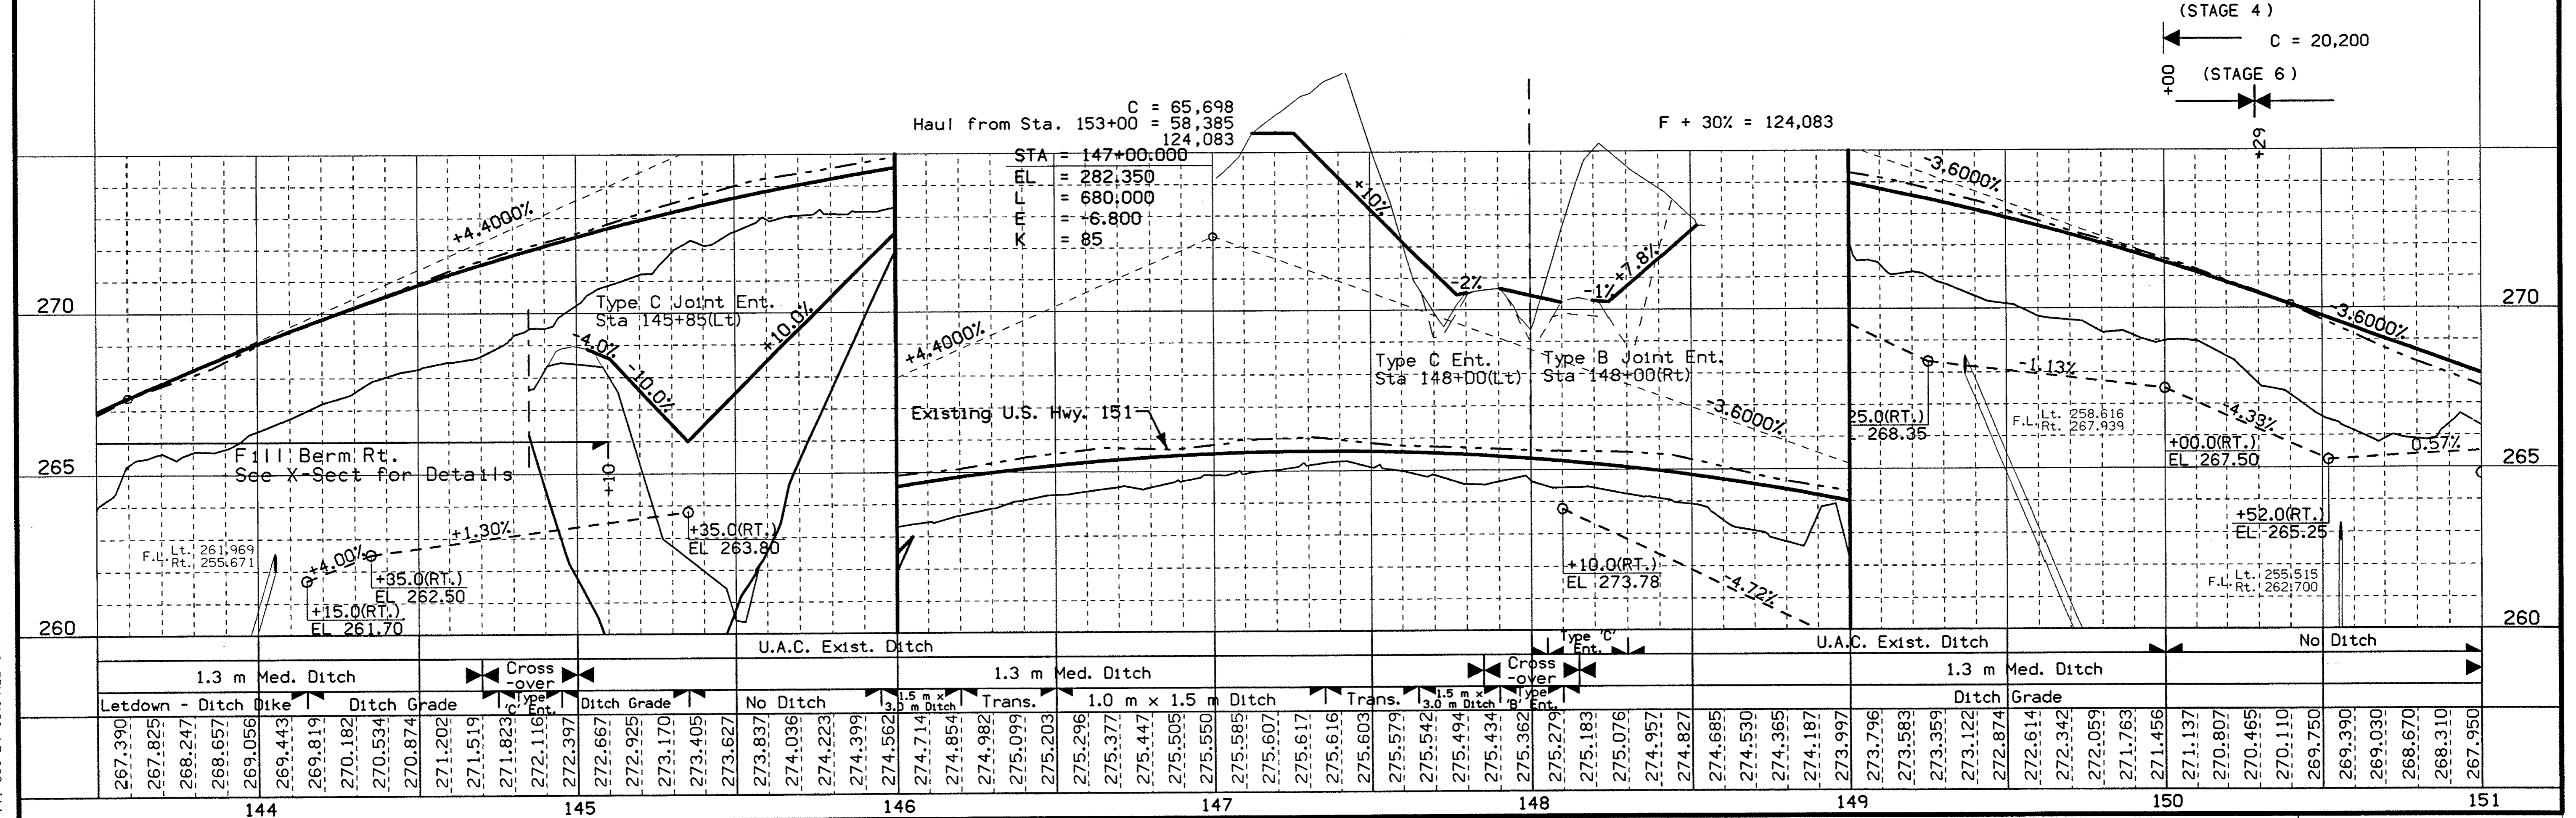

prf = \\WATSON1\DATA\PL01\PL463P\004H.PRF
 date = Fri Oct 29 10:54:22 1999

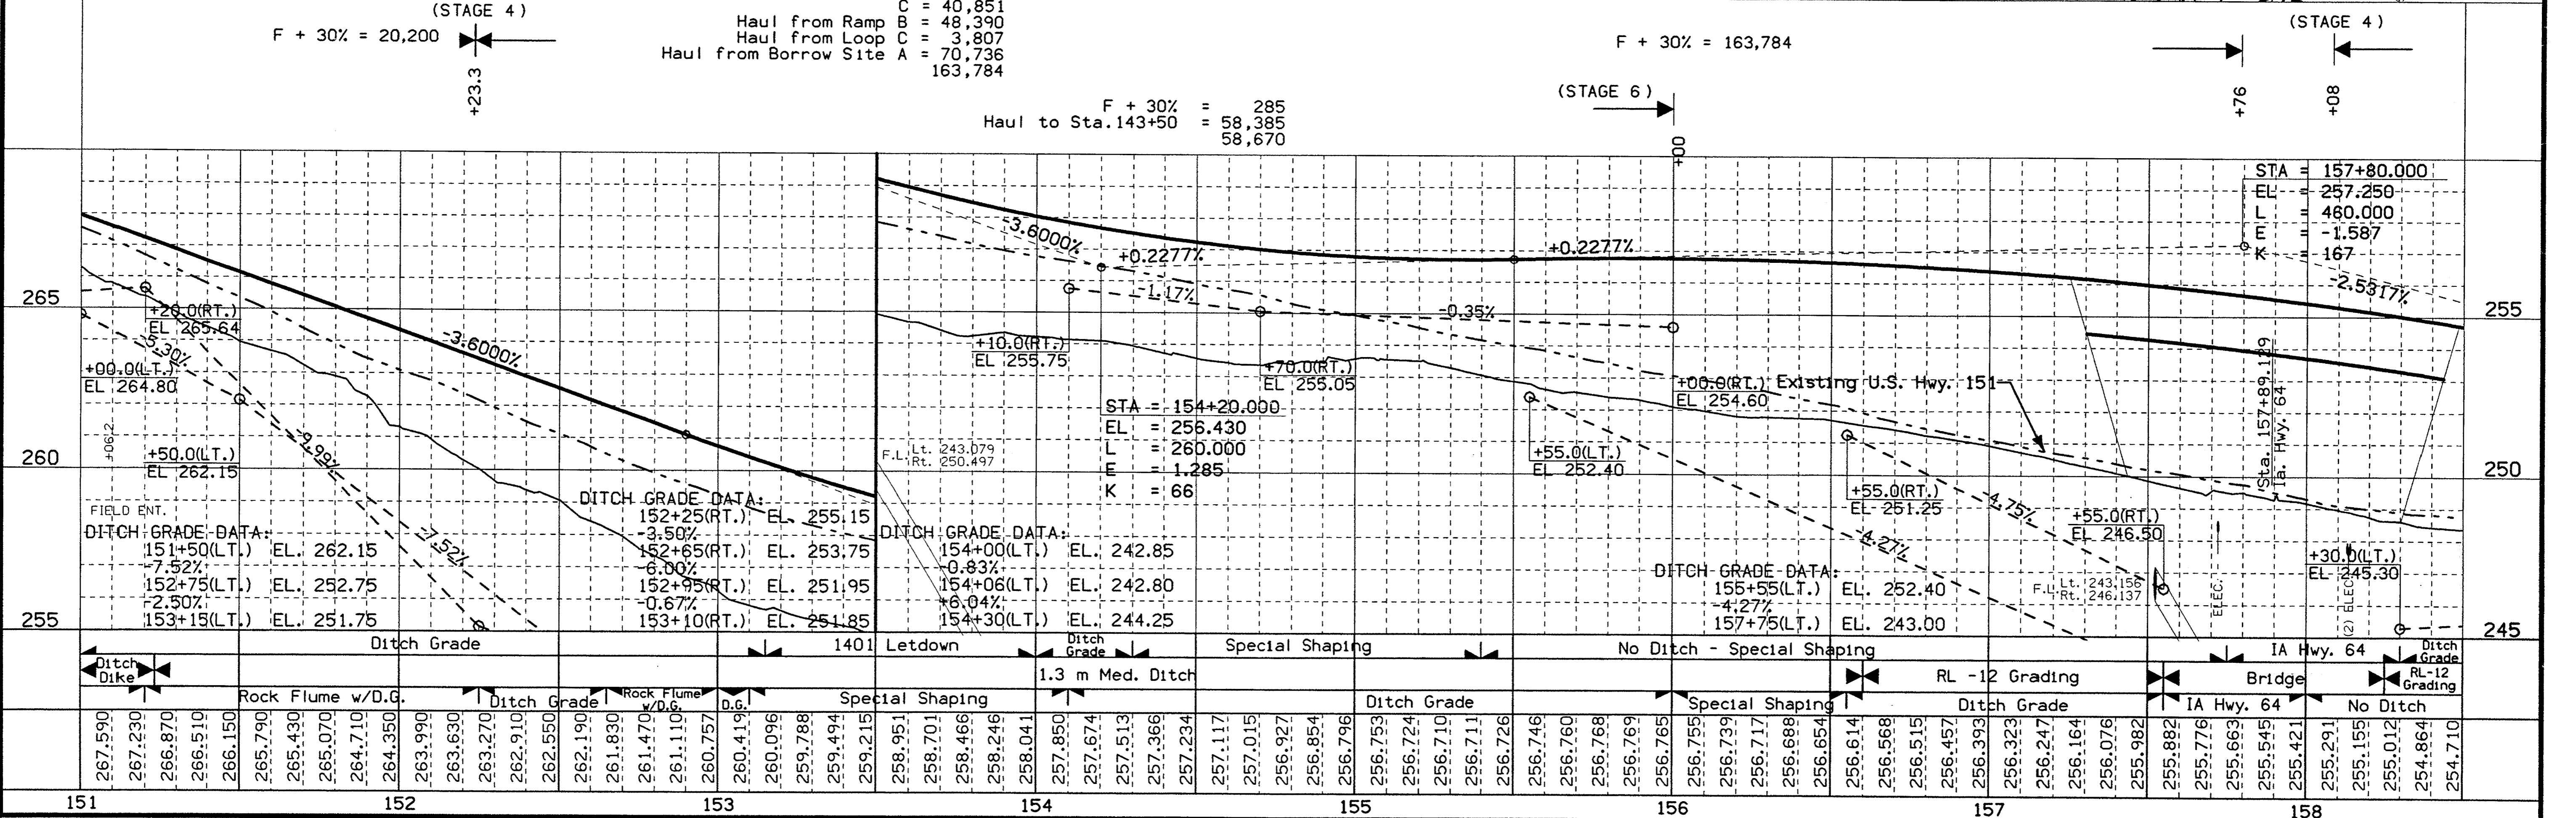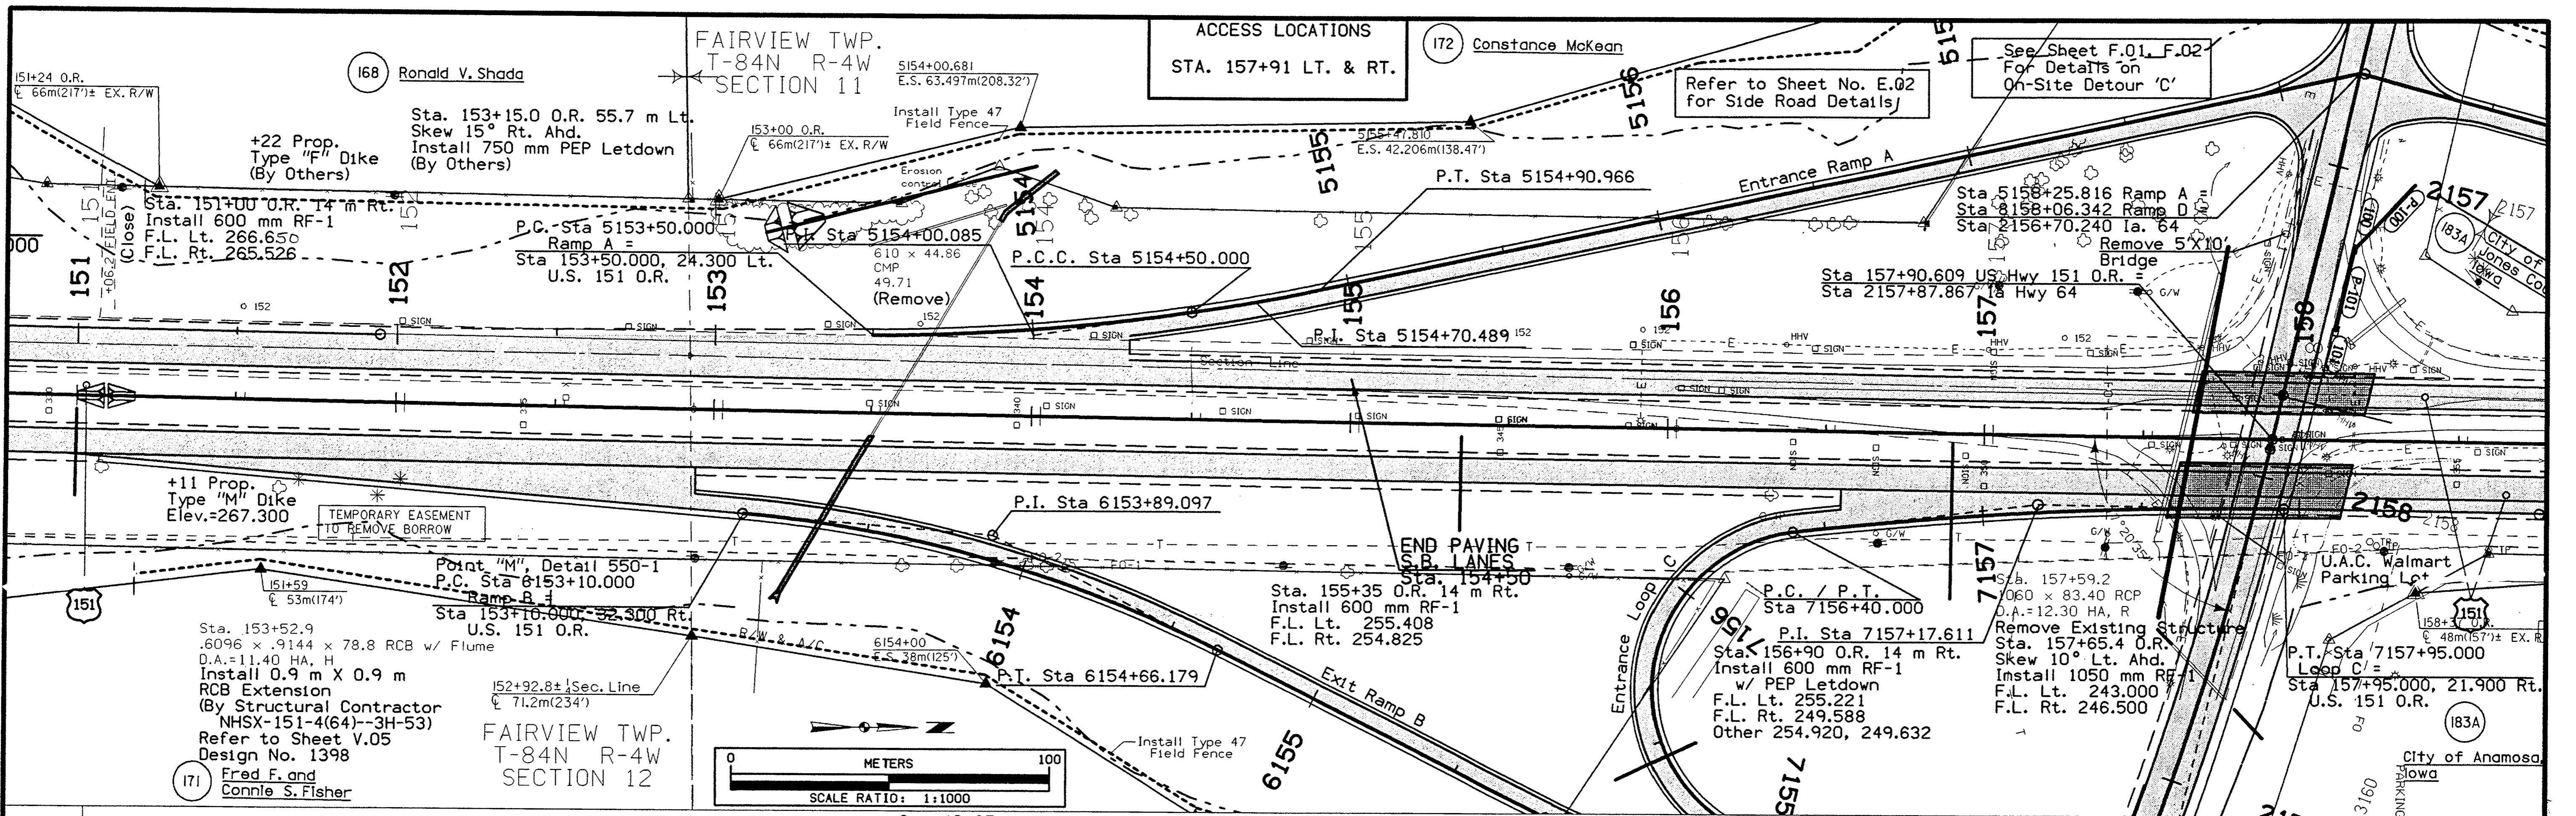


prf = \\WATSON\DATA\PLT\463P\005H.PRF
 date = Fri Oct 29 10:54:40 1999

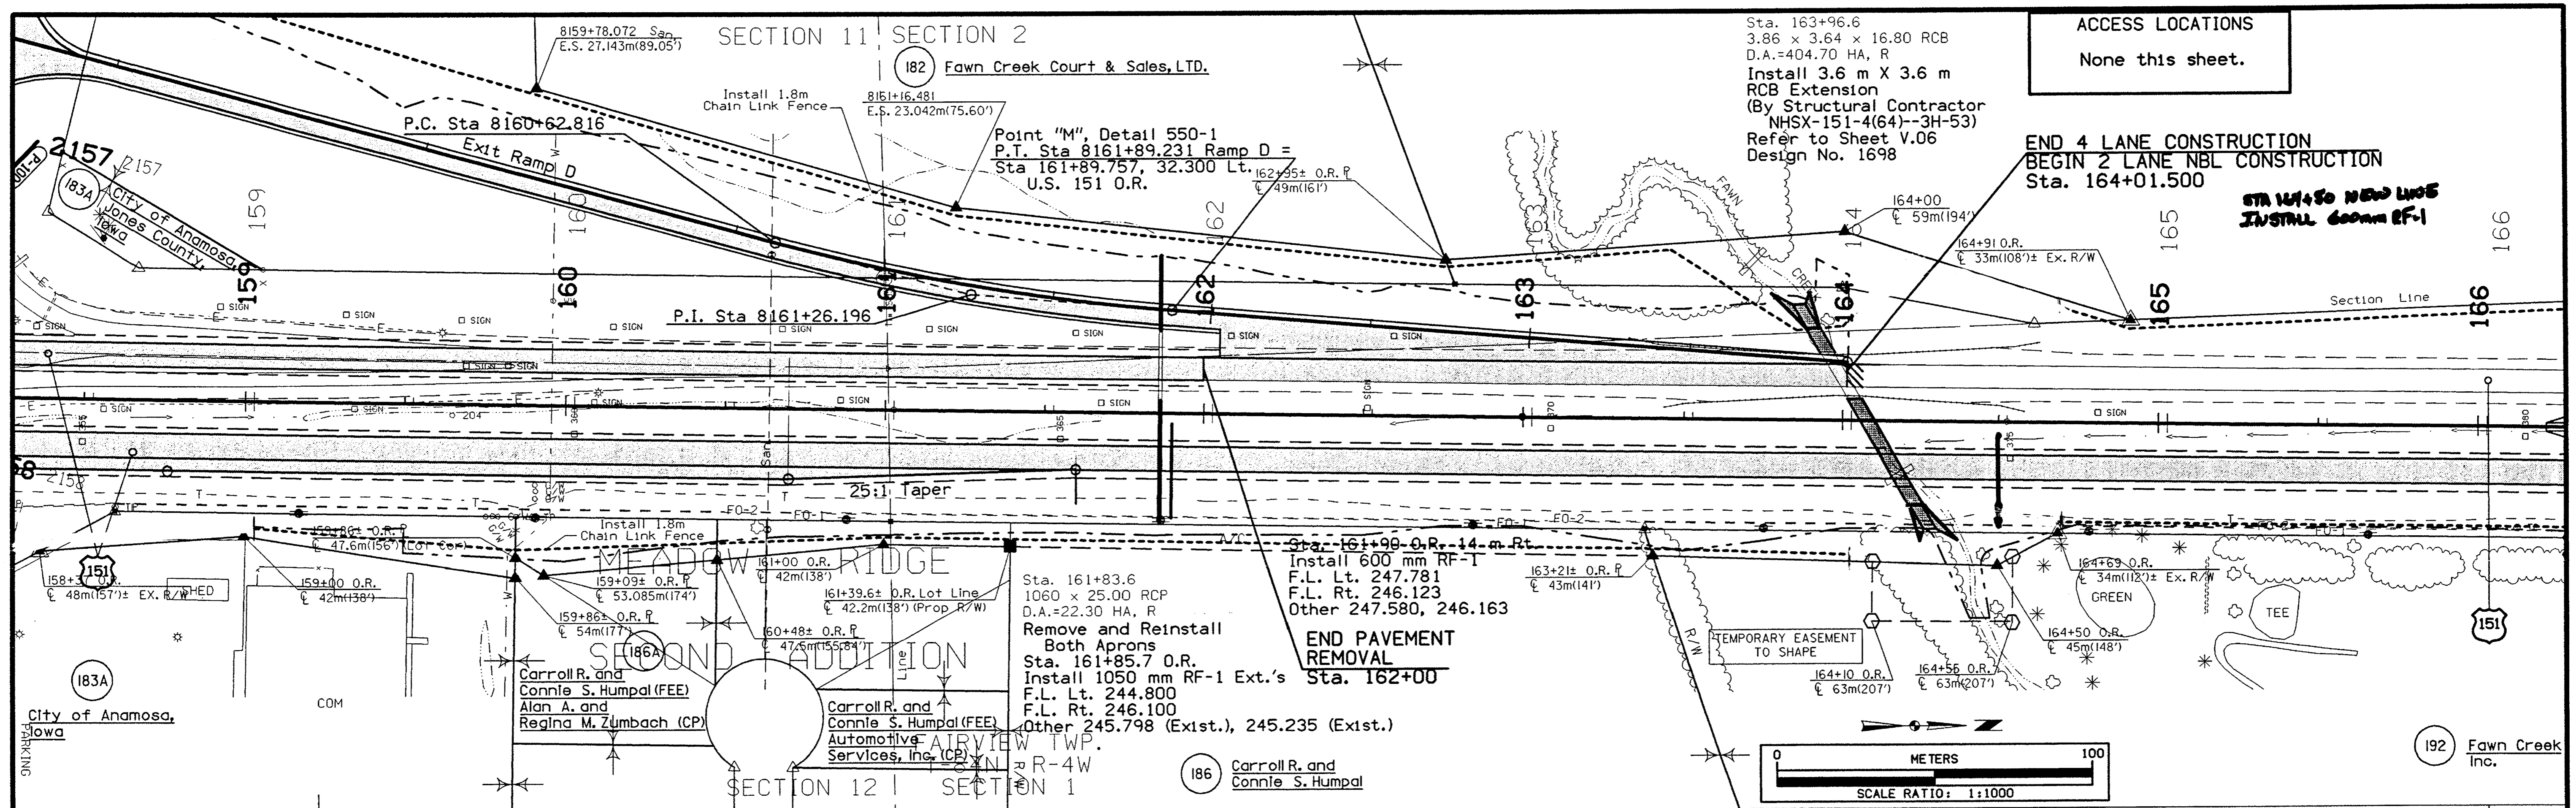

Haul from Borrow
C = 9,035
B = 80,622
89,657


F + 30% = 9,035
F + 20% = 80,622
89,657

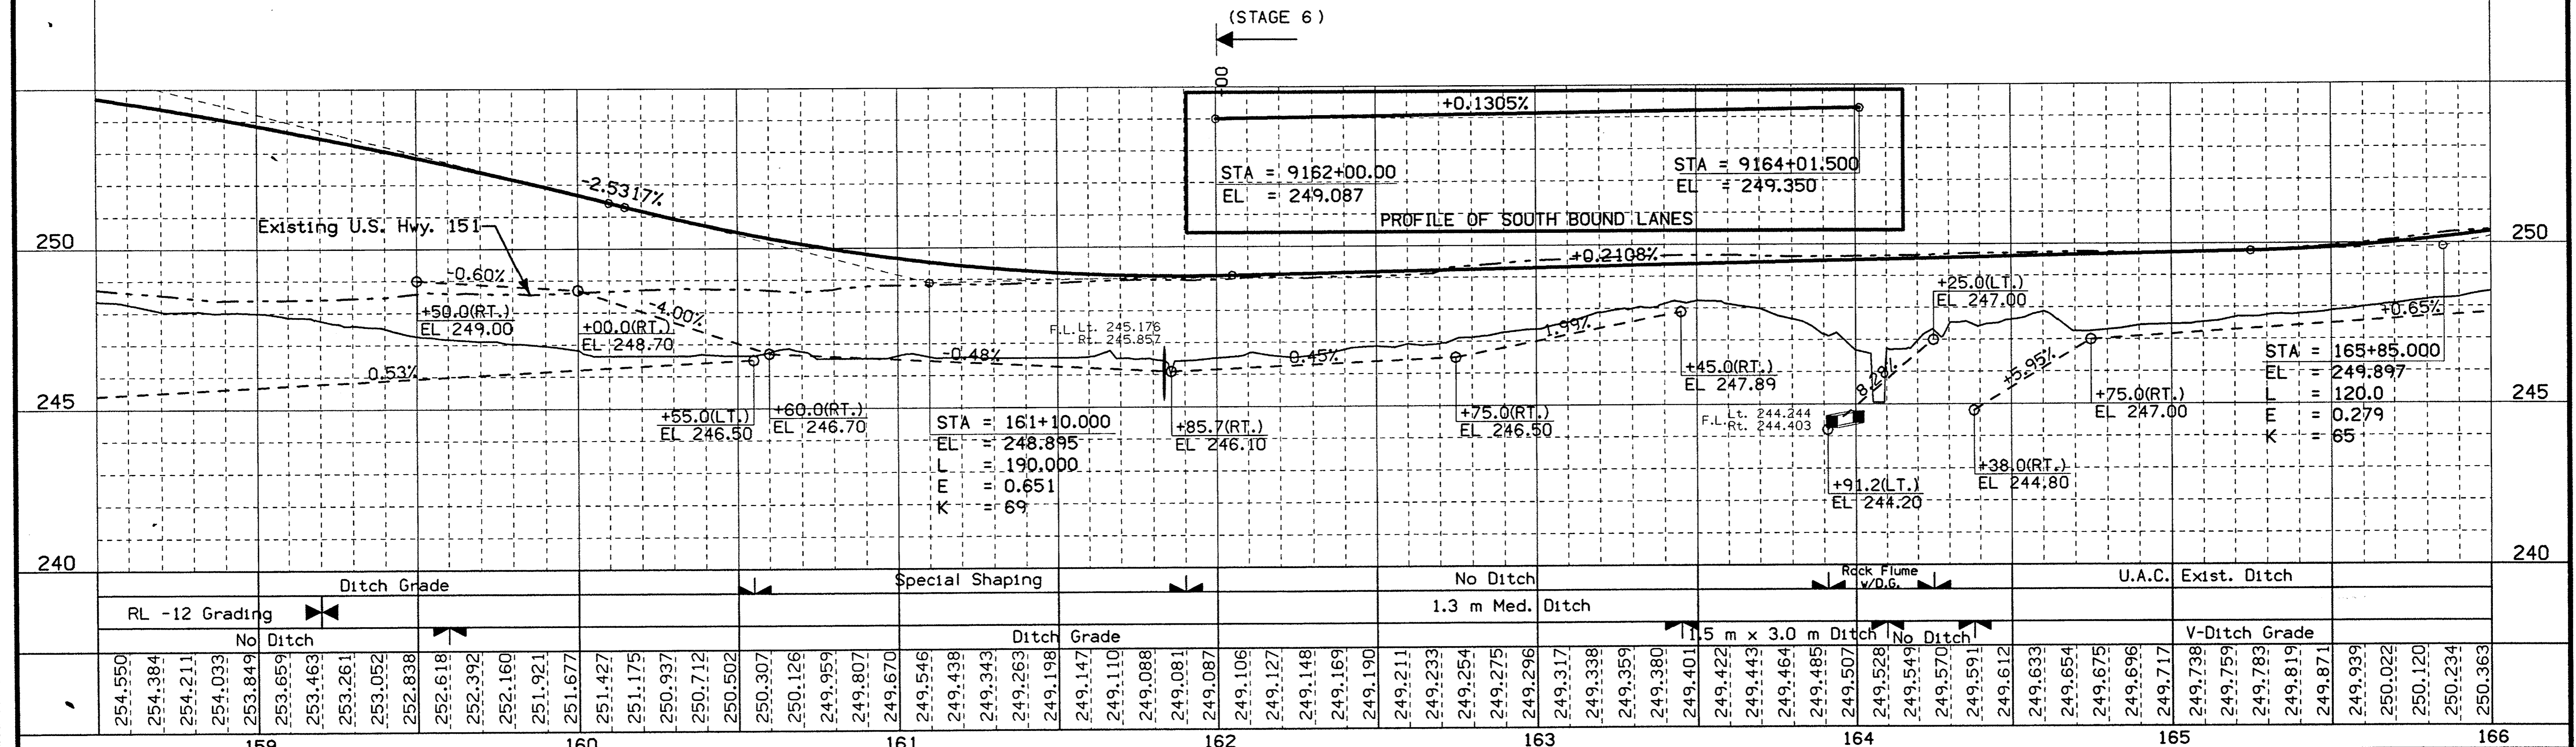

prf = \\WATS01\DATA\PL01\PL463P\DO6H.PRF
date = Wed Oct 27 13:27:01 1999

CASS TWP.
T-85N R-4W
SECTION 36


ACCESS LOCATIONS
STA 183+75 RT.

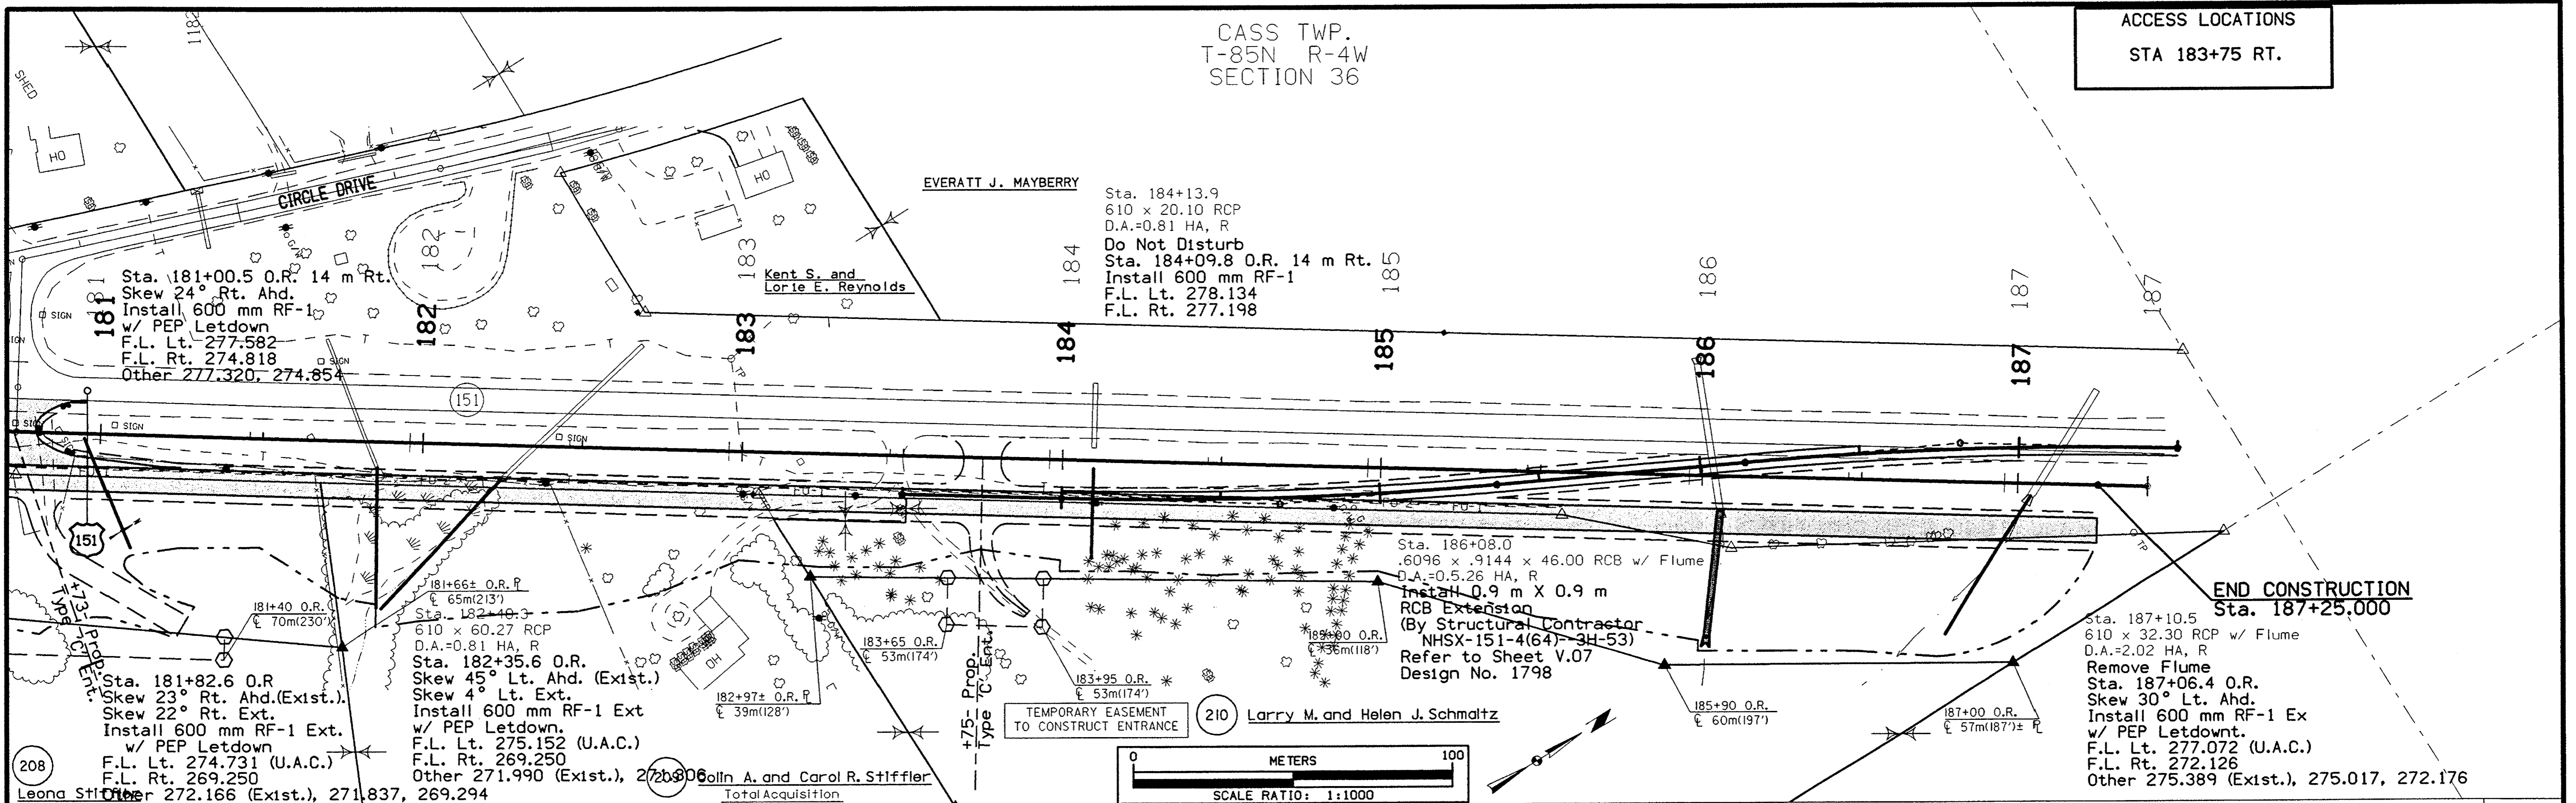

Haul from Borrow C = 6,864
B = 85,040
91,904

F + 30% = 6,864
F + 20% = 85,040
91,904

(STAGE 6)

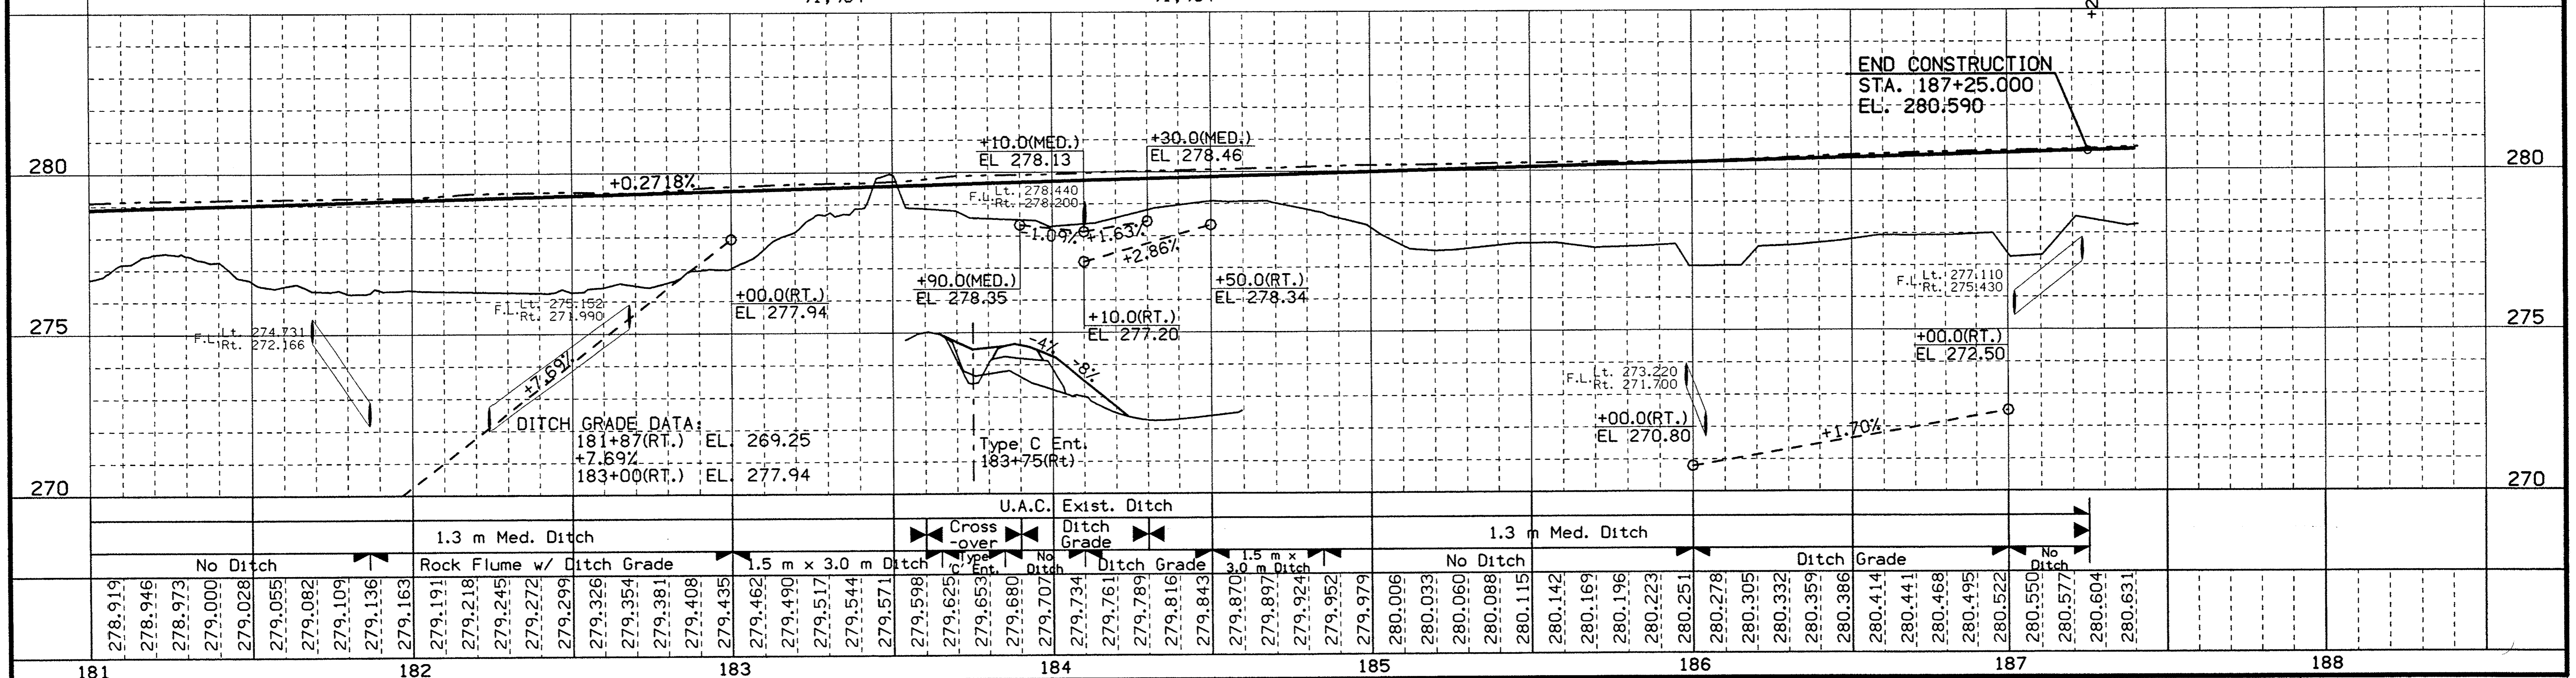

prf = \\WATSON\DATA\PLT\PL463P\009H.PRF
date = Fri Oct 29 10:55:41 1999

Curve Data
 = 49°43'50.019" L
 T = 103.329
 M = 193.518
 P = 22.780
 R = 222.956

FAIRVIEW TWP
 T-84N R-4W
 SECTION 14
 Raoul P. and Janice L. Swanson (FEE)
 D & S Construction, Inc. (CP)

ACQUIRE ACCESS CONTROL
 FROM STA. 3136+91 TO STA. 3137+41

STA. 3136+50.000
 BEGIN CONSTRUCTION

STA. 3137+41.002
 END CONSTRUCTION

STA. 137+62.083 M.L. =
 STA. 3137+59.527 S.R.

STA. 3137+28.4
 Skew 138° Rt. Ahd
 Install 600mm RF-1.
 F.L. Lt. 240.531
 F.L. Rt. 240.797


Raoul P. and
 Janice Lou Swanson

Sta. 3141+47.3
 914 x 17.00 RCP
 D.A.=34.80 HA, H




I hereby certify that this plan was prepared under my supervision and that engineering decisions with regard to the design were made by me or by other duly licensed Professional Engineers under the laws of the State of Iowa.
 Signature: *William Ottesen* 10/29/1999
 Date: 10/29/1999
 Printed or Typed Name: William Ottesen
 My license renewal date is December 31, 2000.

Pages or sheets covered by this seal: E.01 and E.03

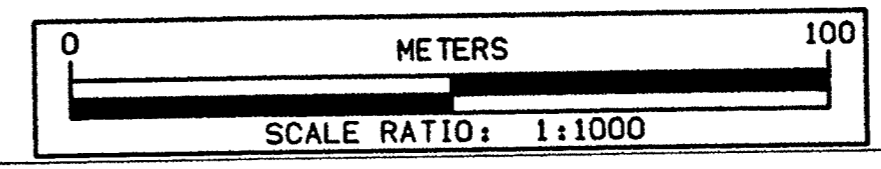

(STAGE 6)
 C = 1,443
 F + 30% = 263
 Haul to Sta. 136+00 = 1,180
 1,443

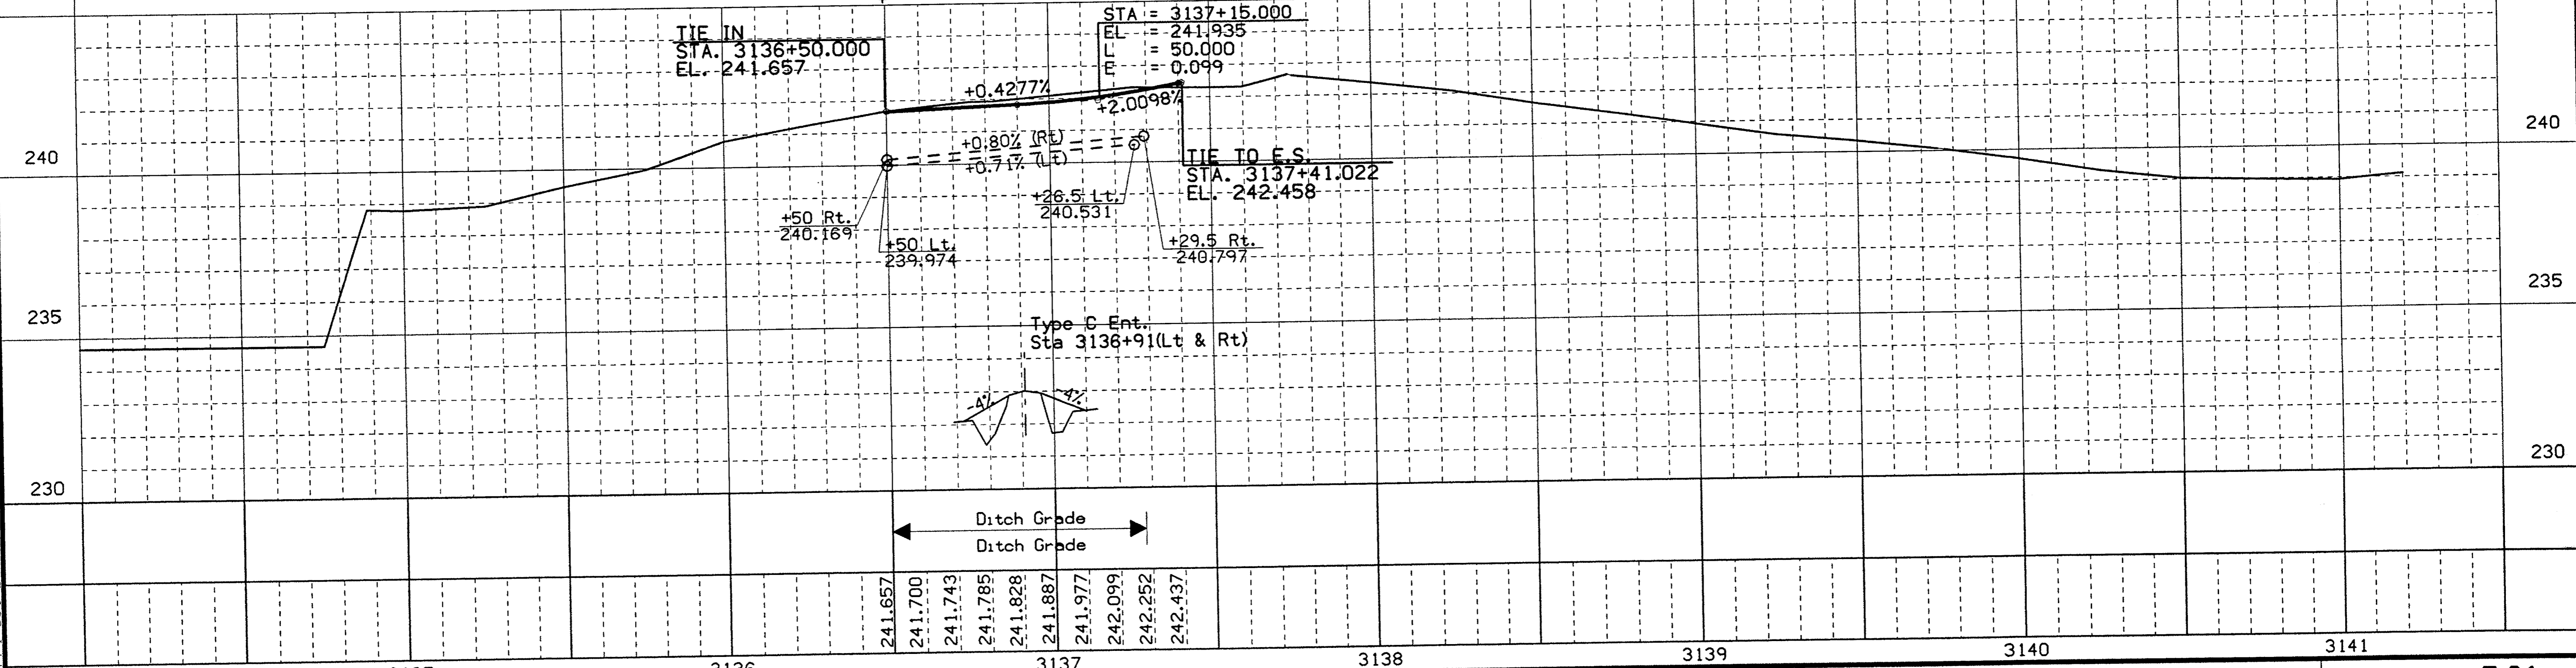


Ditch Grade
 Ditch Grade


241.657
241.700
241.743
241.785
241.828
241.887
241.977
242.099
242.252
242.437

dgn = L:\WORK\PROJECT\34120\CAD\DWG\AS\153151063.e01
 levels = 1-4.7.8
 pen table = L:\pilot\tables\half.tbl
 prf = \WA\T501\DA\TA\PL\OT\PL\483P\ED1H.PRF
 date = Fri Oct 29 09:42:58 1999

Revised

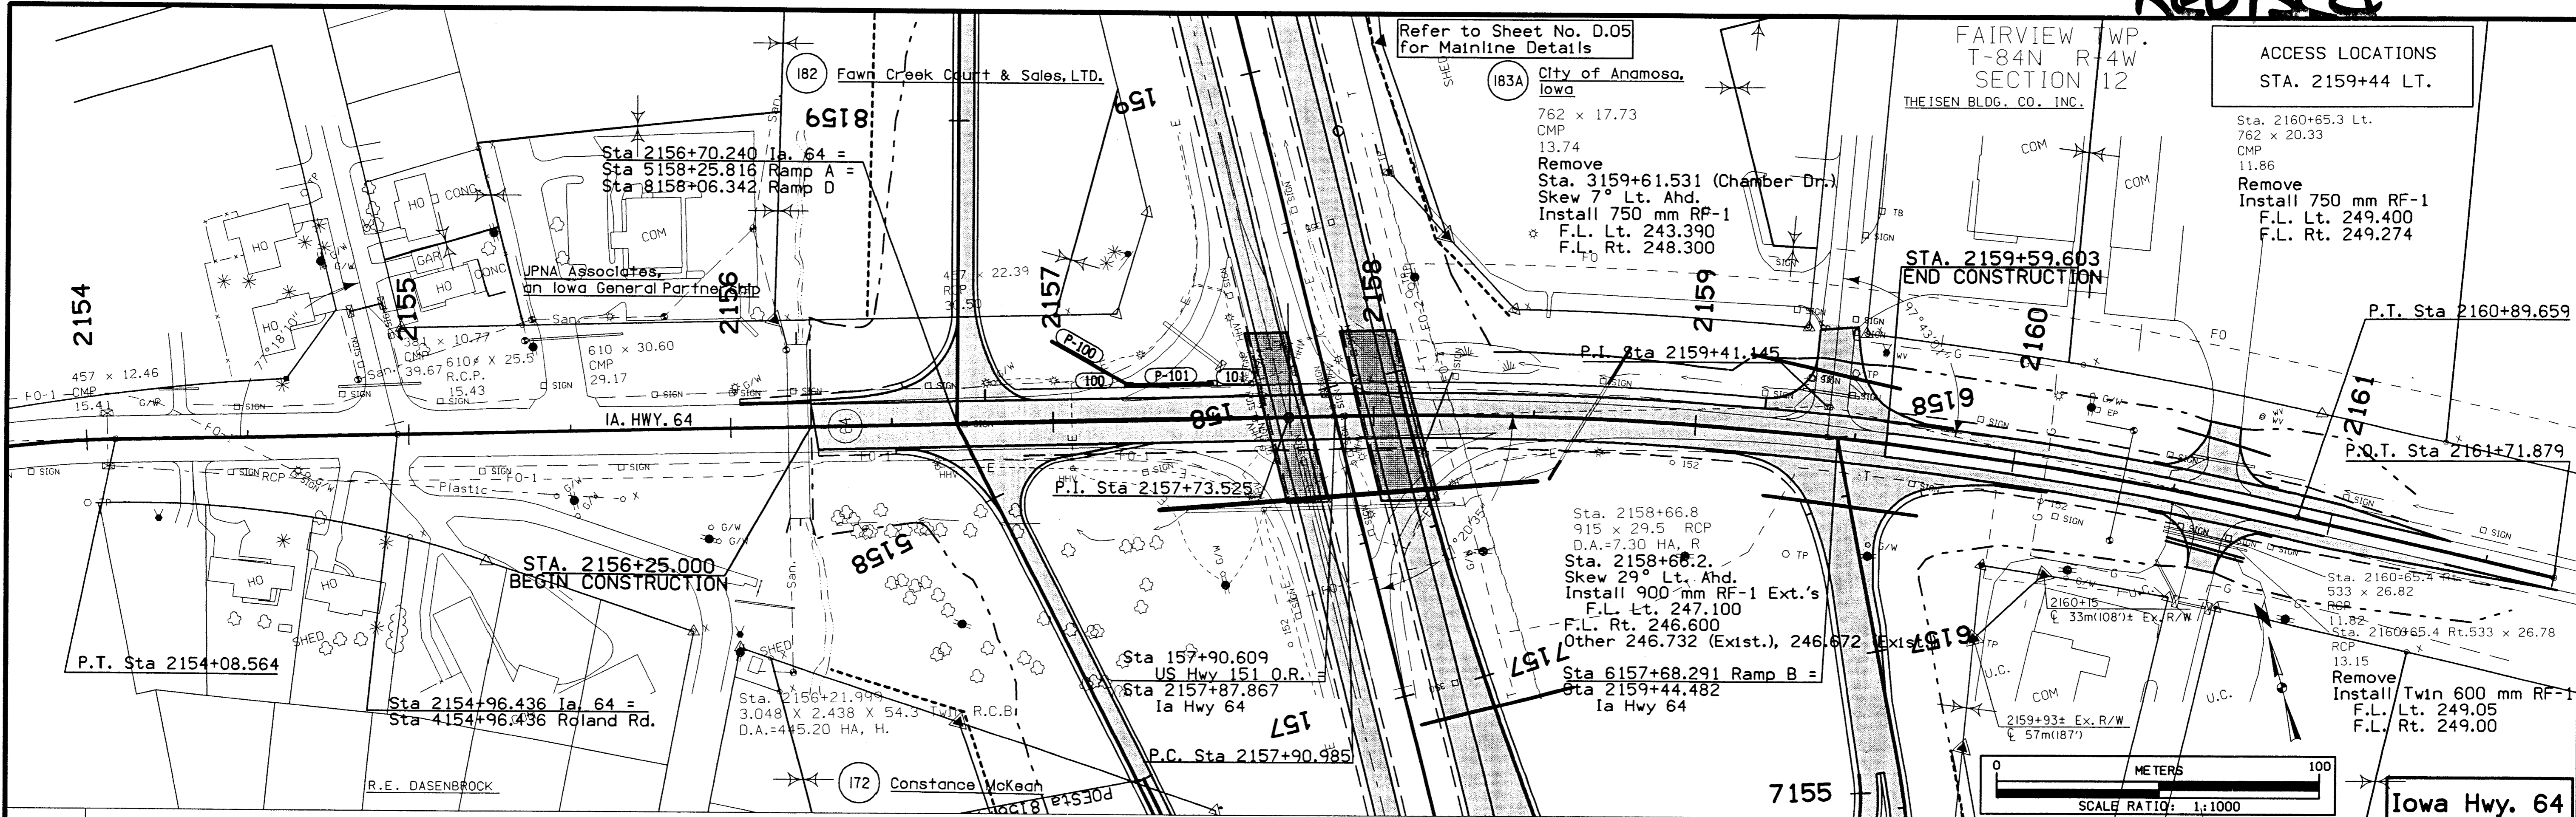

(STAGE 2)	C = 5,307	F + 30% = 3,301
Haul from Borrow A = 238		Haul to Sta. 165+30 = 2,006
F + 30% = 975		5,307
(STAGE 3)	C = 652	F + 30% = 1,213
Haul from Borrow A = 260		Haul to Sta. 165+30 = 9,386
F + 30% = 912		10,599

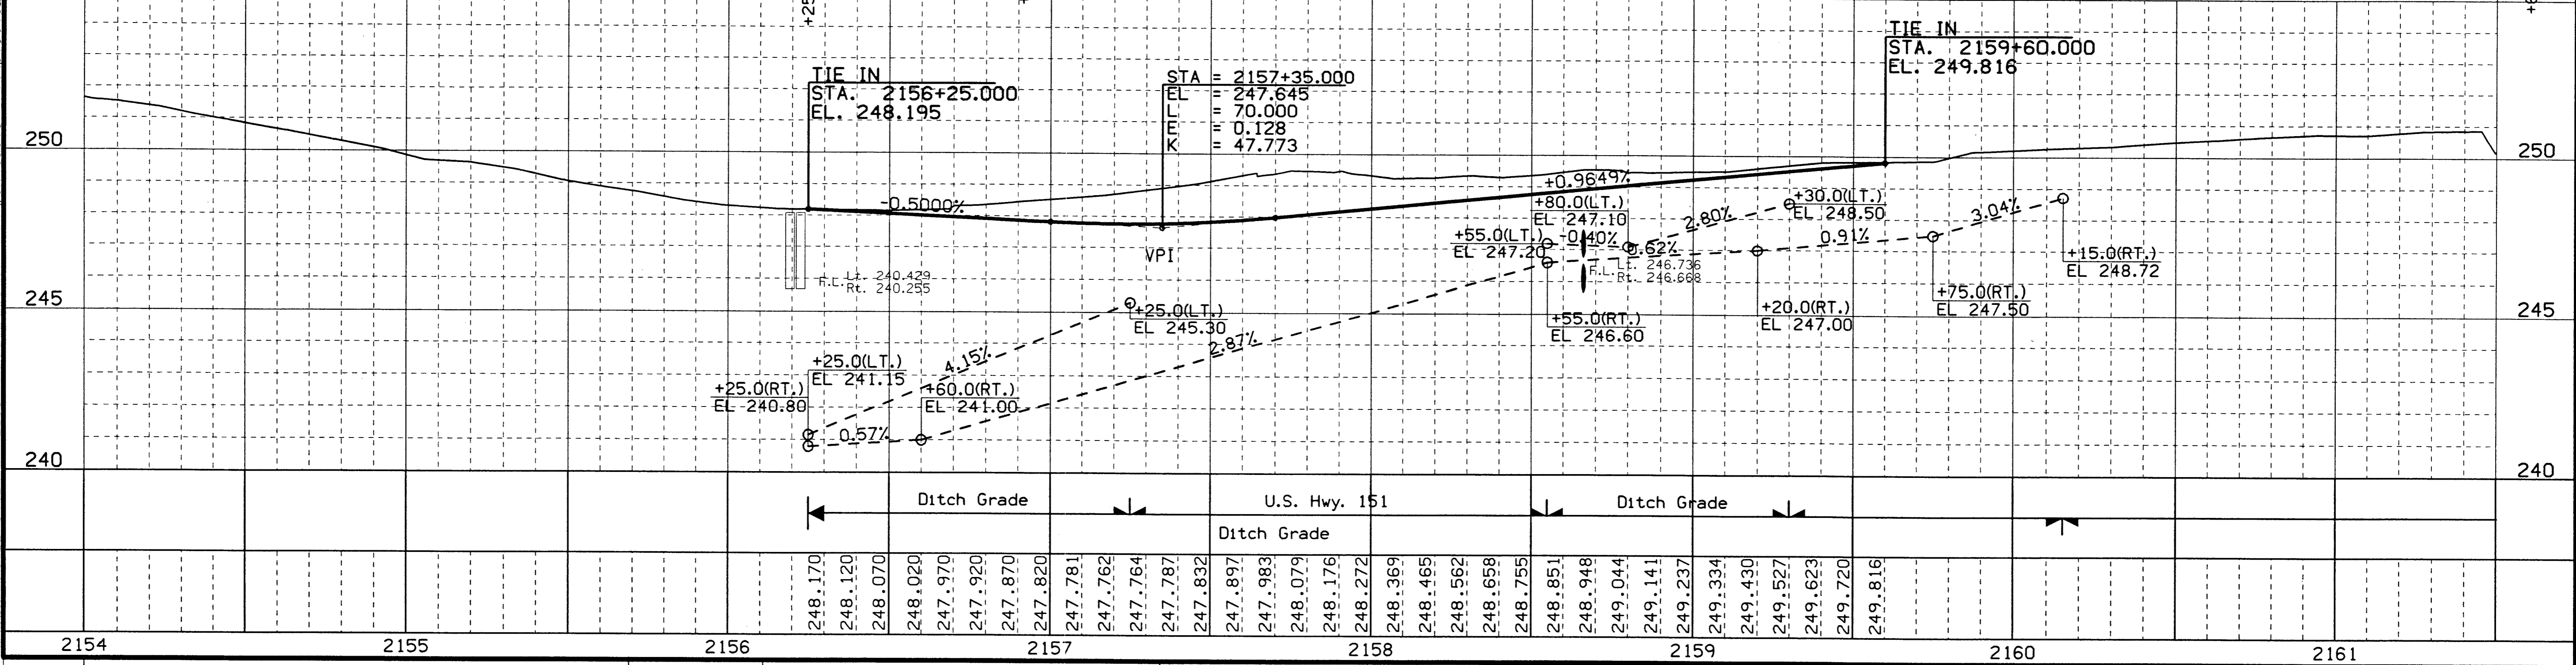


dgn = I:\WORK\project\34120\cadd\east\53151063.e02
 prf = \\\WATSON\DATA\PLT\PL463P\No02h.prf
 date = Tue Feb 22 14:27:34 2000
 levels = 1-59,61-63
 pen table = I:\p\lot\tables\half.tbl


206 D. A. Downing and C. R. McNamara
dba MACDOW, a partnership

205 Lloyd A. Brickley

FAIRVIEW TWP.
T-84N R-4W
SECTION 1

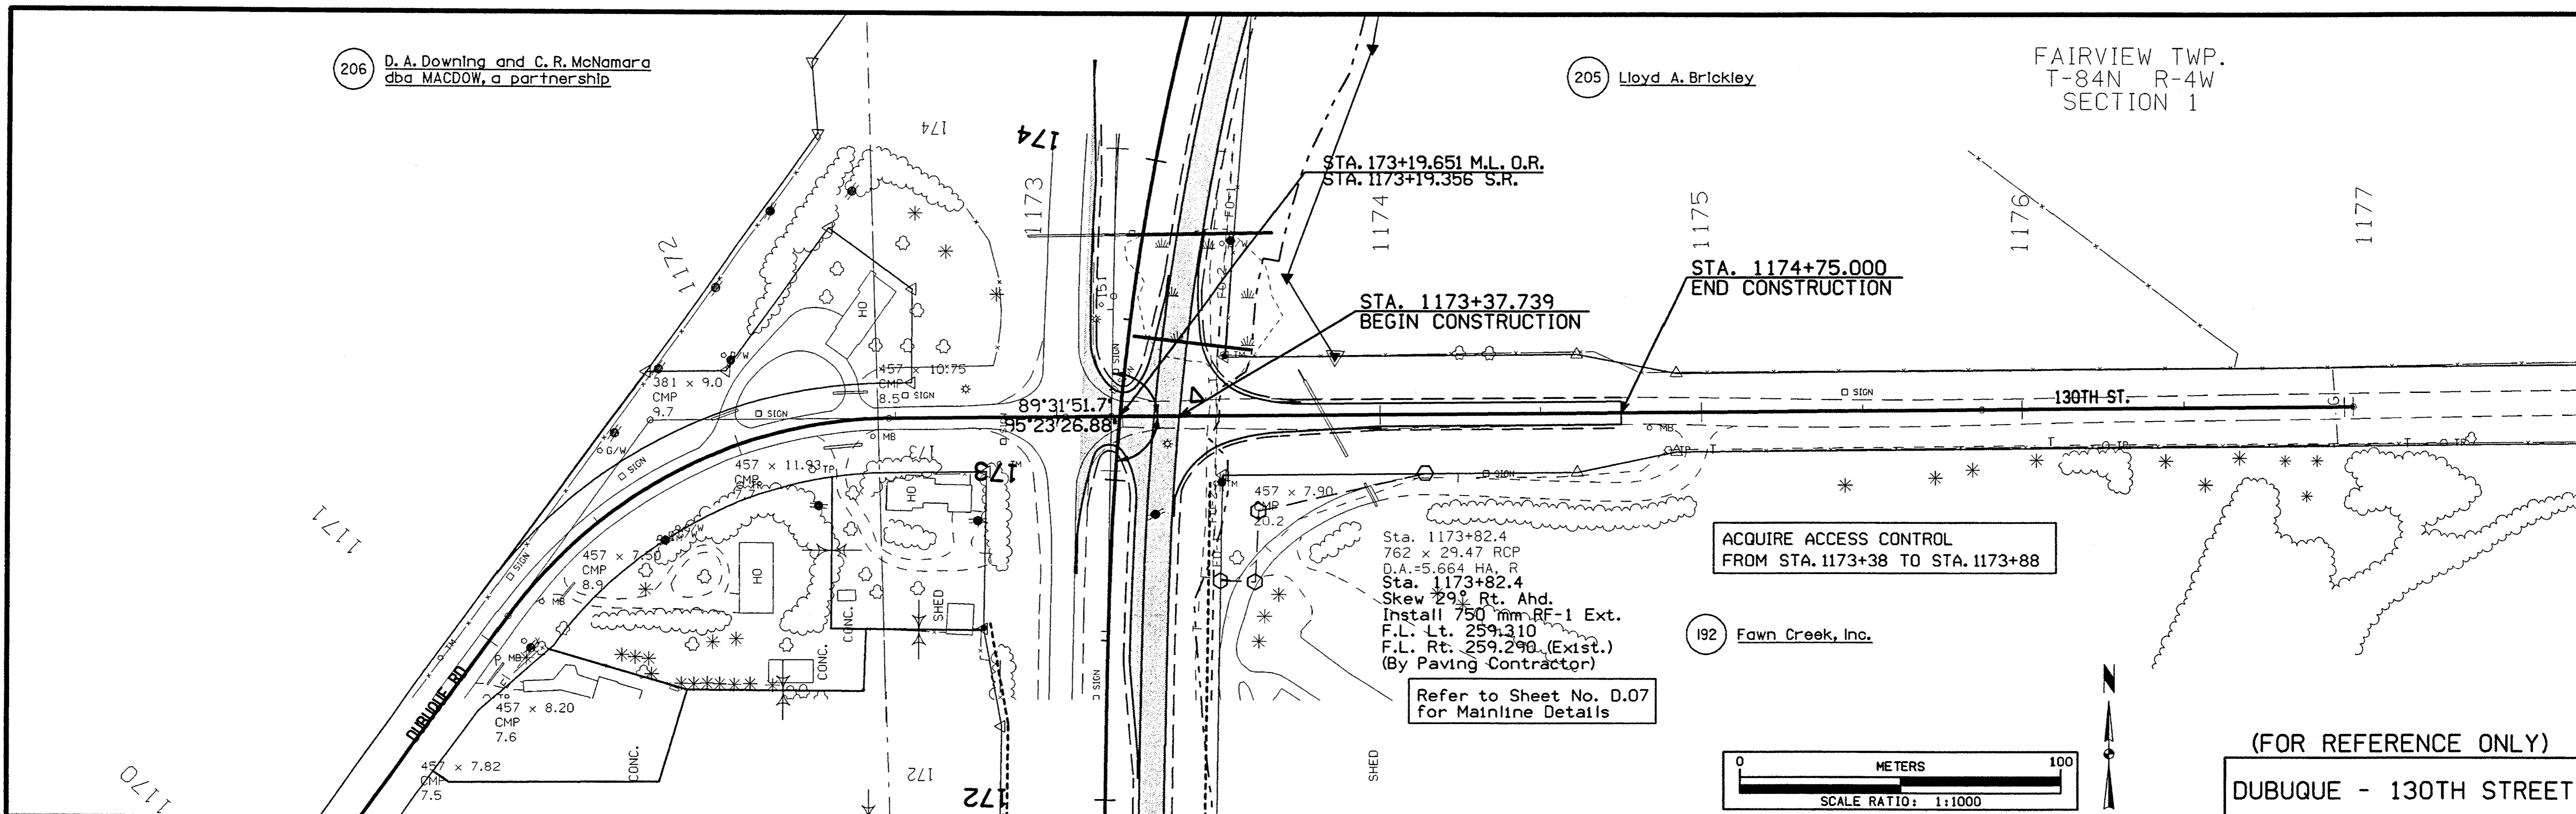


(FOR REFERENCE ONLY)
DUBUQUE - 130TH STREET

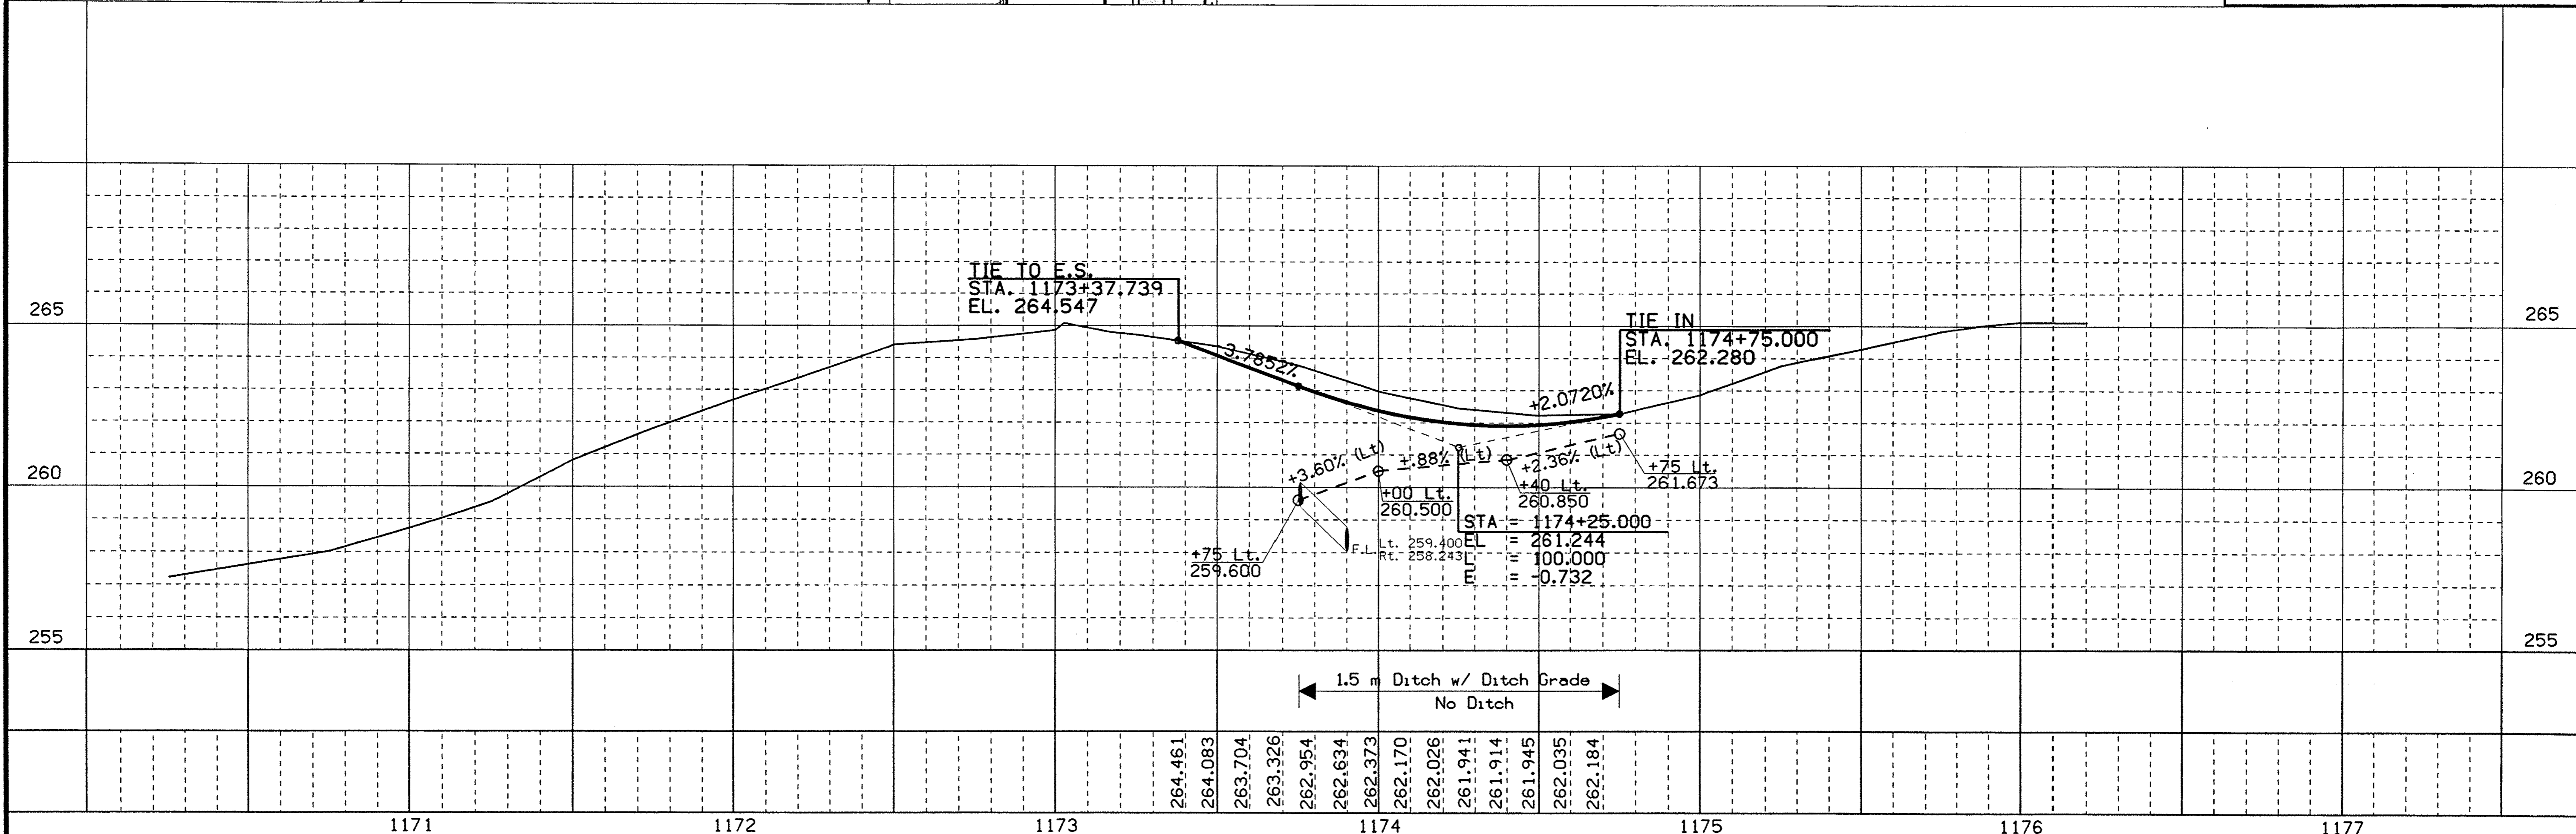

prf = \\WATS01\DATA\PL01\PL463P\EO3.PRF
date = Wed Oct 27 13:34:13 1999

ON-SITE DETOUR 'C'

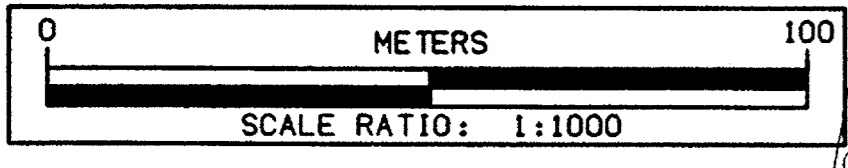


Begin On-Site Detour 'C'
 Sta. 8147+50.000 =
 Sta. 147+50.000, 17.6 m Lt.
 Tie into Southbound Lanes

TEMPORARY EASEMENT
 TO CONSTRUCT ENTRANCE


Sta. 8149+81.6, 34.0 m Lt.
 Skew 10° Rt. Ext.
 Install 600 mm PEP Ext.
 F.L. Lt. 258.616 (Exist.)
 F.L. Rt. 255.800

Sta. 8150+60.1, 31.7 m Rt.
 Skew 25° Rt. Ext.
 Install 600 mm PEP Ext.
 F.L. Lt. 255.515 (Exist.)
 F.L. Rt. 255.400

Sta. 8149+85.2, 39.7 m Lt.
 Skew 30° Lt. Ext.
 Install 600 mm PEP Ext.
 F.L. Lt. 258.000 (Exist.)
 F.L. Rt. 255.800


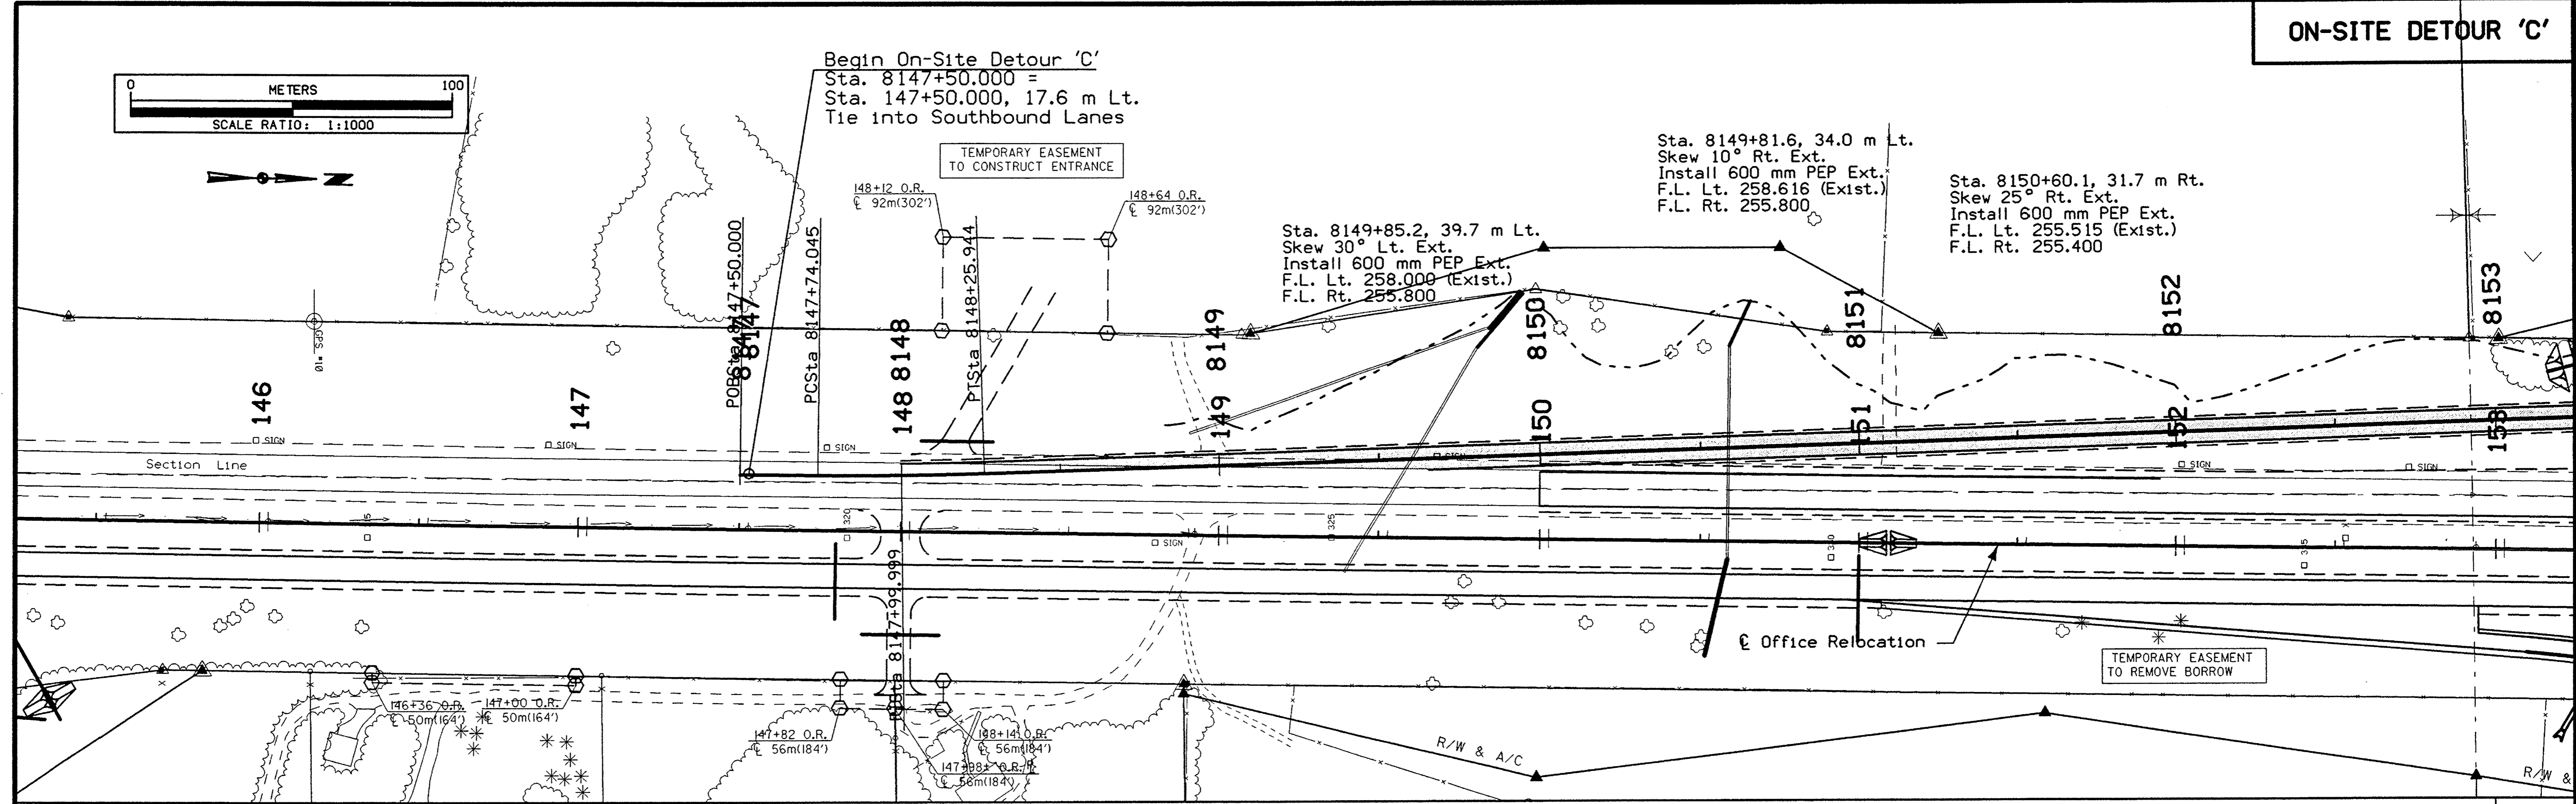


(STAGE 1)
 Haul from Borrow A = 73,066
 C = 2,869
 F + 30% = 75,935

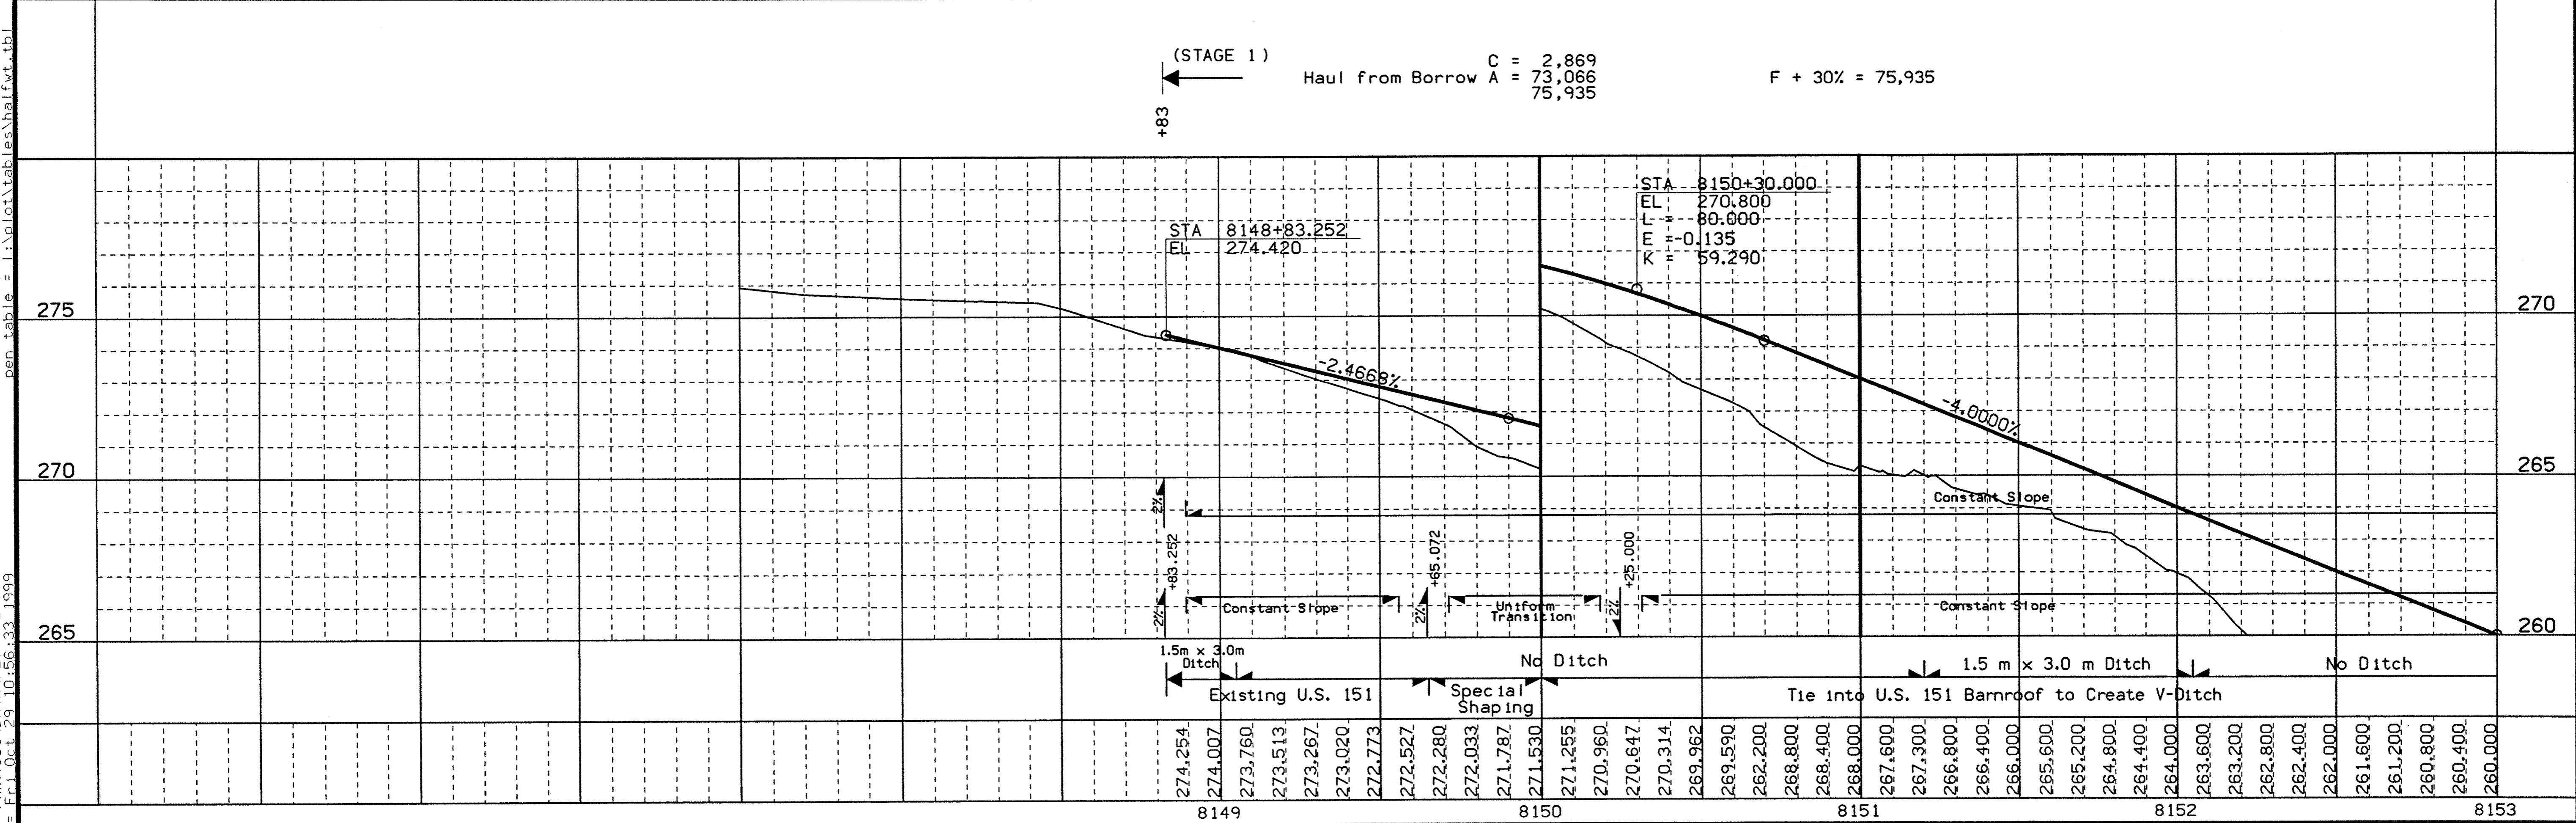

dgn = L:\WORK\PROJECTS\134120\CAD\UAS\153151063.fu1
 prf = \\WATSON\DATA\PLT\PL463P\F01H.PRF
 Date = Fri Oct 29 10:56:33 1999
 levels = 1,2,4,5,9,29,62
 pen table = I:\plot\ables\half.fwt.tbl

ON-SITE DETOUR 'C'

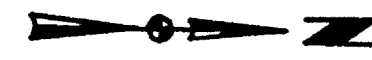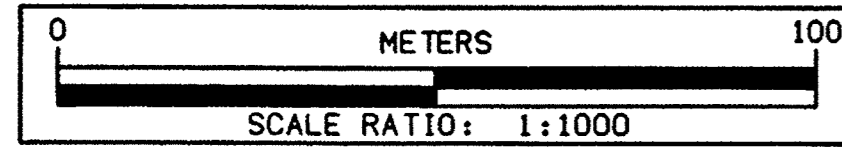



End On-Site Detour 'C'
Sta. 8156+98.024 =
Sta. 5157+00.000 Ent. Ramp 'A'

Sta. 8154+08.3 31.0 m Lt.
Install 600 mm PEP EXT.
F.L. Lt. 242.800 (Exist.)
F.L. Rt. 242.700



Sta. 8154+50.0
Install 450 mm PEP Letdown
F.L. Lt. 248.700
F.L. Rt. 255.000
Other 254.895, 248.730

FAIRVIEW TWP.
T-84N R-4W
SECTION 11

172 Constance McKean

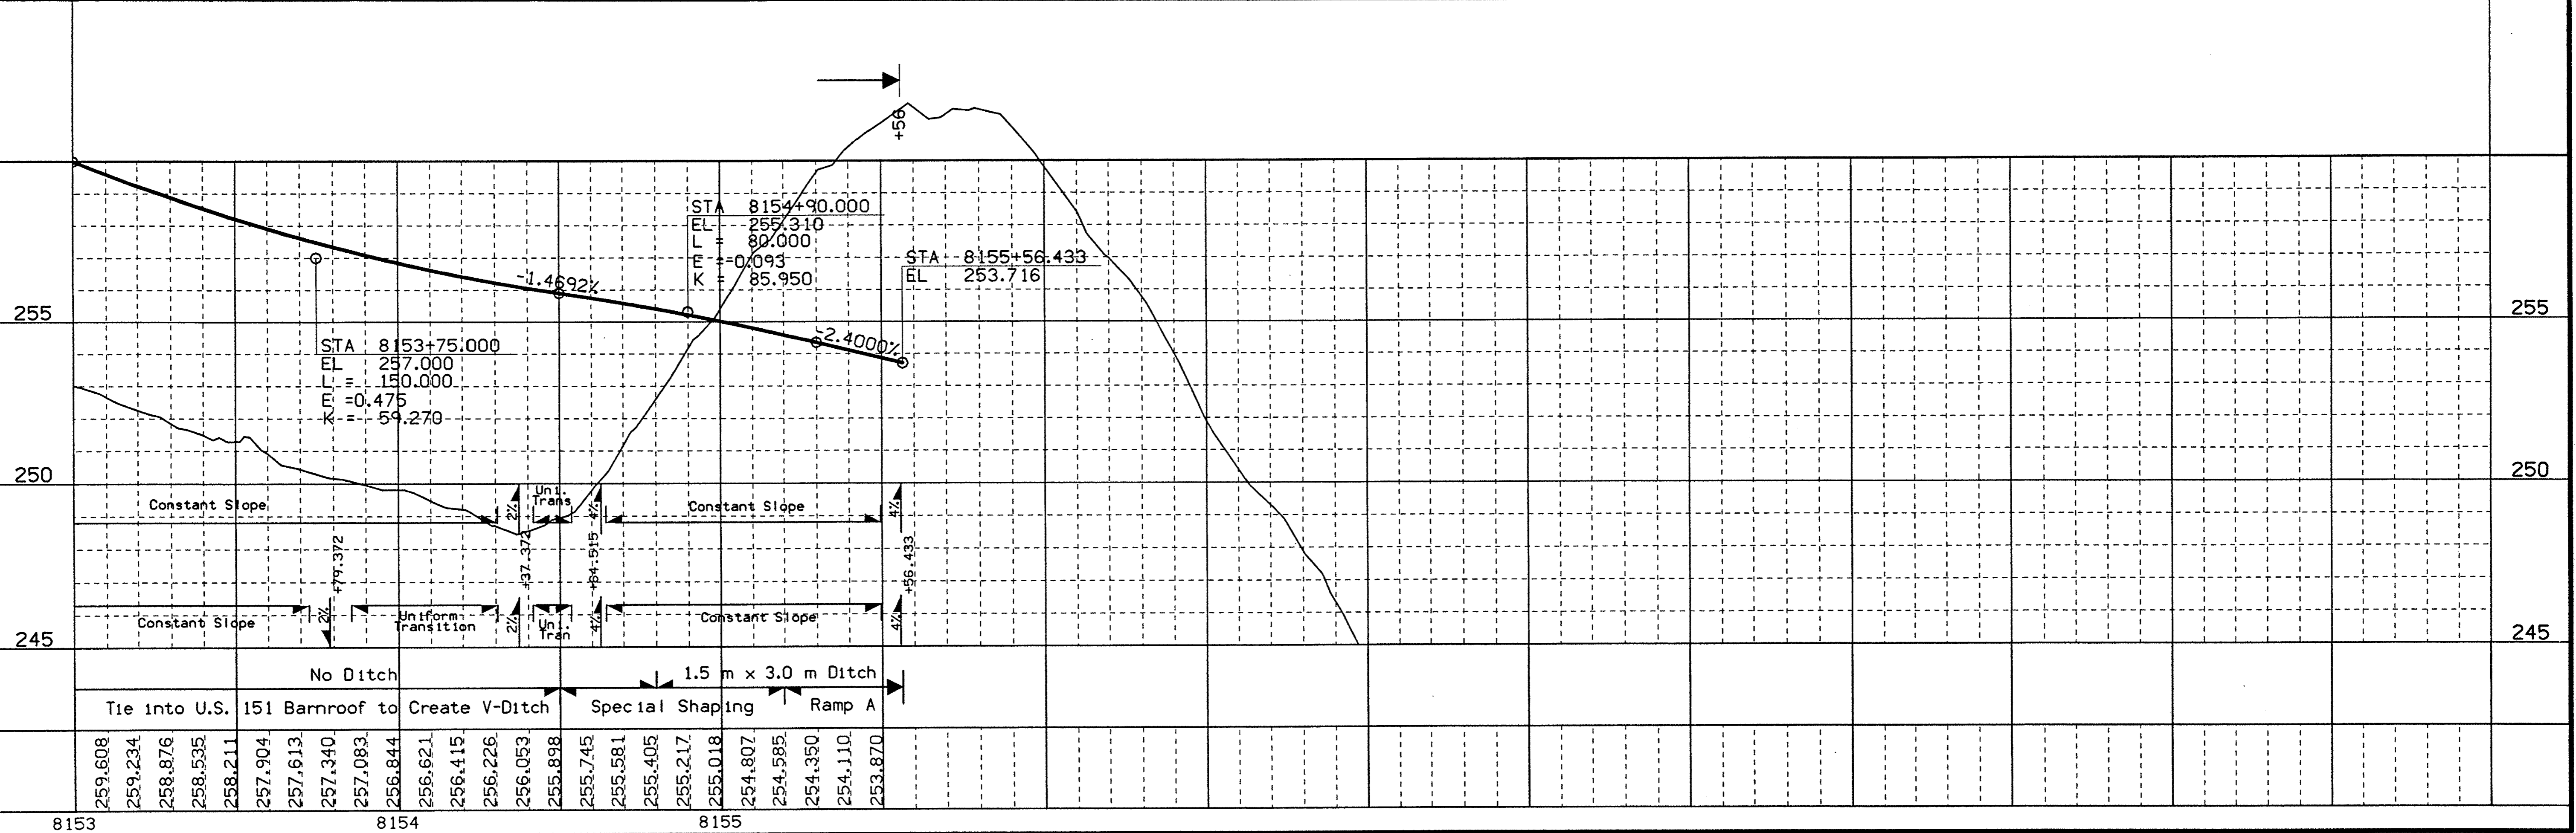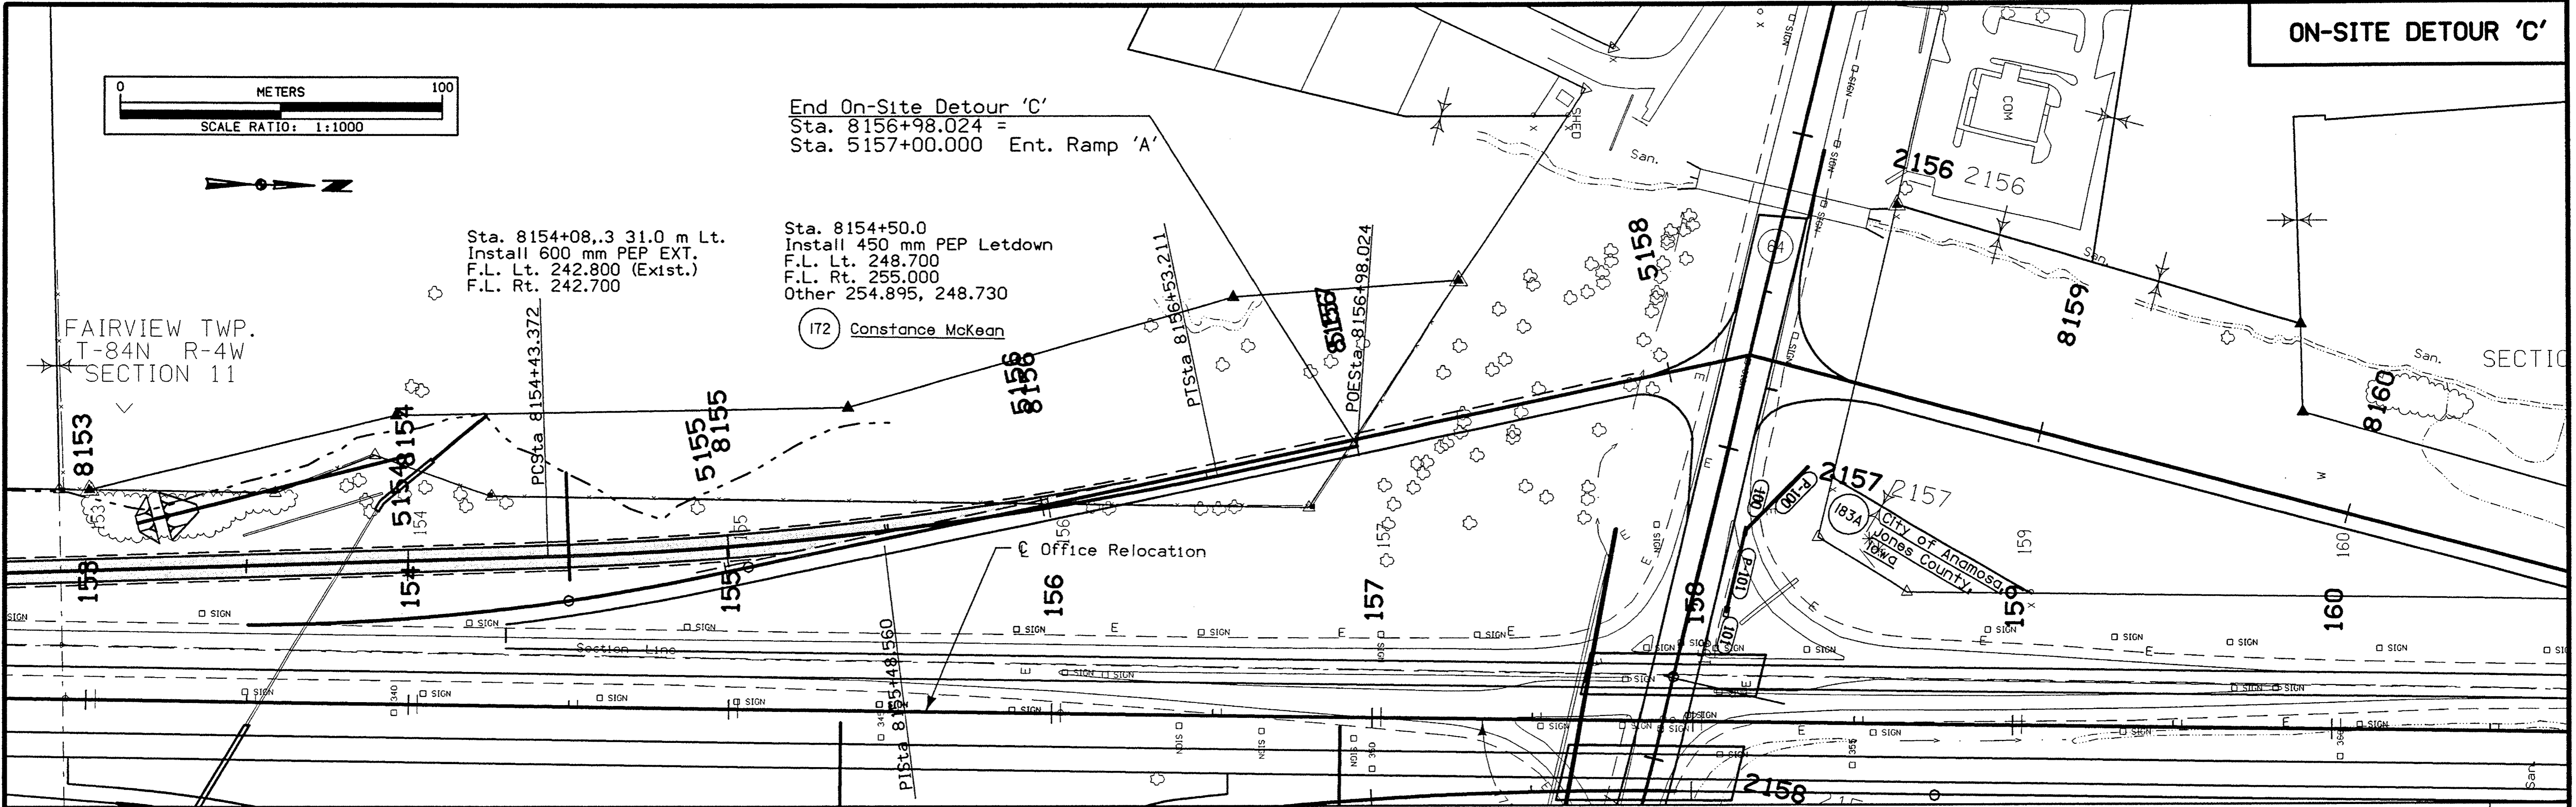

cgn = L:\WORK\PROJECT\3412\UN\CA\UN\AS\53151063.F02
 prf = \\WA1501\DATA\PLT\PL463P\F02H.PRF
 date = Wed Oct 27 13:29:07 1999
 levels = 1-63
 pen table = L:\p\lot\tables\half\wt.tbl

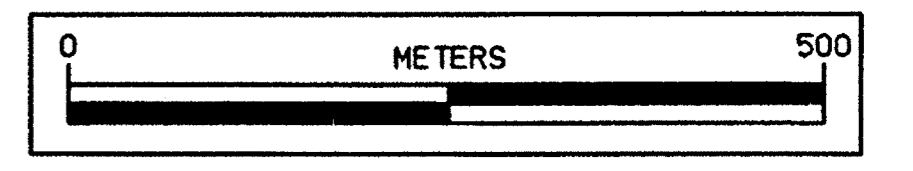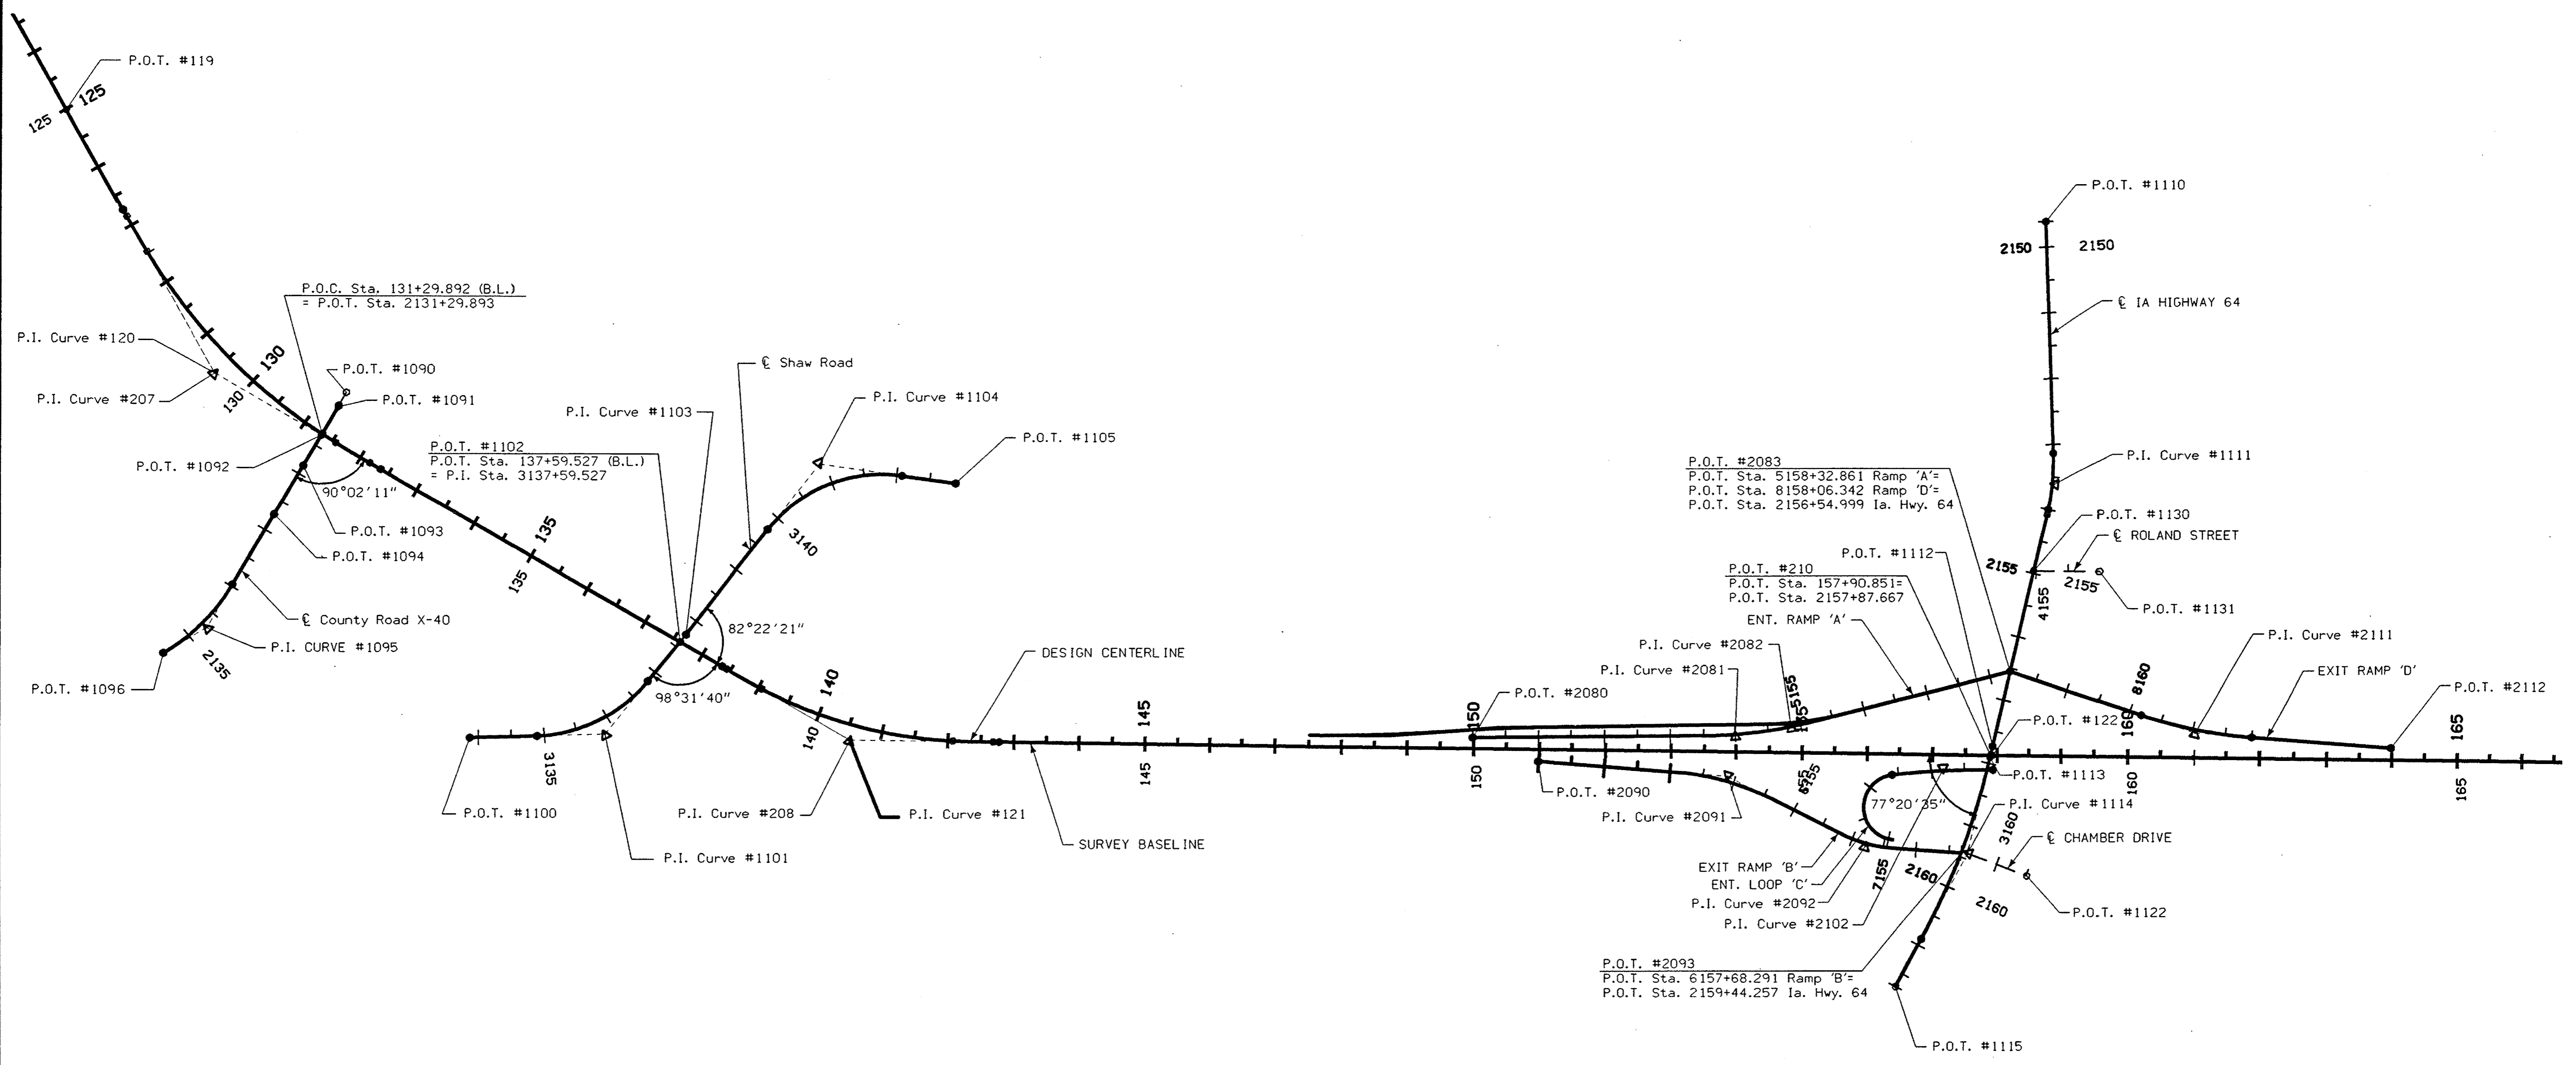

**GEOMETRIC LAYOUT
STA. 165+00 TO STA. 187+50**

prf = \\WATSON\DATA\PL0T\PL463P\G01.PRF
 date = Wed Oct 27 13:29:34 1999

SURVEY BASELINE DATA

POINT NUMBER	OVERALL CURVE DATA															SPIRAL CURVE DATA							CIRCULAR CURVE DATA					SUPERELEVATION DATA			POINT NUMBER	
	P.O.T. OR P.I.			T.S. or P.C.			S.T. or P.T.			S.C.			C.S.			Δ	Ts	Es	Is	LT	ST	Xo	Yo	Δc	Rc	Tc	Lc	Ec	e	L		x
	Station	Coordinates		Station	Coordinates		Station	Coordinates		Station	Coordinates		Station	Coordinates																		
120	129+54.987	7171.327	16544.779	126+83.726	7038.059	16308.512	132+14.782	7405.911	16680.987	127+44.702	7068.623	16361.271	131+53.806	7353.537	16649.767	30°26'00.30"	271.261	32.337	60.976	40.653	20.328	60.969	0.700	26°29'08.77"	885.000	208.274	409.104	24.177				
121	140+58.887	8135.885	17104.839	138+42.753	7948.975	16996.312	142+66.787	8351.996	17108.019	139+03.729	8002.135	17026.169	142+05.811	8291.050	17106.250	29°17'53.29"	216.134	24.081	60.976	40.655	20.329	60.695	0.873	24°22'38.92"	710.000	153.361	302.082	16.374				
122	157+91.027	9876.071	17130.445																													
123	174+94.397	11579.259	17155.349	173+54.159	11439.036	17153.299	176+28.462	11696.294	17232.612	174+15.135	11499.941	17155.841	175+67.486	11644.530	17200.418	32°35'38.07"	140.238	16.128	60.976	40.665	20.338	60.936	1.652	23°16'38.87"	375.000	77.241	152.351	7.872				
124	179+17.753	11937.721	17391.995																													
125	187+45.134	12626.567	17850.307																													

OFFICE RELOCATION DATA

POINT NUMBER	OVERALL CURVE DATA															SPIRAL CURVE DATA							CIRCULAR CURVE DATA					SUPERELEVATION DATA			POINT NUMBER	
	P.O.T. OR P.I.			T.S. or P.C.			S.T. or P.T.			S.C.			C.S.			Δ	Ts	Es	Is	LT	ST	Xo	Yo	Δc	Rc	Tc	Lc	Ec	e	L		x
	Station	Coordinates		Station	Coordinates		Station	Coordinates		Station	Coordinates		Station	Coordinates																		
206	109+81.905	6196.011	14815.664	107+12.382	6193.096	14546.156	112+41.777	6328.425	15050.418	108+04.382	6195.712	14638.108	111+49.777	6284.651	14969.512	28°48'20.21"	269.523	28.649	92.000	61.342	30.675	91.974	1.621	22°44'48.30"	870.000	175.002	345.395	17.427				
207	129+57.469	7171.327	16544.779	126+74.716	7032.413	16298.502	132+28.829	7415.849	16686.758	127+66.716	7079.011	16377.815	131+36.829	7337.125	16639.173	30°26'00.56"	282.753	32.031	92.000	61.342	30.675	91.974	1.621	24°22'28.65"	870.000	187.899	370.113	20.060				
208	140+61.442	8135.885	17104.839	138+36.559	7941.409	16991.918	142+78.276	8360.743	17108.148	139+30.559	8023.747	17037.224	141+84.276	8266.830	17104.601	29°17'53.18"	224.883	23.407	94.000	62.682	31.348	93.955	2.165	21°22'40.11"	680.000	128.351	253.717	12.007	7.30%	94	26	
209	174+97.384	11579.503	17155.510	172+17.411	11299.560	17151.391	177+64.433	11813.153	17309.759	173+09.411	11391.493	17154.507	176+72.433	11735.430	17260.561	32°35'18.98"	279.974	33.937	92.000	61.344	30.676	91.970	1.763	25°59'58.52"	800.000	184.692	363.023	21.043	6.50%	92	28	
210	179+13.698	11937.721	17391.995	178+77.829	11907.787	17372.233	179+49.567	11967.584	17411.864																							
211	187+41.078	12626.567	17850.307																													

**ALIGNMENT DATA
SURVEY BASELINE AND
O.R. CENTERLINE**

don = I:\work\project\34120\cadd\east\53151063.g03
 prf = \\WATSON\DA\A\PILOT\PI463P\G03.prf
 Date = Fri Oct 29 08:10:22 1999
 level s = 1-63
 pen table = I:\plot\tables\half.tbl

SIDEROAD SURVEY BASELINE DATA

LOCATION	CURVE NUMBER	CURVE POINTS									CIRCULAR CURVE DATA					SUPERELEVATION DATA				CURVE NUMBER	COMMENTS
		P.I. (OR P.O.T.)			P.C.			P.T.			Δ	R	T	L	E	e	L	m	x		
		Station	Coordinates		Station	Coordinates		Station	Coordinates												
Shaw Road	1100	3133+86.791	7559.012	17101.357																	
	1101	3135+91.941	7764.082	17095.627	3134+88.613	7660.793	17098.513	3136+82.130	7828.643	17014.951	49°43'50.05"	222.956	103.329	193.518	22.780						
	1102	3137+59.527	7877.002	16954.522																	
	1103	3137+73.653	7885.654	16943.355																	
	1104	3141+04.543	8088.316	16681.790	3139+77.091	8010.255	16782.539	3142+07.870	8214.448	16700.087	60°29'07.26"	218.609	127.452	230.779	34.440						
Iowa Highway 64	1110	2149+61.295	9960.009	16315.259																	
	1111	2153+61.295	9972.627	16715.060	2153+13.457	9971.118	16667.245	2154+08.564	9961.459	16761.576	15°18'28.00"	355.976	47.838	95.107	3.200						
	1112	2157+73.525	9876.260	17116.454																	
	1113	2157+87.867	9872.912	17130.399																	
	1114	2159+41.145	9837.130	17279.442	2157+90.987	9872.184	17133.433	2160+89.658	9766.198	17411.792	14°41'19.56"	1165.011	150.159	298.671	9.637	3.00%	44	13	30		
130th Street	1115	2162+35.391	9697.356	17540.241																	
	1120	1169+13.871	11180.155	16851.779																	
	1121	1169+44.242	11204.979	16869.276																	
	1122	1171+84.361	11400.112	17009.206	1171+09.623	11339.376	16965.652	1172+47.980	11400.927	17083.939	53°43'50.63"	147.537	74.738	138.357	17.850						
	1123	1173+02.792	11401.525	17138.748																	
	1124	1173+16.797	11401.678	17152.752																	
	1125	1175+87.442	11404.134	17423.386																	
Circle Drive	1126	1177+02.793	11405.191	17538.732																	
	1130	1180+77.944	12071.089	17480.729																	
	1131	1180+91.945	12078.926	17469.127																	
	1132	1181+31.734	12101.198	17436.156																	
	1133	1183+21.814	12280.076	17500.446	1182+64.437	12226.080	17481.039	1183+79.040	12336.075	17512.944	7°11'14.43"	913.590	57.377	114.603	1.800						
1134	1185+59.094	12511.804	17552.165	1184+71.734	12426.543	17533.136	1186+42.782	12577.445	17609.810	28°42'25.03"	341.392	87.359	171.048	11.000							
1135	1188+55.423	12737.222	17750.121																		


RAMP, LOOP, SIDEROAD O.R. AND ACCESSWAY DATA

LOCATION	CURVE NUMBER	CURVE POINTS									CIRCULAR CURVE DATA					SUPERELEVATION DATA				CURVE NUMBER	COMMENTS
		P.I. (OR P.O.T.)			P.C.			P.T.			Δ	R	T	L	E	e	L	m	x		
		Station	Coordinates		Station	Coordinates		Station	Coordinates												
Ia. Hwy. 64 Ent. Ramp 'A'	2080	5150+49.940	9132.653	17101.204																	
	2081	5154+00.085	9482.793	17099.354	5153+50.000	9432.708	17099.618	5154+50.000	9532.330	17092.961	8°11'06.38"	700.000	50.085	100.000	1.790	6.30%	65	19.5	21		
	2082	5154+70.489	9552.594	17088.937	5154+50.000	9532.330	17091.961	5154+90.966	9572.646	17084.733	3°21'11.10"	700.000	20.489	40.966	0.300	6.30%	65	19.5	21		
	2083	5158+25.816	9900.372	17016.023																	
Ia. Hwy. 64 Exit Ramp 'B'	2090	6150+96.524	9179.109	17138.292																	
	2091	6153+89.097	9470.716	17162.046	6153+10.000	9391.881	17155.624	6154+66.179	9541.174	17197.989	22°22'15.12"	400.000	79.097	156.178	7.745	8.00%	75	22.5	19		
	2092	6156+22.535	9680.455	17269.042	6155+82.242	9644.562	17250.731	6156+61.764	9720.637	17272.025	22°46'53.59"	200.000	40.294	79.523	4.019	7.90%	60	18	15		
Ia. Hwy. 64 Ent. Loop 'C'	2093	6157+68.046	9826.627	17279.894																	
	2100	7153+86.198	9829.738	17271.746																	
	2101	7159+29.912	9289.562	17209.825	7154+94.346	9722.294	17259.430	7156+39.997	9722.278	17160.082	166°54'10.82"	50.000	435.566	145.650	388.427	8.00%	52	15.6	13		
	2102	7157+17.608	9799.382	17151.218	7156+40.000	9722.281	17160.082	7157+95.000	9876.981	17152.360	7°24'02.54"	1200.000	77.608	155.000	2.507	4.00%	65	19.5	32		
Ia. Hwy. 64 Exit Ramp 'D'	2103	7160+70.000	10151.951	17156.407																	
	2110	8158+06.342	9900.371	17016.022																	
	2111	8161+26.196	10209.321	17098.829	8160+62.816	10148.101	17082.420	8161+89.231	10272.492	17103.975	10°20'50.22"	700.000	63.380	126.416	2.863	6.30%	65	19.5	21		
Crossover 'D'	2112	8163+99.699	10482.264	17121.063																	
	2120	183+50.000	12294.212	17643.834																	
	2121	184+68.538	12392.902	17709.497	184+00.001	12335.841	17671.531	185+36.927	12453.915	17740.719	6°32'15.84"	1200.000	68.537	136.926	1.956						
	2122	186+82.719	12583.701	17807.134	186+14.193	12522.698	17775.917	187+51.096	12640.753	17845.092	6°32'11.96"	1200.000	68.526	136.903	1.955						
On-Site Detour 'C'	2123	188+01.095	12682.381	17872.788																	
	2130	8147+50.000	8832.670	17097.000																	
	2131	8147+99.999	8882.665	17098.000	8147+74.045	8856.713	17098.000	8148.250944	8909.605	17097.000	2°28'40.792"	1200.000	25.954	51.899	0.281	See F.01 and F.02 For Super Elevation Data					
	2132	8150+39.283	9121.406	17086.702	8149+67.144	9049.440	17091.696	8151+11.383	9193.541	17085.867	3°18'20.53"	2500.000	72.139	144.239	1.041						
2133	8156+98.024	9777.664	17043.000																		


ALIGNMENT DATA
SIDEROADS, ACCESSWAYS
AND INTERCHANGE

dpr = I:\work\project\34120\cadd\east\53151063.g04
 prf = \\WAT501\DATA\PL\10\TYPL\463P\G04.prf
 date = Fri Oct 29 08:10:36 1999
 levels = 1-63
 pen table = I:\pilot\tables\halfwt.tbl


P.I. STA. 129+54.987
Set Iron Pin

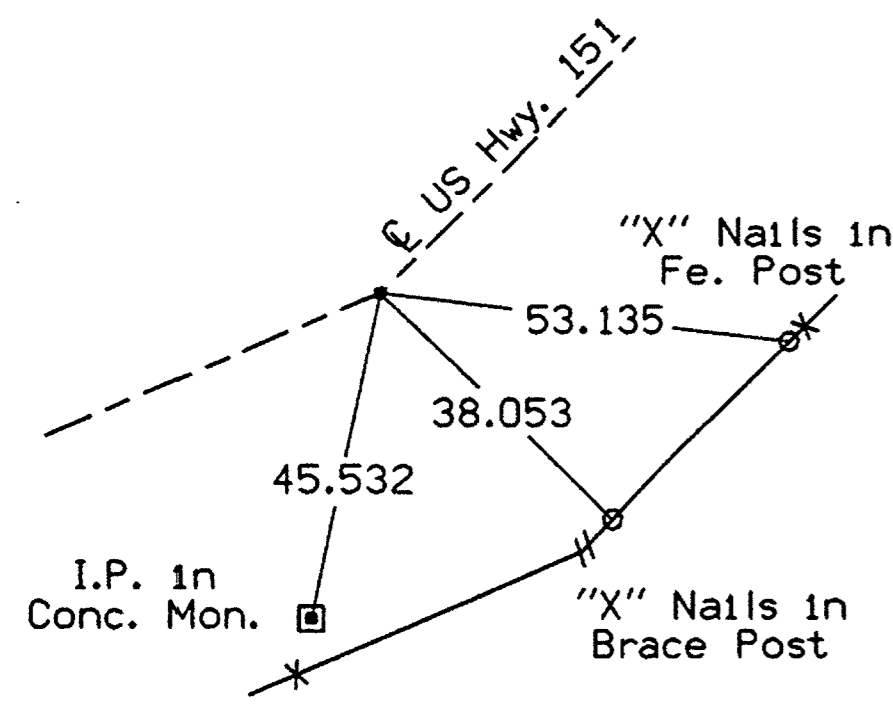


C.S. STA. 131+53.806
Set Iron Pin

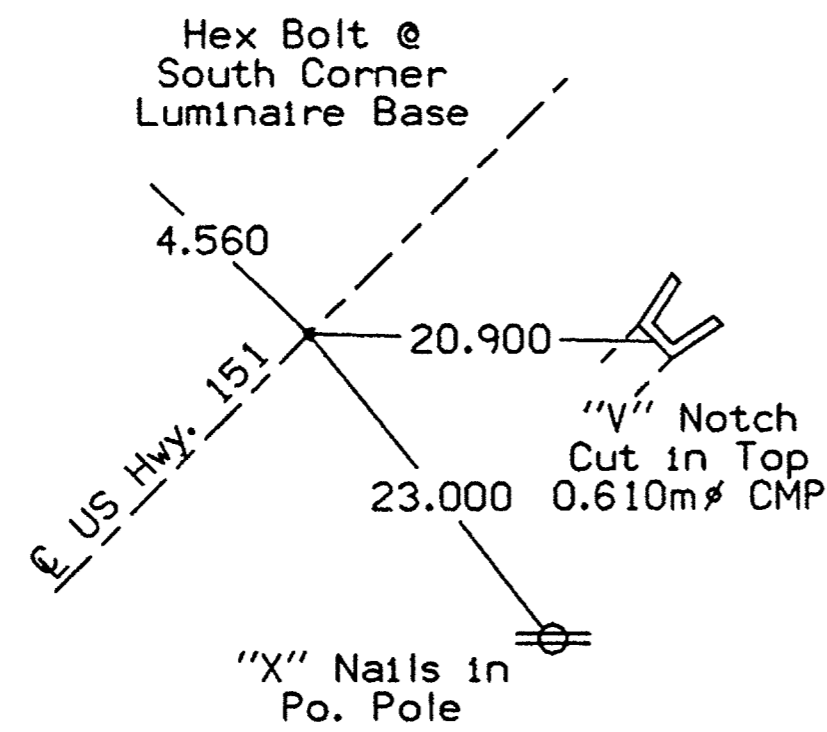


S.T. STA. 132+14.782
Set Iron Pin

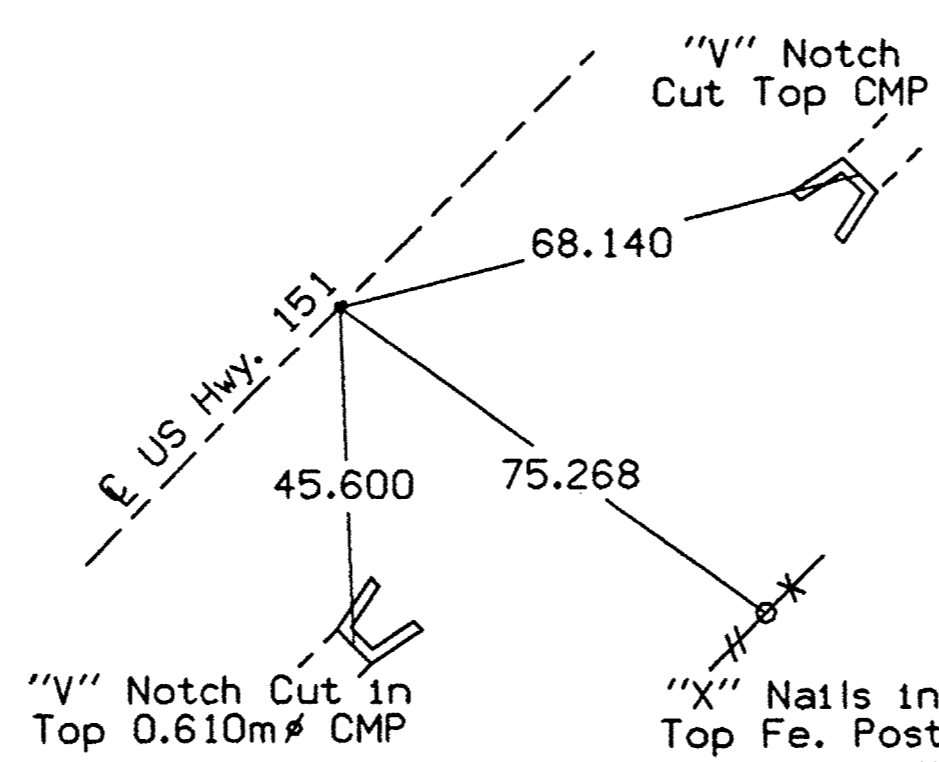


P.O.T. STA. 136+00.018
Set Iron Pin

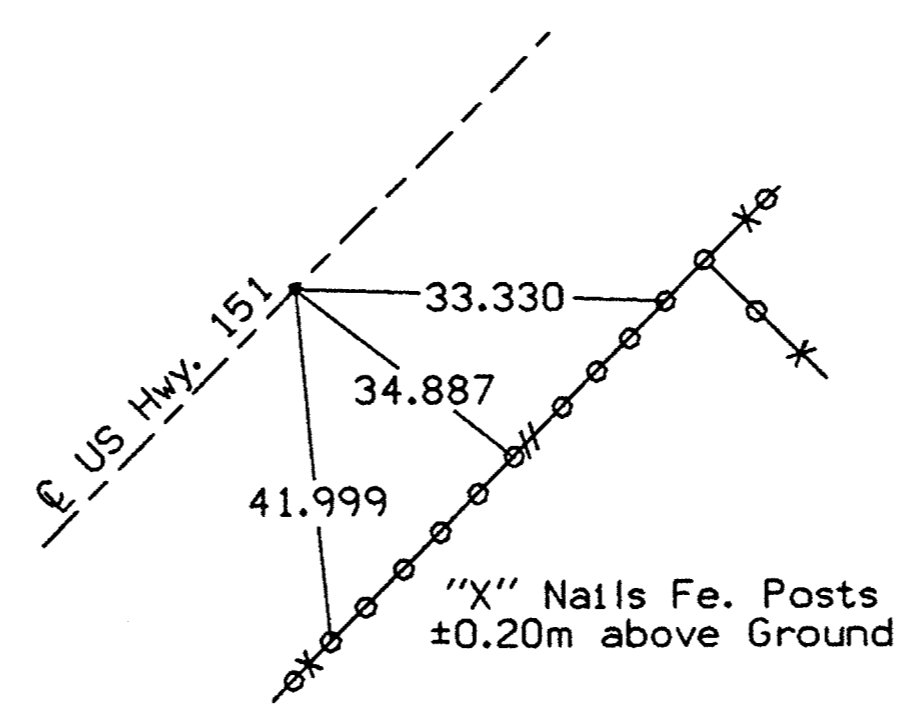


T.S. STA. 138+42.753
Set Iron Pin

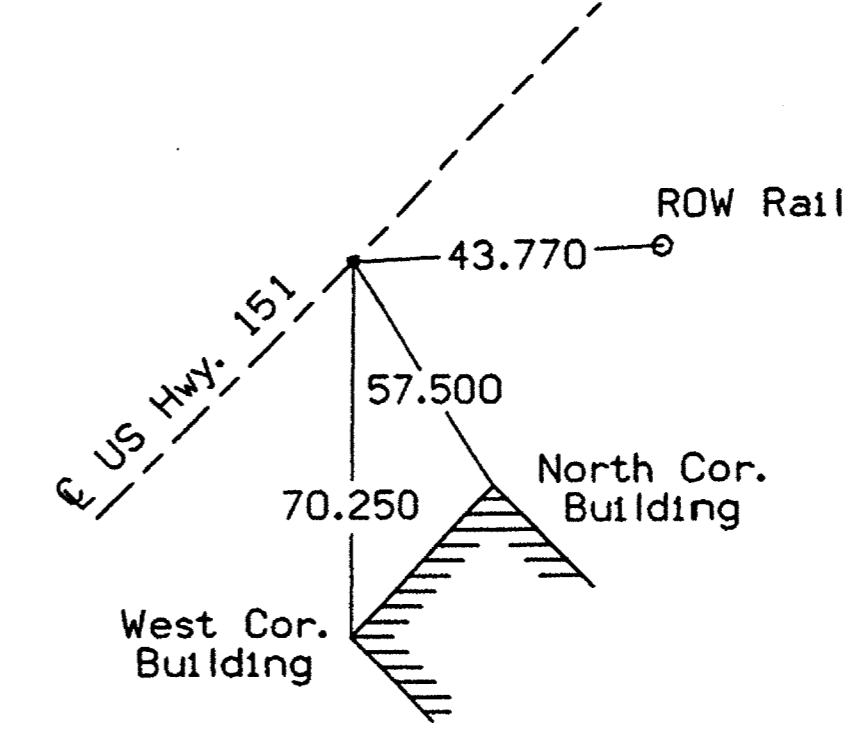


S.C. STA. 139+03.729
Set Iron Pin

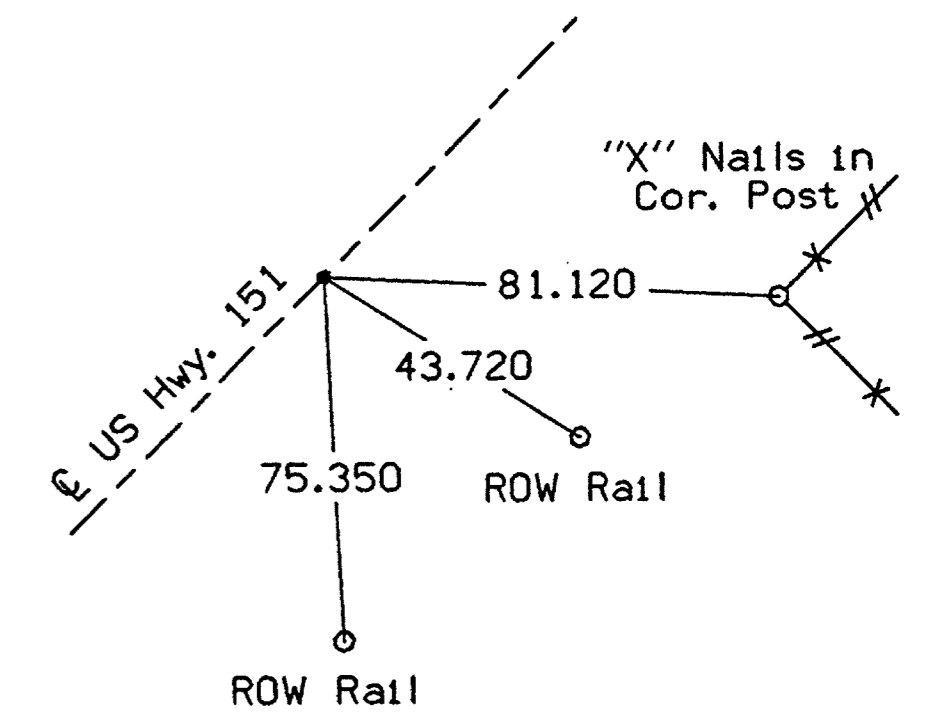


P.I. STA. 140+58.887
Set Iron Pin

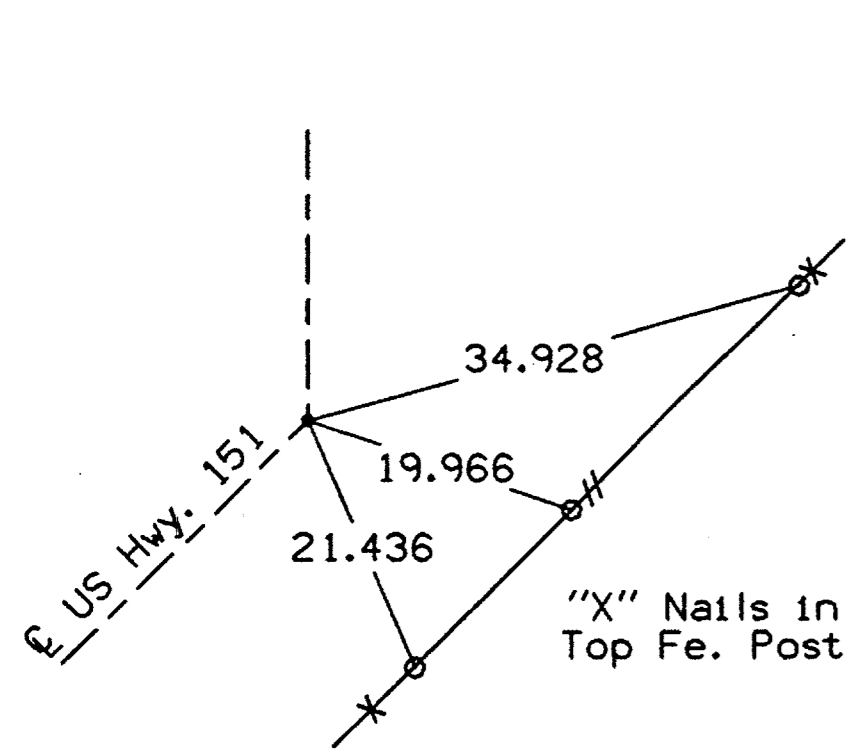


C.S. STA. 142+05.812
Set Iron Pin

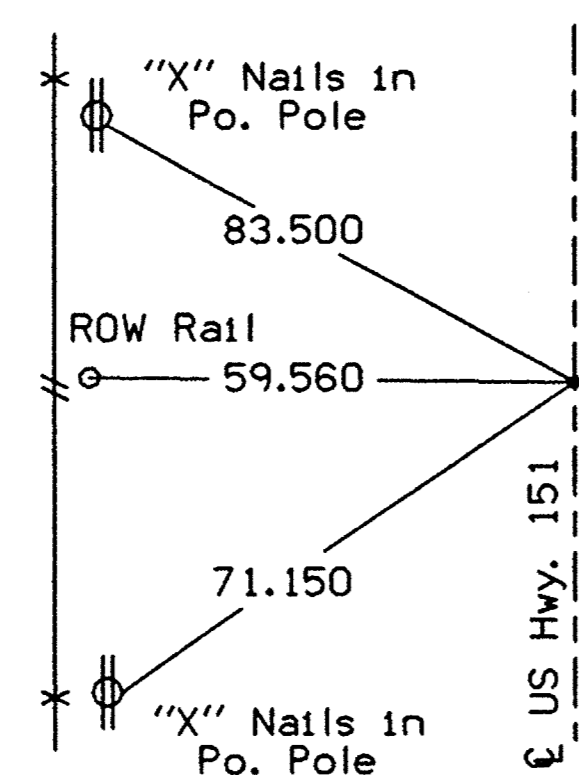


S.T. STA. 142+66.788
Set Iron Pin

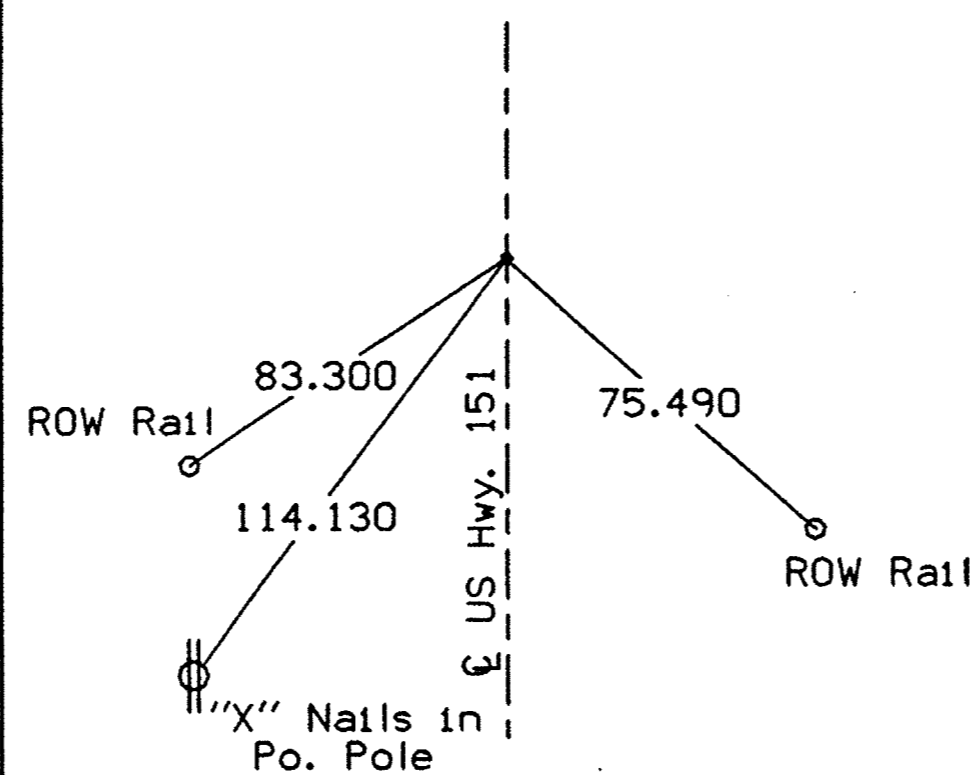


P.O.T. STA. 146+00.000
Set Iron Pin

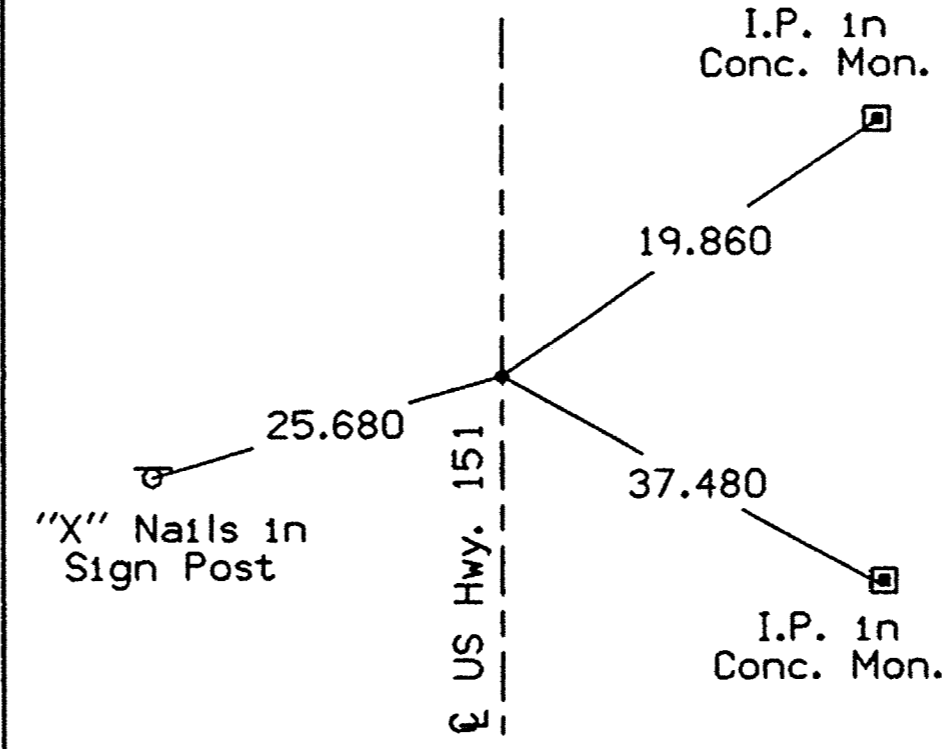


P.O.T. STA. 147+50.000
Set Iron Pin

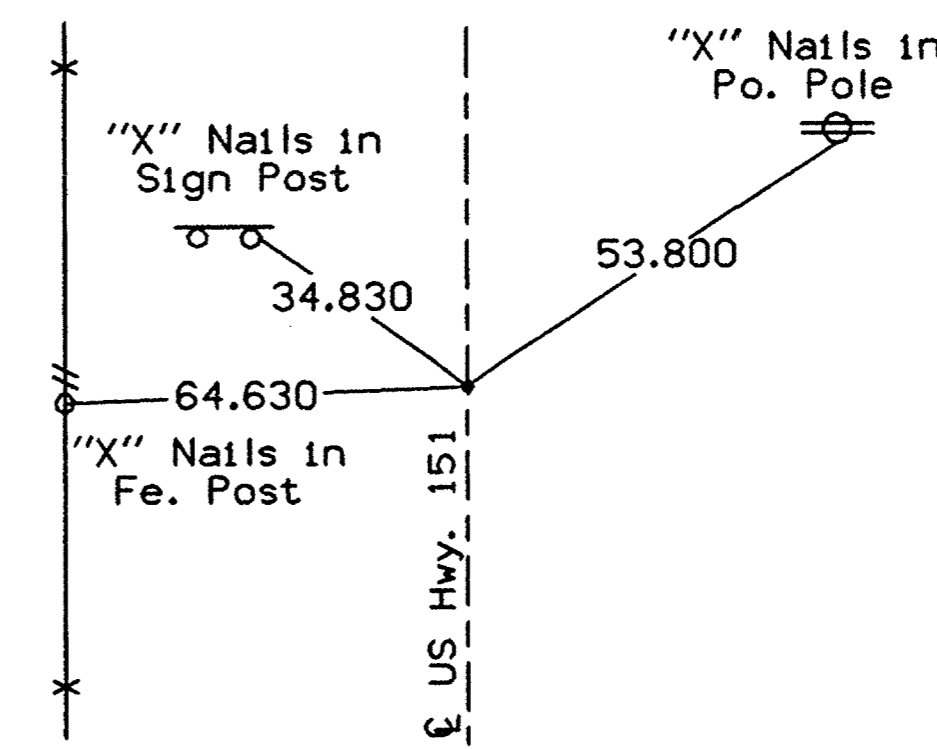


P.O.T. STA. 148+90.000
Set Iron Pin

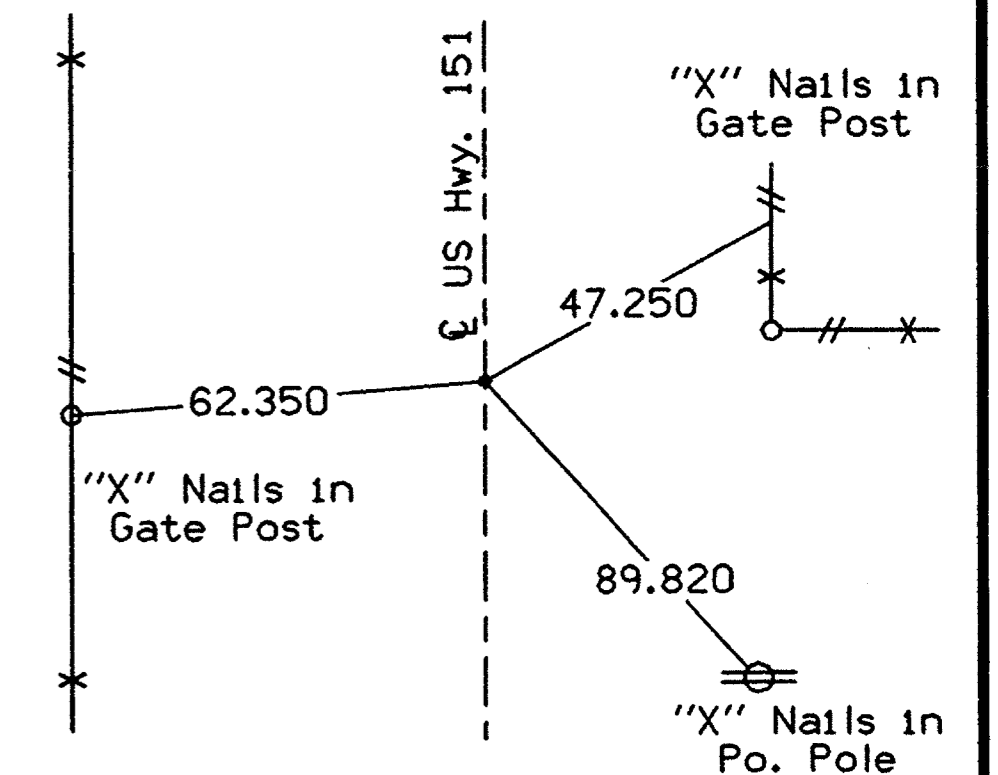


P.O.T. STA. 152+90.941
Set Iron Pin

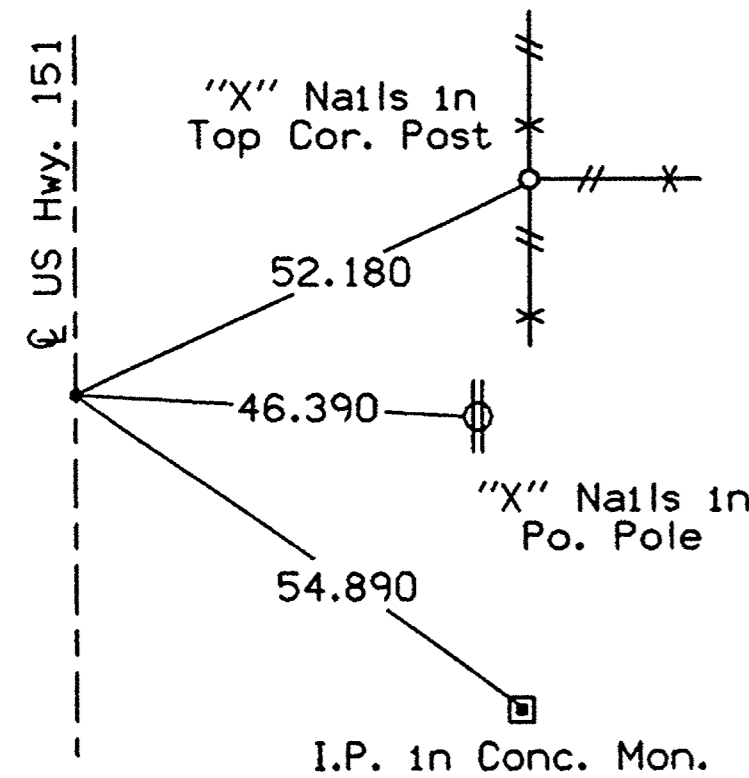


P.O.T. STA. 156+00.000
Set Iron Pin

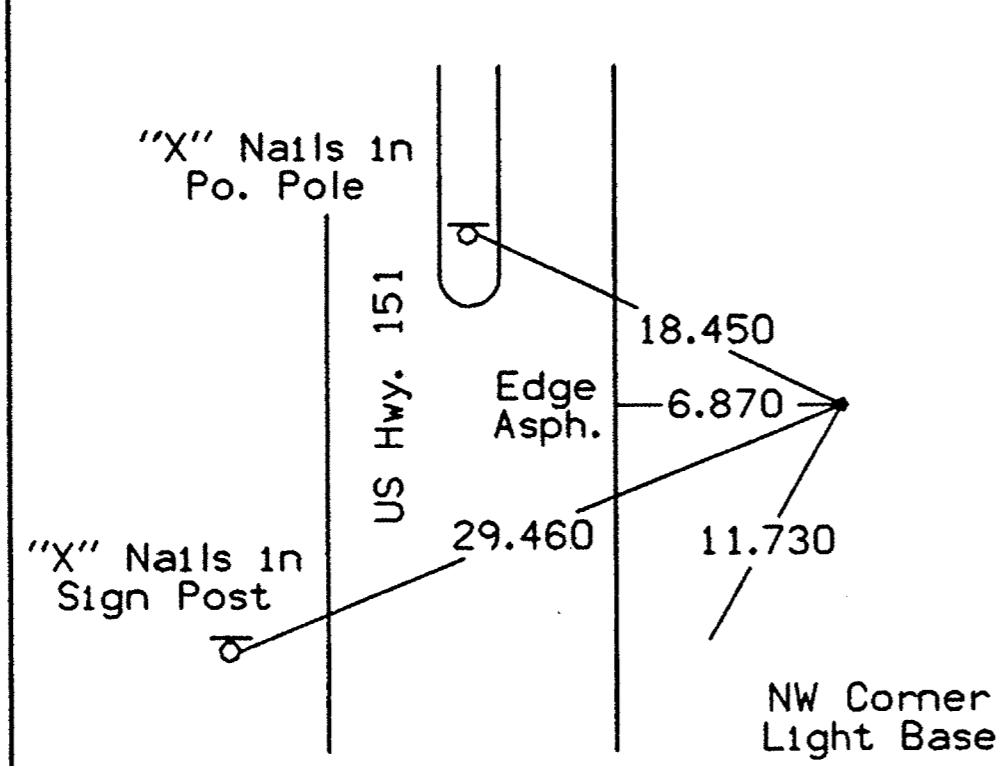


P.I. STA. 157+91.026
Set P.K. Nail

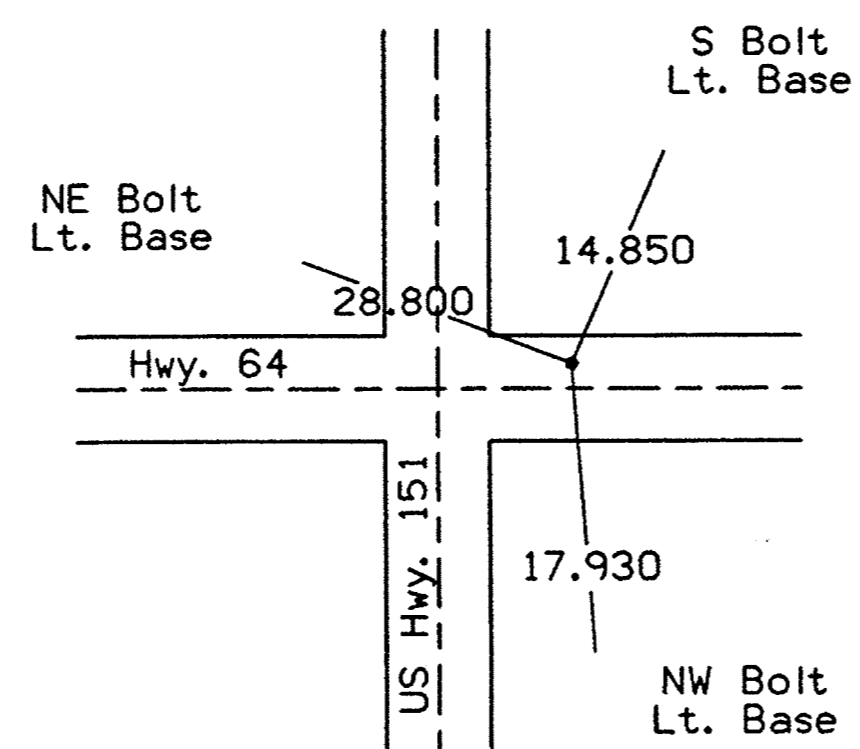


P.O.T. STA. 161+00.000
Set Iron Pin

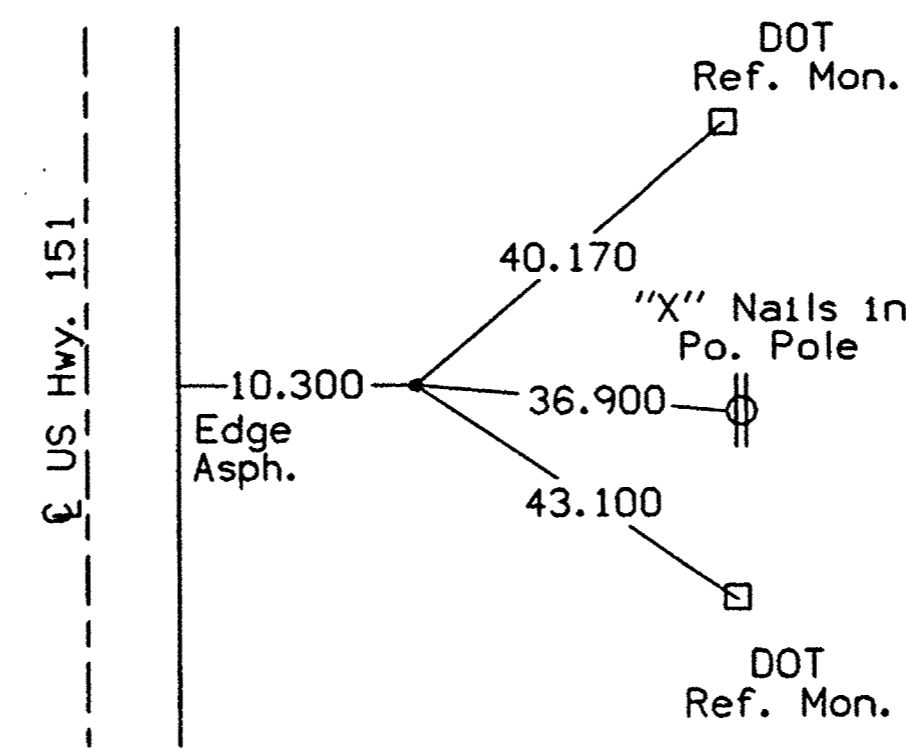

P.O.T. STA. 164+50.000
Set Iron Pin

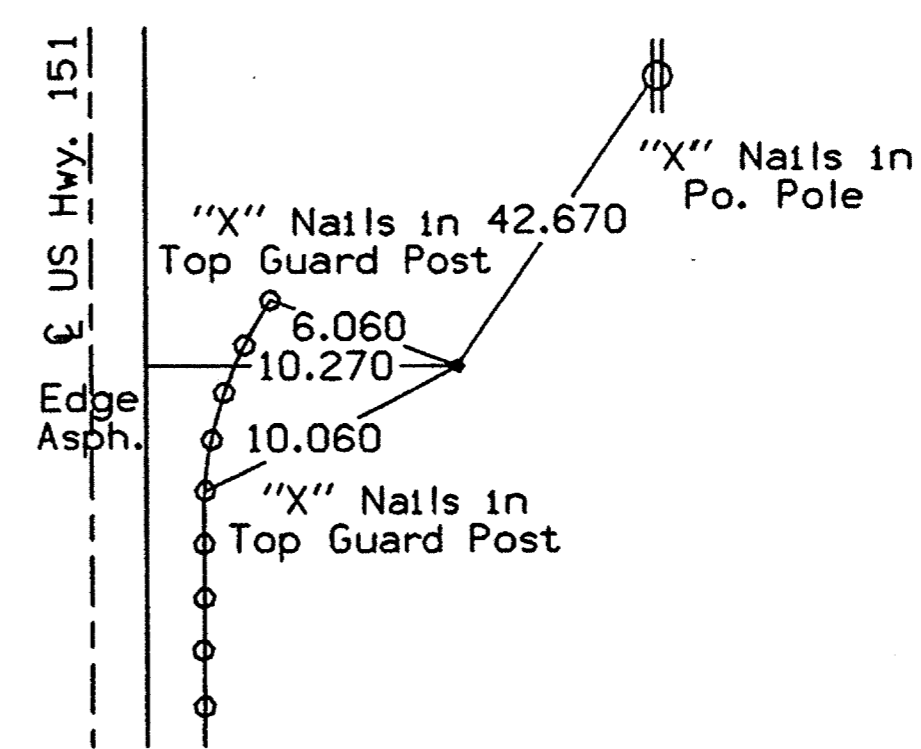

P.O.T. STA. 168+00.000
Set Iron Pin

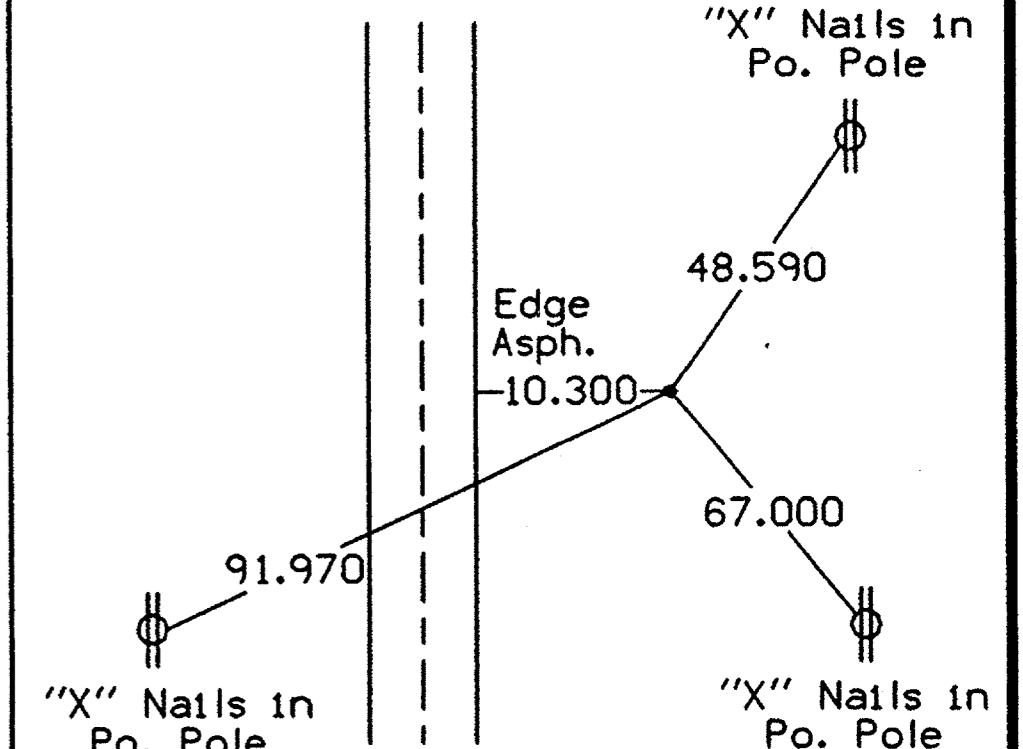

NOTES:
1) All distances measured horizontally.
2) All distances are in meters.


DETAILS OF REFERENCE INFORMATION

All References Plumb Distances
(unless otherwise noted)

P:\WATSON\DATA\PILOT\PL1463P\G05.PRF
 Date: Wed Oct 27 13:50:16 1999


P.O.T. STA. 172+00.000

Set Iron Pin

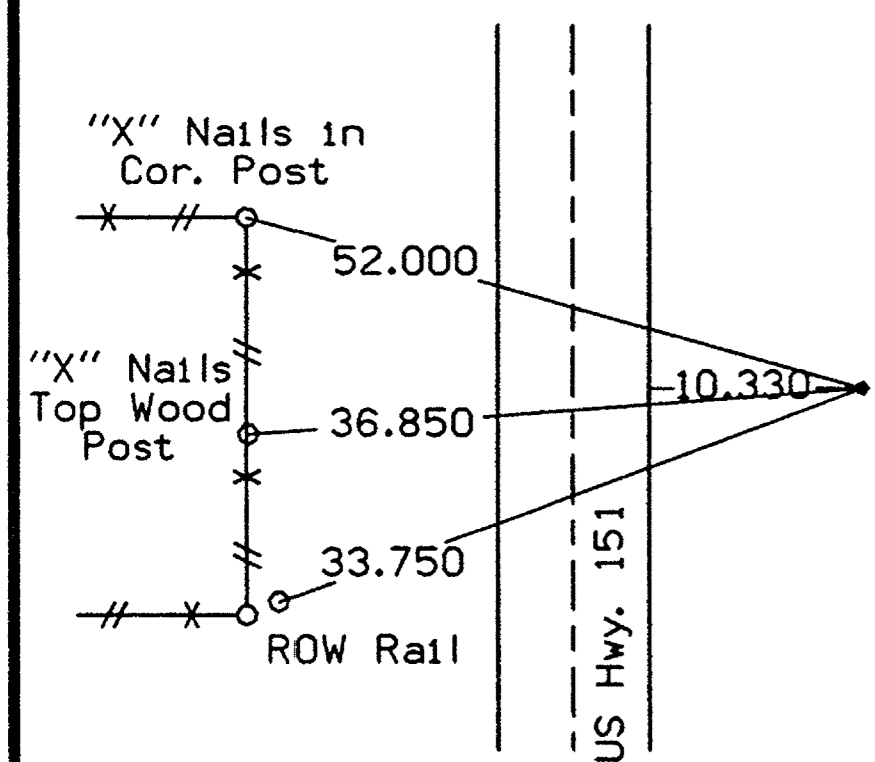


T.S. STA. 173+54.158

Set Iron Pin

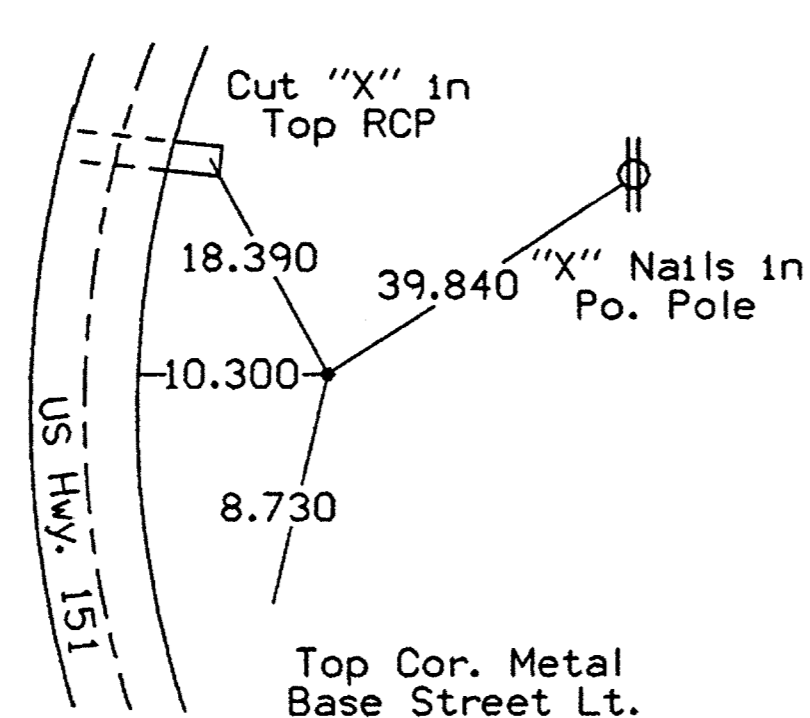


S.C. STA. 174+15.134

Set Iron Pin

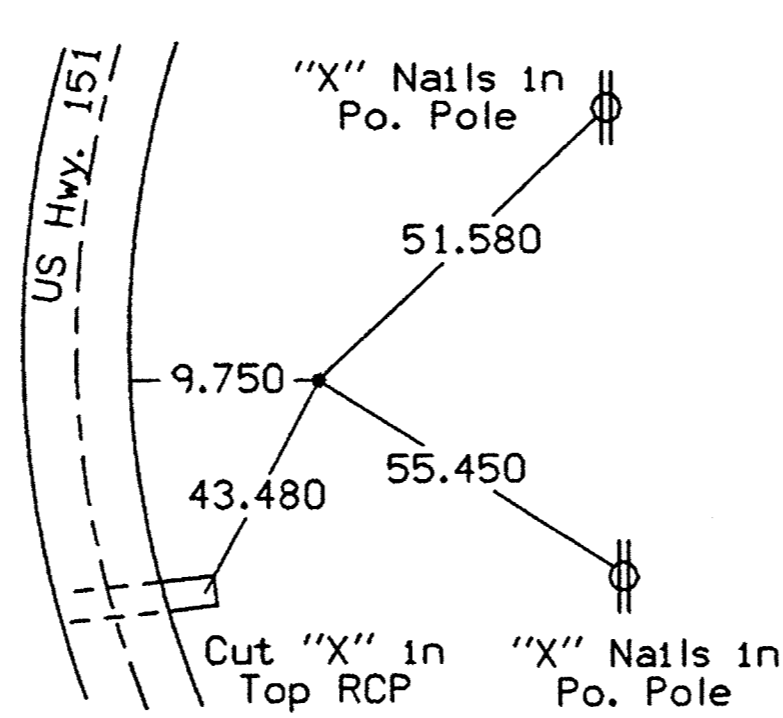


P.I. STA. 174+94.397

Set P.K. Nail

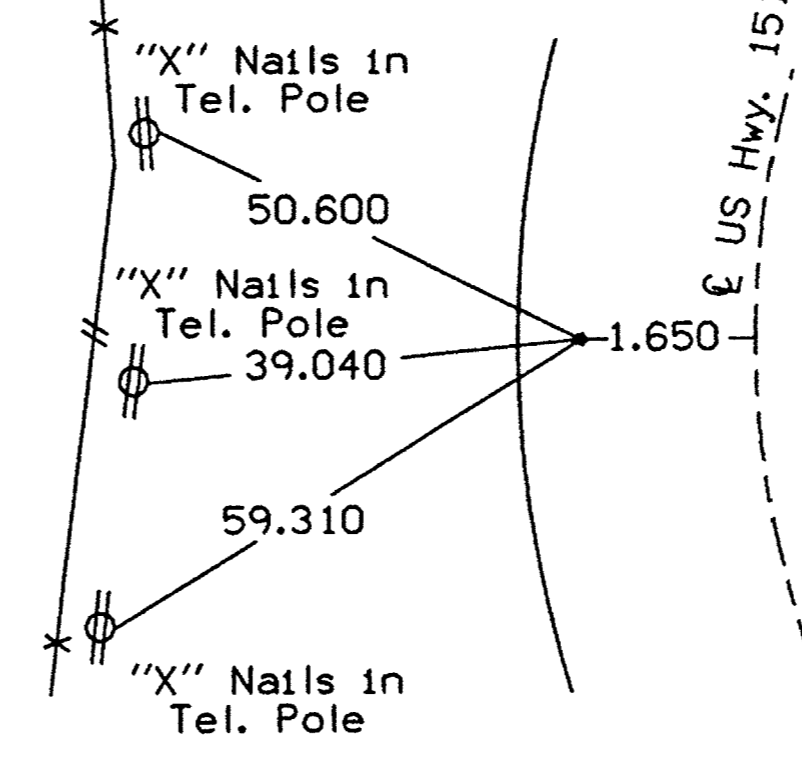


C.S. STA. 175+67.485

Set Iron Pin

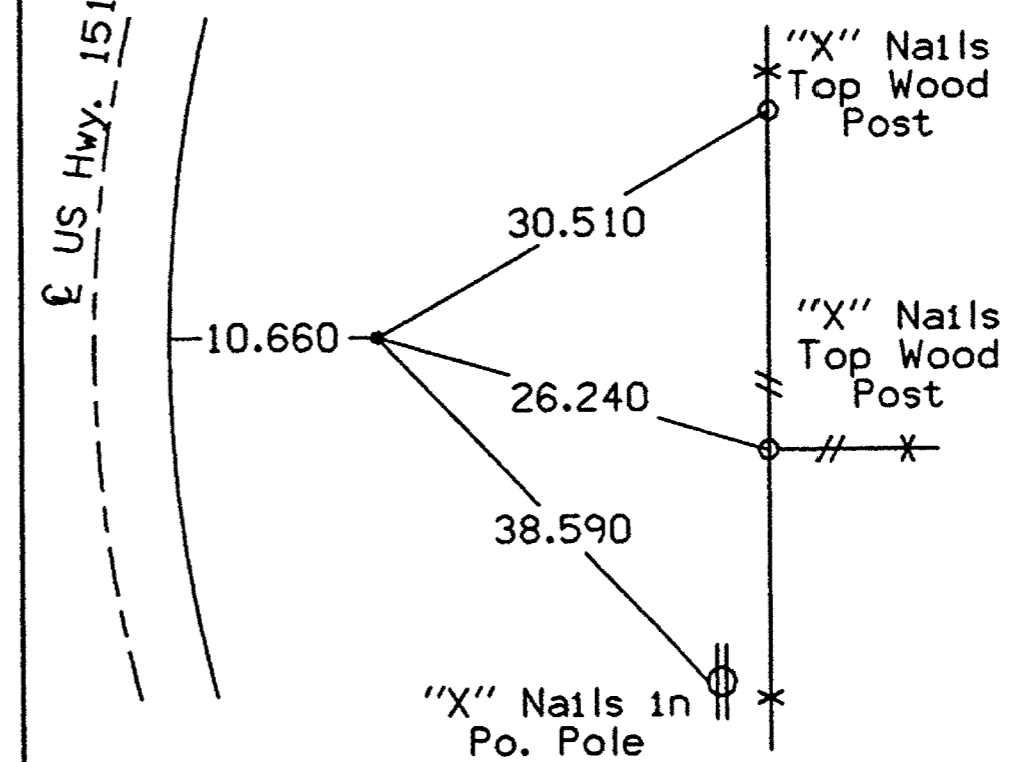


S.T. STA. 176+28.461

Set Iron Pin

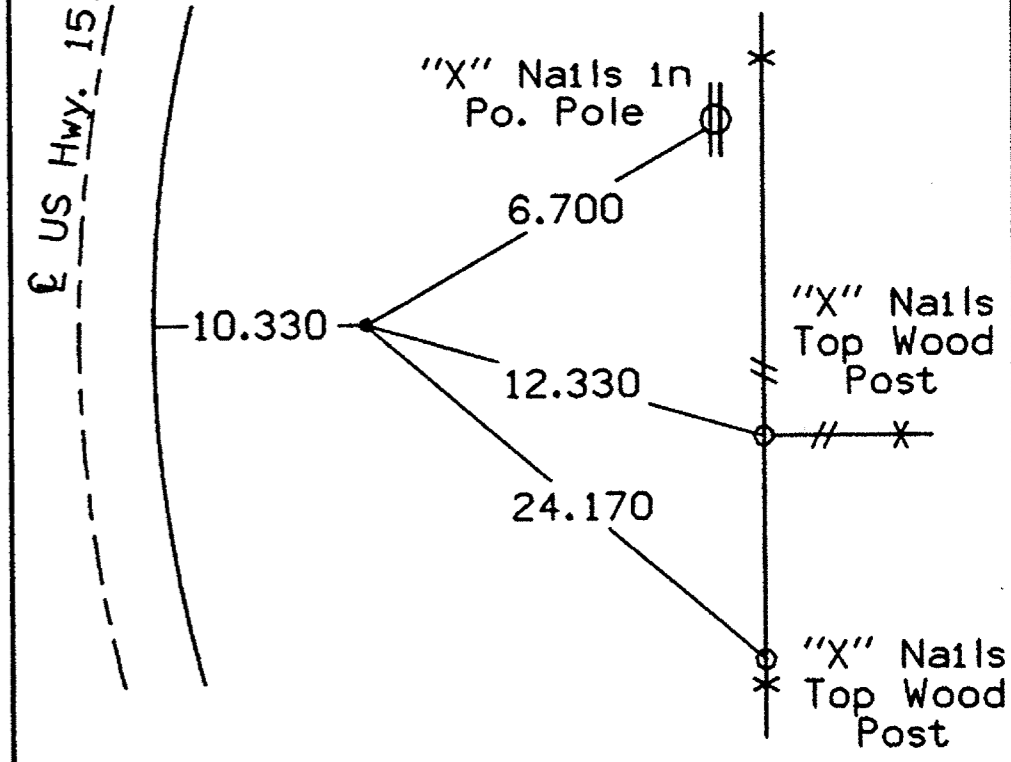


P.I. STA. 179+17.754

Set Iron Pin

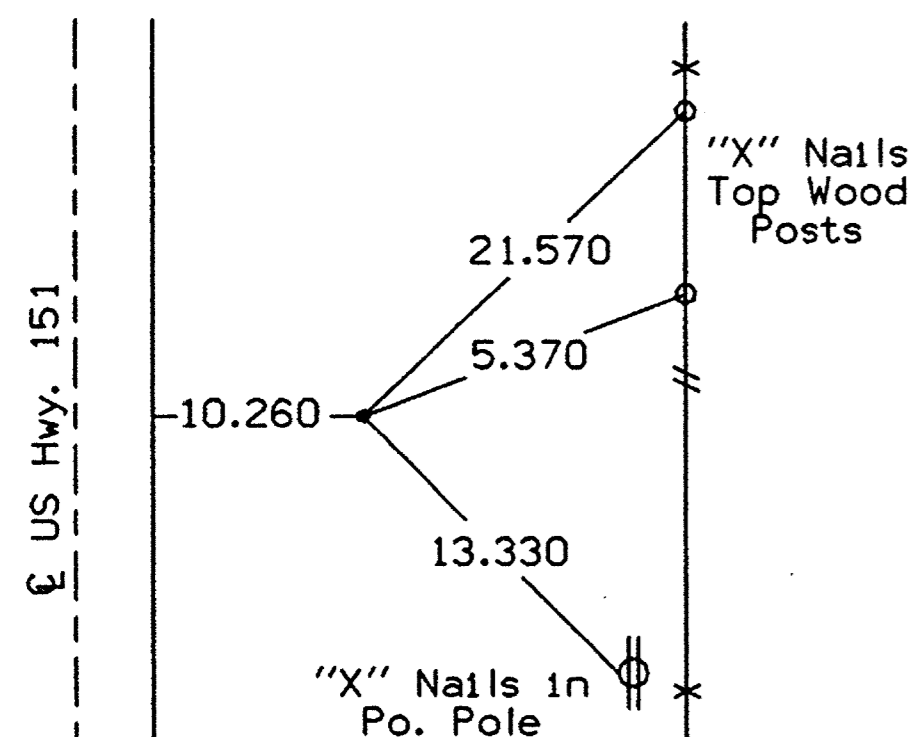


P.O.T. STA. 182+00.000

Set Iron Pin

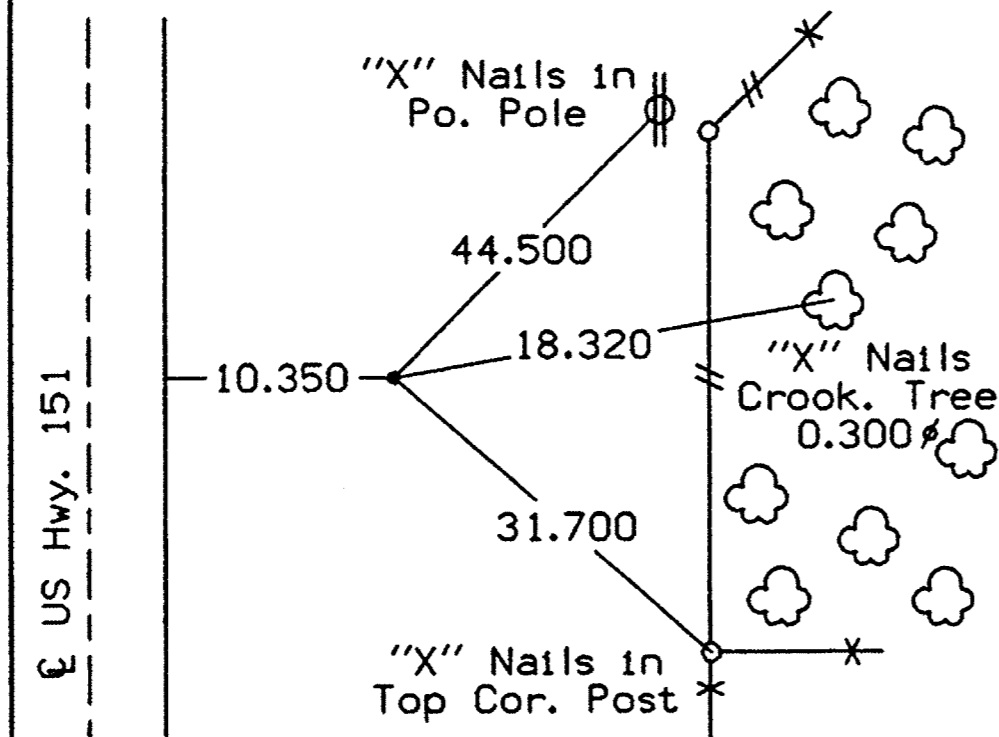

P.O.T. STA. 185+00.000


Set Iron Pin

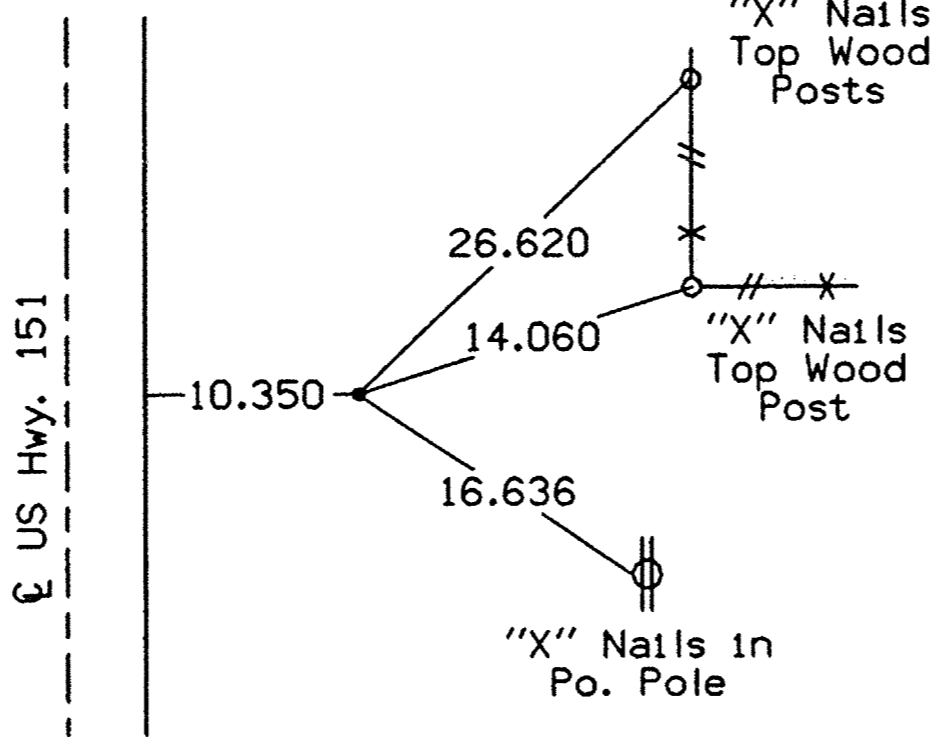

P.O.T. STA. 187+45.132

Set Iron Pin

STATION EQUATION:
 POT Sta. 187+45.132(Back)
 (Project # NHS-151-4(63)-19-53)
 POT Sta. 187+41.079(Ahead)
 (Project # NHS-151-4(63)-2R-53)

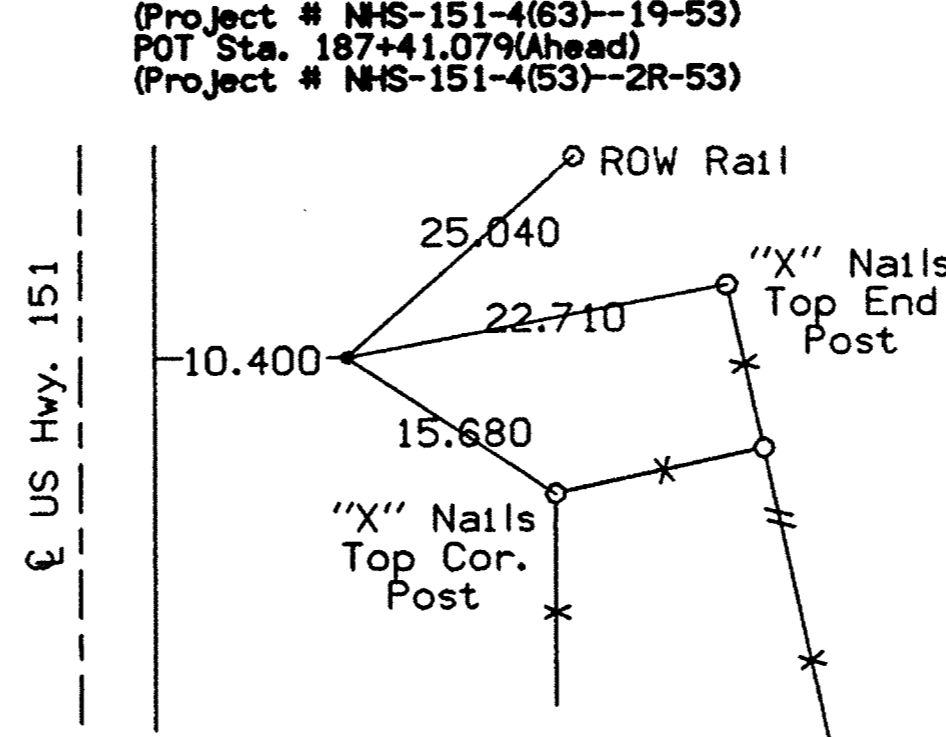


- NOTES:
 1) All distances measured horizontally.
 2) All distances are in meters.

DETAILS OF REFERENCE INFORMATION

All References Plumb Distances (unless otherwise noted)

prf = \\WATSON1\DATA\PL07\PL463P\G06.PRF
date = Wed Oct 27 13:40:22 1999

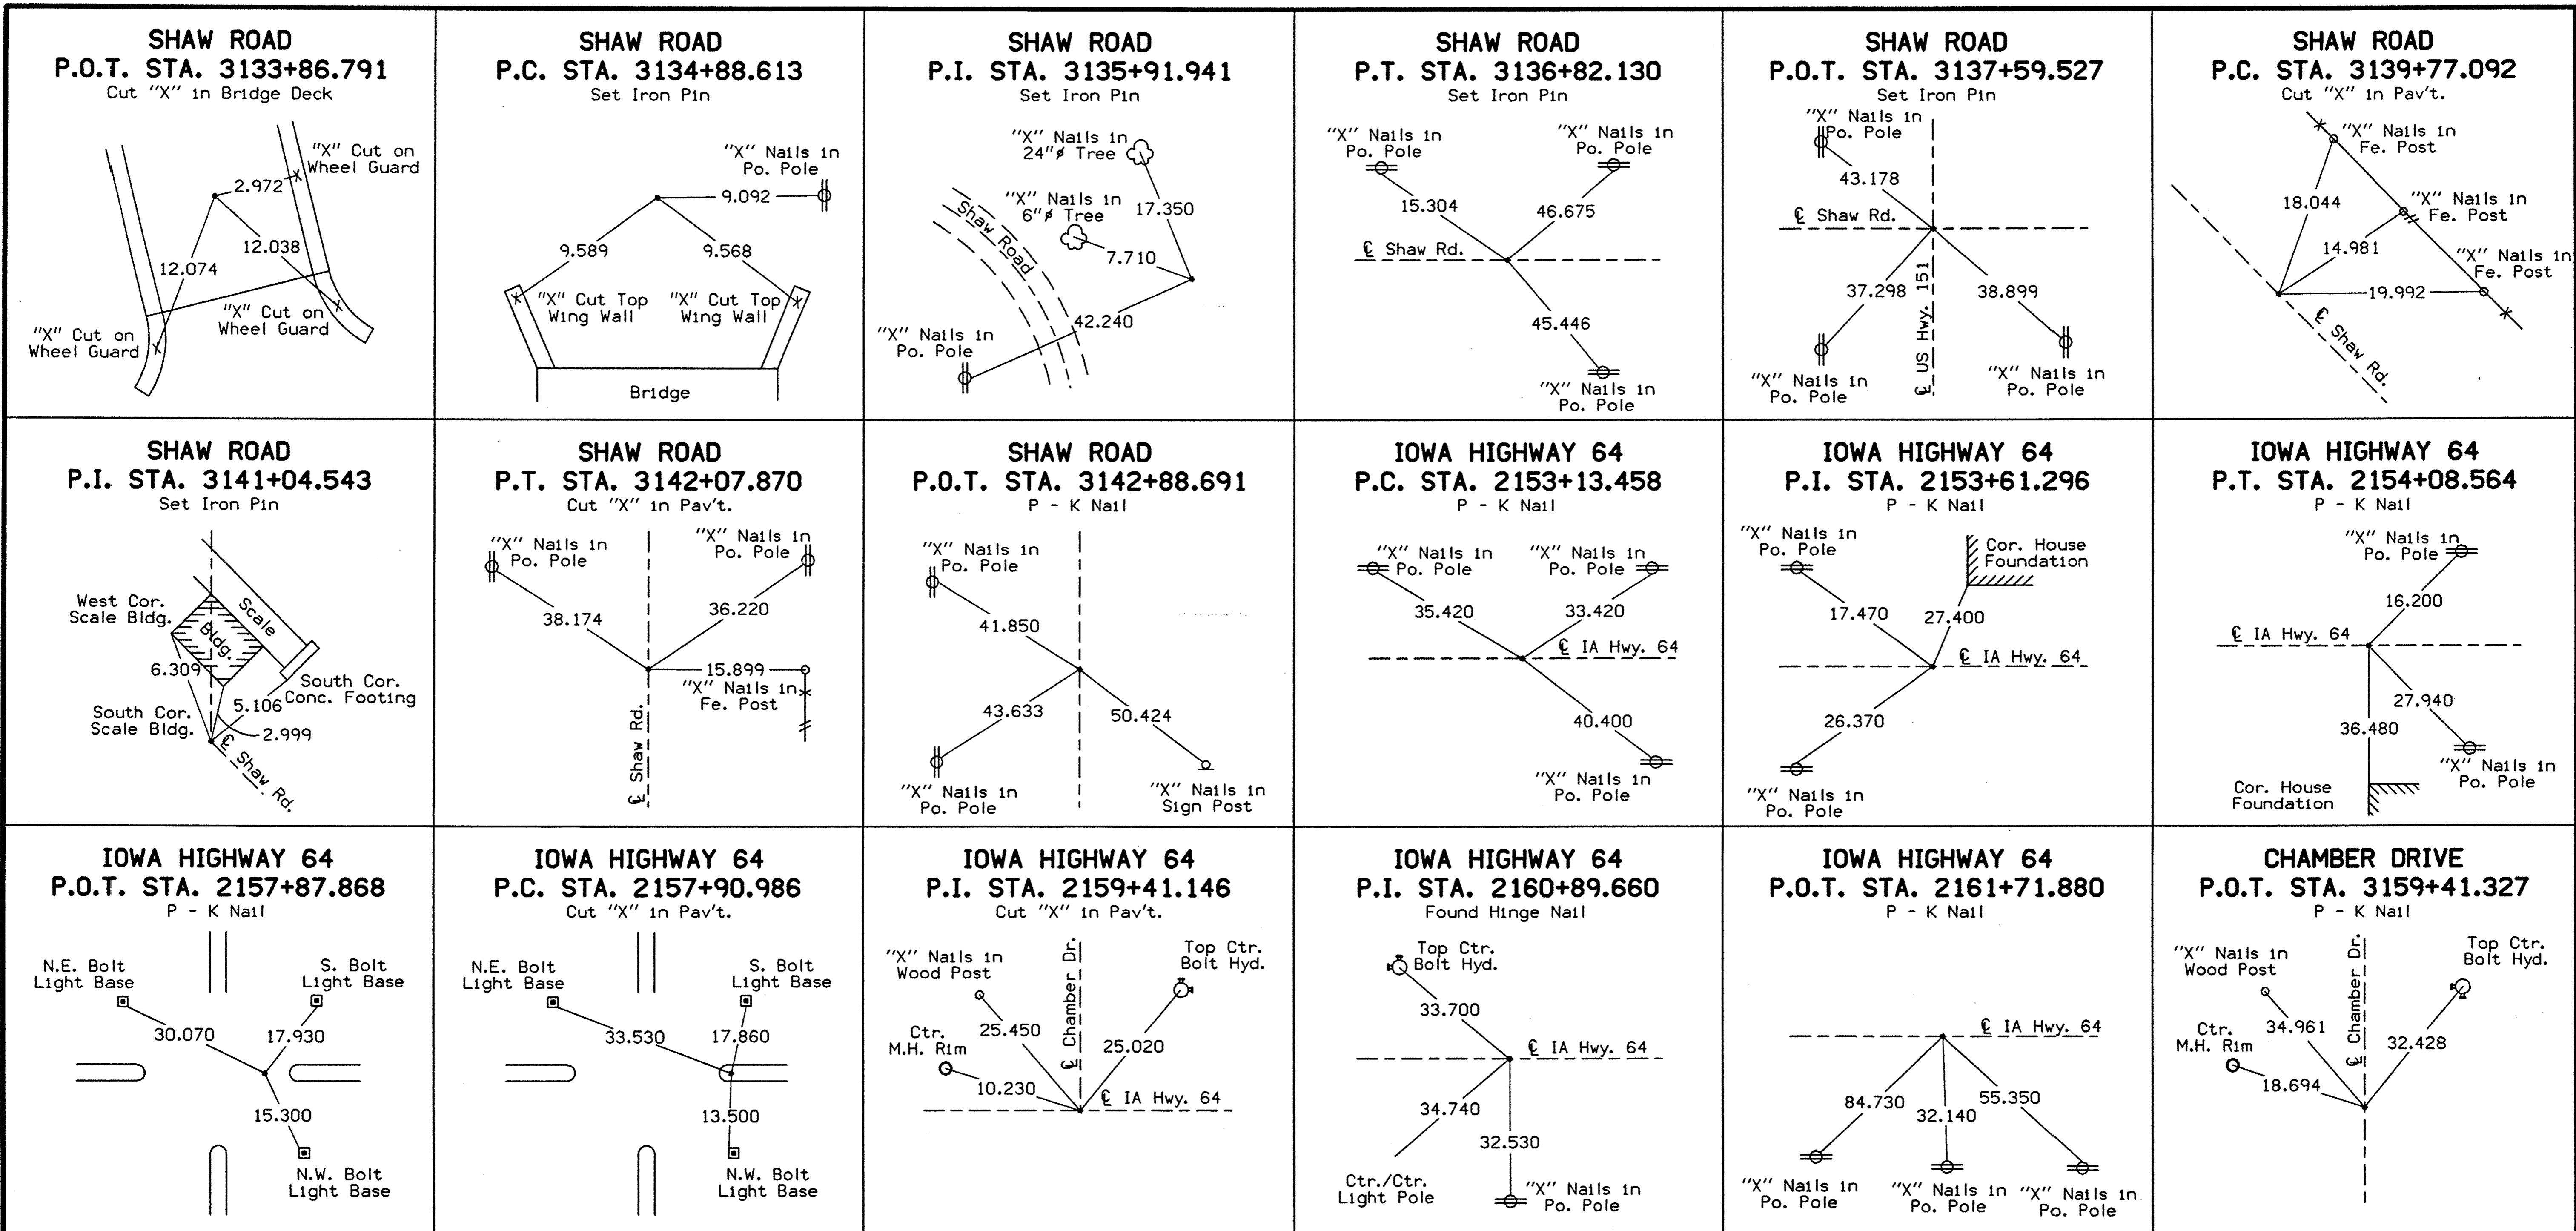


NOTES:
 1) All distances measured horizontally.
 2) All distances are in meters.


DETAILS OF REFERENCE INFORMATION
 All References Plumb Distances
 (unless otherwise noted)

prf = \\WATSON\DATA\PL01463P\G07.PRF
 date = Wed Oct 27 13:30:30 1999


DUBUQUE ROAD
P.O.T. STA. 1169+13.871
 P - K Nail

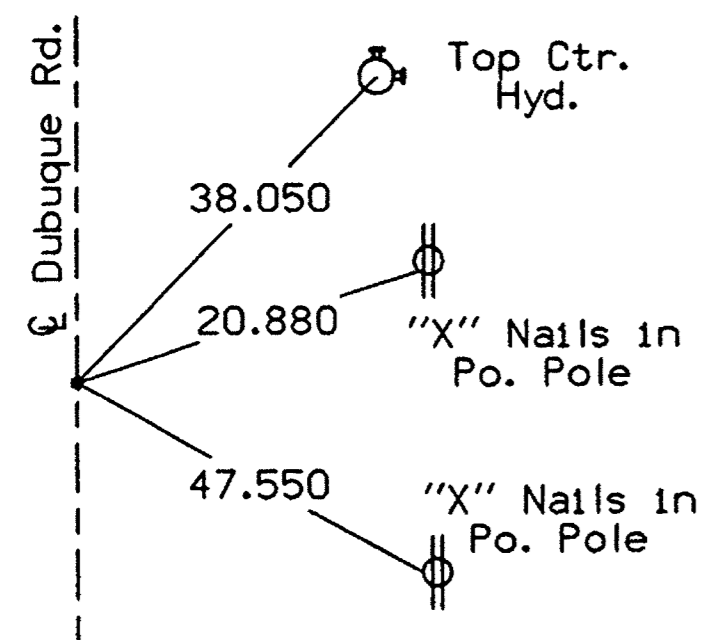


DUBUQUE ROAD
P.I. STA. 1169+44.241
 P - K Nail

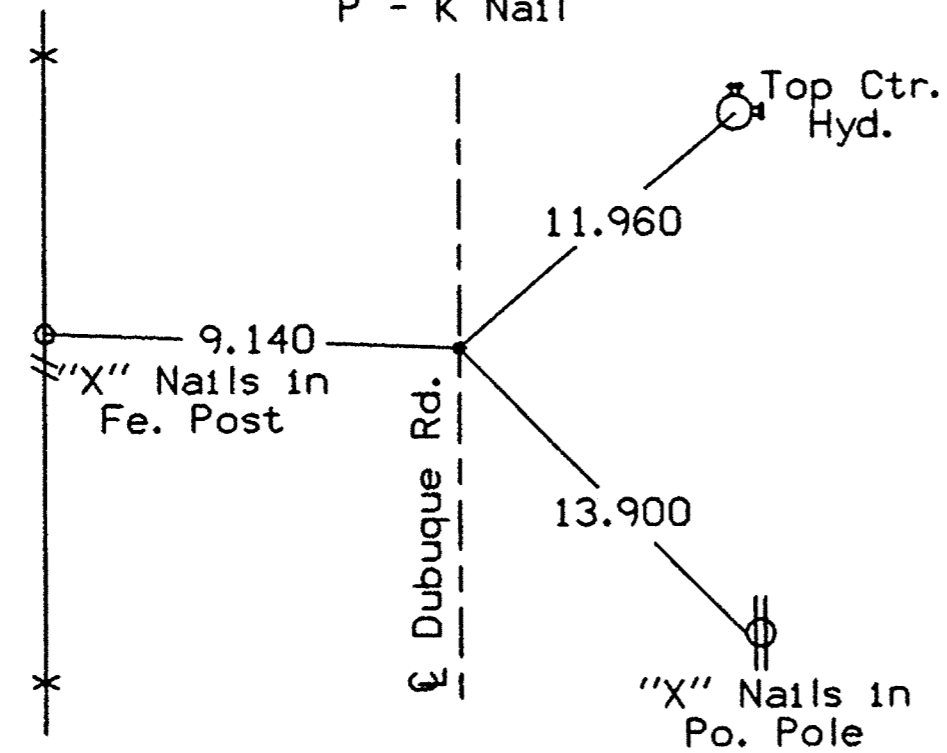

DUBUQUE ROAD
P.C. STA. 1171+09.623
 P - K Nail

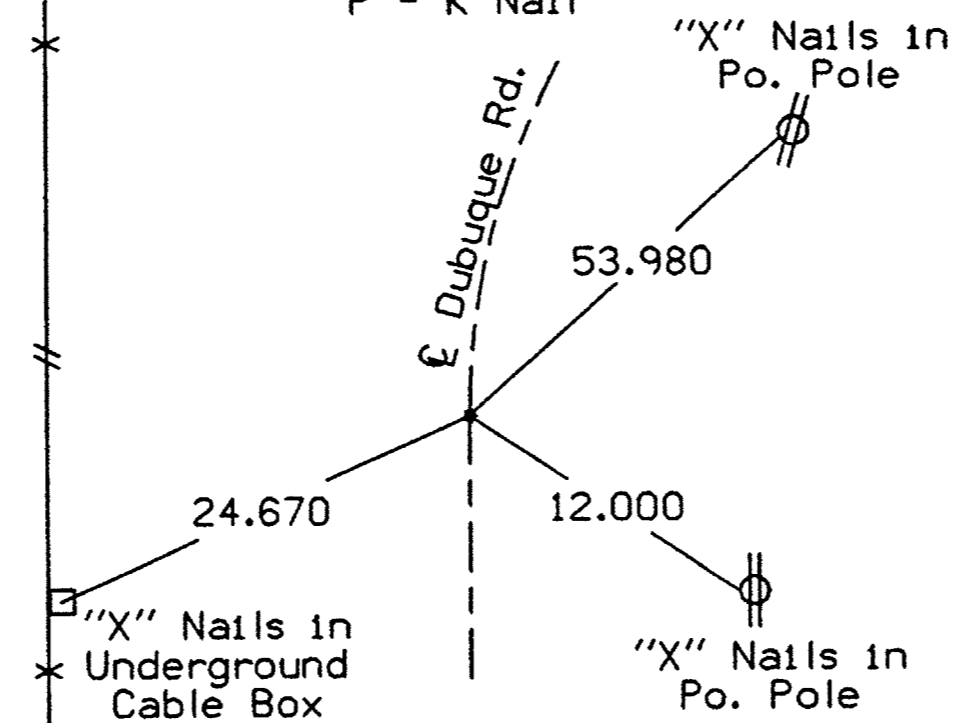

DUBUQUE ROAD
P.I. STA. 1171+84.361
 Set Iron Pin

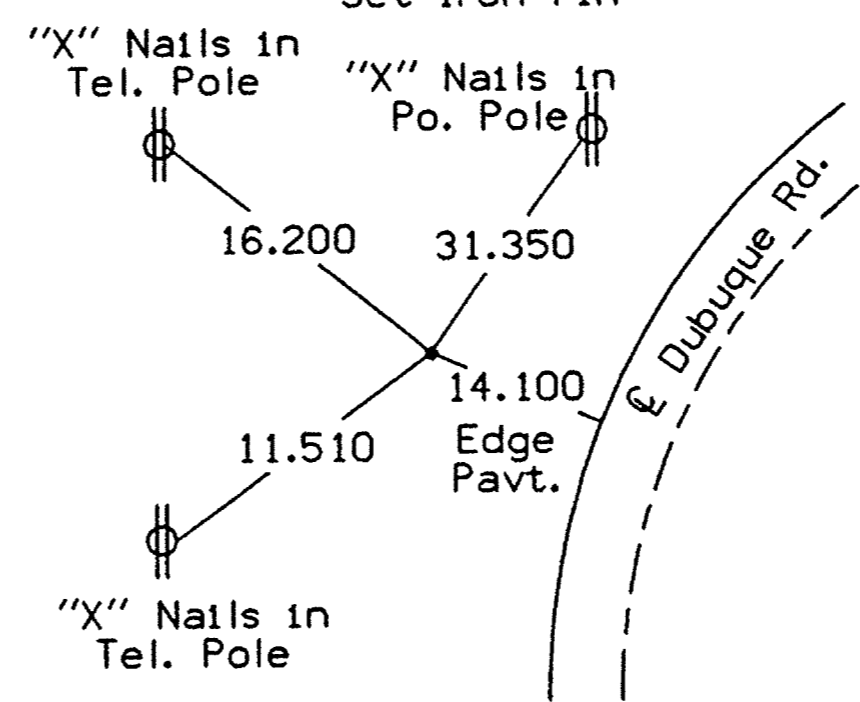


BENCH MARKS

UPDATED BENCH MARKS TO BE COMPLETED


ON PAVING PROJECT:

NHSX-151-3(112)--3H-57


DUBUQUE ROAD
P.T. STA. 1172+47.980
 P - K Nail

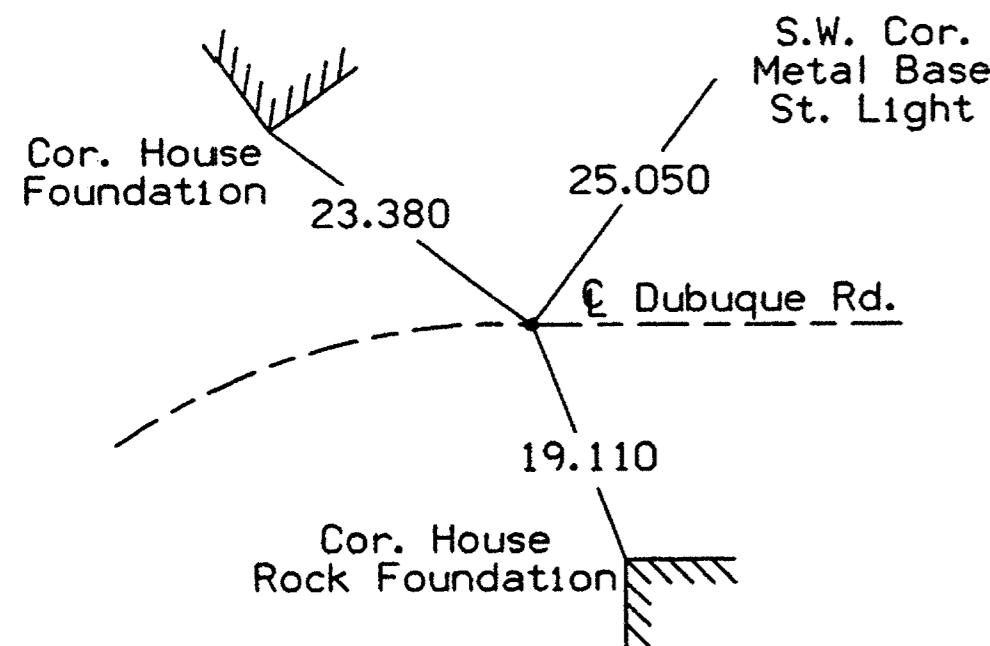


130TH STREET
P.O.T. STA. 1173+16.797
 P - K Nail

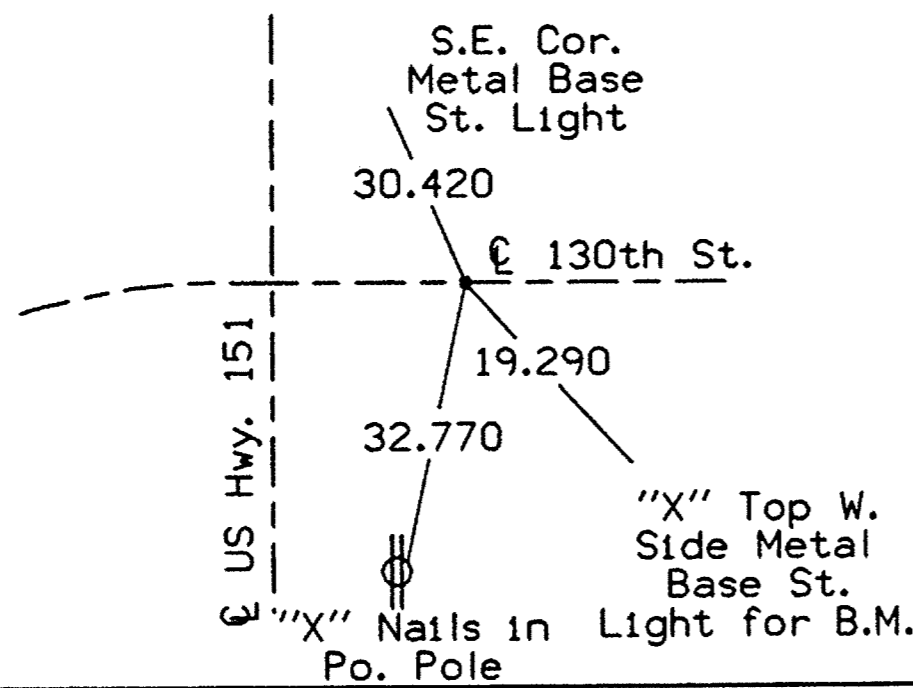

130TH STREET
P.O.T. STA. 1175+87.443
 Set Iron Pin

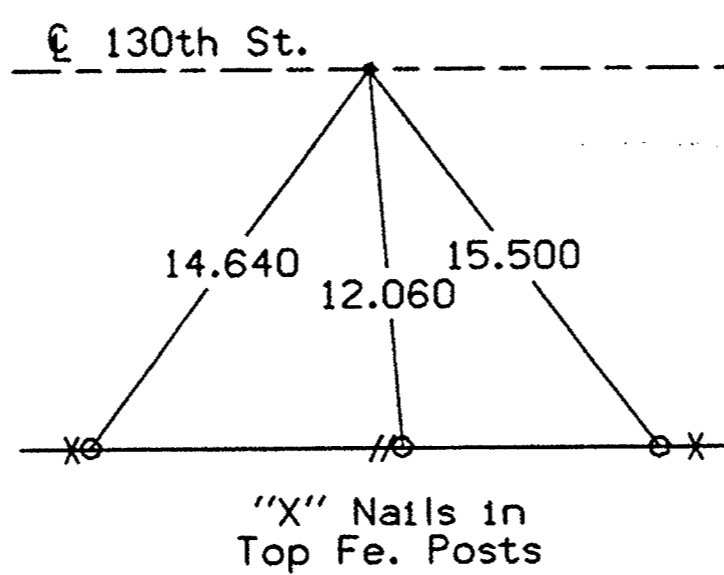


130TH STREET
P.O.T. STA. 1177+02.793
 Set Iron Pin

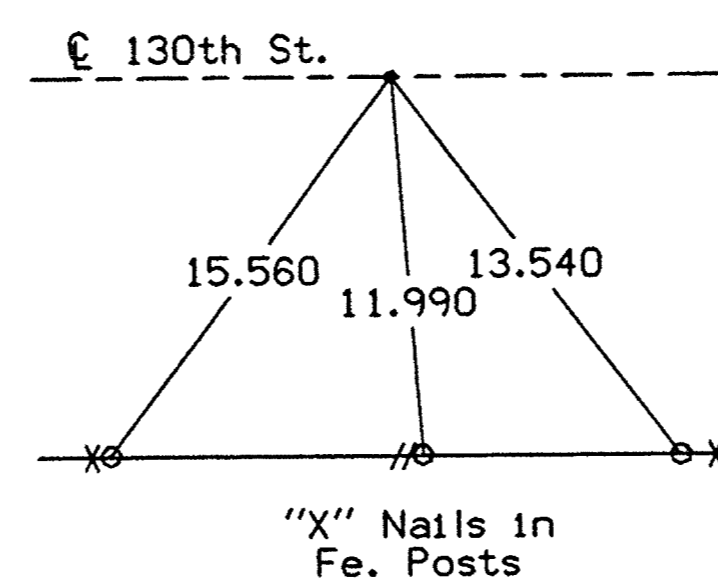


GPS MONUMENT COORDINATES

NO.	LOCAL GRID		IOWA STATE PLANE NORTH ZONE	
	NORTH	EAST	NORTH	EAST
1	5000.000	5000.000	1064348.917	1672668.700
2	5120.571	5414.125	1064479.668	1673079.696
3	5686.810	7137.883	1065088.208	1674788.847
4	6037.529	8807.147	1065480.022	1676450.839
5	6161.773	10638.188	1065649.336	1678276.076
6	6134.030	11856.064	1065651.647	1679494.243
7	6146.932	13764.858	1065711.629	1681402.010
8	6420.496	15521.974	1066023.501	1682951.800
9	7324.591	16712.260	1066961.555	1684319.267
10	8699.373	17050.618	1068344.172	1684623.588
11	10182.077	17093.558	1069827.347	1684629.938
12	11622.341	17138.428	1071269.220	1684639.238
13	12417.753	18349.161	1073092.878	1685805.310
14	15075.155	19495.783	1074777.901	1686910.571
15	16680.015	20421.306	1076404.995	1687796.162


CIRCLE DRIVE
P.O.T. STA. 1180+77.944
 Set Iron Pin

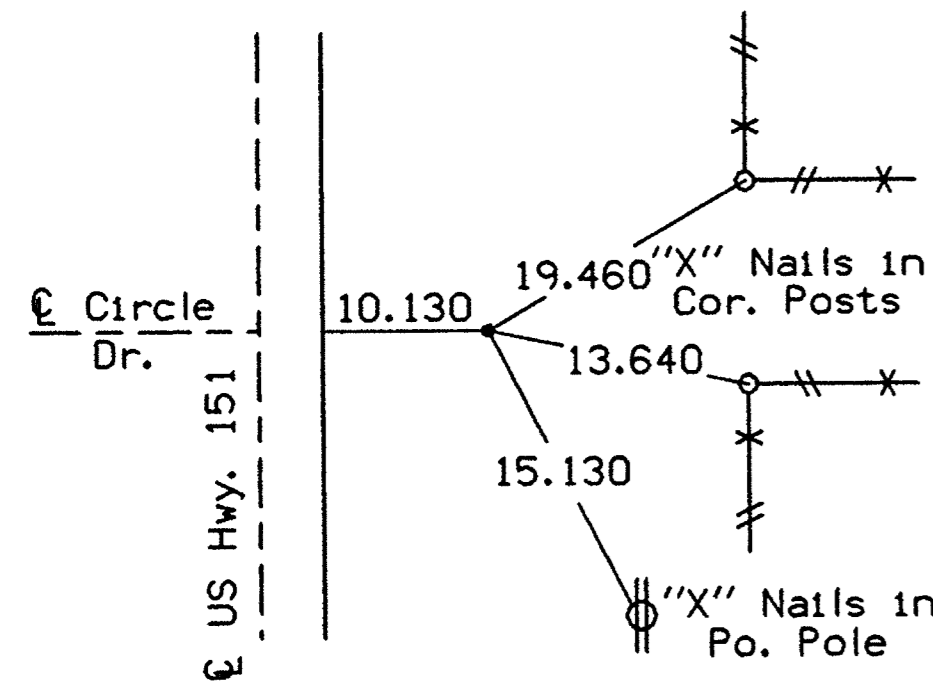


CIRCLE DRIVE
P.I. STA. 1181+31.734
 P - K Nail

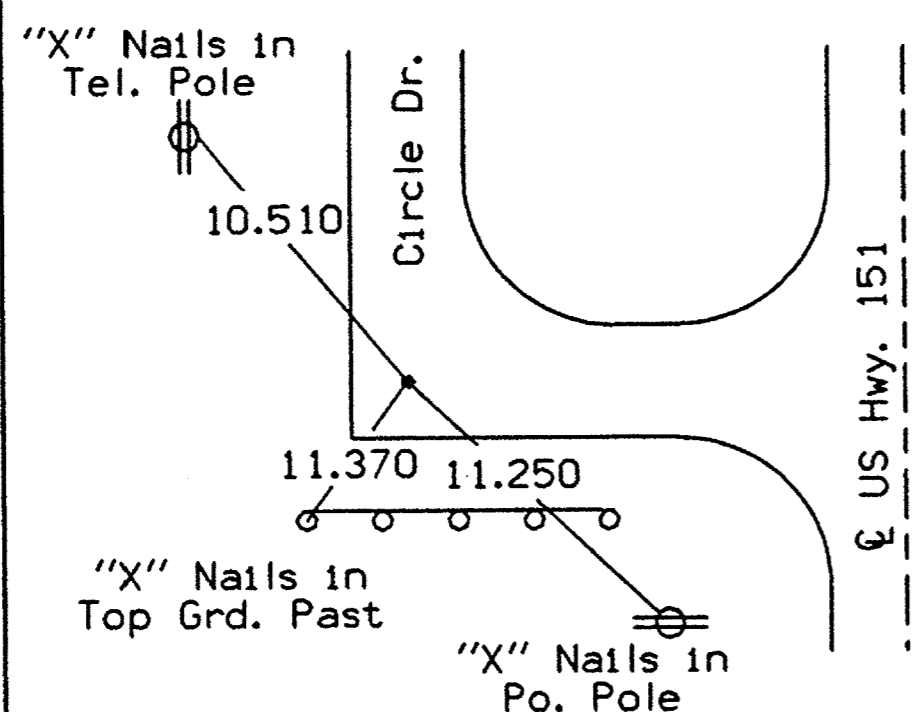

CIRCLE DRIVE
P.C. STA. 1182+64.437
 P - K Nail

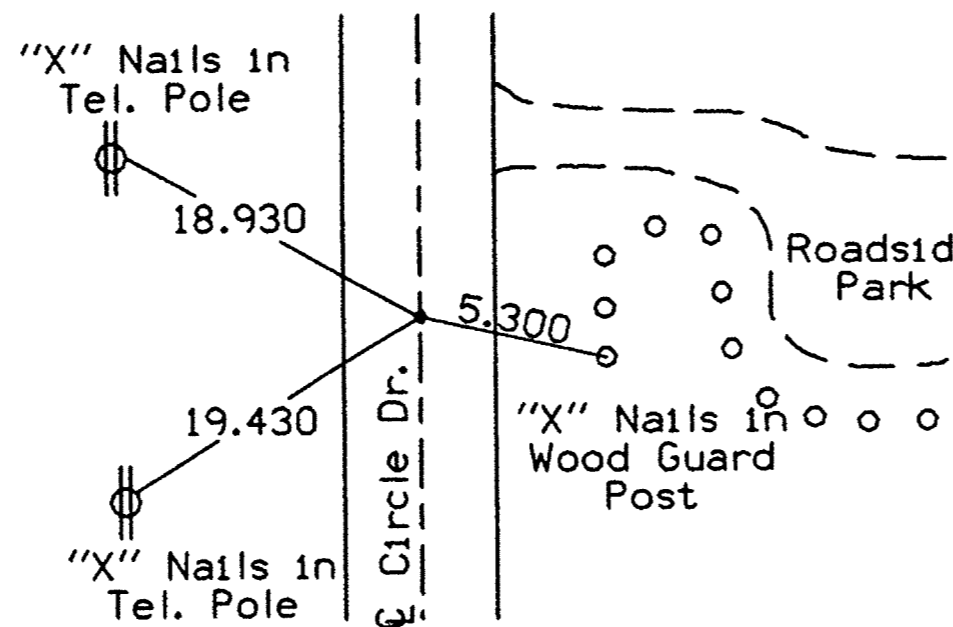


CIRCLE DRIVE
P.I. STA. 1183+21.814
 P - K Nail

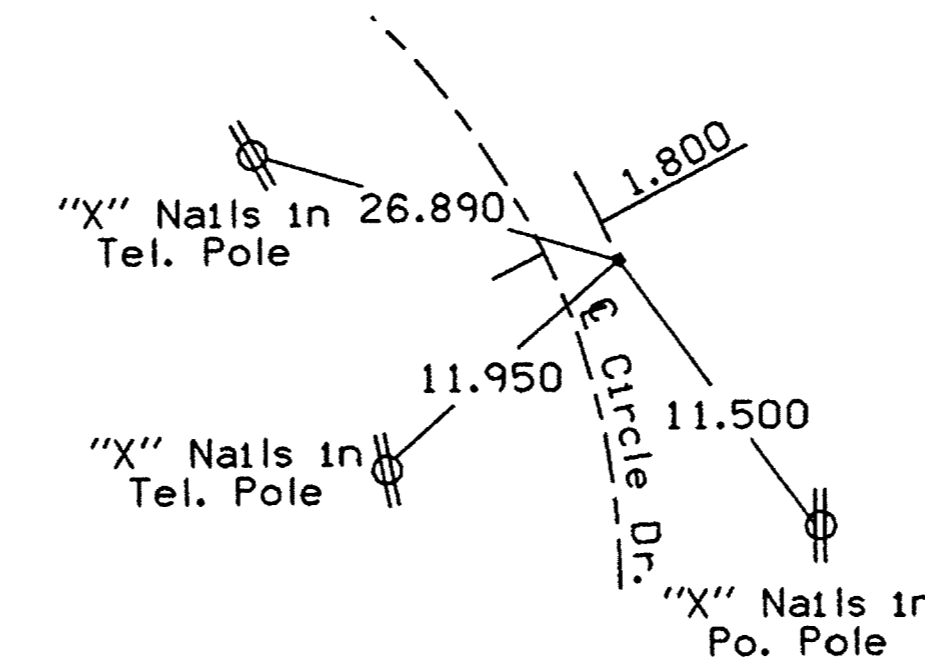


NOTES:
 1) All distances measured horizontally.
 2) All distances are in meters.


CIRCLE DRIVE
P.T. STA. 1183+79.040
 P - K Nail

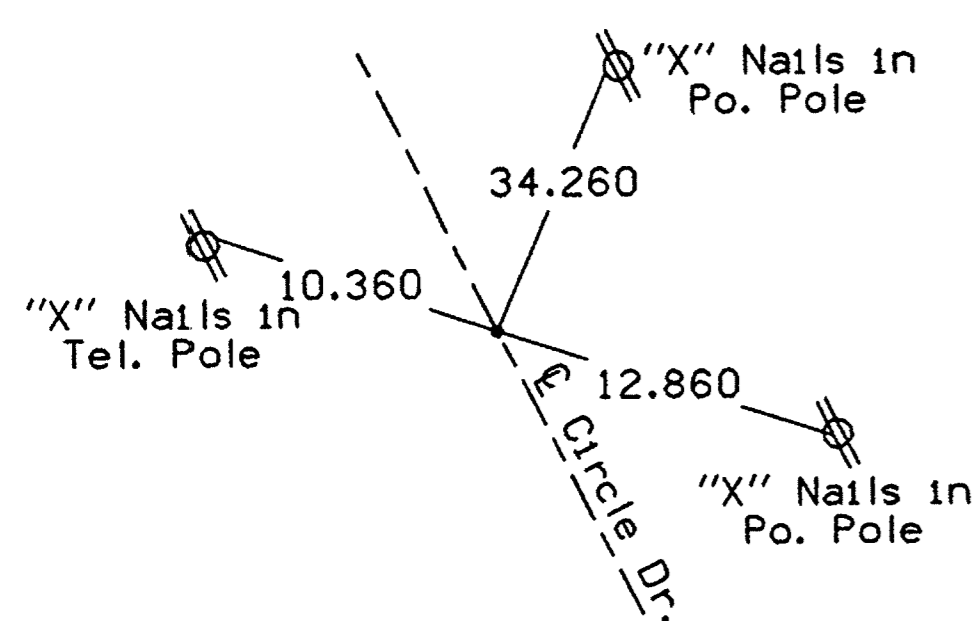


CIRCLE DRIVE
P.C. STA. 1184+71.734
 P - K Nail

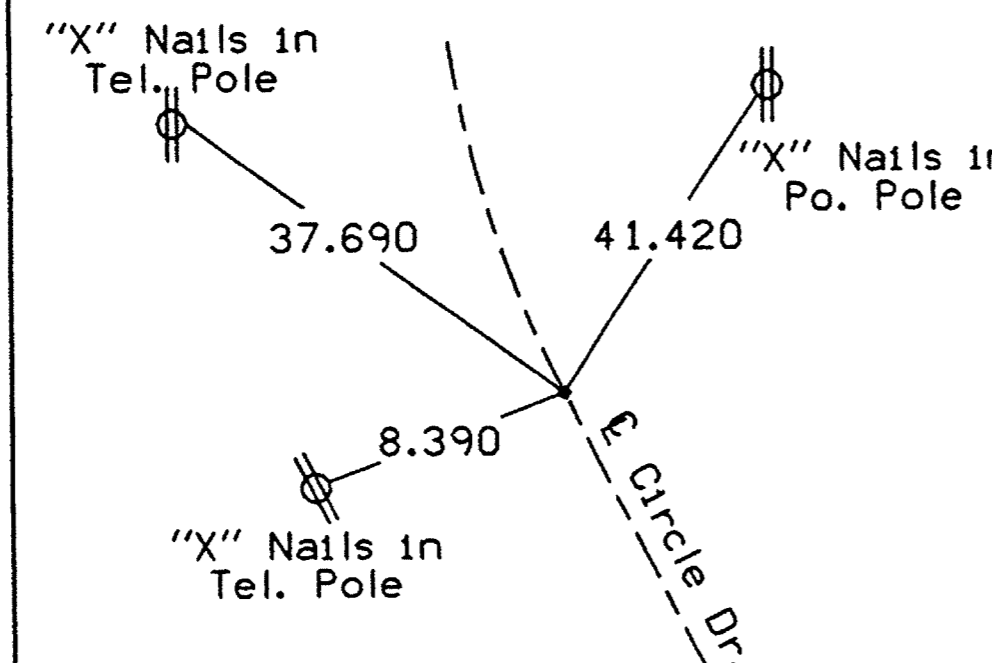

CIRCLE DRIVE
P.I. STA. 1185+59.093
 Set Iron Pin

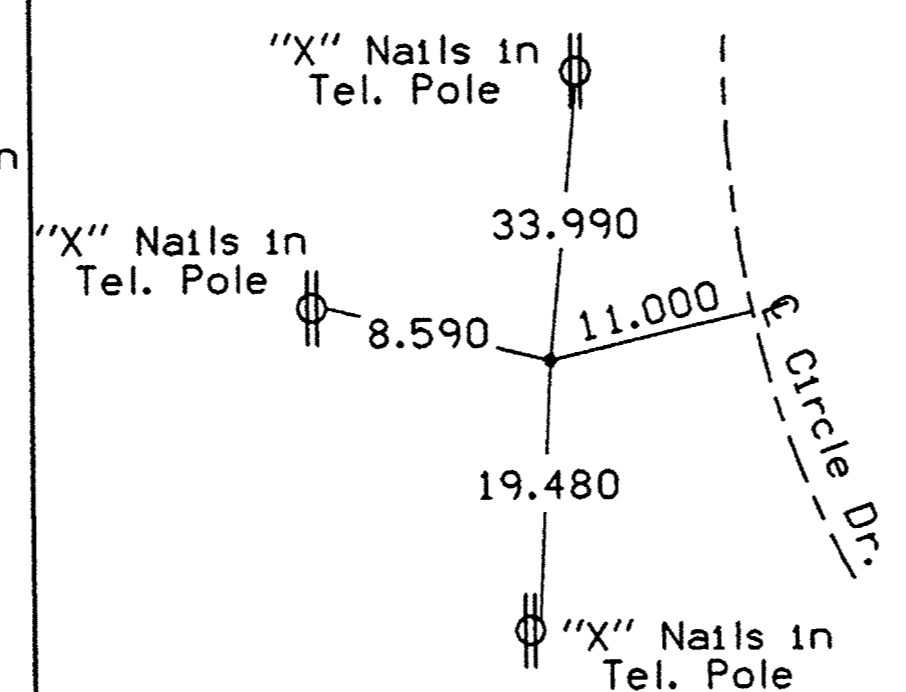

CIRCLE DRIVE
P.T. STA. 1186+42.782
 P - K Nail

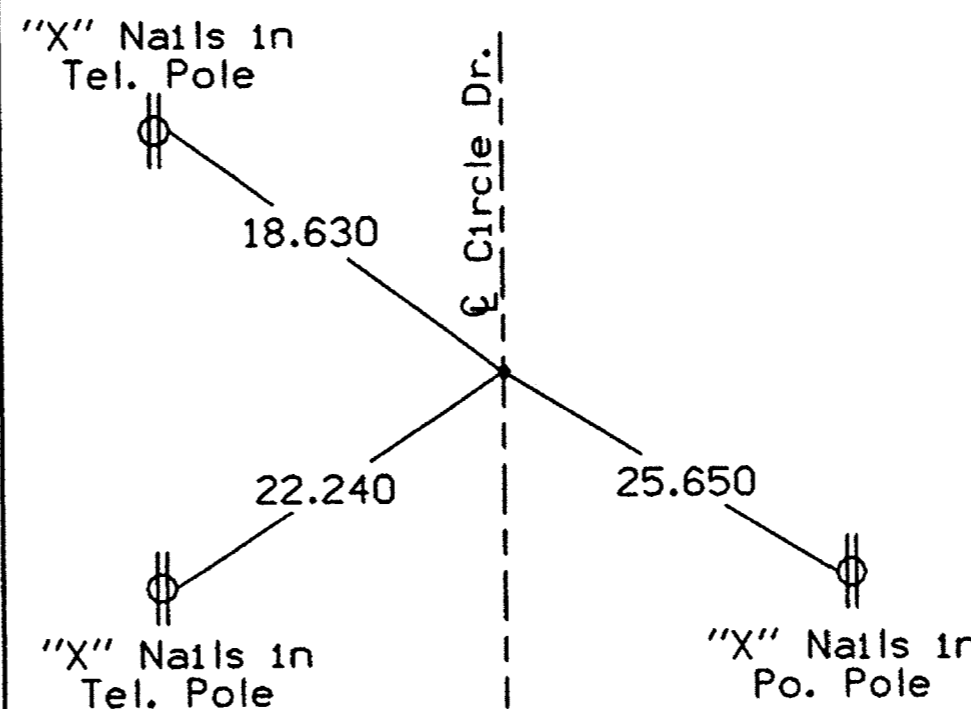

Prof. = \\WATS01\DATA\PLT\PL 463P\G08.PRF
 Date = Wed Oct 27 13:30:37 1999

TRAFFIC CONTROL PLAN

108-23
09-27-94

- Traffic will be maintained on US Hwy. 151 and Iowa 64 at all times. Local access will be provided as noted in Staging Notes Tabulation 108-26.
- Traffic control on this project shall be in accordance with Standard Road Plans RS-2, RS-8, RS-15, RS-16, RS-26, RS-64A and RS-64B, and Detail Sheets J.03 - J.06 contained in the plans. For additional complementary information, refer to Part VI of the Manual of Uniform Traffic Control Devices and to the current Standard Specifications.
- The contractor shall coordinate traffic control with other projects in the area. Other work in progress during the same period of time will include, but will not be limited to construction of the following projects: NHS-151-4(65)--19-53, NHS-151-4(66)--19-53, NHS-151-4(67)--3H-53, NHSX-151-4(64)--3H-53 and NHSX-151-3(102)--3H-57.
- All traffic control devices shall be furnished, erected, maintained, and removed by the contractor.
- Article 2528.12 of the Standard Specifications requires maintenance of all traffic control devices, including maintenance of the devices during nonworking hours in order to assure proper operation.
- Where possible, all post-mounted signs shall be placed at least 0.6 m beyond the curb or edge of shoulder.
- The location for storage equipment by the contractor during non-working hours shall be as approved by the engineer in charge of construction.
- The engineer may require modifications to the pavement marking details shown. Conflicting permanent edge lines, centerlines, or lane lines shall be removed. As applicable, permanent edge lines, centerlines, and lane lines shall be placed before the roadway is returned to normal traffic. The current Standard Specifications and Supplemental Specifications shall apply.
- Proposed sign spacing may be modified as approved by the engineer to meet existing field conditions or to prevent obstruction of the motorist's view of permanent signing.
- Permanent signing that conveys a message contrary to the message of the temporary signing and not applicable to the working conditions shall be covered by the contractor when directed by the engineer.
- Proposed changes in the traffic control plan shall be reviewed with the Office of Construction before changes are made.
- The bid item "Traffic Control" shall include the cost for all traffic measures required of the contractor except for those which are separate bid items or are incidental to other bid items.

STAGING NOTES

108-26
09-27-94

Construction activity in this area may disrupt traffic on U.S. 151 and side roads. Therefore, it is advisable to adopt a construction sequence which directs activities in an orderly manner to maintain most traffic patterns at all times.

The items of work are staged so that U.S. Hwy. 151 and Ia. 64 through traffic may be maintained at all times.

STAGE 1

Traffic
Hwy. 151 - Traffic is to remain as is.
IA. 64 - Traffic is to remain as is.

Construction Activities
Hwy. 151 - Grade the north bridge berm along the Wapsipinicon River from Sta. 135+33 to Sta. 136+50.
IA. 64 - Pave Shoulder Run-around on West Bound Lanes from Sta. 2156+00 to Sta. 2157+20. Remove Raised Median and Place Detour Pav't from Sta. 2157+00 to Sta. 2157+63. Utilize Traffic Control Layout RS-2.
Other - Grade Entrance Ramp 'A', Exit Ramp 'D' and On-Site Detour 'C'.

STAGE 2

Traffic
Hwy. 151 - Close Rt. Acceleration Lane on South Bound Lanes from Sta. 148+00 to Sta. 151+00. Utilize Traffic Control Layout RS-64A.
IA. 64 - Route Head-To-Head Traffic on the existing two West Bound Lanes. Utilize Traffic Control Layout RS-64A and Layout on Sheet J.03.

Construction Activities
IA. 64 - Remove Pavement on East Bound Lanes from Sta. 2156+25 to Sta. 2157+05 and from 1.2 m Lt. of CL South to Edge of Pavement. Place P.C. Pavement from Sta. 2156+25 to Sta. 2156+91 on East Bound Lanes. Place Detour Pav't from Sta. 2156+91 to Sta. 2157+05 on East Bound Lanes.
Other - Pave Entrance Ramp 'A' and On-Site Detour 'C'.

STAGE 3

Traffic
Hwy. 151 - To Remain as in Stage 2. During Construction of Connector Between Exit Ramp 'D' and Exist. Hwy. 151, Utilize RS-2.
IA. 64 - Route Head-To-Head Traffic on the New East Bound Lanes Constructed during Stage 2. Utilize Traffic Control Layout RS-64B and Layout on Sheet J.03.

Construction Activities
IA. 64 - Remove Pavement on West Bound Lanes from Sta. 2156+25 to Sta. 2157+05 and from 1.2 m Lt. of CL North to Edge of Pavement. Place P.C. Pavement from Sta. 2156+25 to Sta. 2156+91 on West Bound Lanes. Place Detour Pav't from Sta. 2156+91 to Sta. 2157+05 on West Bound Lanes.
Other - Pave Exit Ramp 'D' and Connector Between Exit Ramp 'D' and Exist. Hwy. 151. See Sheet J.04 for Limits of Construction.

STAGE 4

Traffic
Hwy. 151 - Route Head-To-Head Traffic from Exist. Hwy. 151 on to On-Site Detour 'C', Entrance Ramp 'A', Exit Ramp 'D' and on to Exist. Hwy. 151. Utilize Traffic Control Layout RS-8, Layout on Sheet J.04 and Layout on Sheet J.05.
IA. 64 - Traffic to Remain as in Stage 3 With Modifications as per Traffic Control Layout on Sheet J.05.

Construction Activities
Hwy. 151 - Grade North Bound and South Bound Lanes from Sta. 150+00 to Sta. 162+00 which includes the IA. 64 bridge berms.
IA. 64 - Construct Detour Pavement as Detailed on Sheet J.04. Utilize Traffic Control Layout RS-2.

STAGE 5

Traffic
Hwy. 151 - To Remain as in Stage 4.
IA. 64 - Route Head to Head Traffic on to Detour Pavement and Existing East Bound Lanes. Utilize Traffic Control Layout on Sheet J.05.

STAGING NOTES

108-26
09-27-94

Construction Activities
Hwy. 151 - Pave South Bound Lanes and Ramp 'A' Taper from Sta. 150+00 to Sta. 154+50.
IA. 64 - Pave West Bound Lanes, Shoulder and Curb from Sta. 2156+91 to Sta. 2159+60. Pave West Bound Lane Outside of Existing Pav't from Sta. 2159+60 to Sta. 2161+15. Construct Detour Pavement as Detailed on Sheet J.05.
Other - Construct Chamber Drive Utilizing Type 'M' Concrete. Construction Will be Staged to Allow Access to Walmart.

STAGE 6

Traffic
Hwy. 151 - Route Head to Head Traffic from Exist. Hwy. 151 on to Newly Paved S. B. Lanes, Ent. Ramp 'A', Ex. Ramp 'D' and on to Exist. Hwy. 151. Utilize Traffic Control Layout on Sheet J.07.
IA. 64 - Route Head to Head Traffic on to Newly Paved West Bound Lanes. Utilize Traffic Control Layout on Sheet J.06.


Construction Activities
IA. 64 - Pave East Bound Lanes from Sta. 2156+91 to Sta. 2159+60. Pave East Bound Lane Outside of Existing Pav't from Sta. 2159+60 to Sta. 2161+15.
Other - Remove On-Site Detour 'C'. Grade and Surface Shaw Rd. Grade Exit Ramp 'B' and Entrance Loop 'C'. Construct Grant Wood Drive Using Type 'M' Concrete. Construction Will be Staged to Allow Access to Businesses.
Hwy. 151 - Grade North Bound Lanes from Sta. 135+50 to Sta. 150+00 and from Sta. 162+00 to Sta. 187+25.

STAGE 7

Traffic
Hwy. 151 - To Remain as in Stage 6.
IA. 64 - Route IA. 64 Traffic on to Newly Constructed East Bound and West Bound Lanes.


dgn = L:\WORK\PROJ\134120\CADD\EAS\N531b1063.j01
 prf = L:\WATSON\DATA\PL\LOT\PL463P\J01H.PRF
 date = Thu Oct 28 07:58:14 1994
 levels = 1-3,62
 par table = L:\Xlot\tables\halfwt.tbl

DUN - L:\WORK\PROJECT\34120\CADD\EA\151063.J02
 PRF - \WATS01\DATA\PL01\PL463P\J02H.PRF
 DATE - THU OCT 28 07:58:27 1999
 LEVELS - 1-62
 PEN TABLE - L:\PLOT\TABLES\HALEWT.TBL

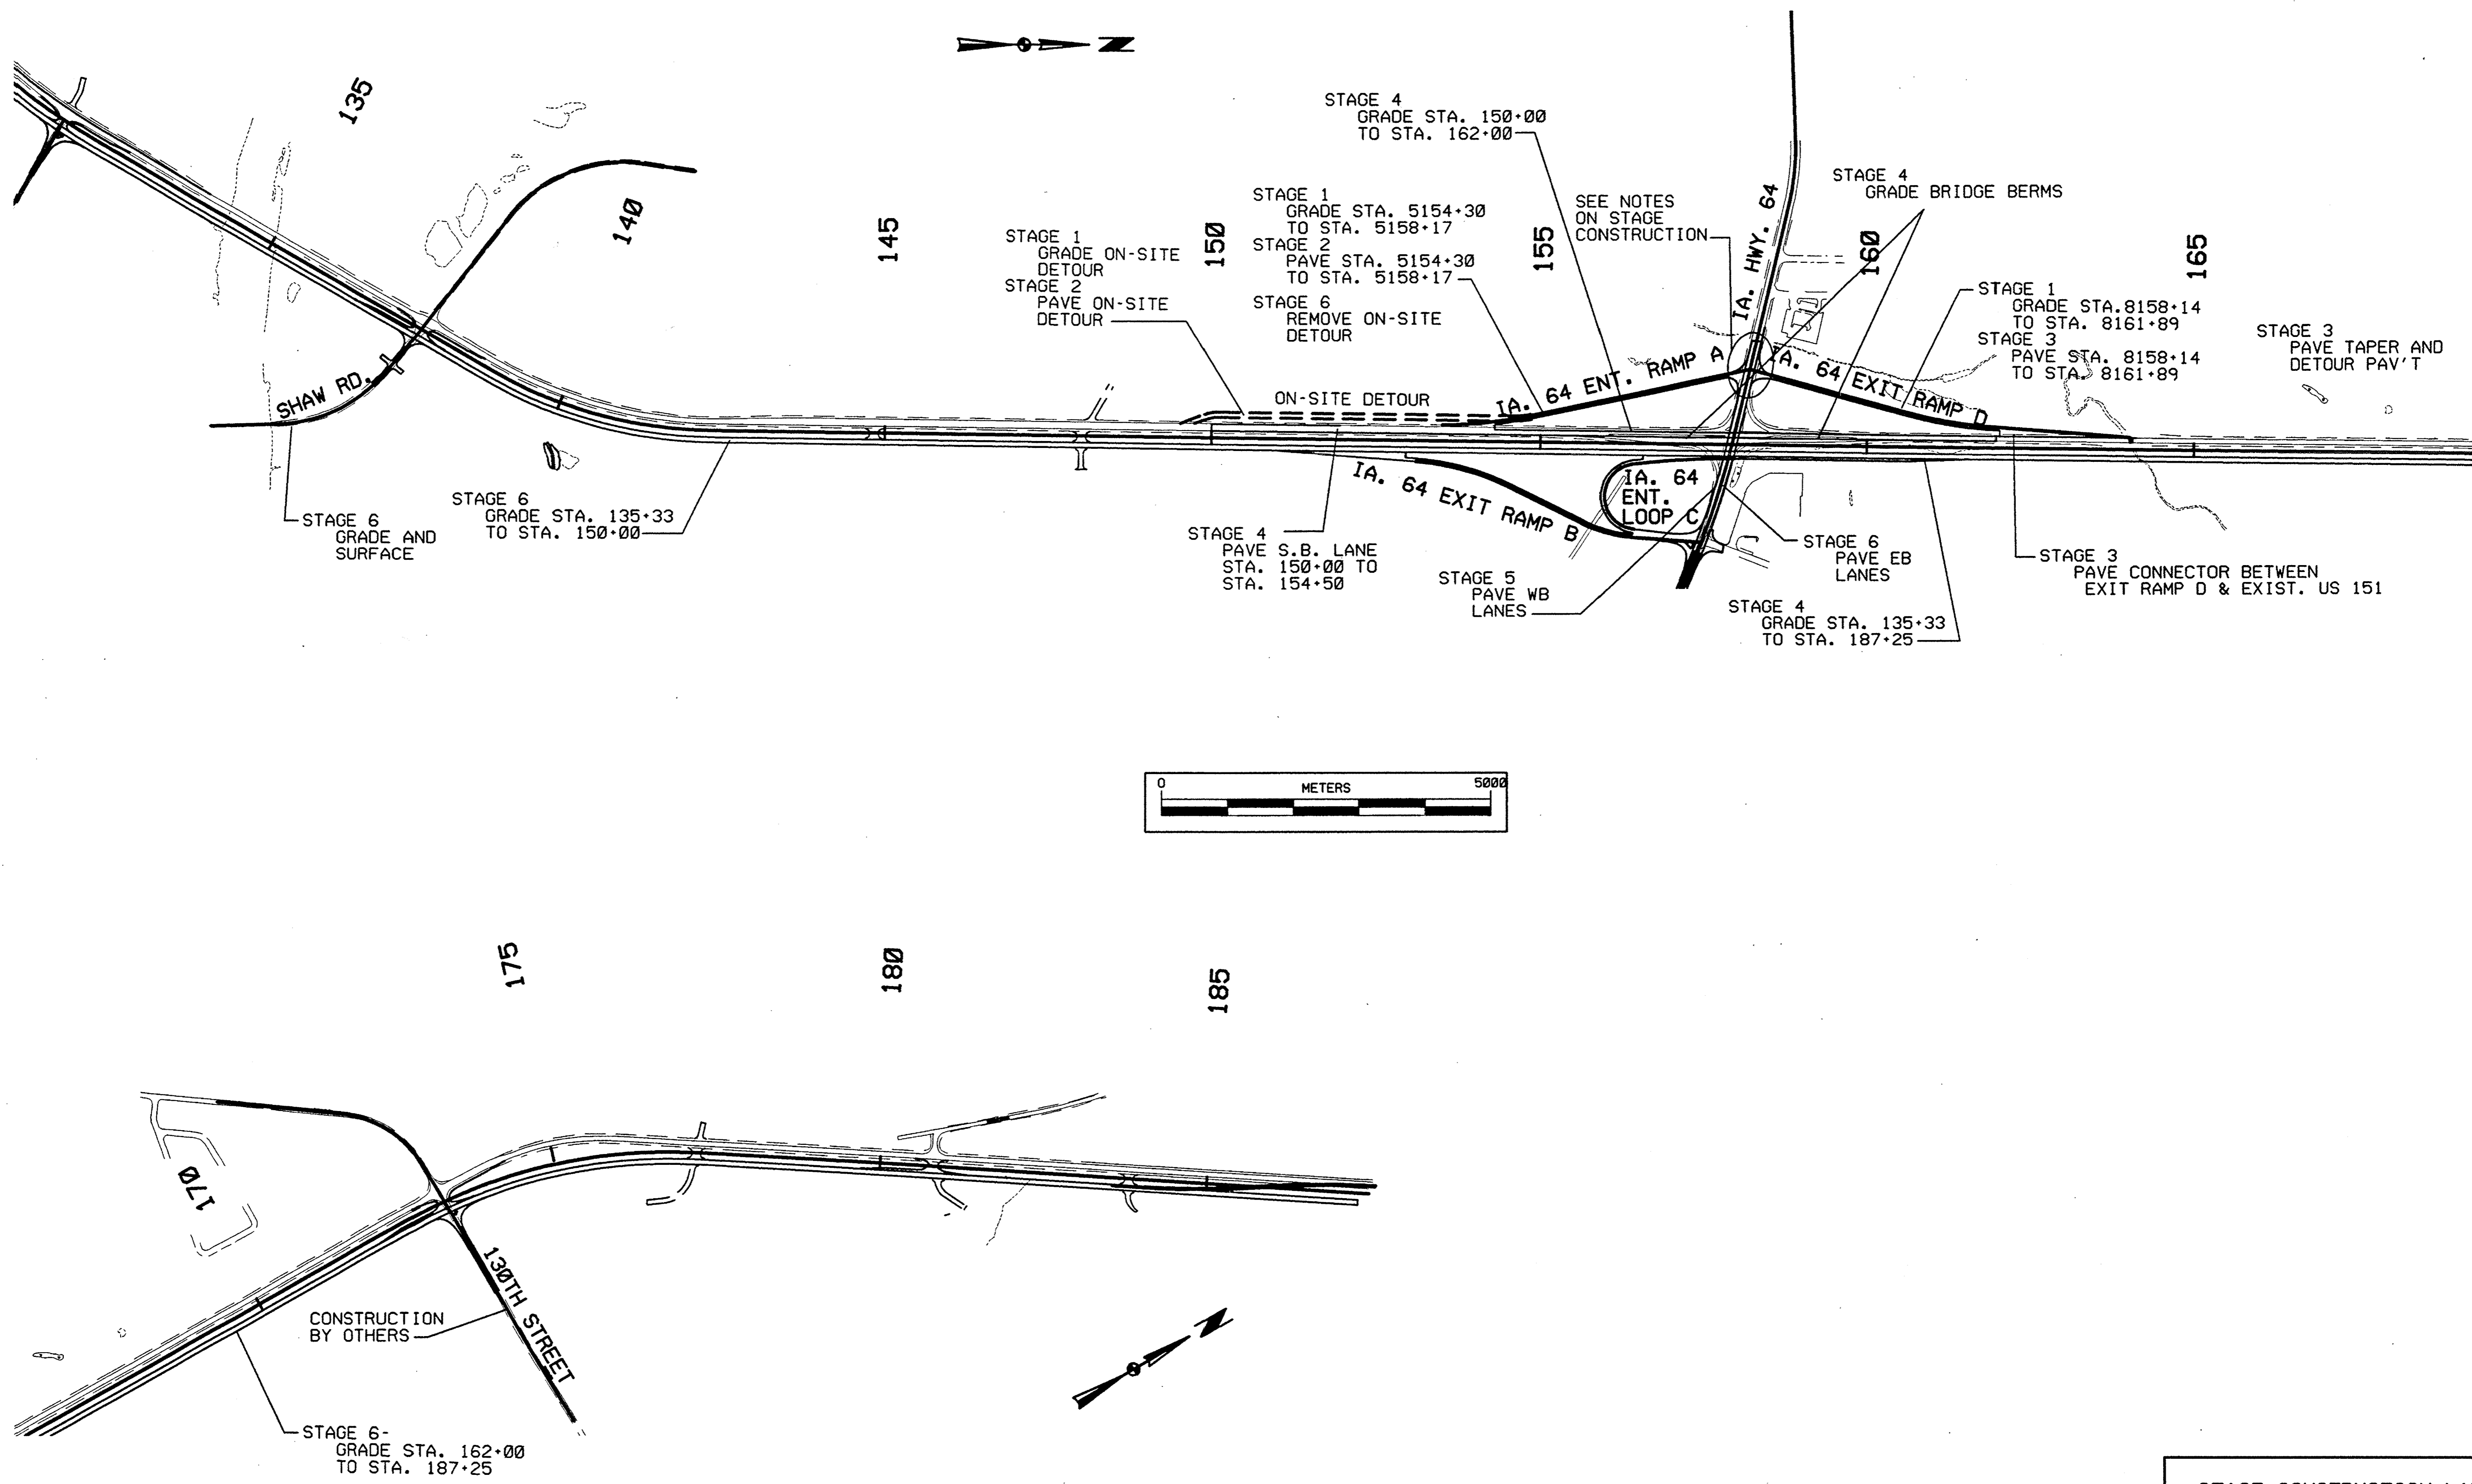


STAGE CONSTRUCTION LAYOUT
 STA. 134+00 TO STA. 185+00

dgn = L:\WORK\proj\sect\34120\caadd\IAS153151063_J03
 prf = \\WATSON\DA\PL\PL\PL\483P_J03h.prf
 Date = Fri Jul 2 14:18:32 1999
 pen table = I:\plot\tables\halfwt.tbl
 levels = 1-62

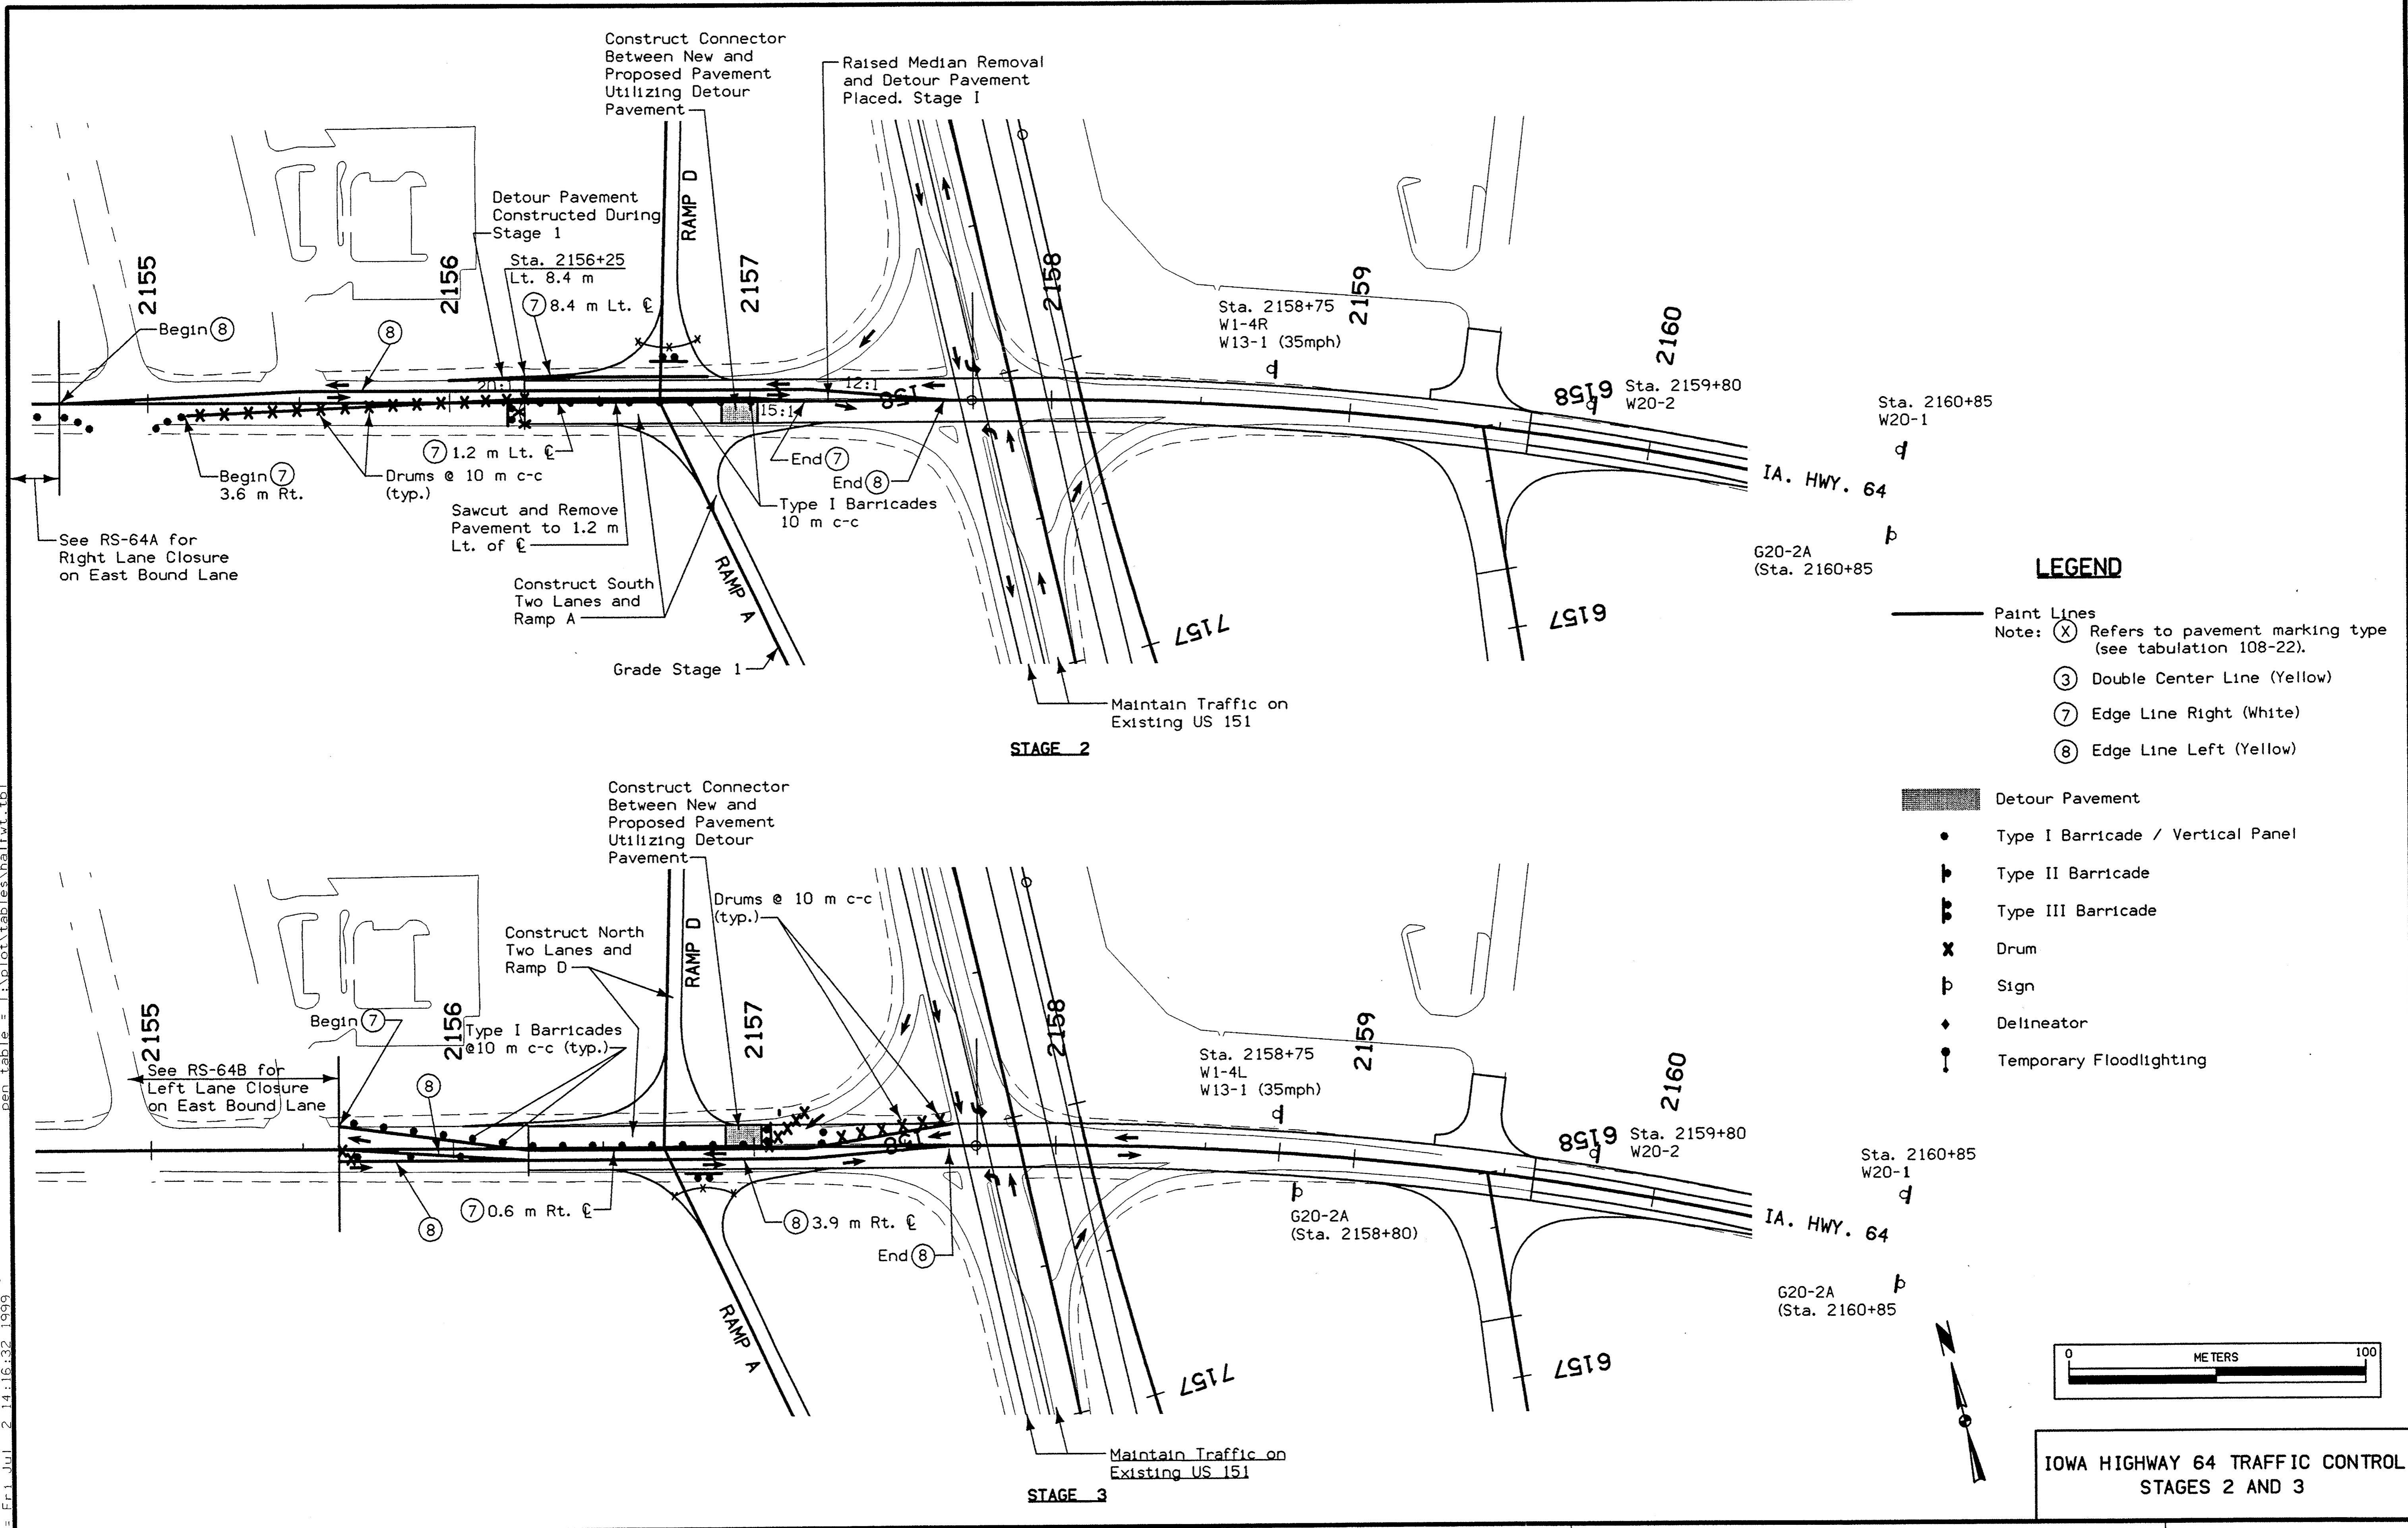


LEGEND

- Paint Lines
- Note: (X) Refers to pavement marking type (see tabulation 108-22).
- (3) Double Center Line (Yellow)
 - (7) Edge Line Right (White)
 - (8) Edge Line Left (Yellow)
- Detour Pavement
- Type I Barricade / Vertical Panel
 - ▬ Type II Barricade
 - ▬ Type III Barricade
 - × Drum
 - ▬ Sign
 - ◆ Delineator
 - ⊙ Temporary Floodlighting

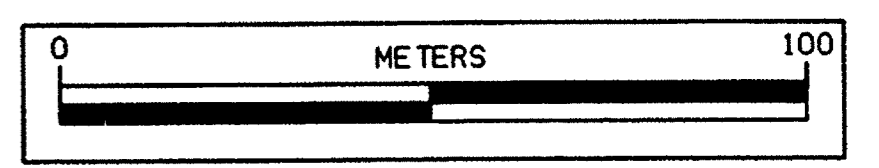


IOWA HIGHWAY 64 TRAFFIC CONTROL STAGES 2 AND 3

dgn = I:\WORK\proj\sect\34120\cadd\EAS153151063.j04
 prf = I:\WATS01\DA\Y\PL01\PL463P\J04h.prf
 Date = Fri Jul 2 14:16:42 1999
 levels = 1-62
 pen table = I:\plot\tables\halfwt.tbl

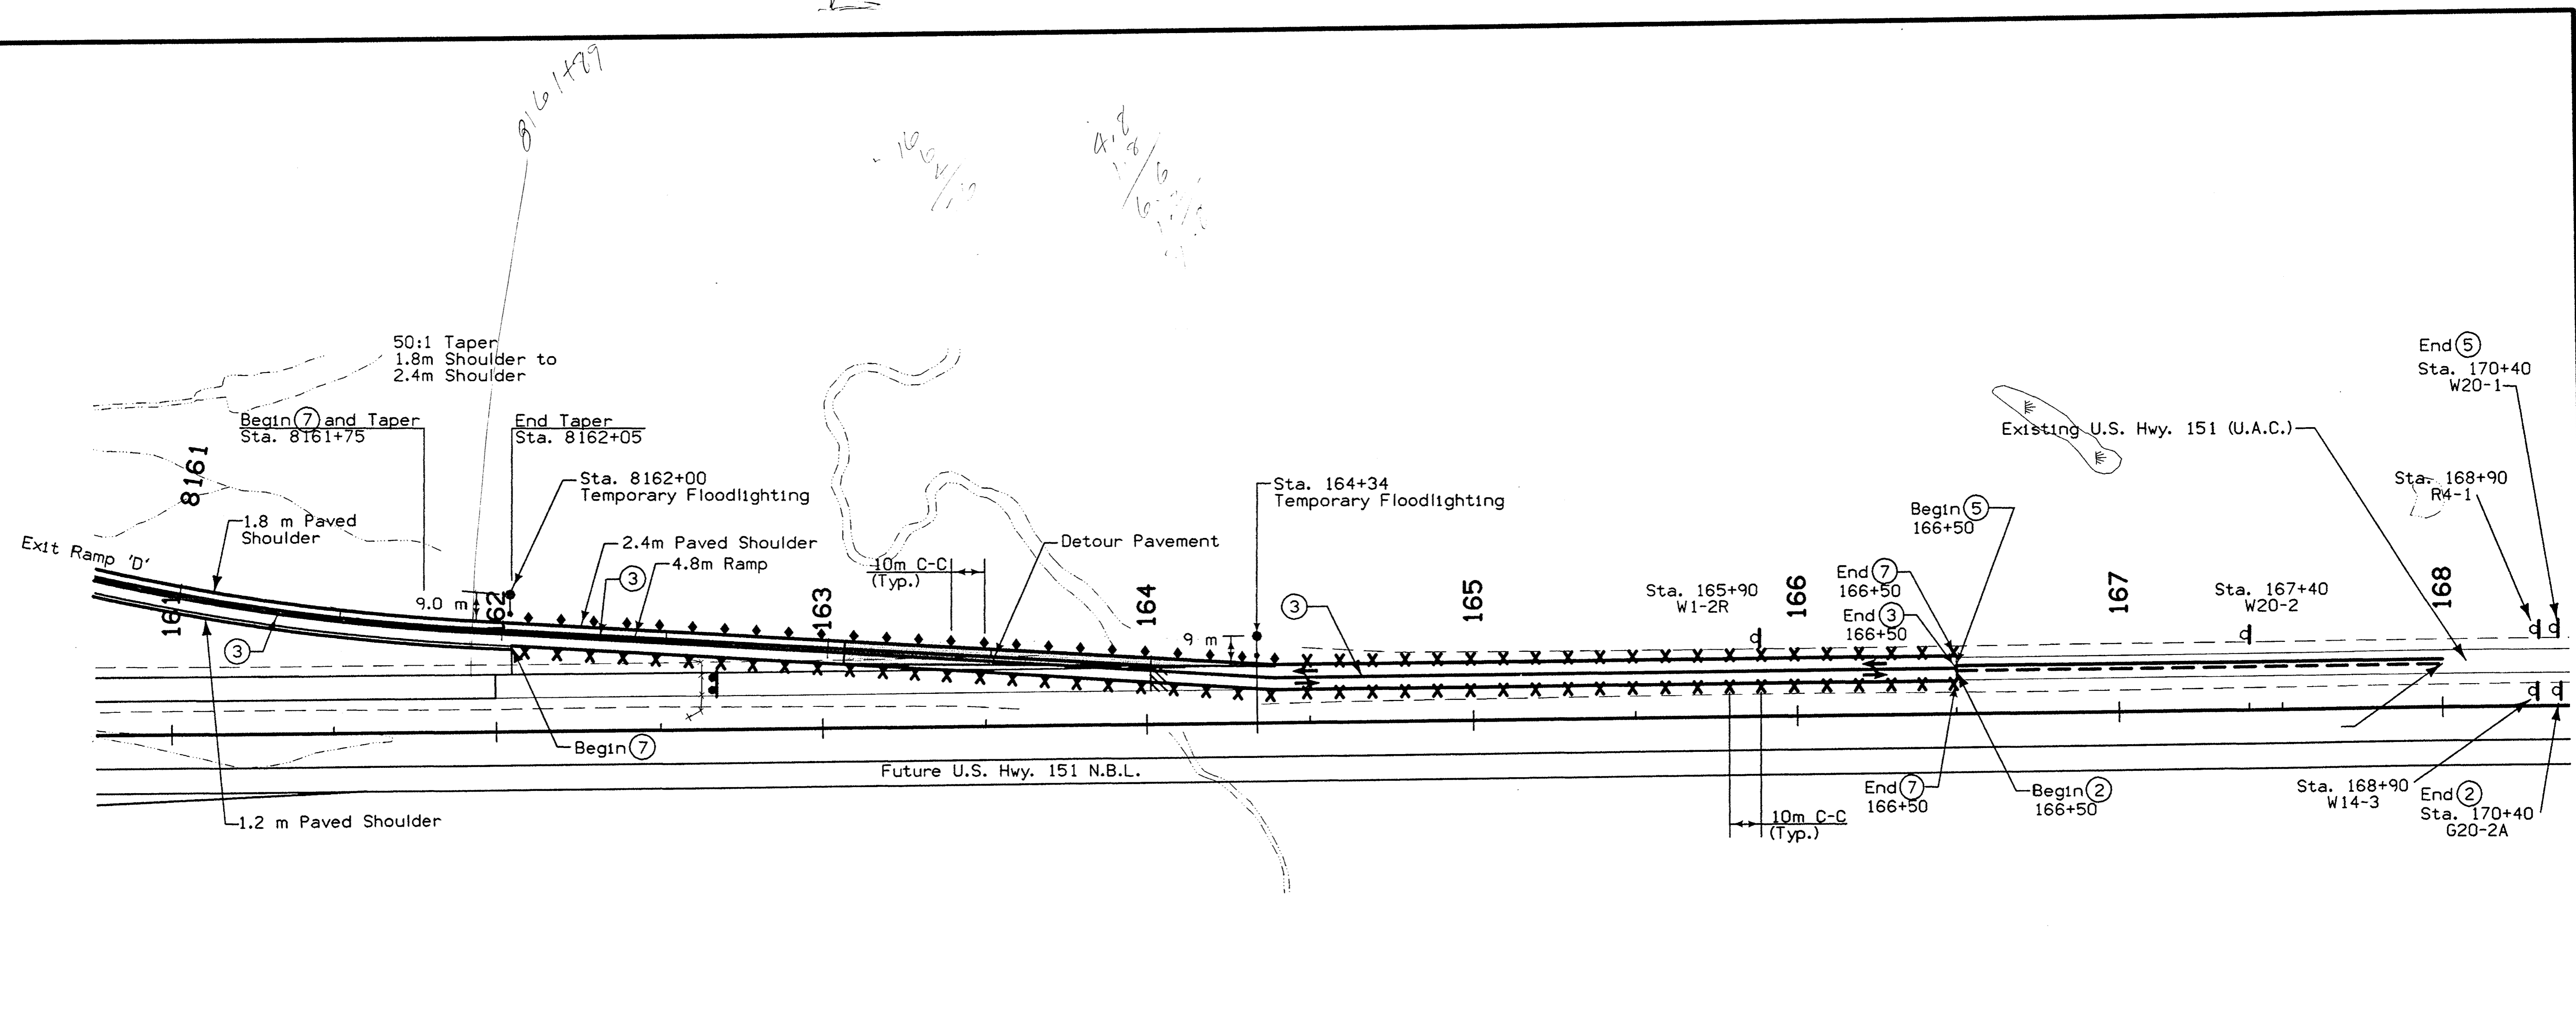


LEGEND

- Paint Lines
- Note: (X) Refers to pavement marking type (see tabulation 108-22).
- (3) Double Center Line (Yellow)
- (7) Edge Line Right (White)
- (8) Edge Line Left (Yellow)
- ▨ Detour Pavement
- Type I Barricade / Vertical Panel
- ⊢ Type II Barricade
- ⊢ Type III Barricade
- x Drum
- ⊢ Sign
- ◆ Delineator
- ⊙ Temporary Floodlighting

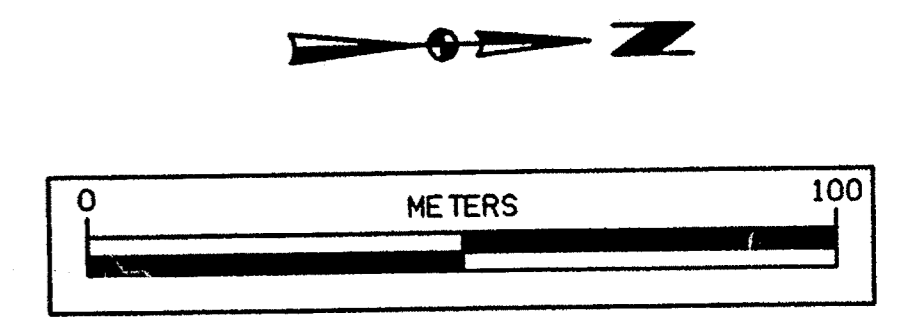


**EXIT RAMP 'D' / EXIST. HWY. 151
STAGE CONSTRUCTION AND
TRAFFIC CONTROL STAGE 4**

DGN : L:\WORK\PROJ\134120\CAUD\LEAS\153151063.JOB
 PRF : \WATSON\DATA\PLT\PL463R.JOB5H.PRF
 DATE : THU OCT 28 07:58:40 1999
 LEVELS : 1-62
 PEN TABLE : L:\PLOT\TABLES\HALFWT.TBL
 L:\WORK\PROJ\134120\CAUD\LEAS\153151063.JOB

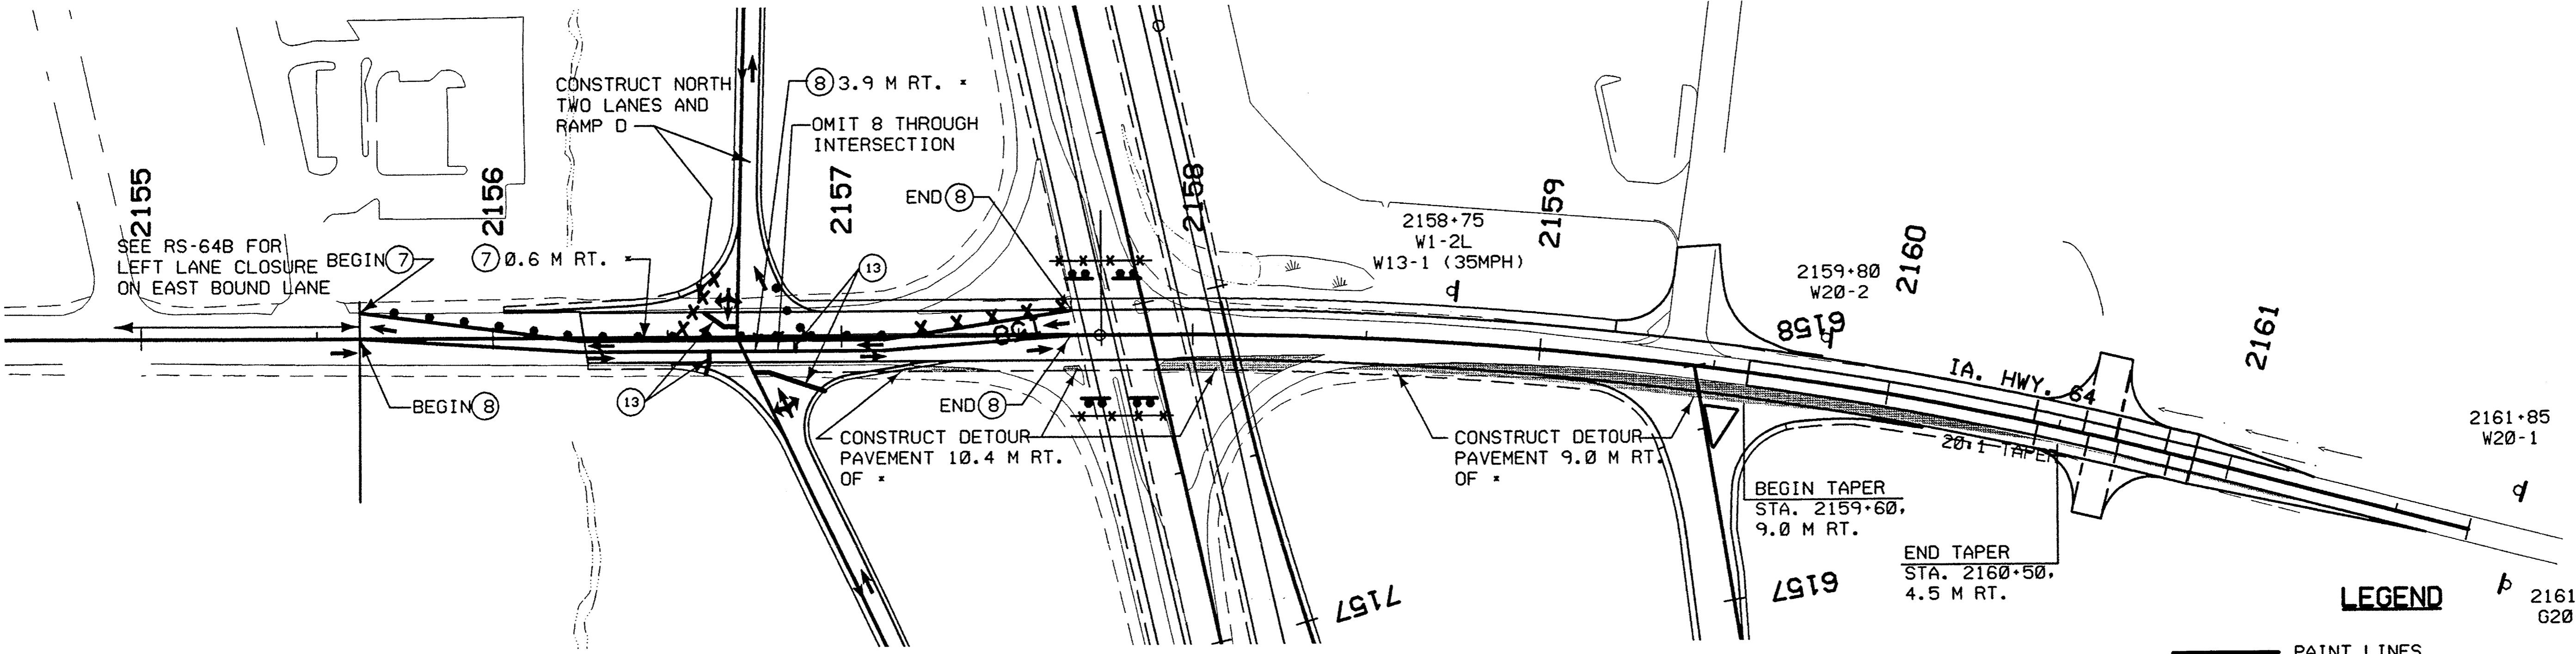

STAGE 4

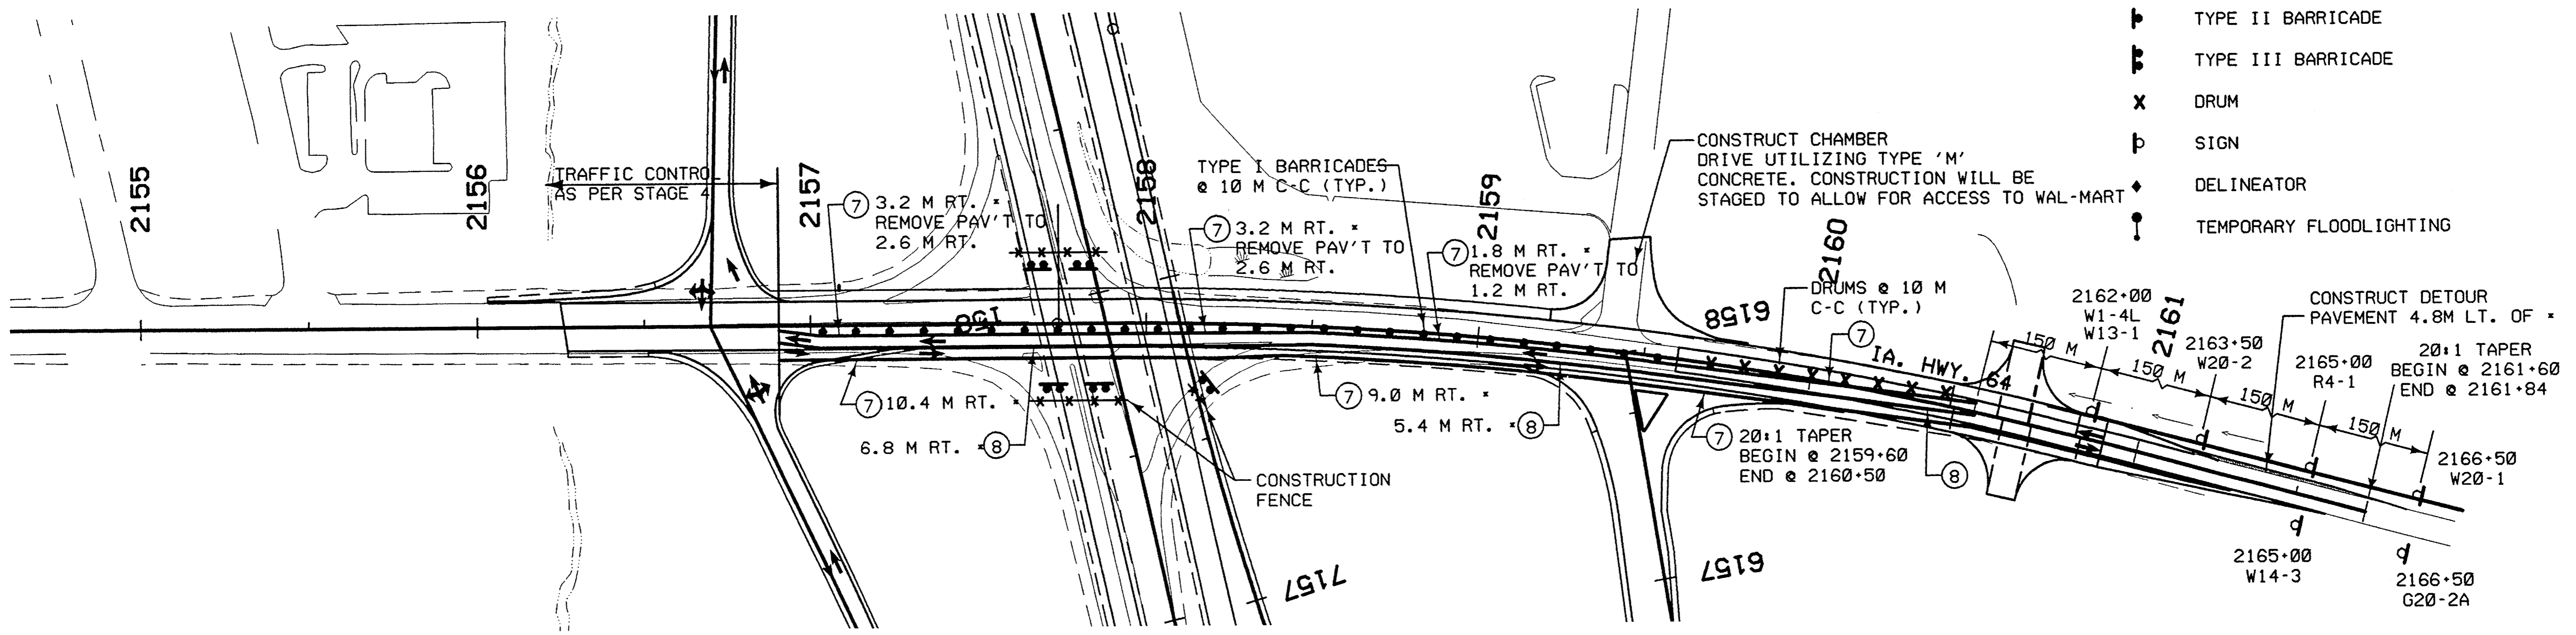


STAGE 5

LEGEND

- PAINT LINES
- NOTE: (X) REFERS TO PAVEMENT MARKING TYPE (SEE TABULATION 108-22).
- (3) DOUBLE CENTER LINE (YELLOW)
- (7) EDGE LINE RIGHT (WHITE)
- (8) EDGE LINE LEFT (YELLOW)
- ▨ DETOUR PAVEMENT
- TYPE I BARRICADE / VERTICAL PANEL
- ⊥ TYPE II BARRICADE
- ⊥ TYPE III BARRICADE
- x DRUM
- ⊥ SIGN
- ◆ DELINEATOR
- ⊥ TEMPORARY FLOODLIGHTING


IOWA HIGHWAY 64 TRAFFIC CONTROL STAGES 4 AND 5

D:\WORK\PROJECTS\34120\CAUD\EA51\53151063.J05
 LEVELS * 1-62
 PEN TABLE * L:\PLOT\TABLES\HALFMT.TBL
 DATE * THU OCT 28 07:58:40 1999
 L:\WORK\PROJECTS\34120\CAUD\EA51\53151063.J05
 PRF * \WATS01\DATA\PLT\PL463P\J05H.PRF
 DATE * THU OCT 28 07:58:40 1999

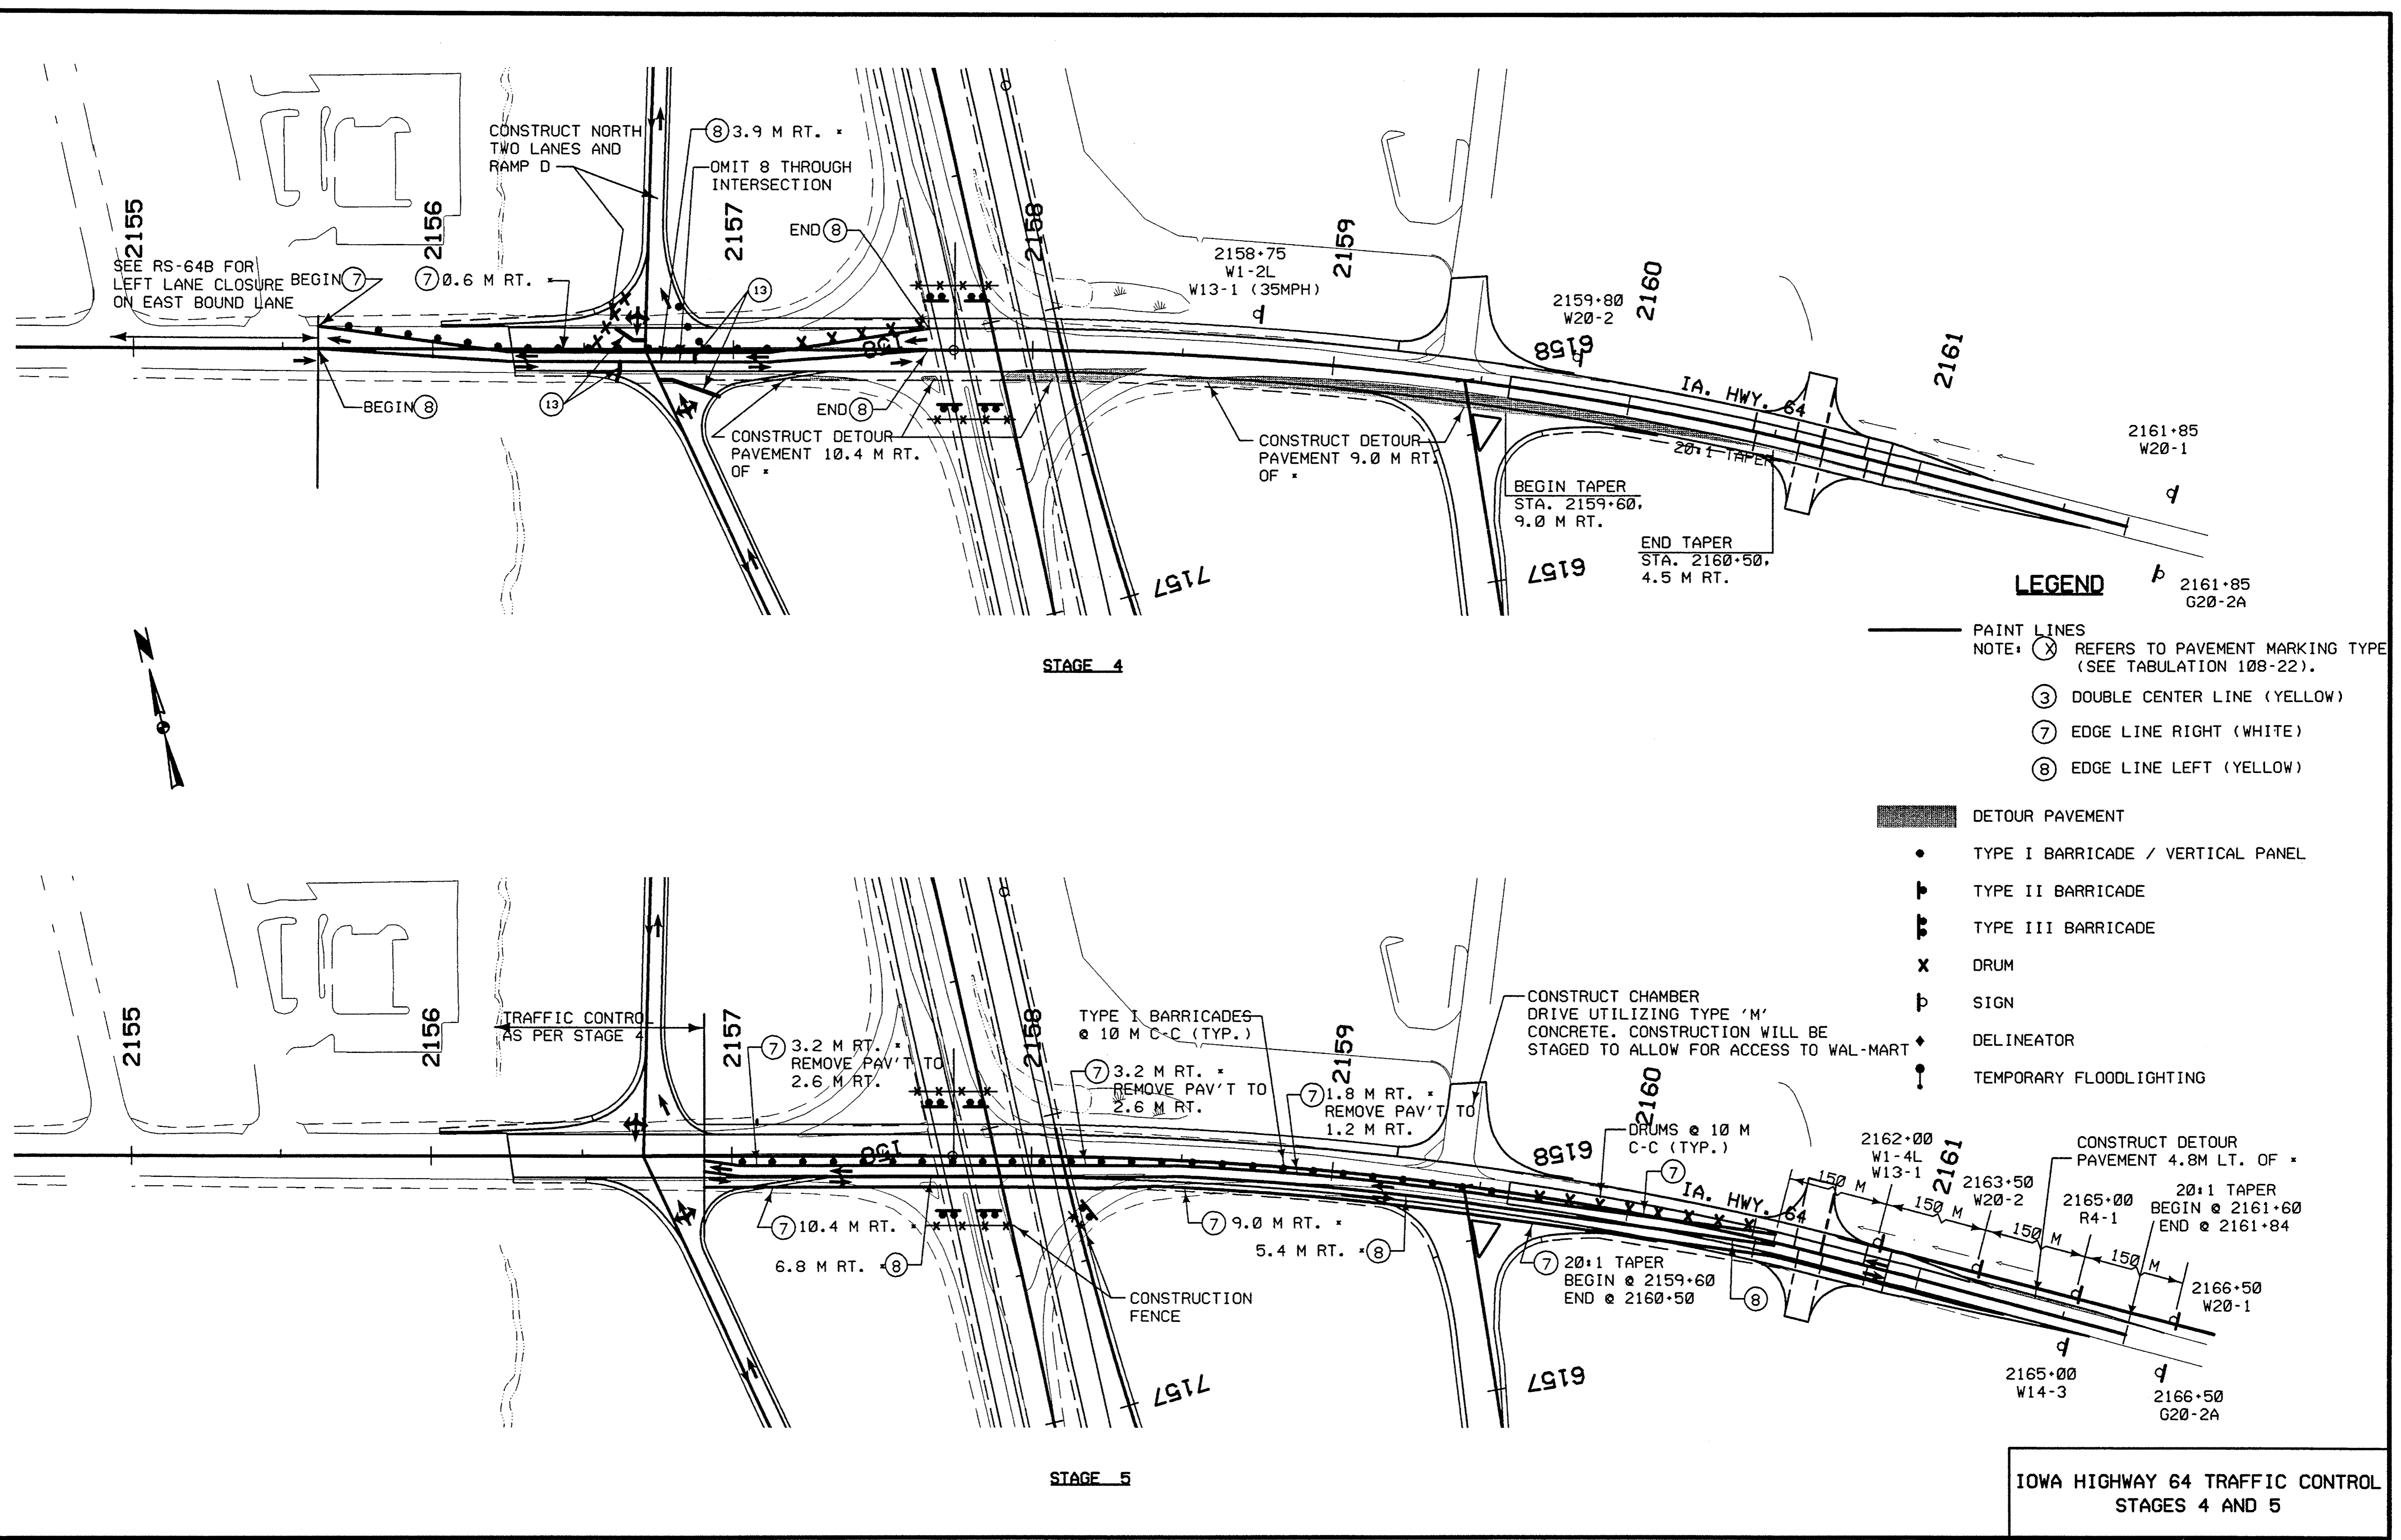


IOWA HIGHWAY 64 TRAFFIC CONTROL STAGES 4 AND 5

DSN = L:\WORK\PROJECT\34120\CAUD\EAS\53151063.J06
 PRF = \WATS01\DATA\LOT\PL463P\J06H.PRF
 DATE = THU OCT 28 07:58:51 1999
 LEVELS = 1-62
 PEN TABLE = I:\PLOT\TABLES\HAEVMT.TBL

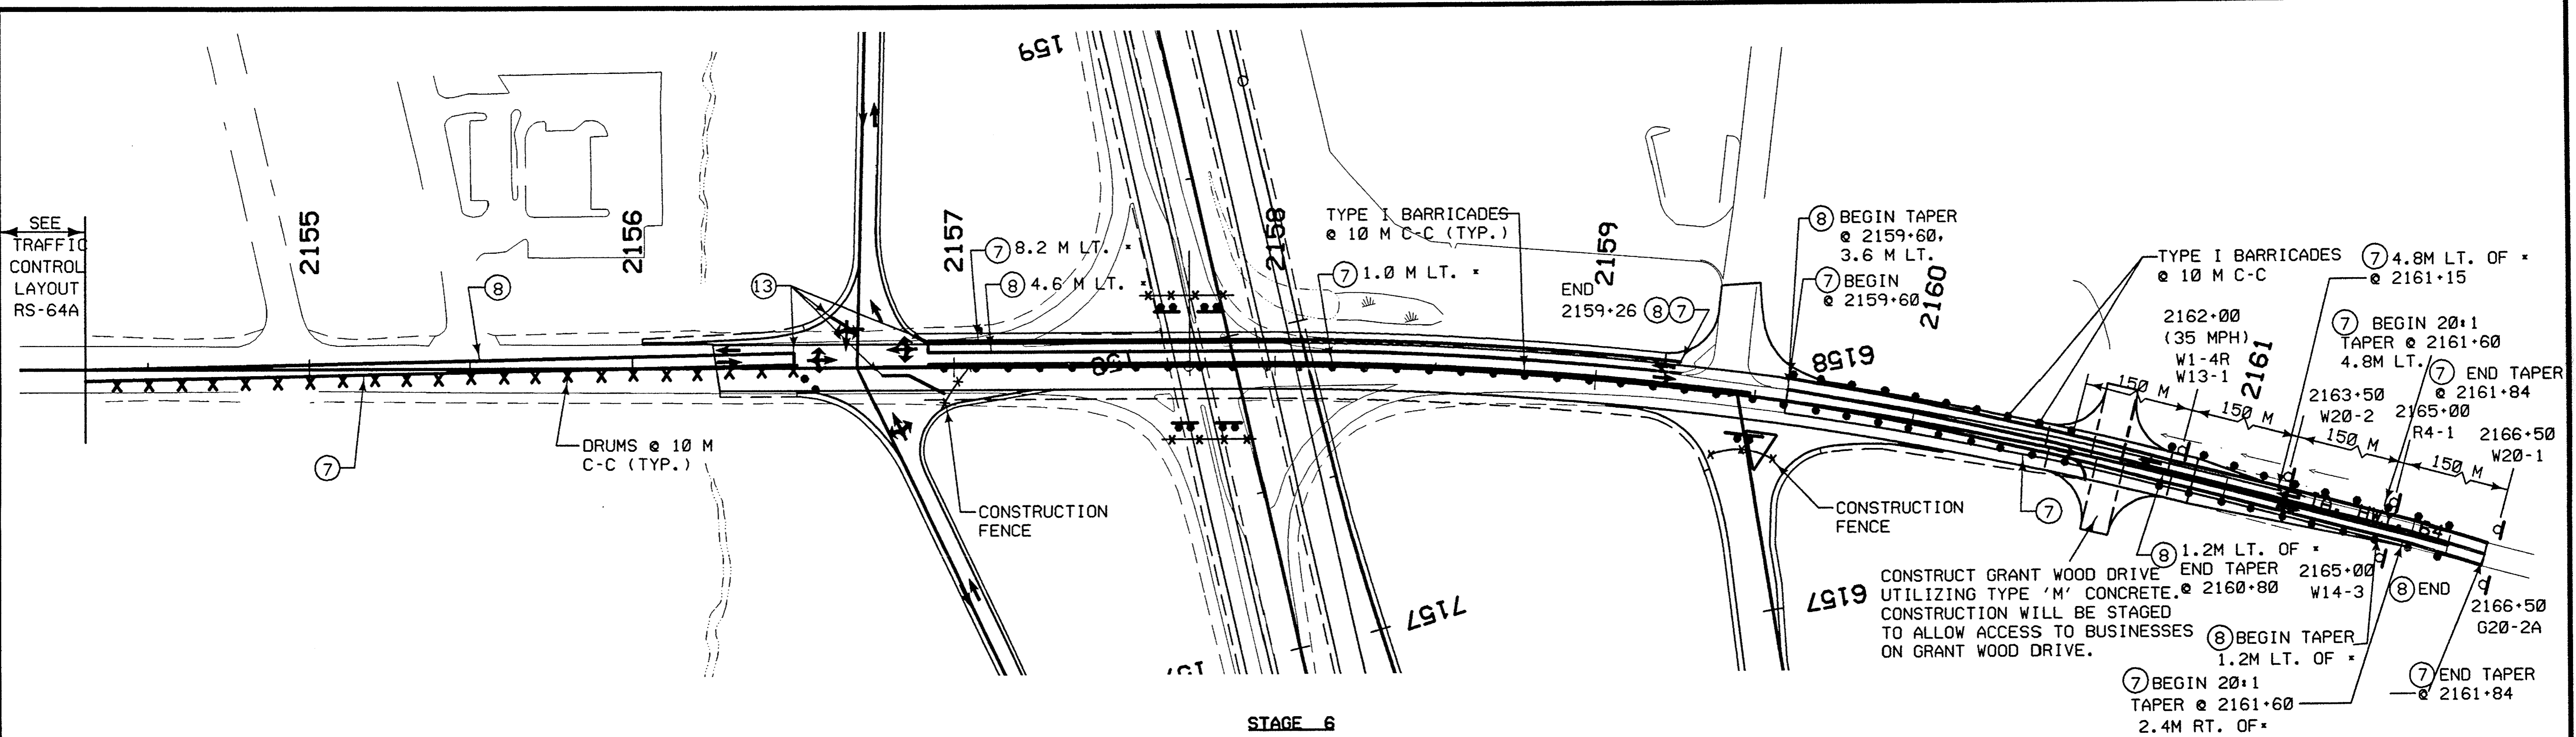


LEGEND

- PAINT LINES
- NOTE: (X) REFERS TO PAVEMENT MARKING TYPE (SEE TABULATION 108-22).
- (3) DOUBLE CENTER LINE (YELLOW)
- (7) EDGE LINE RIGHT (WHITE)
- (8) EDGE LINE LEFT (YELLOW)
- (13) STOP LINE (WHITE)
- ▨ DETOUR PAVEMENT
- TYPE I BARRICADE / VERTICAL PANEL
- ▬ TYPE II BARRICADE
- ▬ TYPE III BARRICADE
- X DRUM
- ▬ SIGN
- ◆ DELINEATOR
- ⦿ TEMPORARY FLOODLIGHTING

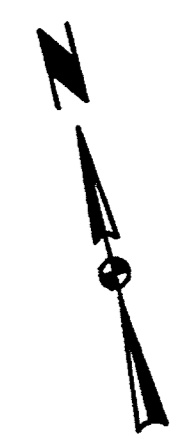

IOWA HIGHWAY 64 TRAFFIC CONTROL
STAGE 6

dgn = L:\WORK\PROJECT\34120\ADD\NEAS\531b 1063.j07
 prf = \\WATSO1\DATA\PLT\463P\J07.PRF
 date = Thu Oct 28 11:53:03 1999
 levels = 1-59,61-63
 den table = I:\Plot\Tables\halfvt.tbl

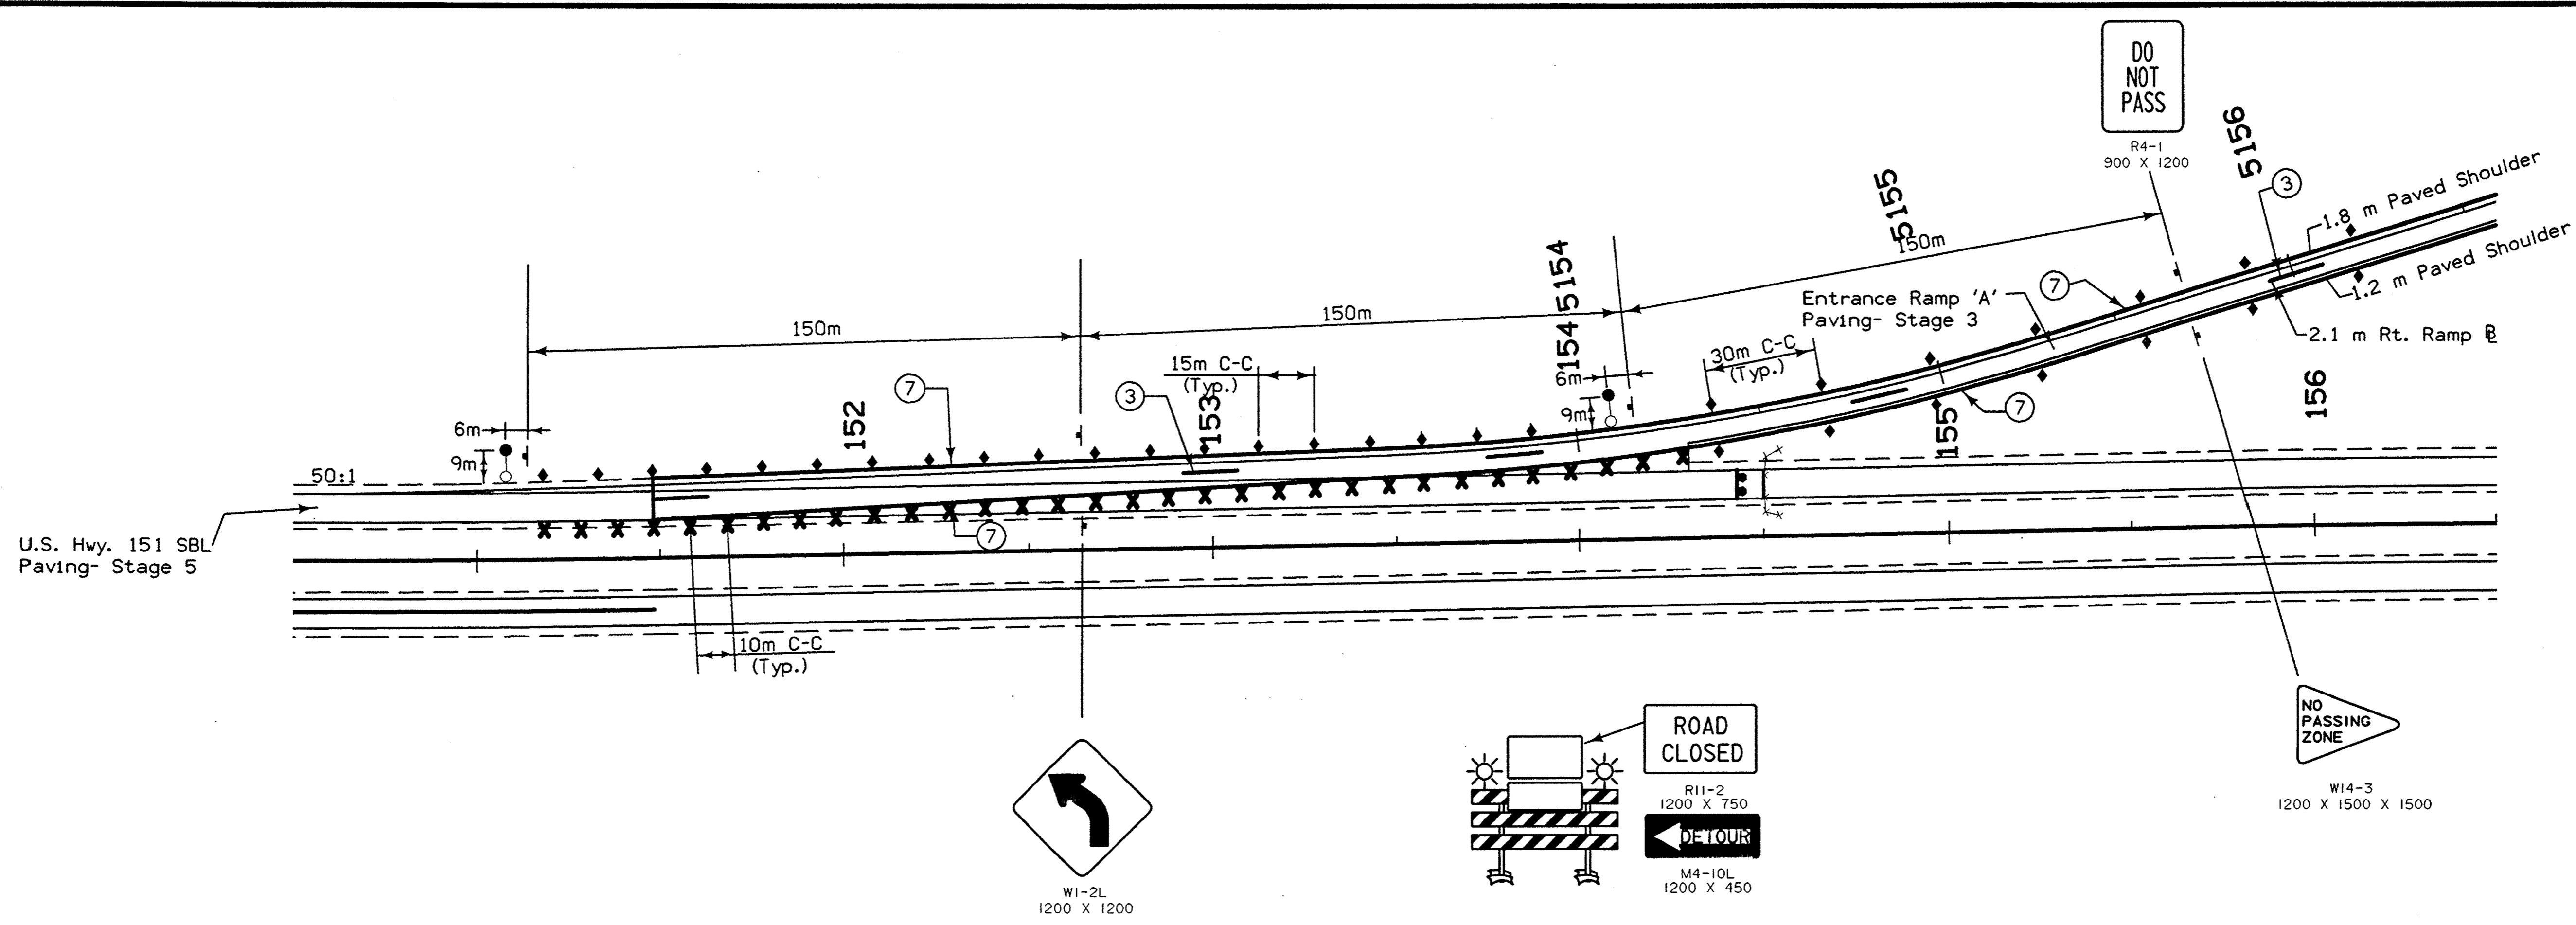


LEGEND


- Paint Lines
- Note: (X) Refers to pavement marking type (see tabulation 108-22).
- (3) Double Center Line (Yellow)
- (7) Edge Line Right (White)
- Type I Barricade / Vertical Panel
- ▬ Type II Barricade
- ▬ Type III Barricade (Type 'A' Low Intensity Flashing Warning Lights Required for Nighttime Use)
- X Drum
- ▬ Traffic Sign
- ◆ Delineator (single white delineators, mounted back-to-back)
- Temporary Floodlighting
- ⋈ Orange Plastic Safety Fence

GENERAL NOTES:

1. The Contractor shall be responsible for the placement and removal of temporary white edgelines and yellow "No Passing" lines. The Contractor shall also be responsible for the removal and replacement of the existing dashed yellow centerline and white edgelines as required by the Traffic Control Layout.
2. For temporary Floodlighting, see Detail Sheet 570-2.
3. Poles for temporary floodlighting and auxiliary poles used to furnish power to signals or floodlights shall be offset 9 meters from the travelled way unless there are right-of-way restrictions. Clearance on overhead wiring for signals and floodlighting shall be a minimum of 6 meters.
4. Post mounted white delineators shall be erected in accordance with Standard Road Plan RE-7.

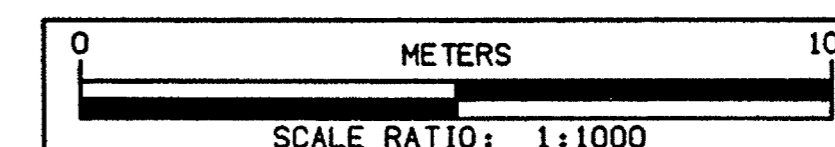

**ENT. RAMP 'A' / HWY. 151
TRAFFIC CONTROL
STAGE 5**

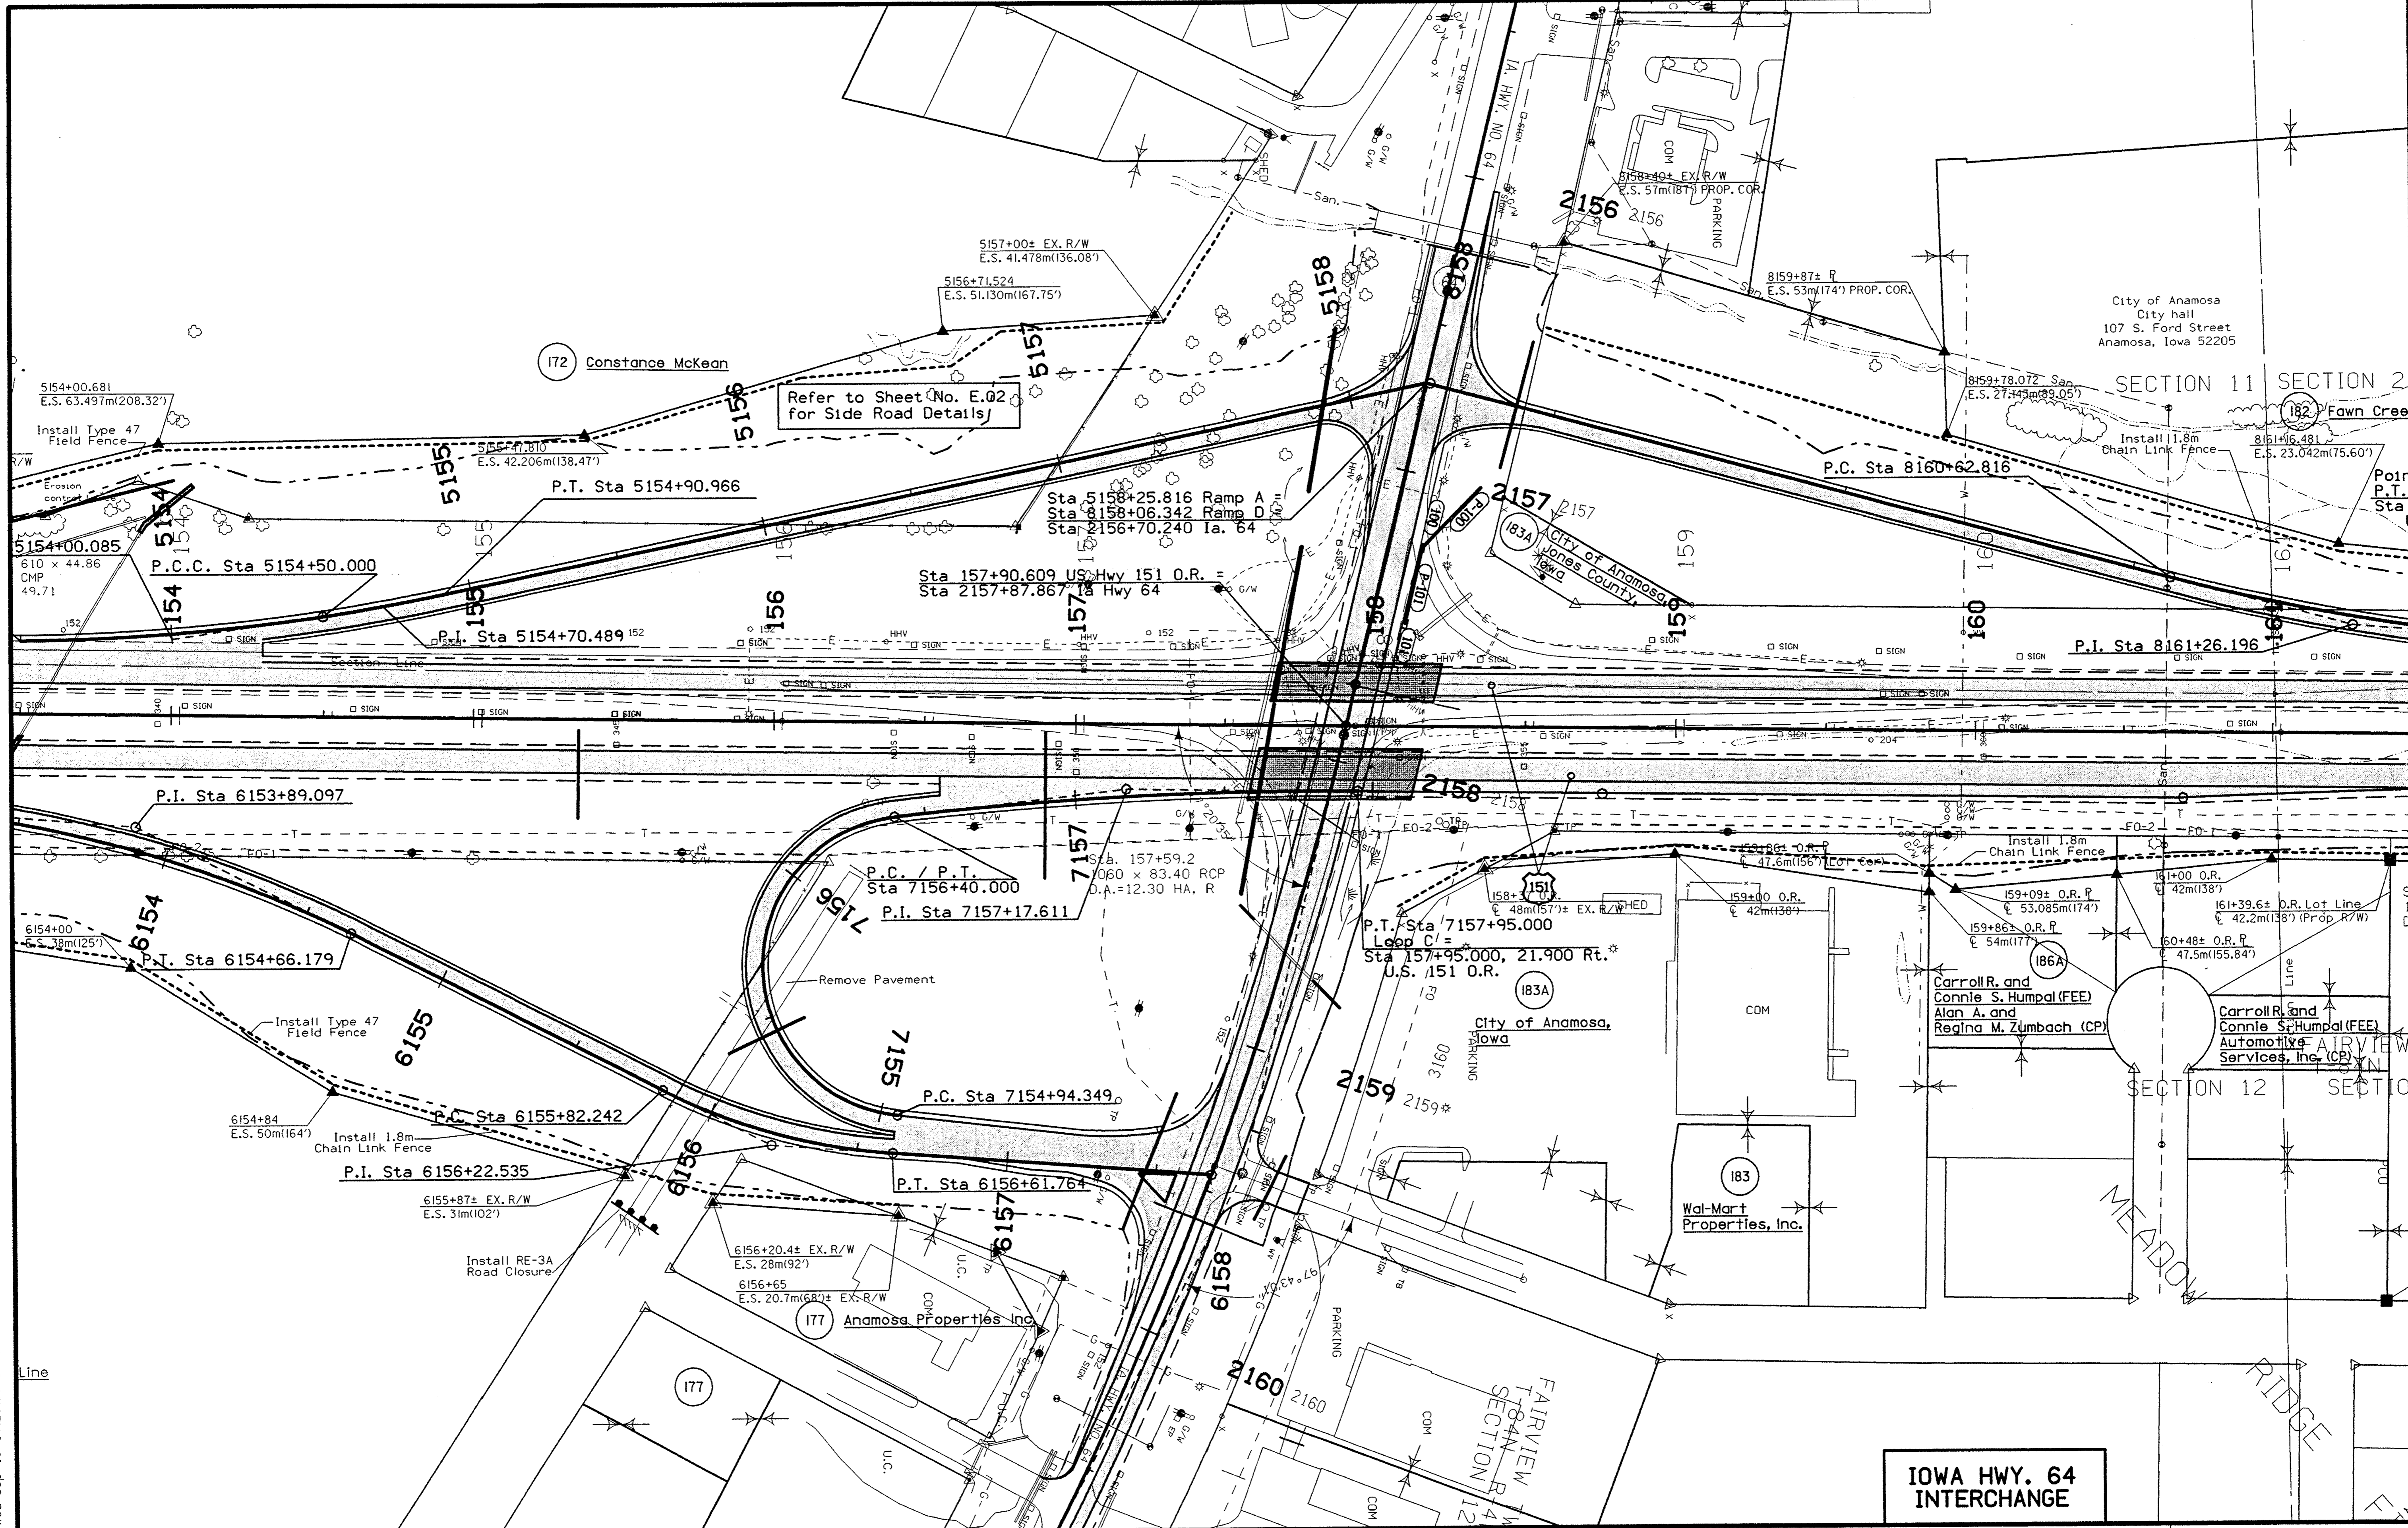

IOWA HWY. 64 INTERCHANGE

prf = \\WATSON1\DATA\PL0T\PL463P\K01.PRF
date = Wed Sep 15 14:23:03 1999

DESIGN TEAM **Skogerboe / EARTH TECH**

METRIC

IOWA DOT * OFFICE OF DESIGN

Jones




COUNTY

PROJECT NUMBER



NHSX-151-4(63)-3H-53

SHEET NUMBER


K.01 59/90

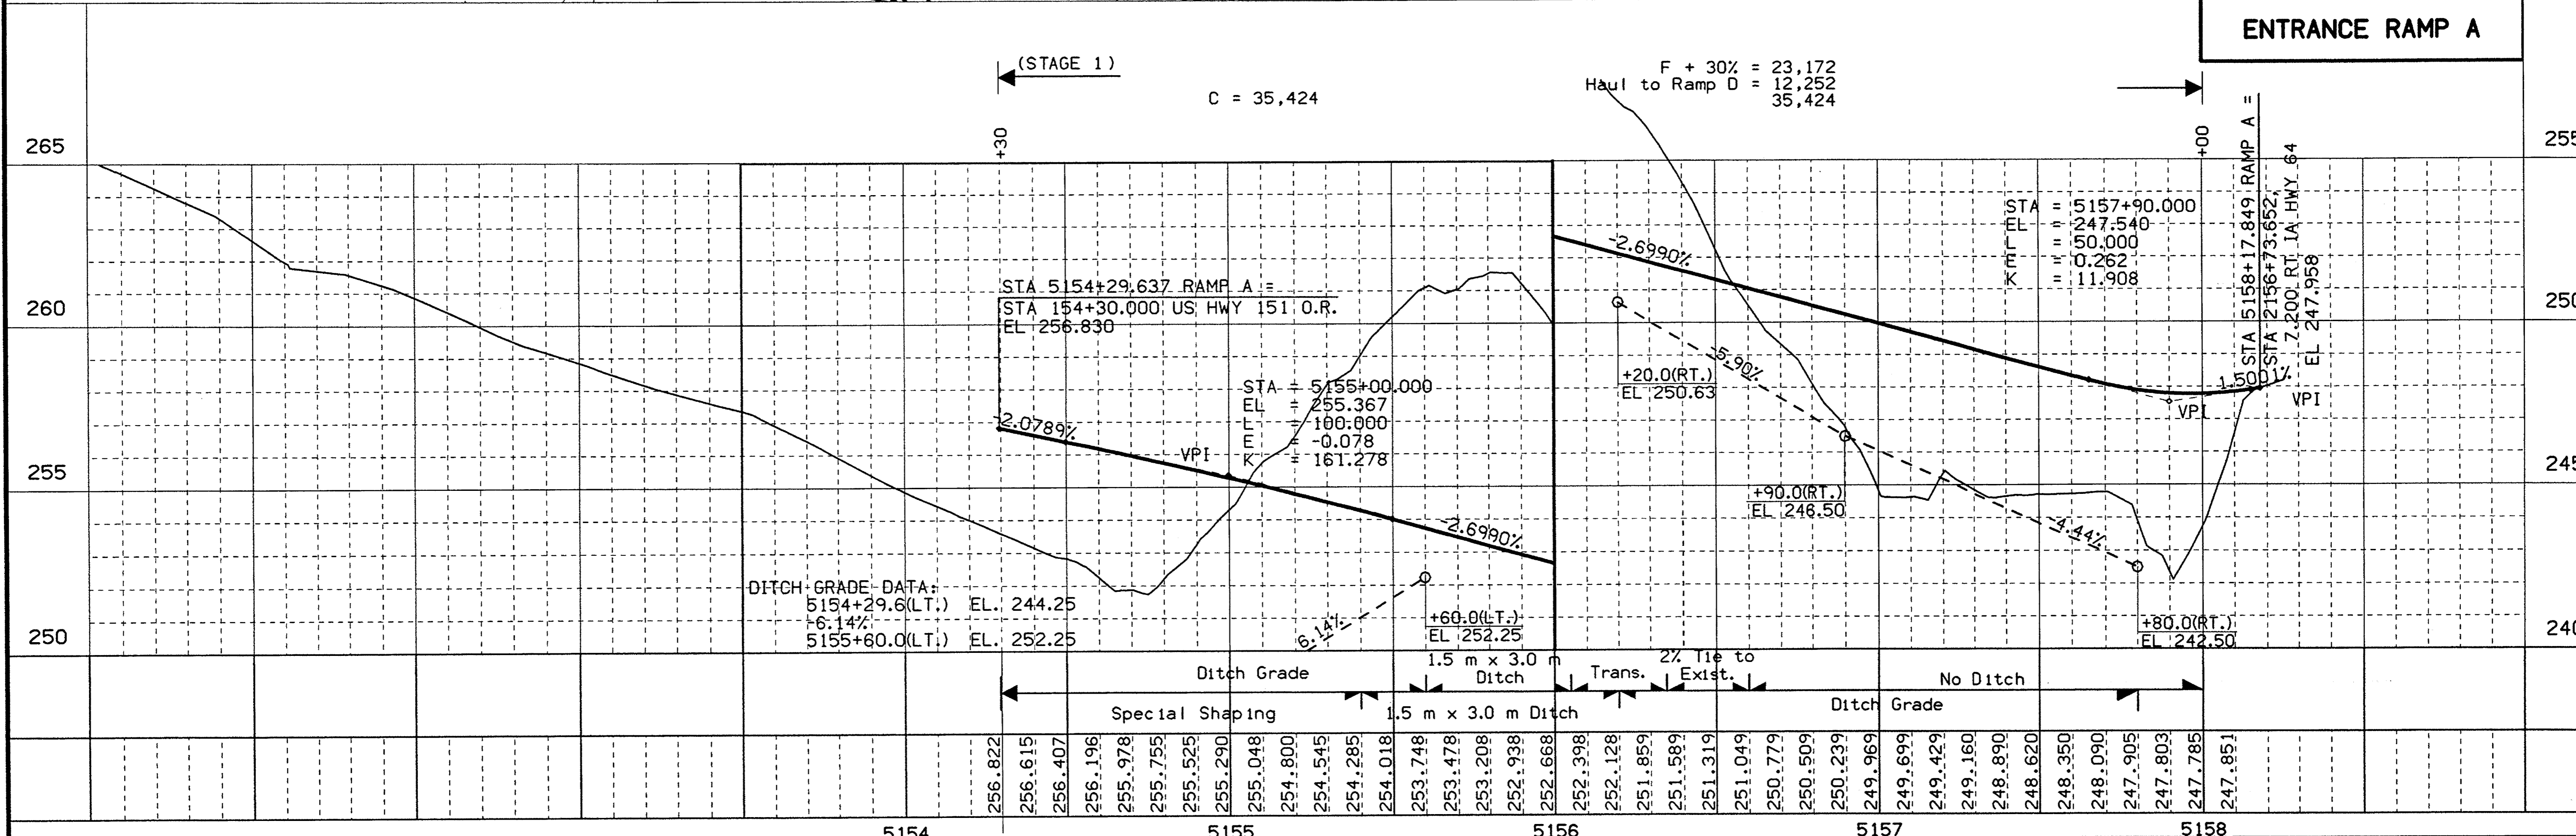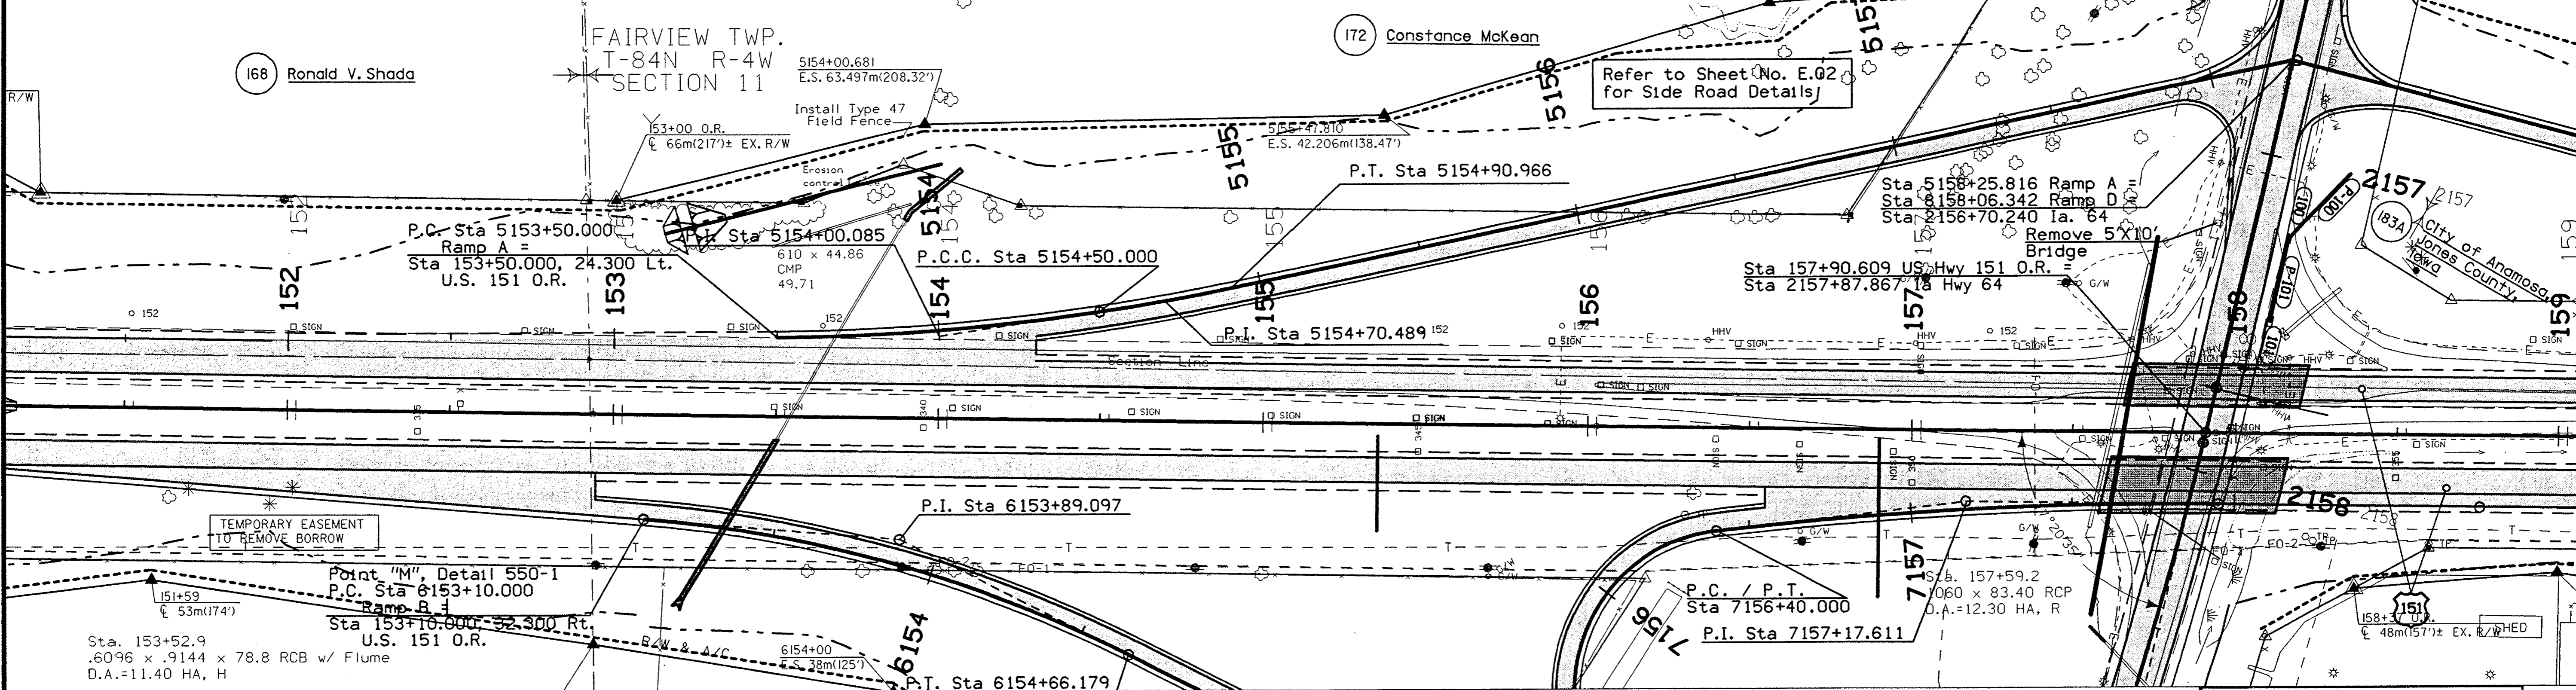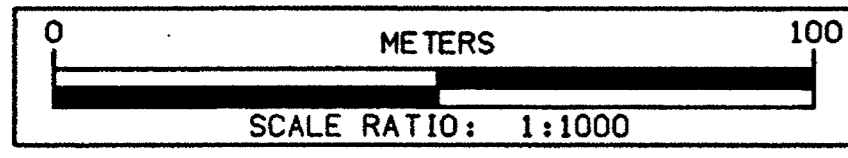

prf = \\WATSON\DATA\PLT\PL463P\K02.PRF
date = Fri Oct 29 10:56:47 1999

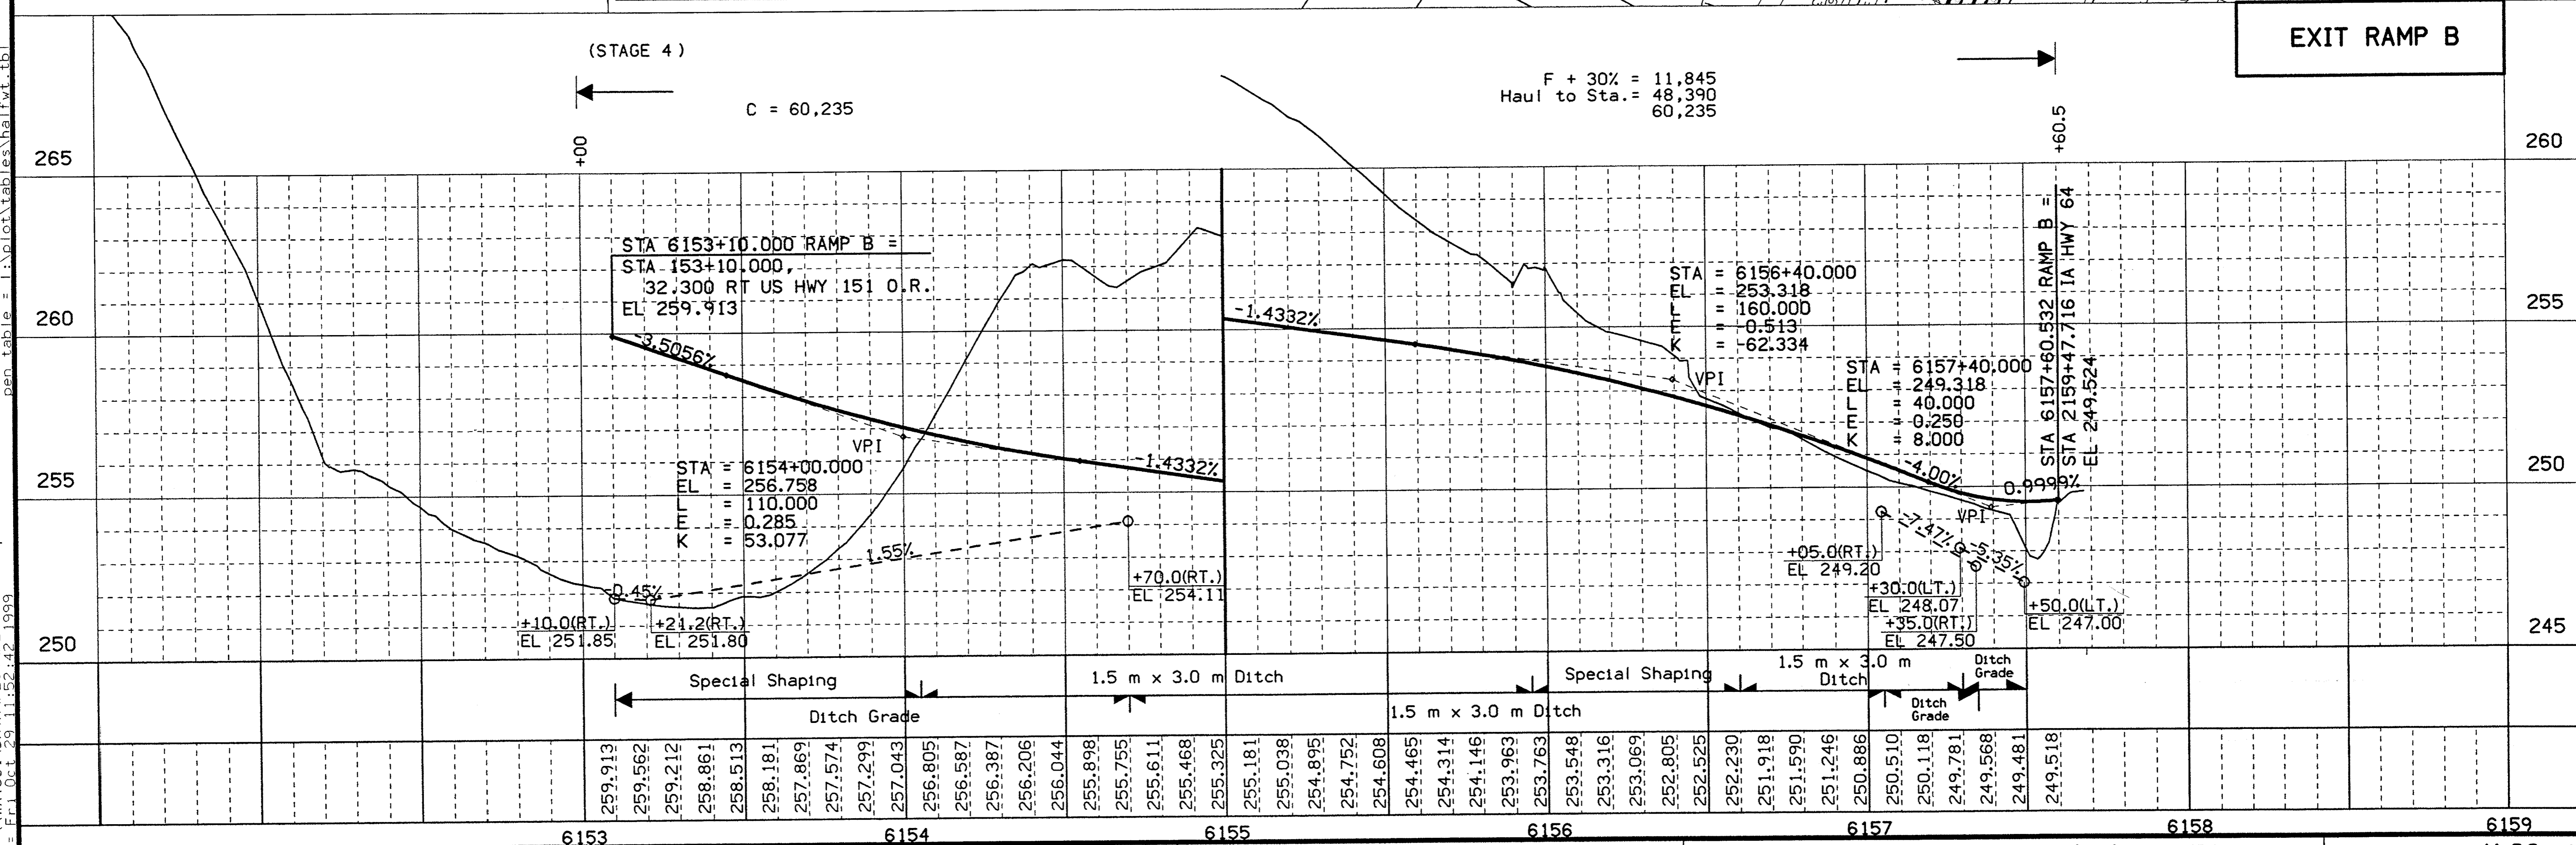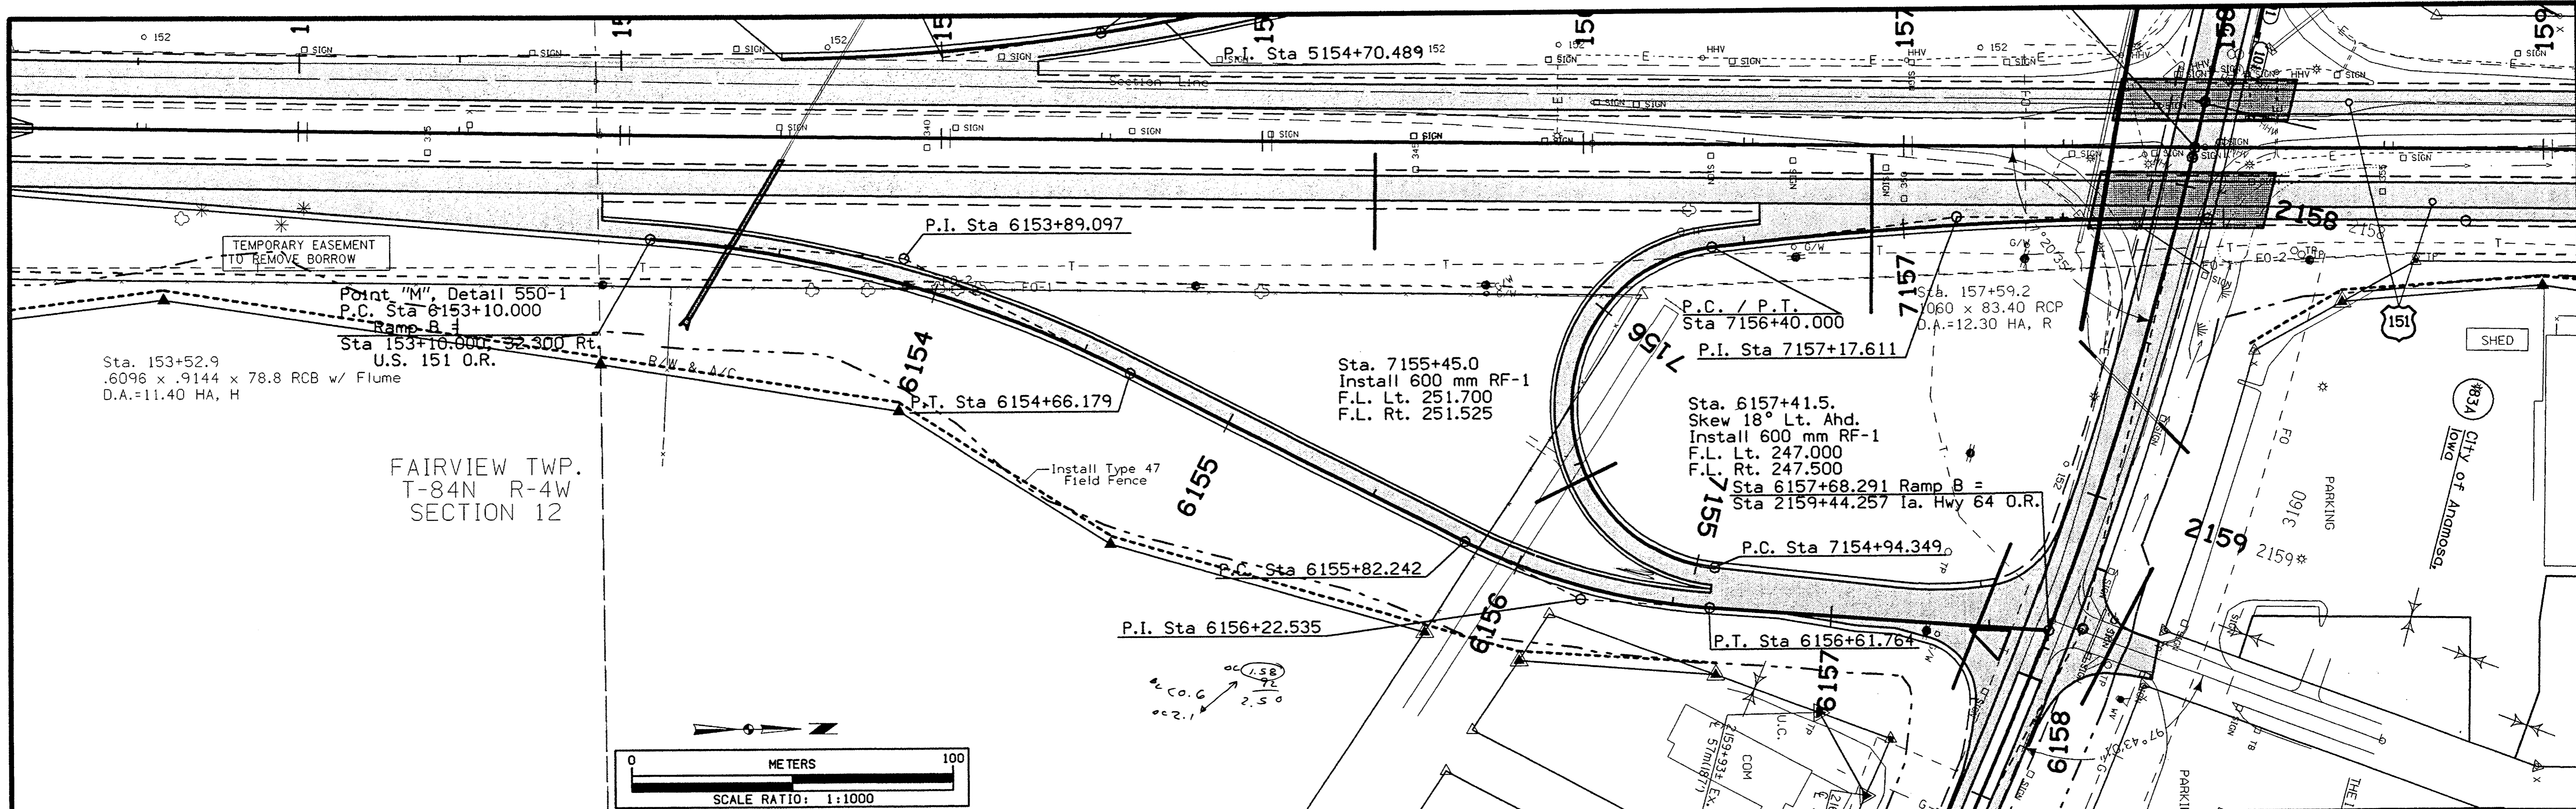


dgn = I:\work\project\34120\cadd\east\3151063.ku3
 levels = 1-4, 7, 8
 prf = \\WATSON1\DATA\PLT\PL463P\K03.prf
 date = Fri Oct 29 11:52:42 1999

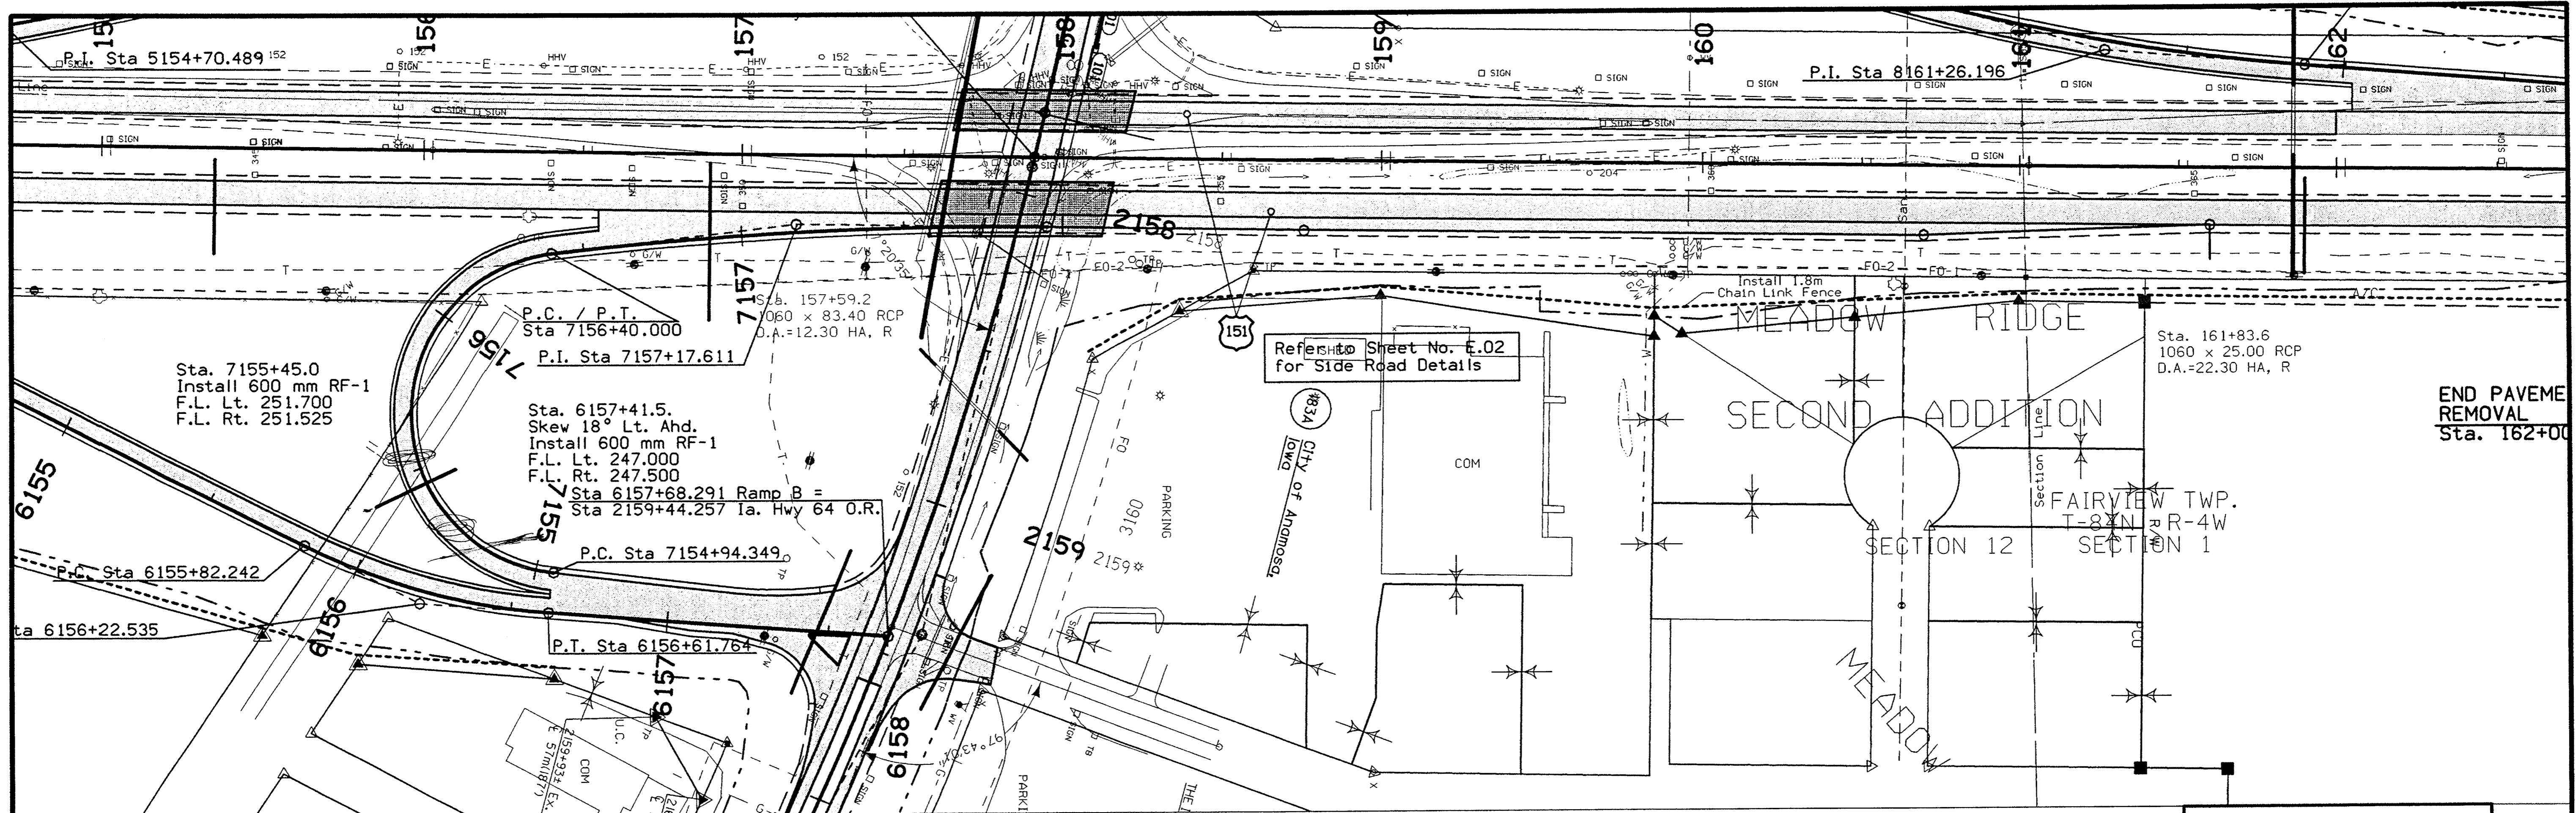

ENTRANCE LOOP C



(STAGE 4)
 C = 6,015
 $F + 30\% = 2,208$
 Haul to Sta. 156+70
 6,015

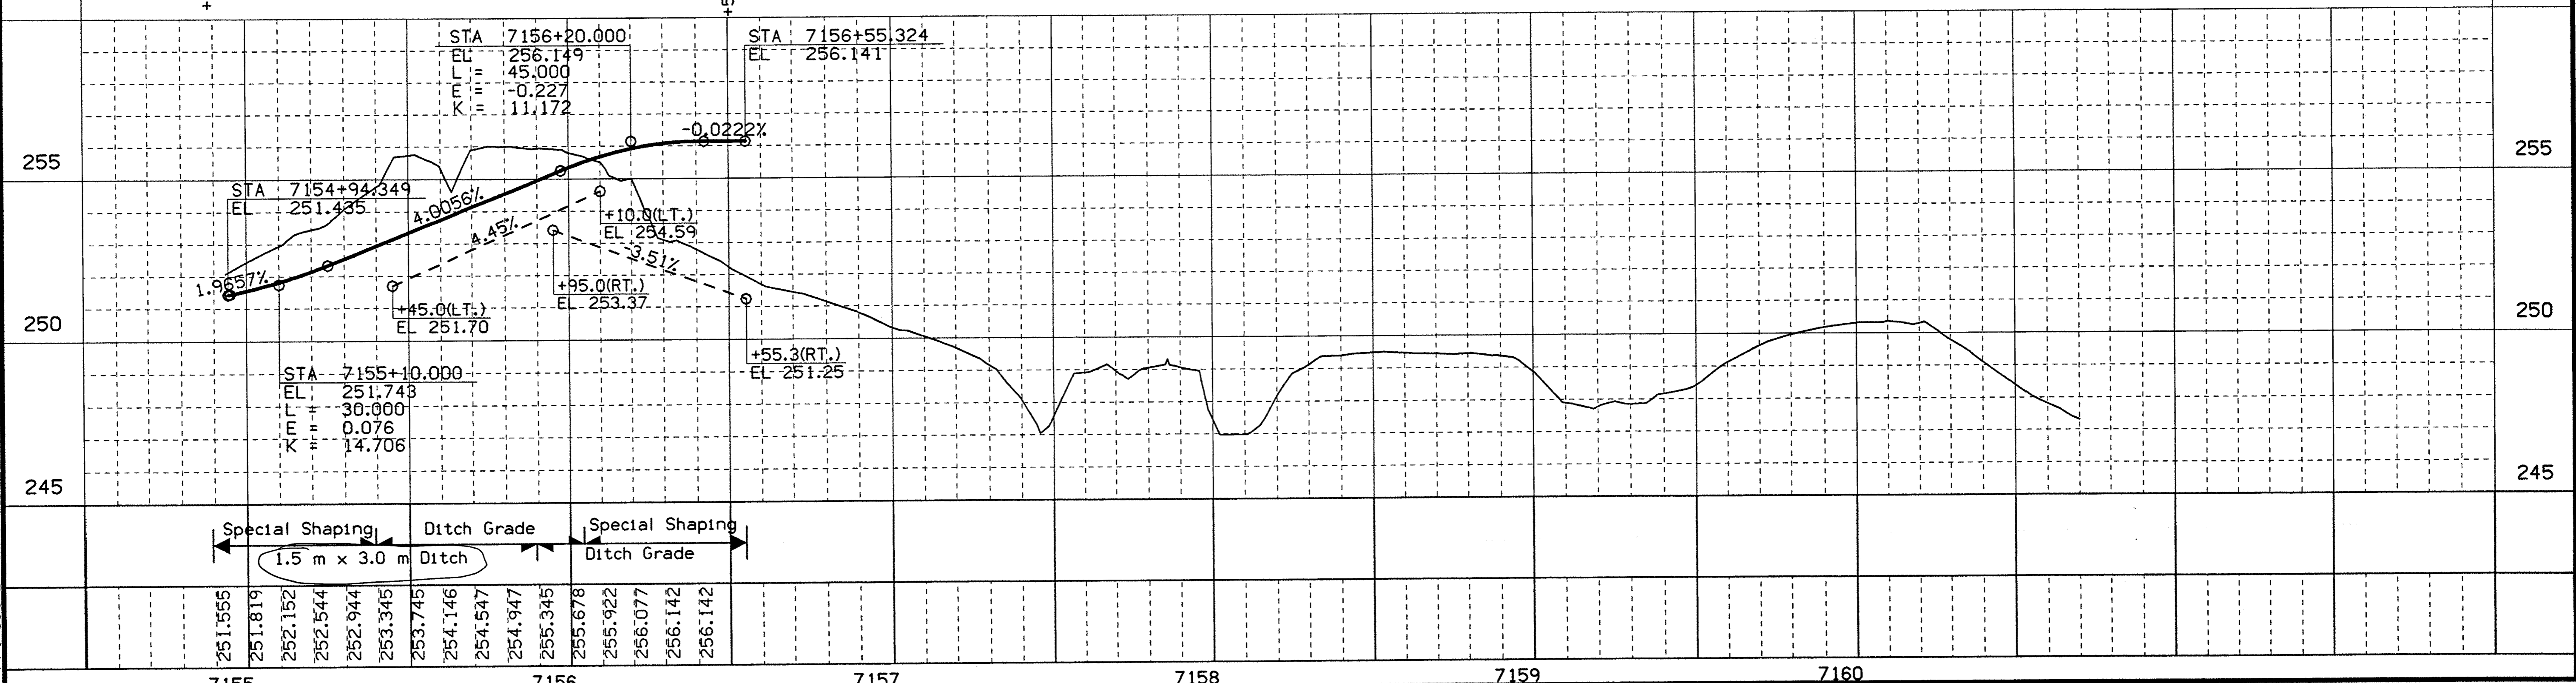

Special Shaping
 1.5 m x 3.0 m Ditch
 Ditch Grade
 Special Shaping
 Ditch Grade

251.555	251.819	252.152	252.544	252.944	253.345	253.745	254.146	254.547	254.947	255.345	255.678	255.922	256.077	256.142	256.142
7155						7156					7157			7158	

dgn = I:\work\project\34120\cadd\east\b31b1063.k04
 prf = \AWATS01\DA\TA\PL01\PL463P\K04.prf
 date = Fri Oct 29 11:53:01 1999
 level = 1-4,7,8
 pen table = I:\plot\tables\halfwt.tbl

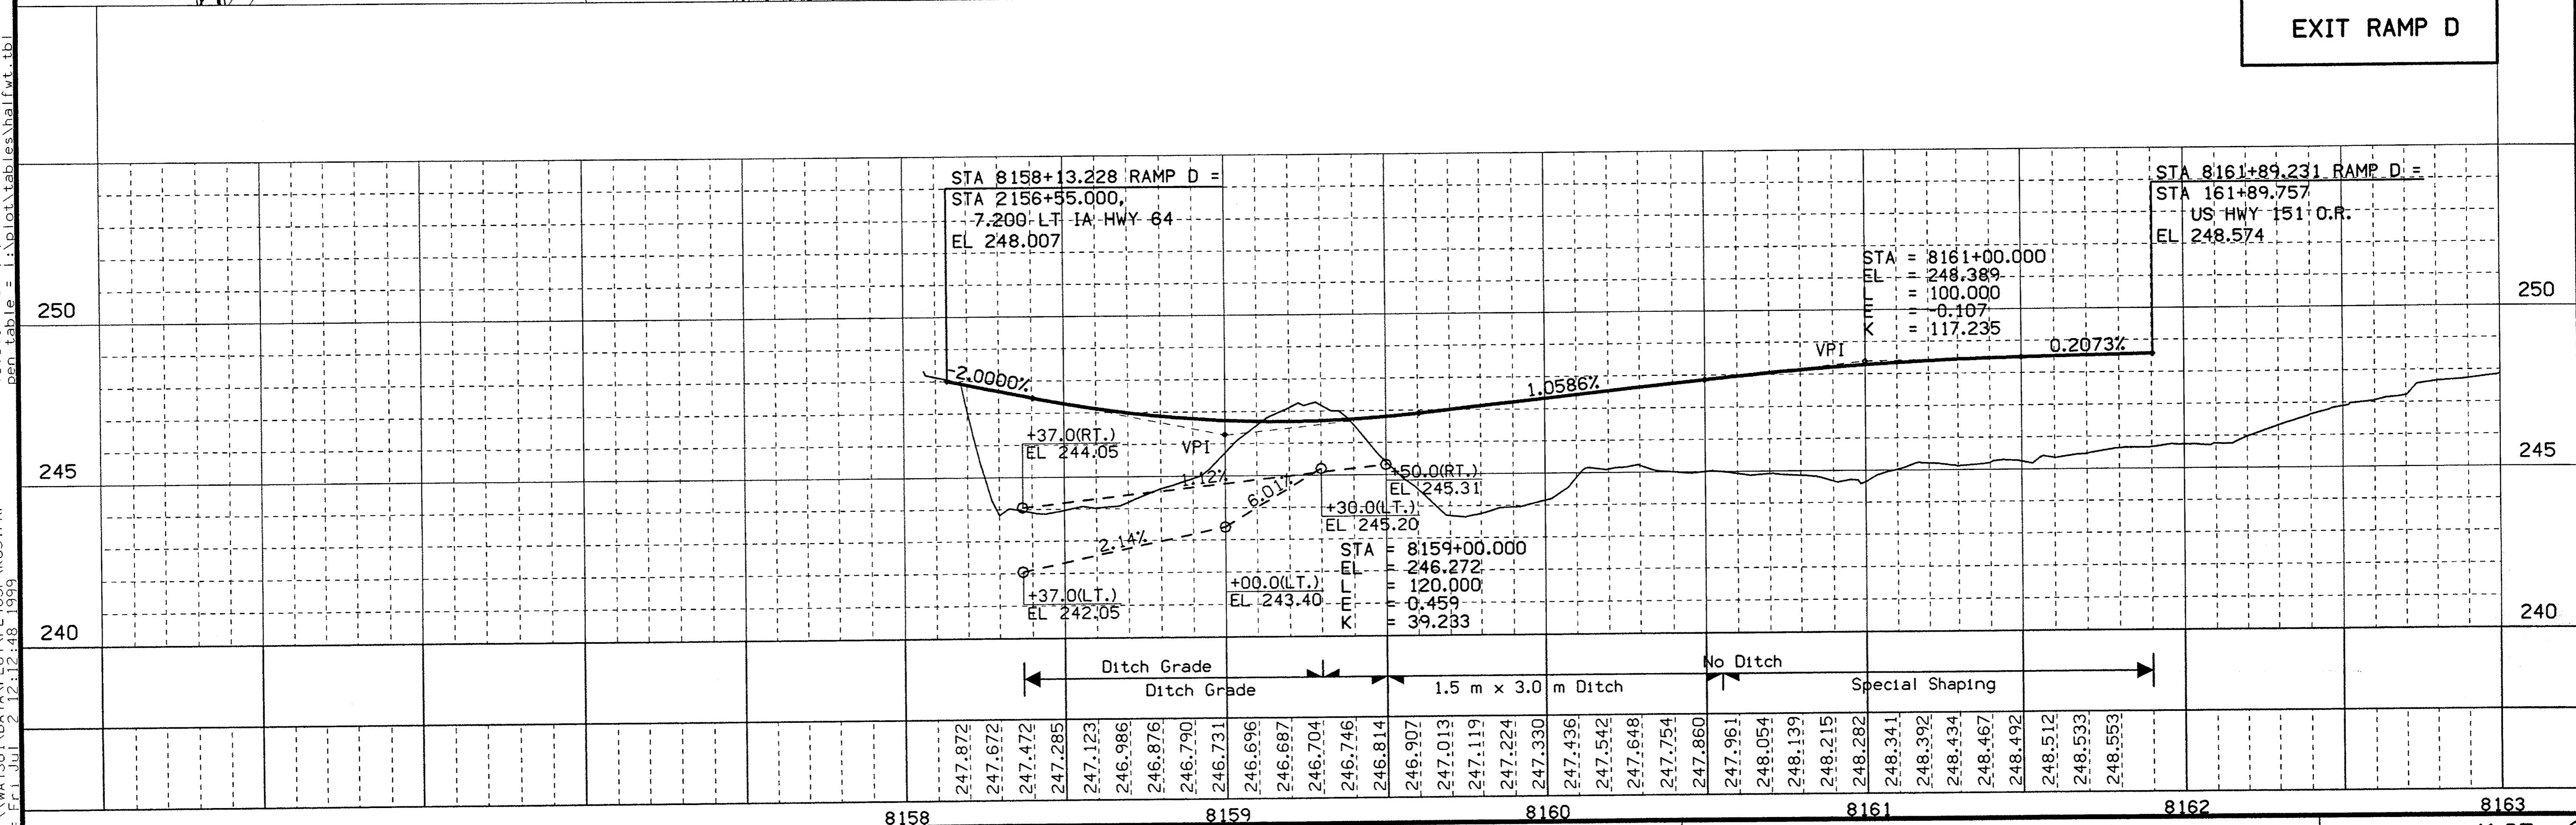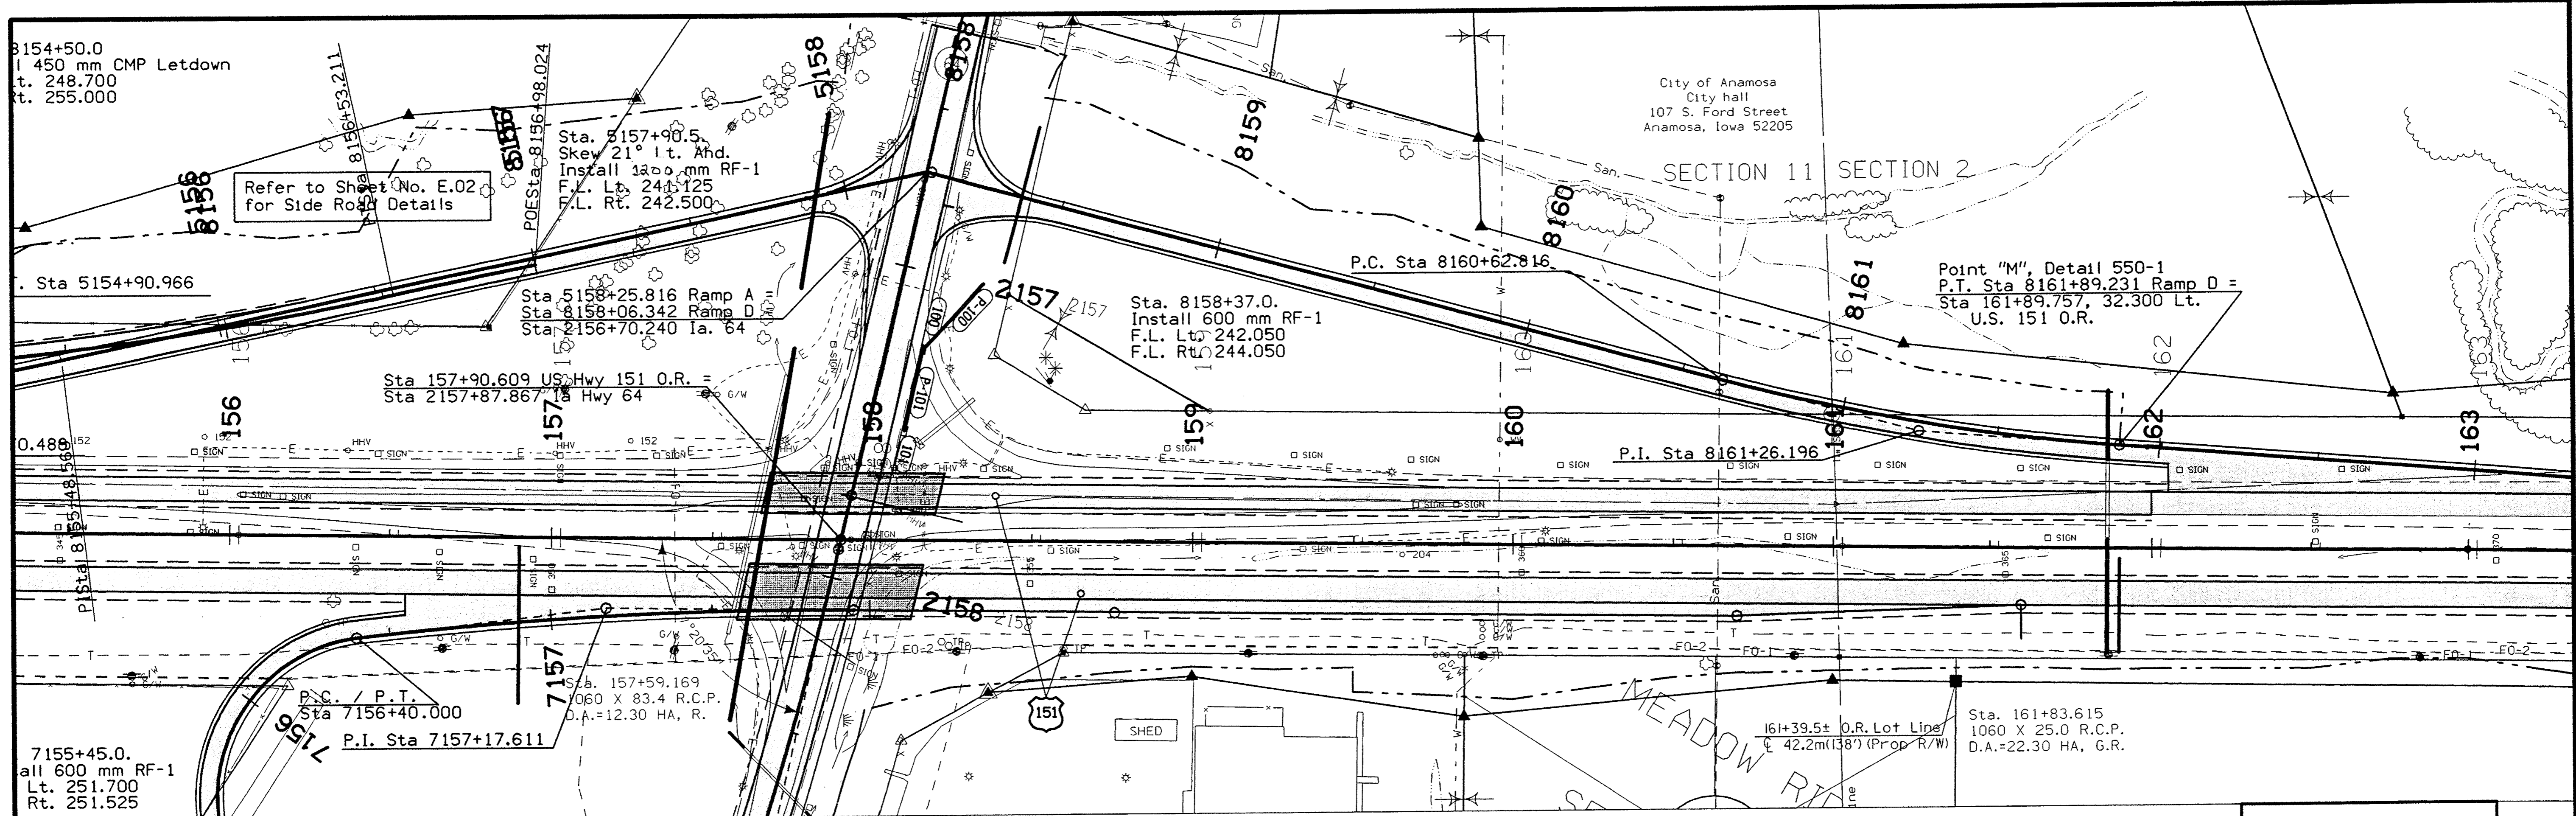

dgn = L:\WORK\PROJECT\34120\CADD\EAST\53151063.K05
 prf = \WA\501\DA\PL\PL\PL\463\K05.PRF
 date = Fri Jul 2 12:12:48 1999
 levels = 1-4, 7, 8
 pen table = I:\lot\tables\half.tbl

EXIT RAMP D

STA 8158+13.228 RAMP D =
 STA 2156+55.000,
 -7.200 LT IA HWY 64
 EL 248.007

STA 8161+89.231 RAMP D =
 STA 161+89.757
 US HWY 151 O.R.
 EL 248.574

STA = 8161+00.000
 EL = 248.389
 = 100.000
 = -0.107
 = 117.235

← Ditch Grade Ditch Grade 1.5 m x 3.0 m Ditch No Ditch Special Shaping →


247.872	247.672	247.472	247.285	247.123	246.986	246.876	246.790	246.731	246.696	246.687	246.704	246.746	246.814	246.907	247.013	247.119	247.224	247.330	247.436	247.542	247.648	247.754	247.860	247.961	248.054	248.139	248.215	248.282	248.341	248.392	248.434	248.467	248.492	248.512	248.533	248.553																							
8158										8159										8160										8161										8162										8163									

CIRCULAR CURVE DATA

101-10C
09-27-94

NO.	Δ	R	T	L	E
A-1	63.965	15	9.367	16.746	15
A-2	27.532	60	14.699	28.831	60
A-3	73.568	25	18.691	32.100	25
A-4	12.064	70	7.397	14.739	70
A-5	46.003	33	14.009	26.496	33
A-6	18.652	60	9.853	19.532	60
A-7	105.860	15	19.855	27.714	15

* NOTE:
Elevations to be confirmed
at time of construction.

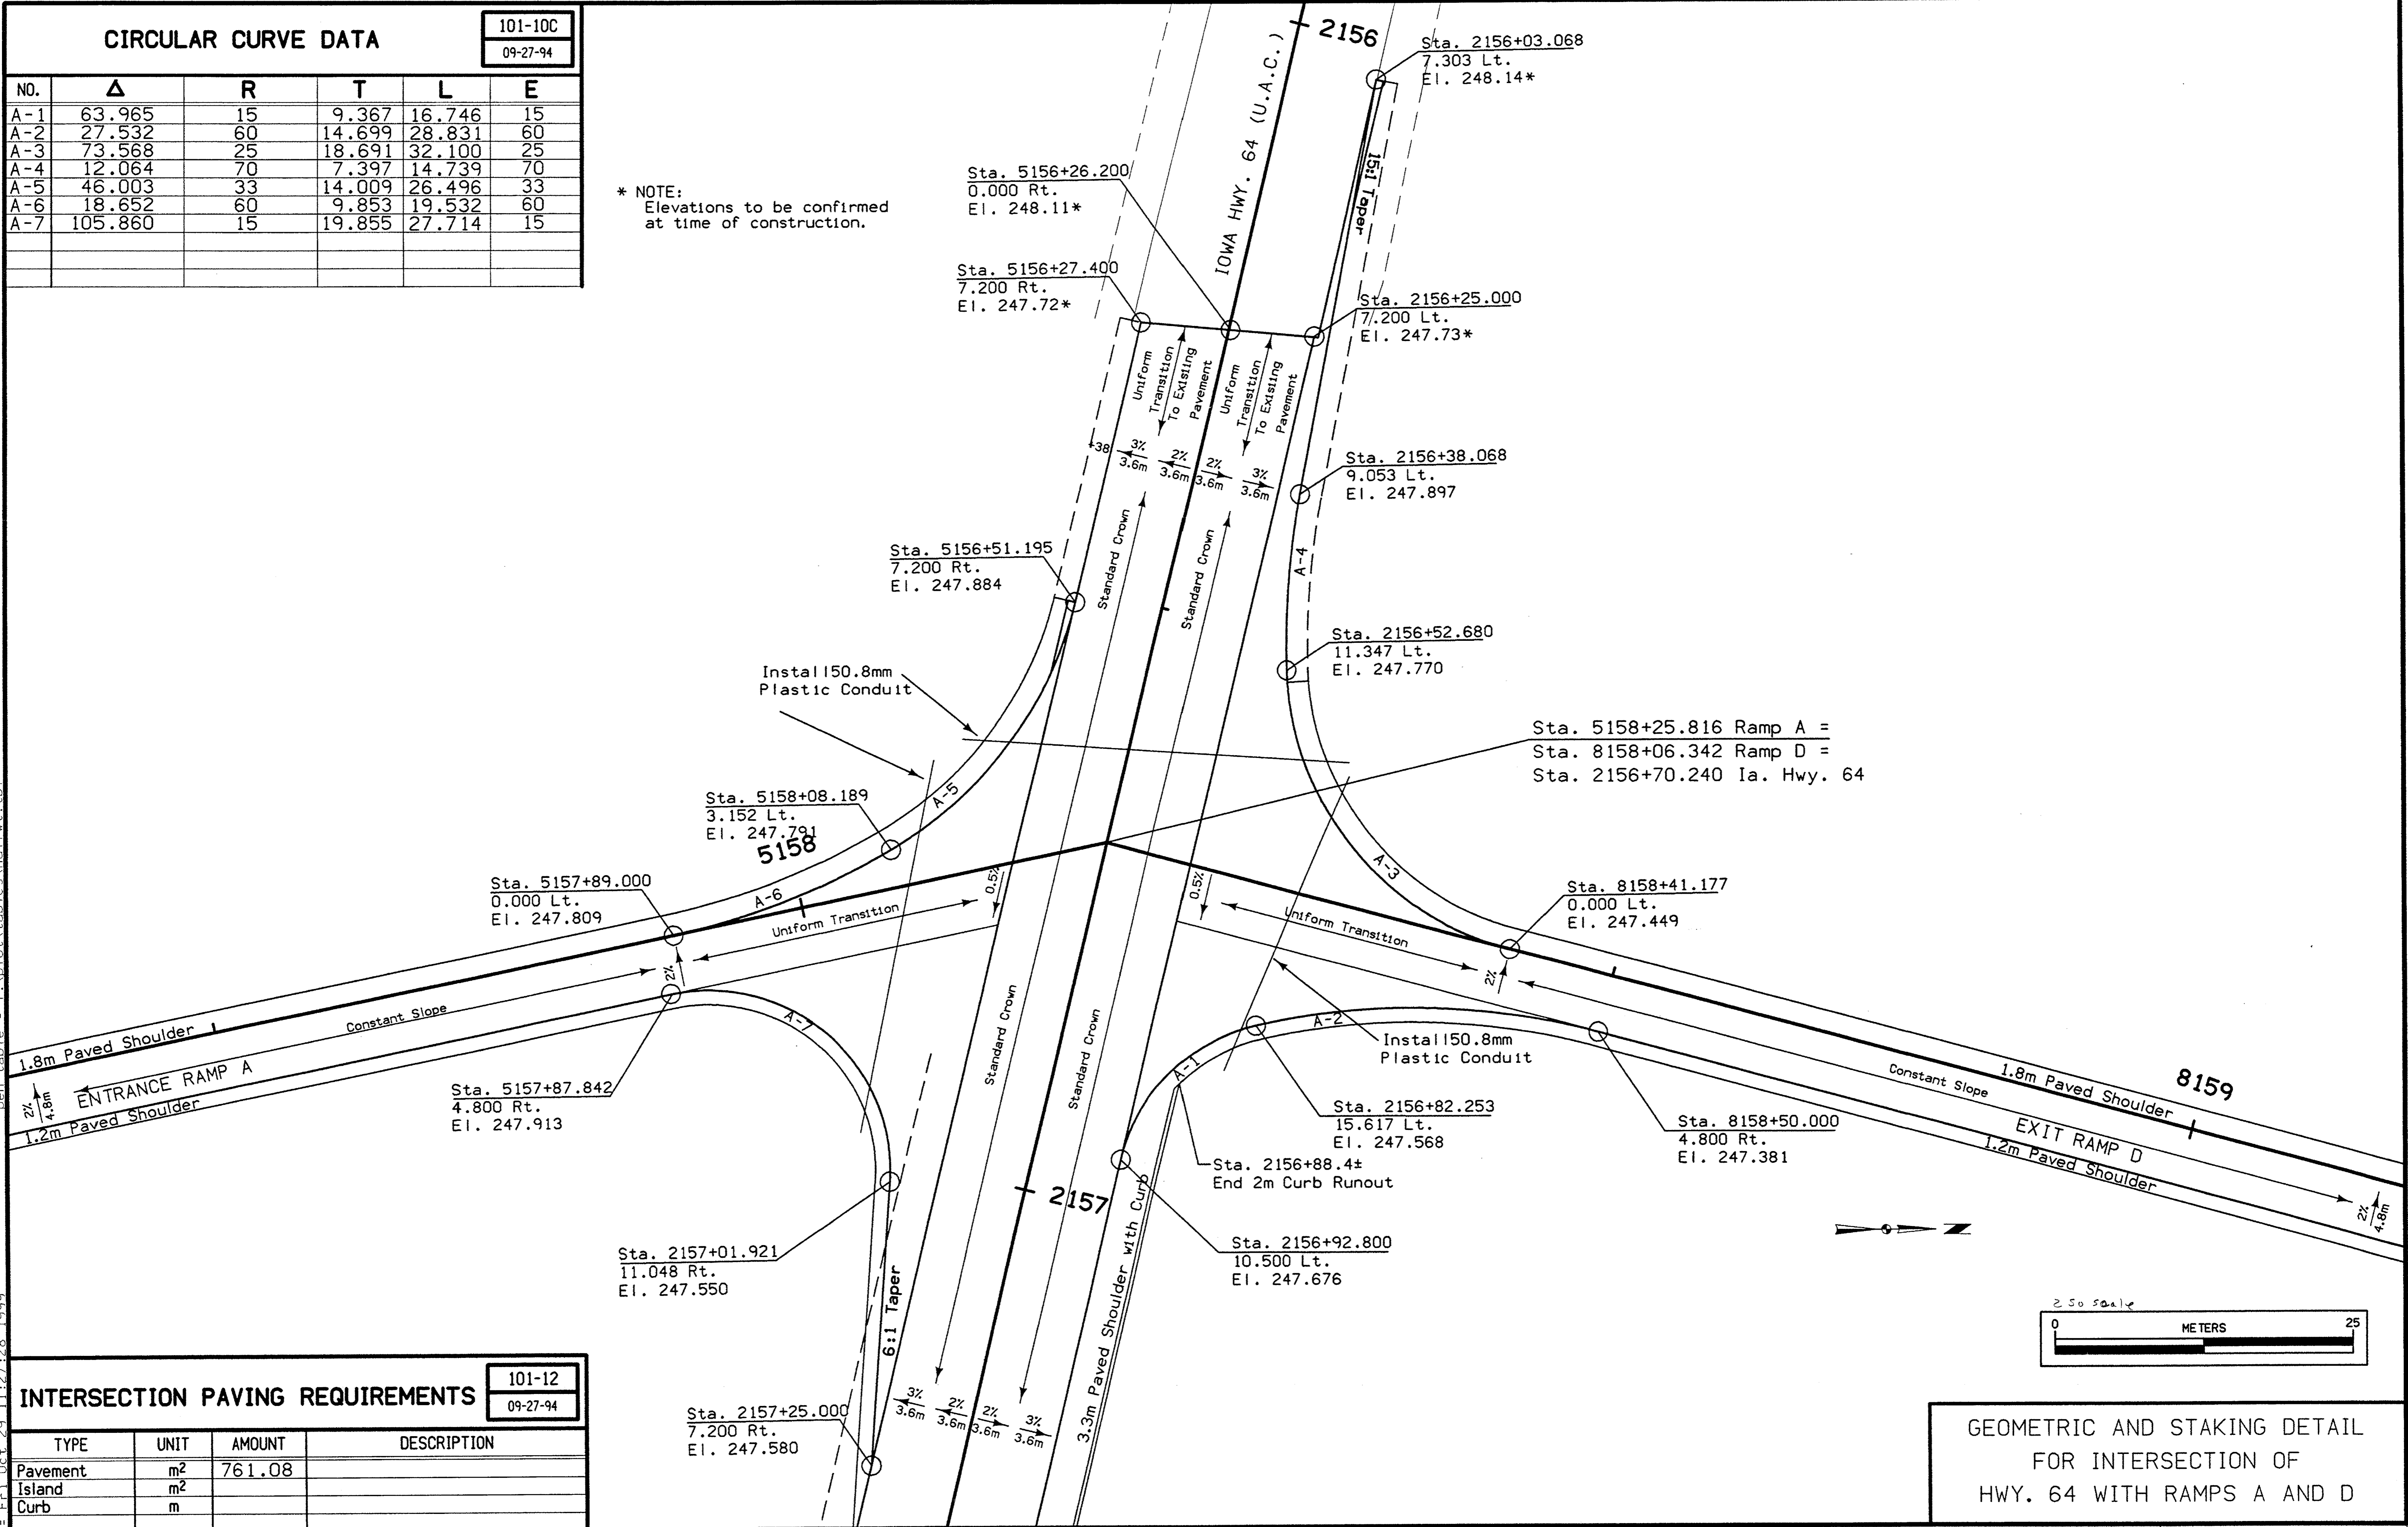

INTERSECTION PAVING REQUIREMENTS


101-12
09-27-94

TYPE	UNIT	AMOUNT	DESCRIPTION
Pavement	m ²	761.08	
Island	m ²		
Curb	m		

GEOMETRIC AND STAKING DETAIL
FOR INTERSECTION OF
HWY. 64 WITH RAMPS A AND D

dgn = I:\work\project\34120\cadd\east\53151063.k06
 prf = \\WATSON1\DATA\PLT\PL463P\K06.prf
 date = Fri Oct 29 11:27:28 1999

dgn = L:\WORK\PROJECTS\134120\CAUDAE5\153151063.K08
 prf = \WA1501\DATA\PL01\PL463P\K08.PRF
 date = Wed Jun 30 12:59:21 1999
 levels = 1-63
 pen table = L:\plot\tables\hplwt.tbl

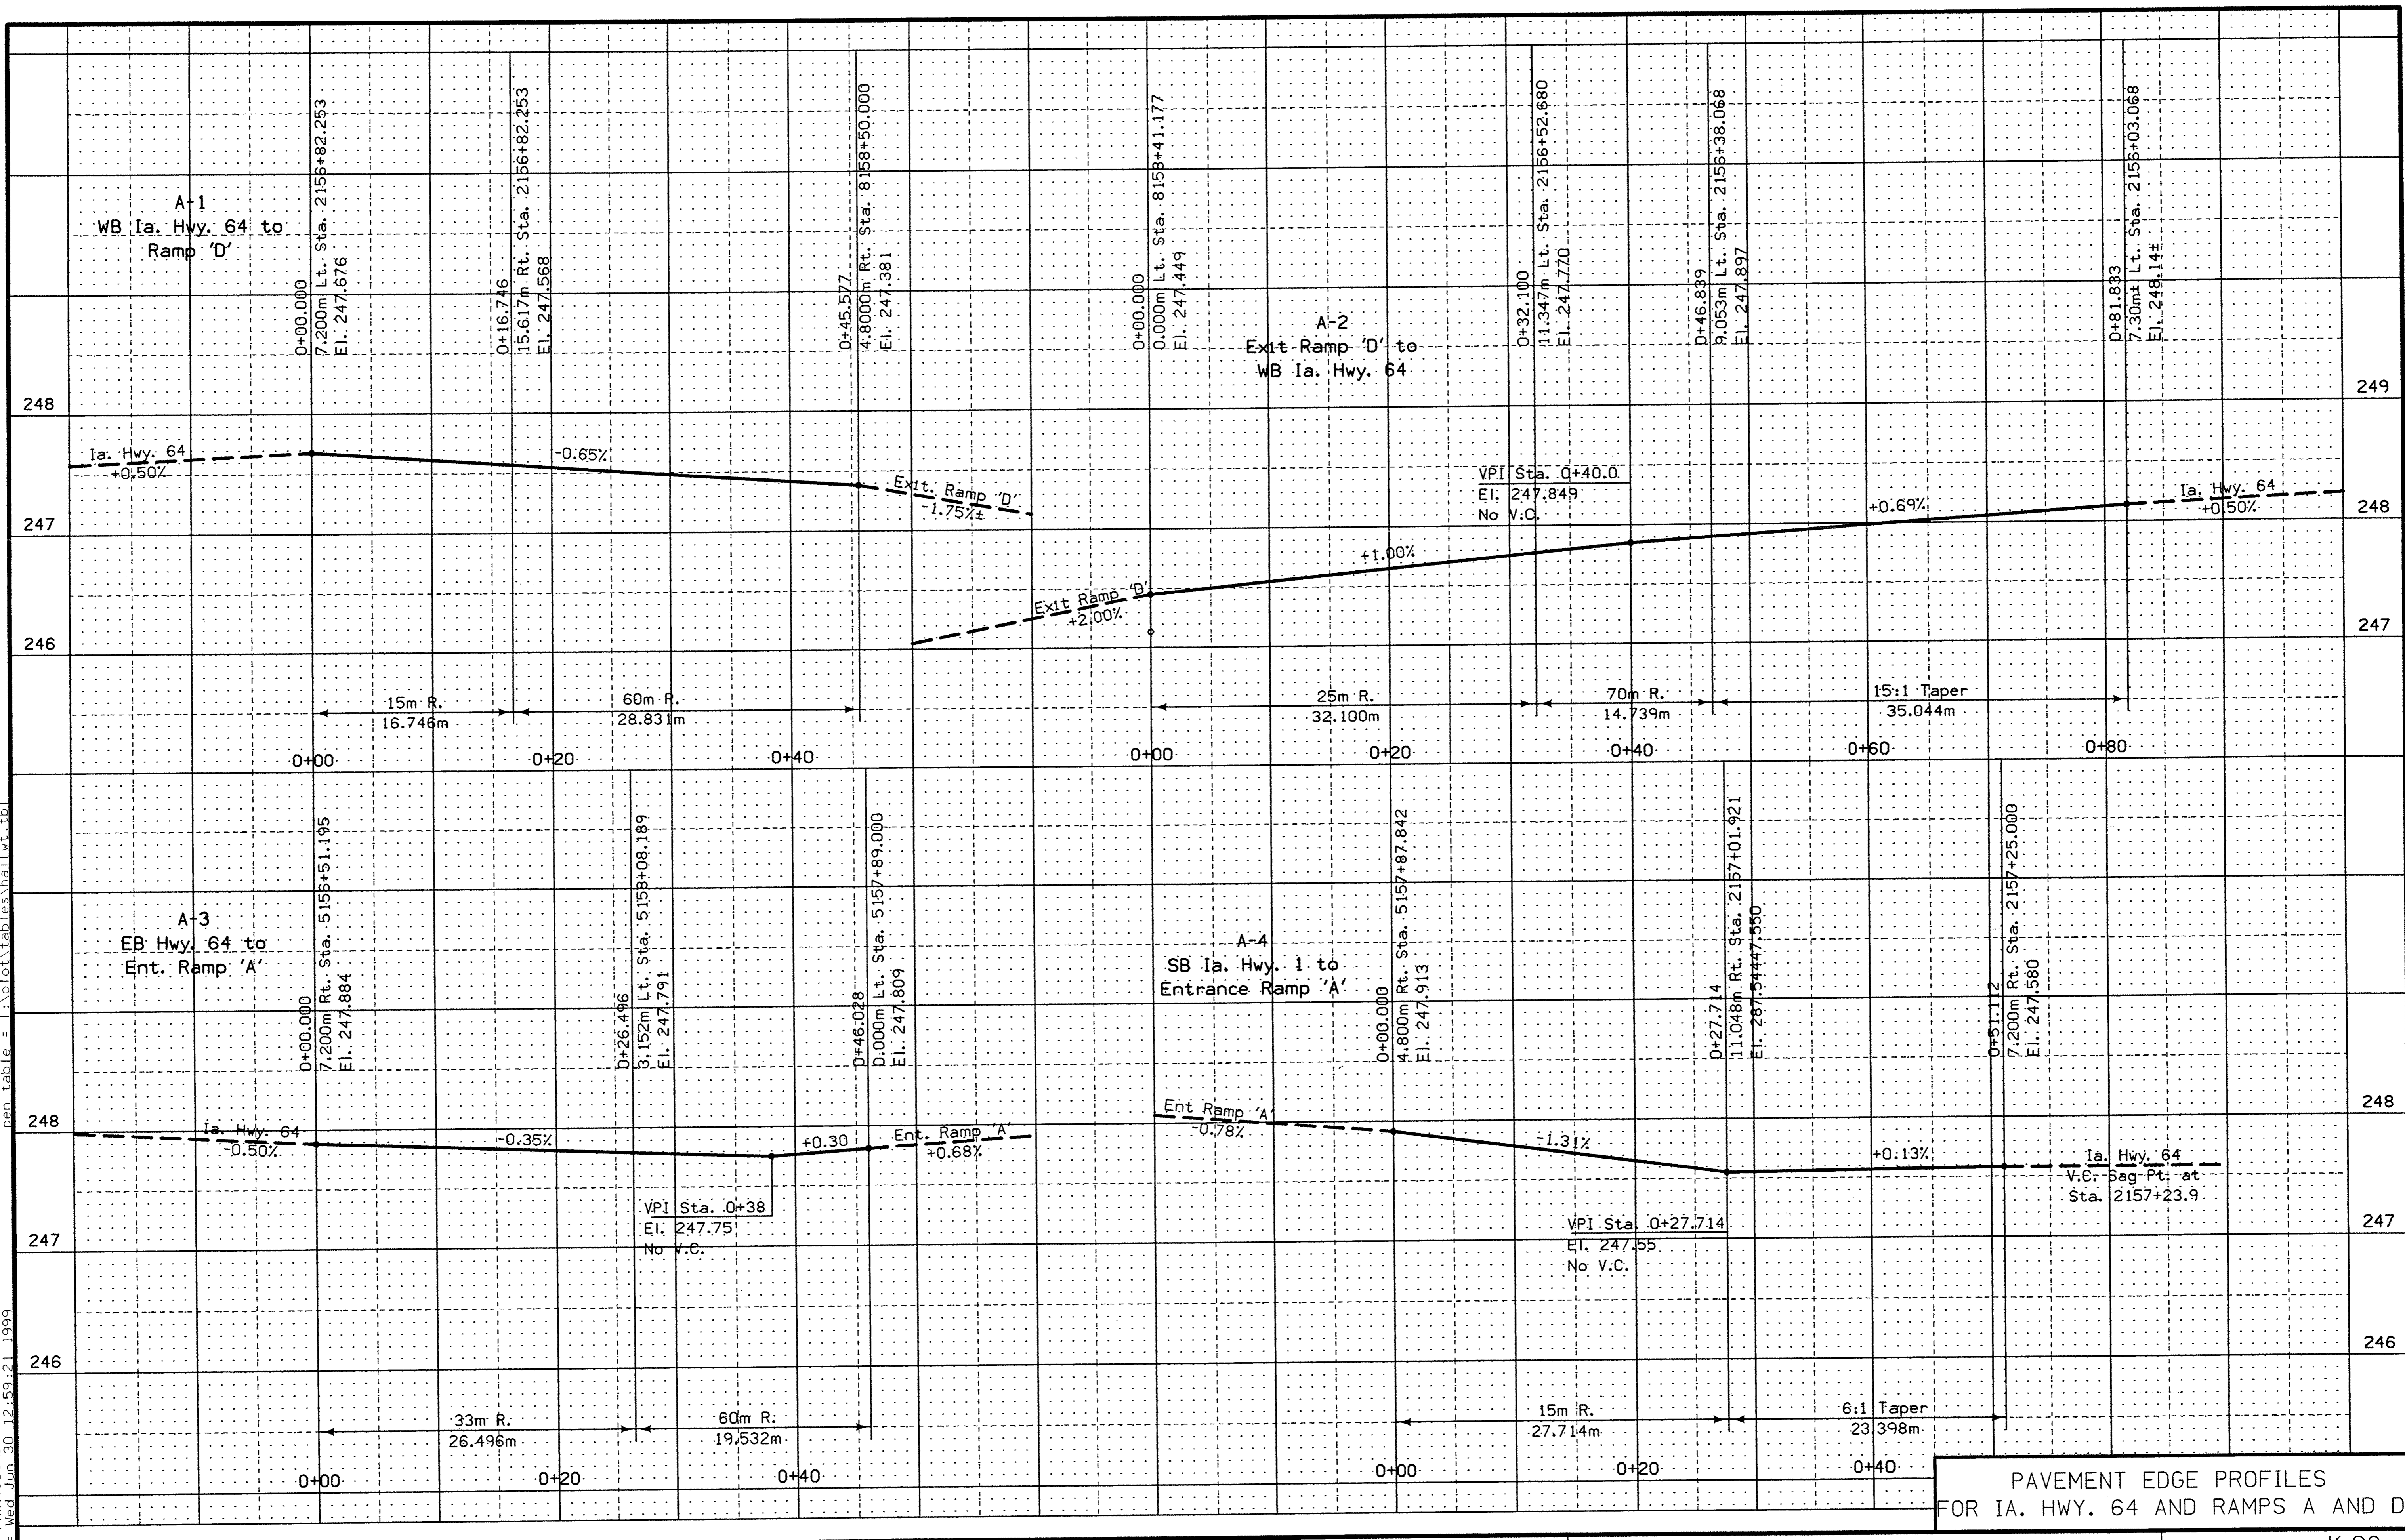


PAVEMENT EDGE PROFILES
 FOR IA. HWY. 64 AND RAMPS A AND D

Revised

CIRCULAR CURVE DATA

101-10C
09-27-94

NO.	Δ	R	T	L	E
B-1	12.100	75	7.949	15.839	0.420
B-2	51.197	25	11.977	22.339	2.721
B-3	14.069	120	14.807	29.466	0.910
B-4	80.363	20	16.890	28.052	6.178
B-5	16.738	120	17.653	35.055	1.292
B-6	16.683	60	8.797	17.470	0.641
B-7	55.359	20	10.491	19.324	2.585
B-8	7.161	100	6.257	12.498	0.196
B-9	89.420	15	14.849	23.410	6.107

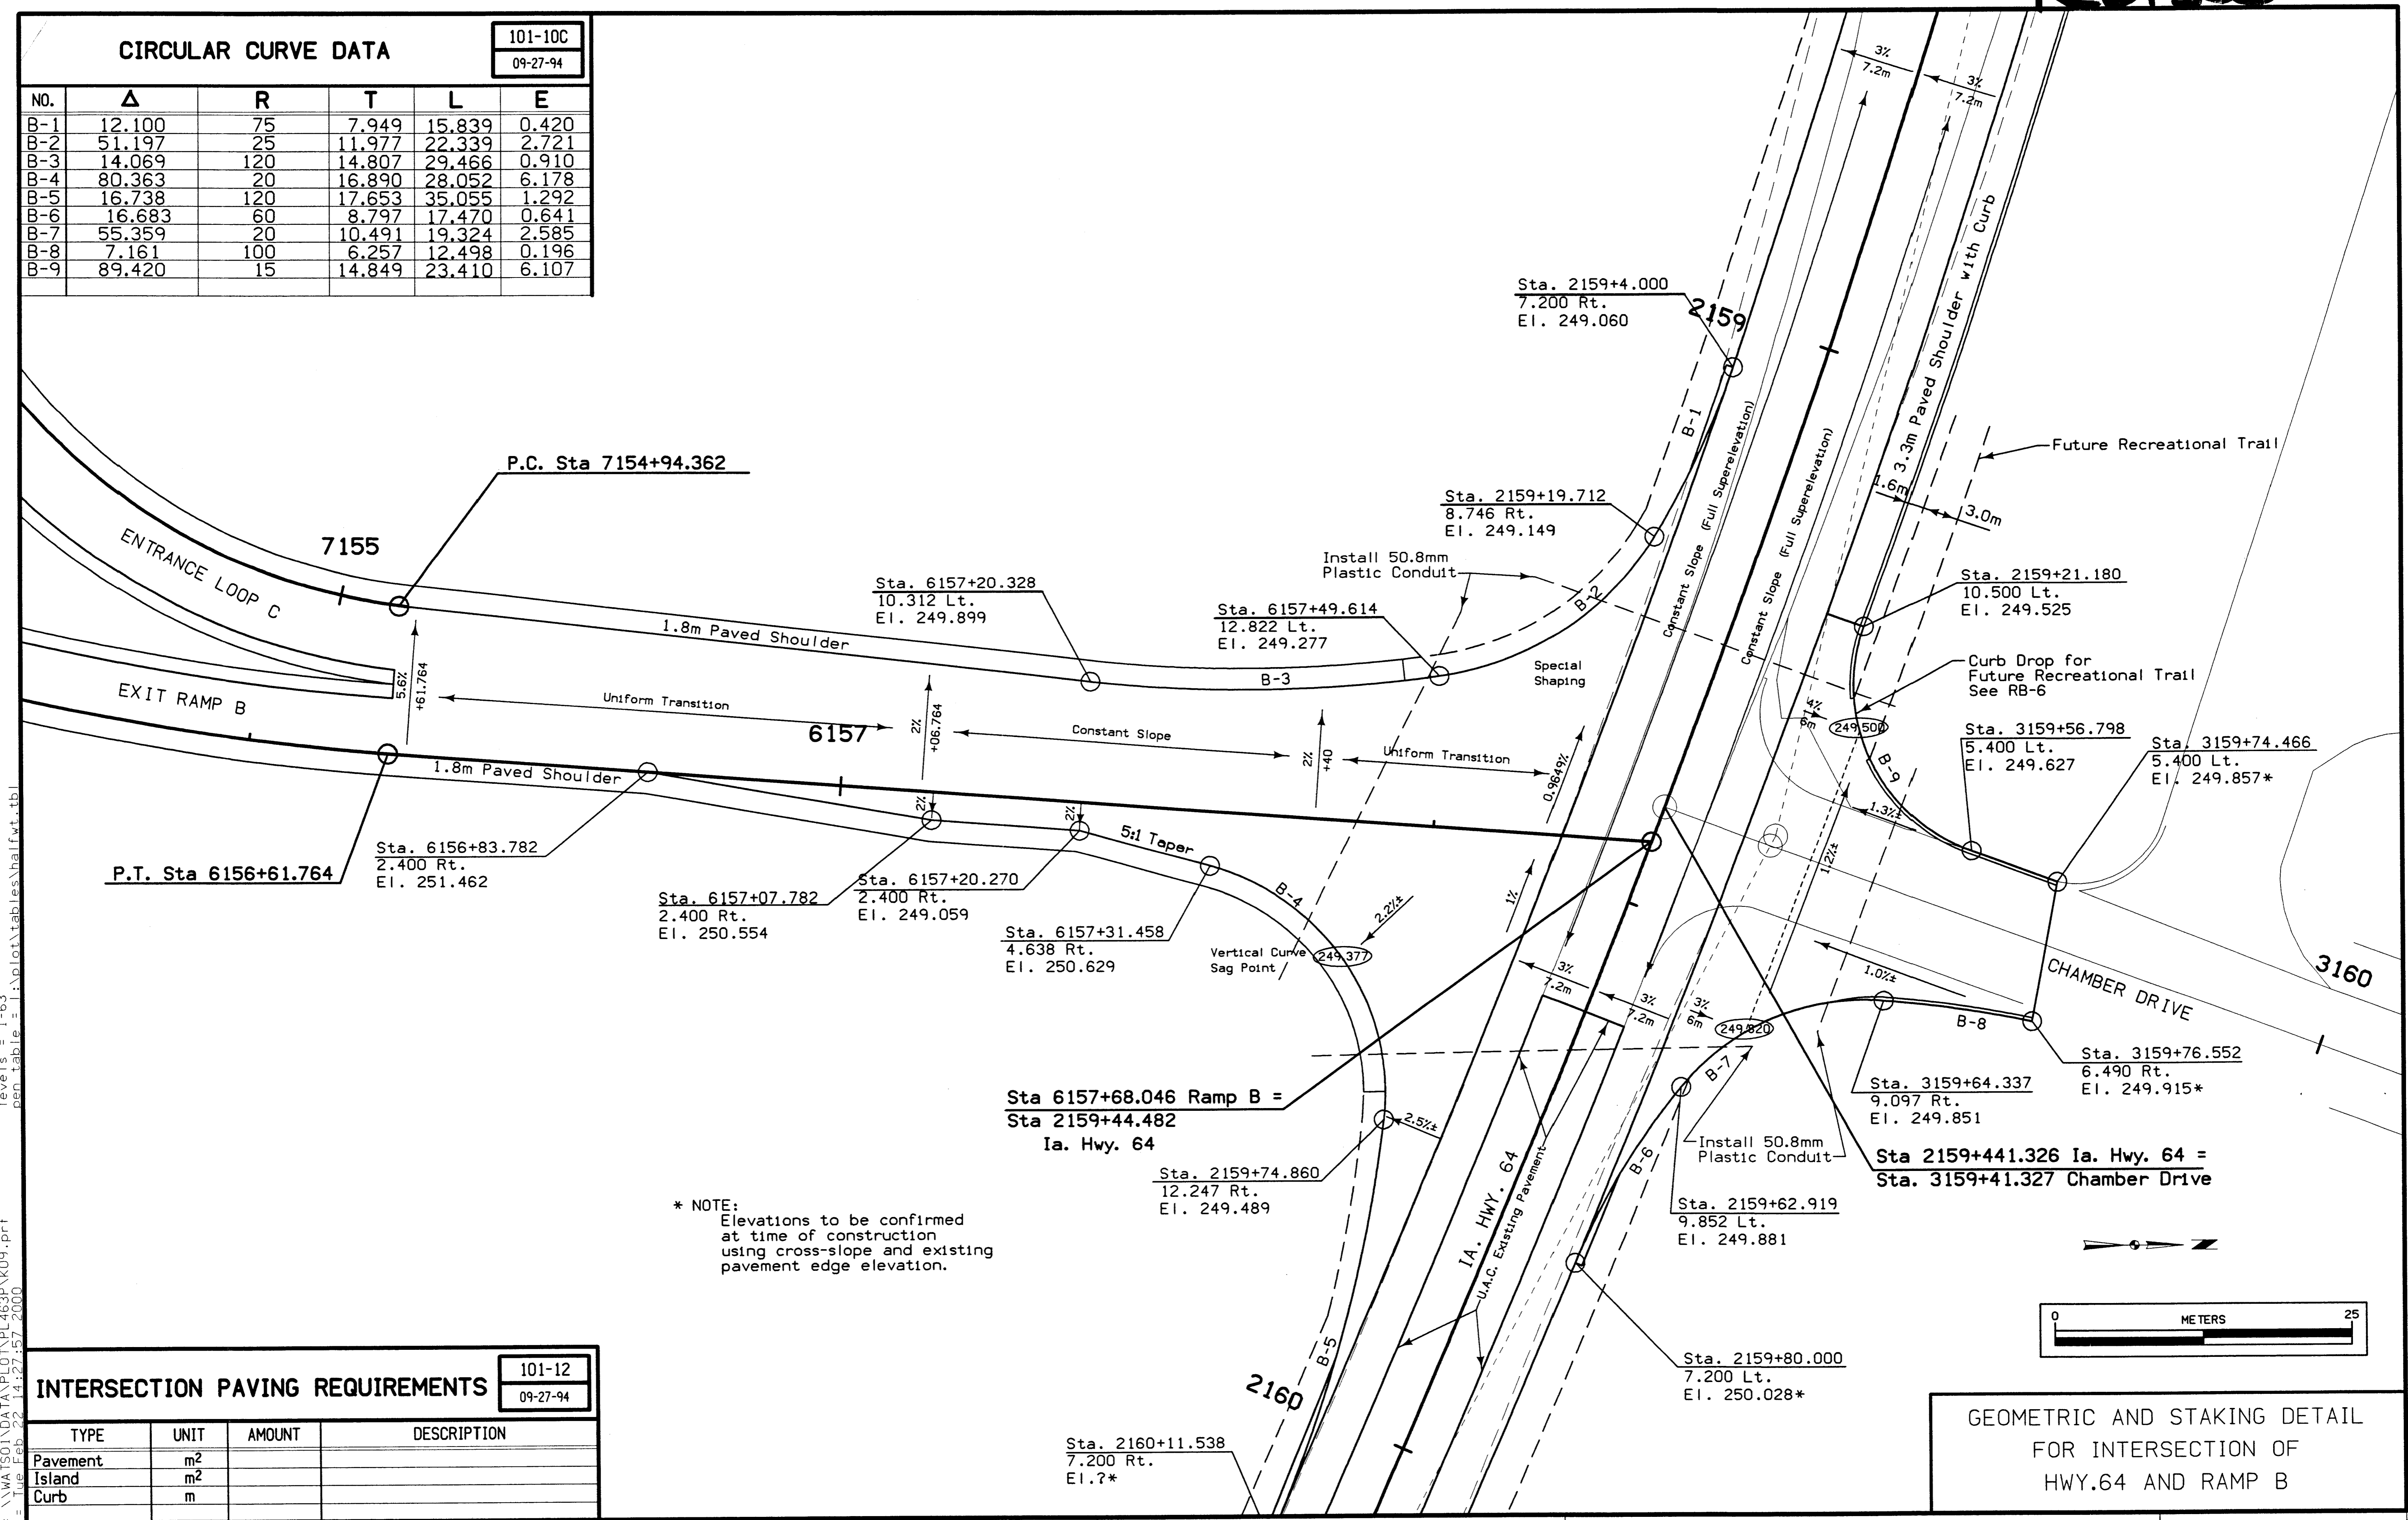

* NOTE:
Elevations to be confirmed
at time of construction
using cross-slope and existing
pavement edge elevation.

INTERSECTION PAVING REQUIREMENTS


101-12
09-27-94

TYPE	UNIT	AMOUNT	DESCRIPTION
Pavement	m ²		
Island	m ²		
Curb	m		

GEOMETRIC AND STAKING DETAIL
FOR INTERSECTION OF
HWY.64 AND RAMP B

dgn = I:\WORK\proj\sect\34120\csdd\seast\53151063.k09
 prf = I:\WA\SOI\DA\TA\NP\OT\16\639\K09.prf
 date = Tue Feb 22 14:21:57 2000
 pgn table = I:\pilot\tables\half\wt.tbl
 levels = 1-63

Revised

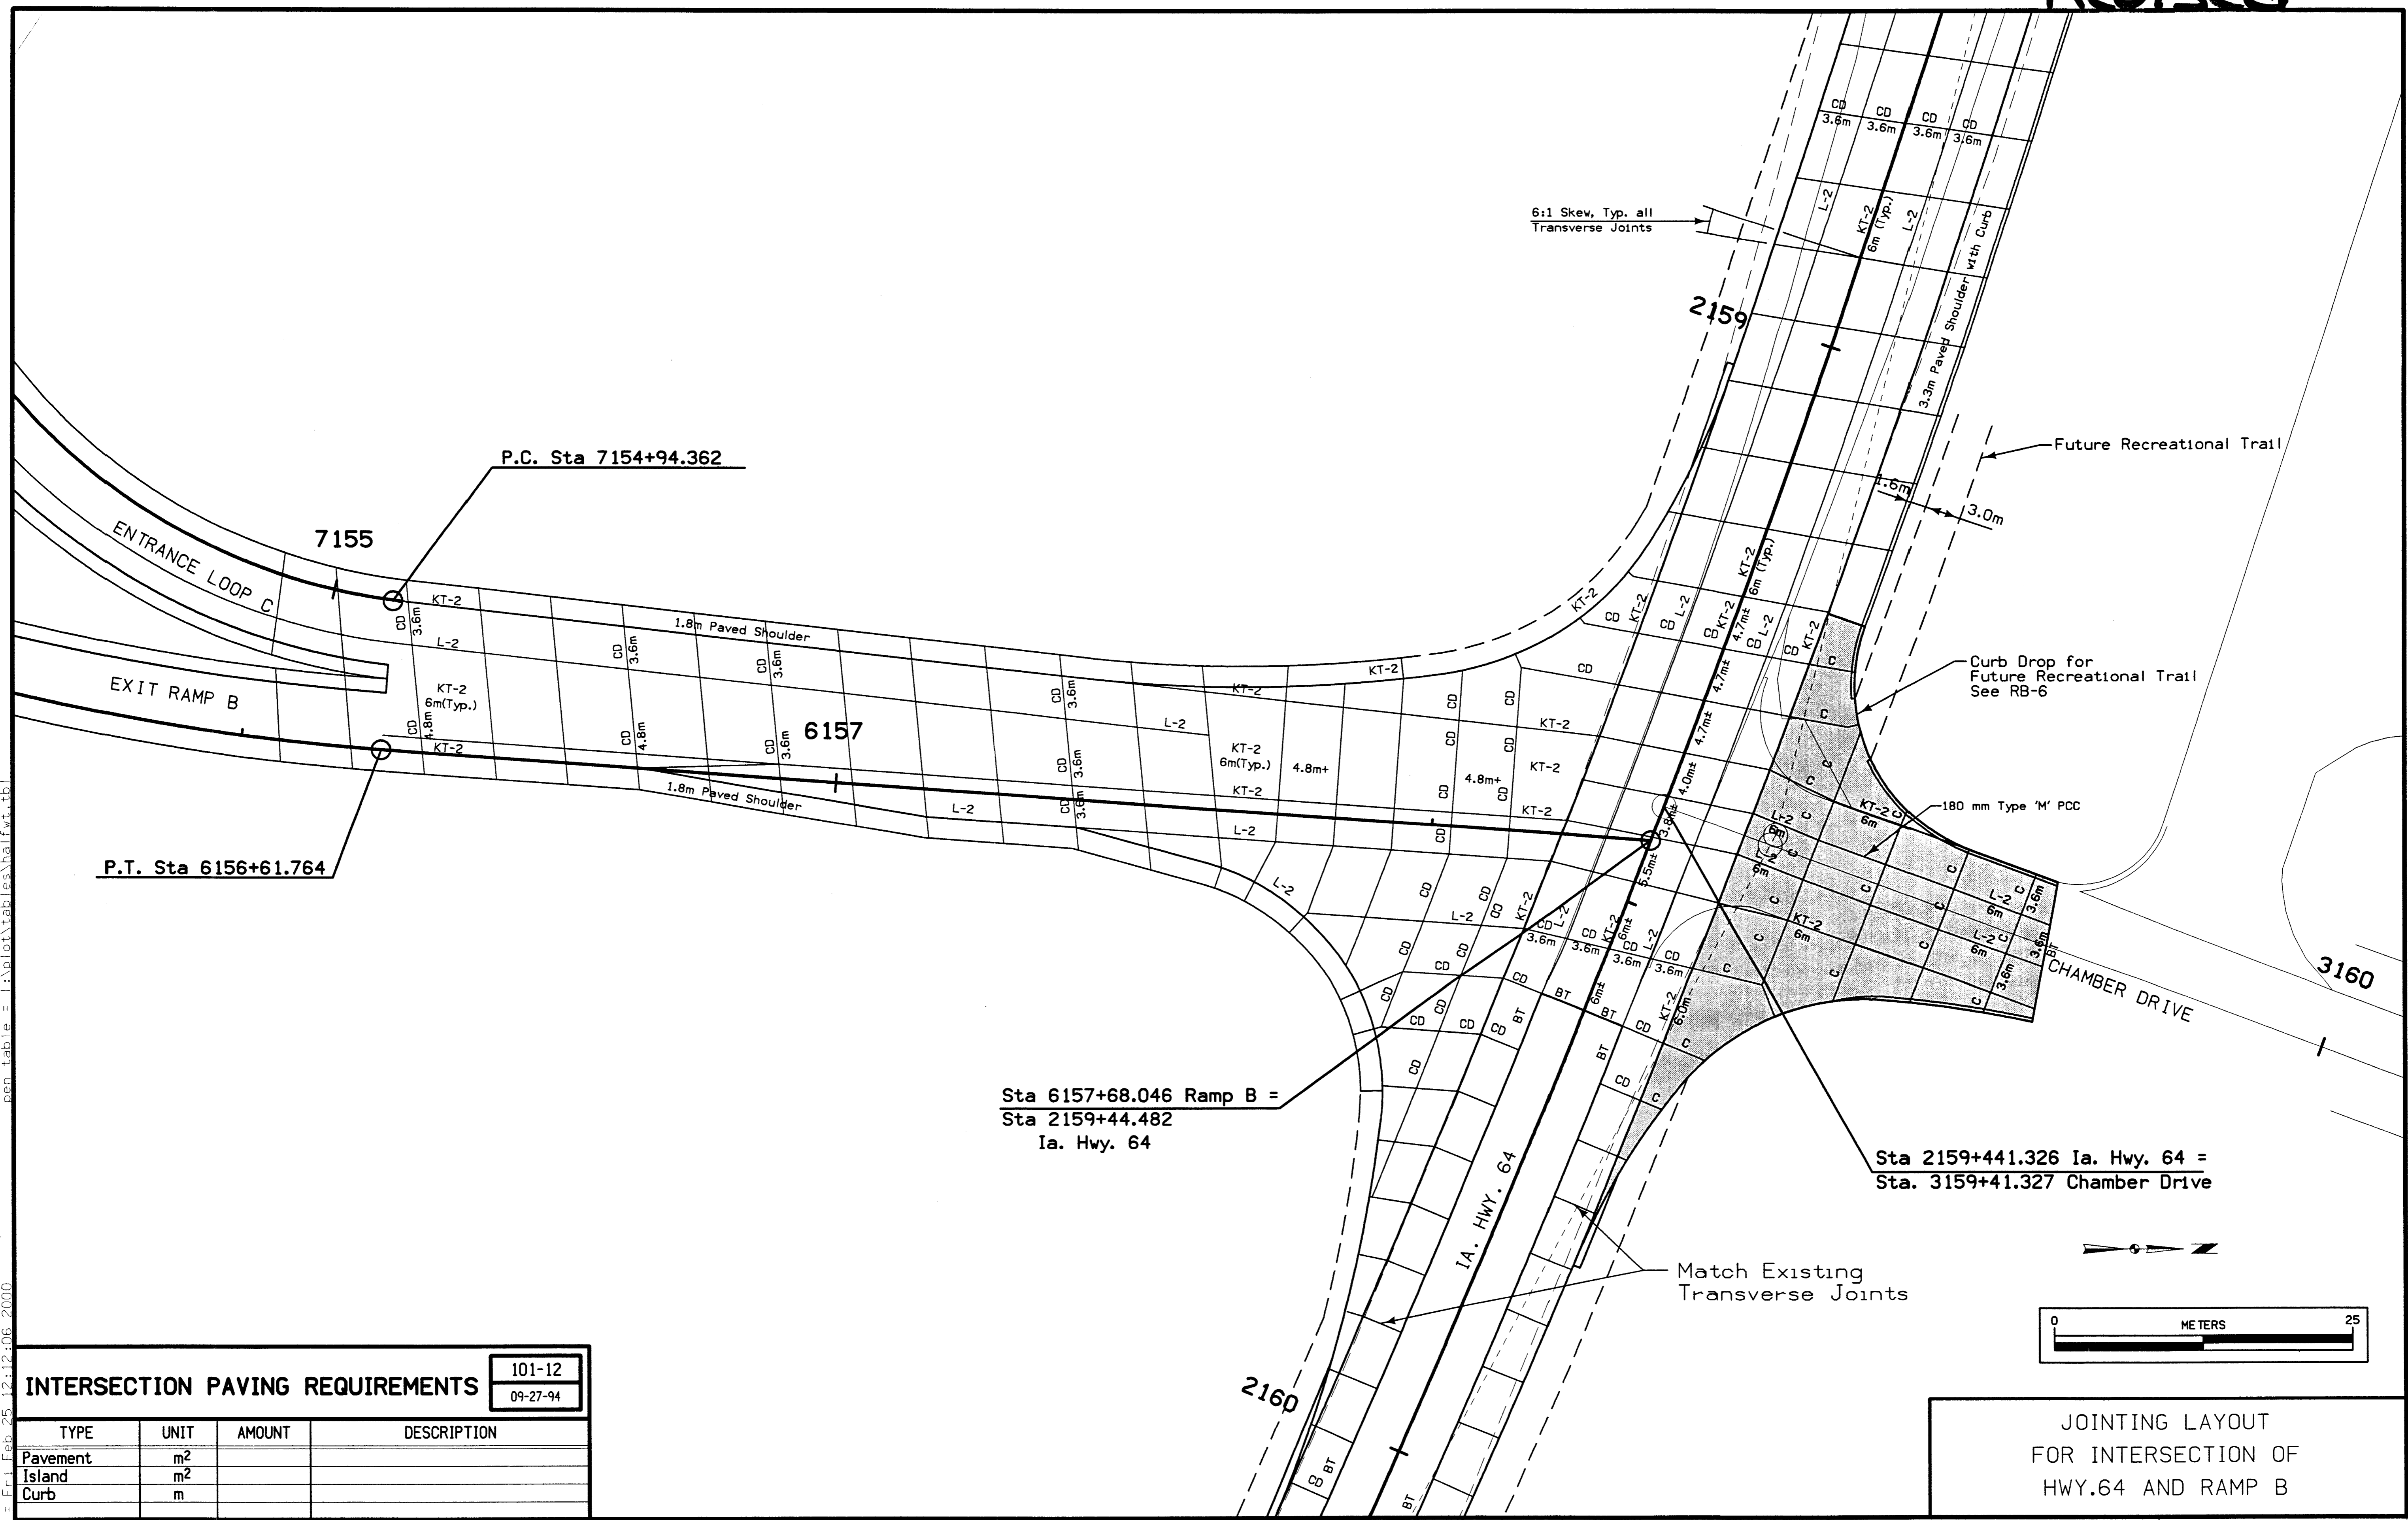

INTERSECTION PAVING REQUIREMENTS


101-12
09-27-94

TYPE	UNIT	AMOUNT	DESCRIPTION
Pavement	m ²		
Island	m ²		
Curb	m		

JOINTING LAYOUT
FOR INTERSECTION OF
HWY. 64 AND RAMP B

dgn = I:\WORK\project\34120\cadd\east\53151063.k10
 prf = \\WA1501\DA\I\PL\NPL\463PK10.prf
 date = Fri Feb 25 12:12:06 2000
 levels = 1-63
 pen table = I:\plot\tables\half.tbl

dgn = I:\work\project\34120\cadd\east\53151063.k11
 pcf = \\WATSON\DATA\PLT\PL463P\K11.pcf
 Date = Fri Oct 29 14:46:03 1999
 levels = 1-63
 den table = :plot\tables\halfwt.tbl

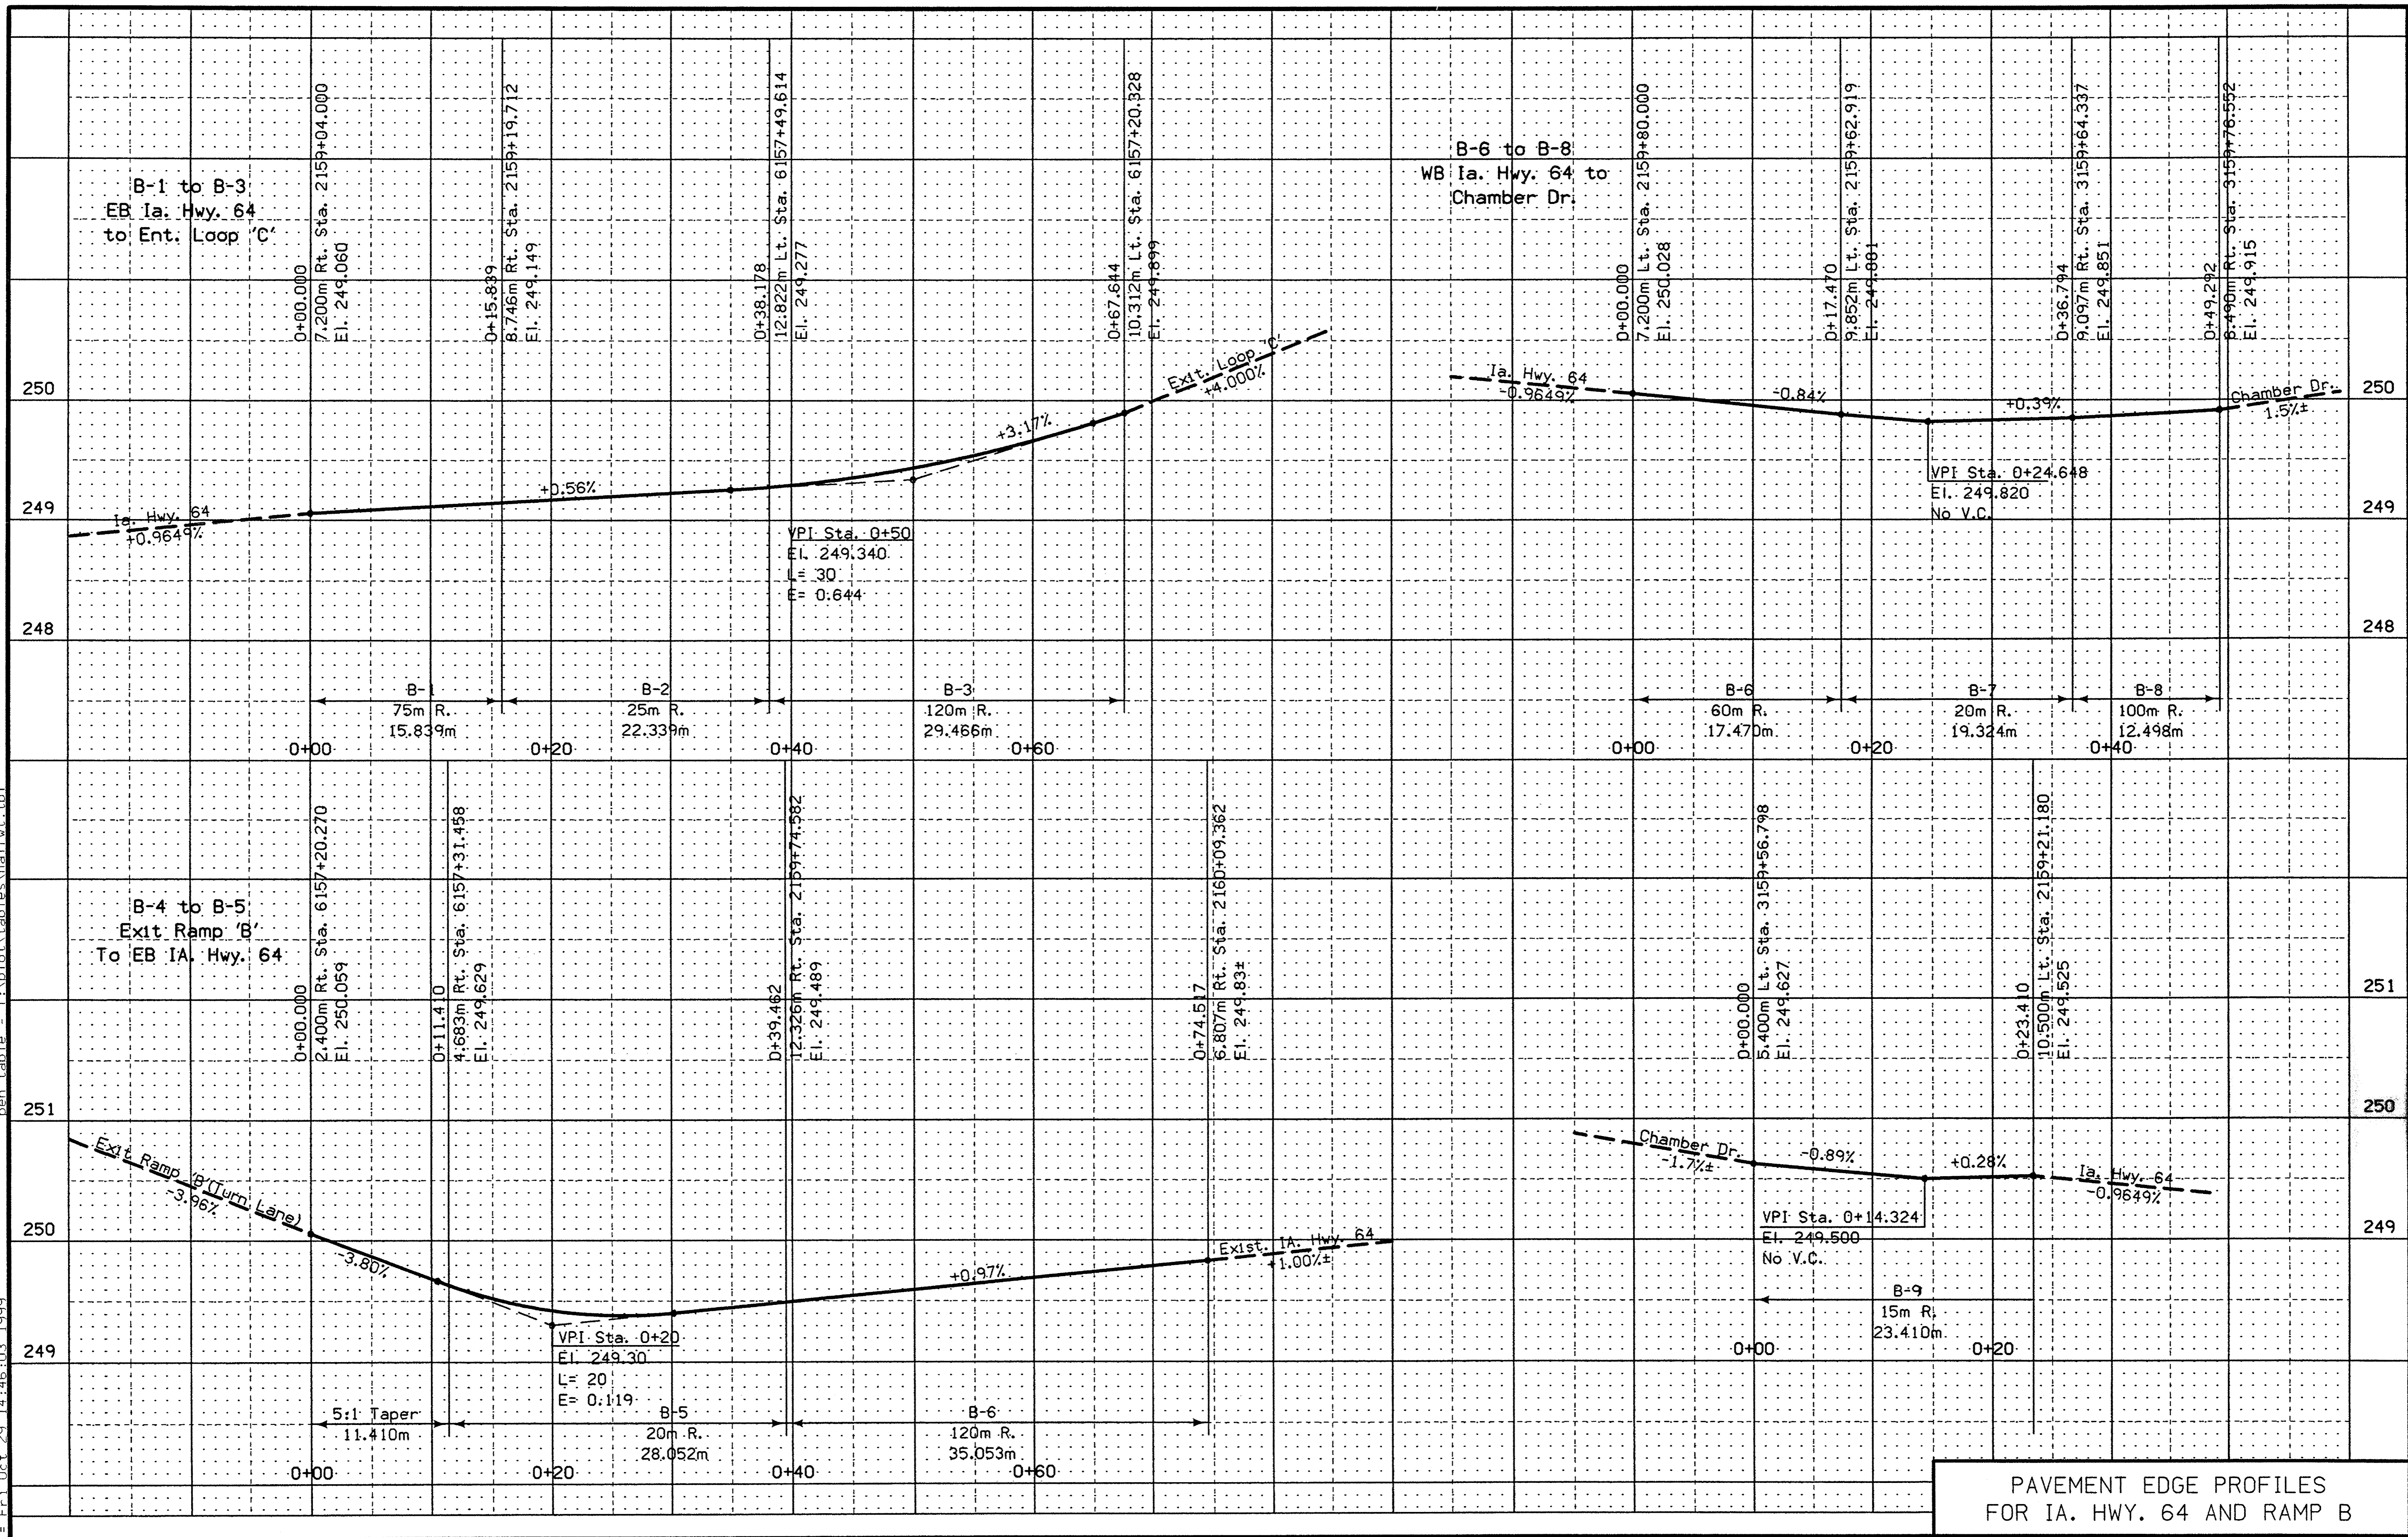


PAVEMENT EDGE PROFILES
 FOR IA. HWY. 64 AND RAMP B

CIRCULAR CURVE DATA

101-10C
09-27-94

NO.	Δ	R	T	L	E
C-1	30.456	20	5.444	10.631	0.728
C-2	130.715	5	10.899	11.407	6.992
C-3	18.792	100	16.548	32.799	1.360
C-4	29.103	20	5.192	10.159	0.686
C-5	131.620	5	11.131	11.486	7.202
C-6	19.235	100	16.945	33.571	1.425

* NOTE:
Elevations to be confirmed
at time of construction
using cross-slope and existing
pavement edge elevation.

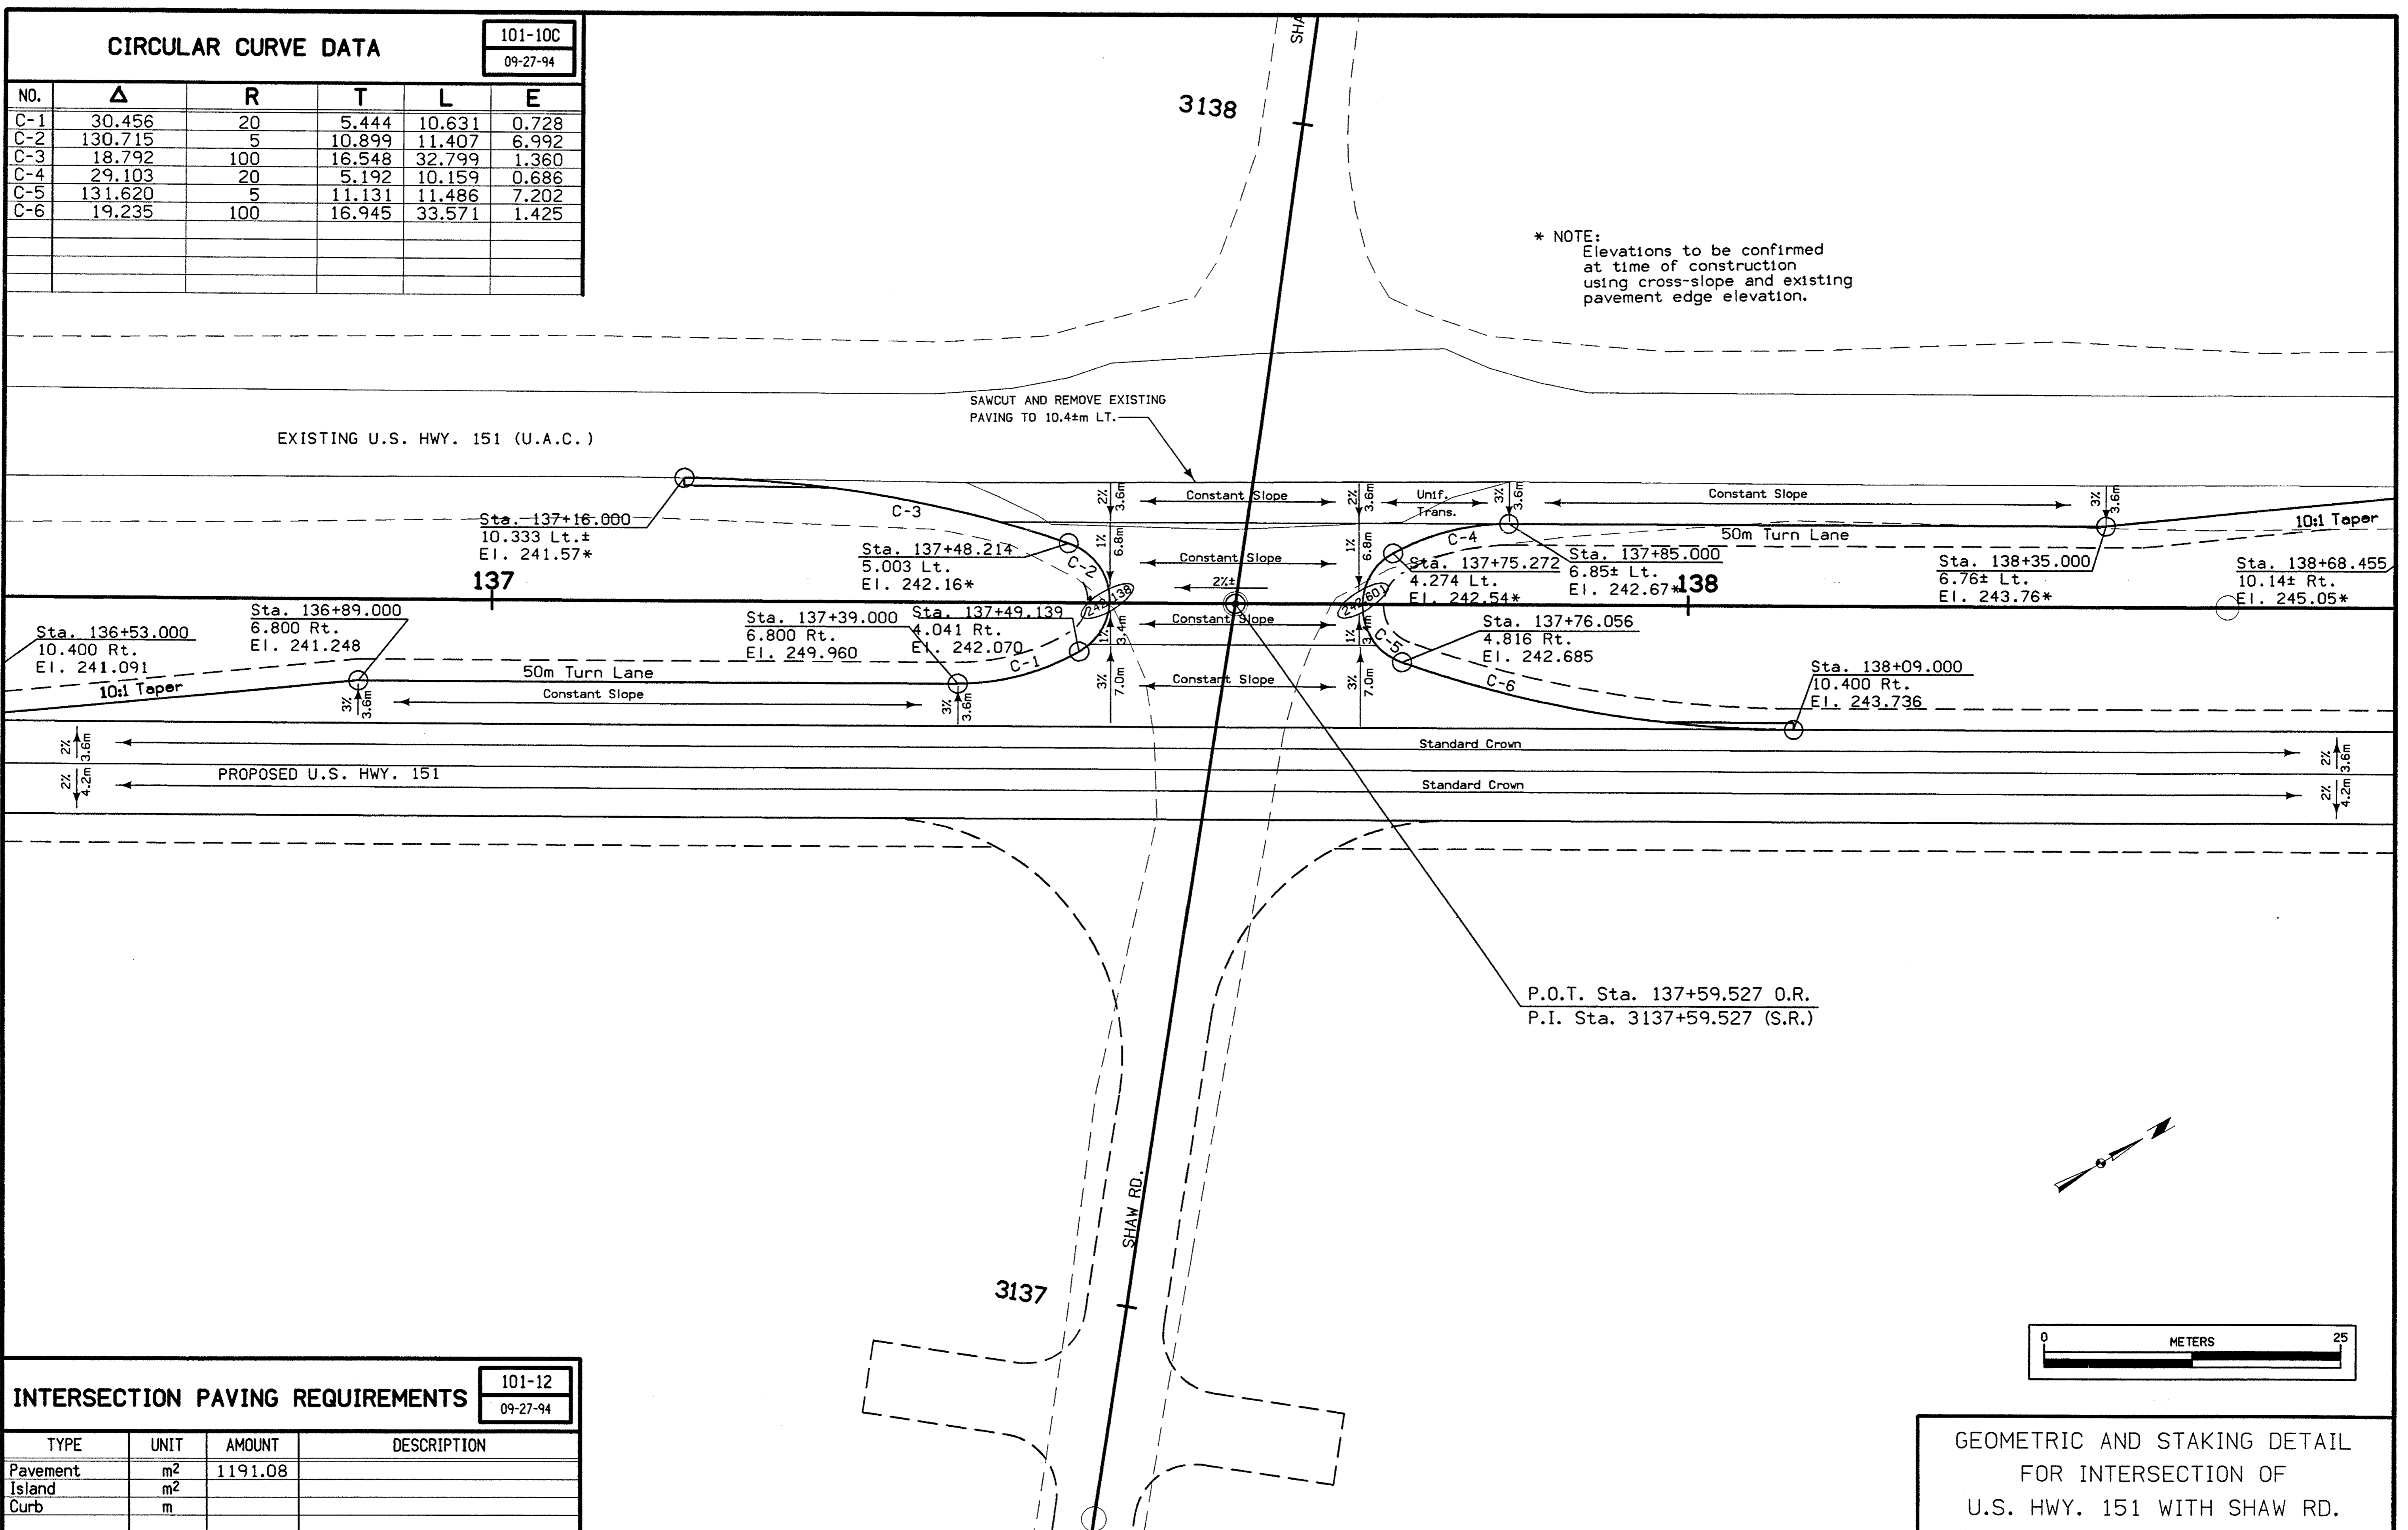

INTERSECTION PAVING REQUIREMENTS

101-12
09-27-94

TYPE	UNIT	AMOUNT	DESCRIPTION
Pavement	m ²	1191.08	
Island	m ²		
Curb	m		

GEOMETRIC AND STAKING DETAIL
FOR INTERSECTION OF
U.S. HWY. 151 WITH SHAW RD.

dgn = L:\WORK\PROJECT\34120\CAD\NEAS\N531b1063.101
 prf = \\WATSON1\DATA\PLT\PL463P\LO1.PRF
 date = Tue Sep 14 11:03:54 1999
 pep_table = L:\p\lot\tables\half\vt.tbl
 levels = 1-63

CIRCULAR CURVE DATA


101-10C
09-27-94

NO.	Δ	R	T	L	E
D-1	33.614	28	8.457	16.427	1.249
D-2	132.399	5	11.336	11.554	7.390
D-3	16.162	130	18.458	36.670	1.304
D-4	68.251	25	16.942	29.780	5.200
D-5	15.875	60	8.366	16.624	0.580
D-6	18.350	50	8.076	16.013	0.648
D-7	65.619	22	14.183	25.196	4.176
D-8	15.810	120	16.662	33.112	1.151
D-9	49.214	20	9.160	17.179	1.998
D-10	95.008	5	5.457	8.291	2.401
D-11	22.744	25	5.028	9.924	0.501

ISLAND DATA

101-13
09-27-94

POINT NO.	STATION	DISTANCE

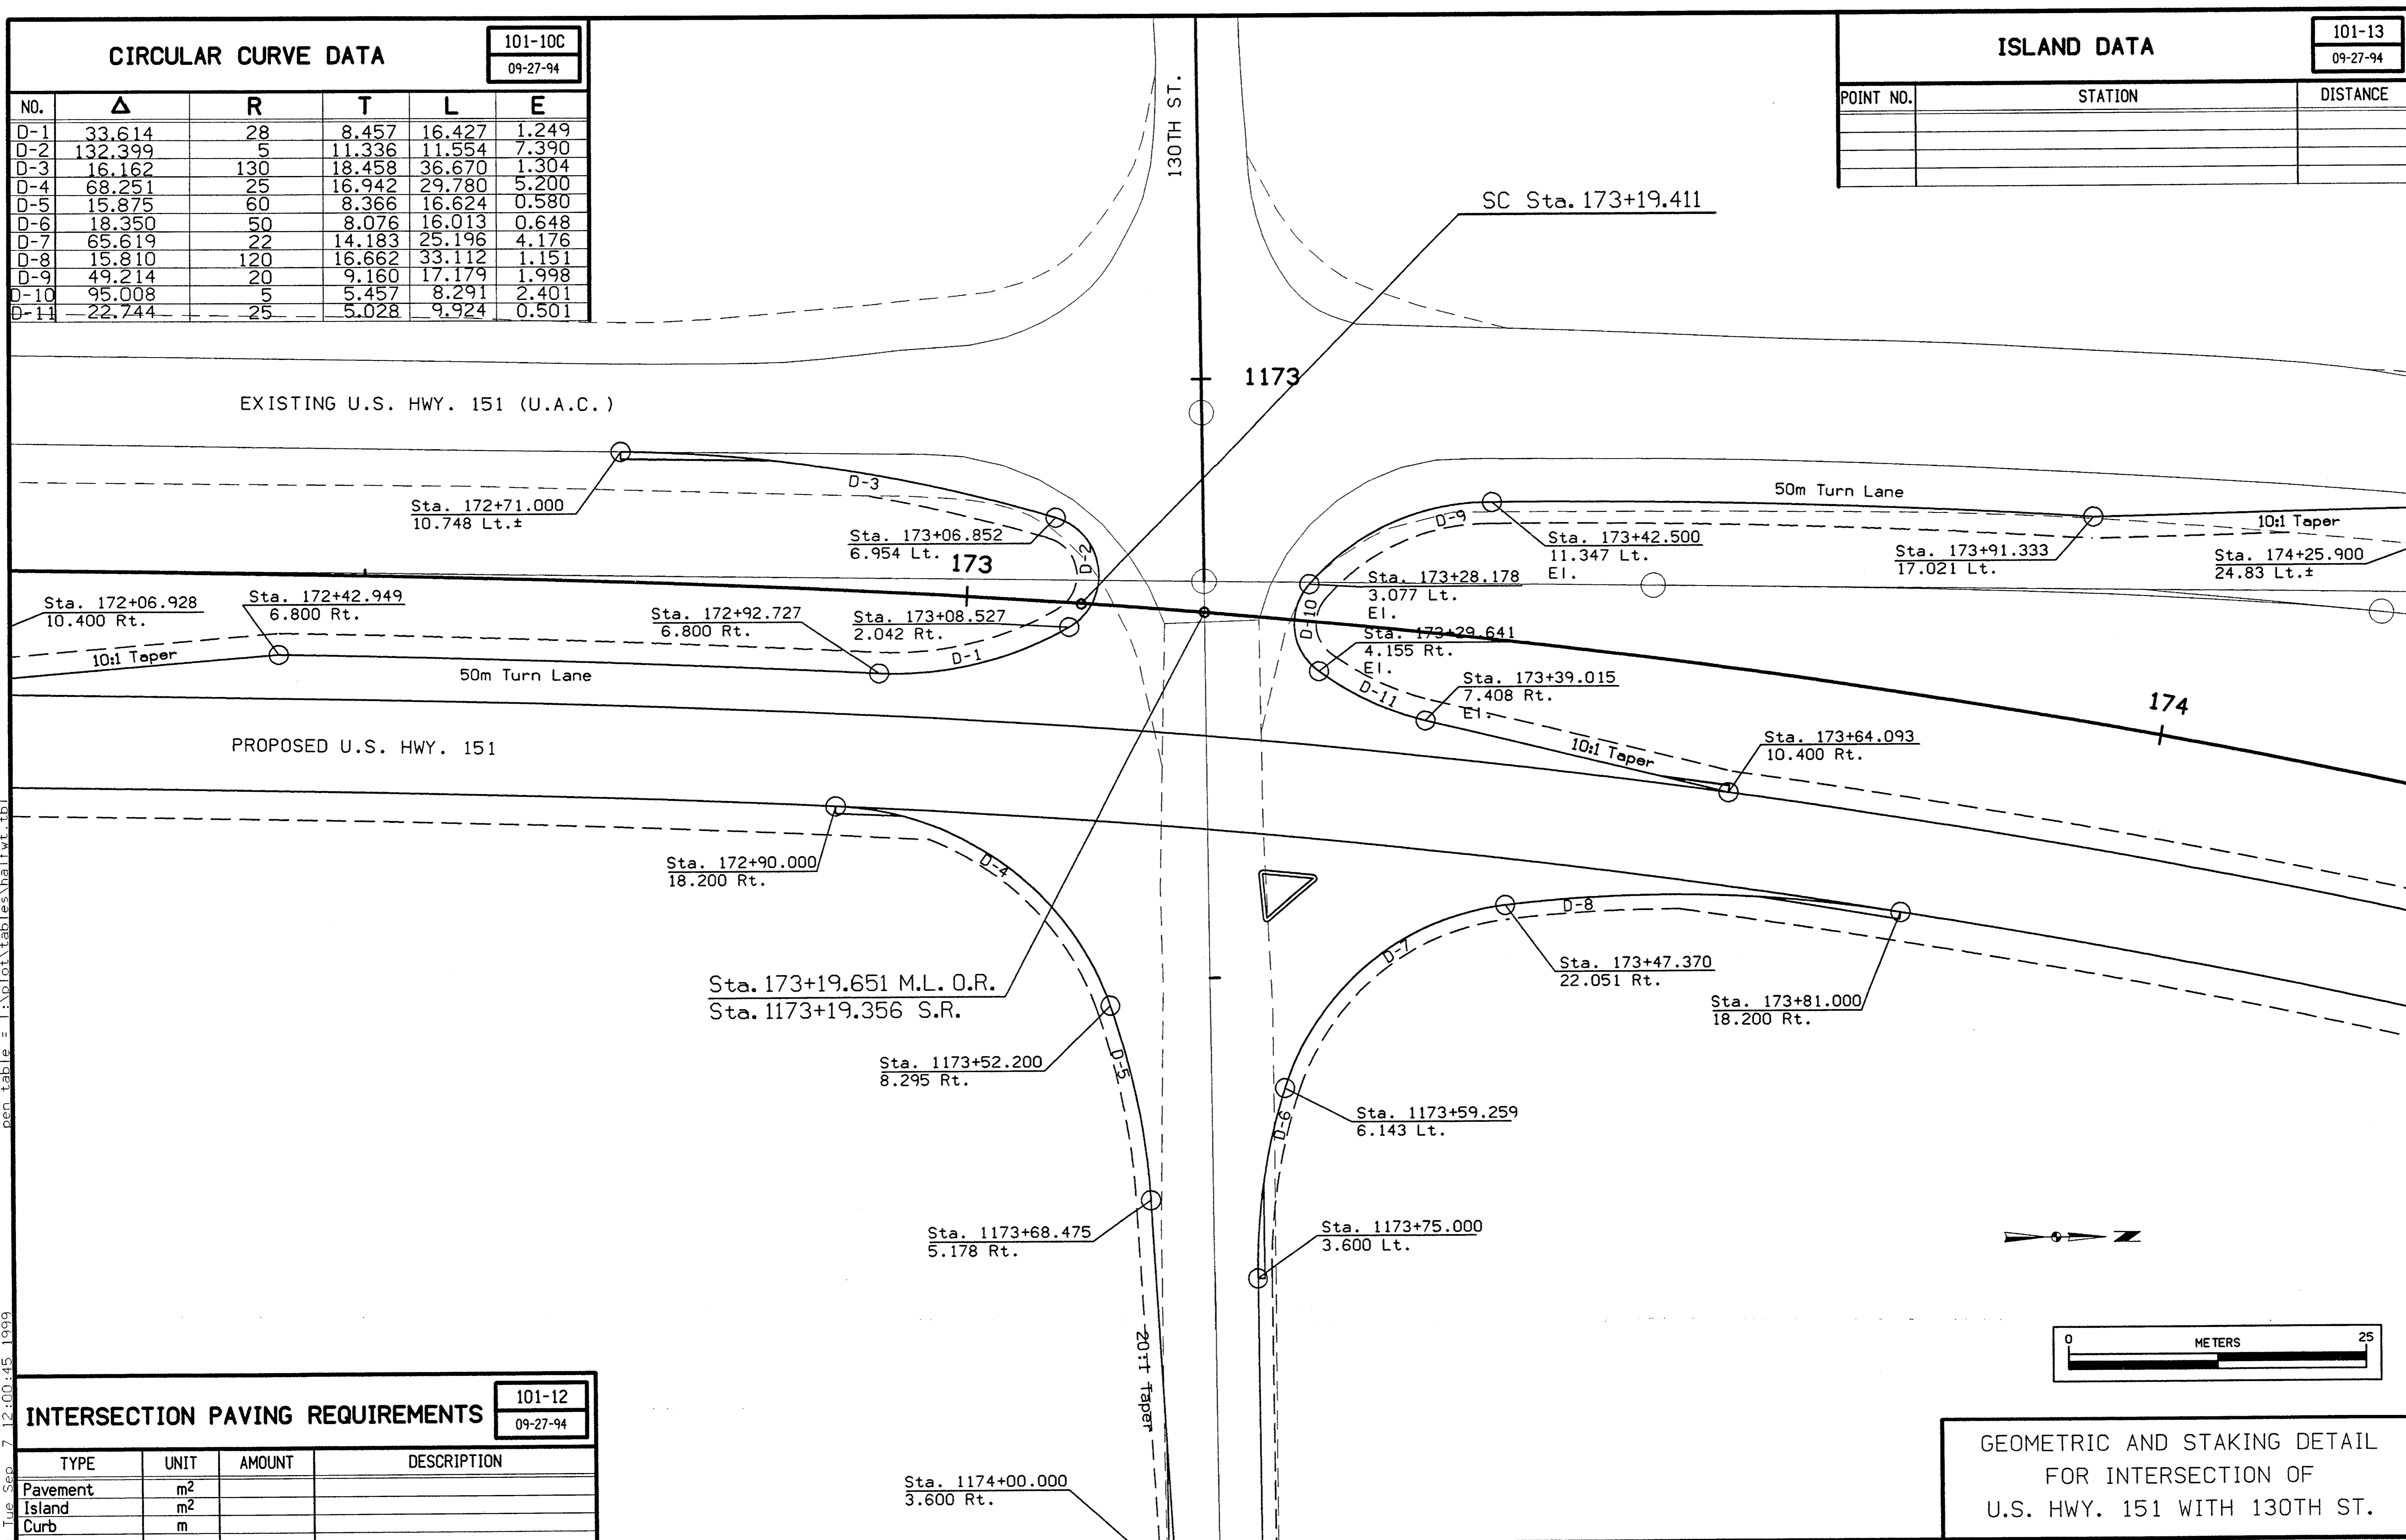

INTERSECTION PAVING REQUIREMENTS

101-12
09-27-94

TYPE	UNIT	AMOUNT	DESCRIPTION
Pavement	m ²		
Island	m ²		
Curb	m		


GEOMETRIC AND STAKING DETAIL
FOR INTERSECTION OF
U.S. HWY. 151 WITH 130TH ST.

dgn = L:\WORK\PROJECT\34120\CADD\EAST\53151063.102
 prj = L:\WORK\PROJECT\34120\CADD\PILOT\PL463P\L02.PRF
 date = Tue Sep 12 12:00:45 1999
 levels = 1-63
 pen table = L:\pilot\tables\halfwt.tbl

CIRCULAR CURVE DATA

101-10C
09-27-94

NO.	Δ	R	T	L	E
F-1	45.925	20	8.474	16.031	1.721
F-2	114.190	5	7.727	9.965	4.204
F-3	19.846	50	8.747	17.319	0.759
F-4	43.530	20	7.985	15.195	1.535
F-5	101.093	5	6.075	8.822	2.868
F-6	29.631	25	6.613	12.929	0.860

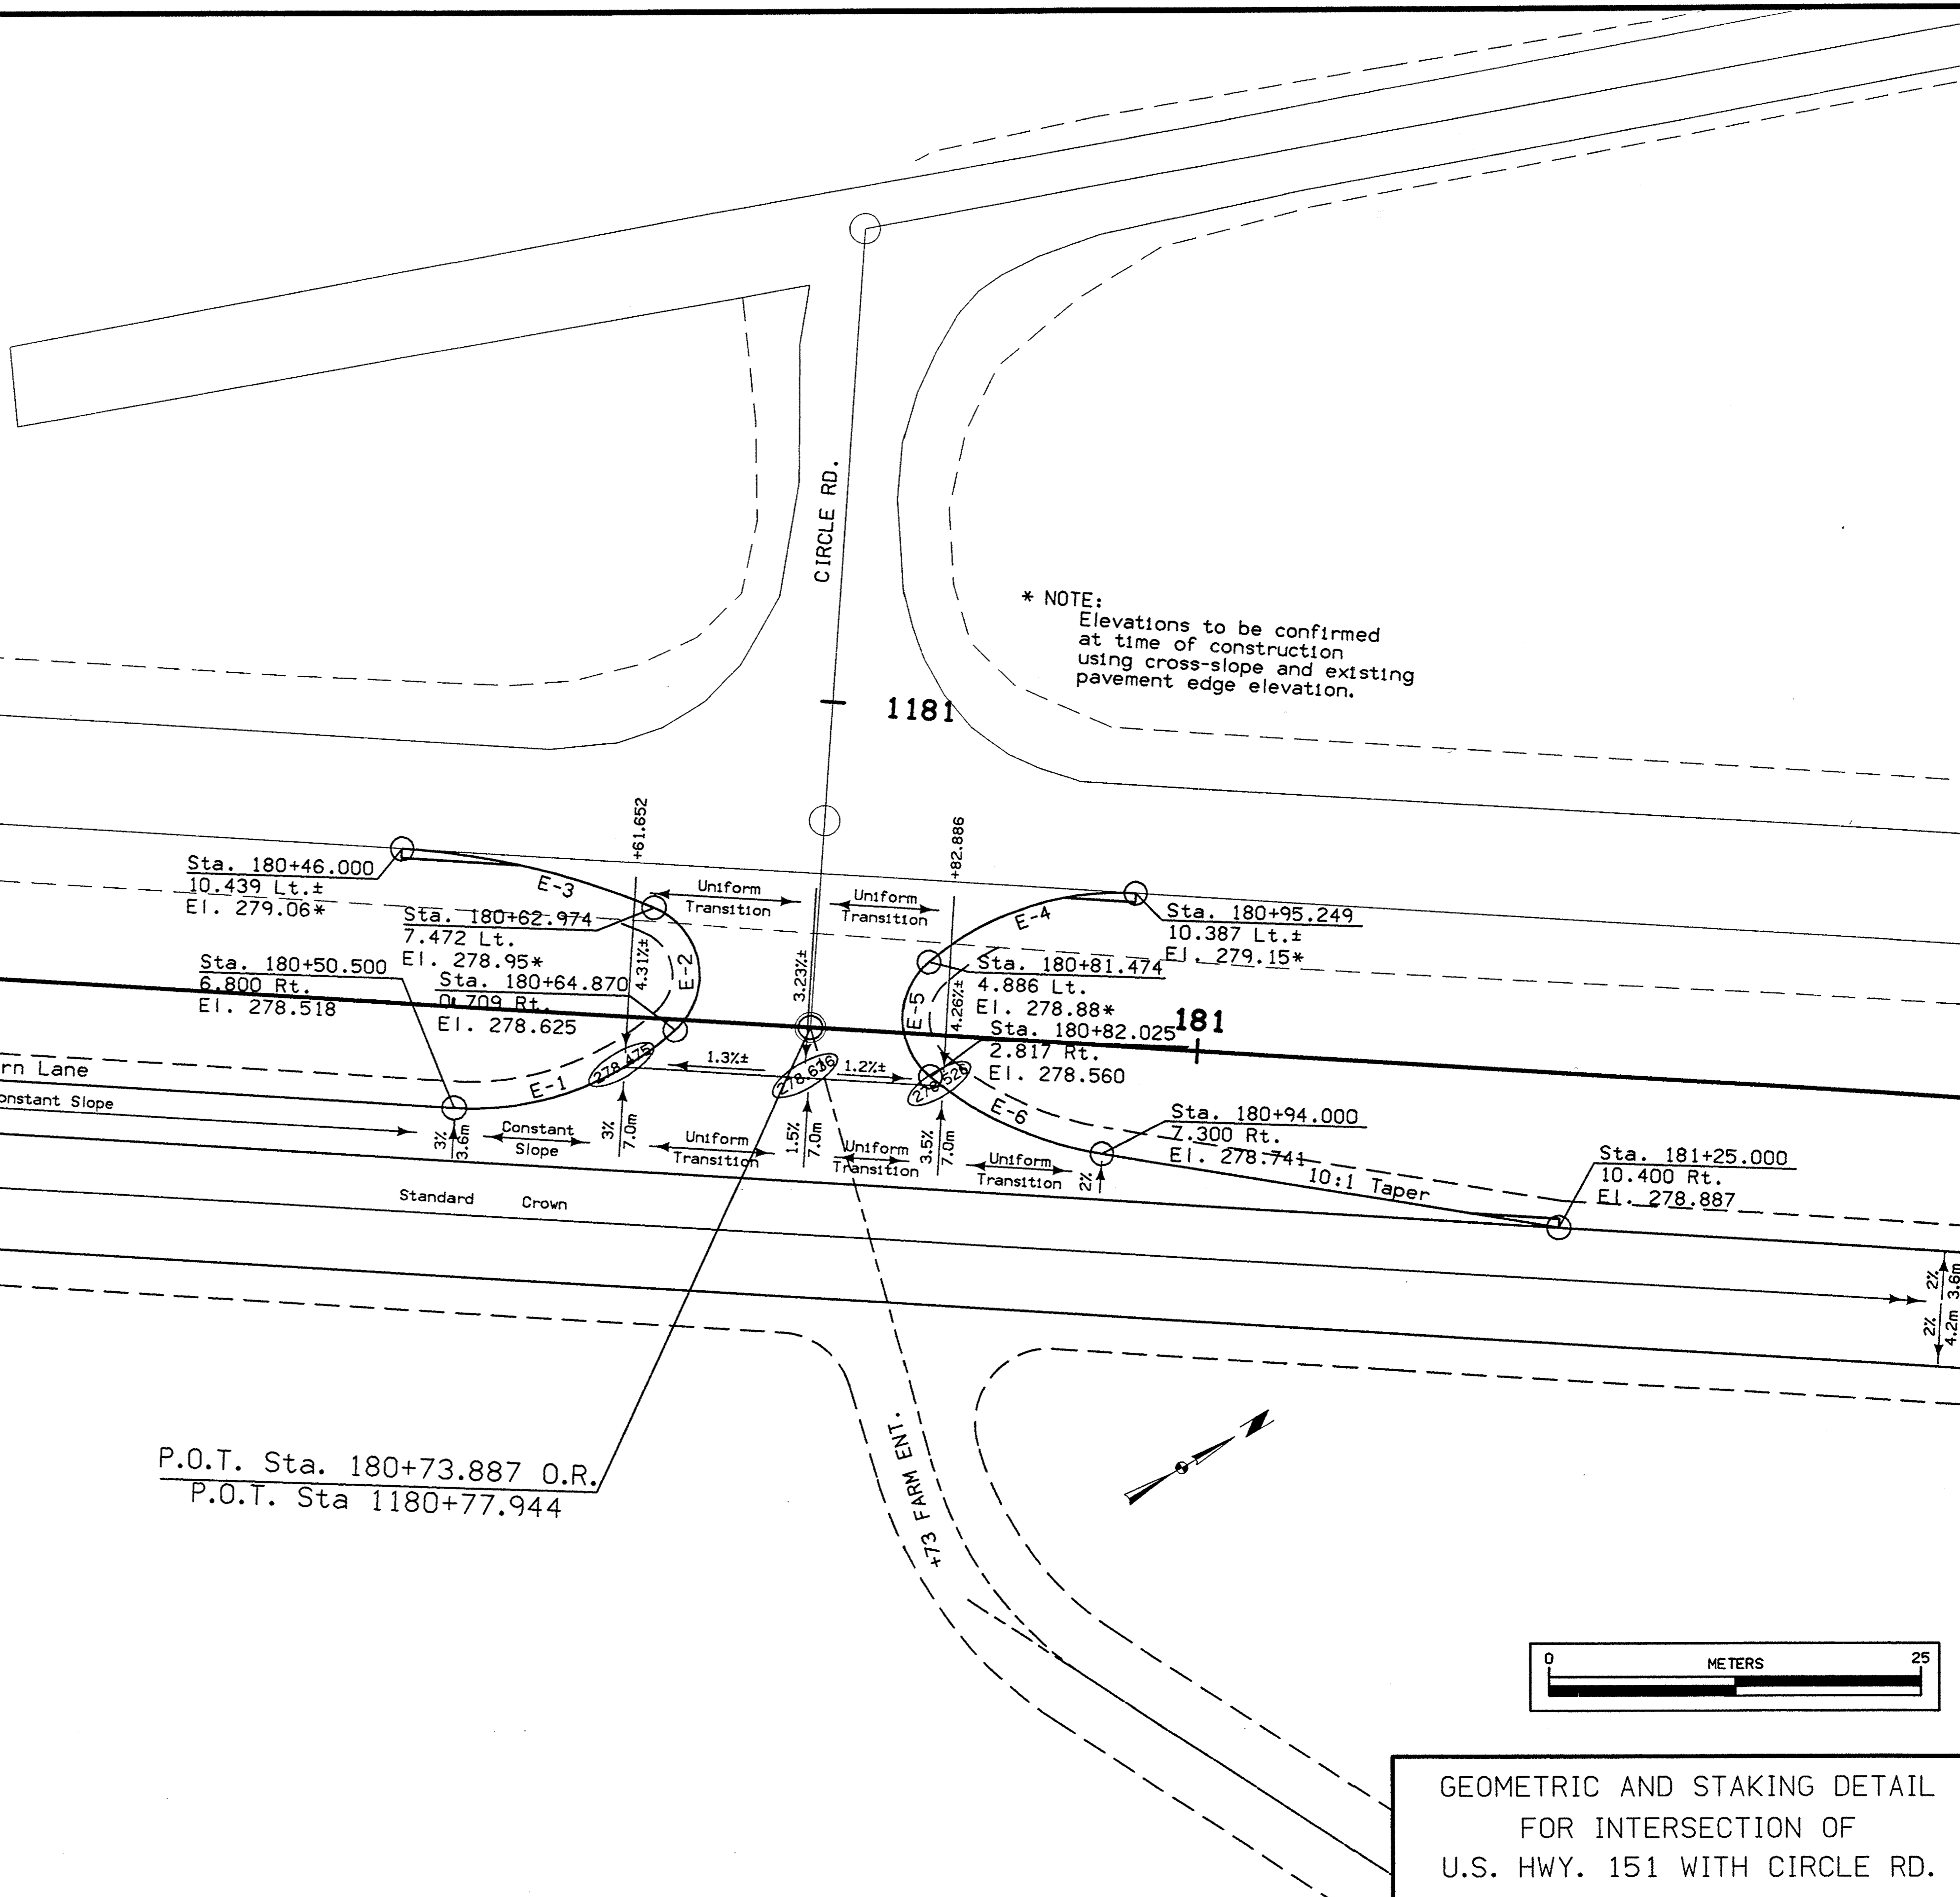

* NOTE:
Elevations to be confirmed
at time of construction
using cross-slope and existing
pavement edge elevation.

dgn = I:\WORK\proj\sect\34120\cadd\east\531b1063.103
 prf = \WATSON\04\PLT\PL4632\103.prf
 date = Tue Oct 26 07:48:37 1999
 levels = 1-63
 pen table = I:\plot\tables\haifvt.tbl

P.O.T. Sta. 180+73.887 O.R.
P.O.T. Sta 1180+77.944

INTERSECTION PAVING REQUIREMENTS


101-12
09-27-94

TYPE	UNIT	AMOUNT	DESCRIPTION
Pavement	m ²	811.14	
Island	m ²		
Curb	m		



GEOMETRIC AND STAKING DETAIL
FOR INTERSECTION OF
U.S. HWY. 151 WITH CIRCLE RD.

Revised

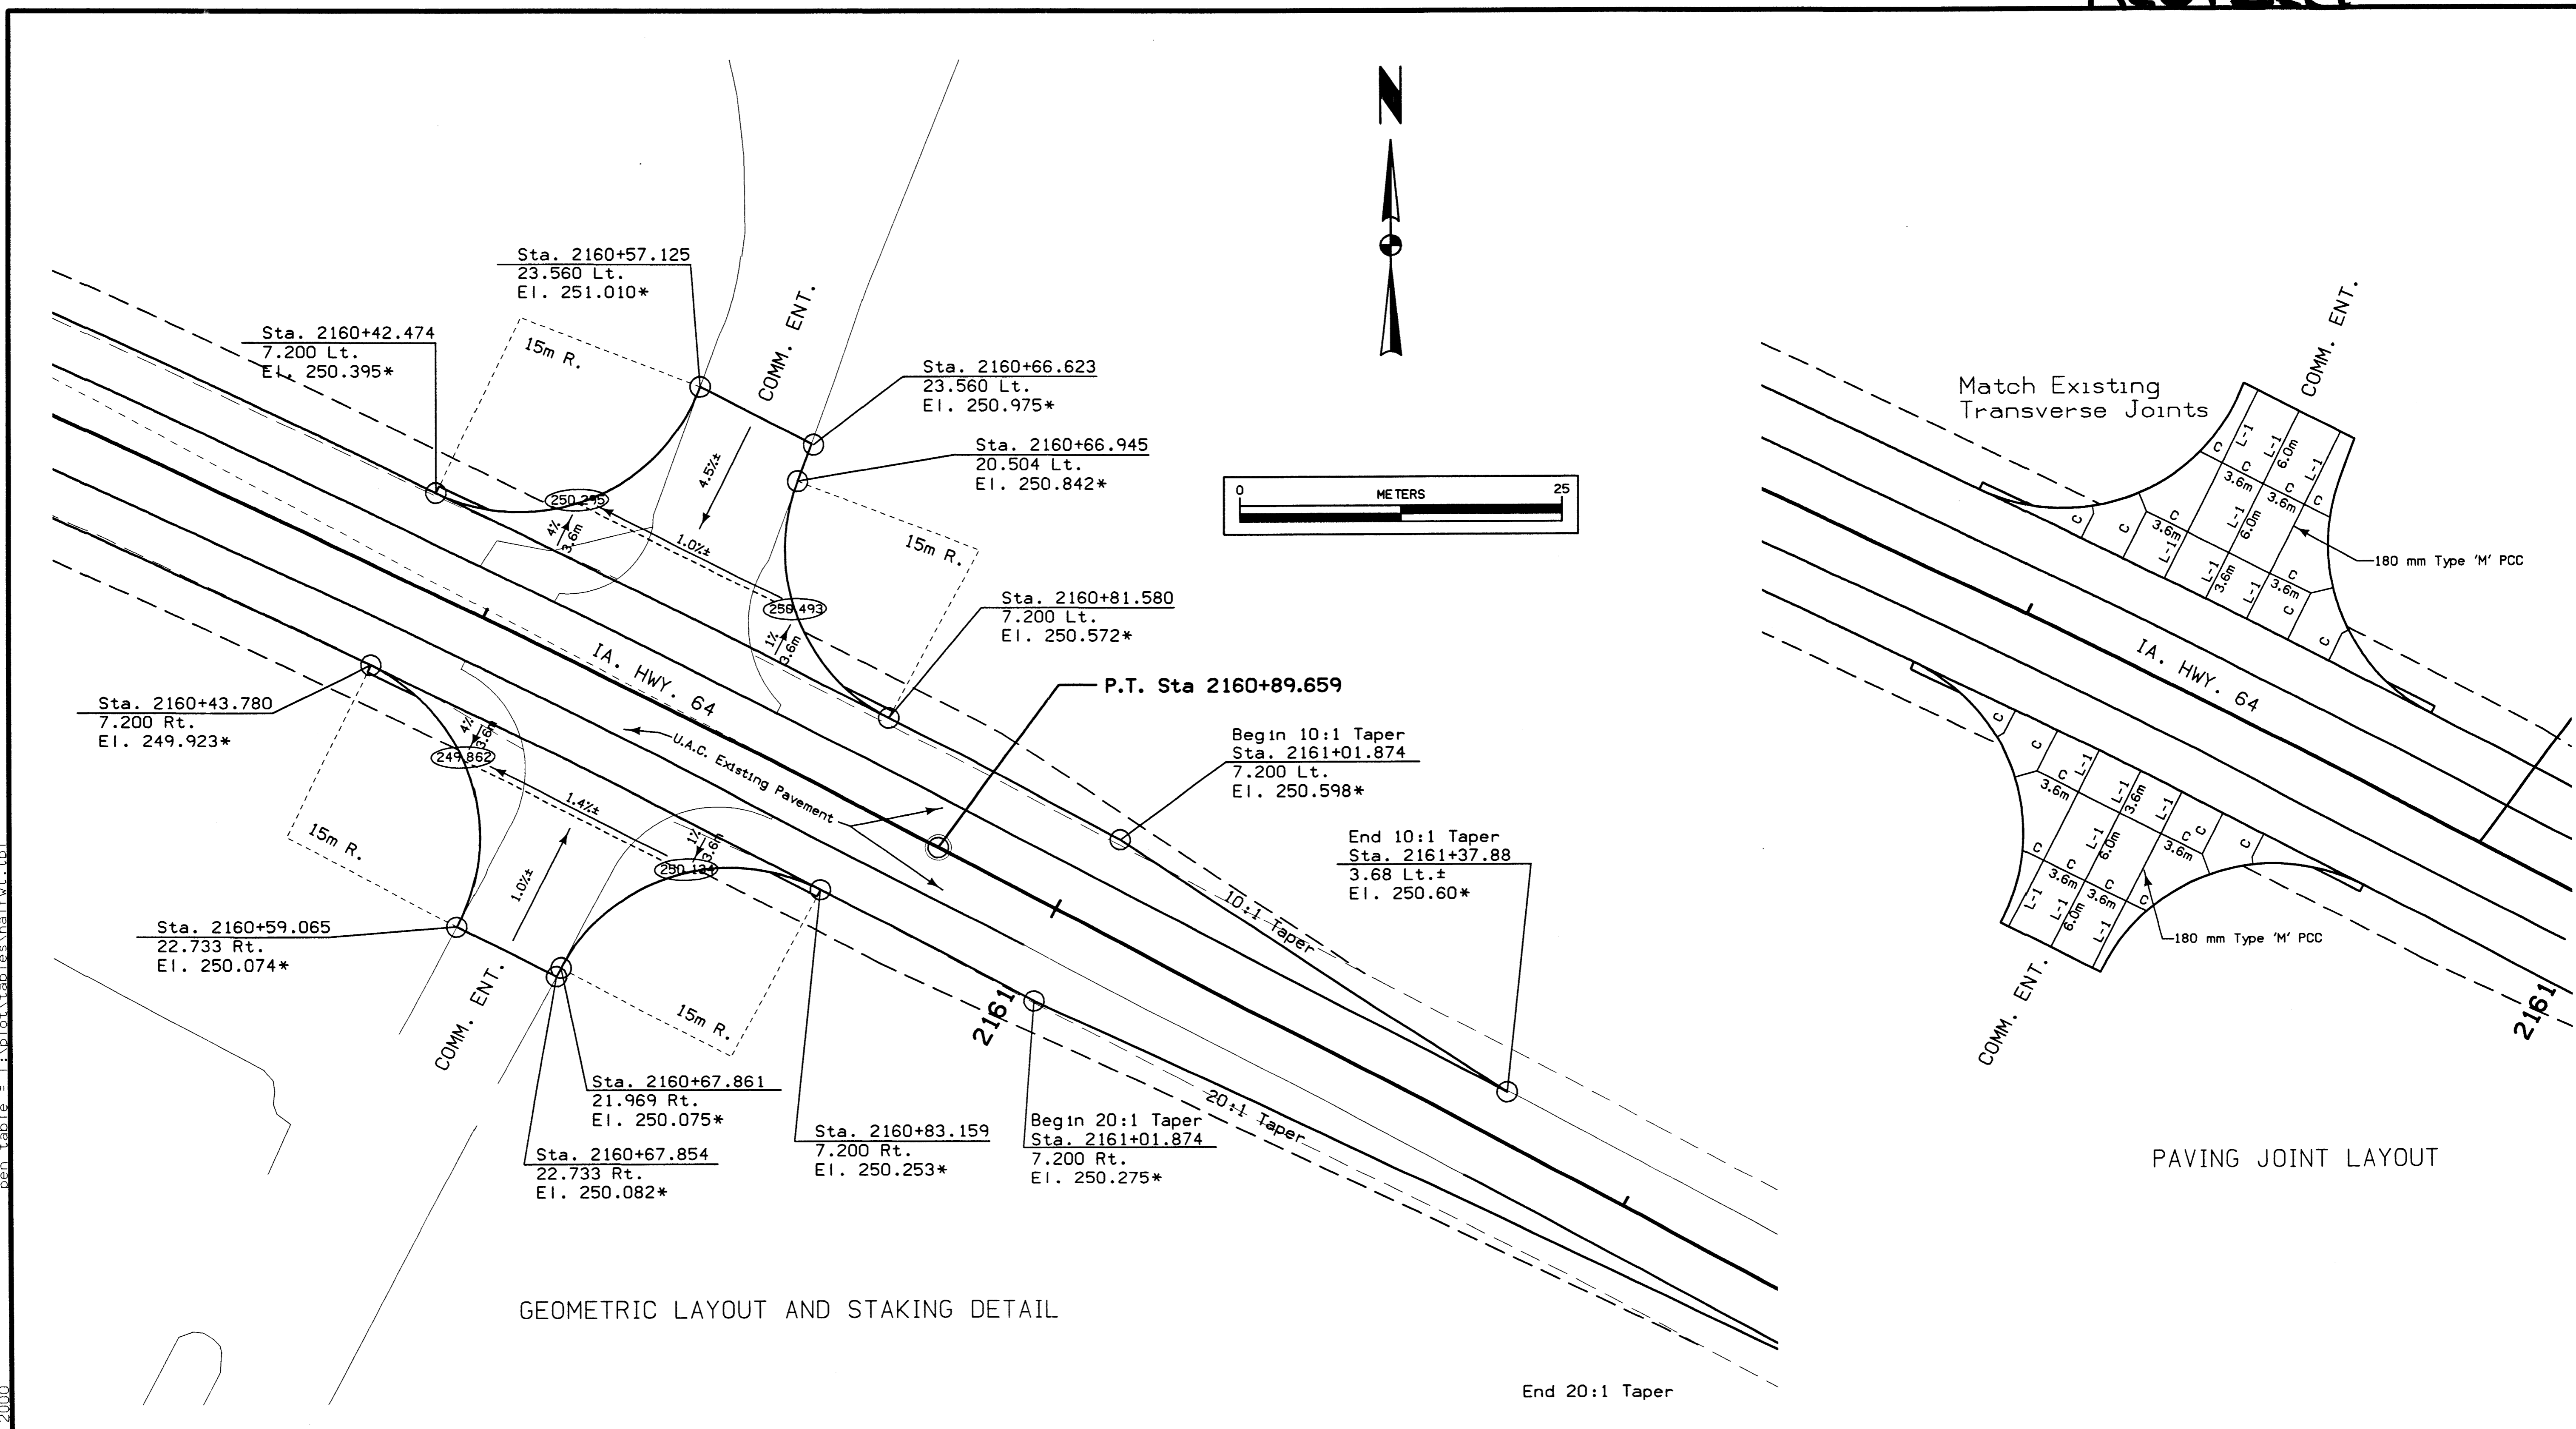

GEOMETRIC LAYOUT AND STAKING DETAIL

PAVING JOINT LAYOUT

INTERSECTION PAVING REQUIREMENTS			
		101-12	
		09-27-94	
TYPE	UNIT	AMOUNT	DESCRIPTION
Pavement	m ²		
Island	m ²		
Curb	m		

GEOMETRIC AND STAKING DETAIL AND PAVING JOINT LAYOUT FOR INTERSECTION OF IA. HWY. 64 WITH ENTRANCES AT STA. 2160+64±

cgr = I:\WORK\pcc\pcc\pcc\34120\cadd\east\53151063.104
 prf = \WA\SOI\06\PILOT\PL4639\04.prf
 date = Fri Feb 25 12:12:20 2000
 levels = 1-63
 pen table = I:\plot\tables\half.tbl

TABULATION OF TEMPLATE QUANTITIES AND ADJUSTMENTS

Refer to Standard Road Plans RL-1A and RL-1B

107-28
03-26-96

STATION	TEMPLATE CUT	ADDITIONAL QUANTITY +C	SUBGRADE TREATMENT +C	MOISTURE AND DENSITY +C	TOPSOIL PLACEMENT +C	SELECT SOIL -C	PAVEMENT REMOVAL -C	ROCK -C	TOPSOIL REMOVAL -C	ADJUSTED EARTH CUT	UNSUIT-ABLE C - 3	UNSUIT-ABLE C - 5	ROCK CUT	ADDITIONAL ROCK CUT +C	PERCENT SWELL	ADJUSTED ROCK + SWELL	TEMPLATE FILL	ADDITIONAL QUANTITY +F	MOISTURE AND DENSITY +F	PAVEMENT REMOVAL +F	TOPSOIL PLACEMENT -F	SUBTRACT QUANTITY -F	SUBGRADE TREATMENT -F	ROCK FILL -F	ADJUSTED FILL	UNSUITABLE FILL	PERCENT SHRINK	ADJUSTED FILL + SHRINK	UNSUITABLE FILL + SHRINK	BALANCE AND OVERHAUL	
8148+83																															
OVERHAUL = 56,978 STA. m																															
8155+56																															
5154+30																															
OVERHAUL = 20,741 STA. m																															
5158+00																															
8158+13																															
OVERHAUL = 42,777 STA. m																															
8161+89																															
135+15																															
OVERHAUL = 142,386 STA. m																															
136+50																															
2156+25																															
NO OVERHAUL																															
2156+91																															
NO OVERHAUL																															
2156+91																															

dpm = L:\WORK\PROJECT\34120\CAUDA\AS\5/15/06\3.t01
 pff = \\WATSON\DATA\PLT\PI\463P\T01.PRF
 date = Fri Oct 29 14:29:10 1999
 pen table = I:\plot\tables\half.vt.tbl
 levels = 1-63

TABULATION OF TEMPLATE QUANTITIES AND ADJUSTMENTS

Refer to Standard Road Plans RL-1A and RL-1B

107-28

03-26-96

STATION	TEMPLATE CUT	ADDITIONAL QUANTITY +C	SUBGRADE TREATMENT +C	MOISTURE AND DENSITY +C	TOPSOIL PLACEMENT +C	SELECT SOIL -C	PAVEMENT REMOVAL -C	ROCK -C	TOPSOIL REMOVAL -C	ADJUSTED EARTH CUT	UNSUITABLE C - 3	UNSUITABLE C - 5	ROCK CUT	ADDITIONAL ROCK CUT +C	PERCENT SWELL	ADJUSTED ROCK + SWELL	TEMPLATE FILL	ADDITIONAL QUANTITY +F	MOISTURE AND DENSITY +F	PAVEMENT REMOVAL +F	TOPSOIL PLACEMENT -F	SUBTRACT QUANTITY -F	SUBGRADE TREATMENT -F	ROCK FILL -F	ADJUSTED FILL	UNSUITABLE FILL	PERCENT SHRINK	ADJUSTED FILL + SHRINK	UNSUITABLE FILL + SHRINK	BALANCE AND OVERHAUL	
STAGE 4																															
Mainline																															
150+00		0	148		0	0	83	0	29	186	0	0	0	0	10	0	4125	Dike		0	149	148	0	3828	0	30	4976	0	NO OVERHAUL	+00	
150+50	4650	0	297		60	0	83	0	367	4557	0	0	0	0	10	0	4250	37		82	205	297	0	3867	0	30	5027	0			
151+00	9800	0	375		148	0	0	0	563	9760	0	0	0	0	10	0	475	0		164	134	219	0	286	0	30	372	0			
151+50	5500	0	226		169	0	0	0	288	5607	0	0	0	0	10	0	3500	0		167	235	367	0	3065	0	30	3985	0			
152+00	250	0	0		108	0	0	0	164	194	0	0	0	0	10	0	10500	0		169	423	593	0	9653	0	30	12549	0			
152+50	75	0	0		26	0	0	0	101	0	0	0	0	0	10	0	16800	0		168	567	593	0	15808	0	30	20550	0			
153+00	25	0	0		0	0	0	0	0	25	0	0	0	0	10	0	15850	Dike		167	501	593	0	14923	0	30	19400	0			
153+50	0	0	0		0	0	0	0	0	0	0	0	0	0	10	0	11375	17		168	497	593	0	10470	0	30	13611	0			
154+00	3175	0	6		31	0	0	0	185	3027	0	0	0	0	10	0	7125	0		168	370	587	0	6336	0	30	8237	0			
154+50	8100	0	6		31	0	0	0	409	7728	0	0	0	0	10	0	4825	0		168	204	587	0	4202	0	30	5463	0			
155+00	11425	0	137		31	0	0	0	530	11063	0	0	0	0	10	0	4975	0		177	251	457	0	4444	0	30	5777	0			
155+50	9800	0	218		121	0	0	0	587	9552	0	0	0	0	10	0	5950	0		202	248	375	0	5529	0	30	7188	0			
156+00	5200	0	82		118	0	0	0	424	4976	0	0	0	0	10	0	9900	Guardrail		217	274	511	0	9332	0	30	12132	0			
156+50	2400	0	0		106	0	0	0	210	2296	0	0	0	0	10	0	17350	250		236	422	593	0	16821	0	30	21867	0			
157+00	1775	0	0		205	0	0	0	217	1763	0	0	0	0	10	0	24550	100		317	608	593	0	23766	0	30	30896	0			
157+50	255	0	0		51	0	0	0	30	276	0	0	0	0	10	0	5315	0		75	133	119	0	5138	0	30	6679	0			
157+60	0	0	0		41	0	0	0	0	41	0	0	0	0	10	0	4200	0		60	107	95	0	4058	0	30	5275	0			
157+76	0	0	0		0	0	0	0	0	0	0	0	0	0	10	0	0	0		0	0	0	0	0	0	30	0	0			
158+08	0	0	0		33	0	0	0	0	33	0	0	0	0	10	0	2828	100		49	87	77	0	2813	0	30	3657	0			
158+21	986	0	0		100	0	0	0	161	925	0	0	0	0	10	0	11890	250		184	329	344	0	11651	0	30/20	14395	0			
158+50	1975	0	0		54	0	0	0	434	1595	0	0	0	0	10	0	18400	0		227	464	593	0	17570	0	20	21084	0			
159+00	1675	0	0		97	0	0	0	421	1351	0	0	0	0	10	0	15500	0		173	421	593	0	14659	0	20	17591	0			
159+50	2850	0	0		208	0	0	0	550	2508	0	0	0	0	10	0	10225	0		149	310	593	0	9471	0	20	11365	0			
160+00	1675	0	0		144	0	0	0	370	1449	0	0	0	0	10	0	6175	0		131	270	593	0	5443	0	20	6532	0			
160+50	300	0	55		33	0	0	0	123	265	0	0	0	0	10	0	5600	0		113	282	539	0	4892	0	20	5870	0			
161+00	200	0	203		17	0	0	0	84	336	0	0	0	0	10	0	4575	0		80	235	390	0	4030	0	20	4836	0			
161+50	350	0	297		19	0	0	0	93	573	0	0	0	0	10	0	4125	0		26	248	297	0	3606	0	20	4327	0			
162+00																															
Ramp 'B'																															
6153+10		0	0		8	0	0	0	87	41	0	0	0	0	10	0	6040	0		0	166	163	0	5711	0	30	7424	0			
6153+50	1350	0	0		71	0	0	0	263	1158	0	0	0	0	10	0	3275	0		0	85	204	0	2986	0	30	3882	0			
6154+00	9000	0	102		96	0	0	0	421	8777	0	0	0	0	10	0	250	0		0	0	102	0	148	0	30	192	0			
6154+50	17275	0	204		63	0	0	0	443	17099	0	0	0	0	10	0	0	0		0	0	0	0	0	0	0	30	0	0		
6155+00	16600	0	204		86	0	0	0	478	16412	0	0	0	0	10	0	0	0		0	0	0	0	0	0	0	30	0	0		
6155+50	10625	0	204		116	0	0	0	492	10453	0	0	0	0	10	0	0	0		0	0	0	0	0	0	0	30	0	0		
6156+00	4075	0	204		86	0	0	0	388	3977	0	0	0	0	10	0	0	0		0	0	0	0	0	0	0	30	0	0		
6156+50	1300	0	270		83	0	0	0	387	1266	0	0	0	0	10	0	0	0		0	0	0	0	0	0	0	30	0	0		
6157+00	1025	0	175		88	0	0	0	324	964	0	0	0	0	10	0	350	0		0	11	148	0	191	0	30	248	0			
6157+50	77	0	22		7	0	0	0	18	88	0	0	0	0	10	0	132	0		0	10	46	0	76	0	30	99	0			
6157+61																															
Loop 'C'																															
7154+50	1025	0	83		28	0	0	0	162	974	0	0	0	0	10	0	25	0		0	0	0	0	25	0	30	33	0			
7155+00	2600	0	165		55	0	0	0	321	2499	0	0	0	0	10	0	25	0		0	0	0	0	25	0	30	33	0			
7155+50	2075	0	165		61	0	0	0	308	1993	0	0	0	0	10	0	0	0		0	0	0	0	0	0	0	30	0	0		
7156+00	600	0	83		46	0	0	0	192	537	0	0	0	0	10	0	1525	0		0	61	112	0	1352	0	30	1758	0			
7156+50	18	0	0		2	0	0	0	8	12	0	0	0	0	10	0	330	0		0	13	22	0	295	0	30	384	0			
7156+55																															
STAGE 5																															
owa Hwy. 64																															
2156+91		0	19		12	0	21	0	0	181	0	0	0	0	10	0	45	0		0	11	0	0	34	0	30	44	0			
2157+00	171	0	138		62	0	142	0	0	1083	0	0	0	0	10	0	125	0		0	30	0	0	95	0	30	124	0			
2157+50	1025	0	171		28	0	173	0	0	926	0	0	0	0	10	0	150	0		0	38	0	0	112	0	30	146	0			
2158+00	900	0	161		0	0	151	0	0	510	0	0	0	0	10	0	550	0													

TABULATION OF TEMPLATE QUANTITIES AND ADJUSTMENTS

Refer to Standard Road Plans RL-1A and RL-1B

STATION	TEMPLATE CUT	ADDITIONAL QUANTITY +C	SUBGRADE TREATMENT +C	MOISTURE AND DENSITY +C	TOPSOIL PLACEMENT +C	SELECT SOIL -C	PAVEMENT REMOVAL -C	ROCK -C	TOPSOIL REMOVAL -C	ADJUSTED EARTH CUT	UNSUIT-ABLE C - 3	UNSUIT-ABLE C - 5	ROCK CUT	ADDITIONAL ROCK CUT +C	PERCENT SWELL	ADJUSTED ROCK + SWELL	TEMPLATE FILL	ADDITIONAL QUANTITY +F	MOISTURE AND DENSITY +F	PAVEMENT REMOVAL +F	TOPSOIL PLACEMENT -F	SUBTRACT QUANTITY -F	SUBGRADE TREATMENT -F	ROCK FILL -F	ADJUSTED FILL	UNSUITABLE FILL	PERCENT SHRINK	ADJUSTED FILL + SHRINK	UNSUITABLE FILL + SHRINK	BALANCE AND OVERHAUL		
STAGE 6																																
Iowa Hwy. 64																																
2156+91																																+91
2157+00	99	0	25		6	0	27	0	0	103	0	0	0	0	10	0	18	0		0	8	0	0	0	10	0	30	13	0		OVERHAUL = 30,058 STA. m	
2157+50	1650	0	108		85	0	145	0	0	1698	0	0	0	0	10	0	50	0		0	23	0	0	0	27	0	30	35	0			
2158+00	3150	0	75		124	0	110	0	0	3239	0	0	0	0	10	0	0	0		0	0	0	0	0	0	0	30	0	0			
2158+50	2050	0	86		82	0	82	0	0	2136	0	0	0	0	10	0	0	0		0	0	0	0	0	0	0	30	0	0			
2159+00	575	0	96		38	0	81	0	0	628	0	0	0	0	10	0	125	0		0	42	0	0	0	83	0	30	108	0			
2159+50	350	0	96		24	0	54	0	0	416	0	0	0	0	10	0	150	0		0	31	0	0	0	119	0	30	155	0			
2160+00	300	0	71		25	0	15	0	0	381	0	0	0	0	10	0	125	0		0	22	0	0	0	103	0	30	134	0			
2160+50	625	0	68		25	0	0	0	0	718	0	0	0	0	10	0	325	0		0	42	25	0	0	258	0	30	335	0			
2161+00	975	0	98		11	0	0	0	0	1084	0	0	0	0	10	0	375	0		0	52	25	0	0	298	0	30	387	0			
2161+84	180	0	16		0	0	0	0	0	196	0	0	0	0	10	0	45	0		0	10	0	0	0	35	0	30	46	0			
Main line																																
135+50	0	0	0		60	0	0	0	35	25	0	0	0	0	10	0	1074	0		0	176	148	0	0	750	0	30	975	0		OVERHAUL = 203,967 STA. m	
136+00	74	0	0		40	0	0	0	76	38	0	0	0	0	10	0	2768	0		0	151	297	0	0	2320	0	30	3016	0			
136+50	199	0	0		39	0	0	0	97	141	0	0	0	0	10	0	2442	Crossover		0	116	297	0	0	2029	0	30	2638	0			
137+00	447	0	62		57	0	0	0	56	510	0	0	0	0	10	0	886	188		0	87	234	0	0	753	0	30	979	0			
137+50	378	0	62		49	0	0	0	42	447	0	0	0	0	10	0	991	0		0	93	234	0	0	664	0	30	863	0			
138+00	138	0	0		32	0	0	0	68	102	0	0	0	0	10	0	2354	0		0	119	297	0	0	1938	0	30	2519	0			
138+50	179	0	0		30	0	0	0	56	153	0	0	0	0	10	0	4062	0		0	158	297	0	0	3607	0	30	4689	0			
139+00	172	0	0		22	0	0	0	60	134	0	0	0	0	10	0	5109	Dike		0	188	297	0	0	4624	0	30	6011	0			
139+50	1477	0	148		46	0	0	0	186	1485	0	0	0	0	10	0	2727	37		0	107	148	0	0	2509	0	30	3262	0			
140+00	3588	0	297		75	0	0	0	312	3648	0	0	0	0	10	0	348	0		0	17	0	0	0	331	0	30	430	0			
140+50	5017	0	297		85	0	0	0	352	5047	0	0	0	0	10	0	272	Dike		0	6	0	0	0	266	0	30	346	0			
141+00	2840	0	157		46	0	0	0	195	2848	0	0	0	0	10	0	2228	19		0	130	140	0	0	1977	0	30	2570	0			
141+50	538	0	143		21	0	0	0	87	615	0	0	0	0	10	0	2184	0		0	154	140	0	0	1890	0	30	2457	0			
142+00	533	0	135		21	0	0	0	87	602	0	0	0	0	10	0	3461	0		0	124	135	0	0	3202	0	30	4163	0			
142+50	121	0	138		12	0	0	0	45	226	0	0	0	0	10	0	3605	0		0	145	146	0	0	3314	0	30	4308	0			
143+00	122	0	138		12	0	0	0	45	227	0	0	0	0	10	0	11035	Dike+entr		0	158	159	0	0	10718	0	30	13933	0			
143+50	781	0	0		18	0	0	0	79	720	0	0	0	0	10	0	20703	50		0	331	297	0	0	20125	0	30	26163	0			
144+00	1709	0	0		46	0	0	0	197	1558	0	0	0	0	10	0	17509	16152		0	412	297	0	0	32952	0	30	42838	0			
144+50	2081	0	0		44	0	0	0	285	1840	0	0	0	0	10	0	12113	Crossover		0	414	297	0	0	11402	0	30	14823	0			
145+00	2190	0	148		61	0	0	0	352	2047	0	0	0	0	10	0	4476	132		0	219	148	0	0	4241	0	30	5513	0			
145+50	3666	0	297		90	0	0	0	388	3665	0	0	0	0	10	0	2	Dike		0	0	0	0	0	2	0	30	3	0			
146+00	7006	0	297		77	0	0	0	477	6903	0	0	0	0	10	0	2	0		0	0	0	0	0	0	0	30	0	0			
146+50	8485	0	297		63	0	0	0	536	8309	0	0	0	0	10	0	0	0		0	0	0	0	0	0	0	30	0	0			
147+00	9164	Entrance	297		77	0	0	0	496	9042	0	0	0	0	10	0	0	Cover+entr		0	0	0	0	0	0	0	30	0	0			
147+50	9010	1239	297		91	0	0	0	391	10246	0	0	0	0	10	0	0	1048		0	0	0	0	0	1048	0	30	1362	0			
148+00	6277	0	297		112	0	0	0	359	6327	0	0	0	0	10	0	0	0		0	0	0	0	0	0	0	30	0	0			
148+50	2584	0	148		89	0	0	0	270	2551	0	0	0	0	10	0	1342	0		0	68	148	0	0	1126	0	30	1464	0			
149+00	1647	0	0		40	0	0	0	185	1502	0	0	0	0	10	0	5111	0		0	144	297	0	0	4670	0	30	6071	0			
149+50	6116	0	154		79	0	84	0	329	5936	0	0	0	0	10	0	4519	0		0	158	291	0	0	4070	0	30	5291	0			
150+00	7500	0	154		61	0	84	0	213	7418	0	0	0	0	11	0	750	0		0	81	143	0	0	526	0	30	684	0			

TABULATION OF TEMPLATE QUANTITIES AND ADJUSTMENTS


Refer to Standard Road Plans RL-1A and RL-1B

107-28

03-26-96

STATION	TEMPLATE CUT	ADDITIONAL QUANTITY	SUBGRADE TREATMENT	MOISTURE AND DENSITY	TOPSOIL PLACEMENT	SELECT SOIL	PAVEMENT REMOVAL	ROCK	TOPSOIL REMOVAL	ADJUSTED EARTH CUT	UNSUIT-ABLE	UNSUIT-ABLE	ROCK CUT	ADDITIONAL ROCK CUT	PERCENT SWELL	ADJUSTED ROCK + SWELL	TEMPLATE FILL	ADDITIONAL QUANTITY	MOISTURE AND DENSITY	PAVEMENT REMOVAL	TOPSOIL PLACEMENT	SUBTRACT QUANTITY	SUBGRADE TREATMENT	ROCK FILL	ADJUSTED FILL	UNSUITABLE FILL	PERCENT SHRINK	ADJUSTED FILL + SHRINK	UNSUITABLE FILL + SHRINK	BALANCE AND OVERHAUL
	+C	+C	+C	+C	-C	-C	-C	-C	-C	C - 3	C - 5	+C	-F	-F	-F	-F	-F	-F	-F	-F	-F	-F	-F	-F	-F	-F	-F			
Borrow Site "B"																														
161+70	14115	0	0		0	6089	0	0	881	7145			608	0	10	0	0	0		0		0	0	0	0	0	30	0	0	
162+00	59825	0	0		0	31480	0	0	3248	25097			1558	0	10	0	0	0		0		0	0	0	0	0	30	0	0	
162+50	78600	0	0		0	43580	0	0	6108	28912			545	0	10	0	0	0		0		0	0	0	0	0	30	0	0	
163+00	78075	0	0		0	27105	0	0	7528	43442			0	0	10	0	0	0		0		0	0	0	0	0	30	0	0	
163+50	51075	0	0		0	6525	0	0	7003	37547			0	0	10	0	0	0		0		0	0	0	0	0	30	0	0	
164+00	17015	0	0		0	1668	0	0	5378	9969			0	0	10	0	0	0		0		0	0	0	0	0	30	0	0	
164+50	1790	0	0		0	0	0	0	1638	152			0	0	10	0	0	0		0		0	0	0	0	0	30	0	0	
165+00	11	0	0		0	0	0	0	9	2			0	0	10	0	0	0		0		0	0	0	0	0	30	0	0	
165+07																														

dgm = L:\WORK\PROJECT\34120\CAUD\EA5\5/15/1063.t05
 prf = \\WATSON\DATA\PL01\PL463P\105.PRF
 date = Fri Oct 29 14:32:08 1999
 levels = 1-63
 pen table = I:\plot\tables\ha1fv.t.tbl

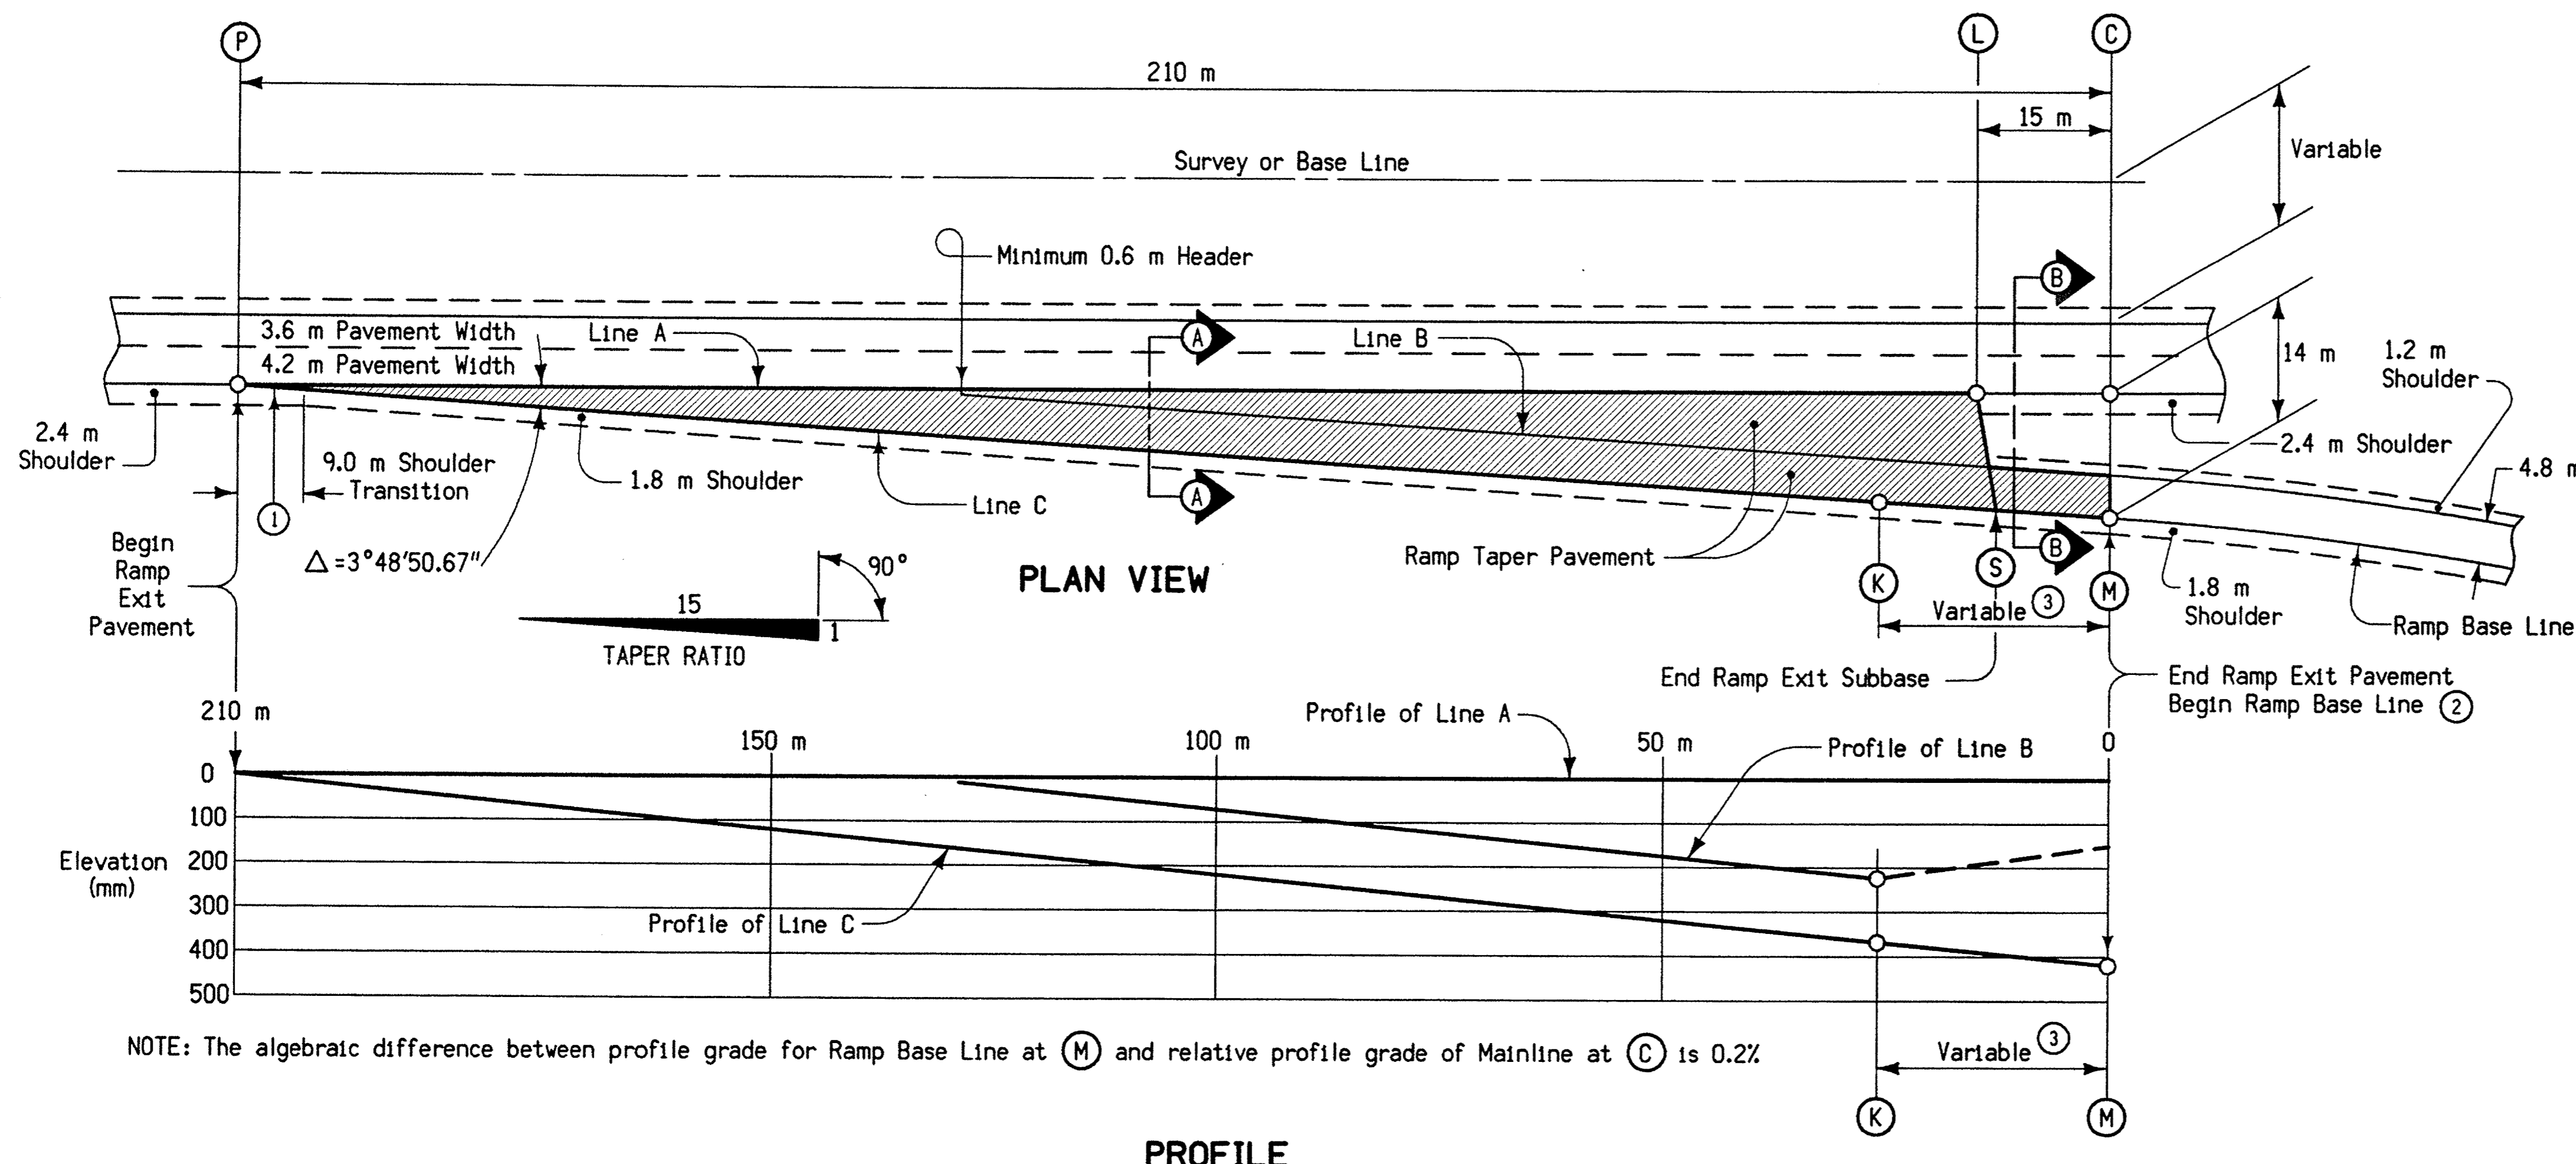

GENERAL NOTES:

This detail sheet shows ramp alignment and grade data for the ramp exit pavement.

Materials and methods of construction shall be in accordance with current Standard and Supplemental Specifications.

Ramp exit pavement shall be the same thickness as the mainline pavement. Ramp exit subbase for both A.C.C. and P.C.C. pavement shall be the same thickness as the mainline subbase.

Ramp exit pavement area shown by shaded area is 1345 square meters.

In order to assure proper drainage, any special shaping of exit area between lines A and B shall be accomplished by methods approved by the Engineer.

Refer to Detail Sheet 550-5 for jointing layout.

Refer to typical cross sections and appropriate Standard Road Plans for design details and requirements for shoulders.

- ① For header construction details at the beginning of taper, refer to the appropriate Typical 7101, 7102, or 7120.
- ② Refer to detail project plans for ramp alignment and grade data.
- ③ The ramp pavement cross slope is determined by superelevation rotated about line C. Refer to Standard Road Plan RP-3 and detail project plans for superelevation transition requirements.

TABLE OF OFFSETS AND DROPS FOR 4.8 m RAMP TAPER

Distance (m) From Point C Along Line A	210	200	190	180	170	160	150	140	130	120	110	100	90	80	70	60	50	40	30	20	10	0
Offset (m) From Line A To Line C	0	0.667	1.333	2.000	2.667	3.333	4.000	4.667	5.333	6.000	6.667	7.333	8.000	8.667	9.333	10.000	10.667	11.333	12.000	12.667	13.333	14.000
Drop (mm) From Line A To Line C	0	20	40	60	80	100	120	140	160	180	200	220	240	260	280	300	320	340	360	380	400	420


NOTE: The elevations at edge of taper from BEGIN TAPER to POINT (M) are established by a constant 3% slope across the appropriate taper widths based on the Taper Ratio of 15:1, Drop = (0.03) x (Offset).

GENERAL REQUIREMENTS			
IDENTIFICATION		EQUIVALENT STATIONS	
INTERCHANGE	RAMP	(C)	(M)


All dimensions given in millimeters unless noted.

M METRIC VERSION	Project Development Division		
	DETAIL SHEET		550-1
	REVISION: Revise shoulder and pavement widths (outside lane).		REVISION NO. 9 REVISION DATE 10-27-98

DECELERATION TAPER FOR 4.8 m EXIT RAMP


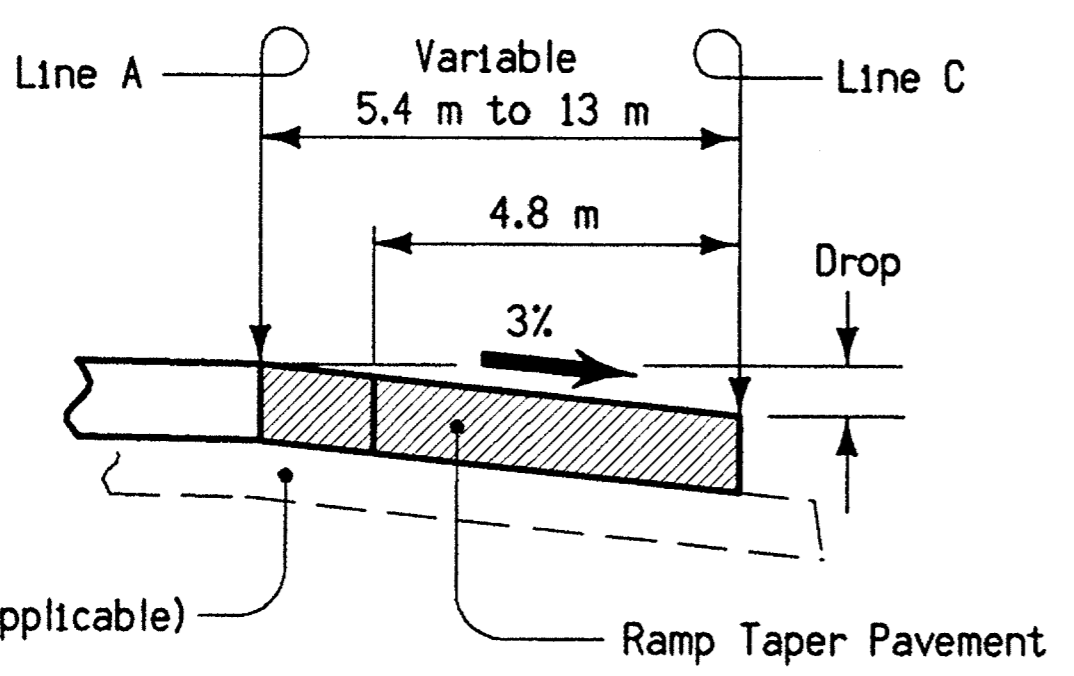


SECTION A-A

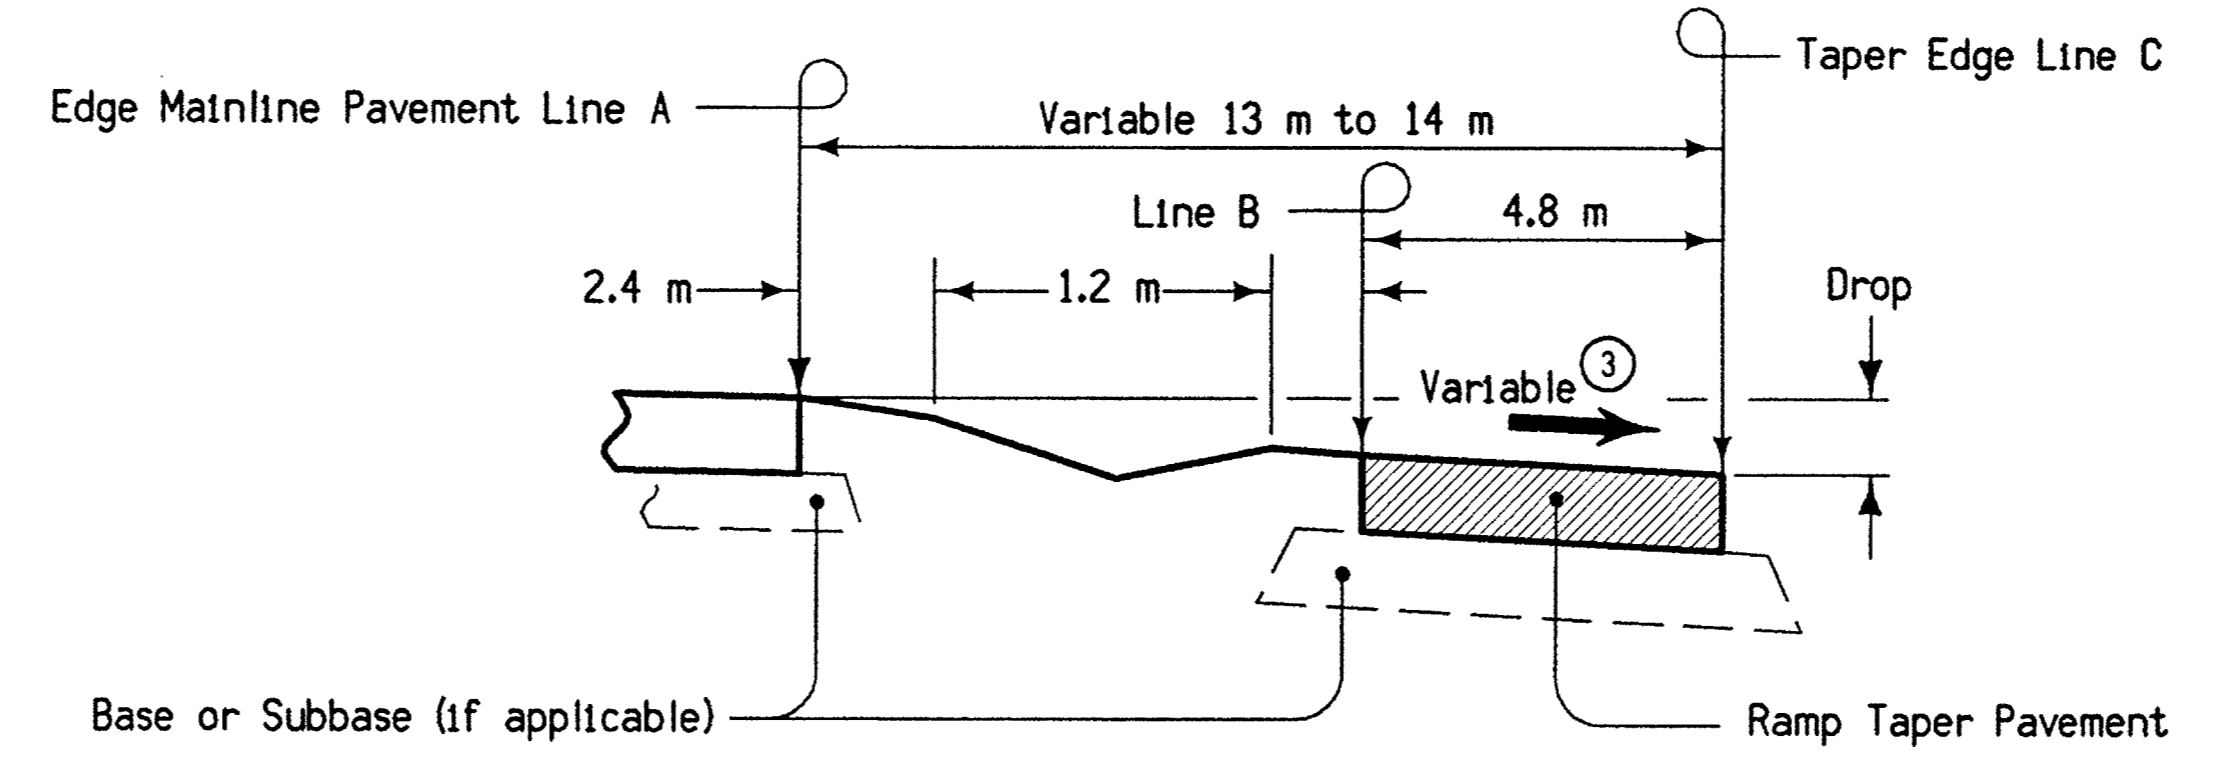

SECTION B-B


dgr = L:\WORK\PHOTO\JUN31\20\UN\CAD\AS\153151063.d01
 prf = L:\WATSON\DATA\PL\16\163P\U01.PRF
 Date = Wed Jun 30 15:08:23 1999
 pen table = L:\plot\tables\hal.fwt.tbl
 levels = 1-63

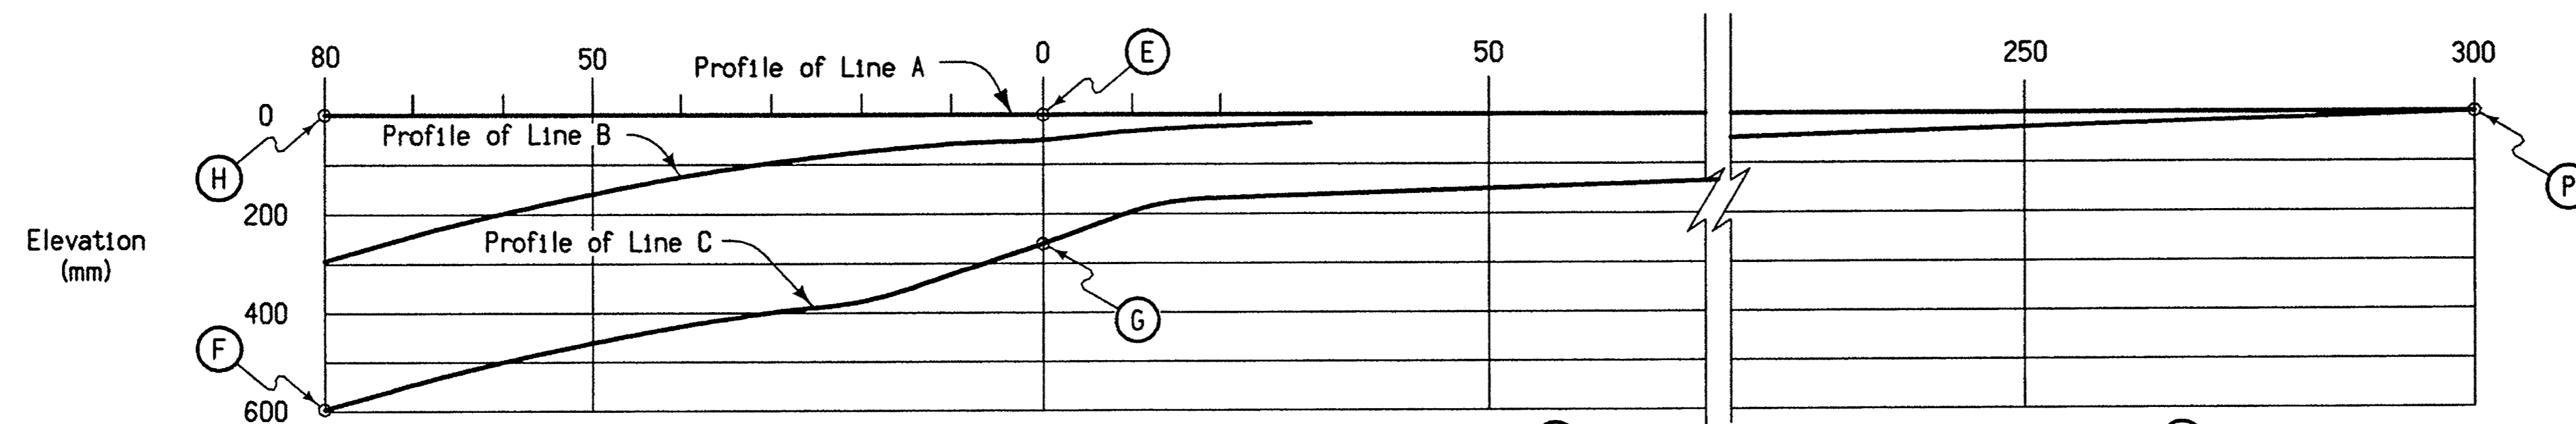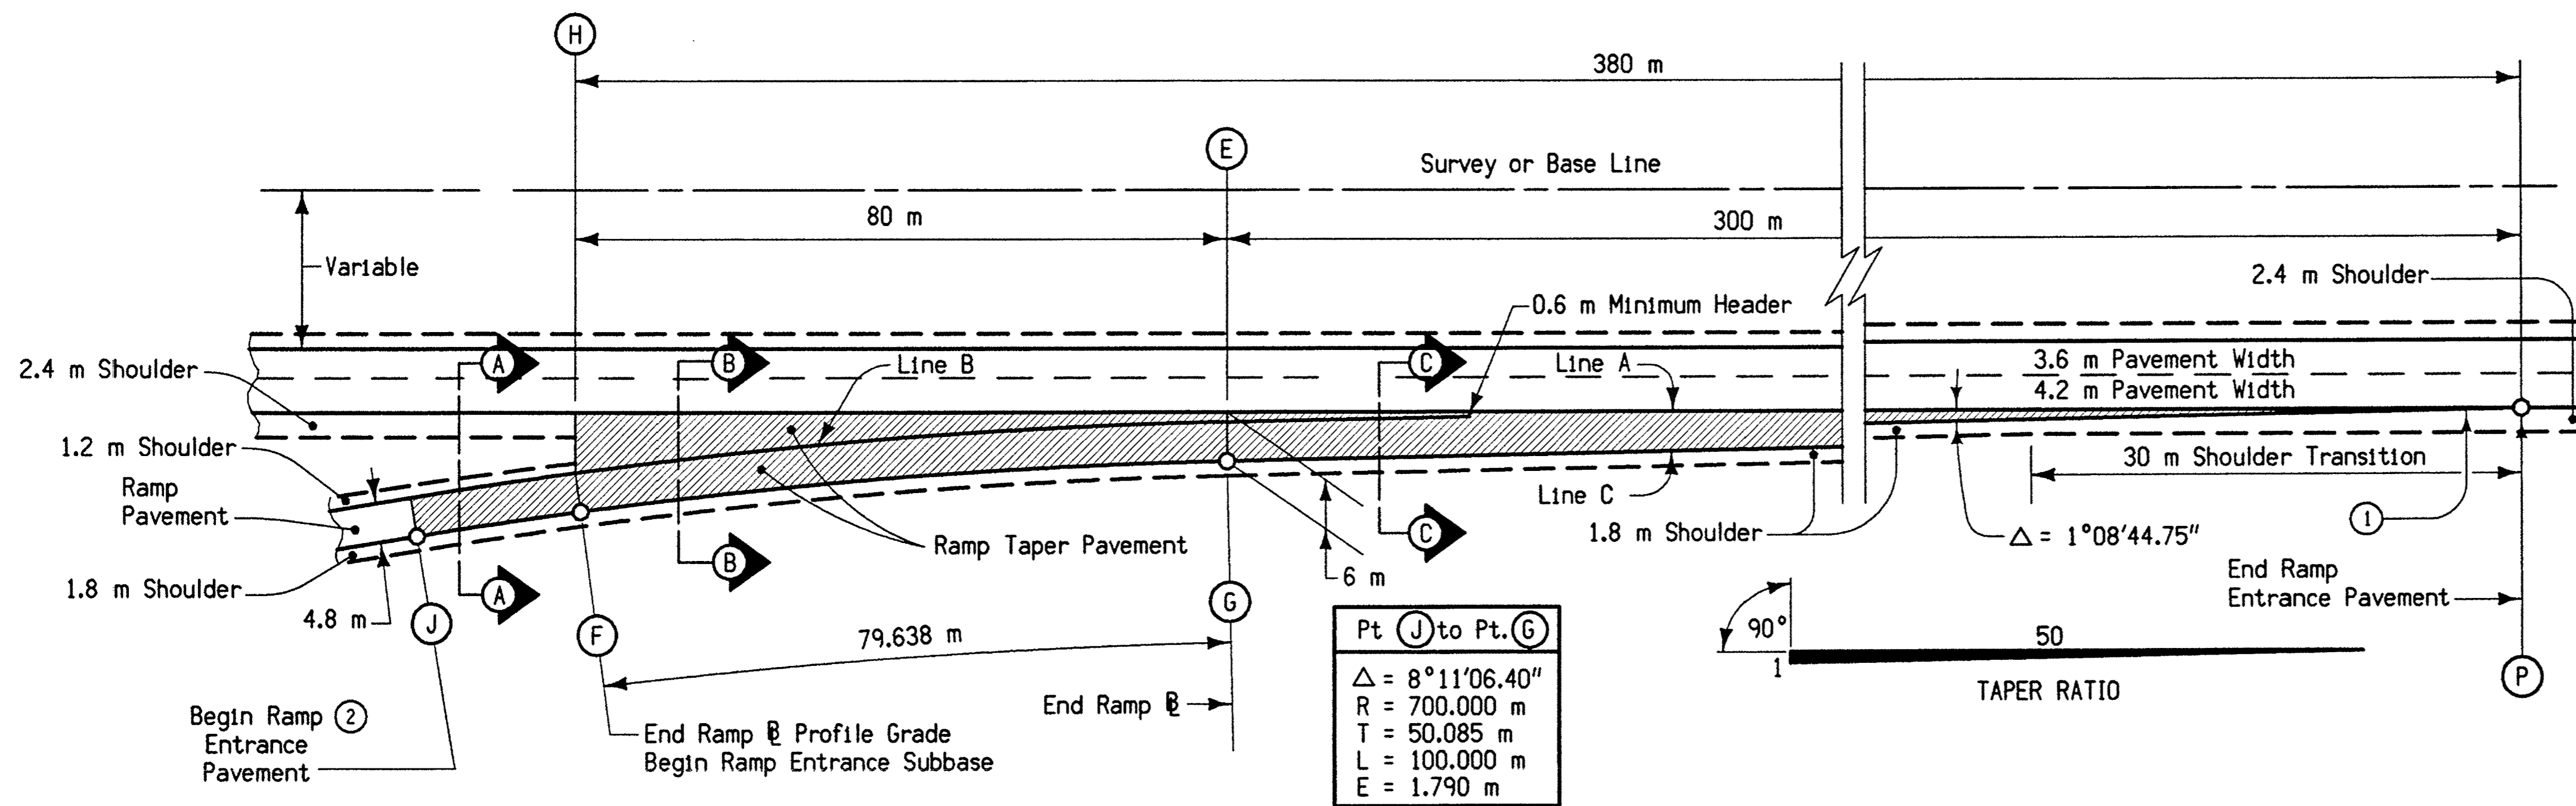


NOTE: The algebraic difference between profile grade for Ramp Base Line at (F) and relative profile grade of Mainline at (H) is 0.54%.

PROFILE


TABLE OF OFFSETS AND DROPS FOR 4.8 m RAMP TAPER																		
Distance From Point (E) Along Line A (m)	80	70	60	50	40	30	20	10	0	10	20	50	100	150	200	250	300	
From Line A To Line B	Offset (m)	7.356	6.083	4.955	3.971	3.131	2.435	1.880	1.469	1.200								
	Slope (%)	← Constant 4.00% Slope →																
	Drop (mm)	294	243	198	159	125	97	75	59	48								
From Line B To Line C	Offset (m)	← Constant 4.8 m Offset →																
	Slope (%)	6.30	6.30	6.30	6.30	6.30	6.30	6.30	5.46	4.41								
	Drop (mm)	302	302	302	302	302	302	302	262	212								
From Line A To Line C	Offset (m)									6.000	5.800	5.600	5.000	4.000	3.000	2.000	1.000	0.000
	Slope (%)									4.41	3.36	3.00	← Constant 3.00% →					
	Drop (mm)	596	545	500	461	427	399	377	322	260	195	168	150	120	90	60	30	0
Distance From Point (G) Along Line C (m)	79.638	69.626	59.631	49.651	39.684	29.728	19.780	9.840	0.000									

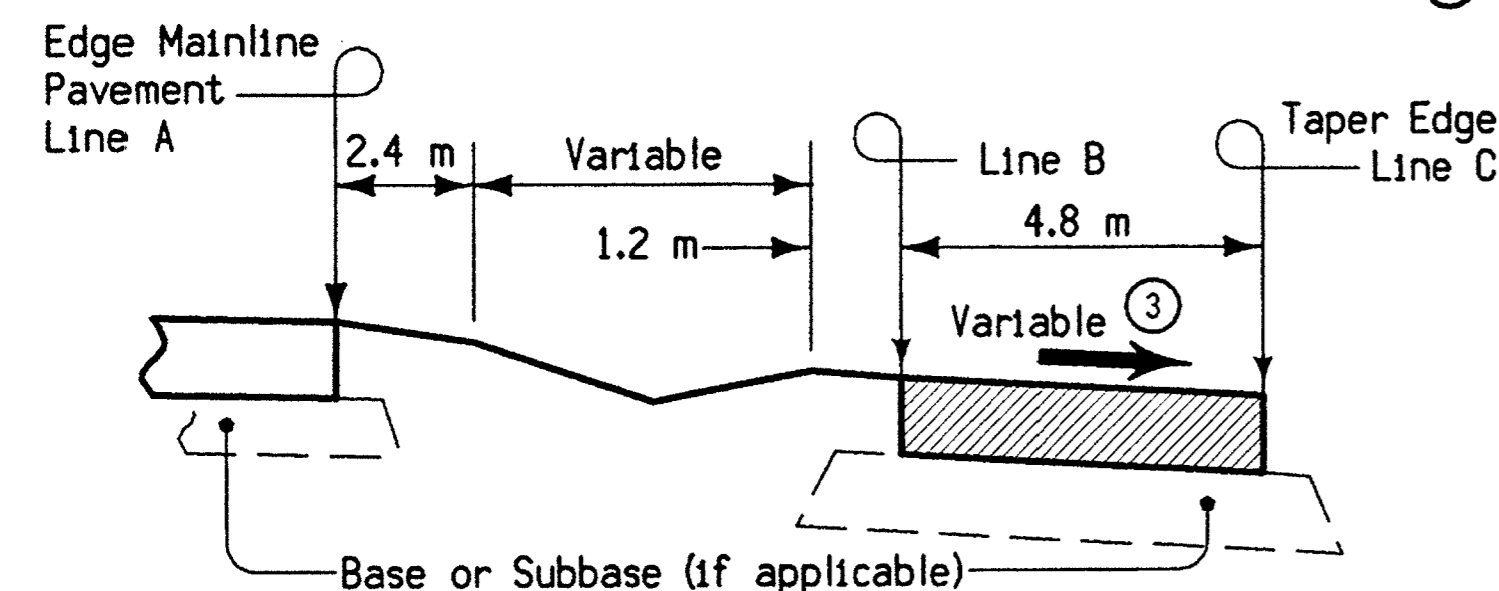

SECTION A-A

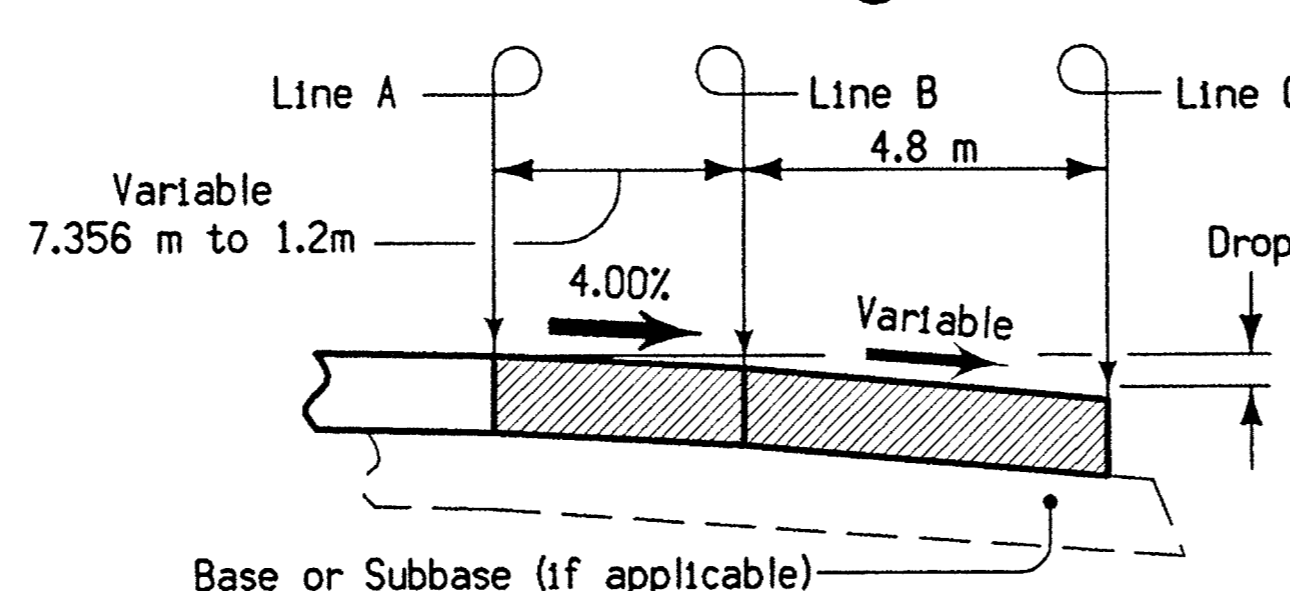

SECTION B-B

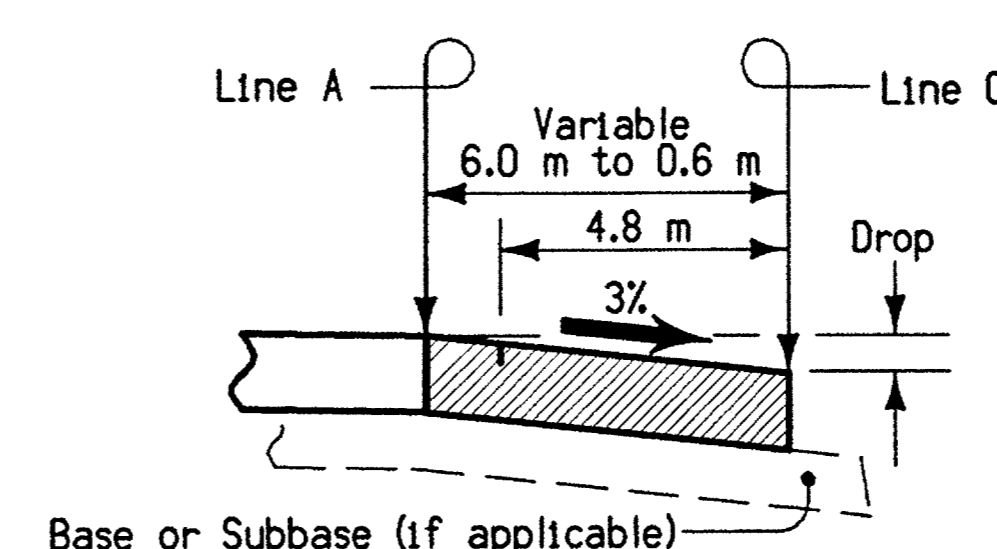

SECTION C-C

GENERAL NOTES:

This detail sheet shows ramp alignment and grade data for the ramp entrance pavement.

Materials and methods of construction shall be in accordance with current Standard and Supplemental Specifications.

Ramp entrance pavement shall be the same thickness as the mainline pavement. Ramp entrance subbase for both A.C.C. and P.C.C. pavement shall be the same thickness as the mainline subbase.

Ramp entrance pavement area shown by shaded area is 1663 square meters.

In order to assure proper drainage, any special shaping of entrance area between lines A and B shall be accomplished by methods approved by the Engineer.

Refer to Detail Sheet 550-5 for jointing layout.

Refer to typical cross sections and appropriate Standard Road Plans for design details and requirements for shoulders.


- ① For header construction details at the beginning of taper, refer to the appropriate Typical 7101, 7102, or 7120.
- ② Refer to detail project plans for ramp alignment and grade data.
- ③ The ramp pavement cross slope between point (J) and point (F) is determined by superelevation rotated about line "C". Refer to Standard Road Plan RP-3 and detail project plans for superelevation transition requirements.

GENERAL REQUIREMENTS			
IDENTIFICATION		EQUIVALENT STATIONS	
INTERCHANGE	RAMP	(E)	(G)


All dimensions given in millimeters unless noted.

M METRIC VERSION	Project Development Division		
	DETAIL SHEET		550-2C
	REVISION: Revise shoulder and pavement widths (outside lane).		REVISION NO. 5 REVISION DATE 10-27-98
ACCELERATION TAPER FOR 4.8 m ENTRANCE RAMP (e max. = 8%)			

dgn = L:\WORK\PROJECT\34120\CAAD\AS\NS3151063.u01
 prf = \\WATS01\DATA\PLT\463\U02.PRF
 date = Wed Jun 30 15:13:16 1999
 pen table = I:\plot\tables\hal.fwt.tbl
 levels = 1-63

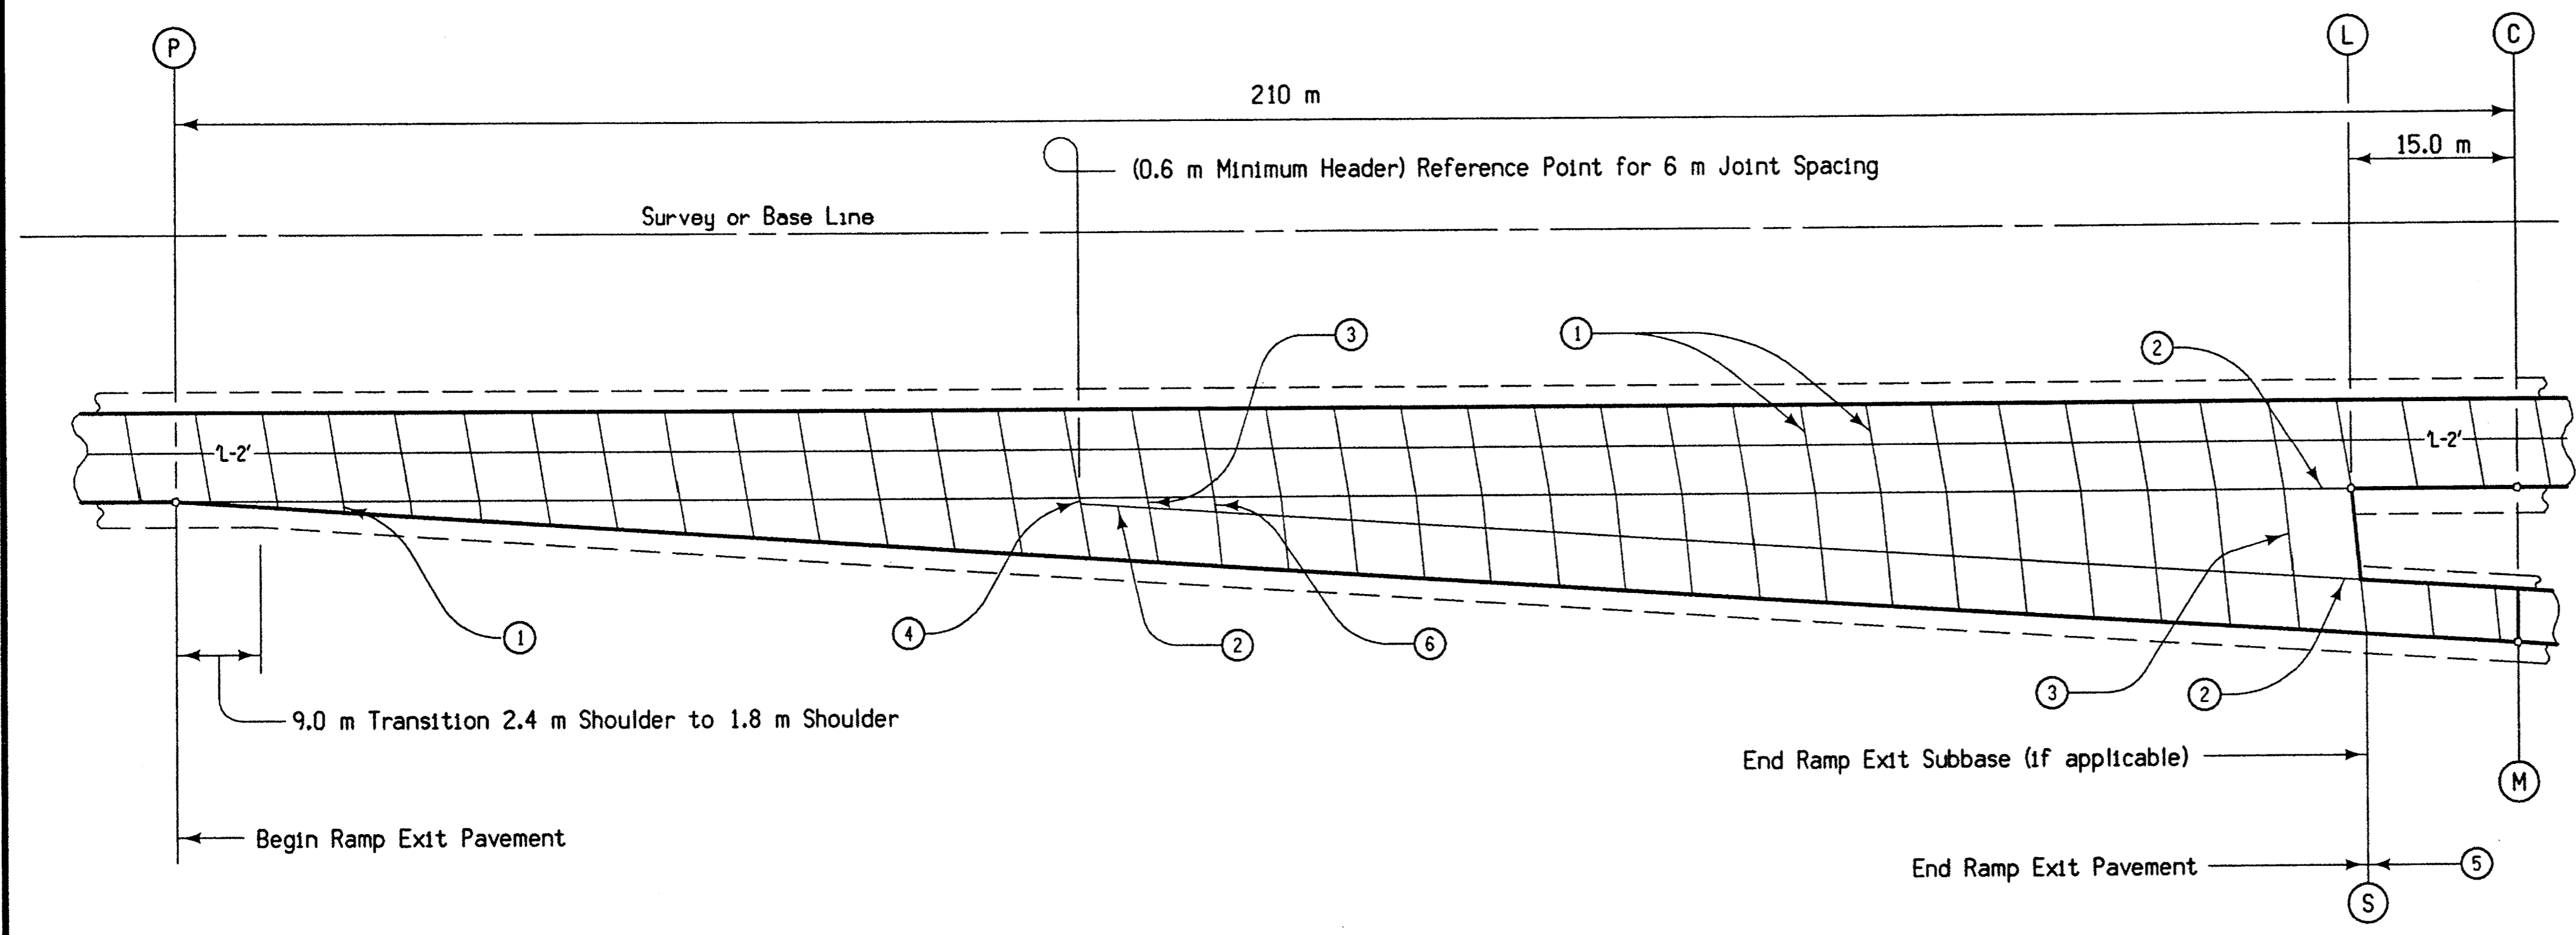

4.8 m EXIT RAMP

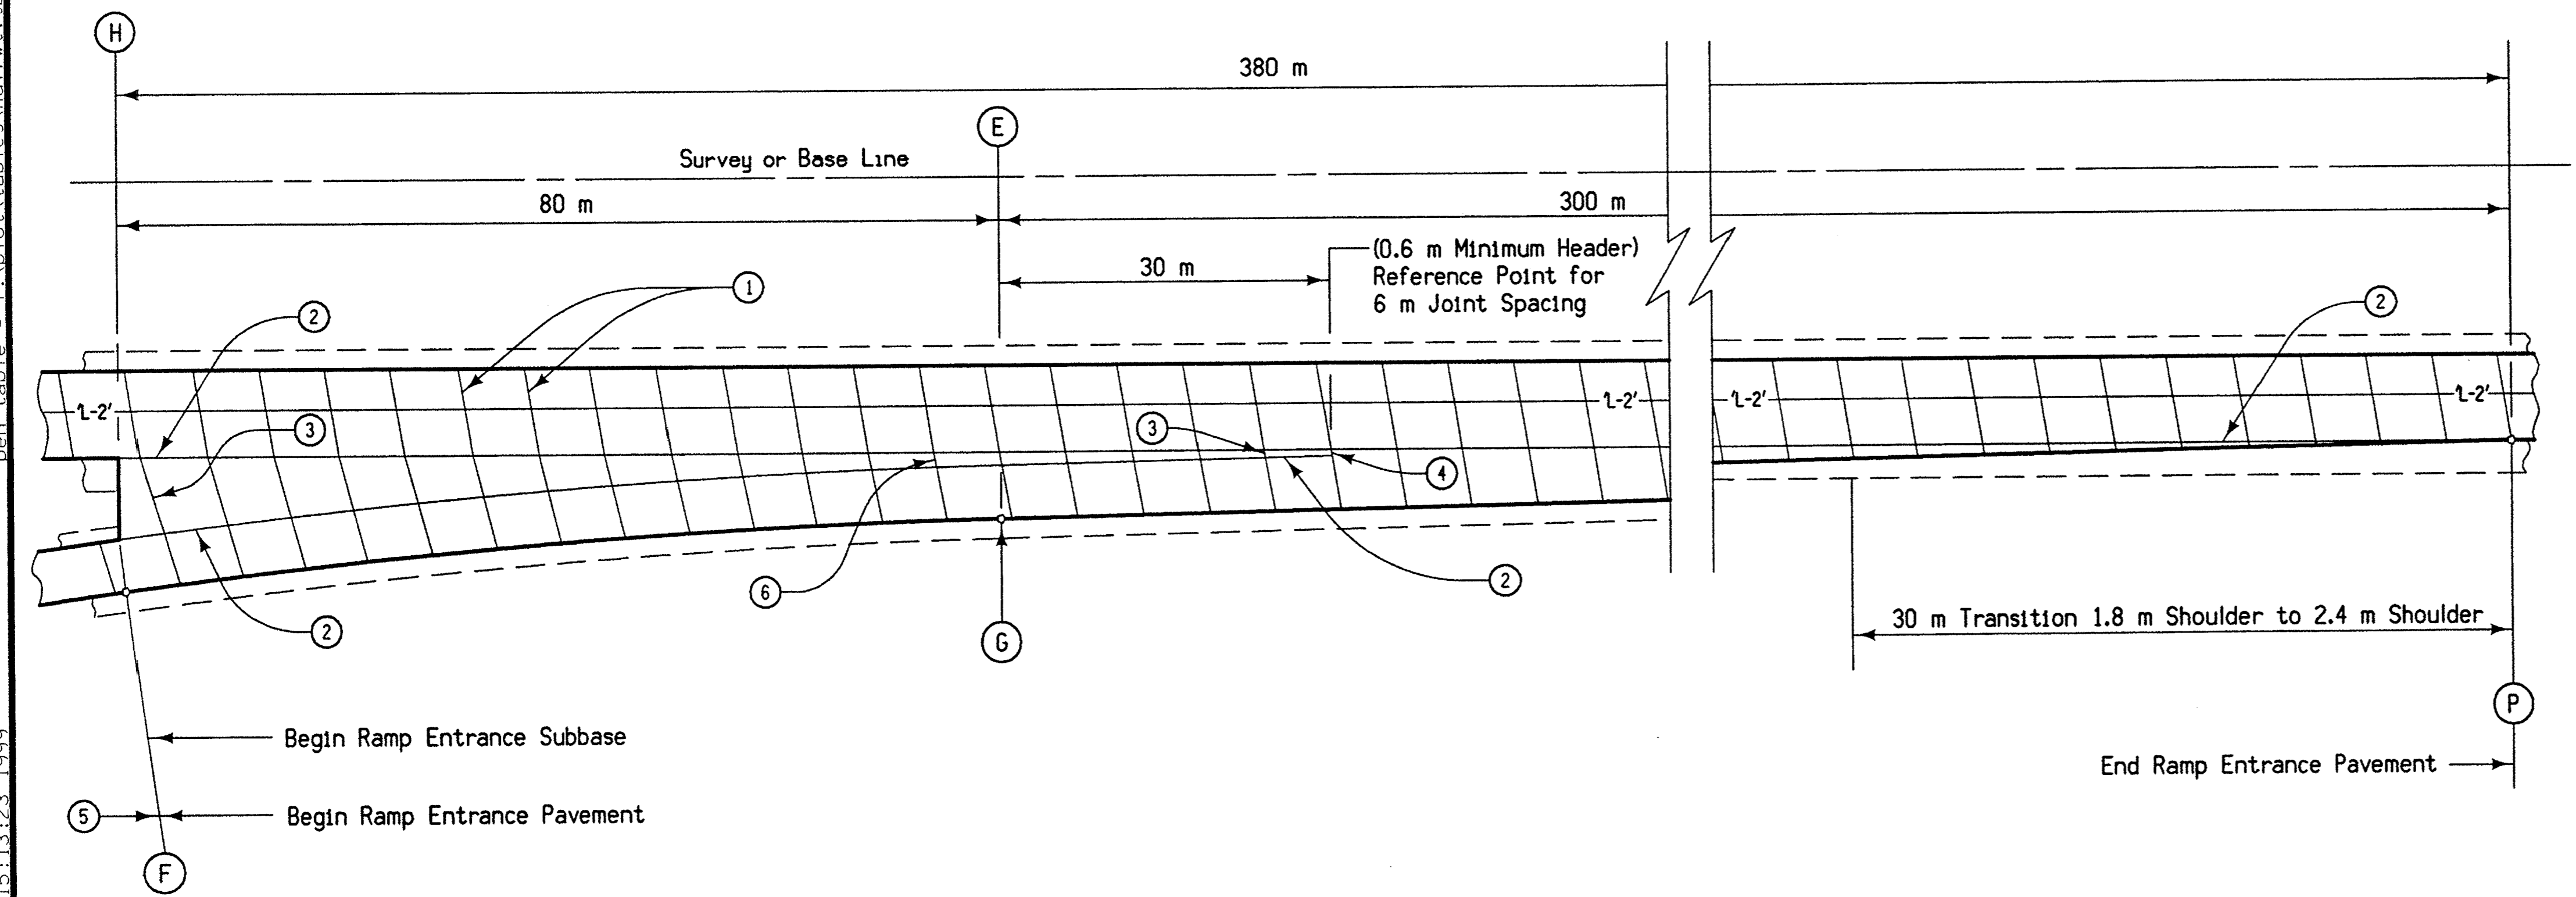

4.8 m ENTRANCE RAMP

GENERAL NOTES:

This plan sheet illustrates the jointing layouts for 4.8 meter exit and entrance ramps. Details are typical. Alternate methods of construction may be submitted to the Engineer for approval.

Materials and methods of construction shall be in accordance with current Standard and Supplemental Specifications.

Refer to Standard Road Plans RH-50, RH-51 and RH-52 for details of construction of pavement joints.

Refer to the appropriate Detail Sheets for the geometric layout and taper profile elevations.

No payment will be made for jointing as detailed on this sheet. The cost of jointing as indicated shall be considered incidental to "Standard or Slip Form Portland Cement Concrete Pavement".

SUGGESTED CONSTRUCTION SEQUENCE

1. Mainline Pavement
2. Ramp Pavement
3. Ramp Exit Pavement or Ramp Entrance Pavement


SPECIAL NOTES:

- ① All mainline transverse joints through the taper shall be 'CD' Joints skewed at 6:1 right ahead and shall be spaced at 6 m intervals. See Standard Road Plan RH-50 for details of joint construction.
- ② 'BT-2' or 'KT-2' Joint. Refer to Standard Road Plan RH-51 for details of joint construction.
- ③ 'C' Joint, refer to Standard Road Plan RH-50 for details of joint construction.
- ④ 'B' Joint, refer to Standard Road Plan RH-50 for details of joint construction.
- ⑤ Refer to Detail Project Plans for ramp jointing.
- ⑥ The transverse joints on the ramp shall be skewed 6:1 with reference to the ramp baseline where the gore area is 1.2 meters or greater.

All dimensions given in millimeters unless noted.

M	Project Development Division	
	DETAIL SHEET 550-5	
	REVISION: Revise shoulder width from 2.3 m to 2.4 m.	REVISION NO. 2 REVISION DATE 10-27-98
METRIC VERSION	TYPICAL JOINTING DETAILS FOR 4.8 m EXIT AND ENTRANCE RAMP	

dcn = L:\WORK\PROJ\4120\CAD\NEAS\153151063.u01
 pof = \WATSON\DATA\PLT\463R\U03.PRF
 Date = Wed Jun 30 15:13:23 1999
 level = 1-63
 open table = L:\plot\tables\half.tbl

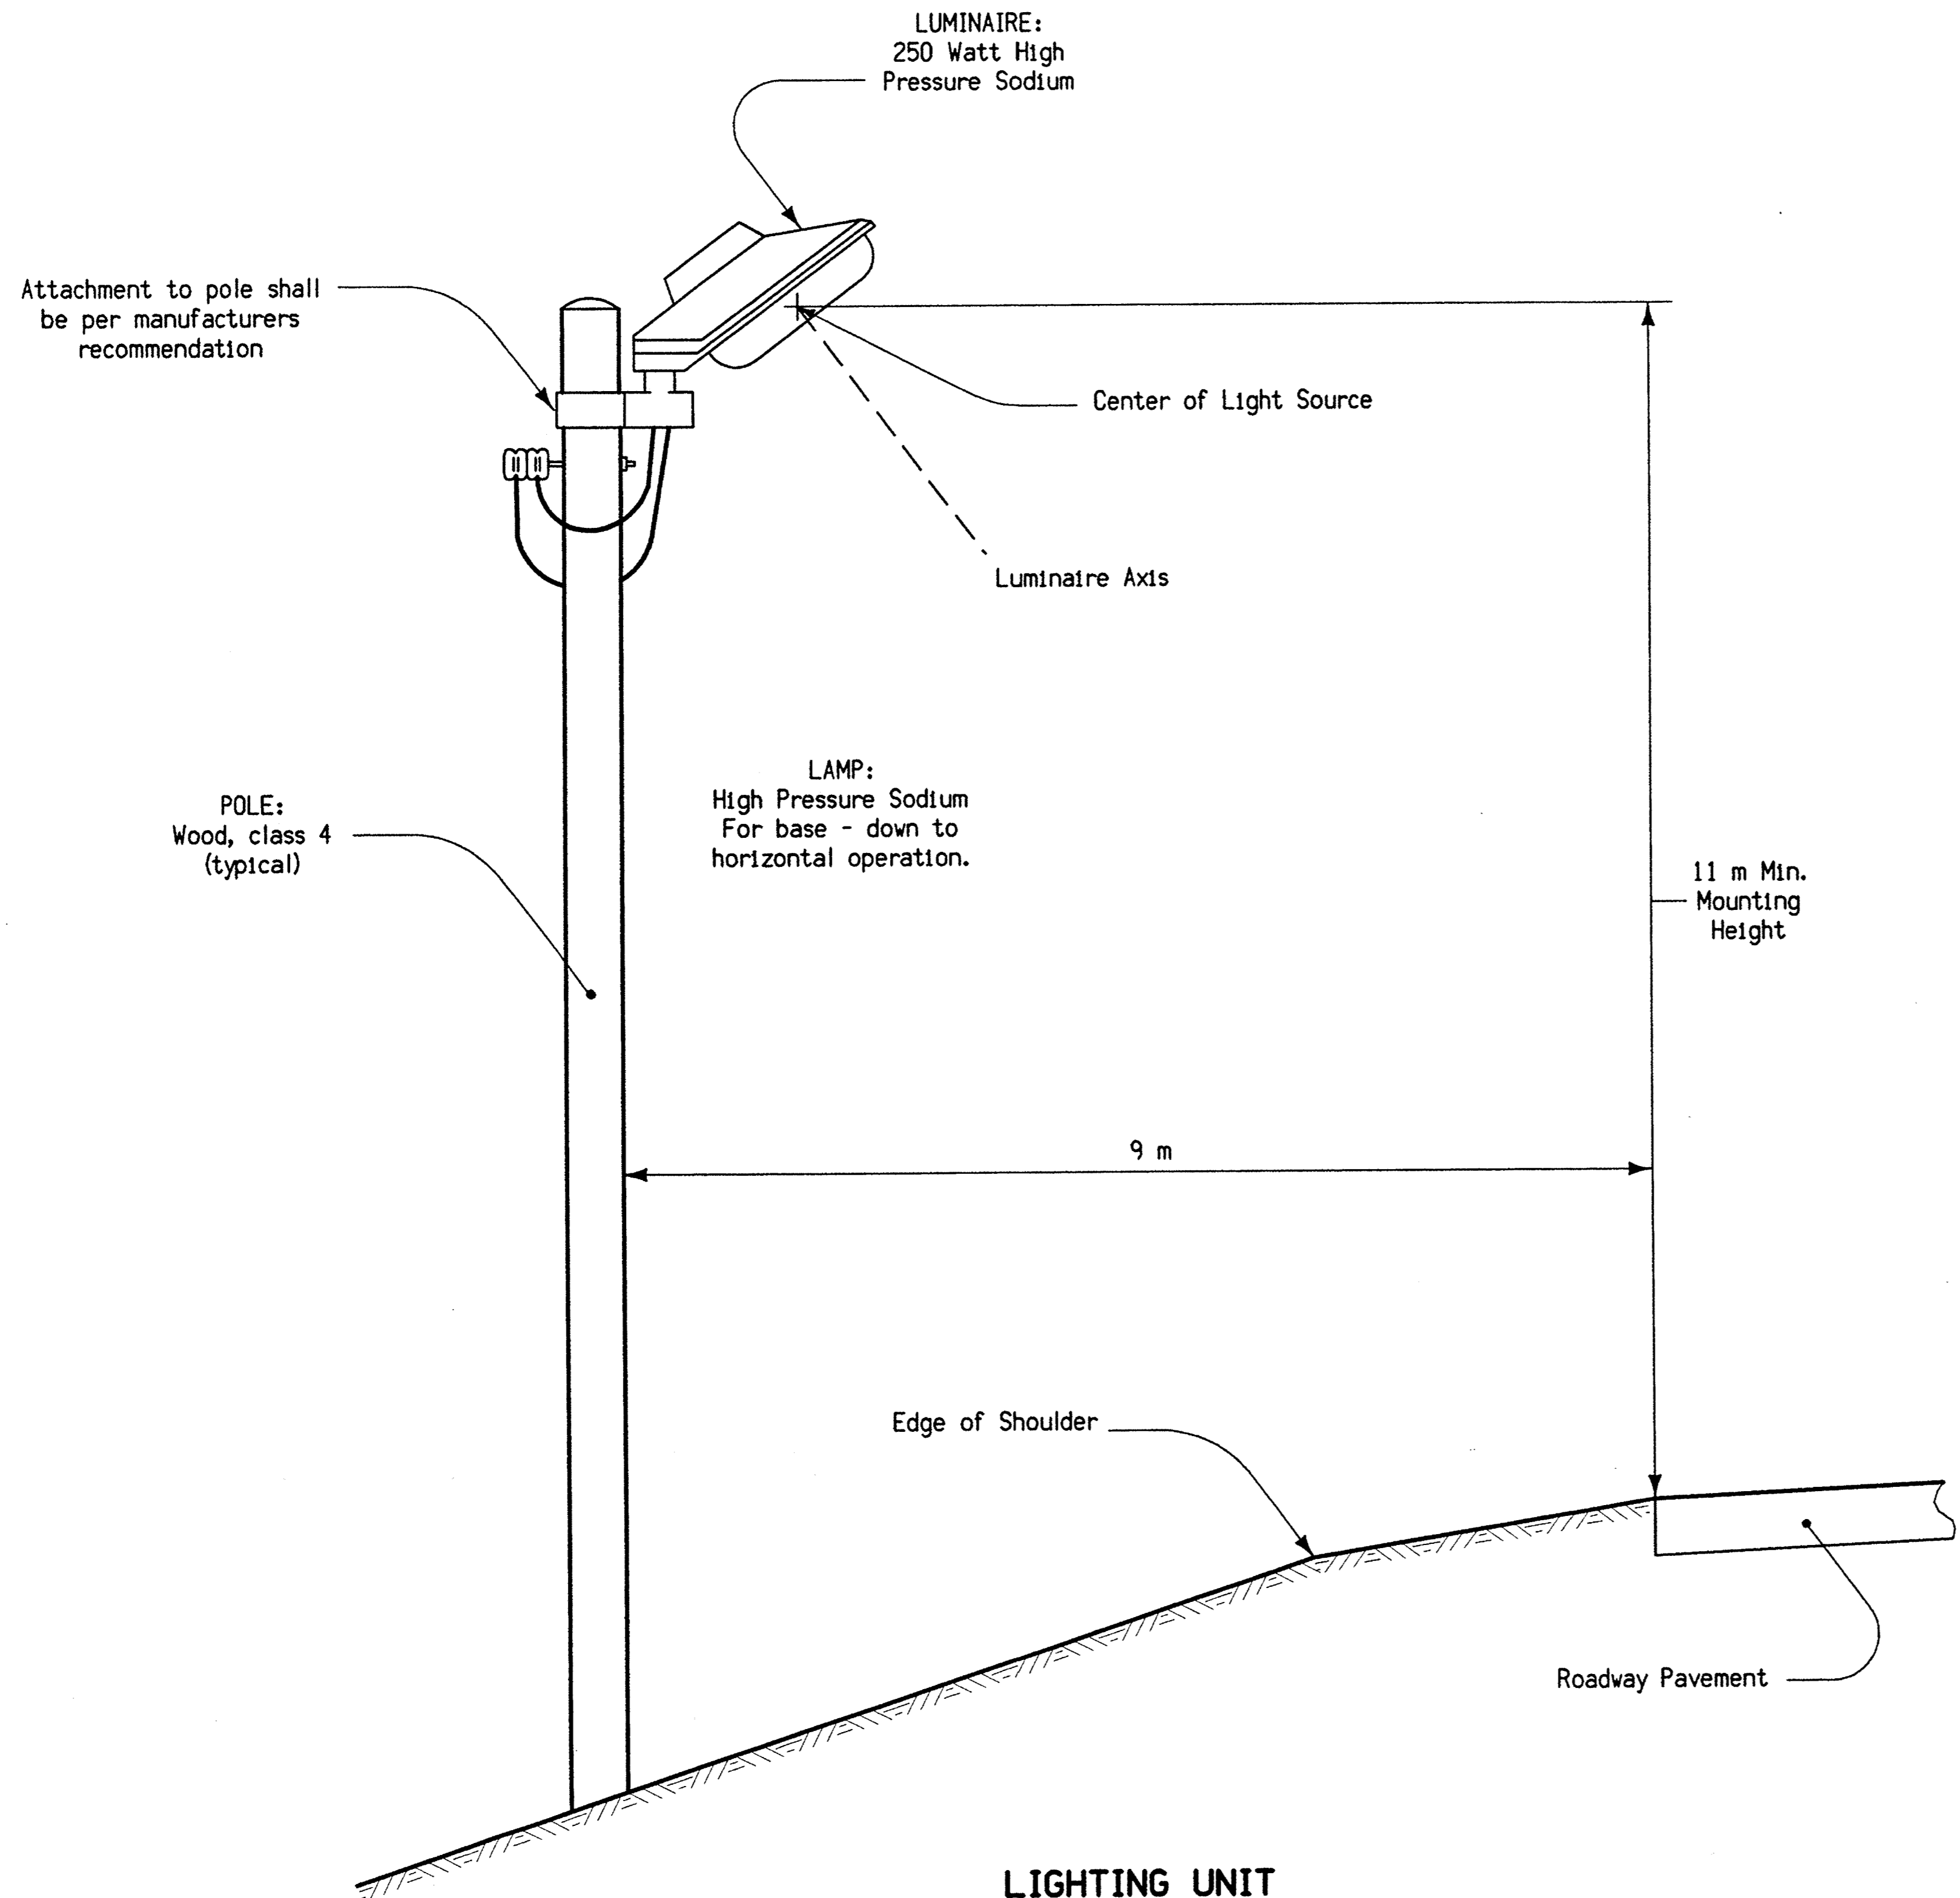

**LIGHTING UNIT
INSTALLATION DETAILS**

GENERAL NOTES:

Temporary floodlighting will be required on this project. The lighting shall conform to current Standard and Supplemental Specifications for floodlighting, Articles 2528.08 and 2528.12 paragraph A (5) except as modified hereon.

Temporary floodlighting shall consist of either a pole mounted luminaire as illustrated hereon or a luminaire mounted on portable type equipment. Location of the temporary floodlighting shall be as shown in the Traffic Control Plan or as determined by the Engineer. The contractor shall determine pole length by field measurement to obtain specified mounting height. Luminaire axis shall be directed to within the limits of the near traffic lane unless specified otherwise.

Proposals for alternatives to the class 4 wood pole used to mount luminaire may be submitted to the Engineer for approval.

The luminaire shall be designed to operate without a mastarm. The "Vector" and "Expressway" luminaire by the Holophane Company, Inc. or the "Interstate" luminaire by the Amerion Electric Division of I.T.T. are the approved luminaires.

Aerial lighting circuits shall be aluminum or A.C.S.R. triplex. Underground lighting circuits shall be type U.S.E. or U.F. All circuit design and materials shall be approved by the engineer before installation commences.


Price bid for "Temporary Floodlighting Luminaire" shall include all cost for furnishing, installing, maintaining and servicing the Temporary Floodlighting Units, all costs for electrical energy, and the cost of removing all lighting materials from the construction site.

All dimensions given in millimeters unless noted.


METRIC VERSION	M		Project Development Division	
	DETAIL SHEET		570-2	
	REVISION: Metric conversion of Detail Sheet 570-2 no. 8 (dated 6-15-93).		REVISION NO. 8	REVISION DATE 03-28-95
TEMPORARY FLOODLIGHTING (OFFSET)				

dcn = L:\WORK\PROJECT\34120\CADD\NEAS\53151063.u01
 pff = \\WATSON\DATA\PLT\PL463P\U04.PRF
 date = Wed Jun 30 15:08:42 1999
 pen table = I:\p\lot\tables\hal.fvt.tbl
 levels = 1-63

Revised

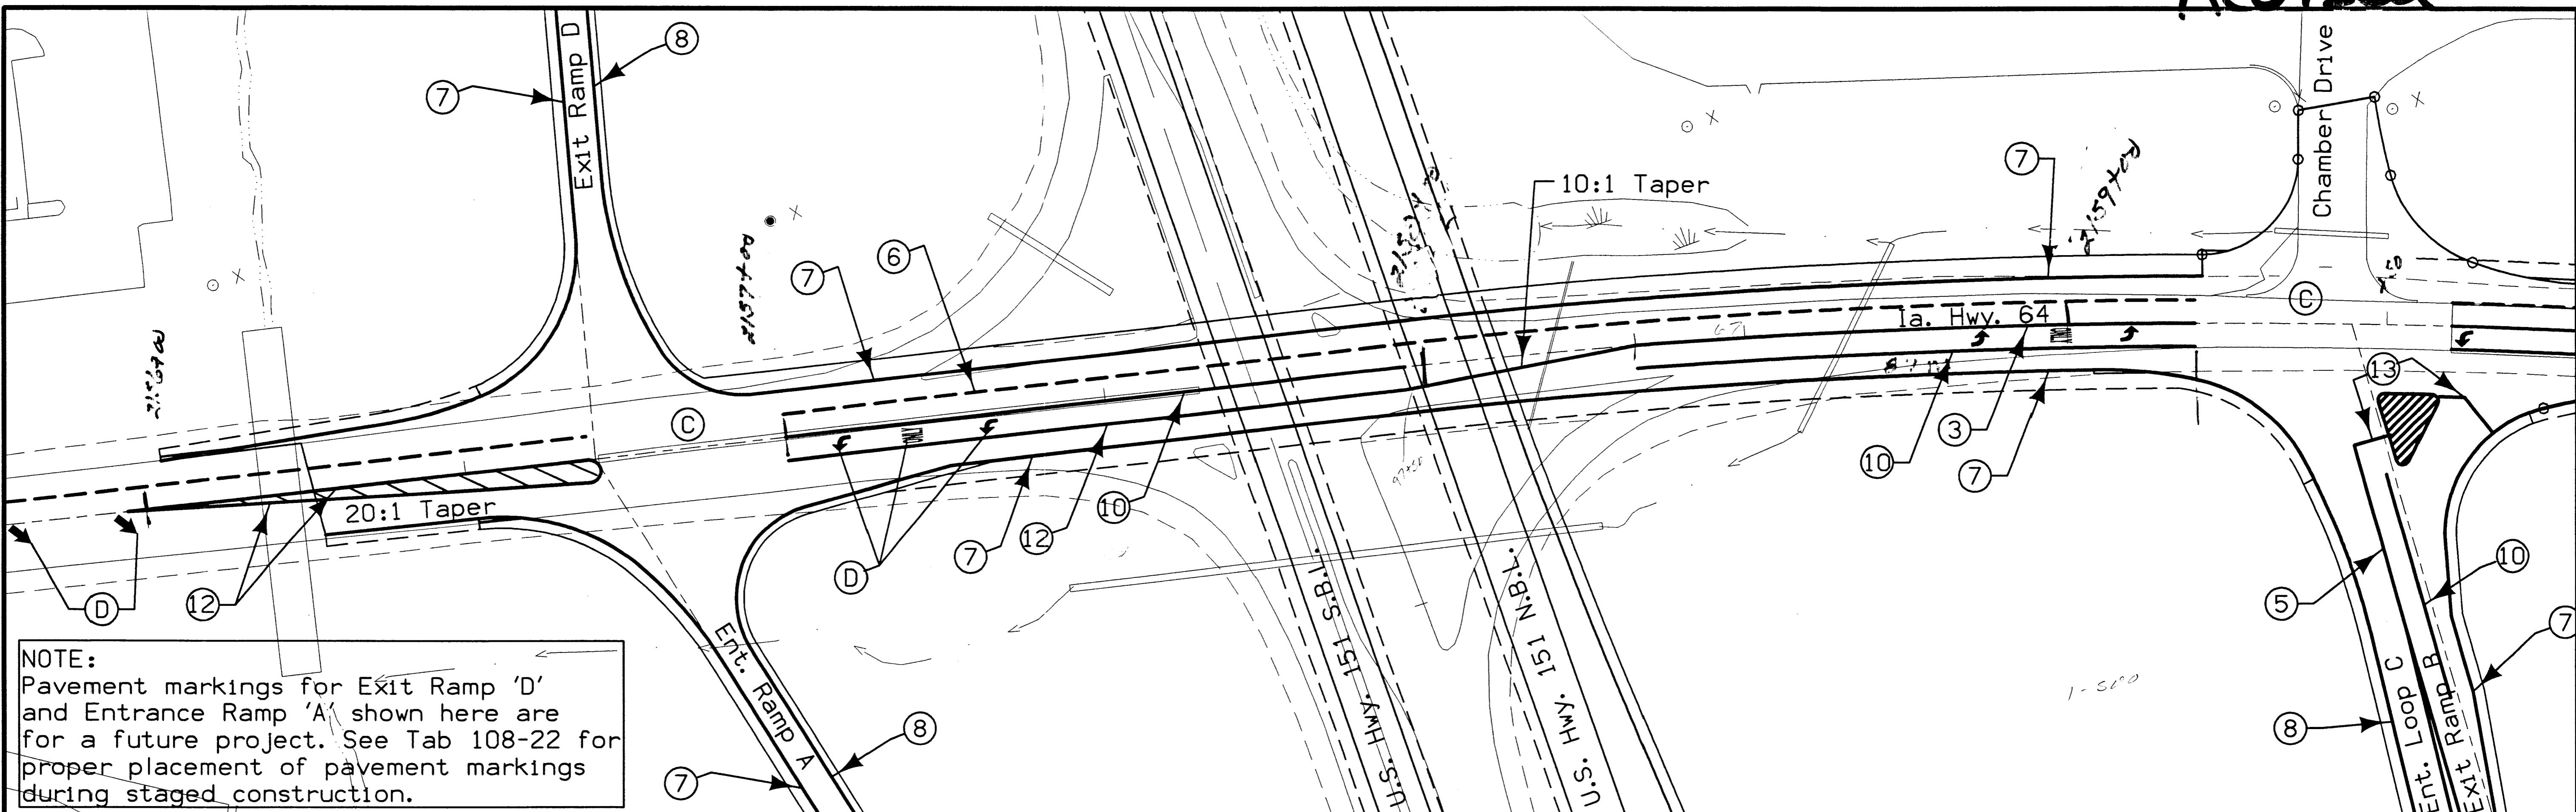

NOTE:
 Pavement markings for Exit Ramp 'D'
 and Entrance Ramp 'A' shown here are
 for a future project. See Tab 108-22 for
 proper placement of pavement markings
 during staged construction.

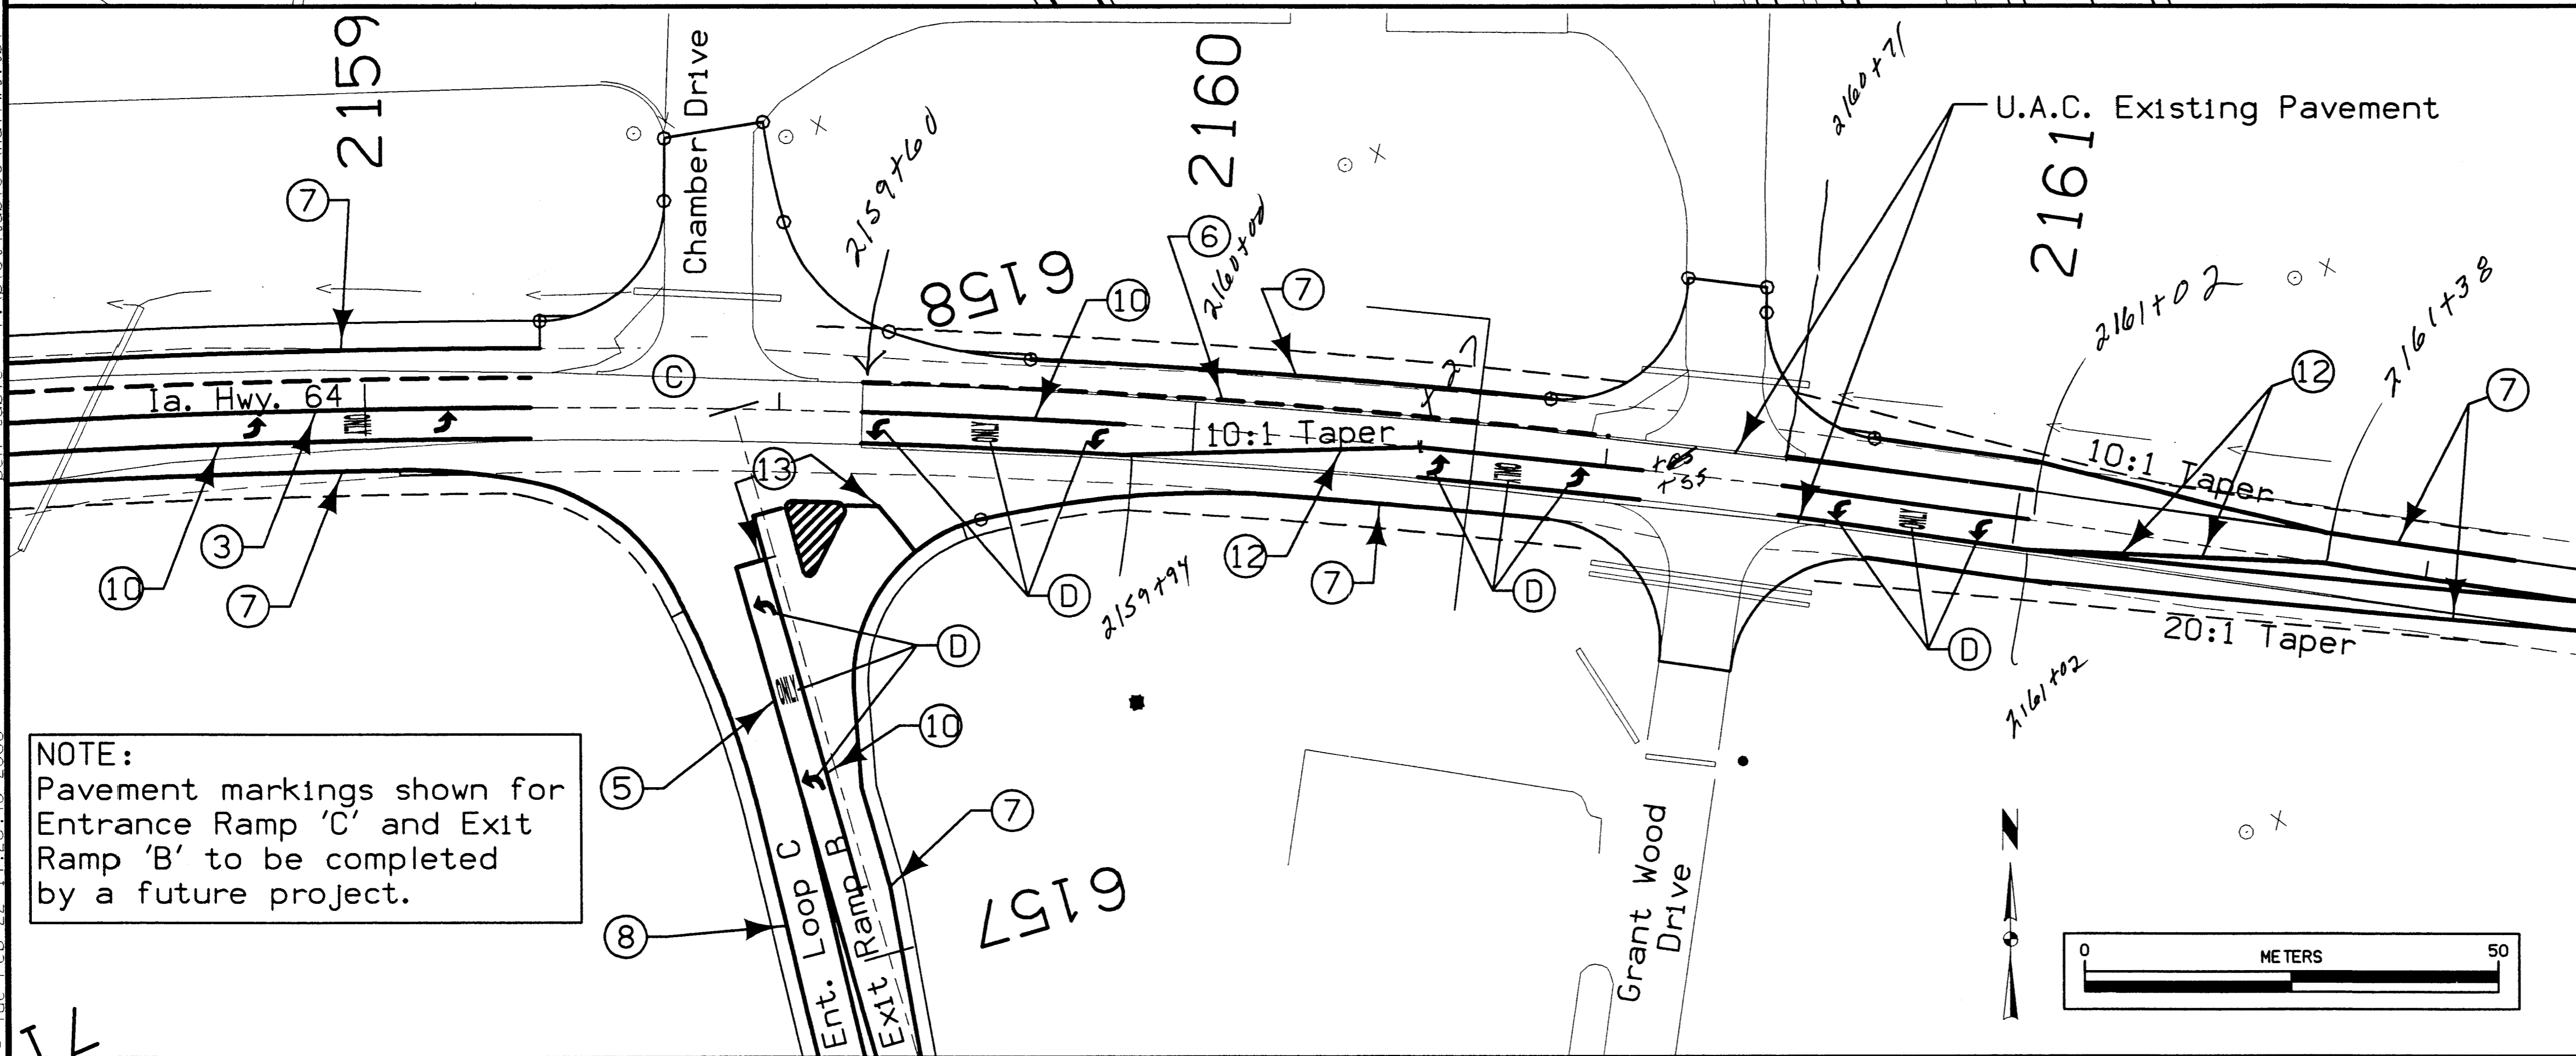

NOTE:
 Pavement markings shown for
 Entrance Ramp 'C' and Exit
 Ramp 'B' to be completed
 by a future project.

- ③ Double Centerline (yellow)
- ⑤ No Passing Zone Line (yellow)
- ⑥ Broken Lane Line (white)
- ⑦ Edge Line Right (white)
- ⑧ Edge Line Left (yellow)
- ⑩ Solid Lane Line (white)
- ⑫ Channelizing Line (yellow)
- ⑬ Stop Line (white)

Ⓒ Terminate All Lane and No Passing
 Zone Lines thru Intersection
 Ⓓ Symbol (when specifically listed in
 Tabulation 108-29); for size and
 shape, refer to Typical Details
 9002, 9008 and 9016 .



**PAVEMENT MARKING
 DETAIL AT IA HWY 64
 AND CHAMBER DRIVE**

dgn = I:\WORK\proj\sect\34120\cadd\east\331b1063.dwg
 prf = \WA\SO\DA\TA\PL\OT\PL463P\U05.prf
 date = Tue Feb 22 14:28:40 2000
 levels = 1-56,58-63
 plot table = I:\plot\tables\hal\wrt.tbl

BENCH MARK
 SURVEY @ STA. 133+86.101, 19.638m LTR
 TOP U.S.G.S. BRASS CAP @ S.W. TOP
 ABUTMENT HWY 151 BRIDGE OVER
 WAPSIPINICON RIVER EL. = 245.096

-6.000% +4.4000%
 VPI STA. 135+75.000 (O.R.)
 EL = 232.850
 VCL = 650.000 m

U.S. HWY. 151 PROFILE GRADE

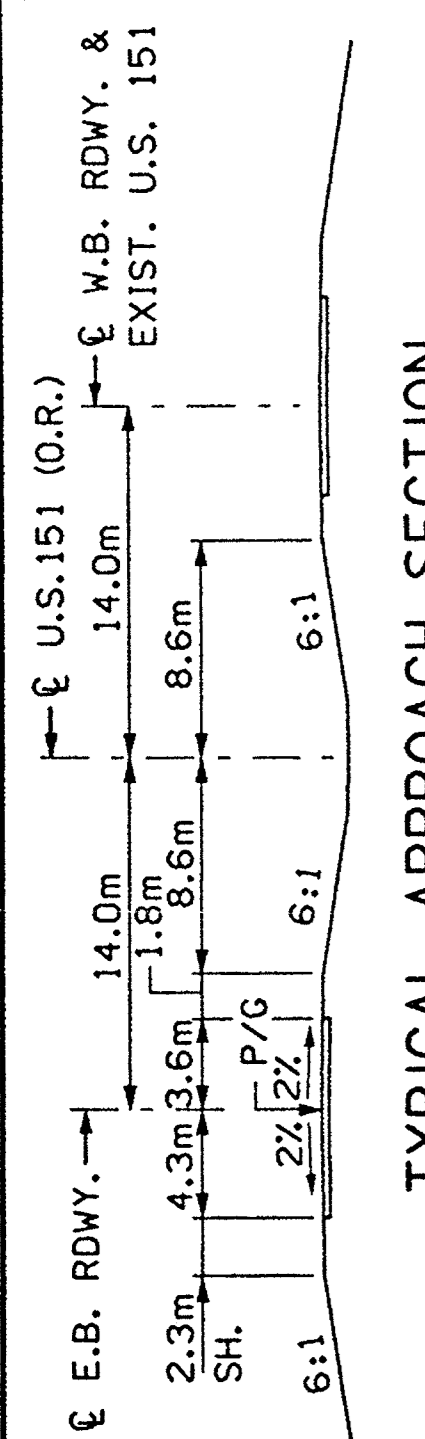
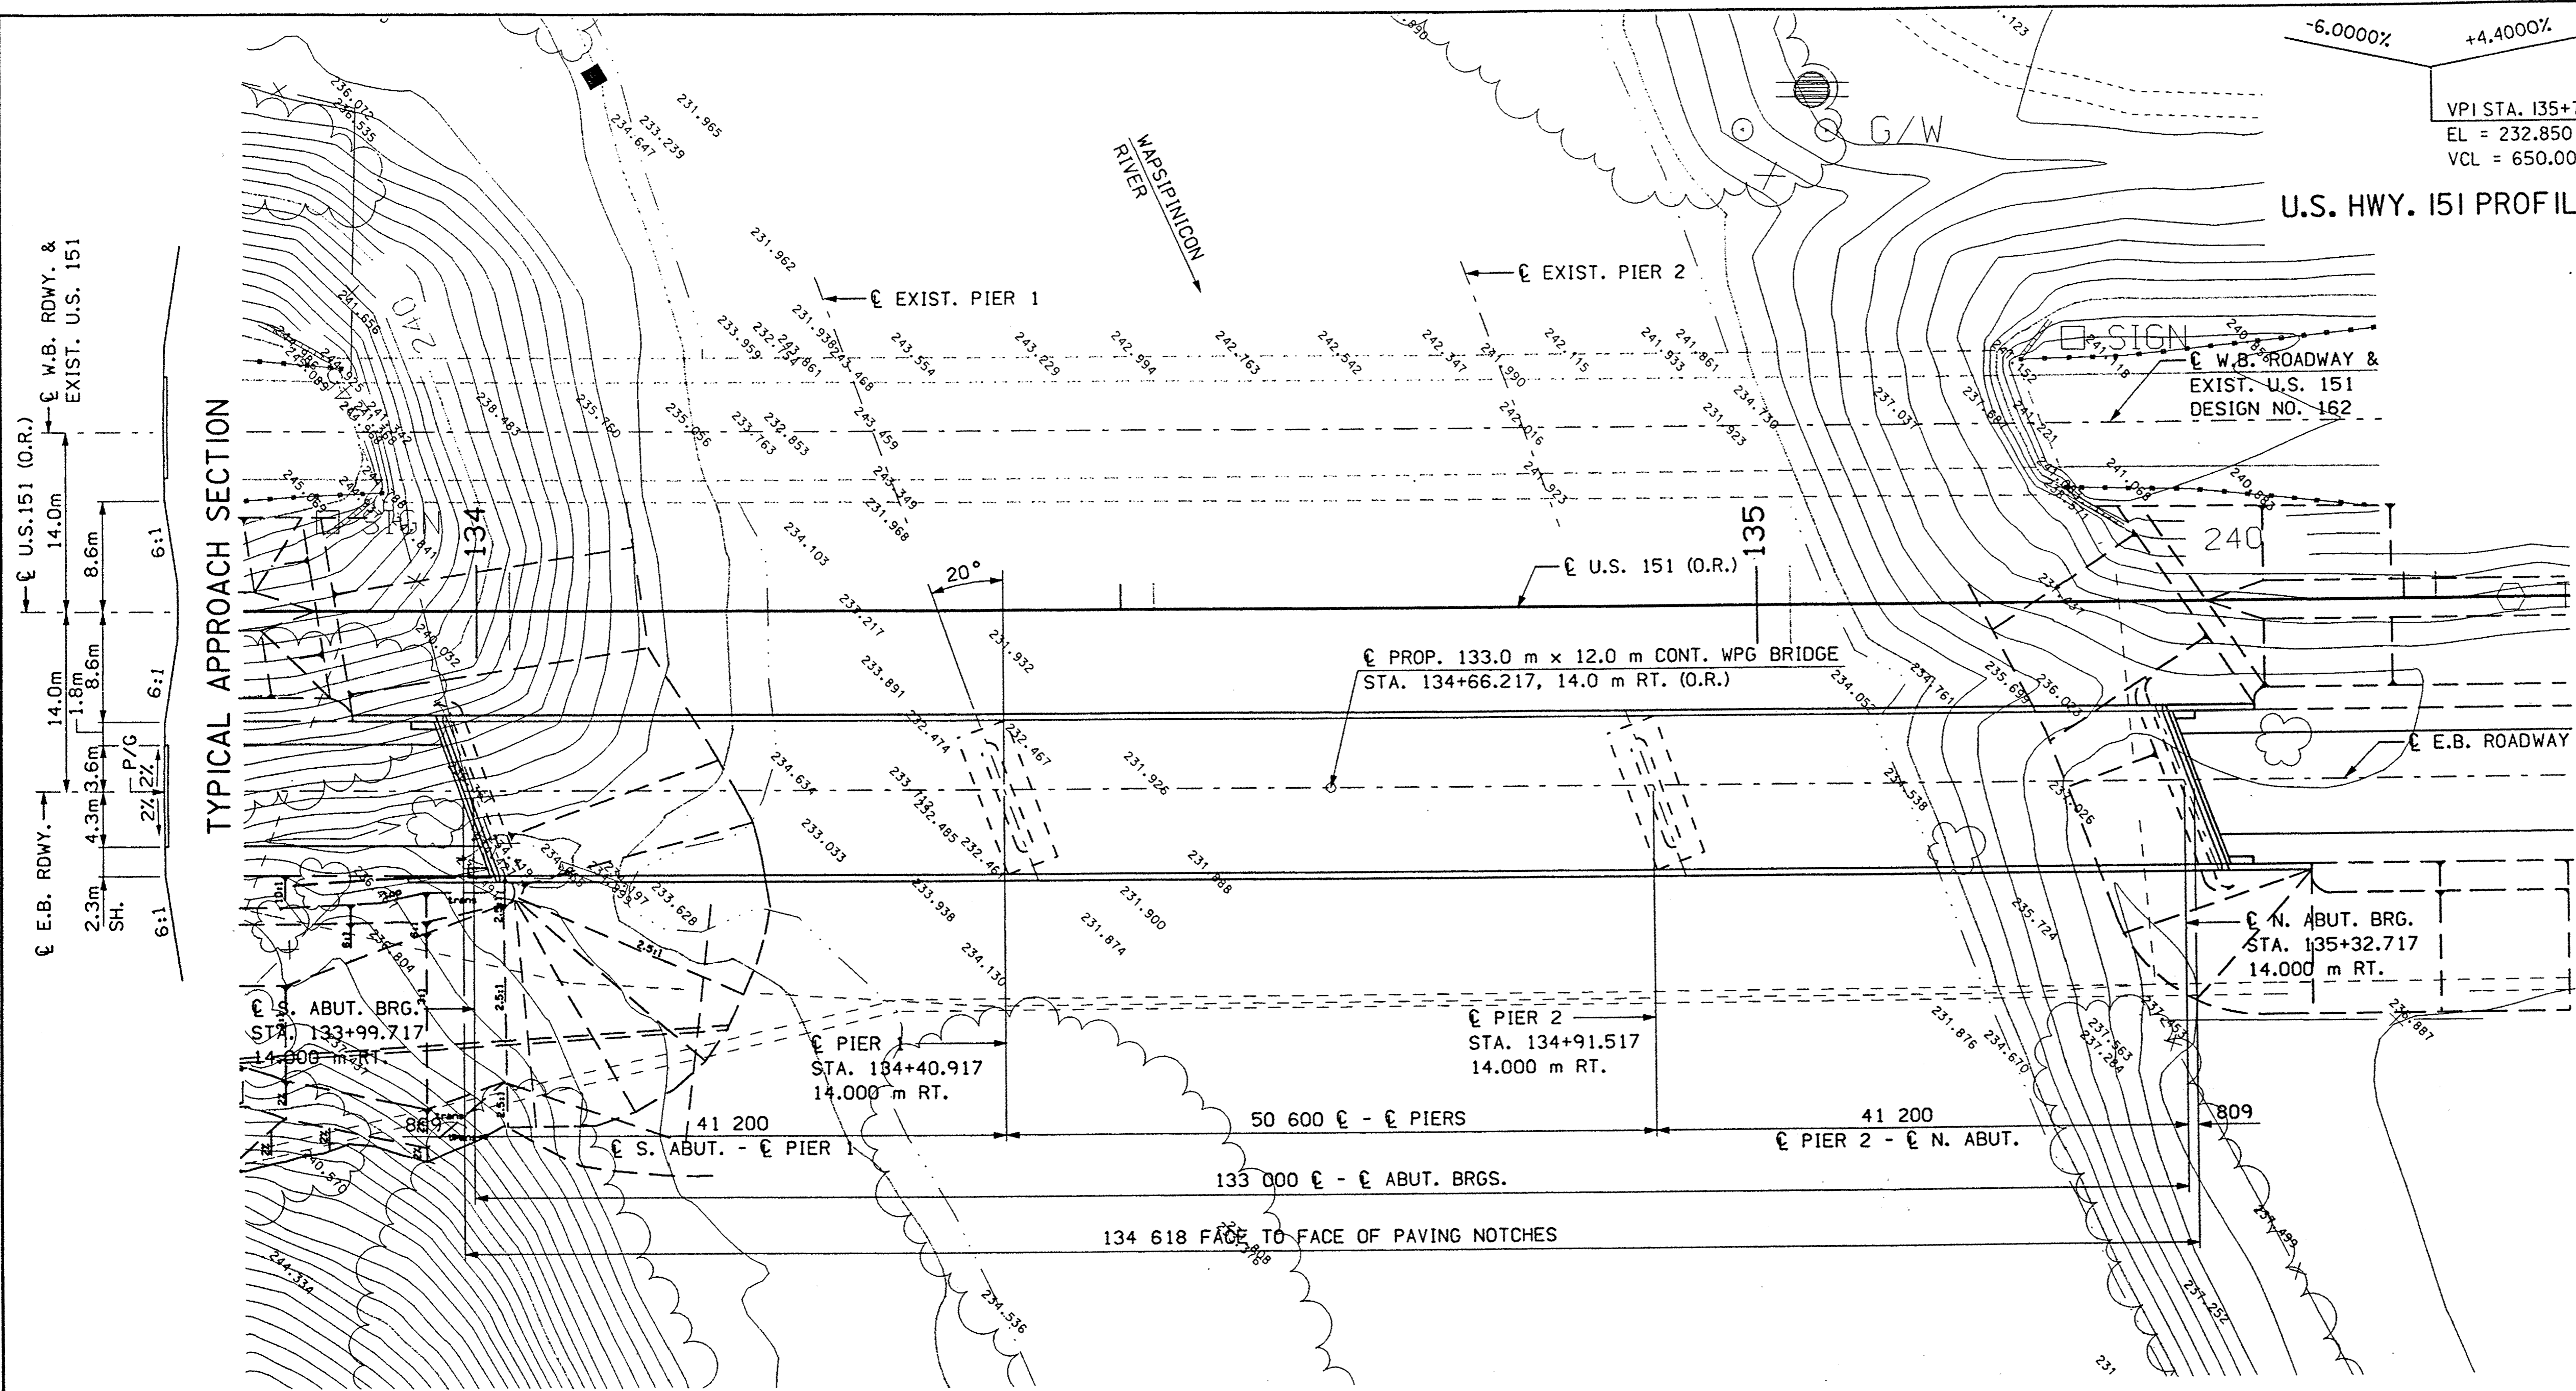


HYDRAULIC DATA
 DRAINAGE AREA = 4084 Km²
 STREAM SLOPE = 0.29 mm/m
 Q50 = 733 m³/s
 NATURAL STAGE = 237.45
 STAGE W/BACKWATER = 237.45
 Q100 = 835 m³/s
 NATURAL STAGE = 237.87
 STAGE W/BACKWATER = 237.87
 CALCULATED SCOUR EL. = 227.0
 Q500 = 997 m³/s
 NATURAL STAGE = 238.51
 Q OVERTOPPING = GREATER THAN 500-YR.
 EXTREME HW STAGE = NOT AVAILABLE

SITUATION PLAN - BRIDGE (E.B.L.)

NOTE:
 MEDIAN GUARD RAIL NOT SHOWN, TO BE DESIGNED.

TRAFFIC DATA			LOCATION
2001 AADT	5530 VPD		U.S. 151 OVER THE
2021 AADT	6630 VPD		WAPSIPINICON RIVER
2021 DHV	712 VPH		T84N - R4W
TRUCKS	13%		SECTION 14
			FAIRVIEW TWP.
			JONES COUNTY

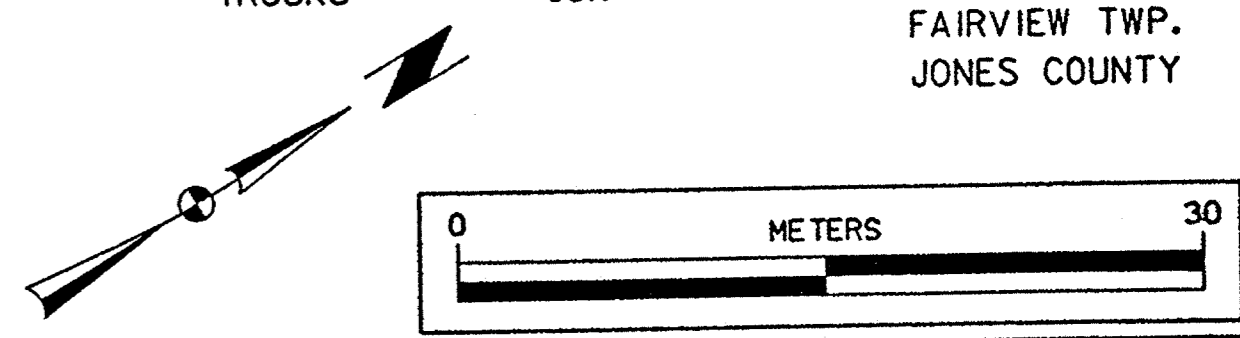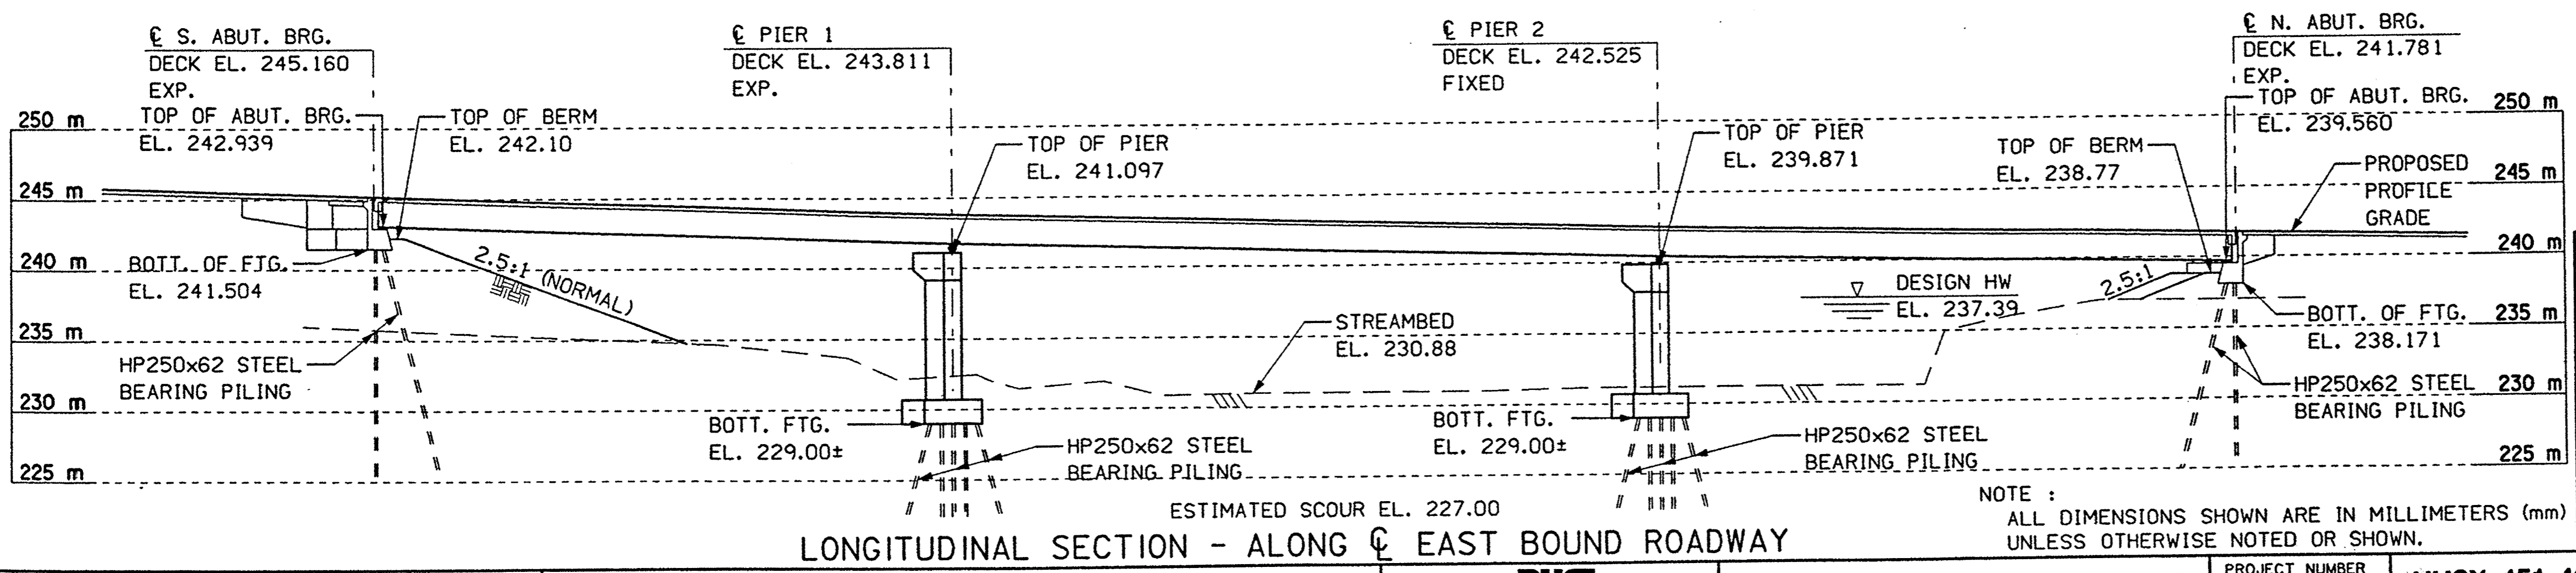

DESIGN FOR 20°00'00" SKEW (R.A.)
133.0 m x 12.0 m CONTINUOUS WELDED PLATE GIRDER BRIDGE
 41.20 m END SPANS 50.60 m CENTER SPAN
 SITUATION PLAN
 STA. 134+66.217, 14.000 m RT. (O.R.) U.S. HIGHWAY 151 MARCH 1998
 JONES COUNTY, IOWA
 IOWA DEPARTMENT OF TRANSPORTATION - PROJECT DEVELOPMENT DIVISION
 DESIGN SHEET NO. 1 OF 1 FILE NO. DESIGN NO.

NOTE:
 ALL DIMENSIONS SHOWN ARE IN MILLIMETERS (mm)
 UNLESS OTHERWISE NOTED OR SHOWN.

DESIGNED BY RMJ TRACED BY JAE
 DETAILED BY RMJ CHECKED BY LLK




RUST
 Rust Environment & Infrastructure Inc.

JONES COUNTY PROJECT NUMBER **NHSX-151-4(63)-3H-53**

STATE	FHWA REGION	FISCAL YEAR	SHEET NO.	TOTAL SHEETS
IOWA	7			84/90

V.01

07/02/09

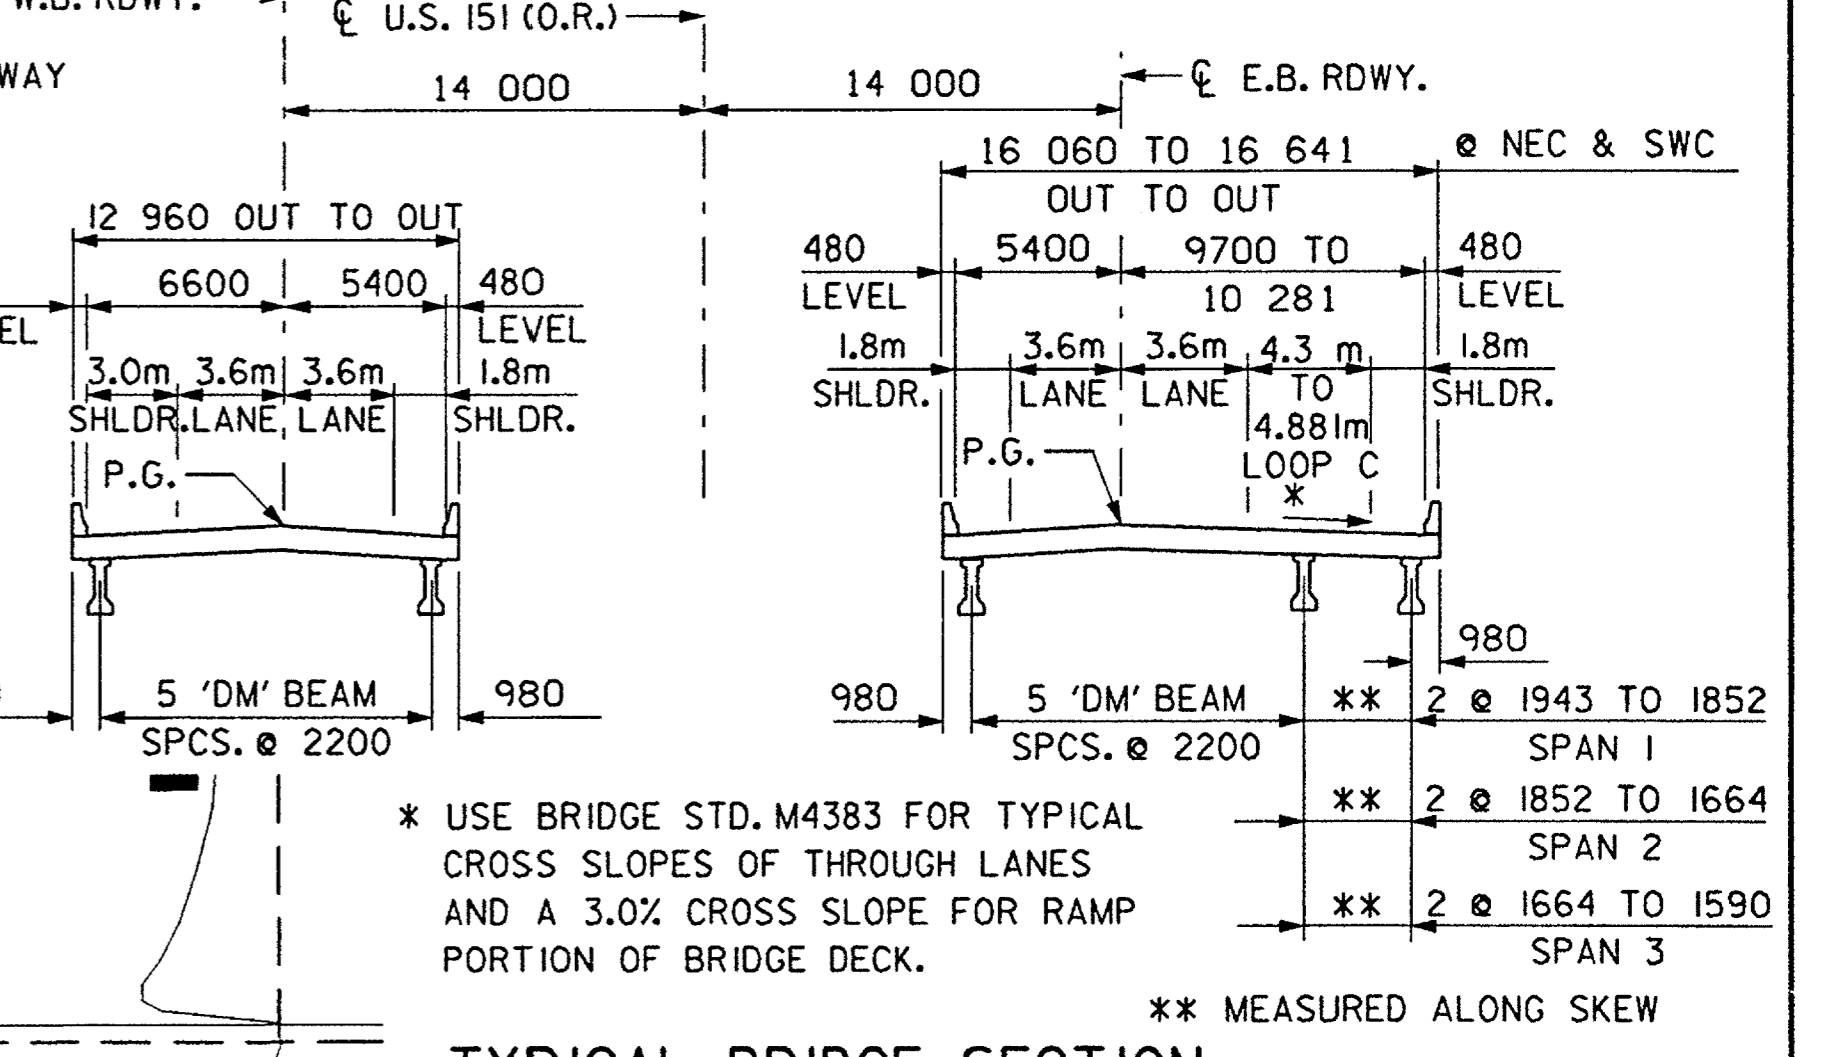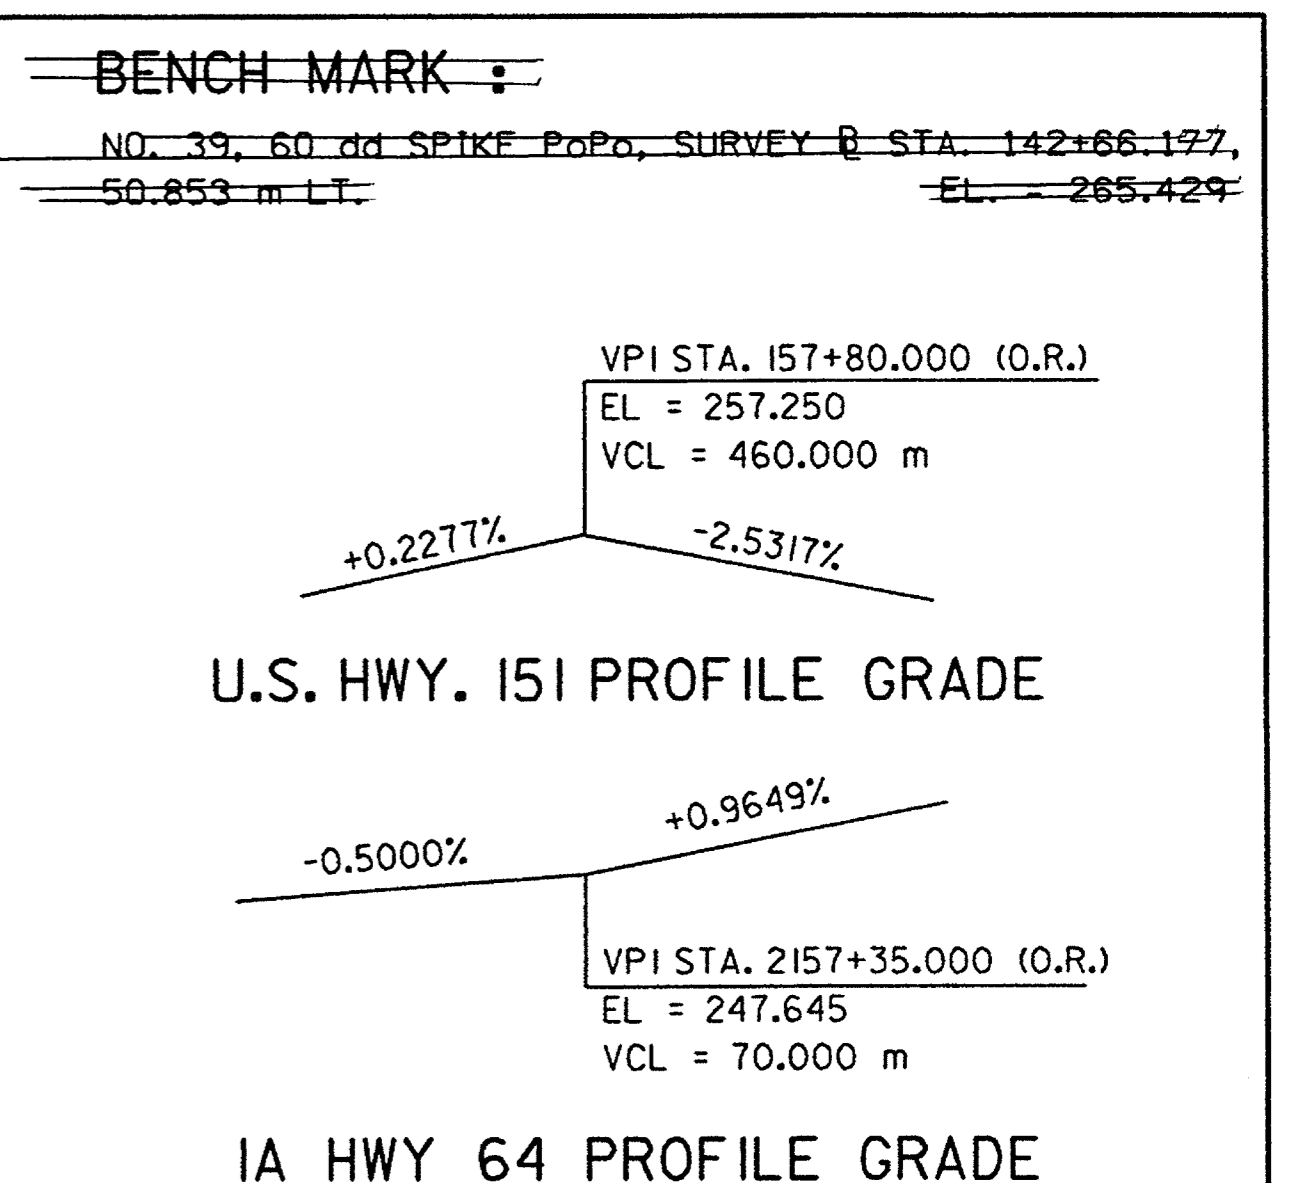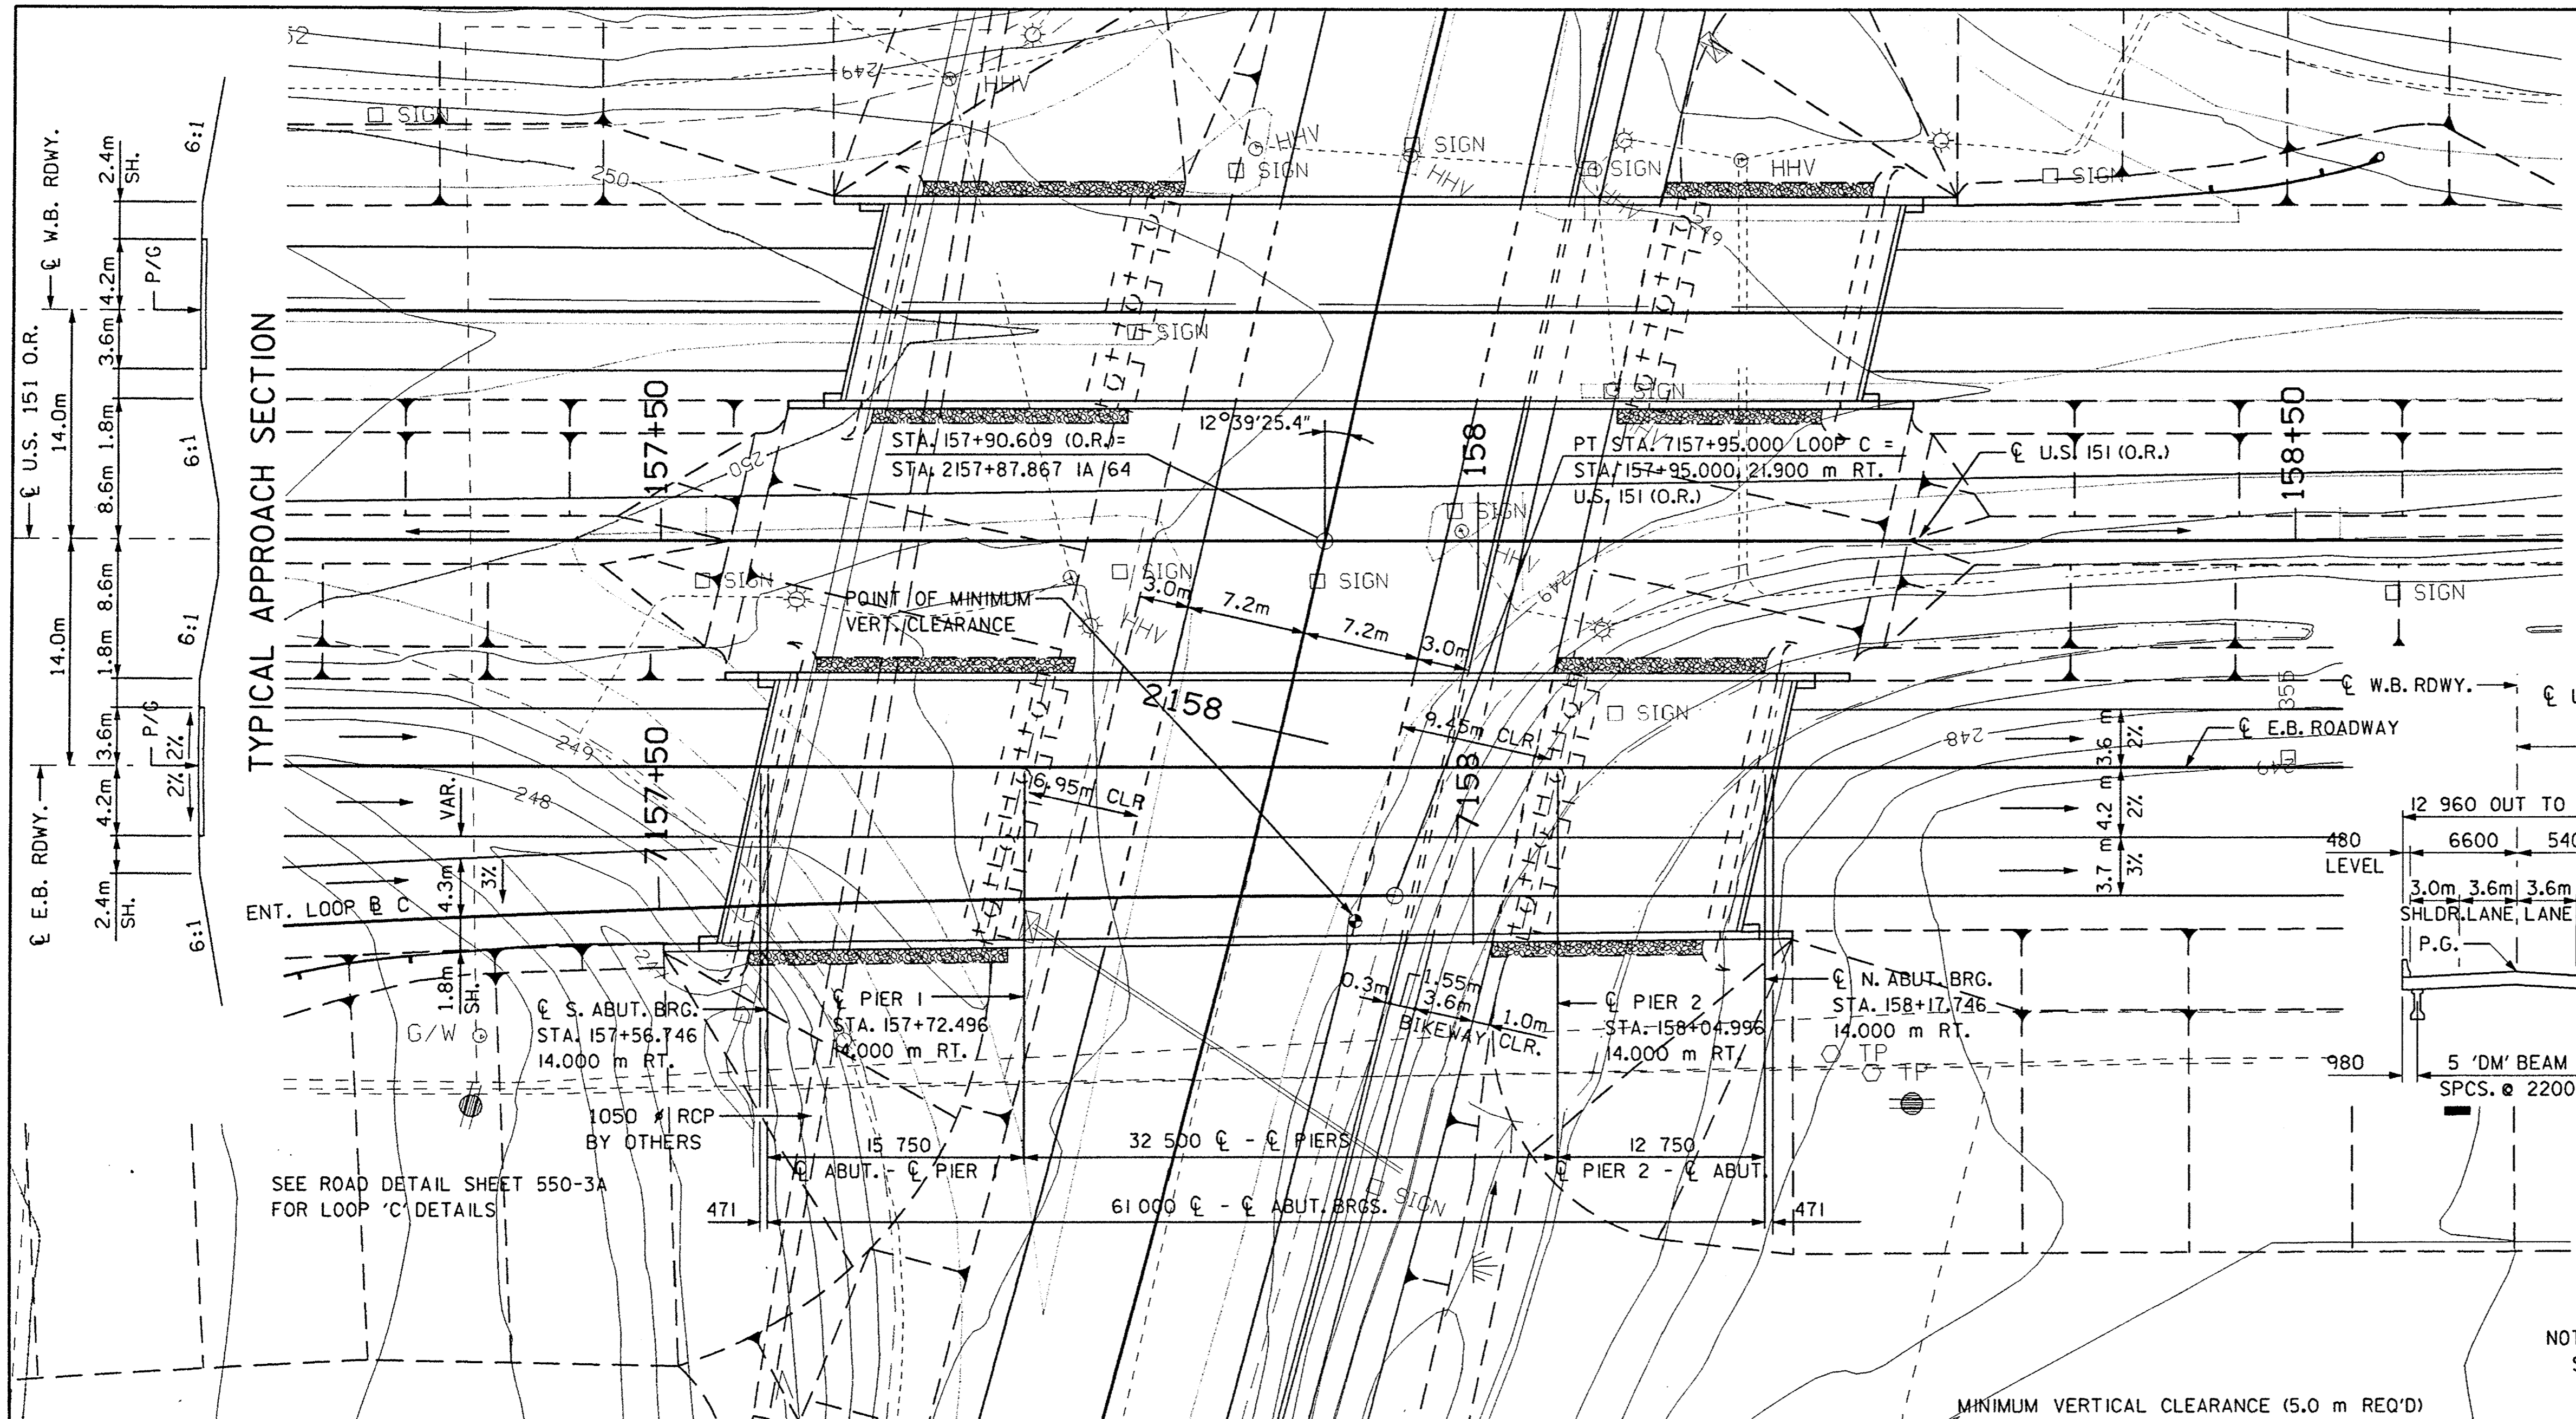


NOTE :
 MINIMUM CLEAR ZONE REQUIRED IS 6.5 m ON IA 64. FUTURE BIKEWAY ON NORTH SIDE OF IA 64, NOT SHOWN. MEDIAN GUARD RAIL NOT SHOWN, TO BE DESIGNED.

SITUATION PLAN - BRIDGE (E.B.L.)

E.B. U.S. 151 (O.R.) STA. 157+92.488, 23.743 m RT. EL. = 255.515 (PROFILE GRADE)
 IA 64 (O.R.) STA. 2158+10.501 EL. = 248.374 (PROFILE GRADE)
 SUPERSTRUCTURE DEPTH TO LOW CONC. (INCL. CROWN AND SUPERLEV.) = 2.060 m
 E.B. MIN. VERTICAL CLEARANCE = 5.081 m


TRAFFIC DATA		LOCATION
2001 AADT	6590 VPD	U.S. 151 OVER IA 64
2021 AADT	7910 VPD	T84N R4W
2021 DHV	850 VPH	SECTION II
TRUCKS	12%	FAIRVIEW TWP. JONES COUNTY

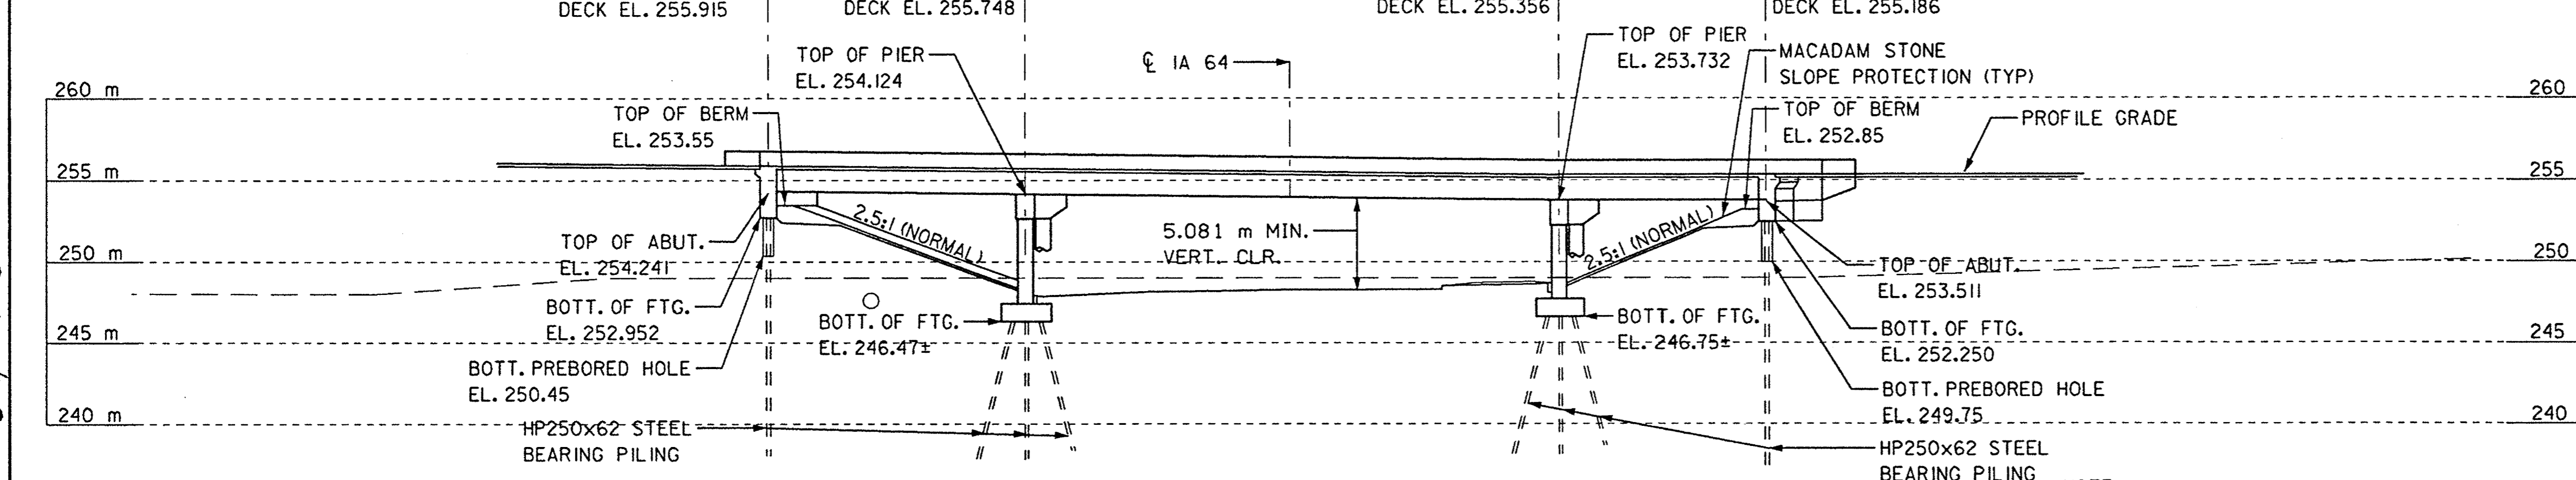

LONGITUDINAL SECTION - ALONG C ROADWAY (E.B.L.)

NOTE :
 ALL DIMENSIONS SHOWN ARE IN MILLIMETERS (mm) UNLESS OTHERWISE NOTED OR SHOWN.

DESIGN FOR 12°39'25" SKEW (L.A.)
61.0 m x VARIABLE WIDTH PRETENSIONED PRESTRESSED CONCRETE BEAM BRIDGE
 15.75 m & 12.75 m END SPANS 32.50 m CENTER SPAN
 SITUATION PLAN
 STA. 157+90.609 (O.R.) C U.S. HWY. 151
 STA. 2157+87.867 (O.R.) C IA 64
 JONES COUNTY
 IOWA DEPARTMENT OF TRANSPORTATION - PROJECT DEVELOPMENT DIVISION
 DESIGN SHEET NO. 1 OF 2 FILE NO. DESIGN NO.

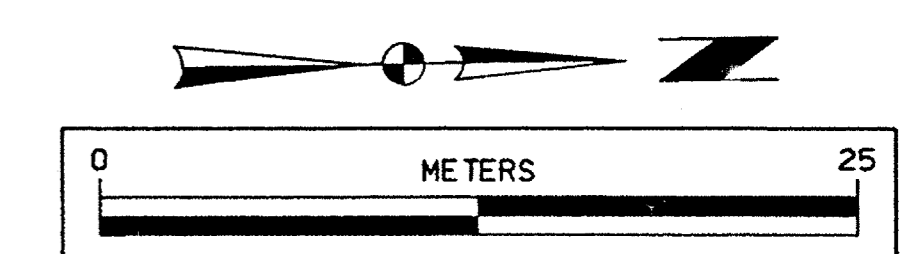

NOTE :
 MINIMUM CLEAR ZONE REQUIRED IS
 6.5 m ON IA 64. FUTURE BIKEWAY ON NORTH
 SIDE OF IA 64, NOT SHOWN. MEDIAN GUARD
 RAIL NOT SHOWN, TO BE DESIGNED.

MINIMUM VERTICAL CLEARANCE (5.0 m REQ'D)

~~BENCH MARK~~

~~NO. 39, 60 OR SPIKE POPS~~
~~SURVEY STA. 142+66.177,~~
~~50.853 m LT. EL. 265.429~~

W.B. U.S. 151 (O.R.) STA. 157+99.969, 8.820 m LT. EL. = 255.421 (PROFILE GRADE)
 IA 64 (O.R.) STA. 2157+77.210 EL. = 248.052 (PROFILE GRADE)
 SUPERSTRUCTURE DEPTH TO LOW CONC. (INCL. CROWN AND SUPEREL.) = 1.802 m
 W.B. MIN. VERTICAL CLEARANCE = 5.567 m

VPI STA. 157+80.000 (O.R.)
 EL. = 257.250
 VCL = 460.000 m

U.S. HWY. 151 PROFILE GRADE

+0.2277% -2.5317%

-0.5000% +0.9649%

VPI STA. 2157+35.000 (O.R.)
 EL. = 247.645
 VCL = 70.000 m



IA HWY 64 PROFILE GRADE

IA 64 CURVE DATA


P.I. STA. 2159+41.145
 $\Delta = 14^{\circ}41'19.56''$ RT.
 R = 1165.011 m
 T = 150.159 m
 L = 298.671 m
 e = 9.637 m
 e = 3.3%
 L = 75.0 m
 x = 45.5 m

TRAFFIC DATA LOCATION

2001 AADT	6590 VPD	U.S. 151 OVER IA 64
2021 AADT	7910 VPD	T84N R4W
2021 DHV	850 VPH	SECTION II
TRUCKS	12%	FAIRVIEW TWP. JONES COUNTY

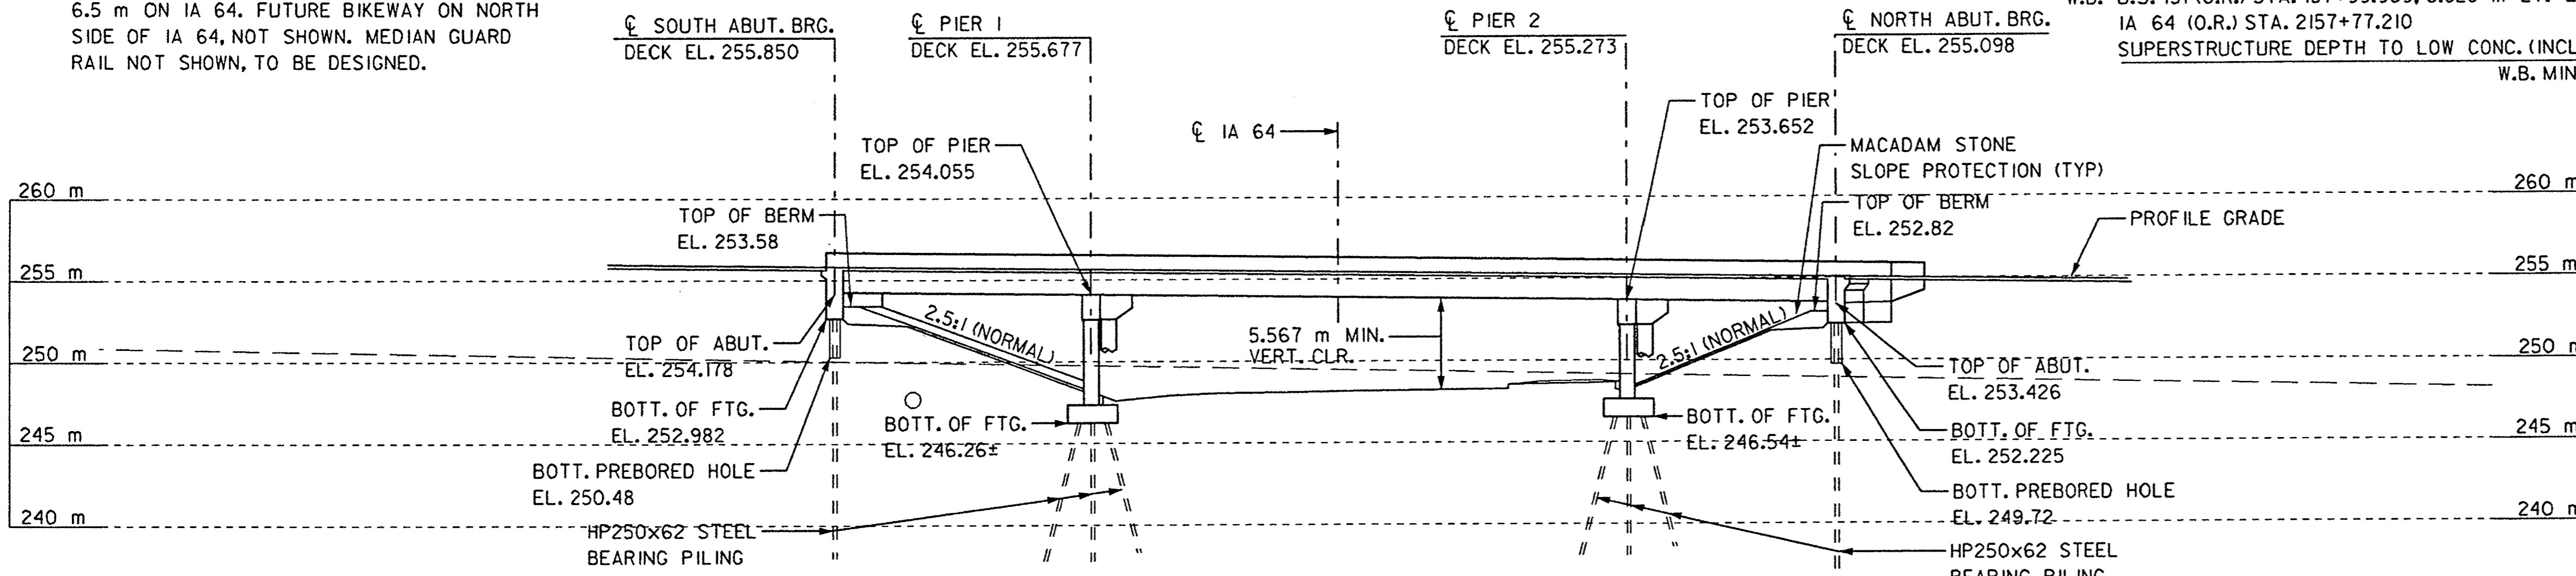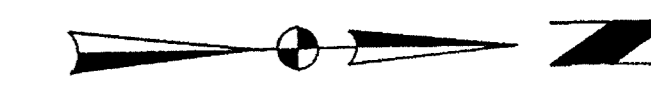

LONGITUDINAL SECTION - ALONG ROADWAY (W.B.L.)

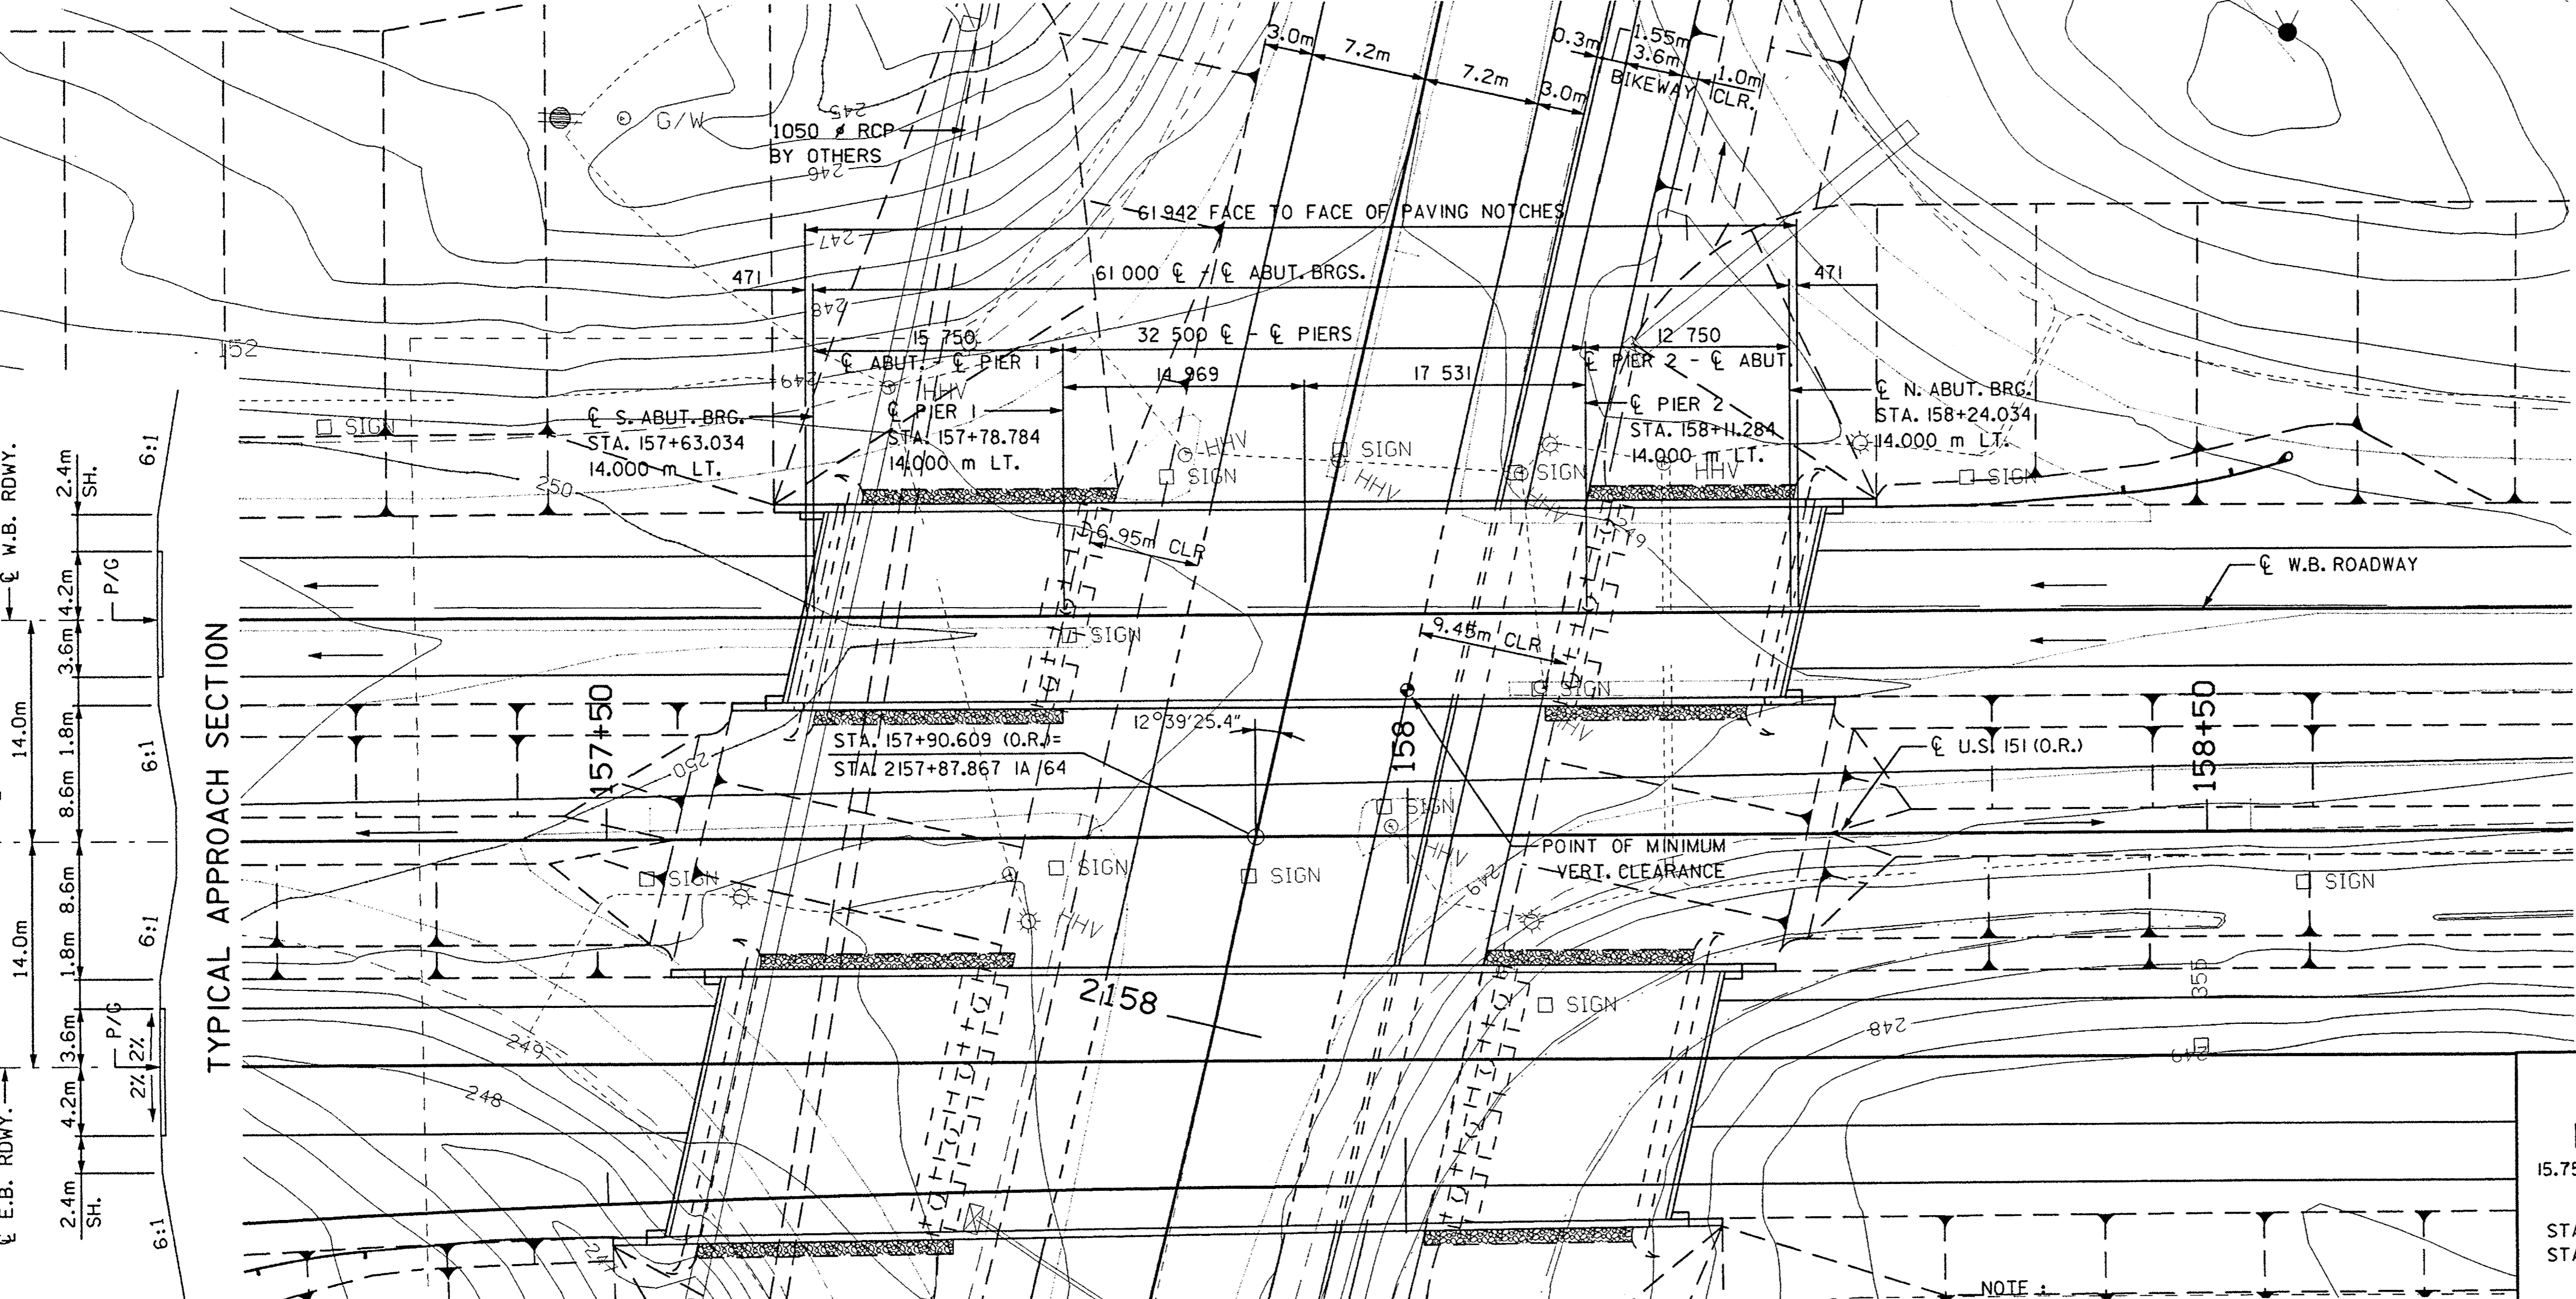

SITUATION PLAN - BRIDGE (W.B.L.)

DESIGN FOR $12^{\circ}39'25''$ SKEW (L.A.)
 61.0 m x 12.0 m PRETENSIONED
 PRESTRESSED CONCRETE BEAM BRIDGE
 15.75 m & 12.75 m END SPANS 32.50 m CENTER SPAN
 SITUATION PLAN
 STA. 157+90.609 (O.R.) U.S. HWY. 151
 STA. 2157+87.867 (O.R.) IA 64
 JONES COUNTY
 IOWA DEPARTMENT OF TRANSPORTATION - PROJECT DEVELOPMENT DIVISION
 DESIGN SHEET NO. 2 OF 2 FILE NO. SHEET NO. TOTAL SHEETS

NOTE :
 ALL DIMENSIONS SHOWN ARE IN MILLIMETERS (mm)
 UNLESS OTHERWISE NOTED OR SHOWN.





DESIGNED BY RMJ CHECKED BY JAE
 DETAILED BY RMJ CADD FILE LLK

EARTH TECH

JONES COUNTY

PROJECT NUMBER **NHSX-151-4(63)-3H-53**

STATE IOWA REGION 7 FISCAL YEAR SHEET NO. 2 OF 2 TOTAL SHEETS 86/90

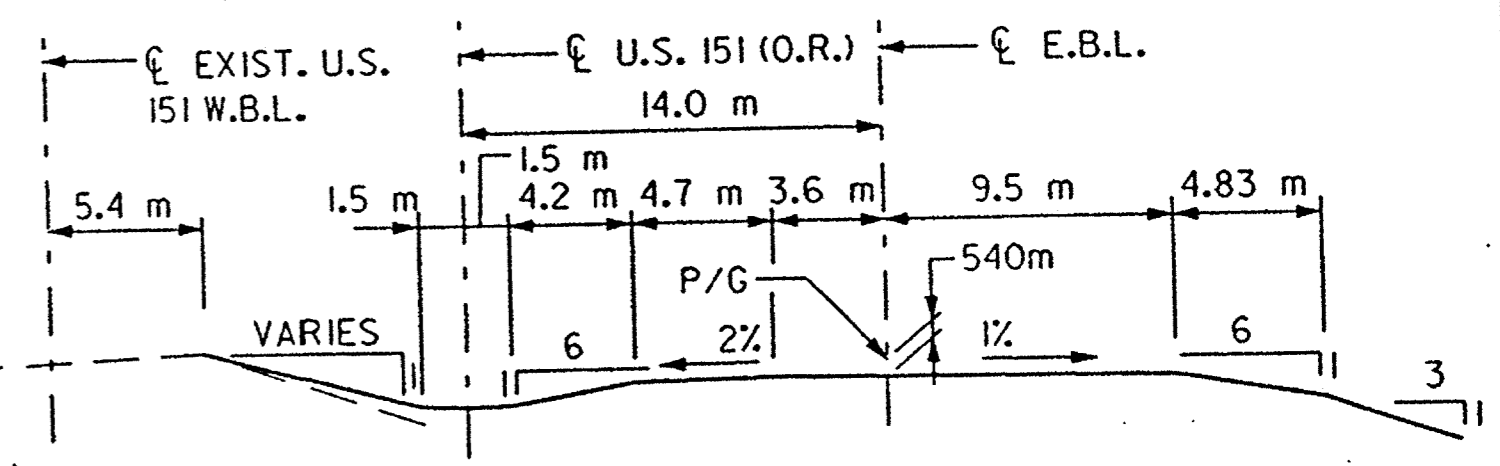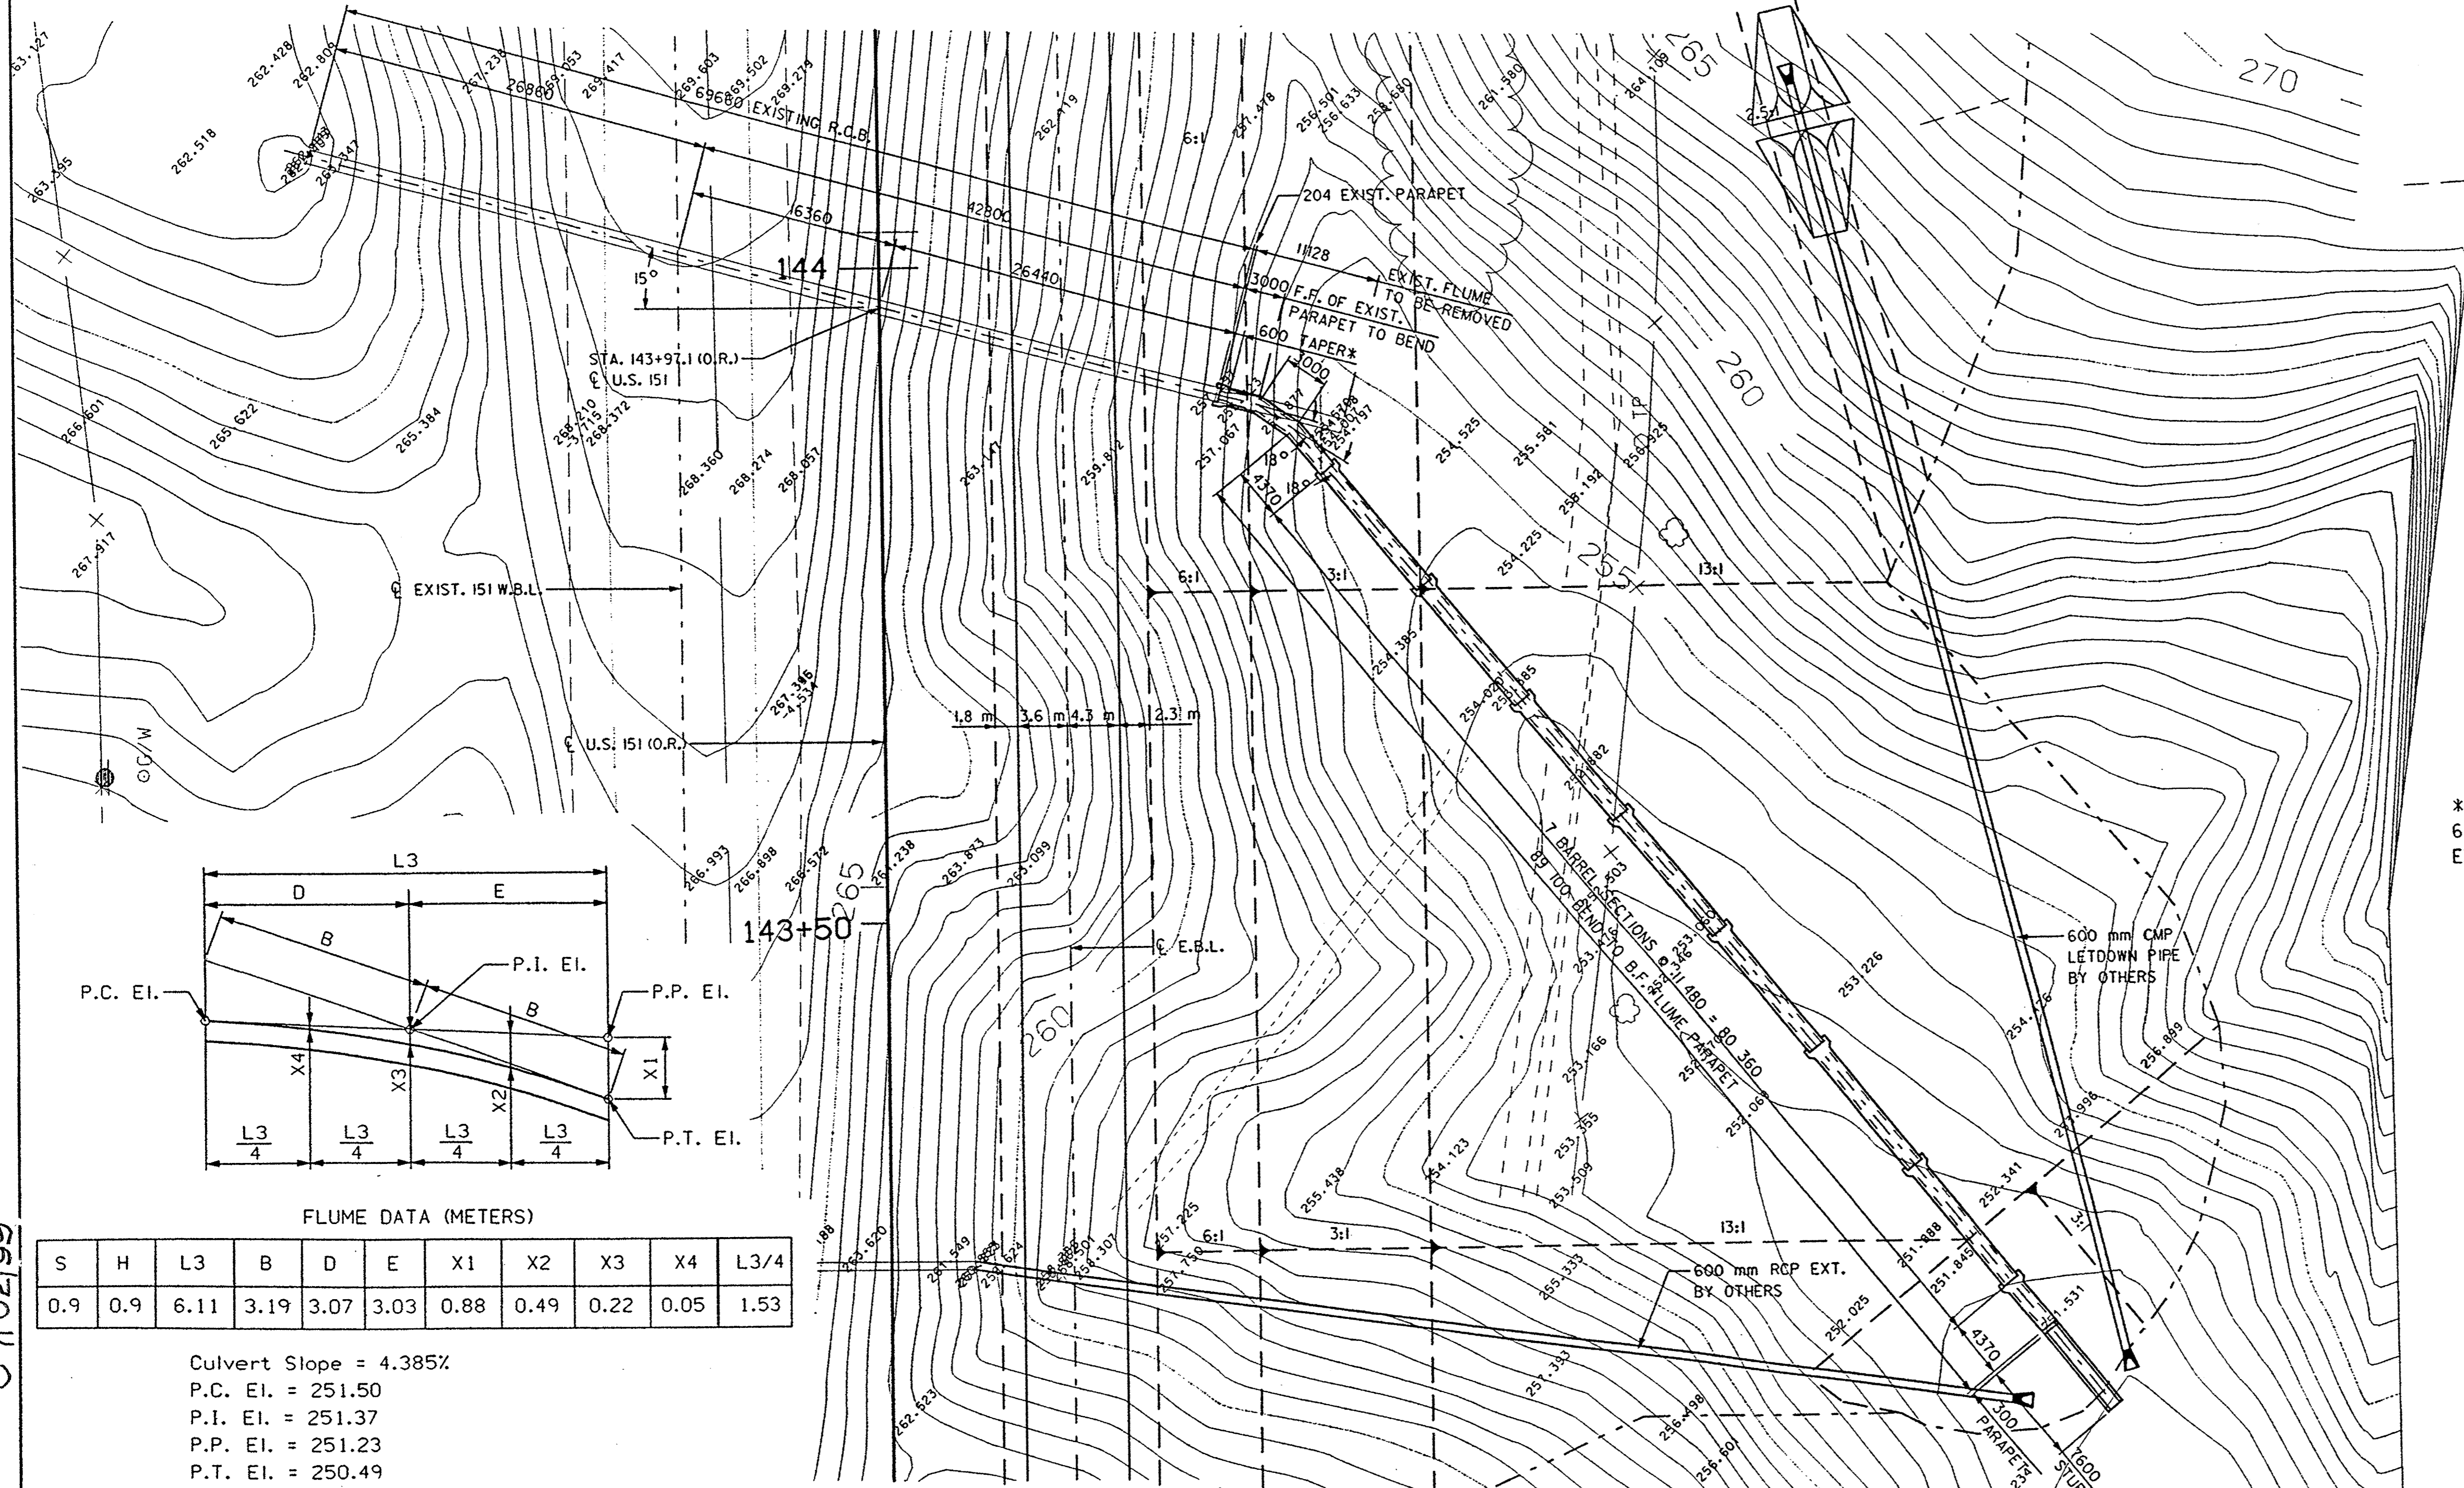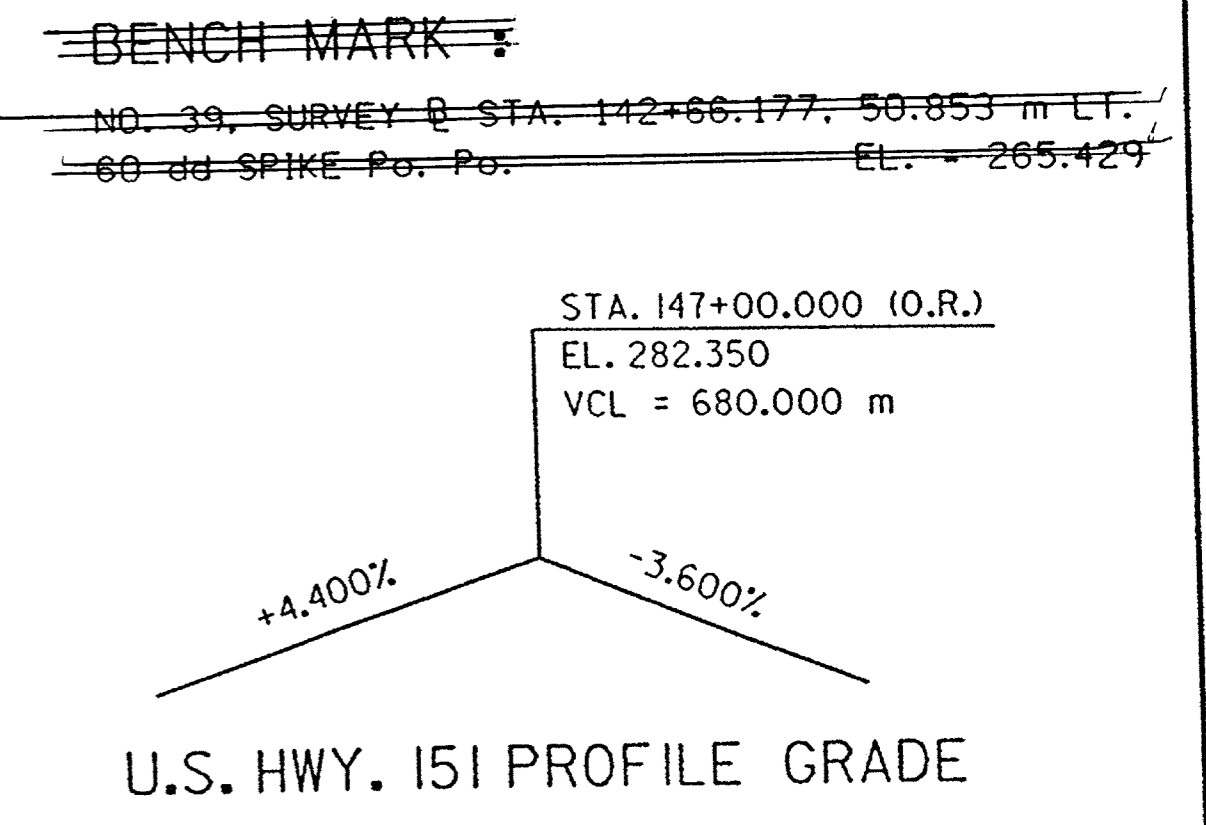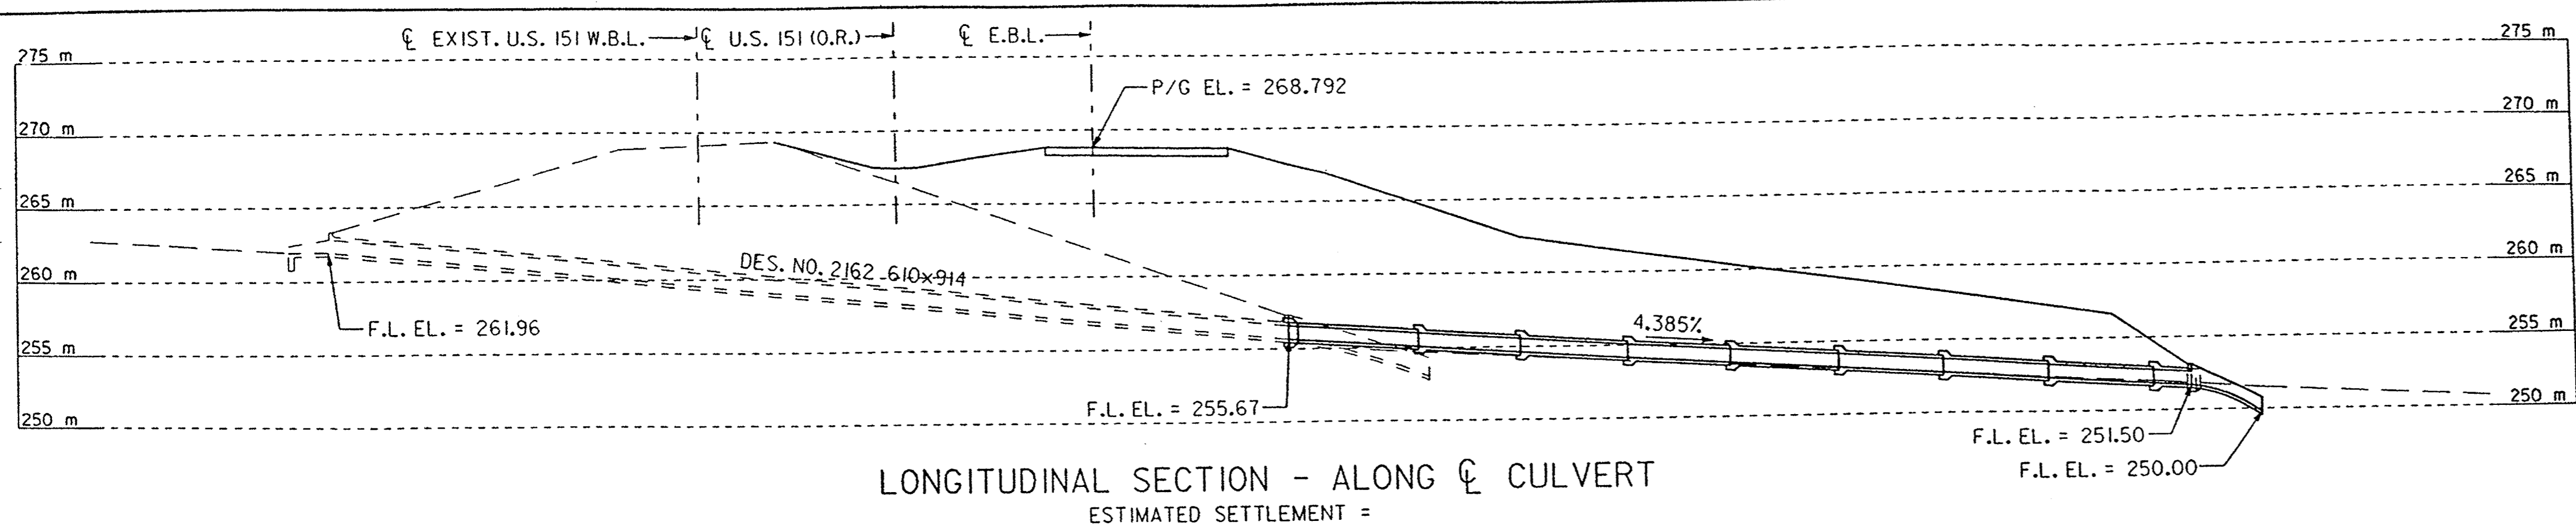

HYDRAULIC DATA

FREQUENCY	DISCHARGE (cms)	HEADWATER ELEV.
10-YEAR	0.71	262.81
25-YEAR	0.81	262.89
50-YEAR	1.01	263.07
100-YEAR	1.21	263.27



DRAINAGE AREA = 4.0 ha, HILLY
50 YEAR DESIGN FREQUENCY

LOCATION
T84N - R4W
SECTION 13 & 14
FAIRVIEW TWP.
JONES COUNTY

TRAFFIC DATA

2001	ADT	6590
2021	ADT	7910
2021	DHV	850
2001	TRUCKS	11%
2021	TRUCKS	12%

* SPAN TAPERS FROM 610 TO 900 IN NEW EXTENSION.

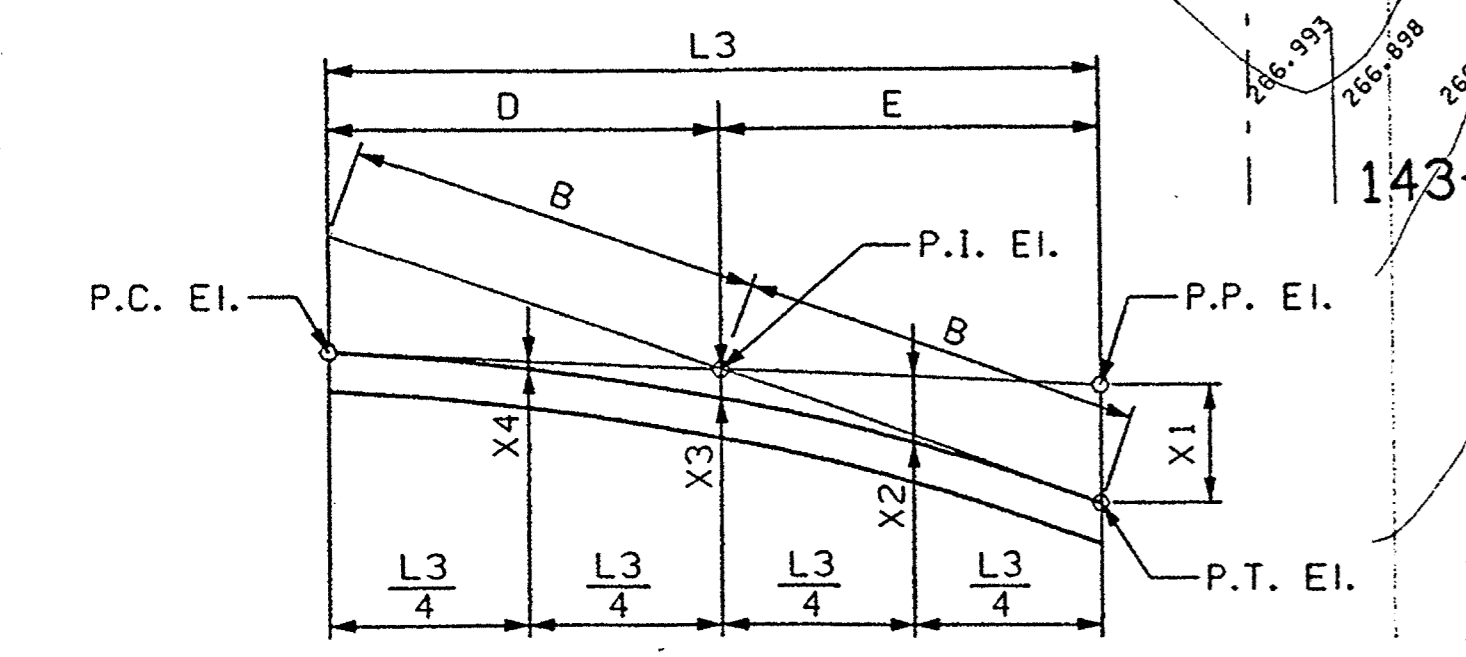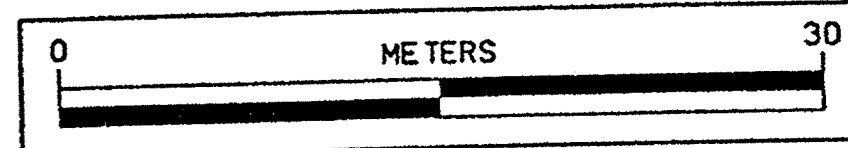

FLUME DATA (METERS)

S	H	L3	B	D	E	X1	X2	X3	X4	L3/4
0.9	0.9	6.11	3.19	3.07	3.03	0.88	0.49	0.22	0.05	1.53

Culvert Slope = 4.385%
P.C. EI. = 251.50
P.I. EI. = 251.37
P.P. EI. = 251.23
P.T. EI. = 250.49

NOTE :
ALL DIMENSIONS SHOWN ARE IN MILLIMETERS (mm)
UNLESS OTHERWISE NOTED OR SHOWN.

SITUATION PLAN
FILL HT. = 11.3 m

DESIGN FOR 15° SKEW (L.A.) EXTENSION RIGHT
WITH TWO - 18° BENDS AND STUB FLUME
**0.9 m x 0.9 m x 95.1 m REINFORCED
CONCRETE BOX CULVERT EXT.**
SITUATION PLAN
STA. 143+97.1 (O.R.) U.S. HIGHWAY 151 1998
JONES COUNTY, IOWA
IOWA DEPARTMENT OF TRANSPORTATION - PROJECT DEVELOPMENT DIVISION
DESIGN SHEET NO. 1 OF 1 FILE NO. DESIGN NO. **1198**

DESIGNED BY DLN TRACED BY JAE
DETAILED BY DLN CHECKED BY RMJ






RUST
Rust Environment & Infrastructure Inc.

JONES COUNTY PROJECT NUMBER

NHSX-151-4(63)-3H-53

STATE	FHWA REGION	FISCAL YEAR	SHEET NO.	TOTAL SHEETS
IOWA	7		87/90	

V.04

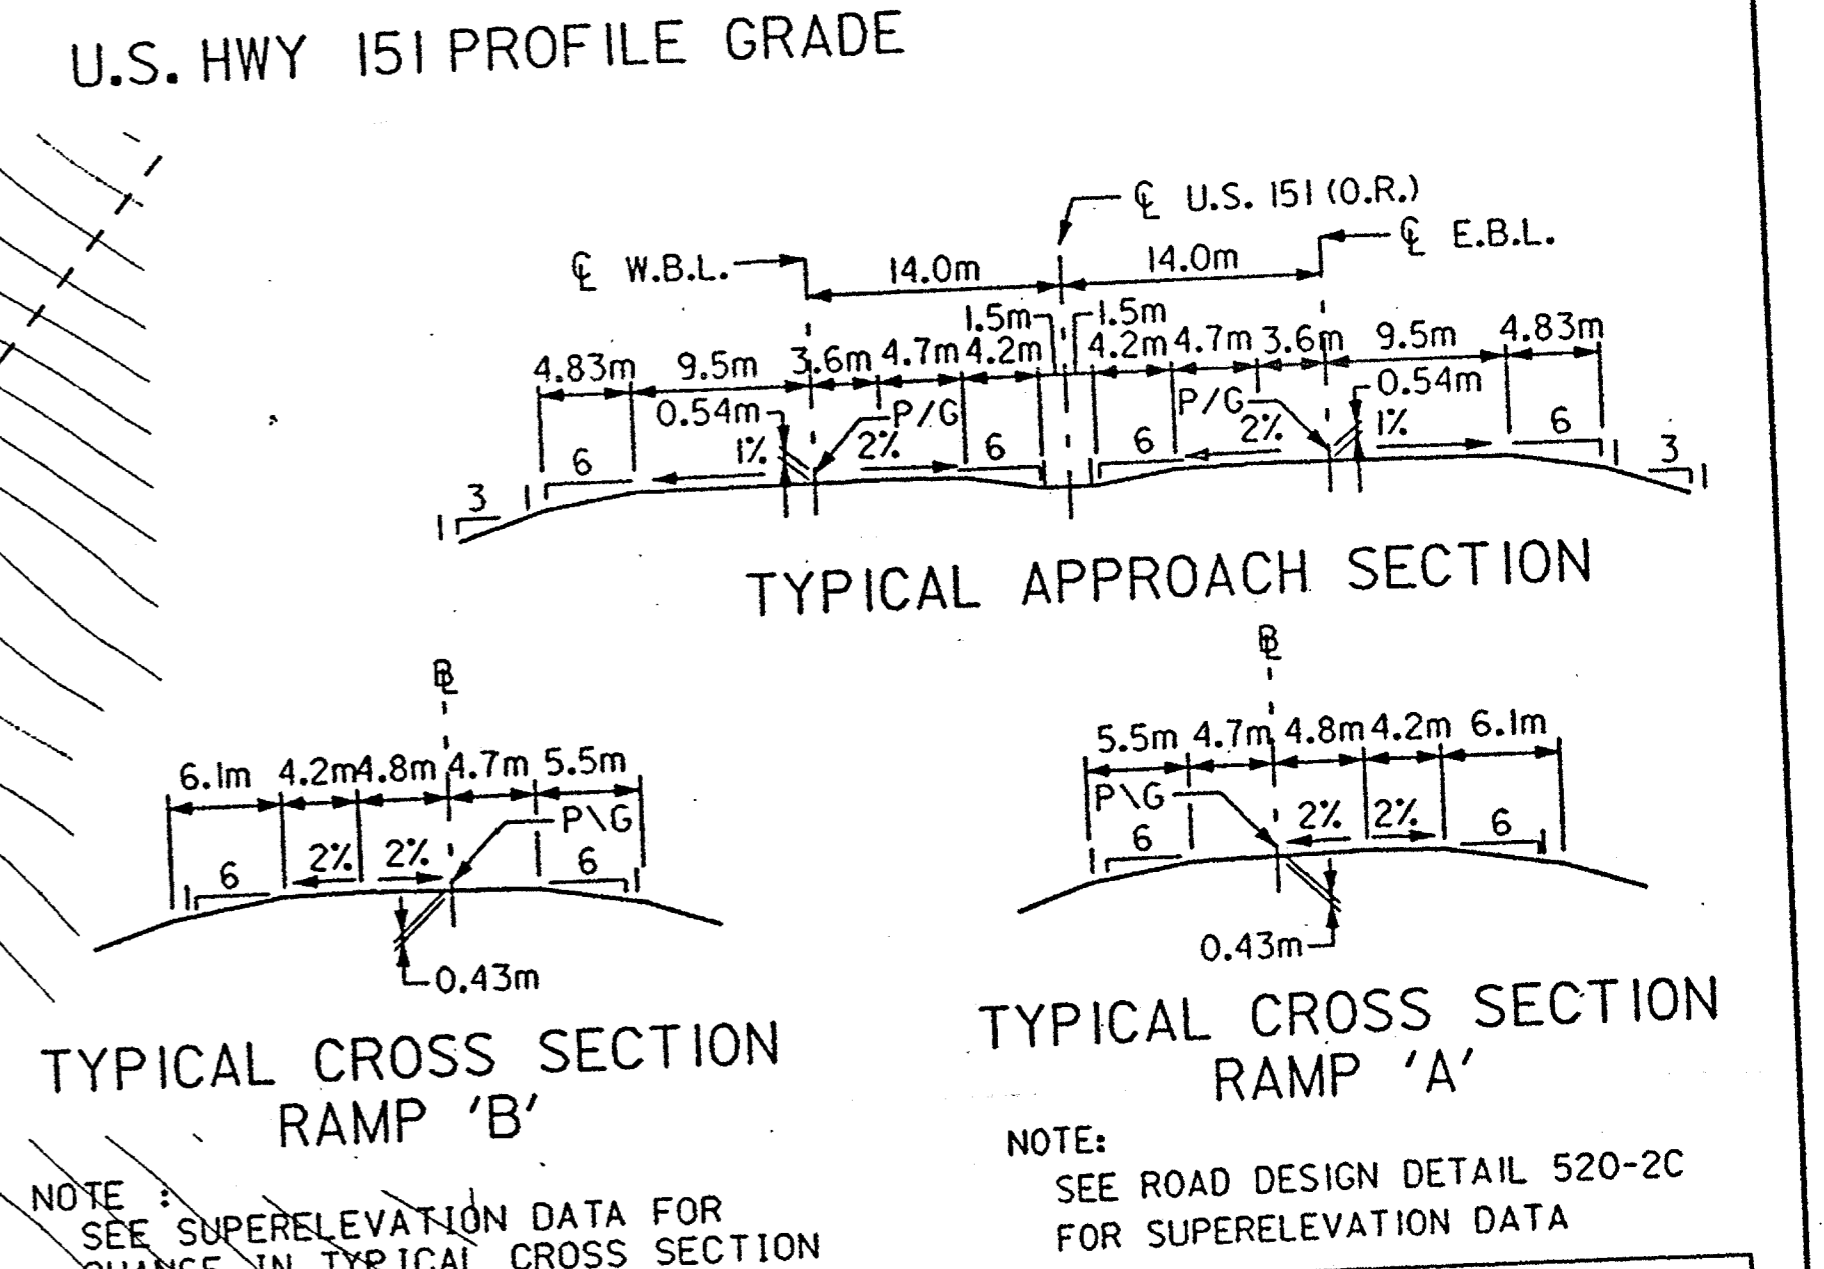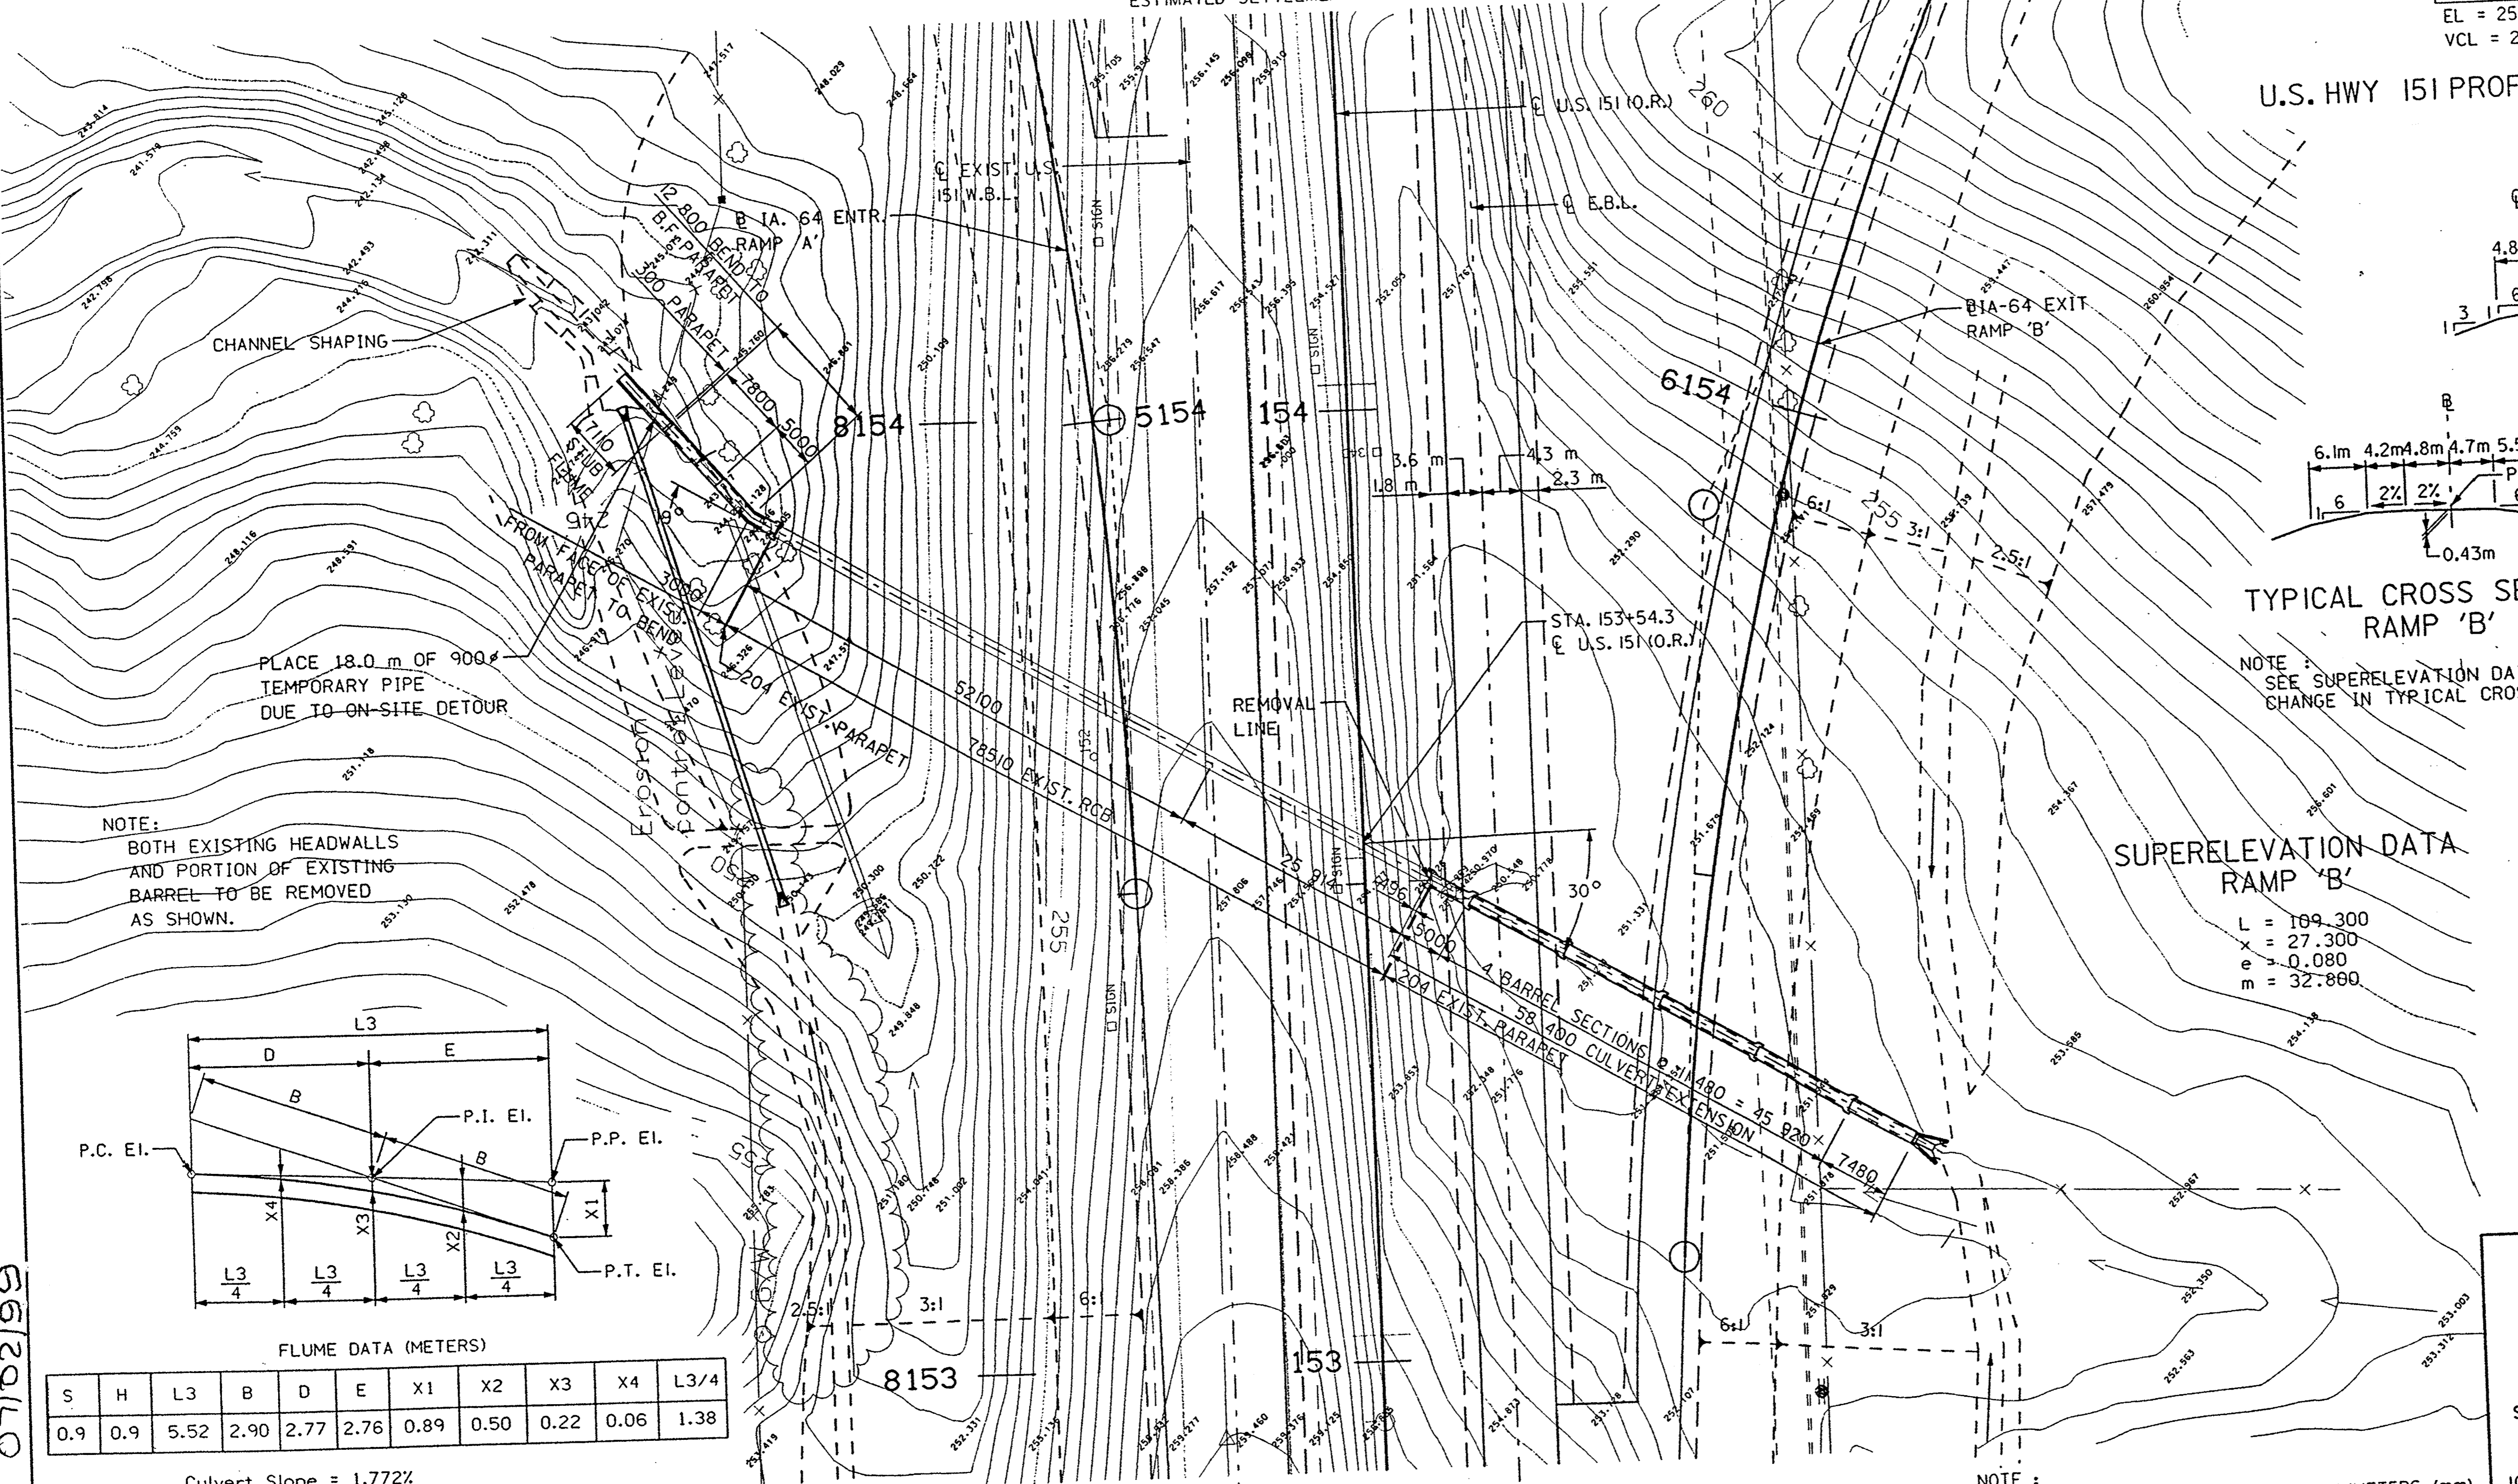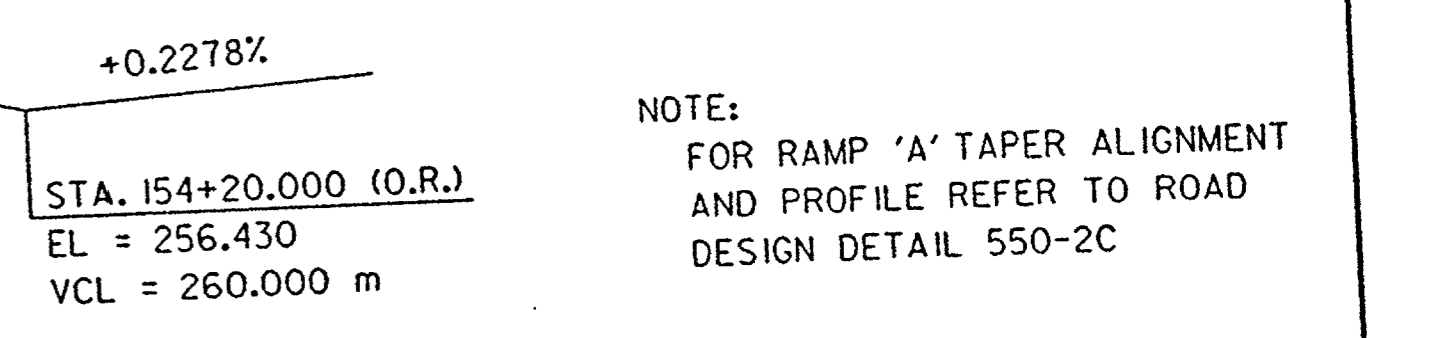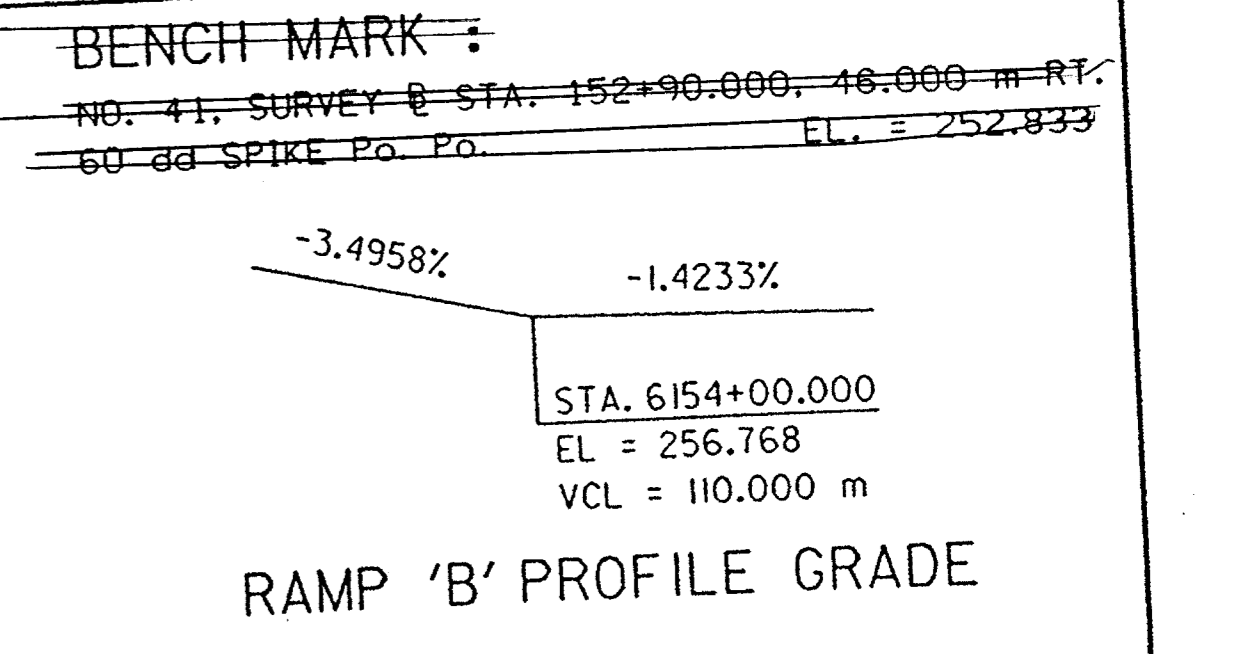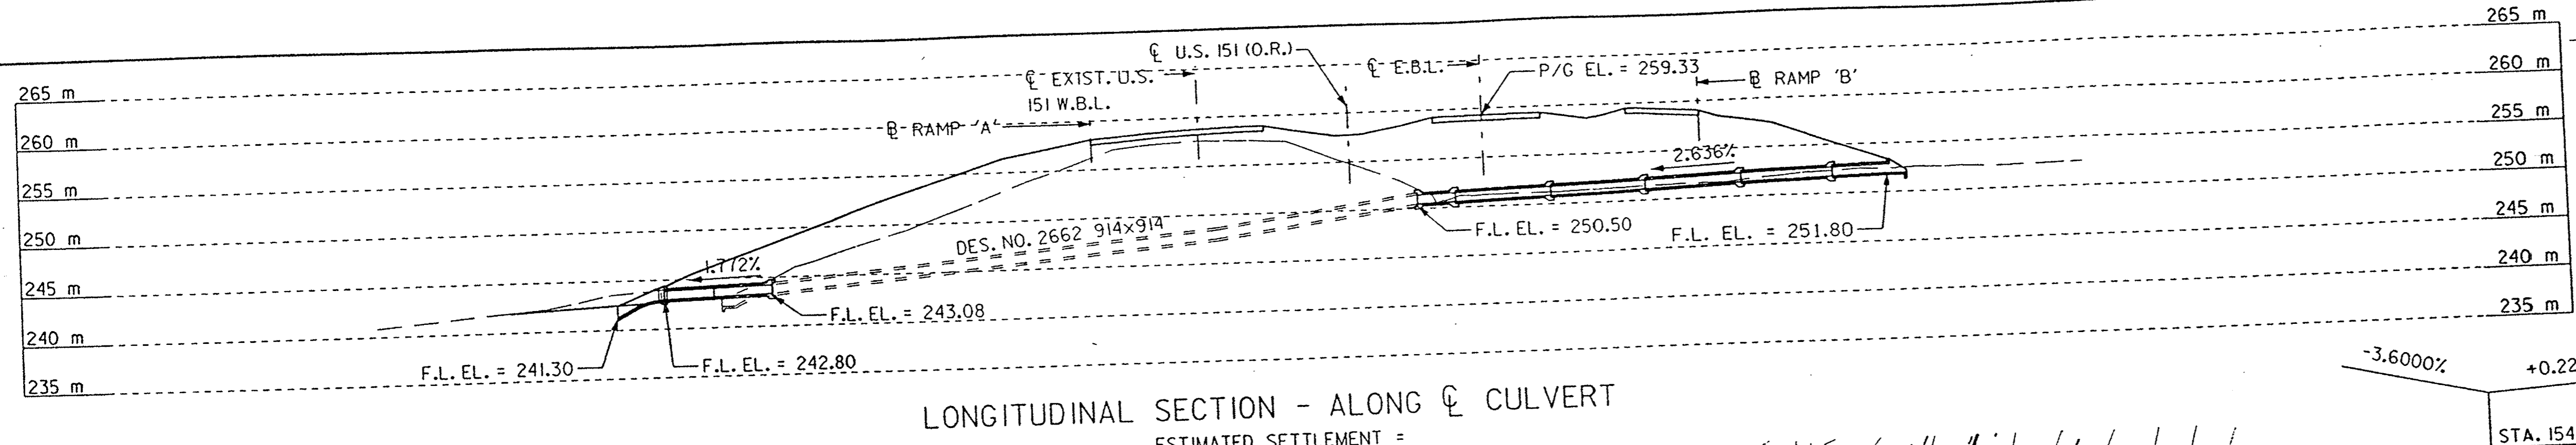


HYDRAULIC DATA

FREQUENCY	DISCHARGE (cms)	HEADWATER ELEV.
10-YEAR	1.51	252.93
25-YEAR	1.73	253.08
50-YEAR	2.16	253.41
100-YEAR	2.59	253.83

LOCATION: T84N - R4W, SECTION 11 & 12, FAIRVIEW TWP., JONES COUNTY

TRAFFIC DATA:

Year	ADT	DHV	TRUCKS (%)
2001	6590	7910	11%
2021	7910	850	12%

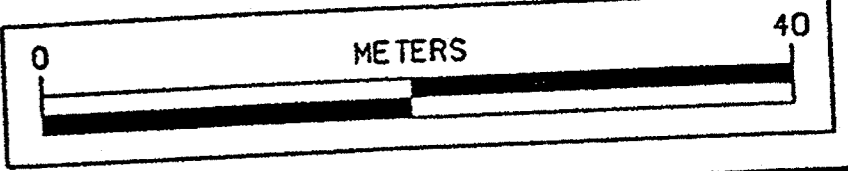

DESIGN FOR 30° SKEW (L.A.) EXTENSION LEFT
WITH 19° BEND AND STUB FLUME AND EXTENSION RIGHT

0.9 m x 0.9 m x 74.2 m REINFORCED
CONCRETE BOX CULVERT EXT.
SITUATION PLAN

STA. 153+54.3 (O.R.) U.S. HIGHWAY 151

JONES COUNTY, IOWA

IOWA DEPARTMENT OF TRANSPORTATION - PROJECT DEVELOPMENT DIVISION

DESIGN SHEET NO. 1 OF 1 FILE NO. 1398

STATE: IOWA REGION: 7 FISCAL YEAR: SHEET NO. TOTAL SHEETS: 88/90

FLUME DATA (METERS)

S	H	L3	B	D	E	X1	X2	X3	X4	L3/4
0.9	0.9	5.52	2.90	2.77	2.76	0.89	0.50	0.22	0.06	1.38

Culvert Slope = 1.772%
P.C. El. = 242.80
P.I. El. = 242.75
P.P. El. = 242.70
P.T. El. = 241.82

SITUATION PLAN
FILL HT. = 7.0 m

NOTE:
ALL DIMENSIONS SHOWN ARE IN MILLIMETERS (mm)
UNLESS OTHERWISE NOTED OR SHOWN.



DESIGNED BY: DLN TRACED BY: JAE
DETAILED BY: DLN CHECKED BY: RMJ

RUST
Rust Environment & Infrastructure Inc.

JONES COUNTY PROJECT NUMBER: NHSX-151-4(63)-3H-53

V.05

07/02/99

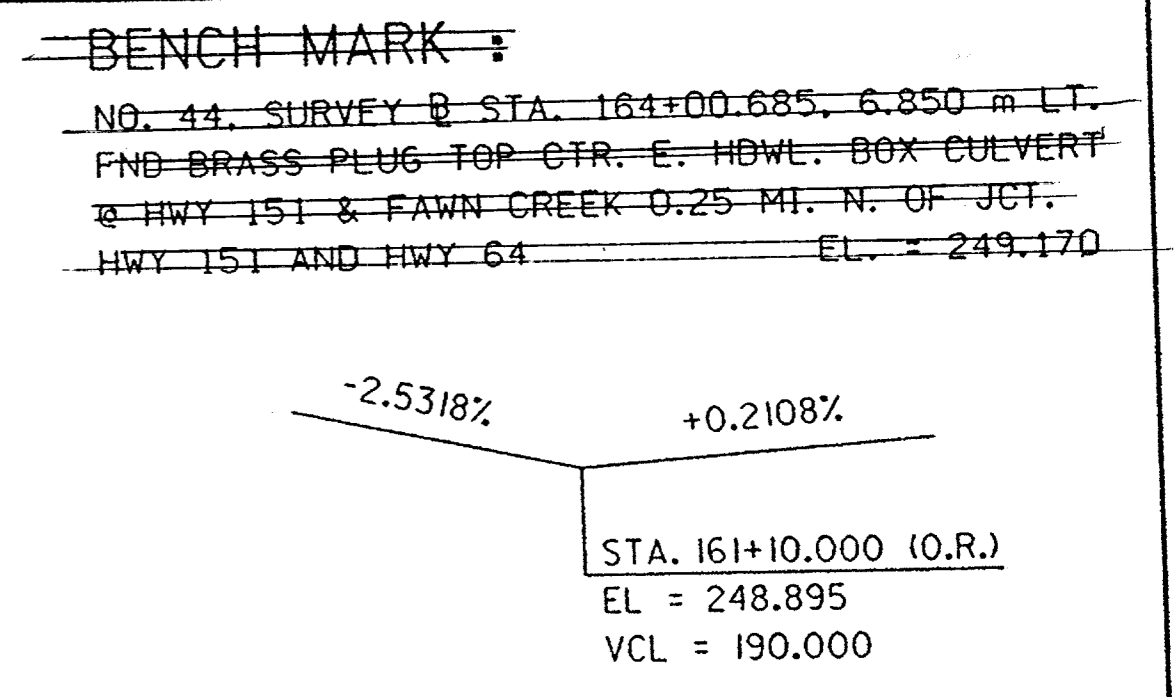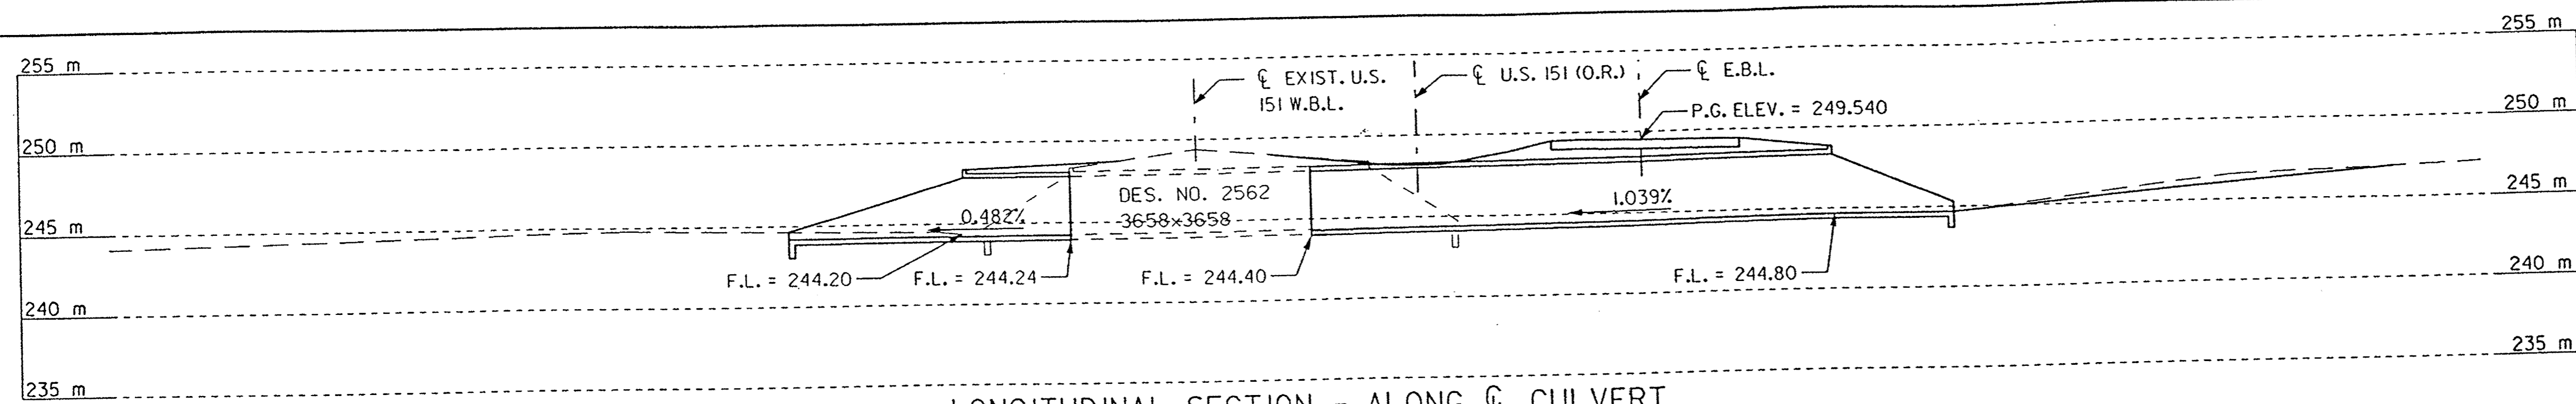



HYDRAULIC DATA

FREQUENCY	DISCHARGE (cms)	HEADWATER ELEV.
10-YEAR	13.90	246.75
25-YEAR	20.07	247.28
50-YEAR	25.02	247.66
100-YEAR	30.50	248.07

DRAINAGE AREA = 404.7 ha, ROLLING
 50 YEAR DESIGN FREQUENCY


LOCATION

T84N - R4W
 SECTION 1 & 2
 FAIRVIEW TWP.
 JONES COUNTY

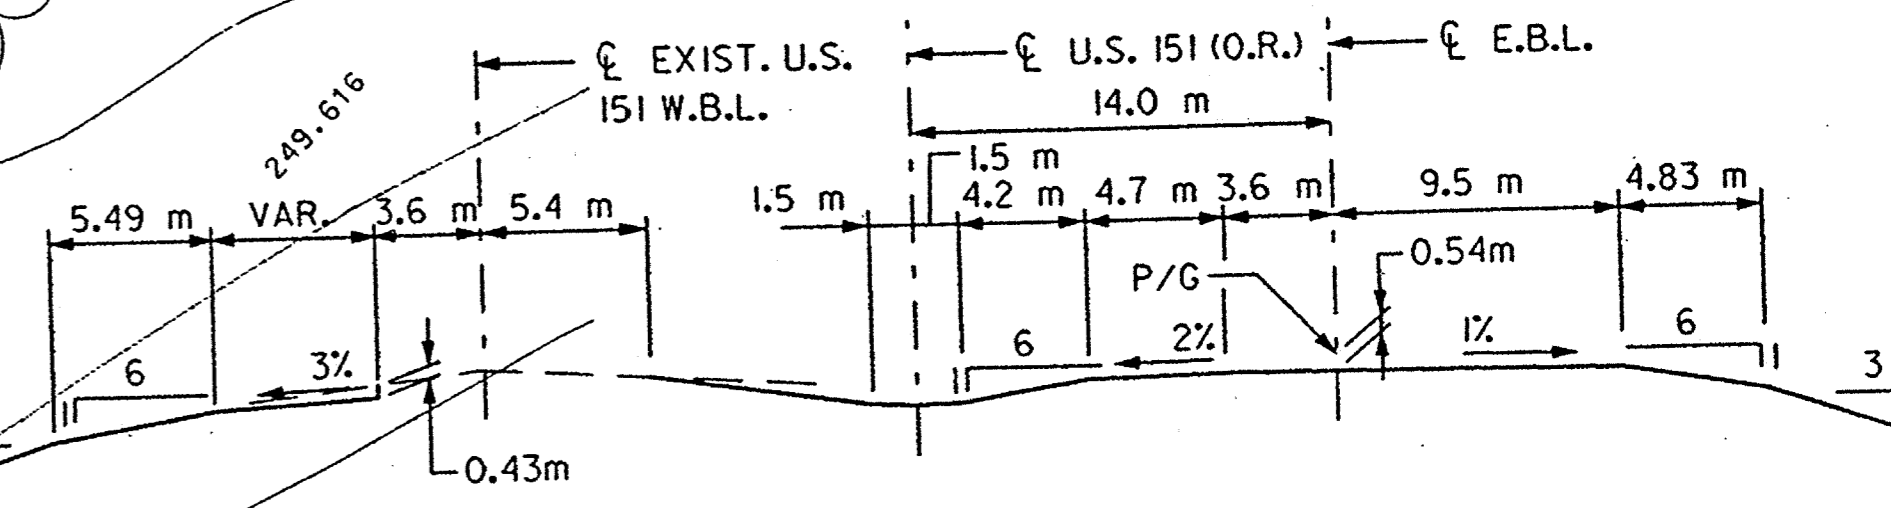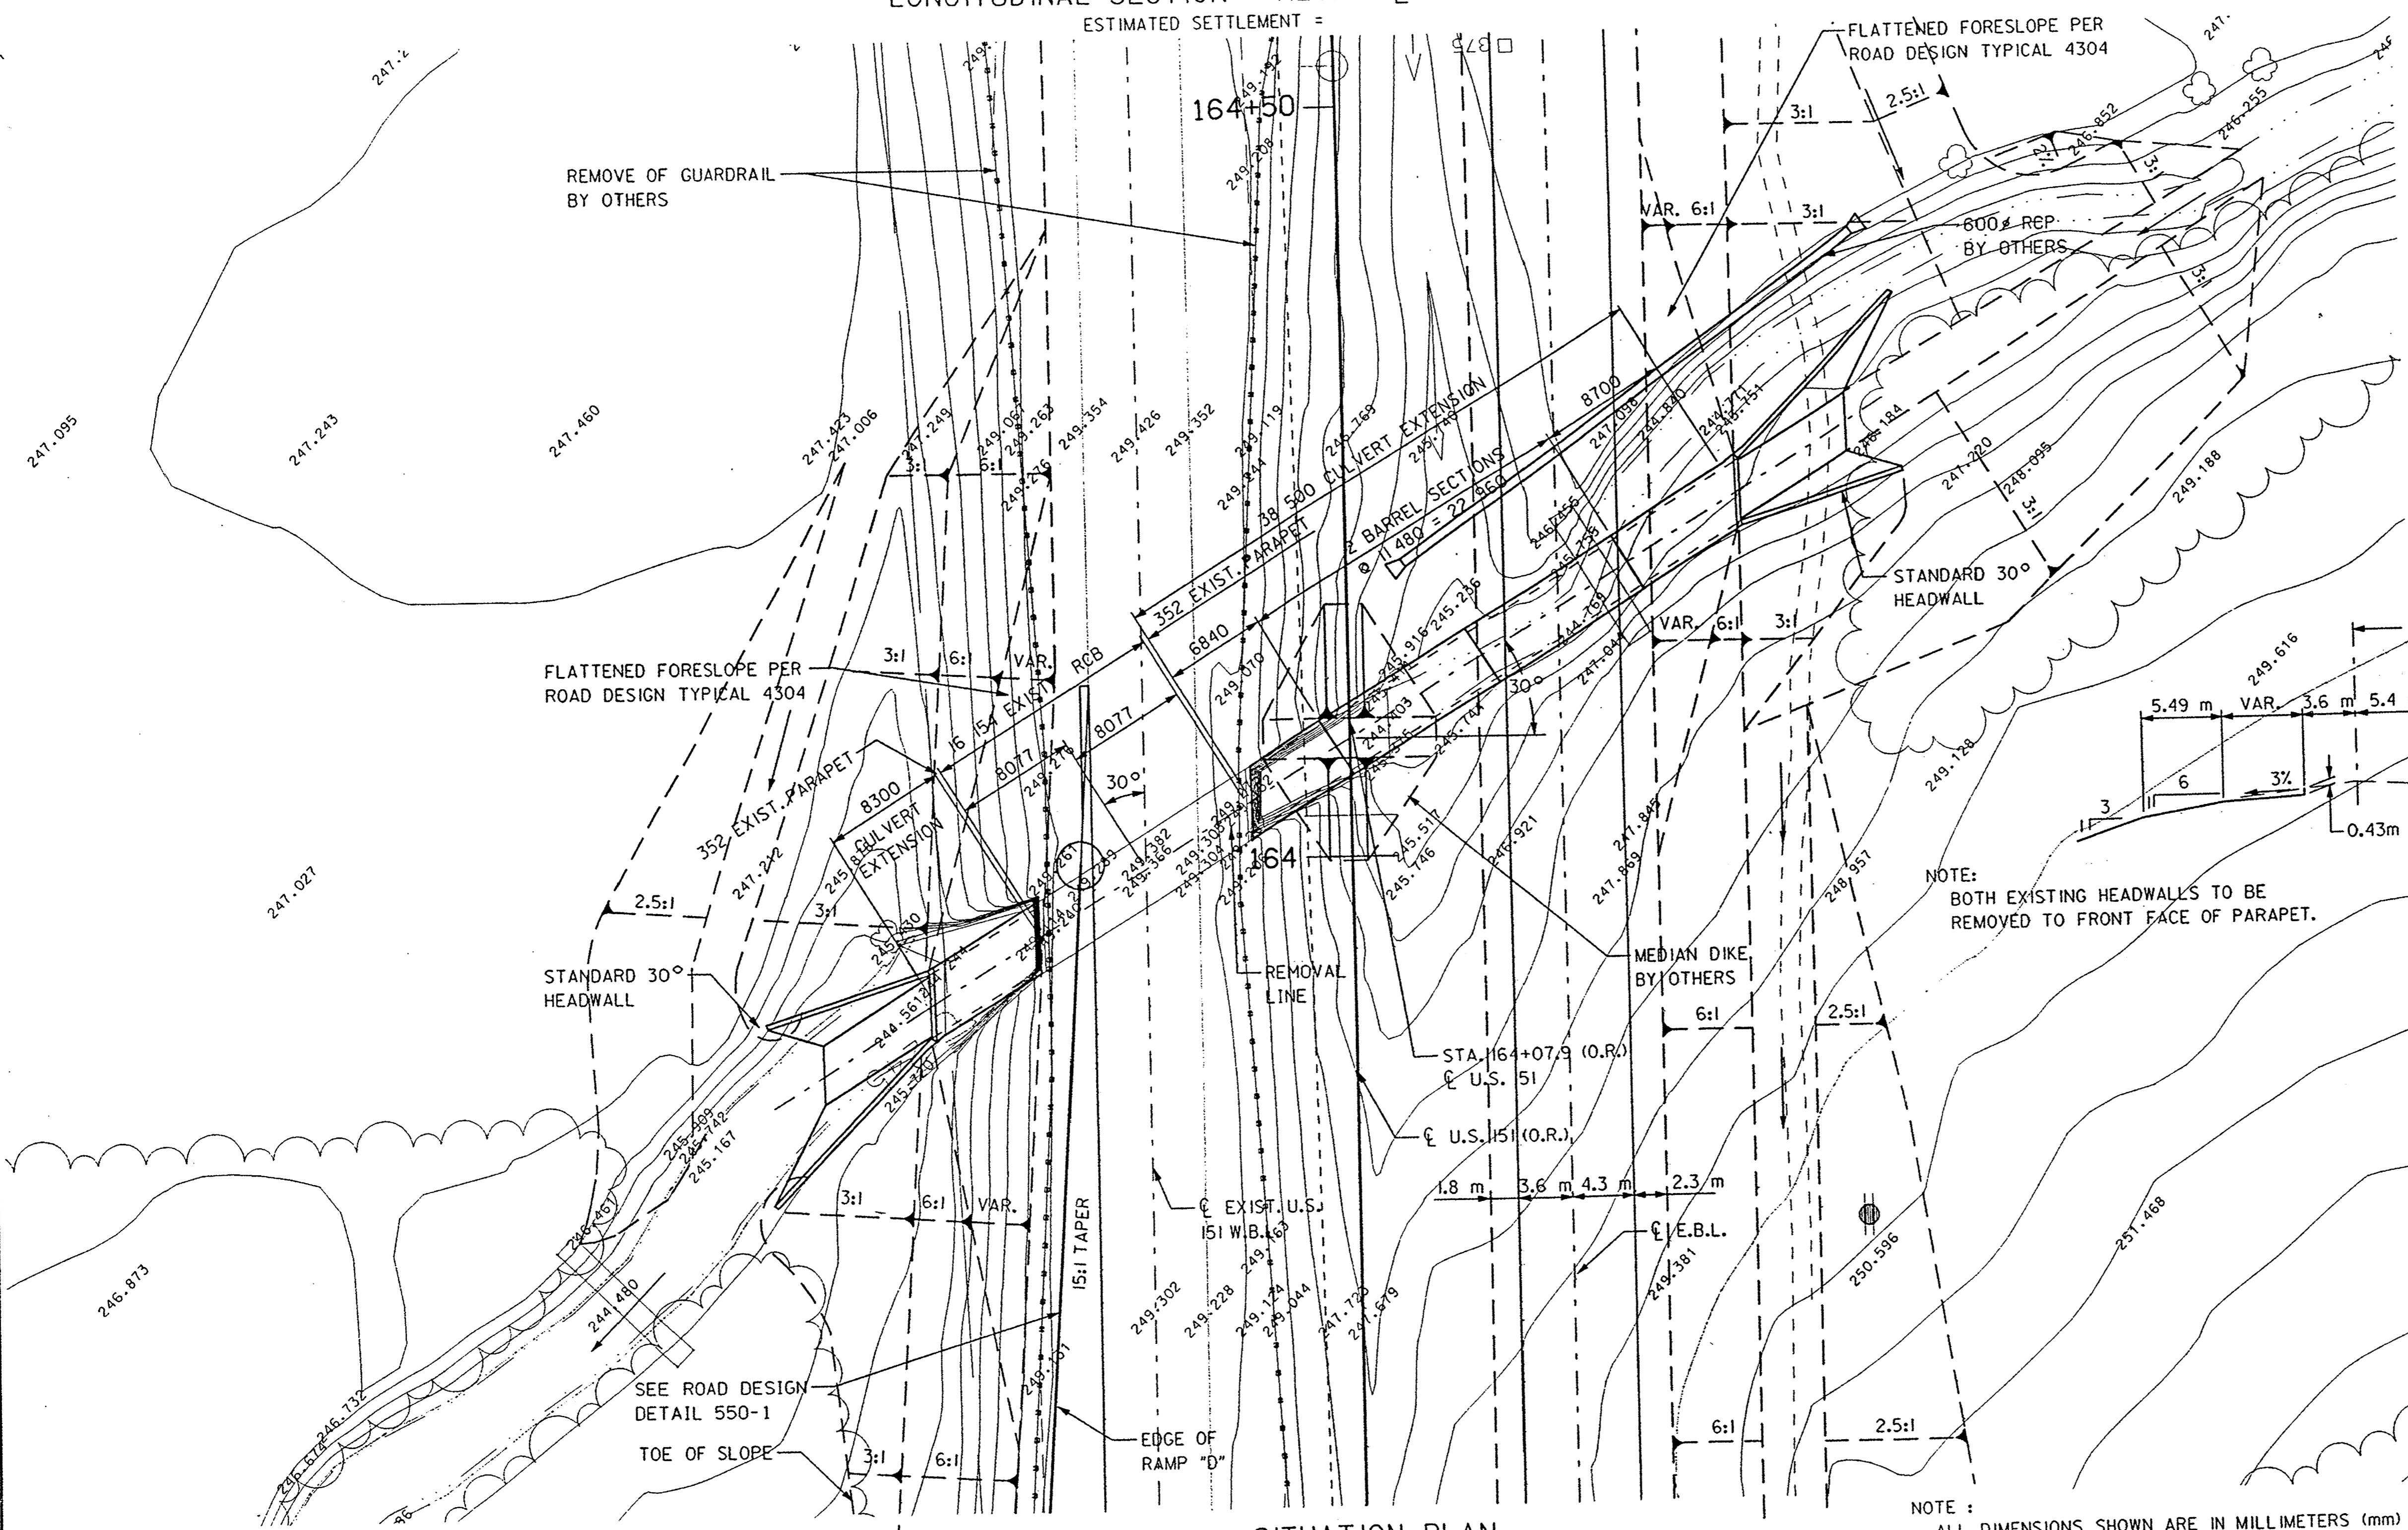

TRAFFIC DATA

2001	ADT	5530
2021	ADT	6630
2021	DHV	712
2001	TRUCKS	11%
2021	TRUCKS	13%

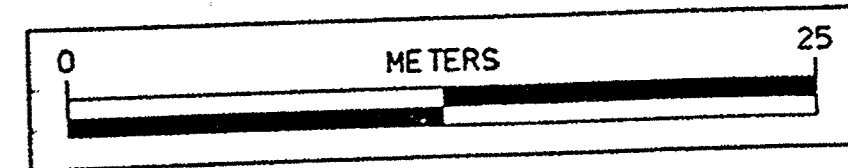

DESIGN FOR 30° SKEW (R.A.) EXTENSION LEFT AND RIGHT
 3.6 m x 3.6 m x 46.8 m REINFORCED
 CONCRETE BOX CULVERT EXT.
 SITUATION PLAN
 STA. 164+07.9 (O.R.) @ U.S. HIGHWAY 151
 JONES COUNTY, IOWA
 IOWA DEPARTMENT OF TRANSPORTATION - PROJECT DEVELOPMENT DIVISION
 DESIGN SHEET NO. 1 OF 1 FILE NO. DESIGN NO. 1698

NOTE:
 ALL DIMENSIONS SHOWN ARE IN MILLIMETERS (mm)
 UNLESS OTHERWISE NOTED OR SHOWN.

06/20/20


DESIGNED BY DLN TRACED BY JAE
 DETAILED BY DLN CHECKED BY RMJ

RUST
 Rust Environment & Infrastructure Inc.

JONES COUNTY PROJECT NUMBER **NHSX-151-4(63)-3H-53**

STATE	FHWA REGION	FISCAL YEAR	SHEET NO.	TOTAL SHEETS
IOWA	7		89/100	

V.06

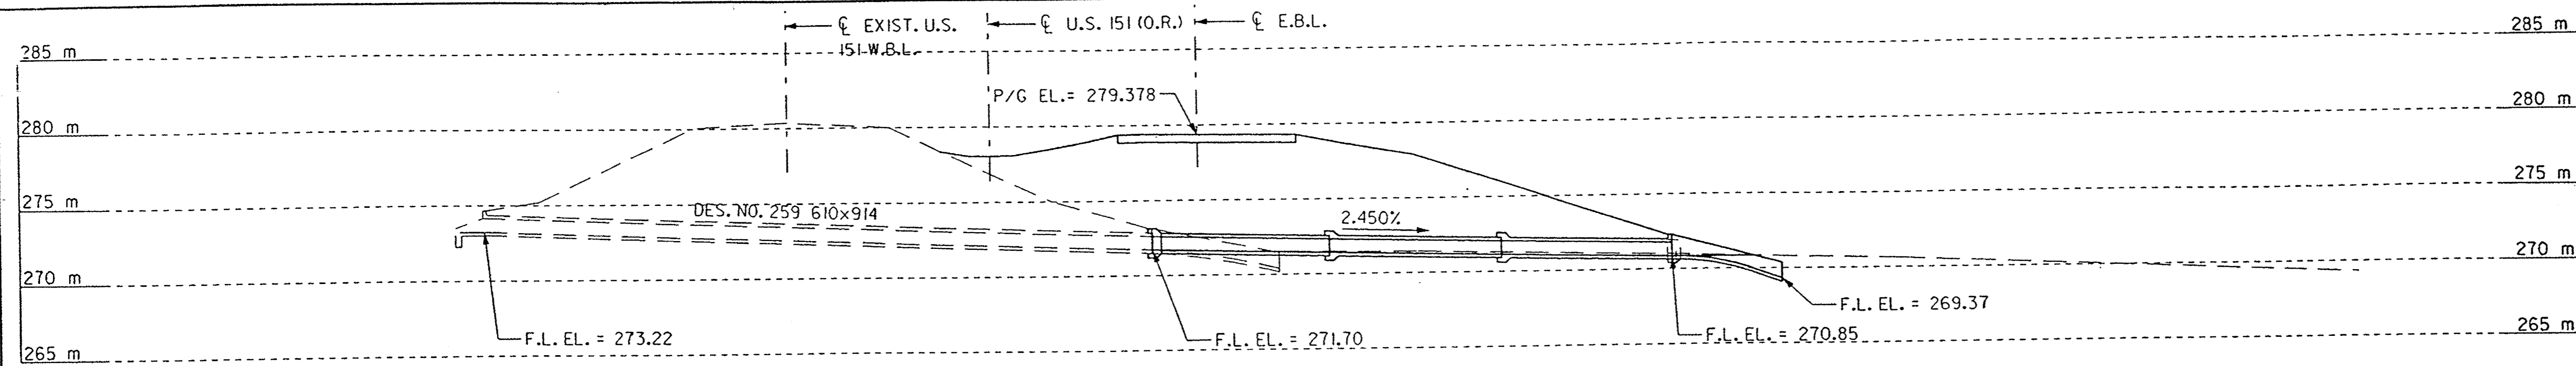


BENCH MARK
 NO. 39, SURVEY B STA. 142+66.177,
 50.853 m LT. 60 dd SPIKE PO, PO.
 EL. 265.429

+0.2718%

STA. 181+00.000 (O.R.) EL. 278.008
 STA. 187+25.000 (O.R.) EL. 279.707

**U.S. HWY. 151
 PROFILE GRADE**

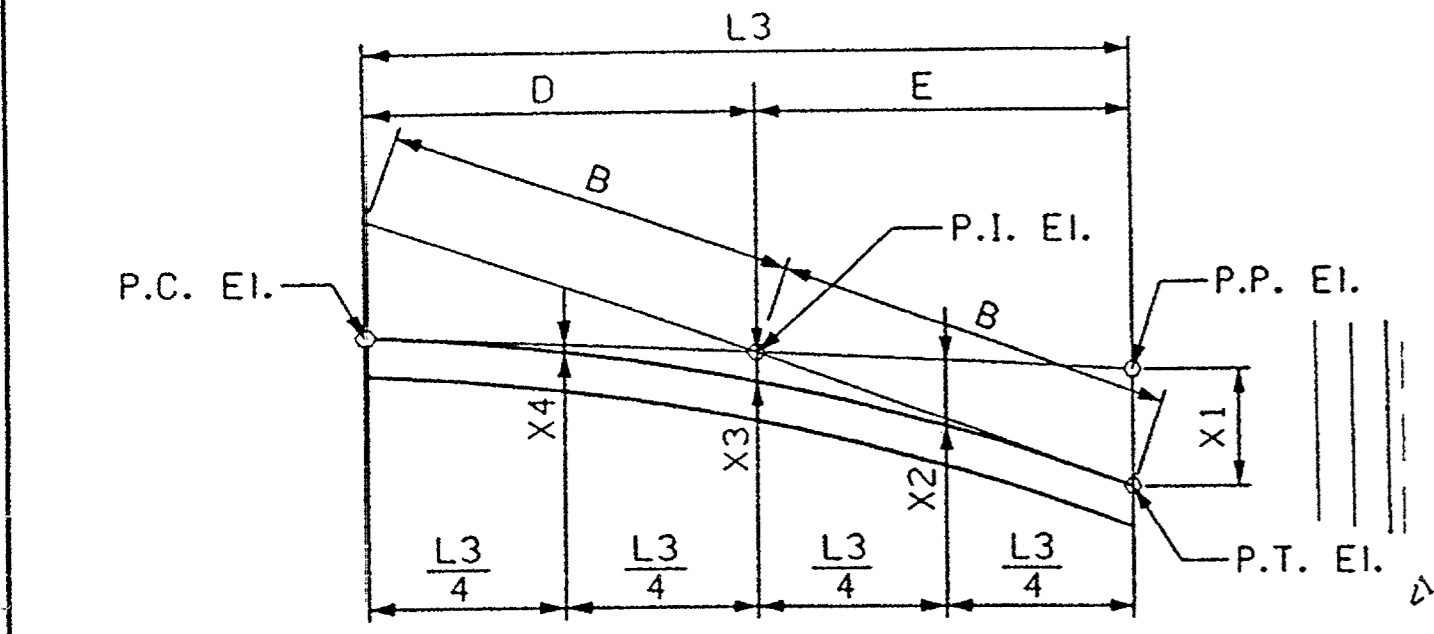


LONGITUDINAL SECTION - ALONG CULVERT
 ESTIMATED SETTLEMENT =

FLUME DATA (METERS)

S	H	L3	B	D	E	X1	X2	X3	X4	L3/4
0.9	0.9	5.73	3.01	2.88	2.86	0.88	0.50	0.22	0.06	1.43

Culvert Slope = 2.450%
 P.C. El. = 270.85
 P.I. El. = 270.78
 P.P. El. = 270.71
 P.T. El. = 269.83

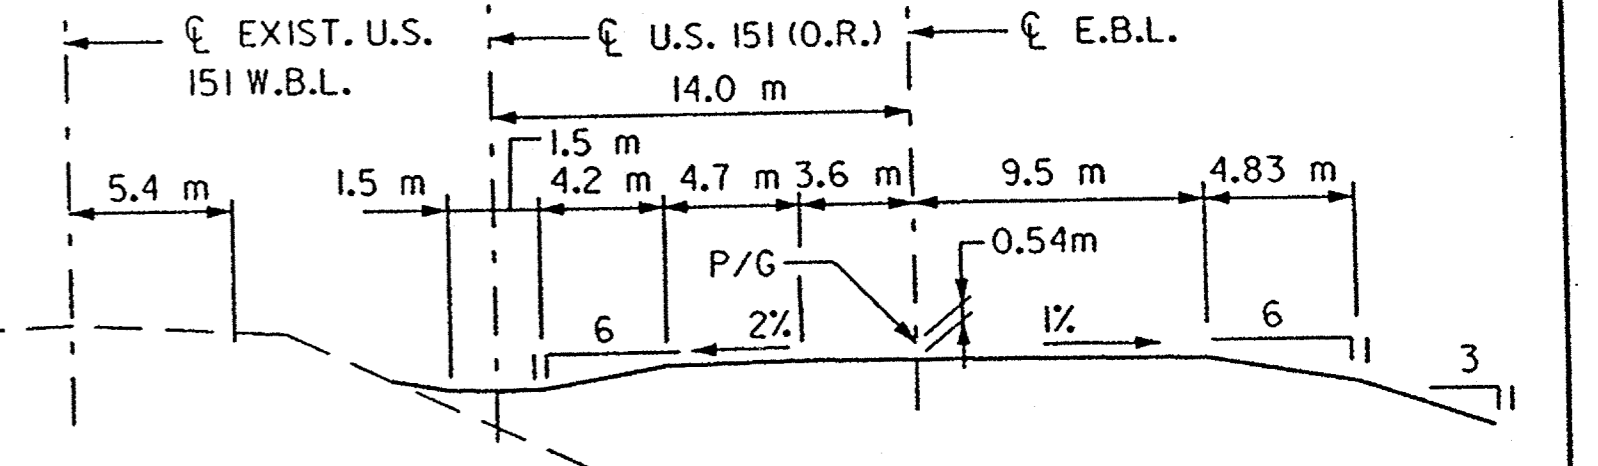

TYPICAL APPROACH SECTION

HYDRAULIC DATA


FREQUENCY	DISCHARGE(cms)	HEADWATER ELEV.
10-YEAR	0.64	274.02
25-YEAR	0.73	274.10
50-YEAR	0.92	274.27
100-YEAR	1.10	274.44

DRAINAGE AREA = 5.3 ha, ROLLING
 50 YEAR DESIGN FREQUENCY

LOCATION
 T85N - R4W
 SECTION 36
 CASS TWP.
 JONES COUNTY

TRAFFIC DATA

2001 ADT	7480
2021 ADT	8950
2021 DHV	960
2001 TRUCKS	10%
2021 TRUCKS	11%

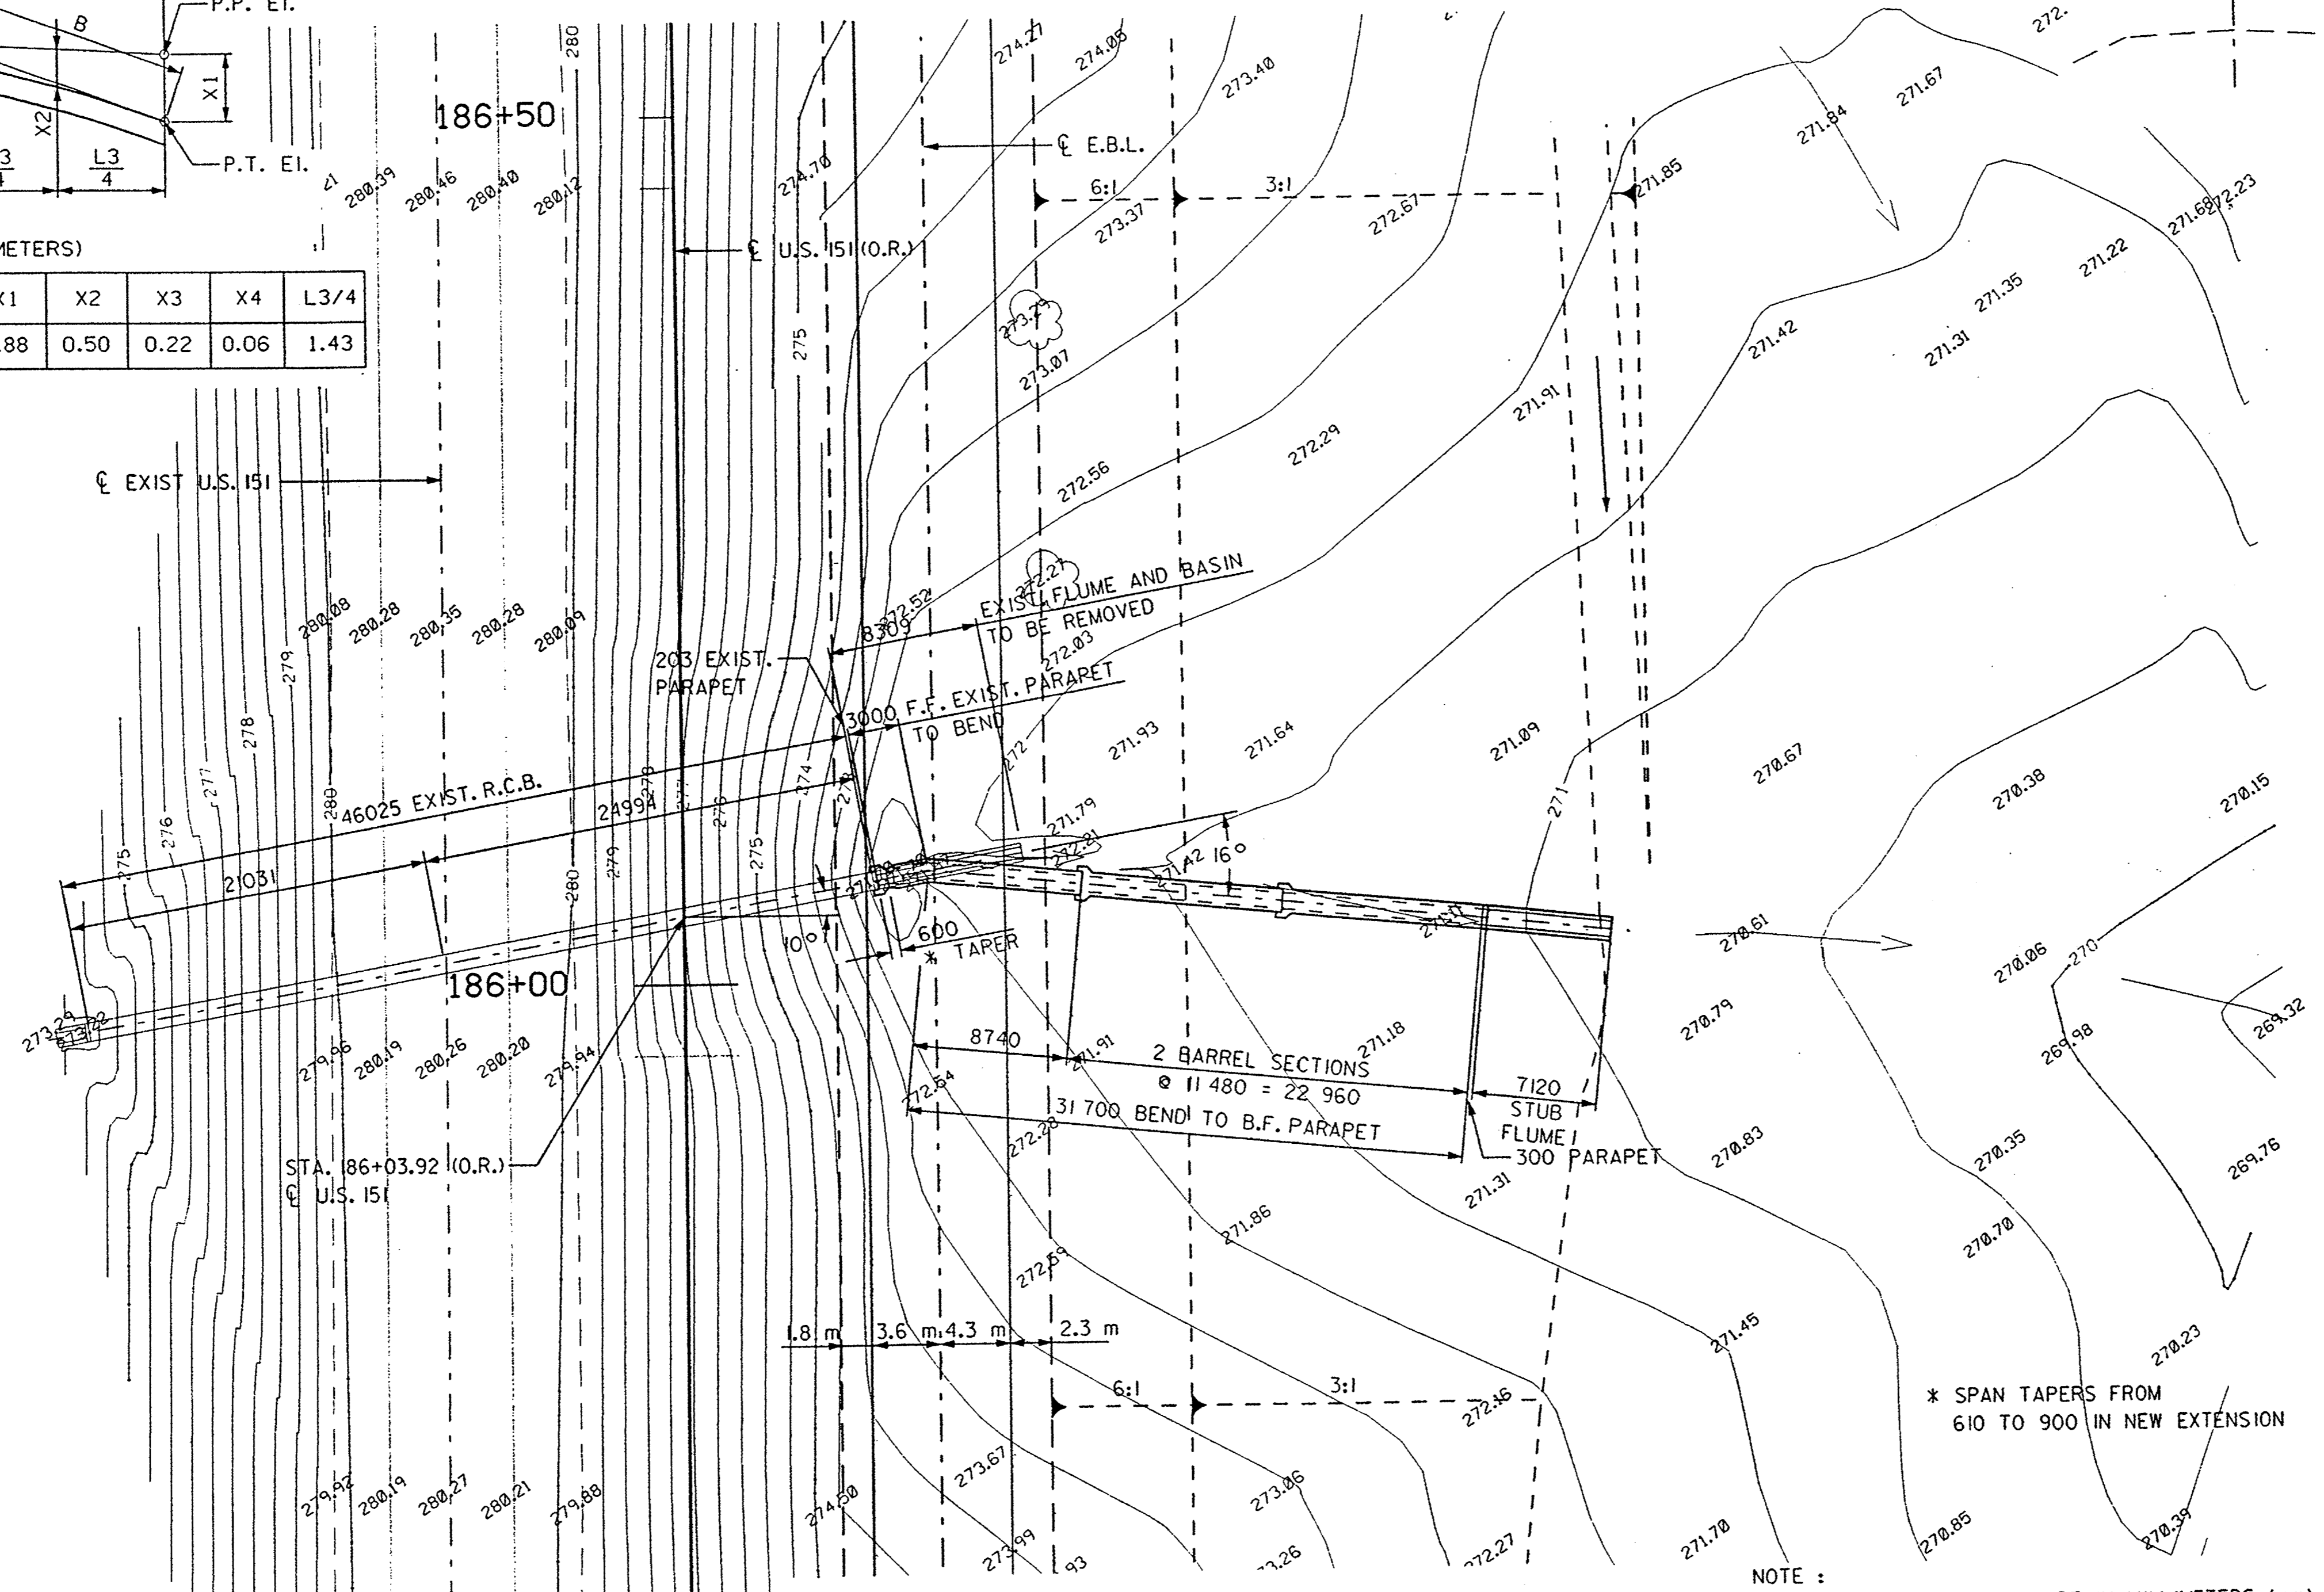

SITUATION PLAN
 FILL HT. = 6.4 m

NOTE :
 ALL DIMENSIONS SHOWN ARE IN MILLIMETERS (mm)
 UNLESS OTHERWISE NOTED OR SHOWN.

* SPAN TAPERS FROM
 610 TO 900 IN NEW EXTENSION

06/20/00

DESIGNED BY _____ DLN TRACED BY JAE
 DETAILED BY _____ DLN CHECKED BY RMJ

RUST
 Rust Environment & Infrastructure Inc.

JONES COUNTY PROJECT NUMBER **NHSX-151-4(63)-3H-53**

DESIGN FOR 10° SKEW (R.A.) EXTENSION RIGHT
 WITH 16° BEND AND STUB FLUME
**0.9 m x 0.9 m x 34.7 m REINFORCED
 CONCRETE BOX CULVERT EXT.**
 SITUATION PLAN
 STA. 186+03.92 (O.R.) C U.S. HIGHWAY 151
 JONES COUNTY, IOWA
 IOWA DEPARTMENT OF TRANSPORTATION - PROJECT DEVELOPMENT DIVISION
 DESIGN SHEET NO. 1 OF 1 FILE NO. _____ SHEET NO. 1798
 TOTAL SHEETS 20/90